



F.A.I.	SECTION	COUNTY	TOTAL SHEETS	SHEET NO.
94/90	*	COOK	556	13
STA.	TO STA.			
FED. ROAD DIST. NO.	ILLINOIS	FED. AID PROJECT		
62300	*1818, ETC, 2324.6-1PR-8			

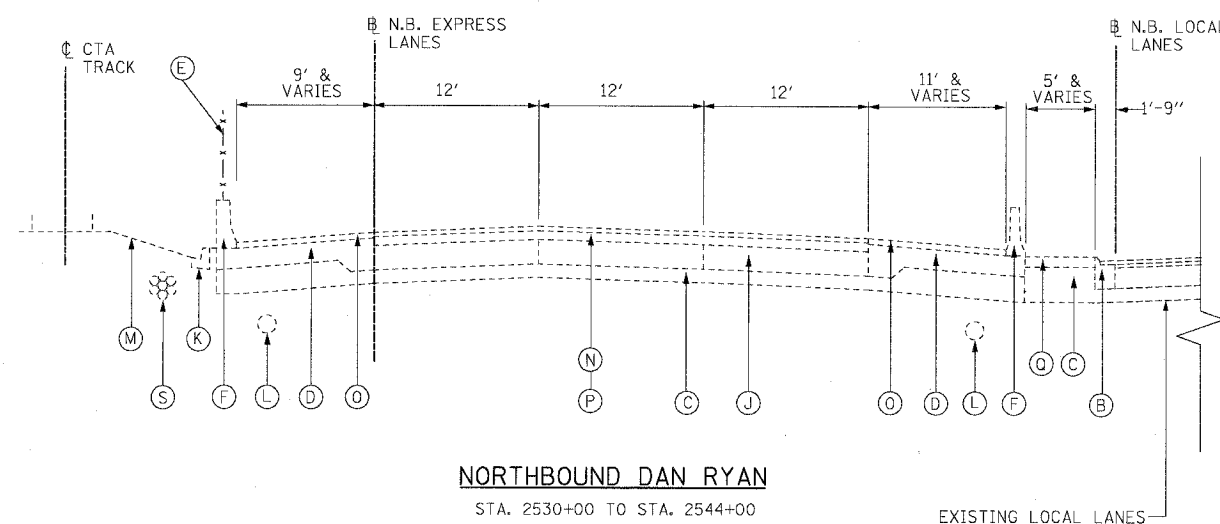


NORTHBOUND DAN RYAN
STA. 2530+00 TO STA. 2544+00

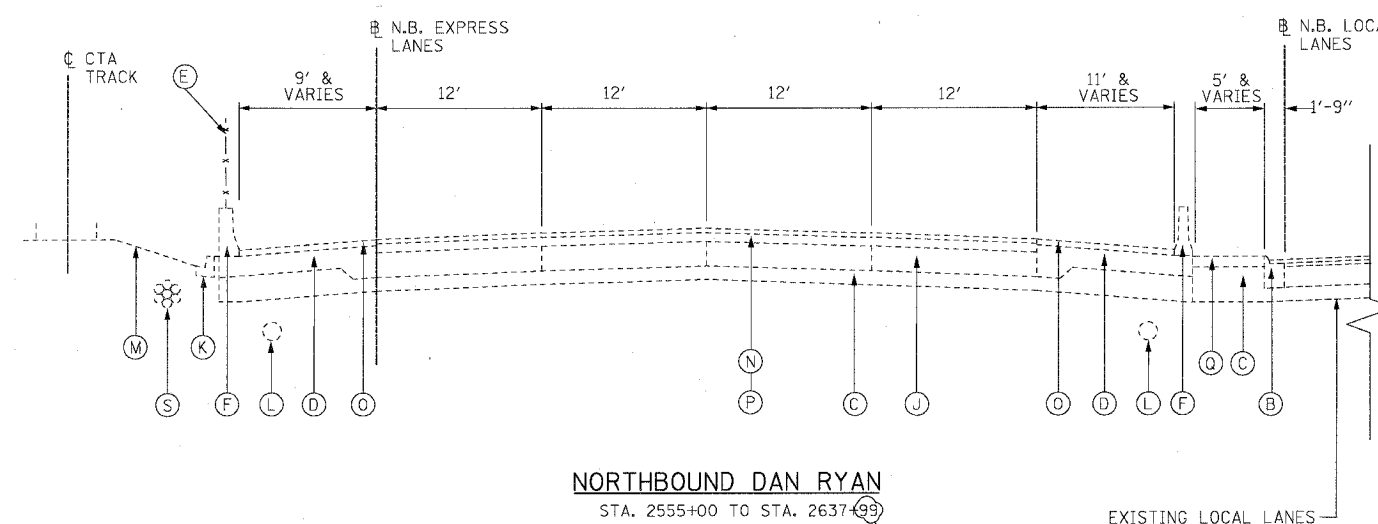

NORTHBOUND DAN RYAN
STA. 2555+00 TO STA. 2637+99

(AREA OF SLIP RAMP GORES FROM STA. 2544+00 TO STA. 2555+00 IS SIMILAR TO THE ABOVE SECTIONS)

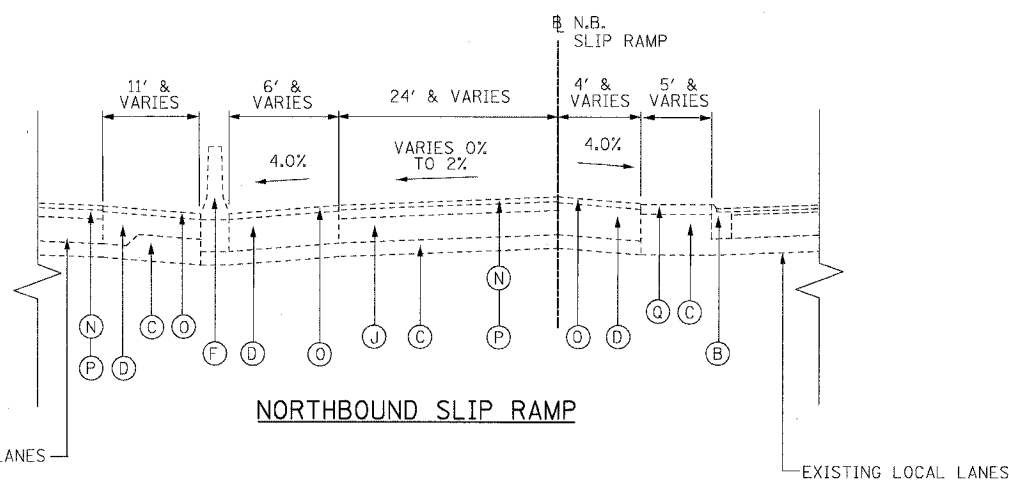

NORTHBOUND SLIP RAMP

EXISTING CONDITIONS LEGEND

- (A) P.C.C. PAVEMENT 10"
- (B) COMBINATION CONCRETE CURB AND GUTTER
- (C) GRANULAR SUB-BASE 6" (VARIES 18"-42" FROM STA. 2582+21 TO STA. 2637+55 - SEE SCHEDULE ON THIS SHEET- AND AT SHOULDERS)
- (D) P.C.C. SHOULDER 9"
- (E) CHAIN LINK FENCE
- (F) CONCRETE BARRIER
- (G) BITUMINOUS CONCRETE SURFACE COURSE, 1 1/2"
- (H) BITUMINOUS CONCRETE BINDER COURSE, 3/4"
- (I) TEMPORARY CONCRETE BARRIER
- (J) C.R.C. PAVEMENT 8"
- (K) TYPE 34 CURB AND GUTTER
- (L) PIPE UNDERDRAINS 8 "
- (M) C.T.A. BALLAST
- (N) BITUMINOUS CONCRETE SURFACE COURSE, 1 3/4"
- (O) BITUMINOUS CONCRETE SURFACE COURSE, 2 1/4"
- (P) BITUMINOUS CONCRETE BINDER COURSE, 3/2"
- (Q) 4" STABILIZED SHOULDER B.A.M.
- (R) BITUMINOUS CONCRETE SURFACE COURSE 1 3/4"
- (S) BITUMINOUS CONCRETE BASE COURSE 12 1/4"
- (T) C.T.A. FIBER OPTIC DUCT

EXISTING VARYING DEPTH SUB-BASE GRANULAR MATERIAL	
STATION	DEPTH
2582+21 - 2586+54	18"
2586+54 - 2587+54	18" - 36"
2587+54 - 2605+69	36"
2605+69 - 2607+84	36" - 18"
2607+84 - 2608+79	18"
2608+79 - 2611+84	24" - 42"
2611+84 - 2618+84	42"
2618+84 - 2622+84	42" - 18"
2622+84 - 2627+34	18" - 42"
2627+34 - 2631+64	42"
2631+64 - 2636+34	42" - 18"
2636+34 - 2637+55	18" - 26"
2637+55 - 2637+99	26"

NOTES:

1. THICKNESS OF EXISTING PAVEMENT AND SUB BASES ARE TAKEN FROM AS-BUILT PLANS.
2. SUPERELEVATED SECTIONS ARE SIMILAR TO TANGENT SECTIONS.
3. REMOVAL OF TYPE 34 COMBINATION CONCRETE CURB AND GUTTER SHALL BE PERFORMED AS REQUIRED. THIS REMOVAL WILL BE INCLUDED IN THE COST OF CTA BARRIER REMOVAL AND WILL NOT BE PAID FOR SEPARATELY.

BOWMAN, BARRETT & ASSOCIATES INC.
CONSULTING ENGINEERS
Chicago, Illinois
312 228 0100
www.bbainc.com

REVISIONS	
NAME	DATE
ADDENDUM 2	9/16/05

ILLINOIS DEPARTMENT OF TRANSPORTATION
F.A.I. 94/90 (DAN RYAN EXPRESSWAY)
31ST STREET TO 71ST STREET
NB EXPRESS LANE RECONSTRUCTION
EXISTING TYPICAL SECTIONS
NORTHBOUND DAN RYAN

SCALE: NTS
DATE: 07/07/05
DRAWN BY: TER
CHECKED BY: JDC

TYP-02

9/14/2005 9:02:53 PM