

CODE NO.	ITEM	UNIT	TOTAL QUANTITY	URBAN				
				CONSTRUCTION CODE				
				80% FED 20% STATE				
				0004				
			LOCATION 1	LOCATION 2	LOCATION 3	LOCATION 4	LOCATION 5	
			SN 049-0228	SN 049-2016	SN 049-2015	SN 049-0575		
* 78100300	REPLACEMENT REFLECTOR	EACH	182	16	88	36	42	
* 78200005	GUARDRAIL REFLECTORS, TYPE A	EACH	31	11	12	6	2	
* 78200011	BARRIER WALL REFLECTORS, TYPE C	EACH	14					14
78300202	PAVEMENT MARKING REMOVAL - WATER BLASTING	SQ FT	5339	670	2206	1222	1241	
K1004595	PRUNING FOR SAFETY AND EQUIPMENT CLEARANCE	L SUM	1	1 <del>0.5</del>			<del>0.5</del>	1
X0322194	POLYMER MODIFIED PORTLAND CEMENT MORTAR	SQ FT	132		38	94		
X0323723	CONCRETE BARRIER WALL REMOVAL AND REPLACEMENT, LOCATION 1	L SUM	1				1	
X0327301	RELOCATE EXISTING MAILBOX	EACH	1			1		
X0900064	MEMBRANE WATERPROOFING SYSTEM FOR BURIED STRUCTURES	SQ YD	78	22	41	15		
X0900075	COFFERDAM (TYPE 1) (IN-STREAM/WETLAND WORK)	EACH	5	1	1	1	1	1
X2501800	SEEDING, CLASS 4 (MODIFIED)	ACRE	0.45	0.09	0.1	0.09	0.16	0.01
X2502024	SEEDING, CLASS 4B (MODIFIED)	ACRE	0.44					
X5430110	CORRUGATED STEEL ARCH LINER	FOOT	139	139				
** X5537800	STORM SEWERS TO BE CLEANED 12"	FOOT	411	160	143	62	46	

\* SPECIALTY ITEM

\*\* NON-PARTICIPATING

MODEL: D:\p11710-745\PTB185-002\AES\W0418\_US\_41\_@\_Unnamed\_CCAD\Drawings\Civil\Sheets\16226-shdX-5007.dgn




USER NAME = all.issa	DESIGNED - AMI	REVISED -
PLOT SCALE = 80.0000' / in.	DRAWN - AMI	REVISED -
PLOT DATE = 6/18/2021	CHECKED - KJD, JMG	REVISED -
	DATE - 6/18/2021	REVISED -

**STATE OF ILLINOIS  
DEPARTMENT OF TRANSPORTATION**

**SUMMARY OF QUANTITIES  
US-41 CULVERTS**

SCALE: 80.0000' / in. SHEET 7 OF 8 SHEETS STA. TO STA.

F.A.P. RTE.	SECTION	COUNTY	TOTAL SHEETS	SHEET NO.
346	2019-049-T	LAKE	139	9
CONTRACT NO. 62J26			REVISED SHEET 10/15/2021	
ILLINOIS FED. AID PROJECT				

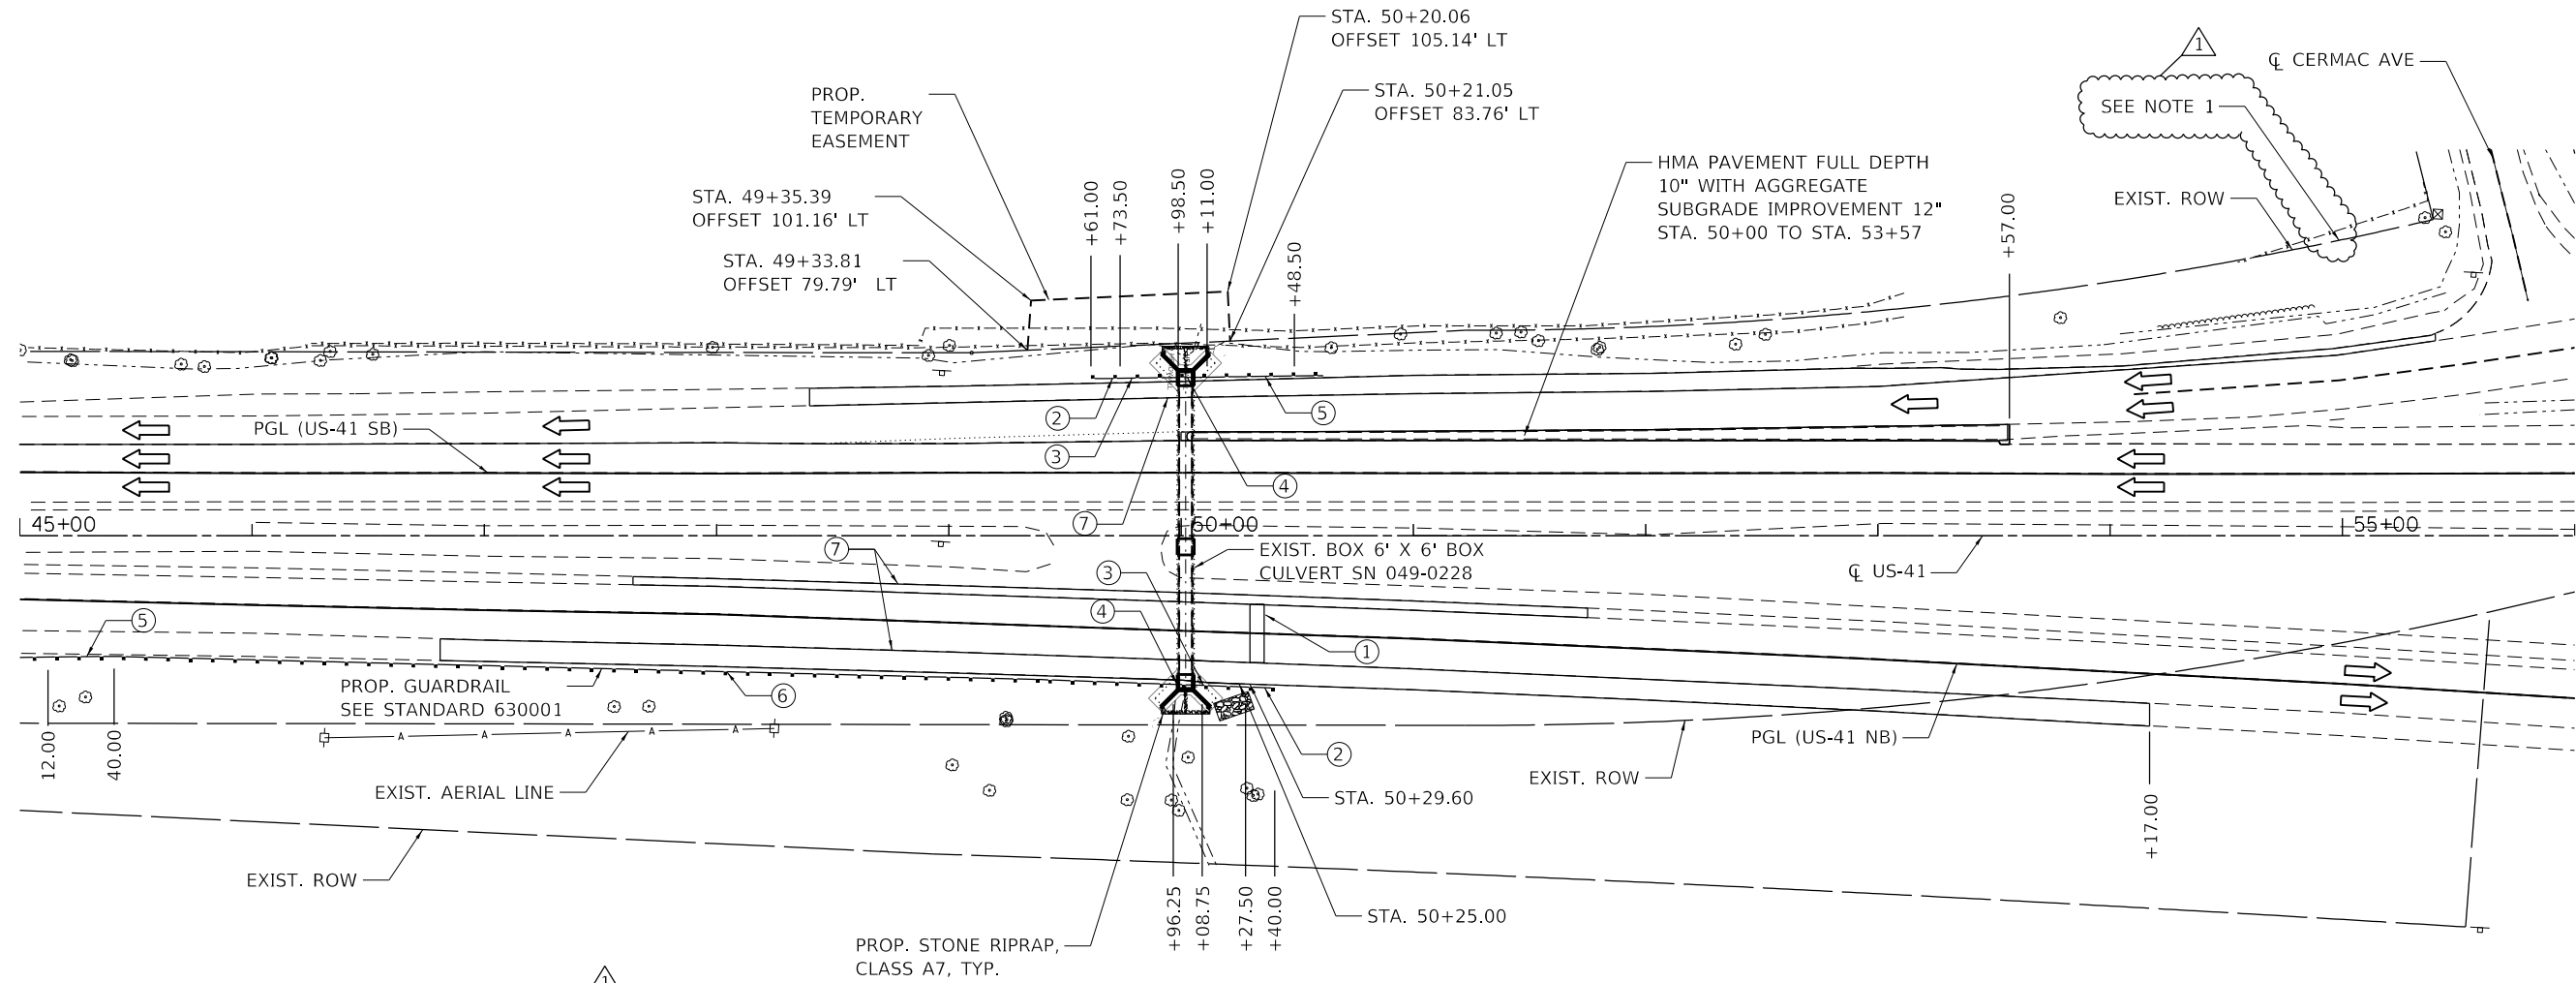

**NOTES:**

1. EXISTING TREES AND BRUSH ALONG THE WEST SHOULDER OF THE ON-RAMP SHALL BE PRUNED AND CLEARED PER THE "PRUNING FOR SAFETY AND EQUIPMENT CLEARANCE" SPECIAL PROVISION.

**PROPOSED PLAN**

**LEGEND**

- ⊕ EXIST. POWER POLE
- ➔ DIRECTION OF TRAFFIC
- PROP. GUARDRAIL
- ① CLASS D PATCHES, TYPE I, 13 INCH (SPECIAL)
- ② PROP. END OF GUARDRAIL BARRIER TERMINAL, TYPE 2, SEE STANDARD 631011
- ③ INSTALL 25.00 LF NEW SPBGR, TYPE A SEE STANDARD 630001
- ④ INSTALL 12.5 LF STRONG POST GUARDRAIL ATTACHED TO CULVERT, SEE STANDARD 630101
- ⑤ INSTALL NEW BARRIER TERMINAL, TYPE 1 (SPECIAL) TANGENT, 37.5 LF
- ⑥ INSTALL 462.50 LF NEW SPBGR TYPE A SEE STANDARD 630001
- ⑦ HMA SHOULDER, 12" WITH 4" SUBBASE GRANULAR MATERIAL, TYPE B

MODEL: D:\p1\17105745\_P1B185-002\_A651W0418\_US\_41\_@\_Unnamed\_C:\CADD\_Sheets\Civil\_Sheets\162126-shkx-plan1.dgn  
 FILE NAME: P117105745\_P1B185-002\_A651W0418\_US\_41\_@\_Unnamed\_C:\CADD\_Sheets\Civil\_Sheets\162126-shkx-plan1.dgn



USER NAME = ali.issa	DESIGNED - AMI	REVISED - 10/14/2021 AMI
PLOT SCALE = 80.0000' / in.	DRAWN - AMI	REVISED -
PLOT DATE = 10/14/2021	CHECKED - K/J, J/MG	REVISED -
	DATE - 10/14/2021	REVISED -

**STATE OF ILLINOIS  
DEPARTMENT OF TRANSPORTATION**

**ROADWAY PLAN WITH GORE RECONSTRUCTION - LOCATION 1  
US-41 CULVERTS**

SCALE: 80.0000' / in. SHEET 1 OF 4 SHEETS STA. TO STA.

F.A.P. RTE. 346	SECTION 2019-049-T	COUNTY LAKE	TOTAL SHEETS 139	SHEET NO. 40
CONTRACT NO. 62J26				
ILLINOIS FED. AID PROJECT				

1 REVISED SHEET 10/15/2021

