
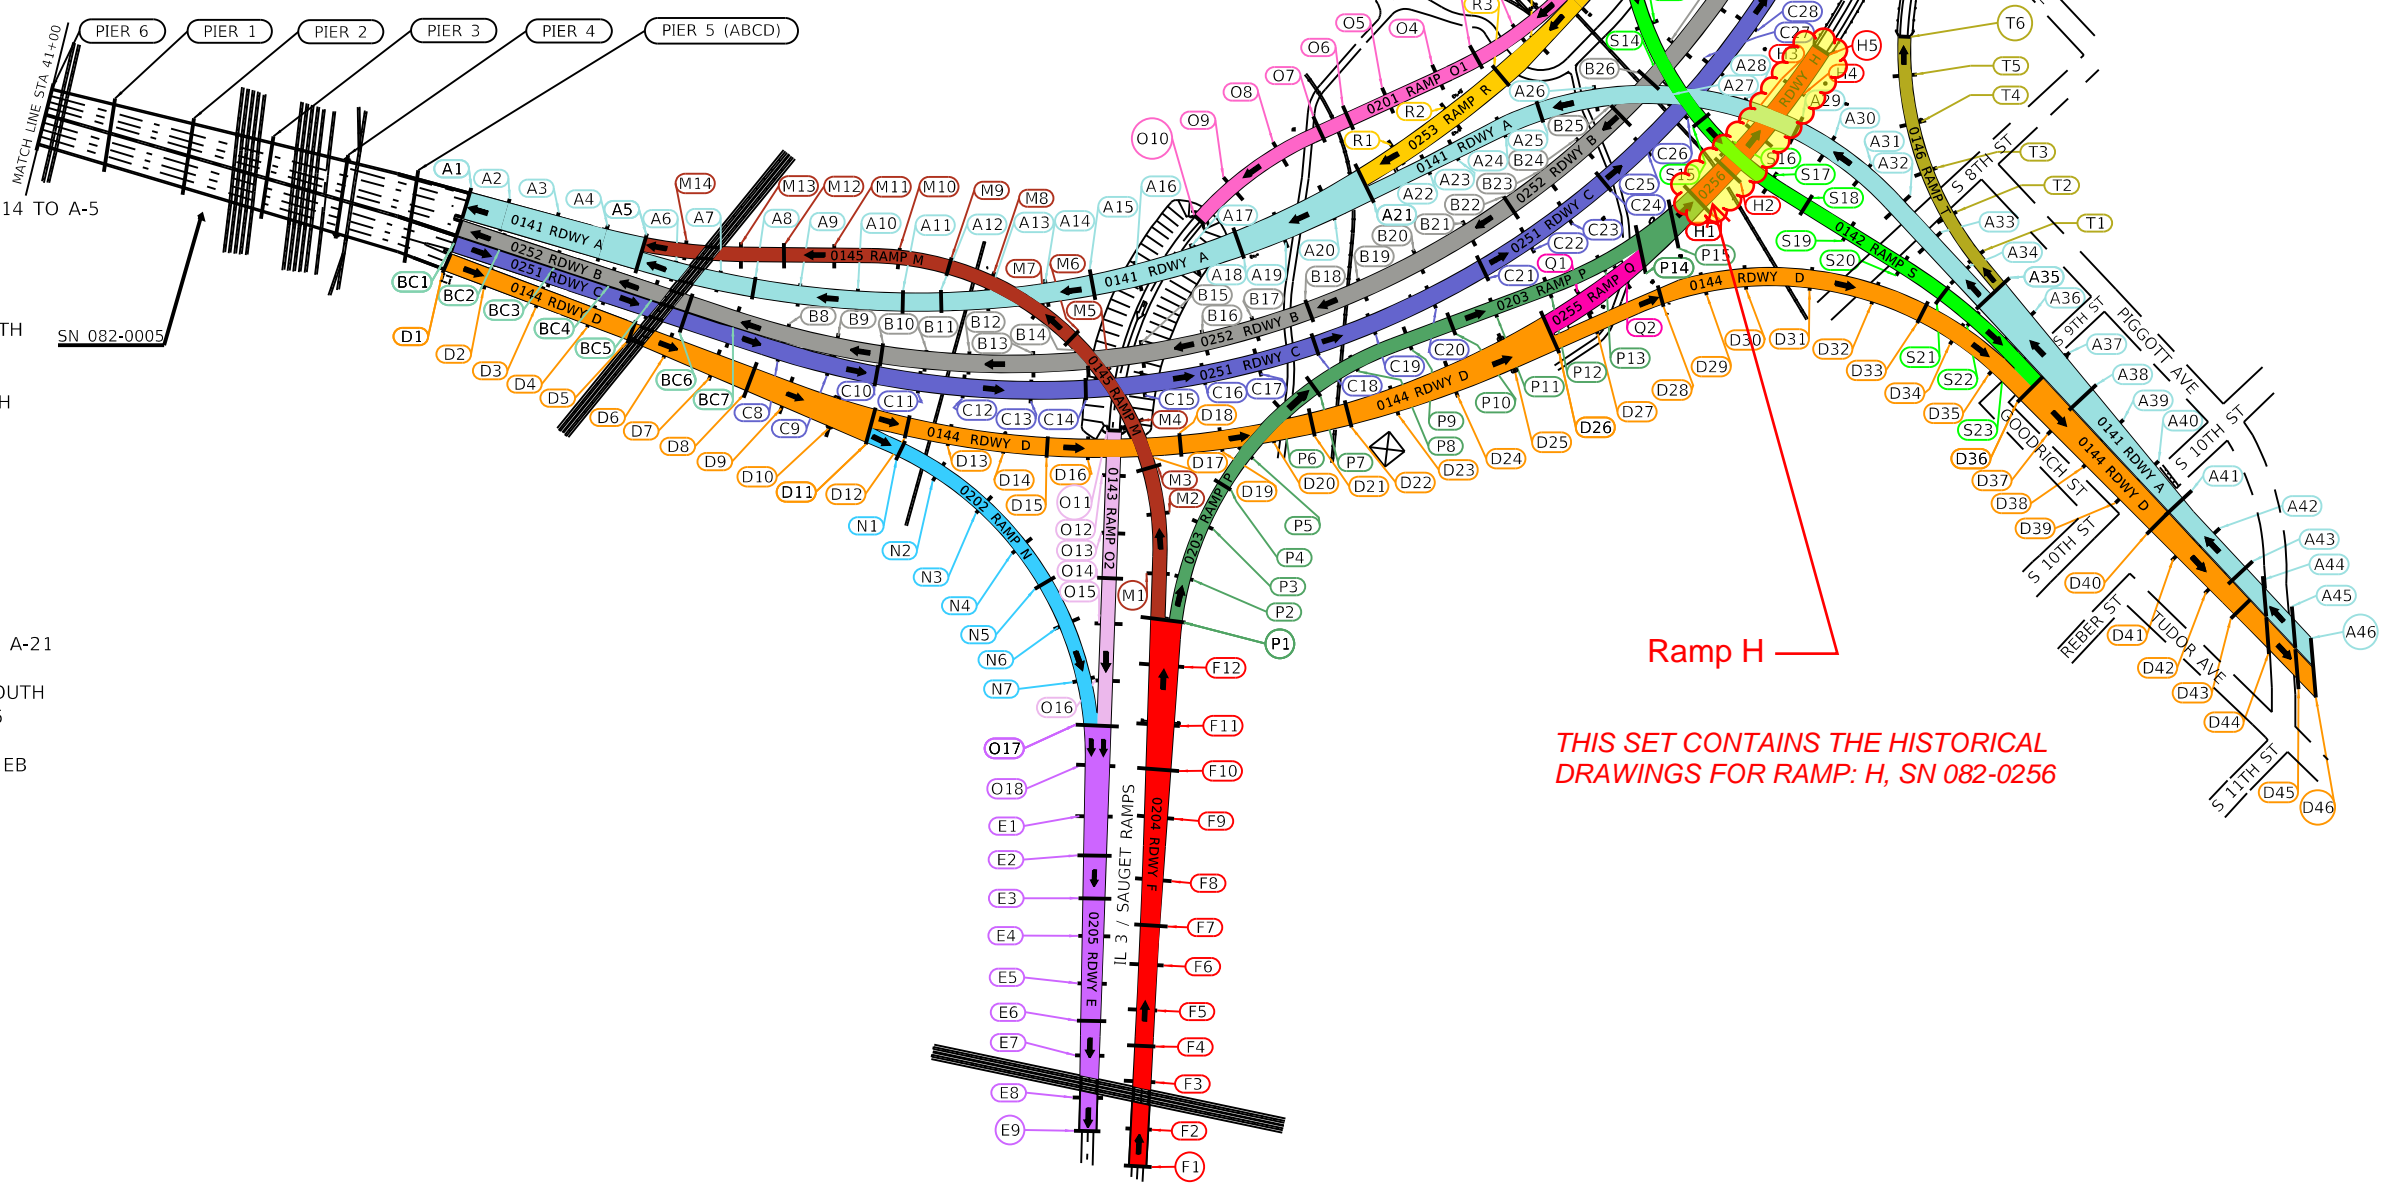


STRUCTURES

- 082-0004 - POPLAR ST. BRIDGE - ORTHOTROPIC - 5 SPAN
LIMITS - RIVER PIER #1 TO RIVER PIER #6
- 082-0005 - 82-3 VB - 6 SPAN CONTINUOUS, MULTI BEAM, PLATE GIRDER
LIMITS - RIVER PIER #6 TO PIERS A1, BC1, AND D1
- Start 2-GIRDER "POPLAR STREET COMPLEX"
- 082-0141 - RDWY "A" 45 SPAN 13TH ST. NORTH TO (C.D. WB)
LIMITS - PIER A-1 ----- ABUT. A-46
- 082-0252 - RDWY "B" 28 SPAN MAINLINE WEST BOUND
LIMITS - PIER B-1 ----- ABUT. B-29
- 082-0251 - RDWY "C" 28 SPAN MAINLINE EAST BOUND
LIMITS - PIER C-1 ----- ABUT. C-29
- 082-0144 - RDWY "D" 45 SPAN ST. LOUIS TO 13TH ST. (C.D. EB)
LIMITS - PIER D-1 ----- ABUT. D-46
- 082-0205 - RDWY "E" 10 SPAN TO ILL.-3 SB
LIMITS - PIER O-17, O-18, E-1 ----- ABUT. E-9
- 082-0204 - RDWY "F" 12 SPAN FROM ILL.-3 NB TO RAMP "P" EAST
LIMITS ABUT. F-1 ----- F-12 TO PIER P-1
- 082-0254 - RDWY "G" 13 SPAN (C.D. WB)
LIMITS - ABUT. G-14 ----- PIER G-1
- 082-0256 - RDWY "H" 4 SPAN (C.D. EB)
LIMITS - PIER H-1 ----- ABUT. H-5
- 082-0145 - RAMP "M" 15 SPAN ILL.-3 TO W.B. CD
LIMITS - PIER P-1 TO ABUT. M-1 ----- PIER M-14 TO A-5
- 082-0202 - RAMP "N" 8 SPAN EB CD TO ILL.-3 SOUTH
LIMITS - PIER D-11 TO N-1 ----- N-7 TO O-17
- 082-0201 - RAMP "O1" 10 SPAN WB CD TO ILL.-3 SOUTH
LIMITS - PIER G-1 TO O-1 ----- ABUT. O-10
- 082-0143 - RAMP "O2" 6 SPAN WB CD TO ILL.-3 SOUTH
LIMITS - ABUT. O-11 ----- PIER O-17
- 082-0203 - RAMP "P" 15 SPAN RTE. ILL.-3 TO EB CD
LIMITS - PIER P-1 ----- P-15 TO H-1
- 082-0255 - RAMP "Q" 3 SPAN EB CD
LIMITS - PIER D-26 TO Q-1 TO Q-2 TO P-14
- 082-0253 - RAMP "R" 6 SPAN WB CD
LIMITS - PIER G-1 TO O-1 TO R-4 ----- R-1 TO A-21
- 082-0142 - RAMP "S" 24 SPAN WB CD TO 13TH ST. SOUTH
LIMITS - PIER G-12 TO S-1 ----- S-23 TO D-36
- 082-0146 - RAMP "T" 6 SPAN 13TH ST. NORTH TO CD EB
LIMITS - PIER A-35 TO T-1 ----- ABUT. T-6

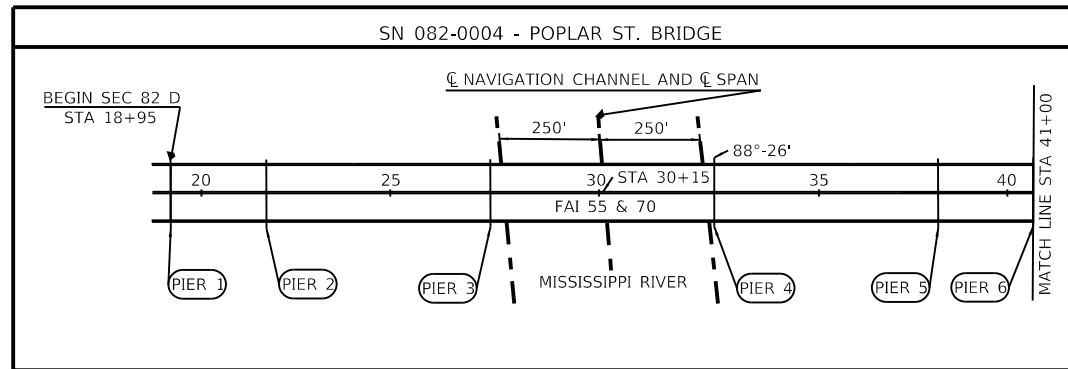

THIS SET CONTAINS THE HISTORICAL DRAWINGS FOR RAMP: H, SN 082-0256

LEGEND	
○	ABUTMENT
←	DIRECTION OF TRAFFIC
○	PIER

USER NAME = HEPPID	DESIGNED -	REVISED -
PLOT SCALE = \$SCALE\$	DRAWN -	REVISED -
PLOT DATE = 11/14/2018	CHECKED -	REVISED -
	DATE -	REVISED -

**STATE OF ILLINOIS
DEPARTMENT OF TRANSPORTATION**

POPLAR STREET COMPLEX			
SCALE: NTS	SHEET 1 OF 1 SHEETS	STA. TO STA.	

F.A. RTE.	SECTION	COUNTY	TOTAL SHEETS	SHEET NO.
		ST CLAIR	1	1
CONTRACT NO.				
ILLINOIS FED. AID PROJECT				

MODEL: \$MODELNAME\$
FILE: \$FILENAME\$. \$EXT\$



Report of Bridge Deck Patching Quantities

County St Clair
Section (82-3HVB-2R-1)-2
Route FAI 70
District 8
Contract No. 76210
Job No. C-98-088-01
Project ACIM-ACBHI-1/178/1

Structure Number ϕ82-ϕ256 (Rdwy H)
Plan Quantity: Partial Depth ϕ Full Depth ϕ
Final Quantity: Partial Depth 161.854 Full Depth ϕ
Date Patching Completed 9-23-04

Please attach documentation showing patch size, type (PD or FD) and location.

Resident Steph [Signature]

CC: Bureau of Bridges & Structures
District Bridge Maintenance Engineer

Rdwy H Post Scarification

Patch	Sta.	Loc.	Disc.	Part/Fall
26	69+73	4.7/10'R	3.22'	P
27	70+18	4.2/10'R	1.18'	P
1,456 sq ft = 161.28 sq ft				

Total For Rdwy H 1456 sq ft


Total: 145.6 / 27 = 5.39 sq ft

INITIALS) DATE

MEASURED BY GMM/MS 9/21/04

CALCULATED BY GMM/MS 9/21/04

CHECKED BY ADL 9/24/04

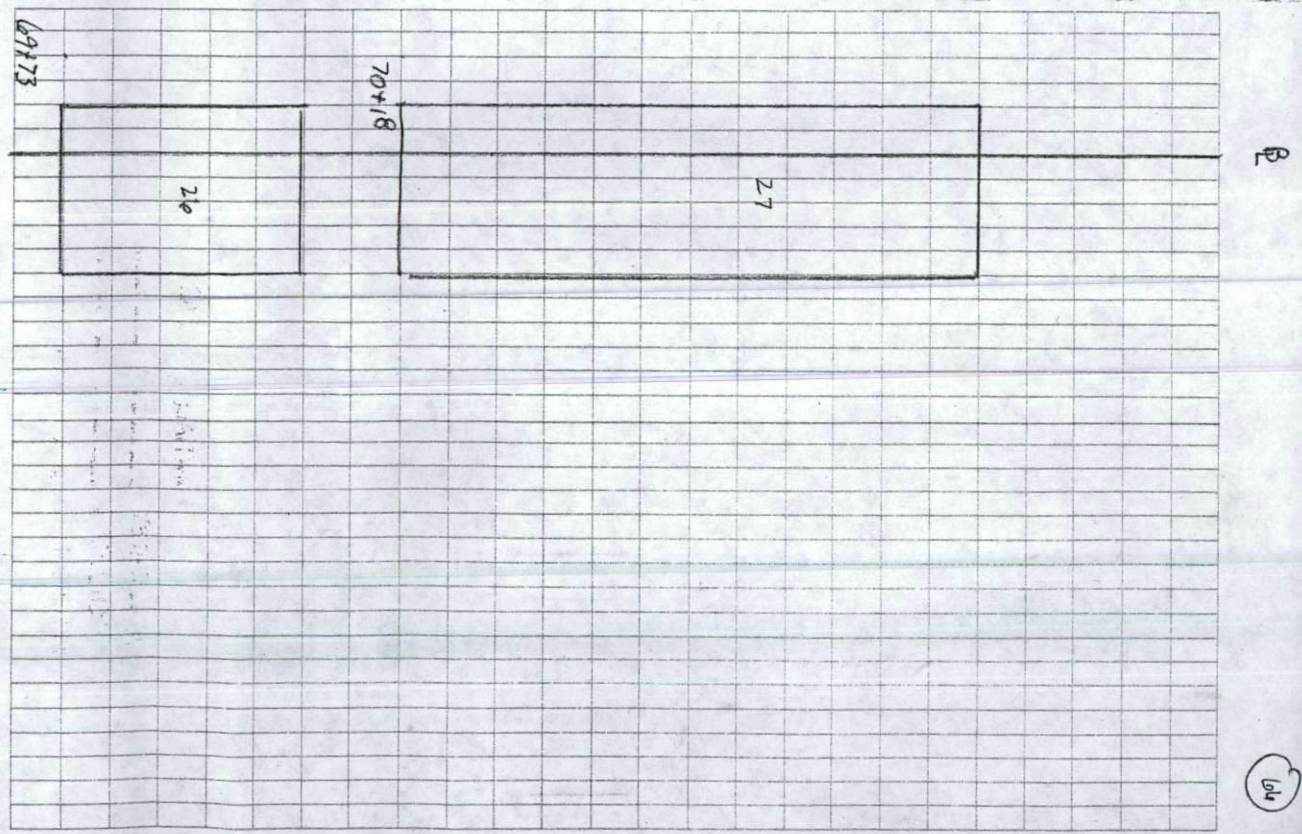

(6)

TOTALS:

RDWY E

~~Z0016200 - DECK SLAB REPAIR (PARTIAL)~~

~~61.97 ~ 62 S.Y.
~ 3.44 C.Y.~~

~~SEE F.B. 3A PGS 72-78; PGS 1-9; 25-41, 34-38~~

RDWY F

~~Z0016200 - DECK SLAB REPAIR (PARTIAL)~~

~~131.66 S.Y. ~ 131.7 S.Y.
~ 5.39 C.Y.~~

~~PGS 57-59, 72-75~~

RAMP N

~~Z0016200 - DECK SLAB REPAIR (PARTIAL)~~

~~510.99 S.Y. ~ 511 S.Y.
~ 17.3 C.Y.~~

~~SEE PGS 10-24~~

RAMP P

~~Z0016200 - DECK SLAB REPAIR (PARTIAL)~~

~~427.16 S.Y. ~ 427.2 S.Y. ~ 17.68 C.Y.
PGS 67-68, 67-68~~

~~Z0016001 - DECK SLAB REPAIR (F.D. T.I.)~~

~~1 S.F. / 9 ~ 0.1 S.Y. PG 65~~

ROADWAY H

Z0016200 - DECK SLAB REPAIR (PARTIAL)

161.78 S.Y. ~ 161.8 S.Y.
~ 5.39 C.Y.

PG 66

~~RAMP N (FULL DEPTH)~~

~~Z0016001 - DECK SLAB REPAIR (FULL DEPTH T.I.)~~

~~9.46 ~ 9.5 S.F. / 9 ~ 1.05
~ 1.1 S.Y.~~

~~X9801200 - DECK SLAB REPAIR (FULL DEPTH T.I.)~~

~~217.75 S.F. / 9 ~ 24.18 ~ 24.2 S.Y.~~

~~PGS 10-11, 13-14, 17~~

MENS BY GMM 11/10/04
CALC. BY: SAR 9/16/04
✓ BY: DAS

106


CONTENTS

STRUCTURE	DESCRIPTION
Ramp O (SN. 082-0143)	Seismic Retrofit, Redundancy Retrofit, Deck rehabilitation and General Repair of Deteriorations of the Substructure and Superstructure for this Structure.
Ramp M (SN. 082-0145)	Seismic Retrofit, Redundancy Retrofit, Deck rehabilitation and General Repair of Deteriorations of the Substructure and Superstructure for this Structure.
Ramp O (SN. 082-0201)	Seismic Retrofit, Redundancy Retrofit, Deck rehabilitation and General Repair of Deteriorations of the Substructure and Superstructure for this Structure.
Ramp N (SN. 082-0202)	Seismic Retrofit, Redundancy Retrofit, Deck rehabilitation and General Repair of Deteriorations of the Substructure and Superstructure for this Structure.
Ramp P (SN. 082-0203)	Seismic Retrofit, Redundancy Retrofit, Deck rehabilitation and General Repair of Deteriorations of the Substructure and Superstructure for this Structure.
ROADWAY F (SN. 082-0204)	Seismic Retrofit, Redundancy Retrofit, Deck rehabilitation and General Repair of Deteriorations of the Substructure and Superstructure for this Structure.
ROADWAY E (SN. 082-0205)	Seismic Retrofit, Redundancy Retrofit, Deck rehabilitation and General Repair of Deteriorations of the Substructure and Superstructure for this Structure.

99.9%
9-24-2005


STATE OF ILLINOIS
DEPARTMENT OF TRANSPORTATION
DIVISION OF HIGHWAYS
**PLANS FOR PROPOSED
REHABILITATION**
PROJECT ACIM-ACBHI-070-1(178)001
FAI ROUTE 70 (I-55/70/64)
SECTION (82-3HVB-2R-1)-2
ILLINOIS ROUTE 3
TO AND FROM
POPLAR STREET BRIDGE COMPLEX
ST. CLAIR COUNTY
C-98-088-01

PROJECT NO.	DISTRICT	COUNTY	SHEET NO.	SHEET NO.
FAI-70		St. Clair	388	1
*ACIM-ACBHI-070-1(178)001 (82-3HVB-2R-1)-2				

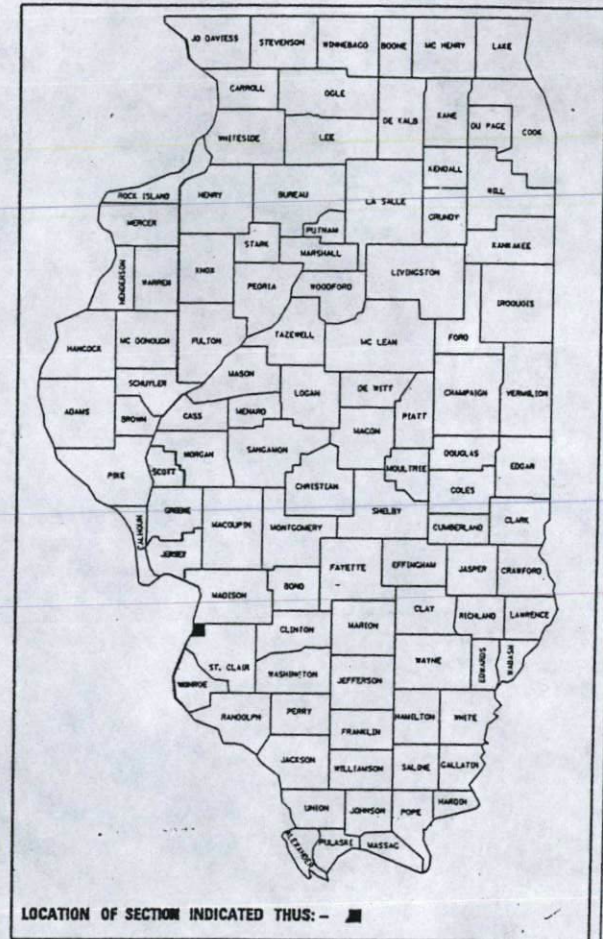

RAMP O	RAMP M	RAMP N
2001 ADT = 6000 (actual)	2001 ADT = 9900 (actual)	2001 ADT = 8700 (actual)
2003 ADT = 6200 (estimated)	2003 ADT = 10200 (estimated)	2003 ADT = 9000 (estimated)
2003 DHV = 620 (estimated)	2003 DHV = 1020 (estimated)	2003 DHV = 900 (estimated)
2023 ADT = 8350 (estimated)	2023 ADT = 13700 (estimated)	2023 ADT = 12100 (estimated)
2023 DHV = 840 (estimated)	2023 DHV = 1370 (estimated)	2023 DHV = 1240 (estimated)
SU = 4.0%	SU = 4.0%	SU = 4.0%
MU = 8.0%	MU = 8.0%	MU = 8.0%

RAMP P	ROADWAY F	ROADWAY E
2001 ADT = 4300 (actual)	2001 ADT = 14200 (actual)	2001 ADT = 14600 (actual)
2003 ADT = 4400 (estimated)	2003 ADT = 14600 (estimated)	2003 ADT = 15000 (estimated)
2003 DHV = 440 (estimated)	2003 DHV = 1460 (estimated)	2003 DHV = 1500 (estimated)
2023 ADT = 5900 (estimated)	2023 ADT = 19600 (estimated)	2023 ADT = 20200 (estimated)
2023 DHV = 590 (estimated)	2023 DHV = 1960 (estimated)	2023 DHV = 2020 (estimated)
SU = 4.0%	SU = 4.0%	SU = 4.0%
MU = 8.0%	MU = 8.0%	MU = 8.0%

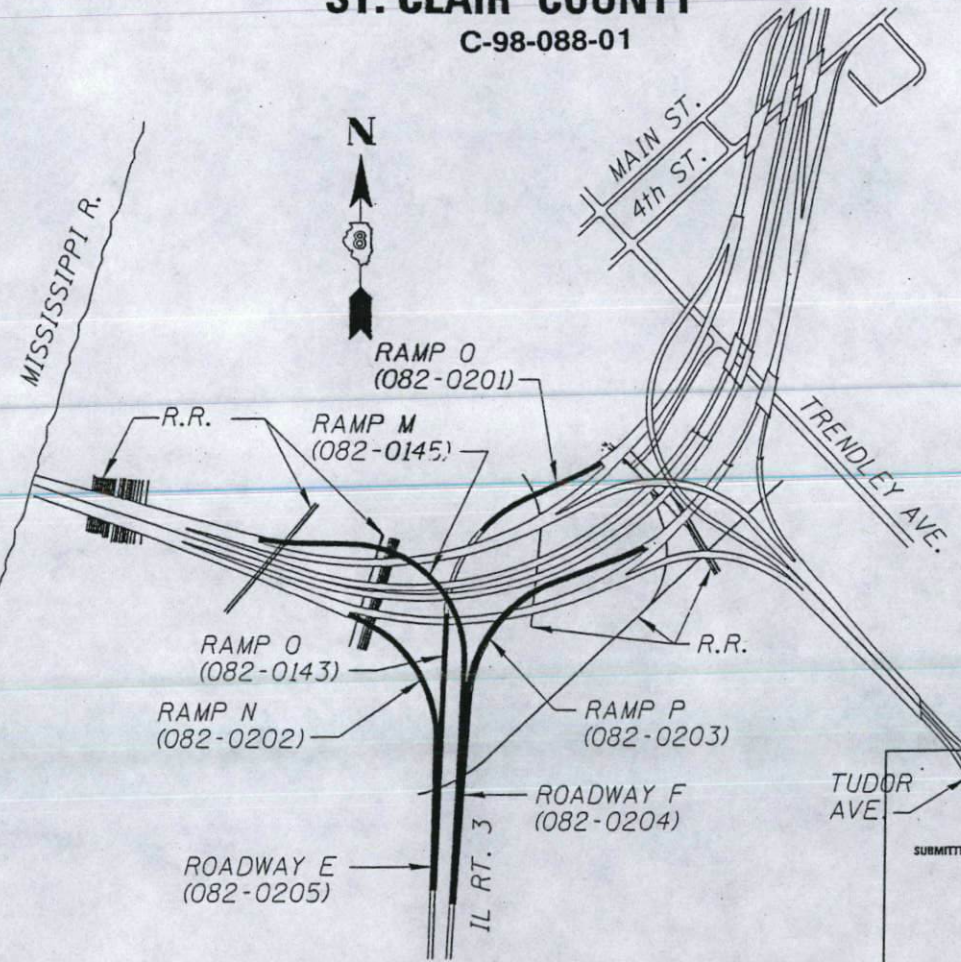

GROSS LENGTH OF PROJECT = 7403.3 FEET = 1.40 MILES
NET LENGTH OF PROJECT = 7403.3 FEET = 1.40 MILES



EXPIRES 11-30-04
John E. Finke
9/3/04
JOHN E. FINKE, S.E.
STRUCTURAL/SEISMIC RETROFIT



LANCE PETERMAN, S.E.
REDUNDANCY RETROFIT
LICENSE EXPIRES 11-30-04



ANDREW P. FREY, P.E.
TRAFFIC CONTROL

STATE OF ILLINOIS
DEPARTMENT OF TRANSPORTATION
DIVISION OF HIGHWAYS

SUBMITTED Oct 24, 2003
Mary Anne
DISTRICT ENGINEER

December 5, 2003
Michael R. Al...
ENGINEER OF DESIGN AND ENVIRONMENT

December 5, 2003
Andrew P. Frey
DIRECTOR, DIVISION OF HIGHWAYS

8-260

PRINTED BY THE AUTHORITY OF THE STATE OF ILLINOIS

PROJECT LEADER: TOM MANNINO (618)346-3159
SQUAD LEADER: GREG HANCOCK (618)346-3195

CONTRACT NO. 76210

DESIGNED	--
CHECKED	--
DRAWN	E. Bazzell
CHECKED	S. Kaemmerer

082-0256
PREPARED BY:
JACOBS CIVIL INC.
ST. LOUIS, MO

STATE OF ILLINOIS
DEPARTMENT OF TRANSPORTATION

182-3H.3-2R-11-2

SUMMARY OF QUANTITIES				URBAN												
CODE NUMBER	ITEM	UNIT	PROJECT TOTAL	ACIM		ACBHI				ACIM		ACBHI				100% STATE
				90% FED. 10% STATE	TRAFFIC CONTROL	RAMP O	RAMP U	RAMP O	RAMP H	RAMP P	ROADWAY F	ROADWAY E	ROADWAY H			
				ROADWAY	1000-2A	STRUCTURE NO. 082-0143 X531-2A	STRUCTURE NO. 082-0145 X531-2A	STRUCTURE NO. 082-0201 X131-2A	STRUCTURE NO. 082-0202 X131-2A	STRUCTURE NO. 082-0203 X531-2A	STRUCTURE NO. 082-0204 X131-2A	STRUCTURE NO. 082-0205 X131-2A	STRUCTURE NO. 082-0206 SFTY-2A			
44000910	BITUMINOUS CONCRETE REMOVAL (DECK)	SO YD	21.594				1.479	3.845	2.499	1.927	3.462	4.801	3.443	138		
50102400	CONCRETE REMOVAL	CU YD	3,398.3	2		275.5	694.9	418.6	356.7	621.9	574.1	437.1	19.5			
50300150	NEOPRENE EXPANSION JOINT - 2"	FOOT	135					27			35	73				
50300155	NEOPRENE EXPANSION JOINT - 2.5"	FOOT	209					27			62	93				
50300160	NEOPRENE EXPANSION JOINT - 4"	FOOT	163					26			65	45				
50300225	CONCRETE STRUCTURES	CU YD	7.8			2.1		2.3			1.7	1.7				
50300255	CONCRETE SUPERSTRUCTURE	CU YD	2,670.0			215.3	561.7	342.8	286.5	493.9	427.6	327.2	15.0			
50300260	BRIDGE DECK GROOVING	SO YD	22,285	2		1,536	3,991	2,591	2,002	3,596	4,906	3,521	142			
50300300	PROTECTIVE COAT	SO YD	5,842	1		491	1,275	680	640	1,113	923	685	25			
50300310	ELASTOMERIC BEARING ASSEMBLY, TYPE I	EACH	14	1			6	1		2	1	6				
50300320	ELASTOMERIC BEARING ASSEMBLY, TYPE II	EACH	18					8	2		2	6				
50301245	FORMED CONCRETE REPAIR (DEPTH EQUAL TO OR LESS THAN 5")	SO FT	3,771	3		11	1,077	222	490	215	381	1,375				
50301250	FORMED CONCRETE REPAIR (DEPTH GREATER THAN 5")	SO FT	4			1	3									
50500105	FURNISHING AND ERECTING STRUCTURAL STEEL	L SUM	1			0.1	0.2	0.1	0.1	0.2	0.2	0.1				
50500715	JACK AND REMOVE EXISTING BEARINGS	EACH	32	1			6	1	8	2	1	6				
50800205	REINFORCEMENT BARS, EPOXY COATED	POUND	523,210	2		43,290	107,980	59,280	55,490	96,580	88,410	69,040	3,140			
54002500	EXPANSION BOLTS (SPECIAL)	EACH	7,752	3		92	502	154	164	390	218	232				
67000400	ENGINEER'S FIELD OFFICE, TYPE A	CAL MO	24		24											
67100100	MOBILIZATION	L SUM	1		1											
70100205	TRAFFIC CONTROL AND PROTECTION, STANDARD 701401	EACH	6													
70100207	TRAFFIC CONTROL AND PROTECTION, STANDARD 701402	EACH	2													
70101800	TRAFFIC CONTROL AND PROTECTION (SPECIAL)	L SUM	1													
70300220	TEMPORARY PAVEMENT MARKING LINE 4"	FOOT	15,759													
70300240	TEMPORARY PAVEMENT MARKING LINE 6"	FOOT	5,493													
70301000	WORK ZONE PAVEMENT MARKING REMOVAL	SO FT	4,061			4,061										
70400500	TEMPORARY CONCRETE BARRIER (STATE OWNED)	FOOT	1,451			1,451										
70400600	RELOCATE TEMPORARY CONCRETE BARRIER (STATE OWNED)	FOOT	4,042			4,042										
7800310	POLYUREA PAVEMENT MARKING TYPE II - LINE 4 INCH	FOOT	17,019		14,840	2,179										
7800340	POLYUREA PAVEMENT MARKING TYPE II - LINE 8 INCH	FOOT	2,380		2,380											
78100105	RAISED REFLECTIVE PAVEMENT MARKER (BRIDGE)	EACH	74		74											
78200100	MONODIRECTIONAL PRESNATIC BARRIER REFLECTOR	EACH	178			178										
78300100	PAVEMENT MARKING REMOVAL	SO FT	1,672			1,672										
X0321781	MECHANICAL SPLICE	EACH	618			50	150	50	50	50	179	89				
X0322050	RAISED REFLECTIVE PAVEMENT MARKER, REFLECTOR REMOVAL	EACH	9			9										
X0322549	COLUMN WRAP	SO FT	17,149	3		950	3,668	1,916	1,385	4,243	3,123	1,864				
X0322553	FOUNDATION WALL DOWEL MODIFICATION	EACH	18			6	2		1	3	2	4				
X0322556	STIFFENER INTERSECTION MODIFICATION	EACH	1,976			272		408	344		544	408				
X0322559	BOLT REPLACEMENT	EACH	514			10	109	6	30	2	273	84				
X0322560	CRACK EXTENSION MODIFICATION	EACH	28			4	4	4	4	4	4	4				
X0322563	VERTICAL WEB STIFFENER REMOVAL	EACH	3,668			316	801	482	360	691	628	390				
X0323082	DRAINAGE SCUPPERS, DS-33	EACH	64			2	10	8	14	7	8	15				
X0323558	BRIDGE JOINT SYSTEM (EXPANSION), 1.5"	FOOT	134	2		26		26		39			17			
X0343400	REMOVE AND REINSTALL BEARINGS	EACH	10						4		2	4				
X70151050	PORTABLE CHANGEABLE MESSAGE SIGN	CAL MO	125			125										
Z0076600	TRAINEES	HOURL	500		500											
XZ193500	BRIDGE DECK MICROSILICA CONCRETE OVERLAY - 2 1/4"	SO YD	23,879	2		1,670	4,340	2,777	2,177	3,896	5,159	3,709	151			
Z0012100	CONCRETE BRIDGE DECK SCARIFICATION (1/4 INCH)	SO YD	23,879	1		1,670	4,340	2,777	2,177	3,896	5,159	3,709	151			
Z0016001	DECK SLAB REPAIR (FULL DEPTH, TYPE I)	SO YD	51			0.4	0.7	0.4	0.4	0.3	0.7	0.2				
Z0016200	DECK SLAB REPAIR (PARTIAL)	SO YD	510.2			41.7	192.4	94.3	81.3	40.1	10.1	50.3				
Z0018800	DRAINAGE SYSTEM	L SUM	1			0.125	0.375	0.125	0.125	0.125	0.125					
Z0022400	FABRIC REINFORCED ELASTOMERIC TROUGH	FOOT	237			27	79	27	27	27	50					
Z0029999	IMPACT ATTENUATOR REMOVAL	EACH	1													
Z0030150	IMPACT ATTENUATOR (NON-REDIRECTIVE), TEST LEVEL 3	EACH	1		1											
Z0047300	PROTECTIVE SHIELD	SO YD	3,026				865	1,037	358	420	171	175				
Z0048665	RAILROAD PROTECTIVE LIABILITY INSURANCE	L SUM	1		1											
Z0049100	RAISED PAVEMENT MARKER REFLECTOR REPLACEMENT	EACH	9			9										
Z0030250	IMPACT ATTENUATORS, TEMPORARY (NON-REDIRECTIVE), TEST LEVEL 3	EACH	24			24										
Z0030350	IMPACT ATTENUATORS, RELOCATE (NON-REDIRECTIVE), TEST LEVEL 3	EACH	48			48										
Z0073200	TEMPORARY SHORING AND CRIBBING	EACH	32	1			6	8	2	2	8	6				
1	REMOVE TIE BEAM (SPECIAL)	EACH	13			1			4		5	3				
1	REPLACE TIE BEAM (SPECIAL)	EACH	6						1		3	2				
1	REMOVE AND REPLACE COLUMN (SPECIAL)	EACH	6						3		1	2				

DESIGNED R. Victor
CHECKED D. James
DRAWN E. Bazzell
CHECKED R. Victor

* SPECIALTY ITEM
Ø YOBO
Δ SFTY 3N

PREPARED BY
JACOBS CIVIL INC.
ST. LOUIS, MO

REHABILITATION FOR FAI 55/70 COMPLEX

SUMMARY OF QUANTITIES
(FAI-70) ST. CLAIR CO.

Benchmark: #26 Elev. 404.396 X-cut in N.W. corner of concrete abutment at center pier of Ill. Central R.R. Bridge over Ill. Rte. 3.





Existing Structure: SN 082-0256 was built as F.A.I. Route 70 Section 132 3HVB-2R-11-2 in 1967. The roadway is striped for one lane. The Superstructure consists of one 3 span continuous unit with two welded steel plate girders, plate girder floor beams, rolled stringers, and non-composite R.C. slab, and one simple span with composite slab on rolled girders. The Substructure is R.C. piers on R.C. piles and one R.C. pile bent abutment. Existing structure shall be rehabilitated with partial deck/barrier replacement.

STATE OF ILLINOIS
DEPARTMENT OF TRANSPORTATION

ROUTE NO.	SECTION	COUNTY	DATE	SHEET NO.
FAI-70	*	St. Clair		6 SHEETS
FED. ROAD DIST. NO.		ALLIANCE	F.A.I. PROJECT	

(82-3HVB-2R-11)-2

Salvage: None.

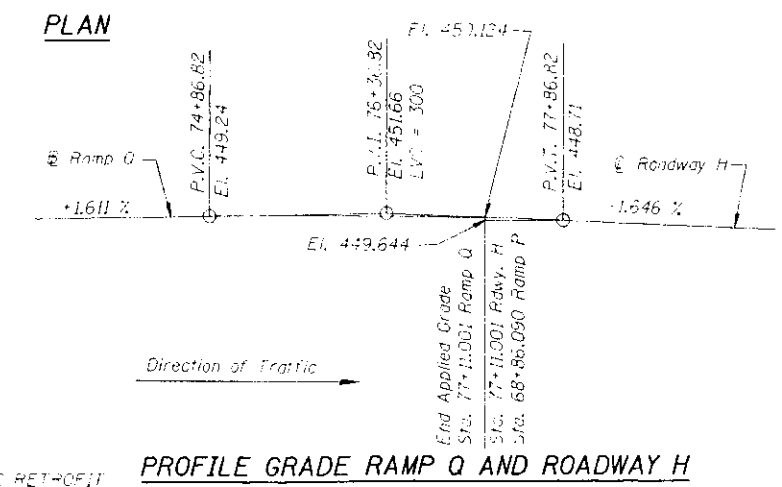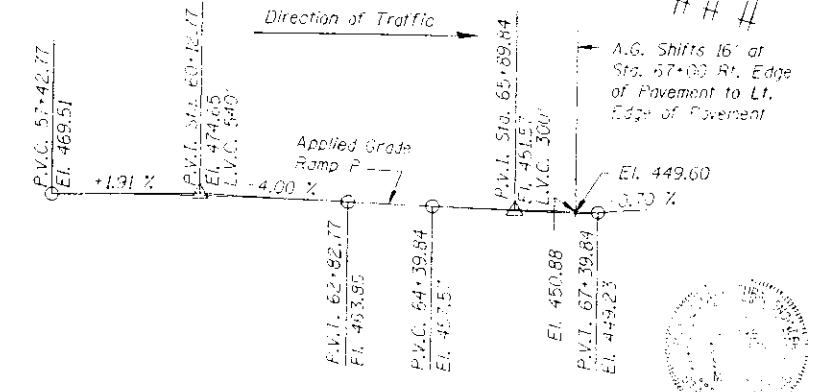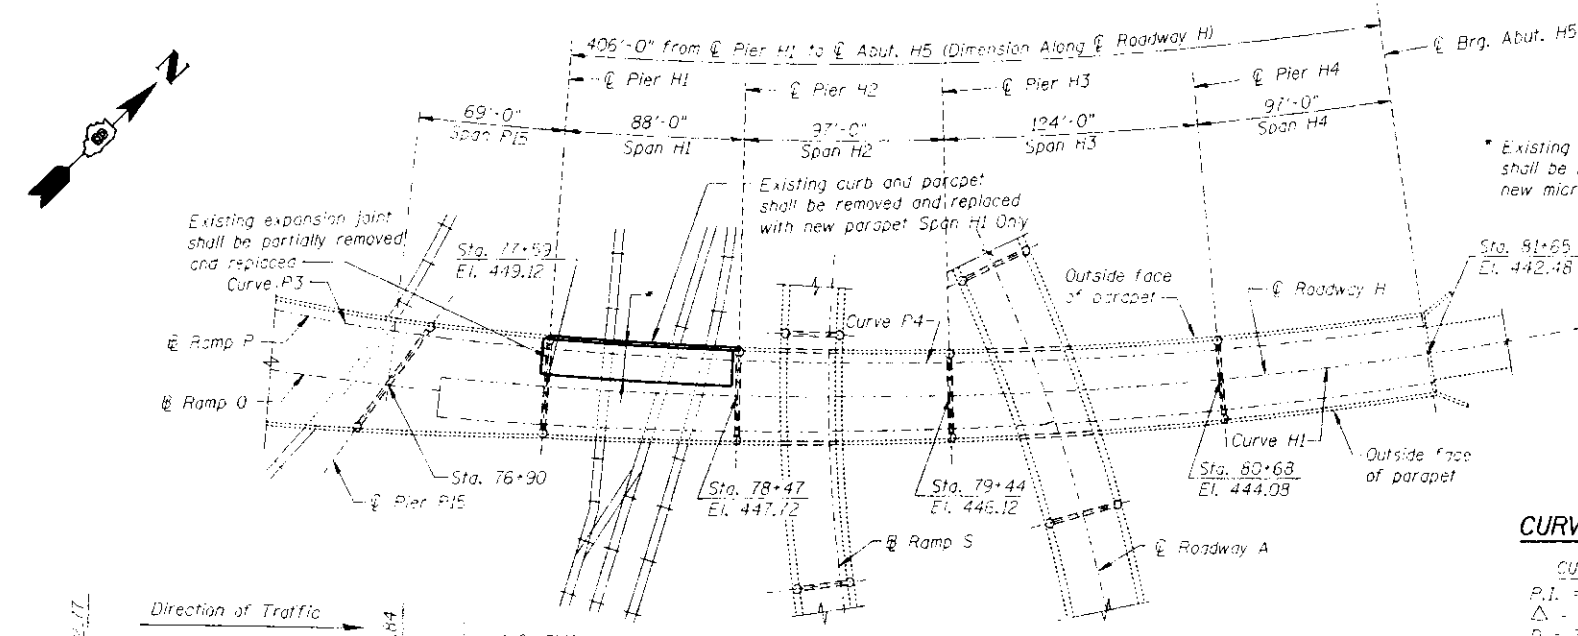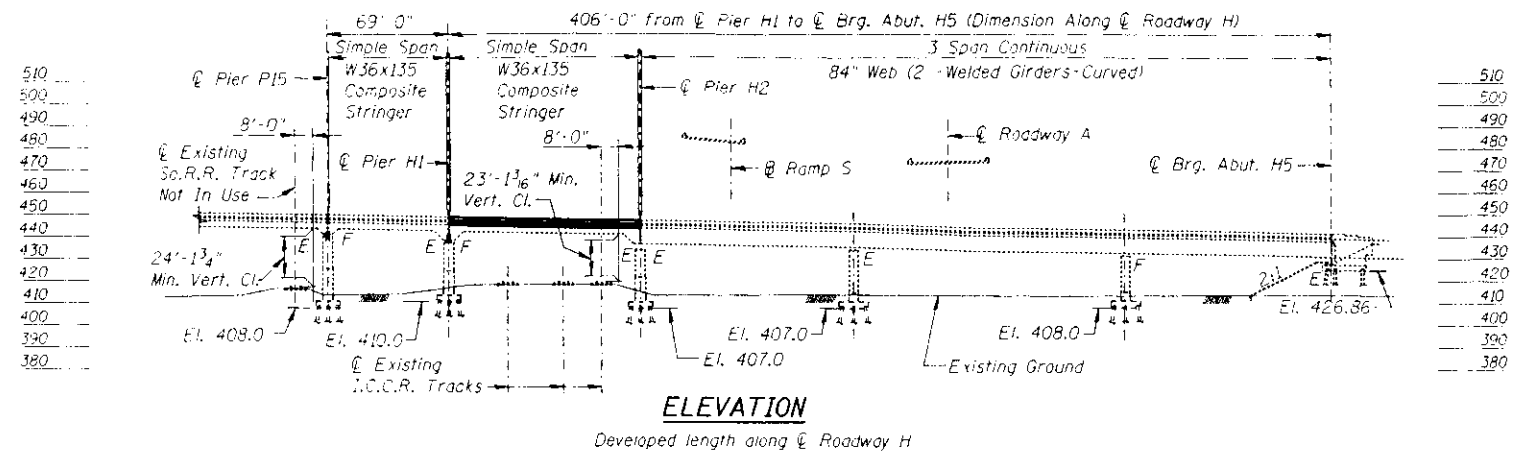


CURVE DATA	CURVE DATA	CURVE DATA
CURVE P-3 P.I. = 57+25.03 Δ = 21°04'14" D = 770'18" R = 816.00' L = 300.00' T = 151.76' E = 13.99' S = 8.00%	CURVE P-4 P.I. = 72+23.10 Δ = 26°15'16" D = 576'49" R = 1,746.72' L = 500.40' T = 407.35' E = 46.87'	CURVE H-1 P.I. = 83+18.82 Δ = 36°57'31" D = 3°09'01" R = 1,818.76' L = 1,173.19' T = 607.82' E = 98.66' S = 8.00%

DESIGN SPECIFICATIONS:
1995 AASHTO with 1997 thru 2002 Interims.
FHWA RD-94-052 "Seismic Retrofitting Manual for Highway Bridges", 1995

DESIGN STRESSES:
New Construction:
Reinforced concrete: $f'_c = 3,500$ psi
Reinforcement bars: $f_y = 60,000$ psi
Existing Structure:
Reinforced concrete: $f'_c = 1,400$ psi
Structural Steel: $f_y = 20,000$ psi

- INDEX OF SHEETS**
- GENERAL PLAN AND ELEVATION SPANS P15 THRU H4
 - GENERAL NOTES, TOTAL BILL OF MATERIAL AND SCOPE OF WORK
 - SLAB SPAN #1
 - PARAPET DETAILS AND SUPERSTRUCTURE BILL OF MATERIAL
 - DEMOLITION DETAILS AND EXPANSION JT. REPLACEMENT DETAILS
 - PJS EXPANSION JOINT DETAILS PIER H1

NOTES
Profile grade elevations are to top of original slab and do not take into account wearing surface or overlay thickness.

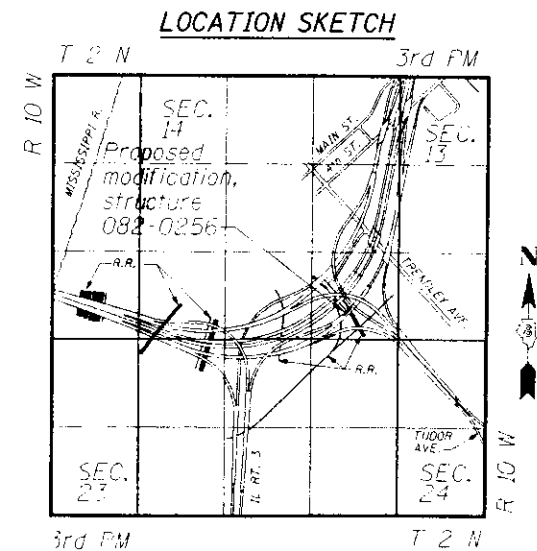

REHABILITATION FOR FAI 55/70 COMPLEX
ROADWAY H - STRUCTURE NO. 082-0256
GENERAL PLAN AND ELEVATION
SPANS P15 THRU H4
STA. 76+30.00 THRU 91+65 (FAI-70) ST. CLAIR CO.

DESIGNED	R. Victor
CHECKED	F. Gambo
DRAWN	J. Smith
CHECKED	F. Gambo

PREPARED BY:
JACOBS CIVIL INC.
ST. LOUIS, MO

STATE OF ILLINOIS
DEPARTMENT OF TRANSPORTATION

ROUTE NO.	SECTION	COUNTY	TOWN	RANGE	SHEET NO. 2
FAI-70	*	St. Clair			6 SHEETS
FED. ROAD DIST. NO. 7	ILLINOIS	FED. AID PROJECT			

*082-3HVB-2R-11-2

GENERAL NOTES

Plan dimensions and details relative to existing structure have been taken from existing plans and are subject to nominal construction variations. It shall be the Contractor's responsibility to verify such dimensions and details in the field and make necessary approved adjustments prior to construction or ordering of materials. Such variations shall not be cause for additional compensation for a change in the scope of the work, however, the Contractor shall be paid for the quantity actually furnished at the unit price for the work.

All transverse and longitudinal dimensions are measured horizontally. All dimensions are measured at a temperature of 50° F.

All existing operational electrical and I.T.S. equipment shall remain in operation during construction unless approved otherwise by the Engineer.

Reinforcement bars shall conform to the requirements of AASHTO M31, M42 or M53, Grade 60.

Fasteners shall be high strength bolts.

Field welding of construction accessories will not be permitted to beams or girders.

All construction joints shall be bonded.

Prior to pouring the new concrete deck, all loose rust, loose mill scale, and other loose potentially detrimental foreign material shall be removed from the surfaces of the beams or girders in contact with concrete. The cost of this work will be included in the pay item covering removal of existing concrete. All heavy rust and other tightly adhered potentially detrimental foreign matter shall also be removed from the surfaces of the beams or girders in contact with concrete. Tightly adhered paint may remain unless otherwise noted. This removal shall be accomplished by methods that will not damage the steel. The cost of this work will be paid for according to Article 109.04.

All existing construction accessories welded to the top flange over the pier(s) between the quarter points of the beams or girders shall be removed. The remaining weld shall be ground smooth and inspected for cracks using magnetic particle testing. Any cracks that can not be removed by grinding approximately 1/4 inch deep shall be identified and reported to the Bureau of Bridges and Structures for further disposition. The cost of this work shall be paid for according to Article 109.04.

Expansion joint openings shall be adjusted according to Article 503.10(c) of the Standard Specifications when the deck is poured at an ambient temperature other than 50° F.

SCOPE OF WORK

GENERAL:

The detailed drawings presented herein are for Roadway H - Structure Number 082-0256 in St. Clair County, Illinois. Work relating to Span H1 and Span P15 (partial) is included within this Scope. Work to be performed is associated with a General Rehabilitation of the Deck and Substructure.

GENERAL REHABILITATION:

1. Perform a Type 2 Deck Rehabilitation (including Overlay Removal, Scarification and Installation of a Microsilica Concrete Overlay) on Span H1, Westside.
2. Remove and Replace Expansion Joints at Pier: H1 (partial).
3. Remove Existing Curbs and Barriers and Replace with New Parapets on Span H1.

TOTAL BILL OF MATERIAL

ITEM	UNIT	SUPERSTRUCTURE	SUBSTRUCTURE	TOTAL
BITUMINOUS CONCRETE REMOVAL (DECK)	SQ YD	138	--	138
CONCRETE REMOVAL	CU YD	19.5	--	19.5
CONCRETE SUPERSTRUCTURE	CU YD	15.0	--	15.0
BRIDGE DECK GROOVING	SQ YD	142	--	142
PROTECTIVE COAT	SQ YD	35	--	35
REINFORCEMENT BARS, EPOXY COATED	POUND	3,140	--	3,140
BRIDGE JOINT SYSTEM (EXPANSION) - 1 3/8"	FOOT	17	--	17
BRIDGE DECK MICROSILICA CONCRETE OVERLAY - 2 1/4"	SQ YD	151	--	151
CONCRETE BRIDGE DECK SCARIFICATION (1/4 INCH)	SQ YD	151	--	151


DESIGNED	R. Victor
CHECKED	G. Dne
DRAWN	J. Smith
CHECKED	F. Dene

PREPARED BY:
JACOBS CIVIL INC.
ST. LOUIS, MO

REHABILITATION FOR FAI 55/70 COMPLEX
ROADWAY H - STRUCTURE NO. 082-0256
GENERAL NOTES,
TOTAL BILL OF MATERIAL
AND SCOPE OF WORK
(FAI-70) ST. CLAIR CO.

STATE OF ILLINOIS
DEPARTMENT OF TRANSPORTATION

ROUTE NO.	DISTRICT	COUNTY	SECTION	SHEET NO.
FAI-70	#	St. Clair		3
SHEETS				6 SHEETS
*182-3HVB-2R-11-2				

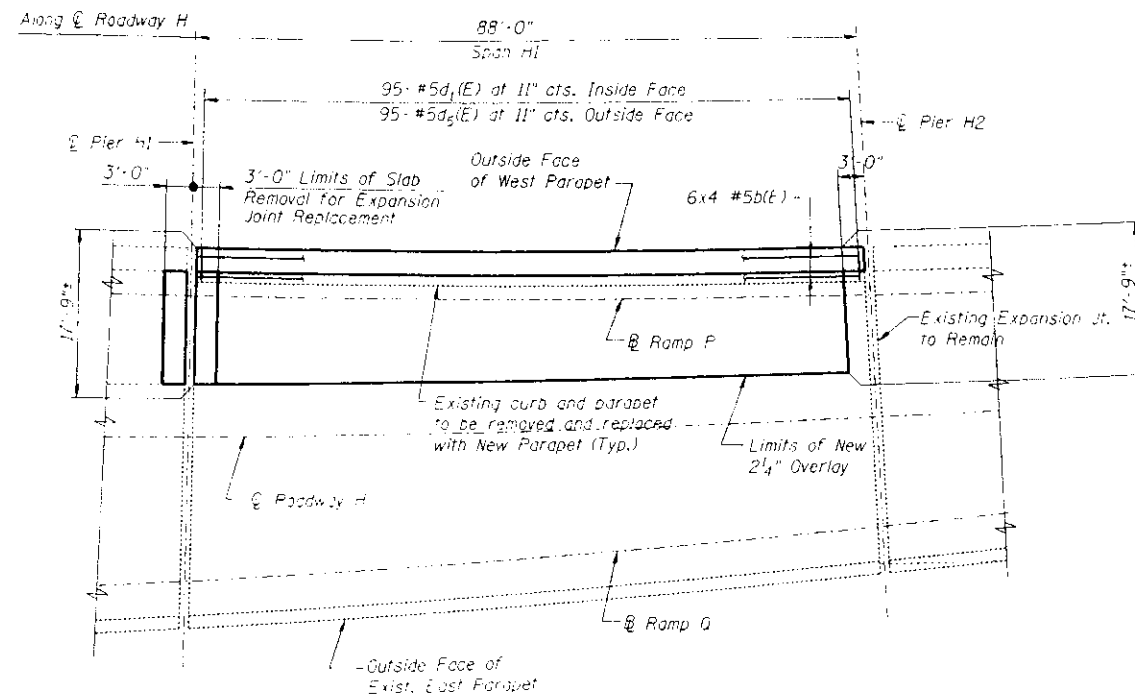

PLAN

NOTES

- Lap splices:
#5 longitudinal bars 2'-7" min.
- For Superstructure Bill of Material, see Sheet 4.
- For Parapet details, see Sheet 4.
- For Expansion Joint details, see Sheets 5 and 6.
- Bars indicated thus 6 x 7-#5 etc. indicates 6 lines of bars with 7 lengths per line.
- For Concrete Removal details, see Sheet 5.

DESIGNED	R. Victor
CHECKED	F. Campuz
DRAWN	J. Smith
CHECKED	F. Campuz


PREPARED BY:
JACOBS CIVIL INC.
ST. LOUIS, MO

REHABILITATION FOR FAI 55/70 COMPLEX
ROADWAY H - STRUCTURE NO. 082-0256
SLAB
SPAN HI



(FAI 70) ST. CLAIR CO.

*(82-3HVB-2R-1)-2

SUPERSTRUCTURE BILL OF MATERIAL

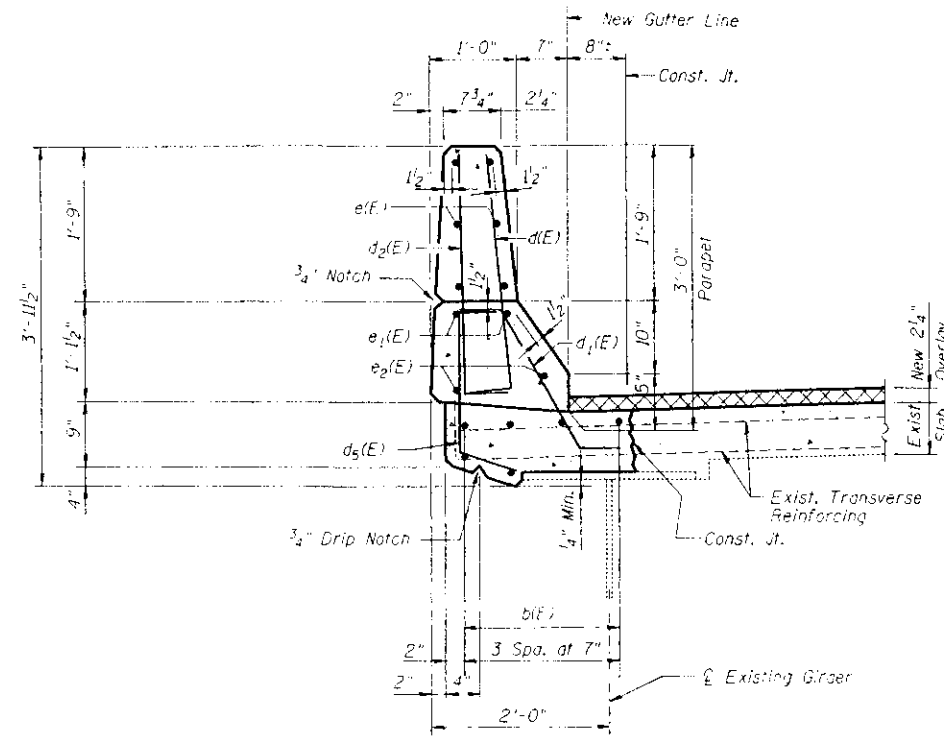

TYPICAL SECTION THRU SLAB AND PARAPET

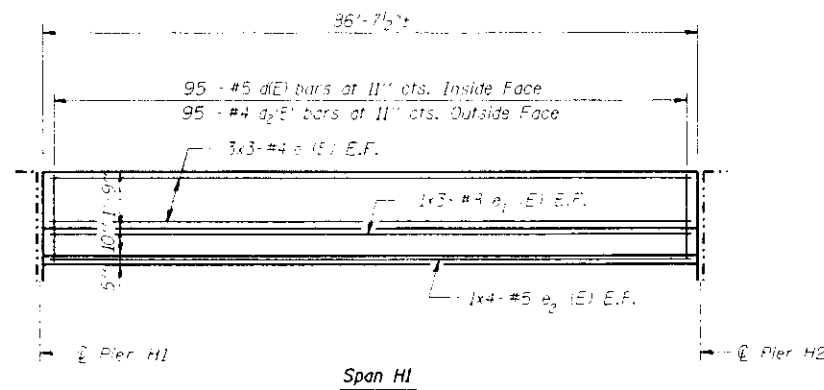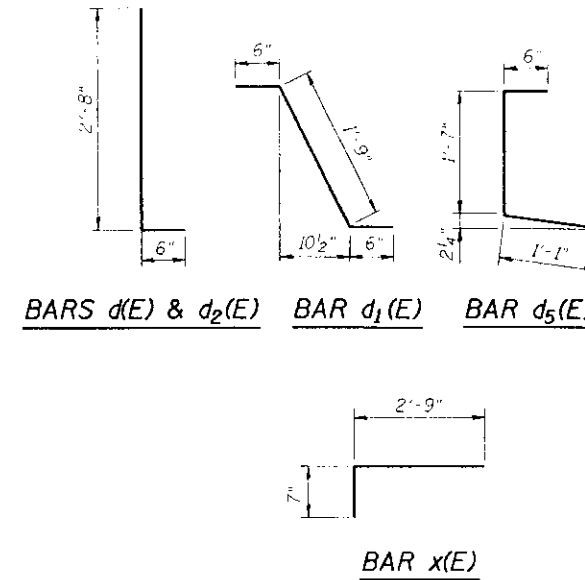

INSIDE ELEVATION - WEST PARAPET

DESIGNED	R. Victor
CHECKED	F. Campa
DRAWN	J. Smith
CHECKED	F. Campa

PREPARED BY:
JACOBS CIVIL INC.
ST. LOUIS, MO

PARAPET NOTES

Parapet lengths are taken from the plans prepared by H.W. Lochner for the original structure. Adjustment shall be made to accommodate new expansion device.

Lap splices:

- #4 longitudinal bars 1'-7" min.
- #5 longitudinal bars 2'-7" min.
- #8 longitudinal bars 5'-6" min.

E.F. indicates each face.

All edges shall have a 3/4" chamfer, unless otherwise noted.


Bars indicated thus 1x2 #5 etc. indicates 1 line of bars with 2 lengths per line.

For expansion joint details, see Sheets 5 and 6.

Bar	No.	Size	Length	Shape	
d1(E)	12	#5	17'-3"	┌	
d2(E)	12	#5	17'-3"	└	
d3(E)	24	#5	24'-0"	┌	
d4(E)	95	#5	3'-2"	┌	
d5(E)	95	#5	2'-9"	└	
d6(E)	95	#4	3'-2"	┌	
d7(E)	95	#4	3'-2"	└	
e1(E)	18	#4	29'-10"	┌	
e2(E)	6	#8	32'-5"	┌	
e3(E)	8	#4	23'-7"	┌	
x(E)	16	#5	3'-4"	┌	
x2(E)	16	#5	3'-4"	└	
Reinforcement Bars, Epoxy Coated				Pound	3,140
Concrete Superstructure				Cu. Yd.	15
Concrete Removal				Cu. Yd.	19.5


Reinforcement bars designated (E) shall be epoxy coated.

REHABILITATION FOR FAI 55/70 COMPLEX
ROADWAY H - STRUCTURE NO. 082-0256
PARAPET DETAILS AND
SUPERSTRUCTURE BILL OF MATERIAL
(FAI-70) ST. CLAIR CO.

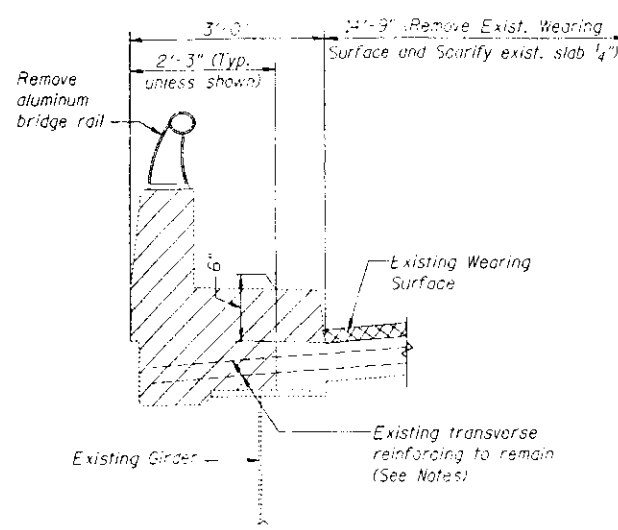


CROSS SECTION - DEMOLITION


Notes:
Remove existing curb, parapet and portion of slab to limits shown by hatched areas.
Remove all existing full length longitudinal bars at concrete removal areas unless otherwise noted.

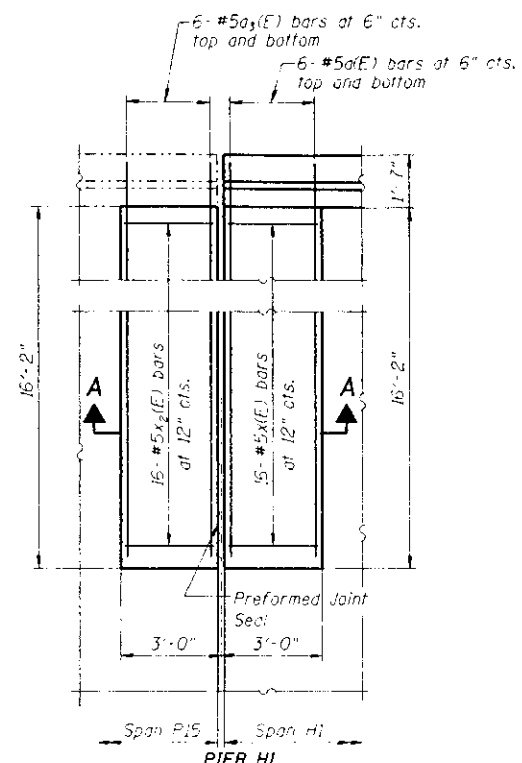

EXPANSION JOINT REPLACEMENT PLAN

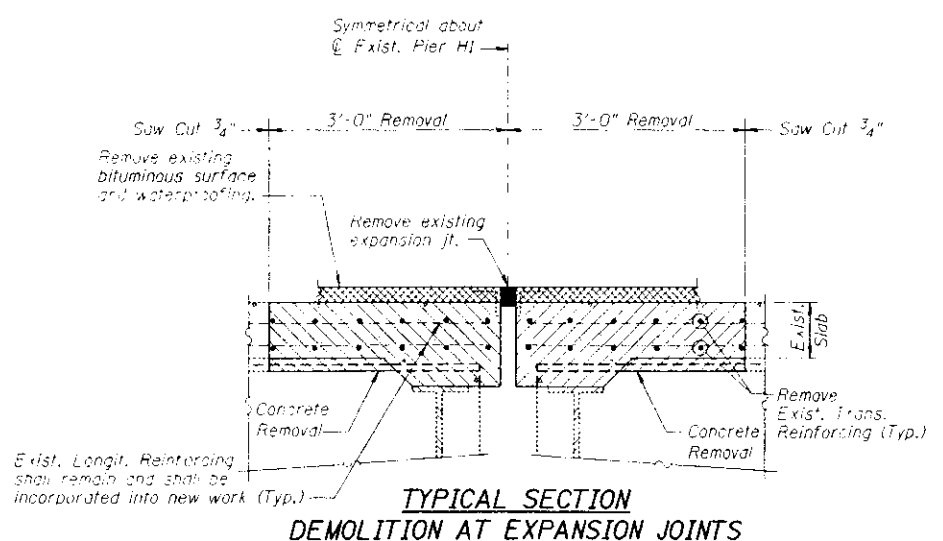

TYPICAL SECTION DEMOLITION AT EXPANSION JOINTS

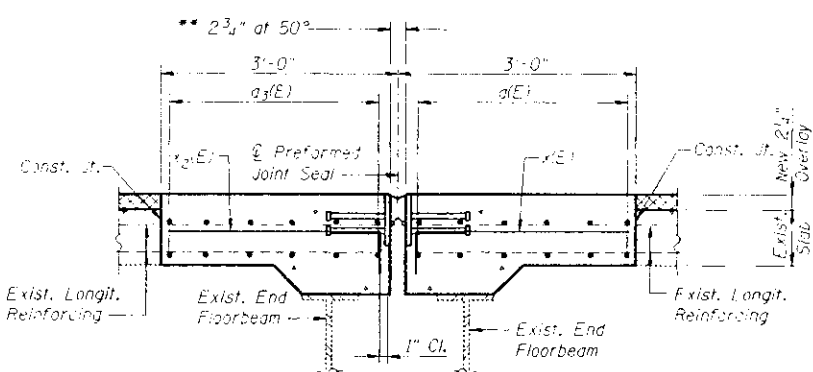

SECTION A-A

** Dimensions are based on PJS joint. If the contractor elects to use the alternate strip seal, deck dimensions may require adjustments to satisfy the details on page 2 of 2 of the Base Sheet EJ-BJS.


NOTES

Existing reinforcement bars extending into the removal area shall be cleaned, straightened, and incorporated into the new construction. Any reinforcement bars that are damaged during concrete removal shall be replaced with an approved bar splitter or anchorage system. Cost included with "Concrete Removal".
Contractor shall provide and install a Temporary Slab Support as required. Temporary Slab Support shall be in place before deck removal. See Special Provisions.

DESIGNED	P. Victor
CHECKED	F. Camba
DRAWN	J. Smith
CHECKED	F. Camba

PREPARED BY:
JACOBS CIVIL INC.
ST. LOUIS, MO

REHABILITATION FOR FAI 55/70 COMPLEX
ROADWAY H - STRUCTURE NO. 082-0256
DEMOLITION DETAILS AND
EXPANSION JT. REPLACEMENT DETAILS
(FAI-70) ST. CLAIR CO.

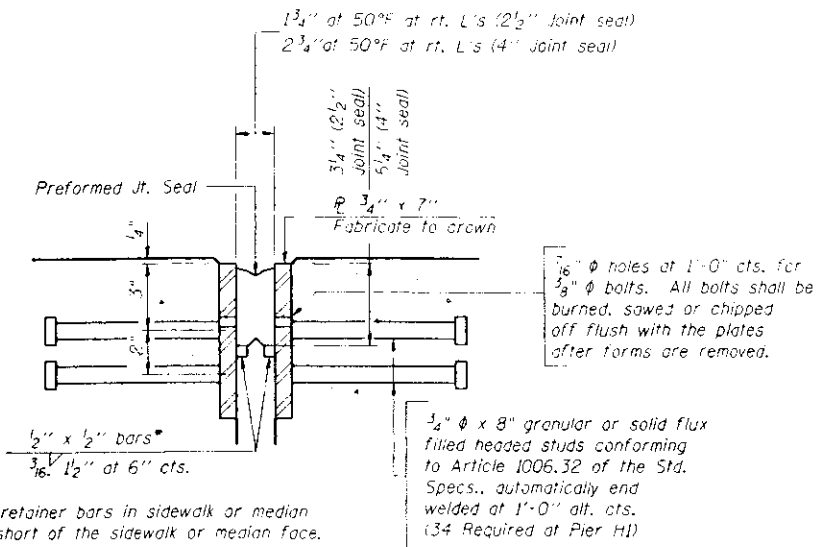


SECTION THRU EXPANSION JOINT
(2 1/2" and 4" joint seals)

Bridge Joint System (Expansion)


DESIGN MOVEMENT	Required Preformed Joint Seal Size	Required Strip Seal rated movement
1"	2 1/2"	1"
1 5/8"	4"	2"

GENERAL NOTES


Furnish steel plates in segments of 20 feet maximum length. Maximum space between installed segments shall be 3/16". Seal space with silicone sealant suitable for structural steel.

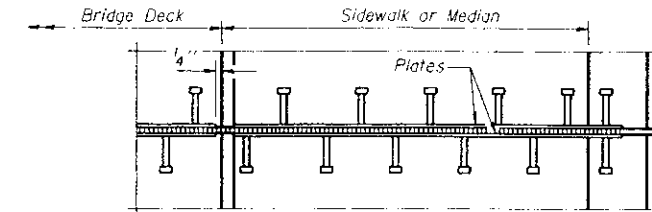


PLAN AT SIDEWALK OR MEDIAN

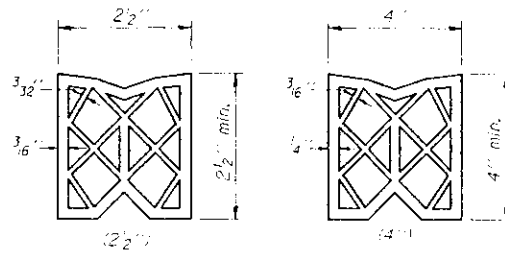


PREFORMED JOINT SEAL

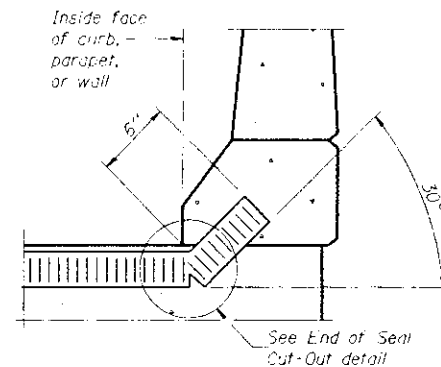

AT CURB, PARAPET, OR WALL
(Showing seal)

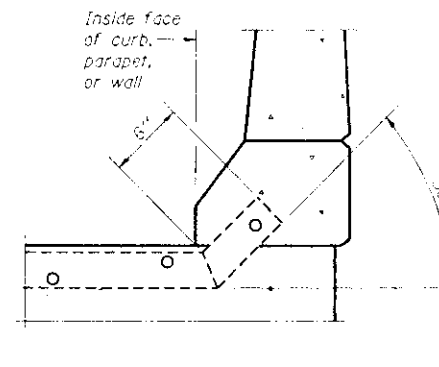


AT CURB, PARAPET, OR WALL
(Showing plate)

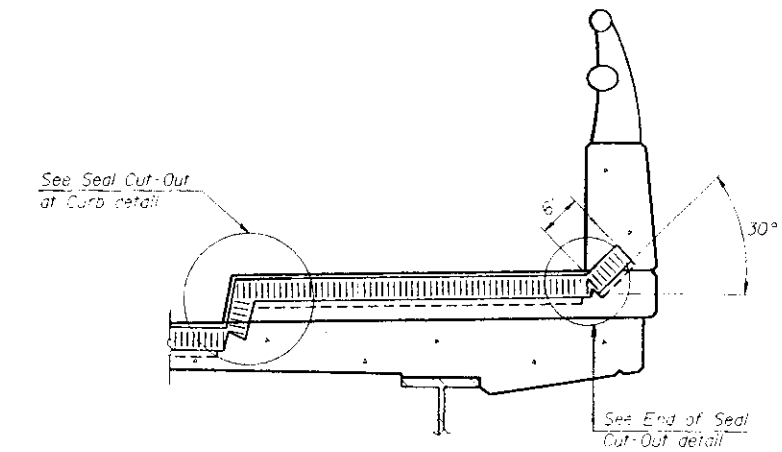


AT SIDEWALK OR MEDIAN
(Showing plate and seal)


TYPICAL END TREATMENTS

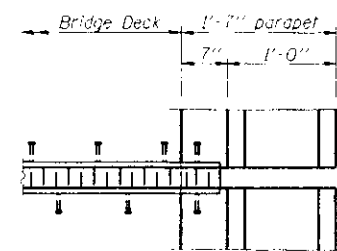

PLAN AT PARAPET

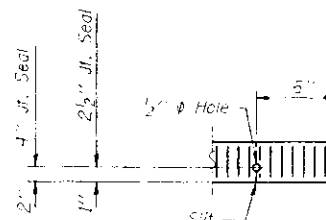

END OF SEAL CUT-OUT

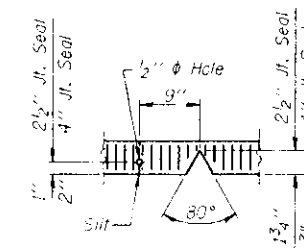

SEAL CUT-OUT AT CURB

BILL OF MATERIAL

Item	Unit	Total
Bridge Joint System (Expansion) - 1 5/8"	foot	17

REHABILITATION FOR FAI 55/70 COMPLEX
ROADWAY H - STRUCTURE NO. 082-0256
PJS EXPANSION JOINT DETAILS
PIER H1
(FAI-70) ST. CLAIR CO.

DESIGNED	M. Capron
CHECKED	R. Victor
DRAWN	J. Smith
CHECKED	R. Victor

EJ-BJS

PREPARED BY:
JACOBS CIVIL INC.
ST. LOUIS, MO

143


95%
6-17-2000

PROJECT NO.	SECTION	SHEET NO.	TOTAL SHEETS
82-3HV-2R-1-1	ACIM-70-1(17)1	5-1	5


THIS CONTRACT
CONSISTS OF
4 SETS

- SET 1 OF 4**
 STRUCTURE NO. 082-0141 (ROADWAY A)
 STRUCTURE NO. 082-0253 (RAMP R)
 STRUCTURE NO. 082-0201 (RAMP O)
 STRUCTURE NO. 082-0254 (ROADWAY G)
- SET 2 OF 4**
 STRUCTURE NO. 082-0144 (ROADWAY D)
 STRUCTURE NO. 082-0255 (RAMP O)
 STRUCTURE NO. 082-0203 (RAMP P)
 STRUCTURE NO. 082-0256 (ROADWAY H)
- SET 3 OF 4**
 STRUCTURE NO. 082-0206 (RAMP C OVER 4TH ST.)
- SET 4 OF 4**
 STRUCTURE NO. 082-0140 (RAMP H OVER TRENDLEY AVE.)

STATE OF ILLINOIS
 DEPARTMENT OF TRANSPORTATION
 DIVISION OF HIGHWAYS
**PLANS FOR PROPOSED
 SEISMIC AND REDUNDANCY
 RETROFIT REPAIRS**
 FAI ROUTE 70
 SECTION 82-3HVB-2R-1-1
POPLAR STREET BRIDGE APPROACHES
 PROJECT ACIM-70-1(17)1
 ST. CLAIR COUNTY

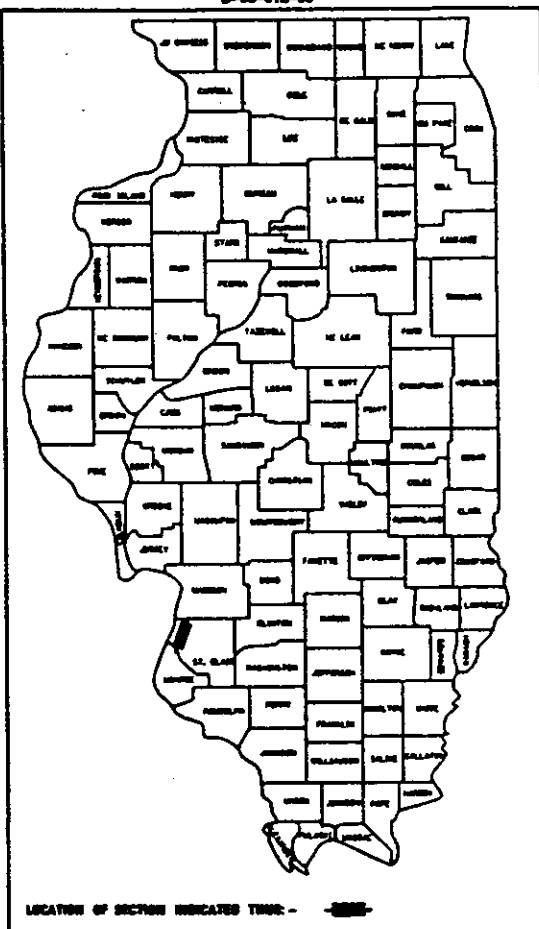

STANDARDS
 701406
 702001

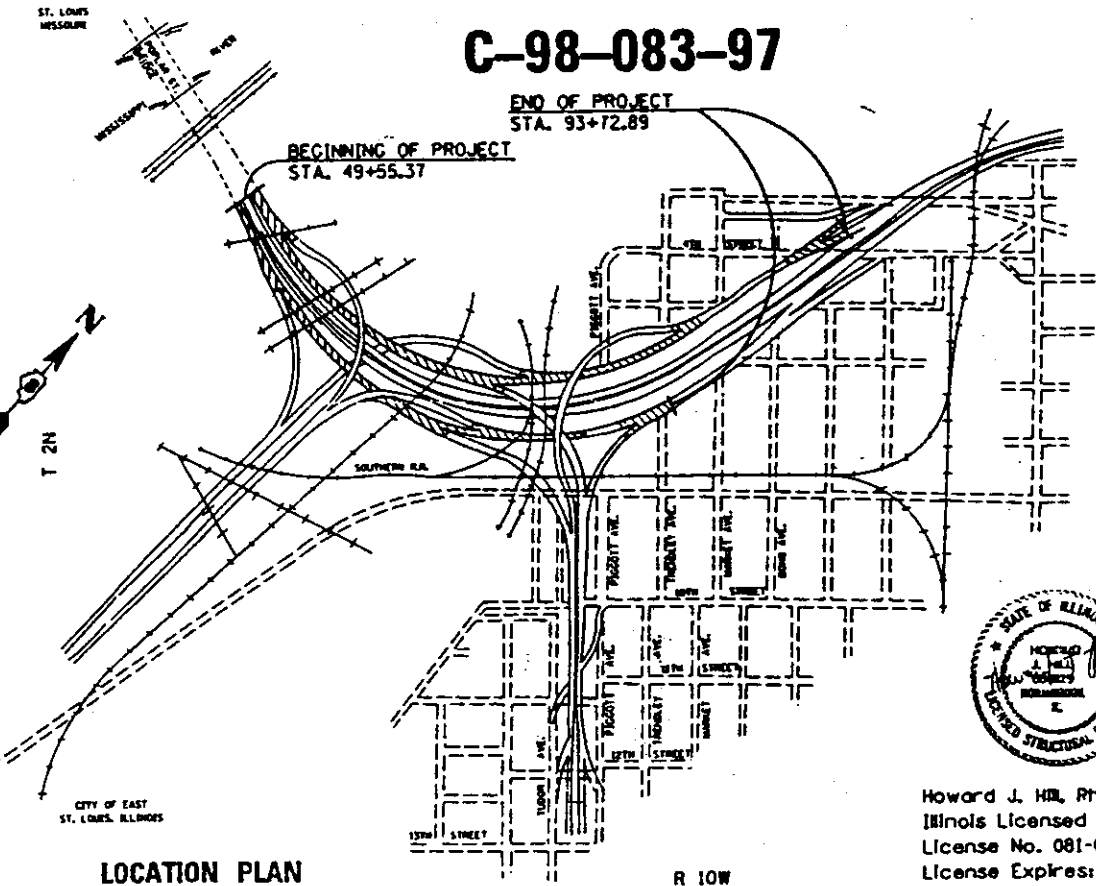

APPROVED
 FOR STRUCTURAL ADEQUACY ONLY
Robert E. Anderson
 ENGINEER OF BRIDGES AND STRUCTURES

PROJECT NET LENGTH :
 0.79 MI. = 4178.58 FT.
 PROJECT GROSS LENGTH :
 0.84 MI. = 4417.52 FT.



Howard J. Hill, Ph.D., SE
 Illinois Licensed Structural Engineer
 License No. 081-004819
 License Expires: 11/30/98

8-231

STATE OF ILLINOIS
 DEPARTMENT OF TRANSPORTATION
 DIVISION OF HIGHWAYS

APPROVED FOR PROJECT DEVELOPMENT AND IMPLEMENTATION
 June 26, 98
Bill Hanky
 CHIEF ENGINEER

APPROVED FOR DESIGN AND ENVIRONMENT
 June 26, 98
James P. St. John
 DIRECTOR, DIVISION OF HIGHWAYS

PROJECT LEADER: BIL LILVI (618)346-1118
 CHIEF LEADER: STEVE JINES (618)346-3191

082-0256

~~082-0253, 0254,~~
 CONTRACT NO. 96680-~~0255,~~ 0256

WJE Wiss, Janney, Elstner Associates, Inc.
 Engineers, Architects, Material Scientists
 138 Pfingsten Road, Northbrook, Illinois 60062
 (847) 272-7400 FAX (847) 291-4813

082-0256
 Rdwy H
 DEC 02 1997

URBAN

90% FED.
10% STATE
SFTY-2A

PROJECT NO.	SHEET NO.	DATE	SCALE	BY
FAJL TO	ST. CLAIR	91	2	

SUMMARY OF QUANTITIES			
CODE NO.	ITEM	UNIT	QUANTITY
50102400	Concrete removal	CUYD	810
50200200	STRUCTURE EXCAVATION (SPECIAL)	CUYD	70
50500405	Furnish & erect structural steel	LBS.	230760
50301245	Formed concrete repair (depth equal to less than 5")	SQ.FT.	570
X0322549	Column wrap	SQ.FT.	10303
X0322550	Wire rope	FT.	2063
X0322551	Epoxy grouted dowels	EACH	1099
X0322552	Embankment protection	SQ.FT.	150
X0322553	Foundation wall dowel modification	EACH	544
X0322554	Foundation wall modification	SQ.FT.	915
X0322555	Cross frame removal	EACH	23
X0322556	Stiffener intersection modification	EACH	920
X0322557	Long span floor beam retrofit	EACH	64
X0322558	Bottom flange splice - bolt replacement	EACH	22
X0322559	Bolt replacement	EACH	18
X0322560	Crack extension modifications	EACH	6
X0322561	Cross beam retrofit	EACH	10
X0322562	Steel girder web reinforcement plate	LBS.	807900
X0322563	Vertical web stiffener removal	EACH	2797
X0322564	Column wrap protection	EACH	4
70101800	Traffic Control and Protection Special	L Sum	1
70101800	Railroad Protective Liability Insurance	L Sum	1
X013200	CHANGEABLE MESSAGE SIGN	CAL MO	12
X010200	ENGINEER'S FIELD OFFICE, TYPE A	CAL MO	12

△ * Sheet 2A & 2B
Traffic Control and
Protection, Special

540

998,300 △

△ ** Sheets 21A & 61A
Redundancy Retrofit Details

INDEX OF SHEETS		INDEX OF SHEETS	
SHEET NO.	DESCRIPTION	SHEET NO.	DESCRIPTION
1	TITLE SHEET	52	SEISMIC RETROFIT DETAILS
2 *	QUANTITIES AND INDEX OF SHEETS	53	SEISMIC RETROFIT DETAILS
3	SET 1 - TITLE SHEET	54	SEISMIC RETROFIT DETAILS
4	GENERAL NOTES	55	SEISMIC RETROFIT DETAILS
5	SCOPE OF WORK	56	SEISMIC RETROFIT DETAILS
6	PROJECT PLAN	57	SEISMIC RETROFIT DETAILS
7	KEY PLAN ROADWAYS A, G, R & O	58	STIFFENER INTERSECTION MODIFICATION DETAIL
8	ELEVATION ROADWAYS A, G, R & O	59	LONG SPAN FLOOR BEAM RETROFIT & BOLT REPLACEMENT
9	TYPICAL SUBSTRUCTURE DETAILS	60	CRACK EXTENSION & CROSS BEAM RETROFITS
10	SEISMIC RETROFIT DETAILS	61**	REDUNDANCY RETROFIT DETAILS
11	SEISMIC RETROFIT DETAILS	62	REDUNDANCY RETROFIT DETAILS
12	SEISMIC RETROFIT DETAILS	63	REDUNDANCY RETROFIT DETAILS
13	SEISMIC RETROFIT DETAILS	64	CONCRETE REPAIR DETAILS
14	SEISMIC RETROFIT DETAILS	65	SEISMIC RETROFIT DETAILS
15	SEISMIC RETROFIT DETAILS	66	PIERS D2 & D5 RETROFIT
16	SEISMIC RETROFIT DETAILS	67	PIERS D8 & D9 RETROFIT
17	SEISMIC RETROFIT DETAILS	68	PIER D11 RETROFIT
18	STIFFENER INTERSECTION MODIFICATION DETAIL	69	PIERS D12 & D13 RETROFIT
19	LONG SPAN FLOOR BEAM RETROFIT & BOLT REPLACEMENT	70	PIERS D15 & D17 RETROFIT
20	CRACK EXTENSION RETROFITS	71	PIERS D18 & D21 RETROFIT
21**	REDUNDANCY RETROFIT DETAILS	72	PIERS D22 & D23 RETROFIT
22	REDUNDANCY RETROFIT DETAILS	73	PIER D24 RETROFIT
23	REDUNDANCY RETROFIT DETAILS	74	PIER D26 RETROFIT
24	CONCRETE REPAIR DETAILS	75	PIERS Q1-1 & Q2-1 RETROFIT
25	SEISMIC RETROFIT DETAILS	76	PIER P14 RETROFIT
26	TEMPORARY EMBANKMENT PROTECTION	77	PIERS P15 & H1 RETROFIT
27	PIER A2 RETROFIT	78	PIERS H2 & H3 RETROFIT
28	PIER A5 RETROFIT	79	PIER H4 RETROFIT
29	PIERS A7 & A8 RETROFIT	80	SET 3 - TITLE SHEET
30	PIERS A9 & A11 RETROFIT	81	GENERAL NOTES
31	PIERS A12 & A15 RETROFIT	82	PROJECT PLAN/SCOPE OF WORK
32	PIERS A16 & A18 RETROFIT	83	KEY PLAN AND ELEVATION FOR RAMP G OVER 4TH STREET
33	PIER A19 RETROFIT	84	SEISMIC RETROFIT DETAILS
34	PIER A21 RETROFIT	85	PIER NO. 1 & NO. 2 RETROFIT
35	PIERS R1-1 & R2-1 RETROFIT	86	SET 4 - TITLE SHEET
36	PIER R3-1 RETROFIT	87	GENERAL NOTES
37	PIERS R4-1 & O1-R RETROFIT	88	PROJECT PLAN/SCOPE OF WORK
38	PIER G1 RETROFIT	89	KEY PLAN AND ELEVATION FOR RAMP H OVER TRENDLEY AVE.
39	PIERS G2 & G5 RETROFIT	90	SEISMIC RETROFIT DETAILS
40	PIERS G9 & G11 RETROFIT	91	PIER NO. 1 & NO. 2 RETROFIT
41	PIER G12 RETROFIT		
42	PIER G13 RETROFIT		
43	SET 2 - TITLE SHEET		
44	GENERAL NOTES		
45	SCOPE OF WORK		
46	PROJECT PLAN		
47	KEY PLAN ROADWAYS D, H, Q & P		
48	ELEVATION ROADWAYS D, H, Q & P		
49	TYPICAL SUBSTRUCTURE DETAILS		
50	SEISMIC RETROFIT DETAILS		
51	SEISMIC RETROFIT DETAILS		

QUANTITIES AND INDEX OF SHEETS

STATE OF ILLINOIS
DEPARTMENT OF TRANSPORTATION
SEISMIC AND REDUNDANCY RETROFIT REPAIRS
FAJ ROUTE TO
POPLAR STREET BRIDGE APPROACHES
ST. CLAIR COUNTY

SCALE: NONE
DATE: 1-23-98
DRAWN BY: JM
CHECKED BY: [Signature]

△ Revised 10/21/98 JCM

△ Revised 1-9-98 R.S.

STATE OF ILLINOIS
 DEPARTMENT OF TRANSPORTATION
 DIVISION OF HIGHWAYS

SET 2 OF
 4 SETS




- * ENCOMPASSING THE FOLLOWING ROADWAYS
- ROADWAY D. STRUCTURE NO. 082-0144
 - RAMP O. STRUCTURE NO. 082-0255
 - RAMP P. STRUCTURE NO. 082-0203
 - ROADWAY H. STRUCTURE NO. 082-0256

**PLANS FOR PROPOSED
 SEISMIC AND REDUNDANCY
 RETROFIT REPAIRS ***

SHEET NO.	DESCRIPTION
S-1	SET 2 - TITLE SHEET
S-2	GENERAL NOTES
S-3	SCOPE OF WORK
S-4	PROJECT PLAN
S-5	KEY PLAN ROADWAYS D, H, O & P
S-6	ELEVATION ROADWAYS D, H, O & P
S-7	TYPICAL SUBSTRUCTURE DETAILS
S-8	SEISMIC RETROFIT DETAILS
S-9	SEISMIC RETROFIT DETAILS
S-10	SEISMIC RETROFIT DETAILS
S-11	SEISMIC RETROFIT DETAILS
S-12	SEISMIC RETROFIT DETAILS
S-13	SEISMIC RETROFIT DETAILS
S-14	SEISMIC RETROFIT DETAILS
S-15	SEISMIC RETROFIT DETAILS
S-16	STIFFENER INTERSECTION MODIFICATION DETAIL
S-17	LONG SPAN FLOOR BEAM RETROFIT & BOLT REPLACEMENT
S-18	CRACK EXTENSION & CROSS BEAM RETROFITS
S-19	REDUNDANCY RETROFIT DETAILS
S-20	REDUNDANCY RETROFIT DETAILS
S-21	REDUNDANCY RETROFIT DETAILS
S-22	NOT USED
S-23	NOT USED
S-24	NOT USED
S-25	NOT USED
S-26	CONCRETE REPAIR DETAILS
S-27	SEISMIC RETROFIT DETAILS
S-28	NOT USED
S-29	PIERS D8 & D9 RETROFIT
S-30	PIERS D8 & D9 RETROFIT
S-31	PIER D11 RETROFIT
S-32	PIERS D12 & D13 RETROFIT
S-33	PIERS D15 & D17 RETROFIT
S-34	PIERS D18 & D21 RETROFIT
S-35	PIERS D22 & D23 RETROFIT
S-36	PIER D24 RETROFIT
S-37	PIER D26 RETROFIT
S-38	PIERS Q1-1 & Q2-1 RETROFIT
S-39	PIER P14 RETROFIT
S-40	PIERS P15 & H1 RETROFIT
S-41	PIERS H2 & H3 RETROFIT
S-42	PIER H4 RETROFIT

⊕ ** S-19A: Redundancy
 Retrofit Details

**FAI ROUTE 70
 SECTION 82-3HVB-2R-1-1
 POPLAR STREET BRIDGE APPROACHES
 ST. CLAIR COUNTY**

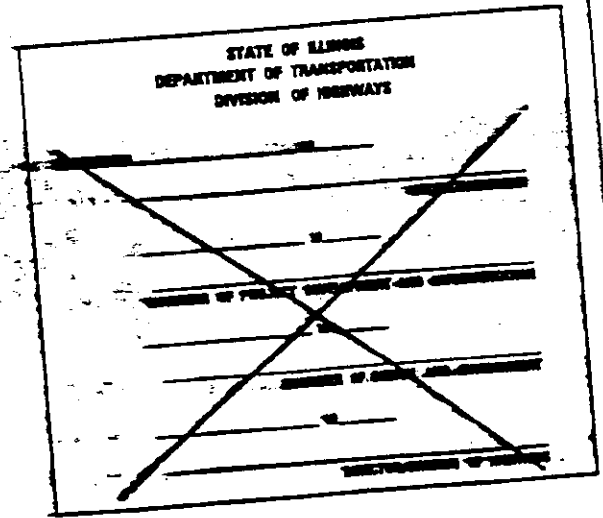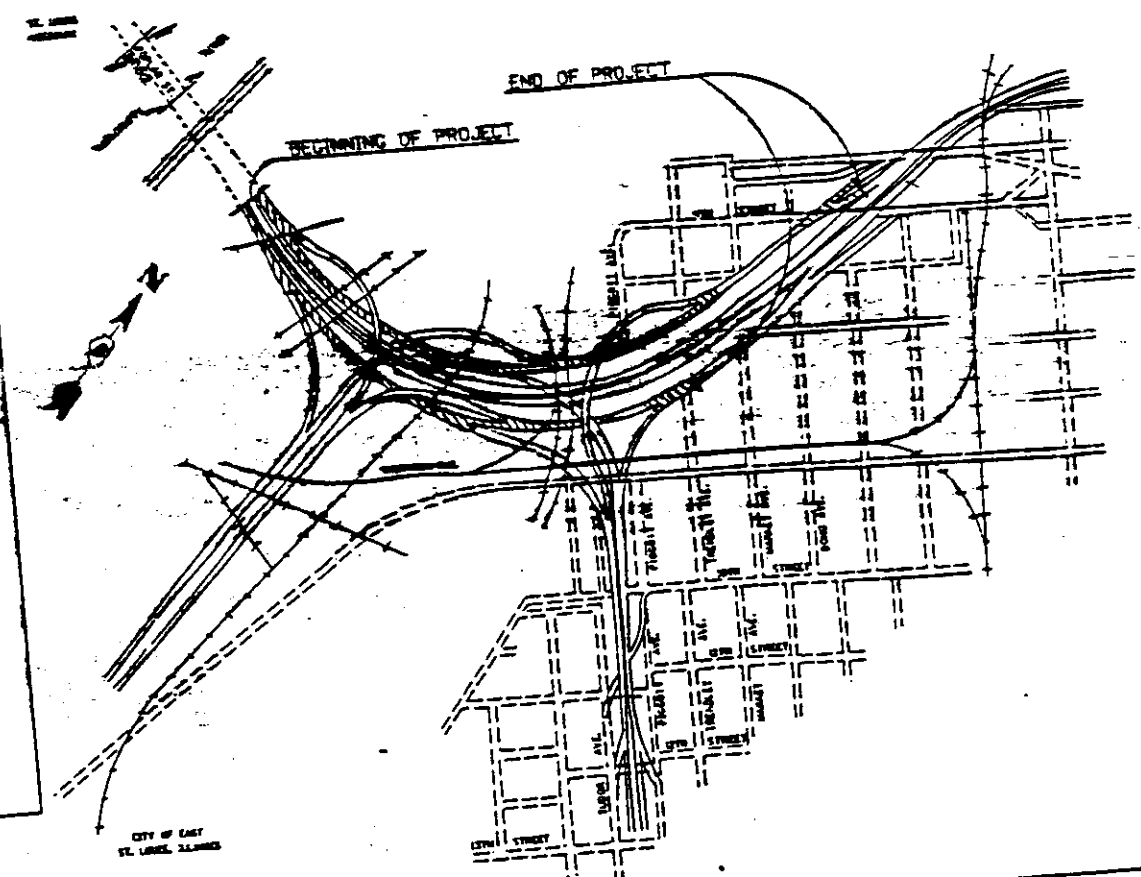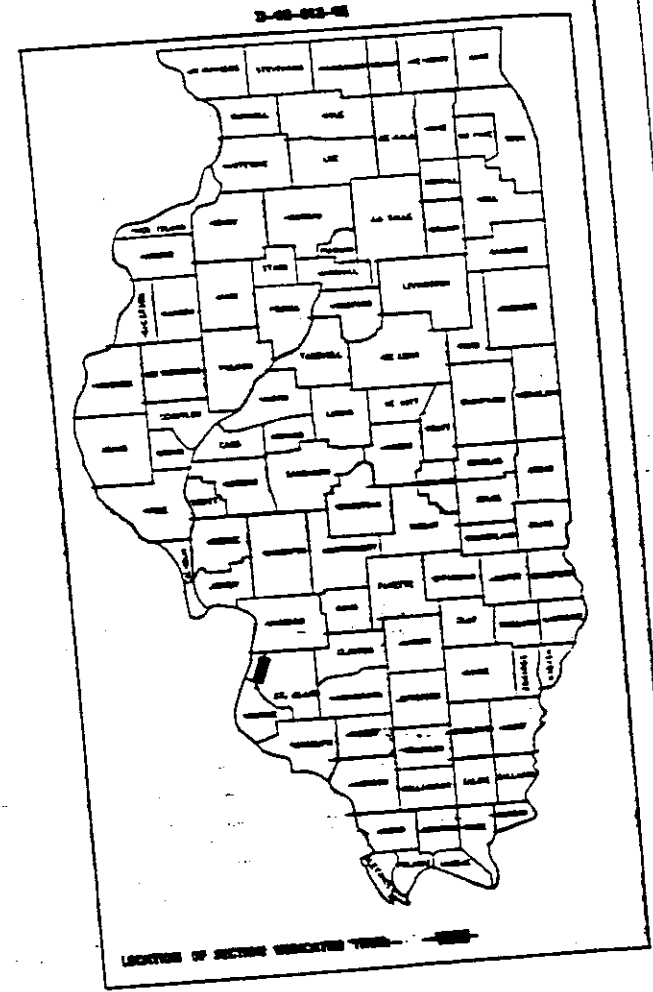

⊕ Revised 10/21/98 JCM

CONTRACT NO. 96680

GENERAL NOTES:

DATE	BY	REVISION	SHEET NO.
			5-2

1. Plan dimensions and details relative to existing structure have been taken from existing plans and are subject to nominal construction variations. It shall be the Contractor's responsibility to verify such dimensions and details in the field and make necessary approved adjustments prior to construction or ordering materials. Such variations shall not be cause for additional compensation for a change in the scope of work, however, the Contractor will be paid for the quantity actually furnished at the unit price bid for the work.
2. This project addresses selected seismic, redundancy and fatigue issues related only to those structures that are listed on the drawings. Related hazards associated with nearby structures or roadways that pass over the subject structures were not considered.
3. Unless noted otherwise, all materials and workmanship shall conform to:
 - a. The Illinois Department of Transportation, "Standard Specifications for Road and Bridge Construction", January 1, 1997.
 - b. Bridge Welding Code, American Welding Society, AWS D15-95.
 - c. Surface Texture, American Society of Mechanical Engineers, ANSI B46.1- Latest Edition.

13. Alternative procedures for the structural modifications will be considered by the Engineer if submitted in writing for approval. The work shall be performed in the sequence listed in the Procedures unless otherwise approved by the Engineer. Where a procedure calls for approval of an Engineer before acceptance, it is anticipated that visual examinations or non-destructive tests will be conducted, and that additional grinding or other work may be required.
14. Where magnetic particle (MT) inspection is called for on the drawings, the minimum qualifications of the Inspector shall meet ASNT Level II requirements. The Engineer will observe the final test acceptance.
15. To avoid bolt clearance installation difficulties, the bumper assemblies shall be installed prior to the installation of the web reinforcement plates.

CONCRETE NOTES:

1. The Engineers' intent is to repair only large areas of unsound concrete or unsound areas receiving column wraps. The contract quantities do not include all of the unsound concrete on the piers. Areas of unsound concrete to be repaired shall be approved by the Engineer.
2. The extent of deteriorated concrete in columns and walls shall be determined by hammer tapping. The concrete removal shall extend a minimum of 4 in. beyond the edge of the unsound area, be as nearly rectangular as possible, and conform to the concrete repair details included in the drawings.
3. Concrete removal equipment consisting of pneumatic chipping hammers shall not exceed a maximum nominal weight of 30 lb. and shall be equipped with a cutting edge not less than 3/4 in. or greater than 2 1/2 in. in width. During concrete removal exercise reasonable care to avoid cracking of underlying sound concrete.

STEEL NOTES:

1. Actual dimensions may vary slightly from the design drawings. The Contractor shall field verify existing dimensions prior to starting work. Dimensions of new members shall be adjusted as required to fit as-built conditions.
2. All new steel assemblies and pieces shall be shop primed with Inorganic zinc rich primer/ Acrylic/ Acrylic paint system. The color of the final finish coat shall be Interstate Green, Munsell No. 7.5 G 4/B. Locations to receive field welding shall be masked off prior to shop priming and field primed after welding.
3. Unless noted otherwise, all bolts shall be high strength bolts (AASHTO M164). All threaded rods and dowels shall conform to the mechanical properties and thread configuration of AASHTO M164 bolts. All bolts, threaded rods, wire rope and hardware shall be galvanized according to DOT galvanized bolt provisions. In bolted applications, threads shall not be permitted in shear planes, unless noted otherwise. AASHTO M253 bolts shall not be galvanized.
4. Unless noted otherwise, all new steel shall be AASHTO M270 Grade 36 and have a minimum CVN impact toughness of 25 Ft.-Lb. at 40° F. All rods with upset ends shall have a maximum yield strength of 45 ksi.
5. ~~Welding electrodes shall be low hydrogen E70XX, unless noted otherwise. Field metal shall have a minimum CVN of 25 Ft.-Lb. at 20° F.~~
6. All turnbuckles, clevises and pins shall be galvanized and capable of developing the ultimate strengths of the corresponding assemblies.
7. All wire ropes shall be galvanized and shall have a minimum effective modulus of elasticity of 10,000 ksi. All wire rope fittings shall be capable of developing the ultimate strength of the corresponding rope.
8. Threads on all bolts, rods, and dowels, not installed per AISC specifications shall be deamed.
9. Turnbuckles located in cross frame retrofits shall be tightened to achieve a torque of 1000 Ft.-Lbs. in the turnbuckle.
10. The existing structural steel coating contains lead. The Contractor should take appropriate precautions to deal with the presence of lead on this project. Lead based paint will not be removed from the structure except as necessary to remove transverse stiffeners and perform fatigue retrofits.
11. At locations of transverse stiffener removal, existing girder webs shall be primed with an inorganic zinc rich primer and painted with a paint system compatible with the existing paint.
12. No welding, flame cutting or carbon-arc cutting is permitted unless specified in a repair detail or approved by the Engineer.

REVISIONS	
NAME	DATE
JCM	10/21/98

GENERAL NOTES

STATE OF ILLINOIS
 DEPARTMENT OF TRANSPORTATION
 SEISMIC AND REDUNDANCY RETROFIT REPAIRS
 I-55 ROUTE 70
 POPLAR STREET BRIDGE APPROACHES
 ST. CLAIR COUNTY

STRUCTURE NO. 082-0144 ROADWAY B1 STRUCTURE NO. 082-0203 RAMP P1
 STRUCTURE NO. 082-0256 ROADWAY B2 STRUCTURE NO. 082-0255 RAMP O1
 SCALE: NONE DRAWN BY: JM

SCOPE OF WORK

SEISMIC RETROFIT

1. Install column wraps on the following piers.
 - Structure No. 082-0144 (Roadway D, 22 locations)

D2	D4	D5	D6	D7
D8	D9	D10	D11	D12
D13	D14	D15	D16	D17
D18	D19	D20	D21	D22
 - Structure No. 082-0255 (Ramp P, 2 locations)

P14	P15
-----	-----
 - Structure No. 082-0203 (Ramp P, 1 location)

P14

2. Install tie beam wraps on the following piers (excluding piers with cross frames)
 - Structure No. 082-0144 (Roadway D, 6 locations)

D4	D7	D16
D6	D10	D19
3. Install cross frame assembly including tie beam wraps, column bands and slab/floor beam connections on the following piers.
 - Structure No. 082-0144 (Roadway D, 6 locations)

D2	D7	D22
D9	D17	D24
 - Structure No. 082-0256 (Ramp P, 2 locations)

H3	H4
----	----
4. Install slab/floor beam connections on the following piers (excluding piers with cross frames)
 - Structure No. 082-0144 (Roadway D, 22 locations)

D3	D7	D14	D20
D4	D10	D16	D22 (East)
D6	D11 (West)	D18	D25
5. Remove existing cross frames and install new cross frames at the following piers.
 - Structure No. 082-0144 (Roadway D, 2 locations)

D8-1	D2-1
------	------
6. Install bumper/tie assembly on the following piers.
 - Structure No. 082-0144 (Roadway D, 7 locations)

D5	D11	D15	D22
D8	D12	D18	
 - Structure No. 082-0203 (Ramp P, 1 location)

P15

 - Structure No. 082-0256 (Roadway H, 1 location)

H1

7. Install foundation wall dowel modifications on the following piers.
 - Structure No. 082-0144 (Roadway D, 23 locations)

D4	D9	D18	D25
D5	D13	D19	
D6	D15	D24	
D8	D17	D25	
 - Structure No. 082-0203 (Ramp P, 1 location)

P14

 - Structure No. 082-0256 (Roadway H, 3 locations)

H1	H3	H4
----	----	----
8. Install shear transfer assembly at the following piers.
 - Structure No. 082-0144 (Roadway D, 2 locations)

D9	D24
----	-----
9. Install bumper assembly on the following piers.
 - Structure No. 082-0144 (Roadway D, 2 locations)

D22	D25
-----	-----
 - Structure No. 082-0256 (Roadway H, 1 location)

H2

10. Install girder tie assembly on the following piers.
 - Structure No. 082-0144 (Roadway D, 2 locations)

D11	D26
-----	-----
 - Structure No. 082-0203 (Ramp P, 1 location)

P14

12. Install bumper column bands on the following piers.
 - Structure No. 082-0144 (Roadway D, 6 locations)

D5	D9	D18
D8	D15	D24
13. Install foundation wall dowel on the following piers.
 - Structure No. 082-0144 (Roadway D, 2 locations)

D22	D21
-----	-----
 - Structure No. 082-0203 (Ramp P, 1 location)

P15

FATIGUE & REDUNDANCY RETROFIT

1. Perform stiffener intersection modifications on the structures.
 - Structure No. 082-0144 (Roadway D, 23 spans)

D1 thru D10	D12 thru D20	D22 thru D25
-------------	--------------	--------------
 - Structure No. 082-0256 (Roadway H, 3 spans)

H2	H3	H4
----	----	----
2. Perform long span floor beam retrofits on the following structures.
 - Structure No. 082-0144 (Roadway D, 4 spans)

D9	D10	D14	D25
----	-----	-----	-----
3. Perform bottom flange brace - BFB replacement on the following structures.
 - Structure No. 082-0144 (Roadway D, 6 spans)

D1	D3	D9
D2	D4	D22
4. Perform BFB replacement retrofits on the following structures.
 - Structure No. 082-0144 (Roadway D, 3 spans)

D22	D23	D24
-----	-----	-----
 - Structure No. 082-0256 (Roadway H, 1 span)

H3

5. Perform cross extension retrofits on the following structures.
 - Structure No. 082-0256 (Roadway H, 2 spans)

H3	H4
----	----
6. Perform cross beam retrofits on the following structures.
 - Structure No. 082-0144 (Roadway D, 1 span)

D22

 - Structure No. 082-0203 (Ramp P, 1 span)

P15

 - Structure No. 082-0256 (Roadway H, 1 span)

H1

7. Install redundancy web plates on the following structures.
 - Structure No. 082-0144 (Roadway D, 23 locations)

D1 thru D10	D12 thru D20	D22 thru D25
-------------	--------------	--------------
 - Structure No. 082-0256 (Roadway H, 3 locations)

H2	H3	H4
----	----	----





*Wrapping of these columns by others (BTP-Research-Project) will be part of this contract. See Special Instructions.

SCOPE OF WORK

STATE OF ILLINOIS
DEPARTMENT OF TRANSPORTATION
SEISMIC AND REDUNDANCY RETROFIT REPAIRS
FAI ROUTE TO
POPLAR STREET BRIDGE APPROACHES
ST. CLAIR COUNTY

STRUCTURE NO. 082-0144 ROADWAY D STRUCTURE NO. 082-0203 RAMP P
STRUCTURE NO. 082-0256 ROADWAY H STRUCTURE NO. 082-0256 RAMP P
SCALE: NONE DRAWN BY: JH
DATE: 1-25-98 CHECKED BY: MH

ROUTE NO.	SECTION	COUNTY	TOTAL SHEETS	SHEET NO.	SHEET NO. S-5
F.A.L. 78	#	ST. CLAIR	91	47	
PROJECT NO.	082-3148-28-1-1	PROJECT NAME	POPULAR STREET BRIDGE APPROACHES		

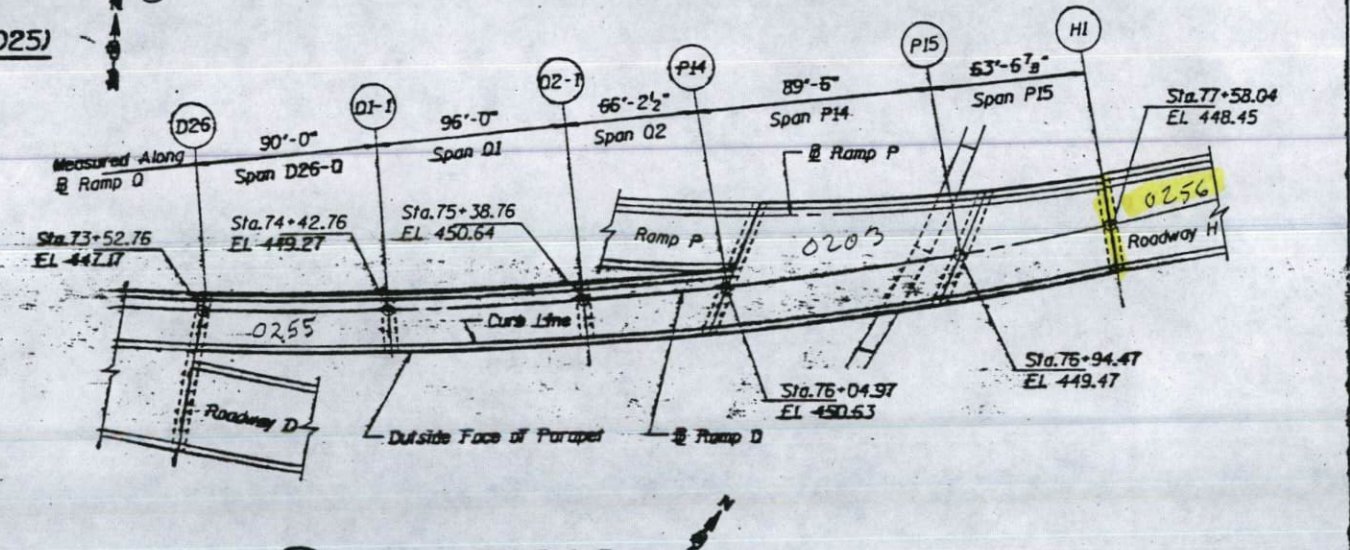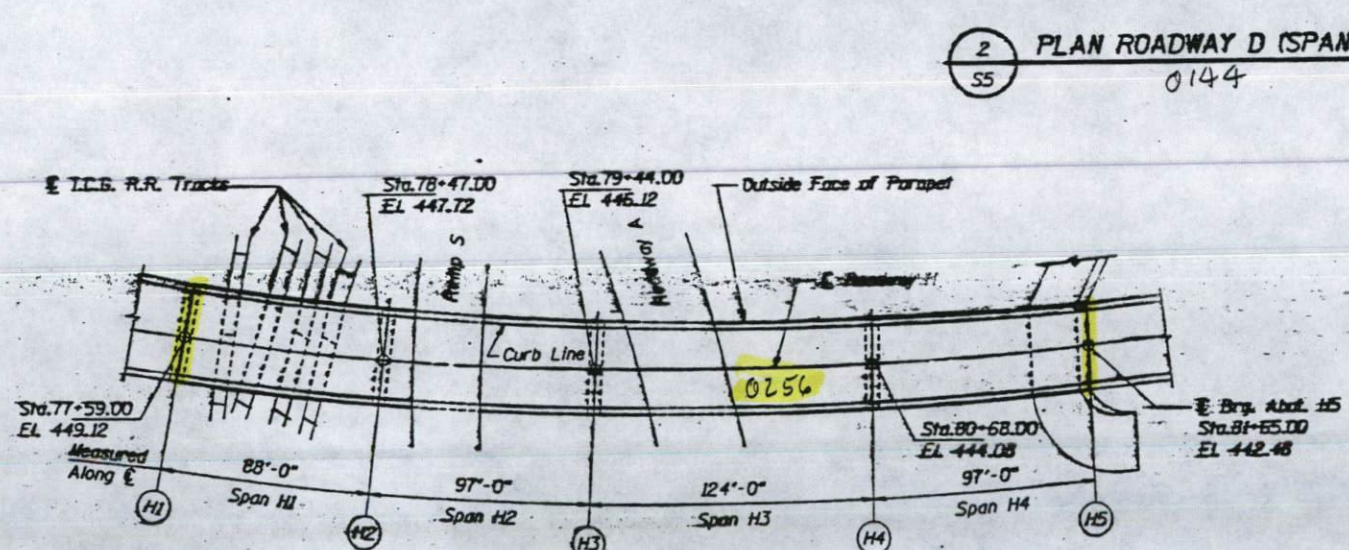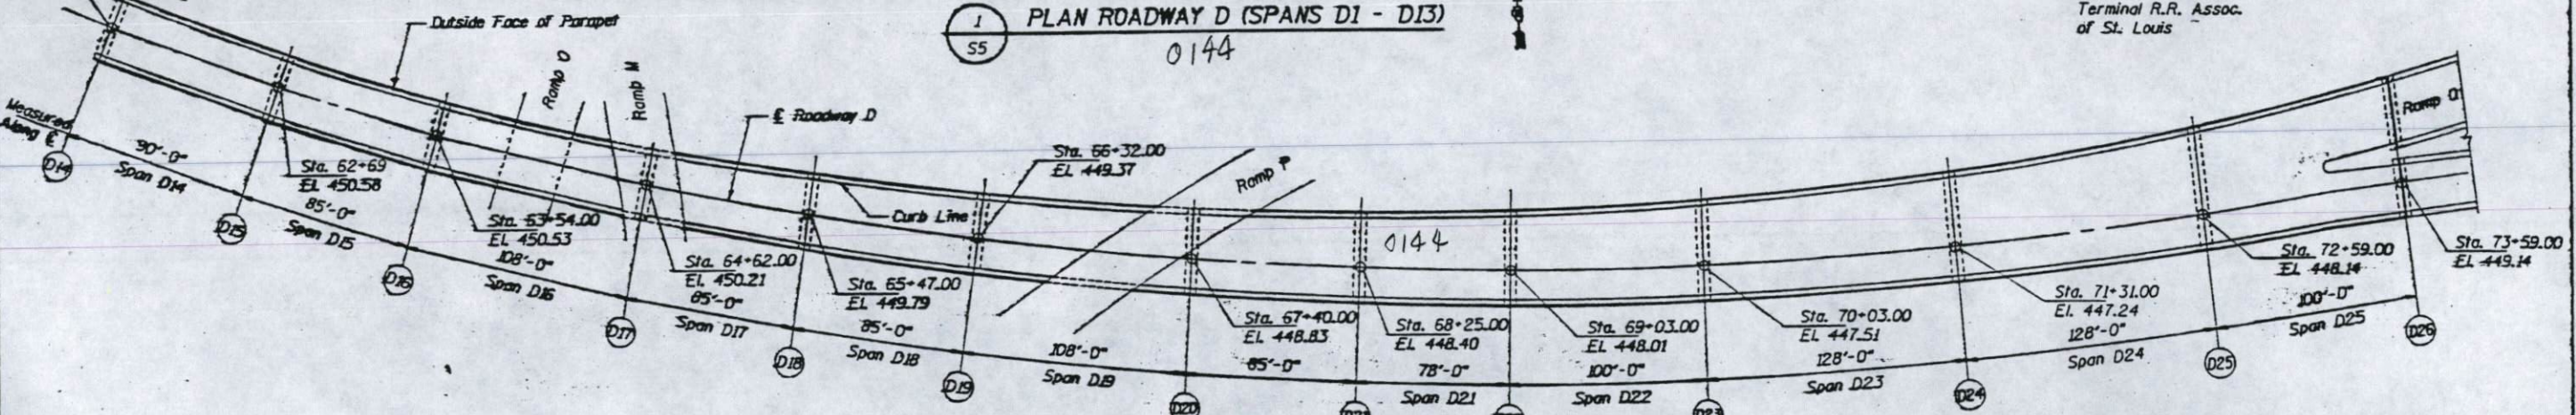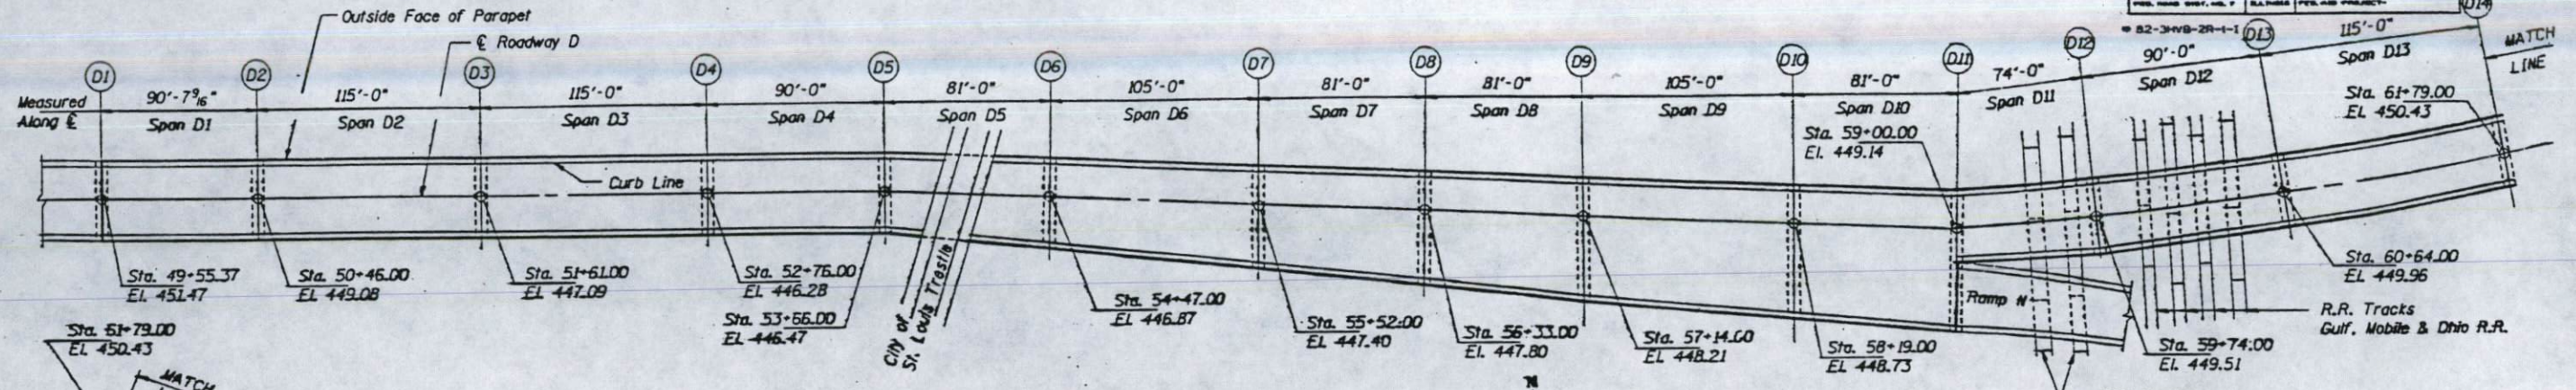


KEY PLAN FOR ROADWAYS D & H AND RAMPS Q & P

STATE OF ILLINOIS
DEPARTMENT OF TRANSPORTATION
SEISMIC AND REDUNDANCY RETROFIT REPAIRS
FAT ROUTE 70
POPULAR STREET BRIDGE APPROACHES
ST. CLAIR COUNTY


STRUCTURE NO. 082-0144 ROADWAY D | STRUCTURE NO. 082-0203 RAMP P
STRUCTURE NO. 082-0205 ROADWAY H | STRUCTURE NO. 082-0205 RAMP Q
SCALE: AS SHOWN | DRAWN BY: JH
DATE: 1-23-98 | CHECKED BY: HM

V:\STRUCTURE\97\28\1812\1812088.DWG


ROUTE NO.	DISTRICT	COUNTY	SHEET NO.	SHEET TOTAL
F.A.L. 78		ST. CLAIR	78	48
SHEETS				
PROJECT: 82-3448-20-1-1				

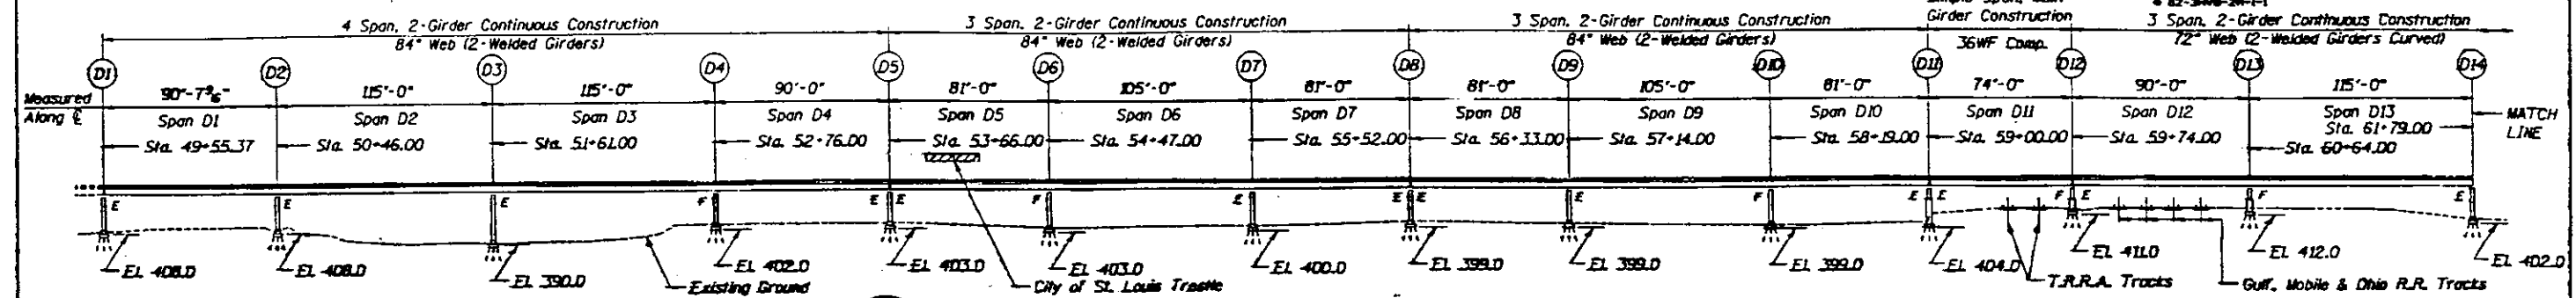


1 ELEVATION ROADWAY D (SPANS D1 - D13)

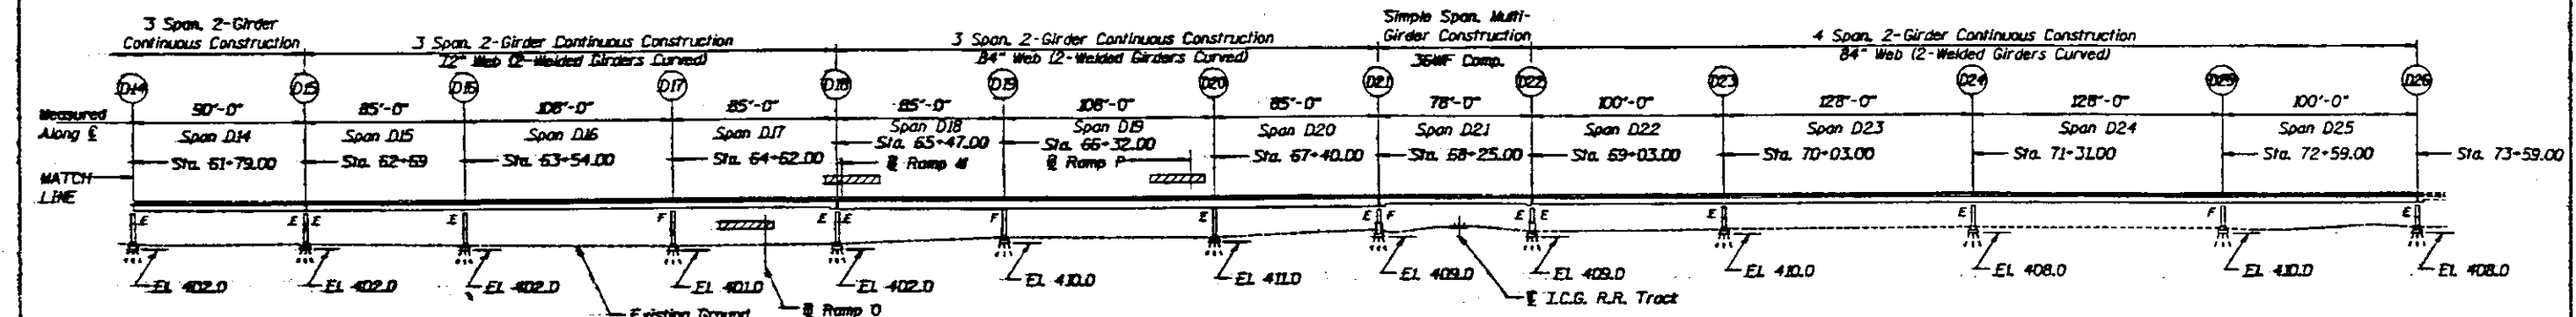

2 ELEVATION ROADWAY D (SPANS D14 - D25)

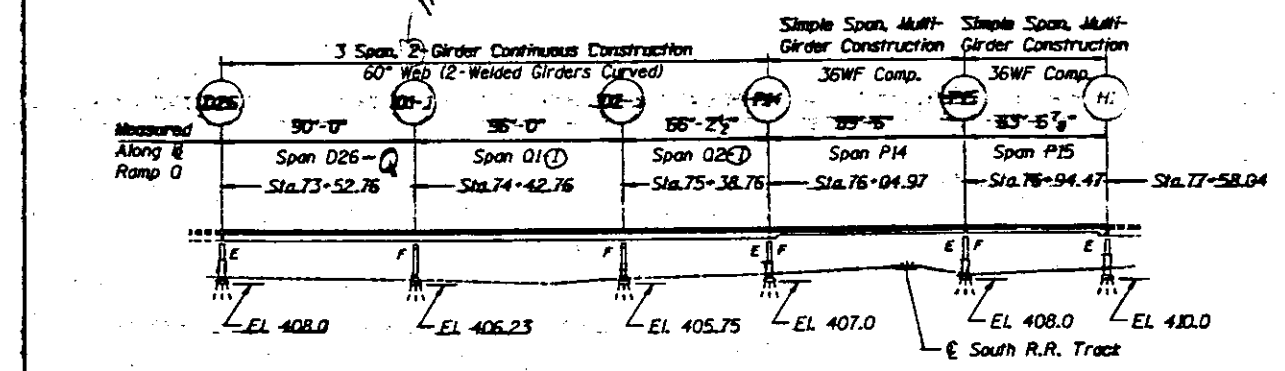

3 ELEVATION RAMPS O & P

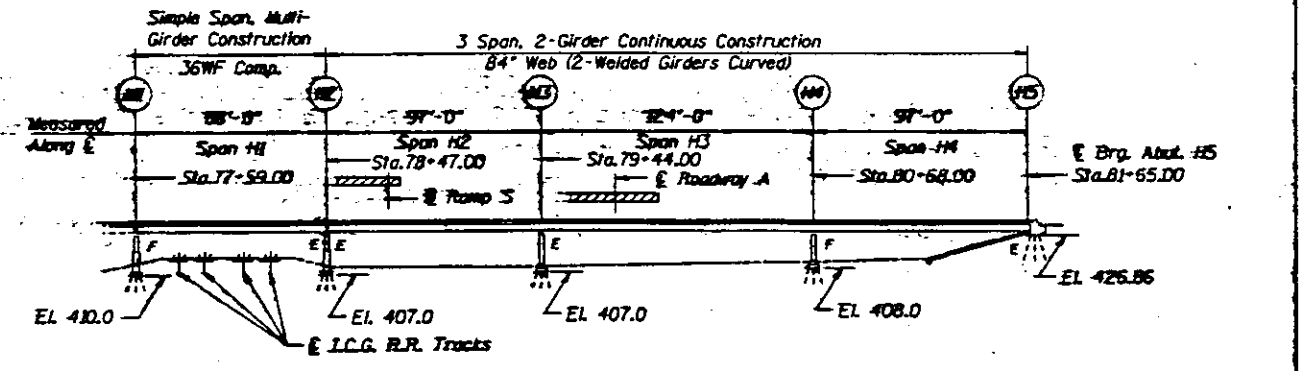


4 ELEVATION ROADWAY H

ELEVATION OF SPAN LIMITS FOR ROADWAYS D & H AND RAMPS O & P

STATE OF ILLINOIS
DEPARTMENT OF TRANSPORTATION
SEISMIC AND REDUNDANCY RETROFIT REPAIRS
FAI ROUTE 70
POPLAR STREET BRIDGE APPROACHES
ST. CLAIR COUNTY

STRUCTURE NO. 082-0144 ROADWAY D STRUCTURE NO. 082-0203 RAMP P
STRUCTURE NO. 082-0206 ROADWAY H STRUCTURE NO. 082-0208 RAMP O
SCALE: NONE DRAWN BY: JH
DATE: 1-23-98 CHECKED BY: JH

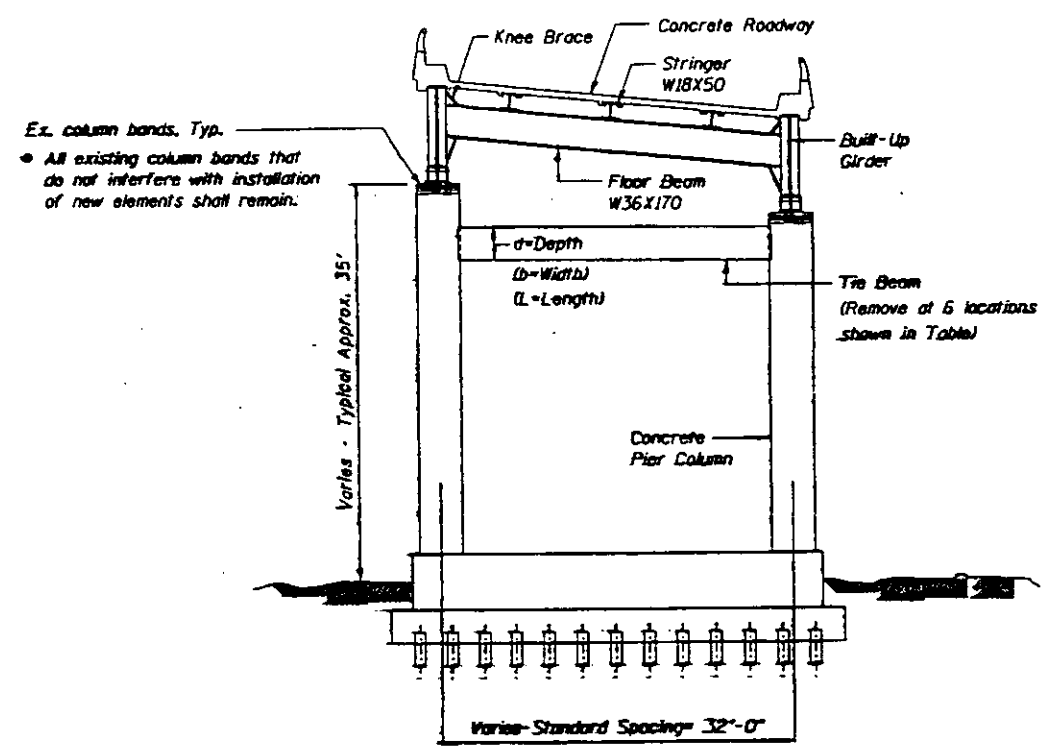


TIE BEAM REMOVAL PARAMETERS

Pier	d (in.)	b (in.)	L (Ft.-in.)	Comments
D5	36	15	28'-0"	
D8	36	21	40'-2"	
D15	36	15	28'-0"	
D18	36	15	28'-0"	
D26	36	15 & 24	57'-0"	See Note 4
P14	36	15	42'-10"	See Note 3

- Notes:**
1. Cut tie beam ends flush with inside faces of columns, such that horizontal ledge is eliminated.
 2. Coat exposed ends of reinforcement bars with IDOT approved epoxy. Epoxy shall overlap a minimum of 1" into surrounding concrete.
 3. Length (L) includes 2 tie beams to be removed.
 4. Includes 9'-0" of 24" x 36" tie beam and 48'-0" of 15" x 36" tie beam, in 3 sections.

1 TYPICAL SECTION THROUGH TWO GIRDER ROADWAY
(Section through Ramp Similar)

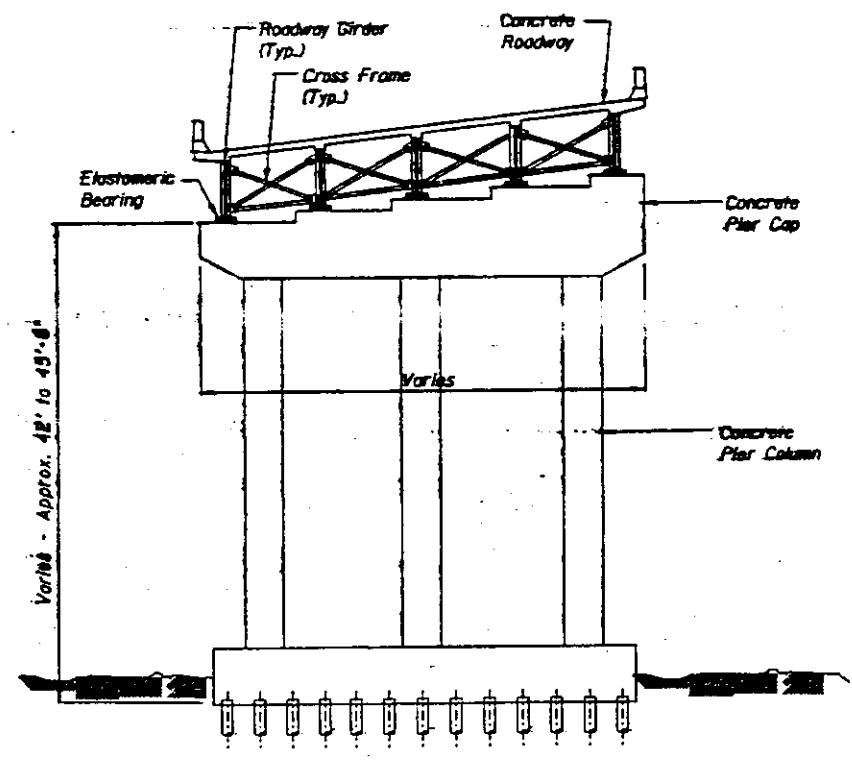


2 TYPICAL SECTION THROUGH MULTI - GIRDER ROADWAY

TYPICAL SUBSTRUCTURE DETAILS


STATE OF ILLINOIS
DEPARTMENT OF TRANSPORTATION
SEISMIC AND REDUNDANCY RETROFIT REPAIRS
FAI ROUTE 70
POPLAR STREET BRIDGE APPROACHES
ST. CLAIR COUNTY

STRUCTURE NO. 082-0144 ROADWAY D1 STRUCTURE NO. 082-0203 RAMP P1
STRUCTURE NO. 082-0256 ROADWAY B8 STRUCTURE NO. 082-0256 RAMP D3
SCALE: NONE DRAWN BY: JH
DATE: 1-23-98 CHECKED BY: HW

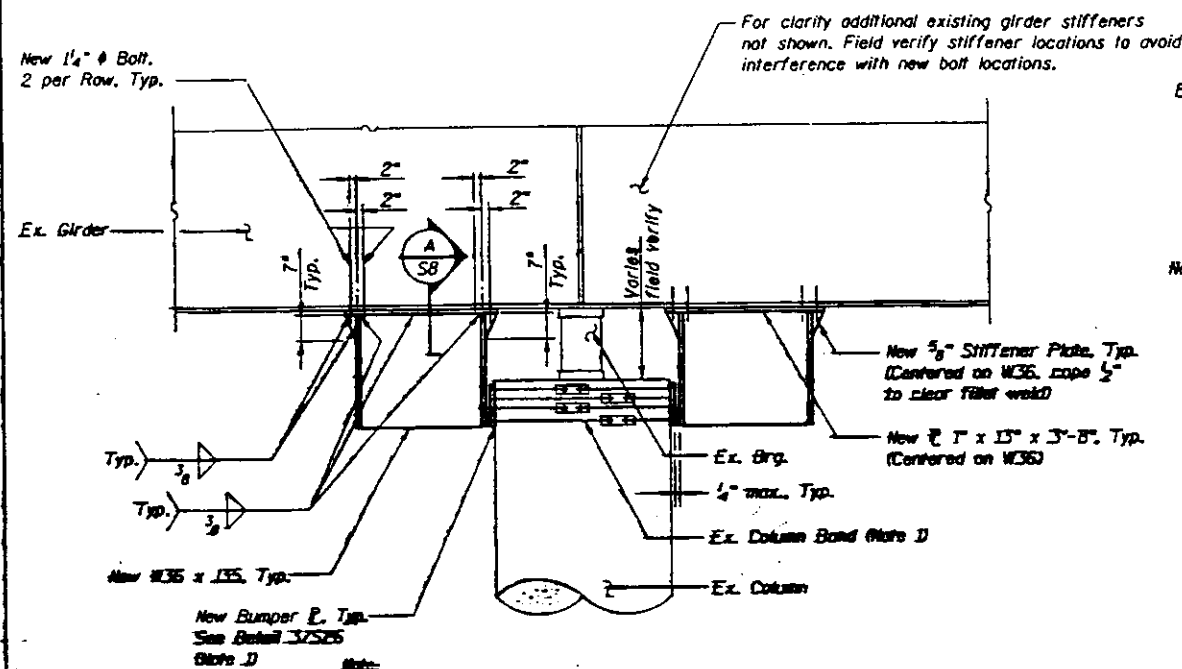


1. Some locations will require new band and bumper P assembly. Appropriate details are called out on elevations of affected piers.


ELEVATION: BUMPERS AT CONTINUOUS GIRDER

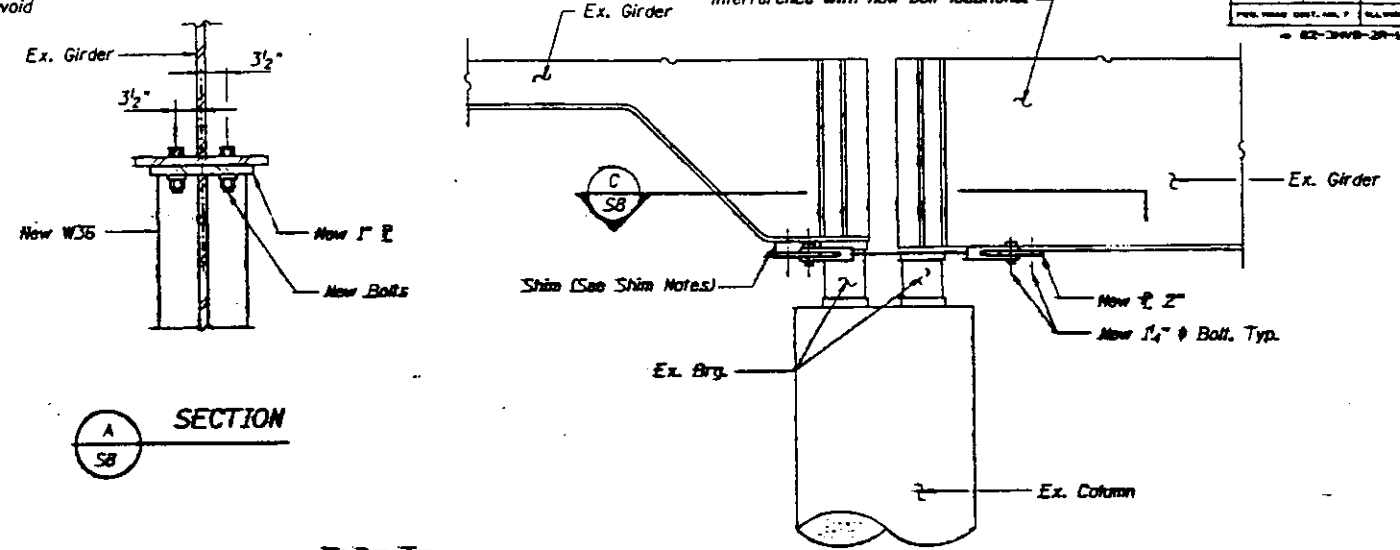

ELEVATION: TIE ASSEMBLY

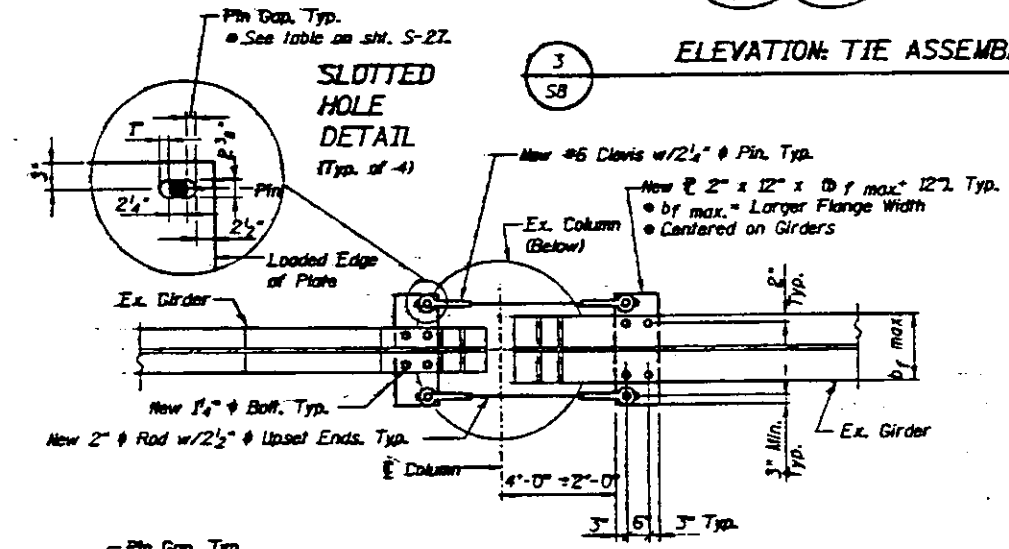


SECTION C

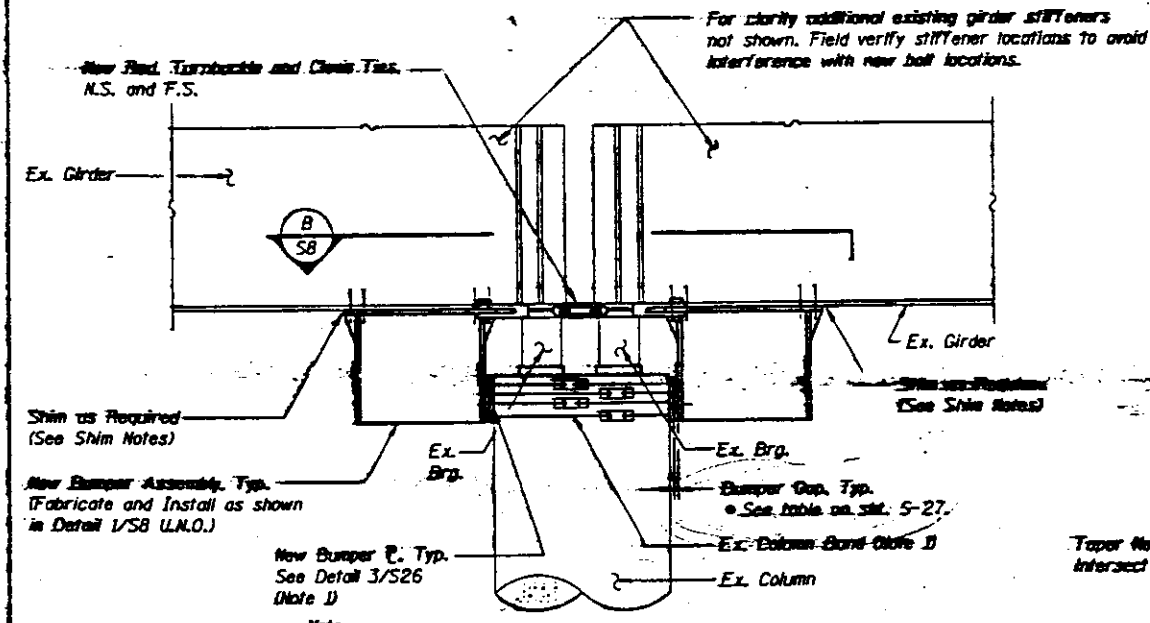

1. Some locations will require new band and bumper P assembly. Appropriate details are called out on elevations of affected piers.

ELEVATION: BUMPER/TIE ASSEMBLY

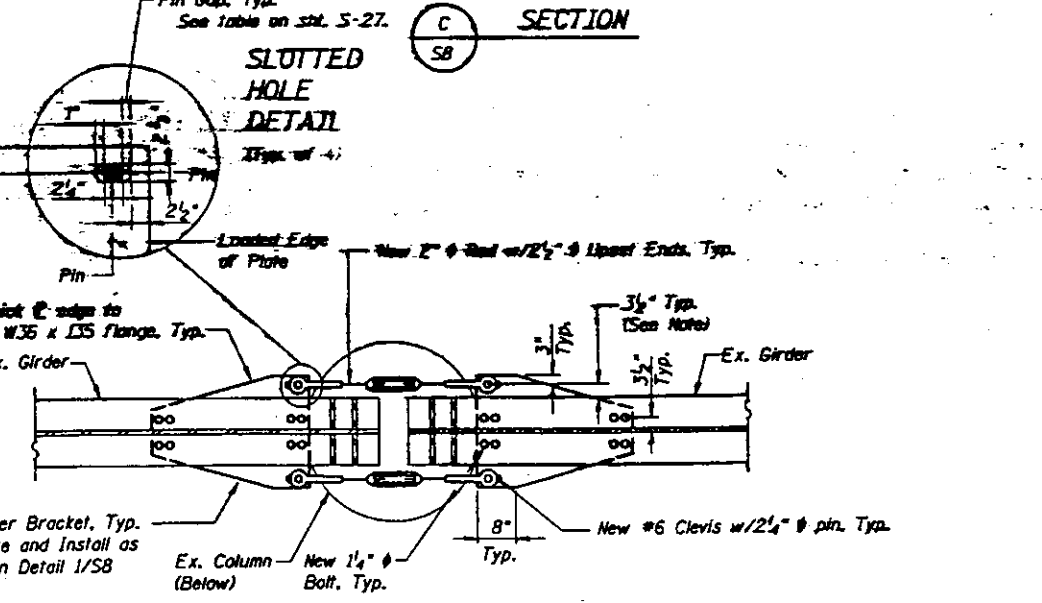

SECTION B


- SHIM NOTES:**
1. Shim higher flange so that elevation difference between ends of rod is no more than 1/2".
 2. Shim Plate length shall match the smaller length of the plates being shimmed, and shim plate width shall match the smaller width of the plates being shimmed.
 3. Field verify shim requirements.
- BUMPER/TIE ROD NOTES:**
1. All bolt holes shall be standard round holes (φ + 1/16") Unless Noted Otherwise.
 2. All bumpers and tie rod connection plates shall be centered on the existing girder.
 3. Tie Rods may be multiple bar sections with turnbuckles or single rods without turnbuckles.
 4. The total length of the unthreaded portion of each tie rod assembly shall not be less than 1'-8".
 5. Tie rods may extend 0" min. to 3/4" max. into clais and turnbuckle openings UNLD.

SEISMIC RETROFIT DETAILS

STATE OF ILLINOIS
 DEPARTMENT OF TRANSPORTATION
 SEISMIC AND REDUNDANCY RETROFIT REPAIRS
 FAI ROUTE 70
 POPLAR STREET BRIDGE APPROACHES
 ST. CLAIR COUNTY


STRUCTURE NO. 082-0144 ROADWAY DR STRUCTURE NO. 082-0203 RAMP P1
 STRUCTURE NO. 082-0285 BRIDGEWAY DR STRUCTURE NO. 082-0285 RAMP G3
 SCALE: NONE
 DATE: 1-23-98

DRAWN BY JH

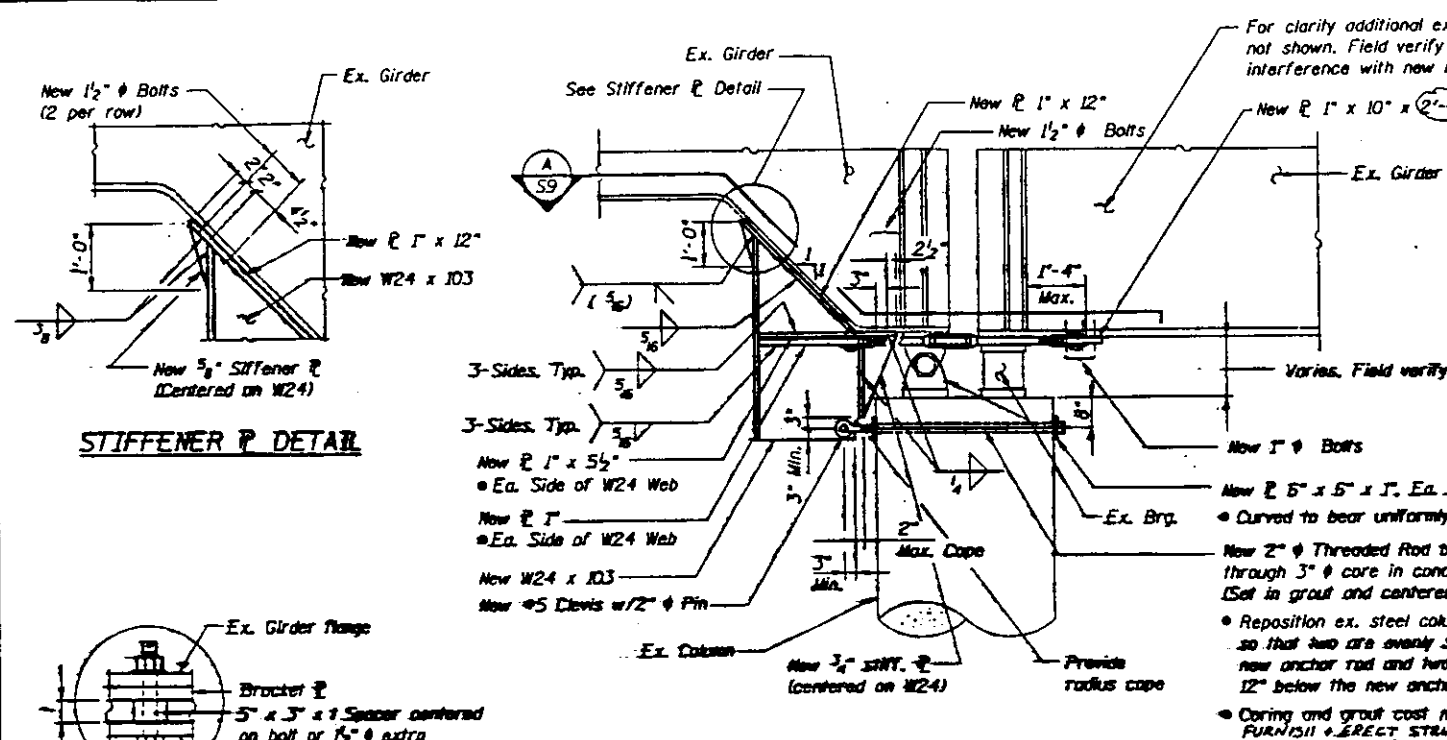


ELEVATION: BUMPER/TIE AT HAUCHED GIRDER WITH FIXED BEARING

1
S9

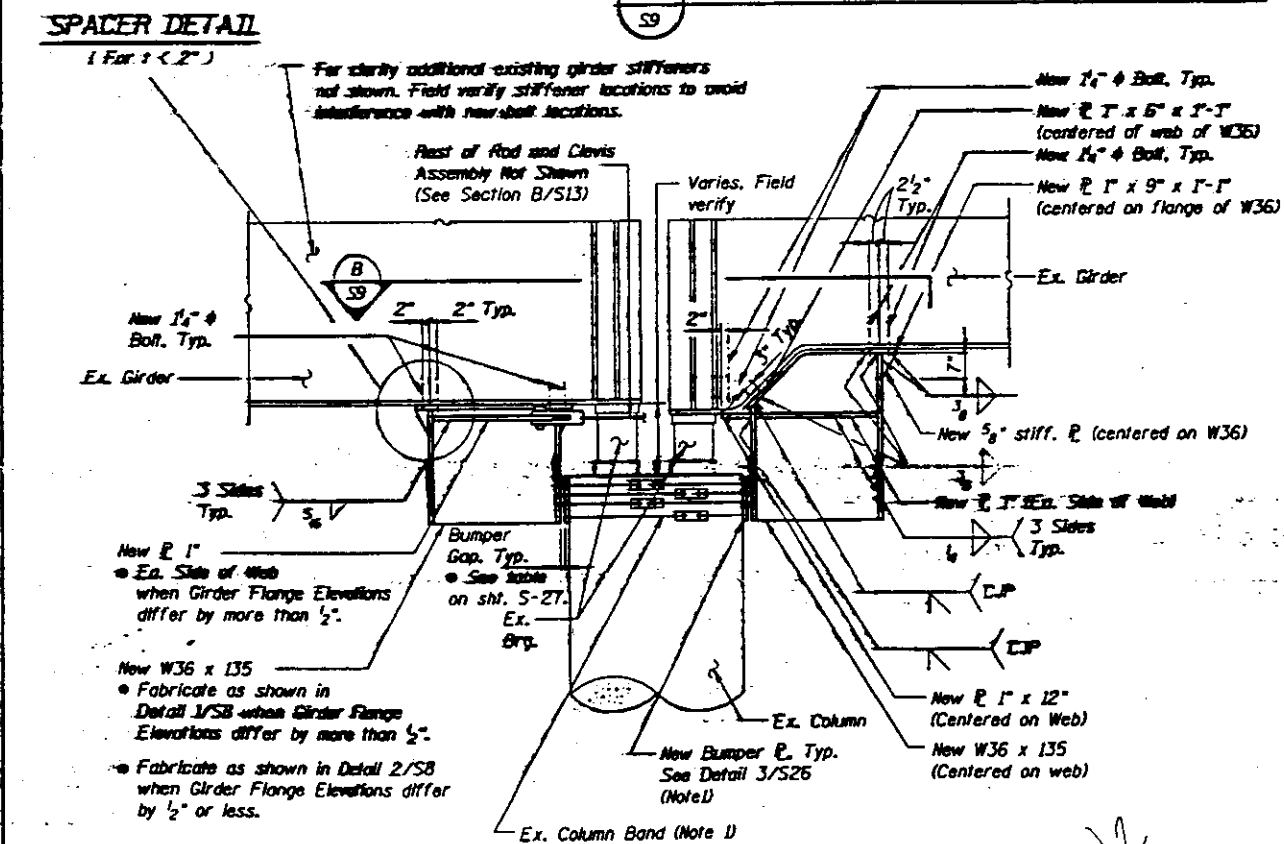


ELEVATION: BUMPER/TIE AT HAUCHED GIRDER

2
S9

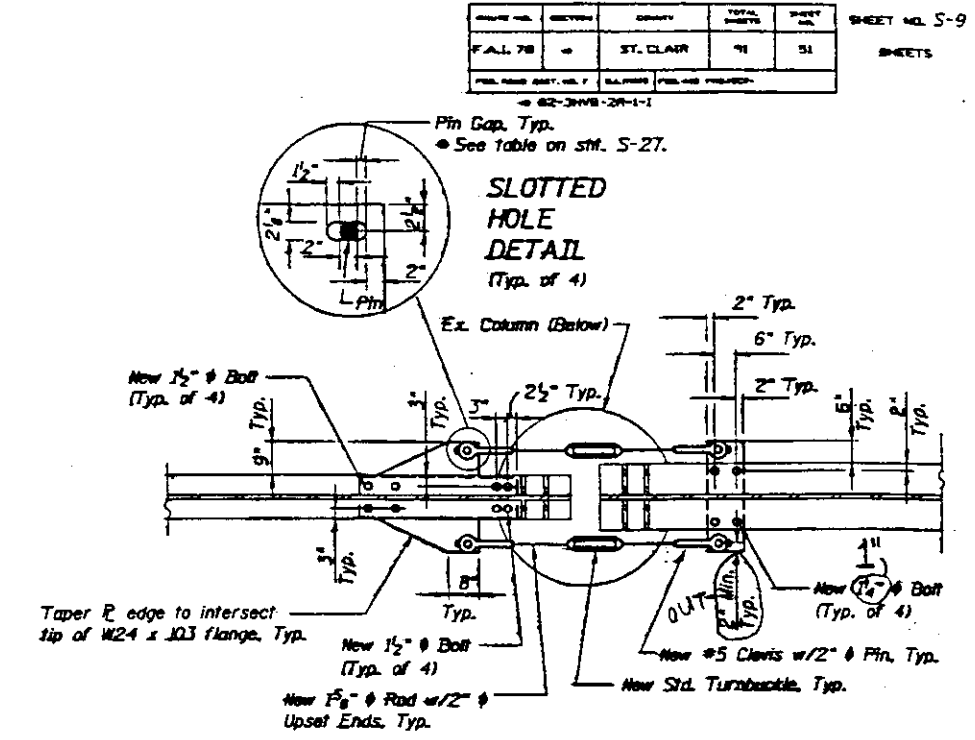

A
SECTION
S9

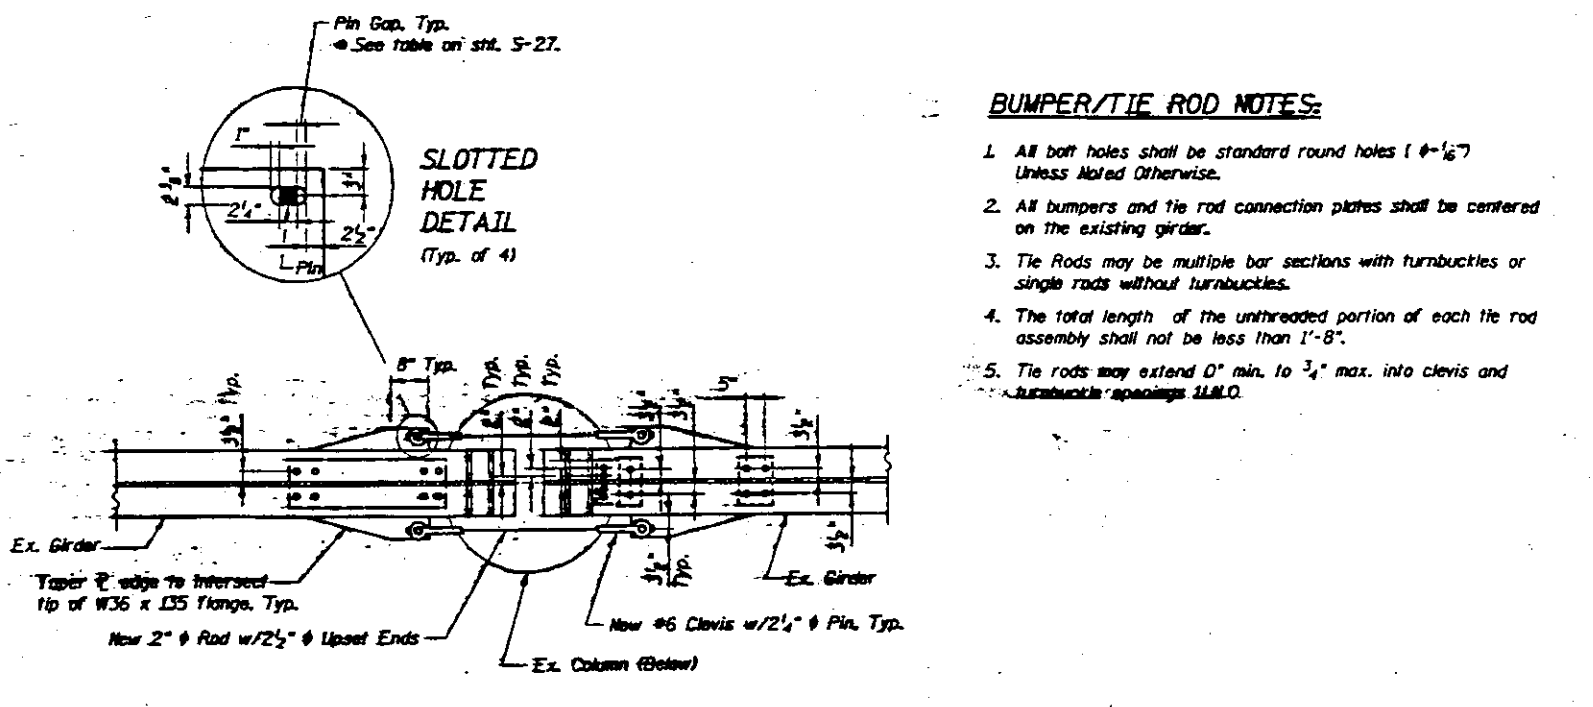

B
SECTION
S9

- BUMPER/TIE ROD NOTES:**
- All bolt holes shall be standard round holes (1/16") unless noted otherwise.
 - All bumpers and tie rod connection plates shall be centered on the existing girder.
 - Tie Rods may be multiple bar sections with turnbuckles or single rods without turnbuckles.
 - The total length of the unthreaded portion of each tie rod assembly shall not be less than 1'-8".
 - Tie rods may extend 0" min. to 3/4" max. into clevis and turnbuckle openings 11810.

SEISMIC RETROFIT DETAILS

STATE OF ILLINOIS
DEPARTMENT OF TRANSPORTATION
SEISMIC AND REDUNDANCY RETROFIT REPAIRS
FAI ROUTE TO
POPLAR STREET BRIDGE APPROACHES
ST. CLAIR COUNTY

STRUCTURE NO. 082-0144 ROADWAY D1 STRUCTURE NO. 082-0203 RAMP P1
STRUCTURE NO. 082-0205 ROADWAY W8 STRUCTURE NO. 082-0205 RAMP D1
SCALE: NONE DRAWN BY: JM
DATE: 1-23-98 CHECKED BY: JM


STRUCTURENO.082-0144ROADWAYD1

TABLE OF COLUMN WRAP AND TIE BEAM WRAP PARAMETERS


Pier No.	No. Coils	D (in.)	N	M	b (in.)	d (in.)	Comments
D2	2	48	7	9	15	36	See Note 5
D4	2	54	8	9	15	36	
D5	2	48	7	9	18	36	
D7	2	48	7	9	21	36	
D8	2	48	7	9	15	36	
D9	2	48	7	9	24	36	See Note 5
D10	2	54	8	9	27	36	See Note 7
D12	2	48	7	9	15	36	See Note 4
D13	2	48	7	9	15	36	See Note 5
D14	2	48	7	9	15	36	See Note 5
D15	2	48	7	9	15	36	
D17	2	54	8	9	15	36	See Note 5
D18	2	48	7	9	15	36	
D19	2	48	7	9	15	36	
D20	2	48	7	9	15	36	
D21	2	48	7	9	15	36	See Note 4
D23	2	54	8	9	21	36	See Note 5
D24	2	54	8	9	24	36	See Note 5, 6 and 7
D25	2	54	8	9	24	36	See Note 7
D26	2	48	7	9	15	36	Wrap North Col. only
D1-1	2	48	7	9	15	36	
D2-1	2	48	7	9	15	36	
H1	2	48	7	9	15	36	Wrap Outside Coils. only
H2	2	54	8	9	15	36	See Note 4
H3	2	48	7	9	21	36	See Note 5
H4	2	48	7	9	18	36	See Note 5

- Notes:
1. Complete all specified dowel bar modifications and concrete repairs at least 3 days before wrapping any member.
 2. See detail 1/SII for column wrap U.L.D.
 3. See detail 2/SII for tie beam wrap U.L.D.
 4. See detail 5/SII for column wrap.
 5. See detail 2/SII for modifications to the tie beam wrap.
 6. Existing dead conduit along face of column interferes with installation of column wrap. Remove conduit (approximate length of 30"). Removal cast shall be incidental to column wrap installation.
 7. Existing live conduit along face of column interferes with installation of column wrap. Conduit shall be rerouted over the length of the wrap by a qualified electrician such that column wrap may be installed (approximate length of 6'-2"). Note that electrical service may only be interrupted between the hours of 8:00 AM and 4:00 PM. Relocation cost shall be incidental to column wrap installation.

Concrete grinding cast, if required to provide uniform & bearing, shall be completed WITH FURNISH - EPOXY STRUCTURAL STEEL.

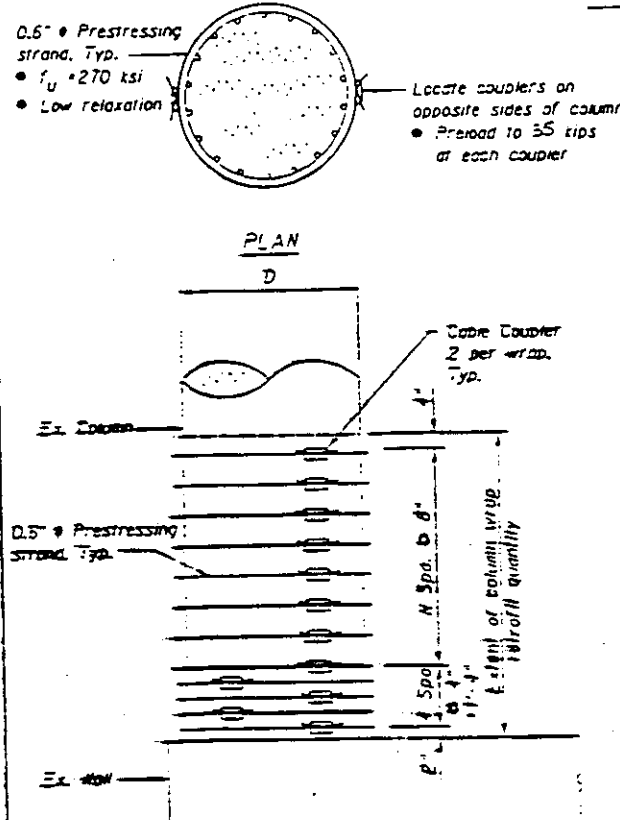


1 ELEVATION - TYPICAL COLUMN WRAP

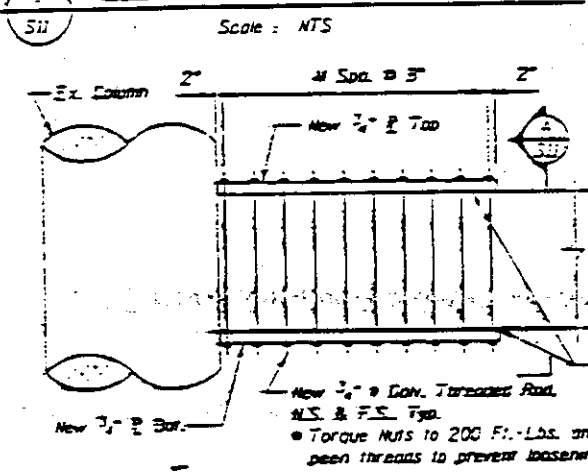

- Notes:
1. See table for dimensions not shown and additional notes.
 2. Wrap each end as shown.

2 ELEVATION - TYPICAL TIE BEAM WRAP

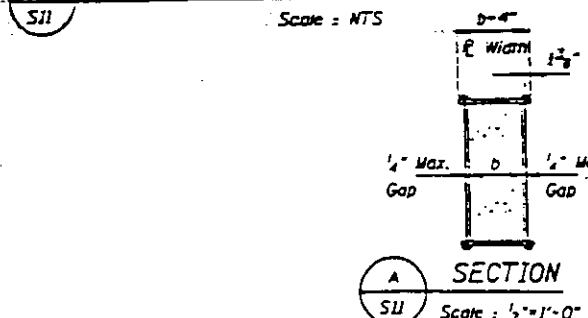


A SECTION Scale: 1/2"=1'-0"

PROJECT NO.	DATE	SCALE	SHEET NO.	TOTAL SHEETS
FAJ 70	ST. CLAIR	1/4" = 1'-0"	70	53

TABLE OF SLAB/FLOOR BEAM CONNECTION


Pier No.	No. of Units	N Per Unit	M Per Unit	Ref. Detail	Comments
D2	2	9	5	3/S-II	
D3	1	5	3	3/S-II	
D4	2	8	5	3/S-II	
D6	2	8	5	3/S-II	
D7	2	5	3	3/S-II	
D9	2	7	4	3/S-II	
D10	2	7	4	3/S-II	
D11	1	7	4	4/S-II	See Note 1
D13	2	8	5	3/S-II	
D14	1	8	5	3/S-II	
D16	1	9	5	3/S-II	
D17	2	7	4	3/S-II	
D19	2	9	5	3/S-II	
D20	1	10	6	3/S-II	
D22	1	7	4	4/S-II	See Note 2
D23	4	7	4	3/S-II	
D24	4	7	4	3/S-II	
D25	2	8	5	3/S-II	
H3	2	8	5	3/S-II	
H4	2	10	6	3/S-II	

- Notes:
1. West side expansion joint only.
 2. East side expansion joint only.

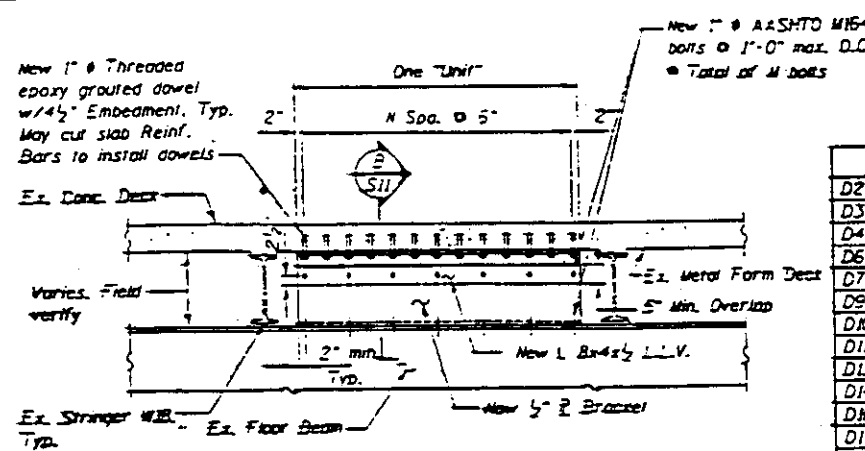


- Notes:
1. See table for number of 'units' per pier.
 2. See table for N.

3 ELEVATION - SLAB FLOOR BEAM CONNECTION

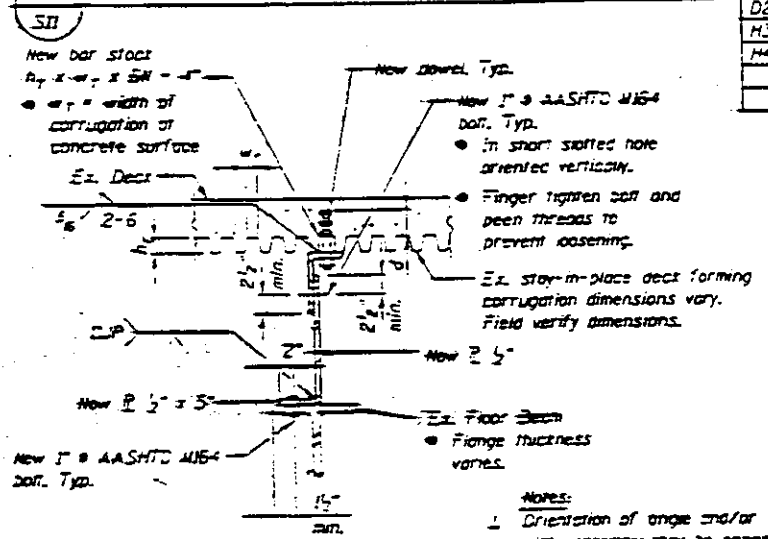


- Notes:
1. Orientation of angle and/or plate assembly may be opposite here to that shown.
 2. Epoxy grouted dowel embedment length (ld) shall be measured from the embedded end of the dowel to the bottom of the corrugation - excludes the fillet.

B SECTION

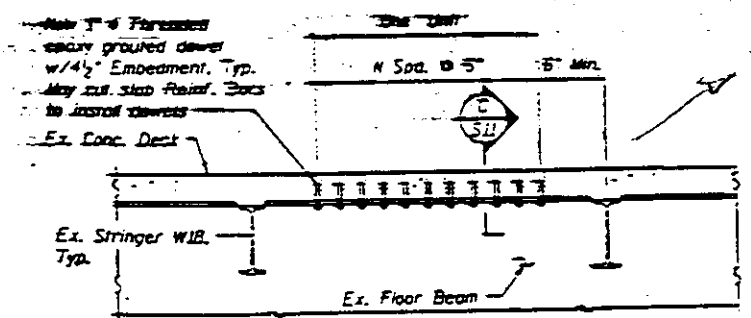

- Notes:
1. See table for number of 'units' per pier.
 2. See table for N.

4 ELEVATION - SLAB FLOOR BEAM CONNECTION

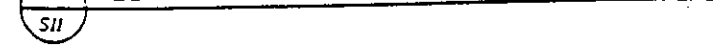

C SECTION


Per Howard Hill on 6/24/2005: These dowels can be placed in adjacent bays or on the opposite side of the stringer. Interference w/ finger R stools at D-22.

SEISMIC RETROFIT DETAILS
 STATE OF ILLINOIS
 DEPARTMENT OF TRANSPORTATION
 SEISMIC AND REDUNDANCY RETROFIT REPAIRS
 FAJ ROUTE 70
 POPLAR STREET BRIDGE APPROACHES
 ST. CLAIR COUNTY
 STRUCTURE NO. D22-02-04 BRIDGEWAY @ STRUCTURE NO. D22-02-03 BRAMP P1
 STRUCTURE NO. D22-02-05 BRIDGEWAY @ STRUCTURE NO. D22-02-02 BRAMP P2
 SCALE: AS NOTED
 DATE: 1-23-98
 DRAWN BY: [Signature]
 CHECKED BY: [Signature]

FOUNDATION WALL DOWEL MODIFICATION TABLE


Pier	Modifications per pier	Ref. Detail	No. of bars cut per modification	Comments
D4	2	1/S12	2	
D5	2	1/S12	8	
D6	2	1/S12	4	
D8	2	1/S12	8	
D9	2	1/S12	6	
D13	2	1/S12	5	
D15	2	1/S12	8	
D17	2	3/S12	6	
D18	2	1/S12	8	
D19	2	1/S12	4	
D24	2	1/S12	6	
D25	2	2/S12	6	
D26	2	1/S12	4	See Note 7
P14	2	1/S12	2	See Note 8
H1	2	2/S12	10	
H4	2	1/S12	4	

- Notes:
- Cut number of foundation dowel bars indicated. To determine which bars to cut, see reference detail and cut bars starting with number 1 and finishing with the number shown in the table.
Example: Pier D6 cut dowel bars 1, 2, 3, and 4 as labeled in detail 1/S12.
 - The contractor shall positively discern between column longitudinal reinforcing bars and foundation wall dowel bars prior to cutting any bars.
 - Dowel bars to be cut must be cut within 2" of top of foundation wall. Corresponding column bars may also be cut at the same location.
 - Concrete removal areas shall be limited to 1'-6" in height and shall be no deeper than 1/2" clear inside the vertical bars.
 - Concrete removal and repair costs shall be incidental to the foundation wall dowel modification. All unsound concrete caused by bar cutting shall be removed prior to concrete repair. See sheet S-25 for concrete removal and repair details.
 - Excavation required to perform foundation wall dowel modifications. See sheet S-28 for additional information.
 - Modify details for north column only.

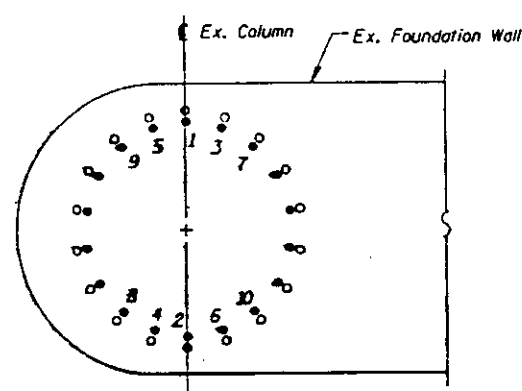


● Foundation Wall dowel bar (#10 or #11 bar)
○ Outline of column bar

1 SECTION - FOUNDATION WALL DOWELS
S12 (18 Bar Layout)

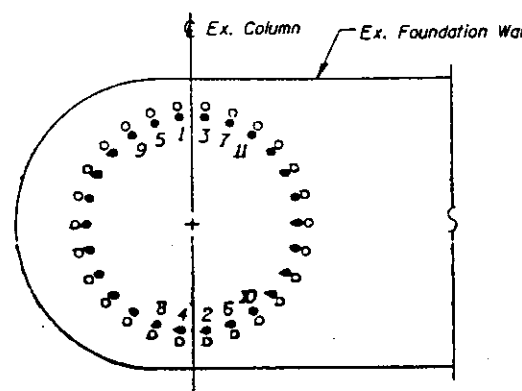


● Foundation Wall dowel bar (#11 bar)
○ Outline of column bar

4 SECTION - FOUNDATION WALL DOWELS
S12 (26 Bar Layout)

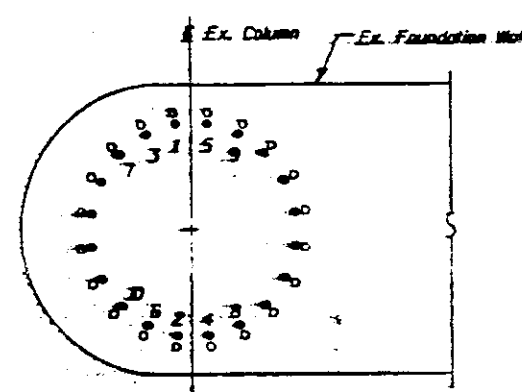


● Foundation Wall dowel bar (#10 or #11 bar)
○ Outline of column bar

2 SECTION - FOUNDATION WALL DOWELS
S12 (20 Bar Layout)

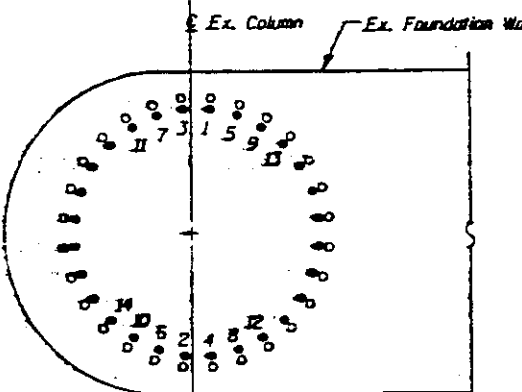


● Foundation Wall dowel bar (#11 bar)
○ Outline of column bar

5 SECTION - FOUNDATION WALL DOWELS
S12 (28 Bar Layout)

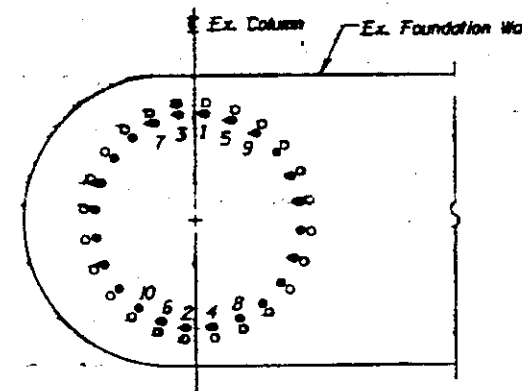


● Foundation Wall dowel bar (#11 bar)
○ Outline of column bar

3 SECTION - FOUNDATION WALL DOWELS
S12 (24 Bar Layout)

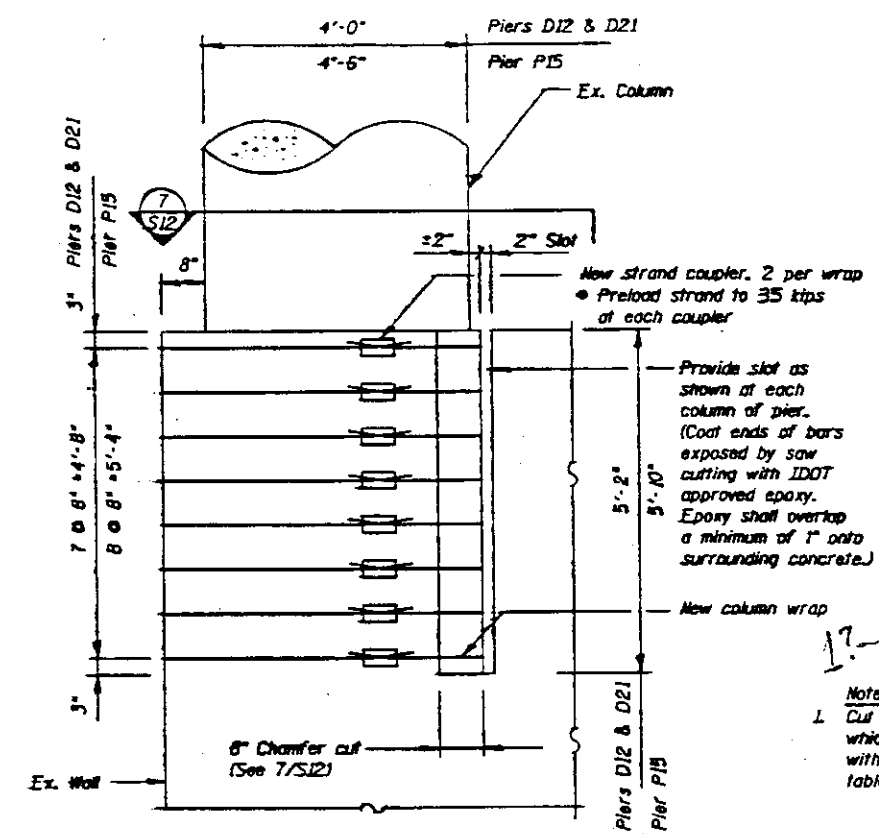

6 ELEVATION - PIERS D12, D21 & P15
S12

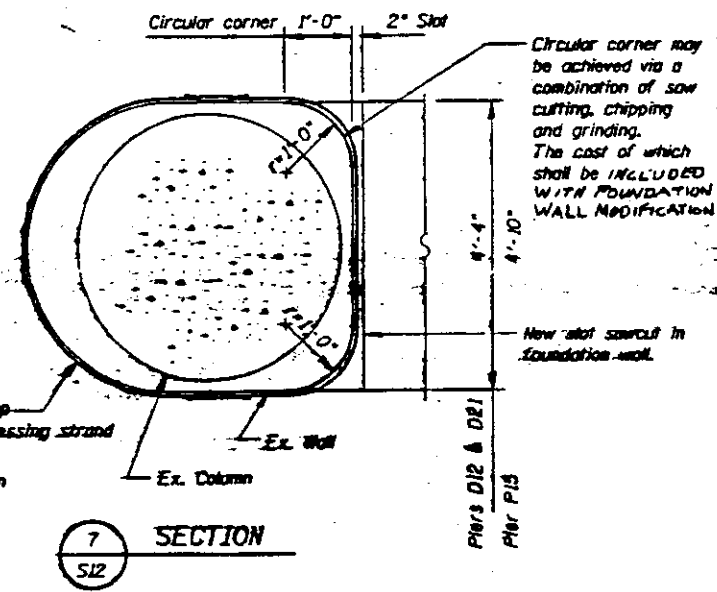


7 SECTION
S12



SEISMIC RETROFIT DETAILS

STATE OF ILLINOIS
DEPARTMENT OF TRANSPORTATION
SEISMIC AND REDUNDANCY RETROFIT REPAIRS
FAI ROUTE 70
POPLAR STREET BRIDGE APPROACHES
ST. CLAIR COUNTY

STRUCTURE NO. 082-0144 (ROADWAY) D1 STRUCTURE NO. 082-0203 (RAMP) P1
STRUCTURE NO. 082-0255 (ROADWAY) H1 STRUCTURE NO. 082-0256 (RAMP) D1
SCALE: NONE DRAWN BY: JH
DATE: 1-23-98 CHECKED BY: JH



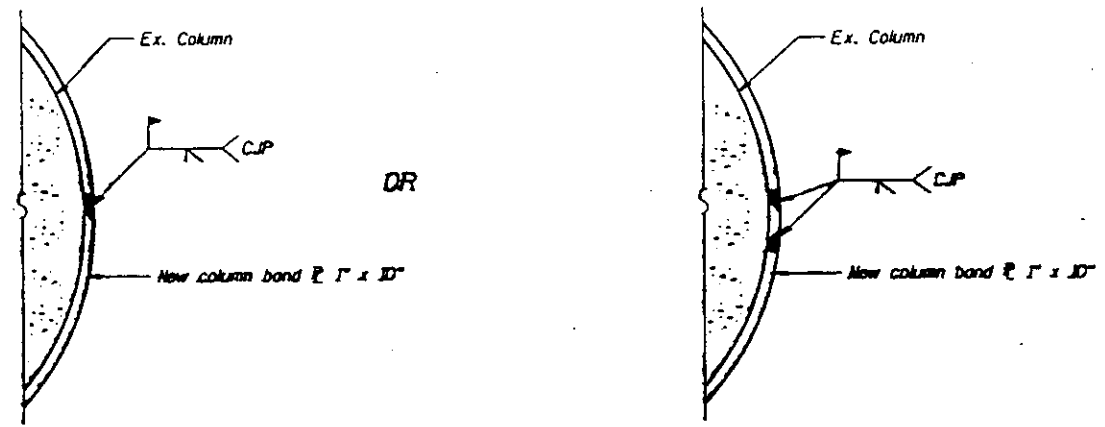


1 COLUMN BAND CONNECTION OPTIONS
S13

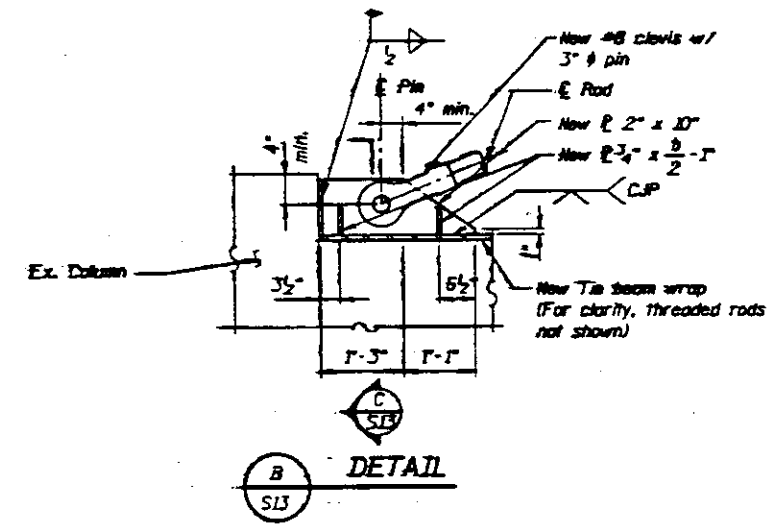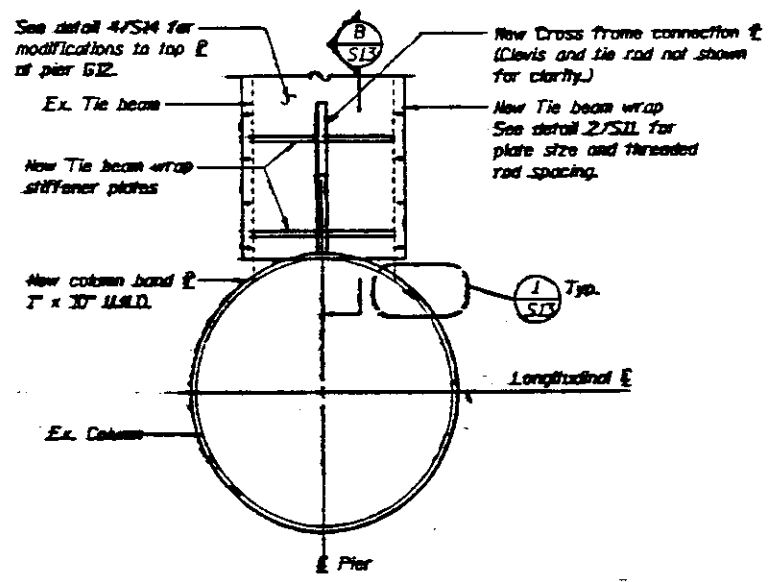

DETAIL
S13

2 CROSS FRAME COLUMN BAND DETAIL
S13

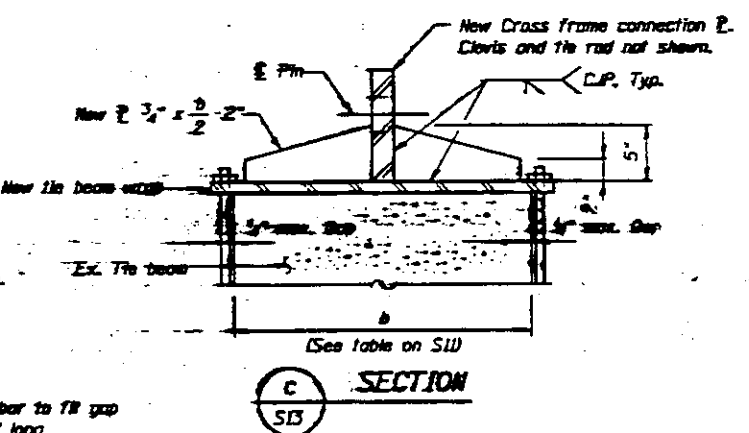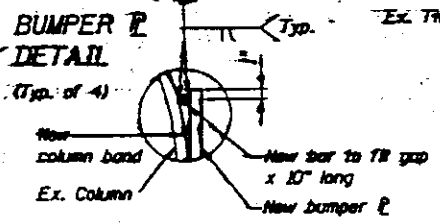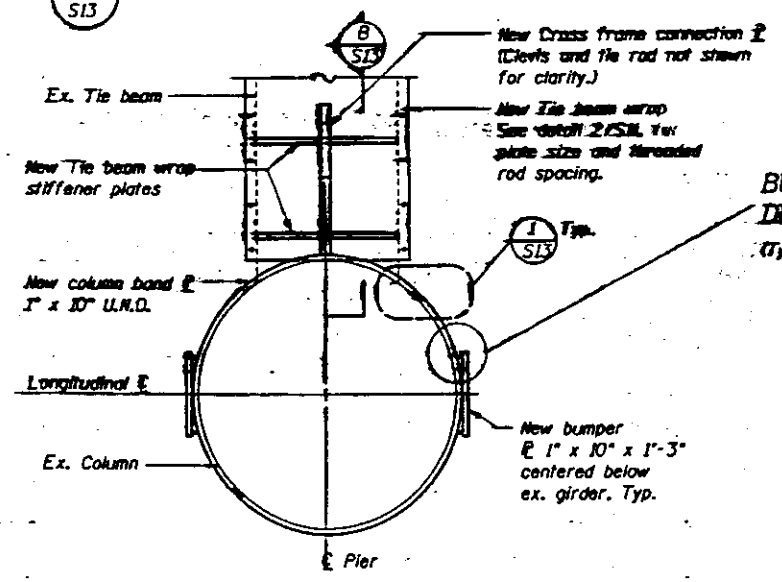

SECTION
S13

3 COLUMN BAND DETAIL AT PIERS WITH BUMPERS & CROSS FRAMES
S13


- Notes:
1. Ex. Column wraps at the top of the columns shall be removed prior to the installation of the new column bands. Removal of EX WRAPS SHALL BE INCLUDED WITH #1.
 2. Impact spray between the column band and concrete column shall be applied uniformly along all the band. This cost shall be INCLUDED WITH #1 FURNISH & ERECT STRUCTURAL STEEL.
 3. Prior to shop painting, mask off area of column band and cross frame connection plate interface. Field touch-up of paint shall be INCLUDED WITH #1 FURNISH & ERECT STRUCTURAL STEEL.
- #1 FURNISH & ERECT STRUCTURAL STEEL.

SEISMIC RETROFIT DETAILS


STATE OF ILLINOIS
DEPARTMENT OF TRANSPORTATION
SEISMIC AND REDUNDANCY RETROFIT REPAIRS
FAI ROUTE TO
POPLAR STREET BRIDGE APPROACHES
ST. CLAIR COUNTY

STRUCTURE NO. 082-0144 BROADWAY IN	STRUCTURE NO. 082-0203 RAMP P1
STRUCTURE NO. 082-0256 BROADWAY IN	STRUCTURE NO. 082-0255 RAMP ON
SCALE: NONE	DRAWN BY: JH
DATE: 1-23-98	CHECKED BY: MH


PROJECT NO.	DISTRICT	COUNTY	TOTAL SHEETS	SHEET NO.	SHEETS
F.A.L. 78		ST. CLAIR	91	96	
FEDERAL ROAD DIST. NO. 7 ALLIANCE FEDERAL PROPERTY © 82-348-20-1-1					

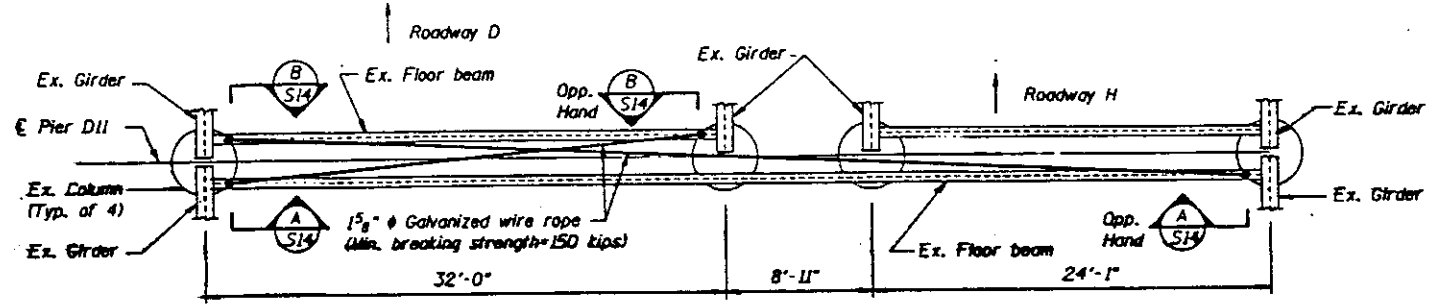


1 SHEAR TRANSFER ASSEMBLY AT PIER D11
S14

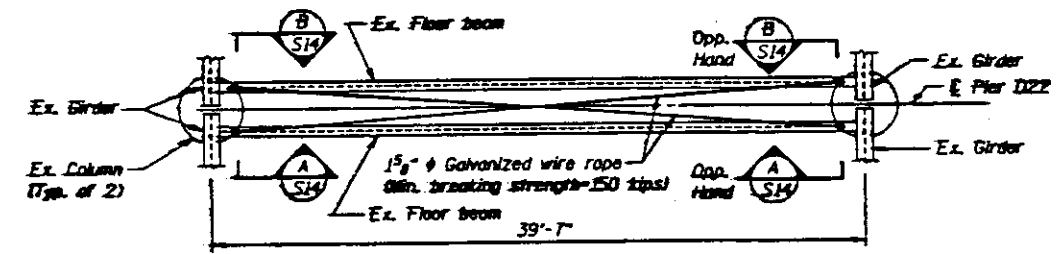

2 SHEAR TRANSFER ASSEMBLY AT PIER D22
S14

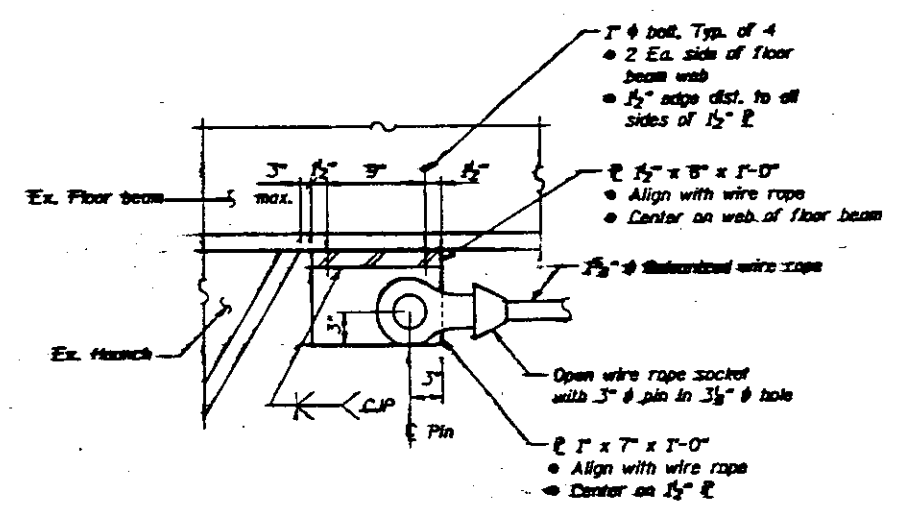

A SECTION
S14

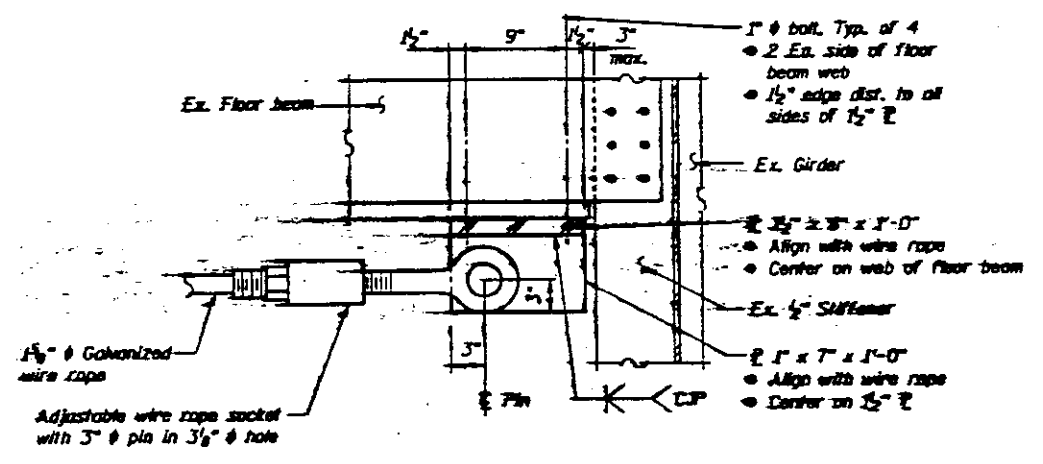

B SECTION
S14

SEISMIC RETROFIT DETAILS


STATE OF ILLINOIS
DEPARTMENT OF TRANSPORTATION
SEISMIC AND REDUNDANCY RETROFIT REPAIRS
FAI ROUTE 70
POPLAR STREET BRIDGE APPROACHES
ST. CLAIR COUNTY

STRUCTURE NO. 082-0144 BROADWAY D3 STRUCTURE NO. 082-0203 GRAMP P1
STRUCTURE NO. 082-0256 BROADWAY 48 STRUCTURE NO. 082-0255 GRAMP D3


SCALE: 1/2"=1'-0"
DATE: AS NOTED CHECKED BY: [Signature]

ROUTE NO.	SECTION	COUNTY	TOTAL SHEETS	SHEET NO.
F.A.I. 78	0	ST. CLAIR	74	58
FUEL ROAD DIST. NO. 7				
ALL DIMS. PER PLAN AND PROFILE				


SHEET NO. S-16
SHEETS

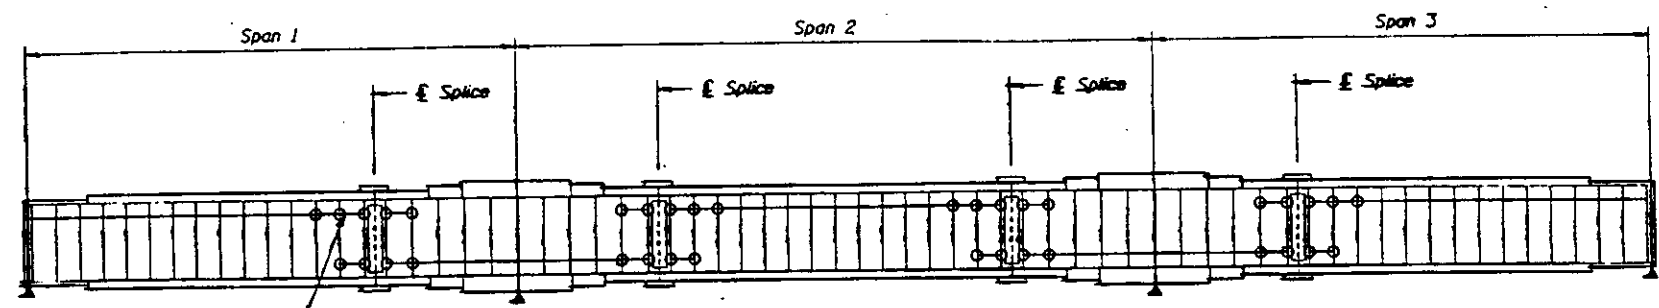

1 GIRDER ELEVATION INDICATING TYPICAL FRACTURE CONTROL MODIFICATION LOCATIONS
S16

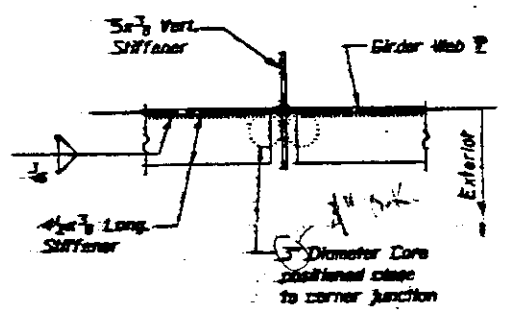

2 STIFFENER INTERSECTION MODIFICATION DETAIL
S16

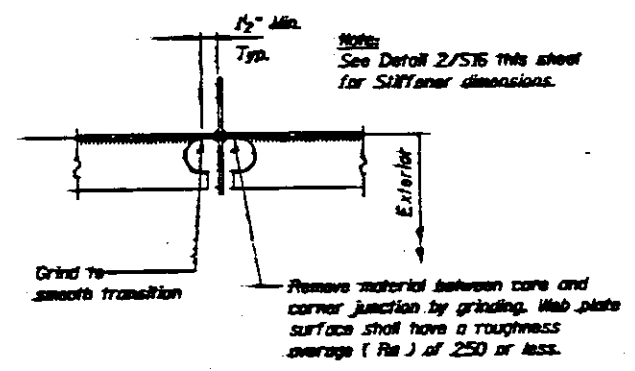

3 STIFFENER INTERSECTION MODIFICATION DETAIL
S16

Procedure :

1. Core 3" diameter holes positioned close to corner junction through 3/4" thick longitudinal stiffener as shown in detail 2/S16.
2. Remove material between core and intersection junction by grinding with carbide tools and a dye grinder as shown in detail 3/S16. Web plate surface shall have a roughness average (Ra) of 250 or less.
3. Remove all burrs from cut edge and check for irregularities. Cored surface shall have an Ra equal to 500 or less.
4. After test removal the modification shall be inspected using magnetic particle (MT) methods. Notify Engineer if a crack is detected. (not incidental to stiffener intersection modification).
5. The exposed steel surfaces shall be cleaned and painted using an aluminum epoxy mastic primer.
6. Obtain approval of Engineer before proceeding.
7. Paint area with top coat.



BILL OF MATERIAL

ITEM	UNIT	QUANTITY
Stiffener intersection modification	EACH	864


STIFFENER INTERSECTION MODIFICATION DETAIL
STATE OF ILLINOIS
DEPARTMENT OF TRANSPORTATION
SEISMIC AND REDUNDANCY RETROFIT REPAIRS
FAI ROUTE 70
POPLAR STREET BRIDGE APPROACHES
ST. CLAIR COUNTY

STRUCTURE NO. 082-0144 ROADWAY 00 STRUCTURE NO. 082-0203 GRAMP 74
STRUCTURE NO. 082-0205 ROADWAY 00 STRUCTURE NO. 082-0206 GRAMP 20
SCALE: NONE DRAWN BY: JH
DATE: 1-23-98 CHECKED BY: JH

ROUTE NO.	SECTION	COUNTY	TOTAL SHEETS	SHEET NO.	SHEET TITLE
F.A.L. 70	4	ST. CLAIR	91	68	
SHEETS					

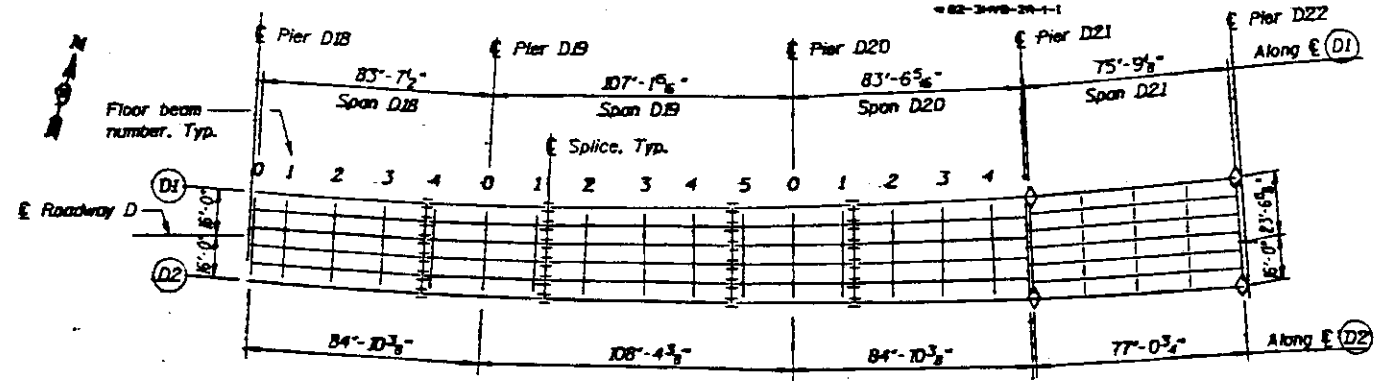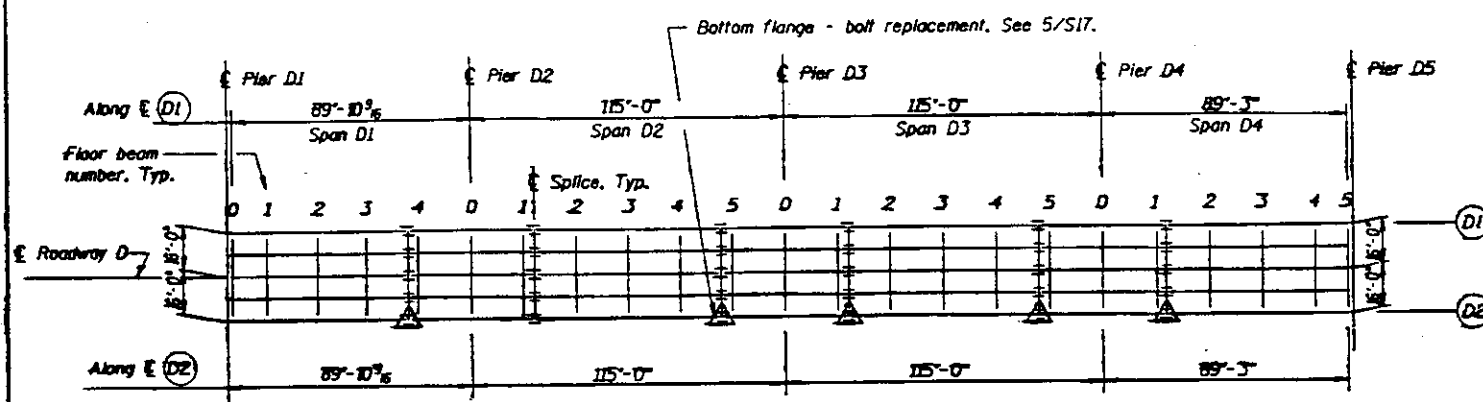


1 SPANS D1 THRU D4 AND D18 THRU D21 (FRAMING PLAN)
S18

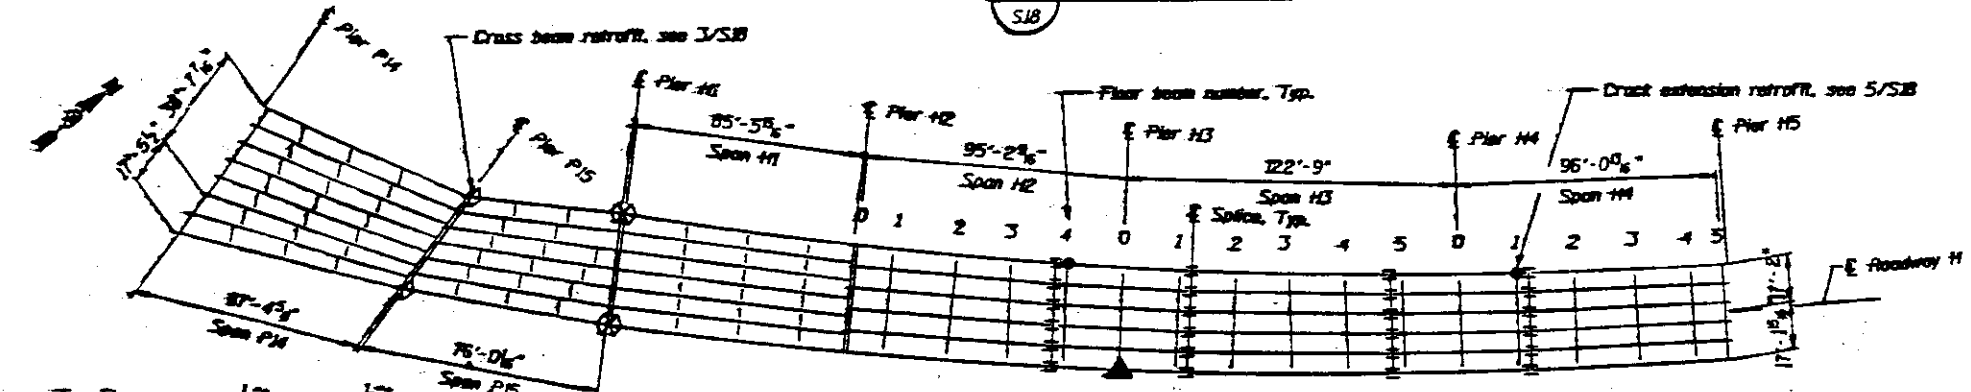


2 SPANS P14 THRU P15 AND H1 THRU H4 (FRAMING PLAN)
S18

LEGEND

- ▲ Bottom flange splice - bolt replacement 15 locations, this sheet. See 5/S17.
- ◇ Cross beam retrofit (10 locations). See 3/S18
- Crack extension retrofit (2 locations, this sheet). See 5/S18
- ▲ Bolt replacement (1 bolt this sheet) See Note 1, sheet S17.

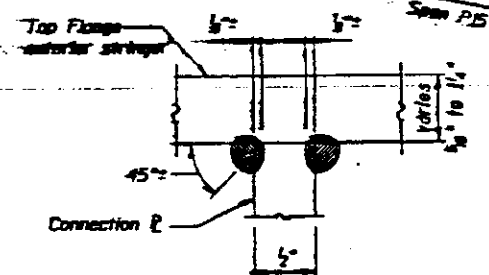

4 WELD DETAIL
S18

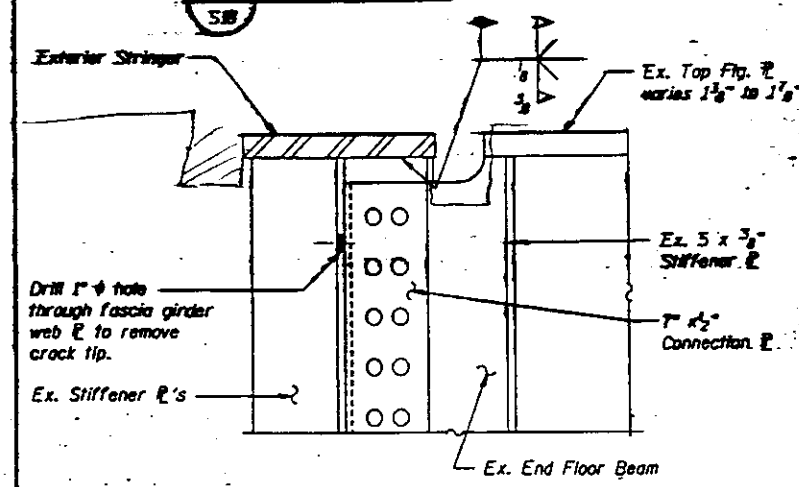


3 CROSS BEAM RETROFIT
S18

Procedure:

1. Inspect floor beam connection region in the vicinity of the top flange for cracking and determine crack tip locations using magnetic particle (MT) inspection methods.
2. Drill 1" diameter hole at end of crack extension to remove crack tip. Re-inspect area using MT methods to verify crack tip removal.
3. Vacuum blast (SSPC SP-10) on area approximately 8" on each side of the connection plate at top flange extension. Area within paint contains lead.
4. Grind ends of connection plate to obtain an approximate 1/8" bevel as shown in Detail 4/S18. Clean weld fit up area to remove contaminants.
5. Eliminate traffic from roadway lane adjacent to connection being welded. Install small groove and fillet welds at connection plate and top flange plate using SMAW low hydrogen E7018 electrodes as shown in Detail 4/S18. Minimum preheat and interpass temperature shall be followed in strict accordance with AWS D1.5-95. Preheat girder flange to a minimum of 150°F prior to any welding. Maintain 150°F as a minimum interpass temperature.
6. After welding is complete, open roadway to traffic.
7. Following cool-down period, the welds shall be visually and MT inspected.
8. Obtain approval of Engineer before proceeding.
9. Clean exposed steel surfaces to remove any contaminants or rusting. Paint surfaces with an aluminum epoxy mastic primer/acrylic paint system.

* COST OF ALL MT TESTING SHALL BE INCIDENTAL TO CROSS BEAM RETROFIT.

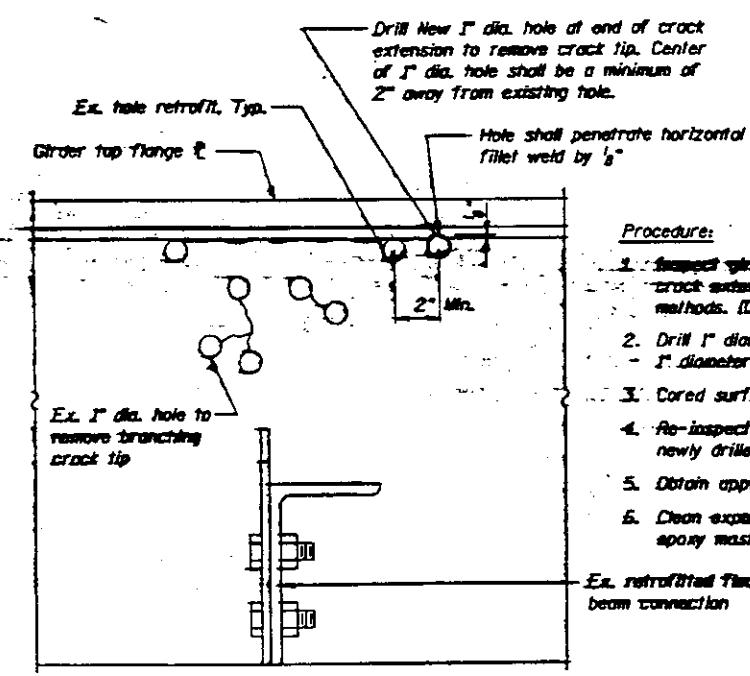

5 CRACK EXTENSION RETROFIT AT FIRST INTERIOR FLOOR BEAMS
S18

BILL OF MATERIAL		
ITEM	UNIT	QUANTITY
Crack extension MODIFICATIONS	EACH	2
Cross beam retrofit	EACH	10


Procedure:

1. Inspect girder web plate in region of existing cracks to determine location of crack extension and crack tip using magnetic particle inspection (MT) methods. (Do not incidental to crack extension MODIFICATIONS at pier)
2. Drill 1" diameter hole at end of crack extension to remove crack tip. Center of 1" diameter hole shall be positioned in accordance with detail 5/S18.
3. Cored surfaces shall have a Roughness Average (Ra) of 500 or less.
4. Re-inspect area using MT methods to verify crack does not extend past the newly drilled holes (Do not INCIDENTAL TO CRACK EXTENSION MODIFICATIONS).
5. Obtain approval of Engineer.
6. Clean exposed steel surface to remove contaminants and paint with an aluminum epoxy mastic primer.


CRACK EXTENSION AND CROSS BEAM RETROFITS

STATE OF ILLINOIS
DEPARTMENT OF TRANSPORTATION
SEISMIC AND REDUNDANCY RETROFIT REPAIRS
FAI ROUTE 70
POPLAR STREET BRIDGE APPROACHES
ST. CLAIR COUNTY


STRUCTURE NO. 082-0144 ROADWAY D1 STRUCTURE NO. 082-0203 GRAMP D1
STRUCTURE NO. 082-0206 APPROACH G1 STRUCTURE NO. 082-0207 APPROACH G2
SCALE: NONE DRAWN BY JH
DATE 1-23-98 CHECKED BY MH

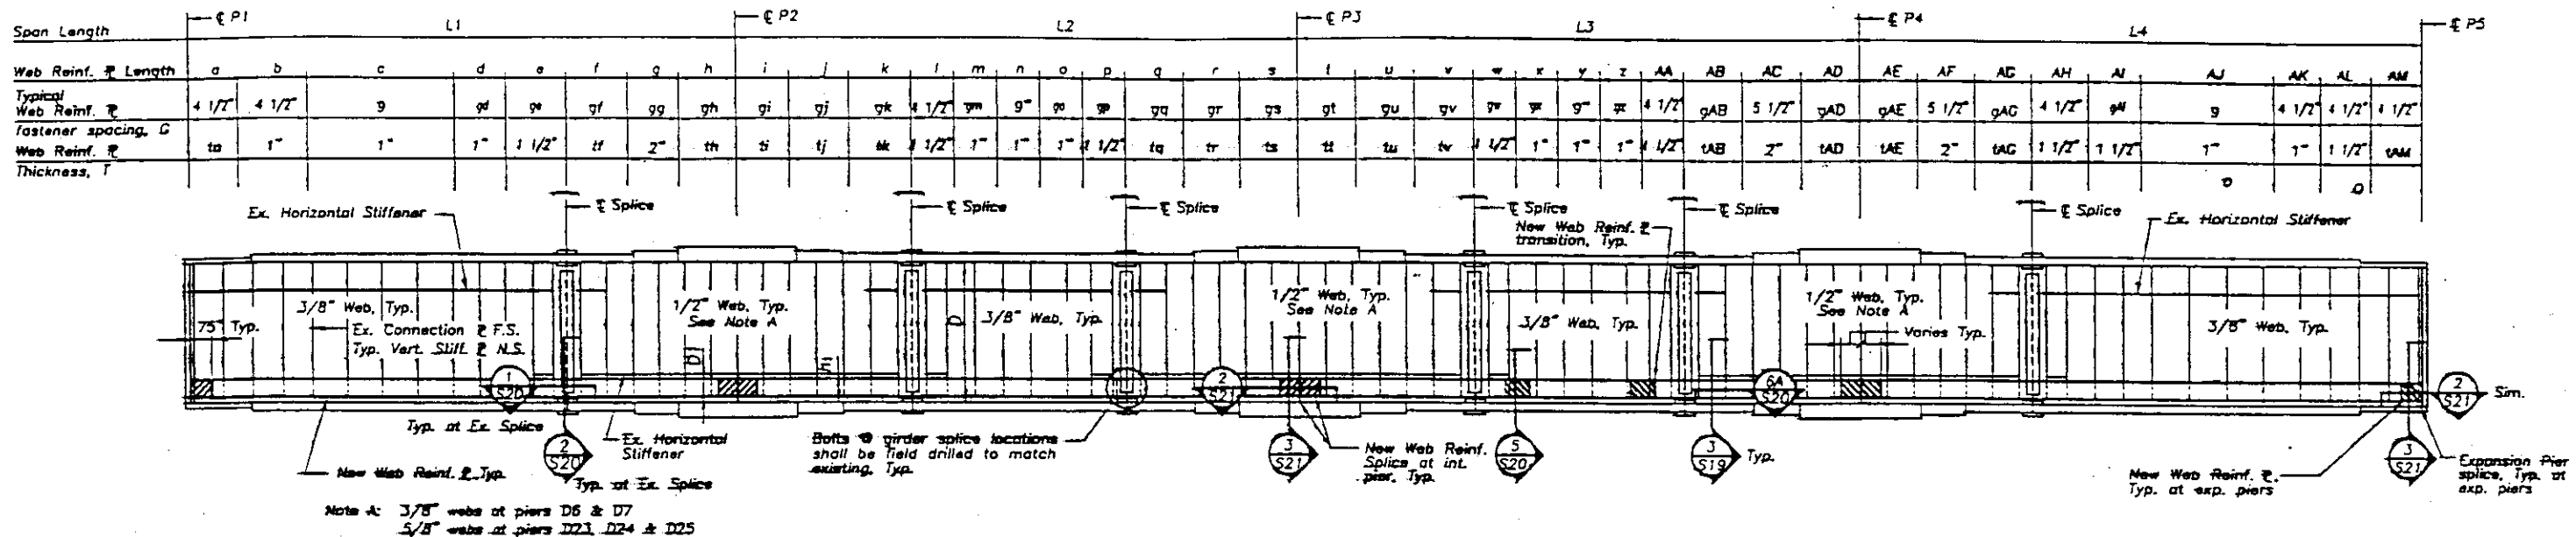

1 GIRDER 2 ELEVATION INDICATING TYPICAL REDUNDANCY RETROFIT LOCATIONS (A)
 (Girder 1 Opposite Hand)
 NOTE: SEE TABLE OF WEB REINFORCEMENT PLATE PARAMETERS SHEET S-19A

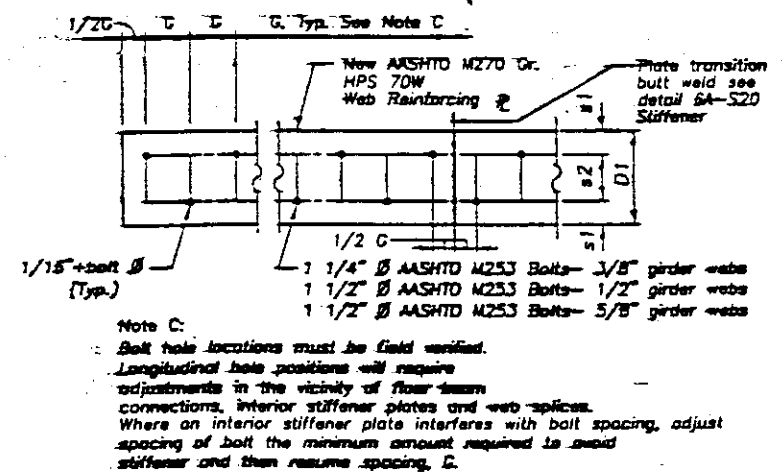

2 WEB REINFORCEMENT PLATE ELEVATION (A)
 S19

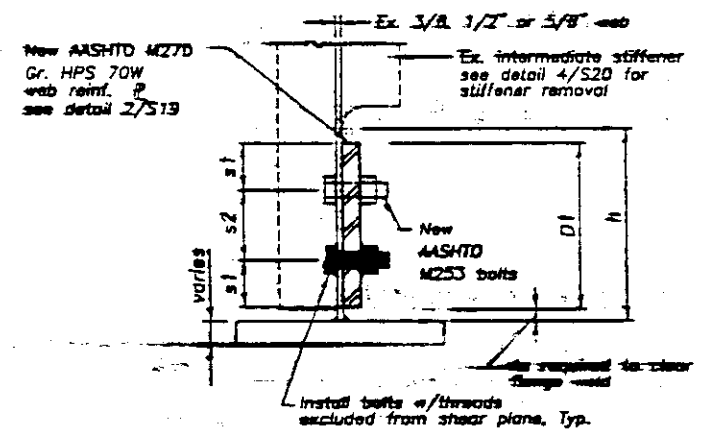

3 TYPICAL WEB REINFORCEMENT PLATE (A)
 S19

Roadway Spans	Web Reinforcement Plate					
	D	D1	s1	s2	h	h1
	in.	in.	in.	in.	in.	in.
D1-D4	84	14	4	6	15	17
D5-D7	84	14	4	6	15	17
D8-D10	84	14	4	6	15	17
D12-D14	72	12	3	6	13	15
D15-D17	72	12	3	6	13	15
D18-D20	84	14	4	6	15	17
D22-D25	84	14	4	6	15	17
H2-H4	84	14	4	6	15	17

BILL OF MATERIAL (A)		
ITEM	UNIT	QUANTITY
Steel girder web reinforcement plate	Lbs.	459,700
Vertical web stiffener removal	EACH	1,226

Bolt Diameter	Girder Web Plate	Total Reinforcement Plate Thickness							
		1	1 1/2	2	2 1/2	3	3 1/2	4	4 1/2
in.	in.	in.	in.	in.	in.	in.	in.	in.	in.
1 1/2	3/8	no	4.50	5.00	5.50	no	no	no	7.50
1 1/2	1/2	3.25	4.25	4.75	5.25	5.75	6.25	6.75	7.50
1 1/4	3/8	3.50	4.00	4.50	5.00	5.50	no	no	no

Note B: including (1) 3/32 rounded corner each end.

REVISIONS	
NAME	DATE
CM	12/21/88


REDUNDANCY RETROFIT DETAILS

STATE OF ILLINOIS
 DEPARTMENT OF TRANSPORTATION
 SEISMIC AND REDUNDANCY RETROFIT REPAIRS
 FAI ROUTE 70
 POPLAR STREET BRIDGE APPROACHES
 ST. CLAIR COUNTY


STRUCTURE NO. 288-0144 (ROADWAY 2) STRUCTURE NO. 288-0205 (RAIL P)
 STRUCTURE NO. 288-0206 (ROADWAY 4) STRUCTURE NO. 288-0207 (RAIL P)

SCALE: NONE
 DATE: 1-23-88
 DRAWN BY: JH
 CHECKED BY: MH


REV. NO.	DATE	BY	CHKD.
1	10/11/98	JH	HH

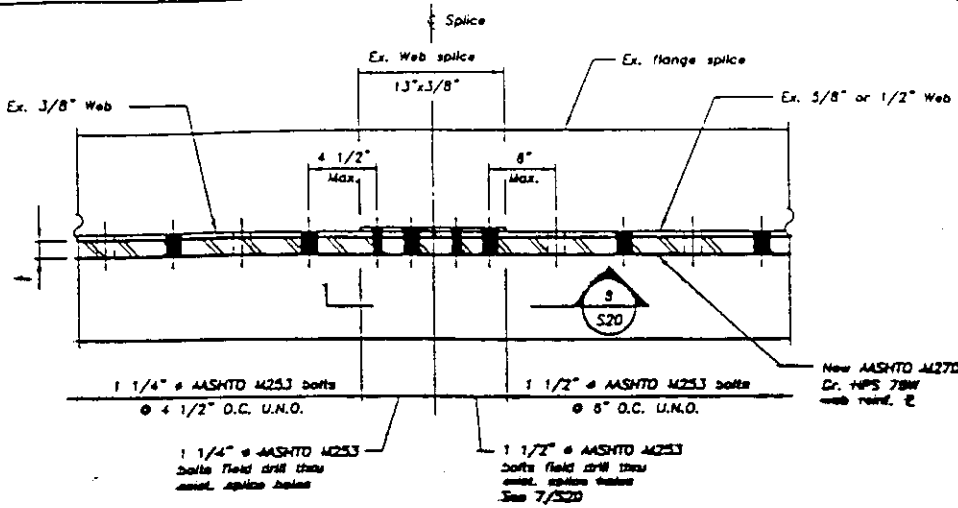


1 WEB REINFORCEMENT PLATE AT GIRDER WEB SPLICE

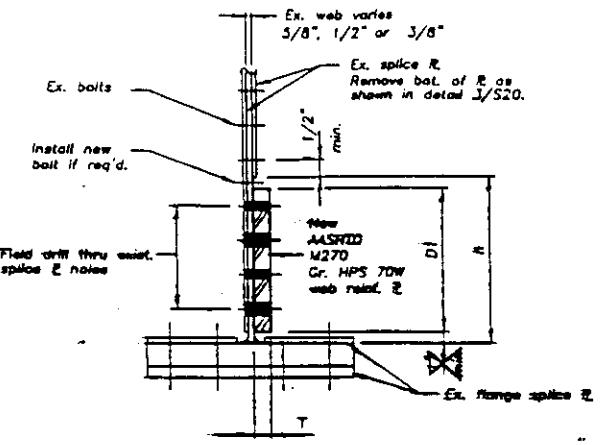

2 WEB REINFORCEMENT PLATE AT GIRDER WEB SPLICE

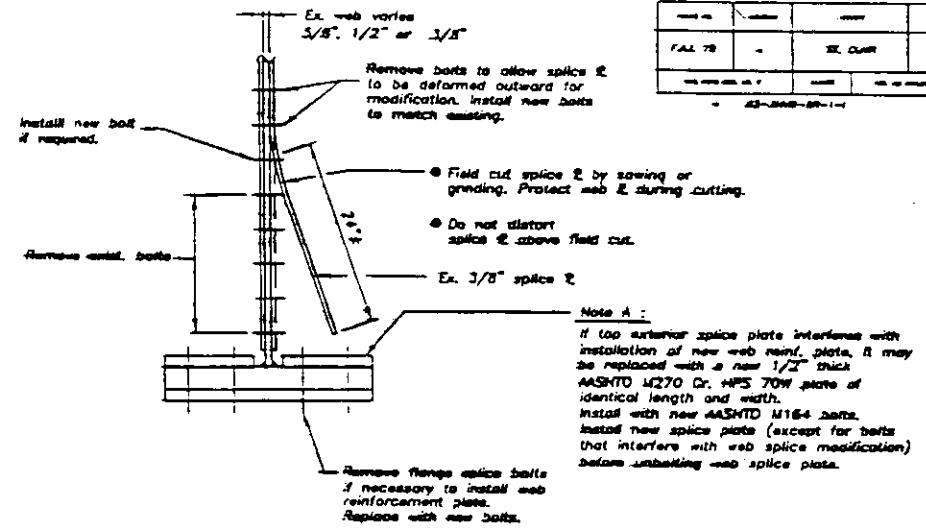


3 GIRDER SPLICE PLATE MODIFICATION

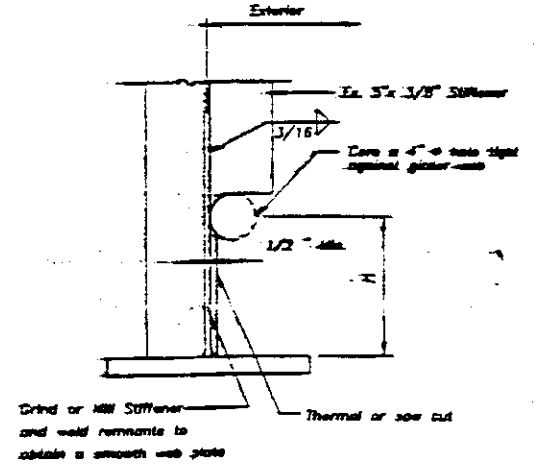


4 VERTICAL STIFFENER MODIFICATION

- Procedure:
1. Care a 4" hole tight against girder web. Do not notch or gouge web plate.
 2. Thermal or saw cut, horizontal cut and vertical cut. Vertical cut shall be positioned at least 1/2" away from girder web. Do not notch or gouge web plate.
 3. Remove all stiffener remnants and connecting welds by grinding or milling. Web plate surface shall have a Roughness Average (Ra) of 250 or less.

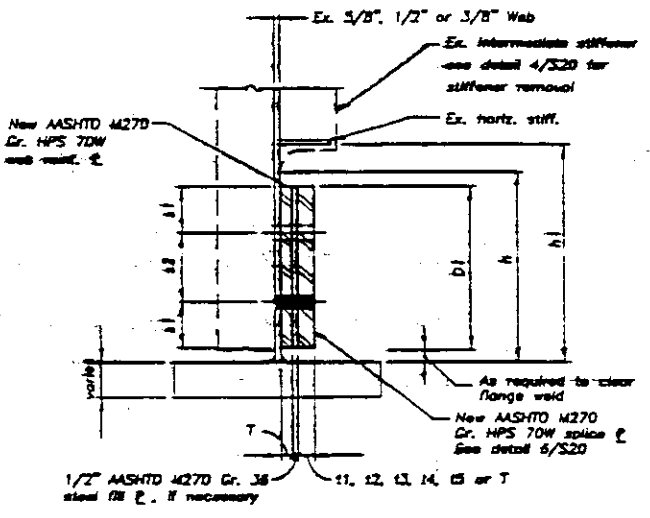


5 TYPICAL WEB REINFORCEMENT PLATE SPLICE

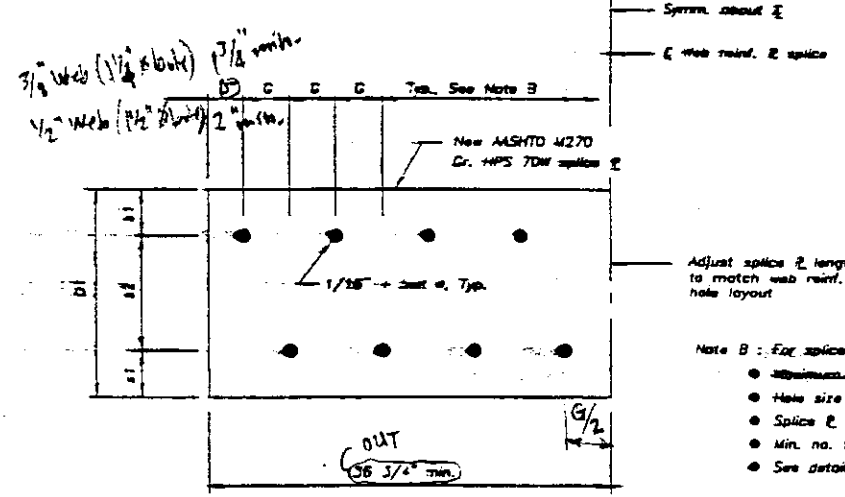


6 TYPICAL WEB REINFORCEMENT SPLICE PLATE


- Note B: For splice locations other than at piers
- Minimum 3 locations per span. For 2 web reinforcement splices.
 - Hole size and spacing to match web reinforcement.
 - Splice thickness to match greater web reinforcement thickness.
 - Min. no. fasteners = 16 @ 4 1/2" spacing; 9 @ 9" spacing.
 - See detail 6A/S20 for butt weld detail at other transitions.

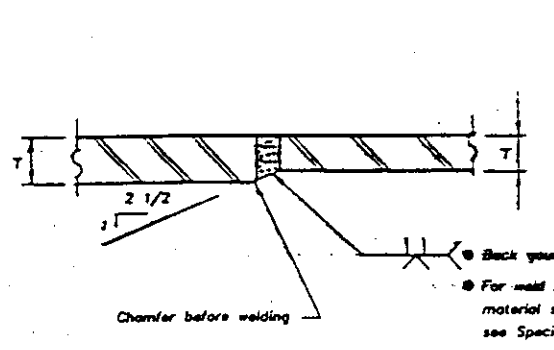

6A BUTT WELD SPLICE AT WEB REINF. PLATE TRANSITIONS

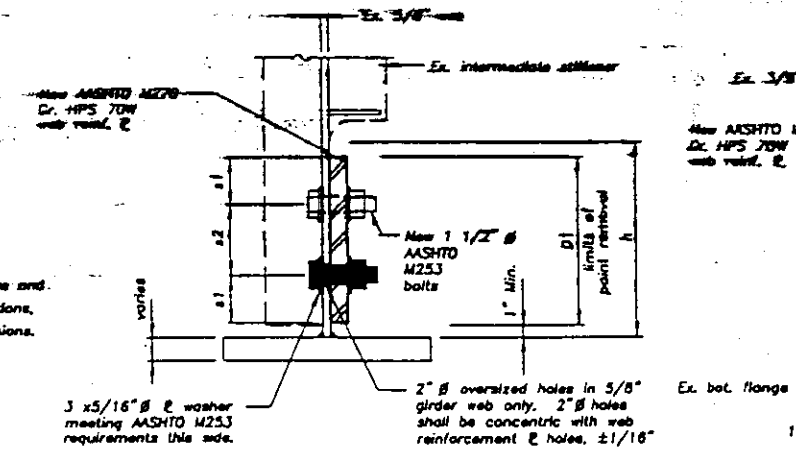

7 WEB REINFORCEMENT PLATE INSTALLATION IN 5/8 IN. GIRDER WEBS

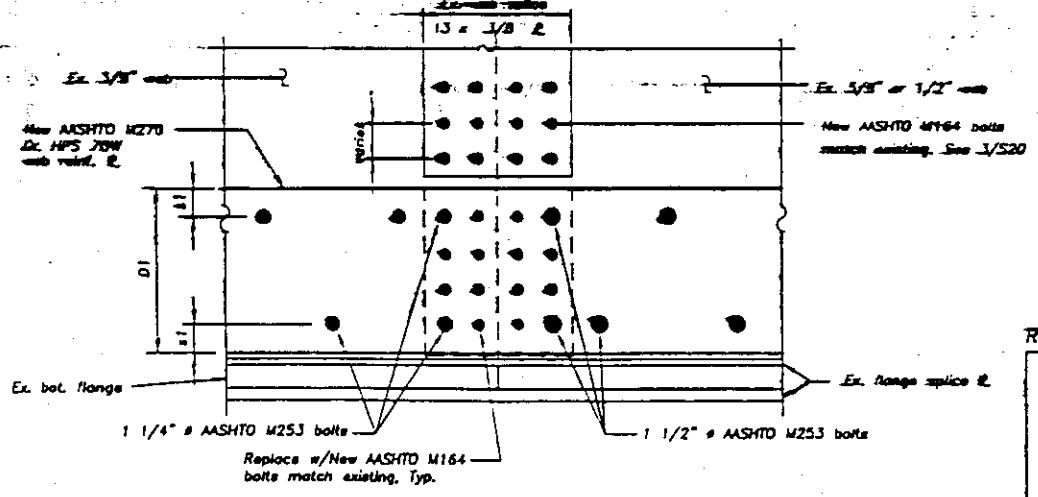

8 ELEVATION AT GIRDER WEB SPLICE

- Notes:
1. See sheet S-19 for dimensions D1, D2, D3, D4, D5.
 2. See sheet S-21 for dimensions T1, T2, T3, T4 and T5.
 3. T = thickness of web reinforcement.
 4. G = spacing of bolts, see sheet S-19A.

REVISIONS	
NO.	DATE
1	10/11/98


REDUNDANCY RETROFIT DETAILS

STATE OF ILLINOIS
DEPARTMENT OF TRANSPORTATION
SEISMIC AND REDUNDANCY RETROFIT REPAIRS
FAI ROUTE 70
POPLAR STREET BRIDGE APPROACHES
ST. CLAIR COUNTY

STRUCTURE NO. 082-0146 (ROADWAY) STRUCTURE NO. 082-0203 (RAIL) P
STRUCTURE NO. 082-0256 (ROADWAY) STRUCTURE NO. 082-0203 (RAIL) P


SCALE: NONE
DATE: 1-23-08
DRAWN BY: JH
CHECKED BY: HH

STRUCTURE 0742 15121815.20 bch

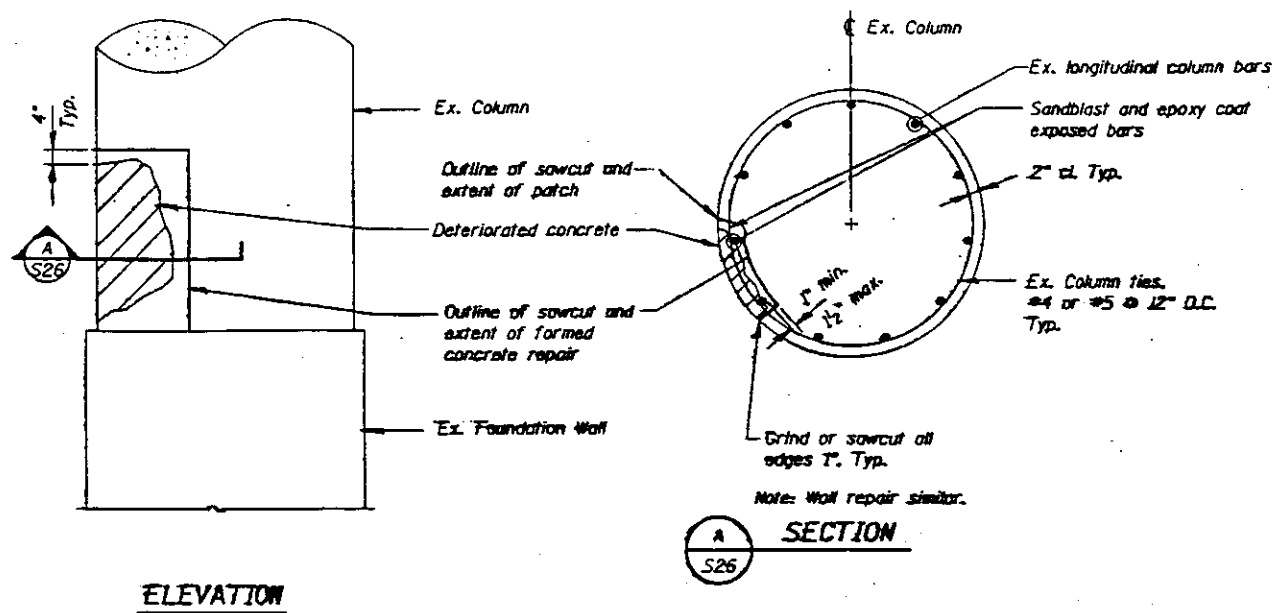


ELEVATION

1 TYPICAL CONCRETE COLUMN REPAIR
S26

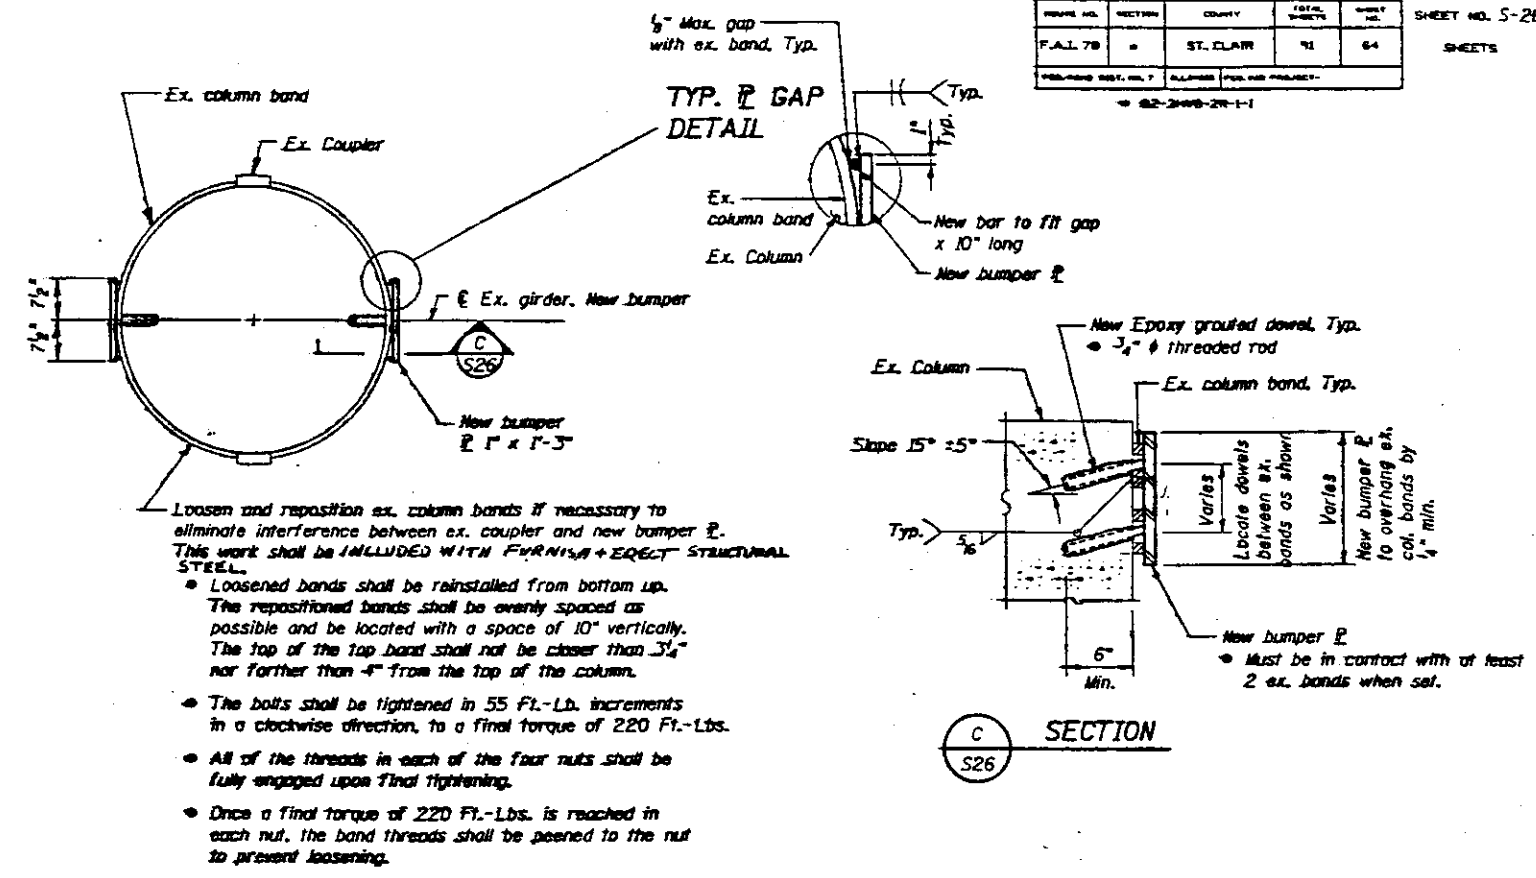


3 BUMPER PLATE DETAIL
S26

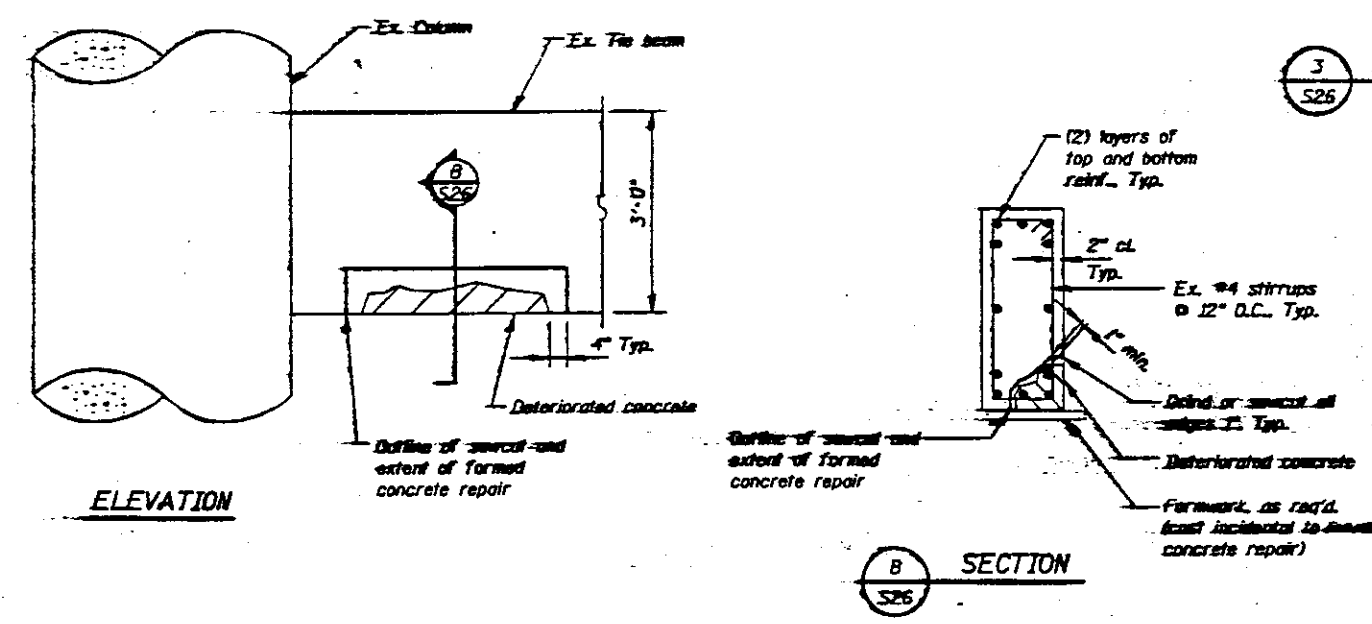


ELEVATION

2 TYPICAL CONCRETE TIE BEAM REPAIR
S26

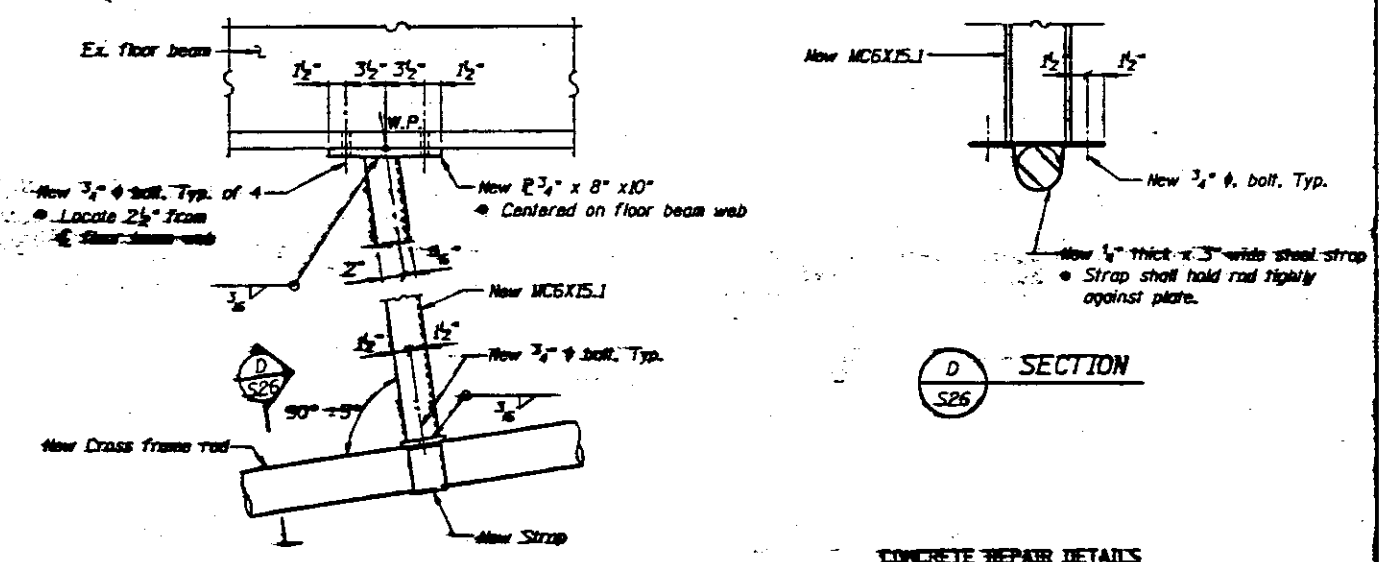

4 TIE ROD SUPPORT DETAIL
S26

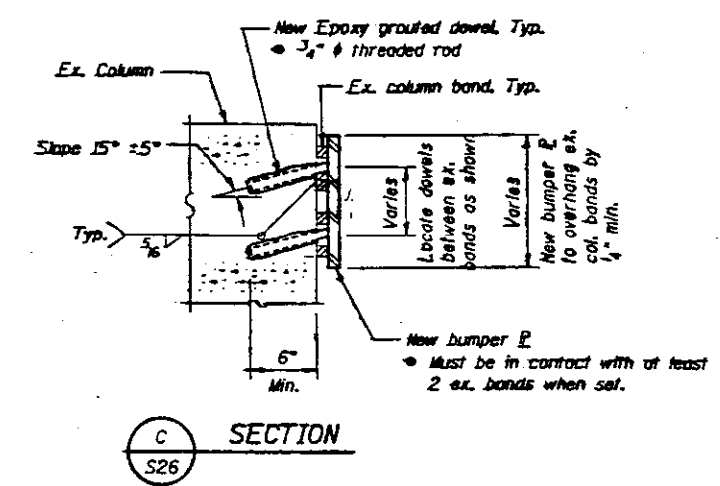

C SECTION
S26

CONCRETE REPAIR DETAILS

STATE OF ILLINOIS
DEPARTMENT OF TRANSPORTATION
SEISMIC AND REDUNDANCY RETROFIT REPAIRS
FAT ROUTE TO
POPLAR STREET BRIDGE APPROACHES
ST. CLAIR COUNTY

STRUCTURE NO. 082-0944 (ROADWAY) OR STRUCTURE NO. 082-0203 (RAMP #1)
STRUCTURE NO. 082-0204 (RAMP #2) OR STRUCTURE NO. 082-0205 (RAMP #3)
SCALE: NONE
DATE: 1-23-98
CHECKED BY: JH

PROJECT NO.	DATE	GROUP	SCALE	SHEET NO.
F.A.L. 70	0	ST. CLAIR	70	65
SHEET NO. 5-27				

SHEET NO. 5-27

SHEETS

© 1998-2000-2011-1

EXPANSION JOINT, BUMPER, PIN AND TIE ROD GAPS

Pier	East Side	West Side
D5	0.60"	1.05"
D8	0.95"	0.95"
D11	0.35"	0.65"
D12	0.55"	N/A
D15	0.95"	1.00"
D18	0.70"	0.60"
D21	N/A	0.95"
D22	1.75"	0.40"
D26	0.65"	1.20"
P14	N/A	0.60"
P15	N/A	0.45"
H1	N/A	0.35"
H2	1.10"	0.45"

Notes:

1. Gaps defined as follows:

- **Bumper Gap:** Minimum clear distance between bumper and bumper plate.
- **Pin Gap:** Minimum clear distance between clevis pin and edge of plate in direction of rod.
- **Tie Rod Gap:** Clear distance between washer and end plate of bracket.

2. Gap dimensions shown were based upon roadway deck temperature of 50° F. If the roadway deck temperature (measured at mid-depth of concrete deck within 4 hours of installation) is greater than 50° F, decrease bumper gaps, and increase pin and tie rod gaps by the following amount:

$$\text{Gap change} = \left(\frac{\text{Actual Deck Temperature} - 50^\circ \text{ F}}{70} \right) \times \text{Gap shown}$$

If roadway deck temperature is less than 50° F, increase bumper gaps, and decrease pin and tie rod gaps by the following amount:


$$\text{Gap change} = \left(\frac{50^\circ \text{ F} - \text{Actual Deck Temperature}}{70} \right) \times \text{Gap shown}$$

SEISMIC RETROFIT DETAILS


STATE OF ILLINOIS
DEPARTMENT OF TRANSPORTATION
SEISMIC AND REDUNDANCY RETROFIT REPAIRS
FAI ROUTE 70
POPLAR STREET BRIDGE APPROACHES
ST. CLAIR COUNTY

STRUCTURE NO. 002-0044-ROADWAY D1 STRUCTURE NO. 002-0203 BRAMP P1
STRUCTURE NO. 002-0005-ROADWAY J2 STRUCTURE NO. 002-0202 BRAMP J2
SCALE: NONE DRAWN BY JH
DATE: 1-23-98 CHECKED BY WH

02-34VB-2R-1-1

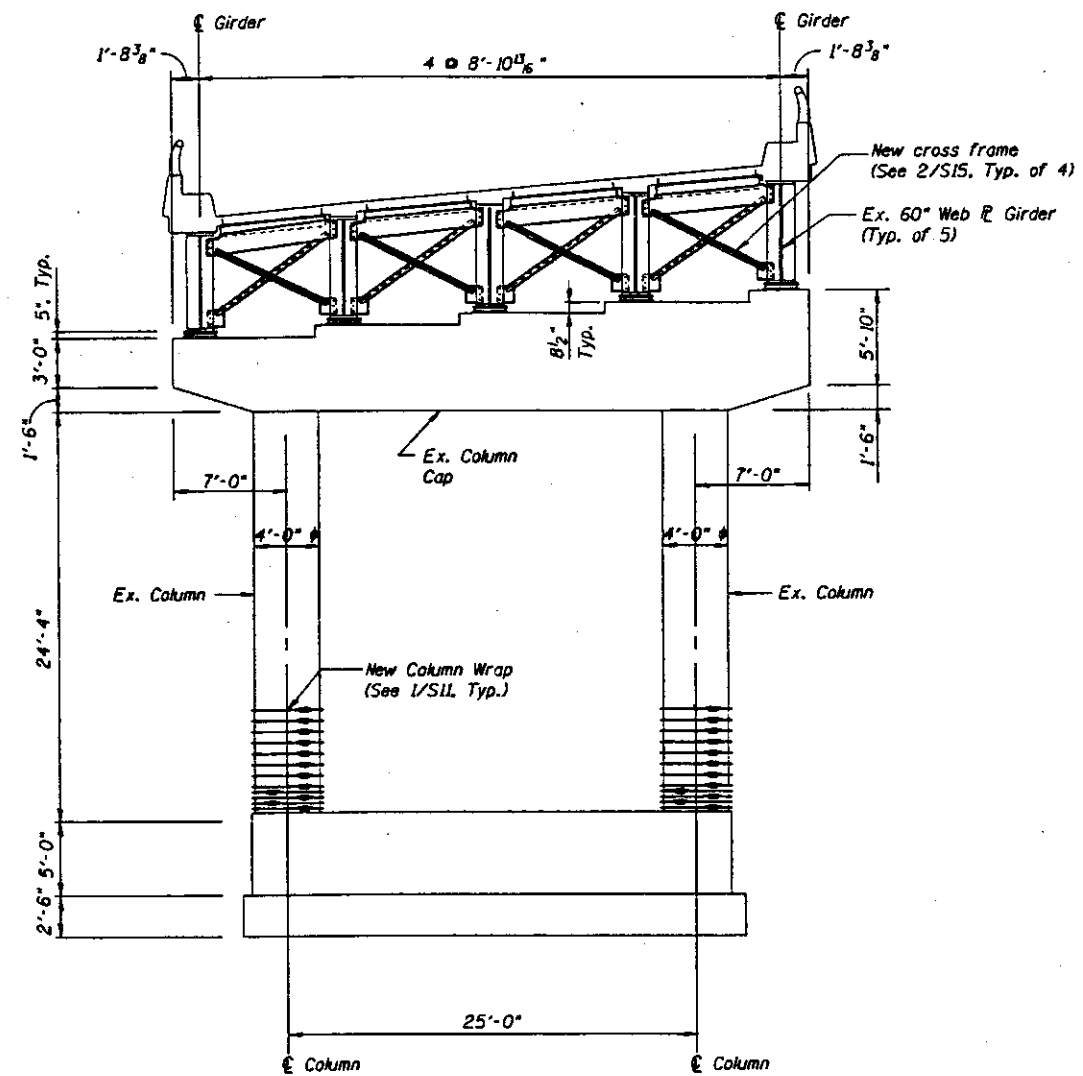

1 ELEVATION PIER Q1-1
S38

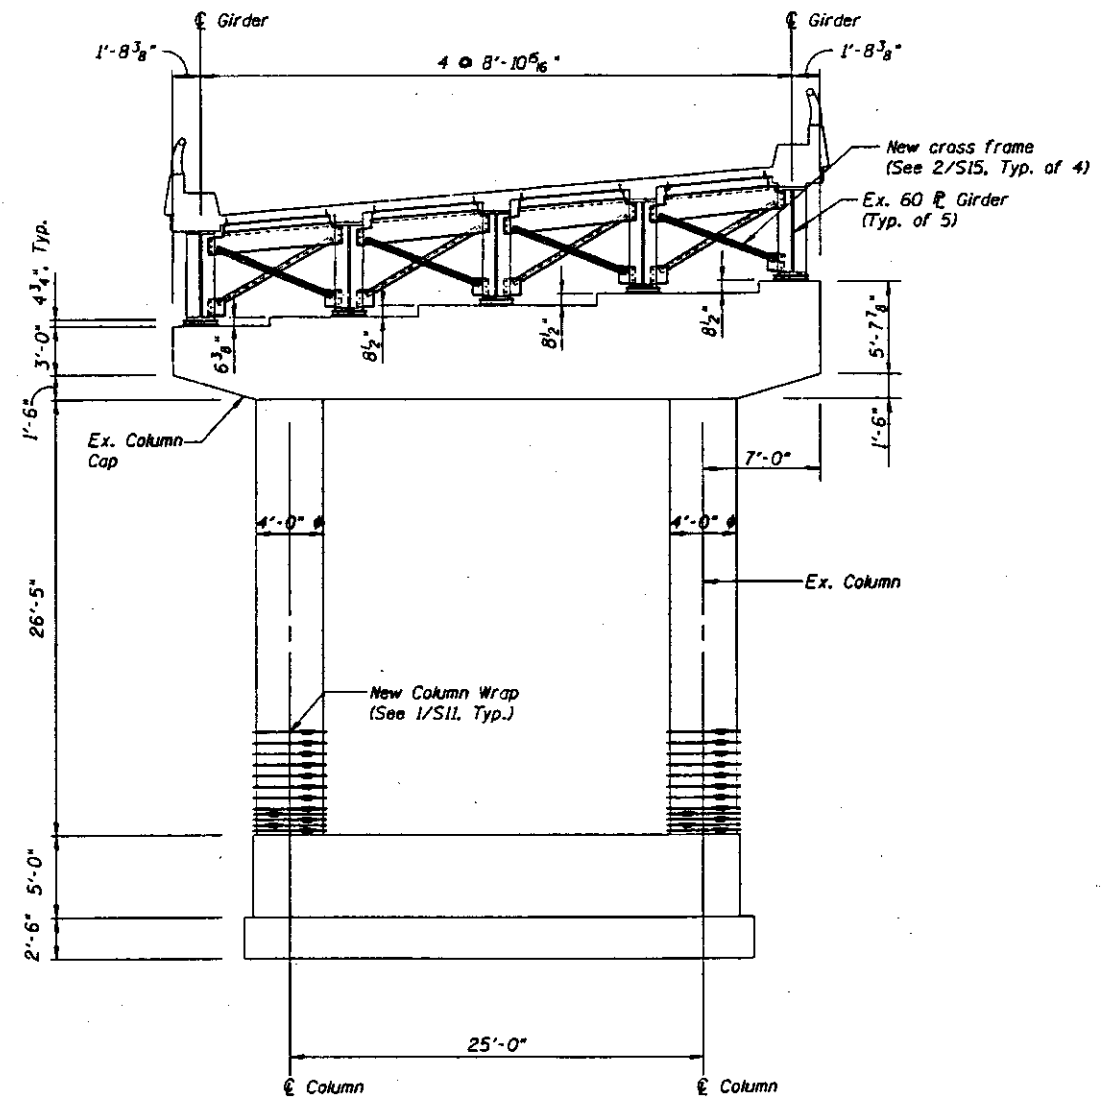

2 ELEVATION PIER Q2-1
S38

BILL OF MATERIAL - PIER Q1-1

ITEM	UNIT	QUANTITY
Furnish and erect structural steel	LBS.	2175
Steel cross frame removal	EACH	4
Epoxy grouted dowels	EACH	20
Column wrap	SQ. FT.	163.4


BILL OF MATERIAL - PIER Q2-1

ITEM	UNIT	QUANTITY
Furnish and erect structural steel	LBS.	2175
Steel cross frame removal	EACH	4
Epoxy grouted dowels	EACH	20
Column wrap	SQ. FT.	163.4


PIERS Q1-1 AND Q2-1 RETROFITS

STATE OF ILLINOIS
DEPARTMENT OF TRANSPORTATION
SEISMIC AND REDUNDANCY RETROFIT REPAIRS
FAI ROUTE TO
POPLAR STREET BRIDGE APPROACHES
ST. CLAIR COUNTY

STRUCTURE NO. 082-0144 (ROADWAY D1) STRUCTURE NO. 082-0203 (RAMP P1)
STRUCTURE NO. 082-0256 (ROADWAY H0) STRUCTURE NO. 082-0255 (RAMP D1)
SCALE: NONE DRAWN BY: JH
DATE: 1-23-98 CHECKED BY: HH

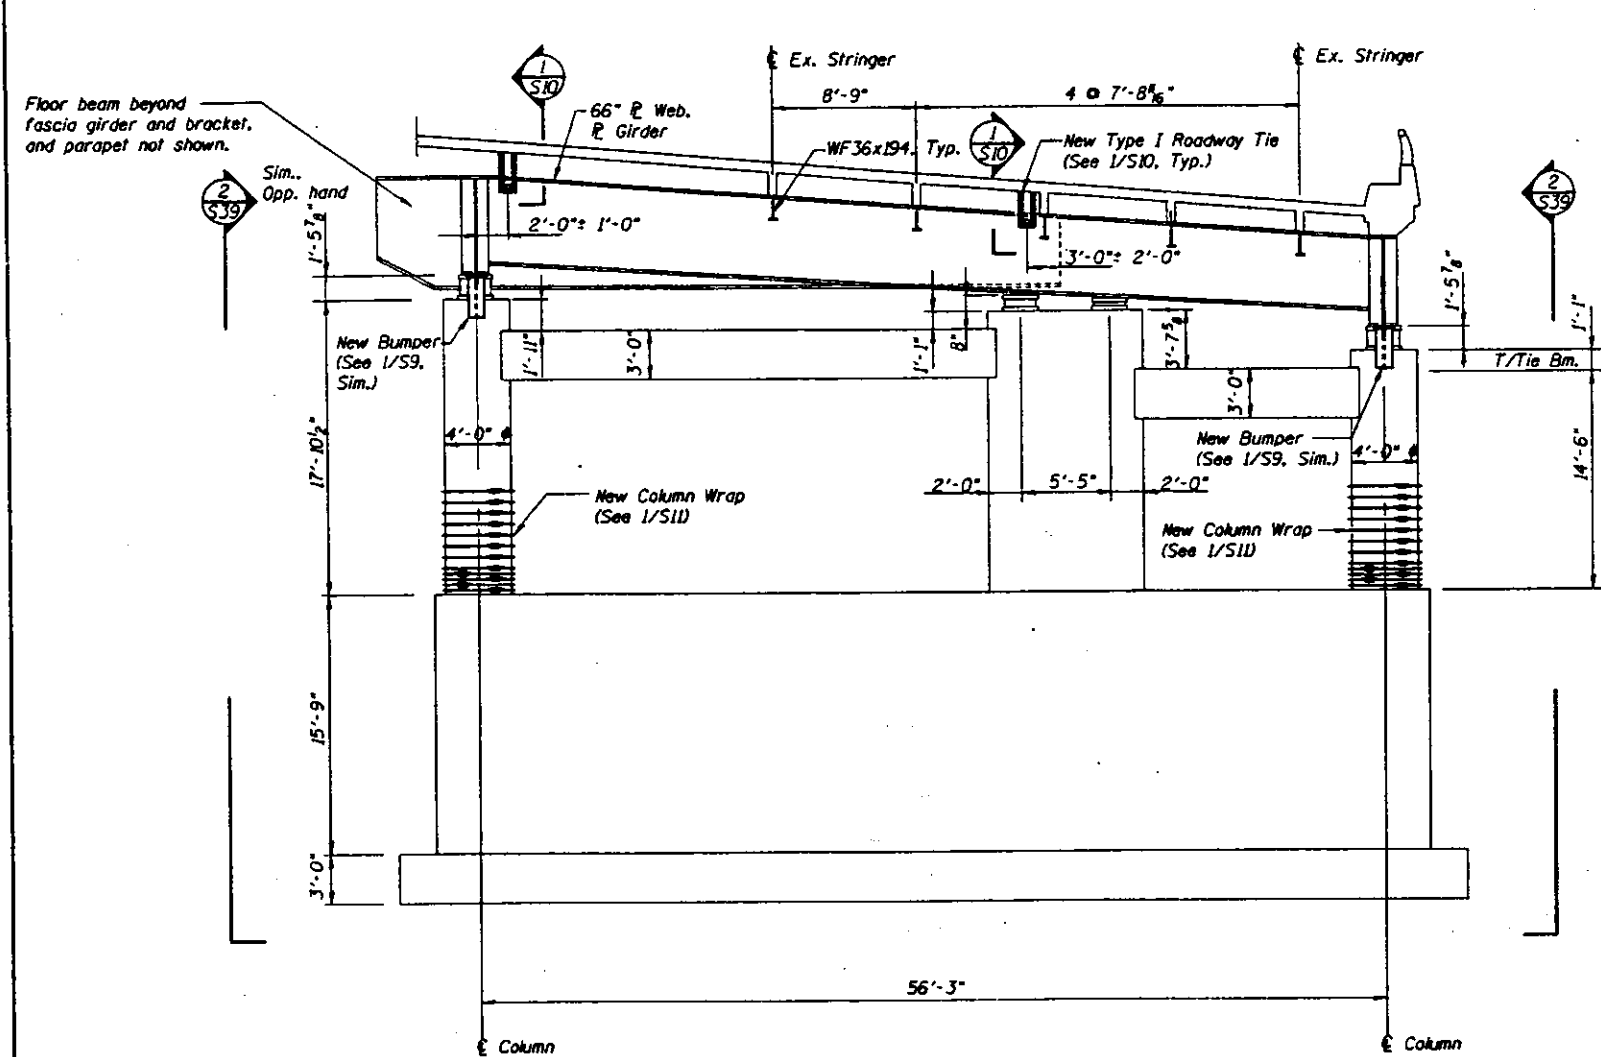

1 ELEVATION PIER P14
S39

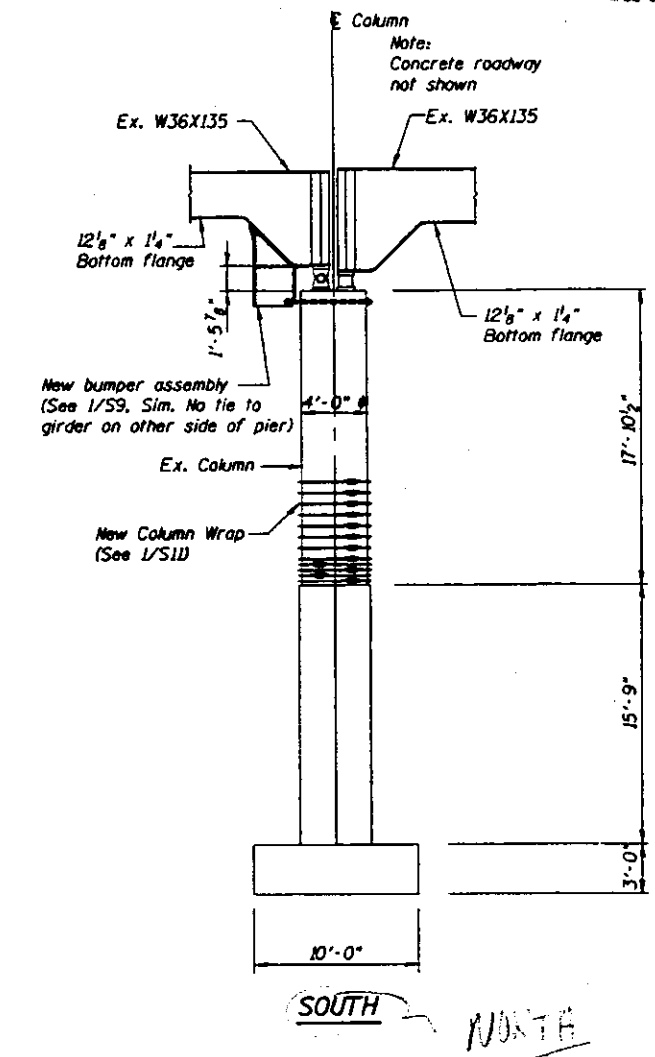

2 ELEVATION PIER P14
S39

BILL OF MATERIAL - PIER P14


ITEM	UNIT	QUANTITY
Concrete removal	C.Y.	6
Furnish and erect structural steel	LBS.	6240
Epoxy grouted dowels	EACH	56
Foundation wall dowel modification	EACH	4
Column wrap	SO. FT.	163.4

PIER P14 RETROFITS


STATE OF ILLINOIS
DEPARTMENT OF TRANSPORTATION
SEISMIC AND REDUNDANCY RETROFIT REPAIRS
FAI ROUTE 70
POPLAR STREET BRIDGE APPROACHES
ST. CLAIR COUNTY

STRUCTURE NO. 082-0144 (ROADWAY D1) STRUCTURE NO. 082-0203 (RAMP P1)
STRUCTURE NO. 082-0256 (ROADWAY H8) STRUCTURE NO. 082-0255 (RAMP D1)
SCALE: NONE DRAWN BY: JN
DATE: 1-23-98 CHECKED BY: JHI

STRUCTURE NO. 082-0144 (ROADWAY D1)

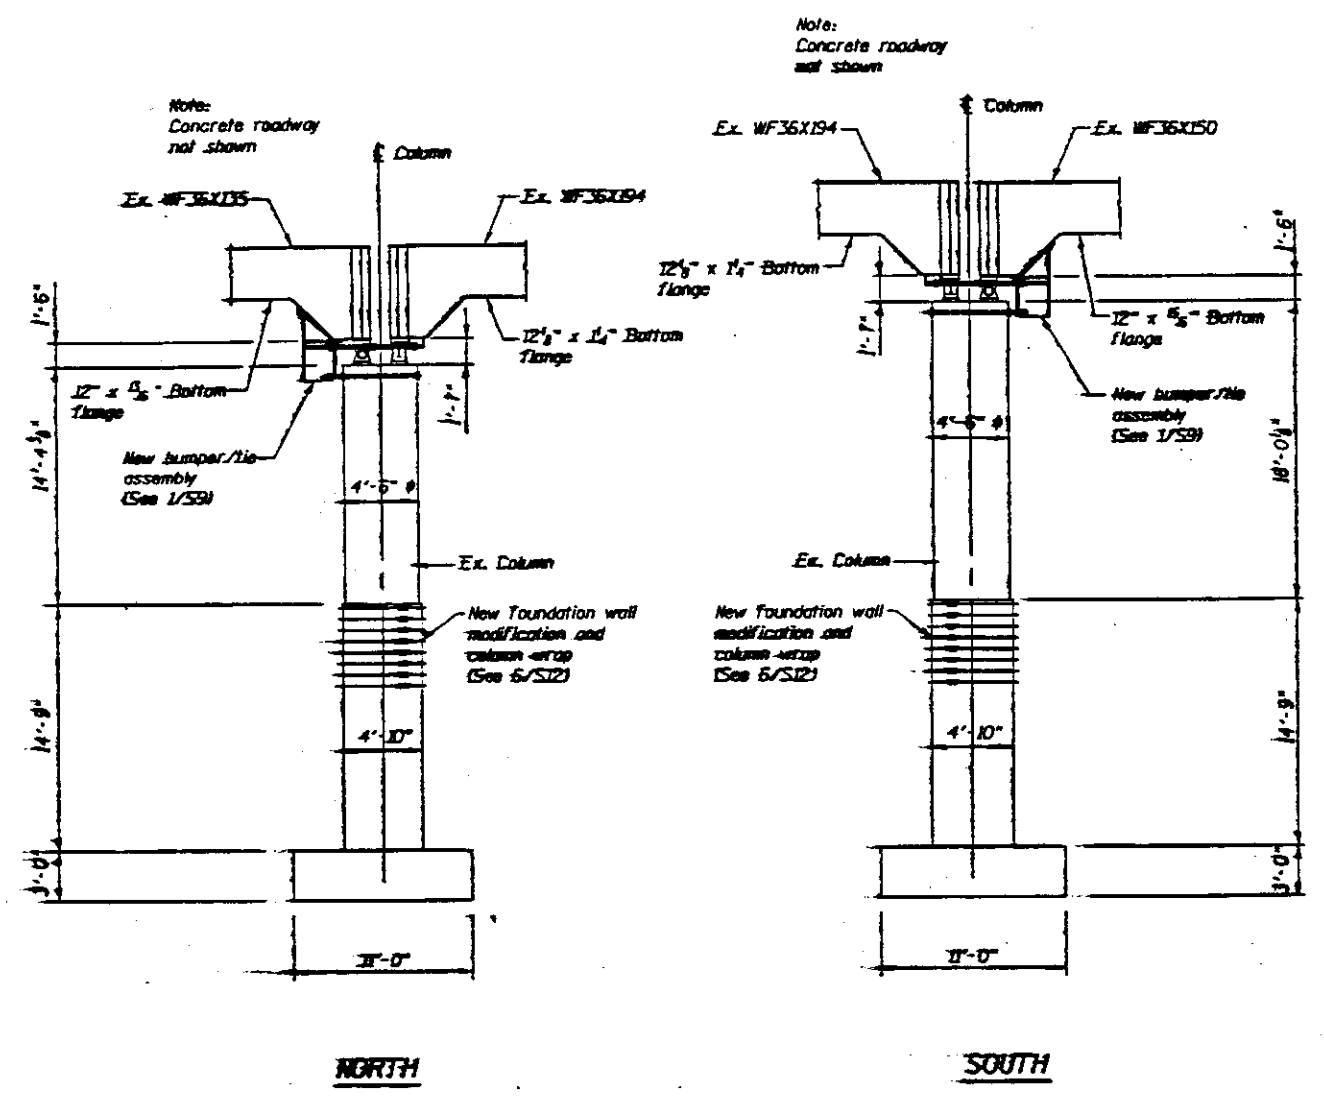

1 ELEVATIONS PIER P15
S40

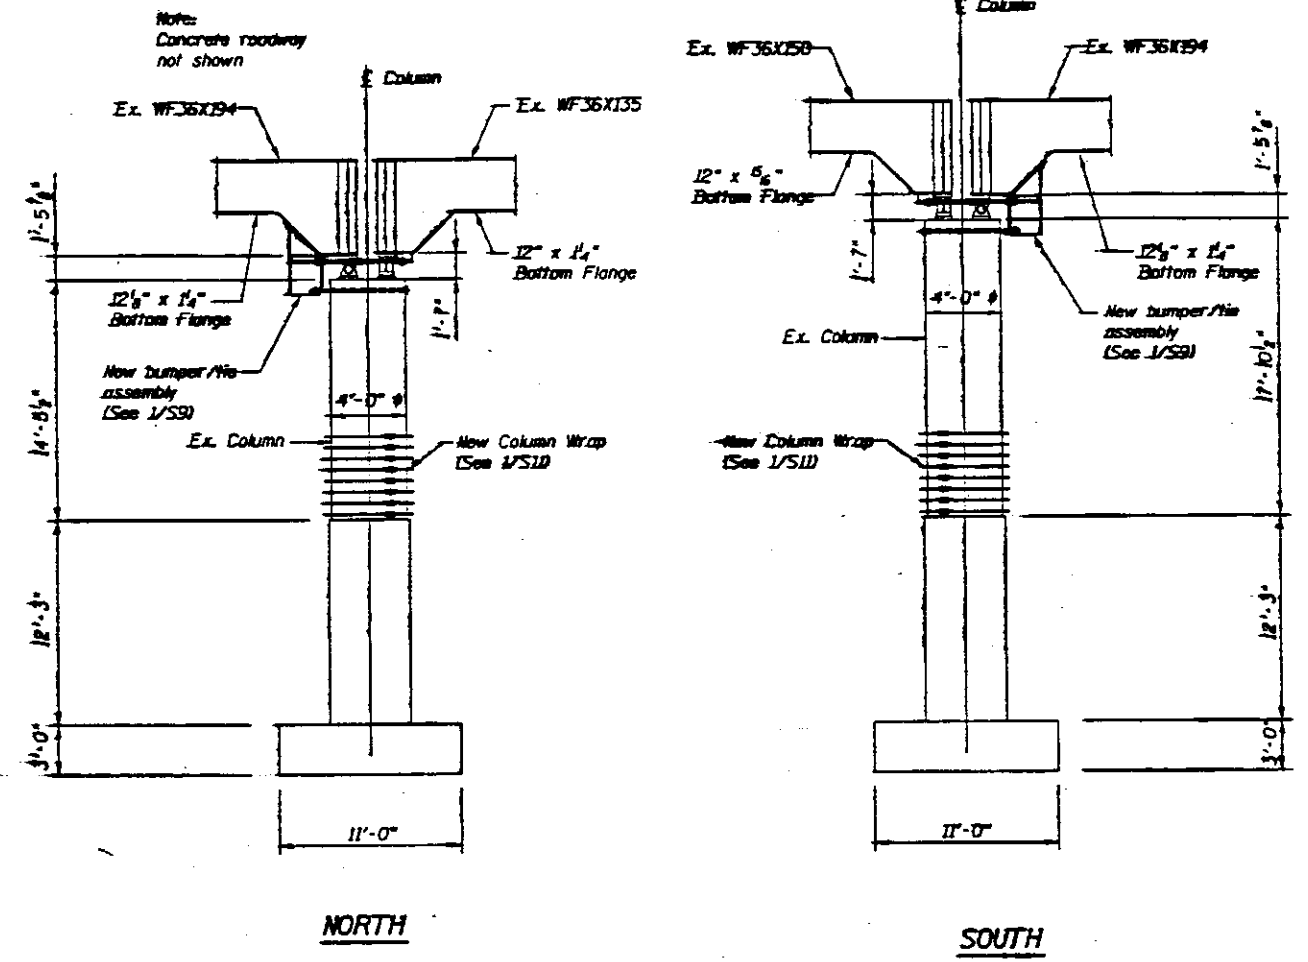

2 ELEVATIONS PIER H1
S40


BILL OF MATERIAL - PIER P15		
ITEM	UNIT	QUANTITY
Furnish and erect structural steel	LBS.	2320
Foundation wall modification	SQ. FT.	56.5
Column wrap	SQ. FT.	221.4

BILL OF MATERIAL - PIER H1		
ITEM	UNIT	QUANTITY
Furnish and erect structural steel	LBS.	2320
Foundation wall dowel modification	EACH	20
Column wrap	SQ. FT.	163.4


PIERS P15 AND H1 RETROFITS

STATE OF ILLINOIS
DEPARTMENT OF TRANSPORTATION
SEISMIC AND REDUNDANCY RETROFIT REPAIRS
FAI ROUTE 70
POPLAR STREET BRIDGE APPROACHES
ST. CLAIR COUNTY

STRUCTURE NO. 082-0444 BRIDGEWAY 40 STRUCTURE NO. 082-0255 BRIDGEWAY 20
STRUCTURE NO. 082-0255 BRIDGEWAY 40 STRUCTURE NO. 082-0255 BRIDGEWAY 20
SCALE: NONE DRAWN BY JH
DATE 1-25-98 CHECKED BY WH

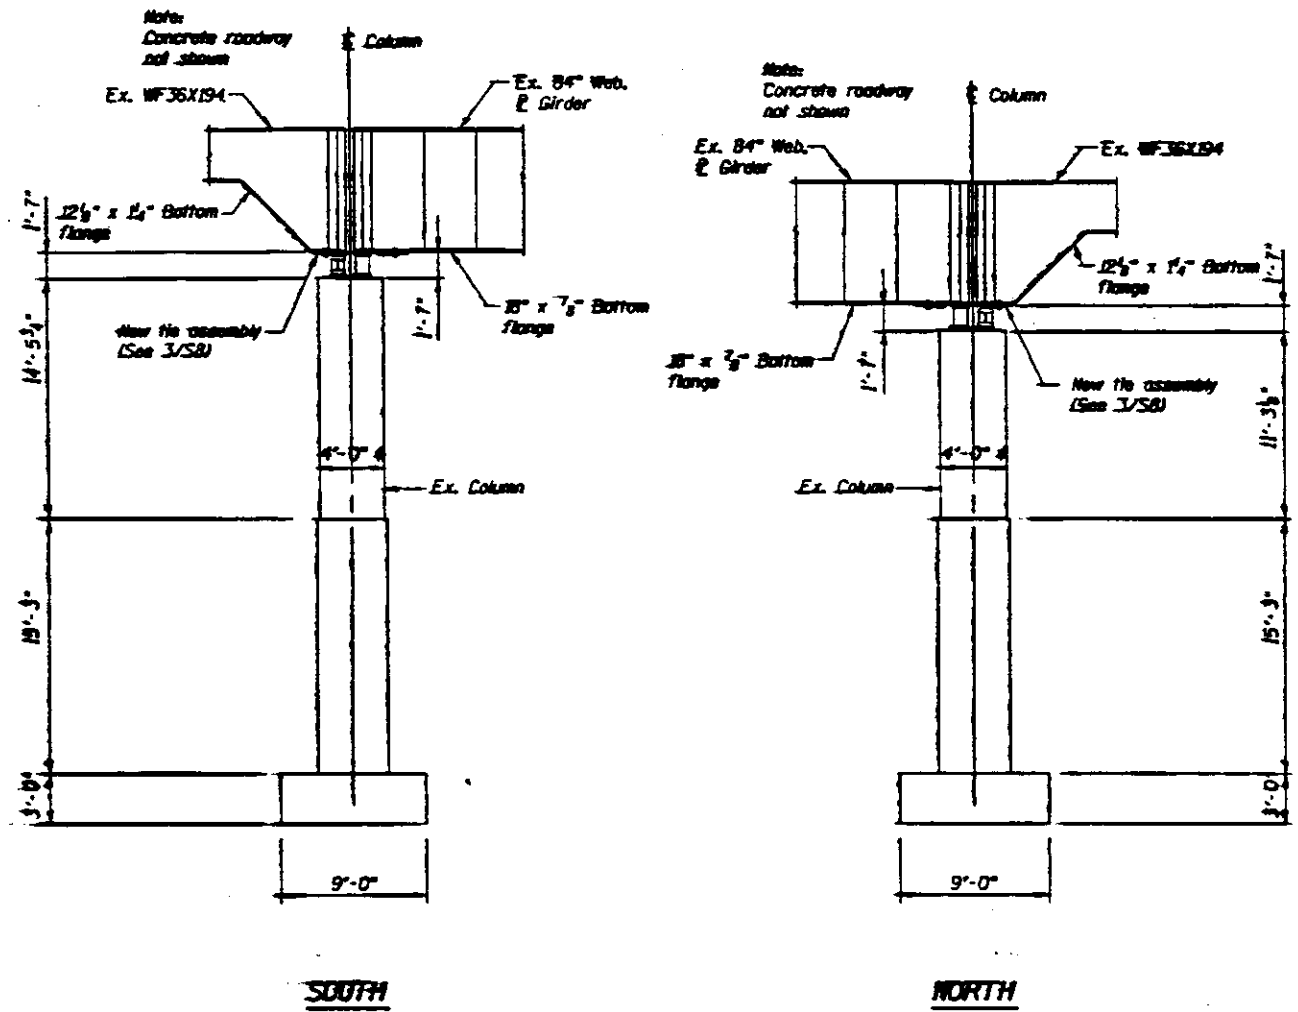

1 ELEVATIONS PIER H2
S41

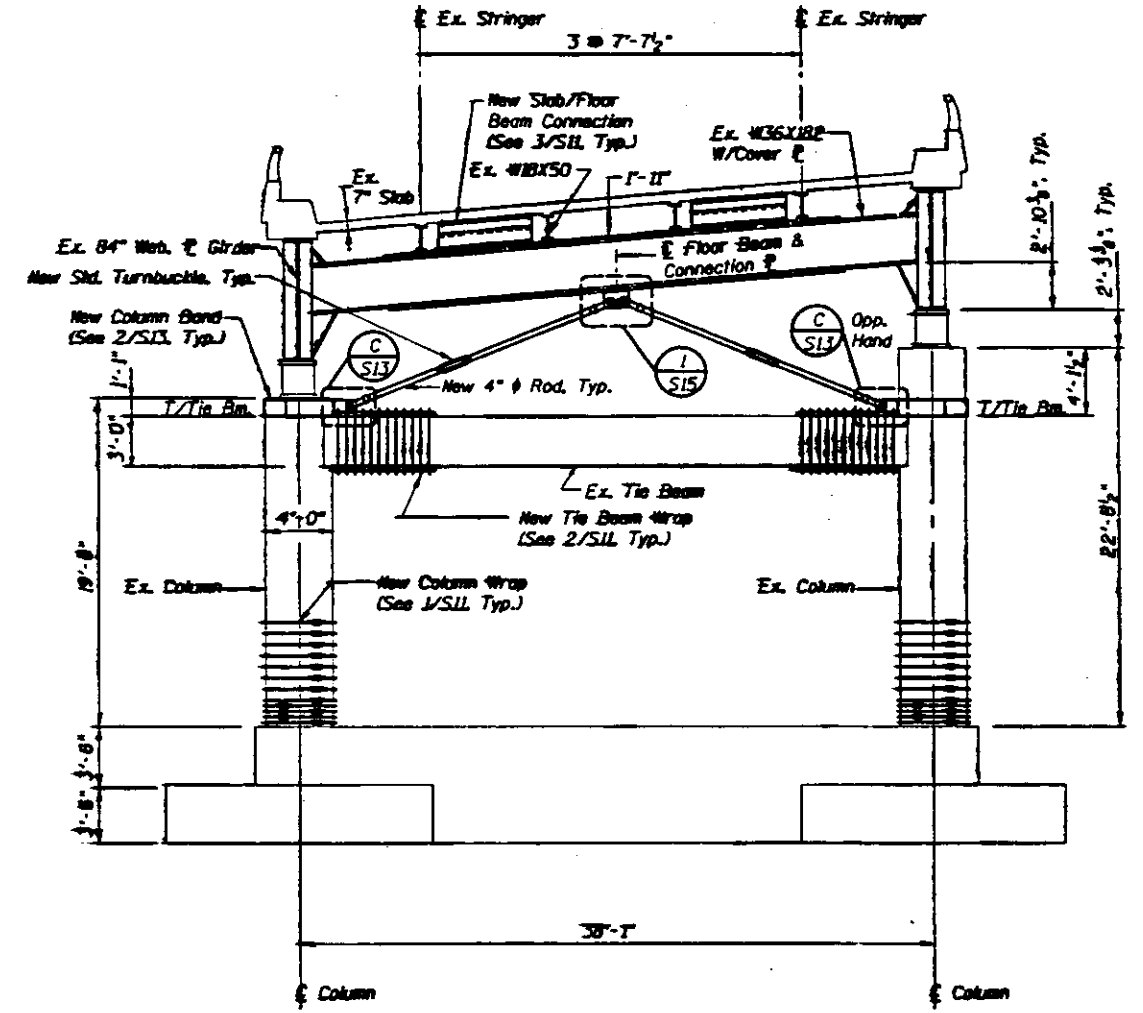

2 ELEVATION PIER H3
S41

BILL OF MATERIAL - PIER H2		
ITEM	UNIT	QUANTITY
Furnish and erect structural steel	LBS.	1605


BILL OF MATERIAL - PIER H3		
ITEM	UNIT	QUANTITY
Furnish and erect structural steel	LBS.	5858
Epoxy grouted dowels	EACH	18
Column wrap	SQ. FT.	163.4

PIERS H2 AND H3 RETROFITS

STATE OF ILLINOIS
DEPARTMENT OF TRANSPORTATION
SEISMIC AND REDUNDANCY RETROFIT REPAIRS
FAI ROUTE TO
POPLAR STREET BRIDGE APPROACHES
ST. CLAIR COUNTY

STRUCTURE NO. 082-044 ROADWAY D STRUCTURE NO. 082-0203 BRAMP P1
STRUCTURE NO. 082-0208 BRAMP P2 STRUCTURE NO. 082-0205 BRAMP P3
SCALE: NONE DRAWN BY: JH
DATE: 1-23-98 CHECKED BY: WH

PROJECT NO.	SECTION	DATE	TOTAL SHEETS	SHEET NO.	SHEET NO. 5-42 SHEETS
F.A.I. 78	0	ST. CLAIR	18	79	
DESIGNED BY: []		CHECKED BY: []			

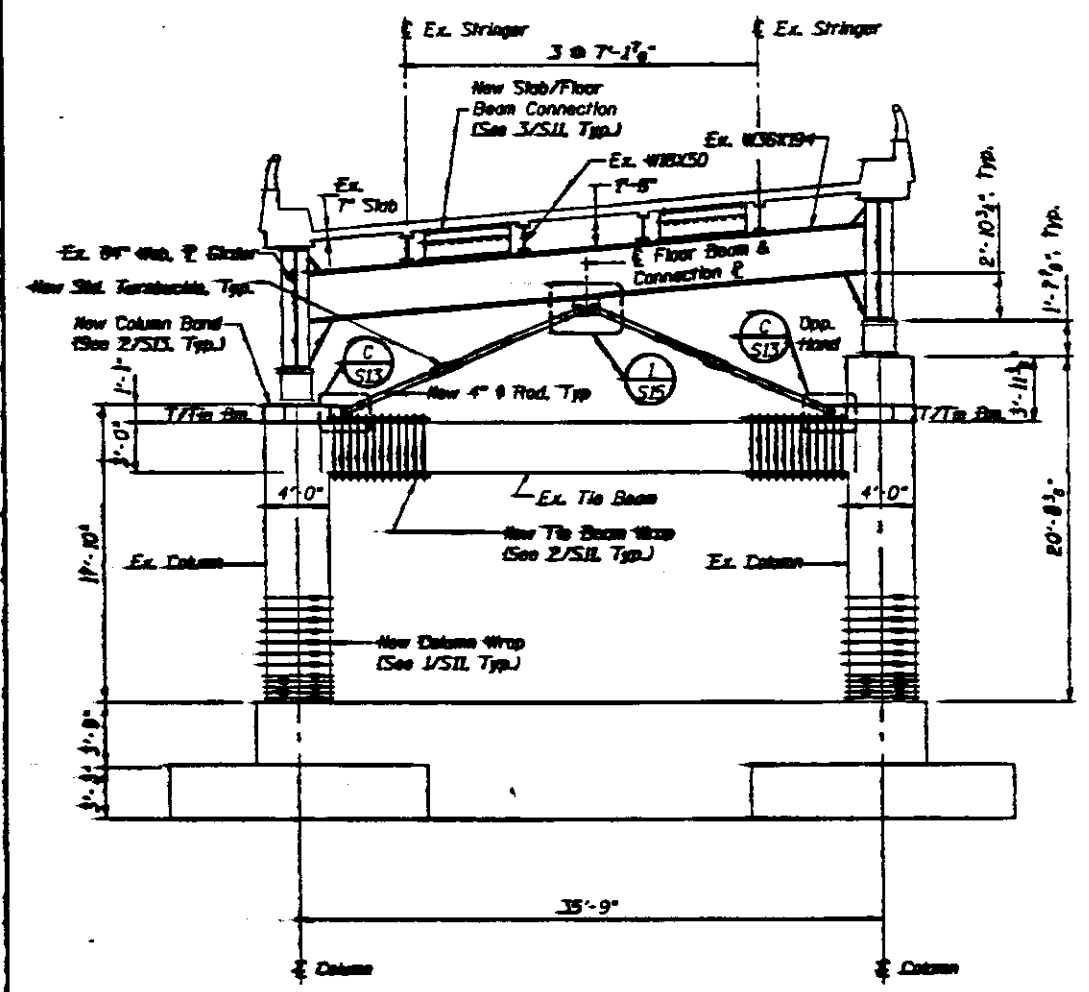

1 ELEVATION PIER H4
S42

ITEM	UNIT	QUANTITY
Furnish and erect structural steel	LBS.	5688
Epoxy grouted dowels	EACH	22
Foundation wall dowel modification	EACH	8
Column wrap	SQ. FT.	163.4

PIER H4 RETROFITS

STATE OF ILLINOIS
DEPARTMENT OF TRANSPORTATION
SEISMIC AND REDUNDANCY RETROFIT REPAIRS
FAI ROUTE TO
POPLAR STREET BRIDGE APPROACHES
ST. CLAIR COUNTY

STRUCTURE NO. 002-0144 ROADWAY 01 STRUCTURE NO. 002-0203 BRAMP P1
STRUCTURE NO. 002-0204 ROADWAY 00 STRUCTURE NO. 002-0205 BRAMP P2
SCALE: NONE DRAWN BY: []
DATE: 1-23-98 CHECKED BY: []

SEE SHEET NO. 7 FOR
INDEX OF SHEETS

THE STRUCTURES REHABILITATED IN THIS
PROJECT WERE BUILT AS SECTIONS:

82-4HS
82-4HS-1
82-3HVF&E-1
82-4HVB

*Construction Changes
Sheets:*

- 2A (246A OF 320)
- 4A (248A OF 320)
- 5A (249A OF 320)
- 6A (250A OF 320)
- 8A (252A OF 320)
- 9A (253A OF 320)
- 10A (254A OF 320)
- 11A (255A OF 320)
- 46A (290A OF 320)

MICROFILMED _____
REEL NUMBER _____
AWARDED _____
RESIDENT ENGINEER _____
AS BUILT CHANGES WERE MADE
ON THE FOLLOWING SHEETS

DESIGN DESIGNATION
C-D'S 2 LANES, 1800(08) TRUNK 17,840-20)

CONTRACT NO. 42345

ST. CLAIR COUNTY SECTION 82-3HVB-2R-1 F.A.I. ROUTE 70


STATE OF ILLINOIS
DEPARTMENT OF TRANSPORTATION

PLANS FOR PROPOSED
FEDERAL AID HIGHWAY

SCALE IN FEET

PLAN 1 INCH 80 FT.
PROFILE HOR. 1 INCH 80 FT.
VERT. 1 INCH 5 FT.
CROSS-SECTIONS
HOR. 1 INCH 10 FT.
VERT. 1 INCH 5 FT.


F.A.I. ROUTE 70
SECTION 82 - 3HVB - 2R - 1
PROJECT IR - 70 - 1 (155) I
ST. CLAIR COUNTY
C-98-106-86

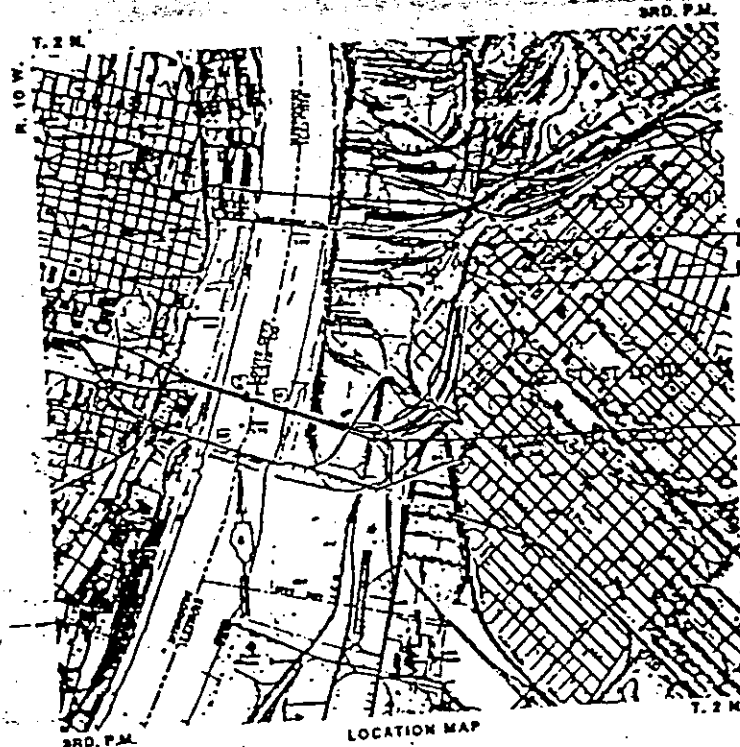

1000 0 1000 2000 3000
SCALE IN FEET

NET LENGTH OF PROJECT - 5,865.75 FT. - 1.111 MILES

82-3HVB-2R-1				
70	8	ST. CLAIR	820	1A
P-98-021-86				

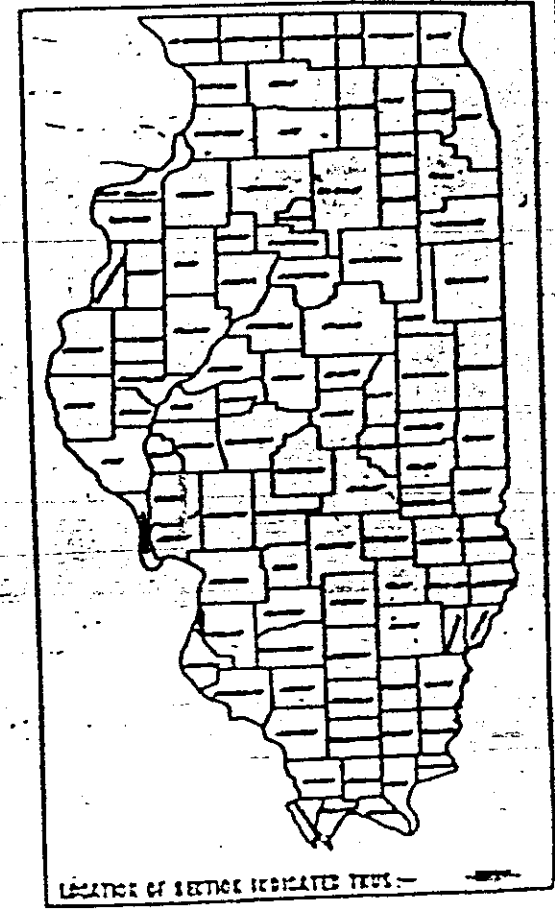

PROJECT
EDGE 115 - 3625 EA. 1-65-70
EQUATION: 111 + 70.50 EA. C-D B.C.
108 + 28.40 EA. 1-65-70 AND

PROJECT
REGAL 50-00-14 EA. C-D

AS REVISED

082-0256

Reel 8-171

ANTHONY W. REMETER
NO. 62-35027
PREPARED BY:
EVERFLUP CORPORATION
ST. LOUIS, MISSOURI

CARLOS A. LEONARDI
NO. 87-3504

DEPARTMENT OF TRANSPORTATION
- FEDERAL AID HIGHWAY DIVISION

Revised 1-25-89 M.H.B.

TOTAL SHEETS	NO.	COUNTY	TOTAL SHEETS	SHEET NO.
70	•	ST. CLAIR	320	7
ALL SHEETS PROJECT				

• 82-3HYB-2R-1

INDEX OF SHEETS

1	TITLE SHEET
2-6	TYPICAL SECTIONS
7	INDEX OF SHEETS
8-10	SUMMARY OF QUANTITIES
11-12	SCHEDULE OF QUANTITIES
13	ALIGNMENT PLAN
14-17	REFERENCE TIES
18-22	PLAN SHEETS
23-25	PROFILE SHEETS
26-28	DRAINAGE PLANS
29	SEWER PROFILES
30-32	TEMPORARY CONNECTION
33-35	SEQUENCE OF CONSTRUCTION AND TRAFFIC CONTROL
35A-35H	TRAFFIC CONTROL AND PROTECTION HOV LANE
36	PAVEMENT MARKING DETAILS
37	RAMP H EXIT & MISC. DETAILS
38-41	SEEDING DETAILS
42-97	BRIDGE - ROADWAYS A, G AND D - DECK REHABILITATION
98-137	BRIDGE - RAMP R RECONSTRUCTION
138-168	BRIDGE - RAMPS O AND P RECONSTRUCTION
169-176	BRIDGE - ROADWAY H - DECK REHABILITATION
177-198	BRIDGE - ROADWAY H OVER TRENDLEY AVENUE
199-224	BRIDGE - RAMP G OVER 4TH STREET
225-244	BRIDGE - ROADWAY C OVER 4TH STREET
245-291	BRIDGES - ROADWAY B & C OVER BROADWAY AND MAIN STREET
292	MAINTENANCE AND CONSTRUCTION SIGN SUPPORT BRACKETS
293-304	SIGNING PLANS
305-320	CROSS SECTIONS

STANDARDS

1527-9	2230-15	2308-4	2343-6
1683-4	2237-10	2314-5	2353-7
2113-2	2240-5	2323-9	2362-3
2130-9	2250-1	2324-6	2364-1
2135	2258-3	2326-3	2381
2143-3	2262-4	2327-10	
2168-11	2263-3	2336-4	2397-1
2203-14	2298-7	2337-2	2419
2213-4	2299-10	2340-4	
2215-3	2300-3	2341-1	
2217-3	2307-6	2342-5	
2228-4			

GENERAL NOTES

1. ALL ELEVATIONS ARE BASED ON U.S. G.S. DATUM.
2. THE STANDARDS WITH THE REVISION NUMBERS LISTED IN THE INDEX OF SHEETS SHALL APPLY TO THIS PROJECT.
3. ANY PARTIAL REMOVAL OF CONCRETE PAVEMENT OR ASPHALTIC CONCRETE PAVEMENT SHALL REQUIRE A SAW CUT.
4. SEED ALL DISTURBED AREAS THAT ARE NOT PAVED.
5. ALL TREES, BRUSH AND SHRUBS WITHIN THE CONSTRUCTION LIMITS WILL BE REMOVED IN ACCORDANCE WITH THE "STANDARD SPECIFICATIONS" AND SPECIAL PROVISIONS. ALL TREES BETWEEN THE CONSTRUCTION LIMITS AND THE EXISTING RIGHT-OF-WAY WILL BE PRESERVED UNLESS DESIGNATED TO BE REMOVED BY THE ENGINEER.
6. WHERE SECTION OR SUBSECTION MARKERS ARE ENCOUNTERED, THE ENGINEER SHALL BE NOTIFIED BEFORE SUCH MONUMENTS ARE REMOVED. THE CONTRACTOR SHALL PROTECT AND CAREFULLY PRESERVE ALL PROPERTY MARKERS AND MONUMENTS UNTIL THE OWNER, AN AUTHORIZED AGENT, OR LAND SURVEYOR HAS WITNESSED OR OTHERWISE REFERENCED THEIR LOCATION. THE CONTRACTOR WILL BE RESPONSIBLE FOR HAVING AN AUTHORIZED SURVEYOR RE-ESTABLISH ANY SECTION OR SUB-SECTION MONUMENTS DESTROYED BY HIS OPERATIONS.
7. LENGTHS OF STORM SEWERS ARE MEASURED FROM CENTERLINE TO CENTERLINE OF STRUCTURES.
8. EXCEPT WHERE DESIGNATED OTHERWISE, THE LOCATIONS AND/OR DEPTHS OF UNDERGROUND UTILITIES SHOWN HAVE BEEN TAKEN FROM OFFICE RECORD INFORMATION FURNISHED BY THE UTILITY OWNERS AND MUST BE CONSIDERED APPROXIMATE. FIELD MARKINGS OF FACILITIES IN CRITICAL AREAS MAY BE OBTAINED BY PROVIDING A MINIMUM OF 96 HOURS ADVANCE NOTICE TO THE RESIDENT ENGINEER SO THAT UTILITIES CAN BE GIVEN NOTICE. AGENCIES KNOWN TO HAVE UNDERGROUND FACILITIES WITHIN THE LIMITS OF THIS IMPROVEMENT ARE THE FOLLOWING MEMBERS OF "JULIE", PHONE 1800182-0123, ARE INDICATED BY ➔
 - UNION ELECTRIC
 - ILLINOIS AMERICAN WATER CO.
 - LALEDE GAS CO.
 - EXPLORER PIPELINE CO.
 - ILLINOIS BELL
9. IT HAS BEEN ESTIMATED THAT 100 SQ. YDS. OF PAVEMENT REMOVAL AND CONTINUOUSLY REINFORCED PORTLAND CEMENT CONCRETE REPLACEMENT, TYPE III IS REQUIRED FOR THE PROJECT AT LOCATIONS DETERMINED BY THE ENGINEER.
10. THE ANCHOR BOLT CAPSULES ARE NOT SUPPLIED BY THE FABRICATION CONTRACT. THE NUMBER AND SIZE OF CAPSULE REQUIRED MUST BE DETERMINED BY THE CONTRACTOR TO MATCH THE ANCHOR BOLT SIZES. IF THE FABRICATION CONTRACTOR ELECTS TO USE THE STATE EXPANSION BOLT, THE CAPSULES WILL NOT BE REQUIRED.
11. ANY INLETS AND PIPES TO BE REMOVED SHOWN IN THE PLANS AND NOT ITEMIZED AS PAY ITEMS SHALL BE CONSIDERED INCIDENTAL TO THE CONTRACT.
12. IF PARAPET RECONSTRUCTION ALTERNATE 1 IS SELECTED BY THE CONTRACTOR, HE WILL BE ALLOWED TO USE A 90 LB. HAMMER TO REMOVE THE PORTION OF THE PARAPET AS SHOWN FOR ALTERNATIVES 2 AND 3.
13. THE CONTRACTOR SHALL SCHEDULE HIS BITUMINOUS OPERATIONS TO INSURE THAT THE PROJECT SCHEDULE IS MET AND THE BITUMINOUS IS PLACED AS SPECIFIED IN THE STANDARD SPECIFICATIONS.

THE FOLLOWING RATES OF APPLICATION HAVE BEEN USED IN CALCULATING PLAN QUANTITIES:

BITUMINOUS CONCRETE	112 LBS. / INCH / SQ. YD.
BITUMINOUS MATERIALS PRIME COAT	0.0003129 TONS / SQ. YD.
GRANULAR MATERIALS	2.05 TONS / CU. YD.
NITROGEN FERTILIZER NUTRIENT	120 LBS. / ACRE
PHOSPHORUS FERTILIZER NUTRIENT	72 LBS. / ACRE
POTASSIUM FERTILIZER NUTRIENT	48 LBS. / ACRE
MULCH	2 TONS / ACRE
EMULSIFIED ASPHALT	0.35 TON / TON OF MULCH

10136
86C11

70	ST. CLAIR	320	8
----	-----------	-----	---

82-3HVB-2R-1

CODE NO.	ITEM	UNIT	QUANTITY	CONSTRUCTION TYPE CODE										
				X 171-50	X 271-2A	X 571-50	X 171-50	X 171-50	X 271-2A	X 271-2A	X 271-2A	X 271-2A	X 271-2A	X 571-50
				ROADWAY A BRIDGE OVER RAILROAD	ROADWAY G BRIDGE OVER ROAD	ROADWAY D BRIDGE OVER ROAD & R.R.	RAMP O & R BRIDGE OVER RAILROAD	RAMP P, O & H BRIDGE OVER RAILROAD	ROADWAY H SPANS H2 - H4 OVER ROAD	ROADWAY H OVER TRENOLLEY AVE.	RAMP G BRIDGE OVER 4th STREET	ROADWAY C BRIDGE OVER 4th STREET	ROADWAY B & C BRIDGES OVER BROADWAY	E.A. & R.A. C-D RAMP G & H
20100100	TREE REMOVAL (6 TO 5 INCH DIAMETER)	IN. DIA.	16											16
20100200	TREE REMOVAL (OVER 15 INCH DIAMETER)	IN. DIA.	40											40
20100600	HEDGE REMOVAL	UNIT	9											9
20200100	EARTH EXCAVATION	CU. YD.	1,575											1,575
20400100	BORROW EXCAVATION	CU. YD.	15,230											15,230
21000100	TRENCH BACKFILL	CU. YD.	552											552
21501200	AGGREGATE SHOULDERS, TYPE B	TON	1,832											1,832
21800100	STABILIZED SUB-BASE 4"	SO. YD.	4,427											4,427
21900600	BITUMINOUS SHOULDERS 8"	SO. YD.	3,209											3,209
30400500	PORTLAND CEMENT CONCRETE BASE COURSE 10"	SO. YD.	3,084											3,084
30500500	PORTLAND CEMENT CONCRETE BASE COURSE WIDENING 10"	SO. YD.	365											365
30800500	BITUMINOUS BASE COURSE 8"	TON	747											747
40600200	BITUMINOUS MATERIALS (PRIME COAT)	TON	10											10
40600300	AGGREGATE (PRIME COAT)	TON	18											18
40600510	LEVELING BINDER (MACHINE METHOD), TYPE I	TON	1,066											1,066
40600710	BITUMINOUS CONCRETE BINDER COURSE, TYPE I	TON	1,311											1,311
40600830	BITUMINOUS CONCRETE SURFACE COURSE, MIXTURE E, CLASS I TYPE I	TON	1,309											1,309
65100200	STRIP REFLECTIVE CRACK CONTROL TREATMENT	LIN. FT.	2,651											2,651
40800500	PORTLAND CEMENT CONCRETE PAVEMENT 10"	SO. YD.	408											408
40801200	PAVEMENT FABRIC	SO. YD.	408											408
40801310	BRIDGE APPROACH PAVEMENT (STANDARD 2353) SPECIAL	SO. YD.	505											505
40801500	P.C. CONCRETE BRIDGE APPROACH SHOULDER PAVEMENT	CU. YD.	266	149.2	66.3	134.6	84.6	153.8	125	168.2	22.0	80.4	432.2	
50102400	CONCRETE REMOVAL	EACH	323											323
50103300	EXPANSION BOLTS 3/4 DIA. INCH X 12 INCH	EACH	1											1
50104720	REMOVAL OF EXISTING CONCRETE DECK	EACH	1											1
50100300	REMOVAL OF EXISTING STRUCTURE (RAMP O) NO. 1	EACH	1				597	180			19	223	421	
50100400	REMOVAL OF EXISTING STRUCTURE (RAMP R) NO. 2	CU. YD.	1,440				12	8			3	6	40	
50200100	STRUCTURE EXCAVATION	EACH	73	8		2						6		
50300100	FLOOR DRAINS	EACH	6									3		
X5033000	INSTALLING ELASTOMERIC BEARING ASSEMBLY, TYPE I	EACH	3										12	
X5033100	INSTALLING ELASTOMERIC BEARING ASSEMBLY, TYPE II	LIN. FT.	469				370	87					12	
50300108	PREFORMED JOINT SEAL 1 1/2"	LIN. FT.	42				30							
50300120	PREFORMED JOINT SEAL 2 1/2"	LIN. FT.	82				82						410	
50300130	PREFORMED JOINT SEAL 4"	SO. YD.	6,771	1,945	1,049	2,048	460	276	260	35	196	92	9	
50300300	PROTECTIVE COAT	EACH	9				706.6	219.0			27.9	180.5	424.3	
50300400	CONCRETE HEADWALL FOR PIPE DRAINS	CU. YD.	1,558.3				811.9	449.3	17.0	146.6	443.9	184.0	695.2	
50400300	CLASS X CONCRETE	CU. YD.	3,053.0	922	747	1,382	15,920.0	7,630.0	1,350.0		673.0	340.0	1,820.0	
50500250	CLASS X CONCRETE SUPERSTRUCTURE	POUND	59,925.0	5,430.0	2,704.0	4,056.0	0.45	0.19		0.01	0.01	0.07	0.23	
50700400	FURNISHING AND ERECTING STRUCTURAL STEEL	L. SUM	1	0.01	0.01	0.02	7.983	3.573			7.209		74	
50700500	ERECTING STRUCTURAL STEEL	EACH	18,839											137
50700500	STUD SHEAR CONNECTORS	LIN. FT.	137											36
51100430	PIPE CULVERT, TYPE 1, RCCP 15"	LIN. FT.	36											18
51101267	PIPE CULVERTS, TYPE 2 RCCP 12"	LIN. FT.	106											44
51101270	PIPE CULVERTS, TYPE 2 RCCP 15"	LIN. FT.	18											352
51101279	PIPE CULVERTS, TYPE 2 RCCP 24"	LIN. FT.	44											1
51101480	PIPE CULVERTS, TYPE 2, CORRUGATED STEEL OR ALUMINUM CULVERT PIPE 15"	LIN. FT.	352											2
51102131	PIPE CULVERTS, TYPE 3 RCCP 36"	EACH	1											1
51113657	PRECAST REINFORCED CONCRETE FLARED END SECTIONS 12"	EACH	2											5
51113660	PRECAST REINFORCED CONCRETE FLARED END SECTIONS 15"	EACH	1											1
51113669	PRECAST REINFORCED CONCRETE FLARED END SECTIONS 24"	EACH	5											1
51113447	END SECTIONS 12"	EACH	1								4,130	19,530	42,550	18,443
51113450	END SECTIONS 15"	POUND	250,603				128,620	37,330			121,610	50,830	136,120	
51200100	REINFORCEMENT BARS	POUND	732,772	12,372	6,070	11,040	234,590	121,920	760	37,460	155	1,691	3,087	
51200200	REINFORCEMENT BARS, EPOXY COATED	LIN. FT.	11,844				5,101	1,810			155	1,691	3,087	
51302200	FURNISHING CONCRETE PILES	LIN. FT.	11,844				5,101	1,810			2	2	3	
51302800	DRIVING CONCRETE PILES	EACH	13				4	2			1	1	1	646
51304200	TEST PILE CONCRETE	EACH	6				1	1						7,715
51400100	NAME PLATES	LIN. FT.	646											236
60705000	PIPE DRAINS, CORRUGATED STEEL OR ALUMINUM ALLOY 12"	LIN. FT.	7,715											7
60707600	PIPE UNDERDRAINS 4"	LIN. FT.	236											1
60708100	PIPE UNDERDRAINS 4" (SPECIAL)	EACH	7											3
61218400	MANHOLES, TYPE A, 4' DIAMETER, TYPE I FRAME, CLOSED LID	EACH	1											7
61244400	FLUSH INLET BOX FOR MEDIAN (2240)	EACH	3											1
61247000	TYPE C INLET BOX, STANDARD 2324	EACH	7											7
61247100	TYPE D INLET BOX, STANDARD 2324	EACH	7											

LEVELS PLOTTED DATE: 10-14-87
 10320 FILE: SUMMARY.DGN
 87C PRF:SUMI

REV. 8/26/88

SUMMARY
 OF
 QUANTITIES

© NON-PART.

TO	ST. CLAIR	320	9
PROJECT			
82-3HYB-2R-1			

CODE NO.	ITEM	UNIT	QUANTITY	CONSTRUCTION TYPE CODE										
				X 171-50	X 271-2A	X 571-50	X 171-50	X 171-50	X 271-2A	X 271-2A	X 271-2A	X 271-2A	X 571-50	SFTY-30
				ROADWAY A BRIDGE OVER RAILROAD	ROADWAY G BRIDGE OVER ROAD	ROADWAY D BRIDGE OVER ROAD & R.R.	RAMP O & R BRIDGE OVER RAILROAD	RAMP P, O & H BRIDGE OVER RAILROAD	ROADWAY H SPANS H2 - H4 OVER ROAD	ROADWAY H OVER TRENOLÉY AVE.	RAMP G BRIDGE OVER 4TH STREET	ROADWAY C BRIDGE OVER 4TH STREET	ROADWAY B & C BRIDGES OVER BROADWAY	E.S. & H.B. C-D RAMPS G & H
61255500	MANHOLES TO BE ADJUSTED	EACH	1											1
61258200	MANHOLES TO BE RECONSTRUCTED WITH NEW TYPE I FRAME, CLOSED LID	EACH	1											1
61260300	INLETS TO BE ADJUSTED WITH NEW TYPE I FRAME, OPEN LID	EACH	1											1
61260900	INLETS TO BE ADJUSTED WITH NEW TYPE 6 FRAME AND GRATE	EACH	1											1
61407910	GRATING FOR CONCRETE FLARED END SECTION 24"	EACH	1											1
61500100	FILLING EXISTING MANHOLES	LIN. FT.	180											180
62900300	CHAIN LINK FENCE, 6 FT.	EACH	3											3
X0320025	FURNISH AND MAINTAIN RADIO													
61605100	COMBINATION CONCRETE CURB AND GUTTER, TYPE B-6.24 (ABUTTING EXISTING PAVEMENT)	LIN. FT.	88											88
61615200	PAVED DITCH, TYPE A-12	LIN. FT.	715											715
XG163901	TEMPORARY CONCRETE BARRIER, TTV	LIN. FT.	11,600											11,600
XG164101	TEMPORARY CONCRETE BARRIER, TERMINAL SECTION, TTV	EACH	12											12
XG164001	RELOCATE TEMPORARY CONCRETE BARRIER, TTV	LIN. FT.	20,600											20,600
61700030	BITUMINOUS SURFACE REMOVAL (VARIABLE DEPTH)	SQ. YD.	2,680											2,680
61700100	PAVEMENT REMOVAL	SQ. YD.	2,547											2,547
61700900	BITUMINOUS CONCRETE REMOVAL	SQ. YD.	747											747
61700920	BITUMINOUS CONCRETE SHOULDER REMOVAL	SQ. YD.	584											584
61701000	BITUMINOUS CONCRETE SURFACE REMOVAL	SQ. YD.	25,118	9,632	4,839	8,597		407	1,248	395				88
61701800	COMBINATION CURB AND GUTTER REMOVAL (PARTIAL)	LIN. FT.	88											88
61704000	PAVED DITCH REMOVAL	LIN. FT.	317											317
61704500	PAVEMENT REMOVAL (SURFACE COURSE)	SQ. YD.	457											457
61704800	SLOPE WALL REMOVAL	SQ. YD.	416							30				386
61800100	SLOPE WALL 4 INCH	SQ. YD.	1,189							30				1,159
62000545	CLASS A PATCHES TYPE III 9 INCH	SQ. YD.	100											100
62800035	TRAFFIC BARRIER TERMINAL, TYPE I	EACH	1											1
62800040	TRAFFIC BARRIER TERMINAL, TYPE IA	EACH	1											1
62800045	TRAFFIC BARRIER TERMINAL, TYPE 2	EACH	3											3
62800070	TRAFFIC BARRIER TERMINAL, TYPE 5	EACH	7											7
62800085	TRAFFIC BARRIER TERMINAL, TYPE 6	EACH	6											6
62800095	TRAFFIC BARRIER TERMINAL, TYPE 6	EACH	6											6
62801900	REMOVAL AND REINSTALLATION OF EXISTING S. P. B. GUARD RAIL, SINGLE RAIL	LIN. FT.	2,725											2,725
62910400	CHAIN LINK FENCE TO BE REMOVED AND RE-ERECTED	LIN. FT.	845											845
63300300	STEEL PLATE BEAM GUARD RAIL REMOVAL	LIN. FT.	920											920
64200200	SEEDING, CLASS 2	ACRE	2.5											2.5
64300820	HAY OR STRAW BALES	EACH	400											400
64600401	ENGINEER'S FIELD OFFICE, TYPE A-1	CAL. MO.	12											12
64600600	ENGINEER'S FIELD LABORATORY	CAL. MO.	12											12
64801800	TRAFFIC CONTROL AND PROTECTION (SPECIAL)	L. SUM	1											1
65000100	MOBILIZATION	L. SUM	1											1
66060200	BARE COPPER WIRE, 1/C NO. 6	LIN. FT.	1,120											1,120
66100300	UNIT DUCT, 2-600 VxLP #6, 1" POLYETHELENE	LIN. FT.	410											410
66100400	UNIT DUCT, 2-600 VxLP #4, 1" POLYETHELENE	LIN. FT.	710											710
66200100	TRENCH AND BACKFILL FOR ROADWAY LIGHTING	LIN. FT.	1,040											1,040
67000100	SIGN LIGHTING (HIGH PRESSURE SODIUM)	LIN. FT.	88											88
T2030100	SIGN PANEL - TYPE 3	SQ. FT.	455											455
T2070100	RELOCATE SIGN PANEL - TYPE 3	SQ. FT.	641.5											641.5
T3094000	OVERHEAD SIGN STRUCTURE - SPAN, TYPE IV-A (6'-0" X 8'-0")	LIN. FT.	171.0											171.0
T3110100	OVERHEAD SIGN STRUCTURE WALKWAY	LIN. FT.	125.25											125.25
T3120200	DRILLED SHAFT CONCRETE FOUNDATIONS	CU. YD.	35.5											35.5
T3170100	REMOVE OVERHEAD SIGN STRUCTURE - SPAN	EACH	2											2
T3200200	REMOVE CONCRETE FOUNDATION - OVERHEAD	EACH	4											4
T5020200	PAINT PAVEMENT MARKING - LINE 4"	LIN. FT.	32,484											32,484
T5020500	PAINT PAVEMENT MARKING - LINE 8"	LIN. FT.	6,810											6,810
T5030600	PERFORMED PLASTIC PAVEMENT MARKING-LINE 12"	LIN. FT.	1,835											1,835
T5040100	RAISED REFLECTIVE PAVEMENT MARKER	EACH	501	21	16	19	9	7	4	3	3	6	32	381
L0008800	REMOVAL OF EXISTING LIGHTING UNIT	EACH	44	9	2	11	6	1	4	1	1	5	3	60
L0669000	PULL UNIT DUCT FROM CONDUIT	LIN. FT.	60											60
XZ178900	INSTALLING REINFORCED NEOPRENE EXPANSION JOINT TREATMENT	LIN. FT.	224	37	41	146								224
X5033800	INSTALLING ELASTOMERIC BEARING ASSEMBLY (SPECIAL)	EACH	50				36	14						50
X0300100	PARAPET RECONSTRUCTION	LIN. FT.	12,138	4,611	2,336	4,465			726					12,138
50701000	JACK AND REPOSITION BEARINGS	EACH	26							26				26
Z0006010	BRIDGE DECK CONCRETE OVERLAY OPTION	SQ. YD.	26,786	10,453	5,142	9,054		420	1,322	395				26,786
Z0012100	CONCRETE BRIDGE DECK SCARIFICATION (1/4 INCH)	SQ. YD.	24,786	9,532	4,750	8,380		407	1,322	395				24,786
Z0013500	CONCRETE THRUST BLOCKS	EACH	5											5

SUMMARY
OF
QUANTITIES

10320 FILE SUMMARY.DGN LEVELS PLOTTED DATE: 10-14-87
87C PRF: SUM2 1.2.3.35

SPECIALTY ITEMS A CONST. CODE Y080 © NON-PART.

REV. 8/26/88

70	ST. CLAIR	320	10
* 82-3HVB-2R-1			

CONSTRUCTION TYPE CODE

CODE NO.	ITEM	UNIT	QUANTITY	CONSTRUCTION TYPE CODE												
				X 171-50 ROADWAY A BRIDGE OVER RAILROAD	X 271-2A ROADWAY G BRIDGE OVER ROAD	X 571-50 ROADWAY D BRIDGE OVER ROAD & R.R.	X 171-50 RAMPS O & R BRIDGE OVER RAILROAD	X 171-50 RAMPS P, O & H BRIDGE OVER RAILROAD	X 271-2A ROADWAY H SPANS H2 - H4 OVER ROAD	X 271-2A ROADWAY H OVER TRENOLLEY AVE.	X 271-2A RAMP G BRIDGE OVER 4TH STREET	X 271-2A ROADWAY C BRIDGE OVER 4TH STREET	X 571-50 ROADWAY B & C BRIDGES OVER BROADWAY	SFTY-30 E.B. & W.B. 1 C-D RAMPS G & H		
Z0013700	CONSTRUCT NG TEST STRIP	EACH	2						7	4	16					2
Z0016001	DECK SLAB REPAIR (FULL DEPTH, TYPE I)	SO. YD.	827	272	153	375		60	105	46						
Z0016200	DECK SLAB REPAIR (PARTIAL)	EACH	104	39	12	33			6	4	6	4				
Z0017900	DRAINAGE SCUPPERS	CU. FT.	2.7								2.7					
Z0020400	EPOXY MORTAR REPAIR	EACH	1		1											
Z0029999	IMPACT ATTENUATOR REMOVAL	EACH	4		1		1	1								1
Z0030000	IMPACT ATTENUATORS	EACH	4		1											430
Z0033400	LOCATING UNDERGROUND CABLE	LIN. FT.	430							38	174	245	39	39		
50300150	NEOPRENE EXPANSION JOINT 2"	LIN. FT.	805	131	32	107							47	68		
50300155	NEOPRENE EXPANSION JOINT 2 1/2"	LIN. FT.	375	68	91	40	61							52		
50300155	NEOPRENE EXPANSION JOINT 2 1/2"	LIN. FT.	407	125	37	72	41	80						12		
50300160	NEOPRENE EXPANSION JOINT 4"	LIN. FT.	12													
50300165	NEOPRENE EXPANSION JOINT 6 1/2"	EACH	19													19
Z0039200	PERMANENT SURVEY MARKERS, TYPE I	LIN. FT.	137													137
Z0040500	PIPE CULVERT REMOVAL	EACH	7													7
X0702200	TRAFFIC BARRIER TERMINAL CONNECTOR	EACH	7													1
Z0076000	TRAINEES	HOUR	1,500													
Z0048655	RAILROAD PROTECTIVE LIABILITY INSURANCE	L. SUM	1	0.25		0.25	0.25	0.25								
X0300101	FLOOR DRAIN REMOVAL	EACH	741	293	149	248			51							
X0974000	OFFICE COPY MACHINE	EACH	1													1
X0300109	TRAFFIC CONTROL AND PROTECTION (HOV LANE)	EACH	400													400
Z0016002	DECK SLAB REPAIR (FULL DEPTH, TYPE II)	SQ. YD.	398	90	200	108										
X2163801	MOVABLE CONCRETE MEDIAN BARRIER TRANSFER AND TRANSPORT VEHICLE	EACH	1													1
X0300103	FACSIMILE MACHINE	CALMO	12													12

10320 FILE: SUMMARY.DGN DATE: 10-14-87
 87C PRE: SUM3

* SPECIALTY ITEMS ^ CONST. TYPE CODE: Y080 ⊗ CONST. CODE SFTY-3N ⊙ NON-PART.

REV. 8/26/88 Rev. 11-18-88

SUMMARY
OF
QUANTITIES

70	N	ST. CLAIR	320	18
----	---	-----------	-----	----

R 62-3HVB-2R-1

BEGIN PROJECT
 P.O.T. 49+55.20 WB C-D
 P.O.T. 74+12.69 RAMP M

PROJECT LIMIT RAMP M
 P.O.C. 70+34.45

BEGIN PROJECT
 P.O.C. 59+00.14


- BENCH MARKS**
- A-4 Chiseled "a" in conc. foundation at N. end of Pier A-4 on W.B. C-D Elev. 425.86
 - A-8 Chiseled "a" in conc. foundation at N. end of Pier A-8 on W.B. C-D Elev. 427.37
 - A-14 Chiseled "a" in conc. foundation at N. end of Pier A-14 on W.B. C-D Elev. 428.86
 - D-14 Chiseled "a" in conc. foundation at N. end of Pier D-14 on E.B. C-D Elev. 429.86
 - D-17 Chiseled "a" in conc. foundation at N. end of Pier D-17 on E.B. C-D Elev. 428.90

Notes:
 1. For Bridge Modifications, See Bridge Drawings.
 2. For Curve Data Information, See Alignment Plan.


T. 2 N., R. 10 W., 3RD. P.M.



10920
87C45

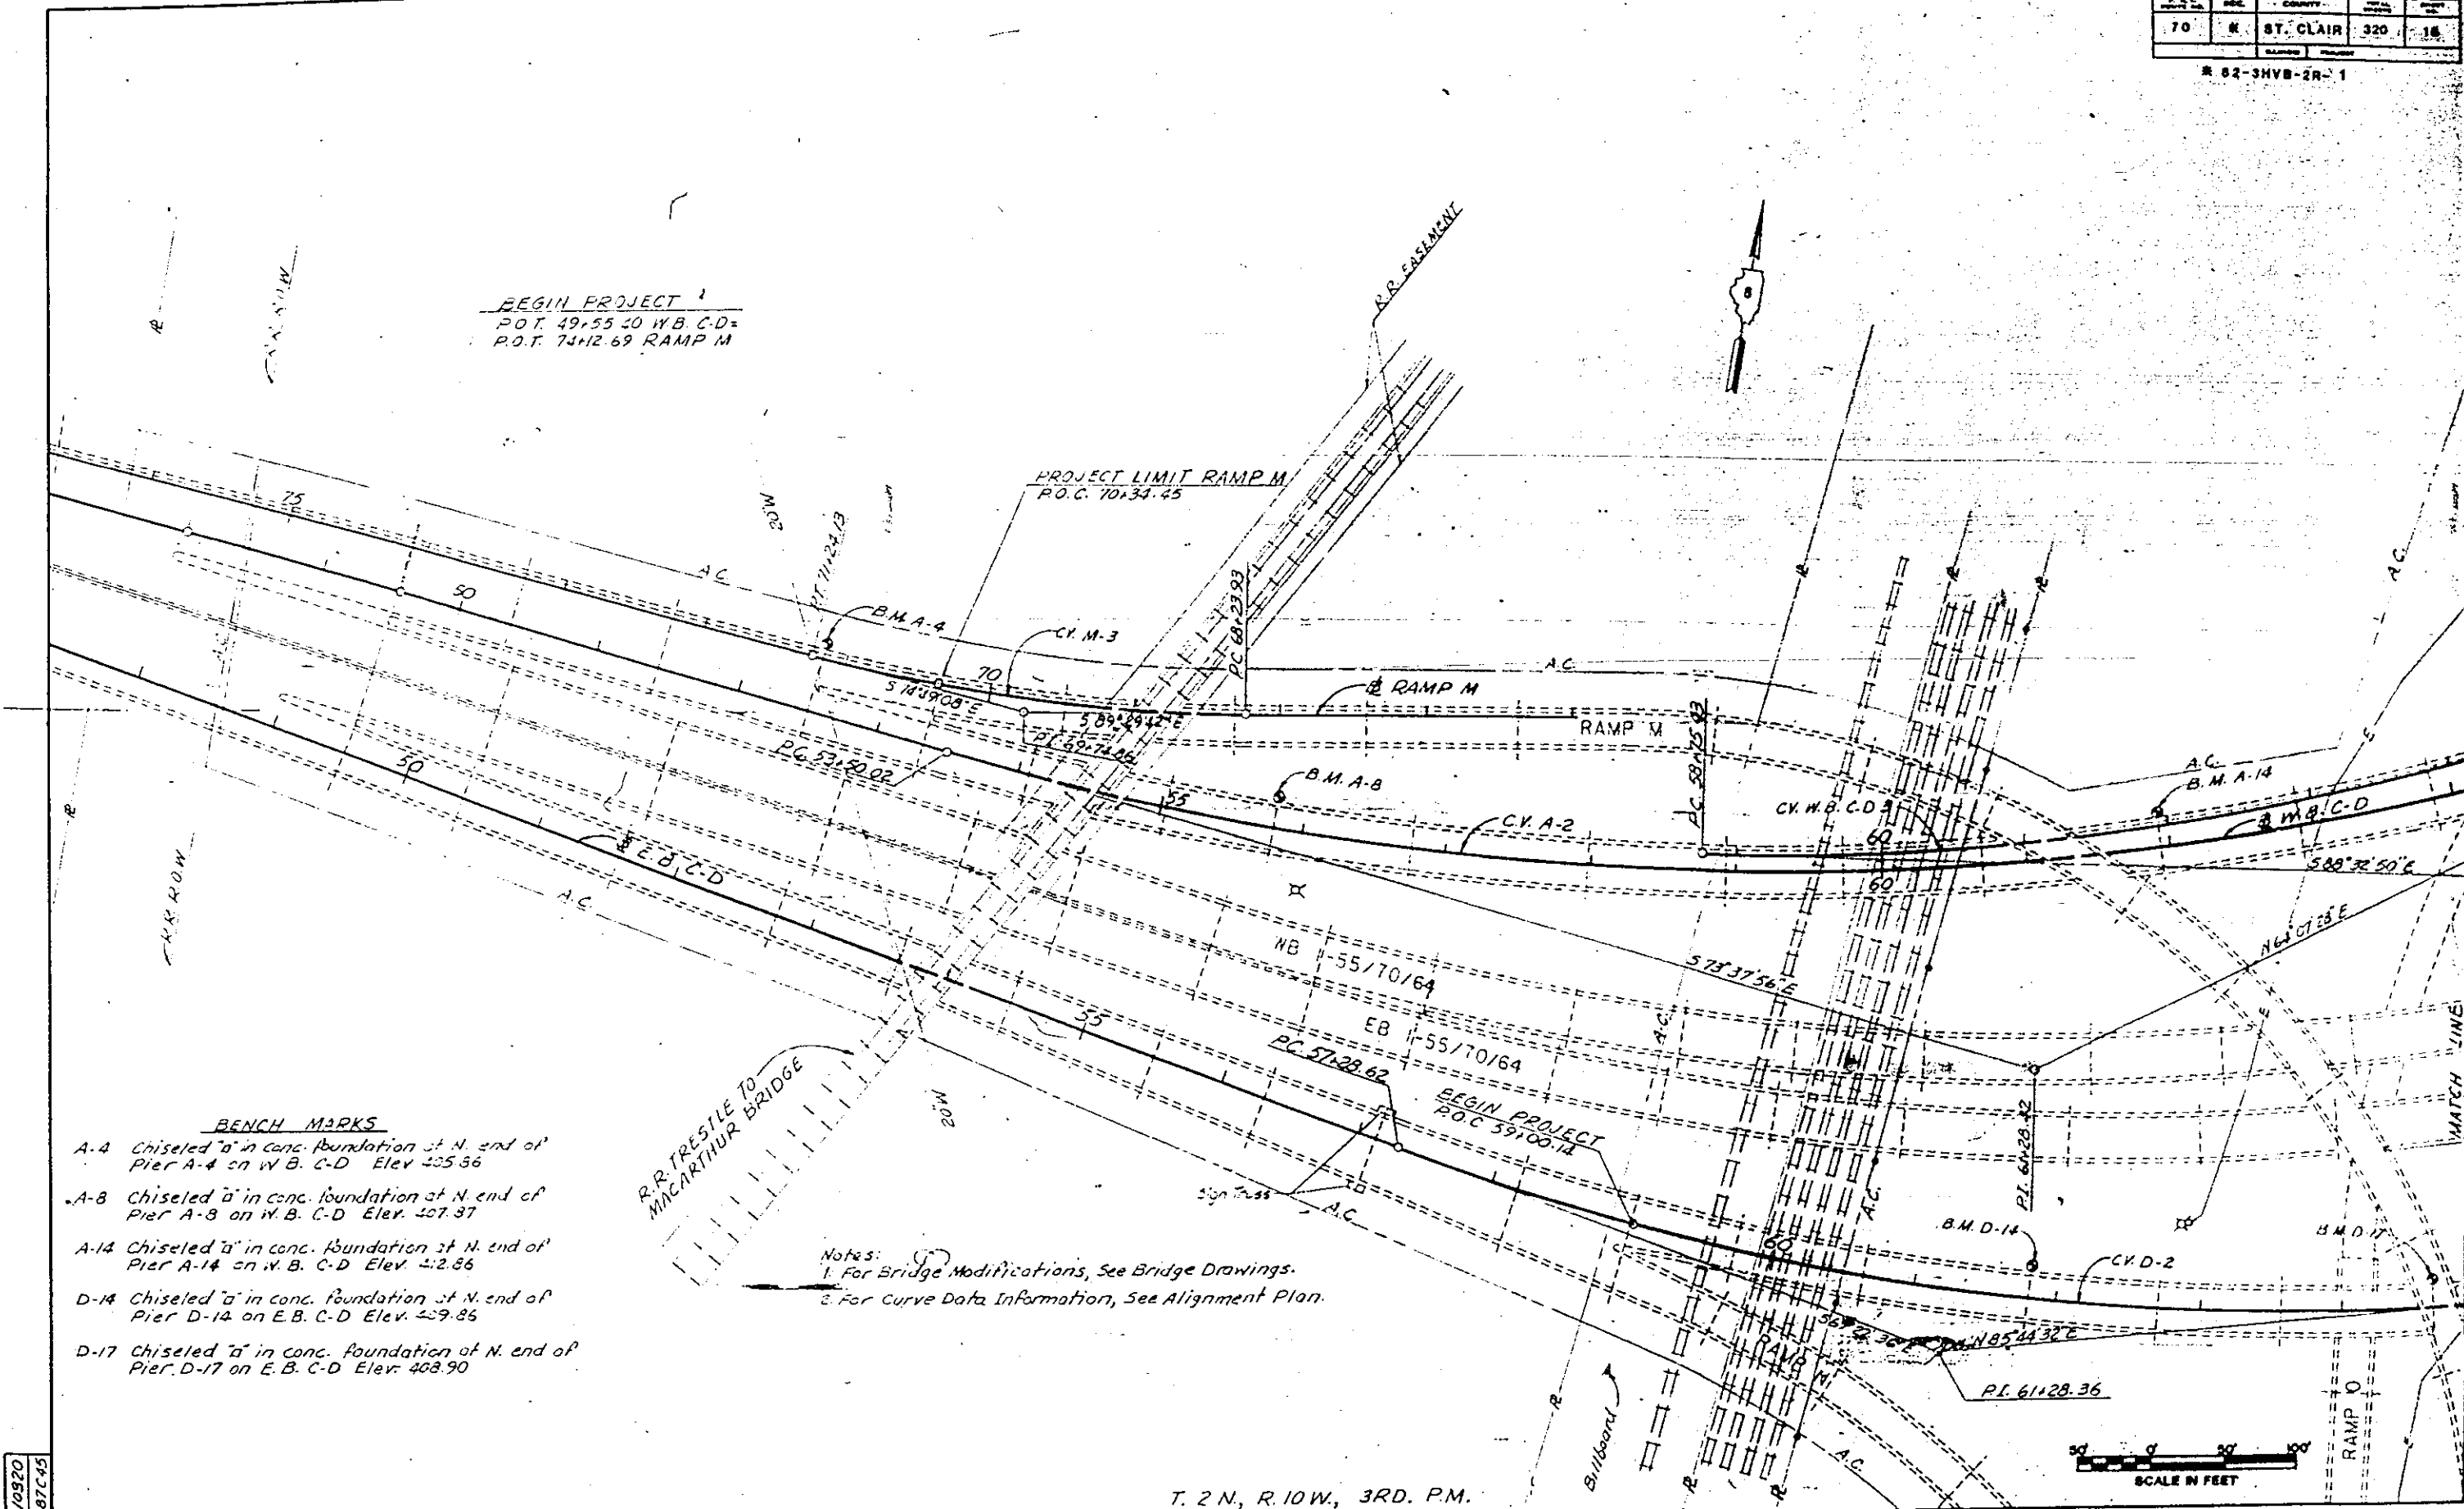

P.L.	MC.	CH.	PL.	ST.
70	ST. CLAIR	320	18	
82-3HVB-2R-1				

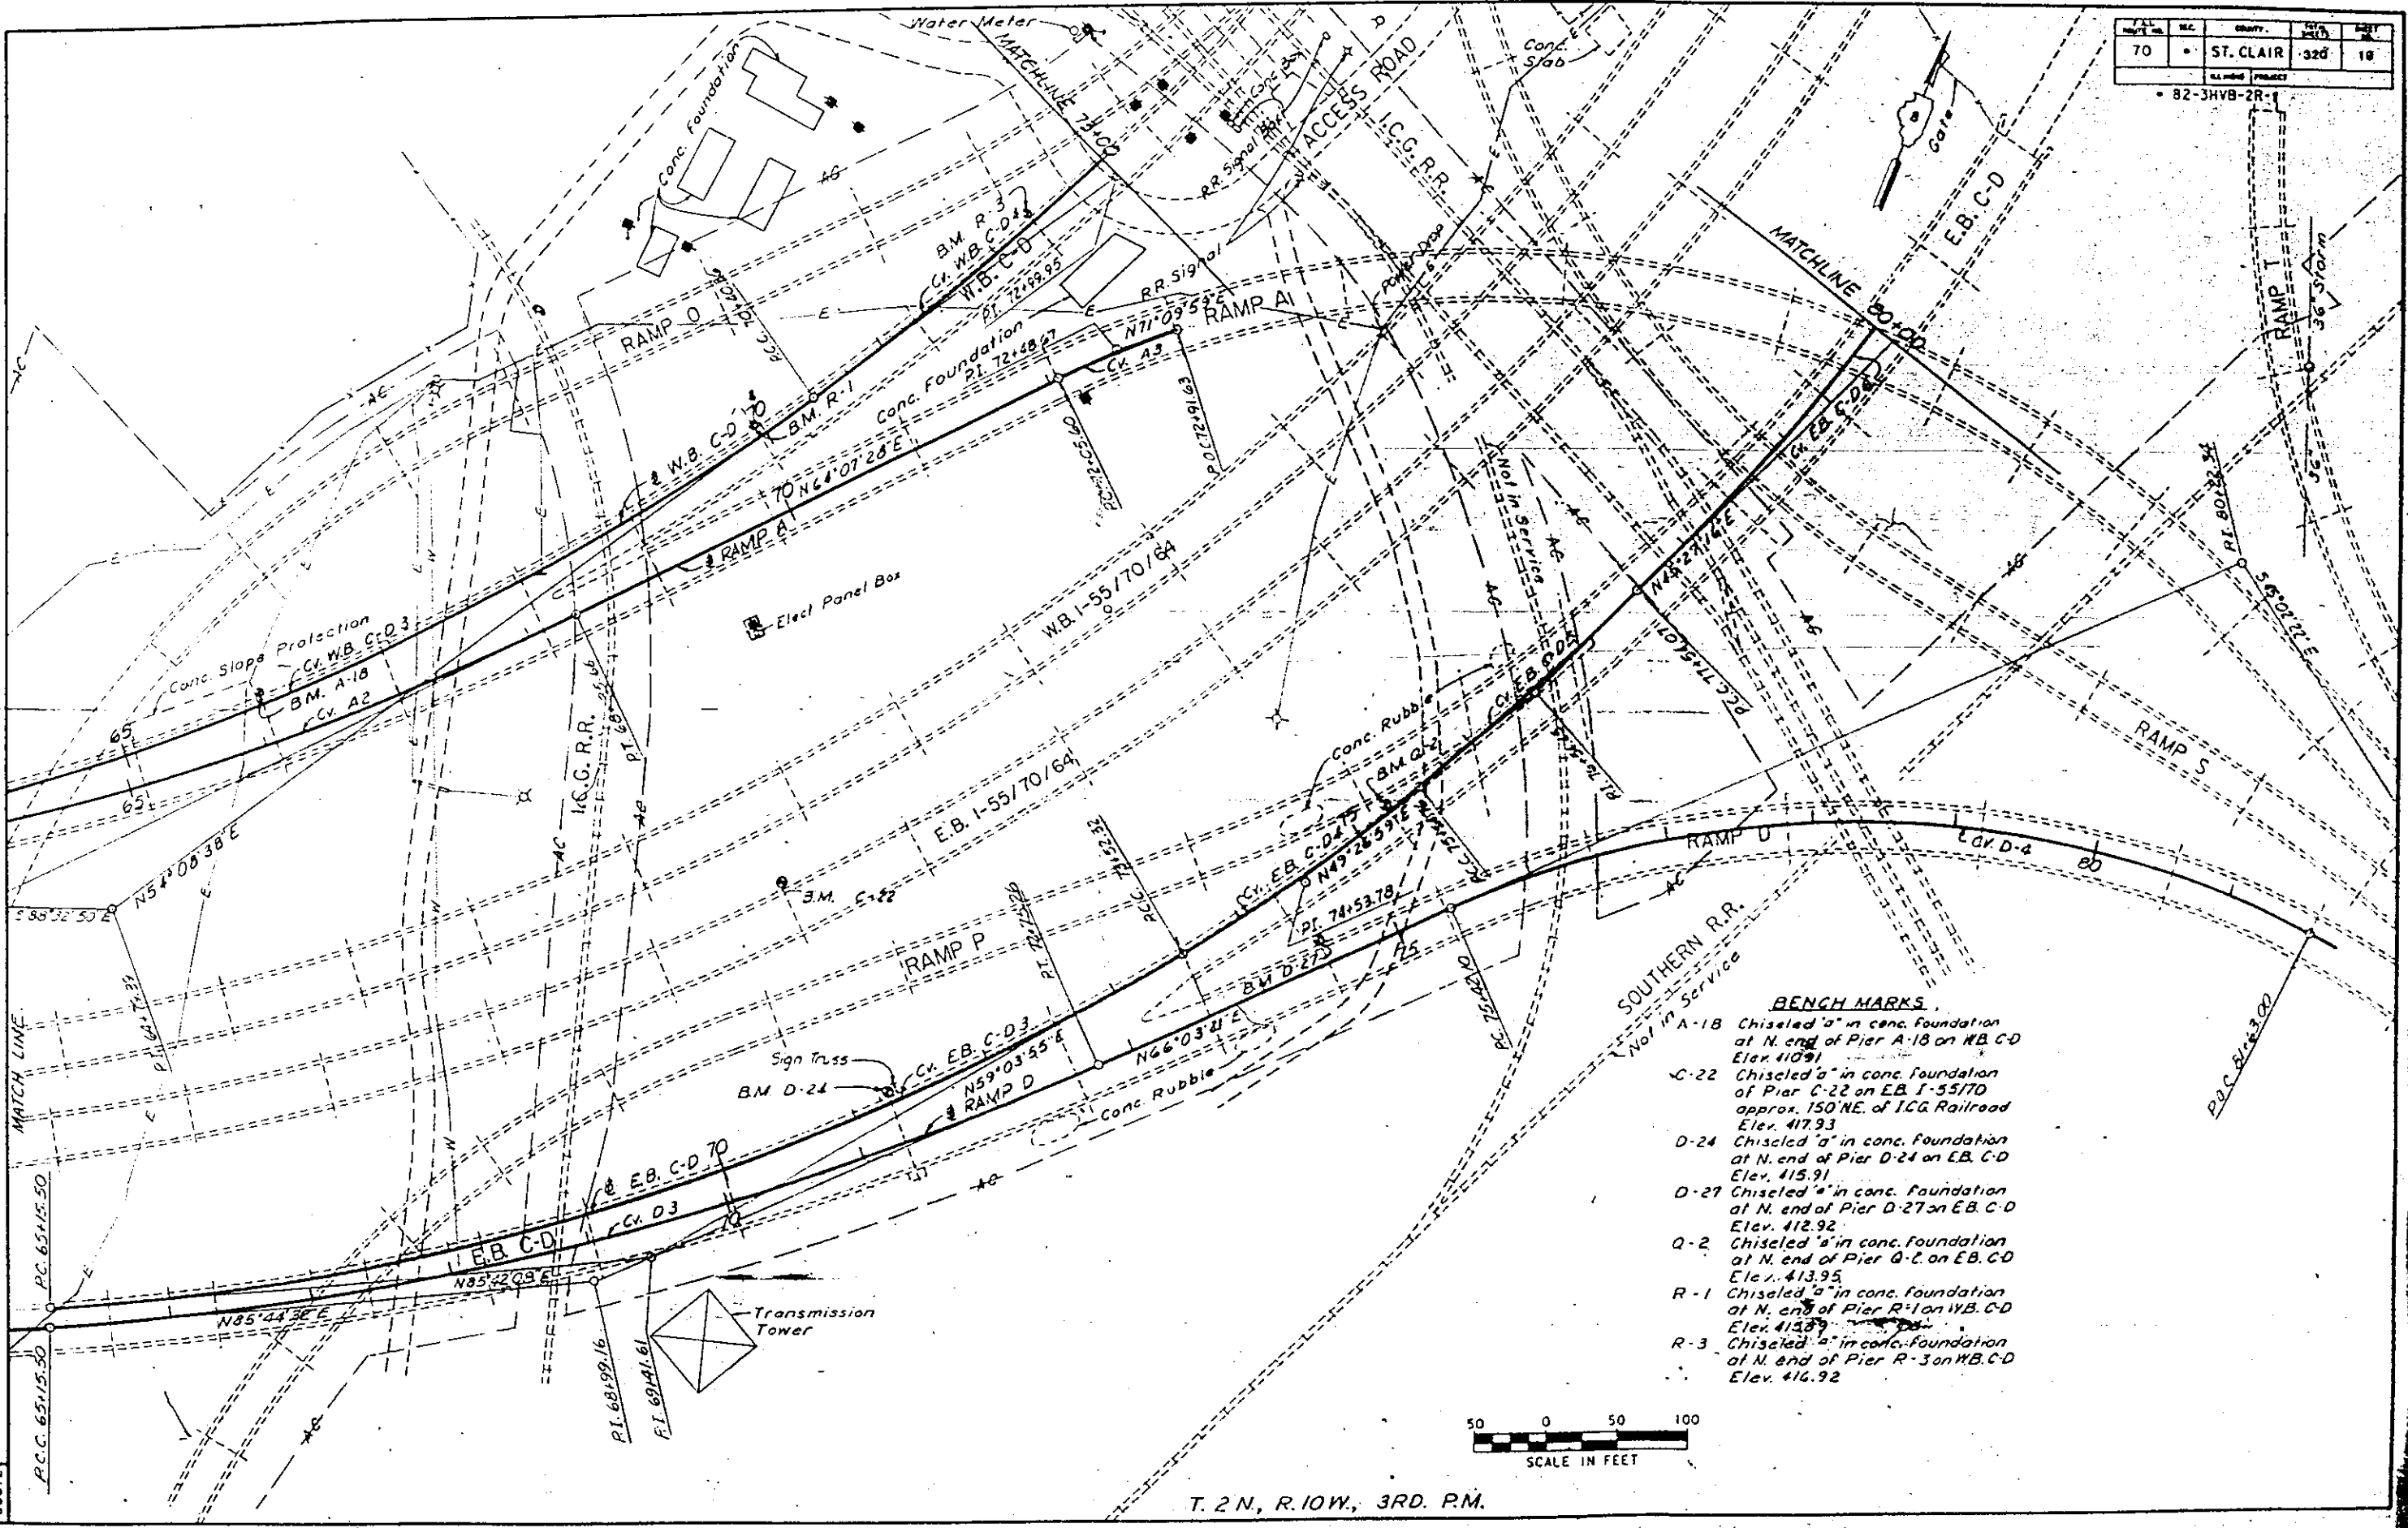

- BENCH MARKS.**
- A-18 Chiseled "a" in conc. foundation at N. end of Pier A-18 on WB. C-D Elev. 410.91
 - C-22 Chiseled "a" in conc. foundation of Pier C-22 on EB. 1-55/70 approx. 150' NE. of I.C.G. Railroad Elev. 417.93
 - D-24 Chiseled "a" in conc. foundation at N. end of Pier D-24 on EB. C-D Elev. 415.91
 - D-27 Chiseled "a" in conc. foundation at N. end of Pier D-27 on EB. C-D Elev. 412.92
 - Q-2 Chiseled "a" in conc. foundation at N. end of Pier Q-2 on EB. C-D Elev. 413.95
 - R-1 Chiseled "a" in conc. foundation of N. end of Pier R-1 on WB. C-D Elev. 415.89
 - R-3 Chiseled "a" in conc. foundation of N. end of Pier R-3 on WB. C-D Elev. 416.92




T. 2 N., R. 10 W., 3RD. P.M.

10136
86C72

P.L.	SEC.	QUART.	T.W.	RANGE
70	ST. CLAIR	320	20	
ALMERE PROJECT				
82-3HYB-2R-1				

BENCH MARKS


- S-12 Chiseled "a" on Concrete Foundation at Pier S-11 about 10' E. of W.B. C-D. Elev. 419.37
- B Chiseled "a" in Concrete at end of E. Wingwall on EB. I-55/70 Bridge about 400' S. of Trendley Ave. Elev. 447.80
- E Chiseled "a" in Concrete at end of N.W. Wingwall on EB. C-D Bridge over Trendley Ave. Elev. 433.97
- I Chiseled "L" on Concrete Foundation at Pier # 3 on EB. C-D Bridge over Trendley Ave. Elev. 415.15
- S-5 Chiseled "a" on Concrete Foundation at S. end of Pier S-5 about 50' S. of Trendley Ave. Elev. 415.89

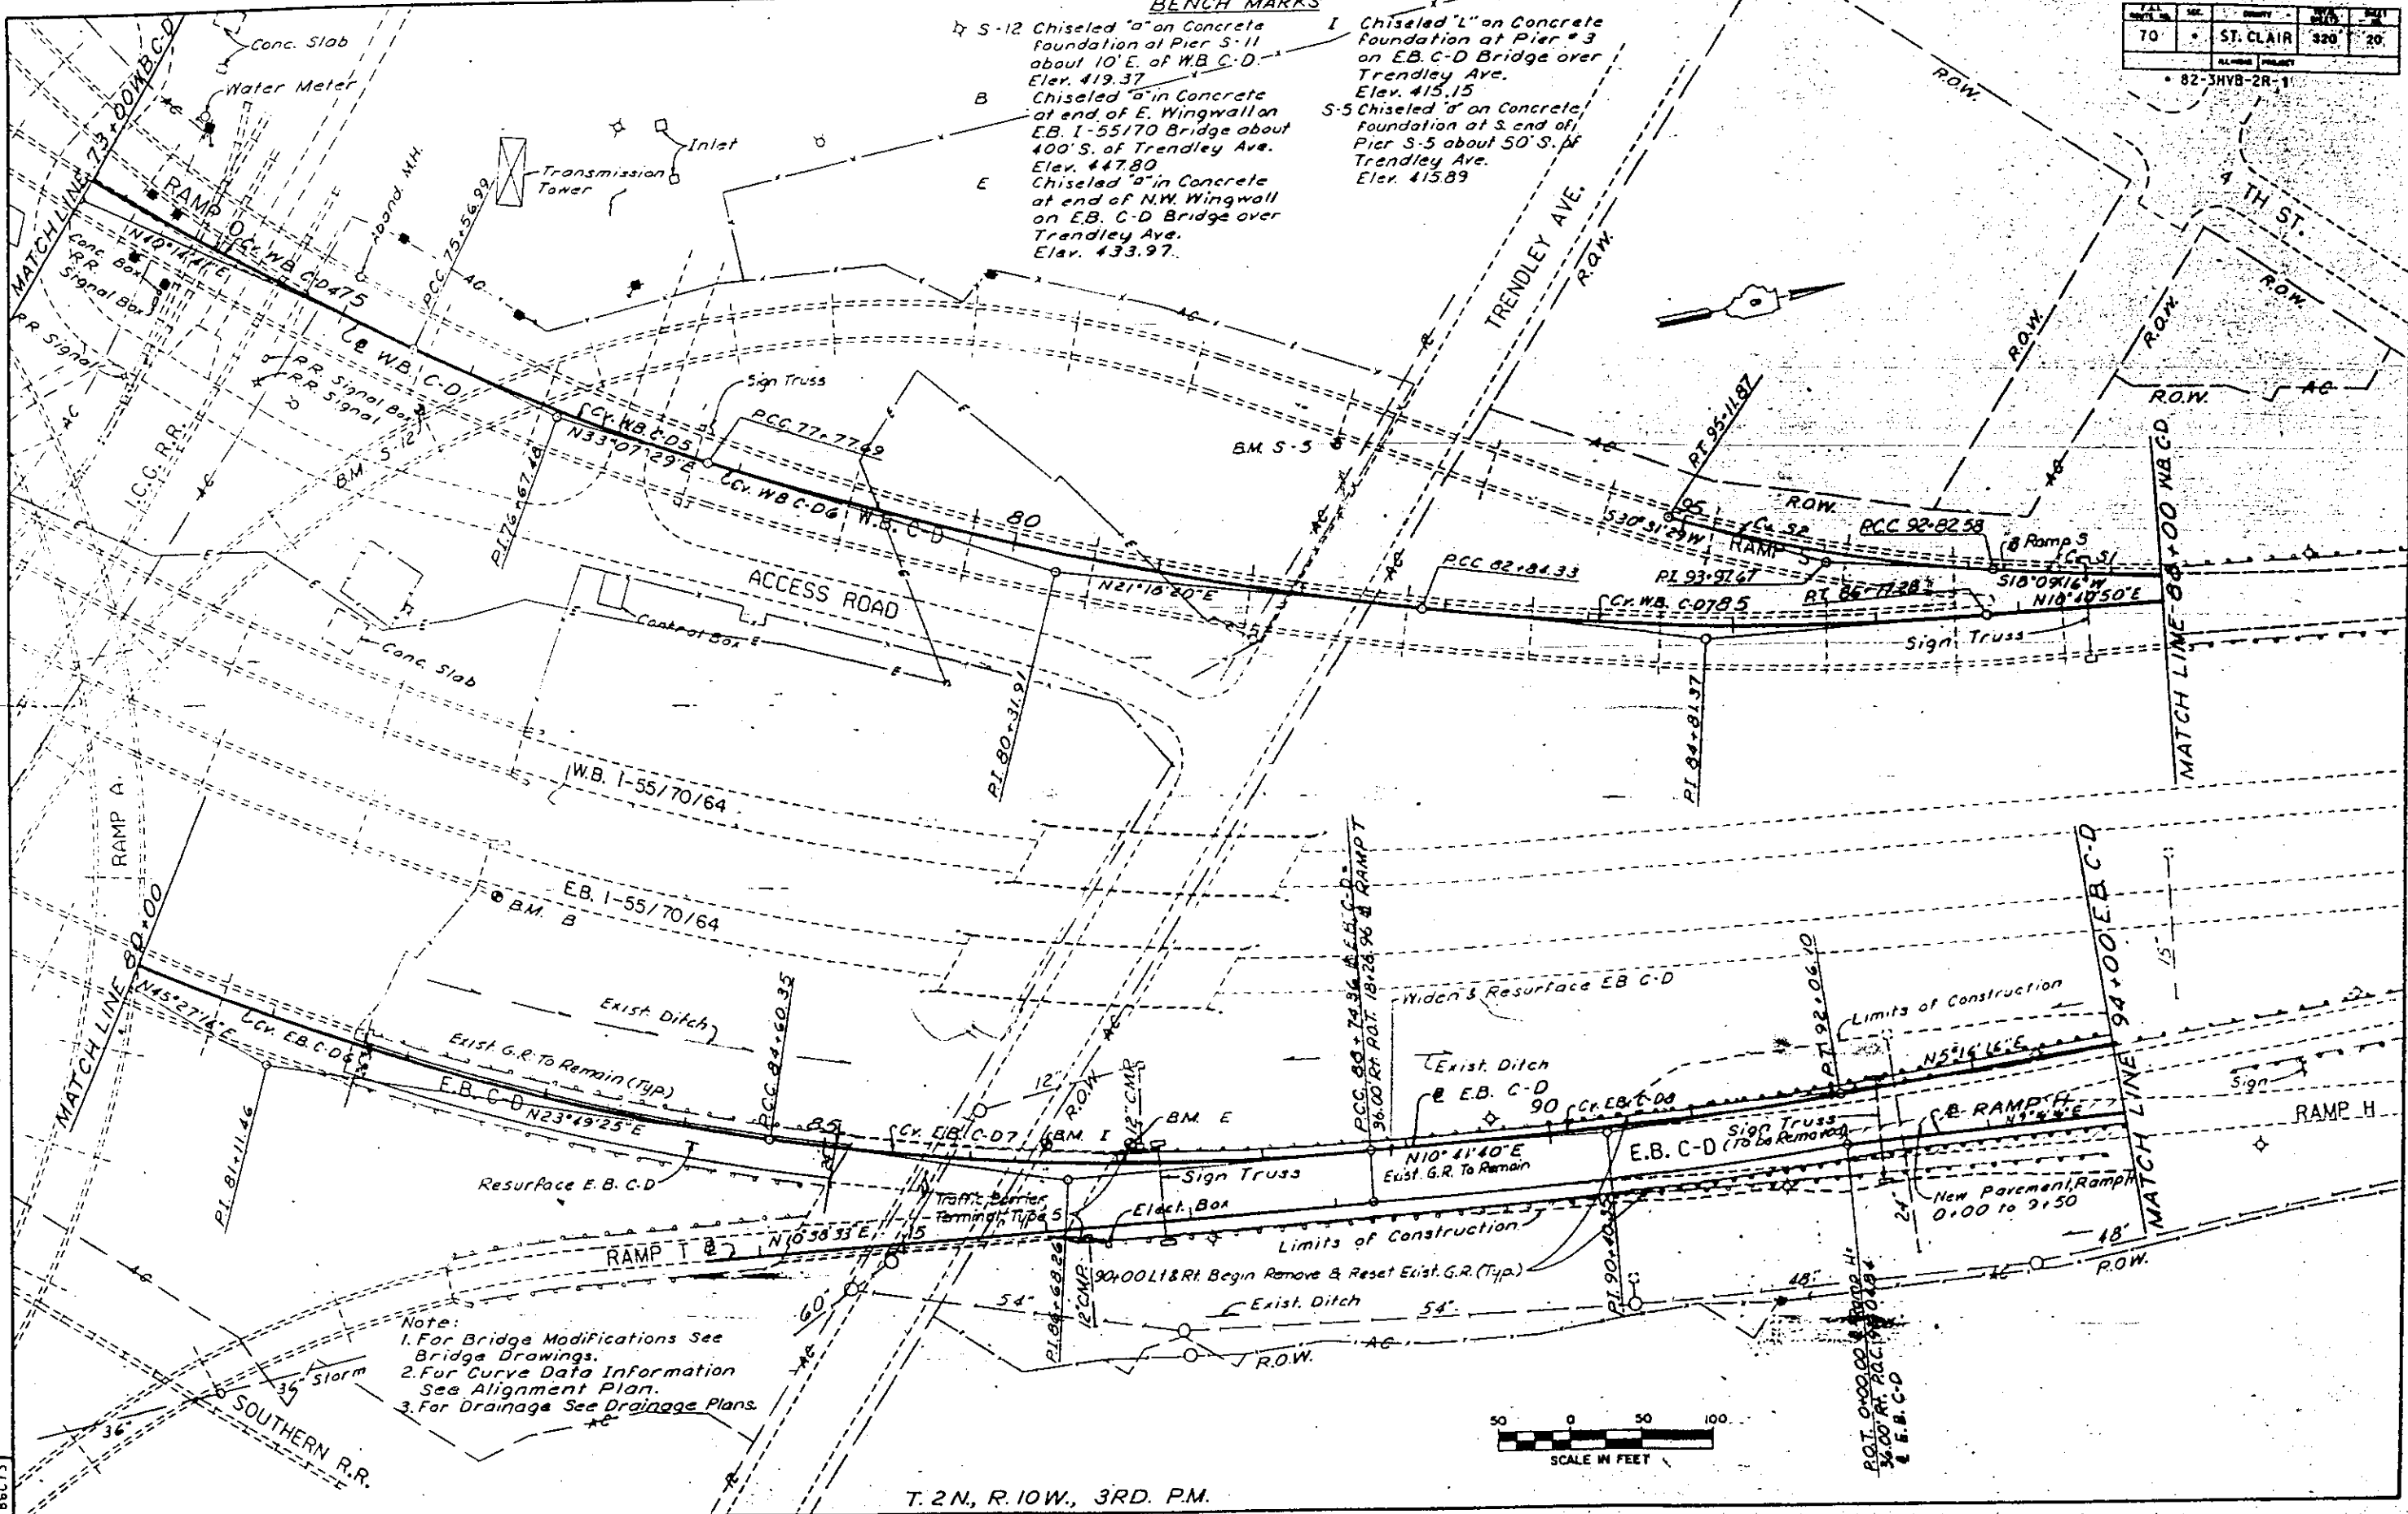

Note:
 1. For Bridge Modifications See Bridge Drawings.
 2. For Curve Data Information See Alignment Plan.
 3. For Drainage See Drainage Plans.

T. 2 N., R. 10 W., 3RD. P.M.

10136
86C73

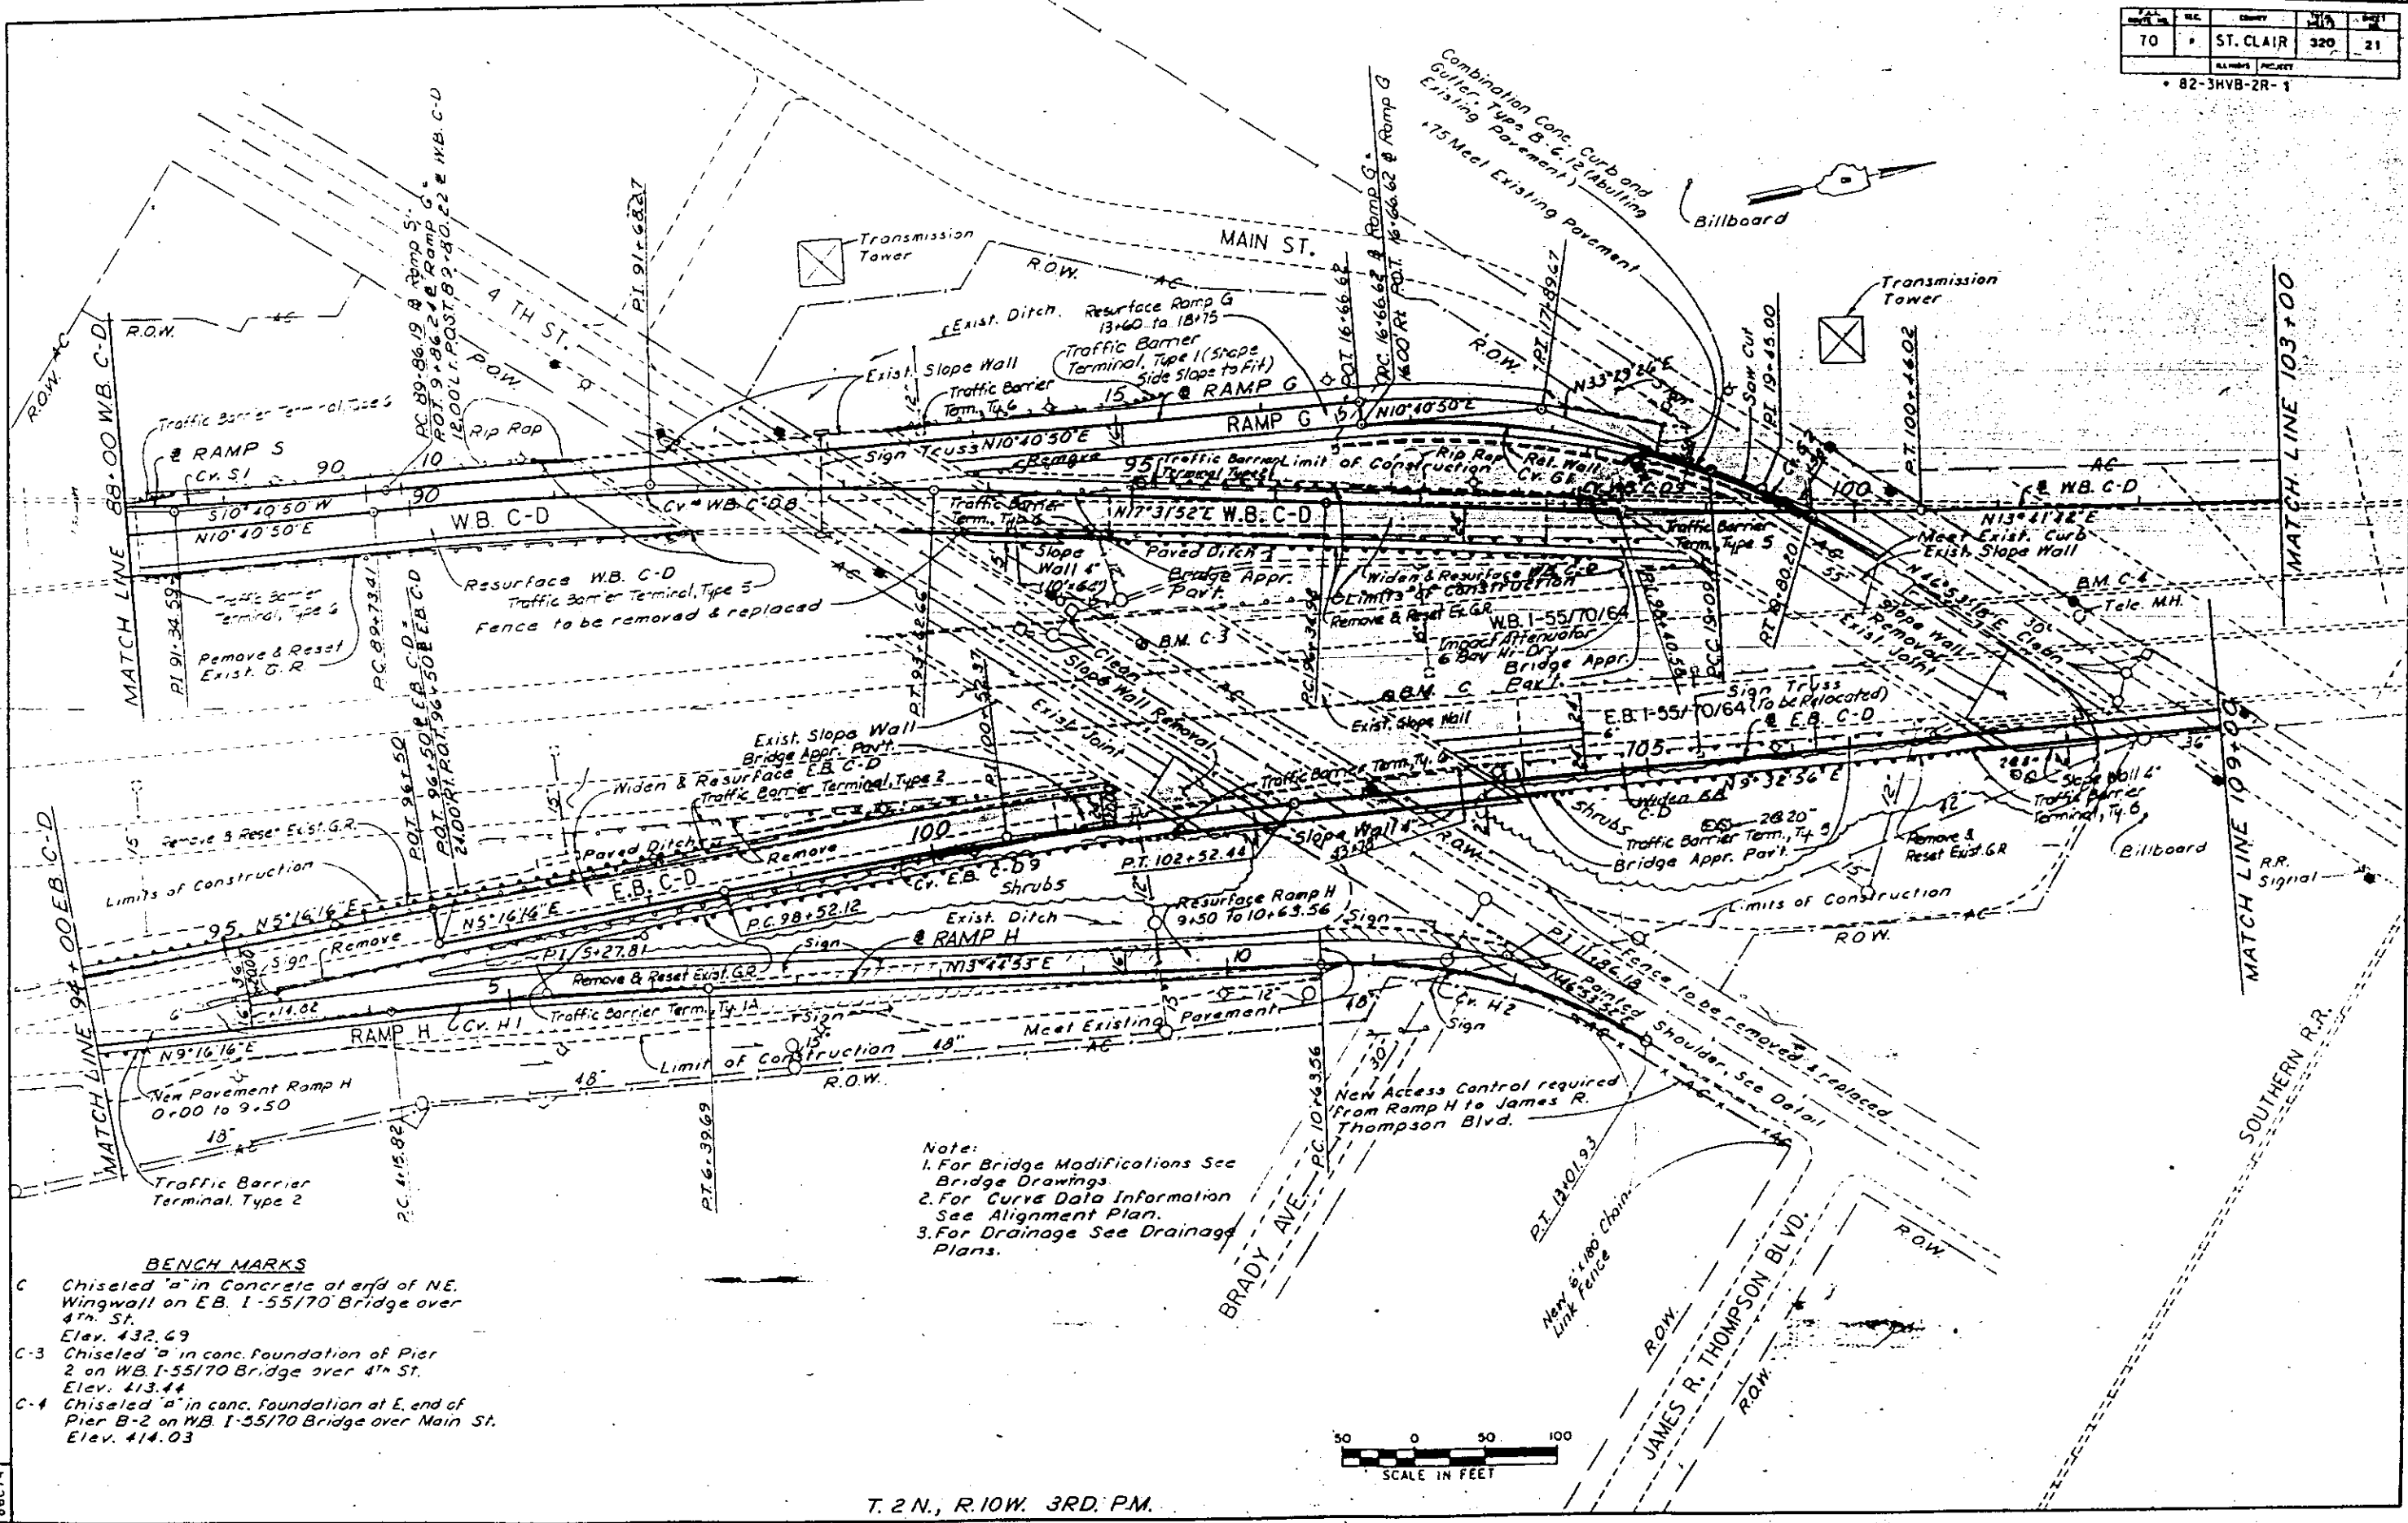

Note:
 1. For Bridge Modifications See Bridge Drawings
 2. For Curve Data Information See Alignment Plan.
 3. For Drainage See Drainage Plans.

BENCH MARKS


- C Chiseled "a" in Concrete at end of NE. Wingwall on E.B. I-55/70 Bridge over 4th St. Elev. 432.69
- C-3 Chiseled "a" in conc. foundation of Pier 2 on WB. I-55/70 Bridge over 4th St. Elev. 413.44
- C-4 Chiseled "a" in conc. foundation at E. end of Pier B-2 on WB. I-55/70 Bridge over Main St. Elev. 414.03

T. 2 N., R. 10 W. 3RD. PM.

10136
86C74

VAL	REV	DATE	BY	CHK
70			ST. CLAIR	320
PROJECT		82-3HVB-2R-1		

BENCH MARKS
 D-1 Chiseled "a" in concrete at end of NW. Wingwall on EB. I-55/70 Bridge over Broadway.
 Elev. 437.16
 J 100p. Spike in Power Pole along S. side of Broadway 90' E. of Pair C-9 at EB. I-55/70 Bridge over Broadway.
 Elev. 416.54

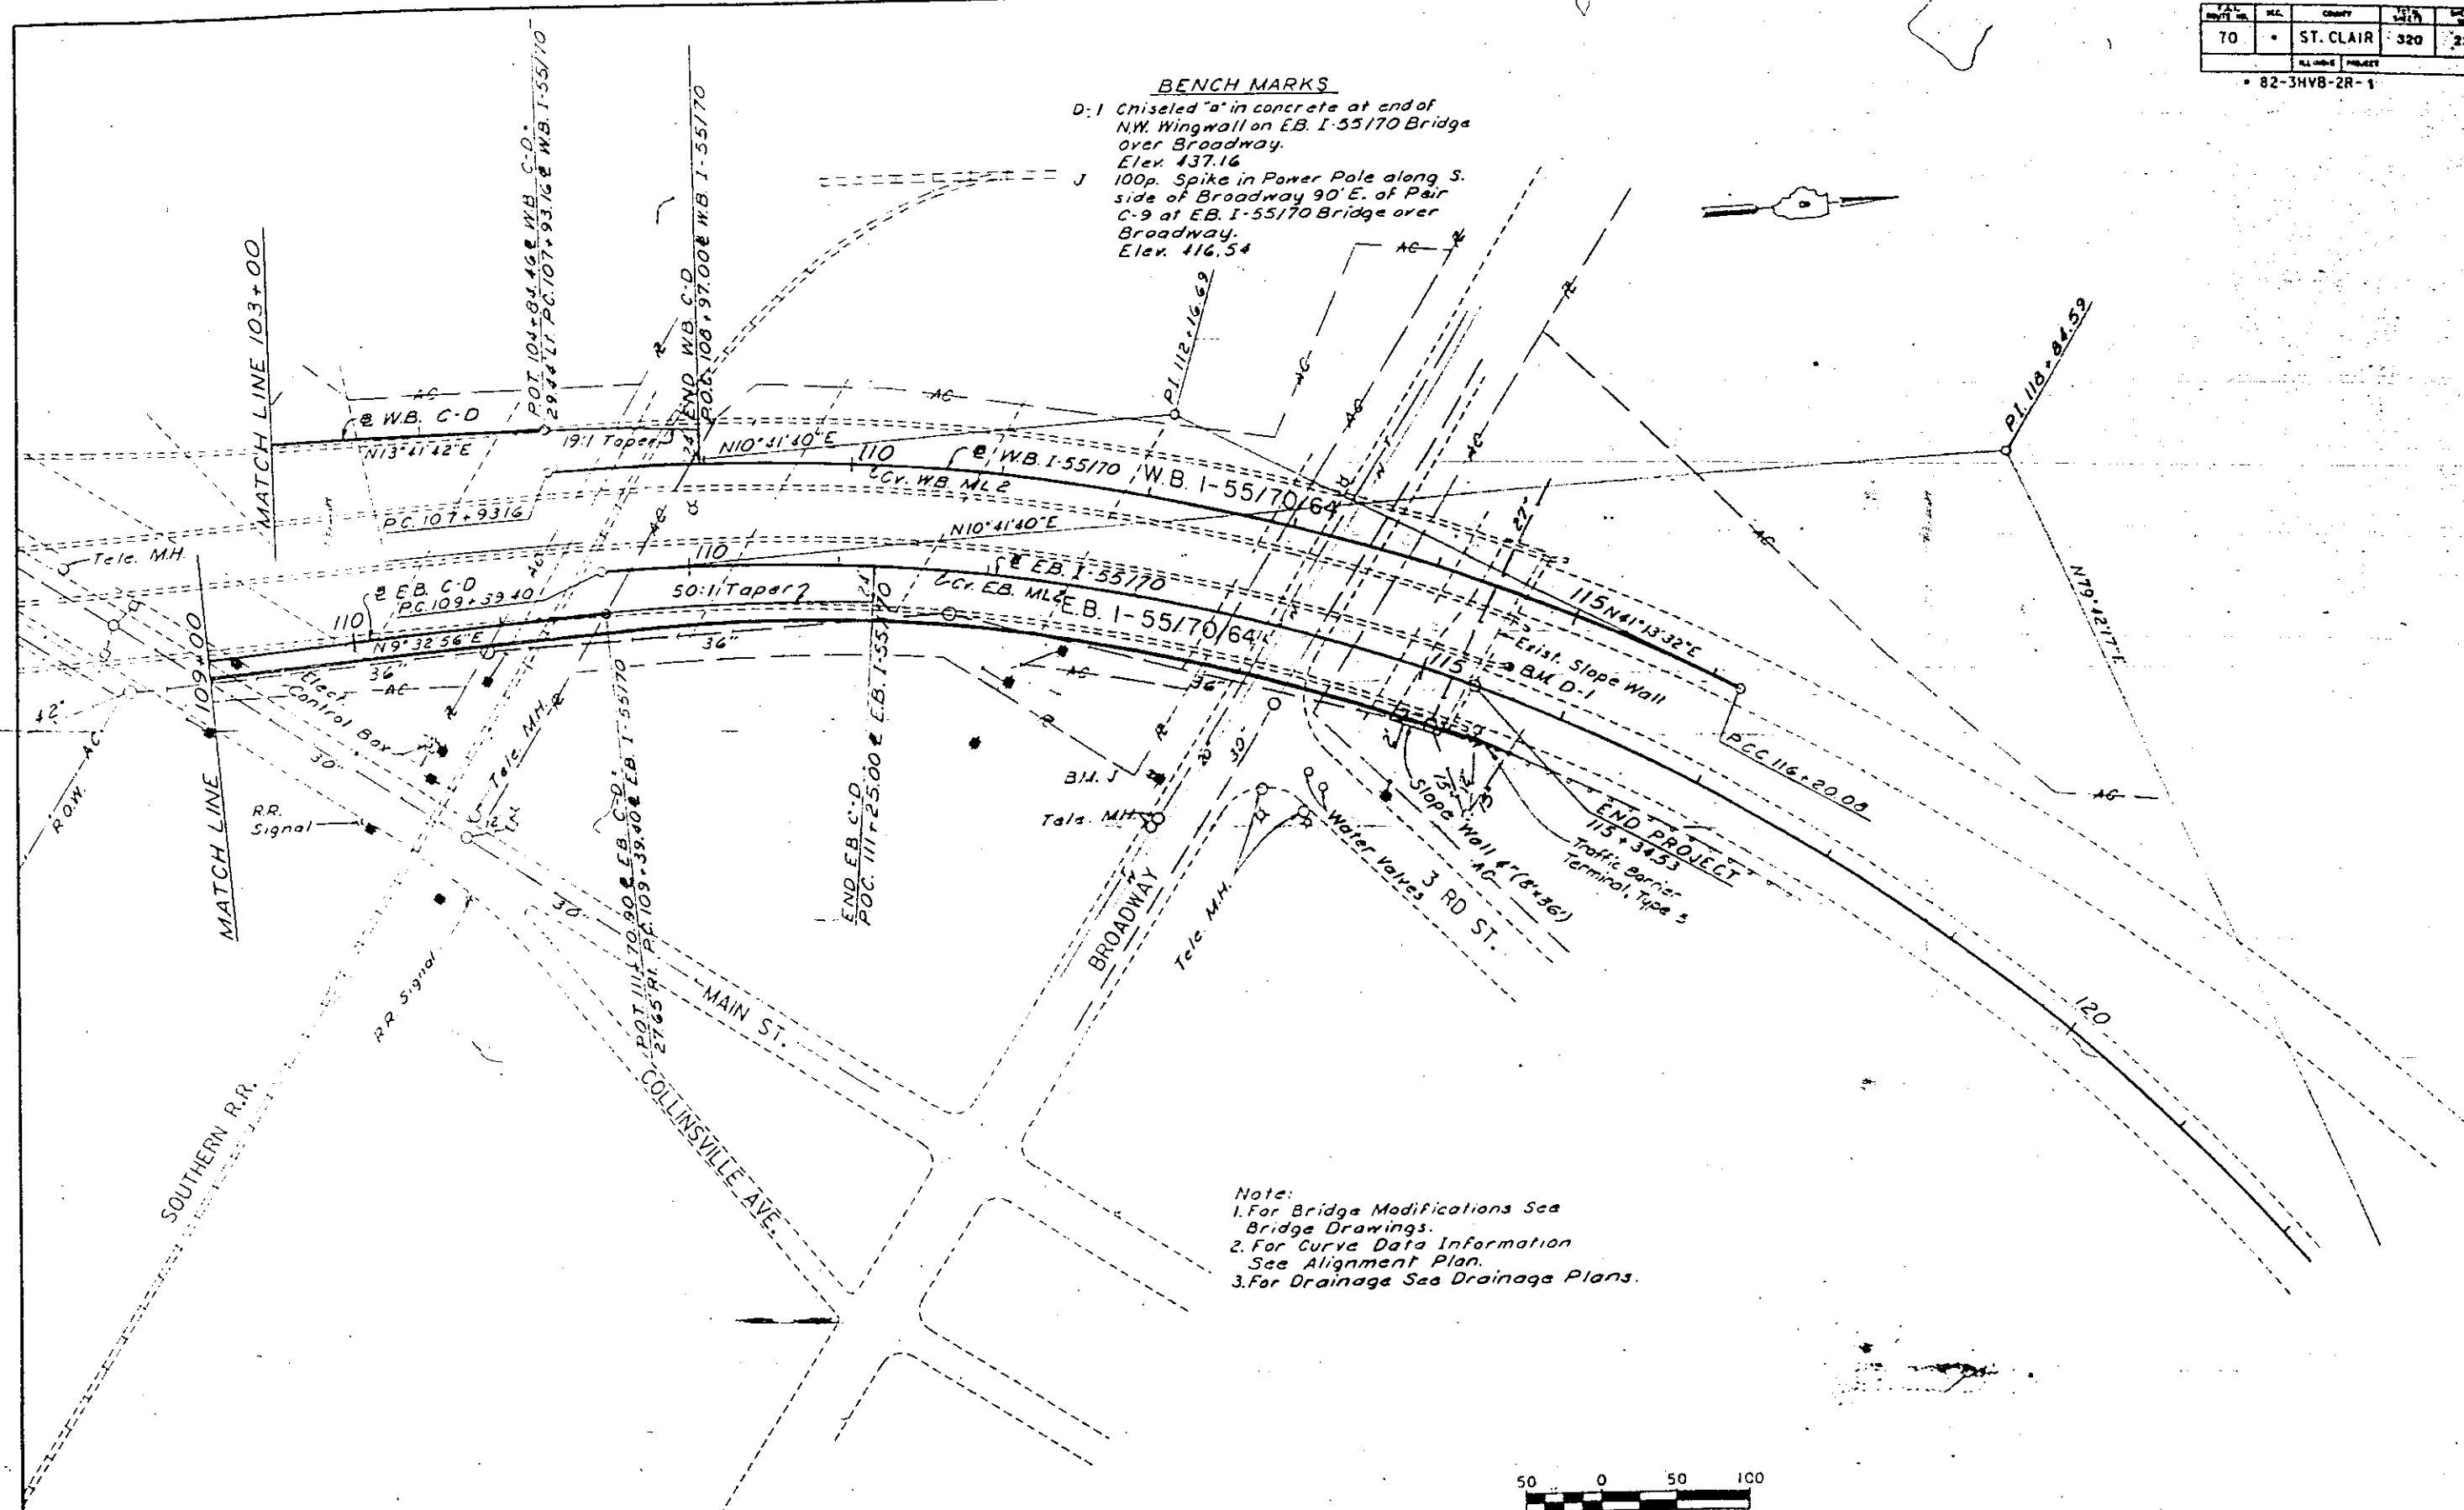

Note:
 1. For Bridge Modifications See Bridge Drawings.
 2. For Curve Data Information See Alignment Plan.
 3. For Drainage See Drainage Plans.




T.2 N., R.10W., 3RD. P.M.

10136
86C75

70	ST. CLAIR	320	33
PROJECT		PROJECT	

82-3HVB-2R-1

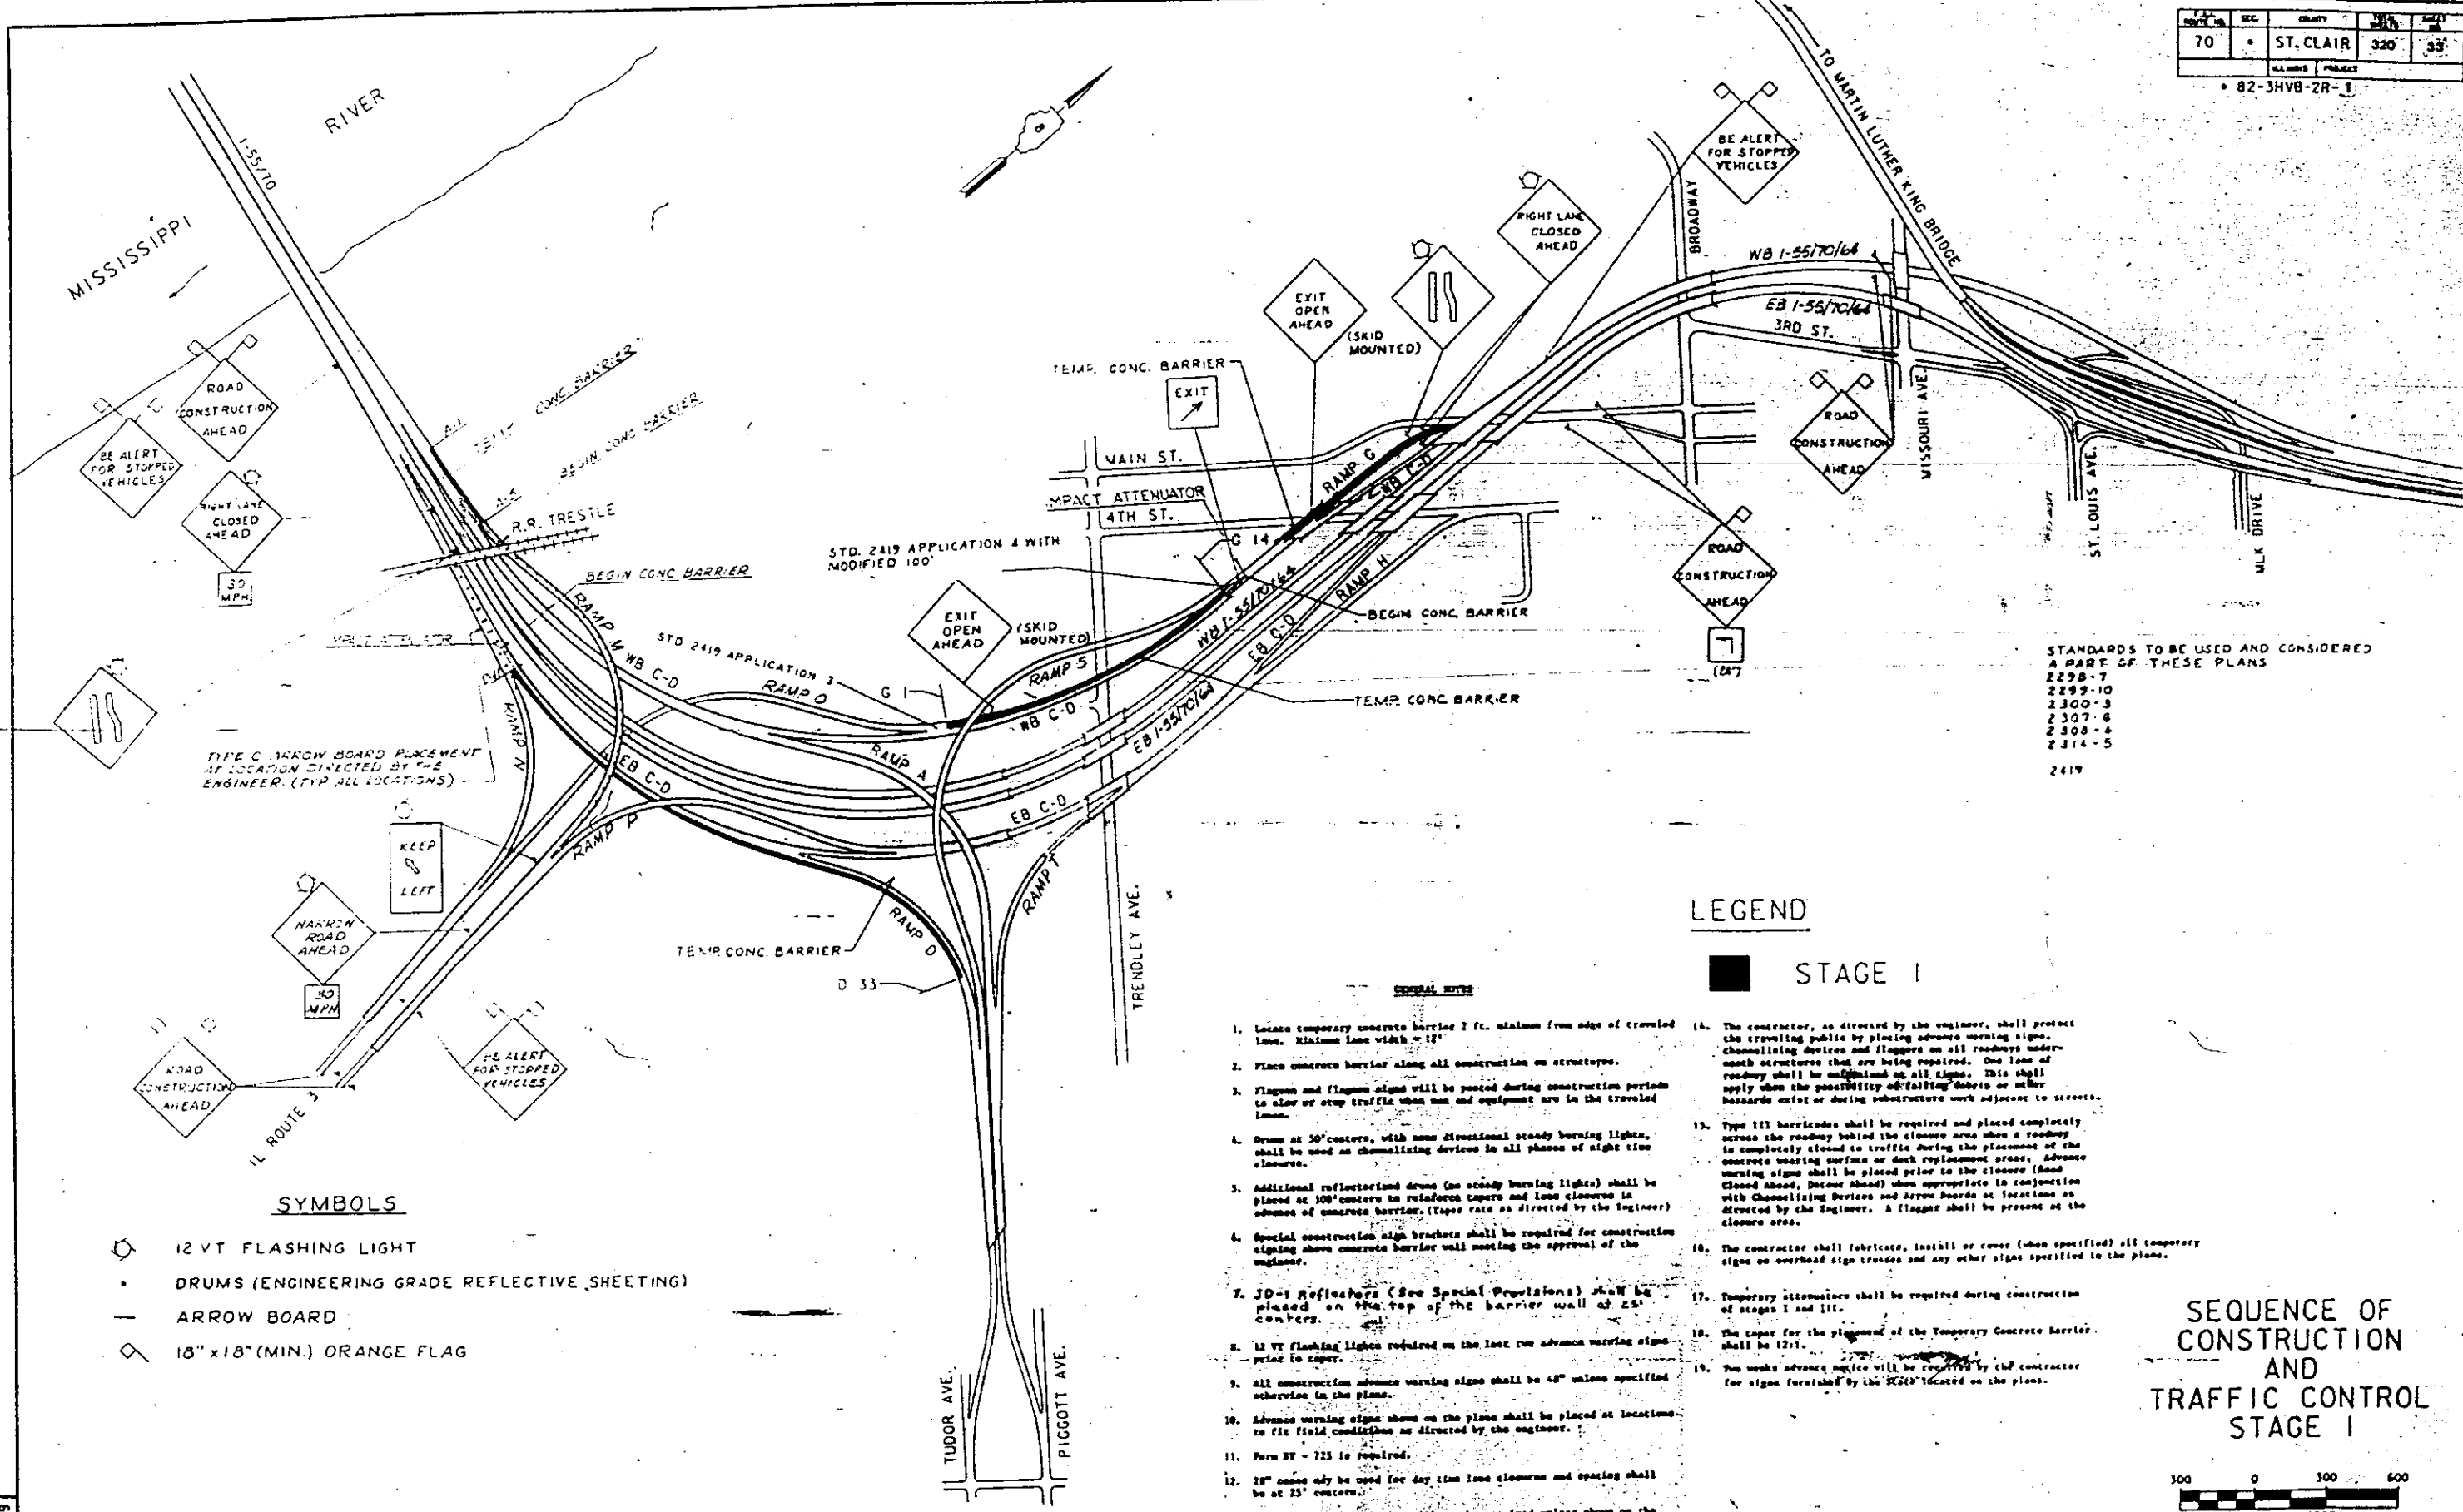

STANDARDS TO BE USED AND CONSIDERED A PART OF THESE PLANS
 2298-7
 2299-10
 2300-3
 2307-6
 2508-4
 2514-5
 2419

TYPE C ARROW BOARD PLACEMENT AT LOCATION DIRECTED BY THE ENGINEER. (FYP ALL LOCATIONS)

SYMBOLS


- ◊ 12 VT FLASHING LIGHT
- DRUMS (ENGINEERING GRADE REFLECTIVE SHEETING)
- ARROW BOARD
- ◊ 15" x 18" (MIN.) ORANGE FLAG

LEGEND

■ STAGE I


1. Locate temporary concrete barrier 2 ft. minimum from edge of traveled lane. Minimum lane width - 12'
2. Place concrete barrier along all construction on structures.
3. Flagmen and flagmen signs will be posted during construction periods to slow or stop traffic when men and equipment are in the traveled lanes.
4. Drums at 50' centers, with non directional steady burning lights, shall be used as channelizing devices in all phases of night time closures.
5. Additional reflectorized drums (no steady burning lights) shall be placed at 100' centers to reinforce tapers and lane closures in advance of concrete barrier. (Taper rate as directed by the engineer)
6. Special construction sign brackets shall be required for construction signing above concrete barrier wall meeting the approval of the engineer.
7. JD-1 Reflectors (See Special Provisions) shall be placed on the top of the barrier wall at 25' centers.
8. 12 VT flashing lights required on the last two advance warning signs prior to taper.
9. All construction advance warning signs shall be 48" unless specified otherwise in the plans.
10. Advance warning signs shown on the plans shall be placed at locations to fit field conditions as directed by the engineer.
11. Form ST-725 is required.
12. 28" cones may be used for day time lane closures and spacing shall be at 25' centers.
13. Dual construction signing will not be required unless shown on the plans.
14. The contractor, as directed by the engineer, shall protect the traveling public by placing advance warning signs, channelizing devices and flaggers on all roadways underneath structures that are being repaired. One lane of roadway shall be maintained at all times. This shall apply when the possibility of falling debris or other hazards exist or during substructure work adjacent to streets.
15. Type III barricades shall be required and placed completely across the roadway behind the closure area when a roadway is completely closed to traffic during the placement of the concrete wearing surface or deck replacement areas. Advance warning signs shall be placed prior to the closure (Road Closed Ahead, Detour Ahead) when appropriate in conjunction with Channelizing Devices and Arrow Boards at locations as directed by the Engineer. A flagger shall be present at the closure area.
16. The contractor shall fabricate, install or cover (when specified) all temporary signs on overhead sign trusses and any other signs specified in the plans.
17. Temporary attenuators shall be required during construction of stages I and III.
18. The taper for the placement of the Temporary Concrete Barrier shall be 12:1.
19. Two weeks advance notice will be required by the contractor for signs furnished by the STATE located on the plans.

SEQUENCE OF CONSTRUCTION AND TRAFFIC CONTROL STAGE I

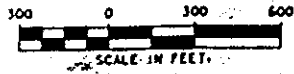

Rev. 11-78-88

10136
86669

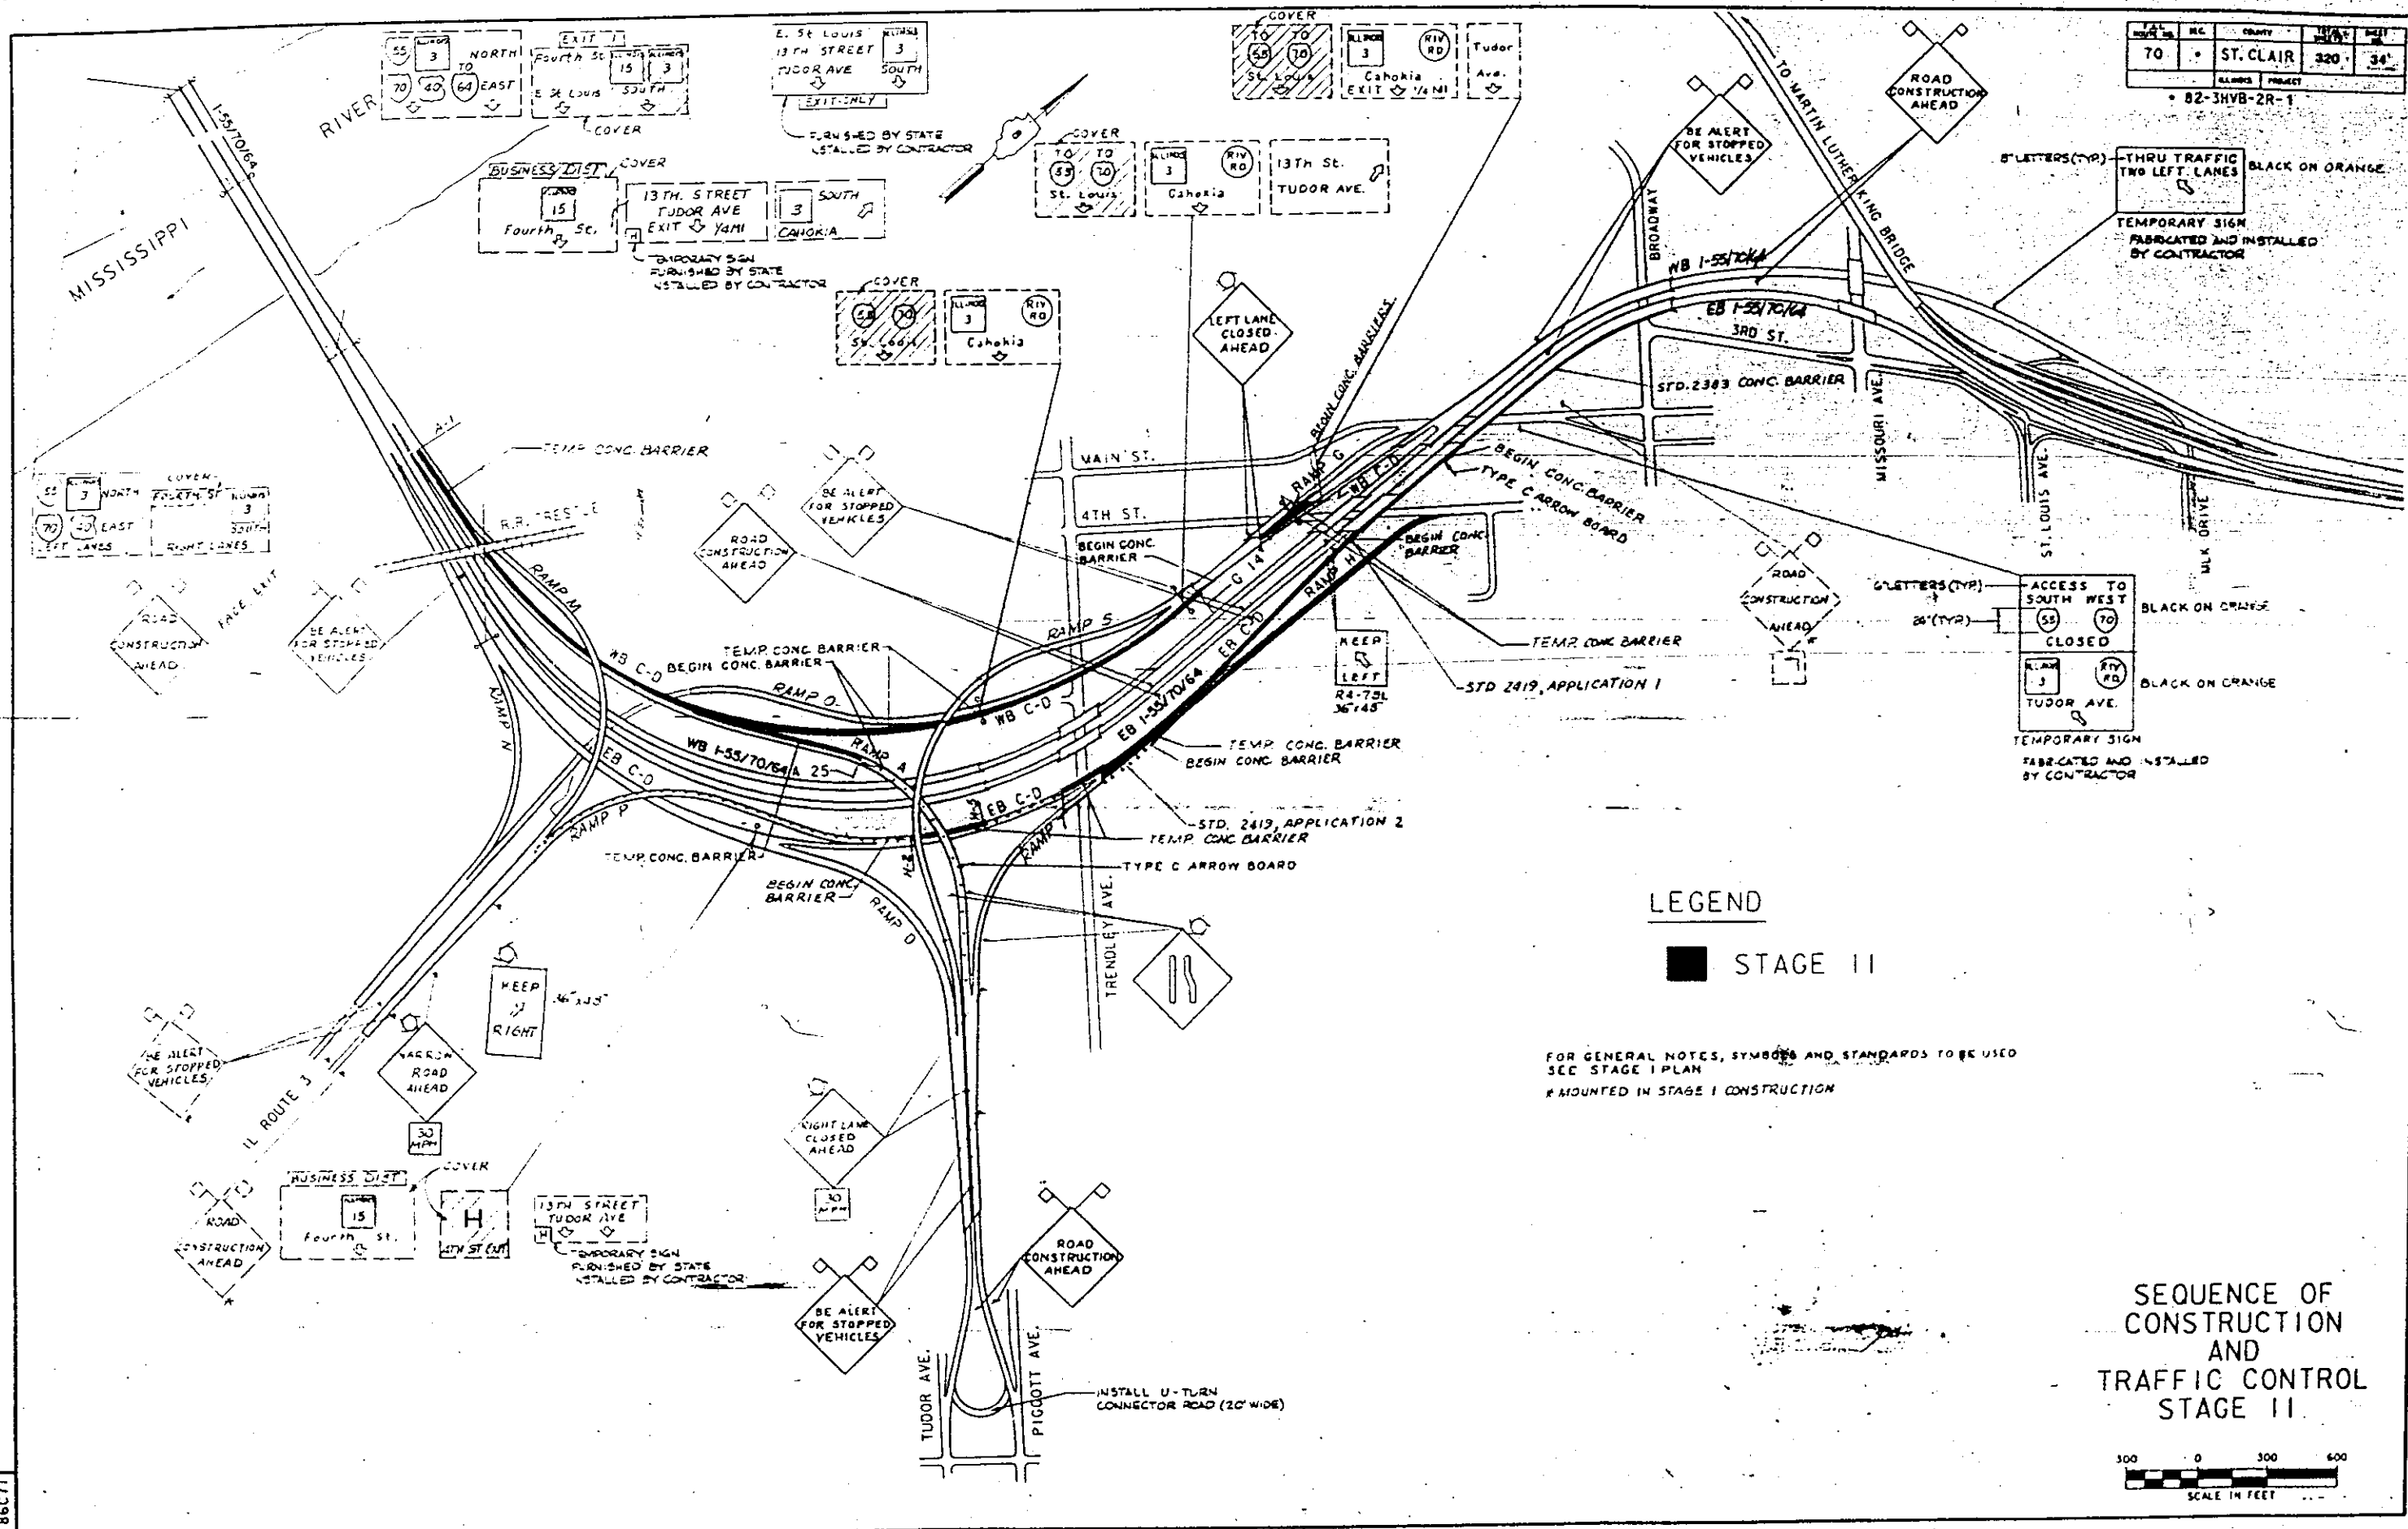


STATE	HC	COUNTY	TRACT	SECTION
70		ST. CLAIR	320	34
ALWAYS PROJECT		82-3HVB-2R-1		

LEGEND

■ STAGE II


FOR GENERAL NOTES, SYMBOLS AND STANDARDS TO BE USED SEE STAGE I PLAN
 * MOUNTED IN STAGE I CONSTRUCTION

SEQUENCE OF CONSTRUCTION AND TRAFFIC CONTROL STAGE II

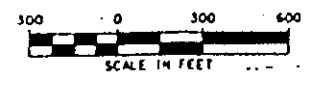

10136
86C71

PLAN NO.	70	SHEET NO.	320	DATE	36
PROJECT	ST. CLAIR				
CONTRACT NO.	82-3HYB-2R-1				

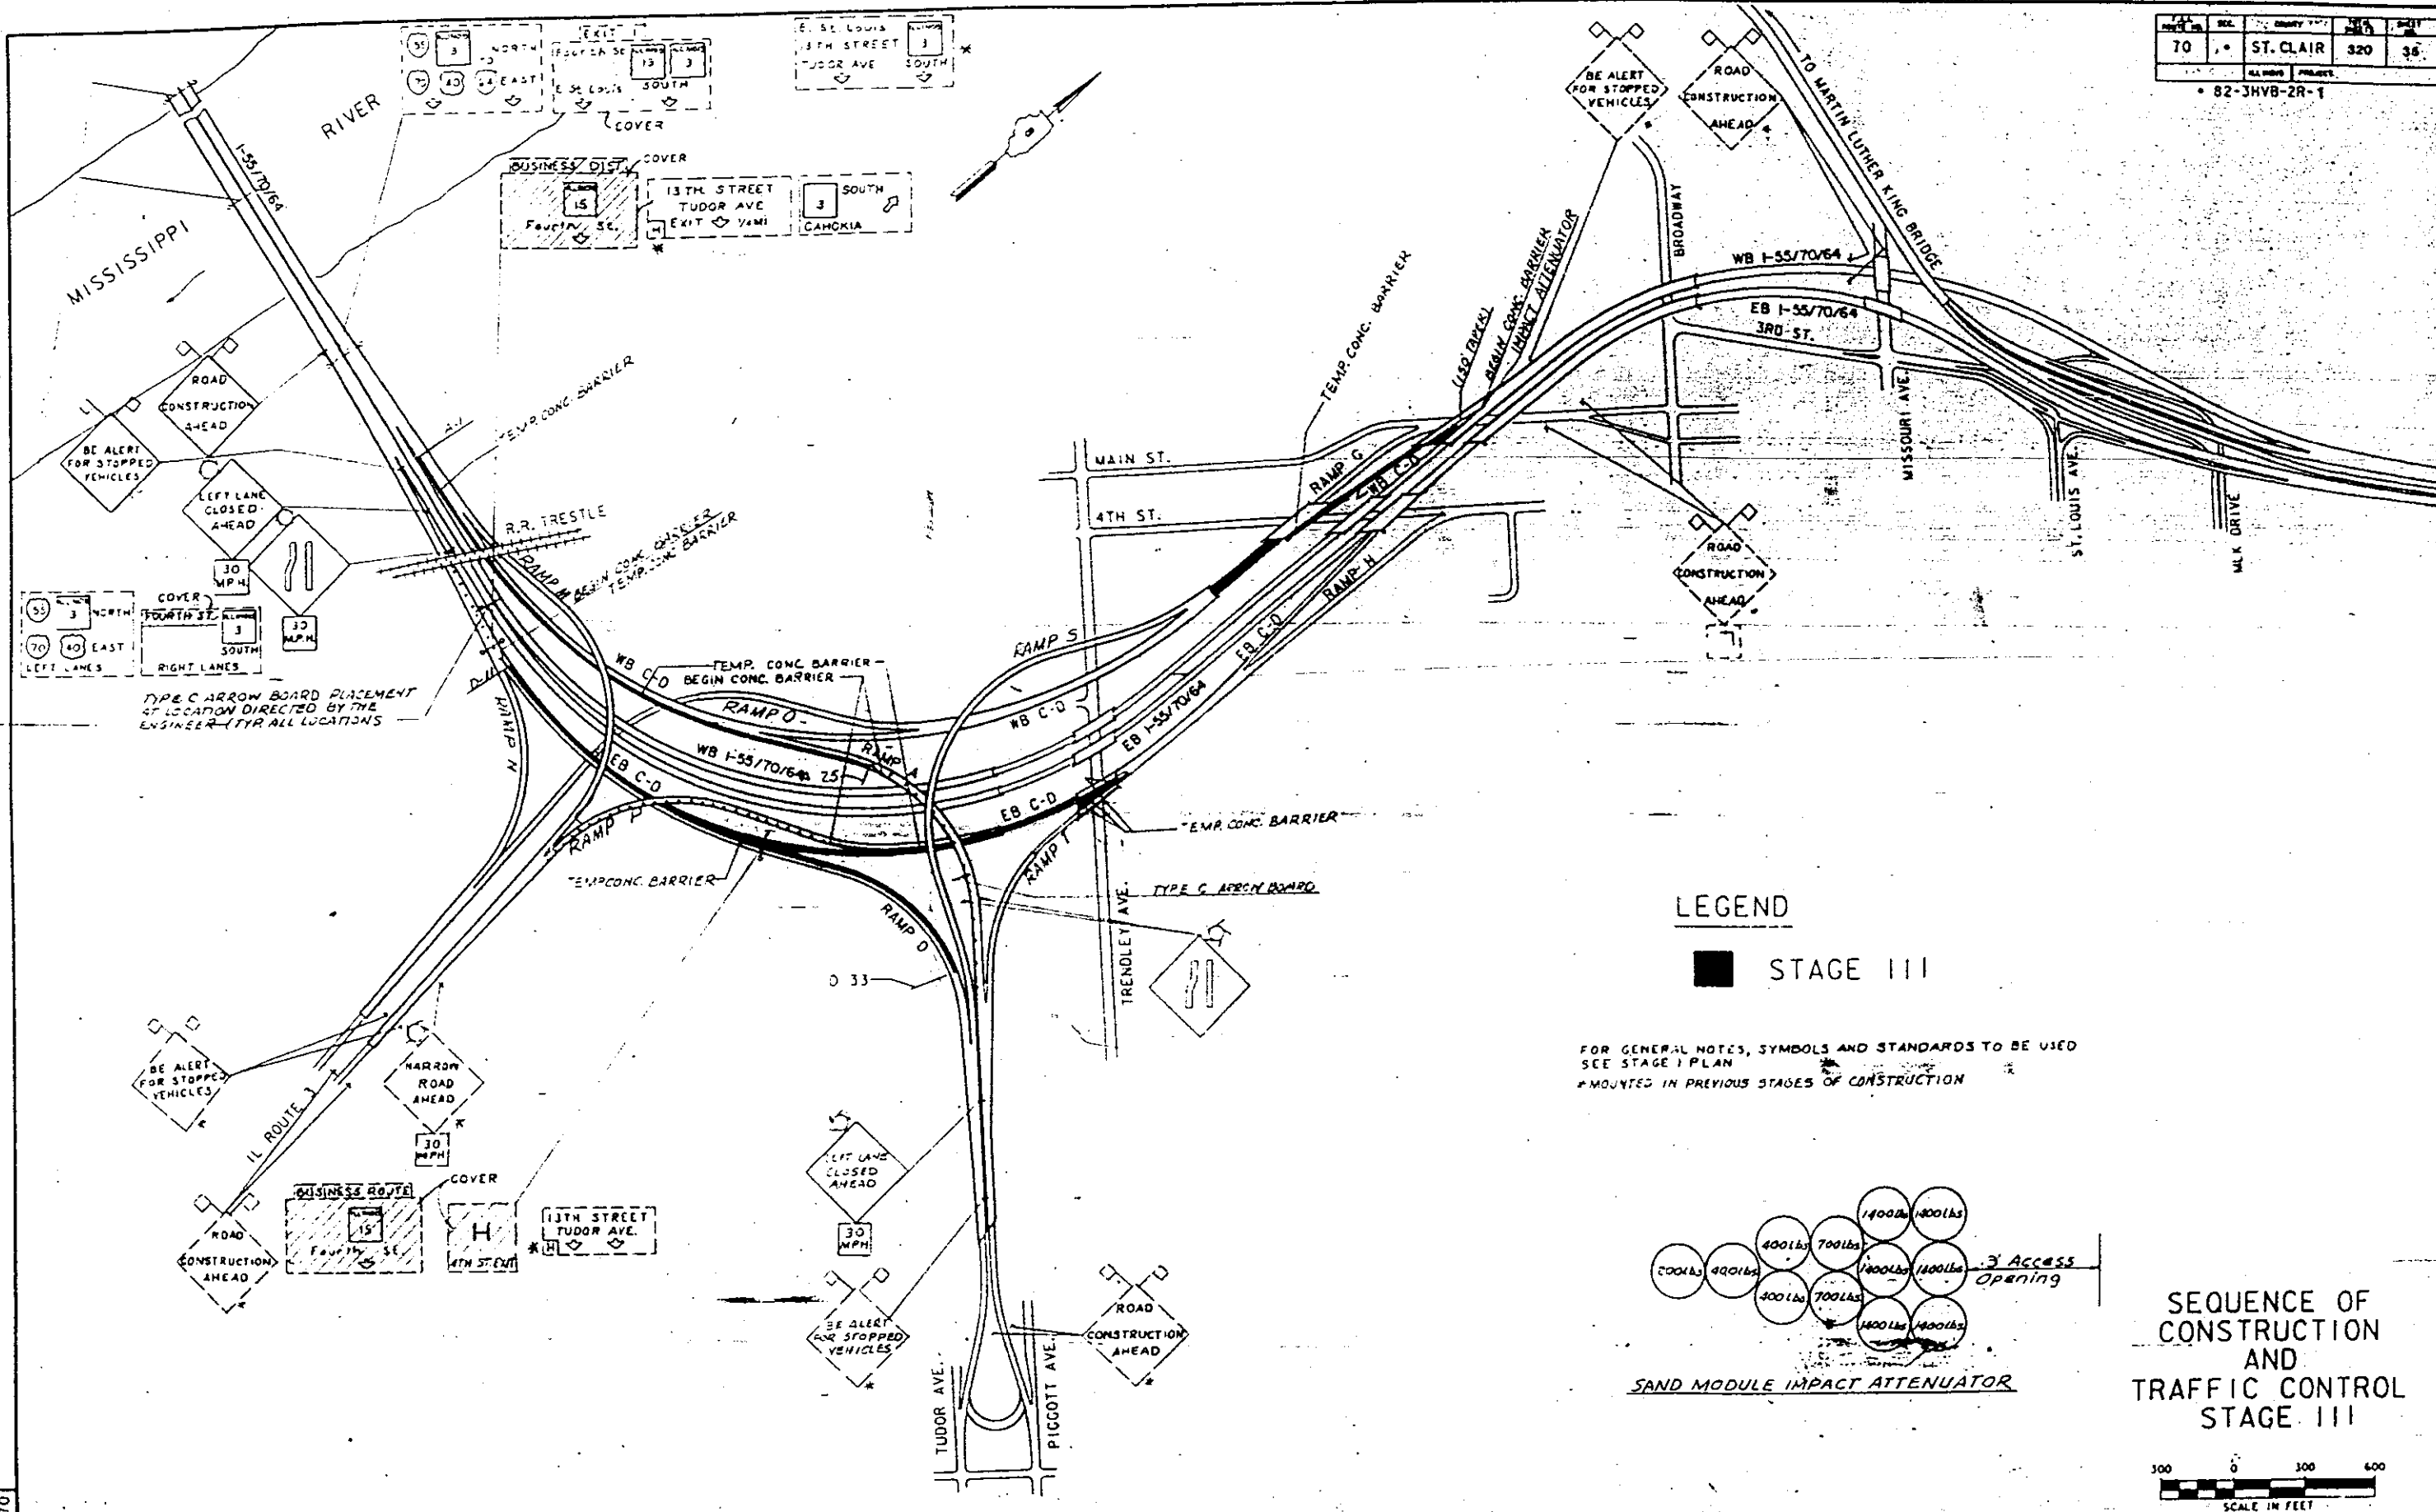

TYPE C ARROW BOARD PLACEMENT AT LOCATION DIRECTED BY THE ENGINEER (TYR ALL LOCATIONS)

LEGEND

■ STAGE III

FOR GENERAL NOTES, SYMBOLS AND STANDARDS TO BE USED SEE STAGE I PLAN
 * MOUNTED IN PREVIOUS STAGES OF CONSTRUCTION



SAND MODULE IMPACT ATTENUATOR

SEQUENCE OF CONSTRUCTION AND TRAFFIC CONTROL STAGE III



10136
86C70

NOTE:
FOR PARAPET REMOVAL, 1740 LBS. REINFORCING BARS
(EPOXY COATED) AND 9.9 CU. YDS. CLASS X CONCRETE
(SUPERSTR.) FOR PARAPET RECONSTRUCTION-ALTERNATE 1.


DATE	REV.	BY	CHK.	NO.
F.A.I. TO	PRK	ST. CLAIR	320	152

82-SHYB-2R-1

BILL OF MATERIAL


SPAN HI				
BAR	NO.	SIZE	LENGTH	SHAPE
880(E)	8	#5	23'-9"	—
881(E)	6	#8	32'-8"	—
DT(E)	6	#5	3'-11"	—
DB(E)	6	#4	5'-4"	—
D9(E)	83	#4	2'-8"	—
D10(E)	91	#5	2'-10"	—
D11(E)	56	#6	2'-5"	—
E40(E)	30	#4	17'-7"	—
BITUMINOUS CONCRETE SURFACE REMOVAL				
			50. YDS.	236
BRIDGE DECK CONCRETE OVERLAY OPTION				
			50. YDS.	249

REINFORCEMENT BARS MARKED (E) SHALL BE EPOXY COATED.

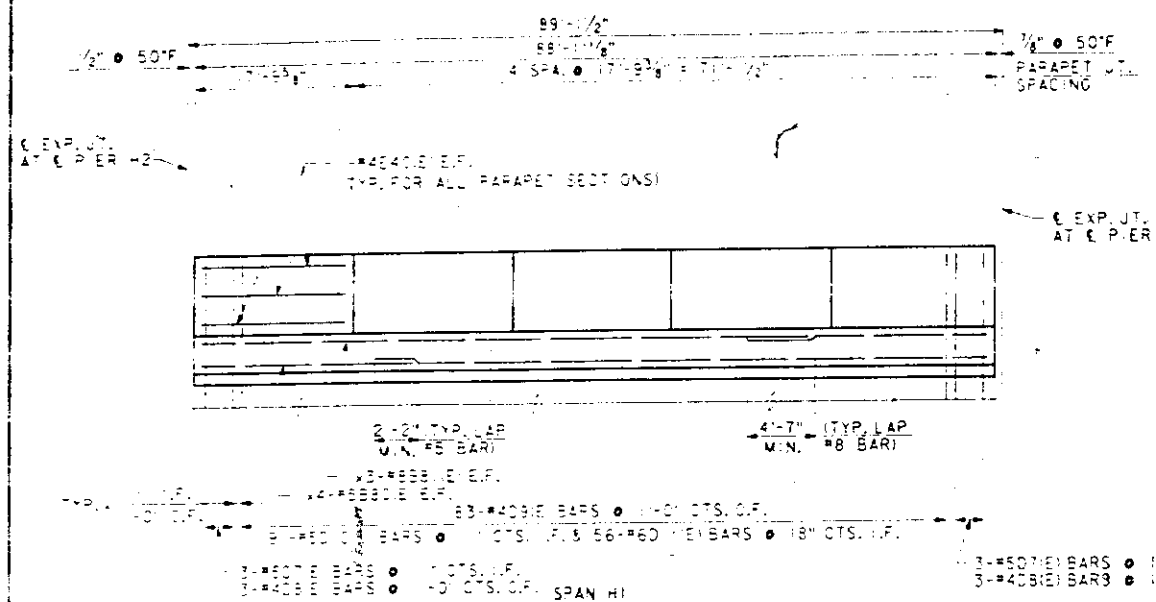

INSIDE ELEVATION OF EAST PARAPET


E.F. INDICATES EACH FACE.
I.F. INDICATES INSIDE FACE.
O.F. INDICATES OUTSIDE FACE.
ALL DIMENSIONS ARE MEASURED
ALONG OUTSIDE FACE OF PARAPET.
BARS TO BE DRILLED AND
GRouted IN PLACE.

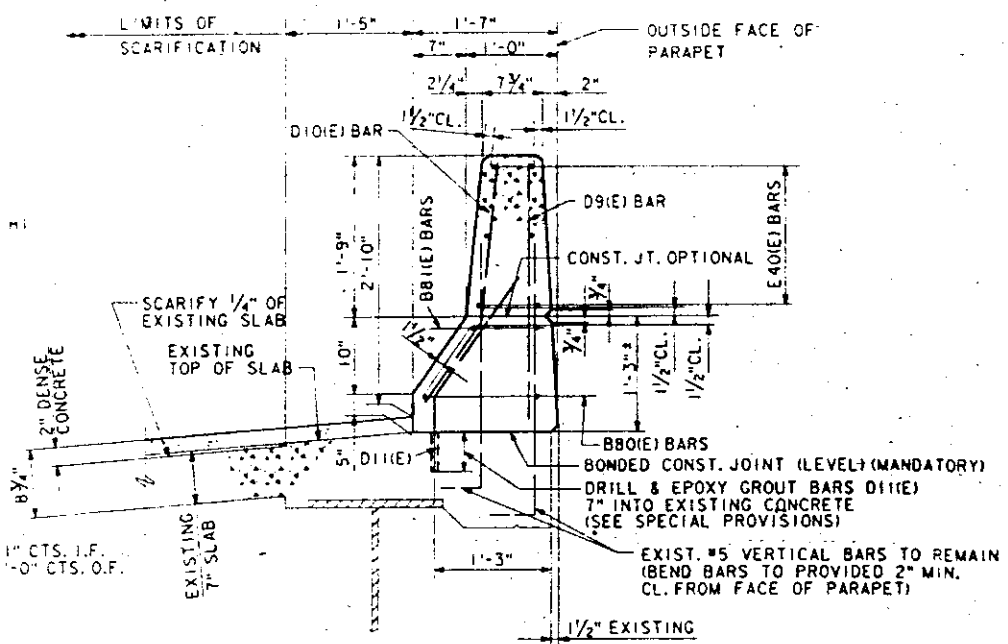

SECTION THRU PARAPET

NOTE: ALL EDGES SHALL HAVE A 3/4" CHAMFER,
EXCEPT AS SHOWN.
FOR SECTION THRU PARAPET NEAR EXP. JOINT
AT PIER H2 SEE ROADWAY H PLANS.


* Quantity of these bars
included with Parapet
Reconstruction - All 1

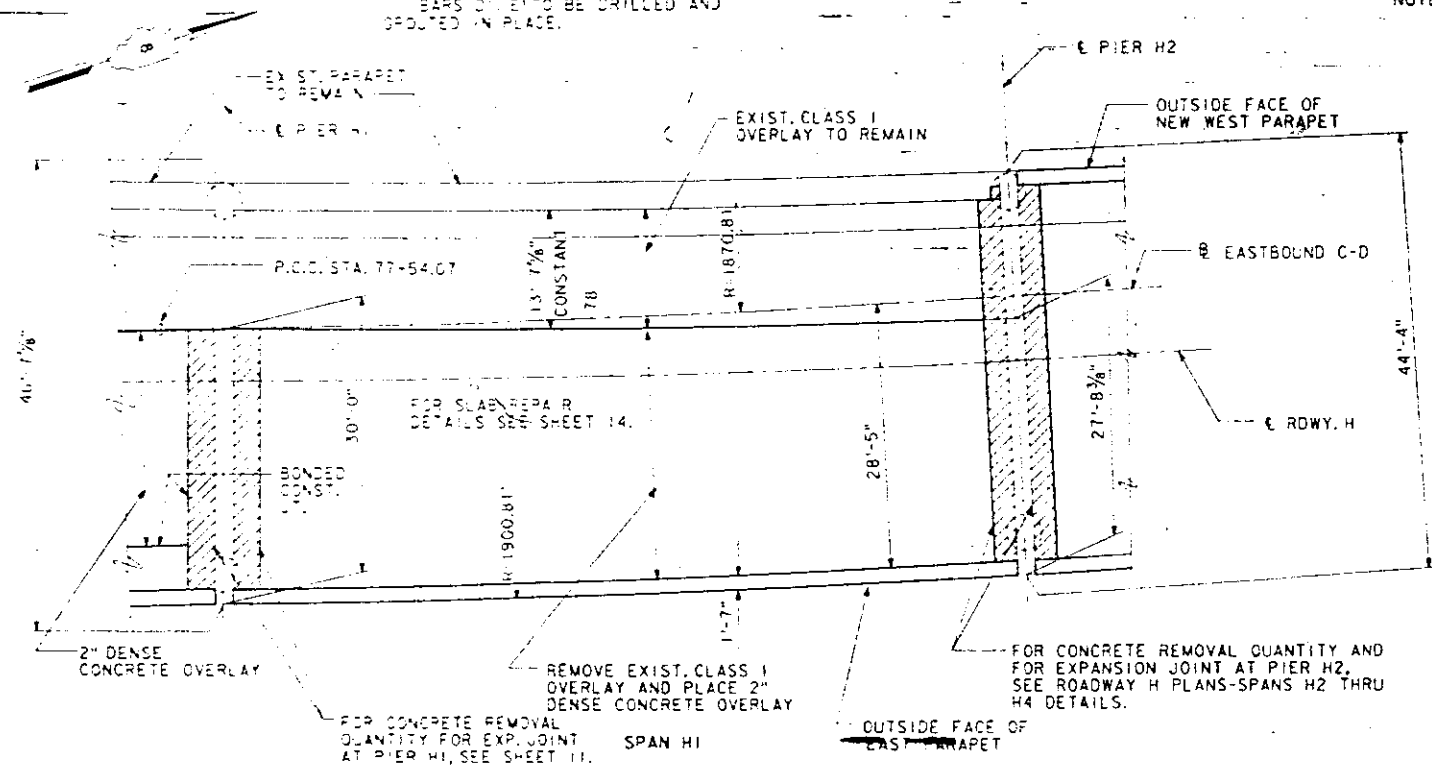

LOCATION PLAN

NOTES

THE CONTRACTOR SHALL TEST 10% OF THE D11(E) BARS IN THE FRONT FACE OF THE NEW PARAPET, AS DIRECTED BY THE ENGINEER, TO MEET A MIN. CERTIFIED PULL OUT LOAD OF 13.3K. FOR EVERY BAR THAT FAILS TO MEET THE PULL OUT LOAD OF 13.3K, THE CONTRACTOR SHALL TEST TWO ADDITIONAL BARS AND REGROUT AN ADDITIONAL D5(E) BAR EITHER SIDE OF THE FAILED BAR. COST OF TESTING AND ADDITIONAL BARS SHALL BE INCIDENTAL TO "REINF. BARS (EPOXY COATED)".

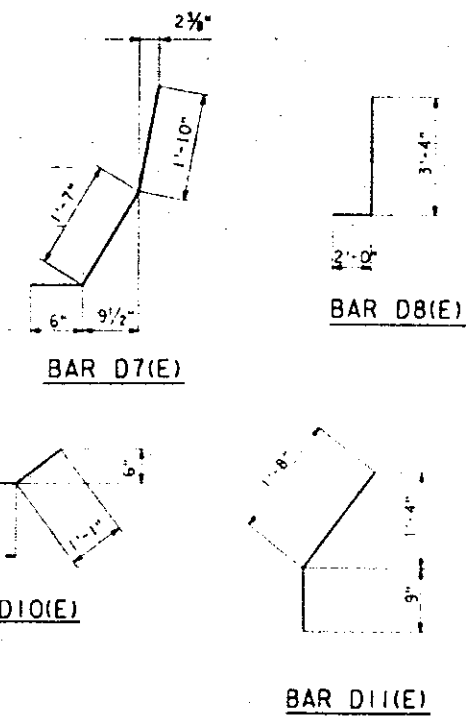

REHABILITATION FOR
FAI - 55770 COMPLEX
ROADWAY H
EAST PARAPET - SPAN HI
STRUCTURE NO. 082-0256
STA. 73+52.76 TO STA. 78+45.71 (FAI-70) ST. CLAIR CO.

PREPARED BY:
SVERDRUP CORPORATION
ST. LOUIS, MISSOURI

LEVELS PLOTTED DATE: OCT. 14, 1987
35 54 56 57 63
10320: FILE: ZP31110, IJ081147E.DGN
875664 PRF:DET147E

T.V. DILLON
DESIGNED
C. LIZANA
CHECKED
L. SCHURMAN-JGC
DRAWN
P.W. CLARK
CHECKED

Joint Size	"C" at 50°F	"D" at 50°F	Location
4"	3"	2 1/2" Min.	Piers D26 & H2


INSTALLATION NOTES

- Install sponge mandrels into positions shown to form flap convolution.
- Install parapet or sidewalk piece (trim roadway flap to fit before applying epoxy).
- Install continuous seal in roadway.
- Install anchor blocks as indicated.

NOTE A: Maximum spacing of anchor bolts shall be 12" centers.

SKREW LIMITATIONS


The details of the anchor blocks and the elastomeric membrane in the parapet, as shown, are for up to 50° skews. For skews greater than 50° the anchor blocks and the elastomeric membrane, installed in accordance with dimension "D" might require modifications to insure a minimum clearance of 1/2" from centerline of anchor studs to edge of parapet opening. The anchor blocks and the elastomeric membrane shall also be installed to the top of the parapet with the anchor studs spaced at 12" cts.

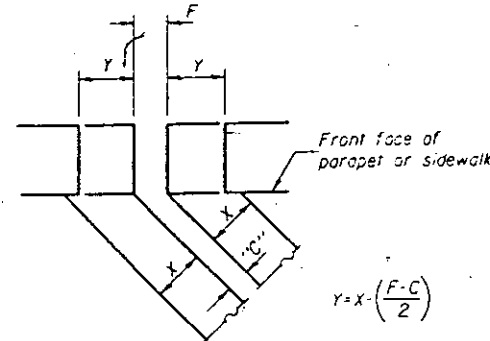

FORMING BLOCKOUT SKETCH

$$Y = X \left(\frac{F-C}{2} \right)$$

For dimension "F" see parapet details.

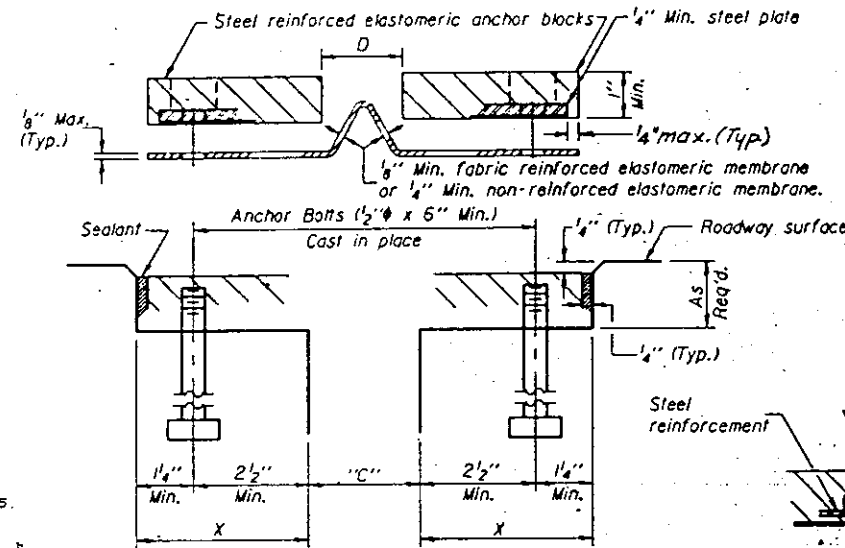


CROSS SECTION


ANCHOR BLOCK REINFORCEMENT WITH ASPHALT SURFACE

GENERAL NOTES


Continuous Seal Neoprene Expansion Joint shall consist of molded anchor blocks of elastomer and steel, field assembled over continuous lengths of elastomeric membrane. See Special Provisions.
The elastomeric membrane shall be premolded with a single or a double upward convolution that will have a "memory" to return to its molded position upon joint closure.
The steel reinforcement must extend up the back face of anchor blocks when asphalt surfaces are used but is optional in concrete blockout.
The convolution length shall be such that the extended length will not be greater than the manufactured length when the joint is fully expanded in its design range and will not protrude above the anchor blocks when the joint is fully compressed.
Joint openings shall be adjusted in accordance with Article 503.07(c) of the Standard Specifications when the deck is poured at an ambient temperature other than 50° F.
The parapet and sidewalk flaps may be furnished factory vulcanized to the roadway membrane provided the centerline of the convolution is maintained and the process and method meet the approval of the Engineer.

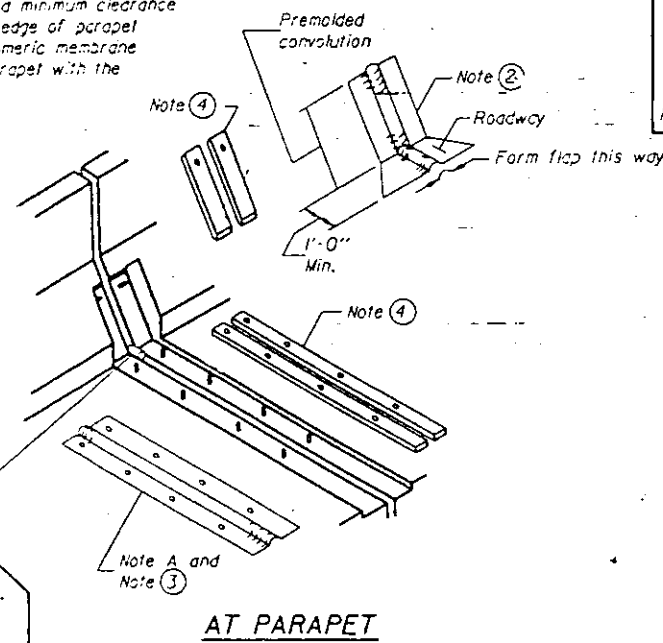


AT PARAPET

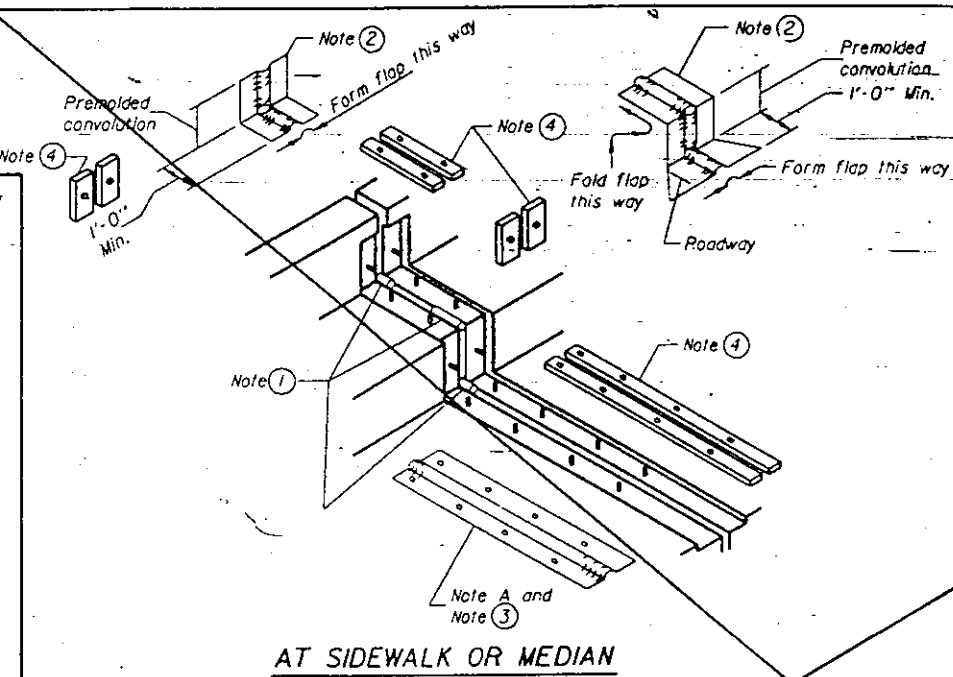


AT SIDEWALK OR MEDIAN

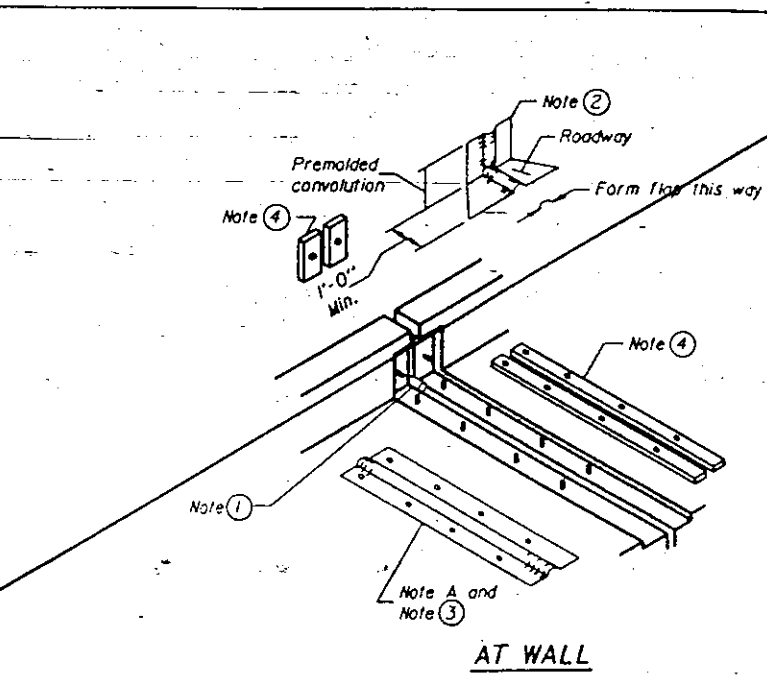


AT WALL

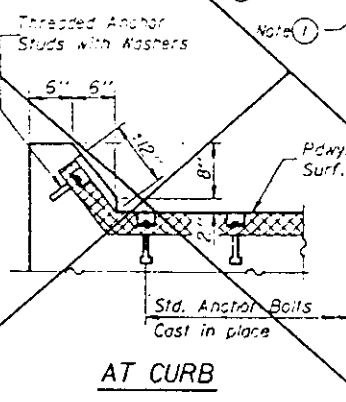


AT CURB

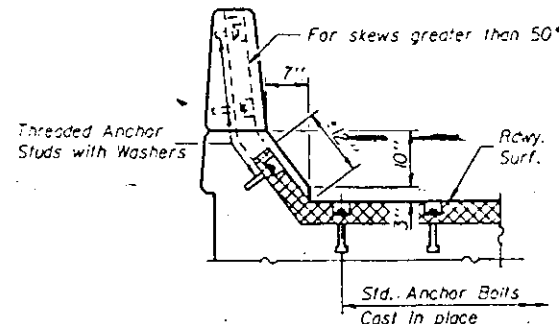

AT PARAPET

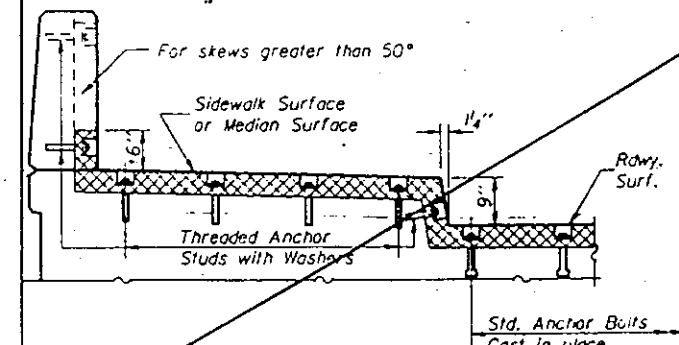

AT SIDEWALK OR MEDIAN

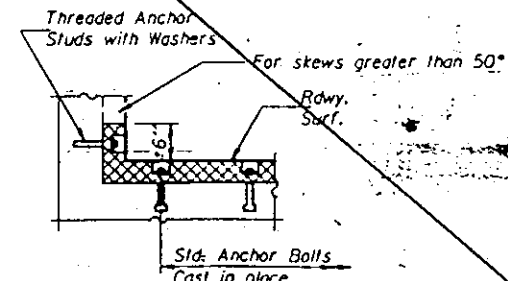

AT WALL

DESIGNED	
CHECKED	
DRAWN	
CHECKED	G.J.O=

EJ-CS 12-1-83

PREPARED BY
SYVERDRUP CORPORATION

REHABILITATION FOR
FAI-55/70 COMPLEX
CONTINUOUS SEAL TYPE
NEOPRENE EXPANSION JOINTS
FOR 4" MOVEMENT


STRUCTURE NO. 082-0255 (RAMP Q)
STRUCTURE NO. 082-0203 (RAMP P)
STRUCTURE NO. 082-0256 (RDWY. H)

(FAI-70) ST. CLAIR CO.

PROJECT NO.	SECTION	CHART	SHEET NO.	TOTAL SHEETS
FAI-70	ST. CLAIR	320	169	

BENCH MARK 3


CHISELED "3" IN CONCRETE AT END OF EAST WALL ON E.B. 1-55/70 BRIDGE ABUT. 400 S. OF TRENDELY AVE. ELEV. 447.80

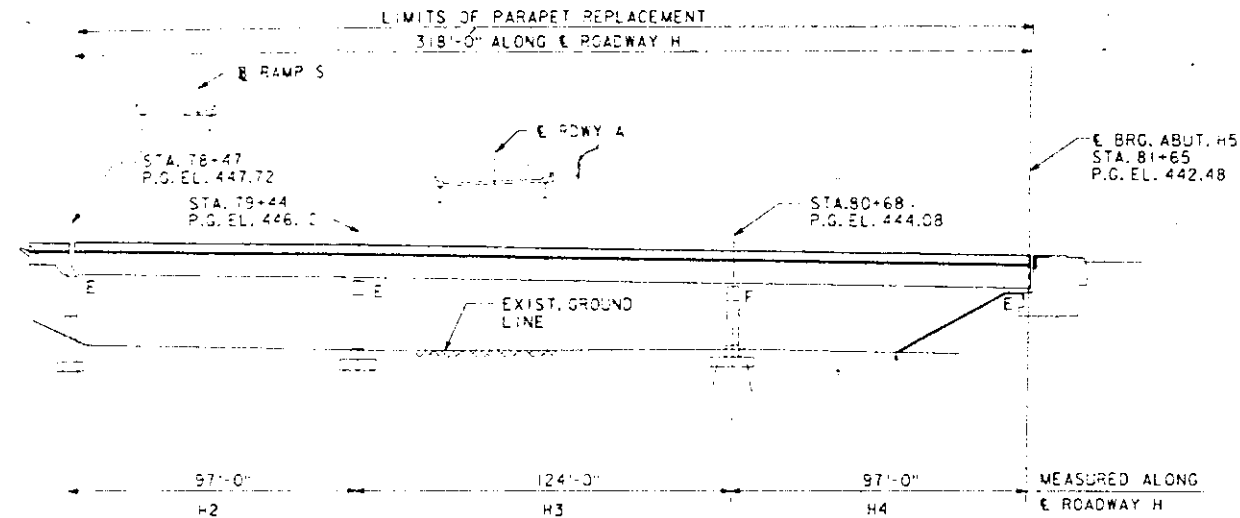


ELEVATION

NOTE: STAT. ONING IS ALONG E. ROADWAY H. P.S. ELEVATIONS SHOWN ARE AT TOP OF EXISTING 7" SLAB.

NOTE A: EXISTING NAME PLATE TO BE SALVAGED, CLEANED AND RELOCATED. (COST INCIDENTAL)

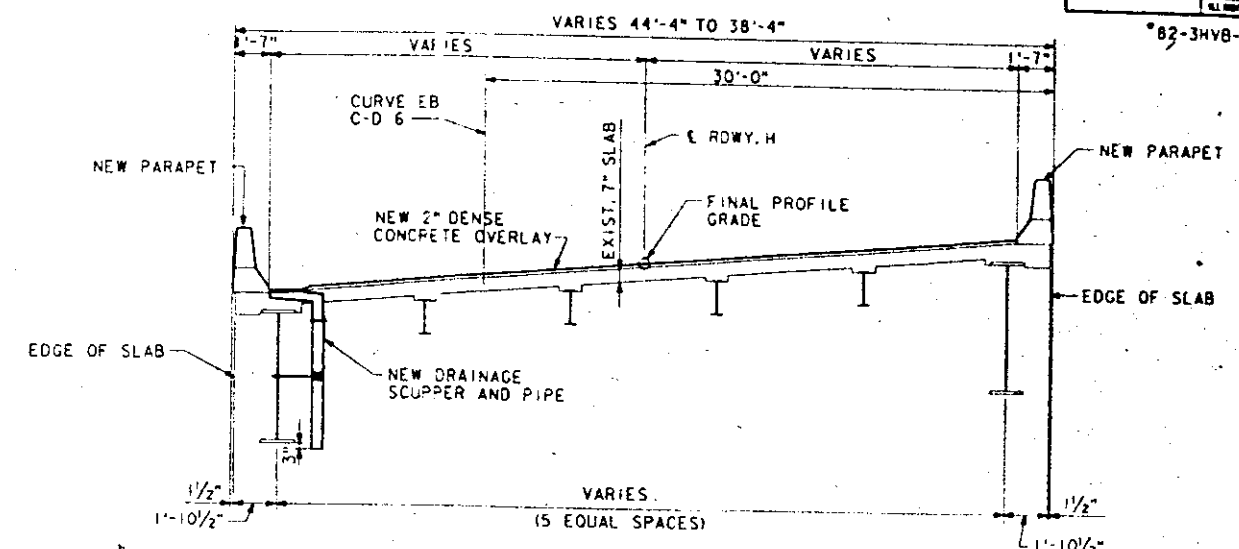


TYPICAL CROSS SECTION - SPAN H2-H4
(LOOKING AHEAD STATION)

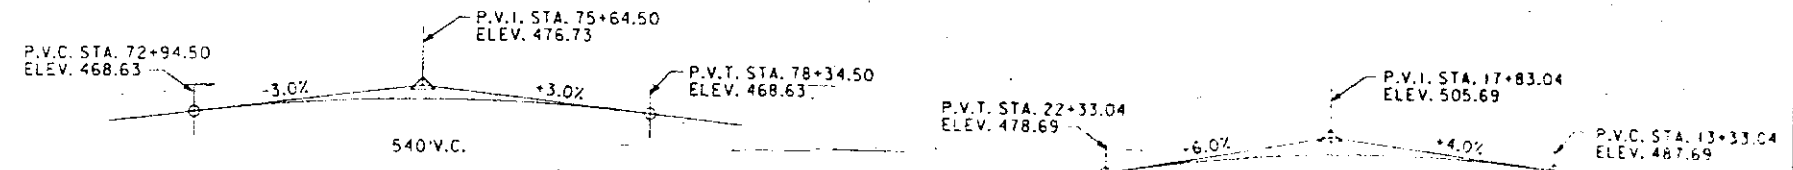

EXISTING PROFILE GRADE - E. ROADWAY A
NOTE: ELEVATIONS SHOWN ARE AT TOP OF EXISTING SLAB.

EXISTING PROFILE GRADE - B RAMP S
NOTE: ELEVATIONS SHOWN ARE AT TOP OF EXISTING SLAB.

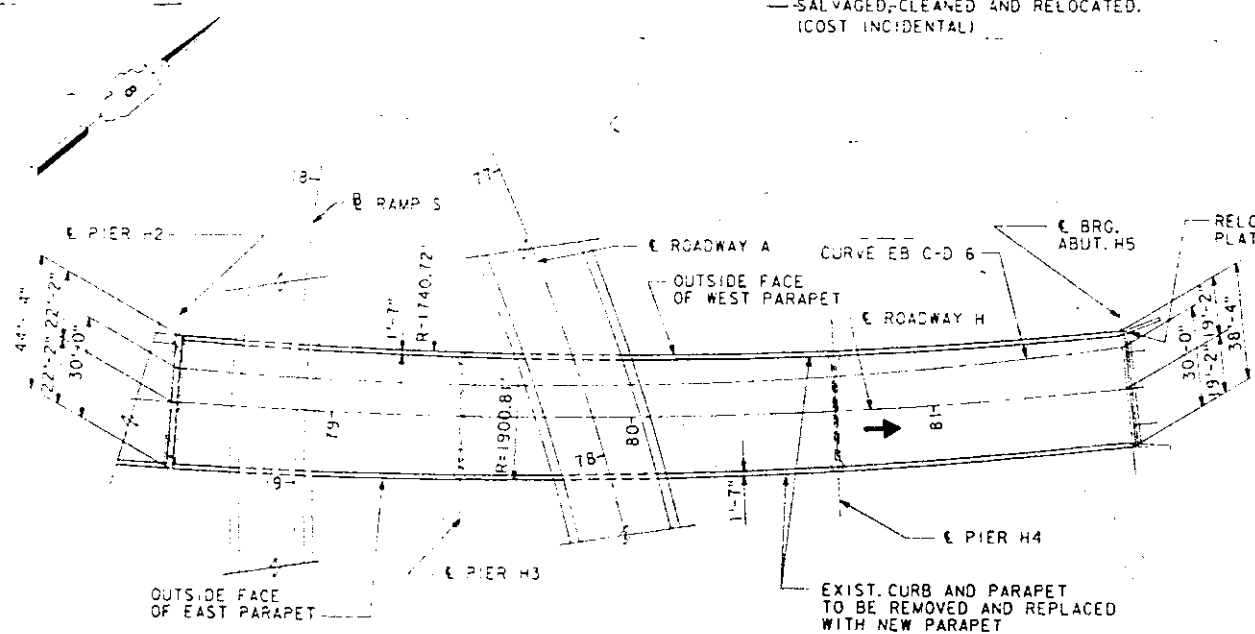

PLAN


CURVE DATA - EB C-D 6

P.I. STA. = 81+11.46
 $\Delta = 21^\circ-37'-50"$ LT.
 $D = 3^\circ-03'-45"$
 $R = 1870.81'$
 $T = 357.39'$
 $L = 706.28'$
 $E = 33.83'$
 P.C.C. STA. = 77+54.07
 P.C.C. STA. = 84+60.35

DESIGN STRESSES

	EXIST. STRUCTURES	NEW CONSTRUCTION
DESIGN SPECIFICATIONS:	AASHTO 1961 AND APPLICABLE 1962 AND 1963 INTERIMS.	AASHTO 1983 AND APPLICABLE 1984 THRU 1987 INTERIMS.
LOADING:	HS20-44 AND ALTERNATE	HS20-44 AND ALTERNATE
REINFORCED CONCRETE:		
DECK SLAB	$f_c = 1400$ psi $n = 10$	$f_c = 3500$ psi
SUBSTRUCTURE	$f_c = 1400$ psi $n = 10$	$f_y = 60,000$ psi (REINFORCEMENT)
REINFORCING	$f_c = 75$ psi - FOOTINGS $f_s = 20,000$ psi	$f_y = 36,000$ psi (M183)
STRUCTURAL STEEL:	$f_s = 20,000$ psi	

APPROVED
 FOR THE STATE OF ILLINOIS
[Signature]
 STATE OF ILLINOIS
 DEPARTMENT OF TRANSPORTATION
 CHICAGO

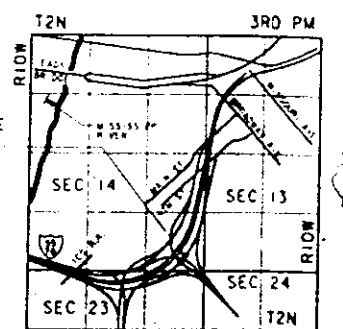

LOCATION SKETCH

REHABILITATION FOR
FAI - 55/70 COMPLEX
 ROADWAY H-DECK REHABILITATION
 GENERAL PLAN AND ELEVATION
 SPANS H2 THRU H4
 STRUCTURE NO. 082-0256
 STA. 78+47.00 TO STA. 81+65.00 (FAI-70) ST. CLAIR CO.

LEVELS PLOTTED DATE: OCT. 14, 1987
 2 26 27 35 38 39 50 56 63
 10370 FILED IN 3:11:10, OPEN 2, DGN
 875135 PRF:GPHZ
 DESIGNED
 CHECKED
 D. RIEHL
 DRAWN
 P. HANSON
 CHECKED

GENERAL NOTES

CONSTRUCTION SPECIFICATIONS: THE 1988 EDITION OF THE STATE OF ILLINOIS DEPARTMENT OF TRANSPORTATION'S STANDARD SPECIFICATIONS FOR ROAD AND BRIDGE CONSTRUCTION, ADDENDA AND THE SPECIAL PROVISIONS SHALL GOVERN.

PLAN DIMENSIONS AND DETAILS RELATIVE TO EXISTING STRUCTURE HAVE BEEN TAKEN FROM EXISTING PLANS, AND ARE SUBJECT TO NOMINAL CONSTRUCTION VARIATIONS. IT SHALL BE THE CONTRACTOR'S RESPONSIBILITY TO VERIFY SUCH DIMENSIONS AND DETAILS IN THE FIELD AND MAKE NECESSARY APPROVED ADJUSTMENTS PRIOR TO CONSTRUCTION BEFORE ORDERING OF MATERIALS. SUCH VARIATIONS SHALL NOT BE CAUSE FOR ADDITIONAL COMPENSATION FOR A CHANGE IN SCOPE OF WORK, HOWEVER, THE CONTRACTOR WILL BE PAID FOR THE QUANTITY ACTUALLY FURNISHED AT THE UNIT PRICE BID FOR THE WORK.

ALL DIMENSIONS ARE MEASURED AT A TEMPERATURE OF 50°F.

ALL TRANSVERSE AND LONGITUDINAL DIMENSIONS ARE MEASURED HORIZONTALLY.

REINFORCEMENT BARS SHALL CONFORM TO THE REQUIREMENTS OF AASHTO M31, M42 OR M53, GRADE 60.

FIELD WELDING OF CONSTRUCTION ACCESSORIES WILL NOT BE PERMITTED TO THE BOTTOM FLANGE OF BEAMS OR GIRDERS NOR TO THE TOP FLANGE FOR A DISTANCE EQUAL TO ONE-FOURTH THE SPAN LENGTH EACH WAY FROM THE PIER SUPPORTS. FIELD WELDING IN OTHER AREAS WILL BE PERMITTED ONLY WHEN APPROVED BY THE ENGINEER.

TRAFFIC CONTROL ON ROADWAY H IS TO BE PART OF THE ROADWAY REHABILITATION CONTRACT BUT IT SHALL NOT EXEMPT THE CONTRACTOR FROM PROVIDING ADDITIONAL TRAFFIC CONTROL AND PROTECTION THAT MAY BE REQUIRED FOR THE SAFETY OF THE PUBLIC AND WORKMEN.

THE ZINC - SILICATE AND VINYL PAINT SYSTEM SHALL BE USED FOR SHOP AND FIELD PAINTING OF NEW STRUCT. STEEL EXCEPT WHERE OTHERWISE NOTED.

PROTECTIVE COAT SHALL NOT BE APPLIED TO SURFACES WHERE BRIDGE DECK CONCRETE OVERLAY IS APPLIED.

FOR MAINTENANCE AND CONSTRUCTION SIGN SUPPORT DETAILS AND LOCATION SEE SHEET 292 OF 320.


INDEX OF DRAWINGS

- 1 GENERAL PLAN AND ELEVATION
- 2 GENERAL NOTES, ESTIMATED QUANTITIES AND INDEX OF DRAWINGS
- 3 PARAPETS
- 4 PARAPET DETAILS
- 5 NEOPRENE EXPANSION JOINT
- 6 SCUPPER DETAILS
- 7 CAST IRON DRAINAGE SCUPPER
- 8 ABUTMENT MODIFICATIONS - ABUTMENT H5


TOTAL BILL OF MATERIAL

ITEM	UNIT	SUPERSTR.	SUBSTR.	TOTAL
CLASS X CONCRETE SUPERSTRUCTURE	CU. YDS.	26.9	—	26.9
REINFORCEMENT BARS, EPOXY COATED	LBS.	2,497	—	2,497
CONCRETE REMOVAL	CU. YDS.	24.5	—	24.5
BITUMINOUS CONCRETE SURFACE REMOVAL (BRIDGE DECK)	SQ. YDS.	1,248	—	1,248
CONCRETE BRIDGE DECK SCARIFICATION (1/4 INCH)	SQ. YDS.	1,322	—	1,322
PARAPET RECONSTRUCTION	LIN. FT.	726	—	726
DECK SLAB REPAIR (PARTIAL DEPTH)	SQ. YDS.	35	—	35
DECK SLAB REPAIR (FULL DEPTH)	SQ. YDS.	1	—	1
BRIDGE DECK CONCRETE OVERLAY OPTION	SQ. YDS.	1,322	—	1,322
NEOPRENE EXPANSION JOINT (2")	LIN. FT.	38	—	38
DRAINAGE SCUPPERS	EACH	6	—	6
PROTECTIVE COAT	SQ. YDS.	260	—	260
FLOOR DRAIN REMOVAL	EACH	51	—	51
FURNISHING AND ERECTING STRUCTURAL STEEL	LBS.	1350	—	1350

NOTE: PARAPET RECONSTRUCTION INCLUDES THE EAST PARAPET OF SPAN H.
QUANTITY DOES NOT INCLUDE BRIDGE DECK SURFACE.

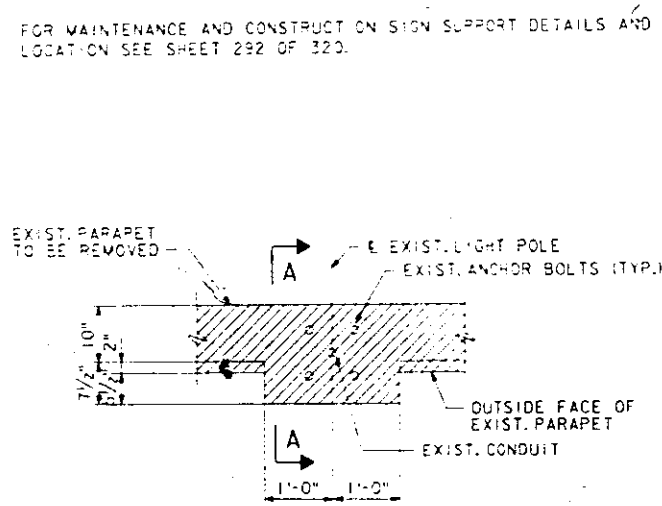

PLAN-EXISTING PARAPET AT LIGHT POLE

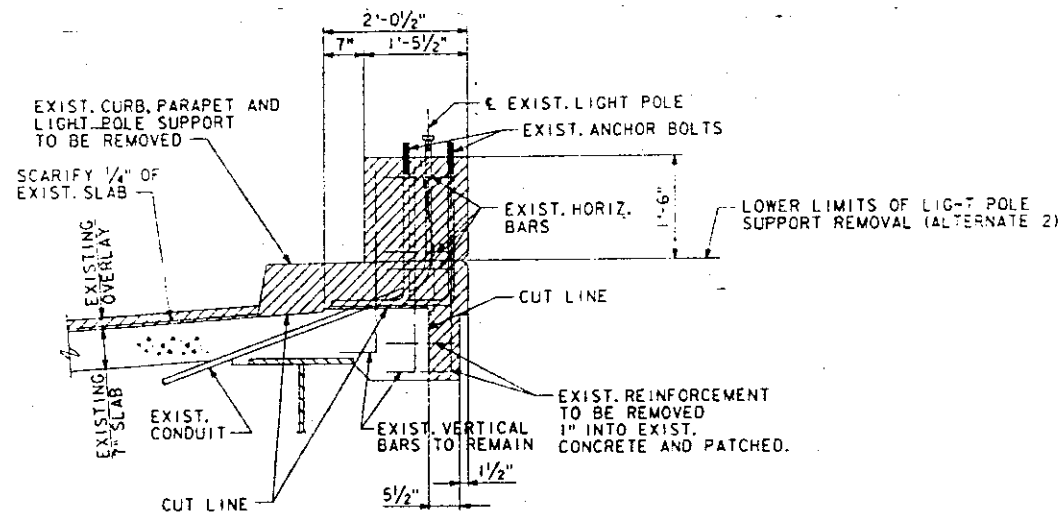

SECTION A-A

NOTE: DEMOLITION SHOWN FOR PARAPET RECONSTRUCTION ALTERNATE 1.
FOR ALTERNATE 2 REMOVE THE LIGHT POLE SUPPORT TO THE LIMITS SHOWN.
FOR ALTERNATE 3 THE LIGHT POLES SHALL BE REMOVED. LIGHT POLE SUPPORT TO REMAIN.
THE PORTION OF THE LIGHT POLE SUPPORTS TO REMAIN SHALL HAVE THE ROADWAY FACE REMOVED TO MATCH THE ADJACENT PARAPET REMOVAL AS SHOWN ON THE PARAPET RECONSTRUCTION DETAIL FOR ALTERNATES 2 AND 3.

10330 FILED 7/23/10 JGENOTH.DGN
 875758 PRF. GENOTH
 LEVELS PLOTTED DATE: OCT. 14, 1987
 35 56 57 58 63

G.J. DEE	DESIGNED
C. LIZANA	CHECKED
K. SCHULT	DRAWN
P. HANSON	CHECKED


PREPARED BY
SYVERDRUP CORPORATION
ST. LOUIS, MISSOURI

REV. 8/26/88

SHEET NO. 2 OF 8

REHABILITATION FOR
FAI - 55/70 COMPLEX
ROADWAY H-DECK REHABILITATION
SPANS H2 THRU H4
GENERAL NOTES, ESTIMATED QUANTITIES
AND INDEX OF DRAWINGS
STRUCTURE NO. 082-0256
STA. 78+47.00 TO STA. 81+65.00 (FAI-70) ST. CLAIR CO.

PROJECT NO.	SECTION	COUNT	SCALE	DATE
F.A.I. 70	300	ST. CLAIR	320	171

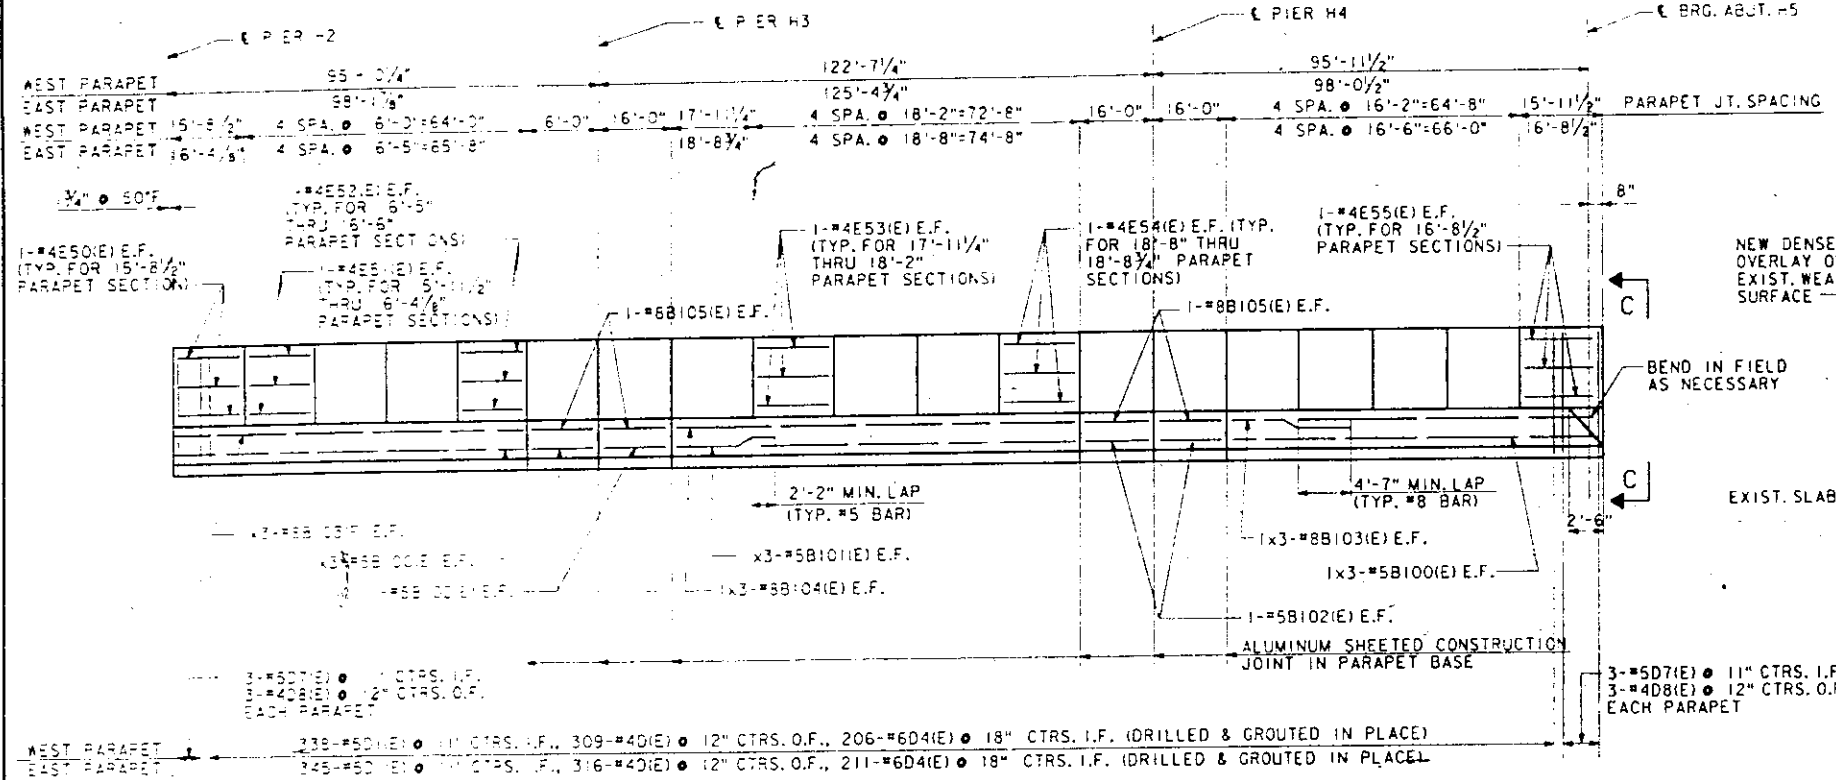

NOTE:
FOR PARAPET REMOVAL, 10,003 LBS. REINFORCING BARS (EPOXY COATED) AND 66.3 CU. YDS. CLASS X CONCRETE (SUPERSTR.) FOR PARAPET RECONSTRUCTION-ALTERNATE 1.

BILL OF MATERIAL

88.5 CU. YDS.
FOR PARAPET REMOVAL, 10,003 LBS. REINFORCING BARS (EPOXY COATED) AND 66.3 CU. YDS. CLASS X CONCRETE (SUPERSTR.) FOR PARAPET RECONSTRUCTION-ALTERNATE 1.

***82-3HVB-2R-1


SPANS H2 THRU H4

BAR	NO.	SIZE	LENGTH	SHAPE
A100(E)	48	#5	23'-0"	
A101(E)	24	#5	20'-0"	
B100(E)	12	#5	28'-11"	
B101(E)	6	#5	32'-6"	
B102(E)	16	#5	15'-9"	
B103(E)	12	#8	30'-7"	
B104(E)	6	#8	34'-2"	
B105(E)	16	#8	15'-9"	
BX(E)	24	#5	2'-10"	
D1(E)	625	#4	2'-8"	
D11(E)	683	#5	2'-10"	
D4(E)	417	#6	2'-0"	
D7(E)	12	#5	3'-11"	
D8(E)	12	#4	5'-4"	
E50(E)	6	#4	15'-5"	
E51(E)	108	#4	15'-8"	
E52(E)	48	#4	16'-2"	
E53(E)	30	#4	17'-8"	
E54(E)	30	#4	18'-5"	
E55(E)	6	#4	16'-5"	
H100(E)	8	#6	20'-2"	
U3(E)	37	#5	1'-11"	
X(E)	124	#5	3'-6"	

CLASS X CONCRETE SUPERSTRUCTURE	CU. YDS.	26.9
REINFORCEMENT BARS (EPOXY COATED)	LBS.	2497
DECK SLAB REPAIR (FULL DEPTH)	SQ. YDS.	1
DECK SLAB REPAIR (PARTIAL)	SQ. YDS.	35
BRIDGE DECK CONCRETE OVERLAY OPTION	SQ. YDS.	1,322
CONCRETE REMOVAL	CU. YDS.	29.5


INSIDE ELEVATION OF WEST PARAPET

NOTE: EAST PARAPET SIMILAR, EXCEPT AS NOTED.
O.F. INDICATES OUTSIDE FACE.
I.F. INDICATES INSIDE FACE.
E.F. INDICATES EACH FACE.
ALL DIMENSIONS ARE MEASURED ALONG OUTSIDE FACE OF PARAPETS.

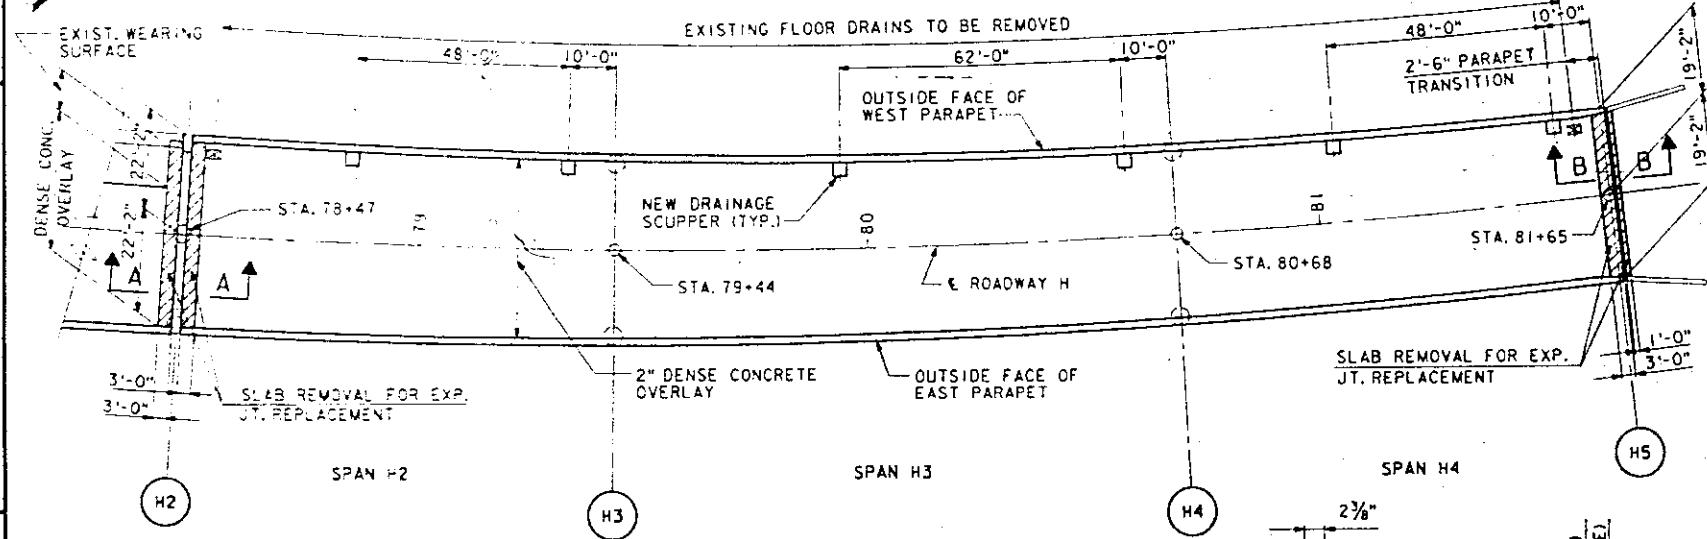


PLAN-SLAB AND PARAPET


NOTE: SPACE SCUPPERS TO MISS FLOORBEAMS.

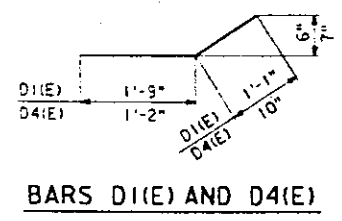


BARS D1(E) AND D4(E)

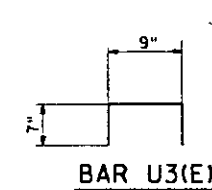


BAR U3(E)

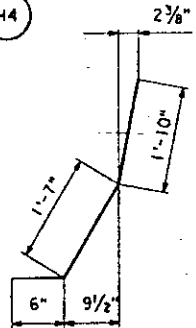

BAR D7(E)

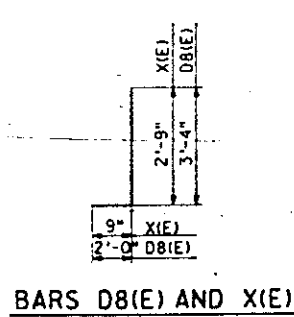


BARS D8(E) AND X(E)

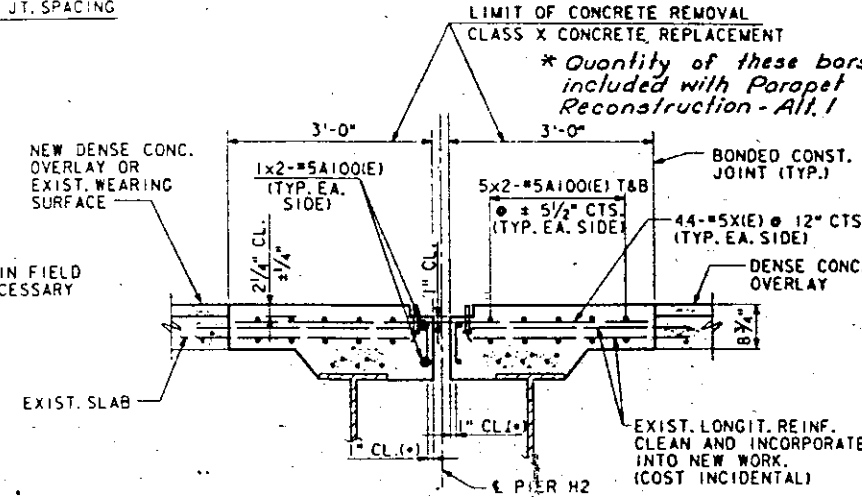


SECTION A-A

(*) PLACE A100(E) BARS IN BACK OF ANCHOR BOLTS, IF REQUIRED, TO MAINTAIN 1" CL. (+0-1/8"). ANCHOR BOLTS SHOULD BE TIED TO A100(E) BARS.

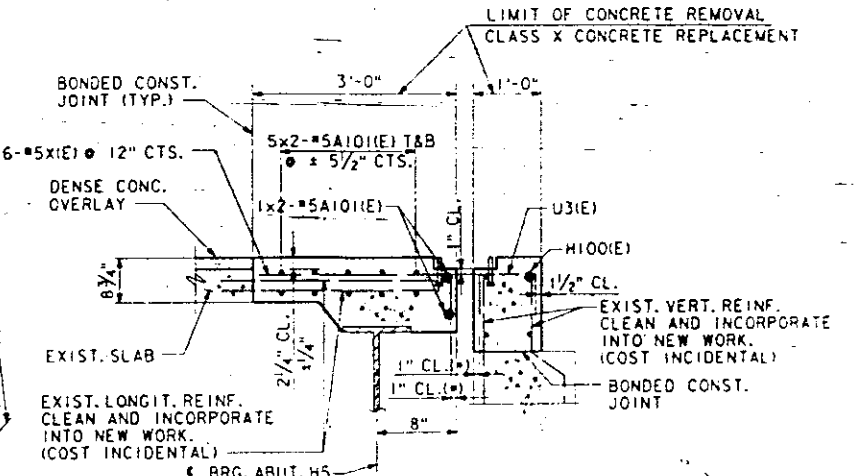

SECTION B-B

(*) PLACE A100(E) AND H100(E) BARS IN BACK OF ANCHOR BOLTS, IF REQUIRED, TO MAINTAIN 1" CL. (+0-1/8"). ANCHOR BOLTS SHOULD BE TIED TO A100(E) AND H100(E) BARS.

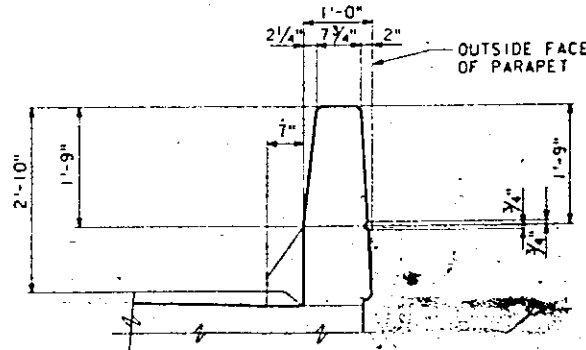

VIEW C-C

WEST PARAPET SHOWN
EAST PARAPET SIMILAR

NOTES

REINFORCEMENT BARS MARKED (E) INDICATES EPOXY COATED.
BARS DESIGNATED 1x3-#8 INDICATES 1 LINE OF BARS WITH 3 LENGTHS PER LINE.
FOR DRAINAGE SCUPPER DETAILS SEE SHEET 7 OF 8.
FOR DETAILS OF FULL DEPTH OR PARTIAL DEPTH PATCHING OF SLAB SEE SHEET 4 OF 8.
FOR DETAILS OF REMOVAL OF EXISTING FLOOR DRAINS AND SLAB PATCHING SEE SHEET 6 OF 8.
FOR DETAILS OF EXPANSION JOINT AT ABUT. H5, SEE SHEET 5 OF 8.
FOR ABUTMENT MODIFICATIONS, SEE SHEET 8 OF 8.
FOR DETAILS OF EXPANSION JOINT AT PIER H2, SEE SHEET 18 OF 32 SPAN H1 DETAILS.

**REHABILITATION FOR
FAI - 55/70 COMPLEX
ROADWAY H-DECK REHABILITATION
SPANS H2 THRU H4
PARAPETS**

STRUCTURE NO. 082-0256

STA. 78+47.00 TO STA. 81+65.00 (FAI-70) ST. CLAIR CO.

LEVELS PLOTTED DATE: OCT. 14, 1987
35 54 56 57 58 63


B. CARLSON	DESIGNED
P. HANSON	CHECKED
K. SCHULT	DRAWN
P. HANSON	CHECKED

PREPARED BY:
SYVERDRUP CORPORATION
ST. LOUIS, MISSOURI

REV. 8/26/88


SHEET NO. 3 OF 8

PROJECT NO.	SECTION	CONTRACT	DATE	BY
FAI-70	*	ST. CLAIR	320	174
DATE	BY			
		82-3HVB-2R-1		

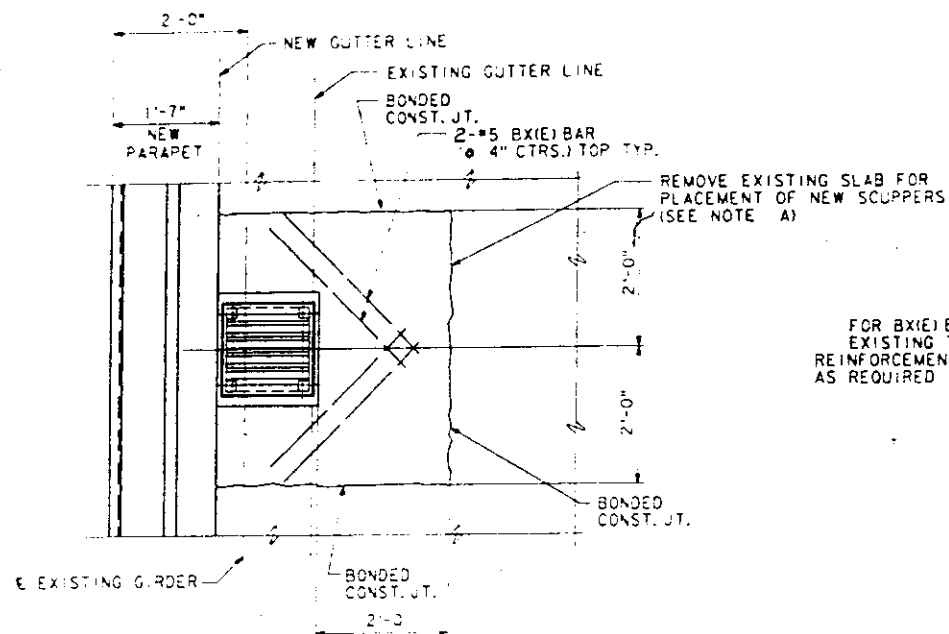


PLAN

NOTE A
FOR BX(1) BAR QUANTITY, SEE SHEET 3 OF 8. EXISTING TRANSVERSE AND LONGITUDINAL REINFORCEMENT BARS SHALL BE CUT OR BENT AS REQUIRED TO MISS THE SCUPPER.

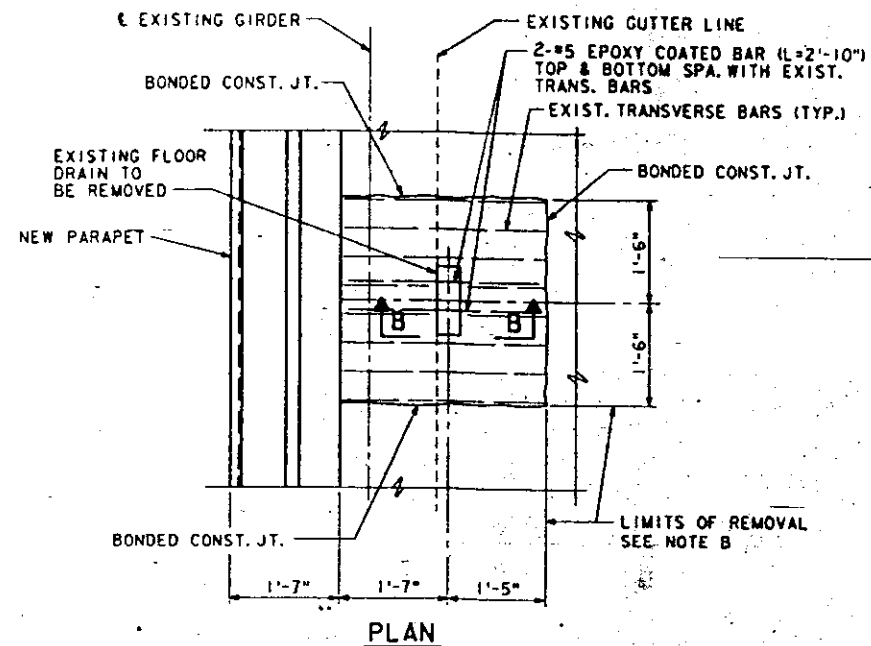

PLAN

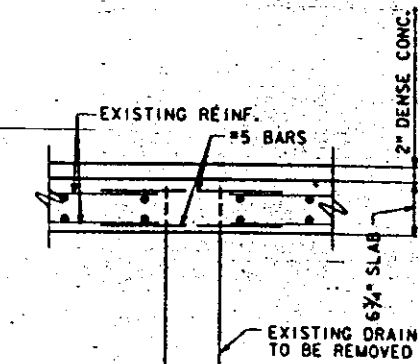



SECTION B-B

- NOTE B**
1. REMOVE THE EXISTING DRAIN TO LIMITS SHOWN WITHOUT DAMAGE TO EXISTING REINFORCEMENT BARS.
 2. CLEAN EXISTING REINFORCEMENT BARS AND TIE NEW #5 BARS TO SPAN DRAIN HOLE.
 3. REPLACE REMOVED CONCRETE WITH CLASS X CONCRETE TO THE LEVEL OF EXISTING CONCRETE.
 4. NEW CONCRETE IS TO ATTAIN FULL 28-DAY STRENGTH PRIOR TO PLACING OVERLAY.
 5. COST OF NEW CLASS X CONCRETE AND #5 BARS TO BE INCIDENTAL TO DECK SLAB REPAIR (FULL DEPTH).
 6. IT IS ESTIMATED THAT IN SPANS H2 THRU H4 THERE ARE 51 FLOOR DRAINS TO BE REMOVED.


FLOOR DRAIN REMOVAL

BEVELED WASHER DETAIL

NOTES: "S" EQUALS THE SLOPE OF THE SUPERELEVATION AT THE INDIVIDUAL SCUPPER LOCATION. THE BEVEL SHALL BE AS REQUIRED FOR VERTICAL INSTALLATION OF DOWN-SPOUT. DIMENSION "A" SHALL BE AS REQUIRED FOR THE PARTICULAR SCUPPER TYPE.

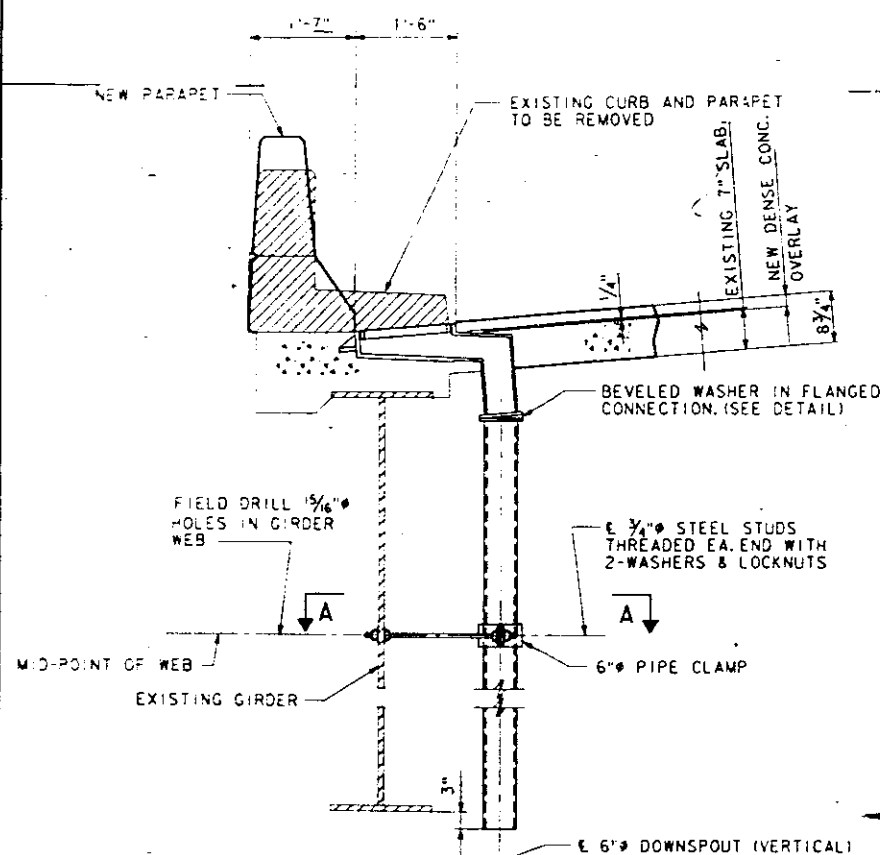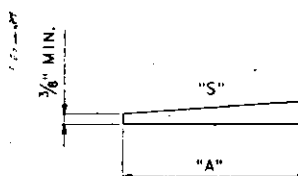

SECTION

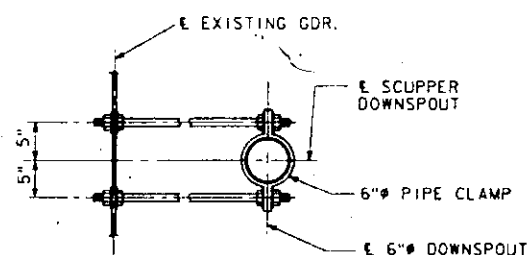

SECTION A-A

DRAINAGE SCUPPER

BILL OF MATERIAL

ITEM	UNIT	QUANTITY
DRAINAGE SCUPPERS	EACH	6

NOTE: FOR SPACING OF DRAINAGE SCUPPERS, SEE SHEET 3 OF 8.

REHABILITATION FOR
FAI - 55/70 COMPLEX
ROADWAY H - DECK REHABILITATION
SCUPPER DETAILS

STRUCTURE NO. 082-0256

STA. 78+47.00 TO STA. 81+65.00 (FAI-70) ST. CLAIR CO.




SHEET NO. 6 OF 8

PREPARED BY:
SVERDRUP CORPORATION
ST. LOUIS, MISSOURI

10136
875291
FILE: 2F3110.11SCUPPERH.DGN
PRT SCUPPER
LEVELS PLOTTED DATE: OCT 14, 1987
35 50 57 58 63




B. CARLSON
DESIGNED
P. HANSON
CHECKED
K. SCHULT
DRAWN
P. HANSON
CHECKED

82-3HV8-2R-1

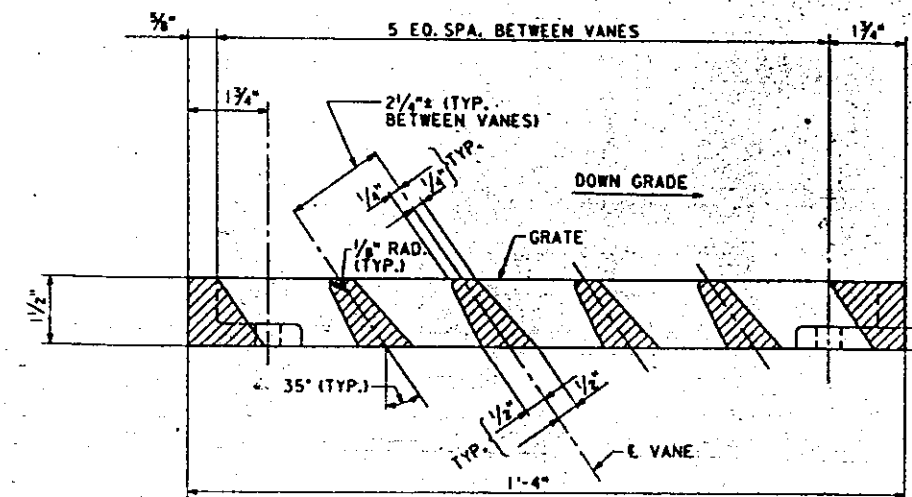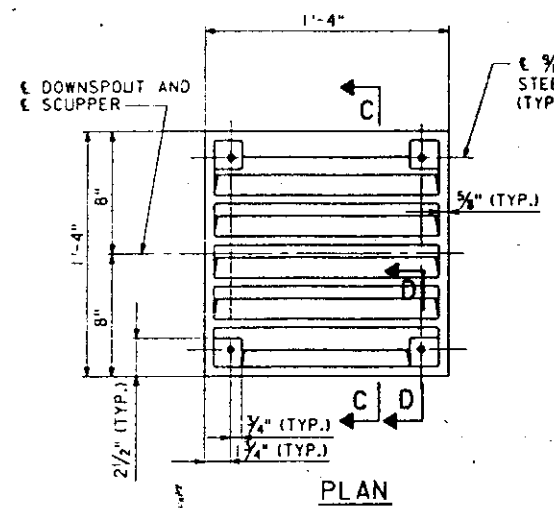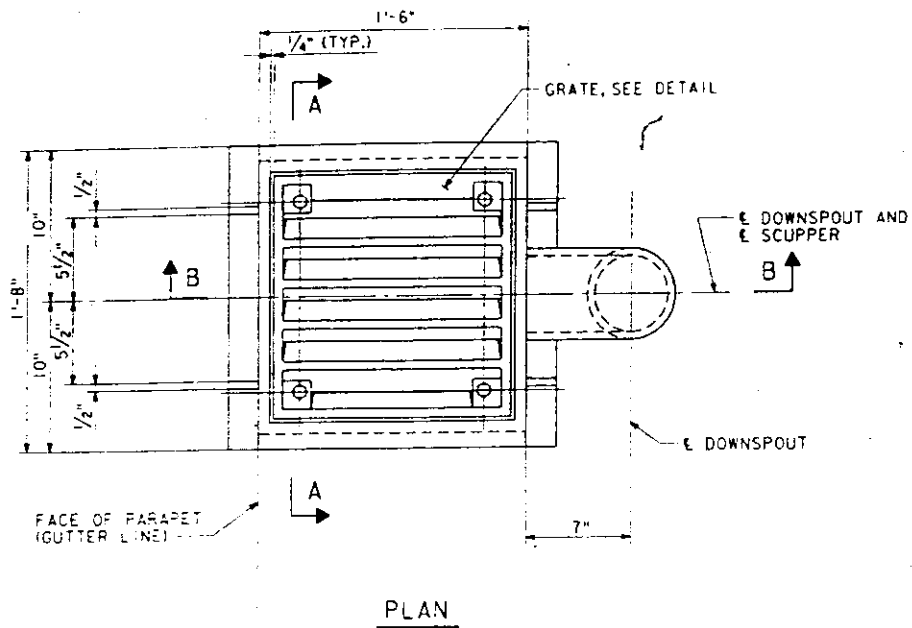

GRATE

NOTE: LOCATION OF HOLES FOR FASTENING GRATE TO CASTING TO SUIT MANUFACTURER'S REQUIREMENTS.

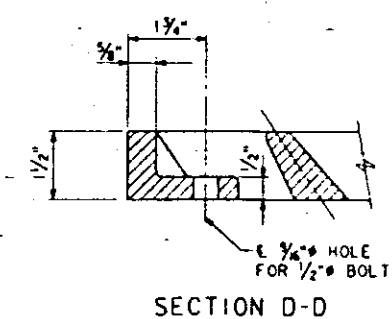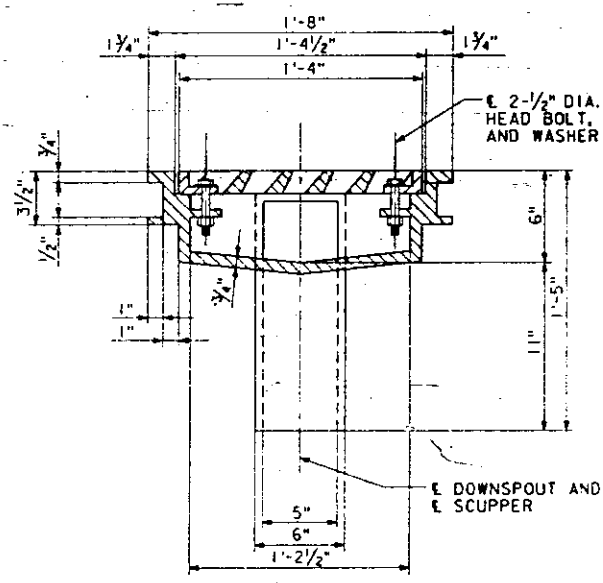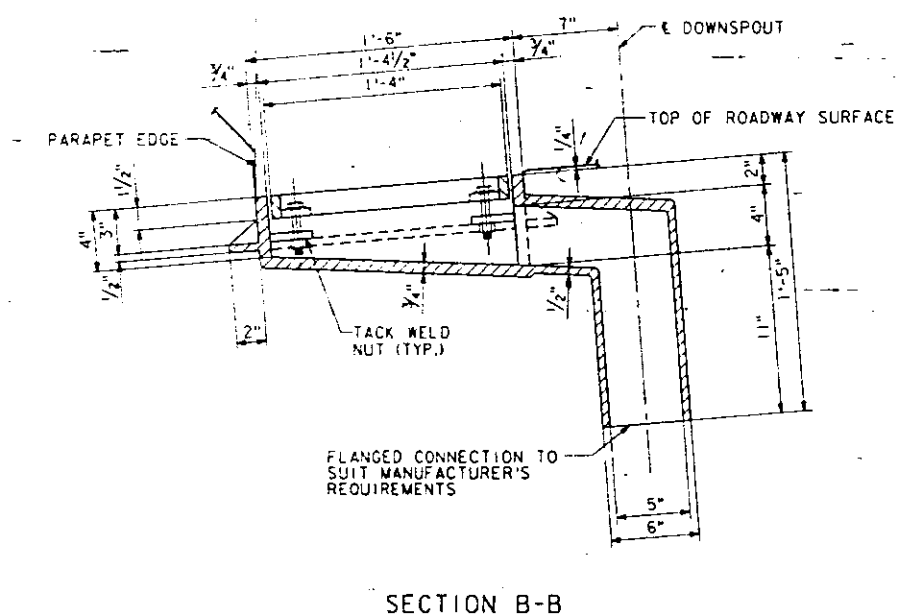

NOTES

ALL CAST IRON PARTS SHALL BE GRAY IRON CONFORMING TO THE REQUIREMENTS OF AASHTO M-105, CLASS 30.
BOLTS AND WASHERS SHALL CONFORM TO THE REQUIREMENTS OF ASTM A307.
ALL BOLTS AND WASHERS SHALL BE GALVANIZED IN ACCORDANCE WITH AASHTO M-232.
AS AN ALTERNATE, BOLTS AND WASHERS MAY BE STAINLESS STEEL CONFORMING TO THE REQUIREMENTS OF ASTM A-193 TYPE 304.
COST OF THE GRATE, FRAME, DOWNSPOUT, BOLTS AND WASHERS INCLUDING COMPLETE INSTALLATION OF SCUPPER SHALL BE PAID FOR AT THE UNIT BID PRICE FOR "DRAINAGE SCUPPERS".
A MATERIAL SUCH AS GREASE SHOULD BE USED AS A TREATMENT FOR THE BOLTS ANCHORING THE GRATE TO THE FRAME.

DRAINAGE SCUPPER

NOTE: FOR CONNECTION OF SCUPPER TO DOWNSPOUT AND DOWNSPOUT TO GIRDER, SEE SHEET 6 SCUPPER DETAILS.

BILL OF MATERIAL

ITEM	UNIT	QUANTITY
DRAINAGE SCUPPERS	EACH	6

REHABILITATION FOR
FAI - 55770 COMPLEX
CAST IRON DRAINAGE SCUPPER

STRUCTURE NO. 082-0256
STA. 78+47.00 TO STA. 81+65.00 (FAI-70) ST. CLAIR CO.

PREPARED BY:
SVERDRUP CORPORATION
ST. LOUIS, MISSOURI

REV. 8/26/88

SHEET NO. 7 OF 8

10320 FILE:ZF3C110J1C1SCUPH.DGN
875012 PRF: CISCUPH

G.J. DEE
DESIGNED
CHECKED
R. ROTH
DRAWN
R. BUTTERFIELD
CHECKED

LEVELS PLOTTED DATE: OCT. 14, 1987
35 56 57 58

STATE OF ILLINOIS
DEPARTMENT OF TRANSPORTATION

* 82-3HVB-2R-1(F)				
F.A.I. ROUTE NO.	SEC.	COUNTY	TOTAL SHEETS	SHEET NO.
70	*	ST. CLAIR	89	1
ILLINOIS PROJECT NO. R-70-1(157)				
P-98-021-85				

SEE SHEET NO. FOR INDEX OF SHEETS

THE STRUCTURES REHABILITATED IN THIS PROJECT WERE BUILT AS SECTIONS:

- 82-4HB
- 82-4HB-1
- 82-3HVF&E-1
- 82-4HVB

PLANS FOR PROPOSED
FEDERAL AID HIGHWAY

SCALE IN FEET


PLAN 1 INCH 50 FT.
PROFILE HOR. 1 INCH 50 FT.
VERT. 1 INCH 5 FT.
CROSS-SECTIONS
HOR. 1 INCH 10 FT.
VERT. 1 INCH 5 FT.

F.A.I. ROUTE 70
SECTION 82 - 3HVB - 2R - 1(F)
PROJECT : 70-1(157)1
ST. CLAIR COUNTY

C-98-005-66

INDEX OF SHEETS

- | | |
|-----------|---|
| Sheet No. | |
| 1 | Title Sheet |
| 2 | Summary of Quantities |
| 3-20 | Roadway A, G & D Deck Rehabilitation |
| 21-38 | Ramp R |
| 39-52 | Ramp Q, P & Roadway H |
| 53-57 | Roadway H over Trendley Avenue |
| 58-66 | Ramp G over 4 th Street |
| 67-73 | Ramp C over 4 th Street |
| 74-89 | Roadway B & C over Broadway and Main Street |

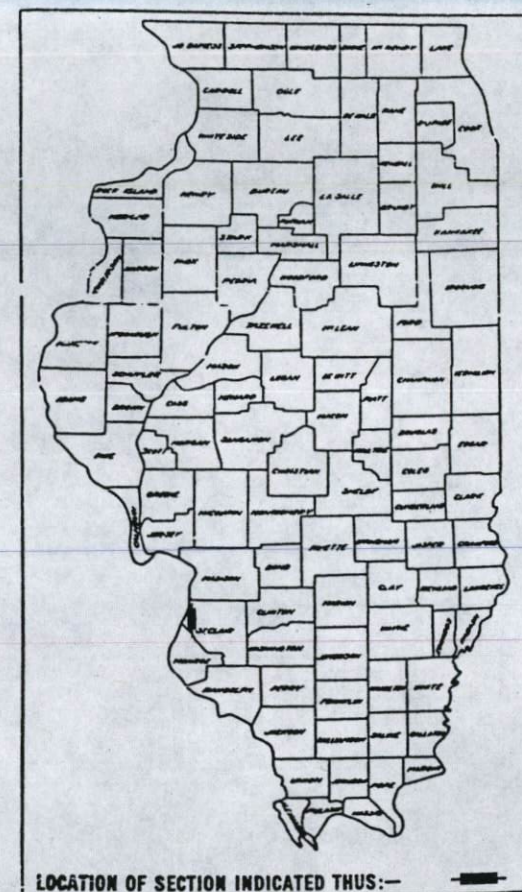

LOCATION OF SECTION INDICATED THIS:—

Sec. 82-3HVB-2R-1(F)
82-4
82-4 JRS
82-4HB
82-3HVB-2R-1

MICROFILMED _____
REEL NUMBER _____
AWARDED _____
RESIDENT ENGINEER _____
AS BUILT CHANGES WERE MADE ON THE FOLLOWING SHEETS

DESIGN DESIGNATION
C-D'S 2 LANES: 1800(06) TRUNK 17.6(C-20)



PROJECT
ENDS 115 + 34.53 E.B. I-55/70
EQUATION: 111 + 70.90 E.B. C-D BK.=
109 + 38.40 E.B. I-55/70 AHD.

PROJECT
BEGINS 59+00.14 E.B. C-D

1000 0 1000 2000 3000
SCALE IN FEET

NET LENGTH OF PROJECT - 5,865.89 FT. - 1.111 MILES

PREPARED BY:
SVERDRUP CORPORATION
ST. LOUIS, MISSOURI


Reels 8-166
8-107
8-63
8-59
8-171

CARLOS A. LIZANA-FARIAS
NO. 81-3956

STATE OF ILLINOIS DEPARTMENT OF TRANSPORTATION	
SUBMITTED	<i>[Signature]</i>
EXAMINED	7-24-87
PASSED	<i>[Signature]</i>
APPROVED	7-24-87
DIRECTOR OF HIGHWAYS	

CONTRACT NO. 42835

ST. CLAIR COUNTY SECTION 82-3HVB-2R-1(F) F.A.I. ROUTE 70

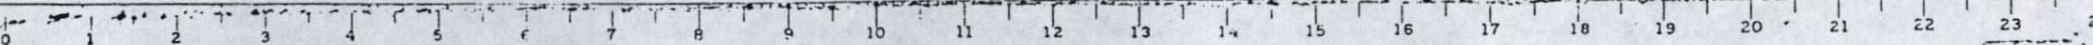

082-0140

5/19/87

REEL 8-166
002-0256

SUMMARY OF QUANTITIES

CODE NO.	ITEM	UNIT	QUANTITY	CONSTRUCTION TYPE CODE														
				X 171-50	X 271-2A	X 571-50	X 171-50	X 171-50	X 271-2A	X 271-2A	X 271-2A	X 571-50						
				ROADWAY A BRIDGE OVER RAILROAD	ROADWAY G BRIDGE OVER ROAD	ROADWAY D BRIDGE OVER ROAD & R.R.	RAMP R BRIDGE OVER RAILROAD	RAMPS Q & P BRIDGE OVER RAILROAD	ROADWAY H BRIDGE OVER TRENDLEY AVE.	RAMP C BRIDGE OVER 4TH STREET	ROADWAY C BRIDGE OVER 4TH STREET	ROADWAY C BRIDGE OVER BROADWAY						
X5032700	FURNISHING ELASTOMERIC BEARING ASSEMBLIES, TYPE 1	EACH	6															
X5032800	FURNISHING ELASTOMERIC BEARING ASSEMBLIES, TYPE 2	EACH	3															
50700200	FURNISHING STRUCTURAL STEEL	LUMP SUM	1	0.01	0.01	0.02	0.45	0.19	0.01	0.01	0.07	0.23						
X0320235	FURNISHING REINFORCED NEOPRENE EXPANSION JOINT TREATMENT	LIN. FT.	224	37	41	146												
X5033600	FURNISHING ELASTOMERIC BEARING ASSEMBLIES (SPECIAL)	EACH	36				36											
X5072500	STORAGE OF STRUCTURAL STEEL	CAL. MONTH	12	0.5	0.5	1.0	3.0	2.0	0.25	0.75	1.5	2.5						
X5072600	DELIVERY OF STRUCTURAL STEEL	LB.	1,817,535	11,520	12,940	44,455	823,780	341,480	5,840	25,100	131,440	420,980						
G5000100	MOBILIZATION	L. SUM	1	0.1	0.1	0.1	0.2	0.1	0.1	0.1	0.1	0.1						
				082-0141	082-0254	082-0144	082-0253	082-0255	082-0256	082-0140								

SCHEDULE OF QUANTITIES - STRUCTURAL STEEL

ITEM	ROADWAY A	ROADWAY G	ROADWAY D	RAMP R	RAMPS Q & P	ROADWAY H OVER TRENDLEY	RAMP C OVER 4TH STREET	ROADWAY C OVER 4TH STREET	ROADWAY C OVER BROADWAY AND MAIN STREET	TOTAL (LBS.)
M-183	11,520	12,940	44,455	573,180	341,480	3525	25,100	131,440	420,000	1,563,640
M-223 (GRADE 50)				250,600		2315			980	253,895

10320 FILE: 2F31110.1JUMBRO.DGN
 8TS461 PRF: JUMBRO
 CHE. BY: G.T.D.
 LEVELS PLOTTED DATE: JUNE 23, 1987
 1 2 63

SUMMARY
OF
QUANTITIES

STATE OF ILLINOIS
DEPARTMENT OF TRANSPORTATION
INDEX OF DRAWINGS

ROUTE NO.	SECTION	COUNTY	TOTAL SHEETS	SHEET NO.
F.A.I. 70		ST. CLAIR	85	3
		ILLINOIS	PROJECT	

* B2-3HVB-2R-1(F)

GENERAL NOTES

The Zinc-silicate and vinyl paint system shall be used for shop and field painting of Structural Steel except where otherwise noted.

REINFORCING BARS SHALL CONFORM TO THE REQUIREMENTS OF AASHTO M 31, M-42 OR M 53, GRADE 60.

PLAN DIMENSIONS AND DETAILS RELATIVE TO EXISTING STRUCTURE HAVE BEEN TAKEN FROM EXISTING PLANS, AND ARE SUBJECT TO NOMINAL CONSTRUCTION VARIATIONS. IT SHALL BE THE CONTRACTOR'S RESPONSIBILITY TO VERIFY SUCH DIMENSIONS AND DETAILS IN THE FIELD AND MAKE NECESSARY APPROVED ADJUSTMENTS PRIOR TO CONSTRUCTION BEFORE ORDERING OF MATERIALS. SUCH VARIATIONS SHALL NOT BE CAUSE FOR ADDITIONAL COMPENSATION FOR A CHANGE IN SCOPE OF WORK. HOWEVER, THE CONTRACTOR WILL BE PAID FOR THE QUANTITY ACTUALLY FURNISHED AT THE UNIT PRICE BID FOR THE WORK.

DIMENSIONS ARE MEASURED AT A TEMPERATURE OF 50°F.

ALL TRANSVERSE AND LONGITUDINAL DIMENSIONS ARE MEASURED HORIZONTALLY.

IF SECTION MONUMENTS AND/OR PERMANENT BENCHMARKS ARE ENCOUNTERED WITHIN THE PAVEMENT OR PARAPET AREAS BEING REHABILITATED, THE CONTRACTOR SHALL ADJUST SAME AS DIRECTED BY THE ENGINEER. PAYMENT TO BE MADE IN ACCORDANCE WITH ARTICLE 509.04 OF THE "STANDARD SPECIFICATIONS".

THE ROADWAY EXPANSION PLATES SHALL BE FLAME CUT AS PROVIDED IN ARTICLE 507.04 (I) OF THE STANDARD SPECIFICATIONS.

CALCULATED WEIGHT OF STRUCTURAL STEEL (M-183):
ROADWAY A = 11,520 LB.
ROADWAY G = 12,940 LB.
ROADWAY D = 44,455 LB.

* INDICATES HIGH STRENGTH BOLT, SHOP OR FIELD INSTALLED UNLESS OTHERWISE NOTED.

Roadway expansion guards shall be assembled in the proper position with the ends in place and shall be left assembled for shop inspection

1 GENERAL NOTES, ESTIMATED QUANTITIES AND INDEX OF DRAWINGS

- ROADWAY A
2 GENERAL PLAN AND ELEVATION SPANS A18 THRU A24
3 CROSS SECTIONS AND DETAILS
4 PARAPETS - SPANS A18 THRU A20
5 PARAPETS - SPANS A21 THRU A24
6 PARAPET DETAILS
7 PARAPETS - SLIDING PLATE DETAILS
8 PARAPET TRANSITION - SPAN A18
9 SCUPPER DETAILS AND FLOOR DRAINS
10 FINGER PLATE DETAILS AT PIER A25
10A MISCELLANEOUS DETAILS

- ROADWAY G
11 GENERAL PLAN AND ELEVATION SPANS G1 THRU G4
12 GENERAL PLAN AND ELEVATION SPANS G5 THRU G13
13 PARAPETS - SPANS G1 THRU G4
14 PARAPETS - SPANS G5 THRU G8
15 PARAPETS - SPANS G9 THRU G13
16 PARAPET DETAILS
17 PARAPET TRANSITION - SPAN G1
18 EXPANSION JOINT DETAILS
18A FINGER PLATE DETAILS AT PIER G5
19 SCUPPER DETAILS
20 MISCELLANEOUS DETAILS

- ROADWAY D
20A GENERAL PLAN AND ELEVATION SPANS D1 THRU D17
20B GENERAL PLAN AND ELEVATION SPANS D18 THRU D21
21 GENERAL PLAN AND ELEVATION SPANS D22 THRU D25
22 GENERAL PLAN AND ELEVATION SPANS D26 THRU D32
23 PARAPETS - SPANS D22 THRU D25
24 PARAPETS - SPANS D26 THRU D29
25 PARAPETS - SPANS D30 THRU D32
26 PARAPET DETAILS
27 EXPANSION JOINT DETAILS AND PARAPET TRANSITION
28 EXPANSION JOINT DETAILS
29 FINGER PLATE DETAILS AT PIERS D22, D28 & D33
29A FINGER PLATE DETAILS AT PIERS D22, D28 & D33
30 SCUPPER DETAILS
31 MISCELLANEOUS DETAILS
31A FINGER PLATE DETAILS AT PIER D15

- ROADWAYS A, G & D
32 NEOPRENE EXPANSION JOINTS - 2" DIA AND 4"
33 STEEL DRAINAGE SCUPPER
34 ALTERNATE - CAST IRON DRAINAGE SCUPPER

NOT IN CONTRACT

NOT IN CONTRACT

	SIGN BRACKET LOCATIONS		
	STATION	LEFT PARAPET	RIGHT PARAPET
RDWY. A	66+90 (E RDWY.)	•	•
	69+95 (E RDWY.)	•	•
	72+90 (E RDWY.)	•	•
RDWY. G	69+10 (E RDWY.)	•	•
	72+55 (E RDWY.)	•	•
	75+45 (E RDWY.)	•	•
	79+15 (E RDWY.)	•	•
RDWY. D	76+50 (E RDWY.)	•	•
	80+50 (E RDWY.)	•	•
	83+65 (E RDWY.)	•	•
	87+30 (E RDWY.)	•	•

NOTE: LEFT AND RIGHT PARAPETS ARE ORIENTED LOOKING AHEAD STATIONING.

TOTAL BILL OF MATERIAL				
ITEM	UNIT	ROADWAY A	ROADWAY G	ROADWAY D
		SUPERSTR.	SUPERSTR.	SUPERSTR.
FURNISHING STRUCTURAL STEEL	LUMP SUM	.51	.61	.02
FURNISHING REINFORCED NEOPRENE EXPANSION JOINT TREATMENT	LN. FT.	37	41	146

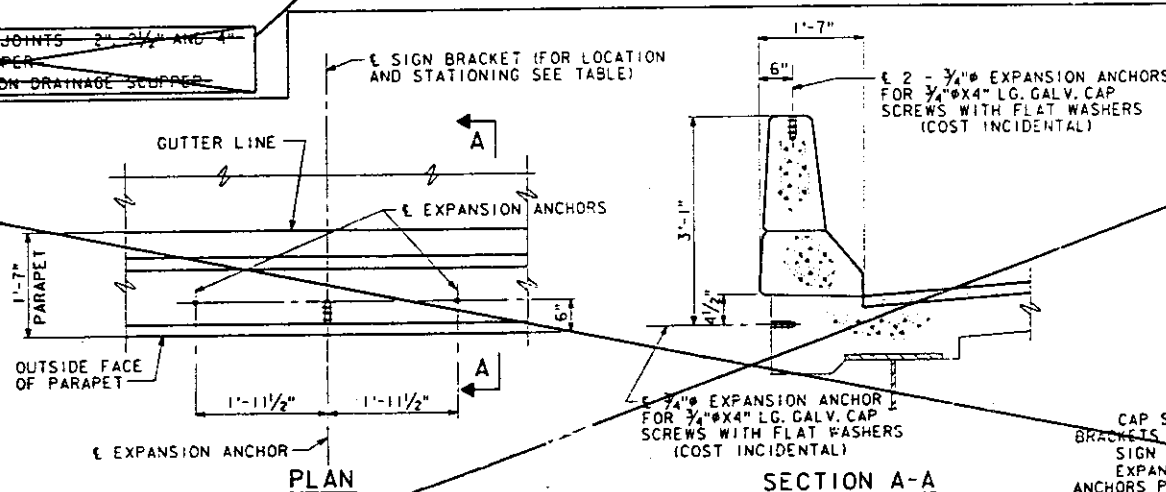

PARAPET EXPANSION ANCHOR DETAILS FOR MAINTENANCE AND CONSTRUCTION SIGN SUPPORT BRACKETS

NOTES

CAP SCREWS SHALL BE LEFT IN PLACE WHEN SIGN BRACKETS ARE NOT ATTACHED.
SIGN BRACKETS SHALL BE FURNISHED BY IDOT.
EXPANSION ANCHORS SHALL BE APPROVED EXPANSION ANCHORS PROVIDING A MINIMUM CERTIFIED PROOF LOAD = 4,080 LBS.


REHABILITATION FOR
FAI - 55/70 COMPLETE
ROADWAYS A, G AND D-DECK REHABILITATION ON
GENERAL NOTES, ESTIMATED QUANTITIES AND INDEX OF DRAWINGS
STRUCTURE NO. 082-0141 (ROADWAY A)
STRUCTURE NO. 082-0254 (ROADWAY G)
STRUCTURE NO. 082-0144 (ROADWAY D)
(FAI-70) ST. CLAIR CO.

PREPARED BY:
SVERDRUP CORPORATION
ST. LOUIS, MISSOURI

SHEET NO. 1 OF 34

LEVELS PLOTTED DATE: JUNE 23, 1987
35, 56, 58, 63
10320 FILE: ZF3(110) DET1.DGN
BTS305 PRF: DET1

DESIGNED
D. RIEHL
CHECKED
G. DEE

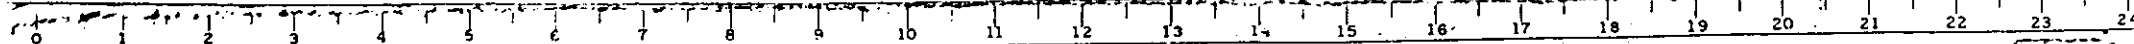

STATE OF ILLINOIS
DEPARTMENT OF TRANSPORTATION

PLANS FOR PROPOSED
SUPERSTRUCTURE REPAIRS

FAI ROUTE 70
SECTION 82-3HVB-IR
PROJ. ACIR-70-1(147)1
POPLAR STREET BRIDGE APPROACHES
ST. CLAIR COUNTY

C-98-115-85


INDEX OF SHEETS	
SHEET NO.	DESCRIPTION
1	TITLE SHEET
2	PROJECT KEY PLAN
3	KEY PLAN FOR ROADWAYS A - H
4	KEY PLAN FOR RAMPS M - T
5	BEARING STIFFENER RETROFIT DETAILS
6	INTERIOR, NON BEARING STIFFENER RETROFIT DETAILS
7	REPAIR DETAIL LOCATIONS; ROADWAYS A,B,C
8	REPAIR DETAIL LOCATIONS; ROADWAYS D - H
9	REPAIR DETAIL LOCATIONS; RAMPS M - R
10	REPAIR DETAIL LOCATIONS; RAMPS S, T + MISCELLANEOUS DETAILS
11	TRAFFIC CONTROL AND PROTECTION

STANDARDS: 2298-7, 2299-10, 2300-3

Sec. 82-3HVB-1R
82-3HVB-R-5
82-3HVB-R-2
82-3-3DRS
82-3HVB-R-4

REF. SEE 82-3HVB-1R SEE S.N. 0141
82-3HVB-2R-1 SEE S.N. 0142
82-3HVB-2R-1(F) SEE S.N. 0143
82-3HVB-R SEE S.N. 0005
82-3HVB-1 SEE S.N. 0141
82-3HVB-R-5 SEE S.N. 0144
82-3HVB SEE S.N. 0005


MICROFILMED _____
REEL NUMBER _____
AWARDED _____
RESIDENT ENGINEER _____
AS BUILT CHANGES WERE MADE
ON THE FOLLOWING SHEETS

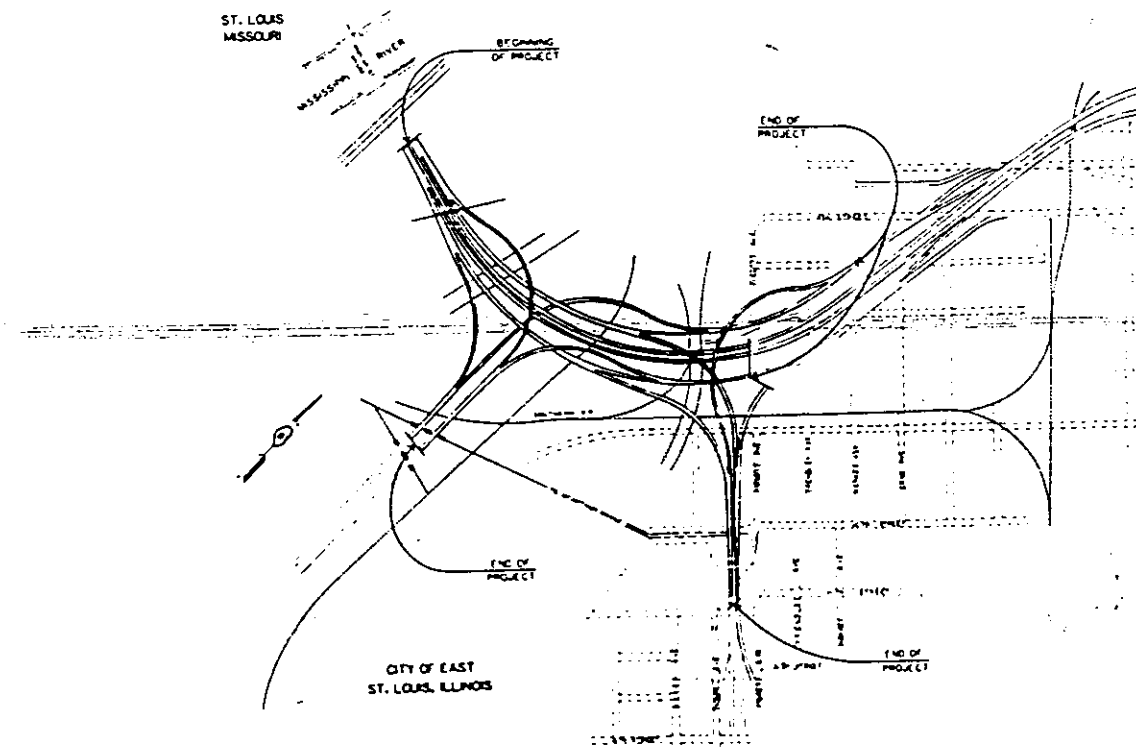

SECTION NO.	SEC.	COUNTY	SECTION NO.	SHEET NO.
FAI.70	82-3HVB-IR	ST. CLAIR	11	1

82-3HVB-IR

P-98-078-83

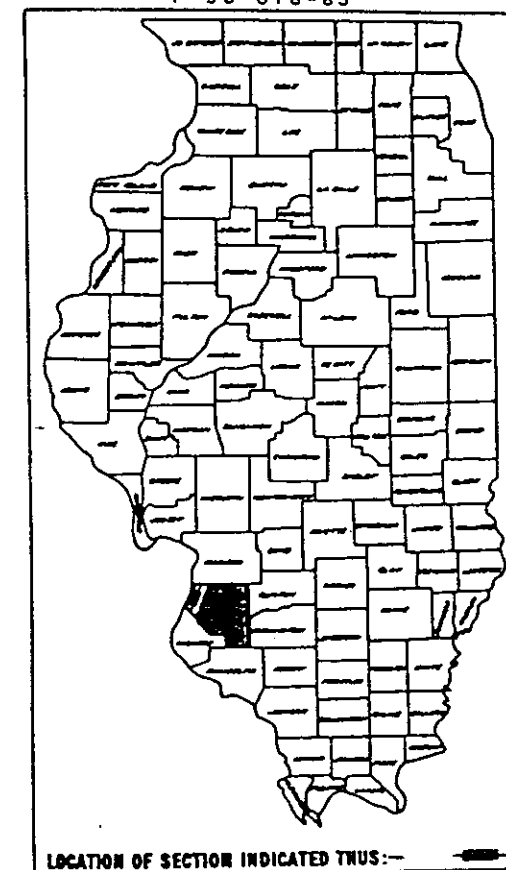

LOCATION OF SECTION INDICATED THUS:—

Reels 8-110
8-112
8-147
8-151
8-159

STATE OF ILLINOIS
DEPARTMENT OF TRANSPORTATION

Michael J. Pitt
March 27, 86

Michael J. Pitt
March 27, 86


Michael J. Pitt
March 27, 86

DEPARTMENT OF TRANSPORTATION
FEDERAL HIGHWAY ADMINISTRATION

APPROVED _____

DATE _____

DESIGN ADMINISTRATOR _____

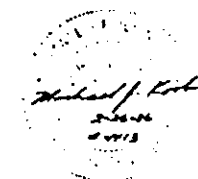


8-159

CONTRACT NO. 40769

ST. CLAIR COUNTY SECTION 82-3HVB-IR FAI ROUTE 70

NET LENGTH OF PROJECT - 166 MILES

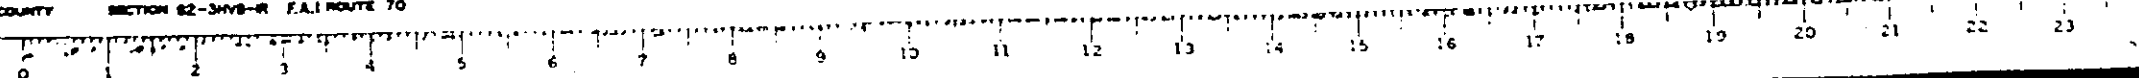

NO.	DATE	BY	REVISION
70	REVISION	ST. CLAIR	11 2

SUMMARY OF QUANTITIES			SFTY-2D
CODE No	ITEM	UNIT	QUANTITY
X09954	Structural Steel Repairs, Type 1	Each	355
X09955	Structural Steel Repairs, Type 2	Each	732
X09956	Removal and Replacement of Existing Traffic Signs	Each	8
X09957	Cleaning and Painting Previously Repaired Connections	Each	20
X09958	Traffic Control for Repair Locations Above Another Roadway	Each	36
Z10527	TRAINEES	HOUR	1500
650001	MOBILIZATION	L SUM	1

GENERAL NOTES

1. Design criteria=A.A.S.H.T.O. Standard Specifications for Highway Bridges, 1983 Edition.
2. New fasteners shall be high-strength bolts, 1/2 inch ϕ , unless noted otherwise.
3. Plan conditions, dimensions, and details relative to the existing structure have been taken from existing plans and are subject to normal construction variations. It shall be the Contractor's responsibility to verify such conditions, dimensions, and details in the field, and make necessary approved adjustments prior to construction. Such variations shall not be cause for additional compensation for a change in scope of work. However, the Contractor will be paid for the quantity actually furnished at the unit price bid for the work.

MAJOR WORK ITEMS

1. Installation of structural steel repair Type 1 at bearing stiffener connections between floor beams above piers and main girders above piers at continuous supports.
2. Installation of structural steel repair Type 2 at non-bearing stiffener connections between first interior floor beams and main girders.
3. Removal and replacement of existing traffic signs and support brackets where they interfere with Type 1 repairs.
4. Cleaning and painting of connections between floor beams and main girder which have been previously retrofitted with metal repairs.
5. Provide traffic control and protection for repair locations which are located above another roadway.


PROJECT KEY PLAN

STATE OF ILLINOIS
DEPARTMENT OF TRANSPORTATION
SUPERSTRUCTURE REPAIRS


FAI ROUTE 70
POPLAR STREET BRIDGE APPROACHES
ST. CLAIR COUNTY

SCALE: NONE
DATE 2/26/86



DRAWN BY: GSA
CHECKED BY: TLR

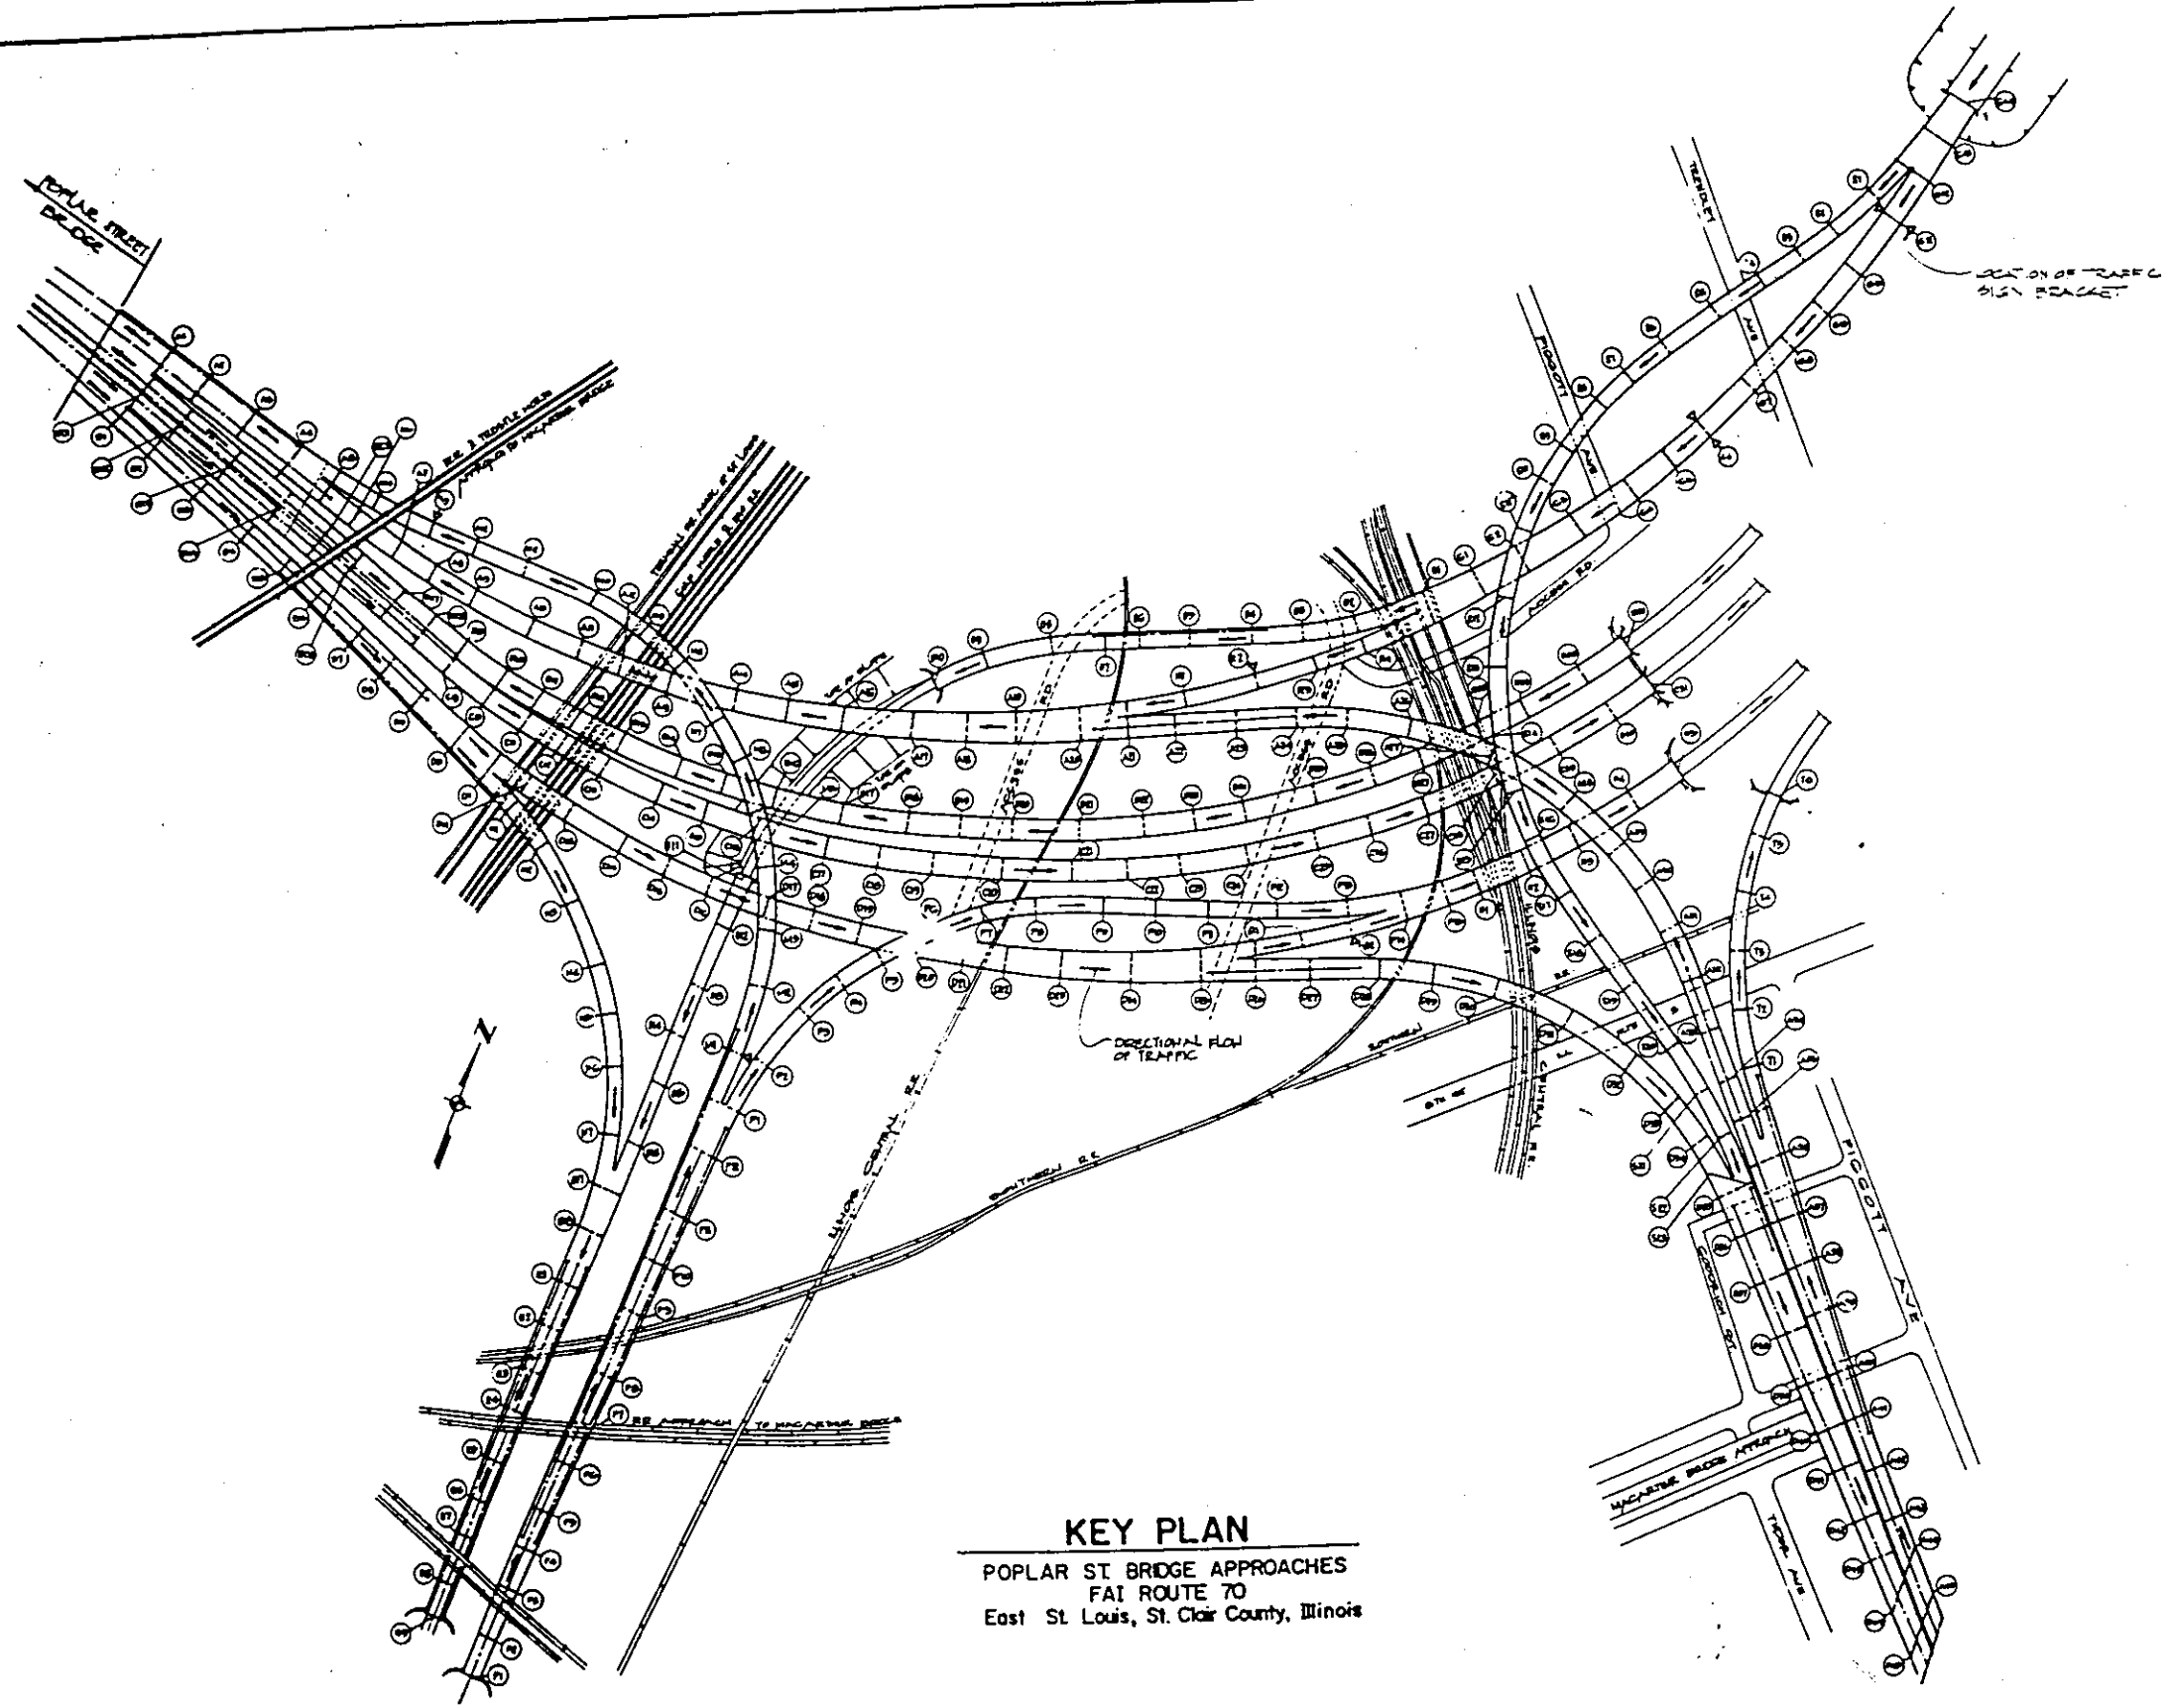

KEY PLAN
POPLAR ST BRIDGE APPROACHES
FAI ROUTE 70
East St. Louis, St. Clair County, Illinois

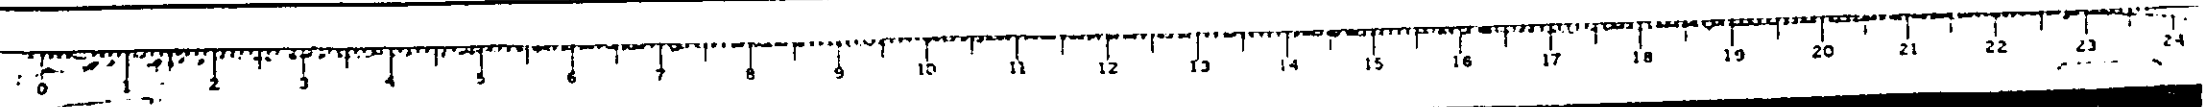

NO.	DATE	BY	REVISION
70	12-3-66	ST. CLAIR	11
			3

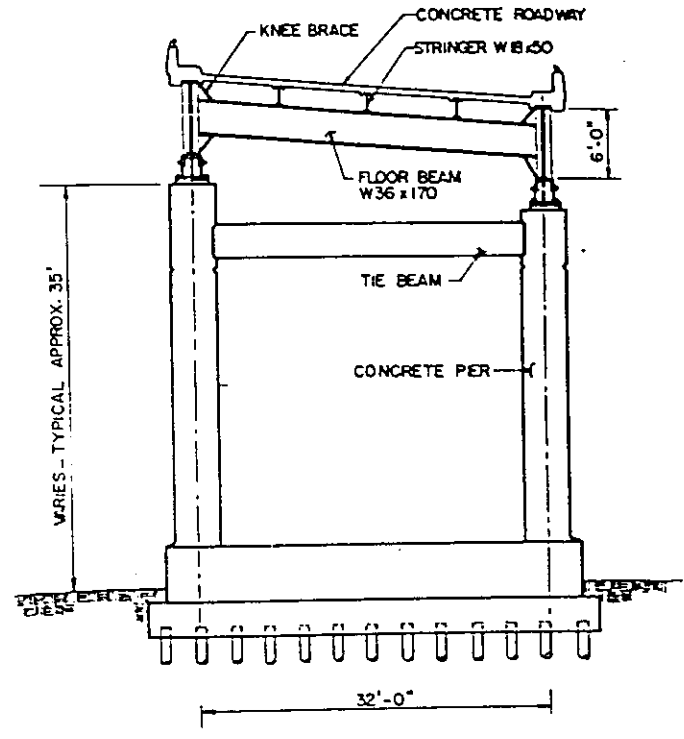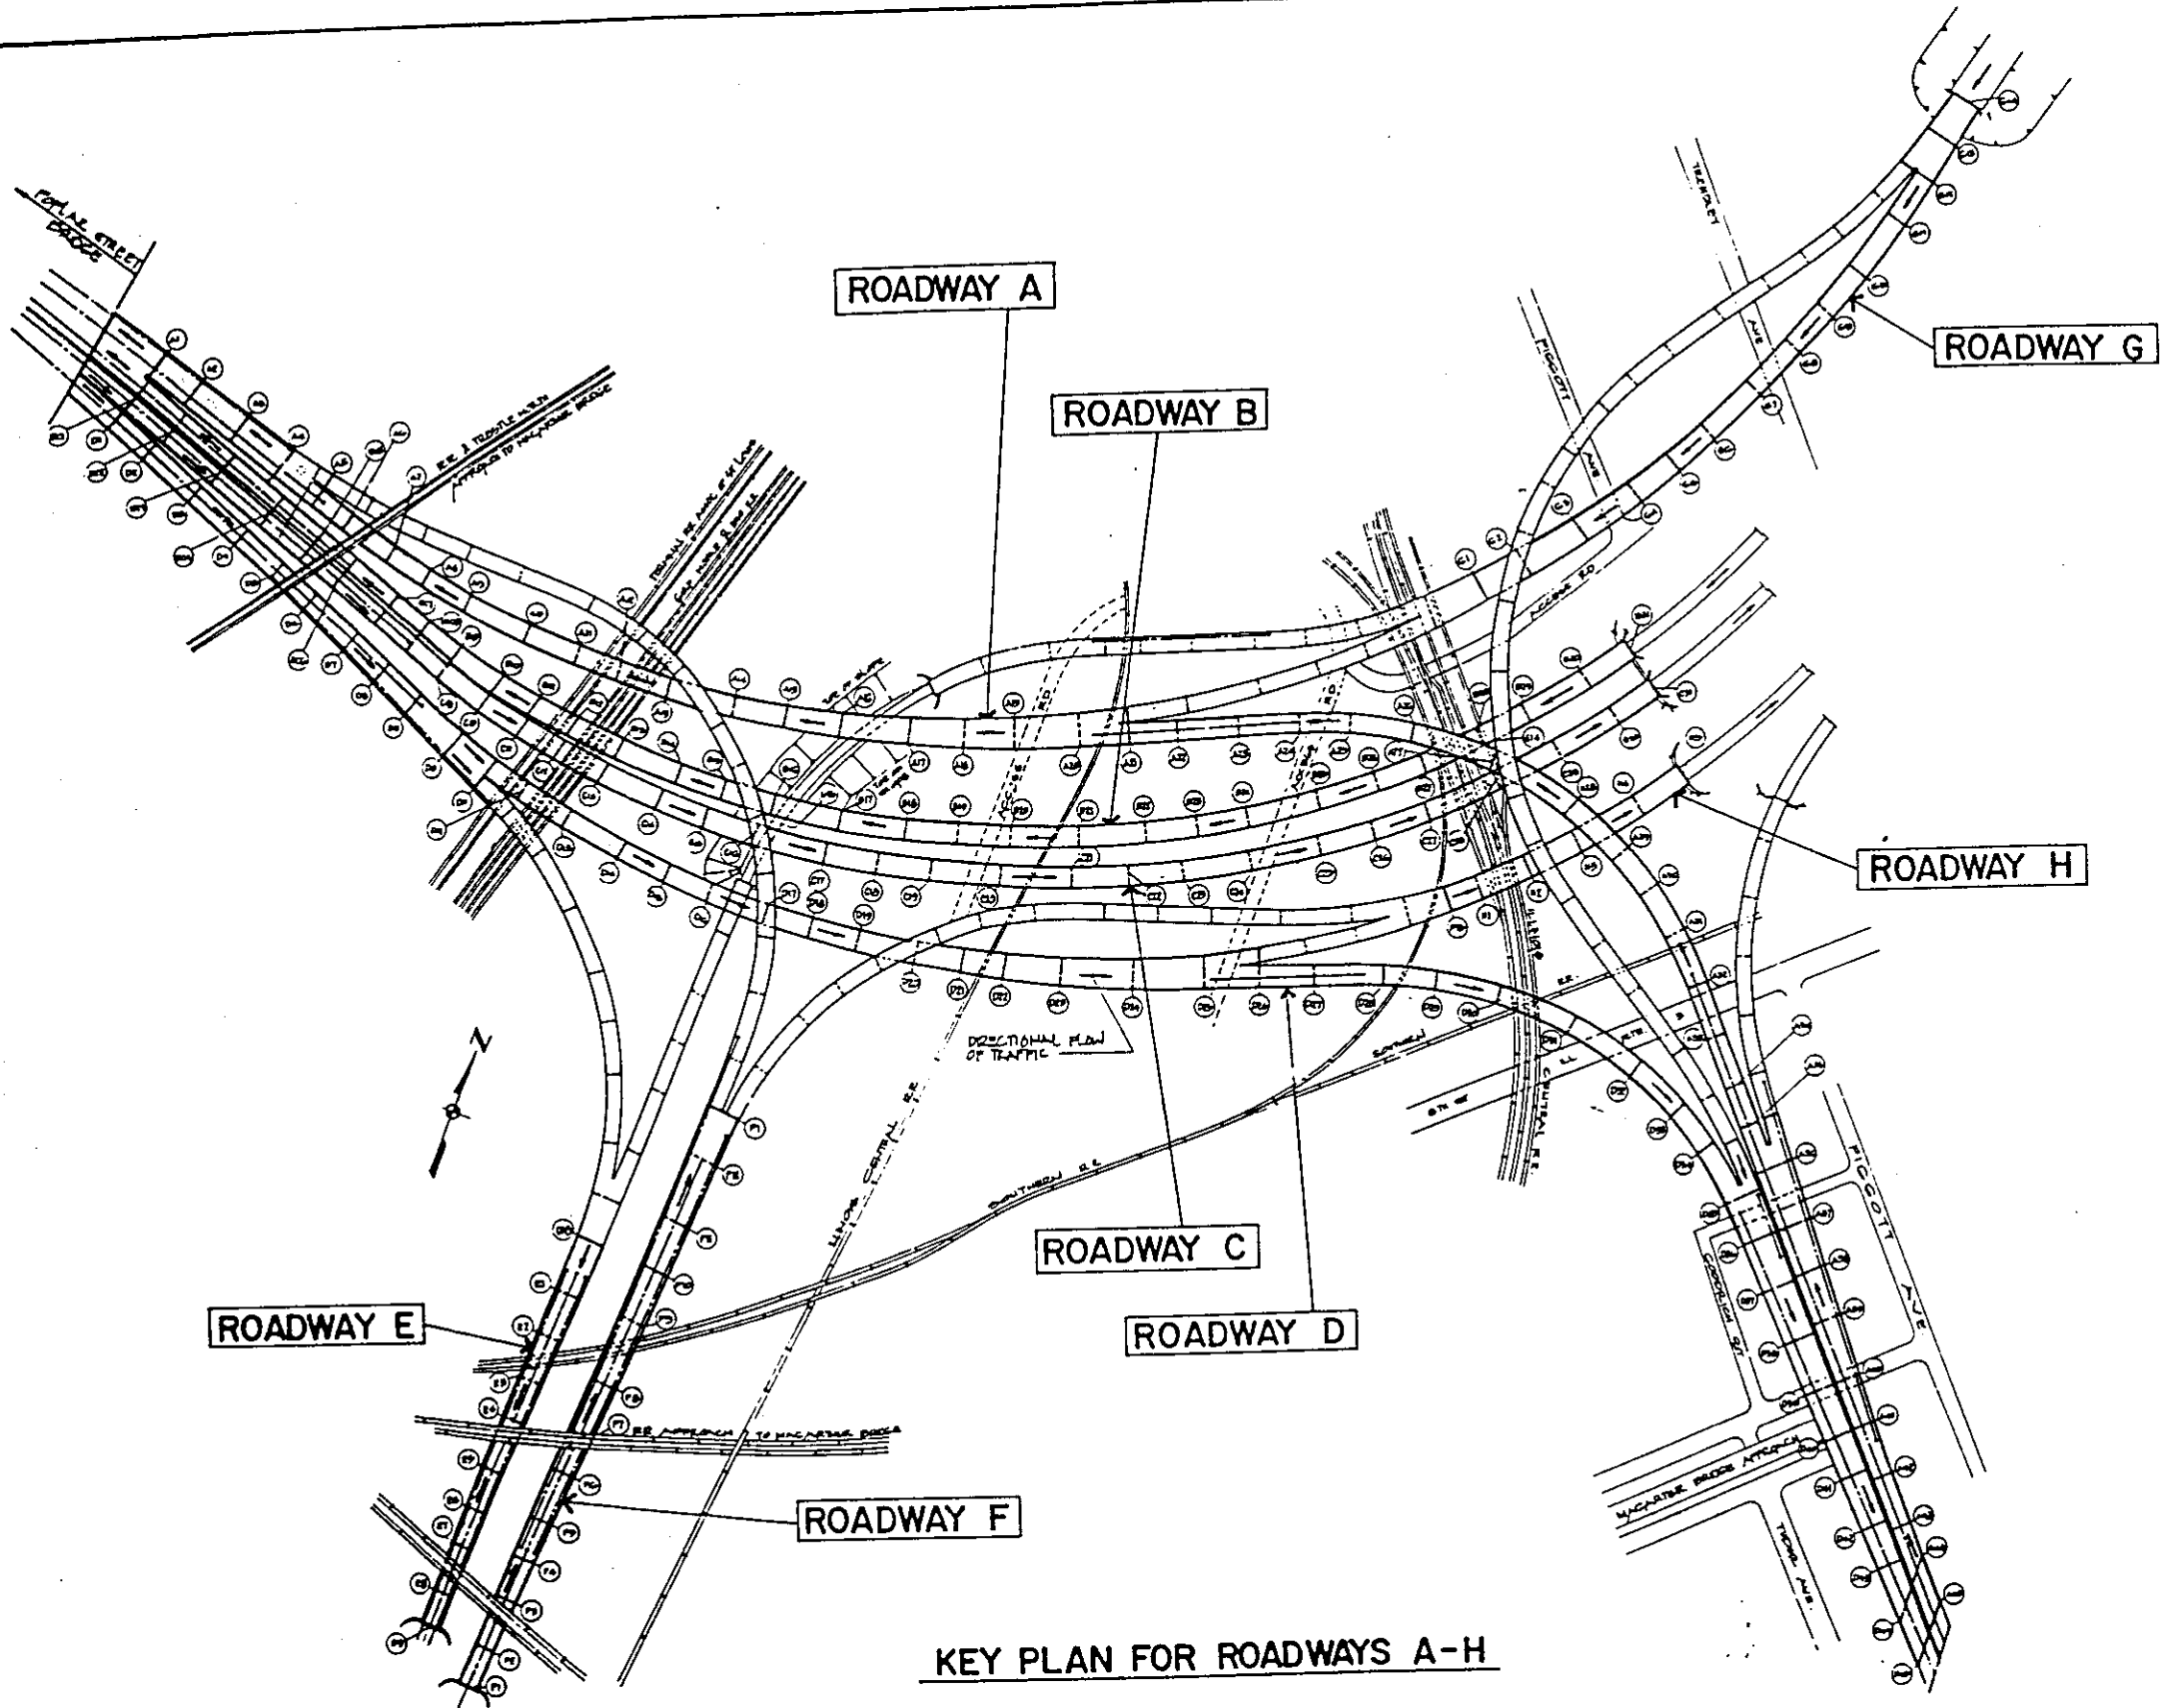

TYPICAL SECTION THROUGH ROADWAY
(Section through Ramp Similar)

KEY PLAN FOR ROADWAYS A-H


KEY PLAN FOR ROADWAYS A-H

STATE OF ILLINOIS
DEPARTMENT OF TRANSPORTATION
SUPERSTRUCTURE REPAIRS



FAI ROUTE TO
POPULAR STREET BRIDGE APPROACHES
ST. CLAIR COUNTY

SCALE: NONE
DATE 2/26/66

DRAWN BY: GSA
CHECKED BY: TLR

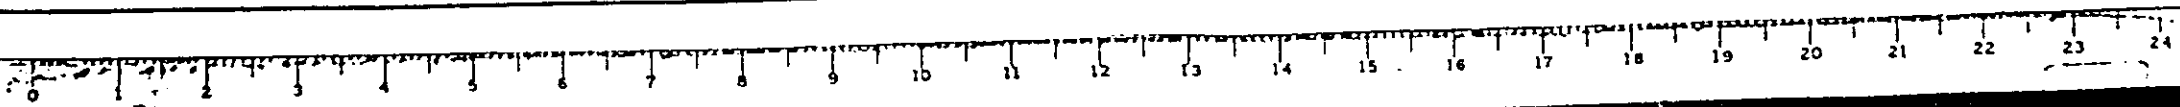


NO.	DATE	BY	CHKD.	APP.
70	02-24-66	ST. CLAIR	11	4
<small>FOR THE USE OF THE CONTRACTOR</small>				

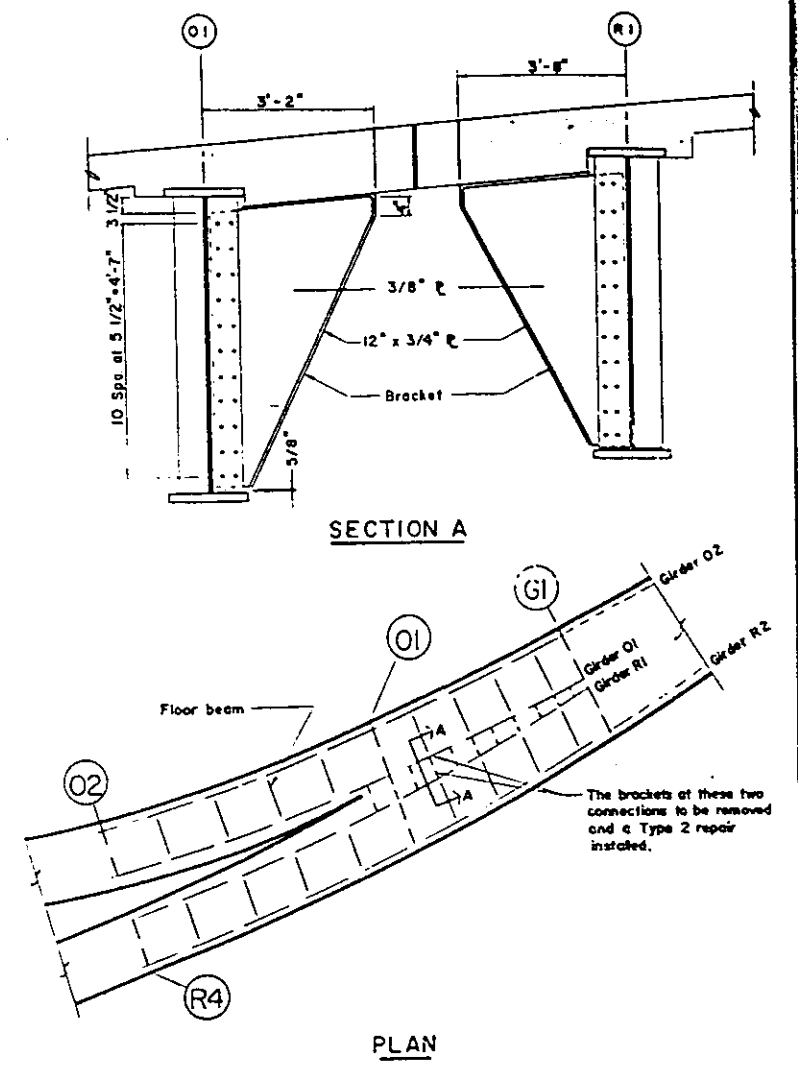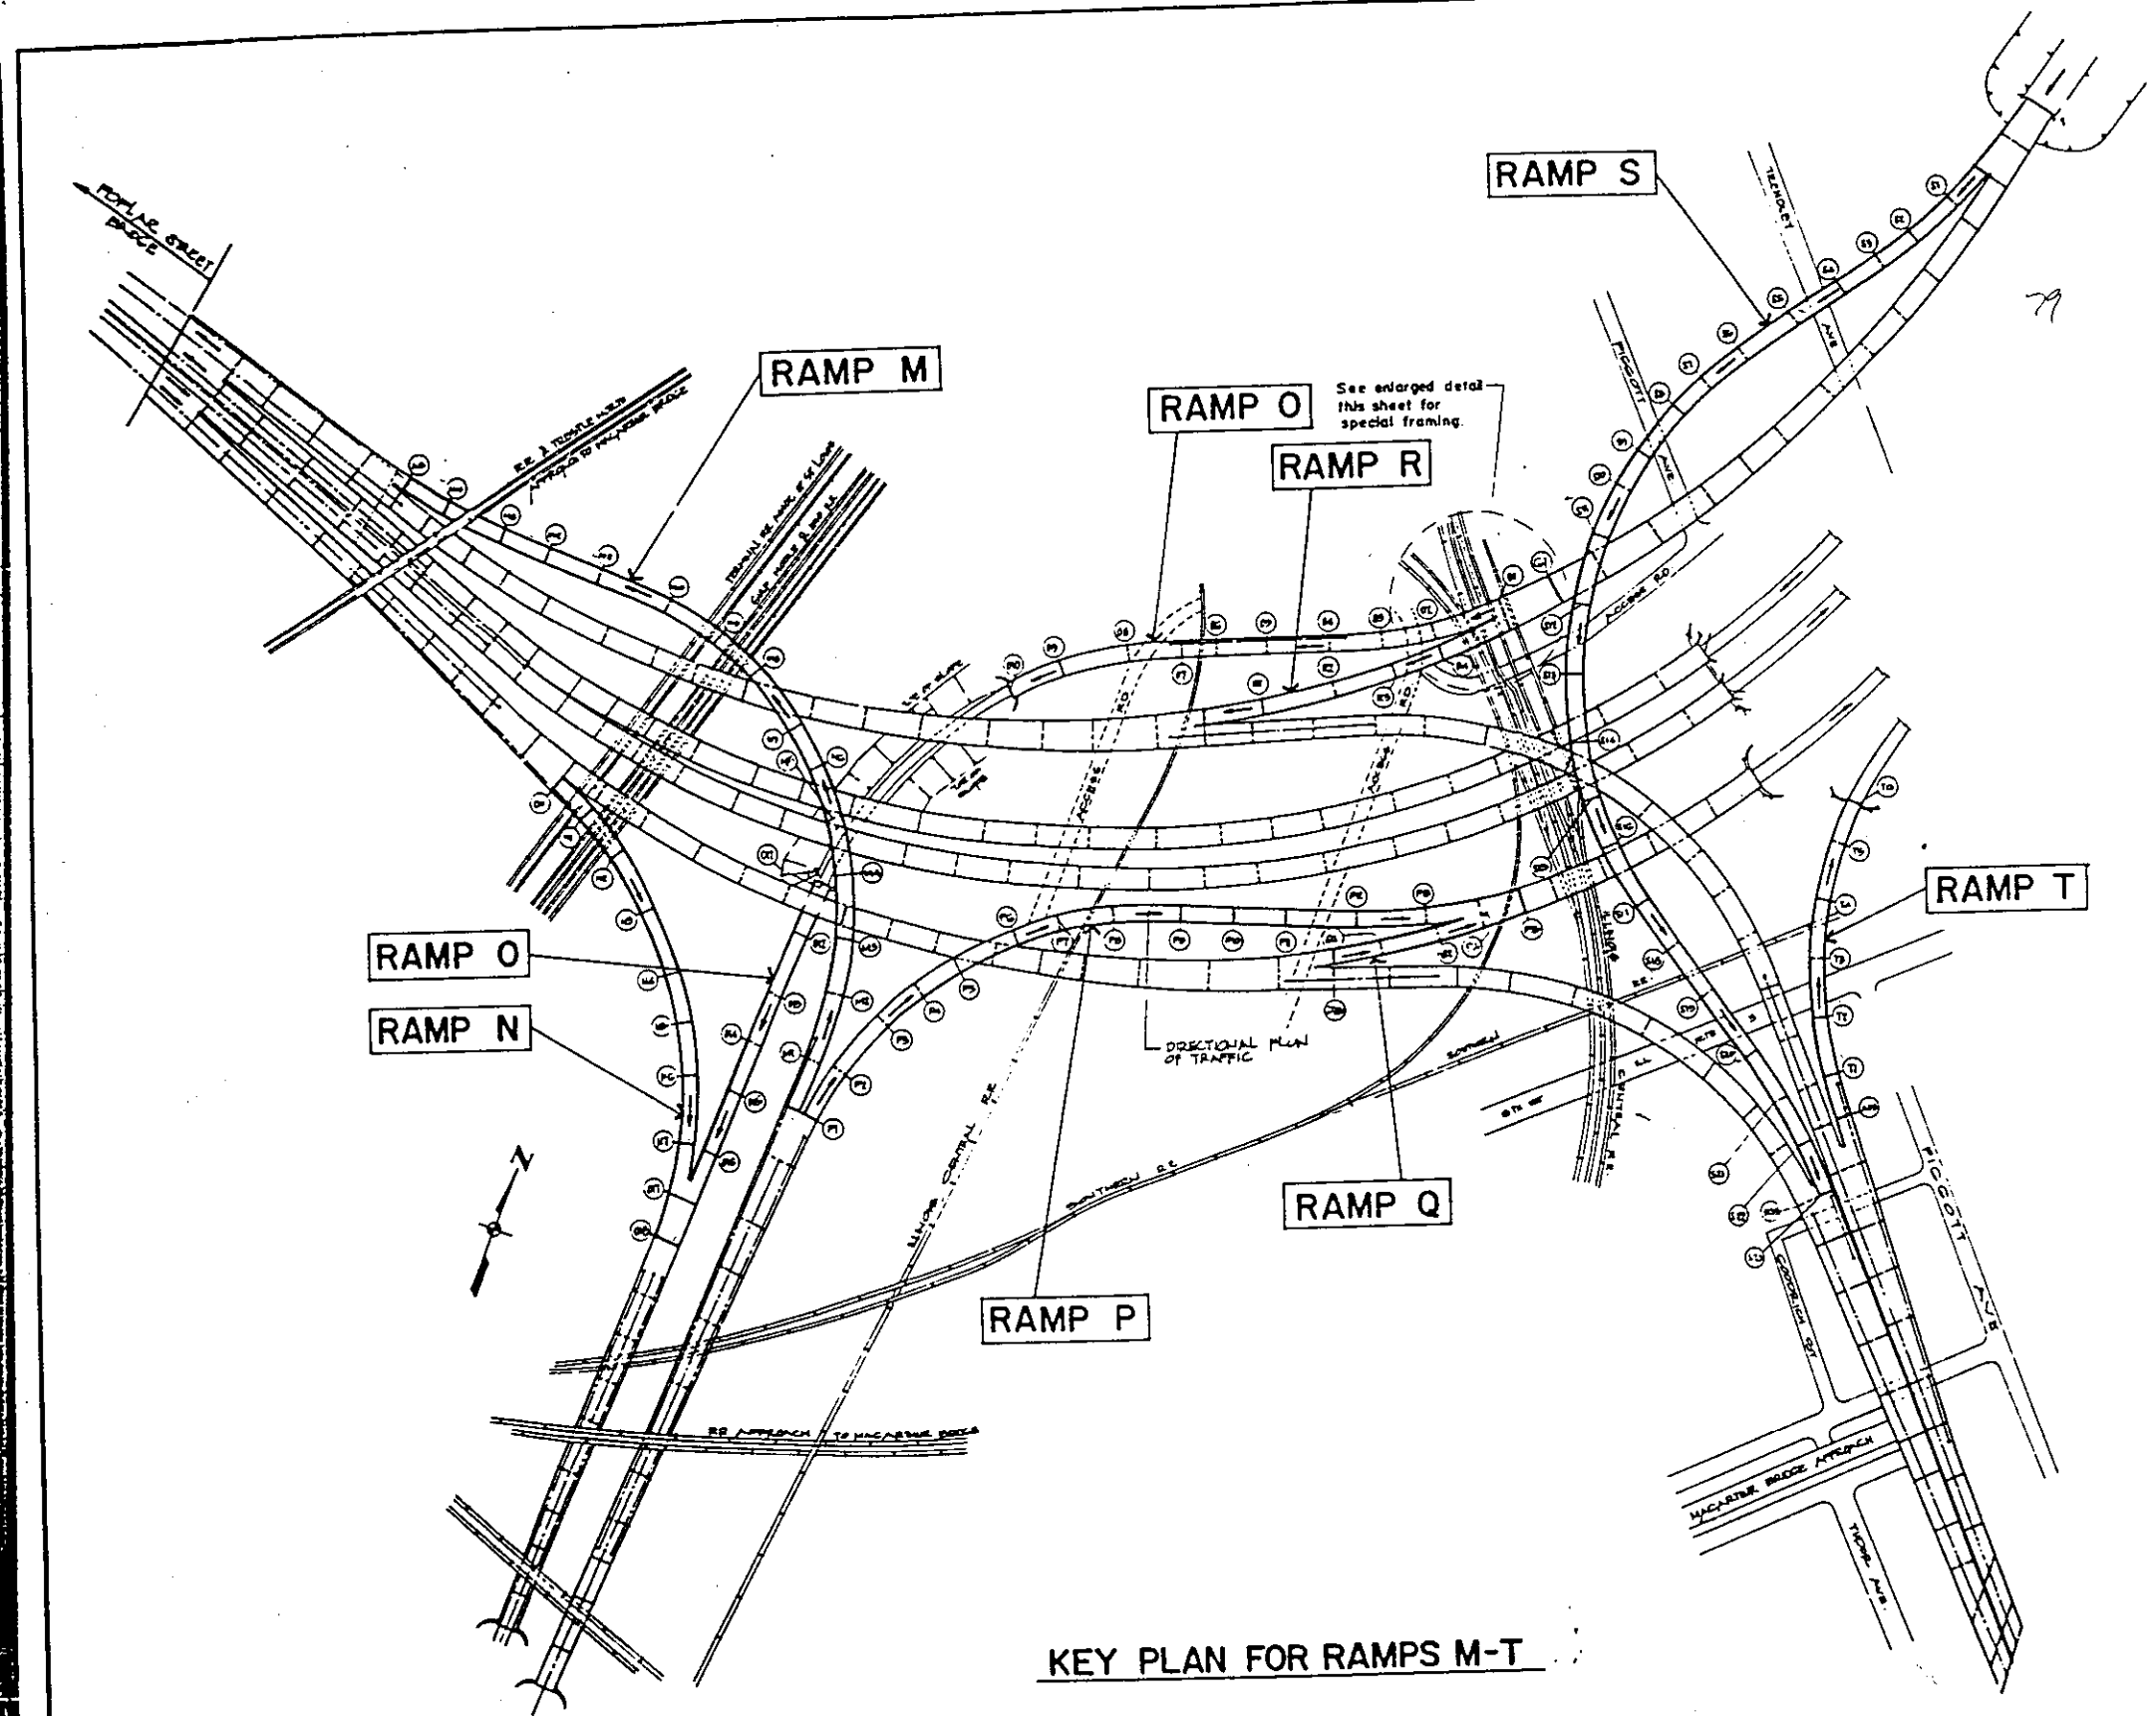


EXISTING BRACKETS AT RAMP O AND RAMP R INTERSECTION

- NOTE: Brackets are to be removed at two locations (O1int-E and O2int-IE) and the Type 2 retrofit detail installed.
1. Remove all existing high strength bolts between the existing bracket and stiffener.
 2. Remove bracket.
 3. Install Type 2 retrofit detail.

KEY PLAN FOR RAMPS M-T
 STATE OF ILLINOIS
 DEPARTMENT OF TRANSPORTATION
 SUPERSTRUCTURE REPAIRS
 FAI ROUTE TO
 POPLAR STREET BRIDGE APPROACHES
 ST. CLAIR COUNTY
 SCALE: NONE
 DATE 2/26/66
 DRAWN BY: GSA
 CHECKED BY: TLR

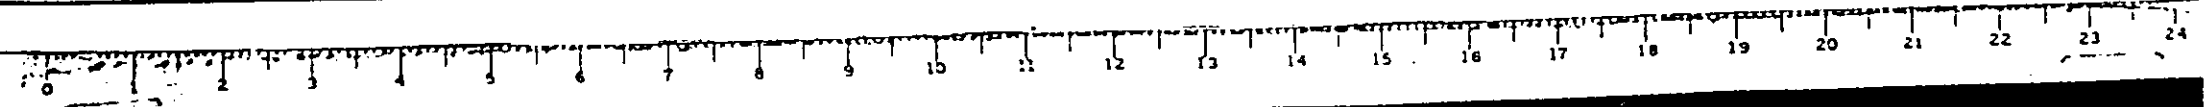


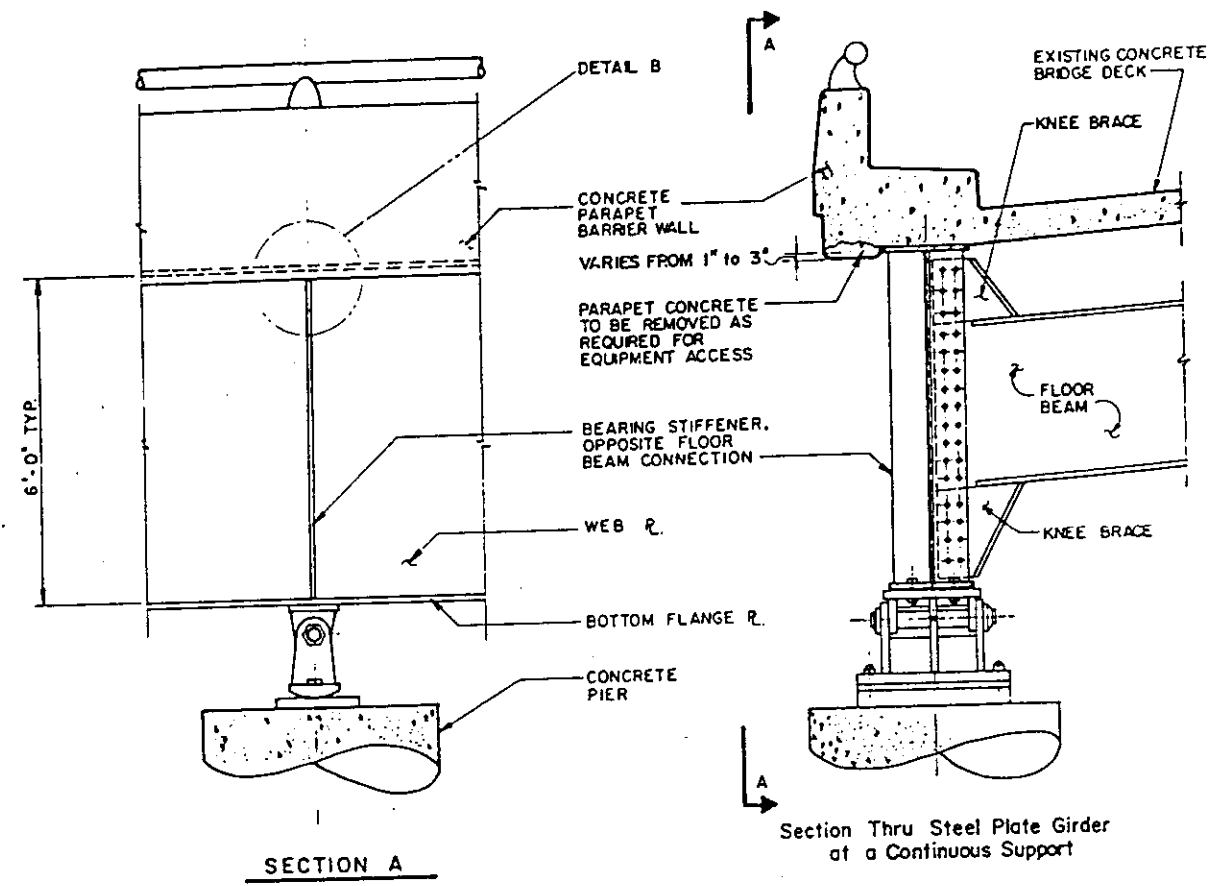


- REPAIR PROCEDURE FOR INSTALLATION OF BEARING STIFFENER RETROFIT**
1. Remove existing parapet concrete, as required, for equipment access.
 2. Core 2 in. diameter holes through web plate adjacent to the top flange as positioned in Detail B. Core hole shall penetrate horizontal and vertical fillet welds approximately 1/8 in. If core does not penetrate weld by 1/8 in., remove additional material by grinding. Remove all burrs from core surface and surface shall have a Roughness average (Ra) of 500 or less. Bevel edges of cored holes 1/16\"/>
 - 3. Obtain approval of engineer before proceeding.
 - 4. Clean surface to remove any cutting oils or contaminants.
 - 5. Clean and paint all areas of existing structural steel affected by this repair process, in accordance with the Special Provisions.
 - 6. Patch parapet concrete at the direction of the Engineer, in accordance with the Special Provisions.


QUANTITIES

ITEM	UNIT	QUANTITY
Structural Steel Repairs, Type 1	Each	355
Removal and Replacement of Existing Traffic Signs	Each	8
Cleaning and Painting Previously Repaired Connections	Each	12
Traffic Control for Repair Locations Above Another Roadway	Each	8

DETAILS FOR REPAIR OF GIRDER WEB CRACKING AT A FLOOR BEAM-TO-BEARING STIFFENER GIRDER CONNECTION
TYPE 1 REPAIR
 Note: Refer to Sheet Nos. 7 through 10 for repair detail locations.

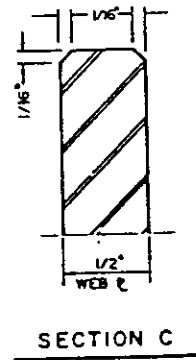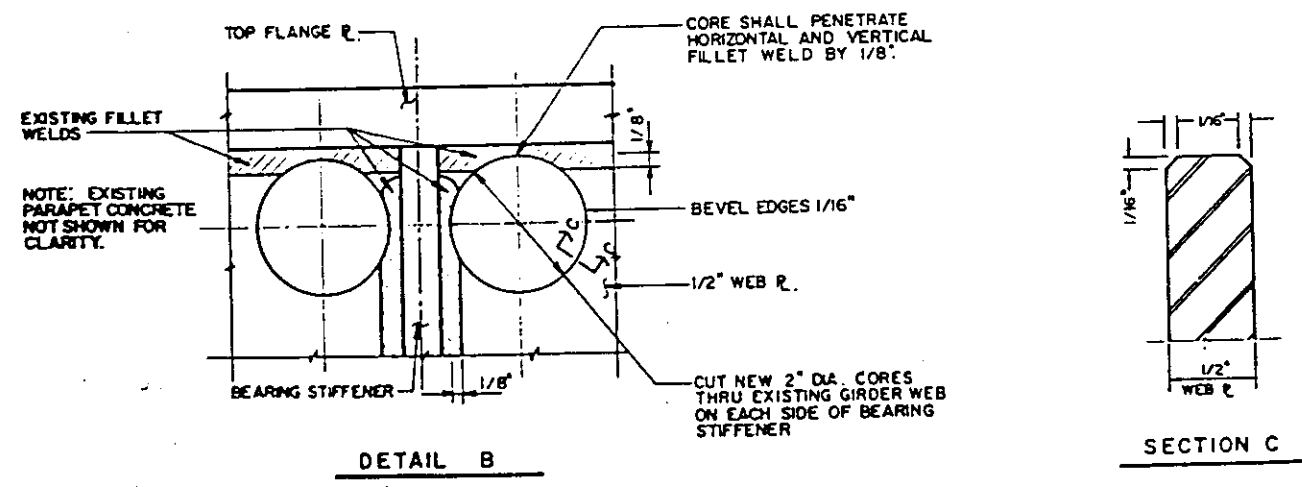

BEARING STIFFENER RETROFIT DETAILS
 STATE OF ILLINOIS
 DEPARTMENT OF TRANSPORTATION
 SUPERSTRUCTURE REPAIRS
 FAI ROUTE TO
 POPLAR STREET BRIDGE APPROACHES
 ST. CLAIR COUNTY
 SCALE: NONE
 DATE 2/26/88
 DRAWN BY: GSA
 CHECKED BY: TLR

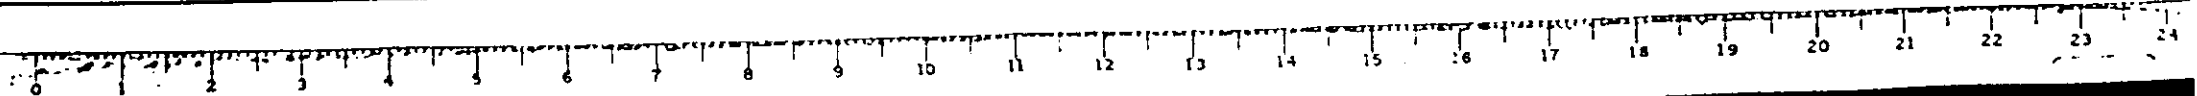


NO.	DATE	BY	CHKD.	APP'D.
70	42-3-46-38	ST. CLAIR	11	6

QUANTITIES

ITEM	UNIT	QUANTITY
Structural Steel Repairs, Type 2	Each	732
Cleaning and Painting Previously Repaired Connections	Each	8
Traffic Control for Repair Locations Above Another Roadway	Each	28

- REPAIR PROCEDURE FOR INSTALLATION OF INTERIOR NON-BEARING STIFFENER RETROFIT:
1. Remove existing bolts between floor beam and connection plate that will interfere with coring operation. Core 4 in. diameter holes through the interior and exterior stiffeners as shown in Detail B.
 2. Make horizontal flame cuts through knee brace and exterior stiffener as shown in Detail B. Refer to Special Provisions.
 3. Make vertical flame cuts through the exterior stiffener and interior connection plate. These cuts shall be sufficiently away from the girder web to avoid gouging of the web plate. Also, utmost care shall be taken to not gouge the top flange plate during the cutting operation. Temperature of web plate shall not exceed 800° F. Refer to Special Provisions.
 4. Grind surfaces immediately after flame cutting. Roughness of all flame cut surfaces shall be (R_a)1000 or less before leaving the location.
 5. Remove remnants of vertical fillet welds and stiffener plates so that the web plate has a surface roughness of (R_a) 250 or less. The final grinding shall be done parallel to the flange. Refer to Special Provisions.
 6. Inspect web plate in region of repairs. Drill 1" holes at ends of all cracks that do not terminate at an existing drilled hole.
 7. Obtain approval of Engineer before proceeding.
 8. Install 7/8" diameter high strength A325 bolts in crack retrofit holes as specified in the Special Provisions. Hardened washers shall be installed under both nut and bolt head. Tighten bolts to the minimum fastener tension, using the "turn-of-the-nut method", as specified in the AISC Specification for Structural Joints Using ASTM A325 or A490 Bolts.
 9. Clean exposed steel surface to remove any contaminants or rust.
 10. Clean and paint all areas of existing Structural Steel affected by this repair process, in accordance with the Special Provisions.

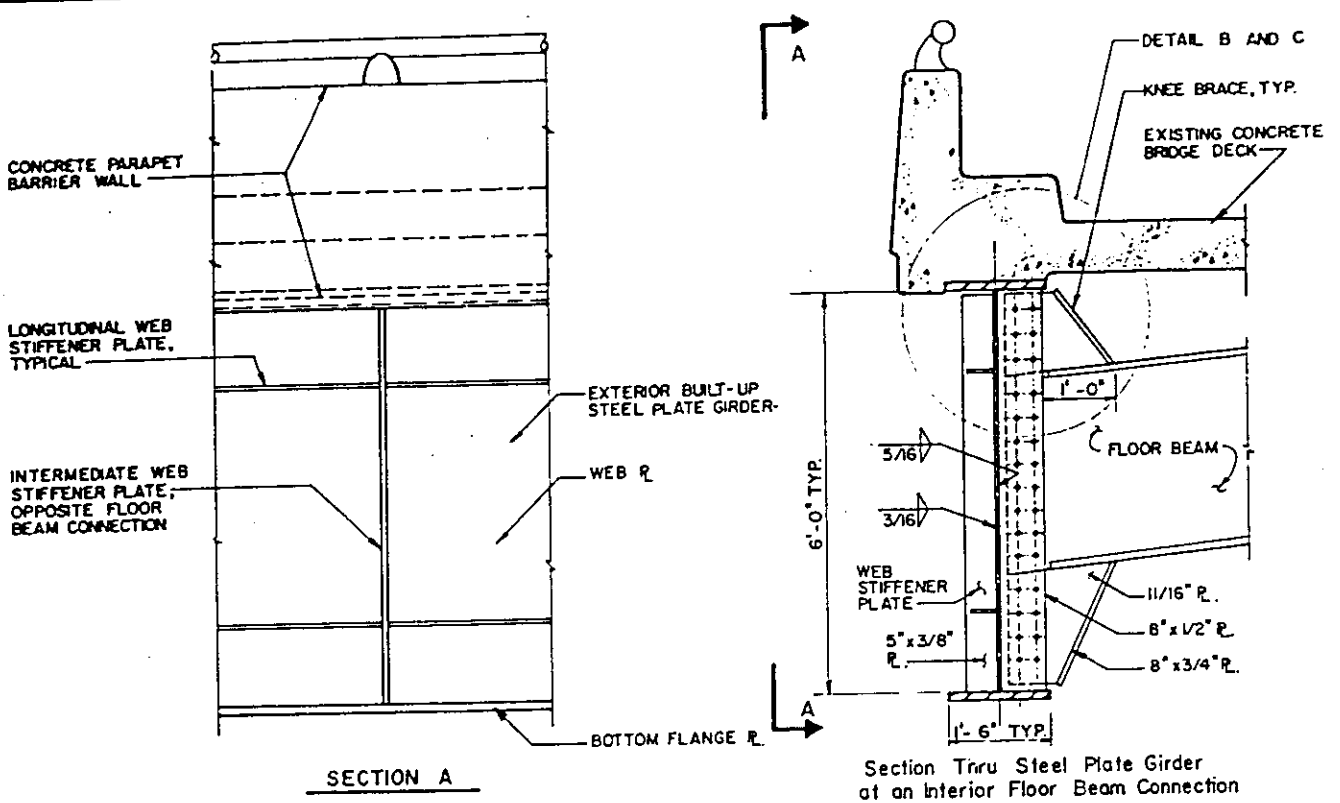


SECTION A

Section Thru Steel Plate Girder of an Interior Floor Beam Connection

DETAILS FOR REPAIR OF GIRDER WEB CRACKING AT FIRST INTERIOR FLOOR BEAM - TO-GIRDER CONNECTION


TYPE 2 REPAIR

Note: Refer to Sheet Nos. 7 through 10 for repair detail locations.

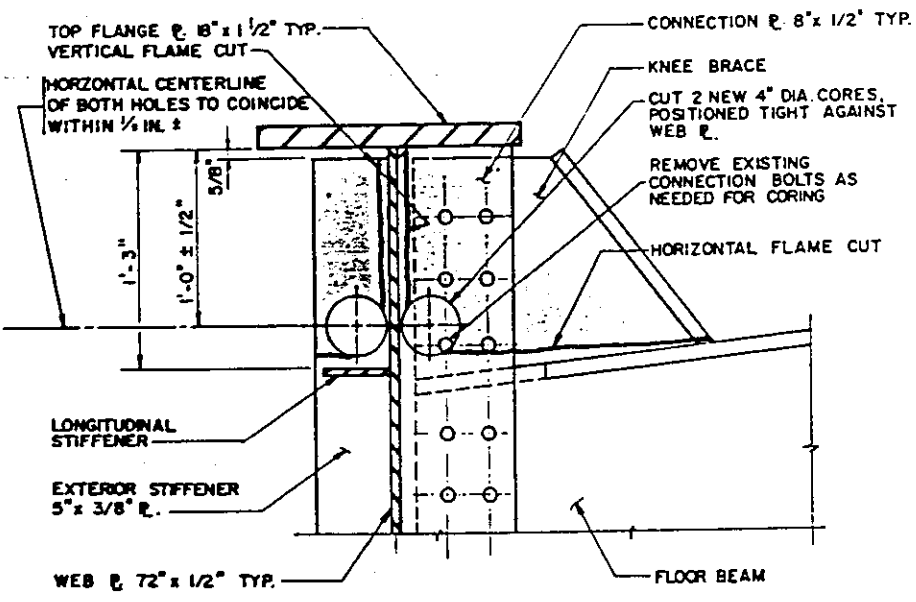


DETAIL B

Illustrating Steps 1 thru 3 of the Repair Sequence

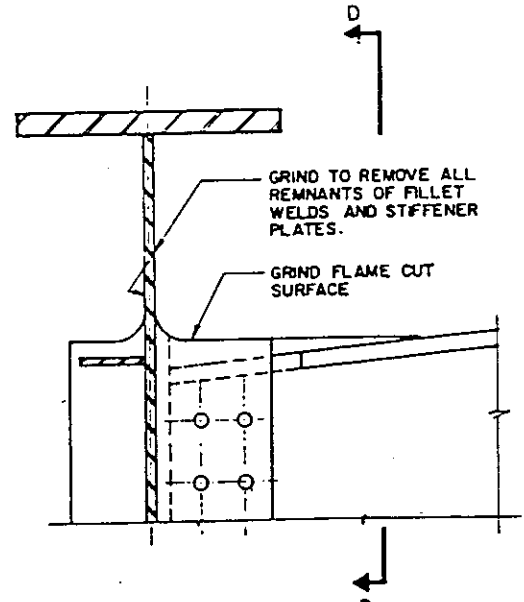

DETAIL C

Illustrating Steps 4 and 5 of the Repair Sequence

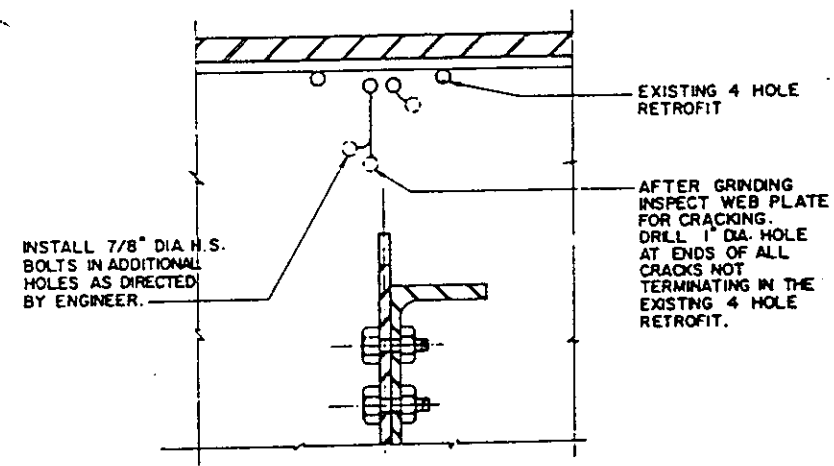


SECTION D

Illustrating Steps 6 thru 9 of the Repair Sequence

INTERIOR NON-BEARING STIFFENER RETROFIT DETAILS

STATE OF ILLINOIS
DEPARTMENT OF TRANSPORTATION
SUPERSTRUCTURE REPAIRS
FAI ROUTE 70
POPLAR STREET BRIDGE APPROACHES
ST. CLAIR COUNTY

SCALE: NONE
DATE 2/26/86
DRAWN BY: GSA
CHECKED BY: TLR

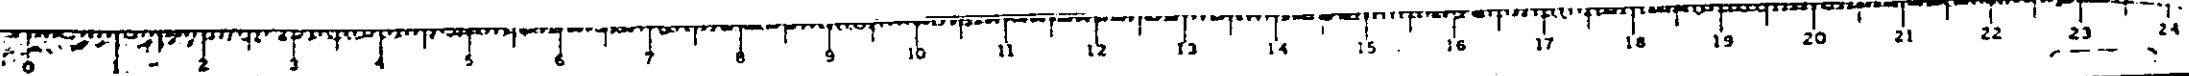

STATE OF ILLINOIS
DEPARTMENT OF TRANSPORTATION

PLANS FOR PROPOSED
FEDERAL AID HIGHWAY

F.A.I. ROUTE 70
SECTION 82-3HVB-R-5
PROJECT IR-70-1(145)0
ST. CLAIR COUNTY
C-98-050-84

INDEX

1. TITLE SHEET & SUMMARY OF QUANTITIES
2. GENERAL PLAN
3. POST-TENSIONING SYSTEM & GENERAL NOTES
4. END CONNECTION BRACKET

STANDARDS:

2298-7 2300-3
2299-10 2307-6

SUMMARY OF QUANTITIES

CODE NO.	PAY ITEM	UNIT	QUANTITY
* X04748	MOBILIZATION	L SUM	1
* X07723	PIER COLUMN REPAIR TYPE I	EACH	270
* X07724	PIER COLUMN REPAIR TYPE II	EACH	151
** Z10527	TRAINEES	HOURS	4,000


* CONSTRUCTION TYPE CODE Y007

** CONSTRUCTION TYPE CODE Y080

MICROFILMED _____
REEL NUMBER _____
AWARDED _____
RESIDENT ENGINEER _____

AS BUILT CHANGES WERE MADE
ON THE FOLLOWING SHEETS

THIS PROJECT CONSISTS OF
THE PIER CAP REPAIR AT VARIOUS
LOCATIONS IN THE POPLAR
STREET BRIDGE COMPLEX

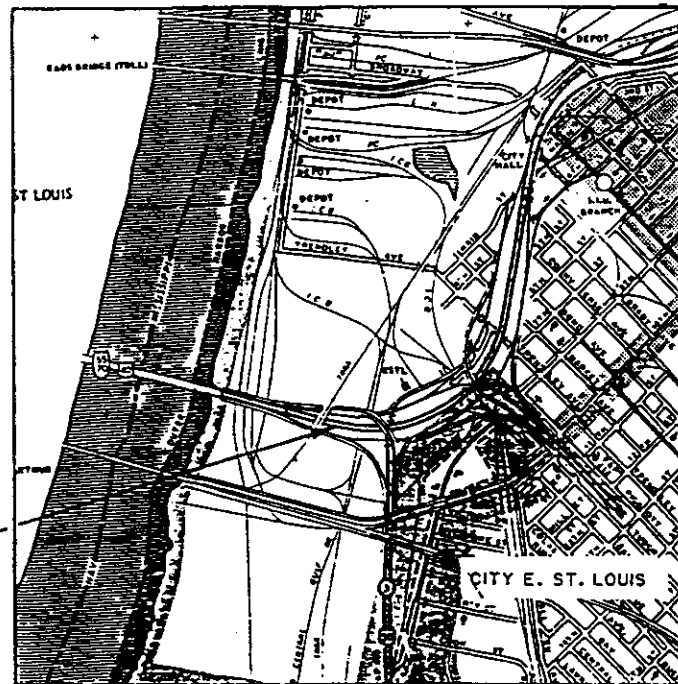


LOCATION MAP

0" 1200 2400
SCALE: 1"=1200FT.

SECTION	SEC.	COUNTY	ROUTE	POST MILE
70	*	ST. CLAIR	4	1

* 82-3HVB-R-5
P-98-073-83

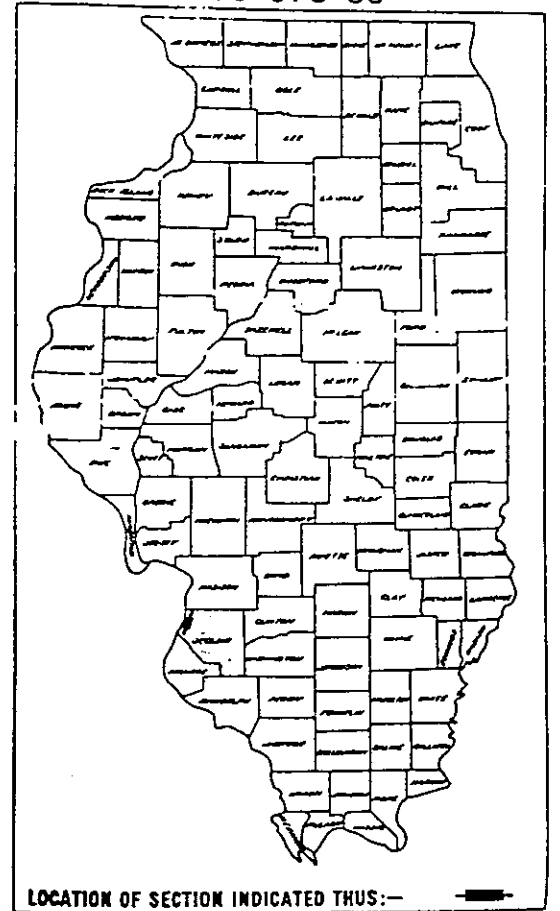


STATE OF ILLINOIS
DEPARTMENT OF TRANSPORTATION

APPROVED: *Del. [Signature]*
DATE: 12-20-87
PREPARED BY: *[Signature]*
CHECKED BY: *[Signature]*
DIRECTOR OF HIGHWAYS: *[Signature]*

REEL 8-151

CONTRACT NO. 38649

ST. CLAIR COUNTY SECTION 82-3HVB-R-5 F.A.I. ROUTE 70

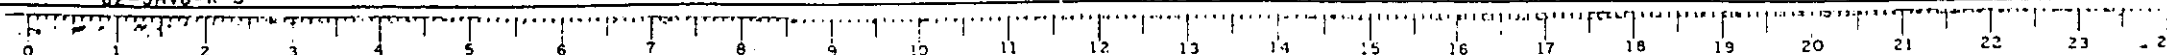


082-0781

STATE OF ILLINOIS
DEPARTMENT OF TRANSPORTATION

SECTION	DATE	BY

Sheet No. 1
3 Sheets

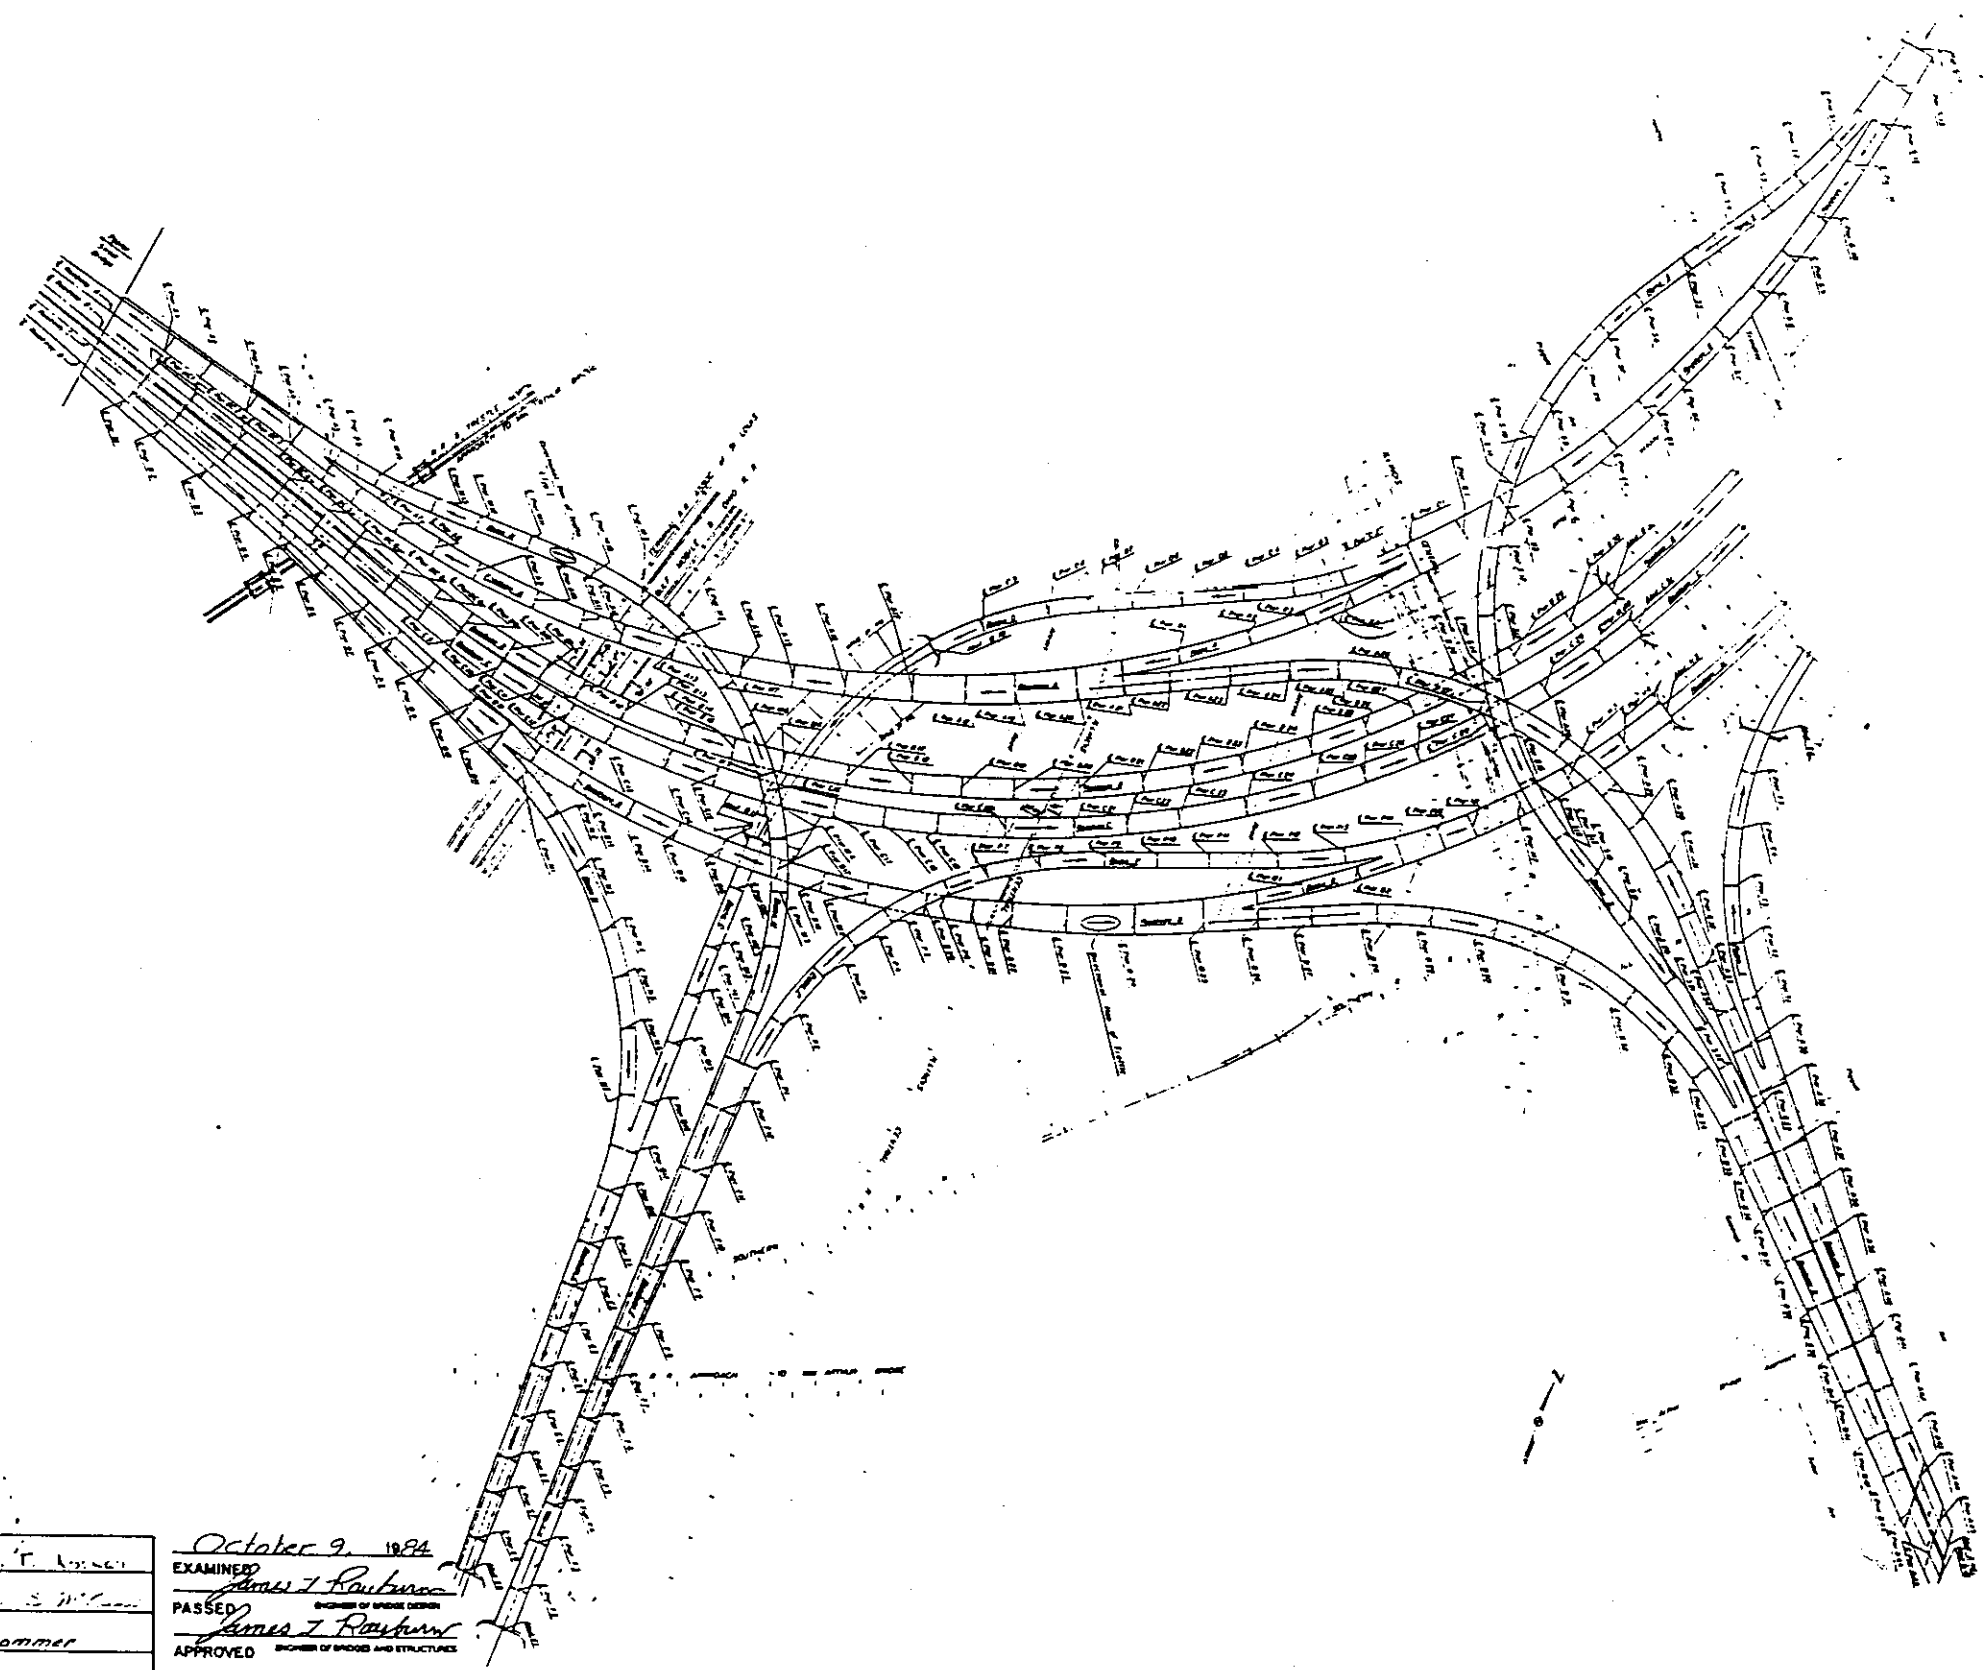

TOTAL BILL OF MATERIALS


ITEM	UNIT	TOTAL
Pier Column Repair - Type I	Each	270
Pier Column Repair - Type II	Each	15

*for pier locations see special provisions

DESIGNED *C. F. ...*
 CHECKED *P. S. ...*
 DRAWN *R. Sommer*
 CHECKED *A. J. ...*

October 9, 1984
 EXAMINED *James J. Rauburn*
 PASSED *James J. Rauburn*
 APPROVED *James J. Rauburn*
ENGINEER OF BRIDGES AND STRUCTURES
DIRECTOR OF HIGHWAYS


GENERAL PLAN
 F.A.I. RT. 70 SEC. 82-34...-R-5
 ST. CLAIR COUNTY

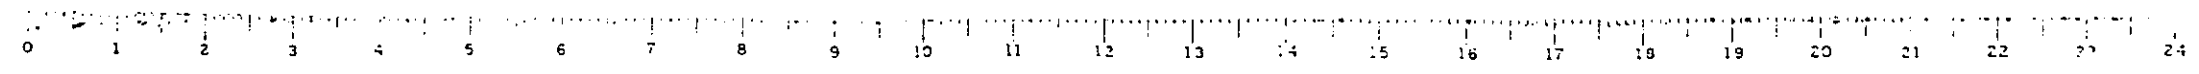


STATE OF ILLINOIS
DEPARTMENT OF TRANSPORTATION

DATE	BY	CHKD	APP'D	NO.
				4


SHEET NO. 2
3 SHEETS

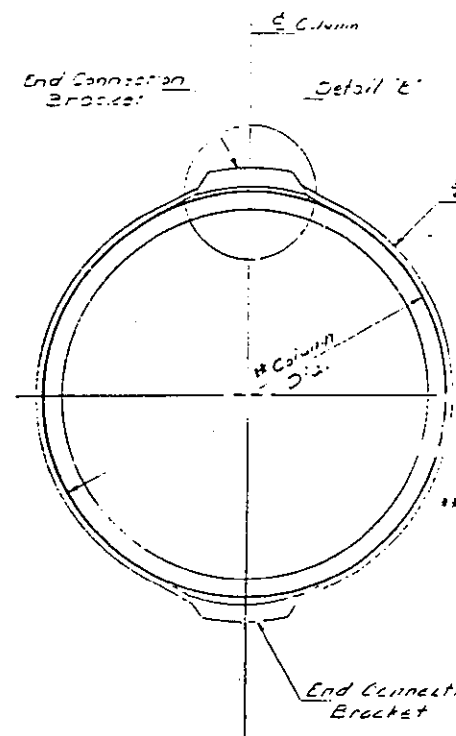

Template shall be made of the top of each column to be repaired. (See Special Provisions)

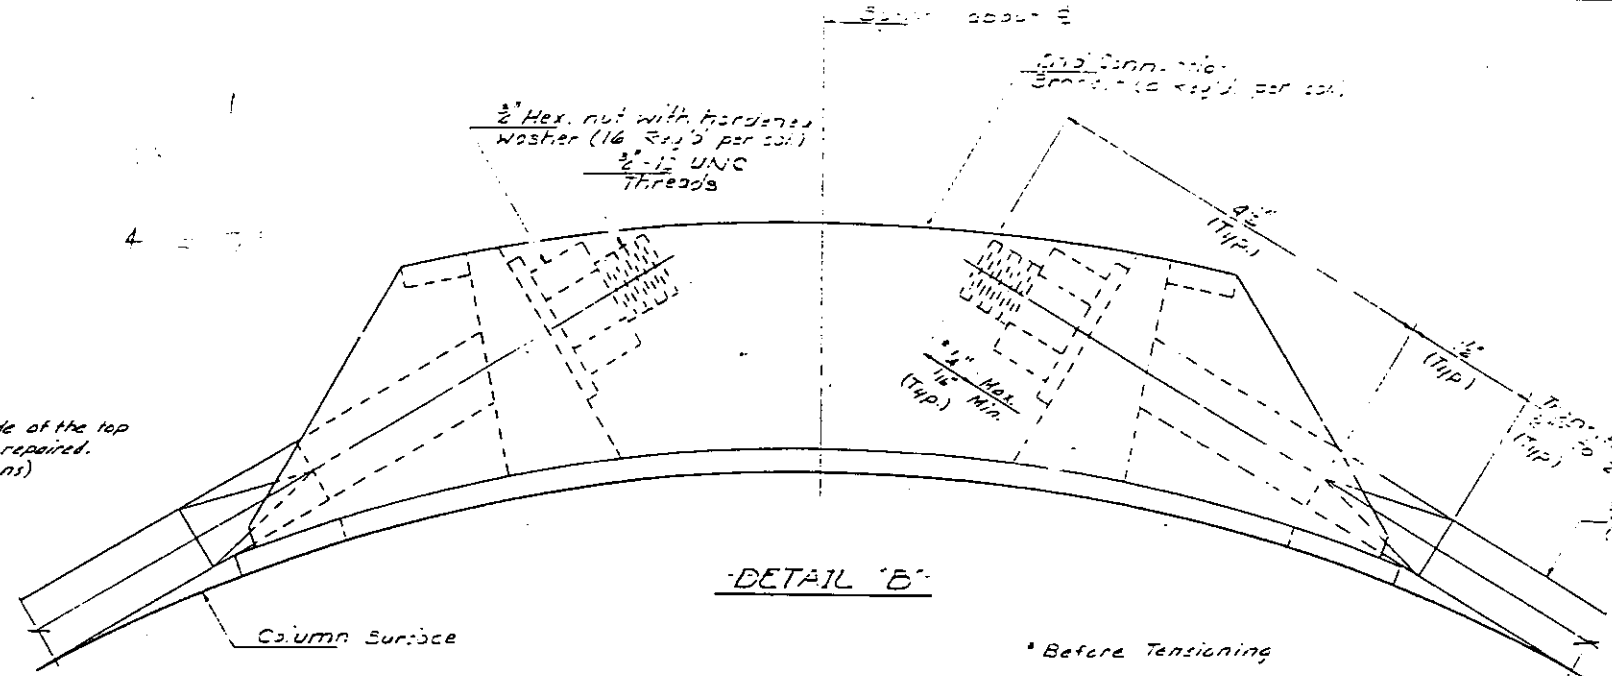

* Before Tensioning

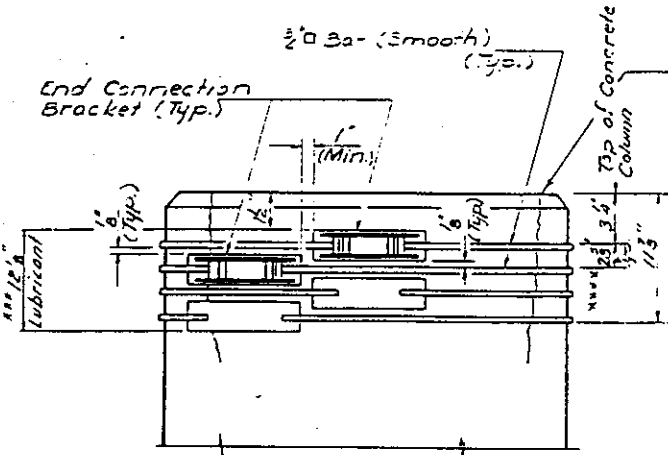


TOP OF PIER COLUMNS
For locations see Special Provisions

Clean and epoxy grout cracks before bar tensioning. See Special Provisions.

BAR TENSIONING PROCEDURE

The 3/4" bars shall be tensioned in sequence from the bottom bar to the top bar. Each bar shall be tensioned by tightening the nuts to the given torques according to the following sequence:

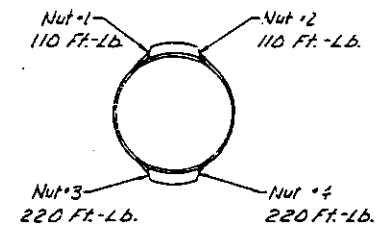

After tightening all four nuts on a bar they shall all be checked for 220 Ft.-Lb. Torque according to the same above sequence. The Engineer shall then verify the 220 Ft.-Lb. torque on all the nuts and the threads shall be set.

QUANTITY OF STRUCTURAL STEEL - PER COLUMN - IN LBS.

COL. DIA.	AASHTO M-223	AISI 4140	TOTAL
4'-0"	113	16	219
4'-6"	112	108	226
5'-0"	113	120	233
5'-6"	113	132	250
6'-0"	112	144	262
6'-6"	112	156	274
7'-0"	117	168	285

All Structural Steel is incidental to "Pier Column Repair - Type I" or "Pier Column Repair - Type II" as applicable.

***A petroleum base lubricant approved by the Engineer shall cover the entire surface area between the 3/4" bars and the concrete surface. This shall be accomplished by placing lubricant on the concrete surface in the area shown around the entire circumference of the column.
****The spacing of the Post Tensioning Bars shall be maintained throughout the perimeter of the columns, as shown, by using templates.


GENERAL NOTES

End Connection Bracket shall conform to the requirements of A.A.S.H.T.O. M-223 Grade 50.
The 3/4" bar shall conform to the requirements of AISI 4140, quenched and tempered to a minimum yield strength of 100,000 psi. and a maximum yield strength of 120,000 psi.
The hardened washer shall conform to the requirements of A.S.T.M. F-436.
The end connection brackets, 3/4" bars, nuts and washers shall receive one shop coat of red lead paint and two shop coats of aluminum paint.
The 1/2" hex. nut shall conform to the requirements of A.S.T.M. A-563, Grade D.H. Plan dimensions and details relative to existing structure have been taken from existing plans and are subject to nominal construction variations. It shall be the Contractor's responsibility to verify such dimensions and details in the field and make necessary approved adjustments prior to construction or ordering of materials. Such variations shall not be cause for additional compensation for a change in the scope of the work. Concrete surfaces to receive Post-Tensioning System shall be smoothed by stoning or grinding as required to eliminate projections.

POST-TENSIONING SYSTEM
PIER COLUMNS - REPAIR
S.E. R. T. D. SEC. 82-3-4-V3-R-5
ST. CLAIR COUNTY

DESIGNED & F. COLLINS
CHECKED R. S. M...
DRAWN J. SCHNEIDER
CHECKED P. S. ... R. F. A.

October 9 1954
EXAMINED James T. Rautern
PASSED James T. Rautern
APPROVED
DIRECTOR OF HIGHWAYS

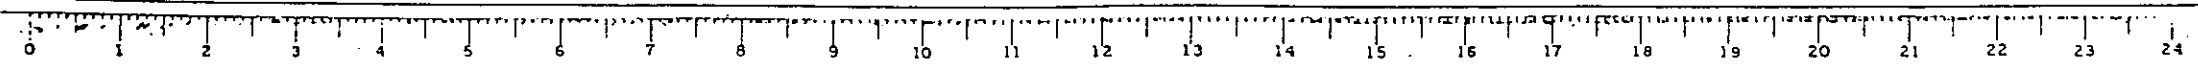

STATE OF ILLINOIS
DEPARTMENT OF TRANSPORTATION

DATE	REVISION	BY	NO.	DATE
			4	
SHEET NO. 3				
3 SHEETS				



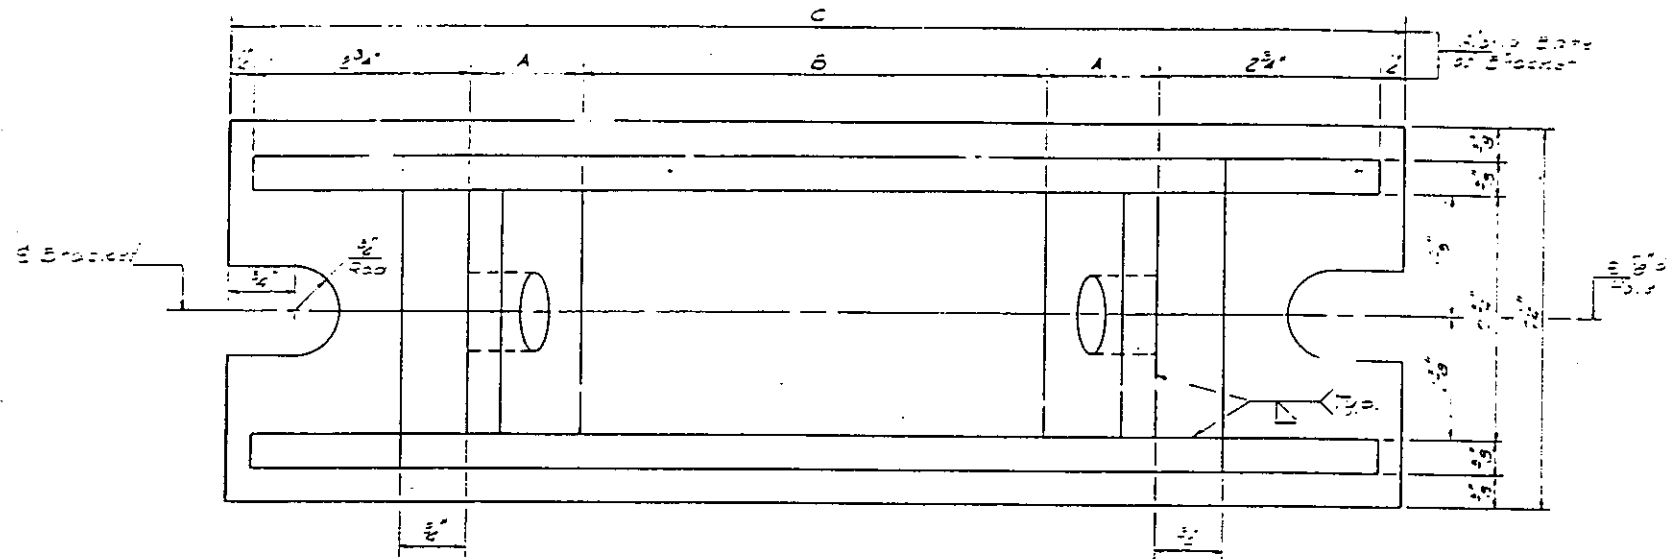


TABLE OF DIMENSIONS


COL. DIA.	A	B	C	D	E	F	G	H
4'-0"	1 7/8"	2 3/4"	13 5/8"	1 3/8"	1 1/2"	4" 20'-30"	24"	26 3/4"
4'-6"	1 3/8"	4 5/8"	13 1/8"	1 3/8"	1 1/2"	10'-50'-25"	27"	29 3/4"
5'-0"	1 3/8"	5"	13 3/8"	1 1/2"	1"	15'-23'-01"	30"	32 3/4"
5'-6"	1 5/8"	5"	13 3/8"	1 1/4"	1"	14'-46'-31"	33"	35 3/4"
6'-0"	1 5/8"	5 1/4"	13 3/8"	1 1/4"	1"	14'-10'-15"	36"	38 3/4"
6'-6"	1 5/8"	5 5/8"	13 5/8"	1 5/8"	1 1/2"	13'-45'-10"	39"	41 3/4"
7'-0"	1 1/2"	5 1/2"	14"	1 5/8"	1 5/8"	13'-09'-07"	42"	44 3/4"

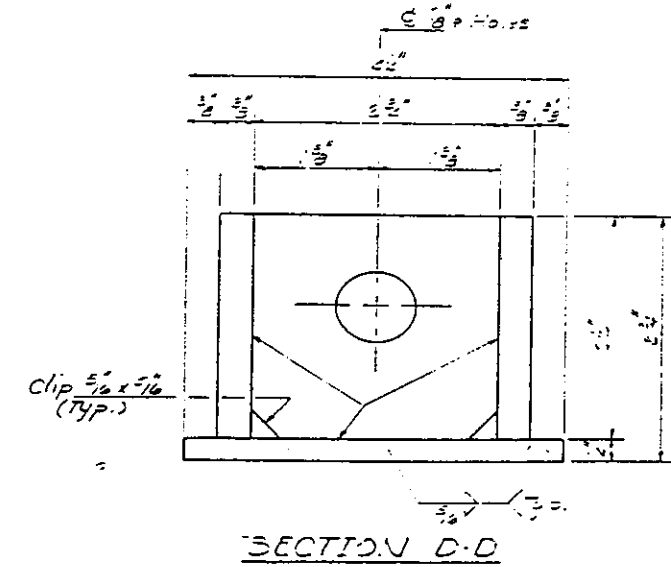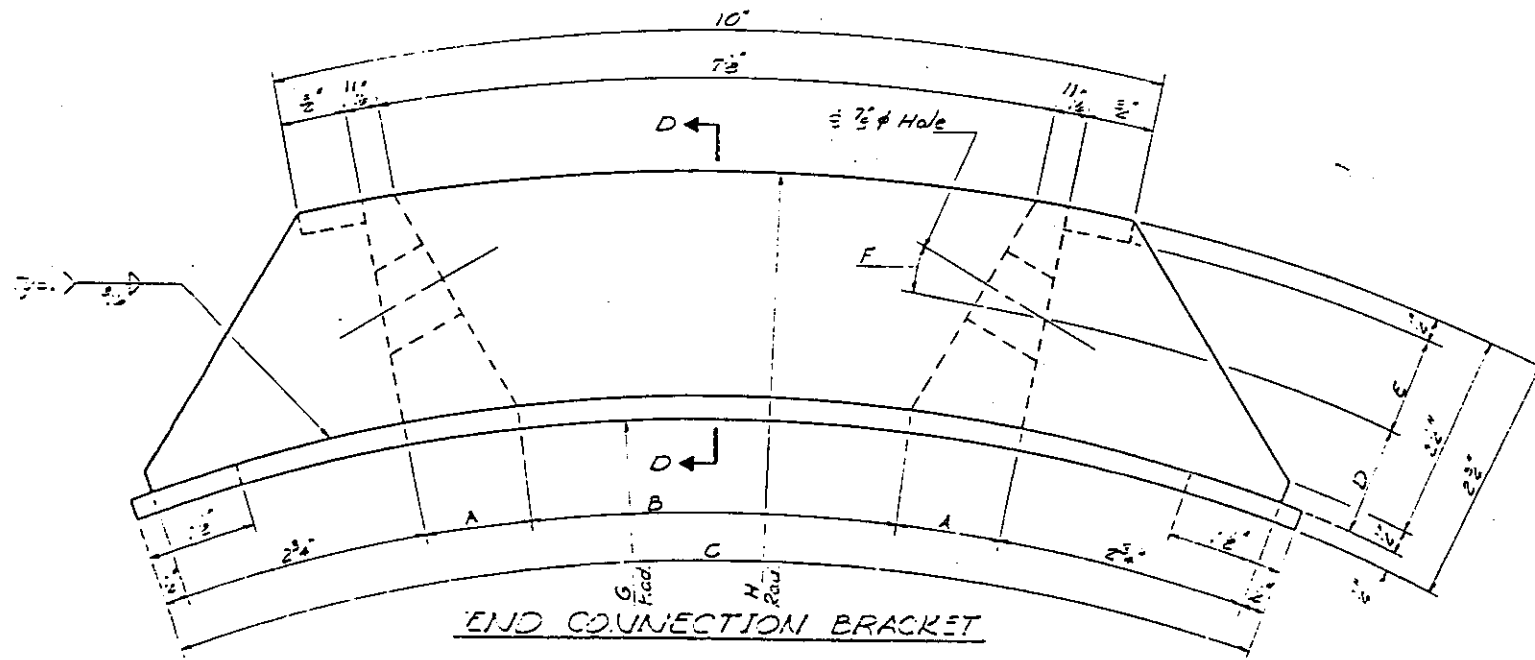

DESIGNED R. F. COLLEY
CHECKED Paul S. Mc...
DRAWN J. SCHNELLER
CHECKED P.S.M. L.F.K.

October 9 1994
EXAMINED James J. Rankin
APPROVED James J. Rankin
DIRECTOR OF HIGHWAY


END CONNECTION BRACKET
POST-TENSIONING SYSTEM
PIER COLUMN REPAIR
S.A. R. 70 SEC. 82-3-HV5-R-5
ST. CLAIR COUNTY

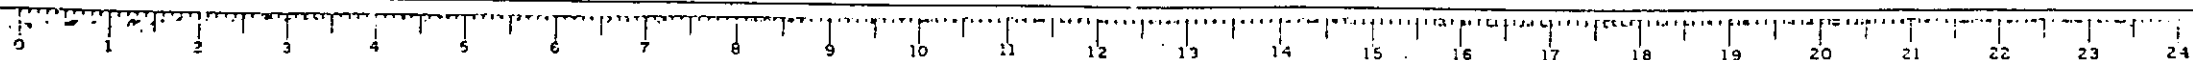

STATE OF ILLINOIS
DEPARTMENT OF TRANSPORTATION

FAI ROUTE NO.	SECTION #	COUNTY	TOTAL SHEETS	SHEET NO.
70		ST. CLAIR	4	2

82-3HVB-R-4
Sheet No. 1
3 Sheets

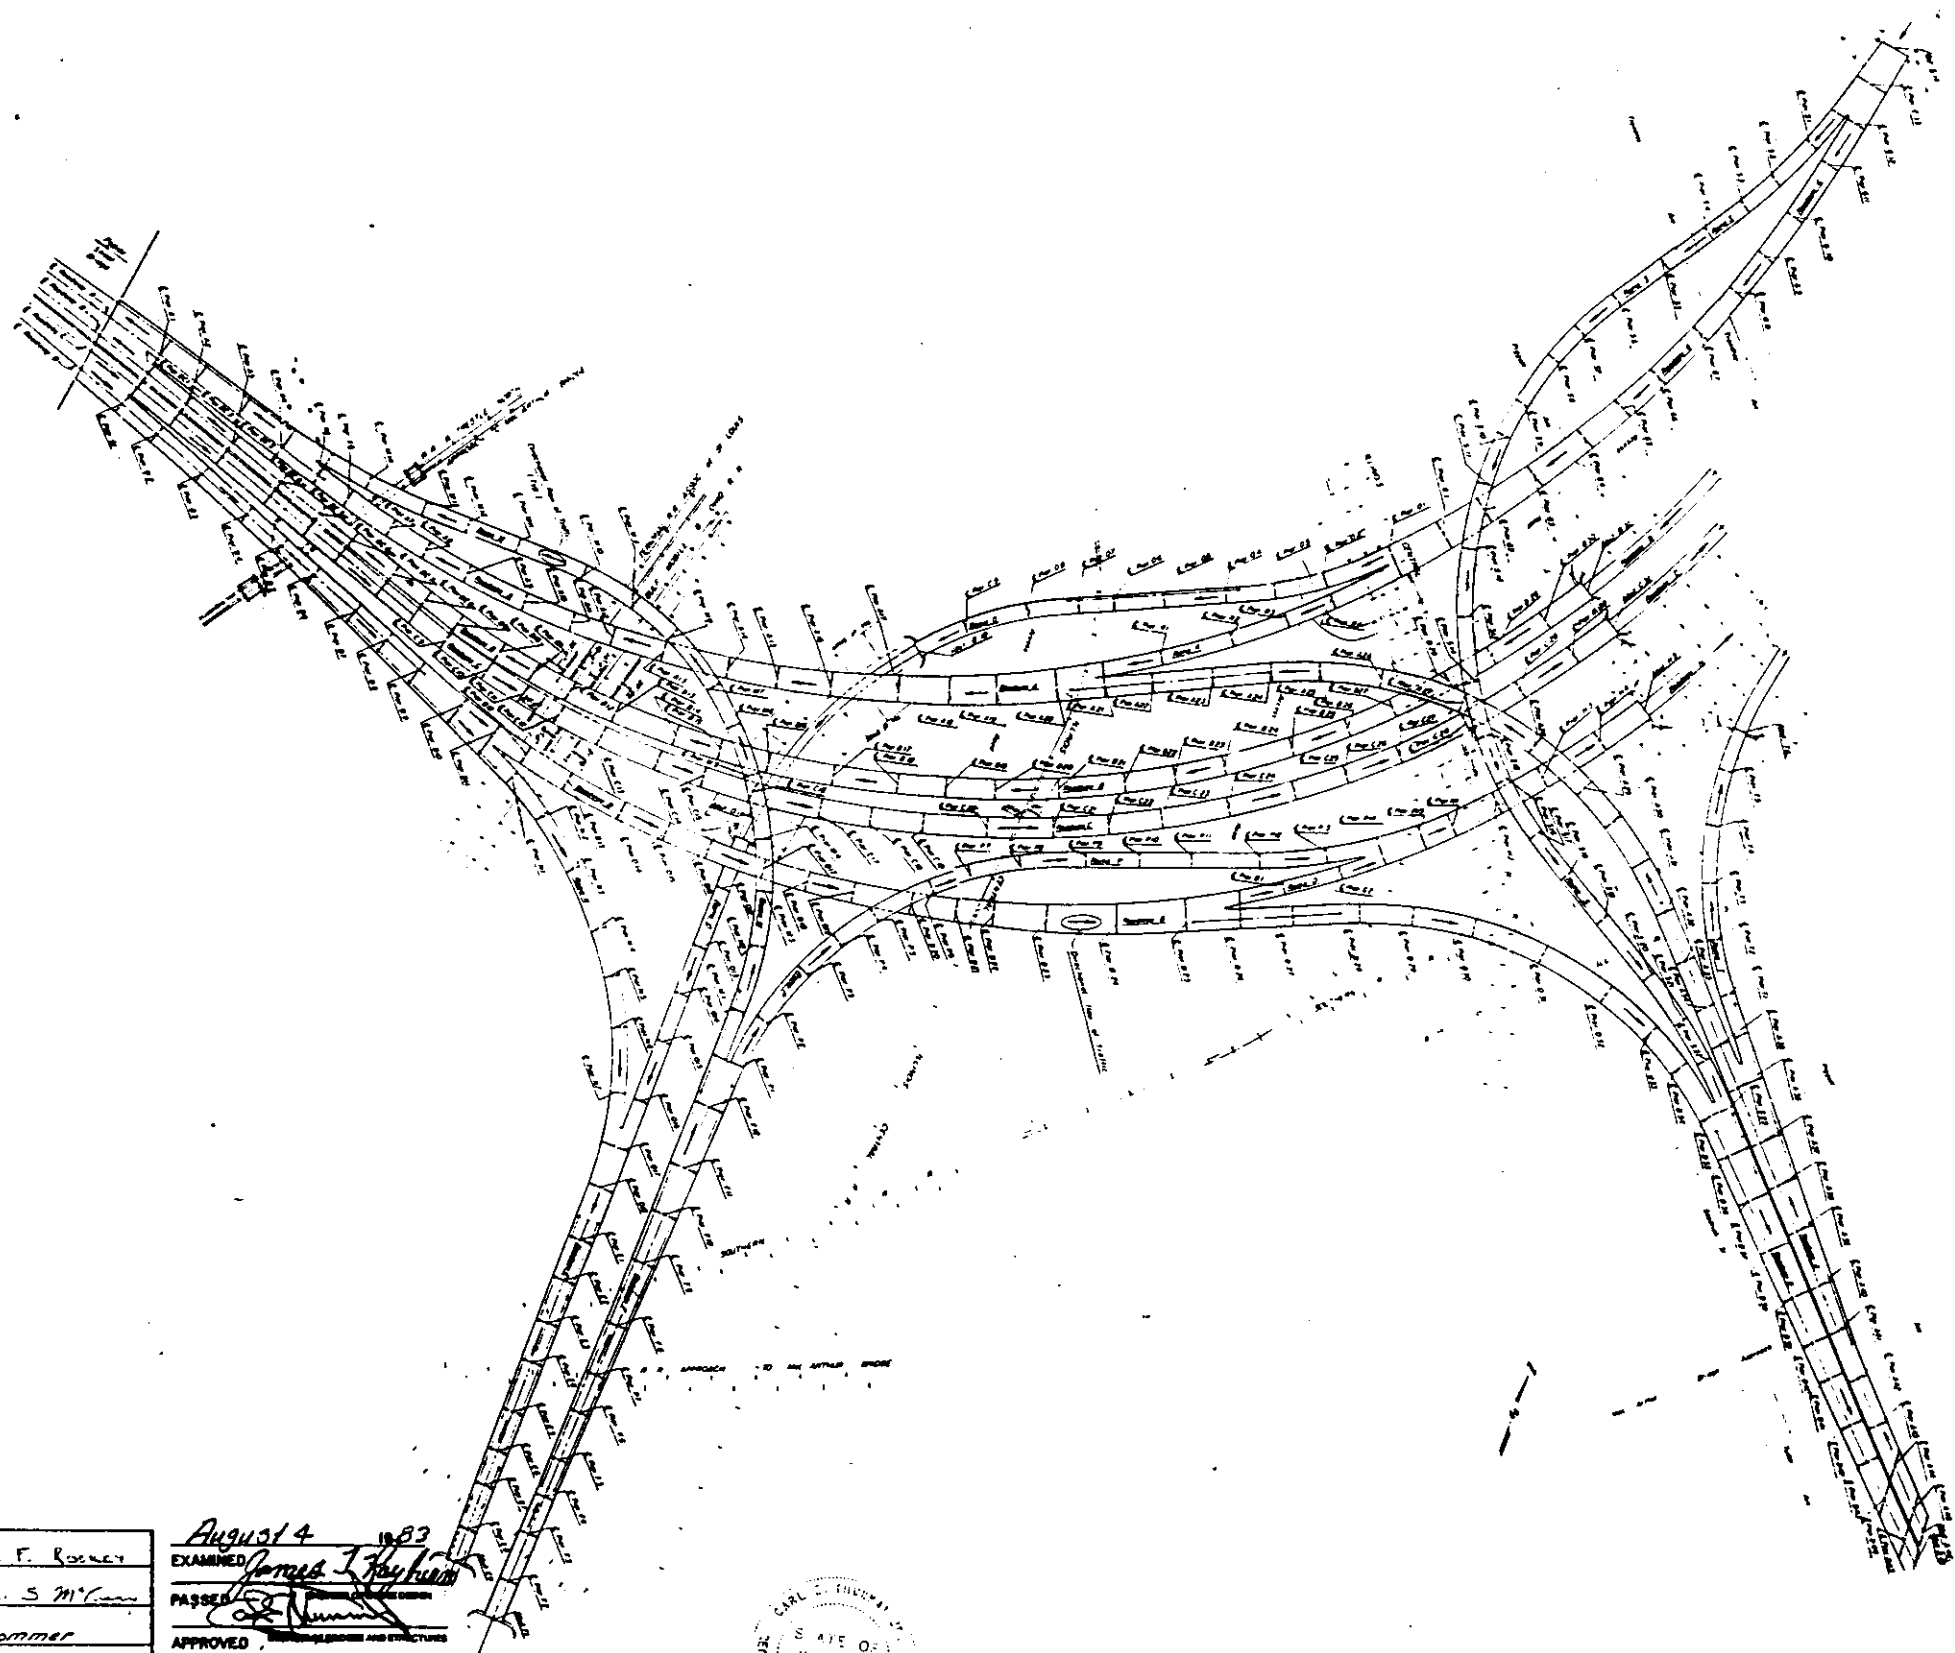

TOTAL BILL OF MATERIALS

ITEM	UNIT	TOTAL
Pier Column Repair - Type I	Each	80
Pier Column Repair - Type II	Each	25


*For pier locations see special provisions

DESIGNED R. F. Roemer
CHECKED R. S. McCann
DRAWN R. Sommer
CHECKED R. S. McCann R.F.R.

August 4 1933
EXAMINED James I. Taylor
PASSED
APPROVED
DIRECTOR OF HIGHWAYS



GENERAL PLAN
FAI. RT. 70 SEC. 82-3HVB-R-4
ST. CLAIR COUNTY

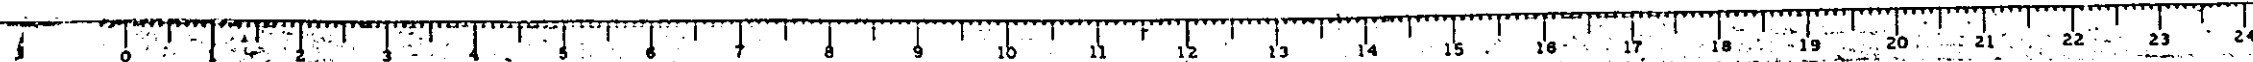


STATE OF ILLINOIS
DEPARTMENT OF TRANSPORTATION

PLANS FOR PROPOSED
FEDERAL AID HIGHWAY

14	70	ST. CLAIR	4	1
----	----	-----------	---	---

P-98-025-76

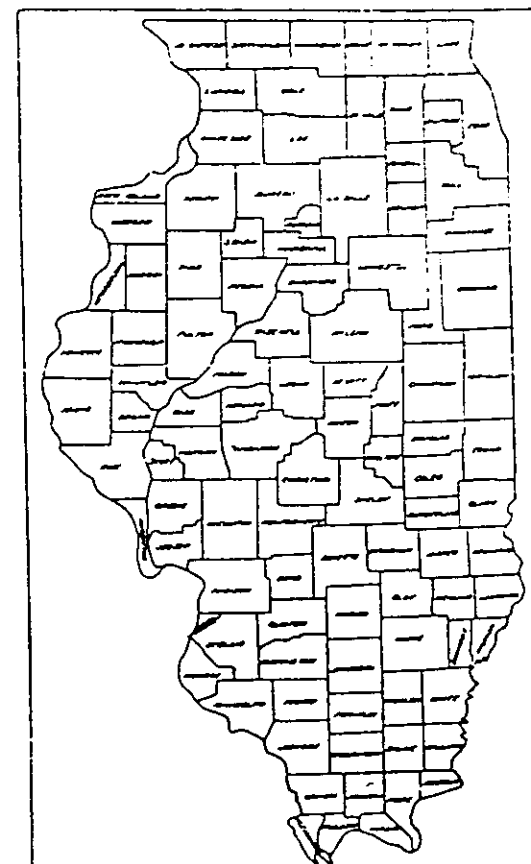


LOCATION OF SECTION INDICATED TRUS:—

F.A.I. ROUTE 70
SECTION 82-3HVB-R-2

ST. CLAIR COUNTY
BRIDGE REPAIRS

C-98-126-77

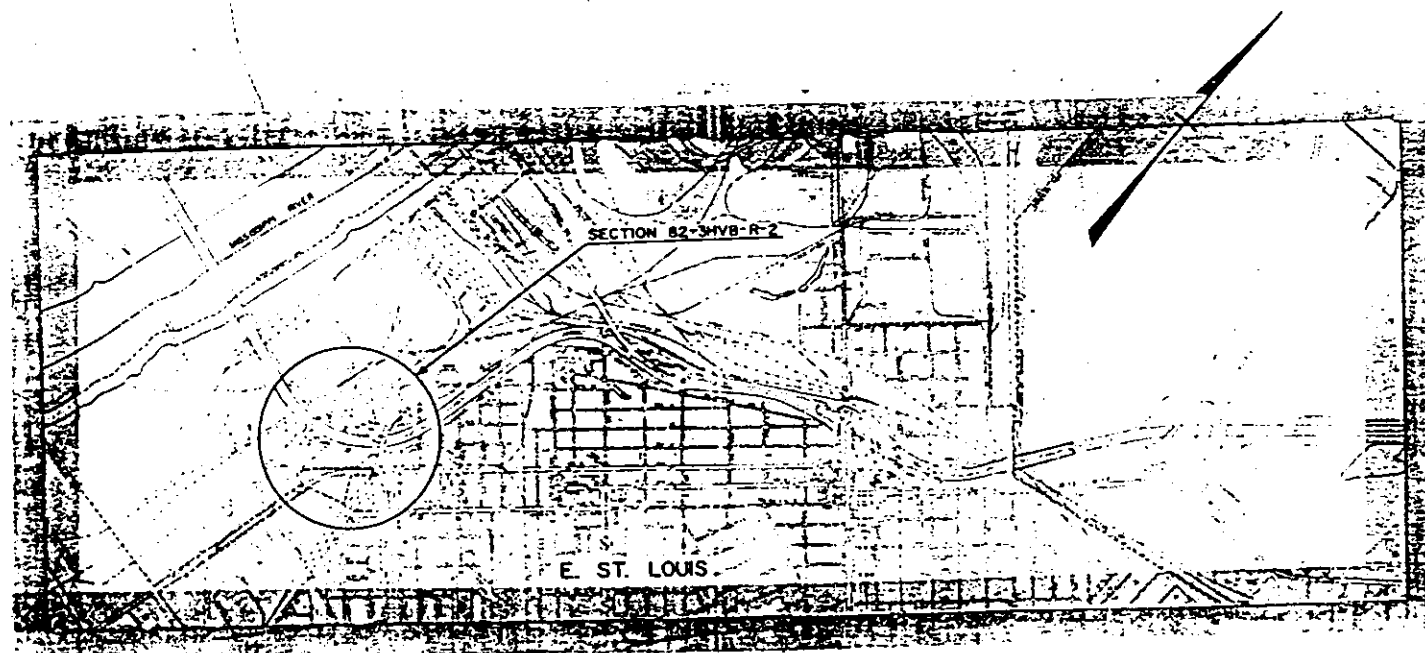

LOCATION MAP
SCALE: 1 INCH = 1600 FEET

INDEX OF SHEETS

- SHEET NO.
- 1 COVER SHEET, INDEX OF SHEETS
 - 2 SUMMARY OF QUANTITIES, GENERAL PLAN
 - 3 SCHEDULE OF REPAIRS, GENERAL NOTES
 - 4 DETAILS OF CONSTRUCTION
- STANDARDS 2298-4
 2299-7
 2300-1
 2314-3

MICROFILMED _____
REEL NUMBER _____
AWARDED _____
RESIDENT ENGINEER _____
AS BUILT CHANGES WERE MADE
ON THE FOLLOWING SHEETS

STATE OF ILLINOIS
DEPARTMENT OF TRANSPORTATION

2-28-77
3-28-77
3-28-77
3-28-77
3-28-77


Thomas R. Johnson
St. Clair County

CONTRACT NO. 92613

ST. CLAIR COUNTY SECTION 82-3HVB-R-2 F.A. ROUTE 70

8-112

PROJECT NO.	DATE	BY	SCALE
FAL-70	8-2	ST. CLAIR	4 : 1

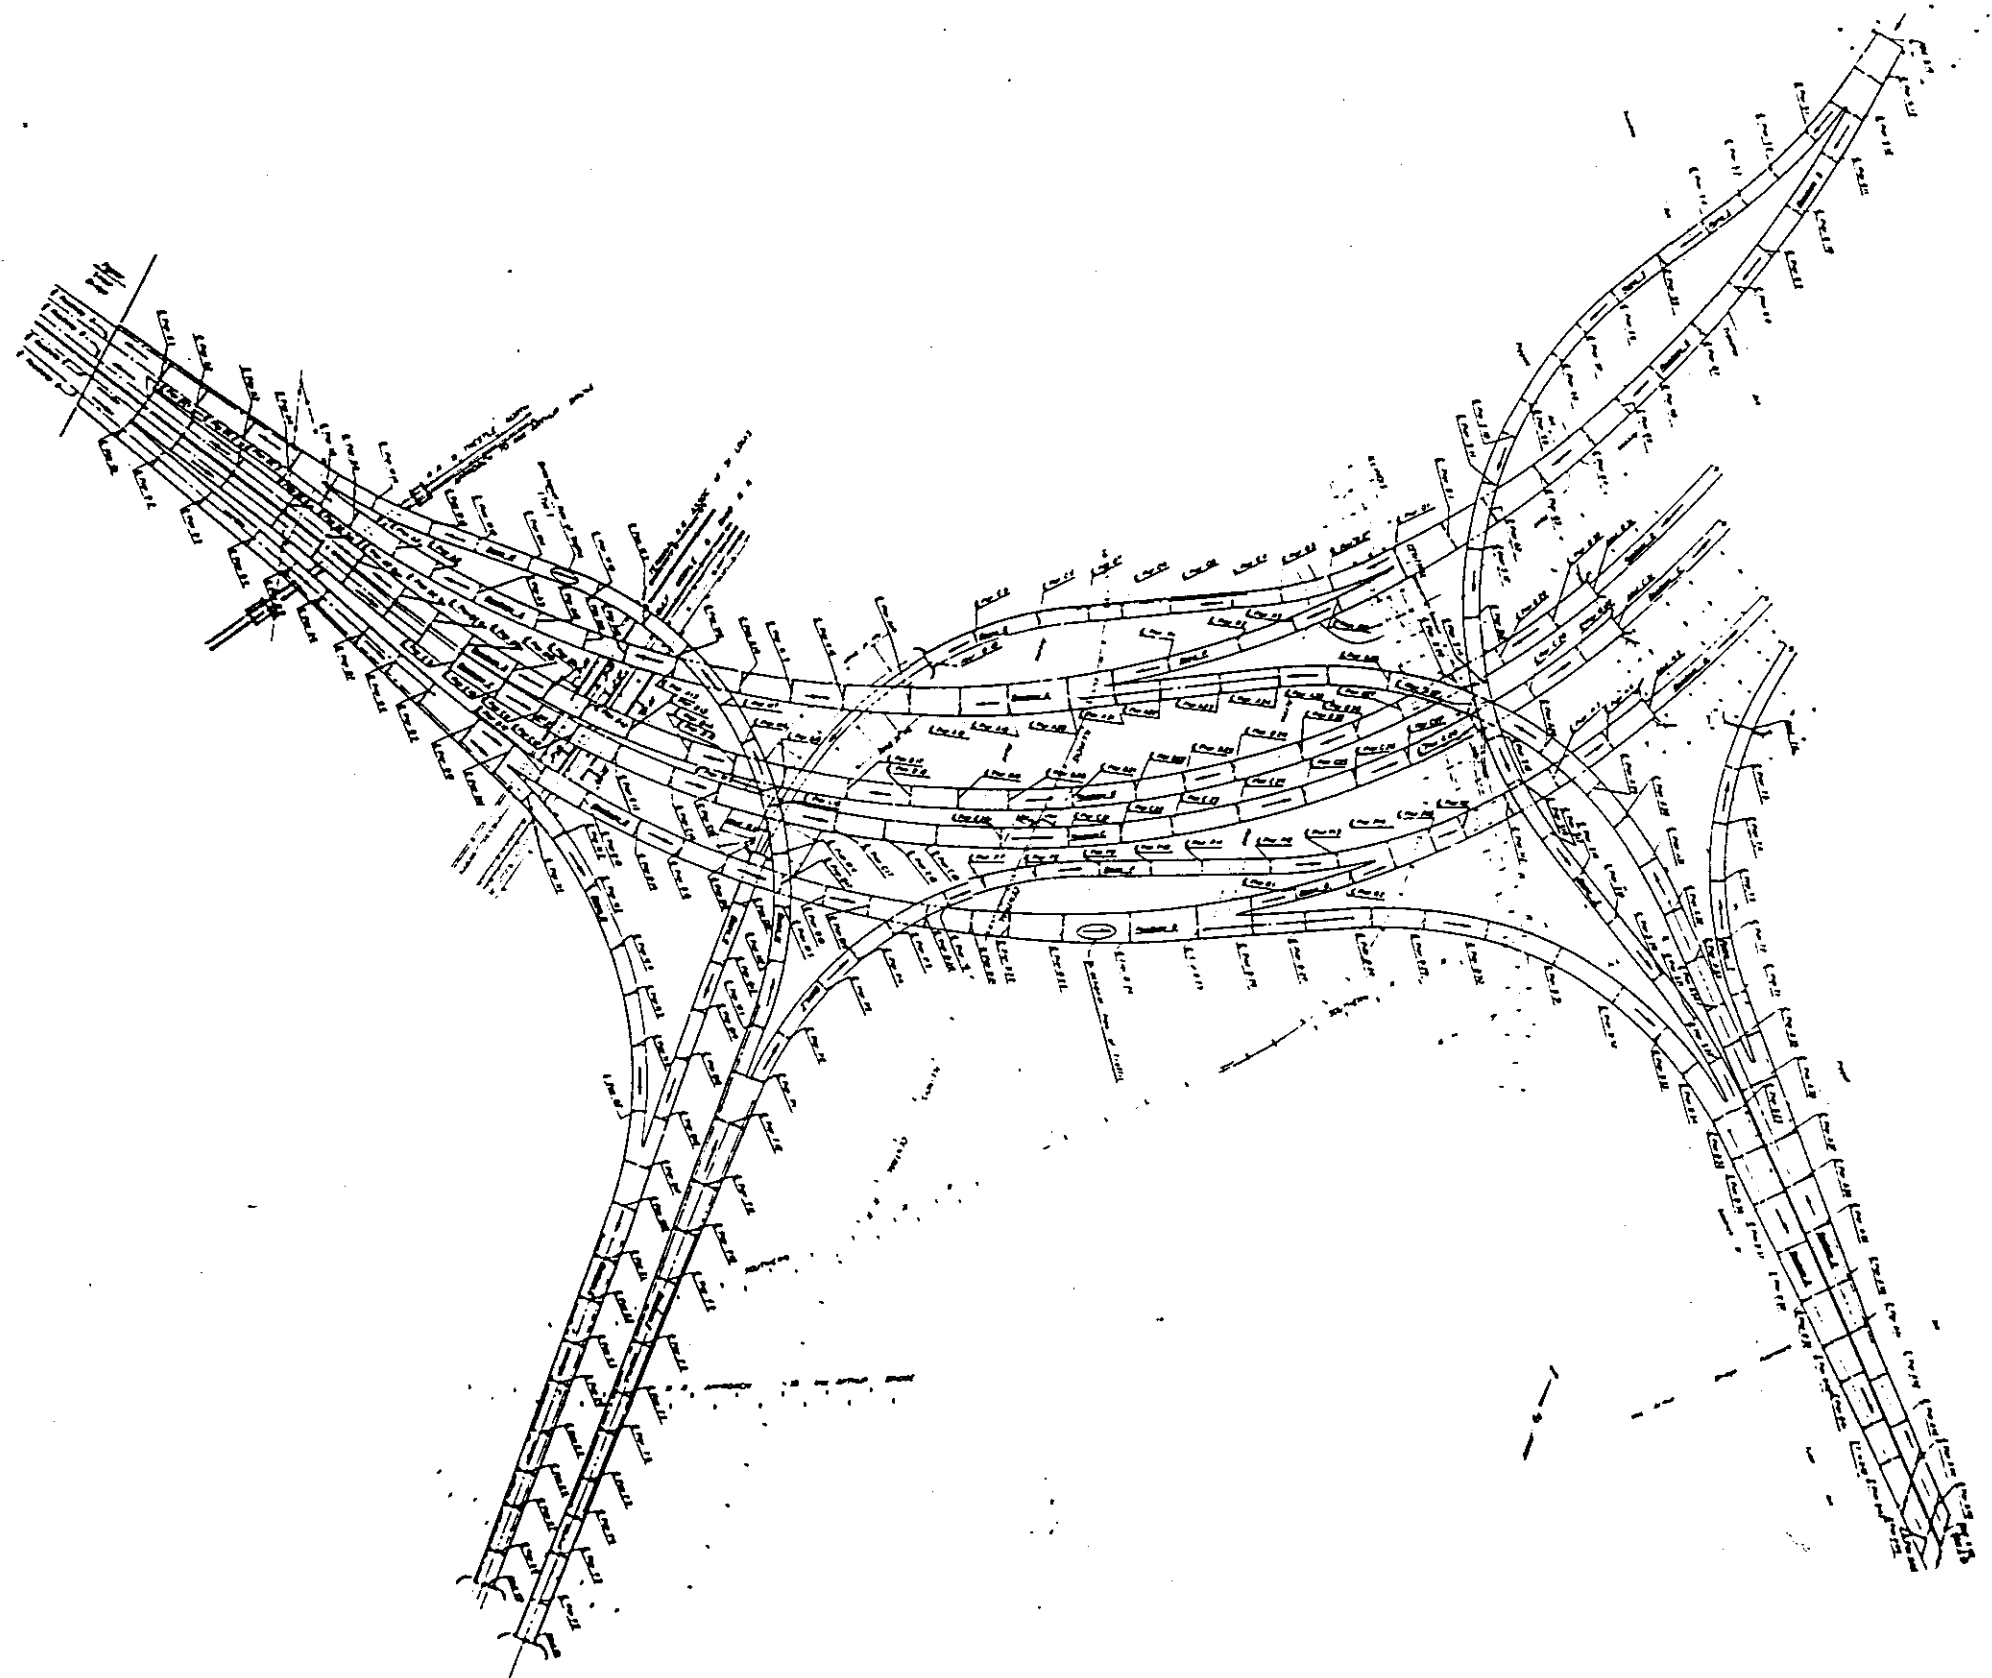

SUMMARY OF QUANTITIES			
CODE NO.	ITEM	UNIT	TOTAL QUANTITY
X05384	PIER COLUMN REPAIR	EACH	145
X06105	ABUT REPAIR	EACH	2
X64401	ENGR. FIELD OFFICE TYPE-A	CAL.MG.	33

GENERAL PLAN
 FAI RTE. 70
 SEC. 82-3HVB-R-2
 ST. CLAIR CO.

SUMMARY OF QUANTITIES

TABLE OF COLUMNS TO BE REPAIRED CRACKS (LESS THAN 15")

Pier No.	Diameter	Length Of Crack (Inches) As Built	Method Of Banding
A-3 N	4'-6"	8-12	B2-3HVB-1 Method 1
A-4 S	4'-0"	12	Method 1
A-9 S	4'-0"	6	Method 2
A-11 U	4'-0"	11	Method 2
A-17 S	4'-6"	8-10	Method 1
A-21 U	4'-0"	10	B2-3HVB-3 Method 1
A-24 U	4'-0"	4	Method 2
A-34 U	4'-6"	3-5	Method 2
A-36 U	4'-6"	12	Method 2
A-37 S	4'-0"	9	Method 1
A-38 S	4'-0"	6	B2-3HVB Method 1
A-11 U	4'-0"	8	Method 1
A-15 U	4'-0"	8	Method 1
A-24 U	4'-0"	12	Method 2
A-28 S	4'-0"	10	B2-3HVB Method 1
C-12 U	4'-0"	10-12	Method 1
C-14 U	4'-0"	3-4-7	Method 1
C-16 S	4'-0"	12	Method 2
C-16 S	4'-6"	13	Method 1
C-25 U	4'-0"	8	B2-3HVB Method 1
D-1 S	4'-0"	10	B2-3HVB-1 Method 1
D-5 S	4'-0"	9	Method 2
D-9 S	4'-0"	4	Method 2
D-11 S	4'-0"	12-12	Method 2
D-15 S	4'-0"	8	B2-3HVB Method 1
D-17 U	4'-6"	11-12	B2-3HVB-1 Method 2
D-18 S	4'-0"	11	Method 1
D-23 U	4'-6"	13	Method 1
D-26 U	4'-0"	13	Method 1
D-26 S	4'-0"	9	Method 2
D-29 U	4'-0"	7	Method 2
D-39 U	4'-0"	10	B2-3HVB-3 Method 2
E-3 W	4'-0"	4-11	B2-3HVB-2 Method 1
E-5 W	4'-0"	7	Method 1
E-6 W	4'-0"	11	Method 1
E-7 E	4'-0"	14	Method 1
E-8 E	4'-0"	4	Method 1
E-9 W	4'-0"	8	Method 1
E-10 E	4'-0"	9	Method 1
E-11 E	4'-6"	9	Method 1
F-11 W	4'-6"	14	B2-3HVB-1 Method 1
G-1 S	4'-0"	13	Method 2
G-6 S	4'-0"	5	Method 2
H-2 S	4'-0"	12	Method 2
H-4 S	4'-0"	12	Method 1
M-1 W	6'-0"	11	B2-3HVB-2 Method 1
M-3 W	6'-0"	4	B2-3HVB Method 1
M-12 W	4'-0"	12	B2-3HVB-1 Method 1
M-13 W	4'-0"	12	Method 2
N-6 U	4'-0"	13	B2-3HVB-2 Method 1
N-6 S	4'-0"	10	Method 1
N-7 S	4'-6"	6-7	Method 1
O-13 S	4'-0"	8	B2-3HVB-1 Method 1
O-13 S	4'-0"	13	Method 1
O-14 S	4'-0"	13	Method 1
O-16 U	4'-0"	5	B2-3HVB-2 Method 2
P-10 E	4'-0"	9	B2-3HVB-1 Method 1
Q-1 U	4'-0"	12	Method 1
R-1 U	4'-6"	8	Method 1
R-3 S	4'-0"	12	Method 2
R-4 S	4'-0"	10	Method 2
S-1 E	4'-0"	7-7	Method 2
S-4 E	4'-6"	6-10	Method 2
S-5 E	4'-0"	5	Method 1
S-5 W	6'-0"	6	Method 1
S-6 W	4'-6"	7	Method 2
S-9 W	6'-0"	9	Method 2
S-10 W	7'-0"	10	B2-3HVB Method 1
S-14 E	7'-0"	5	Method 1
S-22 W	4'-0"	13	B2-3HVB-3 Method 1
S-23 E	4'-6"	6	Method 2
S-24 U	4'-6"	8	Method 1
T-1 W	4'-0"	4	Method 2

SUBTOTAL 70 EACH

ABUTMENT REPAIR

ABUT. No.	TOTAL	REMARKS
E-1-W	1	See Spec. Prov. & Detail On Sheet #4 In Plans
E-1-E	2 Each	

TABLE OF COLUMNS TO BE REPAIRED CRACKS (15" OR LARGER)

Pier No.	Diameter	Length Of Crack (Inches) As Built	Method Of Banding
A-11 S	4'-0"	30-30-36	B2-3HVB-1 Method 2
A-13 S	4'-0"	16	Method 2
A-18 S	4'-0"	15	Method 2
A-18 S	4'-0"	23	B2-3HVB-3 Method 1
A-35 S	4'-0"	10-17	Method 2
A-36 S	4'-6"	12-18	Method 2
A-40 S	4'-0"	12-18	Method 2
A-41 U	4'-0"	15	Method 2
A-45 U	4'-6"	15	Method 2
A-9 U	4'-0"	19	B2-3HVB Method 1
B-11 S	4'-0"	18-18	Method 2
B-12 U	4'-0"	18	Method 1
B-12 S	4'-0"	8-24	Method 2
B-13 S	4'-0"	34	Method 2
B-14 S	4'-0"	18	Method 2
B-15 S	4'-0"	22	Method 2
B-16 U	4'-0"	29	Method 1
B-26 S	4'-6"	16	Method 2
B-26 S	4'-6"	16	Method 1
B-27 U	4'-0"	17	Method 2
B-27 S	4'-0"	19	Method 2
A-28 U	4'-0"	16	Method 1
A-30 U	4'-0"	28-36-39	B2-3HVB Method 1
C-5 S	4'-0"	24	Method 1
C-11 U	4'-0"	10-15-15	B2-3HVB Method 1
C-13 U	4'-0"	10-24	Method 1
C-13 S	4'-0"	21	Method 2
C-15 U	4'-0"	22	Method 1
C-16 U	4'-0"	18	Method 1
D-8 S	4'-0"	17	B2-3HVB-1 Method 2
D-8 S	4'-0"	21	Method 2
D-12 U	4'-0"	17	Method 2
D-13 S	4'-0"	6-18	Method 2
D-22 S	4'-0"	12-19	Method 2
D-25 U	4'-6"	25	Method 2
D-27 U	4'-0"	18	Method 2
D-28 U	4'-0"	24-38	Method 2
D-30 U	4'-0"	36	Method 2
D-31 U	4'-6"	2-16	B2-3HVB-3 Method 2
D-37 U	4'-6"	7-18-23	B2-3HVB-3 Method 2
D-40 U	4'-0"	18	Method 2
D-40 S	4'-0"	17	Method 2
D-44 S	4'-6"	9-20	Method 2
E-6 E	4'-0"	16	B2-3HVB-2 Method 1
E-4 W	4'-0"	12-17	Method 1
F-9 W	4'-0"	18	Method 2
F-10 W	4'-0"	21	Method 1
F-12 W	5'-0"	18-24	Method 1
G-2 S	5'-0"	20	B2-3HVB Method 2
G-5 S	4'-0"	16	B2-3HVB-1 Method 2
G-7 U	4'-0"	33	Method 1
G-7 S	4'-0"	19	Method 2
G-13 U	4'-0"	22-24	Method 2
H-1 U	4'-0"	12-18	Method 2
H-1 S	4'-0"	18	Method 2
H-2 U	4'-0"	15-19	Method 2
M-9 E	4'-0"	26	Method 2
M-10 E	4'-0"		Re-bar exposed (Per *)
N-2 S	4'-0"	16	Method 1
O-3 U	4'-0"	33	B2-3HVB-1 Method 1
O-7 S	4'-0"	16	Method 1
O-17 U	4'-0"	8-15-25	B2-3HVB-2 Method 1
O-17 S	4'-0"	16	Method 1
O-18 U	4'-6"	25-30	Method 1
P-1 W	4'-6"	9-40	Method 1
P-10 W	4'-0"	17	B2-3HVB-1 Method 1
P-14 E	4'-0"	18	Method 2
P-15 E	4'-6"	24	Method 2
P-15 W	4'-6"	21-30	Method 2
S-2 E	4'-0"	15	Method 2
S-3 E	4'-0"	20	Method 1
S-3 W	4'-0"	21	Method 2
S-8 E	5'-6"	9-24	Method 2
S-16 E	7'-0"	5-33	Method 2
S-17 E	6'-6"	6-54-60	Method 1
S-18 E	6'-0"	22-23	Method 1
S-18 W	4'-0"	14-65	B2-3HVB-3 Method 2
T-2 W	4'-6"	27	Method 1

SUBTOTAL 75 EACH

TOTAL COLUMNS TO BE REPAIRED EACH 145

FAIR	#	ST. CLAIR	4	3
------	---	-----------	---	---

B2-3HVB-R-2

- GENERAL NOTES
- For details of method 162 see Sheet #4
 - See Special Provisions for treatment of cracks in Pier Columns.
 - It will be the responsibility of the contractor to verify the Dia. of all pier columns prior to the fabrication of the bands.
 - Steel bands shall receive one shop coat of red lead paint and two field coats of Alum. Paint.






* See Spec. Prov for work involved and unit of Pay

SCHEDULE OF REPAIRS
PIER COLUMNS & ABUT'S
FAI. ROUTE 70
SEC. 82-3HVB-R-2

PROJECT NO.	DATE	BY	SCALE	NO.
FAI-70	8-2-52	ST. CLAIR	4	4


REPAIR OF CRACKED PIER COLUMNS

See table Table A&B for pier columns that need to be repaired. See SHEET #3

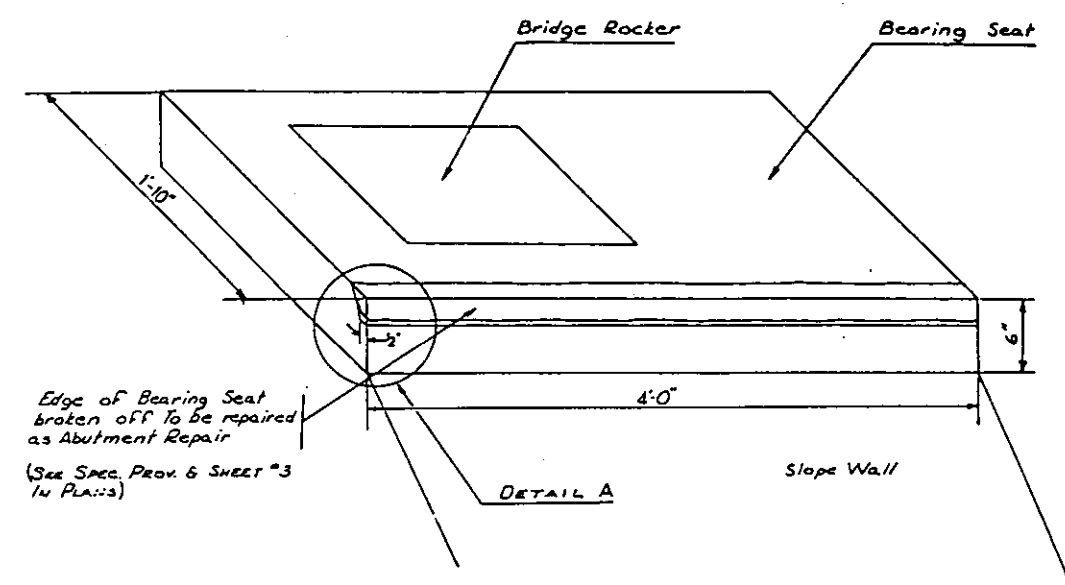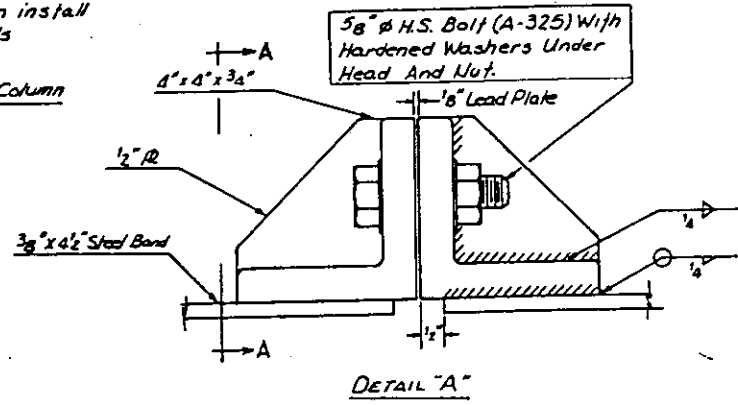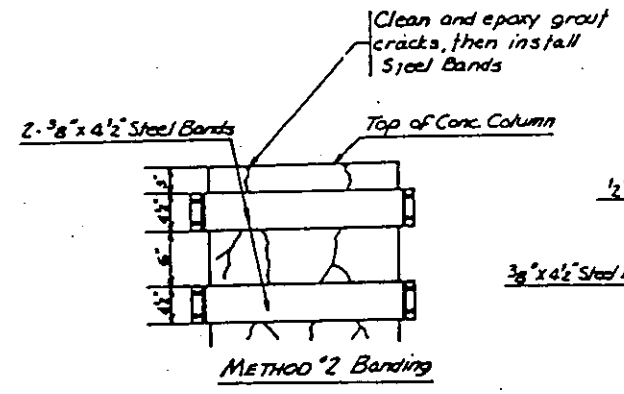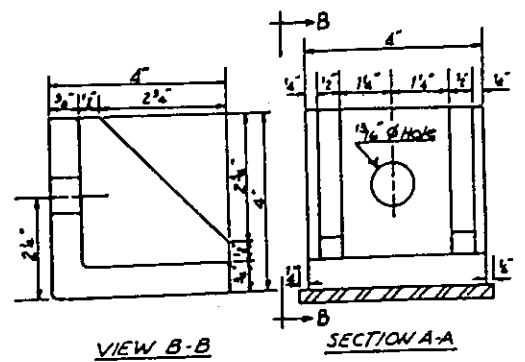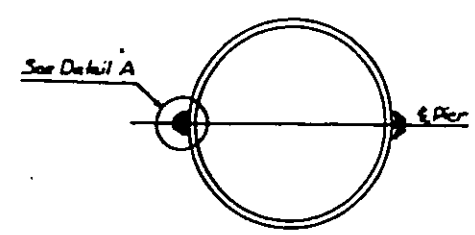


ABUTMENT REPAIR DETAIL
ABUT. No. F-1-W & F-1-E


Cracks On Top of Columns to be Vee'd by use of a chipping hammer or other suitable method approved by the Engineer

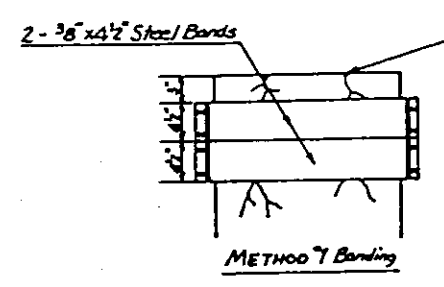


Top of Conc. Column to be cleaned by use of a small air chipping hammer or other suitable method approved by the Engineer to remove all laitance & unsound conc. area to be final cleaned by compressed air.

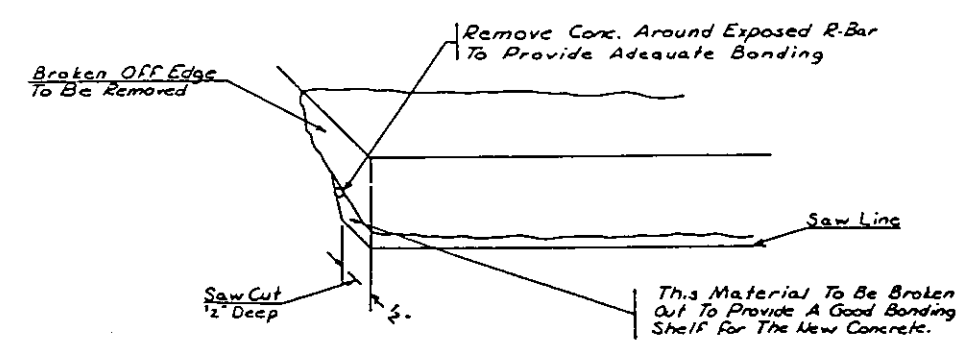

No Scale

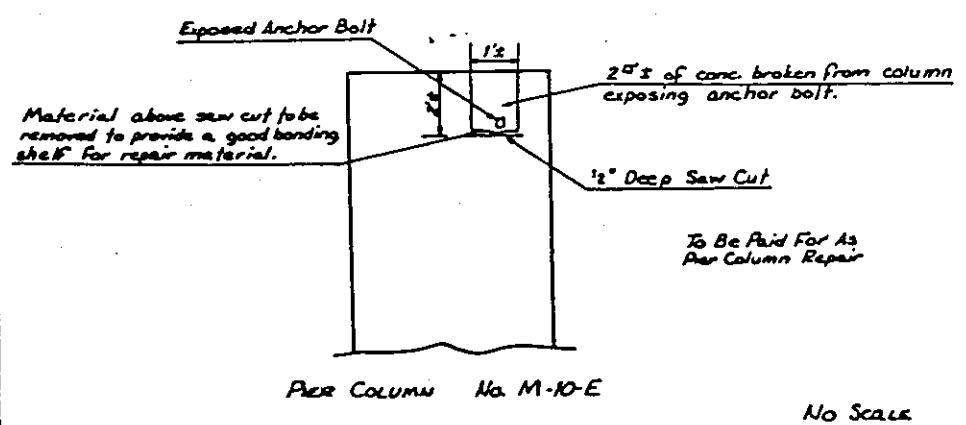



No Scale

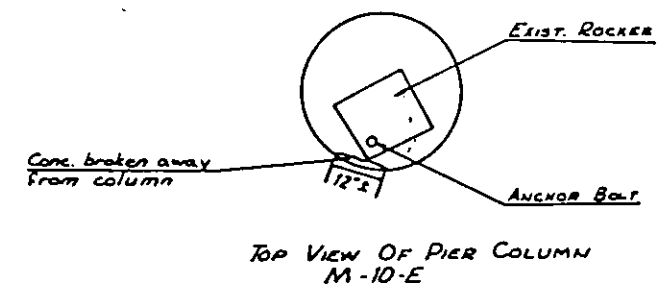


GENERAL PLAN
FAI RTE. 70
SEC. 82-3HVB-R-2
ST. CLAIR CO.
DETAILS OF CONSTRUCTION

ROUTE NO.	SECTION	COUNTY	TOTAL SHEETS	SHEET NO.
F.A.T.70	82-3HVB-1	ST. CLAIR		
FED. ROAD DIV. NO. 4	ILLINOIS	PROJECT		


82-3HVB-E-1 33
82-3HVD-1 68 of 258

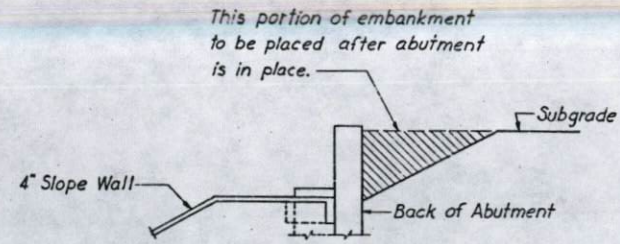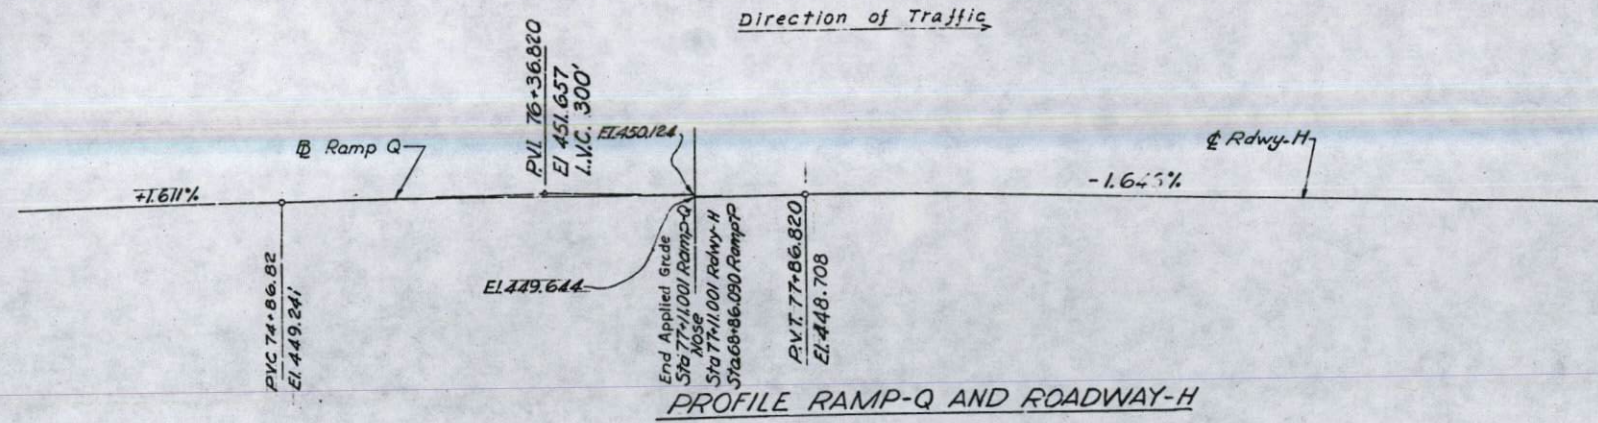

SECTION A-A

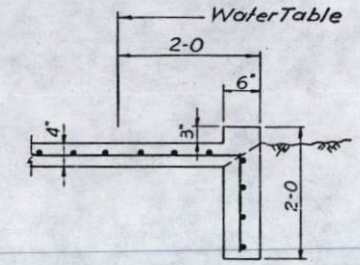


SECTION B-B

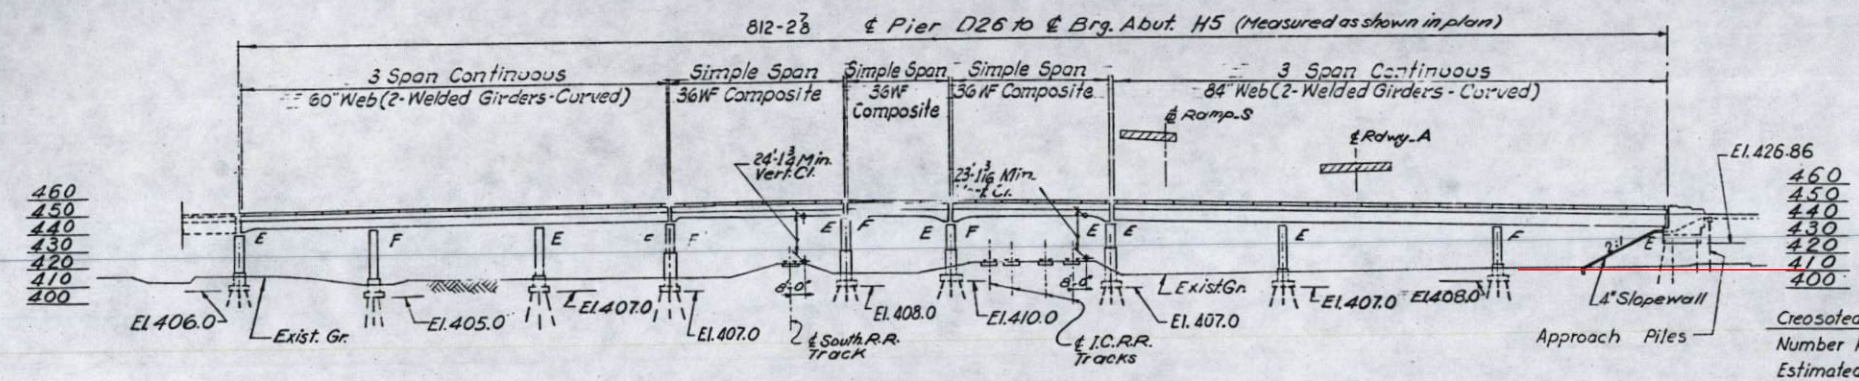


ELEVATION
DEVELOPED LENGTH ALONG RAMP Q & ROADWAY H

Creosoted Approach Piles
Number Required - 6
Estimated Length - 25'
See Special Provisions

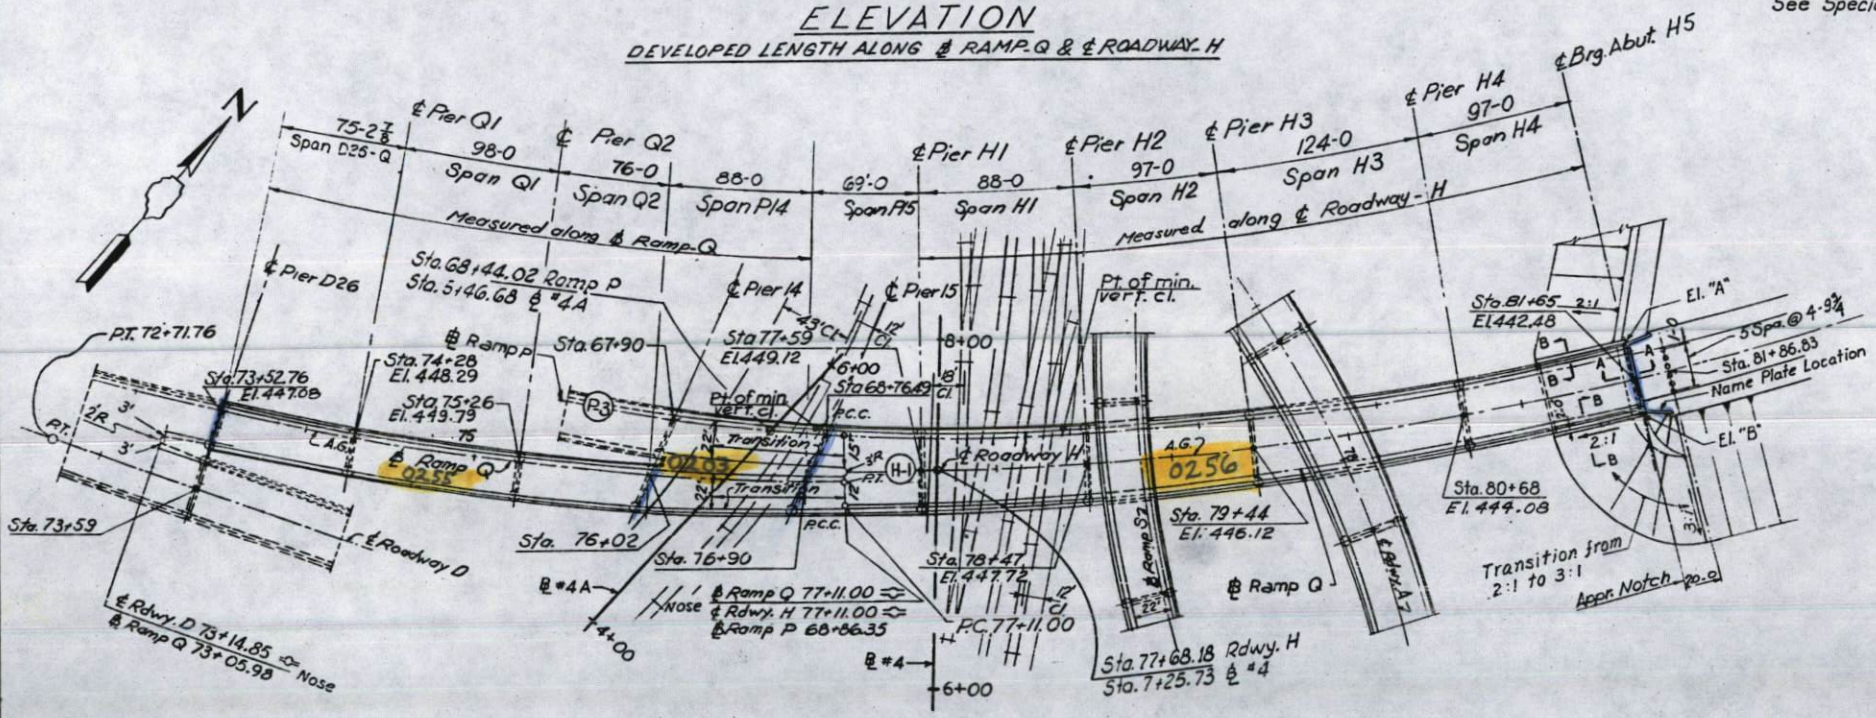

PLAN

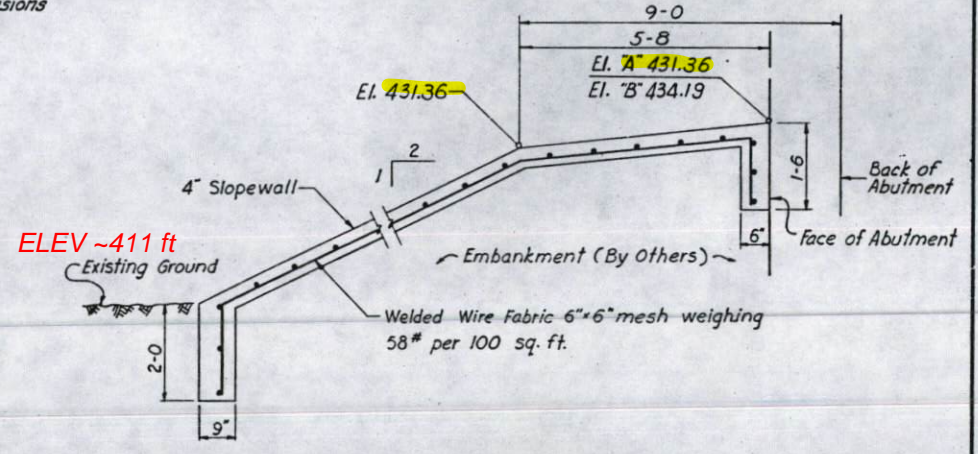

TYPICAL CROSS SECTION OF SLOPE WALL

BILL OF MATERIAL		
Item	Unit	Quantity
Slope Wall 4"	S.Y.	282
Name Plate	Ea.	1
Embankment	C.Y.	100

STATE OF ILLINOIS
DEPARTMENT OF PUBLIC WORKS & BLDGS.
DIVISION OF HIGHWAYS
PLAN AND ELEVATION
SPANS D26-Q, Q1, Q2, P14, P15, H1 THRU H4
POPLAR STREET BRIDGE APPROACHES
ROADWAY "H" AND RAMP "Q"
SECTIONS 82-3HVB-1
82-3HVB-E-1
82-3HVD-1
F.A.I.R.T.70 ST. CLAIR CO.
H. W. LOCHNER, INC.
ENGINEERS
CHICAGO, ILLINOIS

DESIGNED BY J.J.N.
DRAWN BY S.A.P.
CHECKED BY R.M.R.
APPROVED BY K.A.

Ramp P - SN 082-0203
Ramp Q - SN 082-0255
Roadway H - SN 082-0256

Curve P2


P.I. = 58+81.46
 $\Delta = 65^\circ 23' 55''$
 $D = 8^\circ 11' 06''$
 $R = 700.00'$
 $L = 798.99'$
 $T = 449.36'$
 $E = 131.83'$

Curve P3

P.I. = 67+38.03
 $\Delta = 21^\circ 04' 14''$
 $D = 7^\circ 01' 18''$
 $R = 816.00'$
 $L = 300.08'$
 $T = 151.76'$
 $E = 13.99'$

Curve Q1

P.I. = 71+34.70
 $\Delta = 38^\circ 09' 55''$
 $D = 3^\circ 10' 59''$
 $R = 1,800.00'$
 $L = 1,199.00'$
 $T = 622.70'$
 $E = 104.67'$

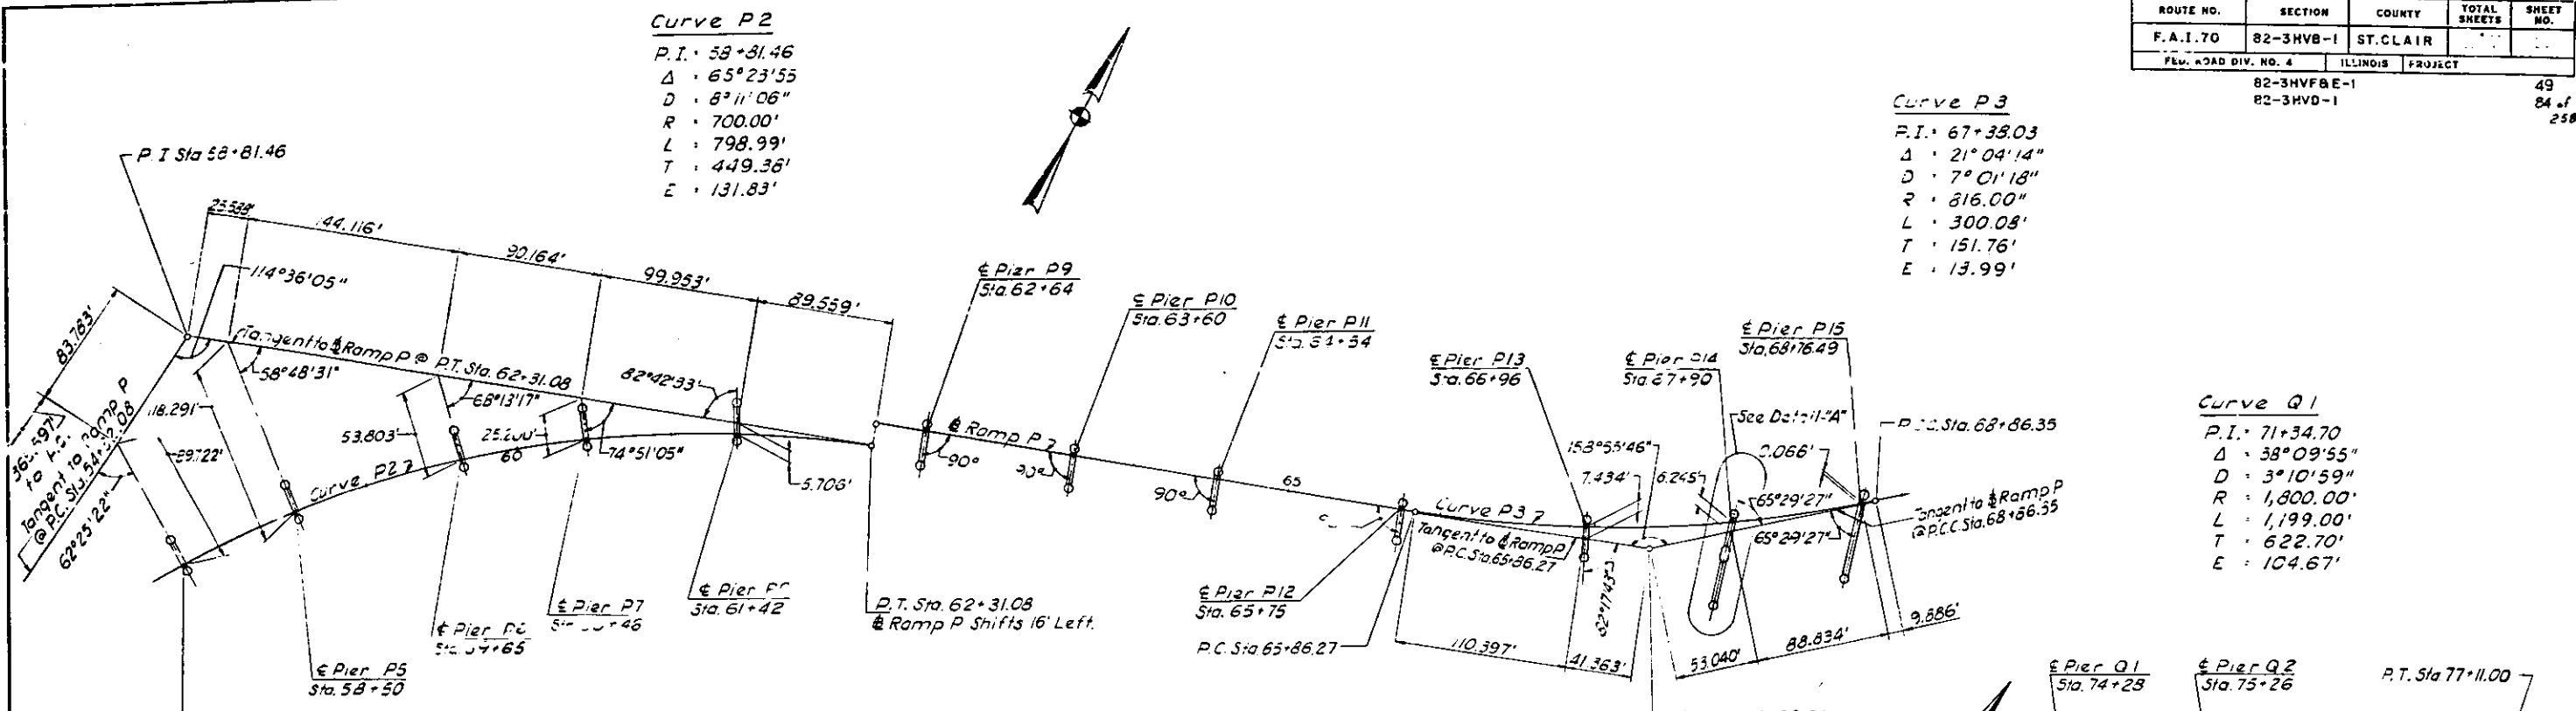


TABLES OF COORDINATES


Pier No.	Ramp P		Azimuth	Right Col. Offset	Left Col. Offset	
	Sta.	N. Coordinate				E. Coordinate
P4	57+69	8704.826	32408.504	122°10'24"	4-0	20-0
P5	58+50	8770.742	32455.501	128°48'12"	4-0	20-0
P6	59+65	8854.053	32534.587	138°12'58"	4-0	20-0
P7	60+46	8904.414	32597.970	144°50'48"	4-0	20-0
P8	61+42	8954.141	32679.999	152°42'14"	4-0	20-0
P9	62+64	9016.149	32787.002	159°59'41"	20-0	4-0
P10	63+60	9048.991	32877.210	159°59'41"	20-0	4-0
P11	64+54	9081.149	32965.538	159°59'41"	20-0	4-0
P12	65+75	9122.544	33079.237	159°59'41"	20-0	4-0
P13	66+96	9170.748	33190.105	152°17'24"	20-0	4-0
P14	67+90	9219.149	33270.626	163°26'00"	52-0	4-3
P15	68+76.49	9271.595	33339.354	163°26'00"	45-4	3-4

Pier No.	Roadway H		Azimuth	Right Col. Offset	Left Col. Offset	
	Sta.	N. Coordinate				E. Coordinate
H1	77+39	9296.990	33393.945	136°34'31"	21-4	21-4
H2	78+47	9359.004	33456.369	133°48'11"	20-2	20-2
H3	79+44	9430.767	33521.613	130°44'51"	19-0 1/2	19-0 1/2
H4	80+68	9527.394	33599.287	126°50'28"	17-10 1/2	17-10 1/2
Brq. Abut. H5	81+65	9606.537	33655.351	123°47'07"	17-11 1/2	17-2

Pier No.	Ramp Q		Azimuth	Right Col. Offset	Left Col. Offset	
	Sta.	N. Coordinate				E. Coordinate
Q1	74+28	9088.251	33139.097	147°05'44"	20-0	4-0
Q2	75+26	9143.701	33218.886	143°58'35"	20-0	4-0

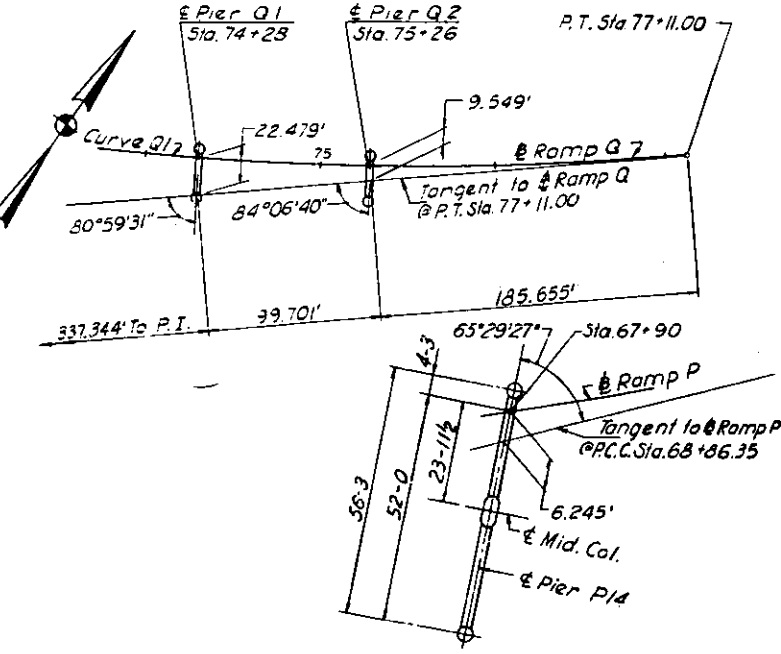

DETAIL - 'A'

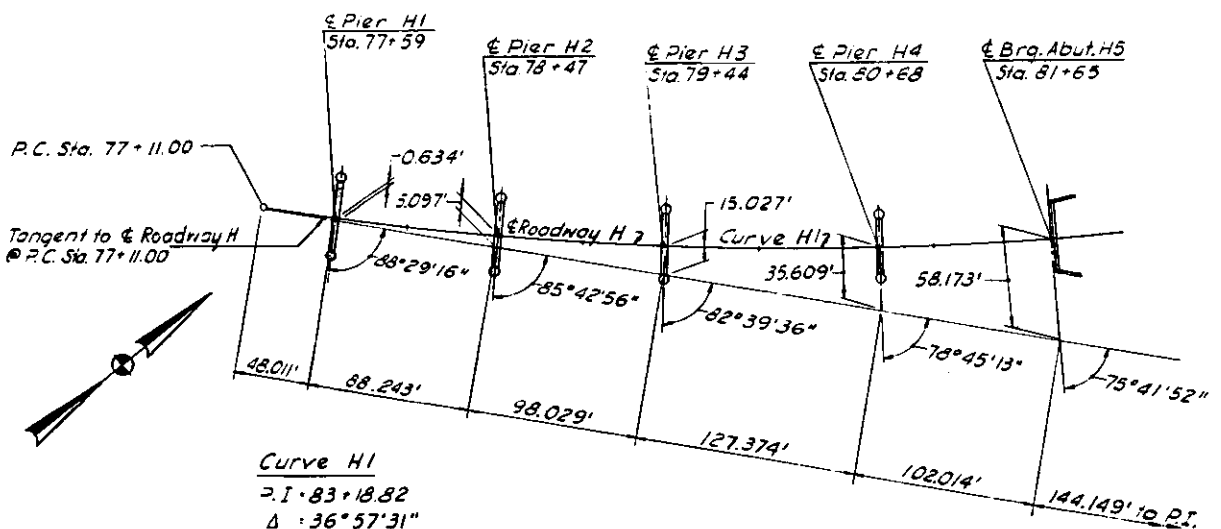

Curve H1


P.I. = 83+18.82
 $\Delta = 36^\circ 57' 31''$
 $D = 3^\circ 09' 01''$
 $R = 1,818.76'$
 $L = 1,173.19'$
 $T = 607.52'$
 $E = 98.88'$

DESIGNED BY R.M.D.
 DRAWN BY I.M.
 CHECKED BY S.G.B.
 APPROVED BY K.A.


STATE OF ILLINOIS
 DEPARTMENT OF PUBLIC WORKS & BLDGS.
 DIVISION OF PLANS
GEOMETRIC LAYOUT
 PIERS P4 THRU P15, Q1 Q2, H1 THRU H5
 POPLAR STREET BRIDGE APPROACHES
 RAMPS P&Q AND ROADWAY "H"
 SECTIONS 82-3HVB-1
 82-3HVF&E-1
 82-3HVD-1
 F.A.I. RT. 70 ST. CLAIR CO.
 H. W. LOCHNER, INC.
 ENGINEERS
 CHICAGO, ILLINOIS

P - 082-0203
 Q - 082-0255
 H - 082-0256

ROUTE NO.	SECTION	COUNTY	TOTAL SHEETS	SHEET NO.
F.A.I.-70	82-3HVD-1	ST. CLAIR	258	116
FED. ROAD DIV. NO. 4	ILLINOIS	PROJECT		

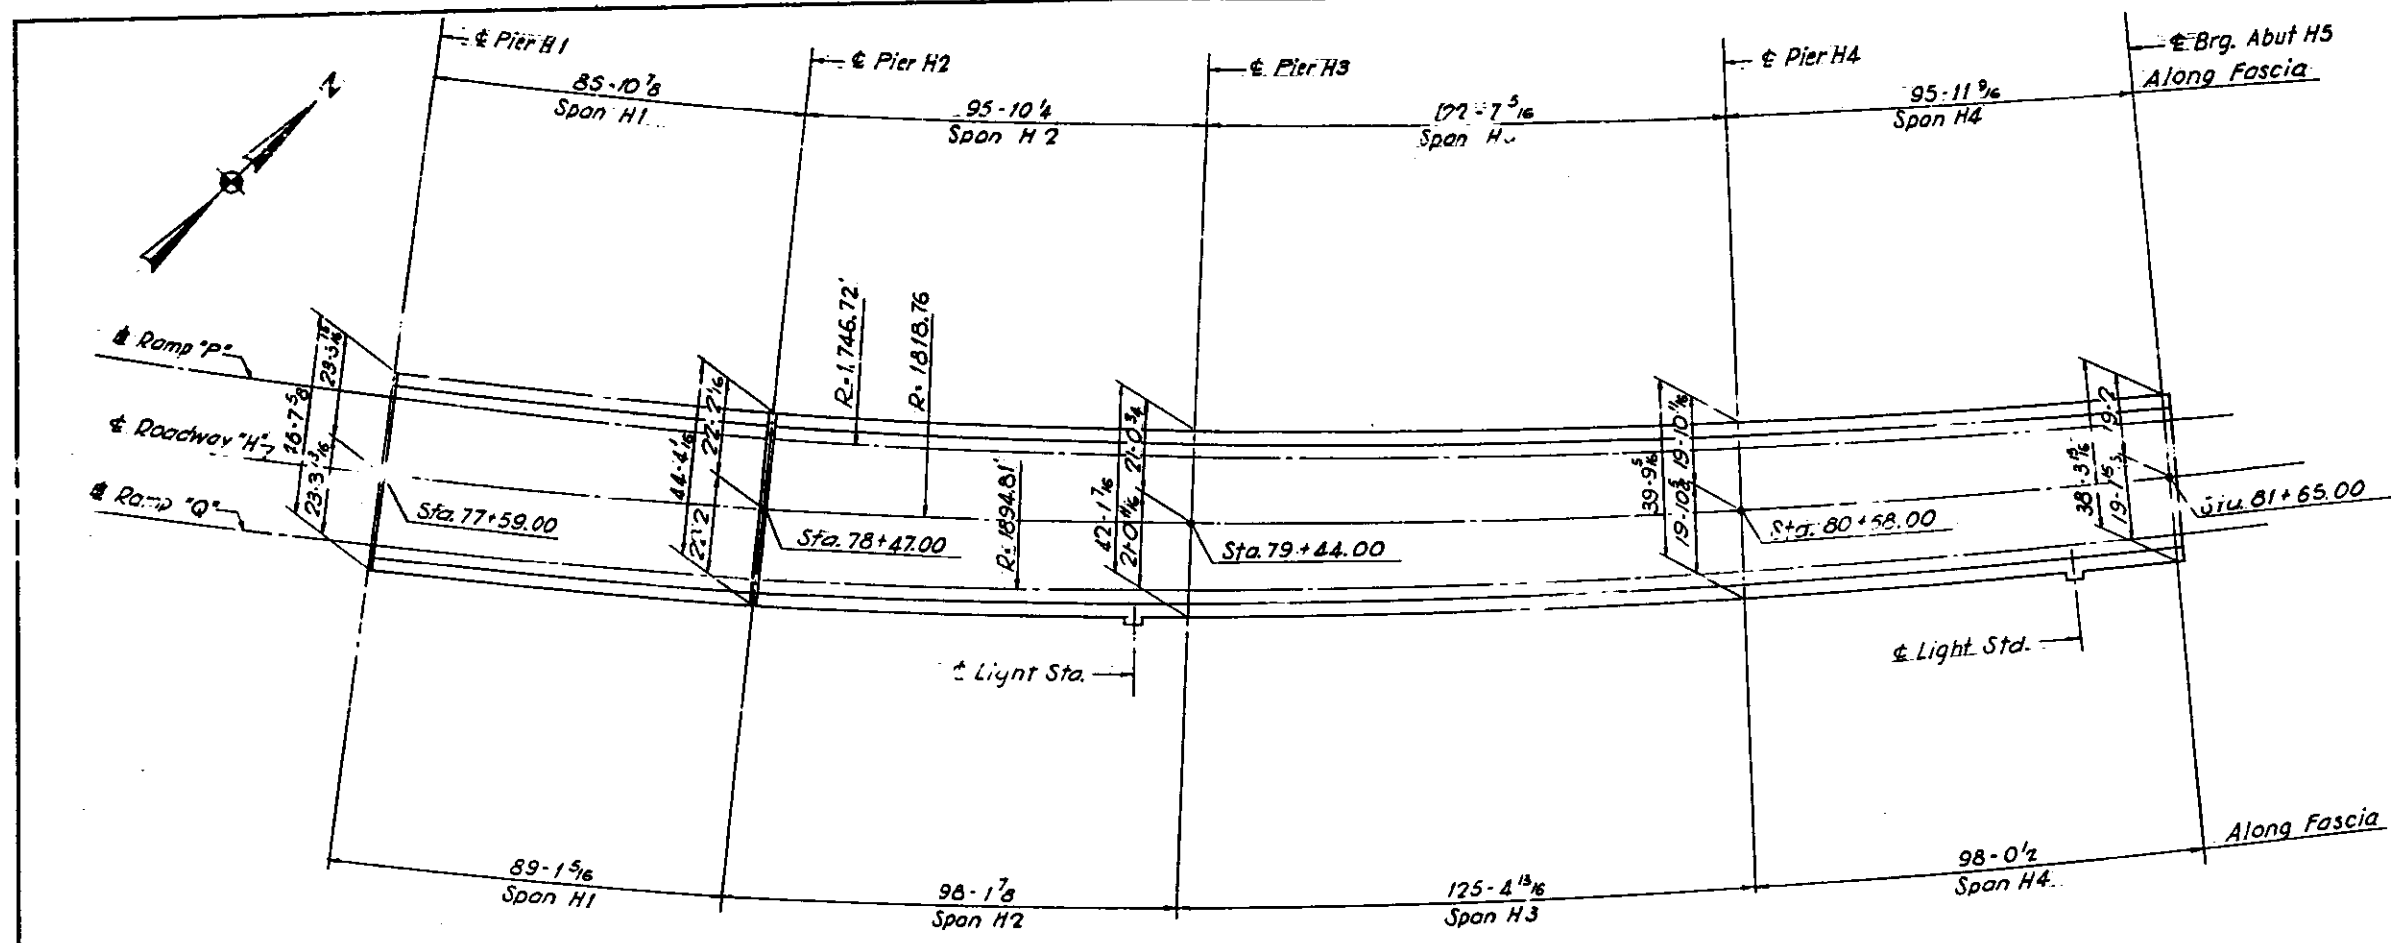

PLAN
Spans H1 thru H4

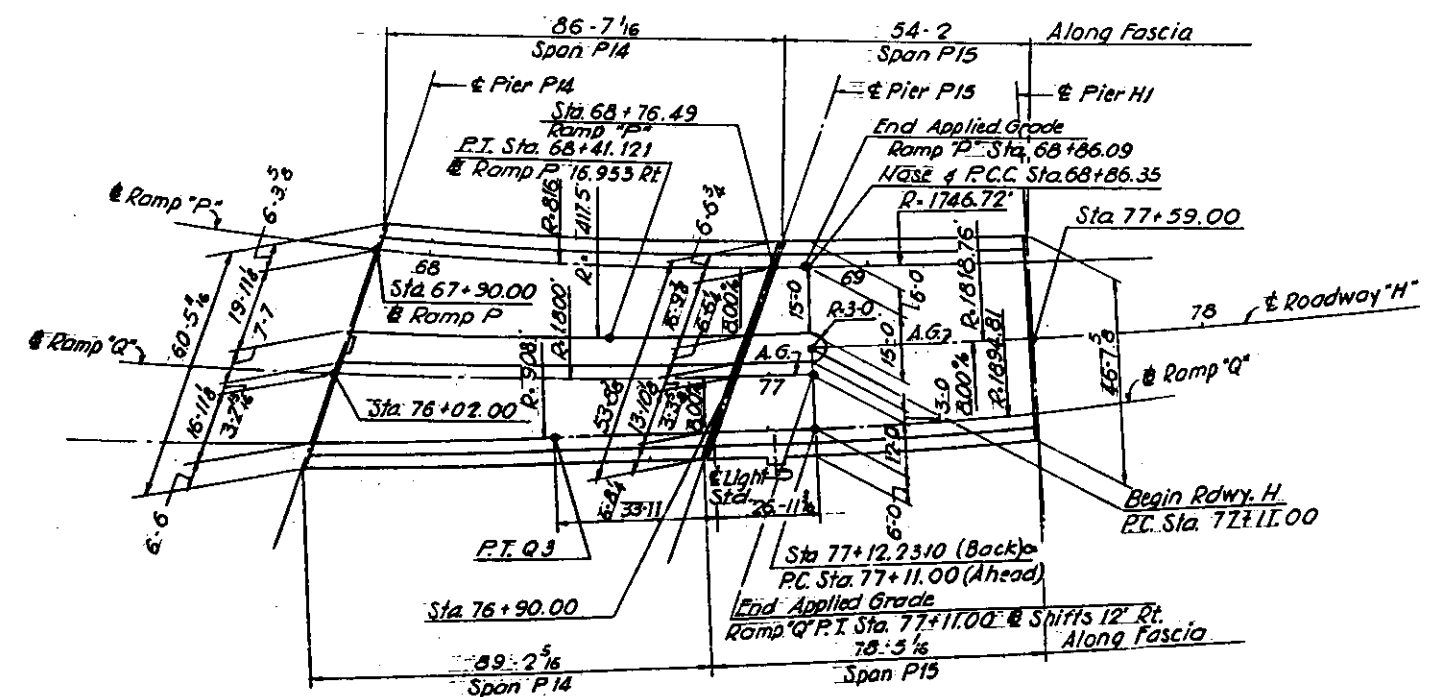


CURVE DATA Q3
 P.T. 76+07.7806504
 $\Delta = 5^\circ 30' 24.738''$
 $R = 908.00'$
 $D_c = 6^\circ 18' 36.368''$
 $L = 87.2706422'$
 $T = 43.6689430'$
 $E = 1.0482769'$

PLAN
Spans P14 & P15

DESIGNED BY R.M.P.
 DRAWN BY T.R.
 CHECKED BY H.J.F.
 APPROVED BY K.A.

STATE OF ILLINOIS
 DEPARTMENT OF PUBLIC WORKS & BLDGS.
 DIVISION OF HIGHWAYS
 SLAB
 DIMENSION PLAN - SPANS H1 THRU H4; P14 & P15
 POPLAR STREET BRIDGE APPROACHES
 ROADWAY "H" AND RAMP "P"
 F.A.I. RT. 70 ST. CLAIR CO. SECTION 82-3HVD-1
 H. W. LOCHNER, INC.
 ENGINEERS
 CHICAGO, ILLINOIS
 SHEET 630758

ROUTE NO.	SECTION	COUNTY	TOTAL SHEETS	SHEET NO.
F. A. I. - 70	82-3HYD-1	ST. CLAIR	258	117
FED. ROAD DIST. NO. 4		ILLINOIS PROJECT		

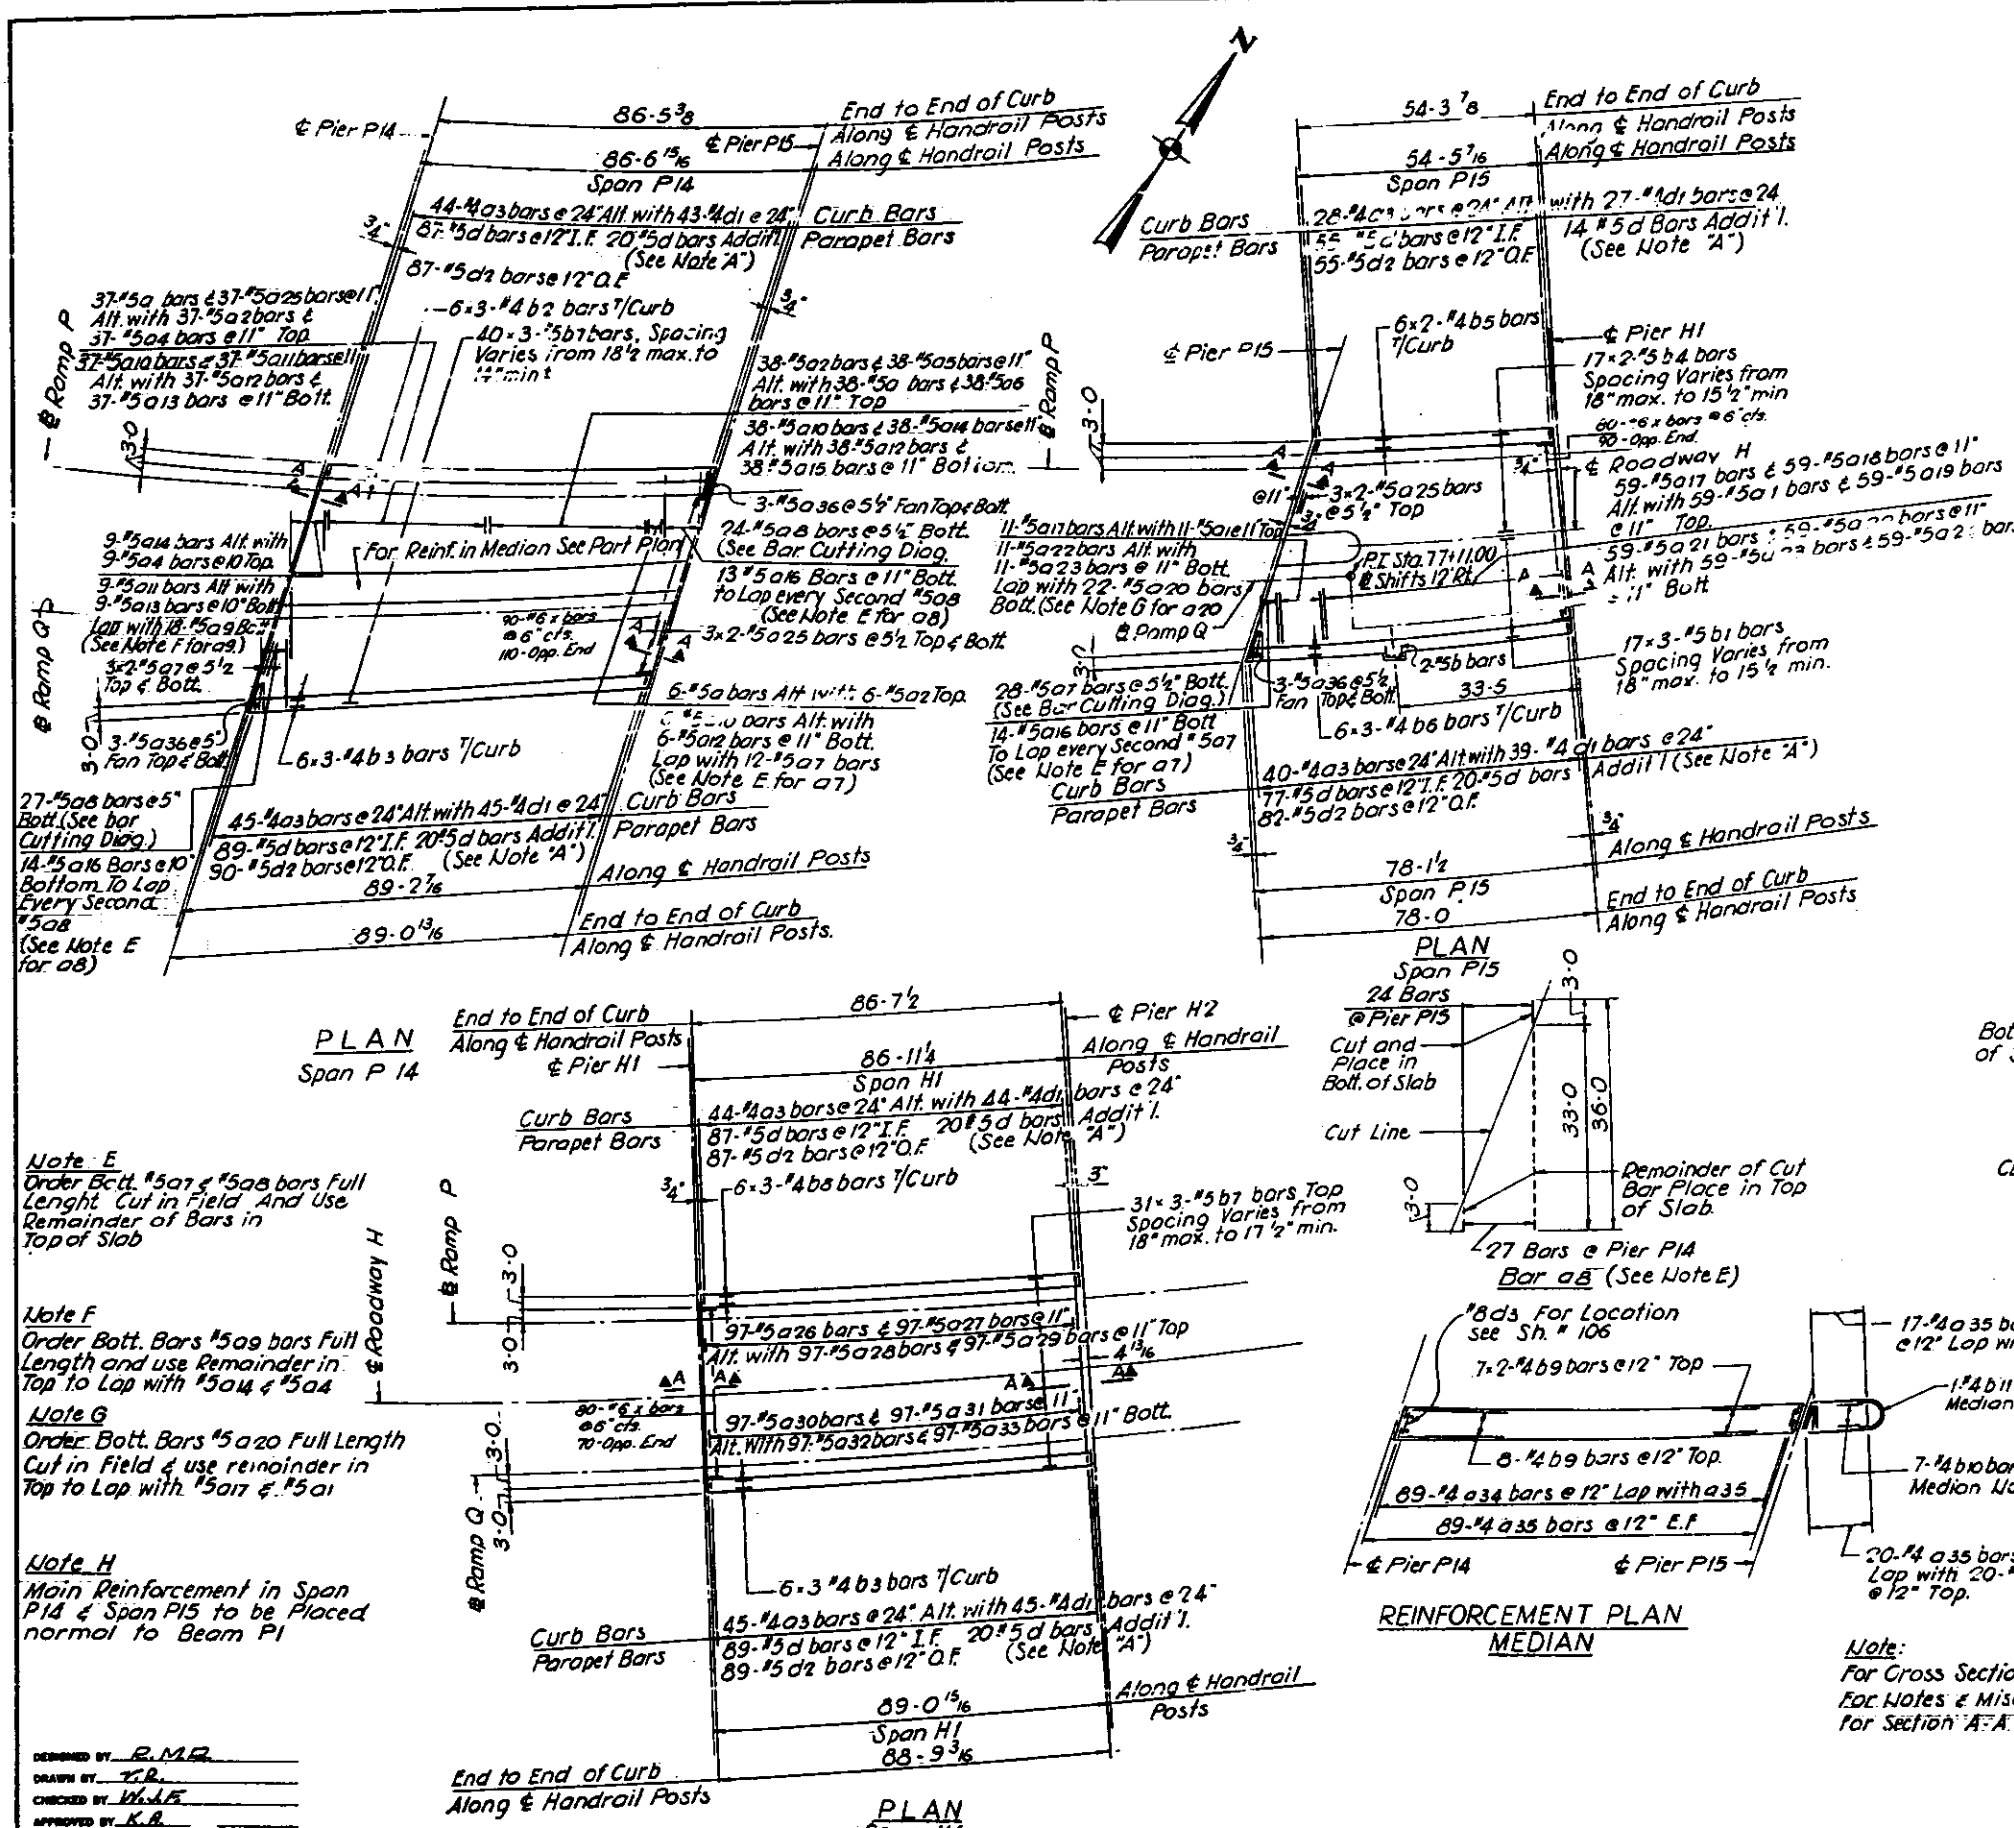

BILL OF MATERIAL

Bar	NO	Size	Length	Shape	
64a1	81	#5	28-9	—	
64a2	81	#5	27-10	—	
64a3	89	#5	35-6	—	
64a4	28	#5	3-9	—	
64a5	4	#5	21-3	—	
64a6	38	#5	19-3	—	
64a7	24	#5	26-0	—	
64a8	51	#5	30-6	—	
64a9	12	#5	32-0	—	
64a10	12	#5	35-11	—	
64a11	81	#5	24-6	—	
64a12	26	#5	33-0	—	
64a13	81	#5	32-10	—	
64a14	46	#5	25-11	—	
64a15	47	#5	30-0	—	
64a16	38	#5	23-9	—	
64a17	27	#5	2-7	—	
64a18	70	#5	20-5	—	
64a19	59	#5	29-7	—	
64a20	59	#5	22-2	—	
64a21	22	#5	35-10	—	
64a22	59	#5	34-4	—	
64a23	70	#5	17-8	—	
64a24	70	#5	24-2	—	
64a25	59	#5	25-10	—	
64a26	49	#5	28-0	—	
64a27		#97	#5	27-9	—
64a28		#97	#5	20-0	—
64a29		#97	#5	20-8	—
64a30		#97	#5	27-3	—
64a31		#97	#5	24-4	—
64a32		#97	#5	23-8	—
64a33		#97	#5	32-7	—
64a34		#97	#5	17-3	—
64a35	89	#4	5-6	—	
64a36	178	#4	2-10	—	
64a37	12	#5	5-0	—	
64b	2	#5	3-8	—	
64b1	150	#5	26-9	—	
64b2	18	#4	29-5	—	
64b3	18	#4	30-3	—	
64b4	104	#4	33-10	—	
64b5	12	#4	27-6	—	
64b6	18	#4	26-8	—	
64b7	342	#5	30-4	—	
64b8	18	#4	29-6	—	
64b9	22	#4	31-0	—	
64b10	7	#4	16-0	—	
64b11	1	#4	15-6	—	
64c	200	#8	4-9	—	
64d	216	#5	3-3	—	
64e	88	#4	1-1	—	
64f	177	#5	3-6	—	
64g	8	#5	4-9	—	

REINFORCEMENT PLAN MEDIAN
 27 Bars @ Pier P14
 Bar a8 (See Note E)
 8ds For Location see Sh. # 106
 7-#4b9 bars @ 12" Top
 8-#4b9 bars @ 12" Top
 89-#4a34 bars @ 12" Lap with a35
 89-#4a35 bars @ 12" E.F.
 17-#4a35 bars @ 12" Lap with a34
 1-#4b11 Top Median Nose
 7-#4b10 bars Top Median Nose
 20-#4a35 bars @ 12" Lap with 20-#4a34 bars @ 12" Top.

Note E
 Order Bott. #5a7 & #5a8 bars Full Length Cut in Field And Use Remainder of Bars in Top of Slab

Note F
 Order Bott. Bars #5a9 bars Full Length and use Remainder in Top to Lap with #5a14 & #5a4

Note G
 Order Bott. Bars #5a20 Full Length Cut in Field & use remainder in Top to Lap with #5a17 & #5a1

Note H
 Main Reinforcement in Span P14 & Span P15 to be Placed normal to Beam P1

DESIGNED BY: R.M.R.
 DRAWN BY: T.R.
 CHECKED BY: W.L.F.
 APPROVED BY: K.R.

H1 Rev. Reinf. from 30,990 to 32,060 Added bars 64x, 6-3-66 N.R.F.
 Added shear conn. in B of M.
 P14 Rev. Reinf. from 37,600 to 37,030 Added bars 64x
 P15 Rev. Reinf. from 25,510 to 26,720 Added bars 64x





STATE OF ILLINOIS
 DEPARTMENT OF PUBLIC WORKS & BLDGS.
 DIVISION OF HIGHWAYS

SLAB
 SPANS P14, P15 AND H1
 POPLAR STREET BRIDGE APPROACHES
 ROADWAY "H" AND RAMPS "P" & "O"

F. A. I. RT. 70 ST. CLAIR CO. SECTION 82-3HYD-1
 H. W. LOCHNER, INC.
 ENGINEERS
 CHICAGO, ILLINOIS

SHEET
 64a32E

ROUTE NO.	SECTION	COUNTY	TOTAL SHEETS	SHEET NO.
F.A.I.-70	82-3HVD-1	ST. CLAIR	258	118
ROAD DIV. NO. 4	ILLINOIS	PROJECT		

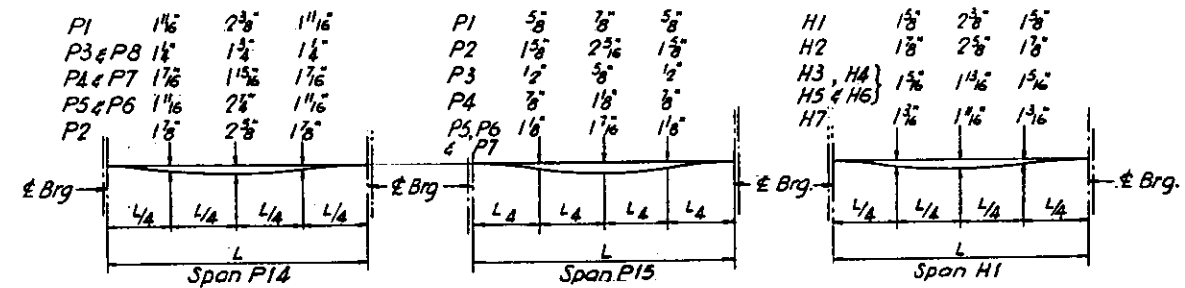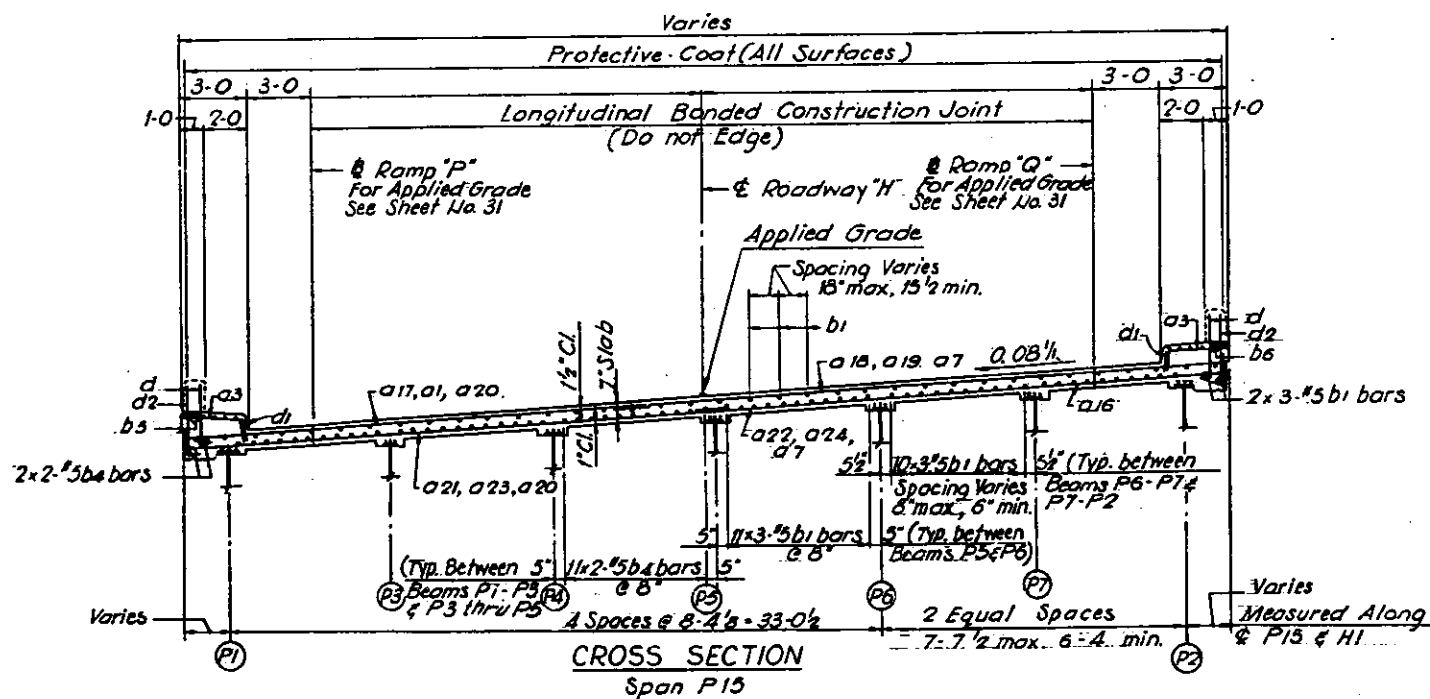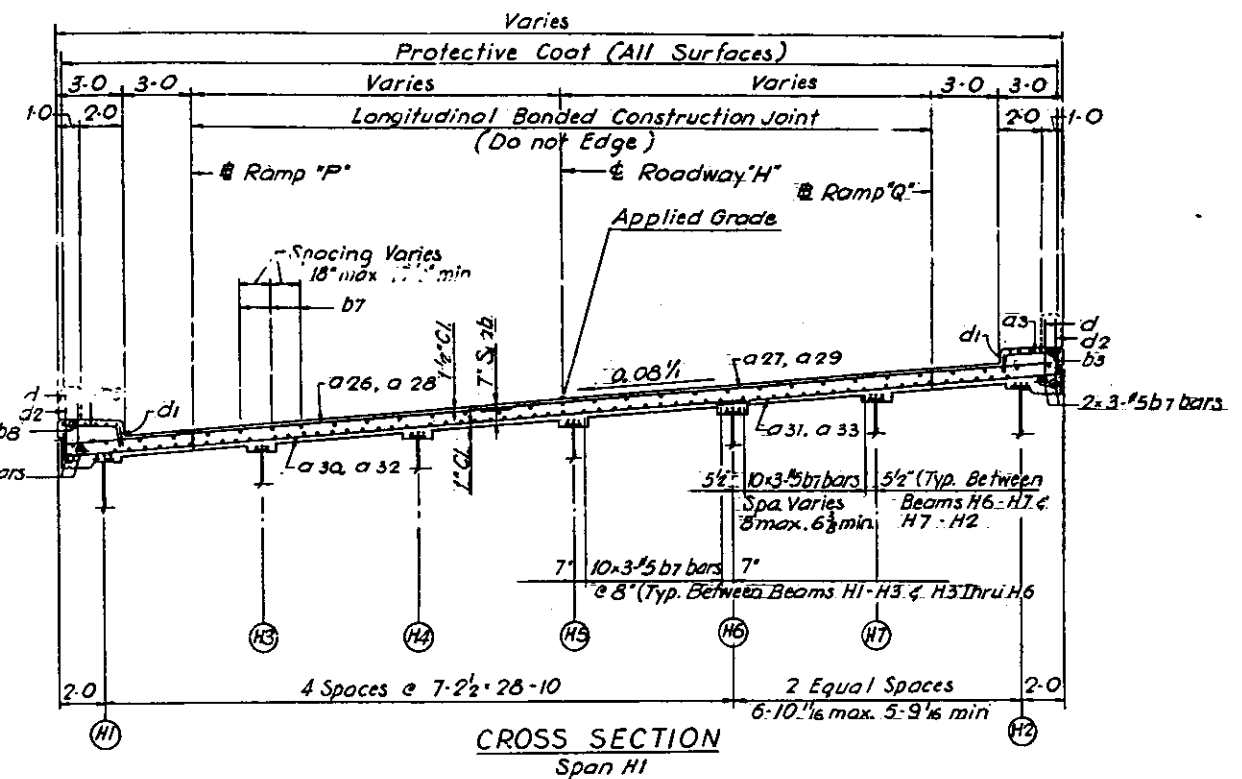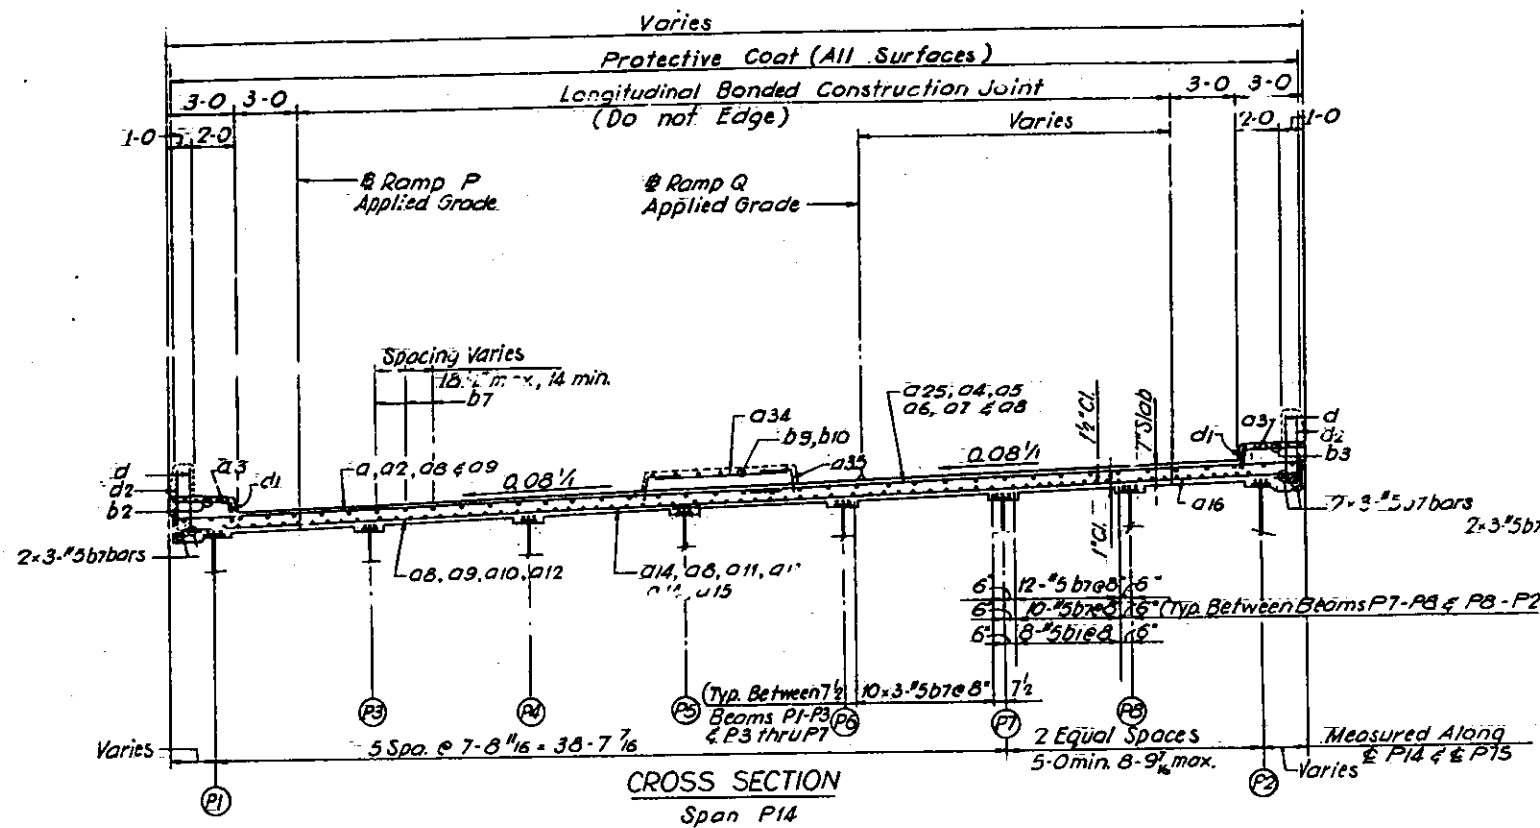

DESIGNED BY R.M.P.
 DRAWN BY T.R.
 CHECKED BY H.L.F.
 APPROVED BY K.B.

Note:
 For Notes & Location of Section See Sheet No. 64

STATE OF ILLINOIS
 DEPARTMENT OF PUBLIC WORKS & BLDGS.
 DIVISION OF HIGHWAYS
 SLAB
 SPANS P14, P15 AND H1
 POPLAR STREET BRIDGE APPROACHES
 ROADWAY "H" AND RAMPS "P" & "Q"
 F.A.I. RT. 70 ST. CLAIR CO. SECTION 82-3HVD-1
 H. W. LOCHNER, INC.
 ENGINEERS
 CHICAGO, ILLINOIS
 SHEET 65 OF 258





ROUTE NO.	SECTION	COUNTY	TOTAL SHEETS	SHEET NO.
F. A. I. - 70	82-3HVD-1	ST. CLAIR	258	119
FED. ROAD DIV. NO. 4	ILLINOIS	PROJECT		

BILL OF MATERIAL

BAR NO.	NO.	SIZE	LENGTH	SHAPE
66a	234	#5	19-8	L
66a1	234	#5	26-9	L
66a2	301	#5	18-10	L
66a3	320	#4	3-9	L
66a4	301	#5	25-3	L
66a5	215	#5	17-11	L
66a6	215	#5	24-0	L
66a7	234	#5	14-4	L
66a8	234	#5	30-7	L
66a9	301	#5	14-0	L
66a10	301	#5	29-3	L
66a11	215	#5	15-3	L
66a12	215	#5	27-8	L
66b	4	#5	3-8	L
66b1	369	#5	35-7	L
66b2	236	#5	32-3	L
66b3	116	#6	35-0	L
66b4	360	#5	27-9	L
66b5	24	#4	15-9	L
66b6	18	#4	27-2	L
66b7	18	#4	30-11	L
66b8	18	#4	27-6	L
66b9	18	#4	27-11	L
66b10	18	#4	31-7	L
66b11	18	#4	28-2	L
66d	777	#5	3-3	L
66d1	319	#4	1-1	L
66d2	645	#5	3-6	L
66x	140	#6	4-9	L

• See Note X Sh. No 35

ITEM	UNIT	TOTAL
Class "X" Concrete	Cu. Yds.	368.3
Reinforcement Bars	Lbs.	114,790
Protective Coat	Sq. Yds.	1602

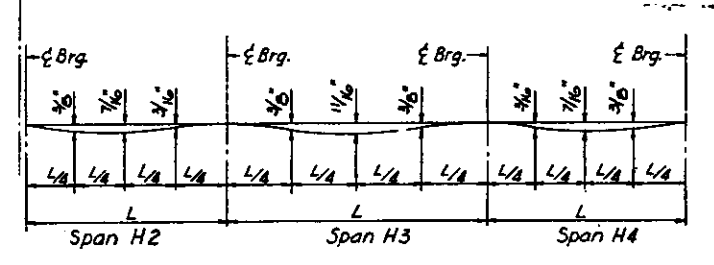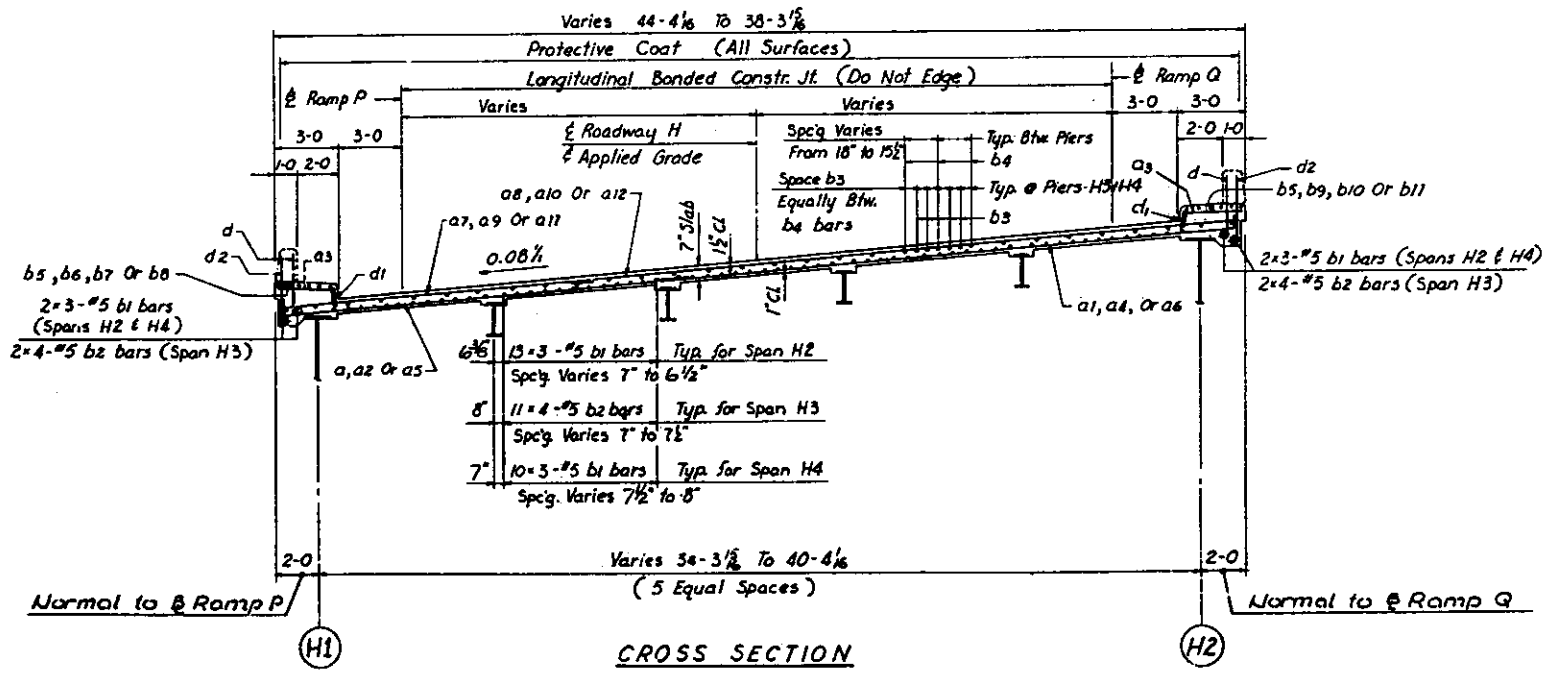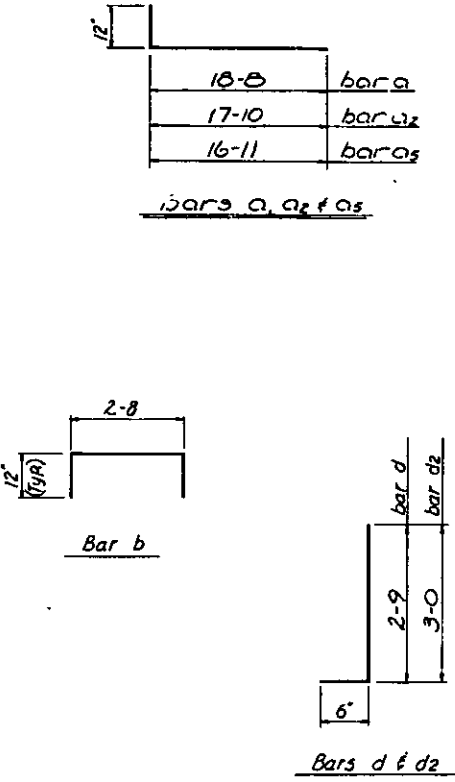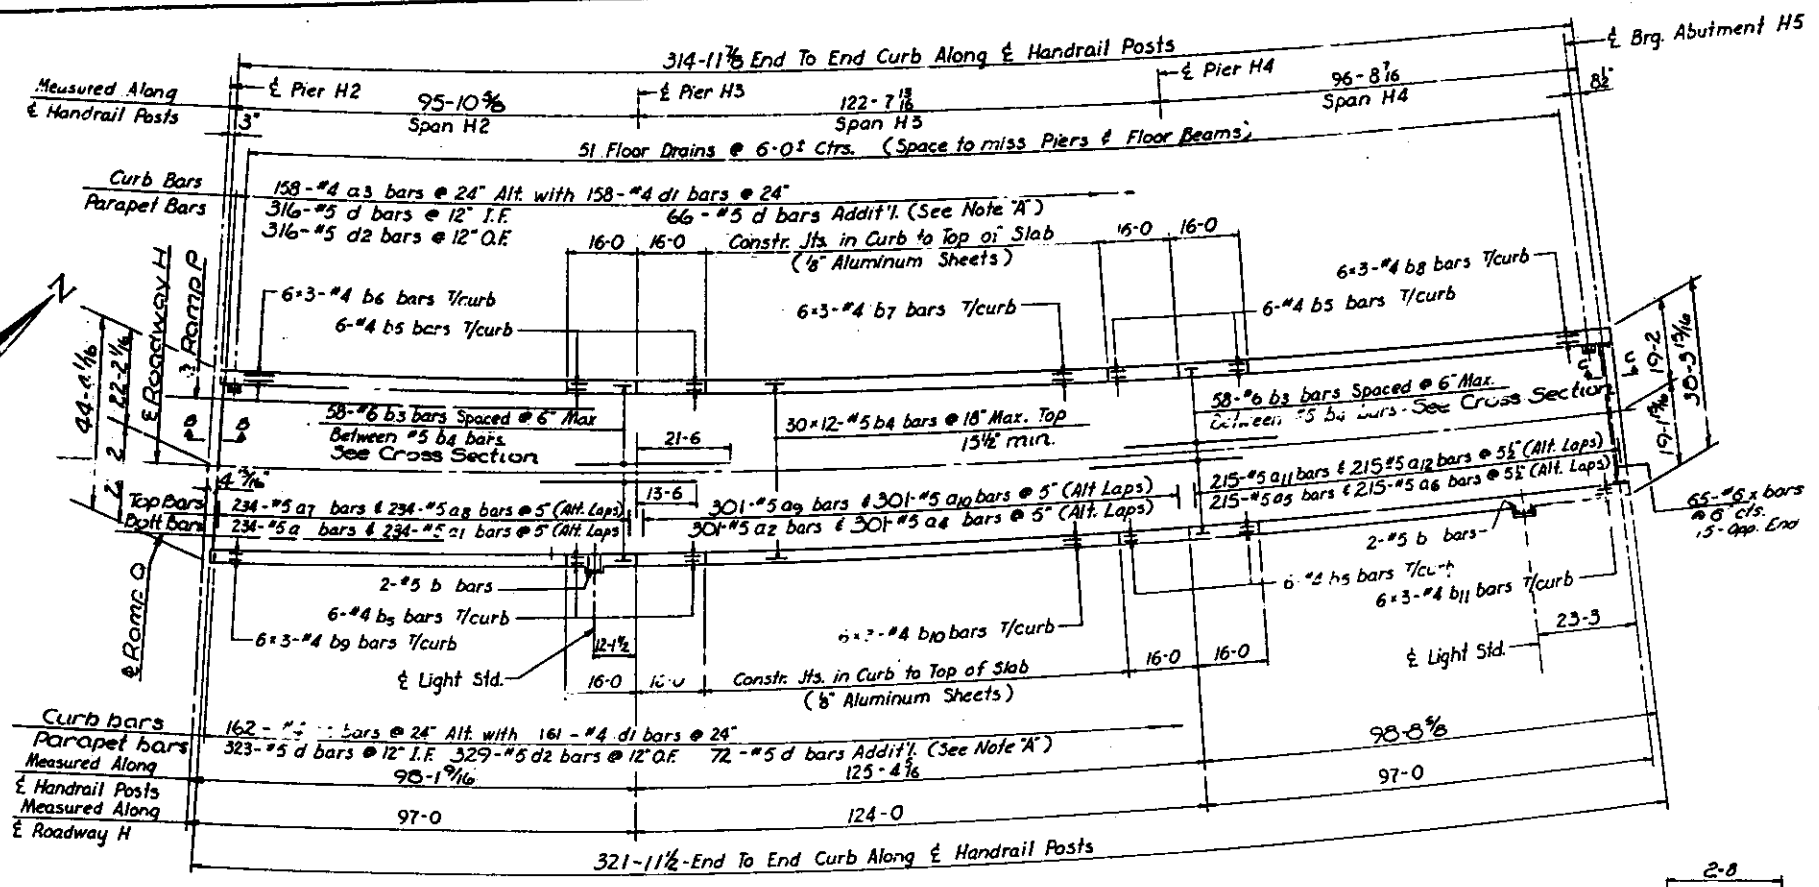

Note:
For Notes & Misc. Details See Sh. 119-35
For Section B-B CC. See Sh. 119-36/37

STATE OF ILLINOIS
DEPARTMENT OF PUBLIC WORKS & BLDGS.
DIVISION OF HIGHWAYS

SLAB
SPANS H2 THRU H4
POPLAR STREET BRIDGE APPROACHES
ROADWAY "H"


F. A. I. RT. 70 ST. CLAIR CO. SECTION 82-3HVD-1
H. W. LOCHNER, INC.
ENGINEERS
CHICAGO, ILLINOIS

SHEET
66 of 258

DESIGNED BY R.M.P.
DRAWN BY D.T.
CHECKED BY W.J.F.
APPROVED BY K.R.


Rev. Reinf. from 118,790 to 114,790. Added bars 66x. 6-3-65 N.R.F.

ROUTE NO.	SECTION	COUNTY	TOTAL SHEETS	SHEET NO.
F.A.I.-70	B2-3HVD-1	ST. CLAIR	258	180
FED. ROAD DIV. NO. 4	ILLINOIS	PROJECT		

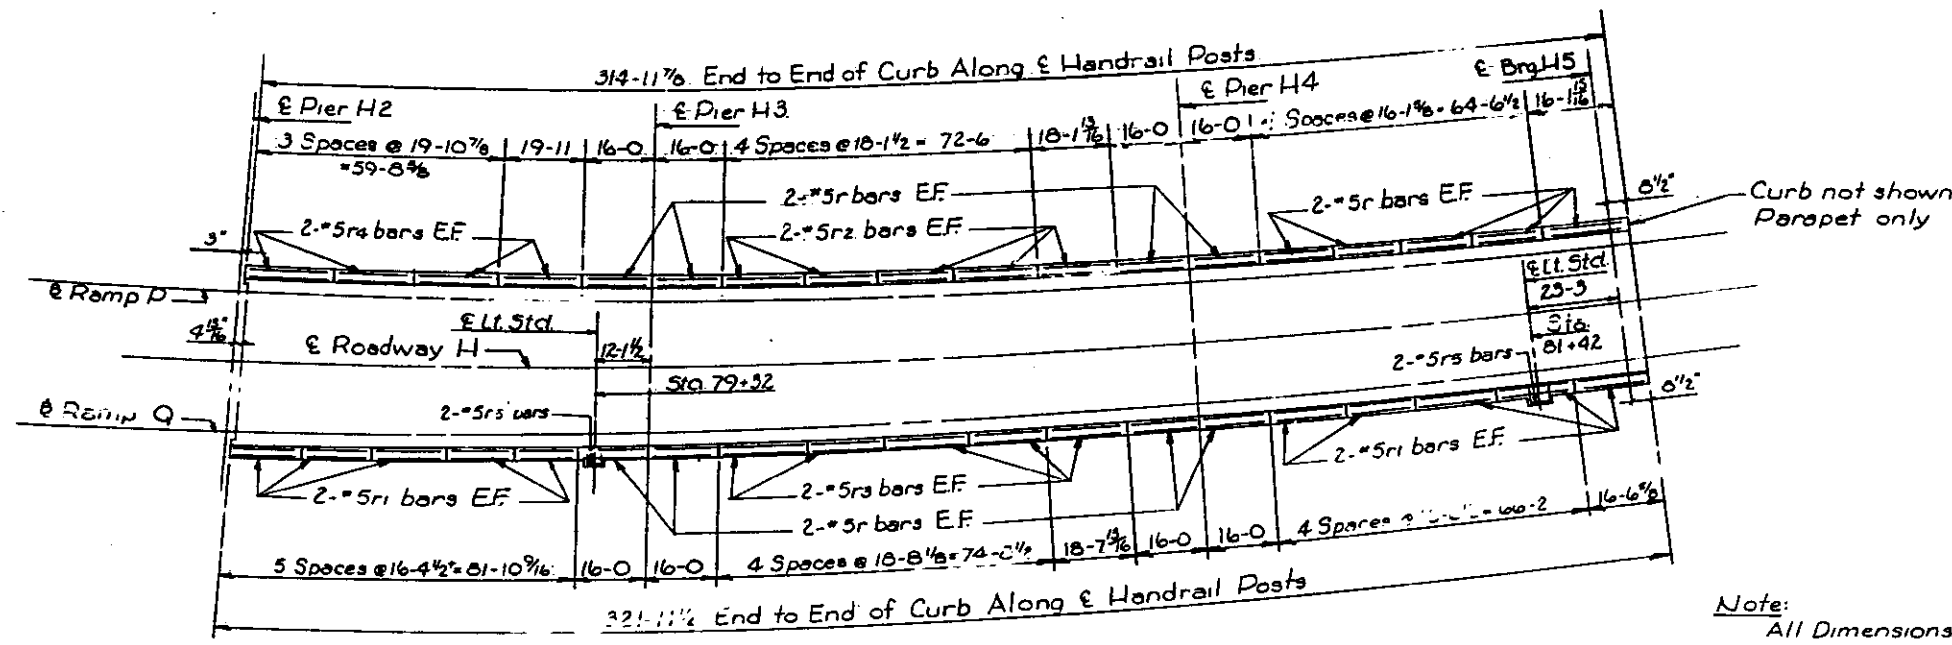

PLAN
Parapet Joint Spacing
Rdwy H
Spans H2-H4


Note:
All Dimensions in Plan
are along E of Post

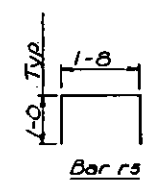

BILL OF MATERIAL

BAR	NO.	SIZE	LENGTH	SHAPE
107r	52	#5	15-0	
107r1	40	#5	15-0	
107r2	20	#5	17-8	
107r3	20	#5	18-2	
107r4	16	#5	19-5	
107r5	4	#5	3-8	
ITEM	UNIT	TOTAL		
Class X Concrete	Cu. Yds.	326		
Reinforcement Bars	Lbs.	2600		
Aluminum Handrails	Lin. Ft.	637		

See Note X Sh. N935

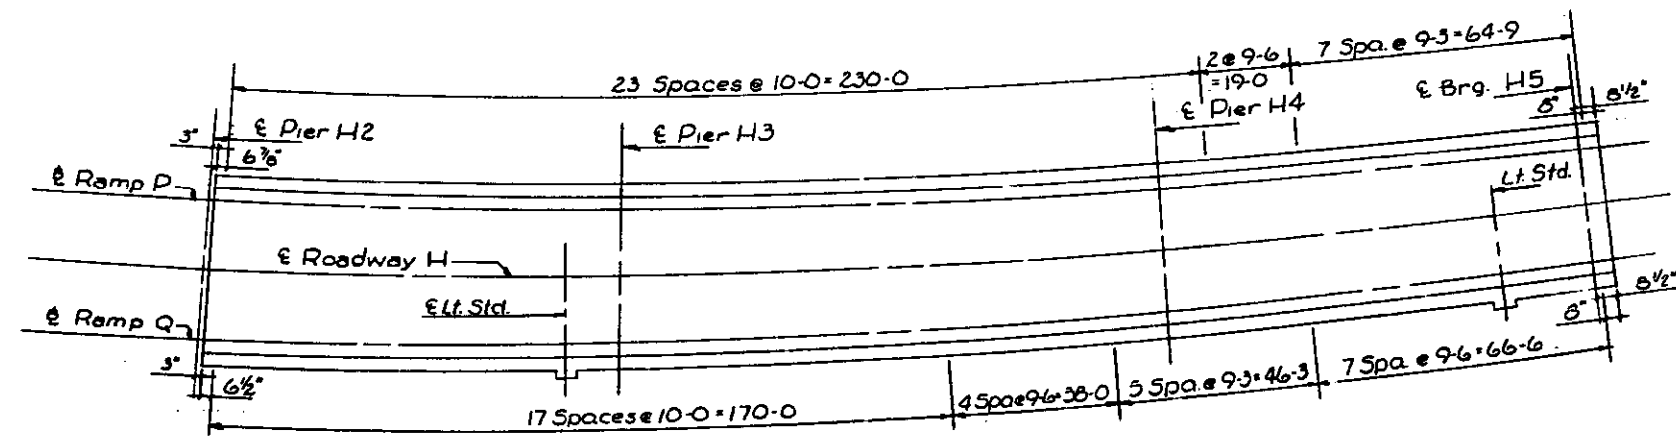

PLAN
Handrail Post Spacing
Rdwy H

Note:
For Detail of Lt. Std. see sh. N935
For Detail of Handrail &
Parapet Joint see sh. N9125

DESIGNED BY R.M.P.
DRAWN BY J.W.A.
CHECKED BY W.J.F.
APPROVED BY KA

STATE OF ILLINOIS
DEPARTMENT OF PUBLIC WORKS BLDGS.
DIVISION OF HIGHWAY
PARAPET AND HANDRAIL
SPANS H2 THRU H4
POPLAR STREET BRIDGE APPROACHES
ROADWAY "H"

F.A.I. RT. 70 ST. CLAIR CO. SECTION B2-3HVD-1
H. W. LOCHNER, INC.
ENGINEERS
CHICAGO, ILLINOIS

SHEET
N7 of 258

ROUTE NO.	SECTION	COUNTY	TOTAL SHEETS	SHEET NO.
F.A. 70	82-3HVD-1	ST. CLAIR	258	212
FED. ROAD DIV. NO. 4		ILLINOIS	PROJECT	

FL BM NO.	STATION	OFFSET	THEO. TOP OF ROAD	THEO. ADJ. FOR D.L.
1	7760.349	- 21.316	447.401	447.401
	7760.344	- 14.108	447.578	447.578
	7760.338	- 6.900	448.555	448.555
	7760.333	.309	449.132	449.132
	7760.328	7.517	449.708	449.708
	7760.323	14.401	450.259	450.259
	7760.318	21.285	450.810	450.810

FL BM NO.	STATION	OFFSET	THEO. TOP OF ROAD	THEO. ADJ. FOR D.L.
1/10'	7770.468	- 21.391	447.268	447.339
	7770.422	- 14.183	447.843	447.900
	7770.376	- 6.975	448.421	448.477
	7770.331	.234	448.998	449.055
	7770.287	7.442	449.576	449.633
	7770.241	14.195	450.116	450.173
	7770.204	20.948	450.657	450.739

FL BM NO.	STATION	OFFSET	THEO. TOP OF ROAD	THEO. ADJ. FOR D.L.
1/20'	7780.567	- 21.410	447.096	447.233
	7780.500	- 14.202	447.678	447.780
	7780.415	- 6.994	448.254	448.358
	7780.330	.213	448.832	448.936
	7780.246	7.421	449.410	449.513
	7780.169	14.043	449.941	450.044
	7780.093	20.666	450.472	450.621

FL BM NO.	STATION	OFFSET	THEO. TOP OF ROAD	THEO. ADJ. FOR D.L.
1/30'	7790.706	- 21.374	446.934	447.112
	7790.579	- 14.166	447.513	447.650
	7790.453	- 6.959	448.091	448.228
	7790.329	.248	448.670	448.808
	7790.205	7.455	449.248	449.385
	7790.095	13.945	449.770	449.885
	7789.965	20.438	450.291	450.487


FL BM NO.	STATION	OFFSET	THEO. TOP OF ROAD	THEO. ADJ. FOR D.L.
1/40'	7800.824	- 21.281	446.775	446.971
	7800.657	- 14.075	447.354	447.505
	7800.491	- 6.869	447.934	448.085
	7800.327	.338	448.513	448.664
	7800.164	7.541	449.092	449.243
	7800.021	13.903	449.603	449.782
	7799.879	20.264	450.114	450.331

FL BM NO.	STATION	OFFSET	THEO. TOP OF ROAD	THEO. ADJ. FOR D.L.
1/50'	7810.941	- 21.134	446.620	446.810
	7810.733	- 13.968	447.200	447.347
	7810.528	- 6.723	447.780	447.927
	7810.323	.483	448.360	448.507
	7810.121	7.688	448.940	449.087
	7809.947	13.914	449.441	449.676
	7809.775	20.145	449.942	450.155

FL BM NO.	STATION	OFFSET	THEO. TOP OF ROAD	THEO. ADJ. FOR D.L.
1/60'	7821.056	- 20.930	446.470	446.628
	7820.808	- 13.726	447.051	447.176
	7820.562	- 6.522	447.631	447.753
	7820.318	.682	448.211	448.334
	7820.076	7.886	448.792	448.915
	7819.873	13.981	449.282	449.396
	7819.671	20.080	449.774	449.854

FL BM NO.	STATION	OFFSET	THEO. TOP OF ROAD	THEO. ADJ. FOR D.L.
1/70'	7831.168	- 20.671	446.324	446.426
	7830.880	- 13.469	446.905	446.986
	7830.594	- 6.268	447.486	447.569
	7830.311	.937	448.067	448.151
	7830.029	6.140	448.648	448.733
	7829.798	14.102	449.129	449.215
	7829.568	20.070	449.610	449.737

FL BM NO.	STATION	OFFSET	THEO. TOP OF ROAD	THEO. ADJ. FOR D.L.
2	7845.652	- 20.203	446.123	446.123
	7845.657	- 12.991	446.700	446.700
	7845.662	- 5.778	447.277	447.277
	7845.668	1.435	447.854	447.854
	7845.673	8.648	448.431	448.431
	7845.677	14.409	448.892	448.892
	7845.681	20.170	449.353	449.353

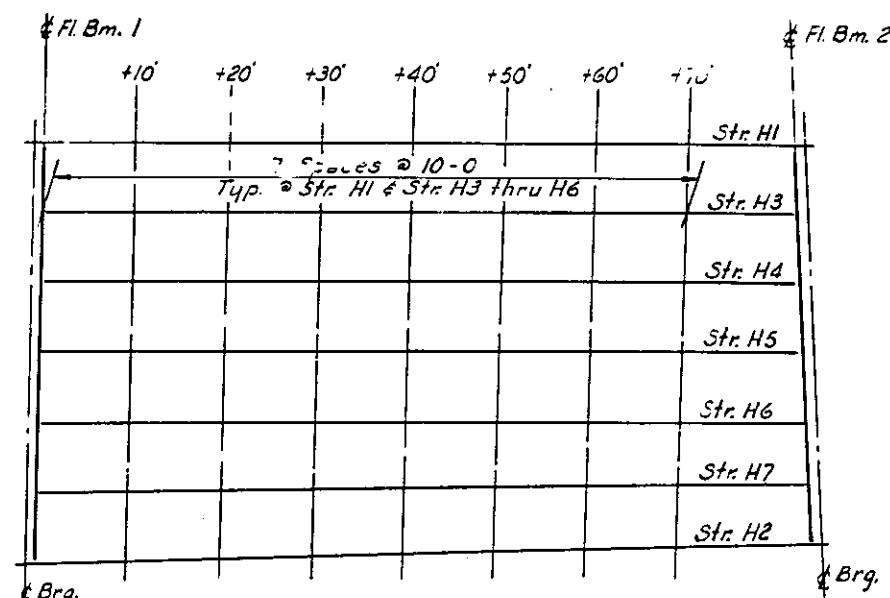

LOCATION PLAN
Span H1

Note
Stringers are identified in the Tables
by their offset.

DESIGNED BY R.M.R.
DRAWN BY A.J.C.
CHECKED BY A.S.
APPROVED BY K.A.

STATE OF ILLINOIS
DEPARTMENT OF PUBLIC WORKS & BLDGS.
DIVISION OF BRIDGES
TABLES OF ELEVATIONS
SPAN H1
POPLAR STREET BRIDGE APPROACHES
ROADWAY "H"
F.A. RT. 70 ST. CLAIR CO. SECTION 82-3HVD-1
H. W. LOCHNER, INC.
ENGINEERS
CHICAGO, ILLINOIS
SHEET
153 of 209

ROUTE NO.	SECTION	COUNTY	TOTAL SHEETS	SHEET NO.
F.A.I. 70	82-3HVD-1	ST. CLAIR	258	213
FED. ROAD DIV. NO. 4		ILLINOIS	PROJECT	



FL. BM. NO.	STATION	OFFSET	THEO. TOP OF ROAD	THEO. ADJ. FOR D.L.	FL. BM. NO.	STATION	OFFSET	THEO. TOP OF ROAD	THEO. ADJ. FOR D.L.	FL. BM. NO.	STATION	OFFSET	THEO. TOP OF ROAD	THEO. ADJ. FOR D.L.	FL. BM. NO.	STATION	OFFSET	THEO. TOP OF ROAD	THEO. ADJ. FOR D.L.	FL. BM. NO.	STATION	OFFSET	THEO. TOP OF ROAD	THEO. ADJ. FOR D.L.
3.0	7848.349	- 20.156	446.083	446.083	6.0	7902.667	- 19.516	445.240	445.273	9.0	7964.667	- 18.849	444.273	444.289	12.0	8026.667	- 18.250	443.300	443.345	15.0	8088.667	- 17.720	442.322	442.332
	7848.343	- 12.095	446.728	446.728		7902.667	- 11.824	445.855	445.889		7964.667	- 11.365	444.87	444.889		8026.667	- 11.025	443.878	443.923		8088.667	- 10.688	442.885	442.895
	7848.337	- 4.033	447.373	447.373		7902.667	- 4.018	446.480	446.513		7964.667	- 3.827	445.475	445.491		8026.667	- 3.726	444.462	444.507		8088.667	- 3.601	443.452	443.462
	7848.331	4.028	448.018	448.018		7902.667	3.788	447.104	447.138		7964.667	3.712	446.078	446.094		8026.667	3.574	445.046	445.091		8088.667	3.487	444.019	444.029
	7848.325	12.089	448.663	448.663		7902.667	11.594	447.725	447.762		7964.667	11.251	446.681	446.697		8026.667	10.873	445.630	445.675		8088.667	10.575	444.586	444.596
	7848.320	20.151	449.308	449.308		7902.667	19.510	448.362	448.395		7964.667	18.843	447.288	447.305		8026.667	18.244	446.220	446.264		8088.667	17.775	445.157	445.167
3.5	7854.833	- 20.077	445.982	445.993	6.5	7913.000	- 19.400	445.079	445.102	9.5	7975.000	- 18.744	444.111	444.142	12.5	8037.000	- 18.157	443.137	443.169	15.5	8099.000	- 17.639	442.158	442.179
	7854.833	- 12.088	446.621	446.632		7913.000	- 11.700	445.695	445.718		7975.000	- 11.307	444.706	444.737		8037.000	- 10.940	443.715	443.747		8099.000	- 10.643	442.718	442.739
	7854.833	- 4.058	447.264	447.275		7913.000	- 3.941	446.316	446.339		7975.000	- 3.810	445.306	445.336		8037.000	- 3.678	444.296	444.327		8099.000	- 3.508	443.282	443.303
	7854.833	3.971	447.906	447.917		7913.000	3.818	446.937	446.960		7975.000	3.687	445.906	445.936		8037.000	3.564	444.877	444.908		8099.000	3.467	443.847	443.868
	7854.833	12.001	448.549	448.560		7913.000	11.578	447.557	447.570		7975.000	11.184	446.505	446.536		8037.000	10.846	445.458	445.489		8099.000	10.522	444.411	444.432
	7854.833	20.071	449.194	449.205		7913.000	19.394	448.183	448.206		7975.000	18.738	447.110	447.140		8037.000	18.152	446.042	446.074		8099.000	17.635	444.980	445.001
4.0	7861.333	- 19.998	445.882	445.902	7.0	7923.333	- 19.286	444.918	444.930	10.0	7985.333	- 18.641	443.949	443.993	13.0	8047.333	- 18.066	442.975	442.992	16.0	8109.333	- 17.589	441.995	442.025
	7861.333	- 12.059	446.517	446.538		7923.333	- 11.628	445.531	445.542		7985.333	- 11.300	444.533	444.580		8047.333	- 10.896	443.548	443.566		8109.333	- 10.650	442.547	442.578
	7861.333	- 4.060	447.157	447.177		7923.333	- 3.914	446.148	446.160		7985.333	- 3.843	445.133	445.177		8047.333	- 3.670	444.125	444.144		8109.333	- 3.626	443.109	443.140
	7861.333	3.938	447.797	447.817		7923.333	3.799	446.785	446.777		7985.333	3.613	445.730	445.773		8047.333	3.556	444.704	444.722		8109.333	3.398	443.671	443.702
	7861.333	11.937	448.436	448.457		7923.333	11.513	447.382	447.394		7985.333	11.069	446.326	446.370		8047.333	10.782	445.282	445.300		8109.333	10.422	444.233	444.264
	7861.333	19.992	449.081	449.102		7923.333	19.280	448.003	448.015		7985.333	18.636	446.931	446.975		8047.333	18.061	445.865	445.882		8109.333	17.555	444.804	444.835
4.5	7871.667	- 19.875	445.721	445.755	7.5	7933.667	- 19.174	444.757	444.760	10.5	7995.667	- 18.541	443.787	443.840	13.5	8057.667	- 17.976	442.812	442.818	16.5	8119.667	- 17.482	441.831	441.867
	7871.667	- 11.965	446.354	446.388		7933.667	- 11.650	445.359	445.362		7995.667	- 11.234	444.372	444.425		8057.667	- 10.931	443.375	443.381		8119.667	- 10.593	442.381	442.418
	7871.667	- 4.016	446.990	447.024		7933.667	- 3.980	445.972	445.976		7995.667	- 3.818	444.965	445.018		8057.667	- 3.740	443.951	443.957		8119.667	- 3.606	442.941	442.977
	7871.667	3.933	447.626	447.660		7933.667	3.689	446.586	446.589		7995.667	3.598	445.558	445.612		8057.667	3.450	444.526	444.532		8119.667	3.387	443.500	443.537
	7871.667	11.882	448.262	448.295		7933.667	11.359	447.200	447.203		7995.667	11.014	446.151	446.205		8057.667	10.641	445.101	445.107		8119.667	10.380	444.060	444.096
	7871.667	19.869	448.901	448.934		7933.667	19.168	447.824	447.827		7995.667	18.535	446.753	446.807		8057.667	17.971	445.688	445.694		8119.667	17.478	444.628	444.664
5.0	7882.000	- 19.753	445.561	445.601	8.0	7944.000	- 19.063	444.596	444.596	11.0	8006.000	- 18.442	443.625	443.682	14.0	8068.000	- 17.889	442.649	442.649	17.0	8130.000	- 17.406	441.667	441.704
	7882.000	- 11.898	446.190	446.229		7944.000	- 11.613	445.192	445.192		8006.000	- 11.111	444.211	444.268		8068.000	- 10.909	443.207	443.207		8130.000	- 10.489	442.220	442.257
	7882.000	- 3.997	446.822	446.861		7944.000	- 3.988	445.802	445.802		8006.000	- 3.735	444.802	444.858		8068.000	- 3.752	443.780	443.780		8130.000	- 3.527	442.777	442.814
	7882.000	3.903	447.454	447.493		7944.000	3.638	446.412	446.412		8006.000	3.641	445.392	445.448		8068.000	3.404	444.352	444.352		8130.000	3.435	443.334	443.371
	7882.000	11.804	448.086	448.125		7944.000	11.264	447.022	447.022		8006.000	11.017	445.982	446.038		8068.000	10.560	444.925	444.925		8130.000	10.397	443.891	443.928
	7882.000	19.747	448.721	448.761		7944.000	19.057	447.645	447.645		8006.000	18.436	446.575	446.632		8068.000	17.884	445.511	445.511		8130.000	17.402	444.451	444.489
5.5	7892.333	- 19.634	445.401	445.440	8.5	7954.333	- 18.955	444.434	444.440	11.5	8016.333	- 18.345	443.463	443.516	14.5	8078.333	- 17.804	442.485	442.488	17.5	8140.333	- 17.333	441.503	441.535
	7892.333	- 11.890	446.020	446.059		7954.333	- 11.519	445.029	445.035		8016.333	- 11.053	444.046	444.100		8078.333	- 10.828	443.043	443.046		8140.333	- 10.441	442.054	442.086
	7892.333	- 4.037	446.648	446.688		7954.333	- 3.900	445.636	445.641		8016.333	- 3.715	444.633	444.687		8078.333	- 3.706	443.613	443.616		8140.333	- 3.508	442.609	442.640
	7892.333	3.816	447.277	447.318		7954.333	3.646	446.242	446.248		8016.333	3.622	445.220	445.274		8078.333	3.416	444.183	444.185		8140.333	3.425	443.183	443.195
	7892.333	11.669	447.905	447.944		7954.333	11.228	446.849	446.854		8016.333	10.959	445.807	445.861		8078.333	10.538	444.753	444.755		8140.333	10.307	443.718	443.750
	7892.333	19.628	448.541	448.581		7954.333	18.949	447.467	447.472		8016.333	18.339	446.397	446.451		8078.333	17.799	445.334	445.336		8140.333	17.329	444.275	444.307

Note: For Notes see Sheet No. 126

DESIGNED BY R.M.R.
 DRAWN BY A.N.C.
 CHECKED BY A.S.
 APPROVED BY K.A.



STATE OF ILLINOIS
 DEPARTMENT OF PUBLIC WORKS & BLDGS.
 DIVISION OF HIGHWAYS
 TABLES OF ELEVATION
 SPANS H2 THRU H4
 POPLAR STREET BRIDGE APPROACHES
 ROADWAY "H"
 F.A.I. RT. 70 ST. CLAIR CO. SECTION 82-3HVD-1
 H. W. LOCHNER, INC.
 ENGINEERS
 CHICAGO, ILLINOIS
 SHEET
 160 OF 526

ROUTE NO.	SECTION	COUNTY	TOTAL SHEETS	SHEET NO.
F.A.I.—70	82-3HV8-1	ST. CLAIR	238	241
FED. ROAD DIV. NO. 4	ILLINOIS PROJECT	82-3HV8-1	238	241

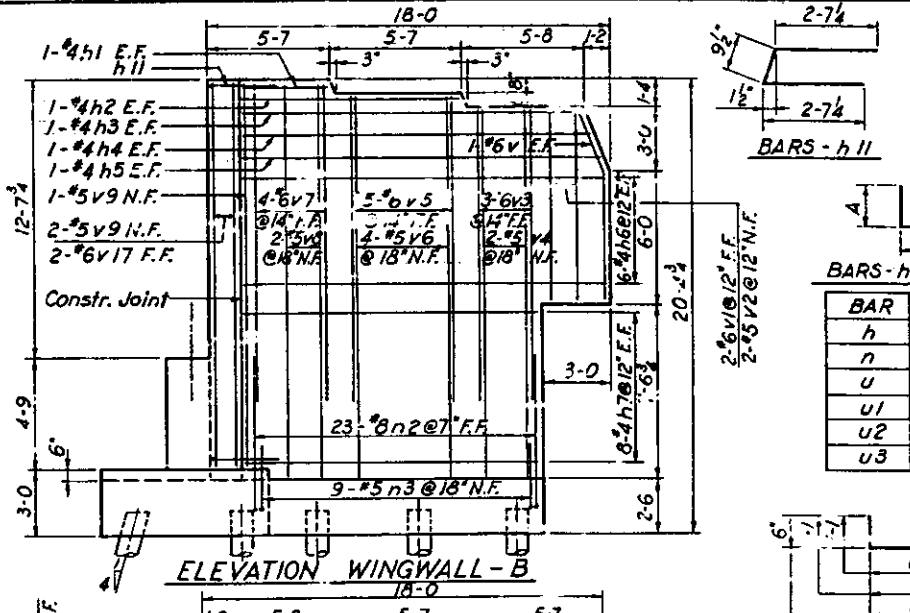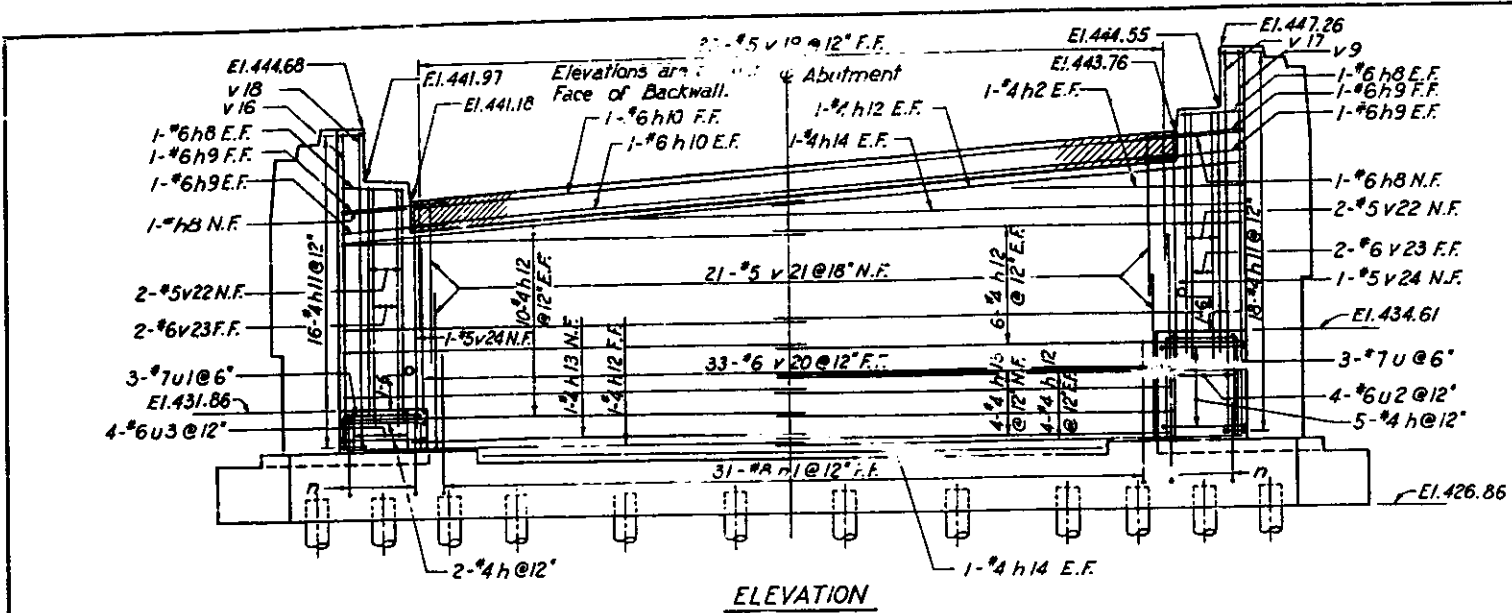

BILL OF MATERIAL



BAR NO.	SIZE	LENGTH	SHAPE
h	7	9-8	
h1	4	4-0	
h2	6	9-7	
h3	4	15-3	
h4	4	15-7	
h5	4	15-11	
h6	24	16-4	
h7	26	13-4	
h8	6	2-10	
h9	6	4-5	
h10	3	32-2	
h11	2	6-0	
h12	3	19-7	
h13	5	16-2	
h14	4	25-7	
n	8	10-8	
n1	3	7-5	
n2	4	8-2	
n3	18	3-7	
u	3	12-7	
u1	3	7-1	
u2	4	12-1	
u3	4	6-7	
v	4	9-0	
v1	4	8-10	
v2	4	8-10	
v3	3	13-3	
v4	2	16-6	
v5	5	14-1	
v6	4	17-2	
v7	4	14-9	
v8	2	17-10	
v9	3	17-4	
v10	3	10-10	
v11	2	13-11	
v12	5	11-6	
v13	4	14-7	
v14	4	12-2	
v15	2	15-3	
v16	3	14-9	
v17	2	17-4	
v18	2	14-9	
v19	3	6-0	
v20	33	7-9	
v21	42	7-4	
v22	4	11-2	
v23	4	11-4	
v24	2	10-4	
w	138	7-2	
w1	69	7-2	
w2	12	13-3	
w3	8	8-6	
w4	12	9-6	
w5	4	22-3	
w6	4	28-10	
ITEM			TOTAL
Class "X" Concrete			Cu. Yds. 24.9
Reinforcement Bars			Lbs. 6,130
Concrete Piles			Lin. Ft. 1,550
Test Piles (Concrete)			Each 1

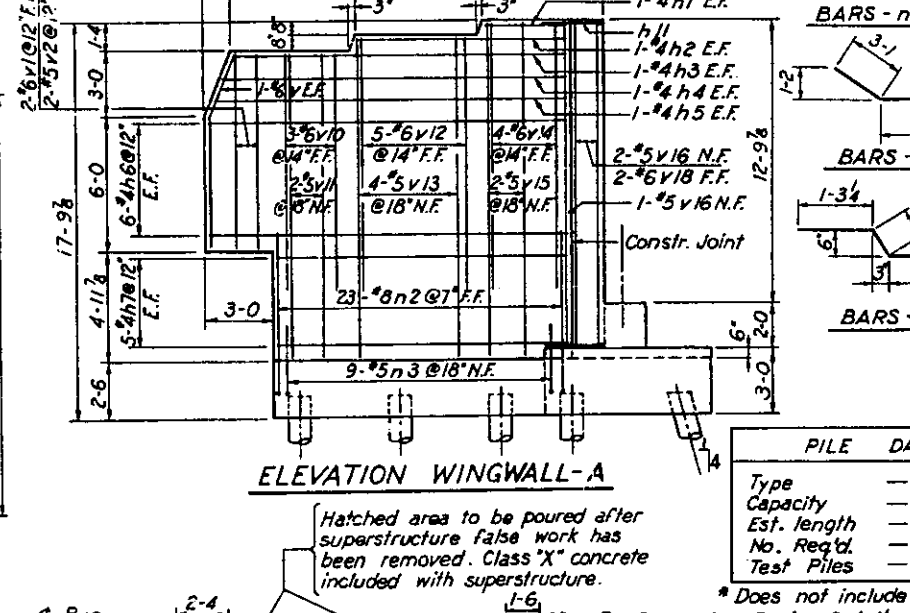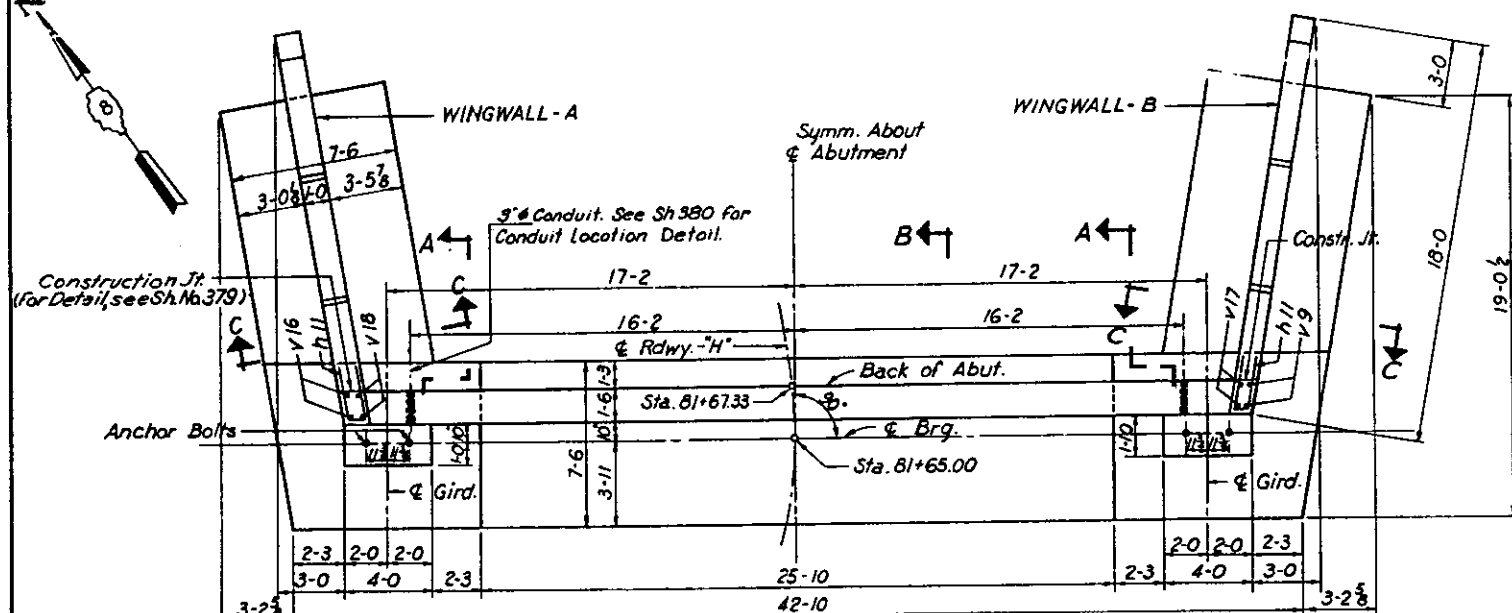

PILE DATA

Type	Concrete
Capacity	28 T.
Est. length	50 Ft.
No. Req'd.	33 *
Test Piles	1

* Does not include test pile.
 † For Expansion Device Details, see Sh. No. 362
 ‡ (Not Applicable to 82-3HV8-1)

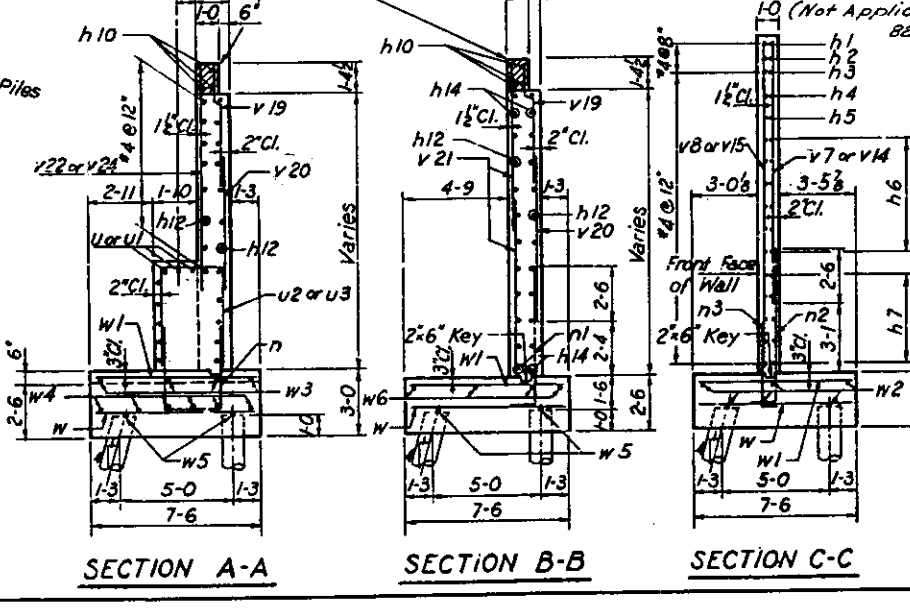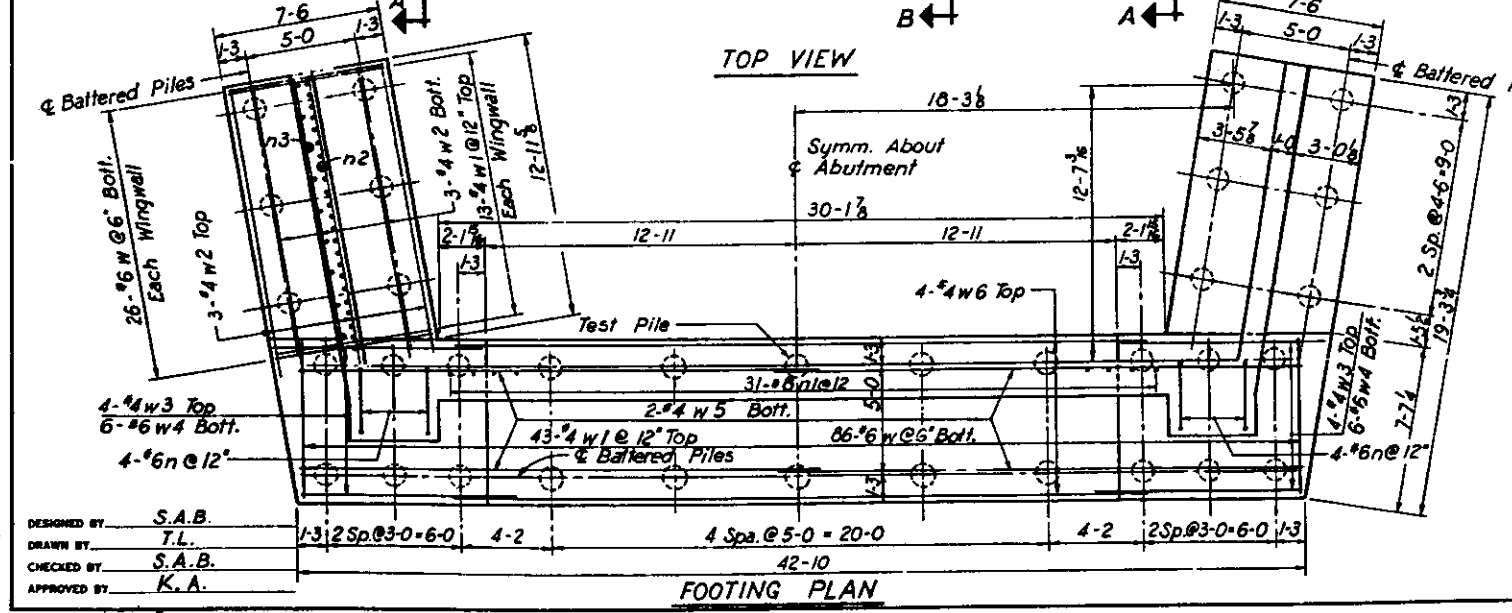

STATE OF ILLINOIS
 DEPARTMENT OF PUBLIC WORKS
 DIVISION OF HIGHWAYS

ABUTMENT H5
 POPLAR STREET BRIDGE APPROACHES
 ROADWAY "H"









F.A.I. RT. 70 ST. CLAIR CO. SECTION 82-3HV8-1

H. W. LOCHNER, INC.
 ENGINEERS
 CHICAGO, ILLINOIS

SHEET 378 of 526

DESIGNED BY S.A.B.
 DRAWN BY T.L.
 CHECKED BY S.A.B.
 APPROVED BY K.A.


ROUTE NO.	SECTION	COUNTY	TOTAL SHEETS	SHEET NO.
F.A.I-70	82-3HVB-1	ST. CLAIR	207	104
FED. ROAD DIV. NO. 4		ILLINOIS PROJECT		

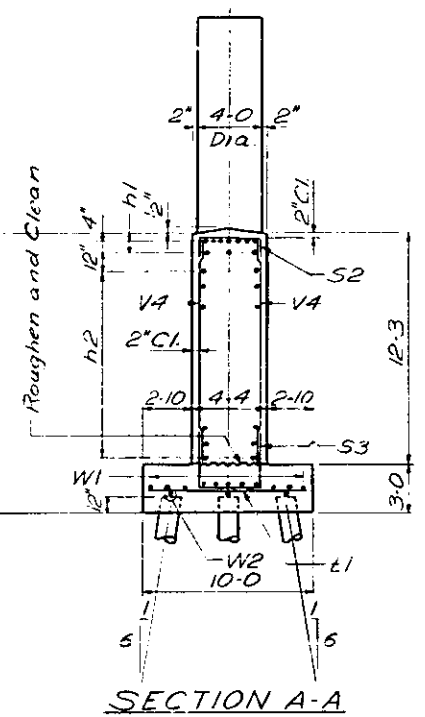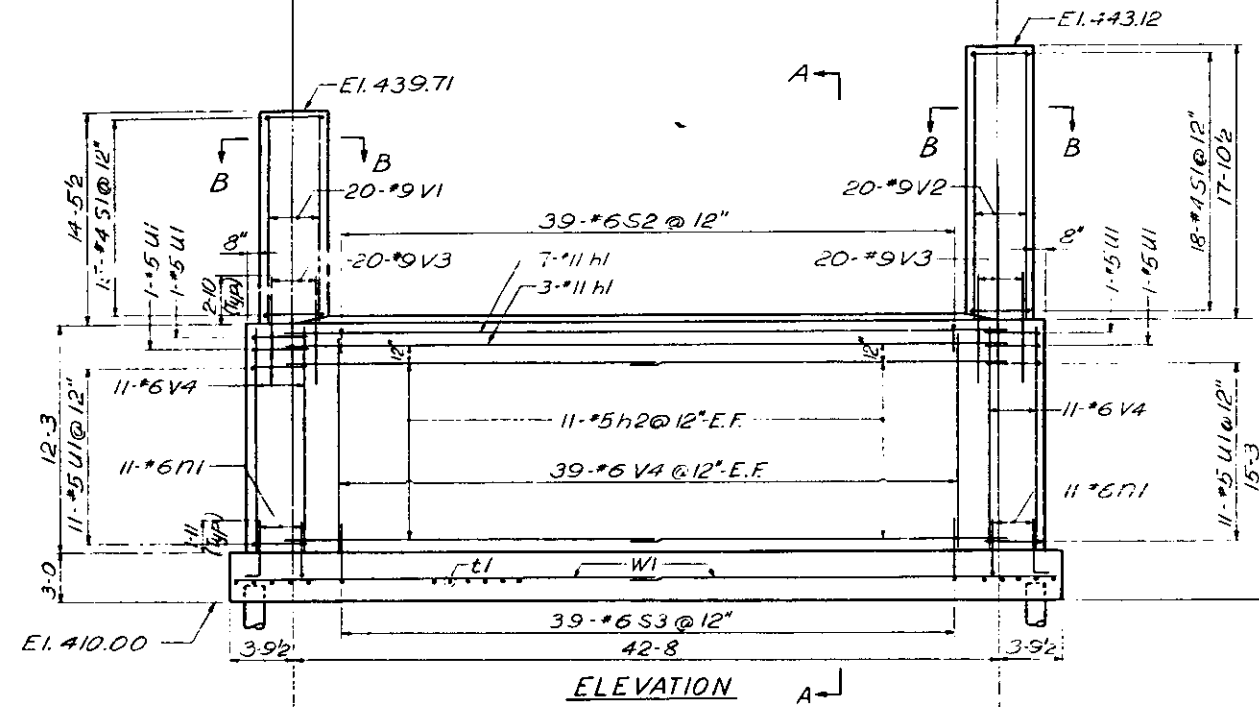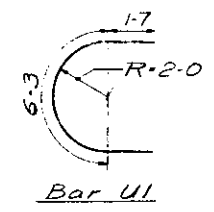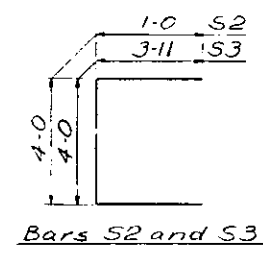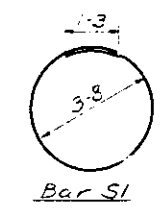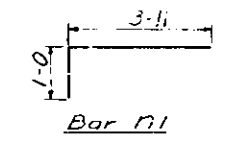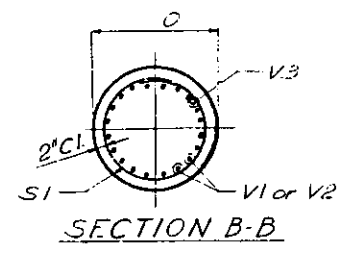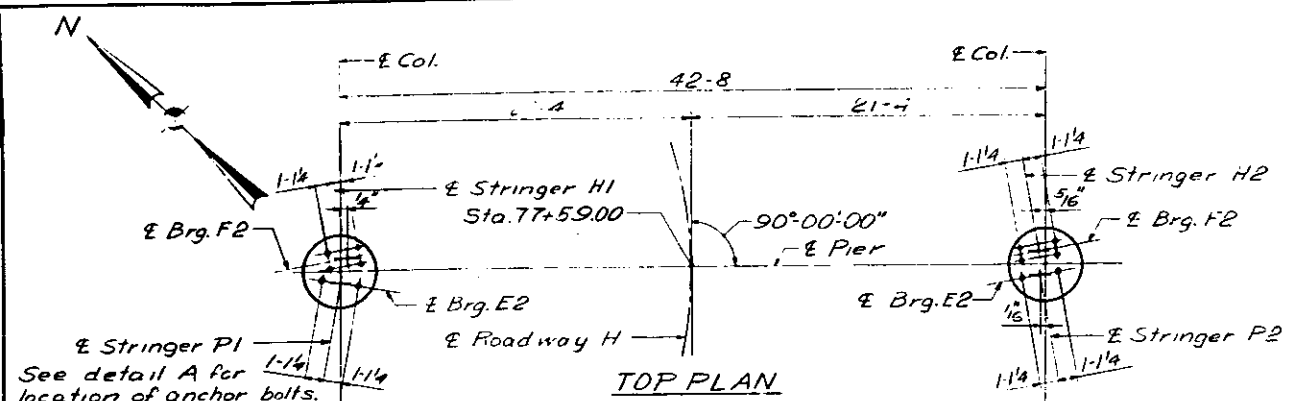

Mark	No.	Repd.	Length	Shape
426 h1	10	#11	43-8	—
426 h2	44	#5	22-8	—
426 M1	22	#6	4-11	□
426 S1	33	#4	12-9	○
426 S2	39	#6	6-0	□
426 S3	39	#6	11-10	□
426 t1	51	#7	9-8	—
426 U1	26	#5	9-5	□
426 V1	20	#9	14-3	—
426 V2	20	#9	17-8	—
426 V3	40	#9	6-8	—
426 V4	100	#6	12-1	—
426 W1	22	#6	25-11	—
426 W2	6	#4	25-7	—

*See Note "X" Sh. No. 35

Item	Unit	Total
Class "X" Concrete	C.Y.	162.6
Reinforcement Bars	Lbs.	11,960
Concrete Piles	L.F.	1421 *
Test Piles (Concrete)	Ea.	1

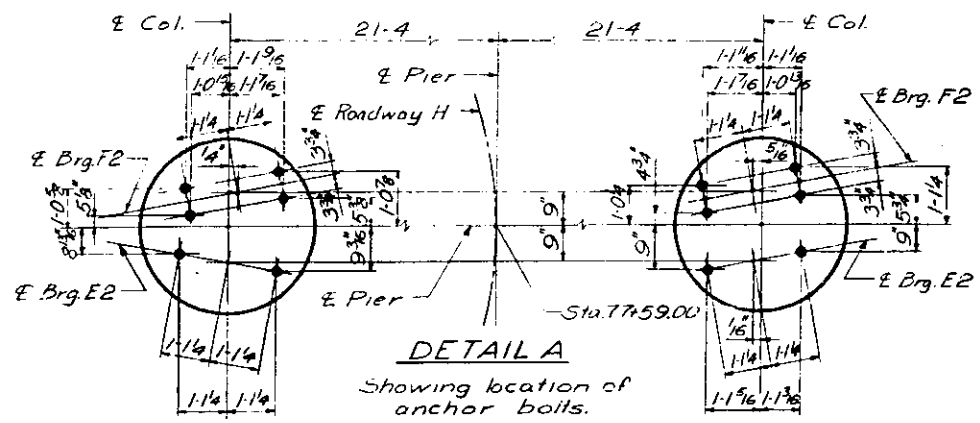

PILE DATA:
 Type: Concrete.
 Req'd Capacity: 337
 Est. Length: 49-0
 No. Req'd: 29*
 Test Piles: 1

* Does not include test pile.

DESIGNED BY: E.W.
 DRAWN BY: S.A.
 CHECKED BY: S.K.
 APPROVED BY: K.A.

○ Indicates battered pile. ⊙ Indicates test pile.

STATE OF ILLINOIS
 DEPARTMENT OF PUBLIC WORKS &
 DIVISION OF HIGHWAYS

PIER HI
 POPLAR STREET BRIDGE APPROACHES
 ROADWAY "H"

F.A.I. R1.70 ST. CLAIR CO SECTION 82-3HVB-1
 H. W. LOCHNER, INC.
 ENGINEERS
 CHICAGO, ILLINOIS

SHEET
 426 of 526

STATE OF ILLINOIS
DEPARTMENT OF PUBLIC WORKS AND BUILDINGS
DIVISION OF HIGHWAYS

ROUTE NO.	SECTION	COUNTY	TOTAL SHEETS	SHEET NO.
F. A. I. - 70	82-3HVD-1	ST. CLAIR	258	1
FED. ROAD DIV. NO. 4		ILLINOIS	PROJECT 2-28-70-1(82)0	

P-98-087-00

DESCRIPTION OF PROJECT
SECTION 82-3HVD-1 INCLUDES THE COMPLETE CONSTRUCTION OF THE REINFORCED CONCRETE DECK SLAB FOR THE FOLLOWING:



ROADWAY A	TWO 4-SPAN CONTINUOUS UNITS SPANS: 1 EACH @ 83'-5 5/8", 106'-106"-83" 87'-110'-110'-87'
	FIVE 3-SPAN CONTINUOUS UNITS SPANS: 2 @ 97'-124'-97' 1 EACH @ 75'-96'-75' 95'-122'-95' 89'-114'-89'
	ONE SIMPLE SPAN - 88'
ROADWAY D	TWO 4-SPAN CONTINUOUS UNIT SPANS: 1 @ 98'-7 9/16", 115'-115'-90" 1 @ 100'-128'-128'-100'
	ONE 5-SPAN CONTINUOUS UNIT SPANS: 107'-137'-137'-137'-107'
	FIVE 3-SPAN CONTINUOUS UNITS SPANS: 2 @ 85'-108'-85' 2 @ 81'-105'-81' 1 @ 90'-115'-90'
	ONE 2-SPAN CONTINUOUS UNIT SPANS: 89'-4", 89'-4"
	TWO SIMPLE SPANS SPANS: 1 @ 74' 1 @ 78'
ROADWAY G	TWO 4-SPAN CONTINUOUS UNITS SPANS: 1 @ 88'-113'-113'-88" 1 @ 87'-110'-110'-87'
	ONE 3-SPAN CONTINUOUS UNIT SPANS: 90'-116'-90'
	ONE 2-SPAN CONTINUOUS UNIT SPANS: 76'-76'
ROADWAY H	ONE 3-SPAN CONTINUOUS UNIT SPANS: 97'-124'-97'
	ONE SIMPLE SPAN - 88'
RAMP M	THREE 3-SPAN CONTINUOUS UNITS SPANS: 1 @ 90'-115'-90" 1 @ 109'-134'-109" 1 @ 90'-115'-85-10 11/16
RAMP N	ONE 4-SPAN CONTINUOUS UNIT SPANS: 90'-115'-115'-90'
	ONE SIMPLE SPAN - 73-3 5/16
RAMP O	FOUR 3-SPAN CONTINUOUS UNIT SPANS: 1 @ 97'-8 3/4", 130'-101' 1 @ 90'-115'-90" 1 @ 95'-121'-95' 1 @ 94'-120'-94'
	ONE SIMPLE SPAN - 65'
	ONE 4-SPAN CONTINUOUS UNIT SPANS: 94'-121'-121'-94'
RAMP P	TWO 3-SPAN CONTINUOUS UNIT SPANS: 1 @ 81'-115'-81' 1 @ 96'-122'-96'
	TWO SIMPLE SPANS 1 @ 88' 1 @ 69'

PLANS FOR PROPOSED
FEDERAL AID HIGHWAY
F. A. I. ROUTE 70 SECTION 82-3HVD-1
PROJECT I-IG-70-1(82)0
POPLAR STREET BRIDGE APPROACHES
ST. CLAIR COUNTY
C-98-033-65

RAMP Q	ONE 3-SPAN CONTINUOUS UNIT SPANS: 75-2 7/8", 98'-76'
RAMP R	TWO 3-SPAN CONTINUOUS UNITS SPANS: 1 @ 104'-4 5/16", 134'-104" 1 @ 101'-130'-101'
RAMP S	ONE 4-SPAN CONTINUOUS UNIT SPANS: 85'-108'-108'-85'
	THREE 3-SPAN CONTINUOUS UNIT SPANS: 1 @ 73'-2 7/8", 95'-74" 1 @ 69'-97'-69" 1 @ 88'-113'-88'

THE POPLAR STREET BRIDGE APPROACHES FOR THIS SECTION CARRY THE FOLLOWING:
ROADWAY A OVER THE TRACKS OF THE TERMINAL R. R. ASSOCIATION, GULF, MOBILE AND OHIO, AND ILLINOIS CENTRAL RAILROADS AND RAMP Q;
ROADWAY D OVER THE TRACKS OF THE TERMINAL R. R. ASSOCIATION, GULF, MOBILE AND OHIO, ILLINOIS CENTRAL AND SOUTHERN RAILROADS, RAMP O AND ILLINOIS ROUTE 3;
ROADWAY G OVER TRENDLEY AND FIOGOTT AVENUES;
ROADWAY H OVER THE ILLINOIS CENTRAL RAILROAD;
RAMP M OVER ROADWAY A AND THE TRACKS OF THE TERMINAL R. R. ASSOCIATION AND THE GULF, MOBILE AND OHIO RAILROADS;
RAMP N OVER THE TRACKS OF THE TERMINAL R. R. ASSOCIATION AND GULF, MOBILE AND OHIO RAILROADS;
RAMP O OVER THE ILLINOIS CENTRAL RAILROAD;
RAMP P OVER ROADWAY D, FUTURE ACCESS ROADS AND THE ILLINOIS CENTRAL RAILROAD;
RAMP Q OVER THE ILLINOIS CENTRAL RAILROAD;
RAMP R OVER THE ILLINOIS CENTRAL RAILROAD AND A FUTURE ACCESS ROAD;
RAMP S OVER TRENDLEY AVENUE AND ROADWAY H.

THIS SECTION ALSO INCLUDES THE INSTALLING AND TESTING OF COMPLETE HIGHWAY LIGHTING SYSTEMS, THE FURNISHING AND ERRECTING OF HIGHWAY SIGNS, THE FINISH GRADING, THE PAVING, FIELD PAINTING ALL STRUCTURAL STEEL, AND ALL APPURTENANT AND COLLATERAL WORK NECESSARY TO COMPLETE THE PROJECT AS SHOWN ON THE PLANS.

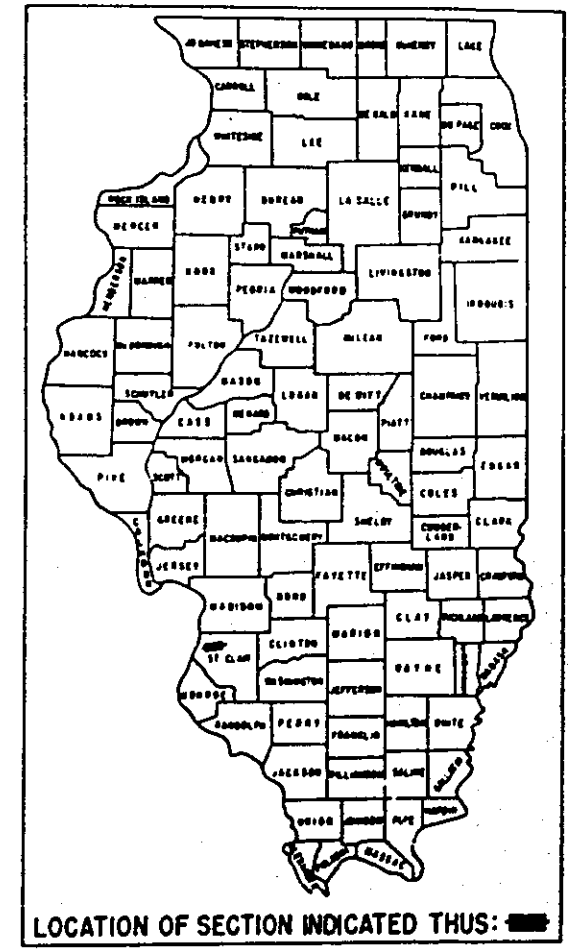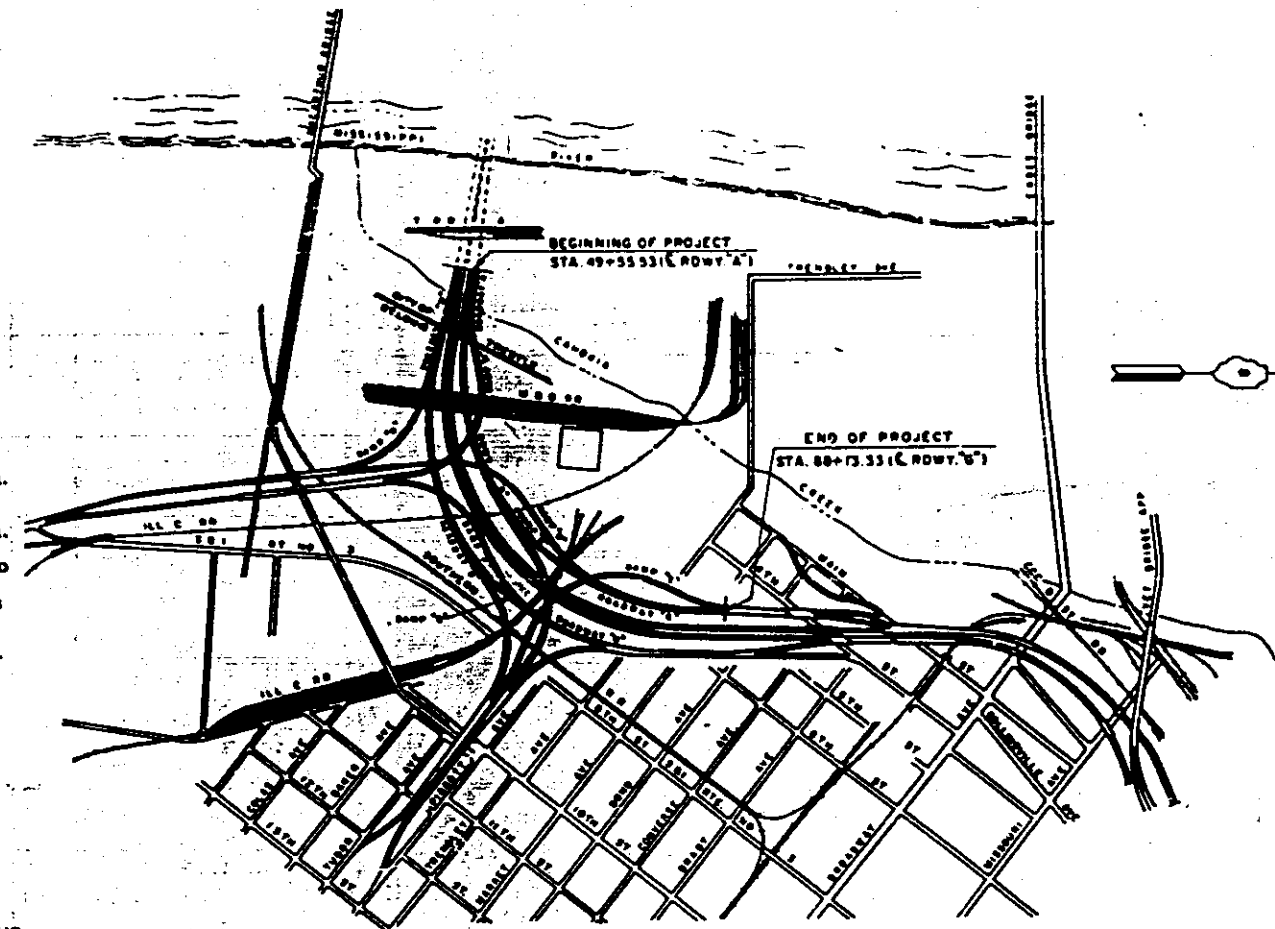

LOCATION OF SECTION INDICATED THUS: [shaded box]

NOTE:
FOR INDEX OF SHEETS AND SUMMARY OF QUANTITIES SEE SHEET NO. 2

APPROVED
FOR STRUCTURAL ACCOUNT ONLY

[Signature]
STATE OF ILLINOIS
DEPARTMENT OF PUBLIC WORKS AND BUILDINGS
DIVISION OF HIGHWAYS

11-30-65
Robert E. Krout

5-9-67
William Handberg

5-9-67
W. E. Baumann

5-9-67
Anna S. [Signature]

8-67

DEPARTMENT OF COMMERCE
BUREAU OF PUBLIC ROADS

APPROVED

DIVISION ENGINEER DATE

H. W. LOCHNER, INC.
ENGINEERS
CHICAGO, ILLINOIS

LENGTH OF PROJECT
4261.16 FT. = .807 MILES


LOCATION PLAN




CONTRACT NO. 25092

082-0256

FEDERAL-AID ROUTE NO.	SECTION	COUNTY	TOTAL SHEETS	SHEET NO.
F.A.I. 70	B2-SHVD-1	ST. CLAIR	258	4
FED. ROAD DIV. No. 4 ILLINOIS PROJECT				

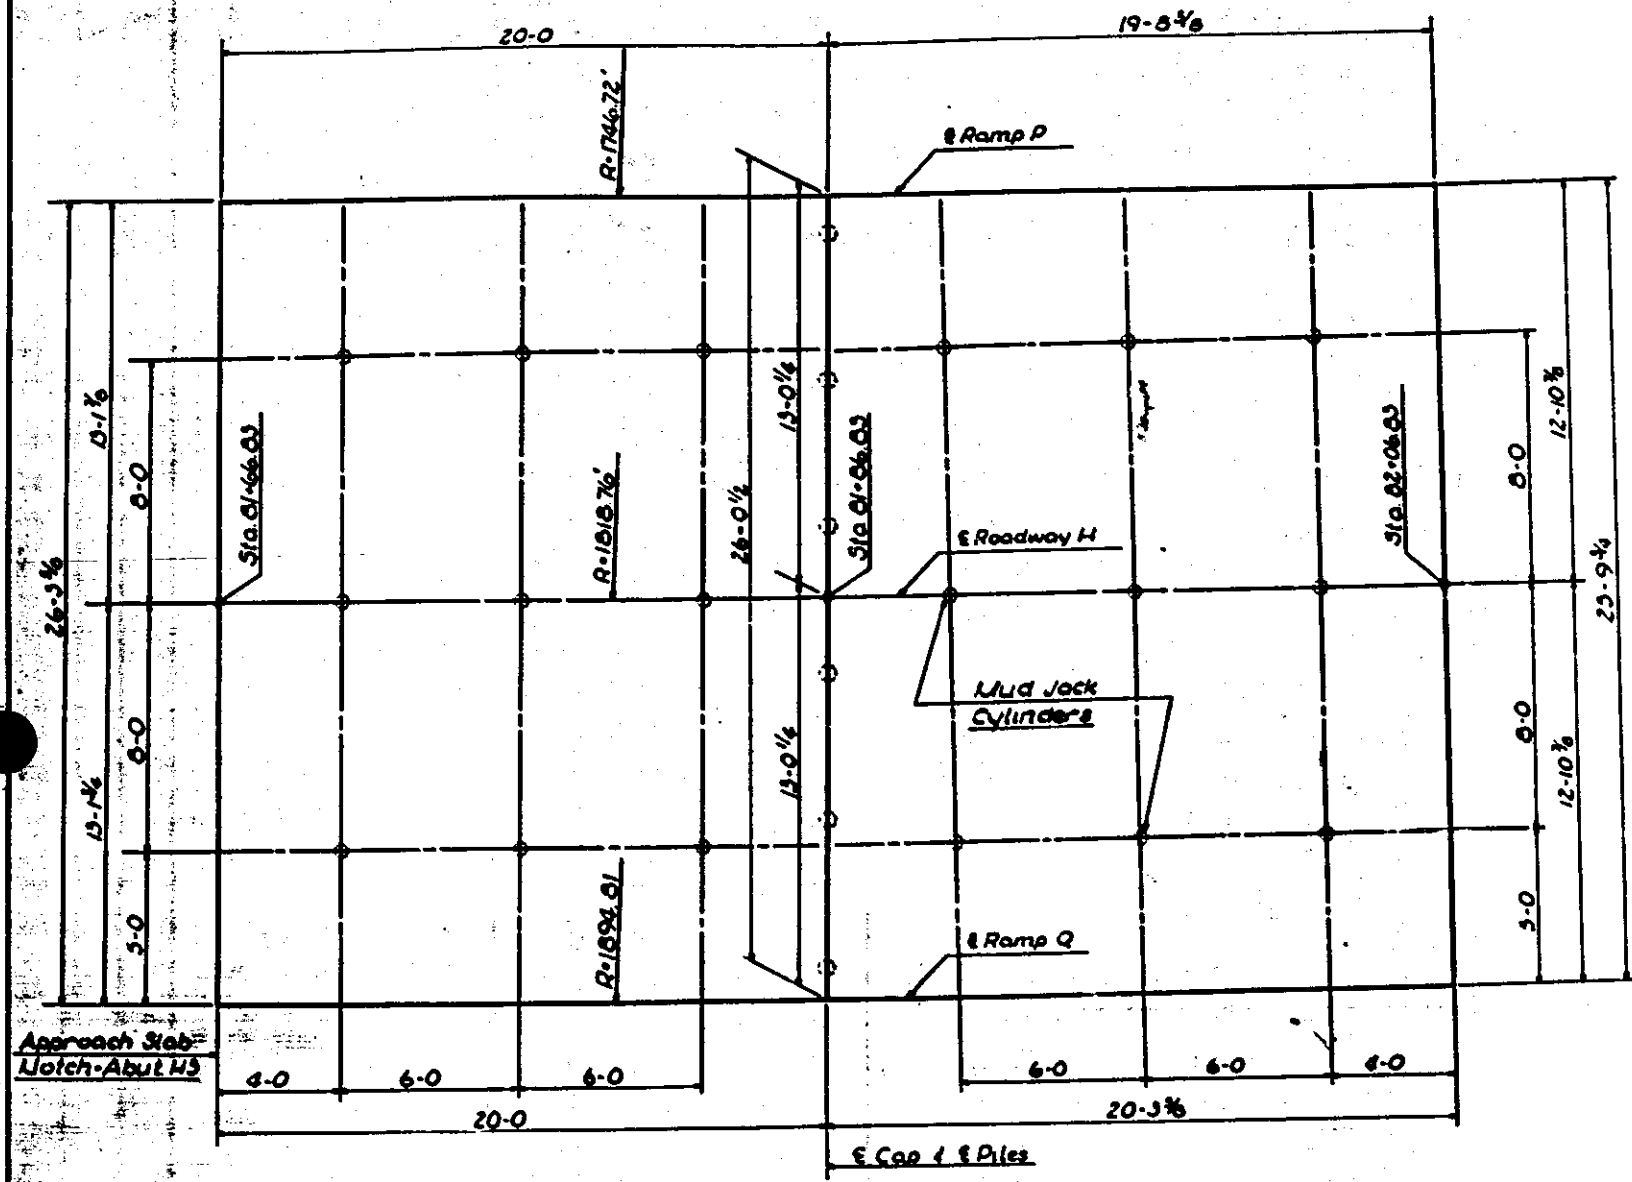

DIMENSION PLAN

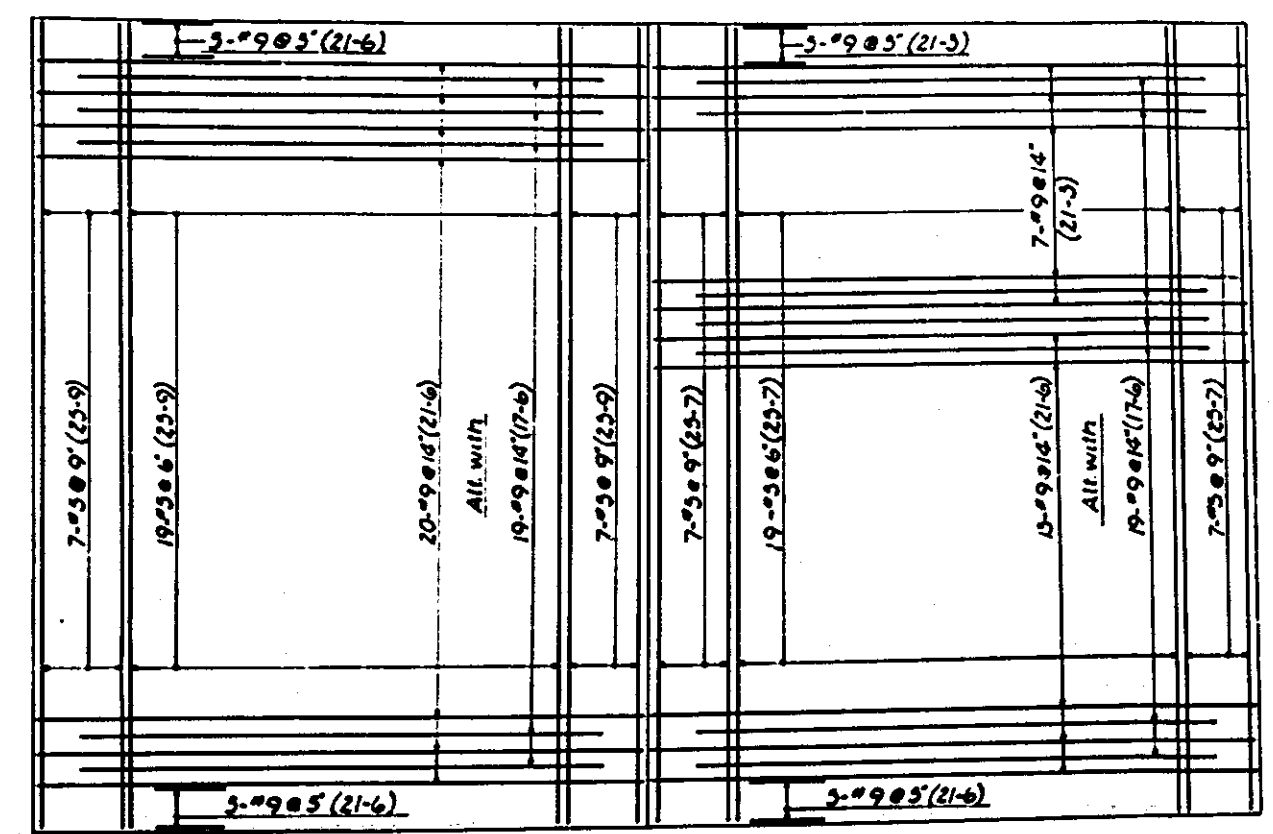

REINFORCEMENT PLAN

Note:
For Details and Sections not shown see Approach Slab Standards 2158-4 (Method I)

QUANTITIES			
Slab	Reinforcement		Weight
	No	Size & Length	
Slab	33	#5 x 25-9	6,410 Lbs
	33	#5 x 21-7	
	48	#9 x 21-6	
	12	#9 x 21-5	
Cap	38	#9 x 17-6	630 Lbs
	8	#6 x 25-9	
	22	#4 x 5-0	

Pavement
16 1/2 - 12 - 16 1/2
118 Sq. Yds.

Class X Concrete
1.0 Cu. Yds.

STATE OF ILLINOIS
DEPARTMENT OF PUBLIC WORKS & BUILDINGS
DIVISION OF HIGHWAYS

APPROACH SLAB
ROADWAY 'H'


H. W. LOCHNER, INC.
ENGINEERS
CHICAGO, ILL.

ROUTE NO.	SECTION	COUNTY	TOTAL SHEETS	SHEET NO.
F.A.I. 70	82-3HYB-1	ST. CLAIR		
FED. ROAD DIV. NO. 4		ILLINOIS	PROJECT	


82-3HYB-E-1
82-3HYD-1

33
68 of
258


Direction of Traffic

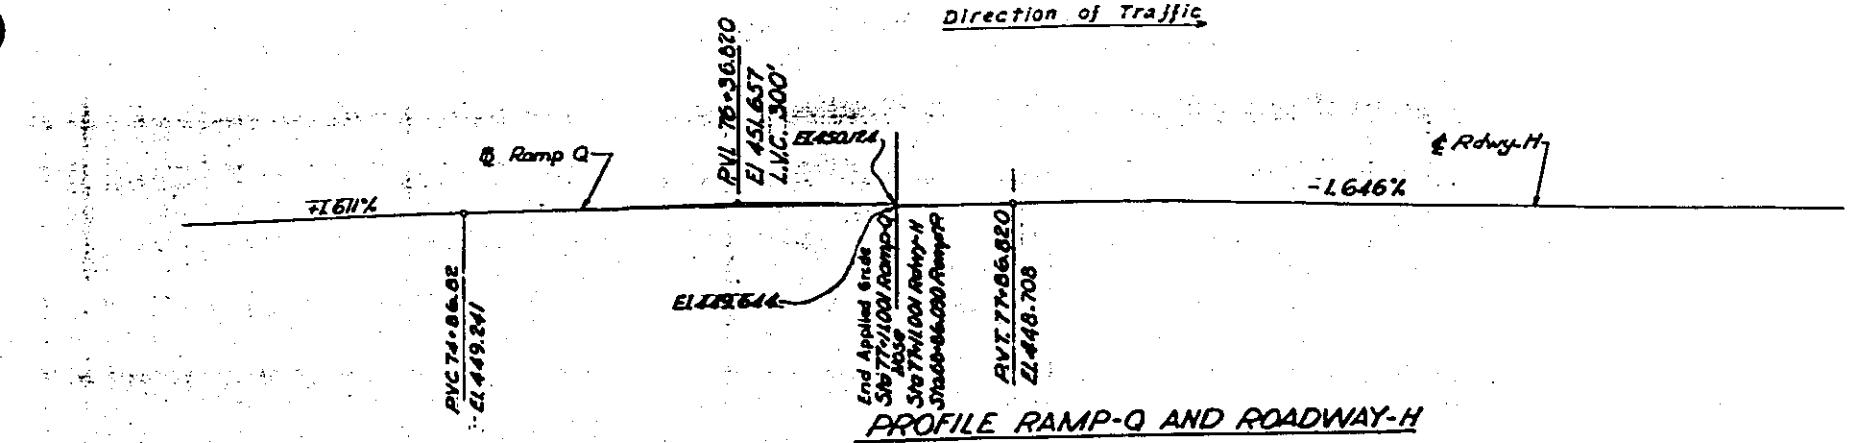


PROFILE RAMP-Q AND ROADWAY-H

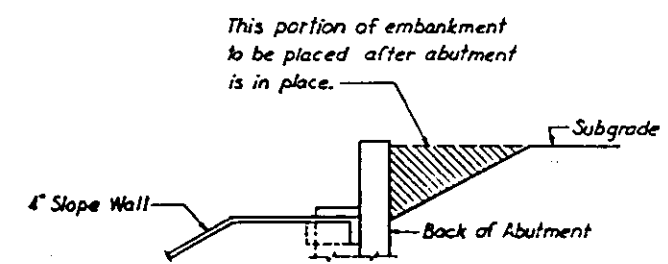


SECTION A-A

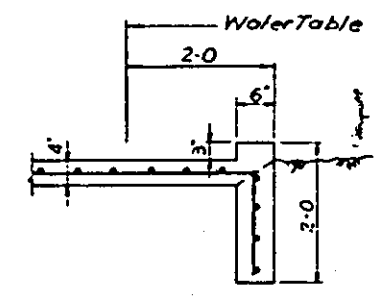


SECTION B-B

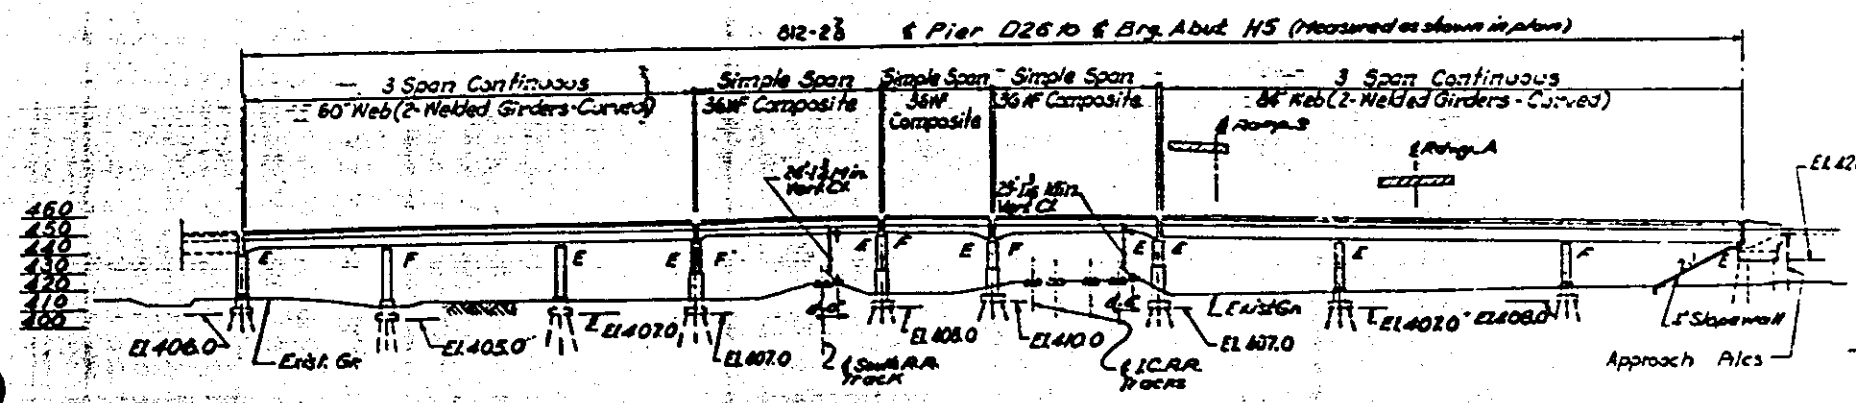

ELEVATION
DEVELOPED LENGTH ALONG RAMP Q & ROADWAY H

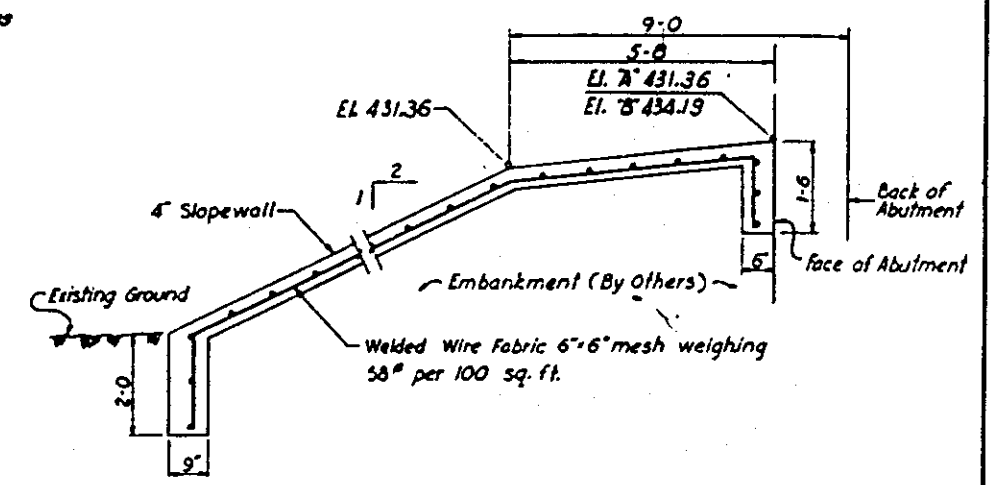

TYPICAL CROSS SECTION OF SLOPE WALL

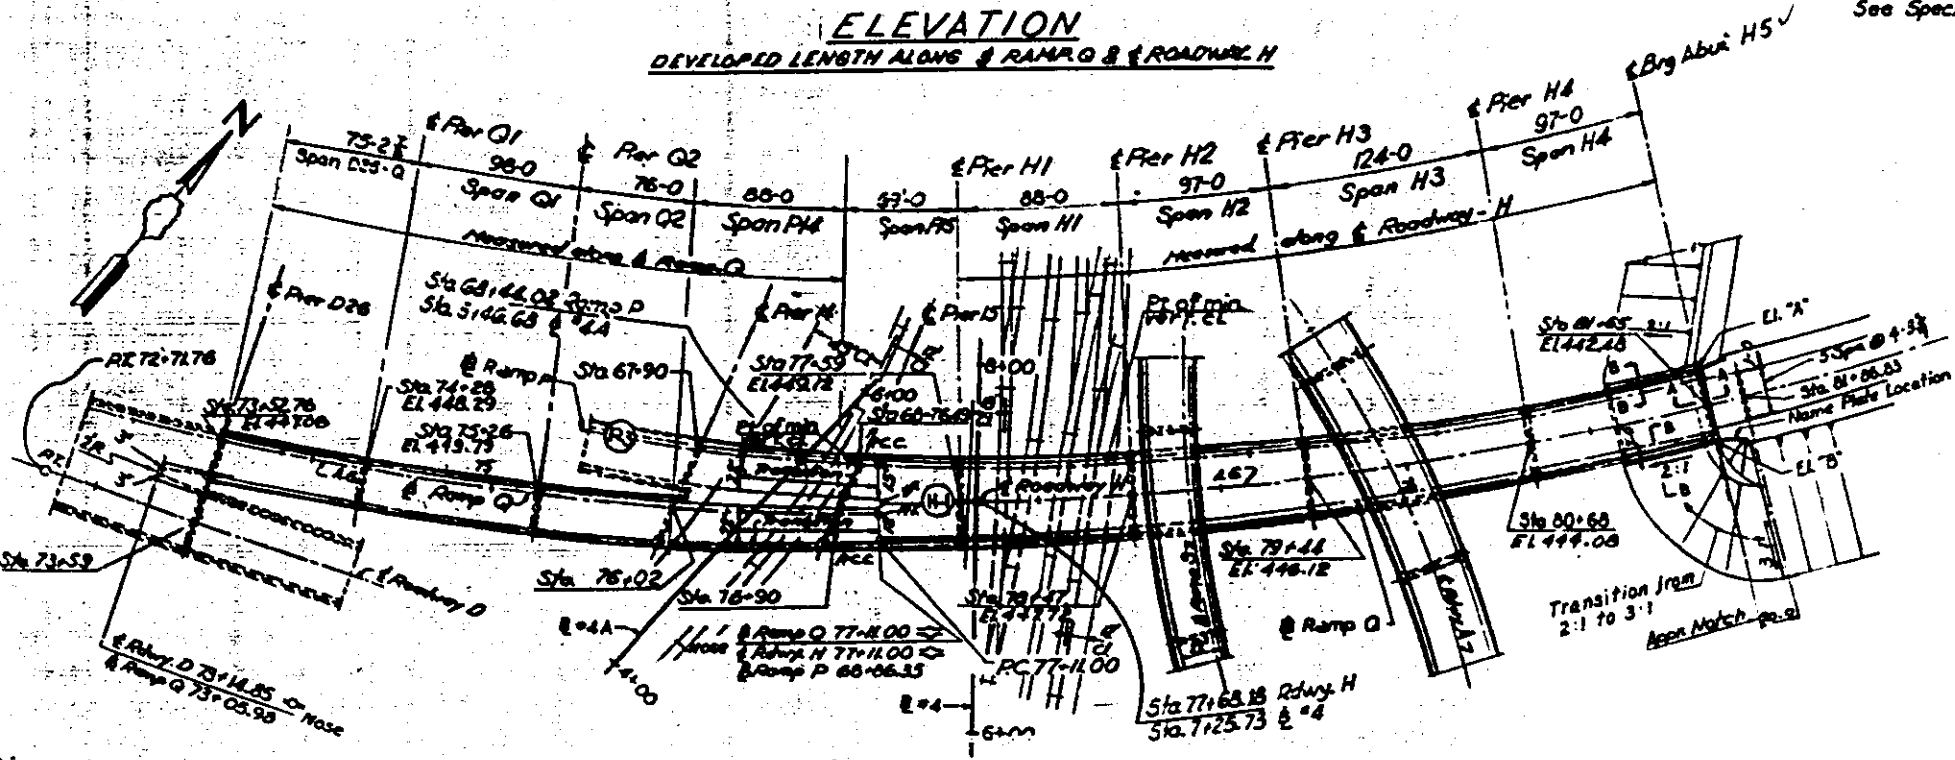

PLAN

BILL OF MATERIAL		
Item	Unit	Quantity
Slope Wall 4'	S.Y.	282
Name Plate	Ea.	1
Embankment	C.Y.	100

STATE OF ILLINOIS
DEPARTMENT OF PUBLIC WORKS & BLDGS.
DIVISION OF HIGHWAYS
PLAN AND ELEVATION
SPANS D26-0, Q1, Q2, P14, P18, H1 THRU H4
POPLAR STREET BRIDGE APPROACHES
ROADWAY "H" AND RAMP "Q"

SECTIONS 82-3HYB-1
82-3HYE-1
82-3HYD-1

F.A.I. RT. 70 ST. CLAIR CO.
H. W. LOCHNER, INC.
ENGINEERS
CHICAGO, ILLINOIS

15 of 328

DESIGNED BY: J.J.N.
DRAWN BY: J.A.O.
CHECKED BY: R.M.R.
APPROVED BY: K.A.

ROUTE NO.	SECTION	COUNTY	TOTAL SHEETS	SHEET NO.
F.A.I. 70	82-3HVB-1	ST. CLAIR		
FED. ROAD DIV. NO. 4	ILLINOIS	PROJECT		




82-3HVB-E-1
82-3HVB-1

49
84 of
258

Curve P2
 P.I. 58+81.46
 Δ 65°23'55"
 D 8°11'06"
 R 700.00'
 L 798.99'
 T 449.38'
 E 131.83'

Curve P3
 P.I. 67+39.03
 Δ 21°04'14"
 D 7°01'18"
 R 216.00'
 L 300.08'
 T 151.76'
 E 13.99'

Curve Q1
 P.I. 71+34.70
 Δ 38°09'55"
 D 3°10'59"
 R 1,900.00'
 L 1,199.00'
 T 622.70'
 E 104.67'

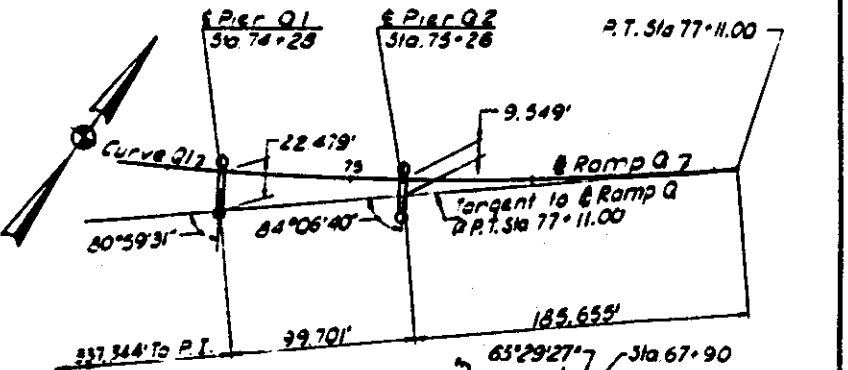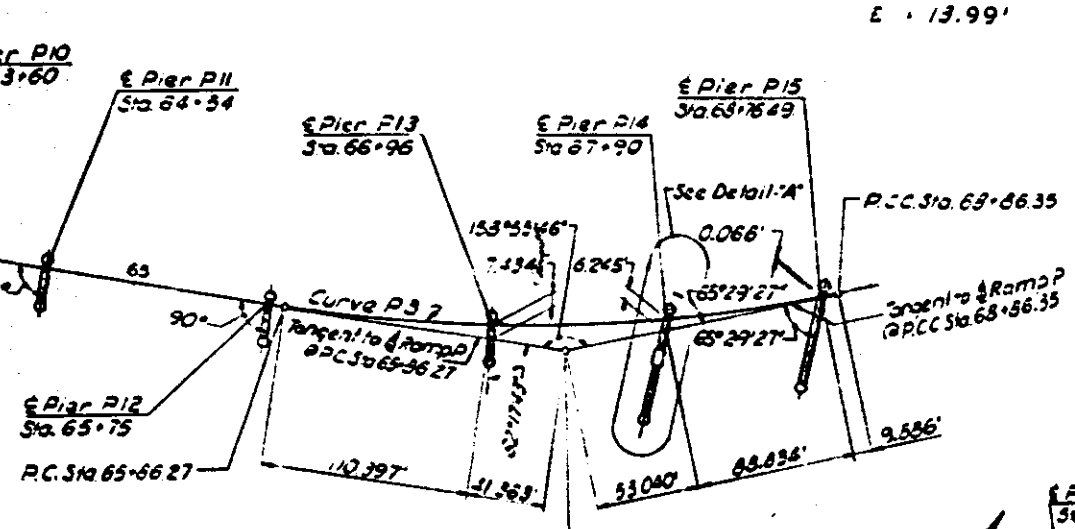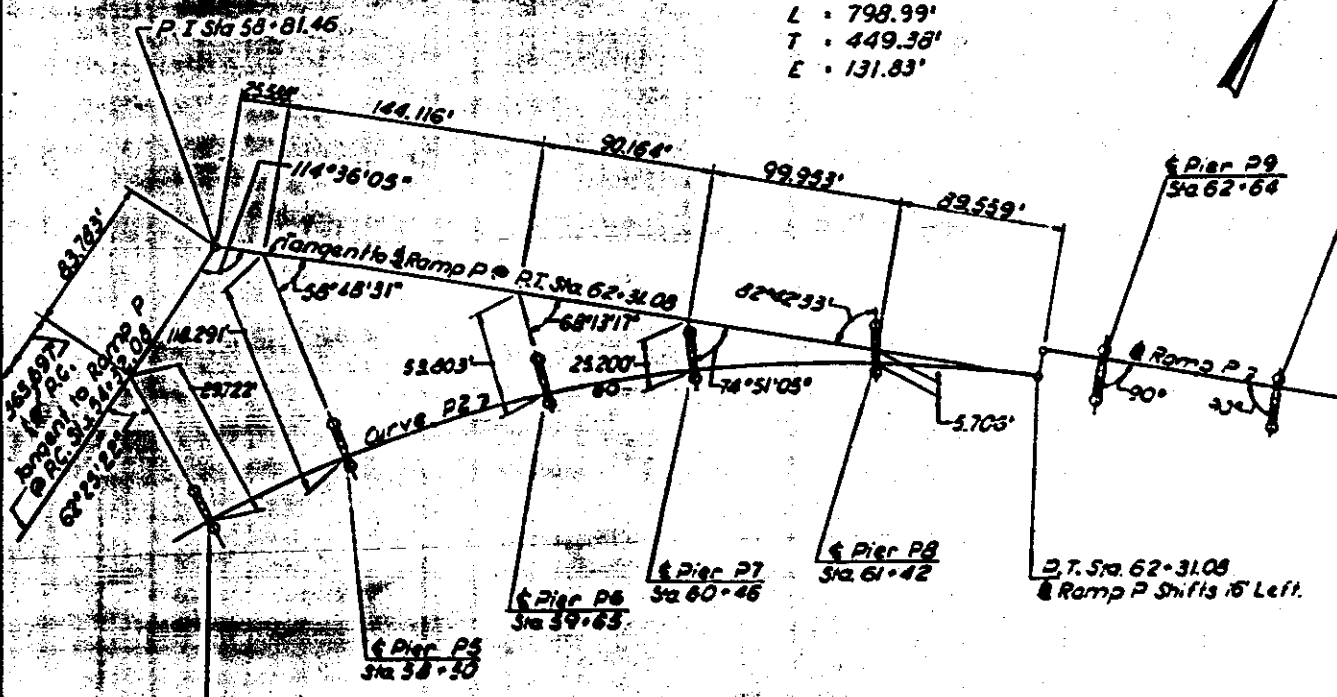


TABLES OF COORDINATES

Pier No.	Ramp P		Azimuth	Right Col. Offset	Left Col. Offset
	Sta.	N. Coordinate			
P4	57+69	8704.828	32408.504	122°10'24"	4-0 20-0
P5	58+50	8770.742	32455.501	128°48'12"	4-0 20-0
P6	59+63	8854.053	32534.587	138°12'58"	4-0 20-0
P7	60+46	8904.414	32597.970	144°50'48"	4-0 20-0
P8	61+42	8954.141	32679.999	152°42'14"	4-0 20-0
P9	62+64	9016.149	32787.002	159°59'41"	20-0 4-0
P10	63+60	9049.901	32877.210	159°59'41"	20-0 4-0
P11	64+54	9081.149	32965.538	159°59'41"	20-0 4-0
P12	65+75	9122.544	33079.237	159°59'41"	20-0 4-0
P13	66+96	9170.748	33190.105	152°17'24"	20-0 4-0
P14	67+90	9219.149	33270.626	163°26'00"	52-0 4-3
P15	68+76.49	9271.595	33339.354	163°26'00"	45-4 3-4

Pier No.	Roadway H		Azimuth	Right Col. Offset	Left Col. Offset
	Sta.	N. Coordinate			
H1	77+59	9296.990	33393.945	136°34'31"	21-4 21-4
H2	78+47	9359.004	33456.369	133°48'11"	20-2 20-2
H3	79+44	9430.767	33521.815	130°44'51"	19-0 19-0
H4	80+68	9527.394	33599.287	126°50'28"	17-10 17-10
Abut.H5	81+65	9606.537	33635.351	123°47'07"	17-1 17-2

Pier No.	Ramp Q		Azimuth	Right Col. Offset	Left Col. Offset
	Sta.	N. Coordinate			
Q1	74+28	9288.251	33139.097	147°05'44"	20-0 4-0
Q2	75+26	9143.701	33219.696	143°58'35"	20-0 4-0

Curve H1
 P.I. 83+48.82
 Δ 36°57'31"
 D 3°09'01"
 R 1,018.76'
 L 4,173.19'
 T 607.52'
 E 98.88'

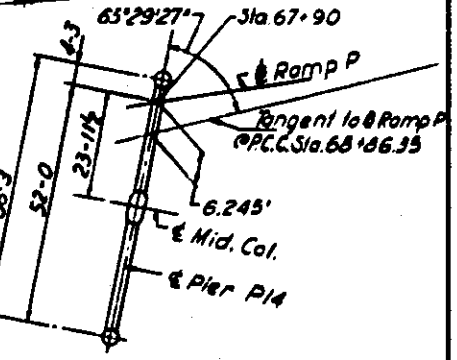

DETAIL - 'A'

STATE OF ILLINOIS
 DEPARTMENT OF PUBLIC WORKS & BLDGS.
 DIVISION OF HIGHWAYS
GEOMETRIC LAYOUT
 PIERS P4 THRU P15, Q1, Q2, H1 THRU H5
 POPLAR STREET BRIDGE APPROACHES
 RAMPS P&Q AND ROADWAY "H"

SECTIONS 82-3HVB-1
82-3HVB-E-1
82-3HVB-1


F.A.I. RT. 70 ST. CLAIR CO.

H. W. LOCHNER, INC.
 ENGINEERS
 CHICAGO, ILLINOIS


SHEET
 21 of 22

DESIGNED BY R.M.R.
 DRAWN BY L.M.
 CHECKED BY S.R.B.
 APPROVED BY K.A.

ROUTE NO.	SECTION	COUNTY	TOTAL SHEETS	SHEET NO.
F. A. I.-70	82-3HVD-1	ST. CLAIR	258	116
FED. ROAD DIV. NO. 4	ILLINOIS	PROJECT		

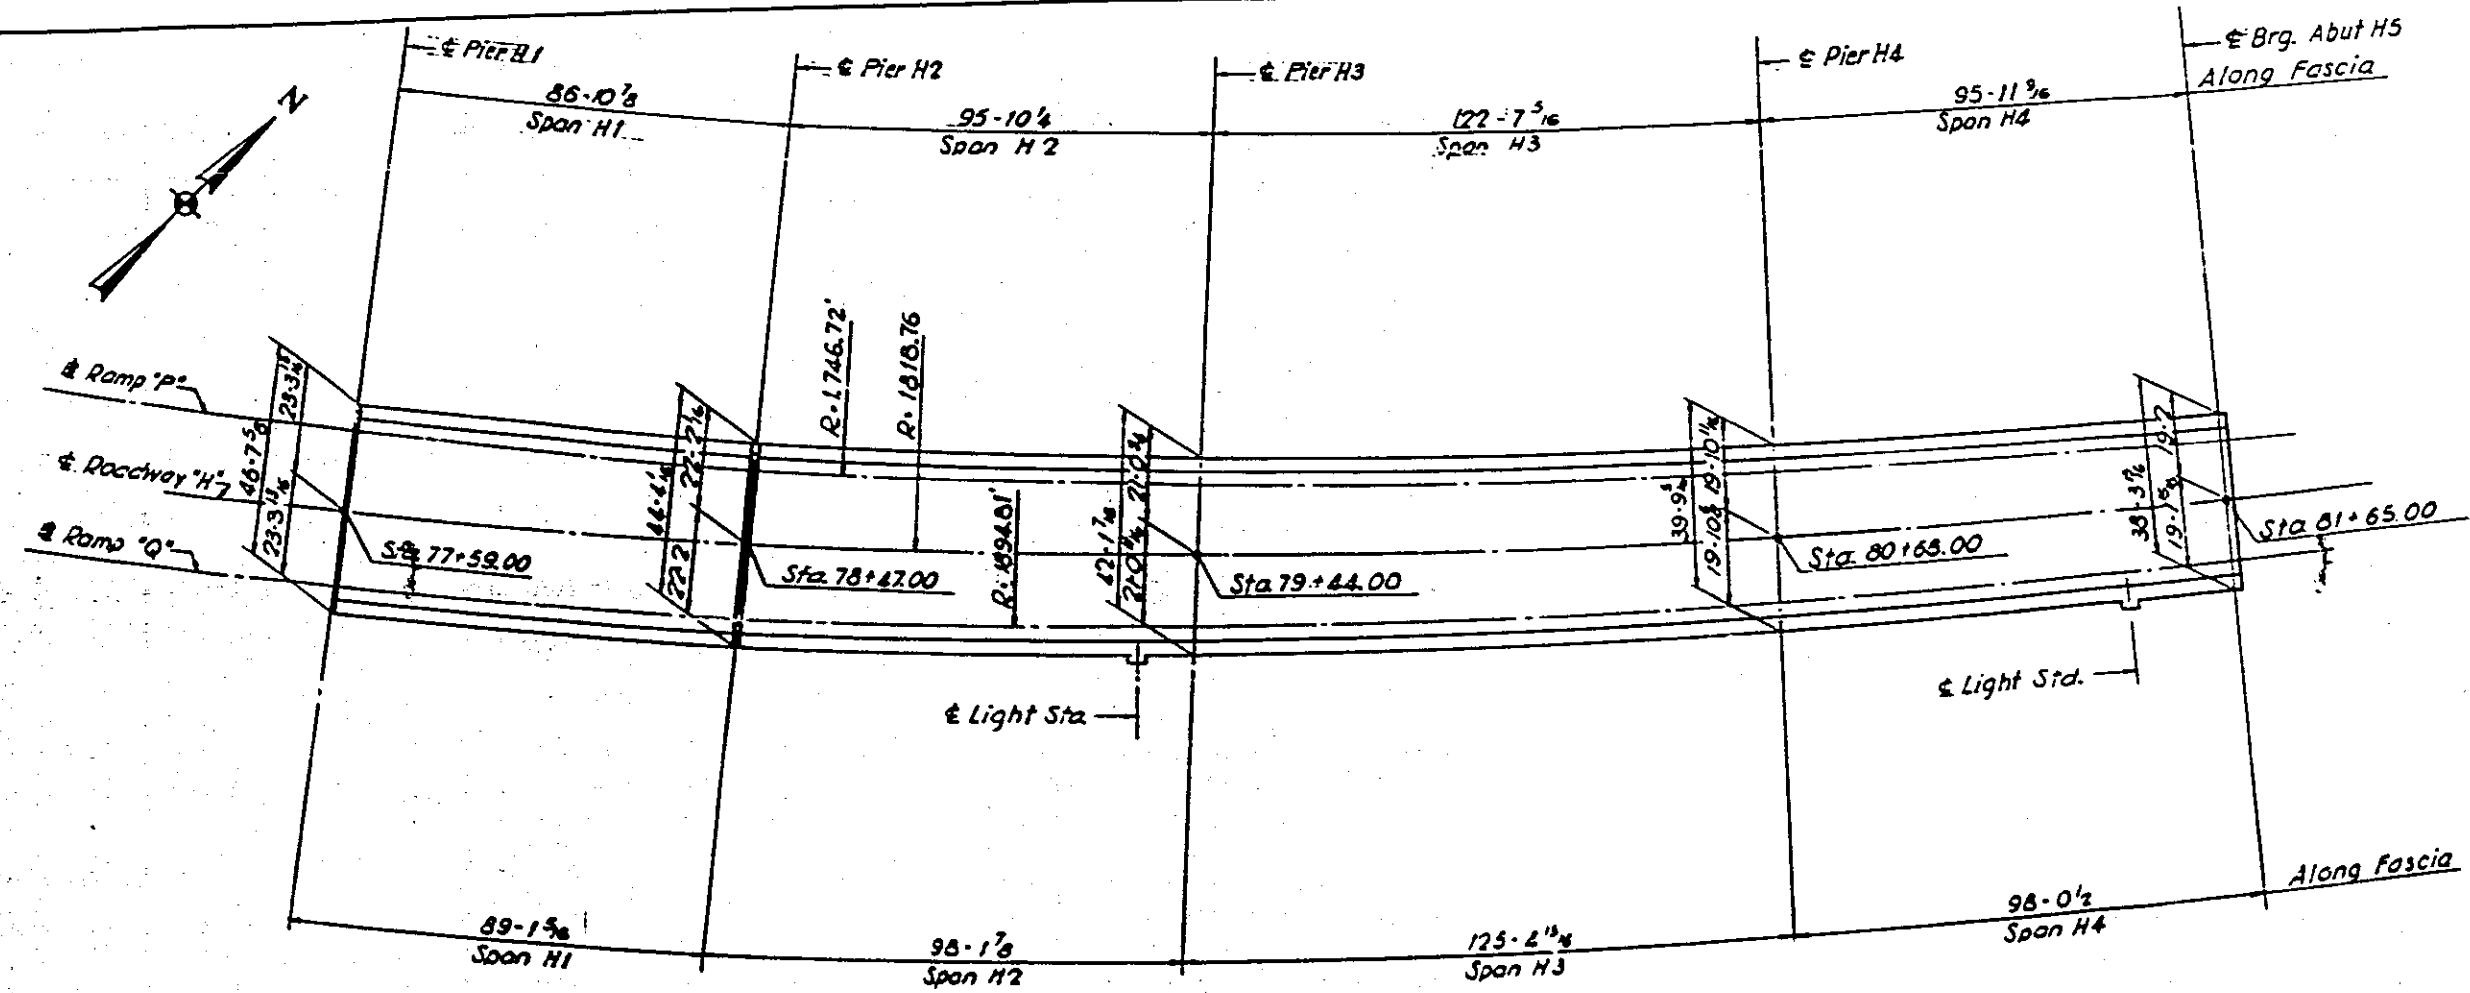

PLAN
Spans H1 thru H4

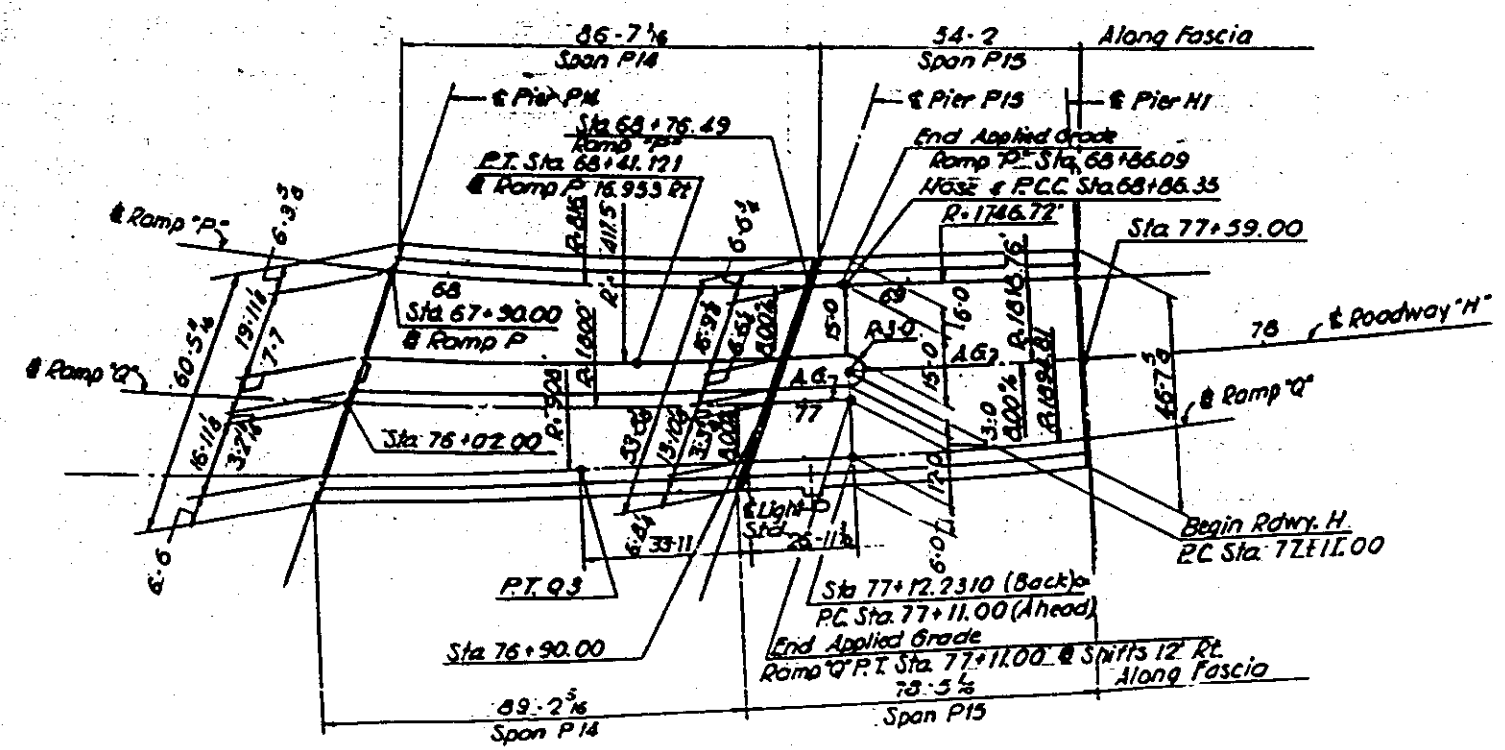








PLAN

CURVE DATA Q3
 P.I. 75+07.7806504
 $\Delta = 5^\circ 30' 24.738''$
 R = 908.00'
 Dc = 6' 18" 36.368
 L = 87.2706422'
 T = 43.6689430
 E = 1.0482769

DESIGNED BY R.M.P.
 DRAWN BY T.R.
 N.I.F.

STATE OF ILLINOIS
 DEPARTMENT OF PUBLIC WORKS & BLDGS.
 DIVISION OF HIGHWAYS
SLAB
 DIMENSION PLAN—SPANS H1 THRU H4; P14 & P15
 POPLAR STREET BRIDGE APPROACHES
 ROADWAY "H" AND RAMP "P"
 F. A. I. RT. 70 ST. CLAIR CO. SECTION 82-3HVD-1
 H. W. LOCHNER, INC.
 ENGINEERS

ROUTE NO.	SECTION	COUNTY	TOTAL SHEETS	SHEET NO.
F. A. I. - 70	82-3HYD-1	ST. CLAIR	258	117
FED. ROAD DIV. NO. 4		ILLINOIS	PROJECT	

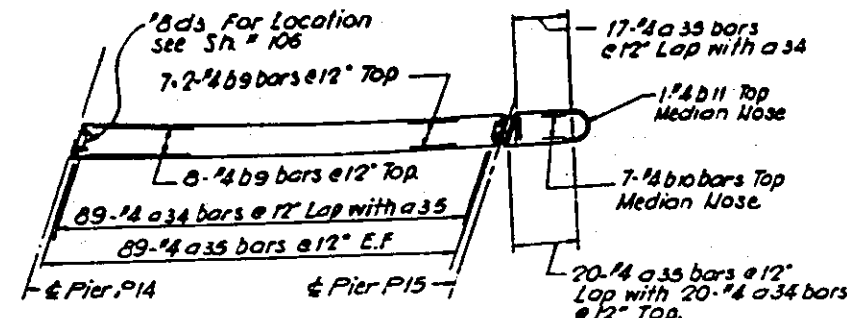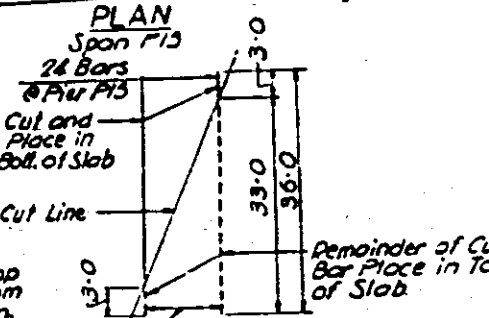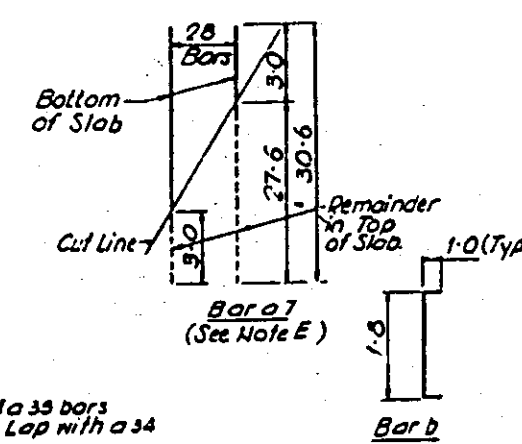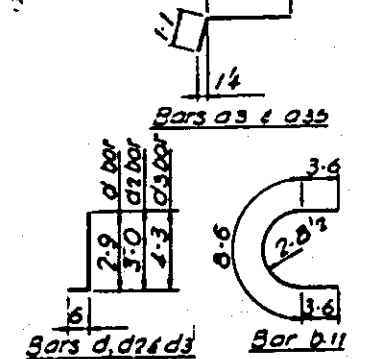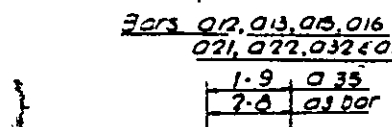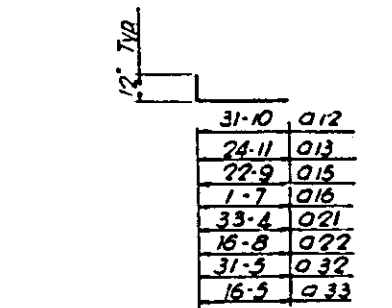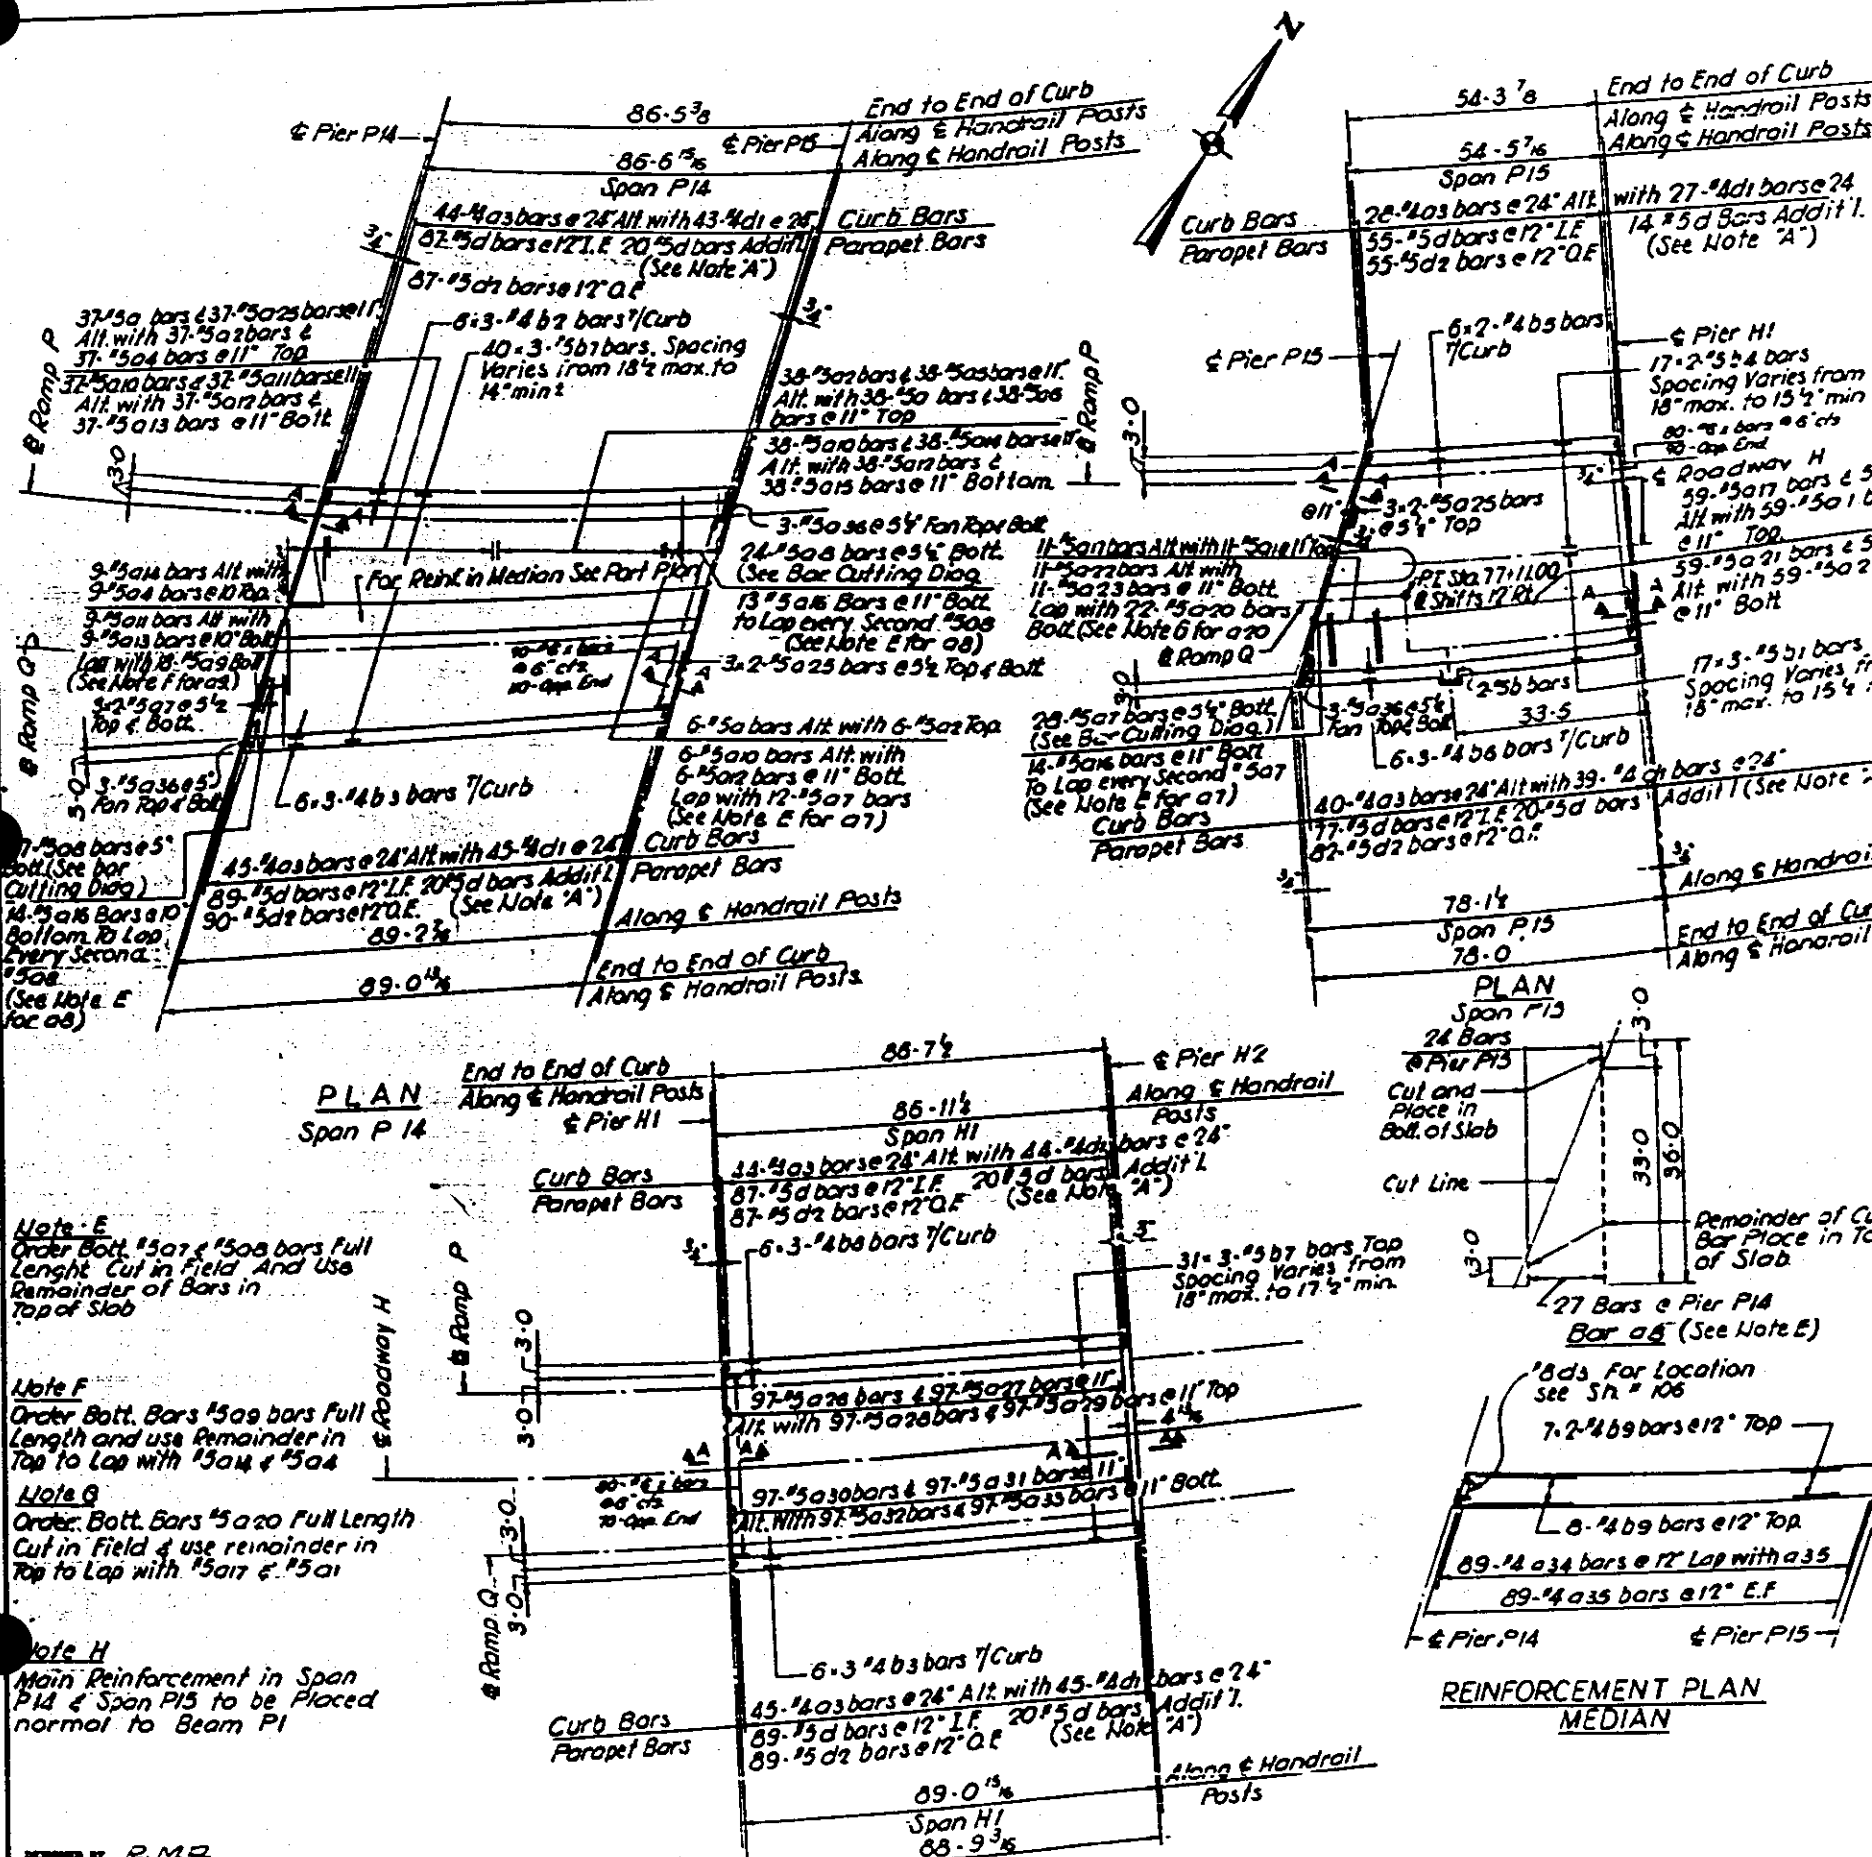

REINFORCEMENT PLAN
MEDIAN


Note:
For Cross Section see Sheet No. 65
For Notes & Misc. Details See Sheet No. 35
For Section 'A-A' See Sheet No. 362

BILL OF MATERIAL

Bar	NO	Size	Length	Shape
	P14	P15	H1	
64a	81		#5 28-9	
64a1		70	#5 27-10	
64a2	81		#5 35-6	
64a3	89	68	#5 3-9	
64a4	46		#5 21-3	
64a5	38		#5 19-3	
64a6	38		#5 26-0	
64a7	24	28	#5 30-6	
64a8	51		#5 36-0	
64a9	18		#5 35-11	
64a10	81		#5 24-6	
64a11	46		#5 33-0	
64a12	81		#5 32-10	
64a13	46		#5 25-11	
64a14	47		#5 50-0	
64a15	38		#5 23-9	
64a16	27	14	#5 2-7	
64a17		70	#5 20-5	
64a18		59	#5 29-7	
64a19		59	#5 22-2	
64a20		27	#5 33-10	
64a21		59	#5 34-4	
64a22		70	#5 17-8	
64a23		70	#5 24-2	
64a24		59	#5 25-10	
64a25	49	12	#5 28-0	
64a26			#5 27-9	
64a27			#5 20-0	
64a28			#5 20-0	
64a29			#5 25-3	
64a30			#5 24-4	
64a31			#5 23-8	
64a32			#5 37-7	
64a33			#5 17-5	
64a34	89	20	#5 3-6	
64a35	178	37	#5 2-10	
64a36	12	6	#5 3-0	
64b		2	#5 3-8	
64b1		150	#5 26-9	
64b2		18	#5 29-5	
64b3		18	#5 30-3	
64b4		104	#5 33-10	
64b5		12	#5 27-6	
64b6		18	#5 26-8	
64b7	342	283	#5 30-4	
64b8		18	#5 29-6	
64b9	22		#5 31-0	
64b10		7	#5 16-0	
64b11		1	#5 15-6	
64c	200	170	#5 4-9	
64d	216	166	#5 3-3	
64e1	88	66	#5 1-7	
64e2	177	137	#5 3-6	
64e3	8		#5 4-9	
*See Note 'X' S.H. No. 35				
ITEM	UNIT	P14	P15	H1
Class 'X' Concrete	Cu Yds	140.8	90.1	109.7
Reinforcement Bars	Lbs	3120	2670	3260
Protective Coat	Sq Yds	488	384	488
1/2\"/>				

STATE OF ILLINOIS
DEPARTMENT OF PUBLIC WORKS & BLDGS.
DIVISION OF HIGHWAYS
SLAB
SPANS P14, P15 AND H1
POPLAR STREET BRIDGE APPROACHES
ROADWAY "H" AND RAMPS "P" & "Q"

ROUTE NO.	SECTION	COUNTY	TOTAL SHEETS	SHEET NO.
F.A.I.-70	82-3HVD-1	ST. CLAIR	258	160
FED. ROAD DIV. NO. 4	ILLINOIS	PROJECT		

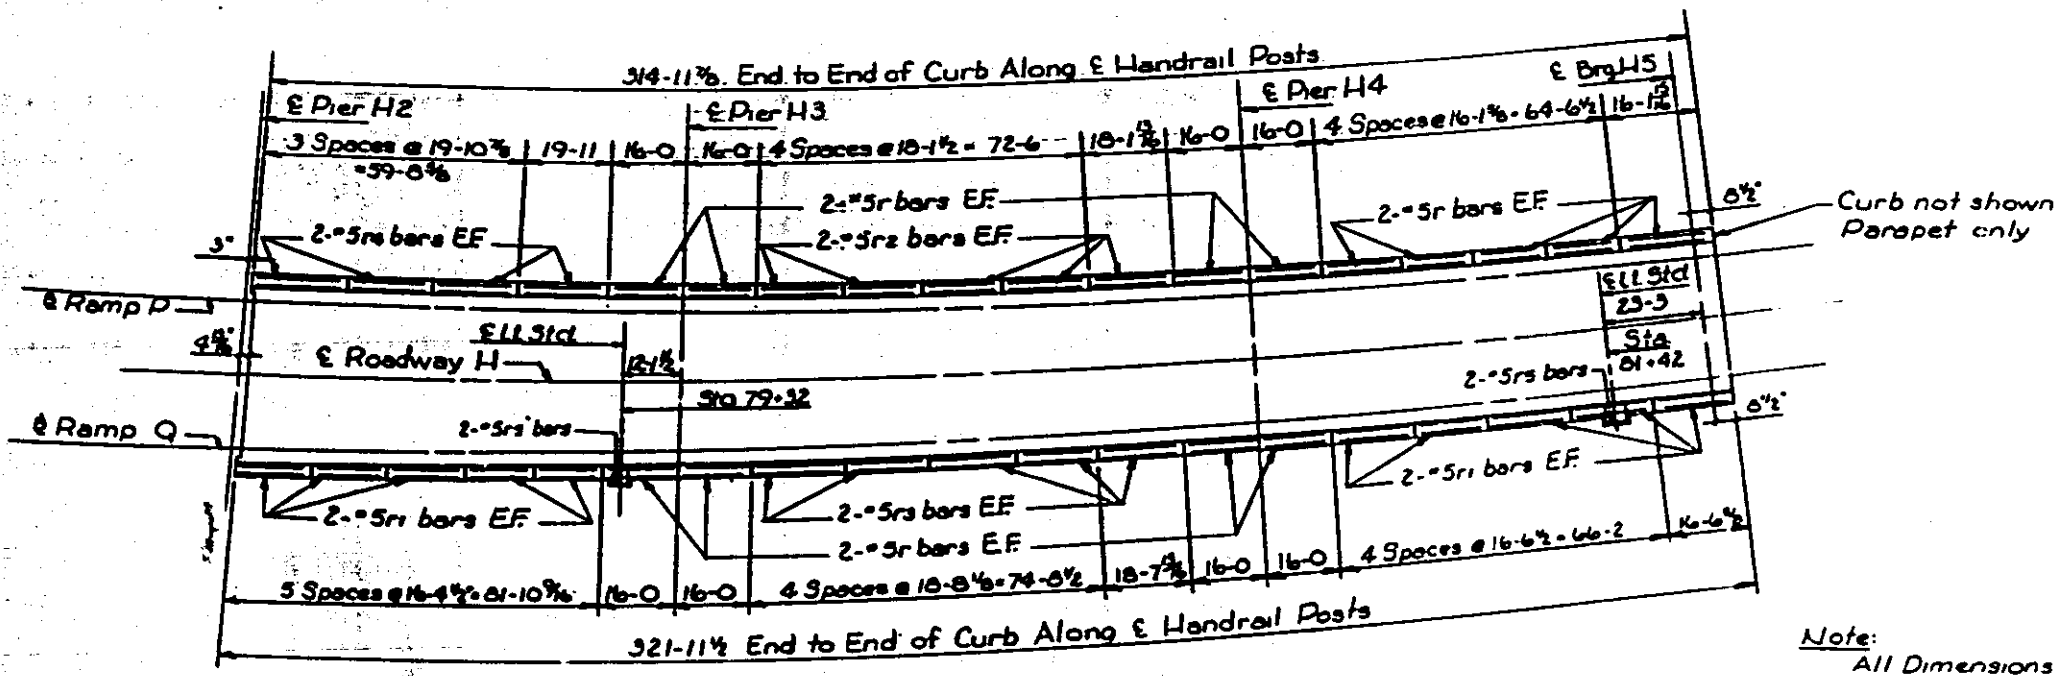


PLAN
Parapet Joint Spacing
Rdwy H
Spans H2-H4

BILL OF MATERIAL


BAR	NO	SIZE	LENGTH	SHAPE
107r	52	"5	15-8	
107r1	40	"5	16-0	
107r2	20	"5	17-8	
107r3	20	"5	18-2	
107r4	16	"5	19-5	
107r5	4	"5	3-8	

ITEM	UNIT	TOTAL
Class X Concrete	Cu. Yds.	326
Reinforcement Bars	Lbs.	2600
Aluminum Handrails	Lin. Ft.	637

Note:
All Dimensions in Plan
are along E of Post

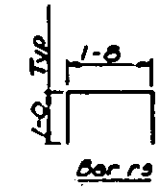

Note:
For Detail of Lt. Std see sh. nr 35
For Detail of Handrail /
Parapet Joint see sh. nr 129

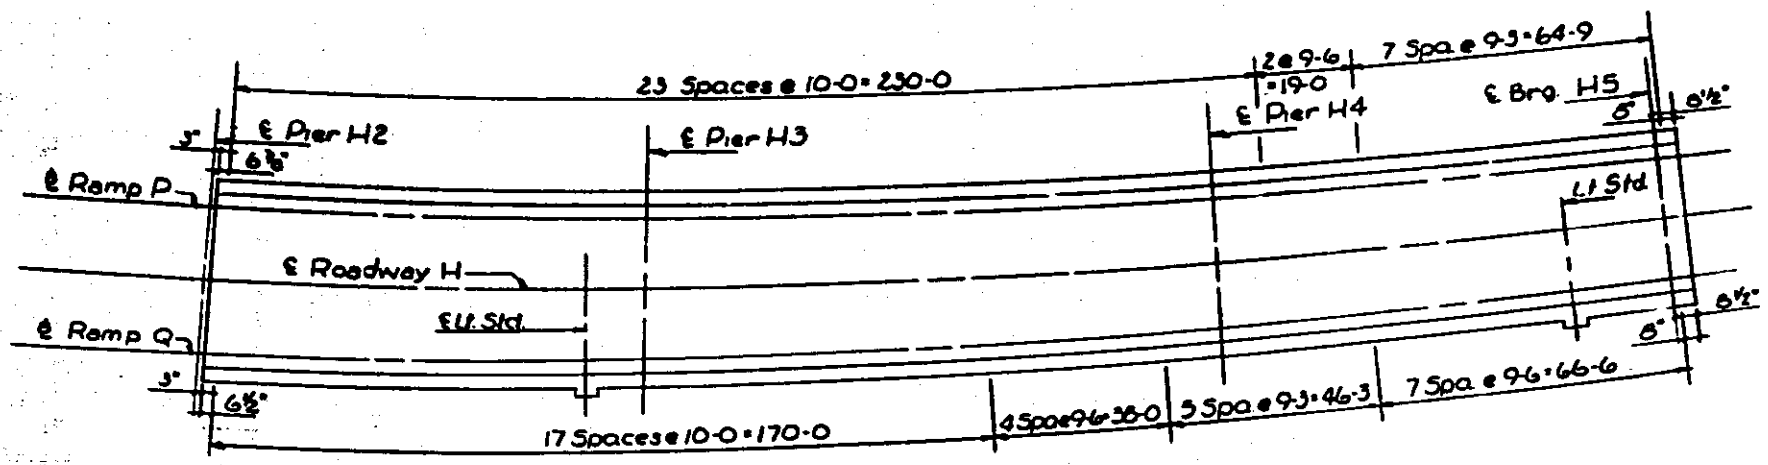

PLAN
Handrail Post Spacing
Rdwy H

DESIGNED BY R.M.P.
DRAWN BY JVA
CHECKED BY H.J.F.
APPROVED BY KA

STATE OF ILLINOIS
DEPARTMENT OF PUBLIC WORKS & BLDGS.
DIVISION OF HIGHWAYS
PARAPET AND HANDRAIL
SPANS H2 THRU H4
POPLAR STREET BRIDGE APPROACHES
ROADWAY "H"

F.A.I. RT. 70 ST. CLAIR CO. SECTION 82-3HVD-1
N. W. LOCHNER, INC.
ENGINEERS
CHICAGO, ILLINOIS

SHEET
107 of 258

ROUTE NO.	SECTION	COUNTY	TOTAL SHEETS	SHEET NO.
F.A.I. 70	82-3HVD-1	ST. CLAIR	258	212
FED. ROAD DIV. NO. 4		ILLINOIS	PROJECT	

FL. BM. NO.	STATION	OFFSET	THEO. TOP OF ROAD	THEO. ADJ. FOR S.L.
1	7766.318	- 21.316	447.401	447.401
	7766.344	- 14.168	447.978	447.978
	7766.328	- 6.908	448.388	448.388
	7766.333	.308	448.132	448.132
	7766.328	7.917	448.708	448.708
	7766.323	14.061	448.238	448.238
	7766.318	21.205	448.818	448.818

FL. BM. NO.	STATION	OFFSET	THEO. TOP OF ROAD	THEO. ADJ. FOR S.L.
1+10'	7776.488	- 21.381	447.288	447.288
	7776.482	- 14.183	447.843	447.843
	7776.378	- 6.975	448.481	448.477
	7776.331	.234	448.088	448.088
	7776.287	7.442	448.678	448.632
	7776.245	14.188	448.118	448.173
	7776.204	20.948	448.657	448.738

FL. BM. NO.	STATION	OFFSET	THEO. TOP OF ROAD	THEO. ADJ. FOR S.L.
1+20'	7786.387	- 21.418	447.088	447.238
	7786.328	- 14.282	447.678	447.788
	7786.418	- 6.984	448.284	448.388
	7786.338	.213	448.832	448.938
	7786.248	7.421	448.418	448.513
	7786.188	14.043	448.011	448.094
	7786.088	20.888	448.672	448.821

FL. BM. NO.	STATION	OFFSET	THEO. TOP OF ROAD	THEO. ADJ. FOR S.L.
1+30'	7796.708	- 21.374	448.887	447.118
	7796.678	- 14.188	447.913	447.888
	7796.658	- 6.988	448.601	448.288
	7796.328	.248	448.678	448.688
	7796.288	7.435	448.388	448.388
	7796.088	13.948	448.778	448.888
	7796.088	20.438	448.291	448.487


FL. BM. NO.	STATION	OFFSET	THEO. TOP OF ROAD	THEO. ADJ. FOR S.L.
1+40'	7806.884	- 21.281	448.778	448.971
	7806.857	- 14.078	447.384	447.988
	7806.481	- 6.888	447.884	448.088
	7806.327	.328	448.513	448.684
	7806.184	7.384	448.382	448.843
	7806.021	13.988	448.888	448.772
	7796.878	20.284	448.114	448.331

FL. BM. NO.	STATION	OFFSET	THEO. TOP OF ROAD	THEO. ADJ. FOR S.L.
1+50'	7816.941	- 21.138	448.888	448.818
	7816.738	- 13.928	447.888	447.347
	7816.528	- 6.723	447.788	447.827
	7816.323	.483	448.388	448.807
	7816.121	7.888	448.988	448.087
	7808.947	13.944	448.441	448.878
	7808.778	20.148	448.942	448.138

FL. BM. NO.	STATION	OFFSET	THEO. TOP OF ROAD	THEO. ADJ. FOR S.L.
1+60'	7821.088	- 20.988	448.478	448.828
	7820.888	- 13.788	447.881	447.172
	7820.582	- 6.582	447.631	447.753
	7820.378	.082	448.211	448.334
	7820.278	7.888	448.712	448.913
	7818.873	13.981	448.882	448.388
	7818.671	20.888	448.774	448.954

FL. BM. NO.	STATION	OFFSET	THEO. TOP OF ROAD	THEO. ADJ. FOR S.L.
1+70'	7831.188	- 20.871	448.384	448.428
	7830.888	- 13.688	448.988	448.988
	7830.584	- 6.484	447.488	447.888
	7830.311	.087	448.887	448.191
	7830.228	8.148	448.848	448.738
	7828.778	14.182	448.828	448.218
	7828.588	20.878	448.618	448.737

FL. BM. NO.	STATION	OFFSET	THEO. TOP OF ROAD	THEO. ADJ. FOR S.L.
2	7846.882	- 20.888	448.128	448.128
	7846.887	- 12.881	448.788	448.788
	7846.882	- 6.778	447.877	447.877
	7846.388	1.438	447.838	447.834
	7846.673	8.848	448.431	448.431
	7846.677	14.888	448.932	448.932
	7846.881	20.178	448.388	448.383

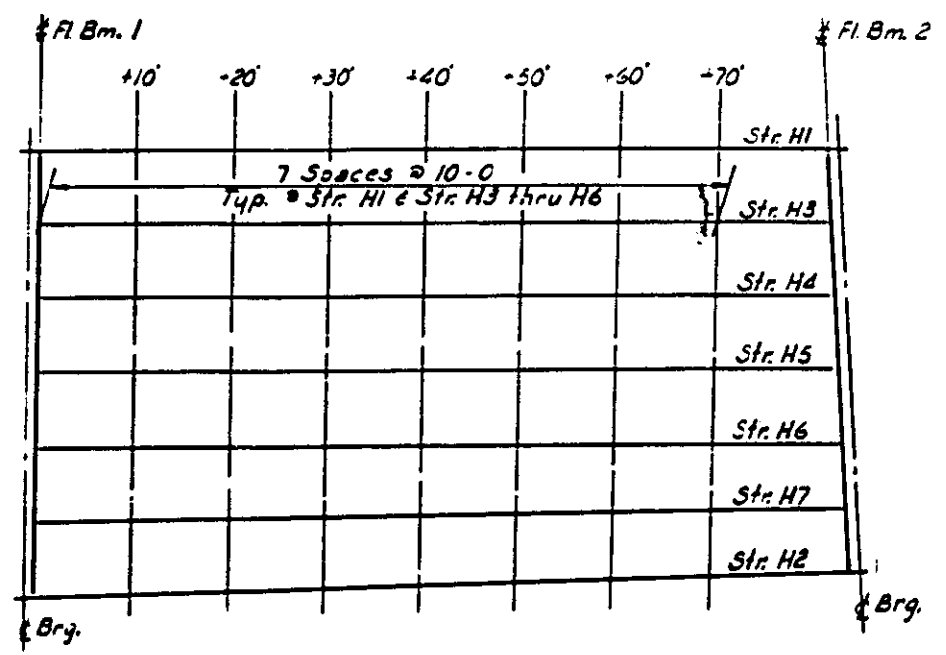

LOCATION PLAN
Span H1

Note
Stringers are identified in the Tables
by their offset.

DESIGNED BY R.M.R.
DRAWN BY A.J.C.
CHECKED BY A.S.
APPROVED BY K.A.

STATE OF ILLINOIS
DEPARTMENT OF PUBLIC WORKS & BLDGS.
DIVISION OF HIGHWAYS
TABLES OF ELEVATIONS
SPAN H1
POPLAR STREET BRIDGE APPROACHES
ROADWAY "H"
F.A.I. RT. 70 ST. CLAIR CO. SECTION 82-3HVD-1
H. W. LOCHNER, INC.
ENGINEERS
CHICAGO, ILLINOIS
SHEET
158 of 268

ROUTE NO.	SECTION	COUNTY	TOTAL SHEETS	SHEET NO.
F.A.I. 70	82-3MVD-1	ST. CLAIR	258	213
FED. ROAD DIV. NO. 4		ILLINOIS PROJECT		

FL. NO.	STATION	OFFSET	THEO. TOP OF ROAD	THEO. ADJ. FOR S.L.
3.0	7046.340	- 20.130	446.083	446.083
	7046.340	- 12.000	446.788	446.788
	7046.337	- 4.080	447.373	447.373
	7046.331	- 4.080	446.018	446.018
	7046.325	- 12.000	446.883	446.883
	7046.320	- 20.131	446.308	446.308

FL. NO.	STATION	OFFSET	THEO. TOP OF ROAD	THEO. ADJ. FOR S.L.
6.0	7022.857	- 19.516	445.340	445.340
	7022.857	- 11.004	446.888	446.888
	7022.857	- 4.018	446.480	446.480
	7022.857	- 3.700	447.104	447.104
	7022.857	- 11.504	447.320	447.320
	7022.857	- 19.516	446.302	446.302

FL. NO.	STATION	OFFSET	THEO. TOP OF ROAD	THEO. ADJ. FOR S.L.
9.0	7004.867	- 18.040	444.273	444.273
	7004.867	- 11.388	444.871	444.871
	7004.867	- 3.827	446.478	446.478
	7004.867	- 3.712	446.870	446.870
	7004.867	- 11.251	446.884	446.884
	7004.867	- 18.043	447.388	447.388

FL. NO.	STATION	OFFSET	THEO. TOP OF ROAD	THEO. ADJ. FOR S.L.
12.0	8026.867	- 18.230	443.300	443.300
	8026.867	- 11.023	443.878	443.878
	8026.867	- 3.788	444.482	444.482
	8026.867	- 3.574	445.044	445.044
	8026.867	- 10.873	445.630	445.630
	8026.867	- 18.244	446.220	446.220

FL. NO.	STATION	OFFSET	THEO. TOP OF ROAD	THEO. ADJ. FOR S.L.
15.0	8008.867	- 17.780	442.322	442.322
	8008.867	- 10.688	442.885	442.885
	8008.867	- 3.801	443.432	443.432
	8008.867	- 3.487	444.019	444.019
	8008.867	- 10.575	444.588	444.588
	8008.867	- 17.716	445.157	445.157

FL. NO.	STATION	OFFSET	THEO. TOP OF ROAD	THEO. ADJ. FOR S.L.
17.5	8140.333	- 17.333	441.503	441.503
	8140.333	- 10.441	442.054	442.054
	8140.333	- 3.508	442.609	442.609
	8140.333	- 3.425	443.163	443.163
	8140.333	- 10.357	443.718	443.718
	8140.333	- 17.329	444.275	444.275

FL. NO.	STATION	OFFSET	THEO. TOP OF ROAD	THEO. ADJ. FOR S.L.
3.5	7034.833	- 20.077	443.988	443.988
	7034.833	- 12.000	446.021	446.021
	7034.833	- 4.088	447.204	447.279
	7034.833	- 3.971	447.308	447.917
	7034.833	- 12.001	446.340	446.380
	7034.833	- 20.071	445.186	445.208

FL. NO.	STATION	OFFSET	THEO. TOP OF ROAD	THEO. ADJ. FOR S.L.
3.5	7013.800	- 19.400	446.070	446.102
	7013.800	- 11.700	446.888	446.710
	7013.800	- 3.941	446.310	446.388
	7013.800	- 3.818	446.927	446.988
	7013.800	- 11.570	447.387	447.388
	7013.800	- 19.394	446.183	446.208

FL. NO.	STATION	OFFSET	THEO. TOP OF ROAD	THEO. ADJ. FOR S.L.
3.5	7075.880	- 18.744	444.111	444.142
	7075.880	- 11.307	444.708	444.737
	7075.880	- 3.810	446.308	446.338
	7075.880	- 3.687	445.928	446.988
	7075.880	- 11.184	446.388	446.388
	7075.880	- 18.738	447.110	447.140

FL. NO.	STATION	OFFSET	THEO. TOP OF ROAD	THEO. ADJ. FOR S.L.
12.5	8037.000	- 18.137	443.137	443.168
	8037.000	- 10.940	443.715	443.747
	8037.000	- 3.678	444.296	444.327
	8037.000	- 3.584	444.877	444.908
	8037.000	- 10.846	445.458	445.489
	8037.000	- 18.132	446.042	446.074

FL. NO.	STATION	OFFSET	THEO. TOP OF ROAD	THEO. ADJ. FOR S.L.
15.5	8099.000	- 17.639	442.158	442.179
	8099.000	- 10.843	442.718	442.739
	8099.010	- 3.588	443.282	443.303
	8099.000	- 3.467	443.847	443.868
	8099.031	- 10.582	444.411	444.432
	8099.000	- 17.635	444.980	445.001

FL. NO.	STATION	OFFSET	THEO. TOP OF ROAD	THEO. ADJ. FOR S.L.
18.0	8130.867	- 17.261	441.338	441.359
	8130.867	- 10.420	441.883	441.908
	8130.867	- 3.518	442.438	442.458
	8130.867	- 3.389	442.990	443.011
	8130.867	- 10.283	443.543	443.563
	8130.867	- 17.257	444.100	444.120

FL. NO.	STATION	OFFSET	THEO. TOP OF ROAD	THEO. ADJ. FOR S.L.
4.0	7061.333	- 19.988	443.882	443.912
	7061.333	- 12.000	446.317	446.338
	7061.333	- 4.080	447.137	447.177
	7061.333	- 3.988	447.737	447.817
	7061.333	- 11.937	446.438	446.467
	7061.333	- 19.983	445.081	445.112

FL. NO.	STATION	OFFSET	THEO. TOP OF ROAD	THEO. ADJ. FOR S.L.
7.0	7023.333	- 19.388	444.918	444.948
	7023.333	- 11.880	446.381	446.382
	7023.333	- 3.914	446.148	446.188
	7023.333	- 3.780	446.788	446.777
	7023.333	- 11.813	447.382	447.381
	7023.333	- 19.380	446.008	446.018

FL. NO.	STATION	OFFSET	THEO. TOP OF ROAD	THEO. ADJ. FOR S.L.
10.0	7082.333	- 18.841	443.980	443.988
	7082.333	- 11.380	444.353	444.380
	7082.333	- 3.843	446.138	446.177
	7082.333	- 3.813	446.738	446.773
	7082.333	- 11.880	446.388	446.378
	7082.333	- 18.838	446.981	446.975

FL. NO.	STATION	OFFSET	THEO. TOP OF ROAD	THEO. ADJ. FOR S.L.
13.0	8047.333	- 18.788	442.975	442.982
	8047.333	- 10.898	443.548	443.580
	8047.333	- 3.670	444.128	444.144
	8047.333	- 3.588	444.704	444.722
	8047.333	- 10.782	445.282	445.300
	8047.333	- 18.881	445.868	445.882

FL. NO.	STATION	OFFSET	THEO. TOP OF ROAD	THEO. ADJ. FOR S.L.
16.0	8108.333	- 17.389	441.975	441.985
	8108.333	- 10.880	442.547	442.578
	8108.333	- 3.828	443.108	443.140
	8108.333	- 3.780	443.671	443.702
	8108.333	- 10.822	444.233	444.264
	8108.333	- 17.388	444.804	444.835

FL. NO.	STATION	OFFSET	THEO. TOP OF ROAD	THEO. ADJ. FOR S.L.
18.5	8157.348	- 17.214	441.229	441.240
	8157.348	- 10.374	441.774	441.787
	8157.348	- 3.488	442.327	442.338
	8157.348	- 3.397	442.878	442.889
	8157.348	- 10.288	443.421	443.439
	8157.348	- 17.211	443.983	443.994

FL. NO.	STATION	OFFSET	THEO. TOP OF ROAD	THEO. ADJ. FOR S.L.
4.8	7071.867	- 19.878	445.721	445.752
	7071.867	- 11.988	446.304	446.330
	7071.867	- 4.016	446.900	447.004
	7071.867	- 3.983	447.500	447.600
	7071.867	- 11.882	446.382	446.410
	7071.867	- 19.860	445.001	445.034

FL. NO.	STATION	OFFSET	THEO. TOP OF ROAD	THEO. ADJ. FOR S.L.
7.5	7033.867	- 19.170	444.787	444.788
	7033.867	- 11.800	446.380	446.382
	7033.867	- 3.880	446.972	446.978
	7033.867	- 3.880	446.588	446.588
	7033.867	- 11.280	447.380	447.380
	7033.867	- 19.168	447.084	447.087

FL. NO.	STATION	OFFSET	THEO. TOP OF ROAD	THEO. ADJ. FOR S.L.
10.5	7082.867	- 18.841	443.787	443.840
	7082.867	- 11.330	444.332	444.385
	7082.867	- 3.810	446.088	446.018
	7082.867	- 3.880	446.688	446.877
	7082.867	- 11.844	446.180	446.388
	7082.867	- 18.838	446.788	446.887

FL. NO.	STATION	OFFSET	THEO. TOP OF ROAD	THEO. ADJ. FOR S.L.
13.5	8087.867	- 17.878	442.812	442.818
	8087.867	- 10.931	443.375	443.381
	8087.867	- 3.780	443.951	443.957
	8087.867	- 3.650	444.528	444.532
	8087.867	- 10.841	445.101	445.107
	8087.867	- 17.871	445.688	445.688

FL. NO.	STATION	OFFSET	THEO. TOP OF ROAD	THEO. ADJ. FOR S.L.
16.5	8118.867	- 17.482	441.831	441.867
	8118.867	- 10.583	442.381	442.418
	8118.867	- 3.808	442.941	442.977
	8118.867	- 3.687	443.500	443.537
	8118.867	- 10.580	444.080	444.098
	8118.867	- 17.478	444.628	444.664

FL. NO.	STATION	OFFSET	THEO. TOP OF ROAD	THEO. ADJ. FOR S.L.
19.0	8164.410	- 17.189	441.119	441.119
	8164.410	- 10.302	441.669	441.669
	8164.415	- 3.439	442.218	442.218
	8164.417	- 3.432	442.767	442.767
	8164.419	- 10.210	443.317	443.317
	8164.421	- 17.185	443.866	443.866

FL. NO.	STATION	OFFSET	THEO. TOP OF ROAD	THEO. ADJ. FOR S.L.
5.0	7082.000	- 19.783	443.981	443.981
	7082.000	- 11.880	446.180	446.220
	7082.000	- 3.977	446.982	446.981
	7082.000	- 3.880	447.484	447.483
	7082.000	- 11.804	446.088	446.125
	7082.000	- 19.747	446.721	446.761

FL. NO.	STATION	OFFSET	THEO. TOP OF ROAD	THEO. ADJ. FOR S.L.
8.0	7044.000	- 19.083	444.388	444.388
	7044.000	- 11.813	446.182	446.182
	7044.000	- 3.788	446.982	446.982
	7044.000	- 3.630	446.412	446.412
	7044.000	- 11.884	447.082	447.082
	7044.000	- 19.087	447.048	447.048

FL. NO.	STATION	OFFSET	THEO. TOP OF ROAD	THEO. ADJ. FOR S.L.
11.0	8008.			

ROUTE NO.	SECTION	COUNTY	TOTAL SHEETS	SHEET NO.
F. A. I. 70	82-3HVF & E-1 82-3HVD-1	ST. CLAIR	252	237
FED. ROAD DIV. NO. 4		ILLINOIS PROJECT		

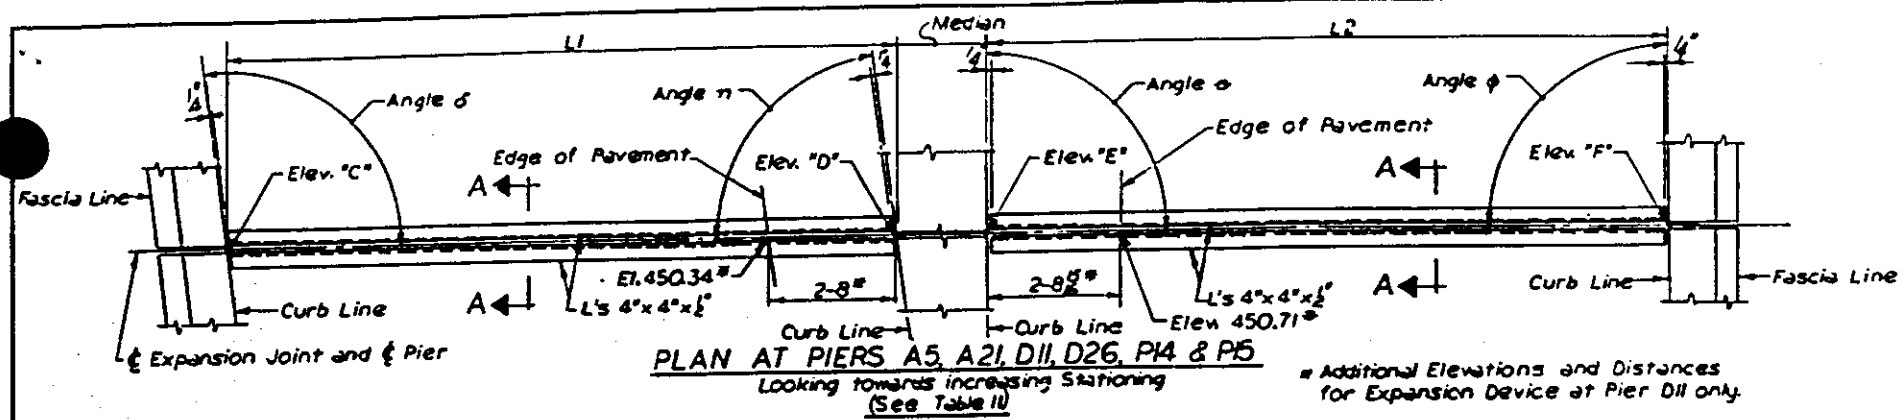


TABLE I
FOR ELEVATIONS, LENGTHS, ANGLES & WEIGHTS

PIER NO.	ANGLE α	ELEV. "A"	L	ELEV. "B"	ANGLE β	WEIGHT
A11	90°03'15"	448.05	30-0	450.45	90°00'00"	830 Lbs.
A12	90°19'37"	448.43	30-3/4	450.85	90°00'00"	830 Lbs.
D5	90°00'00"	446.70	30-0 1/2	446.23	92°36'23"	830 Lbs.
D12	90°00'00"	448.31	30-0	450.71	90°00'00"	830 Lbs.
D18	90°12'05"	448.70	30-0 1/2	450.88	90°00'00"	830 Lbs.
D21	91°47'46"	446.96	34-10 1/2	449.49	90°00'00"	960 Lbs.
G9	90°00'00"	455.58	30-0	457.98	90°00'00"	830 Lbs.
H1	89°12'02"	447.50	40-7 1/2	450.75	89°12'59"	1120 Lbs.
M9	90°00'00"	465.31	22-0	467.07	90°00'00"	610 Lbs.
N1	90°00'00"	451.32	22-0	450.44	90°00'00"	610 Lbs.
O6	90°00'00"	449.26	22-0	449.81	90°00'00"	610 Lbs.
P7	90°00'00"	471.78	22-0	470.02	90°00'00"	610 Lbs.
S3	90°00'00"	457.36	22-0	455.91	90°00'00"	610 Lbs.
G1	*See Details This Sheet*					1380 Lbs.
ABUTMENT						
G14	85°35'35"	443.24	48-8 1/2	443.39	90°00'00"	1340 Lbs.
H5	89°38'48"	441.18	32-3 1/4	443.76	89°36'07"	890 Lbs.
O10	90°00'00"	428.11	22-0	429.87	90°00'00"	610 Lbs.
O11	90°00'00"	424.74	22-0	426.12	90°00'00"	610 Lbs.



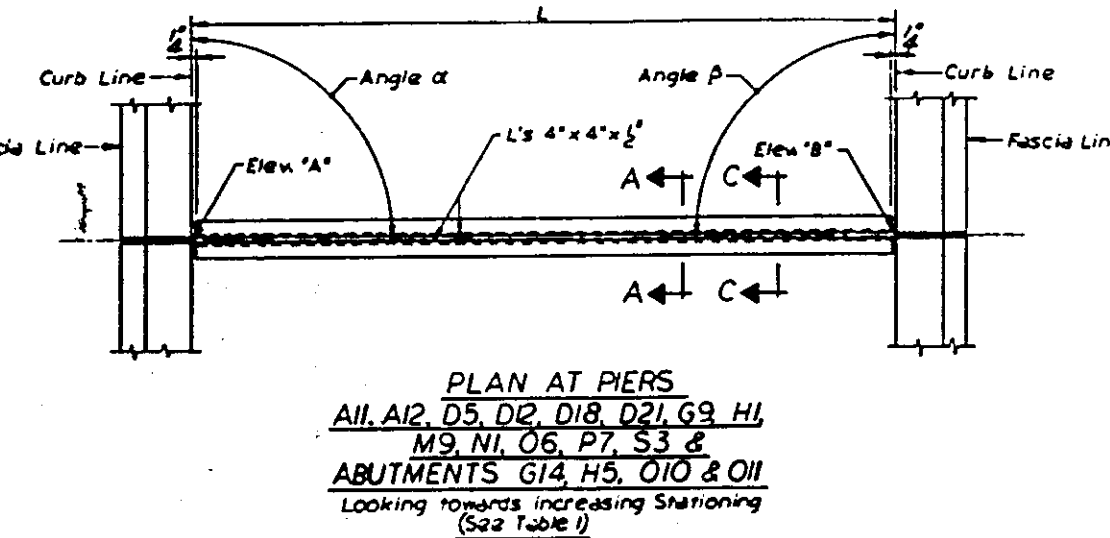


TABLE II
FOR ELEVATIONS LENGTHS ANGLES & WEIGHTS

PIER NO.	ANGLE δ	ELEV. "C"	L1	ELEV. "D"	ANGLE γ	ANGLE ϕ	ELEV. "E"	L2	ELEV. "F"	ANGLE ψ	WEIGHT
A5	95°23'07"	443.51	21-2 1/2	445.31	96°13'25"	90°00'00"	445.68	30-0	447.24	90°00'00"	1410 Lbs.
A21	94°50'36"	454.20	19-4 1/2	455.66	87°13'39"	90°00'00"	456.27	30-0	457.32	90°00'00"	1360 Lbs.
D11	90°00'00"	447.94	32-8	450.42	86°21'42"	78°59'21"	450.63	24-11 1/2	450.45	98°04'36"	1590 Lbs.
D26	97°05'15"	446.84	22-2	448.56	82°59'54"	90°00'00"	448.90	30-0	449.37	90°00'00"	1440 Lbs.
P14	107°48'41"	448.63	23-0 1/2	450.44	72°39'57"	111°54'53"	450.14	23-4 1/2	451.85	67°23'40"	1280 Lbs.
P15	113°54'37"	448.02	20-1 1/2	449.55	64°39'15"	114°43'17"	450.02	20-5 1/2	451.56	63°49'22"	1120 Lbs.

BILL OF MATERIAL

ITEM	UNIT	TOTAL
Structural Steel	Lbs.	23,140

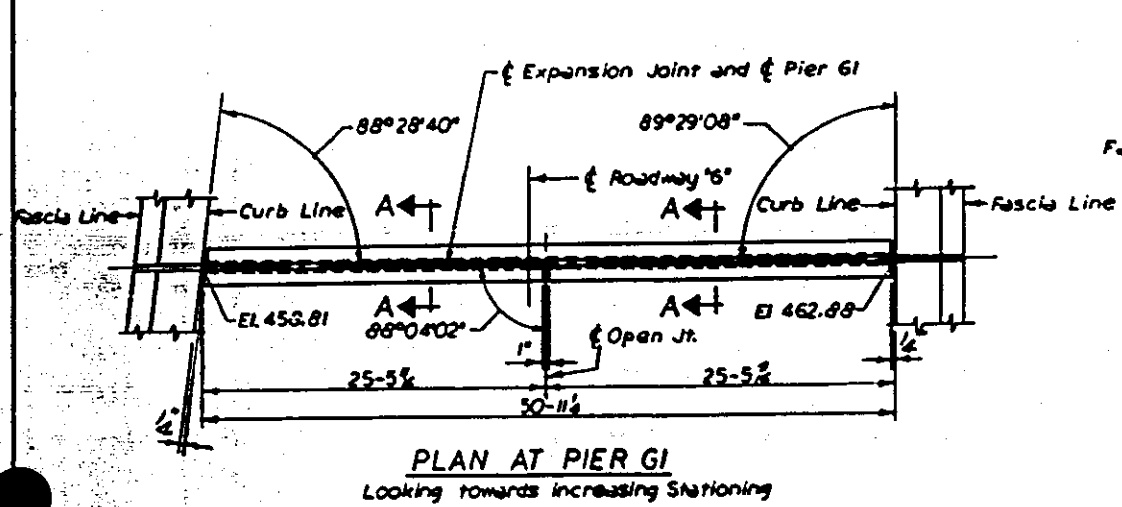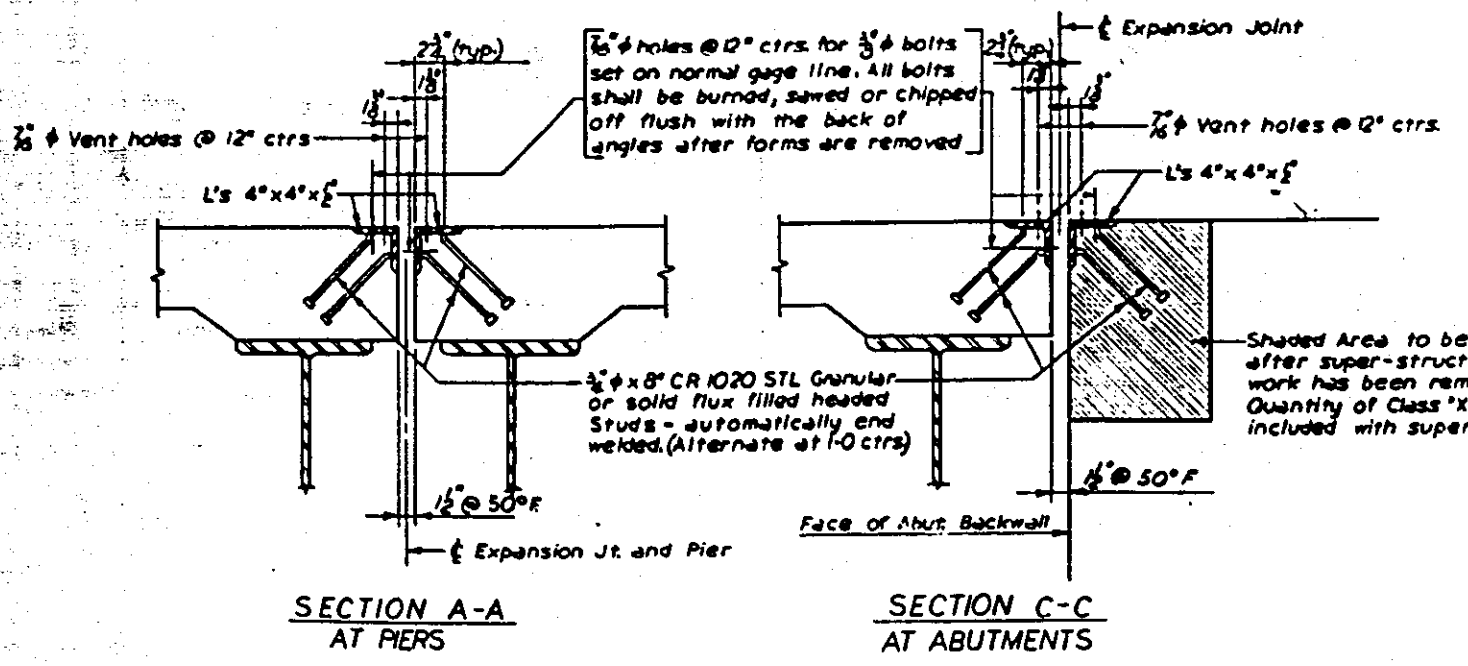

NOTE:

The Contractor for Section 82-3 HVF & E-1 will furnish all expansion devices shown on this sheet. See Special Provisions.
The Contractor for Section 82-3 HVD-1 will erect the expansion devices as shown on this sheet. See Special Provisions.

STATE OF ILLINOIS
DEPARTMENT OF PUBLIC WORKS & BLDGS.
DIVISION OF HIGHWAYS
EXPANSION DEVICES
OPEN TYPE
POPLAR STREET BRIDGE APPROACHES

F. A. I. RT. 70 ST. CLAIR CO. SECTION 82-3HVF & E-1
82-3HVD-1


N. W. LOCHNER, INC.
ENGINEERS
CHICAGO, ILLINOIS

SHEET
542 of 526


DESIGNED BY: PAS
DRAWN BY: PAS
CHECKED BY: LHW
APPROVED BY: KA

ROUTE NO.	SECTION	COUNTY	TOTAL SHEETS	SHEET NO.
F. A. I. 70	82-3HVF & E-1	ST. CLAIR	258	238
FED. ROAD DIV. NO. 4	ILLINOIS	PROJECT		


NOTE:
Stool Spacing to be adjusted to miss Stiffener and Connection Plates on Floor Beams.

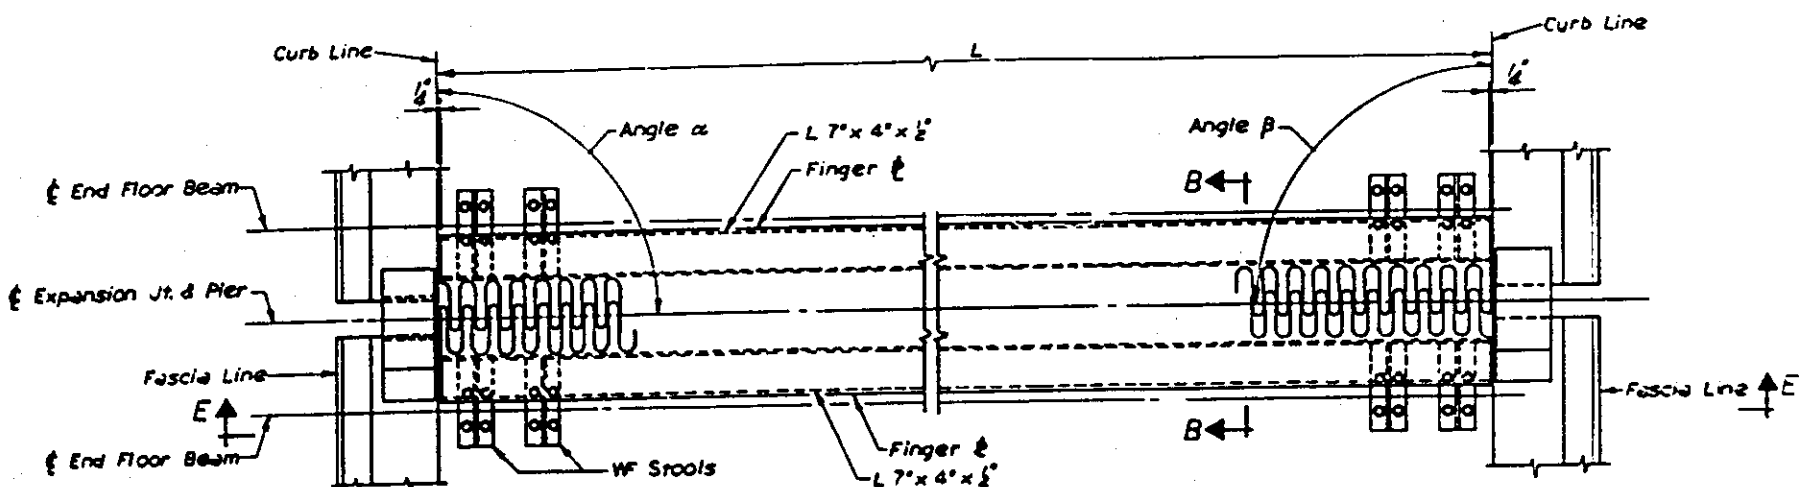


PLAN AT PIERS A8, A15, A18, D8, D15, D22, D28, D33, G5, H2, M12, N5, O3, O14, P4, P10, R3, S7 AND S18
LOOKING TOWARDS INCREASING STA.

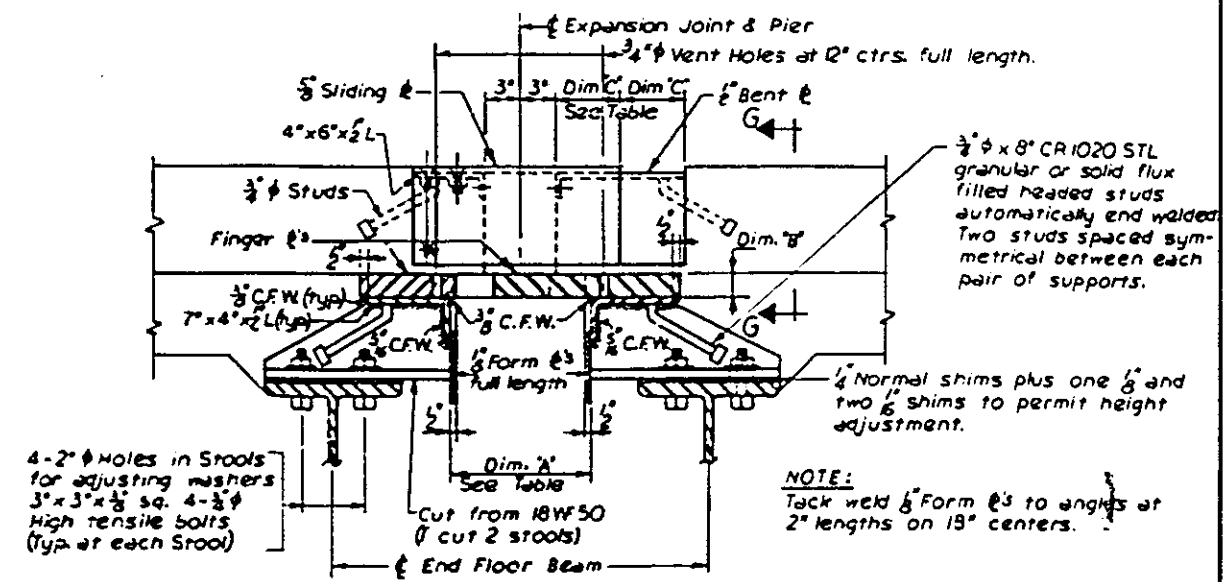


SECTION B-B

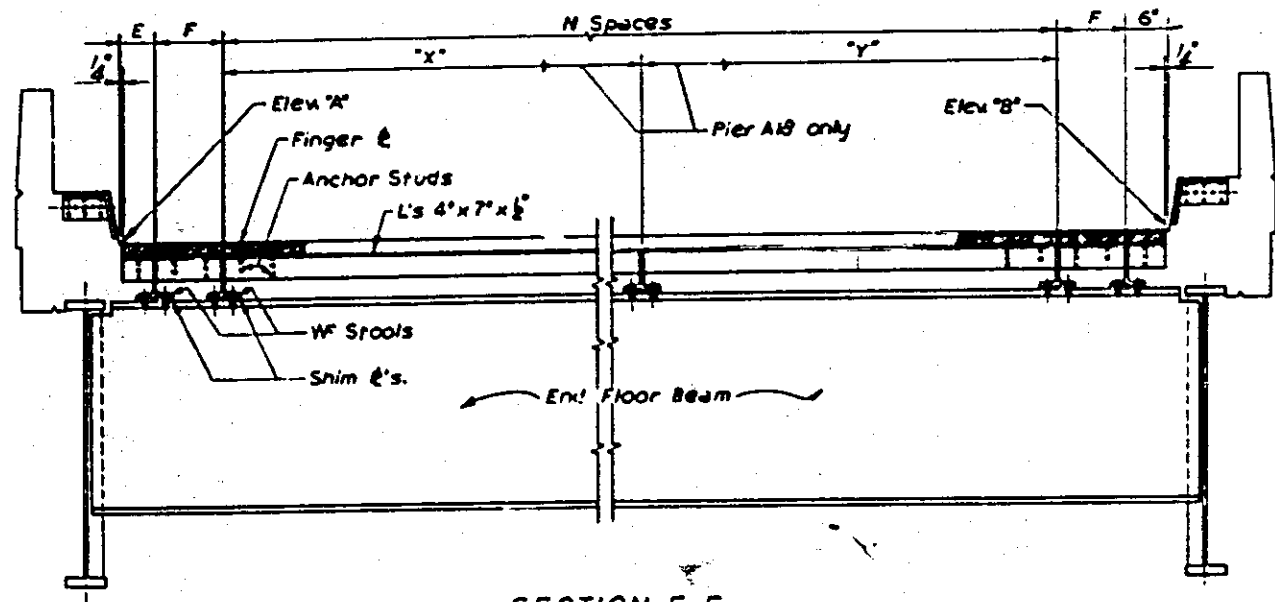

SECTION E-E

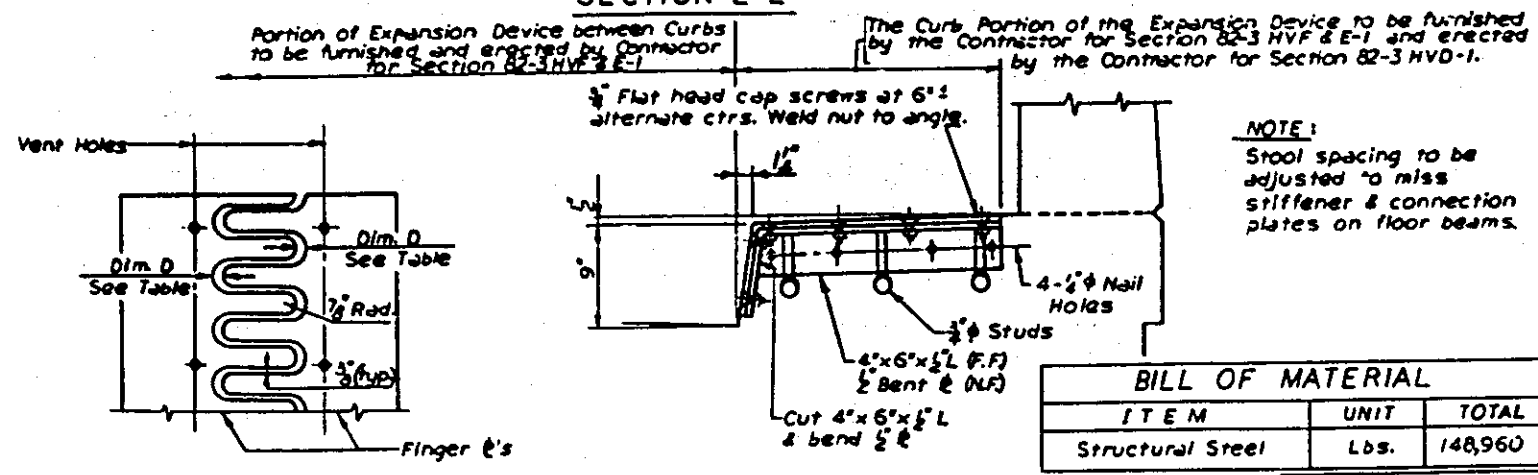

SECTION G-G

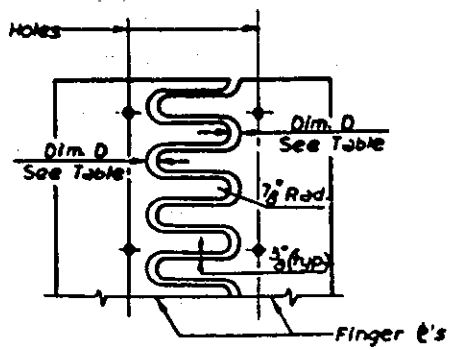

FINGER & CUTTING DETAIL

BILL OF MATERIAL		
ITEM	UNIT	TOTAL
Structural Steel	Lbs.	148,960

Temperature range -30°F. to +130°F. with +50°F. = Normal.

TABLE OF ELEVATIONS, LENGTHS, ANGLES AND WEIGHTS OF FINGER EXPANSION DEVICES

PIER NO.	ELEV. 'A'	ANGLE α	L	ANGLE β	ELEV. 'B'	E	F	N SPACES	WEIGHT
A8	426.49	50°00'00"	30'-0"	50°00'00"	428.89	6"	1'-6"	13 SPACES @ 2'-0" = 26'-0"	7920 lbs.
A15	429.64	50°00'00"	35'-0"	50°00'00"	432.44	7 1/2"	1'-9"	15 SPACES @ 2'-0" = 30'-0"	9250 lbs.
A18	430.39	50°00'00"	45'-7"	50°00'00"	433.03	8"	1'-6"	See Note 'A'	11250 lbs.
D8	427.67	50°00'00"	45'-7"	50°00'00"	427.65	1'-0"	1'-6"	21 SPACES @ 2'-0" = 42'-0"	11450 lbs.
D15	429.38	50°00'00"	30'-0"	50°00'00"	431.78	6"	1'-6"	13 SPACES @ 2'-0" = 26'-0"	7920 lbs.
D22	426.38	50°00'00"	17'-1 1/2"	50°00'00"	429.10	7 1/2"	1'-9"	17 SPACES @ 2'-0" = 34'-0"	8890 lbs.
D28	431.70	50°00'00"	15'-0"	50°00'00"	435.18	6"	1'-6"	13 SPACES @ 2'-0" = 26'-0"	8120 lbs.
D33	431.58	50°00'00"	15'-0"	50°00'00"	435.18	6"	1'-6"	13 SPACES @ 2'-0" = 26'-0"	8120 lbs.
G5	437.41	50°00'00"	14'-7"	50°00'00"	440.18	7 1/2"	1'-9"	15 SPACES @ 2'-0" = 30'-0"	10600 lbs.
H2	426.16	50°00'00"	18'-4"	50°00'00"	429.25	10 1/2"	1'-6"	17 SPACES @ 2'-0" = 34'-0"	10600 lbs.
M12	429.39	50°00'00"	22'-0"	50°00'00"	433.36	5"	1'-6"	9 SPACES @ 2'-0" = 18'-0"	6000 lbs.
N5	429.64	50°00'00"	22'-0"	50°00'00"	433.52	5"	1'-6"	9 SPACES @ 2'-0" = 18'-0"	6000 lbs.
O3	429.18	50°00'00"	22'-0"	50°00'00"	433.42	6"	1'-6"	9 SPACES @ 2'-0" = 18'-0"	6000 lbs.
O14	428.32	50°00'00"	22'-0"	50°00'00"	433.77	6"	1'-6"	9 SPACES @ 2'-0" = 18'-0"	6000 lbs.
P4	427.45	50°00'00"	22'-0"	50°00'00"	433.73	6"	1'-6"	9 SPACES @ 2'-0" = 18'-0"	5360 lbs.
P10	431.04	50°00'00"	22'-0"	50°00'00"	435.72	6"	1'-6"	9 SPACES @ 2'-0" = 18'-0"	6860 lbs.
R3	421.57	50°00'00"	22'-0"	50°00'00"	423.78	6"	1'-6"	9 SPACES @ 2'-0" = 18'-0"	5060 lbs.
S7	427.36	50°00'00"	22'-0"	50°00'00"	428.12	6"	1'-6"	9 SPACES @ 2'-0" = 18'-0"	5960 lbs.
S18	428.07	50°00'00"	22'-0"	50°00'00"	428.75	6"	1'-6"	9 SPACES @ 2'-0" = 18'-0"	6000 lbs.

NOTE 'A': For Dim. 'X' use 12 Spaces @ 1'-11" = 23'-0"; for 'Y' Dim. use 13 Spaces @ 1'-5" = 18'-5"

EXPANSION DEVICE TABLE

PIER NO.	Dimen. 'A' at 50° F.	Dimen. 'B' at 50° F.	Dimen. 'C' at 50° F.	Dimen. 'D' at 50° F.
A8	11 1/2"	1 1/2"	3 1/2"	3 1/2"
A15	12 1/2"	1 1/2"	4"	3 1/2"
A18	9 1/2"	1 1/2"	3"	2 1/2"
D8	11 1/2"	1 1/2"	3 1/2"	3 1/2"
D15	11 1/2"	1 1/2"	3 1/2"	3 1/2"
D22	12 1/2"	1 1/2"	4"	3 1/2"
D28	13"	1 1/2"	4"	3 1/2"
D33	12 1/2"	1 1/2"	4"	3 1/2"
G5	15 1/2"	2 1/2"	5"	4 1/2"
H2	9 1/2"	1 1/2"	3"	2 1/2"
M12	12 1/2"	1 1/2"	4"	3 1/2"
N5	14 1/2"	2 1/2"	4 1/2"	4 1/2"
O3	12 1/2"	1 1/2"	4"	3 1/2"
O14	12 1/2"	1 1/2"	4"	3 1/2"
P4	9 1/2"	1 1/2"	3"	2 1/2"
P10	14 1/2"	2 1/2"	4 1/2"	4 1/2"
R3	13"	1 1/2"	4"	3 1/2"
S7	11 1/2"	1 1/2"	3 1/2"	3 1/2"
S18	10"	1 1/2"	3"	2 1/2"

NOTES: The Portions of the Expansion Devices for Piers A1, D1, A25, M6, S10 & S16 that have been stored by the Contractor for Section 82-3 HVF & E-1 and erected by the Erection Contractor indicated in Section '6-6' on this sheet. See Special Provisions.
The Portions of the Expansion Devices for Piers D33, N5, O14, P4 & S18 that can be erected immediately shall be erected by the Erection Contractor indicated in Section '6-6' this Sheet. The Future portions shall be stored by the Contractor for Section 82-3HVF & E-1 until needed by the Contractors for Sections 82-3HVB-2 and 82-3HVB-3.

STATE OF ILLINOIS
DEPARTMENT OF PUBLIC WORKS & BLDGS.
DIVISION OF HIGHWAYS

EXPANSION DEVICES
FINGER PLATE

POPLAR STREET BRIDGE APPROACHES


F. A. I. R. 70 ST. CLAIR CO. SECTION 82-3HVF&E-1
82-3HVB-1

H. W. LOCHNER, INC.
ENGINEERS
CHICAGO, ILLINOIS


SHEET
363 OF 426

DESIGNED BY: R.A.S.
DRAWN BY: R.A.S.
CHECKED BY: L.H.W.
APPROVED BY: K.A.


ROUTE NO.	SECTION	COUNTY	TOTAL SHEETS	SHEET NO.
F.A.I. - 70	82-3HVB-1	ST. CLAIR	232	241
FED. ROAD DIV. NO. 4	ILLINOIS PROJECT			

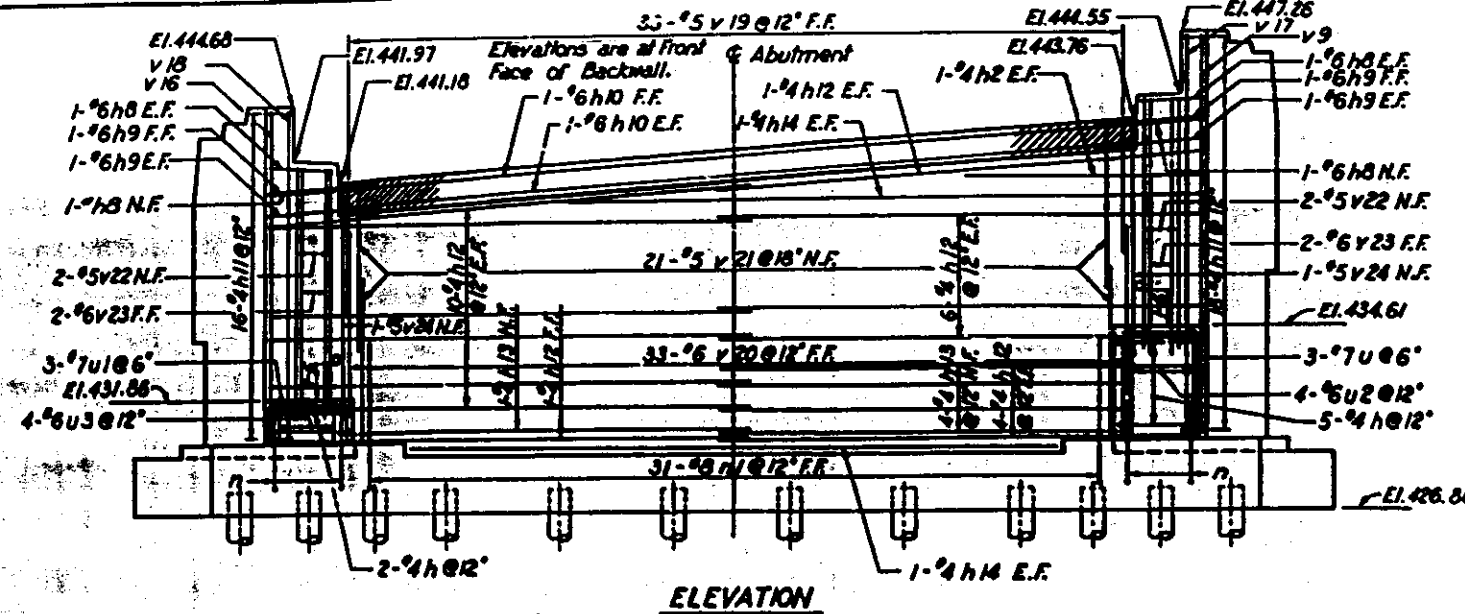

ELEVATION

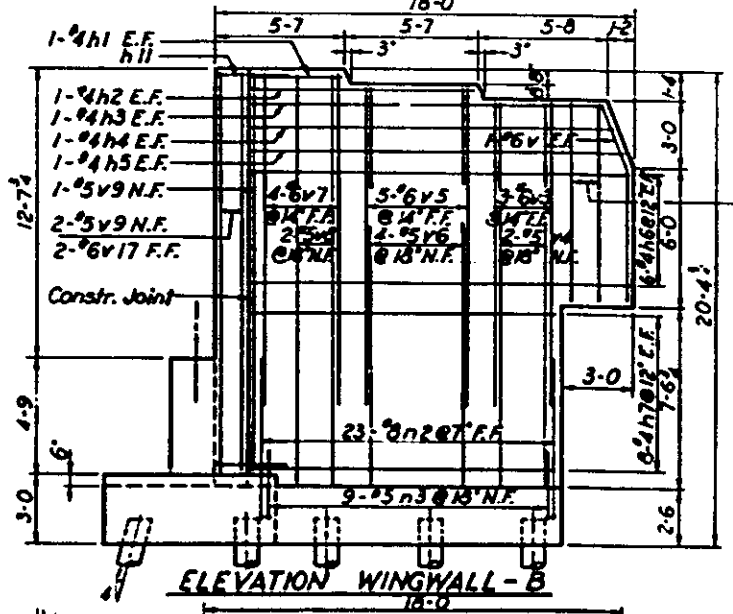

ELEVATION WINGWALL-B

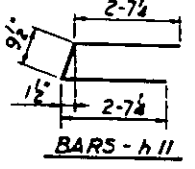

BARS - h, n, u, u2 & u3

BAR	A	B
h	3-0	3-2
n	3-10	3-0
u	4-6	3-7
u1	1-9	3-7
u2	4-6	3-0
u3	1-9	3-0

BILL OF MATERIAL

BAR NO.	SIZE	LENGTH	SHAPE
h	4	9-8	
h1	4	4-0	
h2	4	9-7	
h3	4	13-3	
h4	4	15-7	
h5	4	15-11	
h6	4	16-4	
h7	4	16-7	
h8	4	16-10	
h9	4	16-13	
h10	4	16-16	
h11	4	16-19	
h12	4	16-22	
h13	4	16-25	
h14	4	16-28	
n	4	10-8	
n1	4	7-5	
n2	4	6-2	
n3	4	3-7	
u	4	12-7	
u1	4	7-1	
u2	4	12-1	
u3	4	6-7	
v	4	9-0	
v1	4	8-10	
v2	4	8-10	
v3	4	8-6	
v4	4	14-7	
v5	4	17-2	
v6	4	14-9	
v7	4	17-10	
v8	4	17-1	
v9	4	17-10	
v10	4	10-10	
v11	4	13-11	
v12	4	11-6	
v13	4	14-7	
v14	4	16-2	
v15	4	16-3	
v16	4	14-9	
v17	4	17-4	
v18	4	14-9	
v19	4	6-0	
v20	4	7-9	
v21	4	7-1	
v22	4	11-2	
v23	4	11-2	
v24	4	11-4	
v25	4	10-4	
w	15	7-2	
w1	15	7-2	
w2	15	14-3	
w3	15	8-6	
w4	15	9-6	
w5	15	12-3	
w6	15	28-10	

BARS - n1, n2 & n3

BAR	A	B
n1	6-4	
n2	7-1	
n3	7-1	

BARS - v


BAR	A	B
v	5-11	

BARS - v19

BAR	A	B
v19	1-3/4	
	4-2	

PILE DATA


Type	Concrete
Capacity	28 T.
Est. length	50 Ft.
No. Req'd	53 #
Test Piles	1

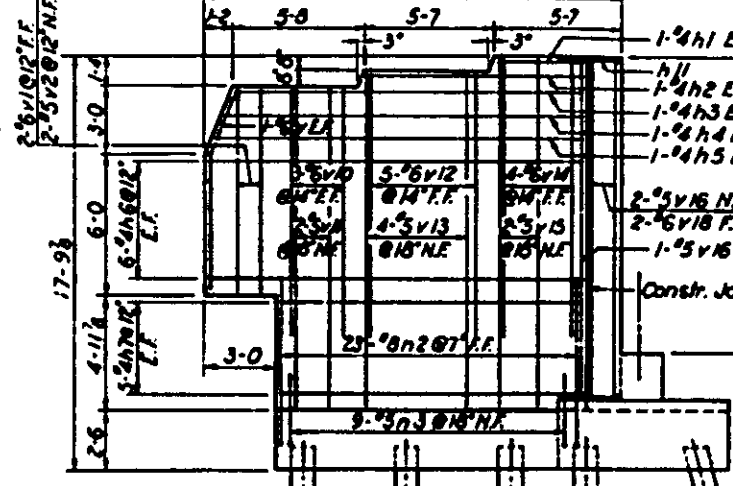


ELEVATION WINGWALL-A

Hatched area to be poured after superstructure false work has been removed. Class 'X' concrete included with superstructure.


* Does not include test pile. For Expansion Device Details, see Sh. No. 352 (Not Applicable to 82-3HVB-1)

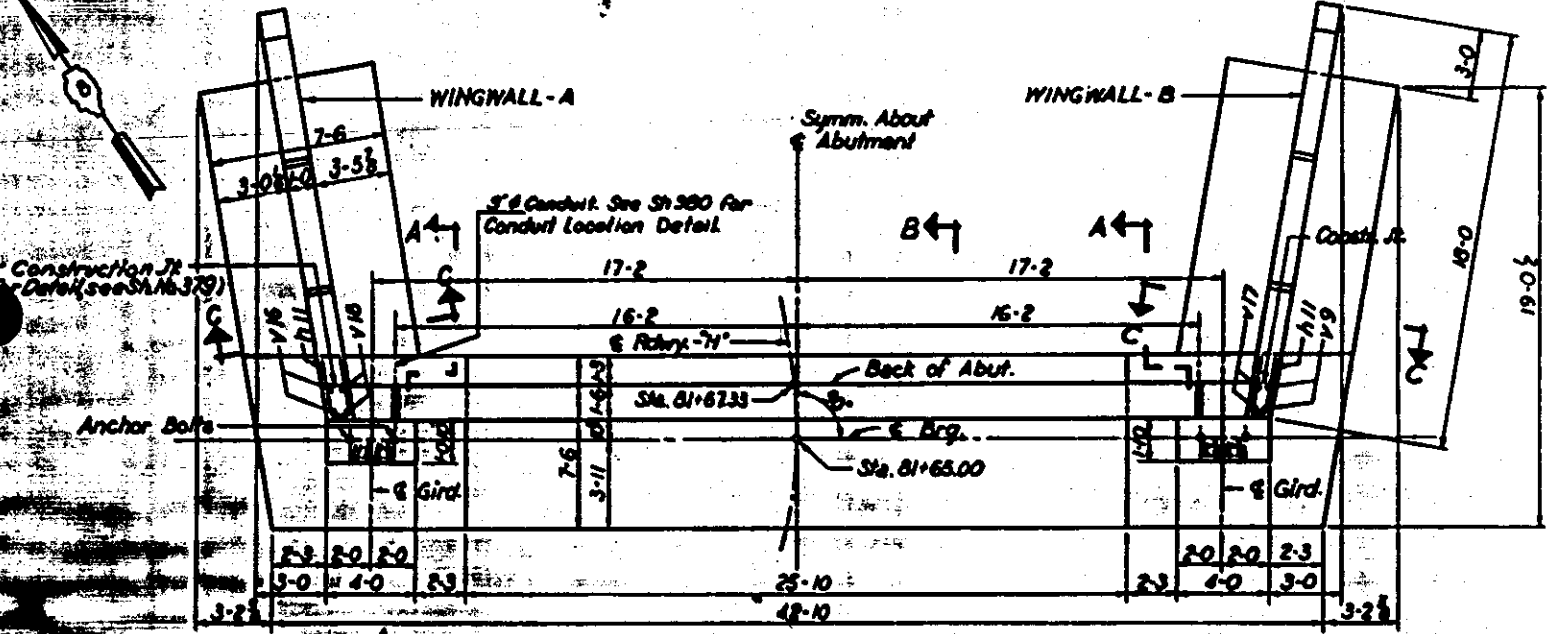

TOP VIEW

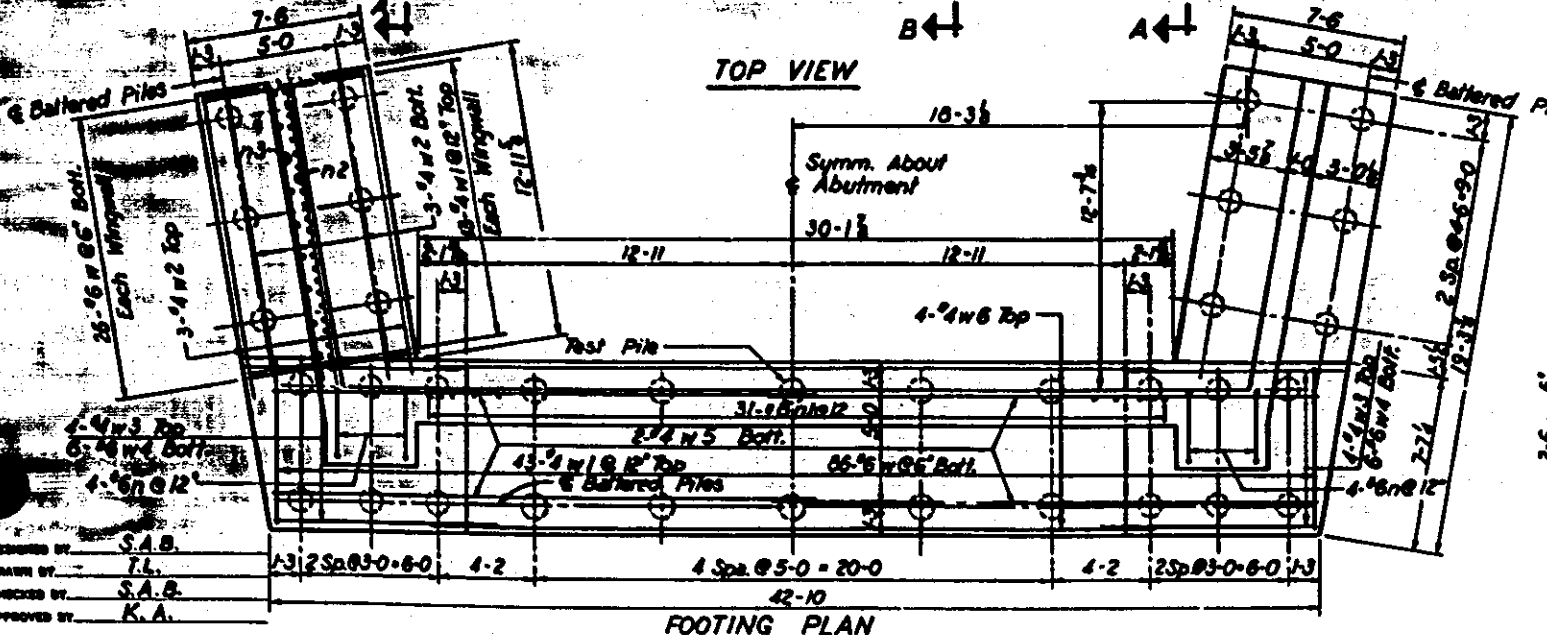

FOOTING PLAN

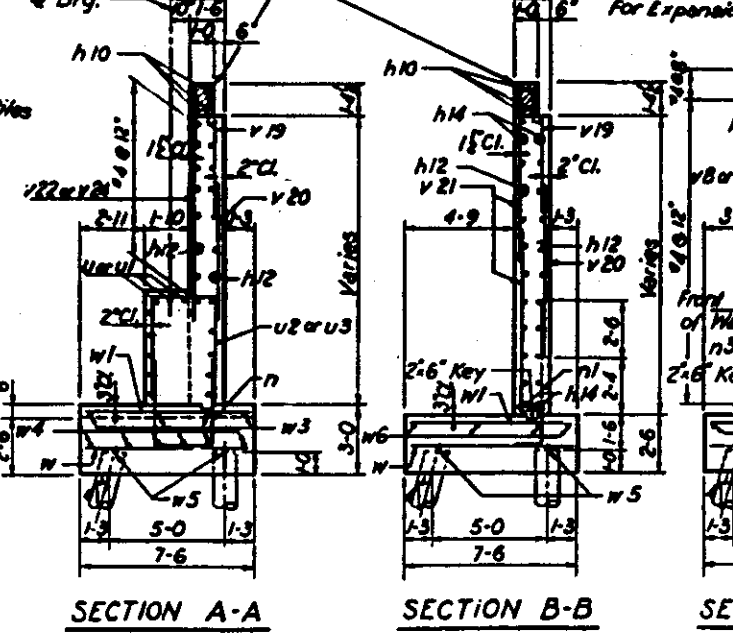

SECTION A-A

SECTION B-B

SECTION C-C

STATE OF ILLINOIS
DEPARTMENT OF PUBLIC WORKS & BLDGS.
DIVISION OF HIGHWAYS

ABUTMENT H5
POPLAR STREET BRIDGE APPROACHES
ROADWAY "H"

F.A.I. RT. 70 ST. CLAIR CO. SECTION 82-3HVB-1
H. W. LOCHNER, INC.
ENGINEERS
CHICAGO, ILLINOIS

DESIGNED BY S.A.B.
DRAWN BY T.L.
CHECKED BY S.A.B.
APPROVED BY K.A.

SHEET 241

STATE OF ILLINOIS
DEPARTMENT OF PUBLIC WORKS AND BUILDINGS

DIVISION OF HIGHWAYS
PLANS FOR PROPOSED
FEDERAL AID HIGHWAY

F. A. I. ROUTE 70 SECTION 82-3HVF&E-1
PROJECT I-IG-70-1(81)0
POPLAR STREET BRIDGE APPROACHES
ST. CLAIR COUNTY

C-98-032-65

ROUTE NO.	SECTION	COUNTY	TOTAL SHEETS	SHEET NO.
F. A. I. - 70	82-3HVF&E-1	ST. CLAIR	247	1
FED. ROAD DIV. NO. 4	ILLINOIS	PROJECT	I-IG-70-1(81)0	

P-98-087-00

DESCRIPTION OF PROJECT:

SECTION 82-3HVF & E-1 INCLUDES THE FURNISHING, FABRICATING AND ERECTING OF THE STRUCTURAL STEEL FOR THE FOLLOWING:


ROADWAY A	TWO 4-SPAN CONTINUOUS UNITS SPANS: 1 EACH @ 83'-5 5/8", 106'-106'-83", 87'-110'-110'-87'
	FIVE 3-SPAN CONTINUOUS UNITS SPANS: 2 @ 97'-124'-97' 1 EACH @ 75'-96'-75' 95'-122'-95' 89'-114'-89'
	ONE SIMPLE SPAN - 80'
ROADWAY D	TWO 4-SPAN CONTINUOUS UNIT SPANS: 1 @ 90'-7 9/16", 115'-115'-90' 1 @ 100'-128'-128'-100'
	ONE 3-SPAN CONTINUOUS UNIT SPANS: 107'-137'-137'-137'-107'
	FIVE 3-SPAN CONTINUOUS UNITS SPANS: 2 @ 83'-108'-83' 2 @ 81'-105'-81' 1 @ 90'-115'-90'
	ONE 2-SPAN CONTINUOUS UNIT SPANS: 89'-6", 89'-6"
	TWO SIMPLE SPANS SPANS: 1 @ 74' 1 @ 78'
ROADWAY G	TWO 4-SPAN CONTINUOUS UNITS SPANS: 1 @ 88'-113'-113'-88' 1 @ 87'-118'-118'-87'
	ONE 3-SPAN CONTINUOUS UNIT SPANS: 90'-116'-90'
	ONE 2-SPAN CONTINUOUS UNIT SPANS: 74'-74'
ROADWAY H	ONE 3-SPAN CONTINUOUS UNIT SPAN: 97'-124'-97'
	ONE SIMPLE SPAN - 88'
RAMP M	THREE 3-SPAN CONTINUOUS UNITS SPANS: 1 @ 98'-115'-98' 1 @ 108'-134'-108' 1 @ 98'-115'-85-18 11/16
RAMP N	ONE 4-SPAN CONTINUOUS UNIT SPANS: 90'-115'-115'-90'
	ONE SIMPLE SPAN - 73-3 5/16
RAMP O	FOUR 3-SPAN CONTINUOUS UNIT SPANS: 1 @ 97'-5 3/4", 130'-101' 1 @ 90'-115'-90' 1 @ 95'-121'-95' 1 @ 94'-120'-94'
	ONE SIMPLE SPAN - 65'
RAMP P	ONE 4-SPAN CONTINUOUS UNIT SPANS: 94'-121'-121'-94'
	TWO 3-SPAN CONTINUOUS UNIT SPANS: 1 @ 81'-115'-81' 1 @ 94'-122'-94'
	TWO SIMPLE SPANS 1 @ 88' 1 @ 49'

RAMP Q	ONE 3-SPAN CONTINUOUS UNIT SPANS: 75-2 7/8", 98'-76'
RAMP R	TWO 3-SPAN CONTINUOUS UNITS SPANS: 1 @ 104-4 5/16", 134'-104' 1 @ 101'-130'-101'
RAMP S	ONE 4-SPAN CONTINUOUS UNIT SPANS: 85'-100'-100'-85'
	THREE 3-SPAN CONTINUOUS UNIT SPANS: 1 @ 73-2 7/8", 95'-74' 1 @ 69'-97'-69' 1 @ 84'-113'-84'

THE POPLAR STREET BRIDGE APPROACHES FOR THIS SECTION CARRY THE FOLLOWING:

- ROADWAY A OVER THE TRACKS OF THE TERMINAL R. R. ASSOCIATION, GULF, MOBILE AND OHIO, AND ILLINOIS CENTRAL RAILROADS AND RAMP Q;
- ROADWAY D OVER THE TRACKS OF THE TERMINAL R. R. ASSOCIATION, GULF, MOBILE AND OHIO, ILLINOIS CENTRAL AND SOUTHERN RAILROADS, RAMP O AND ILLINOIS ROUTE 11;
- ROADWAY G OVER TRENDLEY AND POCOTT AVENUES;
- ROADWAY H OVER THE ILLINOIS CENTRAL RAILROAD;
- RAMP M OVER ROADWAY A AND THE TRACKS OF THE TERMINAL R. R. ASSOCIATION AND THE GULF, MOBILE AND OHIO RAILROADS;
- RAMP N OVER THE TRACKS OF THE TERMINAL R. R. ASSOCIATION AND GULF, MOBILE AND OHIO RAILROADS;
- RAMP O OVER THE ILLINOIS CENTRAL RAILROAD;
- RAMP P OVER ROADWAY D, FUTURE ACCESS ROADS AND THE ILLINOIS CENTRAL RAILROAD;
- RAMP Q OVER THE ILLINOIS CENTRAL RAILROAD;
- RAMP R OVER THE ILLINOIS CENTRAL RAILROAD AND A FUTURE ACCESS ROAD;
- RAMP S OVER TRENDLEY AVENUE AND ROADWAY H.


THE SPANS DESCRIBED ABOVE INCLUDE THIRTY-NINE (39) CONTINUOUS UNITS AND EIGHT (8) SIMPLE SPANS. THE CONTINUOUS UNITS INCLUDE THIRTY-SIX (36) FULLY OR PARTIALLY CURVED AND THREE NON-CURVED WELDED PLATE GIRDERS WITH ROLLED AND WELDED PLATE FLOORDECKS AND ROLLED STRINGERS. THE SIMPLE SPANS ARE ALL COMPOSITE WF.

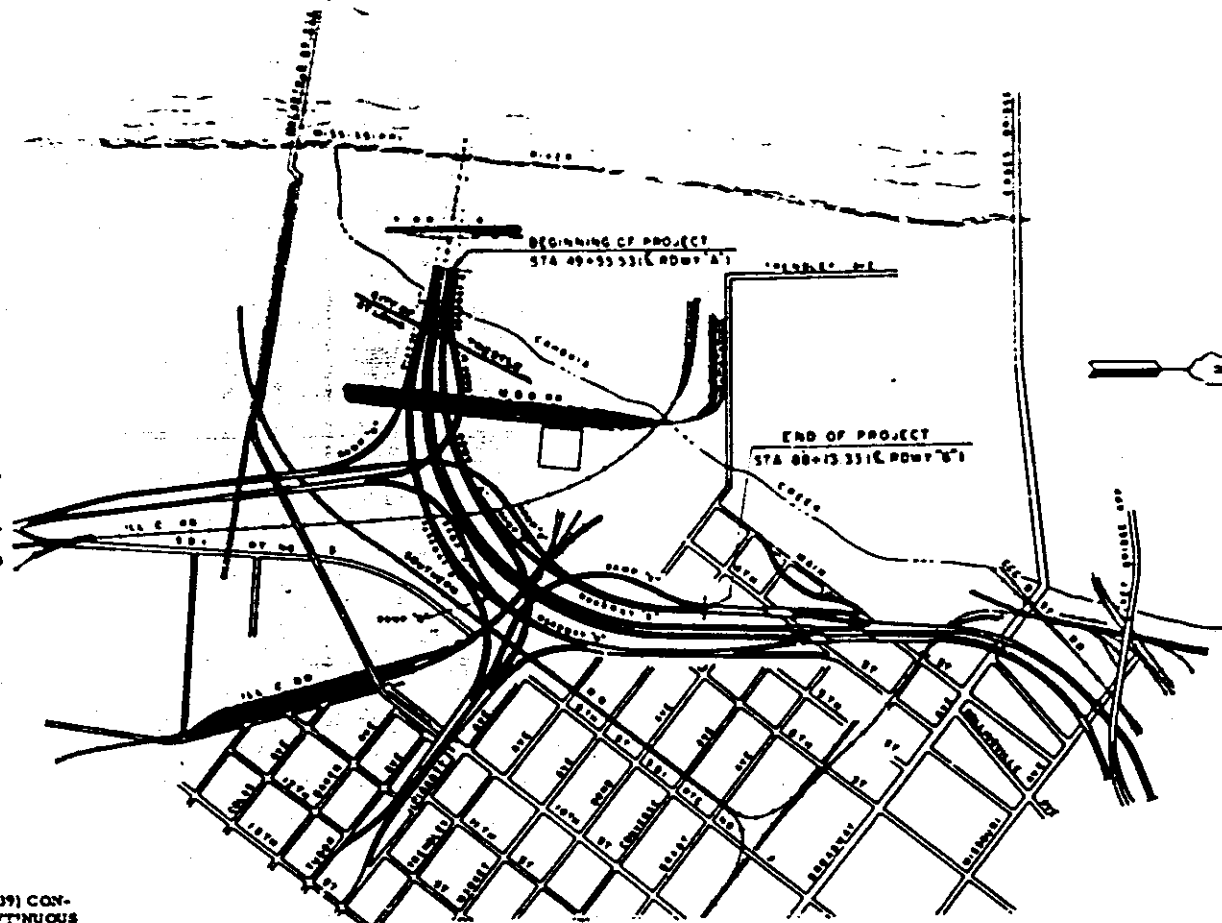

CITY OF EAST ST. LOUIS

LOCATION PLAN

LENGTH OF PROJECT
4261.16 FT. = .807 MILES

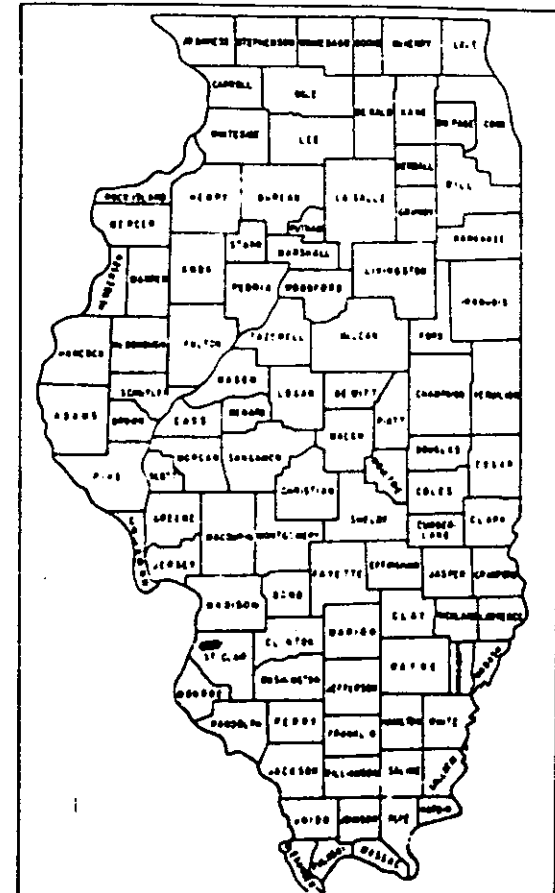

LOCATION OF SECTION INDICATED THIS: [Symbol]

APPROVED

[Signature]

STATE OF ILLINOIS DEPARTMENT OF PUBLIC WORKS AND BUILDINGS DIVISION OF HIGHWAYS
11-30-66 Robert E. Kramt
12-20-66 William A. Quall
12-20-66 W. E. Blum
12-20-66 [Signature]
12-20-66 [Signature]

8-64

DEPARTMENT OF COMMERCE BUREAU OF PUBLIC ROADS
APPROVED
DIVISION ENGINEER DATE

H. W. LOCHNER, INC.
ENGINEERS
CHICAGO, ILLINOIS

2257

[Signature]
Aug. 22, 1965

Contract No. 24962

ST. CLAIR COUNTY SECTION 82-3HVF&E-1 F. A. I. ROUTE 70 PROJECT I-IG-70-1(81)0

082-0256

ROUTE NO.	SECTION	COUNTY	TOTAL SHEETS	SHEET NO.
F. A. I. 70	82-3HVFBE-1	ST. CLAIR	247	1
FED. ROAD DIV. NO. 4		ILLINOIS	PROJECT	

INDEX OF SHEETS
SECTION 82-3 HVF & E-1

SHEET NO.	TITLE
1	TITLE SHEET
2	INDEX OF SHEETS, SUMMARY OF QUANTITIES, GENERAL NOTES
3 AND 4	PLAN OF EXISTING CONDITIONS AND UTILITIES
5 THRU 9	RIGHT OF WAY PLANS (FOR INFORMATION ONLY)
10	LIST OF BENCH MARKS, TIES TO TRAVERSE LINE AND GENERAL PLAN OF TRAVERSE LINE
11 THRU 15	ALIGNMENT PLANS
16 THRU 18	LIST OF COORDINATE POINTS AND DESCRIPTIONS
19	KEY PLAN, GENERAL NOTES AND BILL OF MATERIAL
20 THRU 24	GENERAL PLANS
25 THRU 43	PLAN AND ELEVATION
44 THRU 52	GEOMETRIC LAYOUTS
53 THRU 234	FRAMING PLANS AND STEEL DETAILS
235 THRU 245	STRESS TABLES
246	BEARING ELEVATIONS
247	STANDARDS 1646-3 AND 2176-1
	STANDARD 2110

SUMMARY OF QUANTITIES

SECTION 82-3HVF & E-1

CODE NO.	ITEM	UNIT	TOTAL QUANTITY
20390	ENGINEER'S FIELD OFFICE TYPE "A"	EACH	1
20065	RAILROAD PROTECTIVE SERVICES	L. SUM	1
054001	FURNISHING AND ERECTING STRUCTURAL STEEL	POUND	17,674,325
ZD023	BRIDGE SEAT SEALANT	L. SUM	1

GENERAL NOTES

THE STANDARD SPECIFICATIONS FOR ROAD AND BRIDGE CONSTRUCTION ADOPTED JANUARY 2, 1950, THE SUPPLEMENTAL SPECIFICATIONS FOR HIGHWAY CONSTRUCTION EFFECTIVE MARCH 11, 1963 AND THE SUPPLEMENTAL SPECIFICATIONS EFFECTIVE JANUARY 3, 1966.

ALL ELEVATIONS REFER TO U. S. C. S. MEAN SEA LEVEL DATUM.

THE PROFILE GRADE LINE REFERS TO THE GRADE ELEVATION AT THE POINT SHOWN ON THE TYPICAL SECTIONS AND PLANS.

POSITIVE PROFILE GRADES ARE IN THE DIRECTION OF TRAFFIC AND HIGHER ELEVATIONS.

NEGATIVE PROFILE GRADES ARE IN THE DIRECTION OF TRAFFIC AND LOWER ELEVATIONS.

THE FOLLOWING UTILITY COMPANIES HAVE FACILITIES WITHIN THE LIMITS OF CONSTRUCTION WHICH MAY REQUIRE ADJUSTMENTS:

EAST ST. LOUIS AND INTERURBAN WATER COMPANY
ILLINOIS POWER COMPANY
SOUTHWESTERN BELL TELEPHONE COMPANY
UNION ELECTRIC COMPANY
WESTERN UNION TELEGRAPH COMPANY

Weight of flange shear connectors is not included in quantity of structural steel
Cost of furnishing and placing flange shear connectors is included in section 82-3HVD-1

IG PORTION : 12.1%
I PORTION : 57.9%

STATE OF ILLINOIS
DEPARTMENT OF PUBLIC WORKS & BLDGS.
DIVISION OF HIGHWAYS


INDEX OF SHEETS
SUMMARY OF QUANTITIES
GENERAL NOTES

F. A. I. RT. 70 ST. CLAIR CO. SECTION 82-3HVFBE-1
M. W. LOCHNER, INC.
ENGINEERS
CHICAGO, ILLINOIS


SHEET
OF

ROUTE NO	SECTION	COUNTY	TOTAL SHEETS	SHEET NO
F.A.I. 70	82-SHW-1	ST. CLAIR	247	53
FED. ROAD DIV NO 4	ILLINOIS	PROJECT		


Direction of Traffic

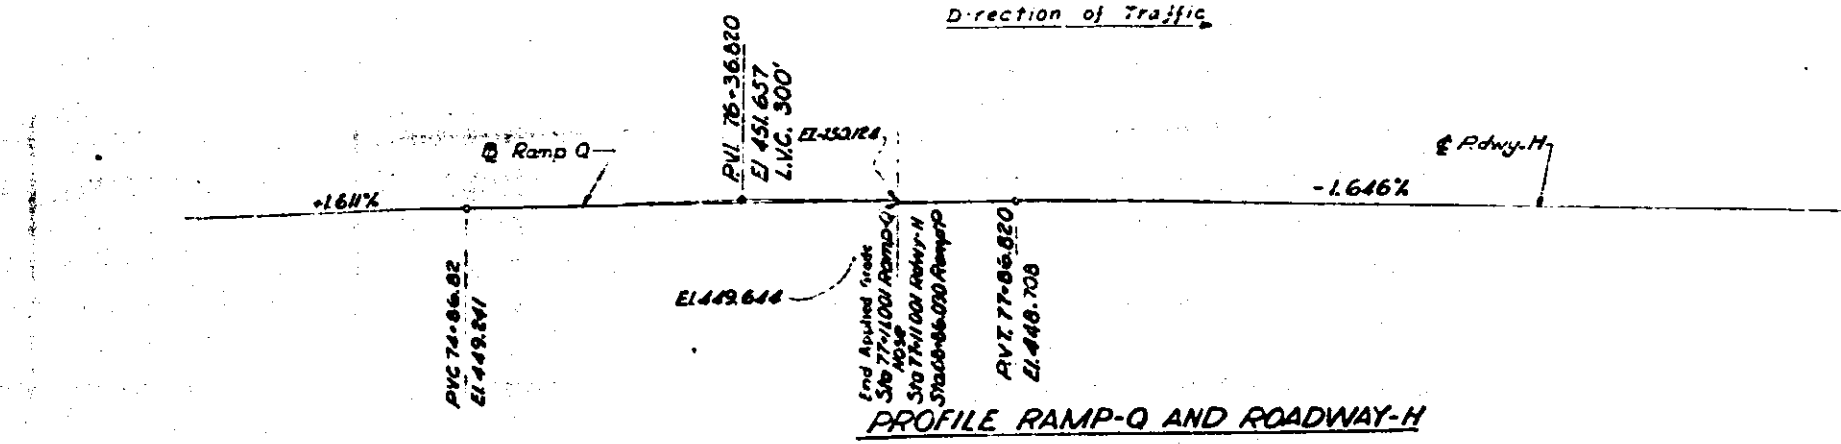

PROFILE RAMP-Q AND ROADWAY-H

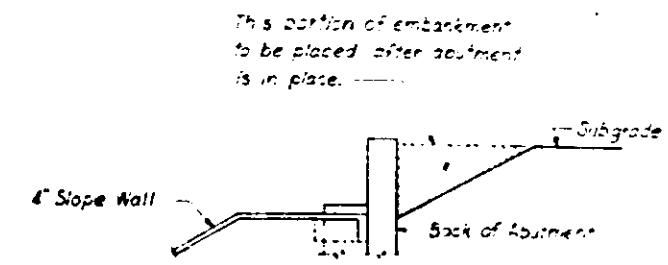


SECTION A-A

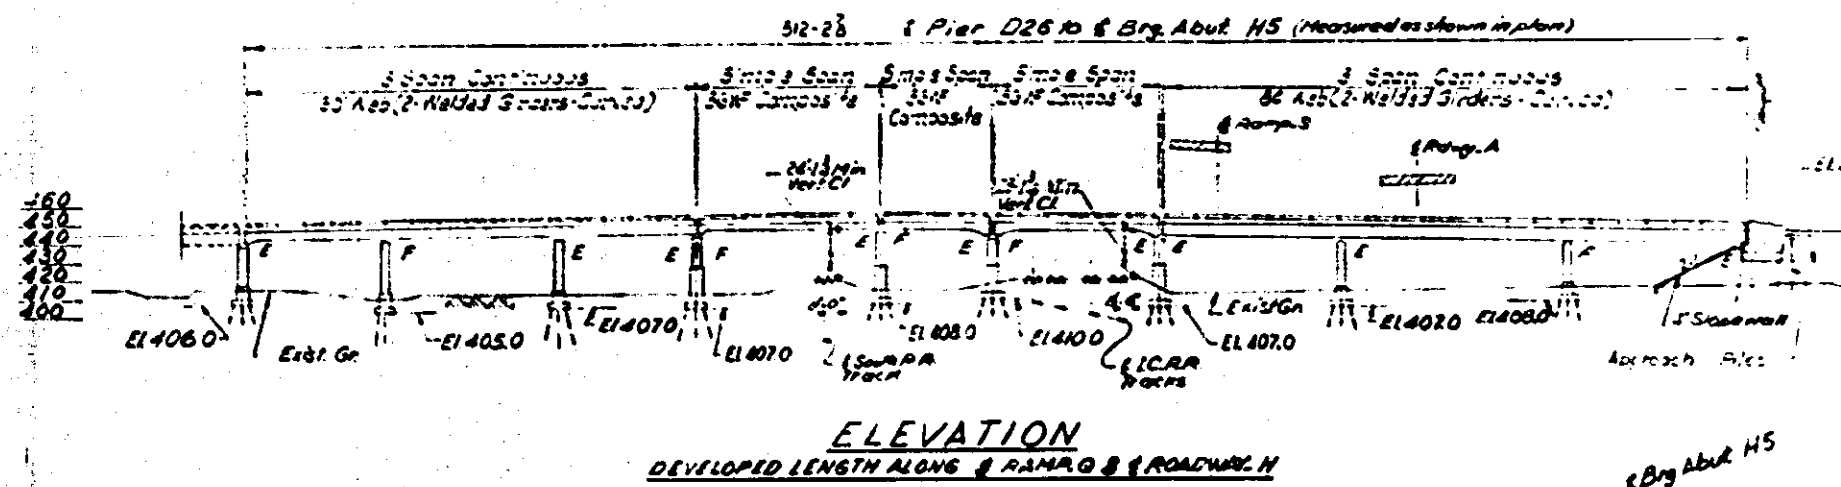


ELEVATION DEVELOPED LENGTH ALONG RAMP Q & ROADWAY H


Created Approach Piles
Number Required - 6
Estimated Length - 25'
See Special Provisions

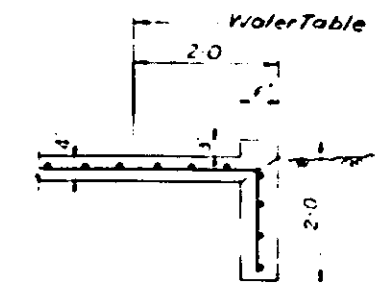

SECTION B-B

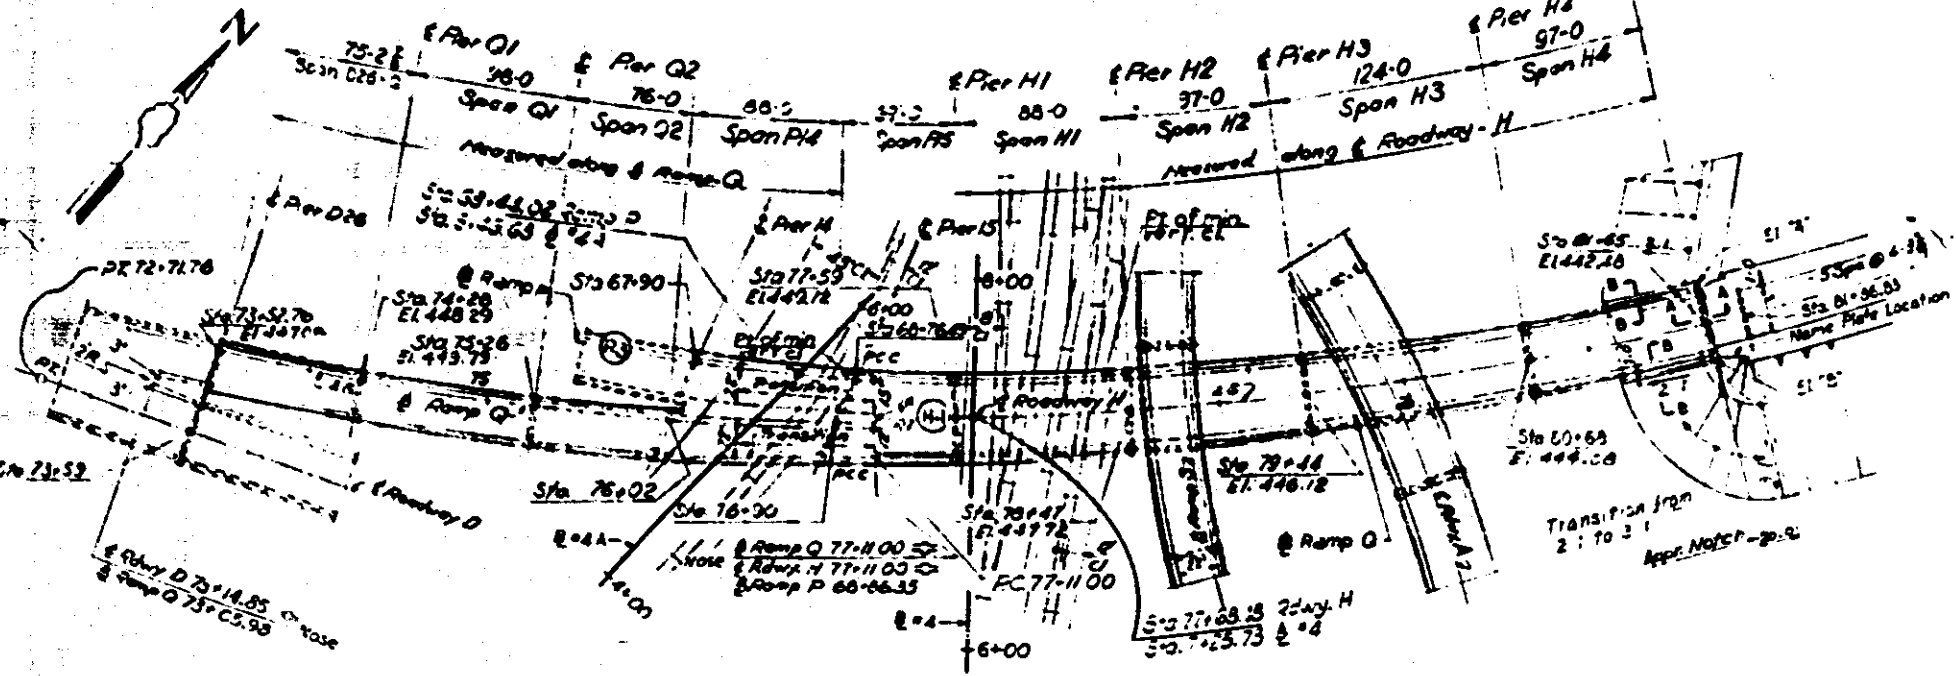

PLAN

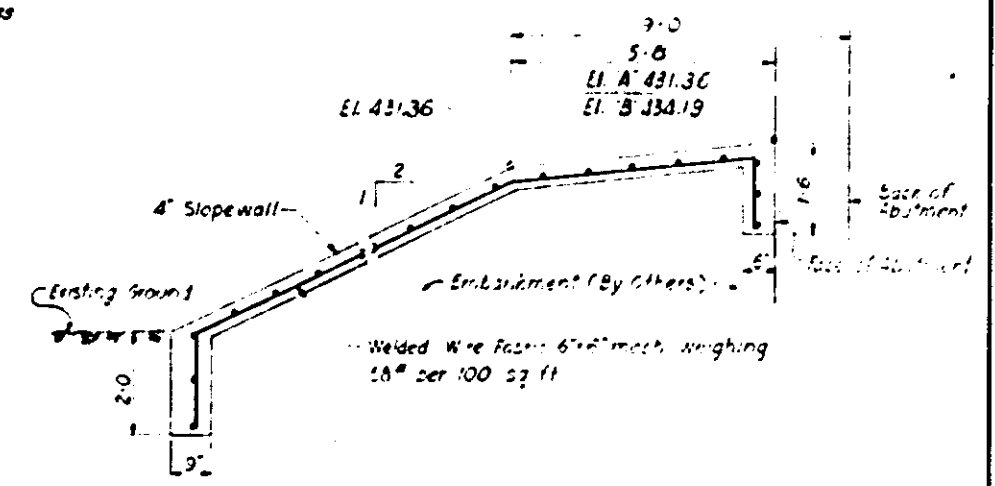

TYPICAL CROSS SECTION OF SLOPE WALL

BILL OF MATERIAL		
Item	Unit	Quantity
Slope Wall 4'	S.Y.	282
Name Plate	Ea.	1
Embankment	C.Y.	100

STATE OF ILLINOIS
DEPARTMENT OF PUBLIC WORKS & BLDGS.
DIVISION OF HIGHWAYS
PLAN AND ELEVATION
SPANS D26-0, 01, 02, P14, P15, M1THRU H4
POPLAR STREET BRIDGE APPROACHES
ROADWAY "H" AND RAMP "Q"

SECTIONS 82-SHW-1
82-SHW-2-1
82-SHW-3-1

F.A.I. RT. 70 ST. CLAIR CO
H. W. LOCHNER, INC.
ENGINEERS
CHICAGO ILLINOIS

SHEET 53 OF 244

DESIGNED BY J.J.N.
DRAWN BY S.A.B.
CHECKED BY R.V.R.
APPROVED BY K.A.

ROUTE NO.	SECTION	COUNTY	TOTAL SHEETS	SHEET NO.
F.A.I. 70	82-3HVFE-1	ST. CLAIR	247	19
FED ROAD DIV NO 4	ILLINOIS	PROJECT		

Curve P2


P.I. Sta 55+81.46
 Δ = 65°23'55"
 C = 5°11'06"
 R = 700.00'
 L = 798.33'
 T = 449.36'
 E = 131.83'

Curve P3

P.I. Sta 67+35.03
 Δ = 21°04'41"
 C = 7°01'15"
 R = 216.00'
 L = 300.00'
 T = 151.76'
 E = 13.99'

Curve P4

P.I. Sta 71+34.70
 Δ = 35°09'55"
 C = 3°10'59"
 R = 1,000.00'
 L = 1,199.00'
 T = 622.70'
 E = 104.67'

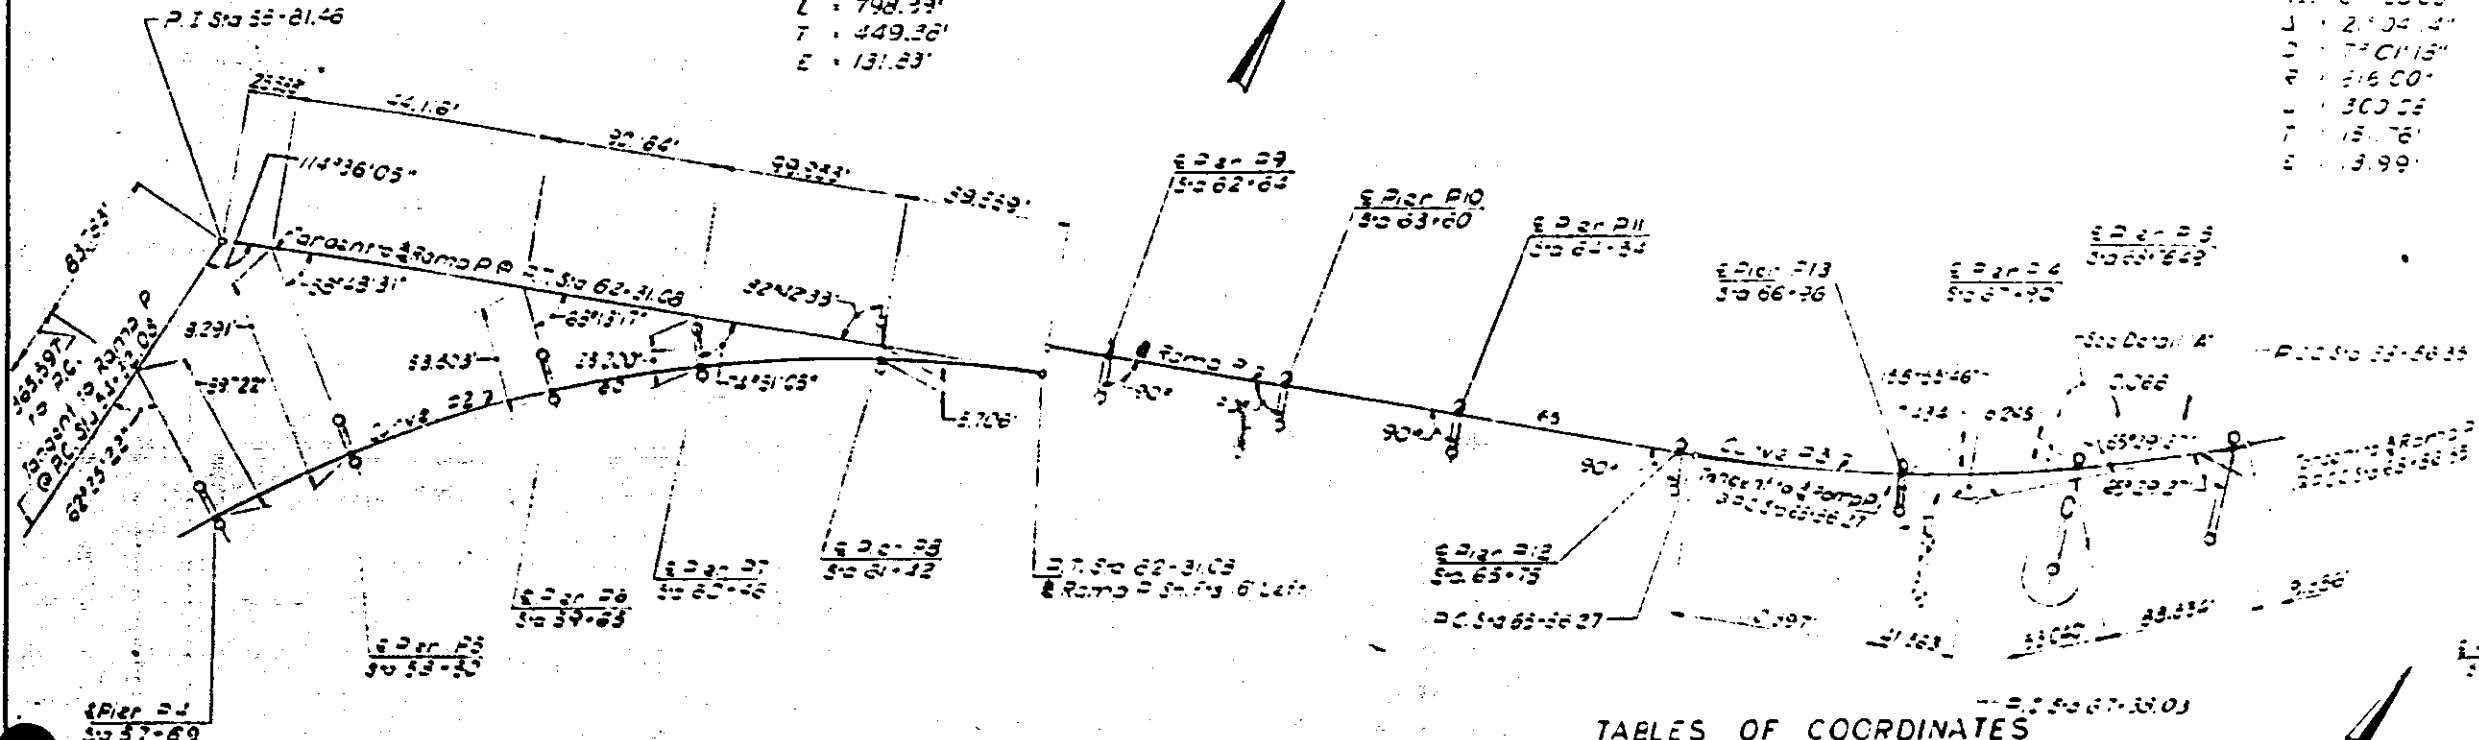

TABLES OF COORDINATES



Pier No.	Ramp 5		Azimuth	Right-of-Way Offset	Left-of-Way Offset	
	Sta.	N. Coordinate				E. Coordinate
P4	57+69	3704.826	32408.524	22°02'24"	4-0	20-0
P5	58+50	3770.743	32455.501	28°42'12"	4-0	20-0
P6	59+65	3854.053	32534.257	38°12'54"	4-0	20-0
P7	60+46	3954.814	32679.970	44°50'46"	4-0	20-0
P8	61+42	3954.141	32679.920	152°42'14"	4-0	20-0
P9	62+63	3956.429	32787.002	59°53'01"	20-0	4-0
P10	63+60	3958.391	32877.210	59°59'41"	20-0	4-0
P11	64+54	3981.429	32965.338	59°59'41"	20-0	4-0
P12	65+75	3922.542	33079.237	59°59'41"	20-0	4-0
P13	68+36	3170.748	33900.026	32°17'24"	20-0	4-0
P14	67+90	3299.149	33270.626	63°16'50"	52-0	4-3
P15	68+76-9	3271.325	33359.354	163°16'00"	45-4	3-4

Pier No.	Roadway H		Azimuth	Right-of-Way Offset	Left-of-Way Offset	
	Sta.	N. Coordinate				E. Coordinate
H1	77+59	3296.993	33193.915	36°34'31"	21-4	21-4
H2	73+27	3359.004	33456.369	133°48'11"	20-2	20-2
H3	79+24	3430.767	33521.613	130°44'13"	19-0	19-0
H4	80+68	3527.394	33599.287	25°50'23"	17-0	17-0
Right-of-Way H5	81+65	3606.337	33655.351	123°37'07"	17-1	17-2

Pier No.	Ramp 3		Azimuth	Right-of-Way Offset	Left-of-Way Offset	
	Sta.	N. Coordinate				E. Coordinate
R1	74+28	3048.241	3339.097	147°05'41"	20-0	4-0
R2	73+26	3143.701	33218.536	143°55'35"	20-0	4-0

Curve H1



P.I. Sta 73+89.2
 Δ = 36°57'31"
 C = 3°09'01"
 R = 1,013.76'
 L = 1,173.19'
 T = 607.32'
 E = 93.83'

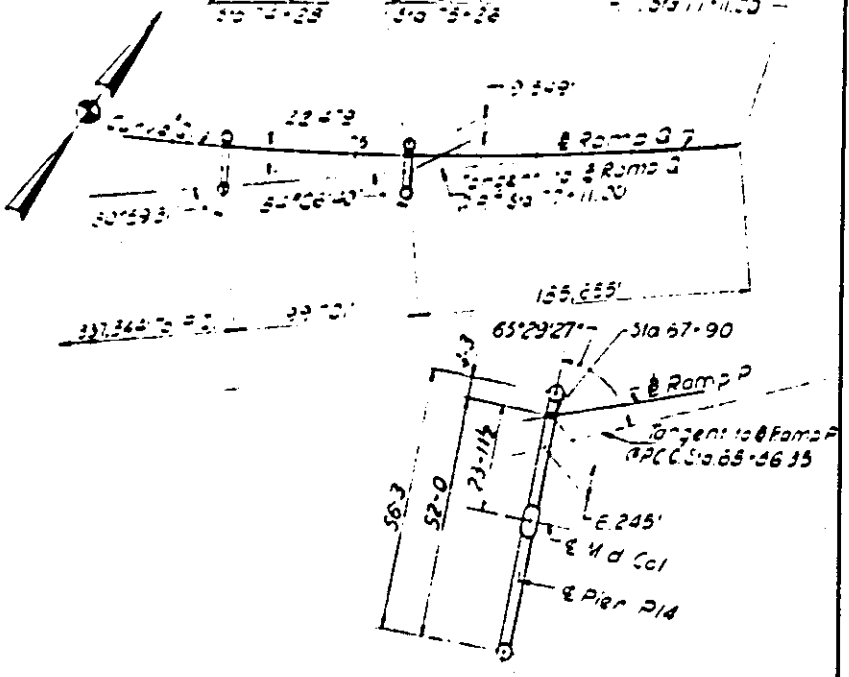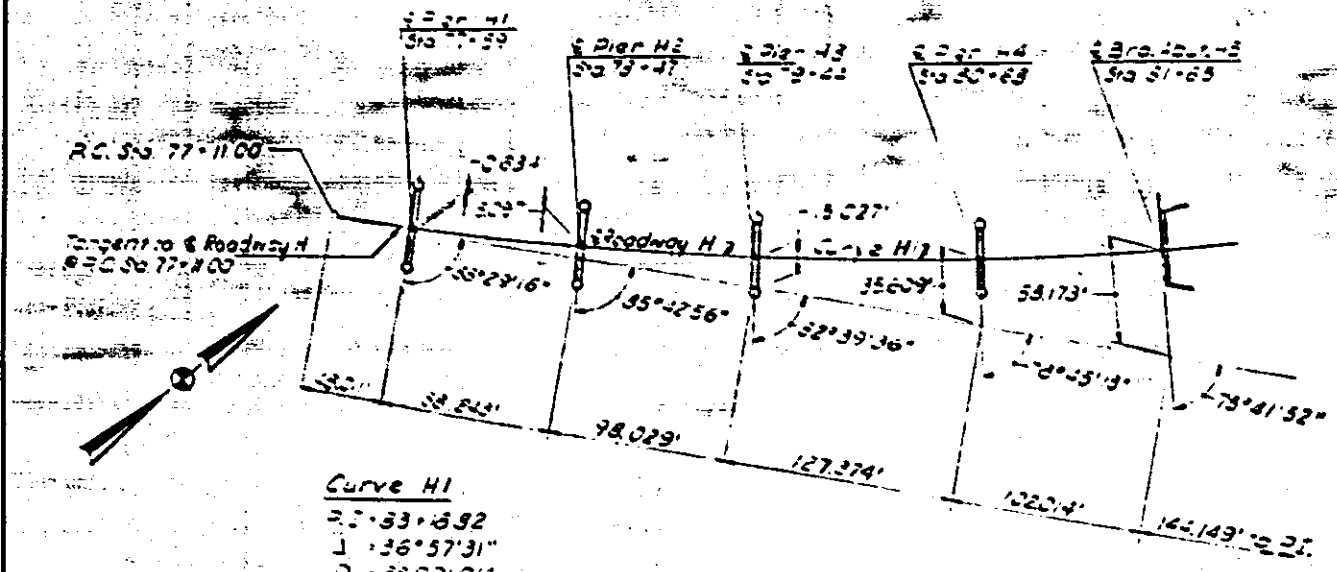

DETAIL 'A'

DESIGNED BY R.M.R.
 DRAWN BY J.M.
 CHECKED BY S.G.B.
 APPROVED BY K.A.

STATE OF ILLINOIS
 DEPARTMENT OF PUBLIC WORKS & BLDGS.
 DIVISION OF HIGHWAYS
GEOMETRIC LAYOUT
 PIERS P4 THRU P15, O18, H1 THRU H5
 POPLAR STREET BRIDGE APPROACHES
 RAMPS P8Q AND ROADWAY "H"
 SECTIONS 82-3HV8-1
 82-3HV8E-1
 82-3HV8-1
 F.A.I. RT. 70 ST. CLAIR CO.
 H. W. LOCHNER, INC.
 ENGINEERS
 CHICAGO, ILLINOIS
 SHEET
 31 OF 526

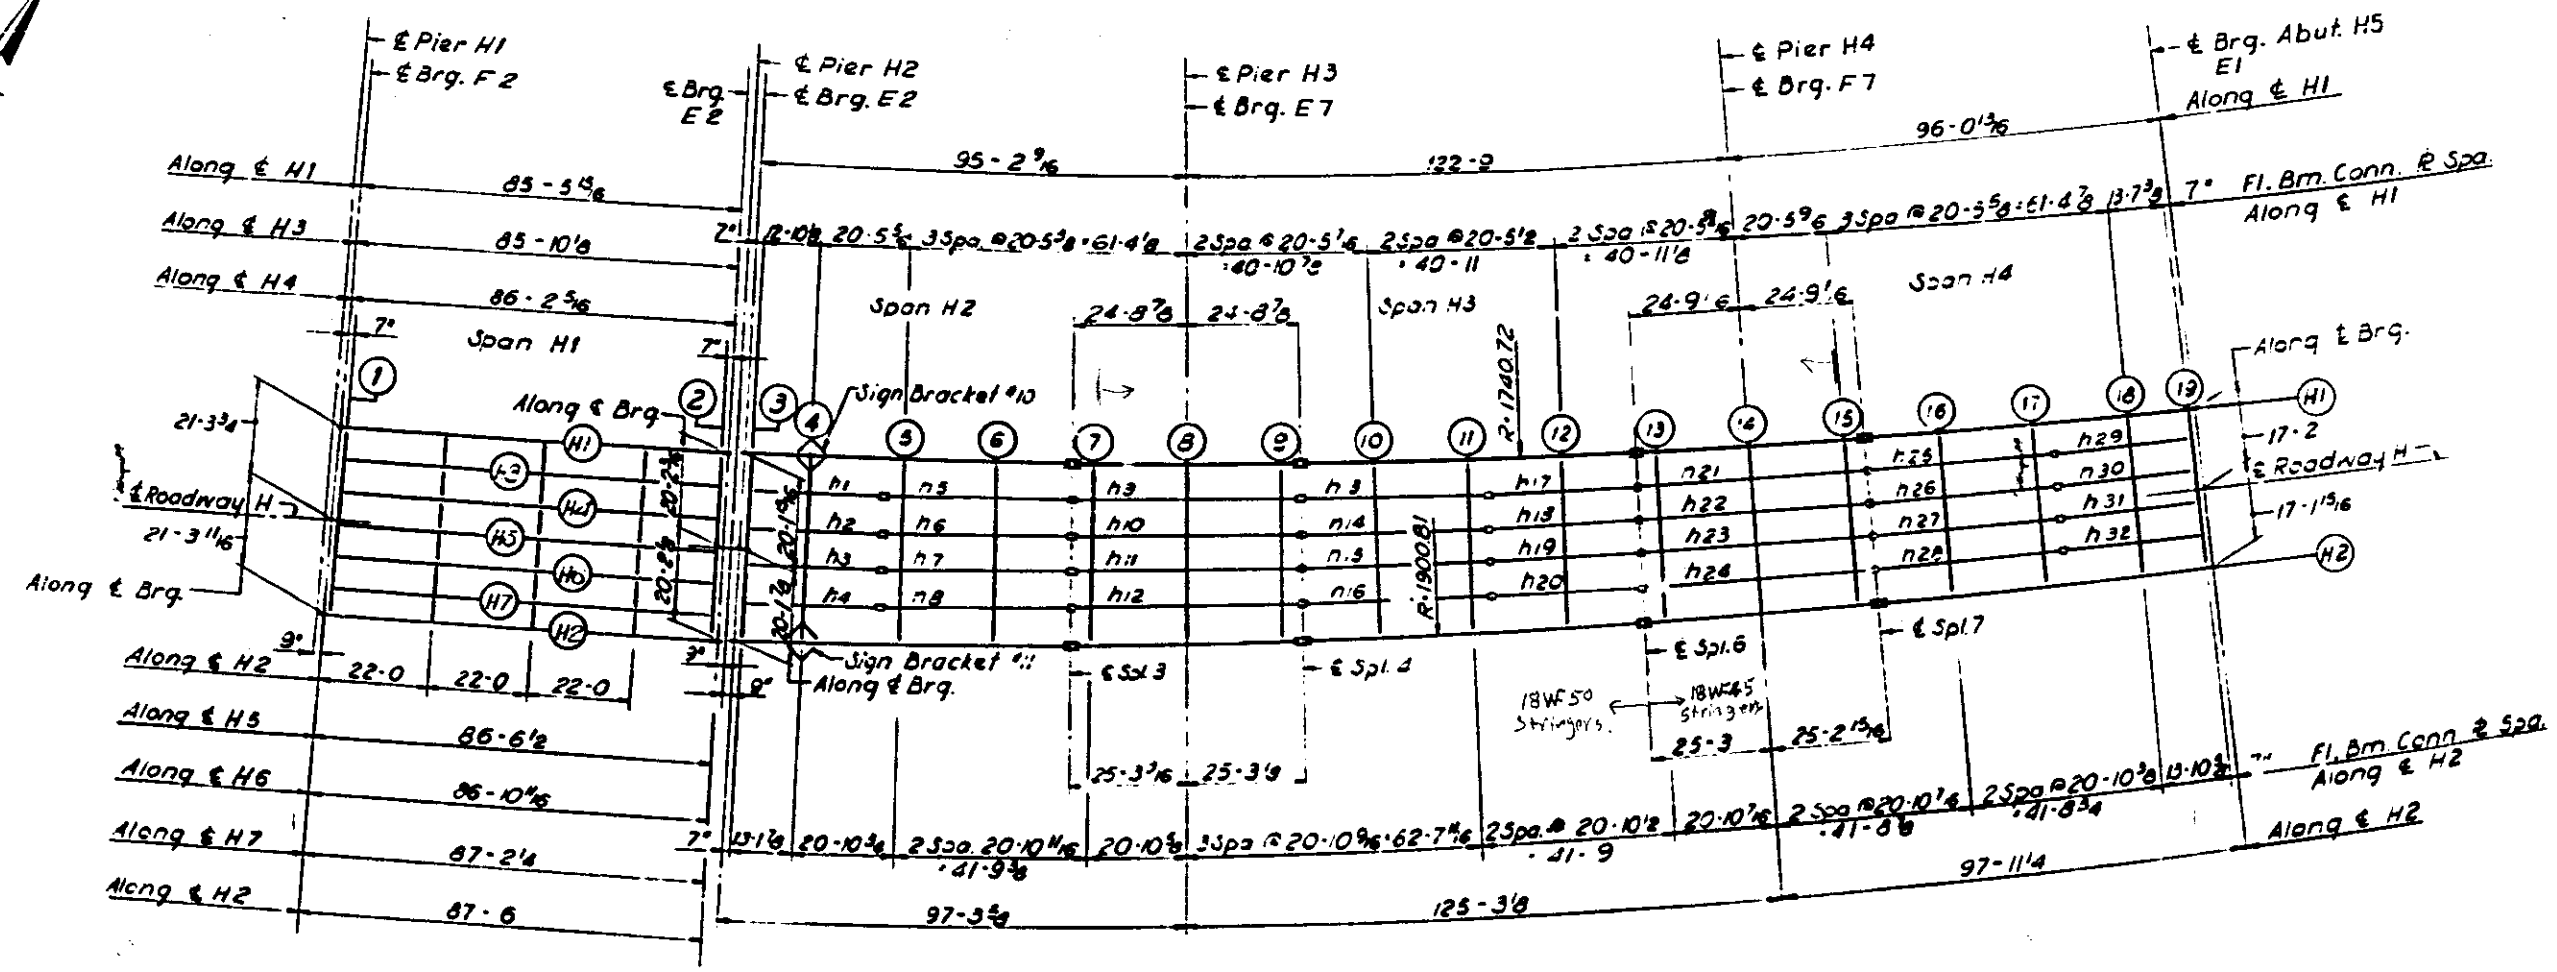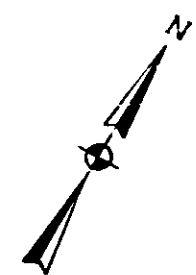

PLAN
SPANS H1 THRU H4

ELEVATION TOP OF FLANGE

CL. BRL.	STR. H	STR. H2	DIFF.
CL. BRL.	448,701	448,110	3,408
FLOOR BEAM 1	448,888	448,108	3,408
FLOOR BEAM 2	448,418	448,845	3,229
CL. BRL.	448,407	448,838	3,229

ELEVATION TOP OF GIRDER WEB

CL. BRL.	GIR. H1	GIR. H2	DIFF.
CL. BRL.	445,175	448,401	3,224
FLOOR BEAM 3	445,188	448,391	3,225
FLOOR BEAM 4	444,965	448,165	3,200
FLOOR BEAM 5	444,644	447,805	3,161
FLOOR BEAM 6	444,323	447,445	3,123
SPLICE 3	444,088	447,162	3,083
FLOOR BEAM 7	444,001	447,087	3,086
FLOOR BEAM 8	443,678	446,789	3,080
FLOOR BEAM 9	443,358	446,371	3,015
SPLICE 4	443,288	446,296	3,008
FLOOR BEAM 10	443,032	446,015	2,983
FLOOR BEAM 11	442,707	445,808	2,972

	GIR. H1	GIR. H2	DIFF.
FLOOR BEAM 12	442,383	445,304	2,881
SPLICE 6	442,188	445,082	2,896
FLOOR BEAM 13	442,038	444,948	2,890
FLOOR BEAM 14	441,732	444,584	2,882
FLOOR BEAM 15	441,405	444,240	2,835
SPLICE 7	441,337	444,168	2,829
FLOOR BEAM 16	441,077	443,888	2,811
FLOOR BEAM 17	440,748	443,538	2,787
FLOOR BEAM 18	440,421	443,194	2,763
FLOOR BEAM 19	440,202	442,989	2,786
CL. BRL.	440,183	442,939	2,746

Note: Dimensions locating Floor Beams are given to the Floor Beam Conn. Plate see sketch Sheet No. 183 For Sign Bracket Detail see Sh. No. 360.

BILL OF MATERIAL		
*Structural Steel	Lbs.	646,740

*Weight of Bearing Assemblies with Lead Plates and Anchor Bolts are Included as Structural Steel Est. Wt. 13,440 Lbs.

STATE OF ILLINOIS
DEPARTMENT OF PUBLIC WORKS & BLDGS.
DIVISION OF HIGHWAYS
FRAMING PLAN
SPANS H1 THRU H4
POPLAR STREET BRIDGE APPROACHES
ROADWAY "H"

F.A. 1 RT. 70 ST. CLAIR CO. SECTION B2-3HVFB-E-1
N. W. LOCHNER, INC.
ENGINEERS
CHICAGO, ILL. NOIS

SHEET
247 OF 247

DESIGNED BY: S.M.R.
DRAWN BY: L.M.
CHECKED BY: A.M.
APPROVED BY: S.A.

ROUTE NO.	SECTION	COUNTY	TOTAL SHEETS	SHEET NO.
FA. I. - 70	82-3HVFB&E	ST. CLAIR	247	136
FED. ROAD DIV. NO. 4		ILLINOIS	PROJECT	








STRINGER DIMENSIONS

STR	L	S1	S2	S3	S4	B1	B2
1	29 1 9/16		12 10 7/8		16 2 3/4	89.54.39	89.07.23
2	29 3 3/16		12 11 5/8		16 3 9/16	89.38.00	89.24.02
3	29 4 13/16		13 3/8		16 4 7/16	89.21.29	89.40.33
4	29 6 7/16		13 1 1/8		16 5 5/16	89.05.08	89.56.54
5	41 13/16	4 3 11/16	20 6 3/8		16 2 3/4	89.44.34	88.57.18
6	41 2 15/16	4 3 7/8	20 7 7/16		16 3 9/16	89.28.47	89.13.06
7	41 5 1/16	4 4 1/8	20 8 1/2		16 4 7/16	89.13.07	89.28.45
8	41 7 3/16	4 4 3/8	20 9 5/8		16 5 1/4	88.57.36	88.44.17
9	48 8 3/16	4 3 11/16	20 6 7/16	20 6 7/16	4 3 11/16	89.34.42	88.50.47
10	48 10 3/4	4 3 7/8	20 7 7/16	20 7 1/2	4 3 7/8	89.20.02	89.05.27
11	50 1 1/4	4 4 1/8	20 8 1/2	20 8 1/2	4 4 1/8	89.05.30	89.20.00
12	50 3 3/4	4 4 5/16	20 9 9/16	20 9 9/16	4 4 5/16	88.51.04	89.34.25
13	41 15/16	16 2 13/16	20 6 1/2		4 3 11/16	89.41.12	89.00.40
14	41 3	16 3 9/16	20 7 1/2		4 3 7/8	89.27.40	89.14.12
15	41 5	16 4 3/8	20 8 1/2		4 4 1/8	89.14.15	88.27.37
16	41 7 1/16	16 5 1/4	20 9 1/2		4 4 5/16	89.00.56	89.40.58
17	32 5 5/8	18 2 13/16			16 2 13/16	89.48.01	89.16.14
18	32 7 3/16	18 3 5/8			16 3 5/8	89.35.25	89.22.31
19	32 8 13/16	18 4 3/8			16 4 3/8	89.22.54	89.35.21
20	32 10 3/8	18 5 3/16			16 5 3/16	89.10.30	89.47.45
21	48 8 7/16	4 3 11/16	20 6 1/2	20 6 9/16	4 3 11/16	89.30.05	88.55.25
22	48 10 13/16	4 3 7/8	20 7 1/2	20 7 1/2	4 3 7/8	89.18.31	89.08.58
23	50 1 3/16	4 4 1/8	20 8 1/2	20 8 1/2	4 4 1/8	89.07.00	89.18.27
24	50 3 1/2	4 4 5/16	20 9 7/16	20 9 7/16	4 4 5/16	88.55.39	89.29.50
25	41 1 1/8	16 2 7/8	20 6 9/16		4 3 11/16	89.36.33	89.05.70
26	41 3 1/16	16 3 5/8	20 7 1/2		4 3 7/8	89.26.08	89.15.44
27	41 4 15/16	16 4 3/8	20 8 7/16		4 4 1/8	89.15.48	89.26.04
28	41 6 7/8	16 5 1/8	20 9 7/16		4 4 5/16	89.05.33	89.36.19
29	29 10 7/8	16 2 7/8	13 8			89.45.49	89.16.13
30	30 9/16	16 3 5/8	13 8 11/16			89.36.19	89.25.43
31	30 1 11/16	16 4 3/8	13 9 5/16			89.26.53	89.35.09
32	30 3 1/8	16 5 1/8	13 9 15/16			89.17.31	89.44.31


FLOOR BEAM DIMENSIONS

FL. BM.	L	F1	F2	F3	F4	F5	F6	A1	A2	A3	A4	A5	A6	A7
1	46 7 3/16	7 2 1/2	7 2 1/2	7 2 1/2	7 2 1/2	6 10 5/8	6 10 5/8	89.22.11	89.22.11	89.22.11	89.22.11	89.22.11	88.37.09	87.52.26
2	44 4 1/2	7 2 3/16	7 2 3/16	7 2 9/16	7 2 9/16	5 9 1/8	5 9 1/8	82.08.31	82.08.31	82.08.31	82.08.31	82.08.31	91.23.29	90.36.46


FL. BM.	L	F1	F2	F3	F4	F5	A1	A2	A3	A4	A5	A6	SECTION
3	40 3 11/16	8 3/4	8 3/4	8 3/4	8 3/4	8 3/4	90.40.04	89.54.39	89.38.00	89.21.29	89.05.08	89.15.47	36 W 150
4	38 11 7/8	7 11 1/4	8	8	8	8 11/16	90.41.50	90.21.45	90.05.05	89.48.35	89.32.13	89.19.03	36 W 150
5	39 6	7 13 1/4	7 10 13/16	7 10 13/16	7 10 13/16	7 11 5/16	90.40.34	89.52.46	89.36.58	89.21.19	89.05.47	89.20.17	36 W 150
6	39 5/16	7 8 5/16	7 9 11/16	7 9 11/16	7 9 11/16	7 11	90.39.18	90.31.50	90.16.02	90.00.22	89.44.51	89.21.31	36 W 150
7	38 6 13/16	7 7 7/8	7 8 9/16	7 8 9/16	7 8 9/16	7 9 1/16	90.38.02	89.42.54	89.28.14	89.13.41	88.59.16	89.22.46	36 W 150
8	38 1 7/16	7 5 3/8	7 7 1/2	7 7 1/2	7 7 1/2	7 9 1/2	90.36.45	90.21.58	90.07.18	89.52.45	89.38.19	89.24.01	36 W 150
9	37 8 5/16	7 5 13/16	7 6 7/16	7 6 7/16	7 6 7/16	7 7 1/8	90.35.28	91.01.01	90.46.21	90.31.49	90.17.73	89.25.16	36 W 150
10	37 3 5/16	7 4 1/8	7 5 1/2	7 5 1/2	7 5 1/2	7 6 13/16	90.34.11	90.12.05	89.58.33	89.45.08	89.31.49	89.26.32	36 W 150
11	36 10 9/16	7 4	7 4 1/2	7 4 1/2	7 4 1/2	7 5	90.32.54	90.51.08	90.37.37	90.24.11	90.10.53	89.27.48	36 W 150
12	36 5 15/16	7 2 11/16	7 3 5/8	7 3 5/8	7 3 5/8	7 4 7/16	90.31.36	90.18.53	90.06.17	89.53.47	89.41.22	89.29.04	36 W 150
13	36 1 1/2	7 2 1/16	7 2 11/16	7 2 11/16	7 2 11/16	7 3 3/8	90.30.18	89.38.16	89.26.42	89.15.14	89.03.51	89.30.70	36 W 150
14	36 9 5/16	6 11 3/4	7 1 7/8	7 1 7/8	7 1 7/8	7 3 7/8	90.29.00	90.17.70	90.05.46	89.54.18	89.42.55	89.31.37	36 W 150
15	36 5 1/4	7 3/8	7 1 1/16	7 1 1/16	7 1 1/16	7 1 11/16	90.27.41	90.56.24	90.44.50	90.33.22	90.21.58	89.32.53	36 W 150
16	35 1 3/8	6 10 15/16	7 5/16	7 5/16	7 5/16	7 1 5/8	90.26.23	90.07.25	89.57.01	89.46.41	89.36.26	89.34.10	36 W 150
17	34 9 11/16	6 11	6 11 9/16	6 11 9/16	6 11 9/16	7 1/16	90.25.04	90.48.29	90.36.04	90.25.45	90.15.29	89.35.28	36 W 150
18	34 6 1/4	6 10 1/16	6 10 7/8	6 10 7/8	6 10 7/8	6 11 9/16	90.23.45	90.16.42	90.07.11	89.57.45	89.48.24	89.36.45	36 W 150
19	34 4	6 10 3/8	6 10 3/8	6 10 3/8	6 10 3/8	6 10 3/8	90.23.58	90.43.47	90.34.17	90.24.51	90.15.29	89.38.42	36 W 150

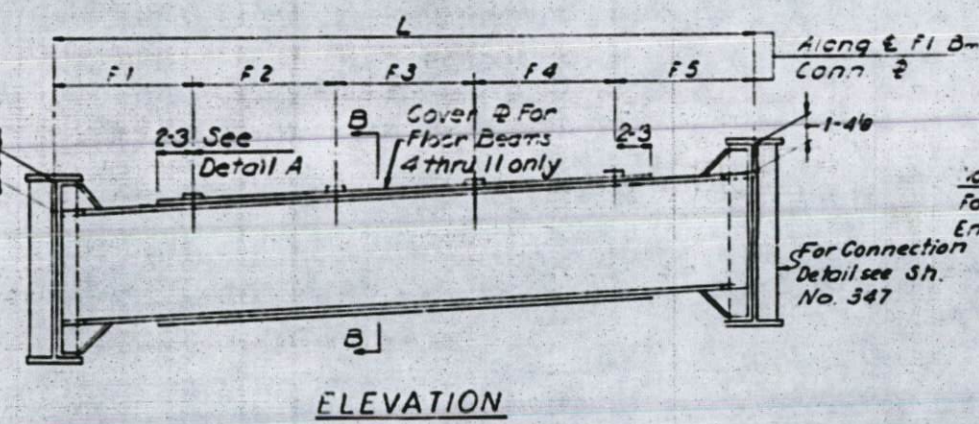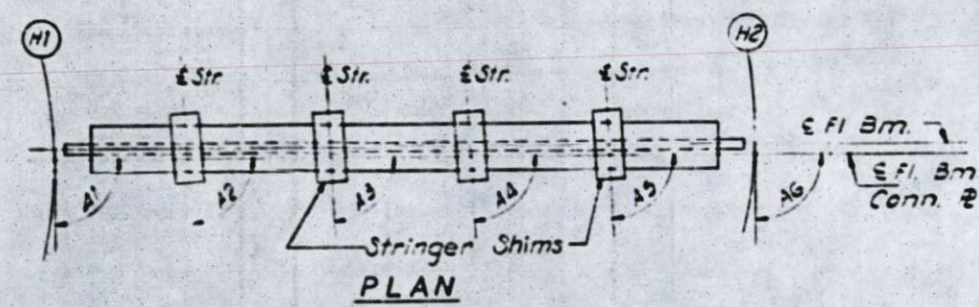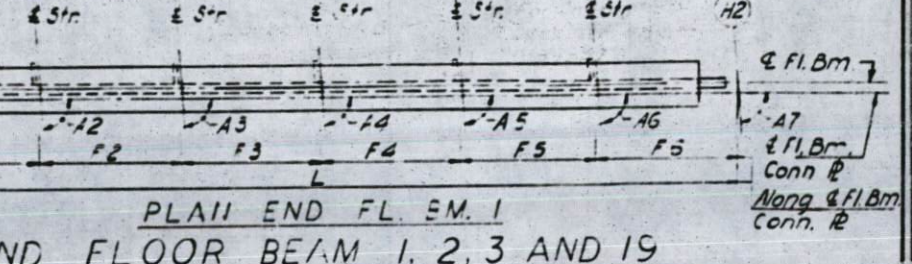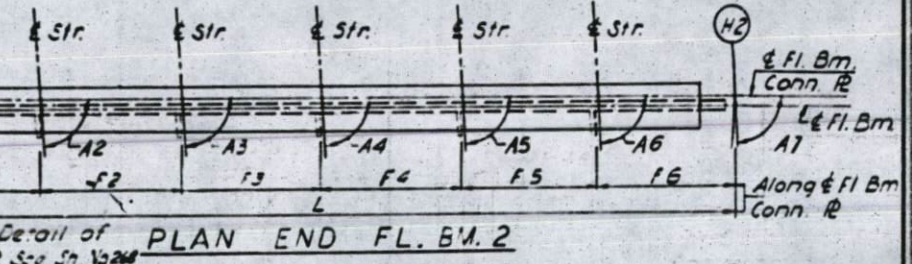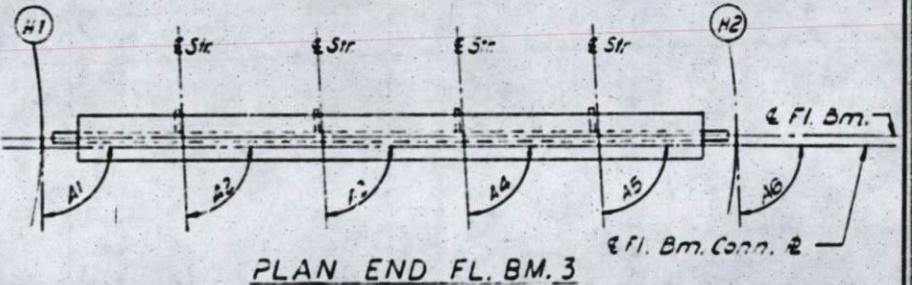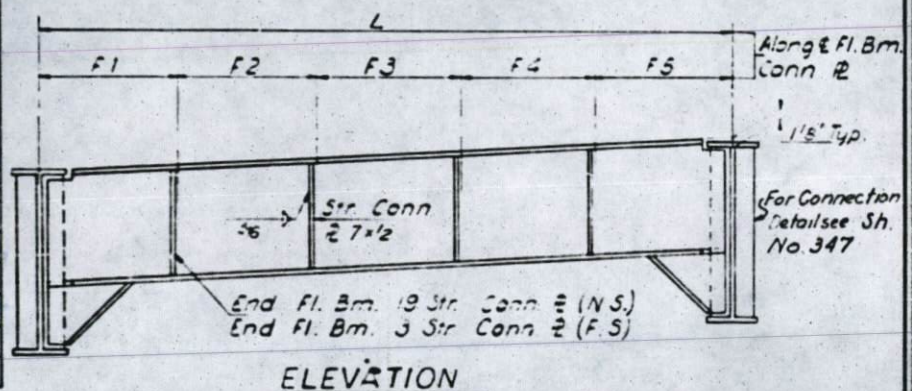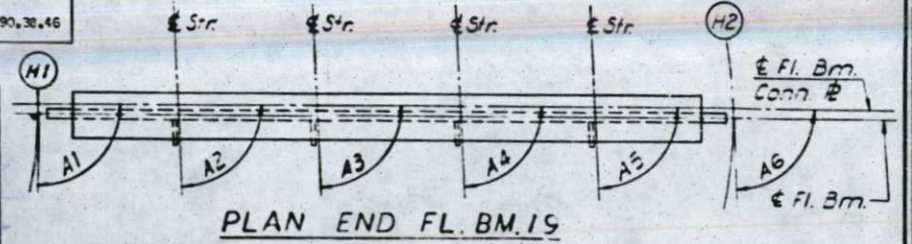

INTERIOR FLOOR BEAM 4 THRU 18

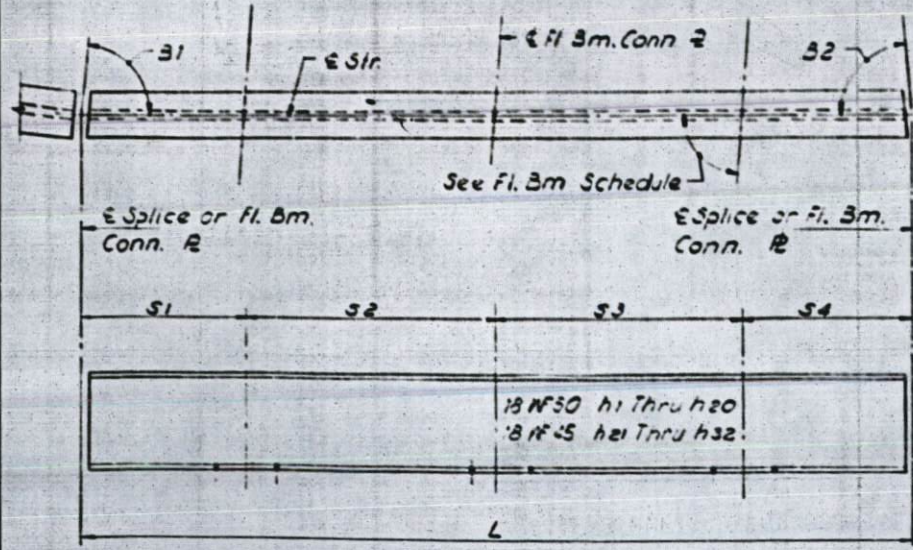

TYPICAL STRINGER

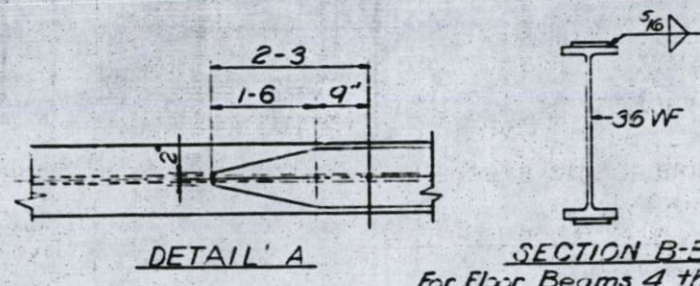

SECTION B-B For Floor Beams 4 thru 11 only

Notes:
 Length L of Stringers and Fl. Bms is correct as given in the table except the increment lengths are given to the nearest 1/8
 All dimensions are in the horizontal plane
 For Intermediate Stiffener, Brq. Stiffener and Connection Plate Details see Sh. No. 348

STATE OF ILLINOIS
 DEPARTMENT OF PUBLIC WORKS & BLDGS.
 DIVISION OF HIGHWAYS
 STRINGER AND FLOOR BEAM
 SCHEDULE
 SPANS H1 THRU H4
 POPLAR STREET BRIDGE APPROACHES
 ROADWAY "H"
 F.A.I. RT 70 ST. CLAIR CO. SECTION 82-3HVFB&E-I
 H. W. LOCHNER, INC. ENGINEERS CHICAGO, ILLINOIS
 SHEET 266 of 526

DESIGNED BY R.M.R.
 DRAWN BY L.M.
 CHECKED BY A.T.
 APPROVED BY S.A.

ROUTE NO.	SECTION	COUNTY	TOTAL SHEETS	SHEET NO.
F.A.I.-70	82-3HVFB-E-1	ST. CLAIR	17	37
FED. ROAD DIV. NO. 4	ILLINOIS	PROJECT		



FLANGE BEAM 3 THRU 6	T1	T2	T3	T4
SER. 1 THRU 6	1 3/8	3/4	1	3/8

FLANGE BEAM 7 THRU 9	T1	T2	T3	T4
SER. 9 THRU 12	1 3/8	3/4	1	3/8


FLANGE BEAM 10 THRU 12	T1	T2	T3	T4
SER. 13 THRU 20	1 3/8	3/4	1	3/8

FLANGE BEAM 13 THRU 16	T1	T2	T3	T4
SER. 21 THRU 24	1 3/8	3/4	1	3/8

FLANGE BEAM 16 THRU 18	T1	T2	T3	T4
SER. 25 THRU 28	1 3/8	3/4	1	3/8

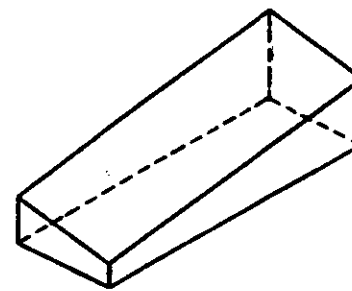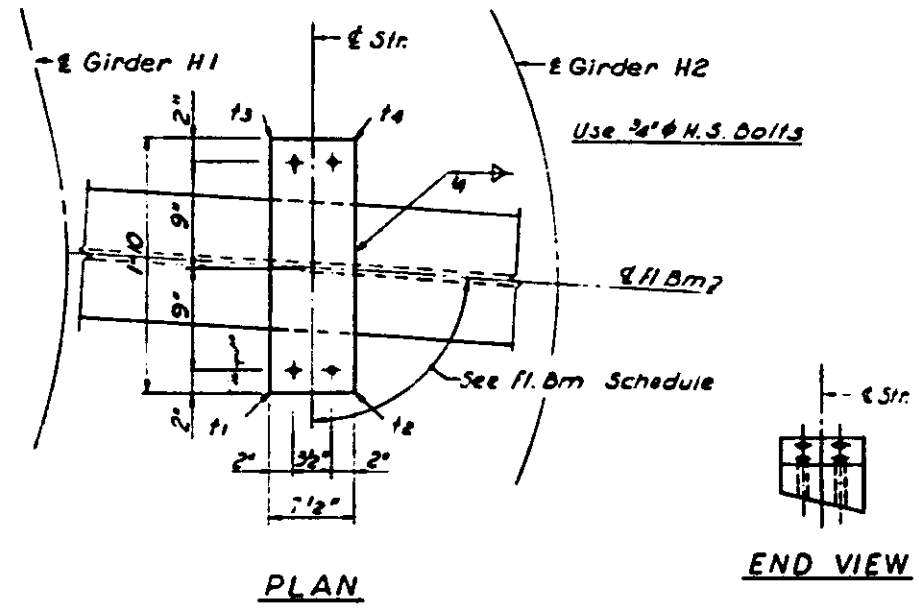

ISOMETRIC VIEW

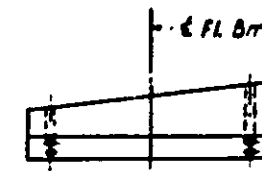

SIDE VIEW

SHIM DETAIL

Shim thickness t_1 , t_2 , t_3 & t_4 shown in the Table are orientated with the Plan View shown above.

DESIGNED BY R.M.R.
 DRAWN BY SCH.
 CHECKED BY AT
 APPROVED BY A.A.


STATE OF ILLINOIS
 DEPARTMENT OF PUBLIC WORKS & BLDGS.
 DIVISION OF HIGHWAYS

STRINGER SHIMS
 SPANS H2 THRU H4
 POPLAR STREET BRIDGE APPROACHES
 ROADWAY "H"

F.A.I. RT. 70 ST. CLAIR CO SECTION 82-3HVFB-E-1
 H. W. LOCHNER, INC.
 ENGINEERS
 CHICAGO, ILLINOIS


SHEET 267 of 526

ROUTE NO.	SECTION	COUNTY	TOTAL SHEETS	SHEET NO.
F.A.I. 70	62-3HV & E-1	ST. CLAIR	247	139
FED. ROAD DIV. NO. 4		ILLINOIS	PROJECT	

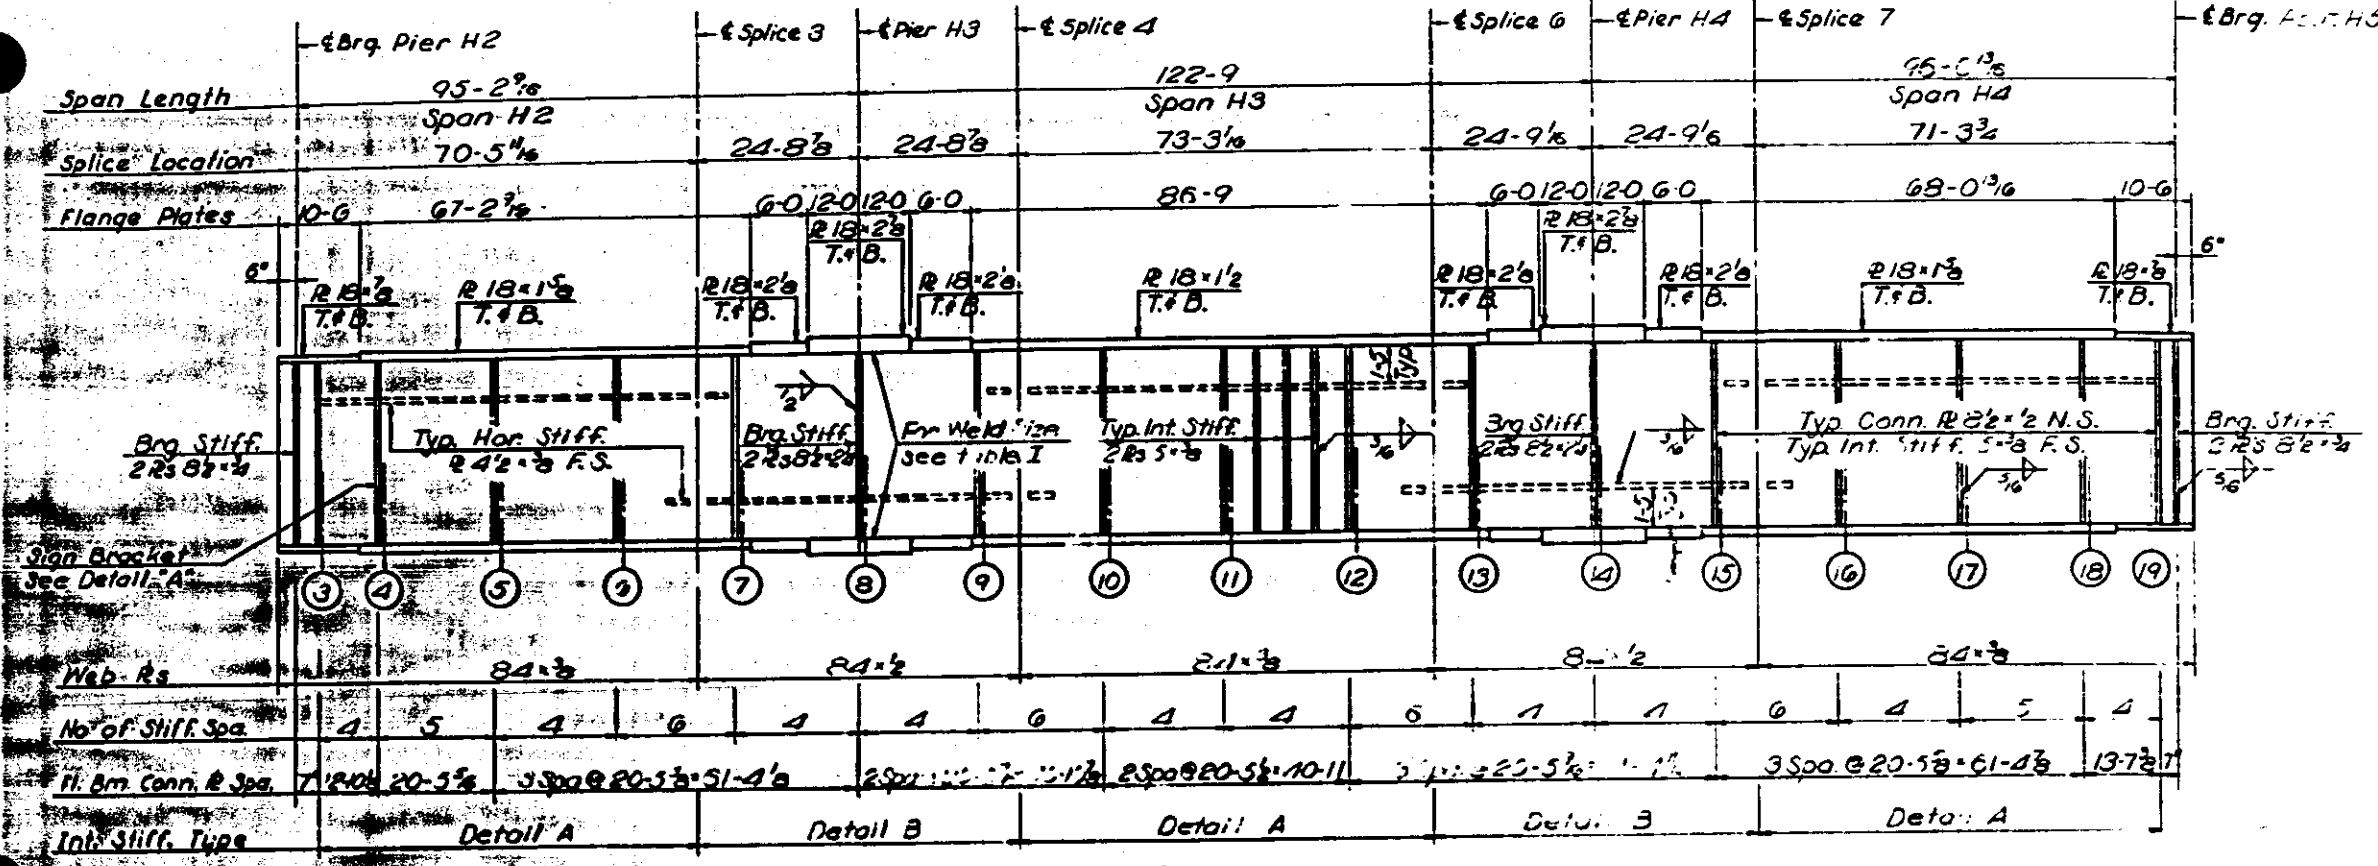

GIRDER H1
SPANS H2 thru H4

Note "A"
Interior Stiffeners should be moved if necessary to clear sign bracket Connection Plates.

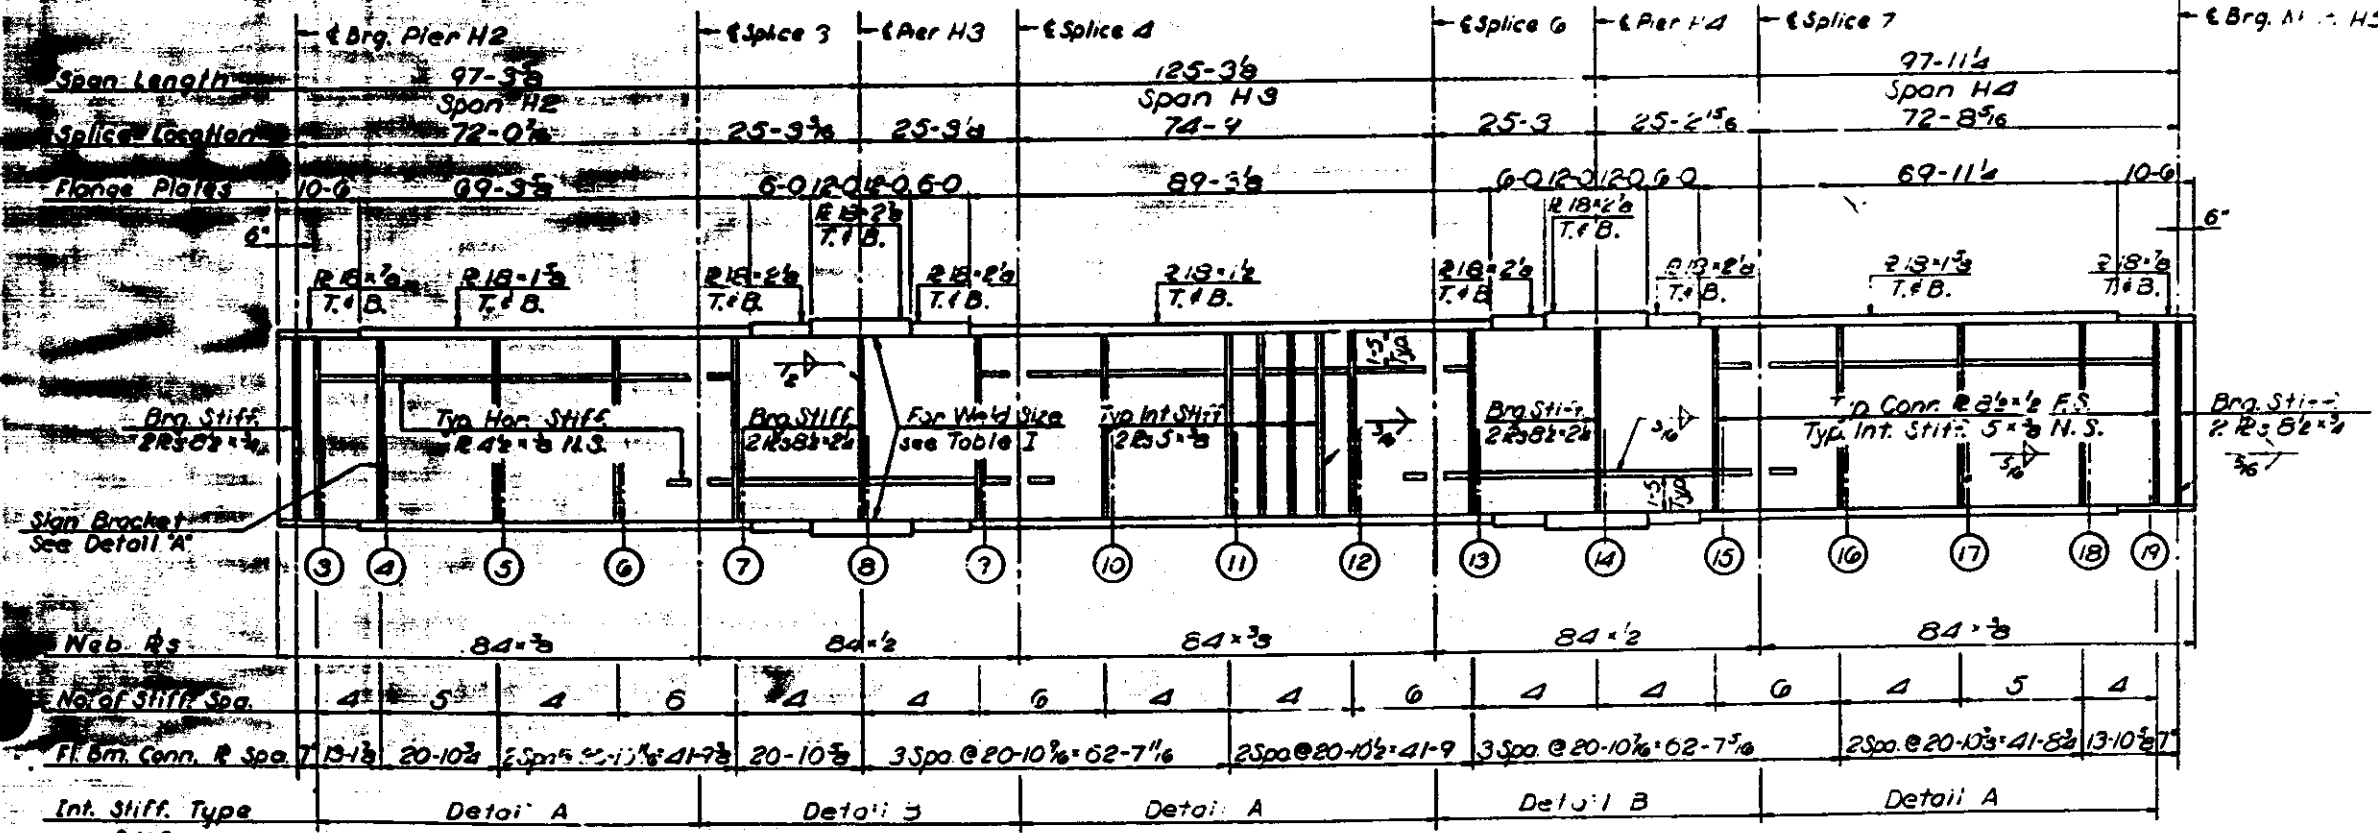

GIRDER H2
SPANS H2 thru H4

Notes:
All Longitudinal Dimensions shown are given along & of Web. See Sh. No. 265.
All Bearing Stiffeners and Connection Plate Details and Table I see Sh. No. 348 349 - J 350.
For Sign Bracket Detail see Sh. No. 360

DESIGNED BY: R.M.B.
DRAWN BY: D.G.H.
CHECKED BY: A.T.
APPROVED BY: K.J.

STATE OF ILLINOIS
DEPARTMENT OF PUBLIC WORKS & BLDGS.
DIVISION OF HIGHWAYS









GIRDERS H1 AND H2
SPANS H2 THRU H4
POPLAR STREET BRIDGE APPROACHES
ROADWAY "H"

FAL RT. 70 ST. CLAIR CO. SECTION 62-3HV & E-1

N. W. LOCHNER, INC.
ENGINEERS
CHICAGO, ILLINOIS

SHEET
26309 326

ROUTE NO.	SECTION	COUNTY	TOTAL SHEETS	SHEET NO.
F.A.I.-70	82-3MVFB-E-1	ST. CLAIR	247	217
FED. ROAD DIV. NO. 4		ILLINOIS	PROJECT	

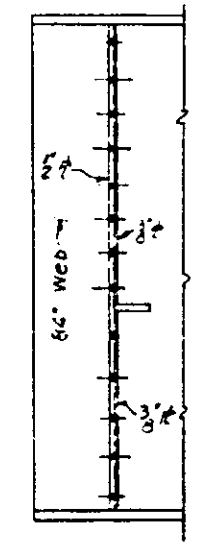
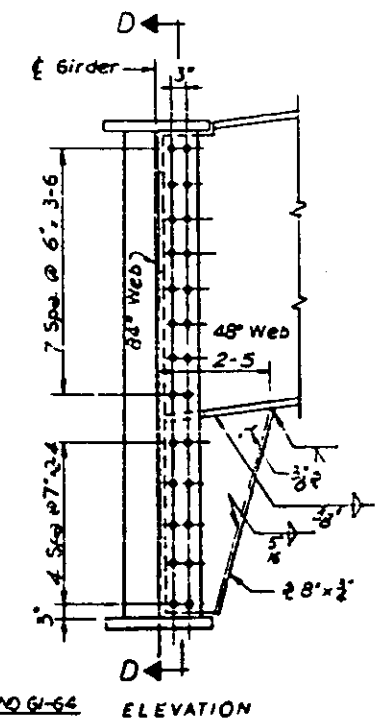
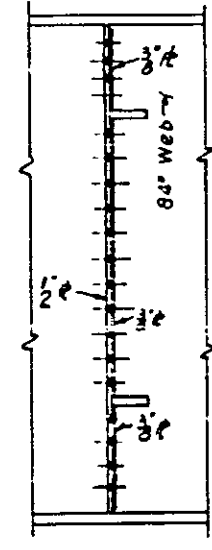
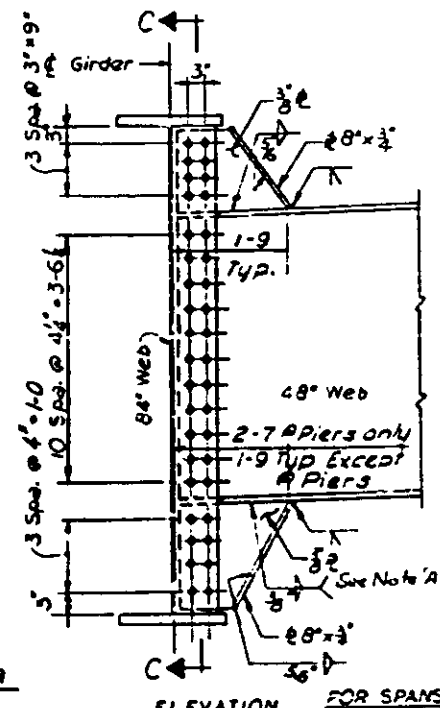
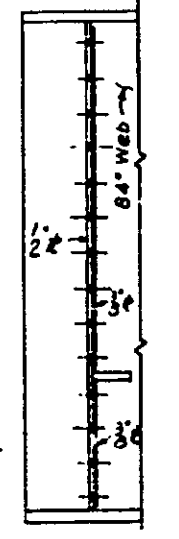
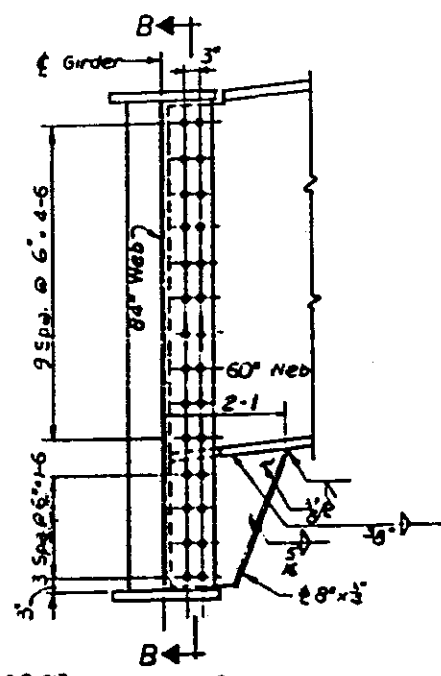
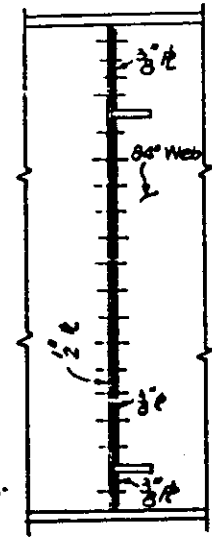
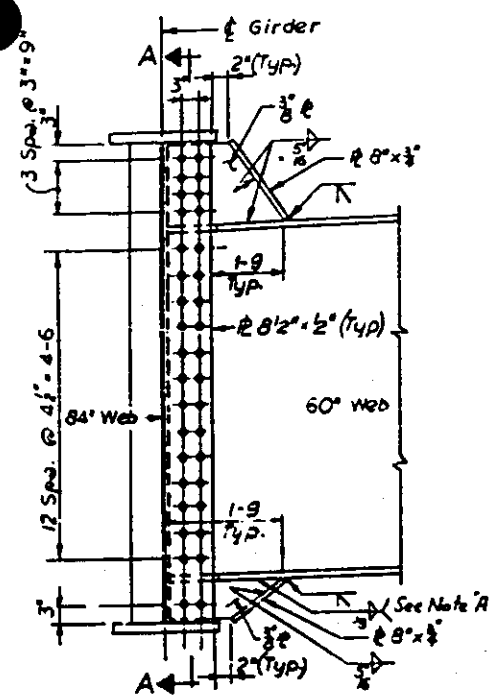


SECTION A-A
ELEVATION FOR SPANS A1-A4, A9-A20, D8-D10, D24-D25 AND G2-G3
INTERIOR FLOOR BEAM TO GIRDER CONNECTION
60" WEB FLOOR BEAMS

SECTION B-B
ELEVATION
END FLOOR BEAM TO GIRDER CONNECTION

SECTION C-C
ELEVATION FOR SPANS A15-A17, D5-D7, D22-D23 AND G4-G6
INTERIOR FLOOR BEAM TO GIRDER CONNECTION
48" WEB FLOOR BEAMS

SECTION D-D
ELEVATION
END FLOOR BEAM TO GIRDER CONNECTION

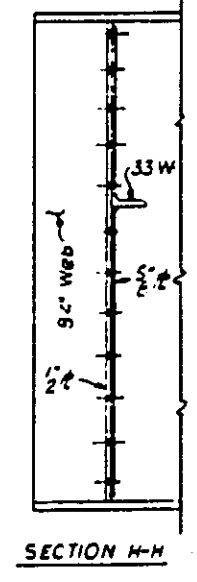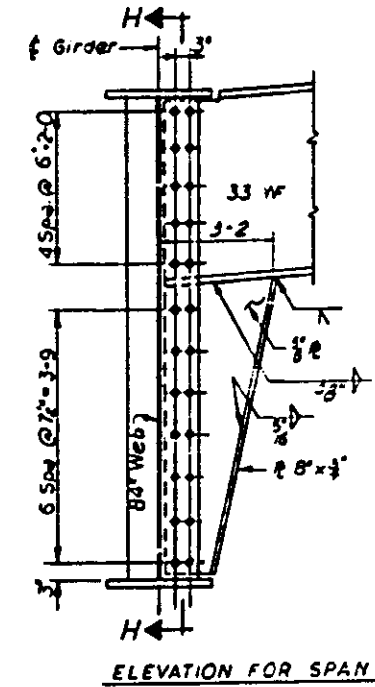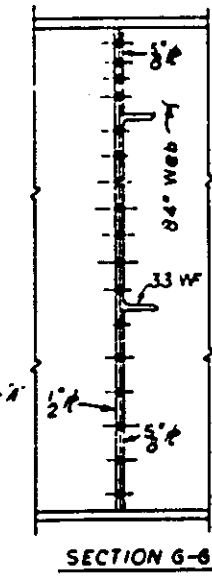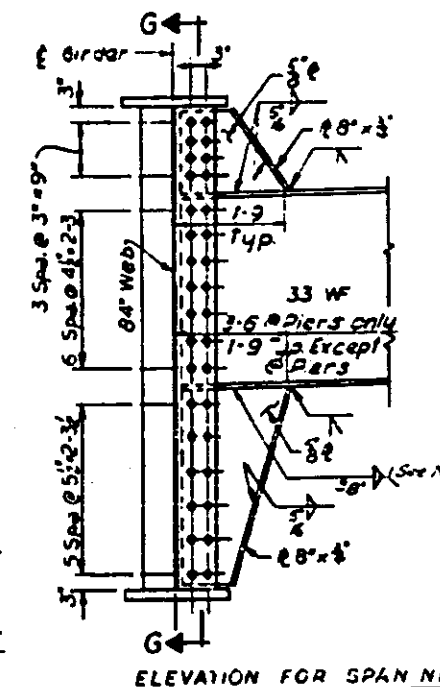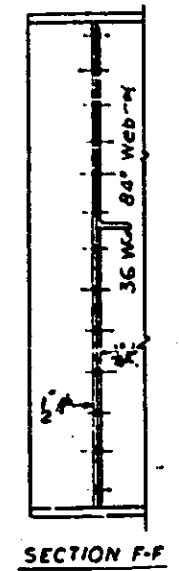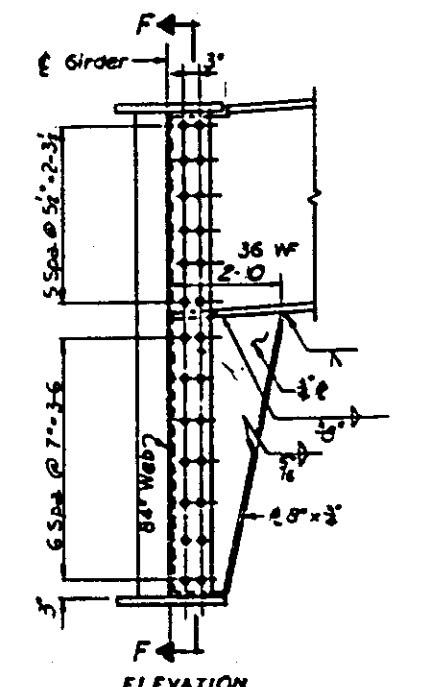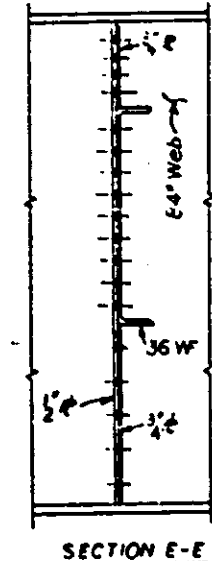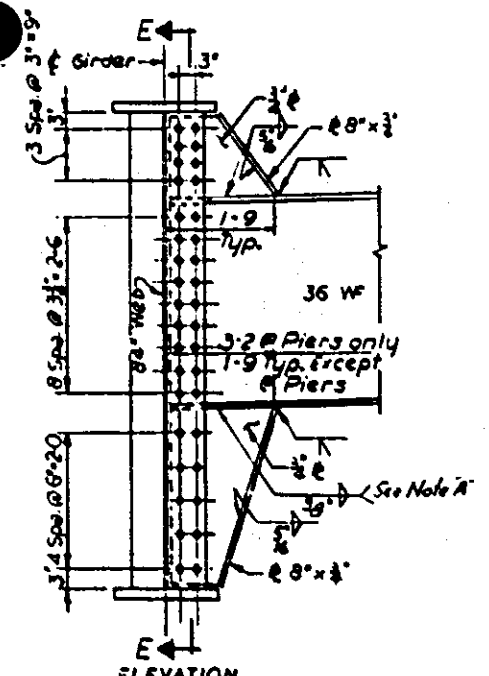

SECTION E-E
ELEVATION
INTERIOR FLOOR BEAM TO GIRDER CONNECTION
36 W FLOOR BEAMS
FOR SPANS G5-G11, D1-D4, D18-D20 & H2-H4

SECTION F-F
ELEVATION
END FLOOR BEAM TO GIRDER CONNECTION

SECTION G-G
ELEVATION FOR SPAN N1-N4
INTERIOR FLOOR BEAM TO GIRDER CONNECTION
33 W FLOOR BEAMS
FOR SPAN N1-N4

SECTION H-H
ELEVATION FOR SPAN N1-N4
END FLOOR BEAM TO GIRDER CONNECTION

NOTES
For size of flange plate welds see Table I Sheer No. 350.
Weld Connection #1's to the top flange and tight fit at the bottom flange in areas designated as Detail "A".
Weld Connection #2's to the bottom flange and tight fit at the top flange in areas designated as Detail "B".
For limits of Detail "A" or Detail "B" see the Girder Elevation Drawings.

Note #1
3/16" Fillet weld Typical
3/8" Fillet weld @ Piers only

84" WEB GIRDER

DESIGNED BY: T.T.
DRAWN BY: P.A.S.
CHECKED BY: K.A.
APPROVED BY:

STATE OF ILLINOIS
DEPARTMENT OF PUBLIC WORKS & BLDGS.
DIVISION OF HIGHWAYS

STEEL FRAMING DETAILS
POPLAR STREET BRIDGE APPROACHES

F.A.I. RT. 70 ST. CLAIR CO. SECTION 82-MVFB-E-1
H. W. LOCHNER, INC.
ENGINEERS
CHICAGO, ILLINOIS
SHEET 347 of 526

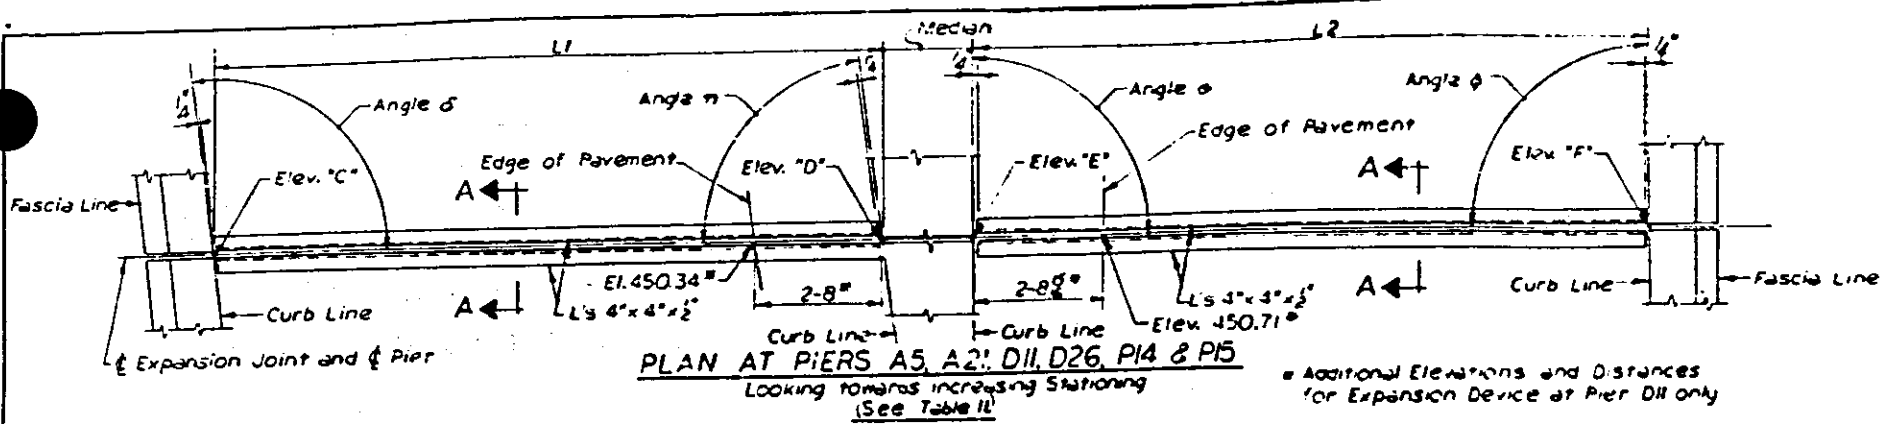


TABLE I
FOR ELEVATIONS, LENGTHS, ANGLES & WEIGHTS

PIER NO	ANGLE α	ELEV. 'A'	L	ELEV. 'B'	ANGLE β	WEIGHT
A11	90°03'15"	448.05	30-0	450.45	90°00'00"	830 Lbs
A12	90°19'37"	448.43	30-3/4	450.55	90°00'00"	930 Lbs
D5	90°00'00"	446.70	30-0 1/4	446.23	92°36'23"	930 Lbs
D12	90°00'00"	448.31	30-0	450.71	90°00'00"	830 Lbs
D18	90°12'05"	448.70	30-0 1/4	450.89	90°00'00"	830 Lbs
D21	91°47'46"	445.96	34-10 1/2	449.49	90°00'00"	960 Lbs
G9	90°00'00"	455.59	30-0	457.98	90°00'00"	830 Lbs
H1	89°12'02"	447.50	40-7 1/2	450.75	89°12'59"	1120 Lbs
N9	90°00'00"	465.31	22-0	467.07	90°00'00"	610 Lbs
N1	90°00'00"	451.32	22-0	453.44	90°00'00"	510 Lbs
O6	90°00'00"	439.26	22-0	443.81	90°00'00"	510 Lbs
P7	90°00'00"	471.78	22-0	470.02	90°00'00"	610 Lbs
S3	90°00'00"	457.36	22-0	455.91	90°00'00"	610 Lbs
G1		See Details	See Details	See Details	See Details	1380 Lbs
ABUTMENT						
G14	85°35'35"	443.24	48-8 1/2	443.39	90°00'00"	1360 Lbs
H5	89°38'49"	441.18	32-3 1/4	443.76	89°36'07"	870 Lbs
O10	90°00'00"	428.11	22-0	429.37	90°00'00"	610 Lbs
O11	90°00'00"	424.74	22-0	426.12	90°00'00"	610 Lbs



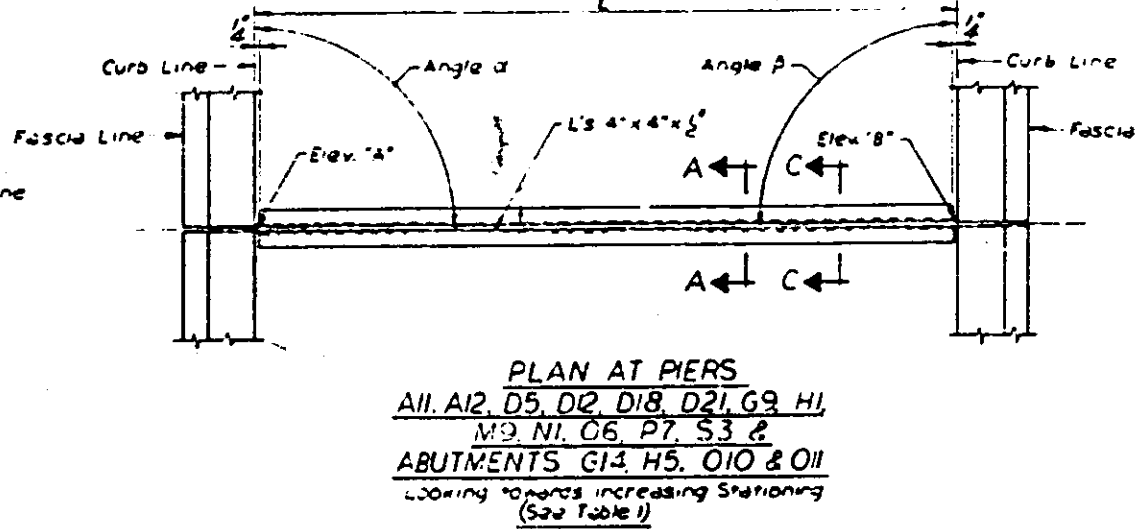


TABLE II
FOR ELEVATIONS, LENGTHS, ANGLES & WEIGHTS

PIER NO.	ANGLE δ	ELEV. 'C'	L1	ELEV. 'D'	ANGLE γ	ANGLE ϕ	ELEV. 'E'	L2	ELEV. 'F'	ANGLE β	WEIGHT
A5	93°43'07"	442.51	21-2 1/2	445.31	96°33'25"	90°00'00"	445.68	30-0	447.24	90°00'00"	1410 Lbs
A2	94°50'36"	454.70	19-4 1/2	455.56	87°13'39"	90°00'00"	456.27	30-0	457.32	90°00'00"	1360 Lbs
D11	90°00'00"	447.94	32-8	450.62	86°21'42"	78°59'21"	450.63	24-11 1/2	450.45	99°04'36"	1590 Lbs
D26	97°25'16"	446.84	22-2	448.56	92°59'54"	90°00'00"	448.90	30-0	449.37	90°00'00"	1140 Lbs
P14	107°48'41"	449.63	23-0 1/2	450.44	72°39'57"	111°54'53"	450.14	23-4 1/2	451.42	67°23'40"	1280 Lbs
P15	113°54'37"	449.02	20-1 1/2	449.55	63°39'15"	114°43'17"	450.02	20-5 1/2	451.56	63°49'22"	1120 Lbs

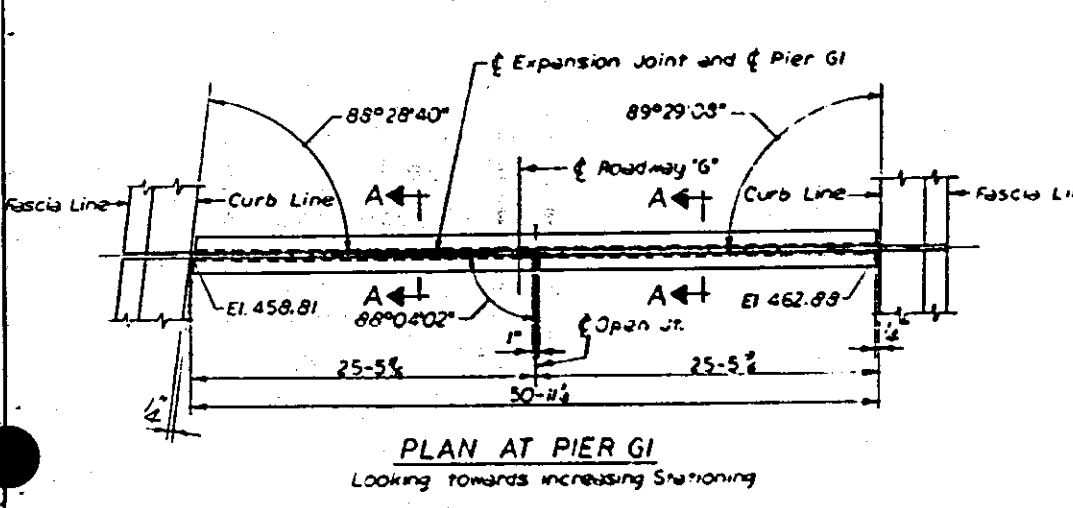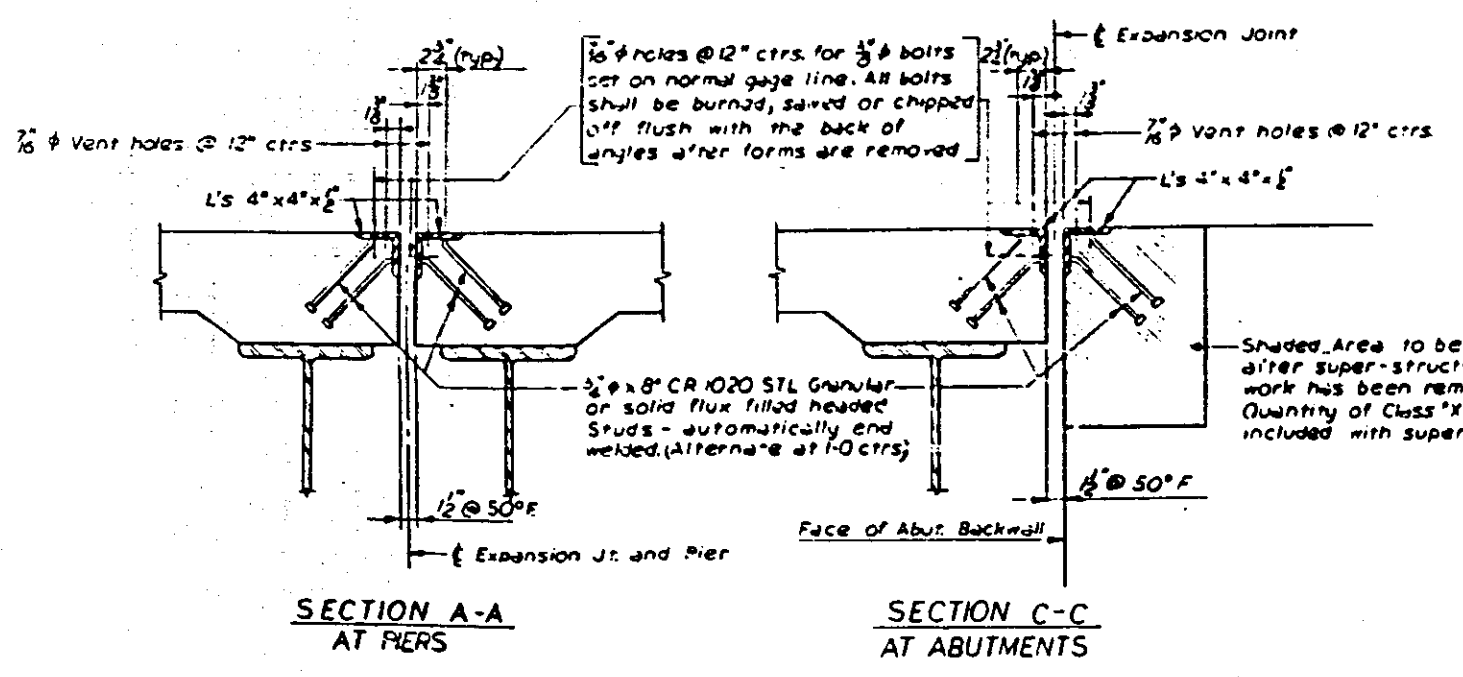


BILL OF MATERIAL

ITEM	UNIT	TOTAL
Structural Steel	Lbs	23,140


NOTE:
The Contractor for Section 82-3 HVF & E-1 will furnish all expansion devices shown on this sheet. See Special Provisions.
The Contractor for Section 82-3 HVD-1 will erect the expansion devices as shown on this sheet. See Special Provisions.

ROUTE NO	SECTION	COUNTY	SHEET NO
F A I 70	B2-3HVF B E-1 B2-3HVD-1	ST. CLAIR	147 233
FED. ROAD DIV. NO. 4	ILLINOIS	PROJECT	


NOTE:
Stool Spacing to be adjusted to miss Stiffener and Connection Plates on Floor Beams

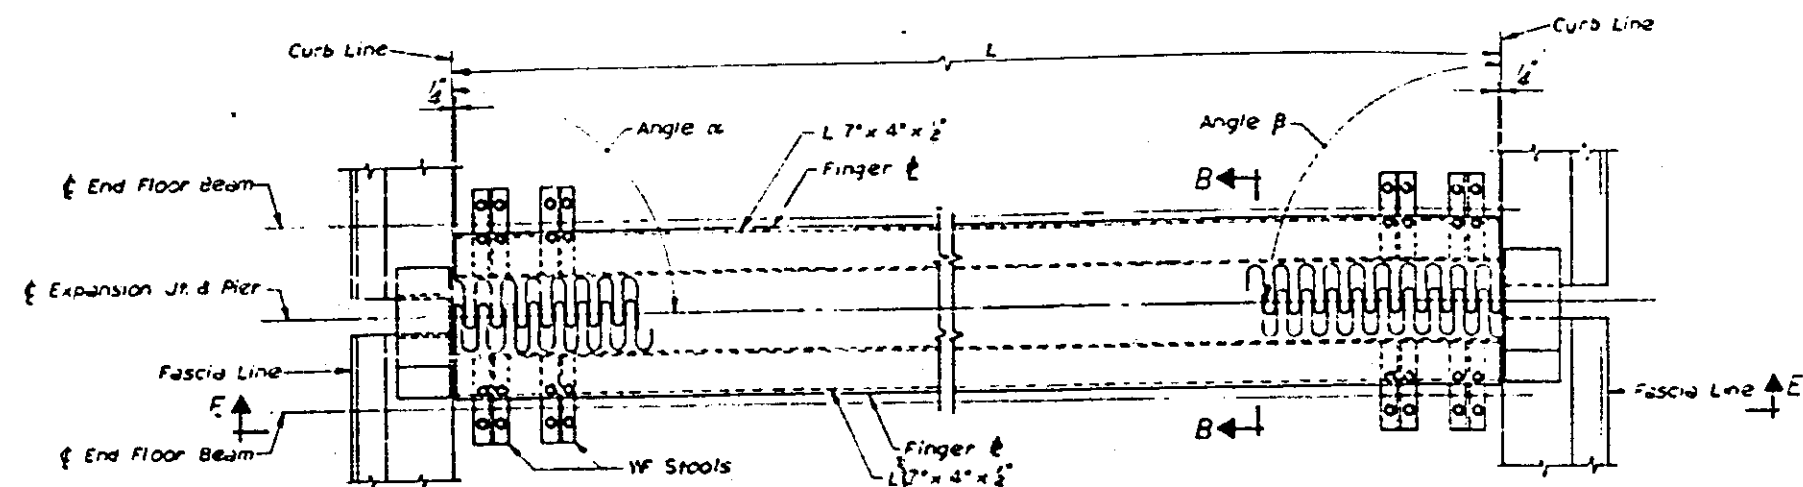


PLAN AT PIERS A8, A15, A18, D8, D15, D22, D28, D33, G5, H2, M12, N5, O3, O14, P4, P10, R3, S7 AND S18
LOOKING TOWARDS INCREASING STA.

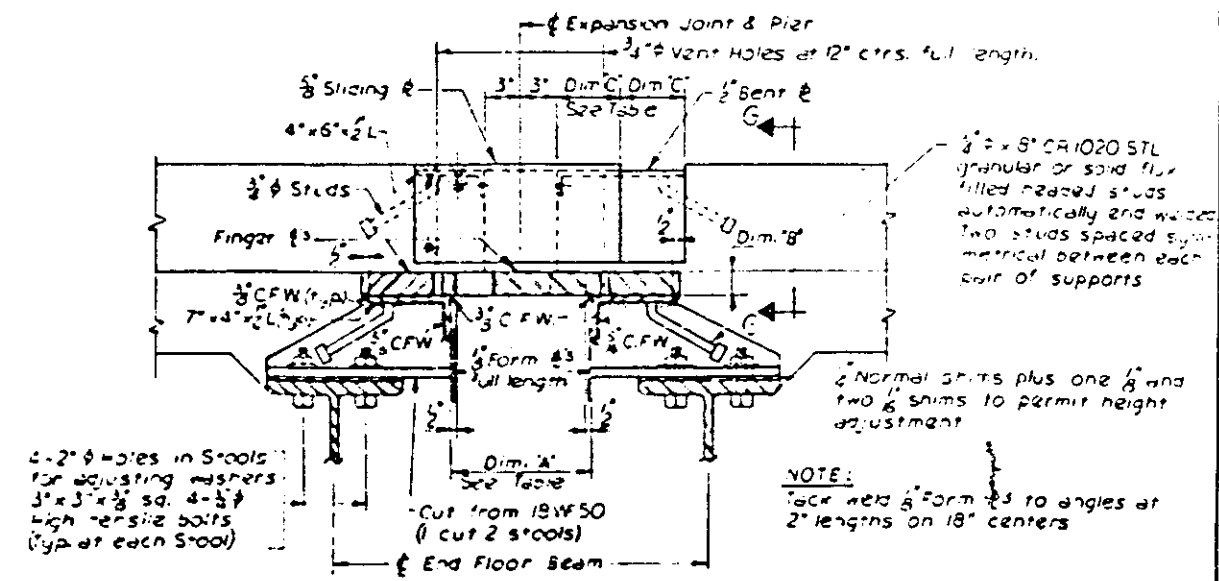


SECTION B-B

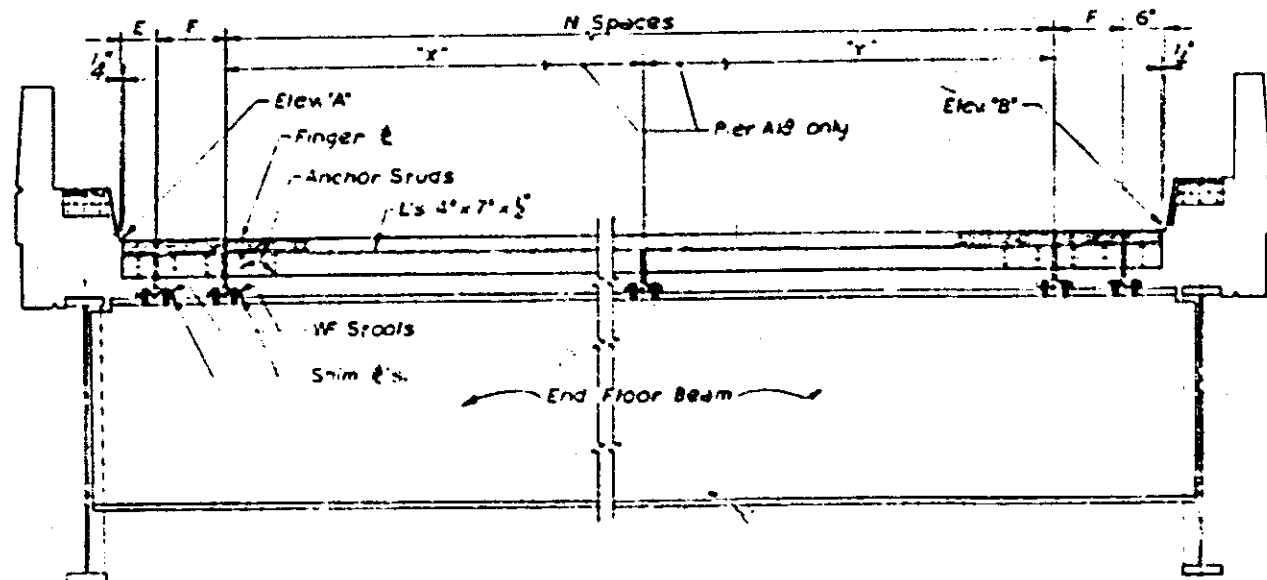

SECTION E-E

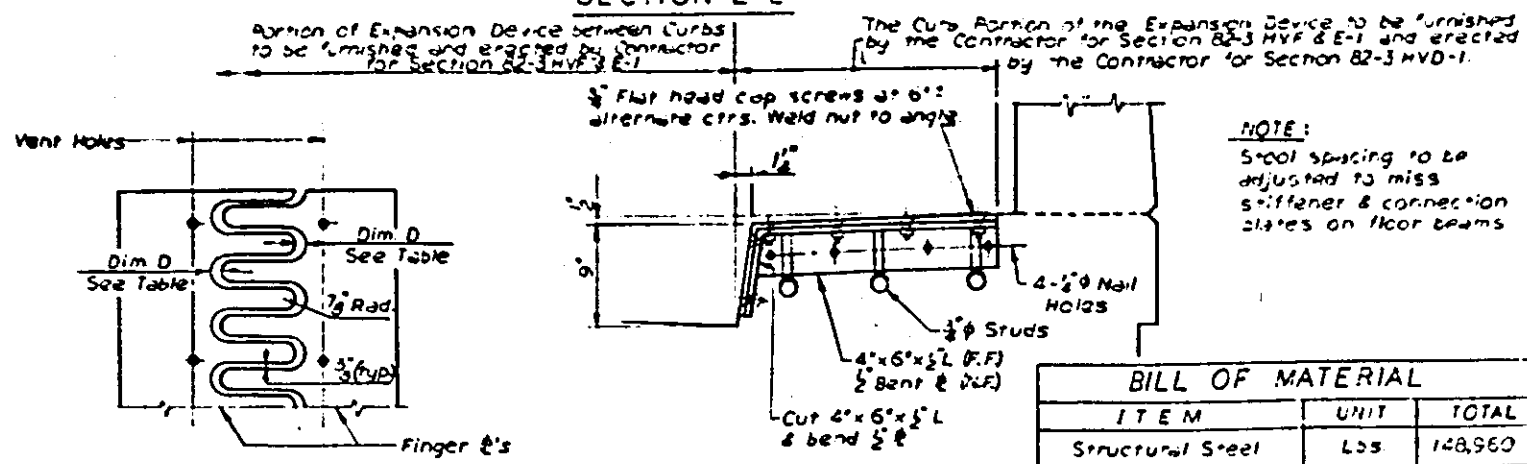

SECTION G-G

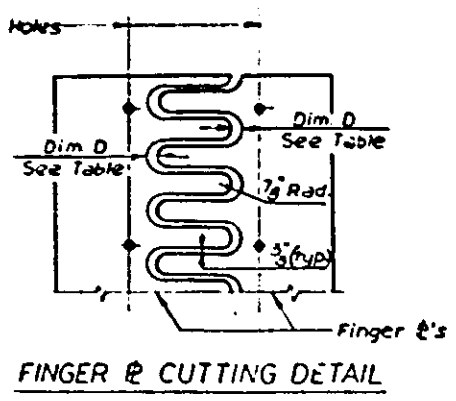

FINGER & CUTTING DETAIL

BILL OF MATERIAL

ITEM	UNIT	TOTAL
Structural Steel	LBS	148,960

Temperature range =
-30°F. to +130°F.
with +50°F. = Normal.

TABLE OF ELEVATIONS, LENGTHS, ANGLES AND WEIGHTS OF FINGER EXPANSION DEVICES

PIER NO	ELEV. 'A'	ANGLE alpha	L	ANGLE beta	ELEV. 'B'	E	F	N SPACES	WEIGHT
A8	228.29	9° 00' 00"	30'-0"	0° 00' 00"	228.89	6"	1'-6"	13 Spaces @ 20" = 26'-0"	10,370 lbs.
A15	249.64	9° 24' 00"	35'-0"	0° 00' 00"	252.24	6"	1'-6"	15 Spaces @ 20" = 30'-0"	9,560 lbs.
A18	250.13	9° 26' 00"	43'-0"	0° 00' 00"	254.03	6"	1'-6"	See Note 'A'	11,900 lbs.
D8	447.47	9° 00' 00"	43'-7"	0° 00' 00"	451.17	1'-0"	1'-6"	21 Spaces @ 18" = 37'-6"	11,450 lbs.
D15	445.38	9° 00' 00"	37'-0"	0° 00' 00"	451.18	6"	1'-6"	13 Spaces @ 20" = 26'-0"	7,970 lbs.
D22	446.38	9° 00' 00"	37'-7"	0° 00' 00"	449.10	7"	1'-9"	17 Spaces @ 18" = 30'-6"	9,950 lbs.
D28	451.70	9° 00' 00"	30'-0"	0° 00' 00"	451.70	6"	1'-6"	13 Spaces @ 20" = 26'-0"	8,220 lbs.
D33	451.98	9° 00' 00"	30'-0"	0° 00' 00"	453.58	6"	1'-6"	13 Spaces @ 20" = 26'-0"	8,070 lbs.
G5	257.41	9° 00' 00"	37'-7"	0° 00' 00"	260.18	7"	1'-9"	15 Spaces @ 20" = 30'-0"	10,750 lbs.
H2	226.78	8° 54' 00"	38'-2"	0° 00' 00"	229.75	10"	1'-6"	9 Spaces @ 20" = 18'-0"	2,730 lbs.
M12	249.39	9° 00' 00"	33'-0"	0° 00' 00"	249.56	6"	1'-6"	9 Spaces @ 20" = 18'-0"	6,000 lbs.
N5	249.69	9° 00' 00"	33'-0"	0° 00' 00"	247.92	6"	1'-3"	9 Spaces @ 20" = 18'-0"	5,860 lbs.
O3	260.18	9° 00' 00"	33'-0"	0° 00' 00"	258.22	6"	1'-6"	9 Spaces @ 20" = 18'-0"	6,010 lbs.
O14	245.32	9° 00' 00"	33'-0"	0° 00' 00"	236.77	6"	1'-6"	9 Spaces @ 20" = 18'-0"	6,100 lbs.
P4	271.49	9° 00' 00"	33'-0"	0° 00' 00"	269.73	6"	1'-5"	9 Spaces @ 20" = 18'-0"	5,760 lbs.
P10	261.04	9° 00' 00"	33'-0"	0° 00' 00"	260.72	6"	1'-5"	9 Spaces @ 20" = 18'-0"	6,060 lbs.
R3	261.51	9° 00' 00"	33'-0"	0° 00' 00"	253.28	6"	1'-5"	9 Spaces @ 20" = 18'-0"	6,060 lbs.
S7	272.36	9° 00' 00"	33'-0"	0° 00' 00"	272.12	6"	1'-6"	9 Spaces @ 20" = 18'-0"	5,970 lbs.
S18	229.22	9° 00' 00"	27'-0"	0° 00' 00"	228.75	6"	1'-5"	8 Spaces @ 20" = 16'-0"	6,270 lbs.

NOTE 'A': For Dim 'x' use 12 Spaces @ 18" = 21'-0"; for 'y' Dim use 13 Spaces @ 15" = 19'-5"

EXPANSION DEVICE TABLE

PIER NO	Dimen. 'A' at 50° F	Dimen. 'B' at 50° F	Dimen. 'C' at 50° F	Dimen. 'D' at 50° F
A8	11 1/2"	1 1/2"	3 1/2"	3 1/2"
A15	12 1/2"	1 1/2"	4"	3 1/2"
A18	9 1/2"	1 1/2"	3"	2 1/2"
D8	11 1/2"	1 1/2"	3 1/2"	3 1/2"
D15	11 1/2"	1 1/2"	3 1/2"	3 1/2"
D22	12 1/2"	1 1/2"	4"	3 1/2"
D28	13"	1 1/2"	4"	3 1/2"
D33	12 1/2"	1 1/2"	4"	3 1/2"
G5	15 1/2"	2 1/2"	5"	4 1/2"
H2	9 1/2"	1 1/2"	3"	2 1/2"
M12	12 1/2"	1 1/2"	4"	3 1/2"
N5	14 1/2"	2 1/2"	4 1/2"	4 1/2"
O3	12 1/2"	1 1/2"	4"	3 1/2"
O14	12 1/2"	1 1/2"	4"	3 1/2"
P4	9 1/2"	1 1/2"	3"	2 1/2"
P10	14 1/2"	2 1/2"	4 1/2"	4 1/2"
R3	13"	1 1/2"	4"	3 1/2"
S7	11 1/2"	1 1/2"	3 1/2"	3 1/2"
S18	10"	1 1/2"	3"	2 1/2"

NOTES: The Portions of the Expansion Devices for Piers A1, D1, A25, M6, S10 & S16 that have been stored by the Contractor for Section B2-3 HVB & E-1 and erected by the Erection Contractor indicated in Section '6-6' on this sheet. See Special Provisions.

The Portions of the Expansion Devices for Piers D33, N5, O14, P4 & S18 that can be erected immediately shall be erected by the Erection Contractor indicated in Section '6-6' this Sheet. The Future portions shall be stored by the Contractor for Section B2-3 HVB & E-1 until needed by the Contractors for Sections B2-3 HVB-2 and B2-3 HVB-3

STATE OF ILLINOIS
DEPARTMENT OF PUBLIC WORKS & BLDGS
DIVISION OF HIGHWAYS

EXPANSION DEVICES
FINGER PLATE

POPLAR STREET BRIDGE APPROACHES

F. A. I. 70 ST. CLAIR CO. SECTION 82-3HVF B E-1
82-3HVD-1

W. W. LOCHNER, INC.
ENGINEERS
CHICAGO, ILLINOIS

SHEET 313 OF 326

DESIGNED BY PAS
DRAWN BY PAS
CHECKED BY L.H.V.
APPROVED BY K.A.

ROUTE NO.	SECTION	COUNTY	TOTAL SHEETS	SHEET NO.
FAI 70	82-34VFBE-1	ST. CLAIR	247	241
FED. ROAD DIV. NO. 1		ILLINOIS PROJECT		

Location		Moment						Reaction					
		.4Span G1	.5Span G2	.5Span G3	.6Span G4	Pier G2	Pier G3	Pier G4	Pier G1	Pier G2	Pier G3	Pier G4	Pier G5
Dead	Primary	2090	1900	1793	1671	4673	4630	4053	135	474	453	415	111
Load	Secondary	21	19	18	17	33	37	33	1	1	1	1	1
Live	Primary	1373	1400	1376	1300	1568	1580	1490	83	137	138	132	79
Load	Secondary	14	14	14	13	13	13	12	1	-	-	-	1
Impact		324	293	290	303	343	350	329	20	30	29	29	19
Centrifugal Force		42	43	42	40	48	52	46	3	4	4	4	2
Total		3869	3663	3533	3344	6683	6762	5983	243	646	625	581	213
Section Modulus		2694	2502	2319	2319	4339	4338	3962	-	-	-	-	-
Torque Loading	Dead Load	5.6	5.1	4.8	4.5	10.3	10.1	8.9					
	Live Load	3.7	3.7	3.7	3.5	3.4	3.7	3.3					
	Impact	0.9	0.8	0.8	0.8	0.8	0.8	0.7					
	Total	10.2	9.6	9.3	8.8	14.5	14.6	12.9					
Section Modulus		81.0	74.3	67.5	67.5	135.0	135.0	121.5					

Location		Moment						Reaction					
		.4Span G5	.5Span G6	.5Span G7	.6Span G8	Pier G6	Pier G7	Pier G8	Pier G5	Pier G6	Pier G7	Pier G8	Pier G9
Dead	Primary	1603	1462	1432	1483	3589	3629	3405	105	372	366	355	98
Load	Secondary	16	14	14	15	29	29	27	1	1	1	1	1
Live	Primary	1270	1265	1232	1170	1472	1540	1380	78	131	131	125	73
Load	Secondary	13	13	12	12	12	11	11	1	-	-	-	1
Impact		305	265	263	264	322	336	310	18	29	29	28	17
Centrifugal Force		47	47	45	43	54	57	51	3	5	5	5	3
Total		3251	3069	2995	3033	5478	5603	5184	206	538	531	514	193
Section Modulus		2135	2135	2135	2135	3587	3779	3403	-	-	-	-	-
Torque Loading	Dead Load	3.5	3.3	3.2	3.5	6.6	6.7	6.6					
	Live Load	2.8	2.8	2.8	2.7	2.7	2.8	2.6					
	Impact	0.7	0.6	0.6	0.7	0.6	0.6	0.6					
	Total	7.1	6.7	6.6	6.9	9.9	10.1	9.8					
Section Modulus		60.8	60.8	60.8	60.8	103.0	114.8	101.8					

Location		Moment			Reaction		
		.4Span G9 & .5Span G11	.5Span G10	Piers G10 & G11	Piers G9 & G11	Piers G10 & G11	Piers G9 & G11
Dead	Primary	1511	1532	3537	99	370	
Load	Secondary	15	15	31	1	1	
Live	Primary	1212	1232	1470	73	125	
Load	Secondary	12	12	12	1	-	
Impact		283	255	327	17	28	
Centrifugal Force		44	42	50	2	4	
Total		3077	3083	5727	193	528	
Section Modulus		2135	2135	3823	-	-	
Torque Loading	Dead Load	3.9	4.0	8.1			
	Live Load	3.2	3.1	3.1			
	Impact	0.7	0.7	0.7			
	Total	7.8	7.8	11.9			
Section Modulus		60.8	60.8	121.5			

Location		Moment			Reaction		
		.4Span G12	.6Span G13	Pier G13	Pier G12	Pier G13	Abut. G14
Dead	Primary	1376	1629	4021	145	478	124
Load	Secondary	20	16	32	1	1	1
Live	Primary	1507	1424	1415	107	158	102
Load	Secondary	15	14	11	1	-	1
Impact		370	354	345	27	39	25
Centrifugal Force		28	26	26	2	3	2
Total		3916	3463	5850	283	679	255
Section Modulus		2694	2319	3962	-	-	-
Torque Loading	Dead Load	5.2	4.3	8.7			
	Live Load	3.9	3.8	3.0			
	Impact	1.0	0.9	0.8			
	Total	10.1	9.0	12.5			
Section Modulus		81.0	67.5	121.5			

Location		Moment				Reaction				
		.4Span H2	.5Span H3	.6Span H4	Pier H3	Pier H4	Pier H2	Pier H3	Pier H4	Abut. H5
Dead	Primary	2175	2053	2012	4936	4736	126	448	433	118
Load	Secondary	22	21	21	40	38	1	1	1	1
Live	Primary	1523	1517	1468	1735	1691	81	140	137	80
Load	Secondary	15	15	15	14	14	1	-	-	1
Impact		340	300	331	366	360	18	30	29	18
Centrifugal Force		58	53	56	66	64	3	5	5	3
Total		4133	3964	3903	7157	6903	230	624	605	221
Section Modulus		2873	2695	2873	4906	4906	-	-	-	-
Torque Loading	Dead Load	8.0	7.6	7.4	14.9	14.2				
	Live Load	5.5	5.5	5.4	5.2	5.1				
	Impact	1.3	1.1	1.2	1.1	1.1				
	Total	14.8	14.2	14.0	21.2	20.4				
Section Modulus		87.8	81.0	87.8	155.3	155.3				

STATE OF ILLINOIS
DEPARTMENT OF PUBLIC WORKS & BLDGS.
DIVISION OF HIGHWAYS
STRESS TABLES
POPLAR STREET BRIDGE APPROACHES
ROADWAYS 'B' & 'W'
FAI 97 70 ST. CLAIR CO. SECTION 82-34VFBE-1
H. W. LOCHNER, INC.
ENGINEERS
CHICAGO, ILLINOIS
SHEET
371 of 526

ROUTE NO.	SECTION	COUNTY	TOTAL SHEETS	SHEET NO.
F. A. I. 70	82-3MVFB E-4	ST. CLAIR	247	246
FED. ROAD DIV. NO. 4		ILLINOIS	PROJECT	

ROADWAY A		
Pier No.	Girder	
	A 1	A 2
A1 - Span A1	441.30	442.11
A2	437.51	438.33
A3	435.03	436.05
A4	434.50	436.54
A5 - Span A4	433.94	437.69
A5 - Span A5	433.39	437.63
A6	437.02	439.47
A7	437.11	439.67
A8 - Span A7	438.17	440.73
A8 - Span A8	439.17	440.73
A9	437.44	440.00
A10	438.76	441.32
A11 - Span A10	439.73	442.29
A11 - Span A11	439.73	442.29
A12 - Span A11	439.09	442.68
A12 - Span A12	439.09	442.63
A13	439.23	442.63
A14	437.73	442.58
A15 - Span A14	439.97	442.93
A15 - Span A15	439.97	442.93
A16	438.39	442.93
A17	439.29	443.77
A18 - Span A17	439.71	443.52
A19 - Span A18	442.71	443.52
A19	439.43	443.52
A20	441.75	443.87
A21 - Span A20	444.51	447.74
A21 - Span A21	443.51	447.74
A22	441.29	447.45
A23	442.57	448.85
A24	443.39	448.60
A25 - Span A24	442.10	449.54

RAMP M		
Pier No.	Girder	
	M1	M2
M6 - Span M7	429.44	428.36
M7	427.73	425.86
M8	423.77	421.87
M9 - Span M9	429.65	427.93
M9 - Span M10	429.65	427.93
M10	428.00	427.30
M11	426.10	425.56
M12 - Span M12	421.66	422.74
M12 - Span M13	421.66	422.74
M13	427.70	429.25
M14	426.30	427.72
M5 - Span M14	423.92	427.43

RAMP R		
Pier No.	Girder	
	R1	R2
R21 - Span R2	424.51	424.22
R1	423.74	420.60
R2	427.45	423.37
R3 - Span R2	423.73	425.41
R3 - Span R3	423.73	425.41
R4	423.06	425.32
R1	423.41	425.31
R1 - Span R1-R	422.09	425.38

ROADWAY D		
Pier No.	Girder	
	D1	D2
D1 - Span D1	442.44	441.90
D2	439.79	438.47
D3	437.20	436.50
D4	436.70	436.40
D5 - Span D4	437.45	436.93
D5 - Span D5	437.45	436.93
D6	437.46	436.71
D7	437.25	436.62
D8 - Span D7	439.07	438.28
D8 - Span D8	438.07	438.28
D9	436.62	438.15
D10	437.34	438.53
D11 - Span D10	438.26	438.25
D11 - Span D11	438.26	441.07
D12 - Span D11	439.79	438.55
D12 - Span D12	437.79	440.55
D13	437.77	442.53
D14	439.73	442.29
D15 - Span D14	441.36	443.62
D15 - Span D15	441.06	443.62
D16	440.27	443.33
D17	440.20	442.76
D18 - Span D17	439.30	441.61
D18 - Span D18	439.36	441.61
D19	438.51	440.33
D20	437.72	437.63
D21 - Span D20	437.63	437.79
D22 - Span D21	437.63	437.79
D23 - Span D21	436.70	437.57
D24 - Span D22	436.70	437.57
D25	435.33	437.56
D26	433.67	437.36
D27	435.73	437.26
D28 - Span D25	437.16	439.79
D28 - Span D26	436.66	439.79
D27	437.71	441.13
D28 - Span D27	443.50	441.65
D28 - Span D28	443.50	441.65
D29	443.31	440.75
D30	441.67	442.11
D31	441.76	441.60
D32	441.22	441.36
D33 - Span D32	440.43	442.24

RAMP N		
Pier No.	Girder	
	N1	N2
N1 - Span D11-N	442.09	440.33
N1 - Span D11-N	442.09	441.73
N1 - Span N1	442.09	441.73
N2	442.37	443.63
N3	441.61	443.67
N4	440.52	443.70
N5 - Span N4	429.66	438.34

RAMP Q		
Pier No.	Girder	
	Q1	Q2
D25 - Span D26-Q	437.16	440.66
Q1	440.33	442.30
Q2	441.63	443.57
P14 - Span Q2	442.80	441.63

ROADWAY G		
Pier No.	Girder	
	G1	G2
G1 - Span G1	449.15	453.38
G2	449.34	452.41
G3	447.13	450.75
G4	447.19	450.47
G5 - Span G4	449.09	451.01
G5 - Span G5	449.09	451.01
G6	448.53	451.15
G7	448.27	451.70
G8	448.27	451.35
G9 - Span G8	448.26	449.32
G9 - Span G9	448.26	449.32
G10	448.20	449.62
G11	448.20	449.36
G12 - Span G11	448.27	451.33
G12 - Span G12	448.27	449.63
G13	448.23	449.42
G14 - Abutment	448.23	449.42

RAMPS		
Pier No.	Girder	
	S1	S2
S12 - Span S1	427.41	427.43
S1	421.32	423.34
S2	423.33	425.35
S3 - Span S2	423.33	423.33
S3 - Span S2	423.33	423.33
S4	422.37	423.33
S5	427.37	426.26
S6	426.33	424.10
S7 - Span S7	426.73	425.01
S7 - Span S8	426.73	425.01
S8	429.33	427.31
S9	427.31	427.37
S10 - Span S10	426.22	424.60
S10 - Span S10	426.22	427.09
S11	427.55	425.33
S12 - Span S12	424.70	423.11
S13 - Span S13	421.49	420.68

RAMP O		
Pier No.	Girder	
	O1	O2
O1 - Span O1	452.87	453.75
O1	452.71	450.73
O2	452.51	450.59
O3 - Span O3	452.51	450.59
O3 - Span O4	452.51	450.59
O4	449.47	448.40
O5	445.43	445.30
O6 - Span O6	441.53	442.13
O6 - Span O7	441.53	442.13
O7 - Span O7	437.73	438.87
O7 - Span O8	437.73	438.87
O8	430.87	432.74
O9	424.22	426.13
O10 - Abutment	420.30	422.22
O11 - Abutment	416.36	418.45
O12	419.62	420.27
O13	424.06	424.54
O14 - Span O14	428.53	429.32

ROADWAY H		
Pier No.	Girder	
	H1	H2
H1 - Span H1	459.71	463.2
H2 - Span H1	458.57	459.73
H2 - Span H2	458.57	459.73
H3	453.60	456.73
H4	452.35	457.73
H5 - Abutment	451.36	455.51

RAMP P		
Pier No.	Girder	
	P1	P2
P2 - Span P2	432.24	432.34
P3	421.33	423.36
P4	422.33	423.01
P5 - Span P5	422.59	422.67
P5 - Span P6	422.59	422.67
P6	422.25	421.53
P7	427.37	426.33
P8 - Span P8	423.77	423.63
P8 - Span P9	423.77	423.63
P9	423.72	423.37
P10	422.13	423.36
P11	421.36	423.53
P12 - Span P12	420.35	422.29
P12 - Span P14	420.35	423.33
P13 - Span P14	420.35	423.33
P14 - Span P14	420.35	423.33
P15 - Span P15	419.71	423.72

Note: Bearing Elevations are to Top of Concrete Piers or Abutments.

STATE OF ILLINOIS
DEPARTMENT OF PUBLIC WORKS & BLDGS.
DIVISION OF HIGHWAYS
BEARING ELEVATIONS
POPLAR STREET BRIDGE APPROACHES
F. A. I. R. 70 ST. CLAIR CO. SECTION 82-3MVFB E-4
H. W. LOCHNER, INC. ENGINEERS
SHEET 246

DESIGNED BY
DRAWN BY
CHECKED BY

STATE OF ILLINOIS
DEPARTMENT OF PUBLIC WORKS AND BUILDINGS
DIVISION OF HIGHWAYS
PLANS FOR PROPOSED
FEDERAL AID HIGHWAY

F. A. I. ROUTE 70 SECTION 82-3HVB-1
 PROJECT I-IG-70-1(78)0
POPLAR STREET BRIDGE APPROACHES
 ST. CLAIR COUNTY
 C-98-010-65

ROUTE NO.	SECTION	COUNTY	TOTAL SHEETS	SHEET NO.
F. A. I. -70	82 3HVB-1	ST. CLAIR	207	1
FED. ROAD DIV. NO. 4		ILLINOIS	PROJECT T-68-70-1(78)0	

P-98-087-00

DESCRIPTION OF PROJECT
 SECTION 82-3HVB-1 INCLUDES THE COMPLETE CONSTRUCTION OF THE FOLLOWING:

ROADWAY A	23-REINFORCED CONCRETE PIERS
ROADWAY D	51-REINFORCED CONCRETE PIERS
ROADWAY G	12-REINFORCED CONCRETE PIERS 1-R. C. PILE BENT ABUTMENT
ROADWAY H	4-REINFORCED CONCRETE PIERS 1-R. C. PILE BENT ABUTMENT
RAMP M	8-REINFORCED CONCRETE PIERS
RAMP N	5-REINFORCED CONCRETE PIERS
RAMP O	12-REINFORCED CONCRETE PIERS 2-R. C. PILE BENT ABUTMENTS
RAMP P	12-REINFORCED CONCRETE PIERS
RAMP Q	2-REINFORCED CONCRETE PIERS
RAMP R	4-REINFORCED CONCRETE PIERS
RAMP S	12-REINFORCED CONCRETE PIERS


THE POPLAR STREET BRIDGE APPROACHES FOR THIS SECTION CARRY THE FOLLOWING:
 ROADWAY A OVER THE TRACKS OF THE TERMINAL R. R. ASSOCIATION, GULF, MOBILE AND OHIO AND ILLINOIS CENTRAL RAILROADS AND RAMP O;
 ROADWAY D OVER THE TRACKS OF THE TERMINAL R. R. ASSOCIATION, GULF, MOBILE AND OHIO, ILLINOIS CENTRAL AND SOUTHERN RAILROADS, RAMP O AND ILLINOIS ROUTE 5;
 ROADWAY G OVER TRENDLEY AND PIGGOTT AVENUES;
 ROADWAY H OVER THE ILLINOIS CENTRAL RAILROAD;
 RAMP M OVER ROADWAY A AND THE TRACKS OF THE TERMINAL R. R. ASSOCIATION AND THE GULF, MOBILE AND OHIO RAILROADS;
 RAMP N OVER THE TRACKS OF THE TERMINAL R. R. ASSOCIATION AND GULF, MOBILE AND OHIO RAILROADS;
 RAMP O OVER THE ILLINOIS CENTRAL RAILROAD;
 RAMP P OVER ROADWAY D, FUTURE ACCESS ROADS AND THE ILLINOIS CENTRAL RAILROAD;
 RAMP Q OVER THE ILLINOIS CENTRAL RAILROAD;
 RAMP R OVER THE ILLINOIS CENTRAL RAILROAD AND A FUTURE ACCESS ROAD;
 RAMP S OVER TRENDLEY AVENUE AND ROADWAY H.
 THIS SECTION ALSO INCLUDES SYSTEM GROUNDING AND ALL APPURTENANT AND COLLATERAL WORK NECESSARY TO COMPLETE THE PROJECT AS SHOWN ON THE PLANS.
 PER D-17 & C-2 CONSTRUCTED UNDER SECTION 82-3HVB

NOTE:
 FOR INDEX OF SHEETS AND SUMMARY OF QUANTITIES SEE SHEET NO. 2


ROAD CLASSIFICATION:
 ROADWAY "A" 4277-T-50
 ROADWAY "D" 4277-T-50
 ROADWAY "G" 1522-T-50
 ROADWAY "H" 1522-T-50

LENGTH OF PROJECT
 3857.90 FT. = 0.730 MILES

CONTRACT NO. 24504

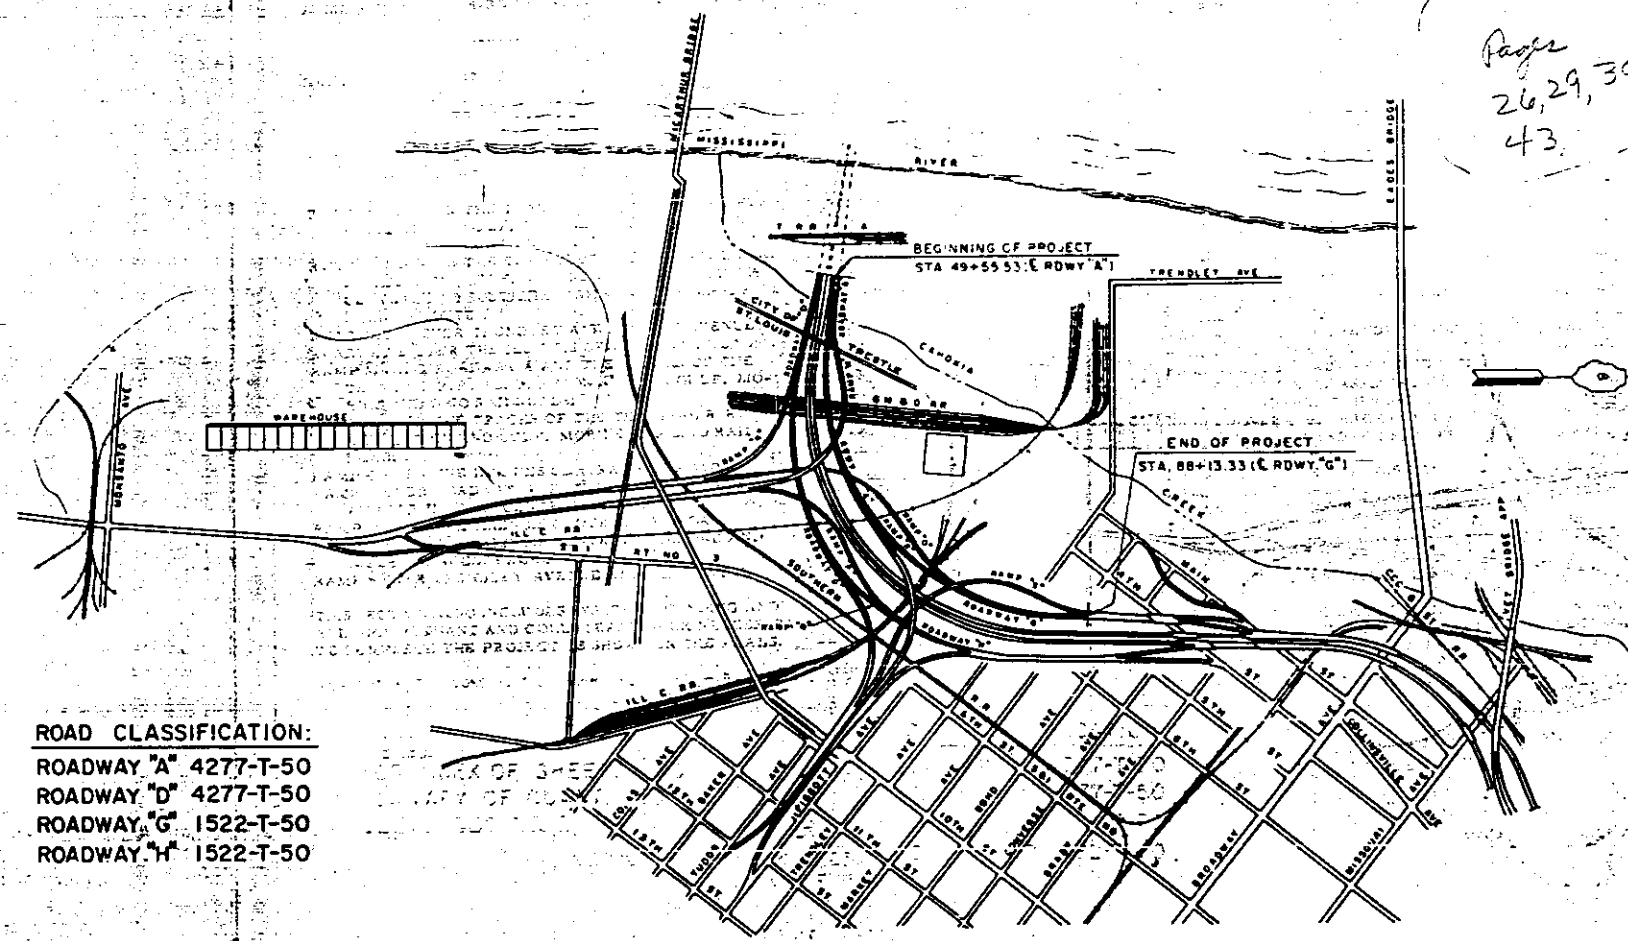

Page
 26, 29, 30, 33
 43

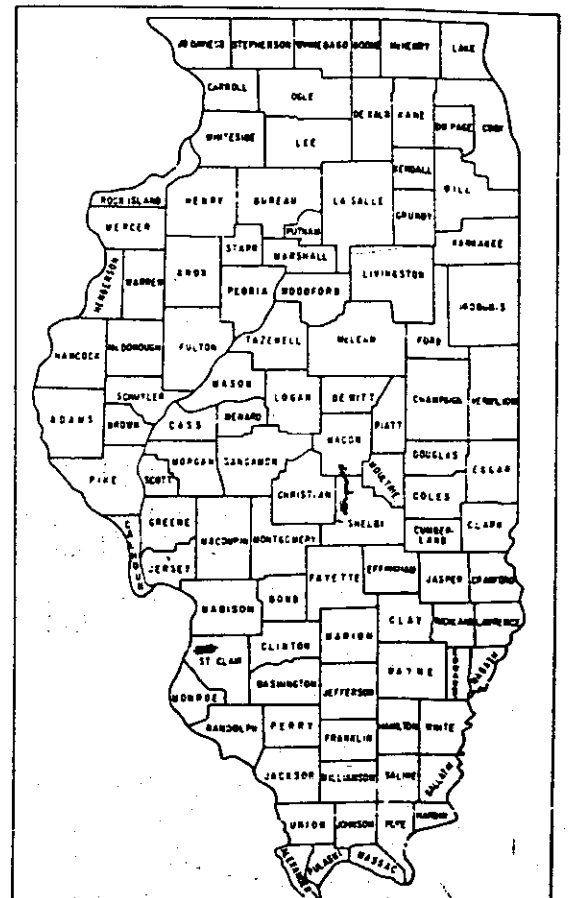

LOCATION OF SECTION INDICATED THUS: [Symbol]

APPROVED

Robert S. Knoch

STATE OF ILLINOIS
 DEPARTMENT OF PUBLIC WORKS AND BUILDINGS
 DIVISION OF HIGHWAYS
 11-30-65
 Robert S. Knoch
 January 11, 1966
 G. W. Van Cleave
 January 21, 1966
 J. P. Allen
 January 21, 1966
 R. M. ...

8-54


DEPARTMENT OF COMMERCE
 BUREAU OF PUBLIC ROADS

APPROVED

DISTRICT ENGINEER DATE

H. W. LOCHNER, INC.
 ENGINEERS
 CHICAGO, ILLINOIS

CITY OF EAST ST. LOUIS
 LOCATION PLAN

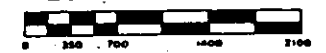

2257
Marion ...
 Aug. 27, 1965

082-0256

ROUTE NO.	SECTION	COUNTY	TOTAL SHEETS	SHEET NO.
F. A. I. 70	B2-3HVB-1	ST. CLAIR	207	2
FED. ROAD DIV. NO. 4		ILLINOIS	PROJECT	

INDEX OF SHEETS
SECTION 82-3 HVB - 1

SHEET NO.	TITLE
1	TITLE SHEET
2	INDEX OF SHEETS, SUMMARY OF QUANTITIES, GENERAL NOTES
3	ELECTRICAL GROUNDING DETAILS
4 AND 5	PLAN OF EXISTING CONDITIONS AND UTILITIES
6 THRU 10	RIGHT OF WAY PLANS (FOR INFORMATION ONLY)
11	LIST OF BENCH MARKS, TIES TO TRAVERSE LINE AND GENERAL PLAN OF TRAVERSE LINE
12 THRU 16	ALIGNMENT PLANS
17 THRU 19	LIST OF COORDINATE POINTS AND DESCRIPTIONS
20	KEY PLAN, GENERAL NOTES AND BILL OF MATERIAL
21 THRU 25	GENERAL PLANS
26 THRU 44	PLAN AND ELEVATION
45 THRU 53	GEOMETRIC LAYOUTS
54	BEARING ELEVATIONS
55 THRU 58	ABUTMENTS
59 THRU 137	PIERS
138 THRU 141	RAILROAD PROFILES
142 THRU 203	BORING LOGS
204	CONCRETE PILE DETAILS
205	STANDARDS 1686-2, 2153-4
206	STANDARD 2113-1, 2114
207	STANDARD 1977-3

SUMMARY OF QUANTITIES
SECTION 82-3HVB-1

CODE NO.	ITEM	UNIT	TOTAL QUANTITY	I 87.9%	I G 12.1%
Z01398	ENGINEER'S FIELD OFFICE TYPE "A"	EACH	1	0.9	0.1
Z01379	ENGINEER'S FIELD LABORATORY	EACH	1	0.9	0.1
010001	TREE REMOVAL (5 TO 15 INCH DIAMETER)	IN. DIA.	322	283	39
010002	TREE REMOVAL (OVER 15 INCH DIAMETER)	IN. DIA.	98	86	12
016001	EMBANKMENT	CU. YD.	354	311	43
050001	CLASS A EXCAVATION FOR STRUCTURES	CU. YD.	19,137	16,921	2,316
052003	CLASS "X" CONCRETE	CU. YD.	17,931.9	15,762.1	2,169.8
059001	REINFORCEMENT BARS	POUND	2,413,060	2,120,080	292,980
060004	FURNISHING CREOSOTED PILES (UP TO 20 FEET)	LIN. FT.	128	112	16
060005	FURNISHING CREOSOTED PILES (20.1 TO 38 FEET)	LIN. FT.	393	345	48
060008	DRIVING TIMBER PILES	LIN. FT.	521	458	63
060043	DRIVING CONCRETE PILES	LIN. FT.	148,118	130,196	17,922
060044	FURNISHING CONCRETE PILES	LIN. FT.	148,118	130,196	17,922
060047	TEST PILE CONCRETE	EACH	129	113	16
083002	SLOPE WALL 4 INCH	SQ. YD.	1,018	895	123
L05066	SYSTEM GROUNDING	LUMP SUM	1	0.9	0.1
Z01023	BRIDGE SEAT SEALANT	LUMP SUM	1	0.9	0.1
Z01065	RAILROAD PROTECTIVE SERVICES	LUMP SUM	1	0.9	0.1

GENERAL NOTES

• THE STANDARD SPECIFICATIONS FOR ROAD AND BRIDGE CONSTRUCTION ADOPTED JANUARY 2, 1958, THE SUPPLEMENTAL SPECIFICATIONS IN EFFECT ON DATE OF INVITATION FOR BIDS, AND THE STANDARD SPECIFICATIONS FOR TRAFFIC SIGNALS, ADOPTED JUNE 1, 1959 SHALL GOVERN THIS CONSTRUCTION.

• ALL ELEVATIONS REFER TO U.S.G.S. MEAN SEA LEVEL DATUM.

• THE PROFILE GRADE LINE REFERS TO THE GRADE ELEVATION AT THE POINT SHOWN ON THE TYPICAL SECTIONS AND PLANS.

• POSITIVE PROFILE GRADES ARE IN THE DIRECTION OF TRAFFIC AND HIGHER ELEVATIONS.

• NEGATIVE PROFILE GRADES ARE IN THE DIRECTION OF TRAFFIC AND LOWER ELEVATIONS.

• BUILDINGS WITHIN R. O. W. LIMITS HAVE BEEN REMOVED OR ARE IN THE PROCESS OF BEING REMOVED DOWN TO EXISTING GROUND LEVEL AND BASEMENTS BACKFILLED WITH BRICK OR MASONRY RUBBLE AND SAND TO FILL THE VOIDS.

• THE FOLLOWING UTILITY COMPANIES HAVE FACILITIES WITHIN THE LIMITS OF CONSTRUCTION WHICH MAY REQUIRE ADJUSTMENTS:

EAST ST. LOUIS AND INTERURBAN WATER COMPANY
ILLINOIS POWER COMPANY
SOUTHWESTERN BELL TELEPHONE COMPANY
UNION ELECTRIC COMPANY
WESTERN UNION TELEGRAPH COMPANY

• WHERE REINFORCING BAR MARKS ARE REFERENCED TO "NOTE X-SHEET 35" THE FIRST 2 OR 3 DIGITS CORRESPOND TO THE SHEET NUMBER AND ARE SHOWN ON THE DRAWING.
• WHERE SECTION OR SUB-SECTION STONES ARE ENCOUNTERED THE ENGINEER SHALL BE NOTIFIED BEFORE SUCH STONES ARE REMOVED. THE CONTRACTOR SHALL PROTECT & CAREFULLY PRESERVE ALL PROPERTY MARKS UNTIL AN OWNER OR AUTHORIZED SURVEYER OR AGENT HAS WITNESSED OR OTHERWISE REFERENCED THERE LOCATION.

Excavation for portions of structures in the embankments shall not be classified.

STATE OF ILLINOIS
DEPARTMENT OF PUBLIC WORKS & BLDGS.
DIVISION OF HIGHWAYS

INDEX OF SHEETS
SUMMARY OF QUANTITIES
GENERAL NOTES

F. A. I. RT. 70 ST. CLAIR CO. SECTION 82-3HVB-1
H. W. LOCHNER, INC.
ENGINEERS
CHICAGO, ILLINOIS

SHEET
OF

B.M. #26 Elev. 404.396
 X-Cut in NW corner of concrete abutment
 at center pier of Ill. Central R.R. Bridge
 over Ill. Rte. 3

ROUTE NO.	SECTION	COUNTY	TOTAL SHEETS	SHEET NO.
F.A.I.-70	82-3HVB-1	ST. CLAIR	207	20
FED. ROAD DIV. NO. 4		ILLINOIS PROJECT		
		82-3HVF & E-1		19
		82-3HVD-1		54

GENERAL NOTES

COARSE AGGREGATE TO BE USED IN PARAPET HANDRAILS AND END POST MUST BE ABSOLUTELY FREE OF CHEART, FLINT, LIMONITE, LIGNITE AND SOFT SANDSTONE.

THE CONCRETE FLOOR SLAB SHALL BE FINISHED IN ACCORDANCE WITH ARTICLE 51.19 OF THE STANDARD SPECIFICATIONS.

SLOPE WALL SHALL BE REINFORCED WITH WELDED WIRE FABRIC 6" X 6" MESH, #4 WIRES WEIGHING 58 LBS. PER 100 SQ. FT.

ALL REINFORCEMENT BARS SHALL BE LAPPED 20 DIAMETERS UNLESS OTHERWISE SHOWN.

ALL WELDING SHALL CONFORM TO THE STANDARD SPECIFICATIONS FOR WELDED HIGHWAY AND RAILWAY BRIDGES OF THE AMERICAN WELDING SOCIETY, AWS D2. 0-63.

ALL STRUCTURAL STEEL SHALL CONFORM TO A. S. T. M. DESIGNATION A-36.

ALL FIELD CONNECTIONS BOLTED, HIGH STRENGTH STEEL BOLTS 7/8" OPEN HOLES 15/16" EXCEPT AS NOTED.

HIGH STRENGTH STEEL BOLT CONNECTIONS SHALL BE IN ACCORDANCE WITH ART. 54.5g OF THE STANDARD SPECS.

ANCHOR BOLTS SHALL BE SET BEFORE BOLTING DIAPHRAGMS OVER SUPPORTS.

ROADWAY EXPANSION GUARDS SHALL BE ASSEMBLED IN THE SHOP IN PROPER POSITION WITH THE ENDS IN PLACE AND SHALL BE LEFT ASSEMBLED FOR SHOP INSPECTION.

SEWER PLATES SHALL BE FLAME CUT AS PROVIDED IN ARTICLE 54.5 (1) OF THE STANDARD SPECIFICATIONS.

ALL SURFACE OF THE EXPANSION GUARD INACCESSIBLE AFTER ERECTION SHALL BE GIVEN TWO SHOP COATS OF RED LEAD PAINT. THE CONTACT SURFACES SHALL BE GIVEN ONE COAT OF RED LEAD PAINT. ANCHOR STUDS SHALL NOT BE PAINTED.

EXPANSION GUARDS ARE INCLUDED IN THE QUANTITY OF STRUCTURAL STEEL. ESTIMATED WEIGHT 105,040 LBS.

EXCEPT AS OTHERWISE PROVIDED, ALL STRUCTURAL STEEL SHALL RECEIVE ONE (1) SHOP COAT OF RED LEAD PAINT AND TWO FIELD COATS OF GREEN PAINT. SEE ARTICLE 56.1 TO 56.3 INCLUSIVE OF THE STANDARD SPECIFICATIONS AND SPECIAL PROVISIONS.

THE CONTRACTOR SHALL DRIVE ONE CONCRETE TEST PILE IN A PERMANENT LOCATION AT EACH ABUTMENT AND EACH PIER AS DIRECTED BY THE ENGINEER BEFORE ORDERING THE REMAINDER OF PILES.

CONCRETE PILES AT ABUTMENTS SHALL BE DRIVEN IN HOLES PRE-CORED THROUGH THE EMBANKMENT IN ACCORDANCE WITH ARTICLE 68.9 (c) OF THE STANDARD SPECIFICATIONS.

CURVED GIRDERS, INTERMEDIATE FLOOR BEAMS AND END FLOOR BEAMS SHALL BE COMPLETELY ASSEMBLED IN THE SHOP IN PROPER POSITION BEFORE REMAINING FIELD CONNECTIONS AND SHALL BE LEFT ASSEMBLED FOR SHOP INSPECTION.

PERMANENT FORMS WILL NOT BE PERMITTED IN FORMING THE CONCRETE FLOOR.

DESIGN STRESSES

$f_c = 1400$ psi Super and Sub
 $f_s = 20,000$ psi Reinforcement
 $f_s = 20,000$ psi Struct. (A-36 Steel)
 $v_c = 75$ psi Footings
 $n = 10$

LOADING HS20-44 & Alt.

Note
 All cross reference sheet numbers shown on the Bridge Plans are the numbers located in the lower right hand corner of each sheet.

STATE OF ILLINOIS
 DEPARTMENT OF PUBLIC WORKS & BLDGS.
 DIVISION OF HIGHWAYS


KEY PLAN, GENERAL NOTES AND BILL OF MATERIAL

POPLAR STREET BRIDGE APPROACHES

F.A.I. RT. 70 ST. CLAIR CO. SECTION 82-3HVB-1
 82-3HVF&E-1
 82-3HVD-1

N. W. LOCKNER, INC.
 ENGINEERS
 CHICAGO, ILLINOIS

SHEET
 1 of 26

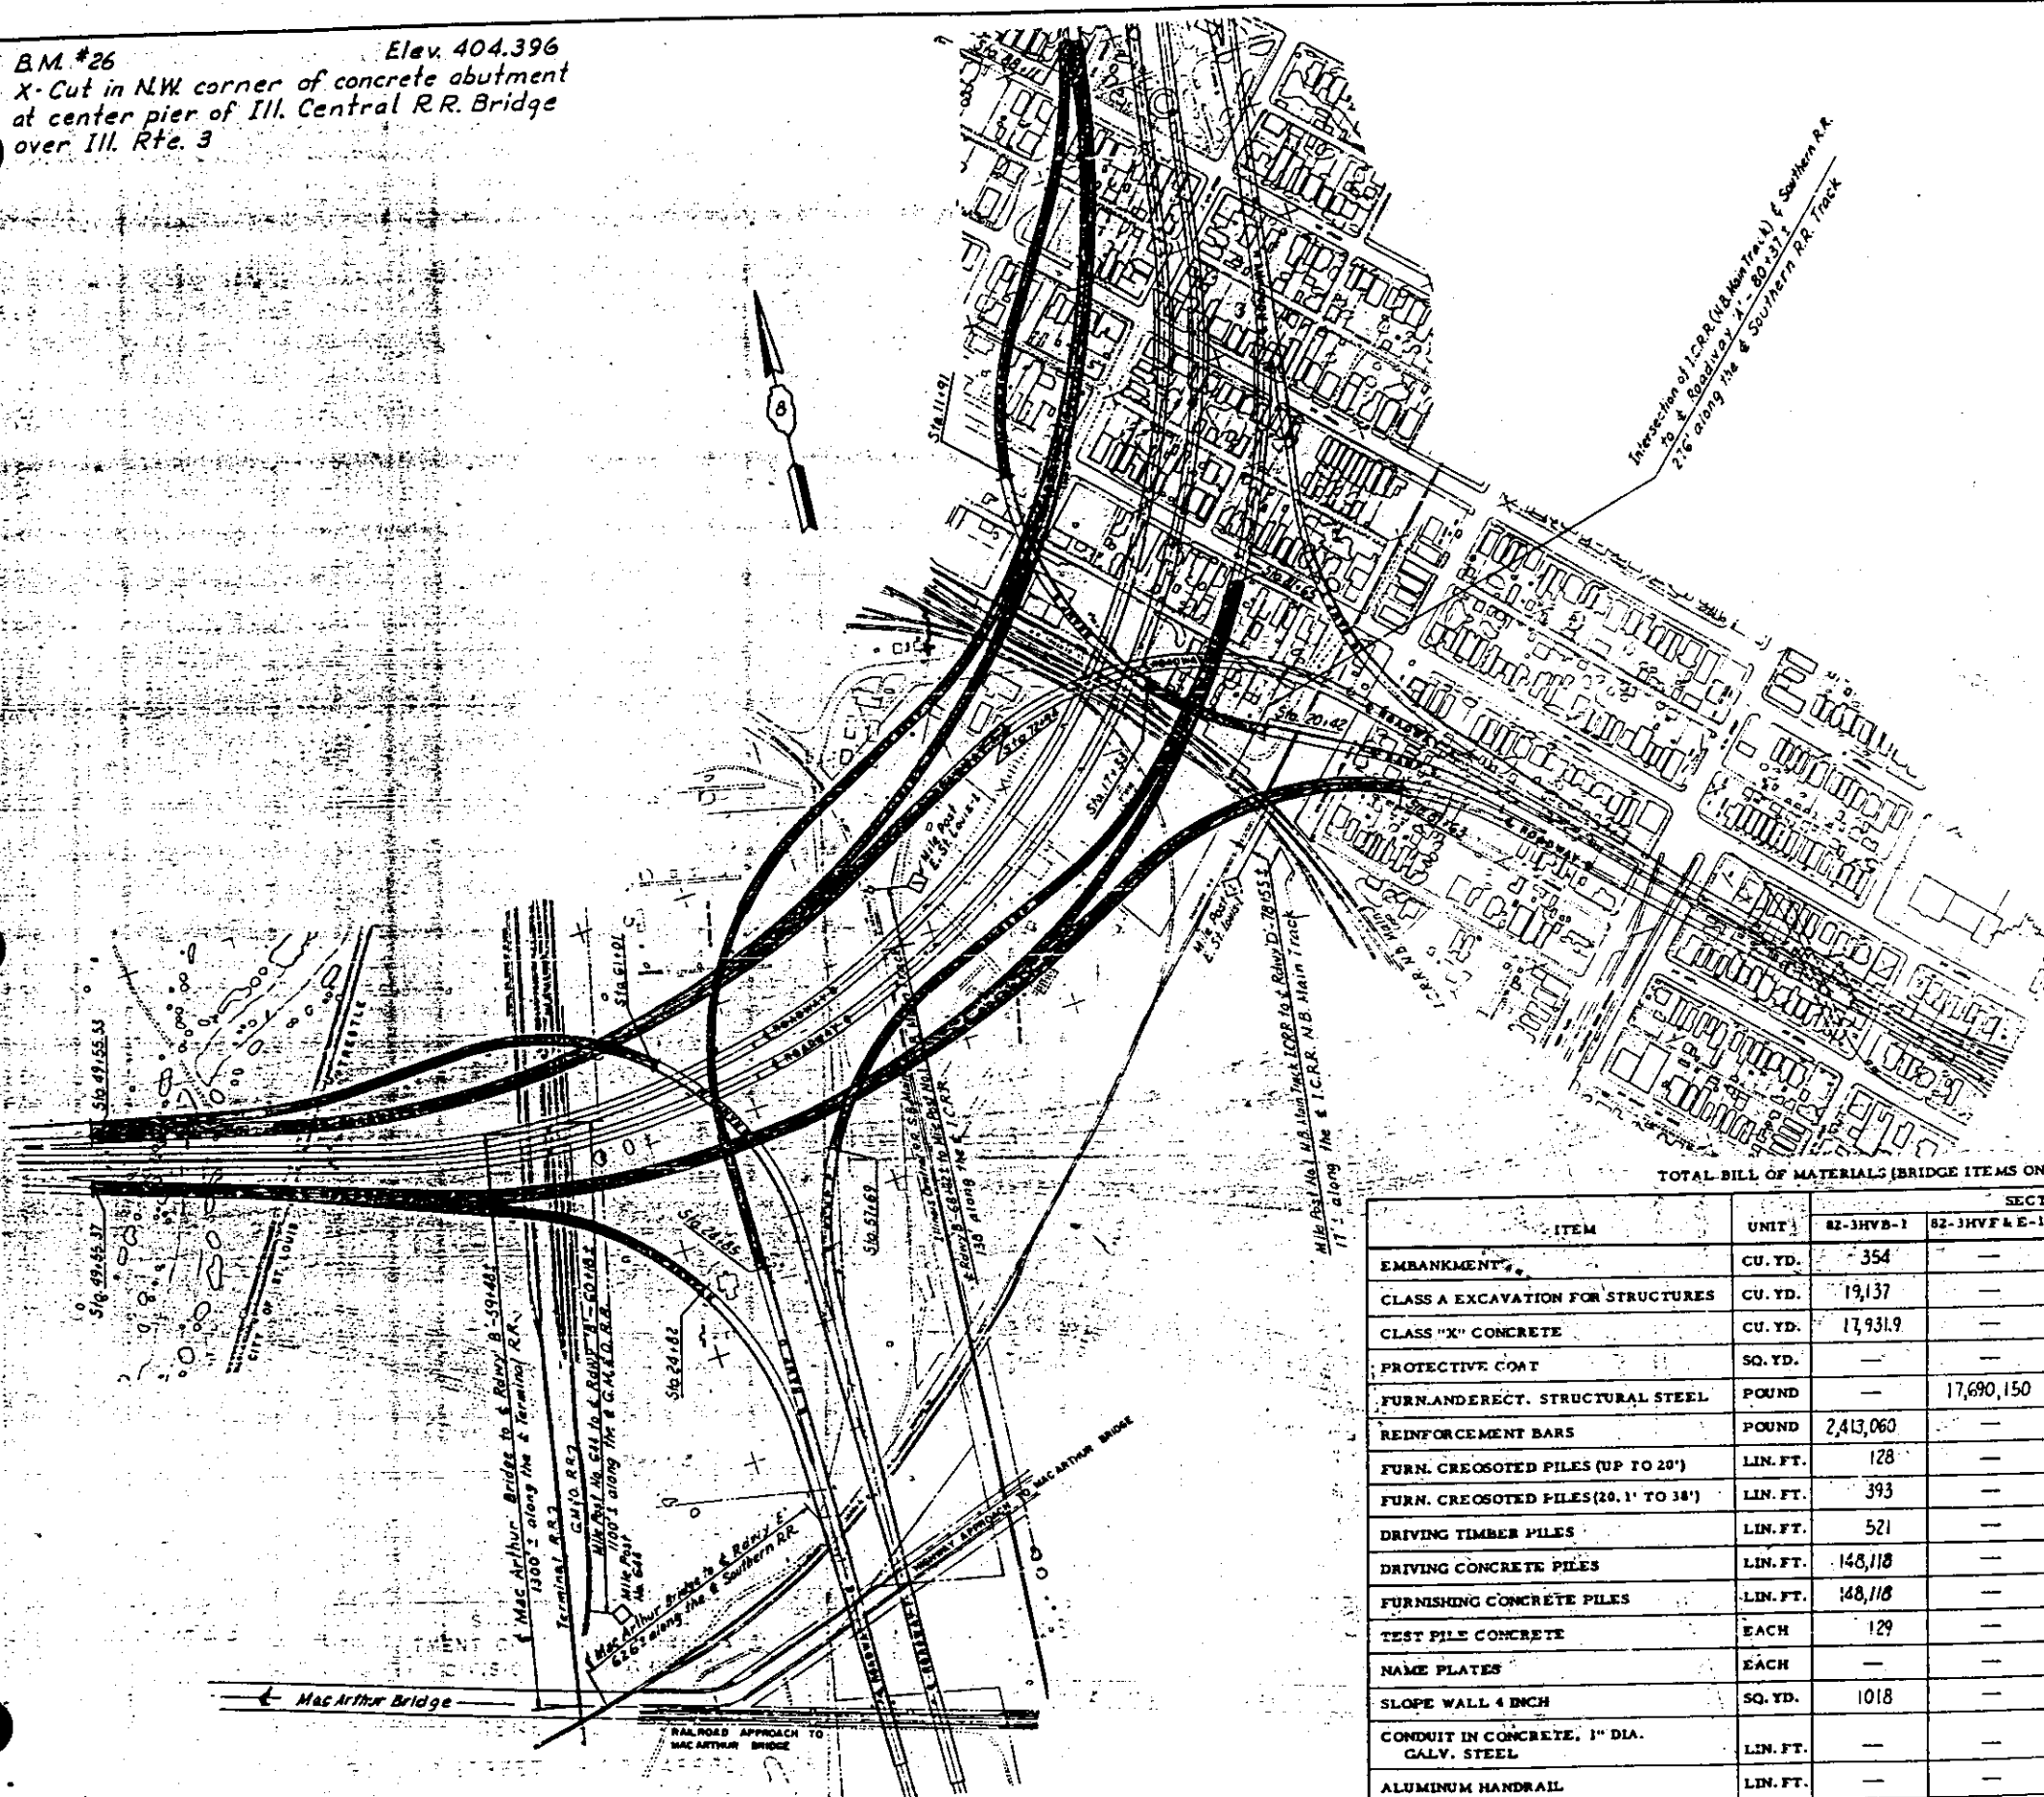

TOTAL BILL OF MATERIALS (BRIDGE ITEMS ONLY)


ITEM	UNIT	SECTION			TOTAL
		82-3HVB-1	82-3HVF & E-1	82-3HVD-1	
EMBANKMENT	CU. YD.	354	—	—	354
CLASS A EXCAVATION FOR STRUCTURES	CU. YD.	19,137	—	—	19,137
CLASS "X" CONCRETE	CU. YD.	17,931.9	—	15,159.3	33,091.2
PROTECTIVE COAT	SQ. YD.	—	—	59,203	59,203
FURN. AND ERECT. STRUCTURAL STEEL	POUND	—	17,690,150	—	17,690,150
REINFORCEMENT BARS	POUND	2,413,060	—	3,956,230	6,369,290
FURN. CREOSOTED PILES (UP TO 20')	LIN. FT.	128	—	—	128
FURN. CREOSOTED PILES (20.1' TO 38')	LIN. FT.	393	—	—	393
DRIVING TIMBER PILES	LIN. FT.	521	—	—	521
DRIVING CONCRETE PILES	LIN. FT.	148,118	—	—	148,118
FURNISHING CONCRETE PILES	LIN. FT.	148,118	—	—	148,118
TEST PILE CONCRETE	EACH	129	—	—	129
NAME PLATES	EACH	—	—	4	4
SLOPE WALL 4 INCH	SQ. YD.	1018	—	—	1018
CONDUIT IN CONCRETE, 1" DIA. GALV. STEEL	LIN. FT.	—	—	364	364
ALUMINUM HANDRAIL	LIN. FT.	—	—	26,188	26,188
BRIDGE SEAT SEALANT *	L. SUM	1	—	—	1
PAINING STRUCTURAL STEEL	POUND	—	—	17,690,150	17,690,150


* BRIDGE SEAT SEALANT TO BE USED AT ABUTMENTS AND PIERS AT EXPANSION JOINTS.

DESIGNED BY: R.M.R.
 DRAWN BY: G.M.R.
 CHECKED BY: R.M.R.
 APPROVED BY: K.A.

KEY PLAN

ROUTE NO.	SECTION	COUNTY	TOTAL SHEETS	SHEET NO.
F. A. I. - 70	82-3HVB-1	ST. CLAIR	207	21
FED. ROAD DIV. NO. 4	ILLINOIS	PROJECT		
	82-3HVB-E-1			20
	82-3HVD-1			55

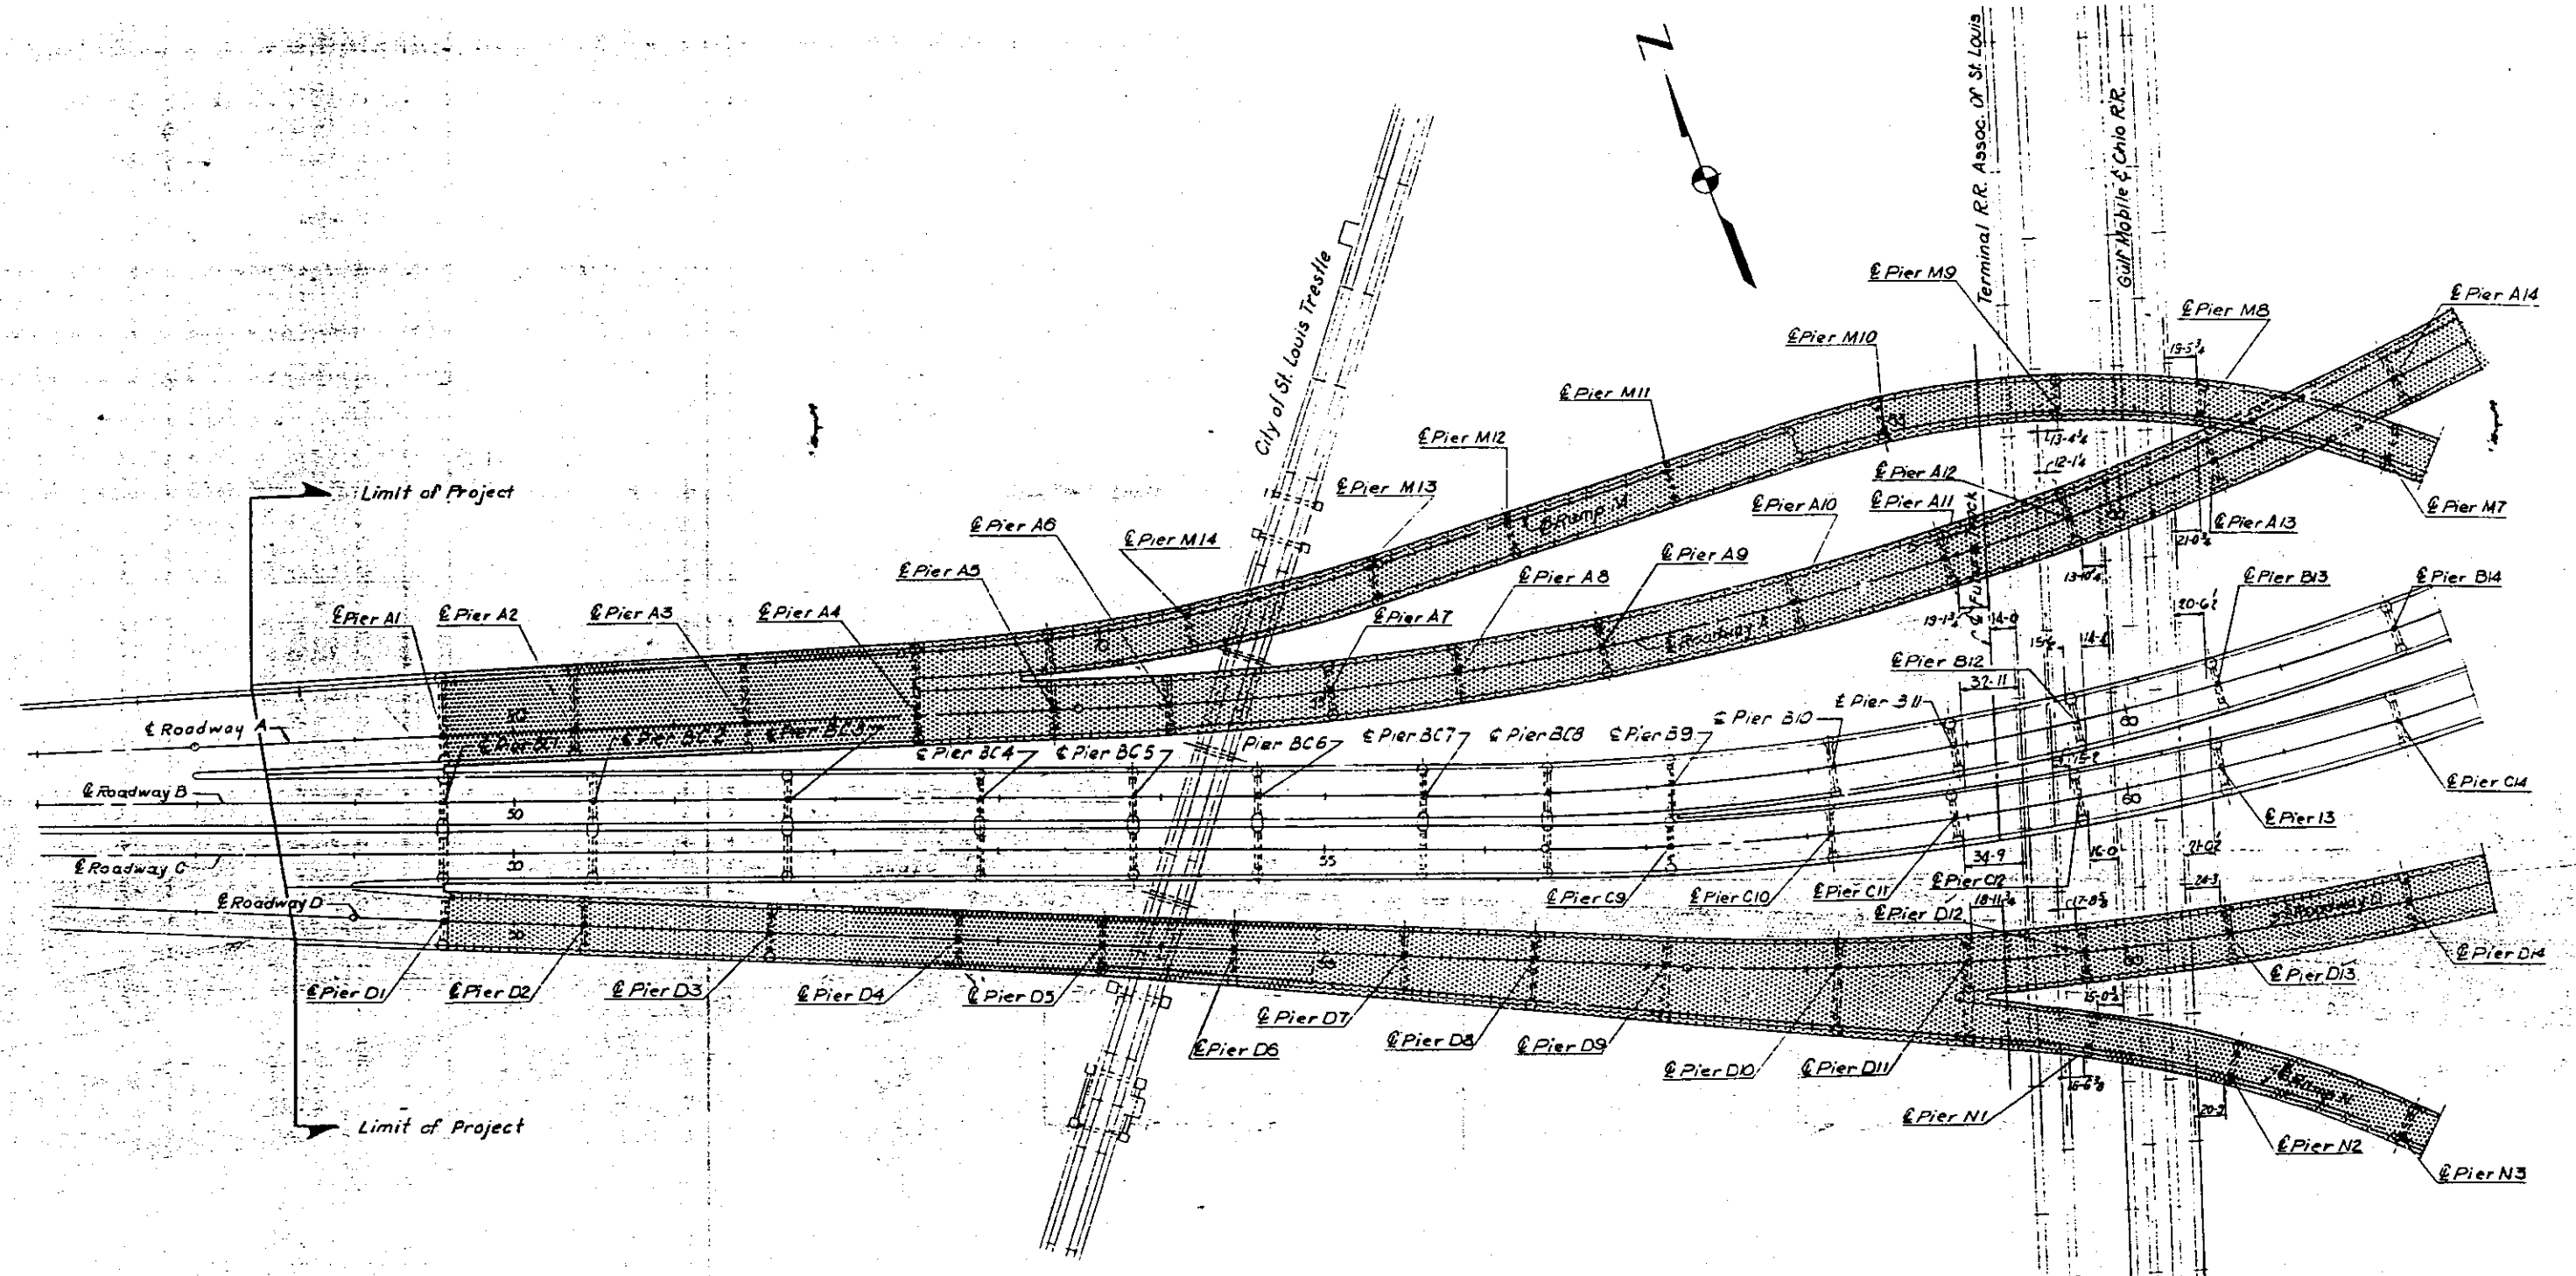

 - Indicates Portion included in Sections 82-3HVB-1, 82-3HVF & E-1 and 82-3HVD-1.

DESIGNED BY RMR
 DRAWN BY JH
 CHECKED BY RMR
 APPROVED BY KA


STATE OF ILLINOIS
 DEPARTMENT OF PUBLIC WORKS & BLDGS.
 DIVISION OF HIGHWAYS


GENERAL PLAN
 POPLAR STREET BRIDGE APPROACHES
 SECTIONS 82-3HVB-1
 82-3HVF&E-1
 82-3HVD-1

F. A. I. R. 70 ST. CLAIR CO.
 H. W. LOCHNER, INC.
 ENGINEERS
 CHICAGO, ILLINOIS

SHEET
 2 OF 55

ROUTE NO.	SECTION	COUNTY	TOTAL SHEETS	SHEET NO.
F. A. I. - 70	B2-3HVB-1	ST. CLAIR	207	22
FED. ROAD DIV. NO. 4	ILLINOIS	PROJECT	- 7	
	82-3HVB & E-1			21
	82-3HVD-1			56

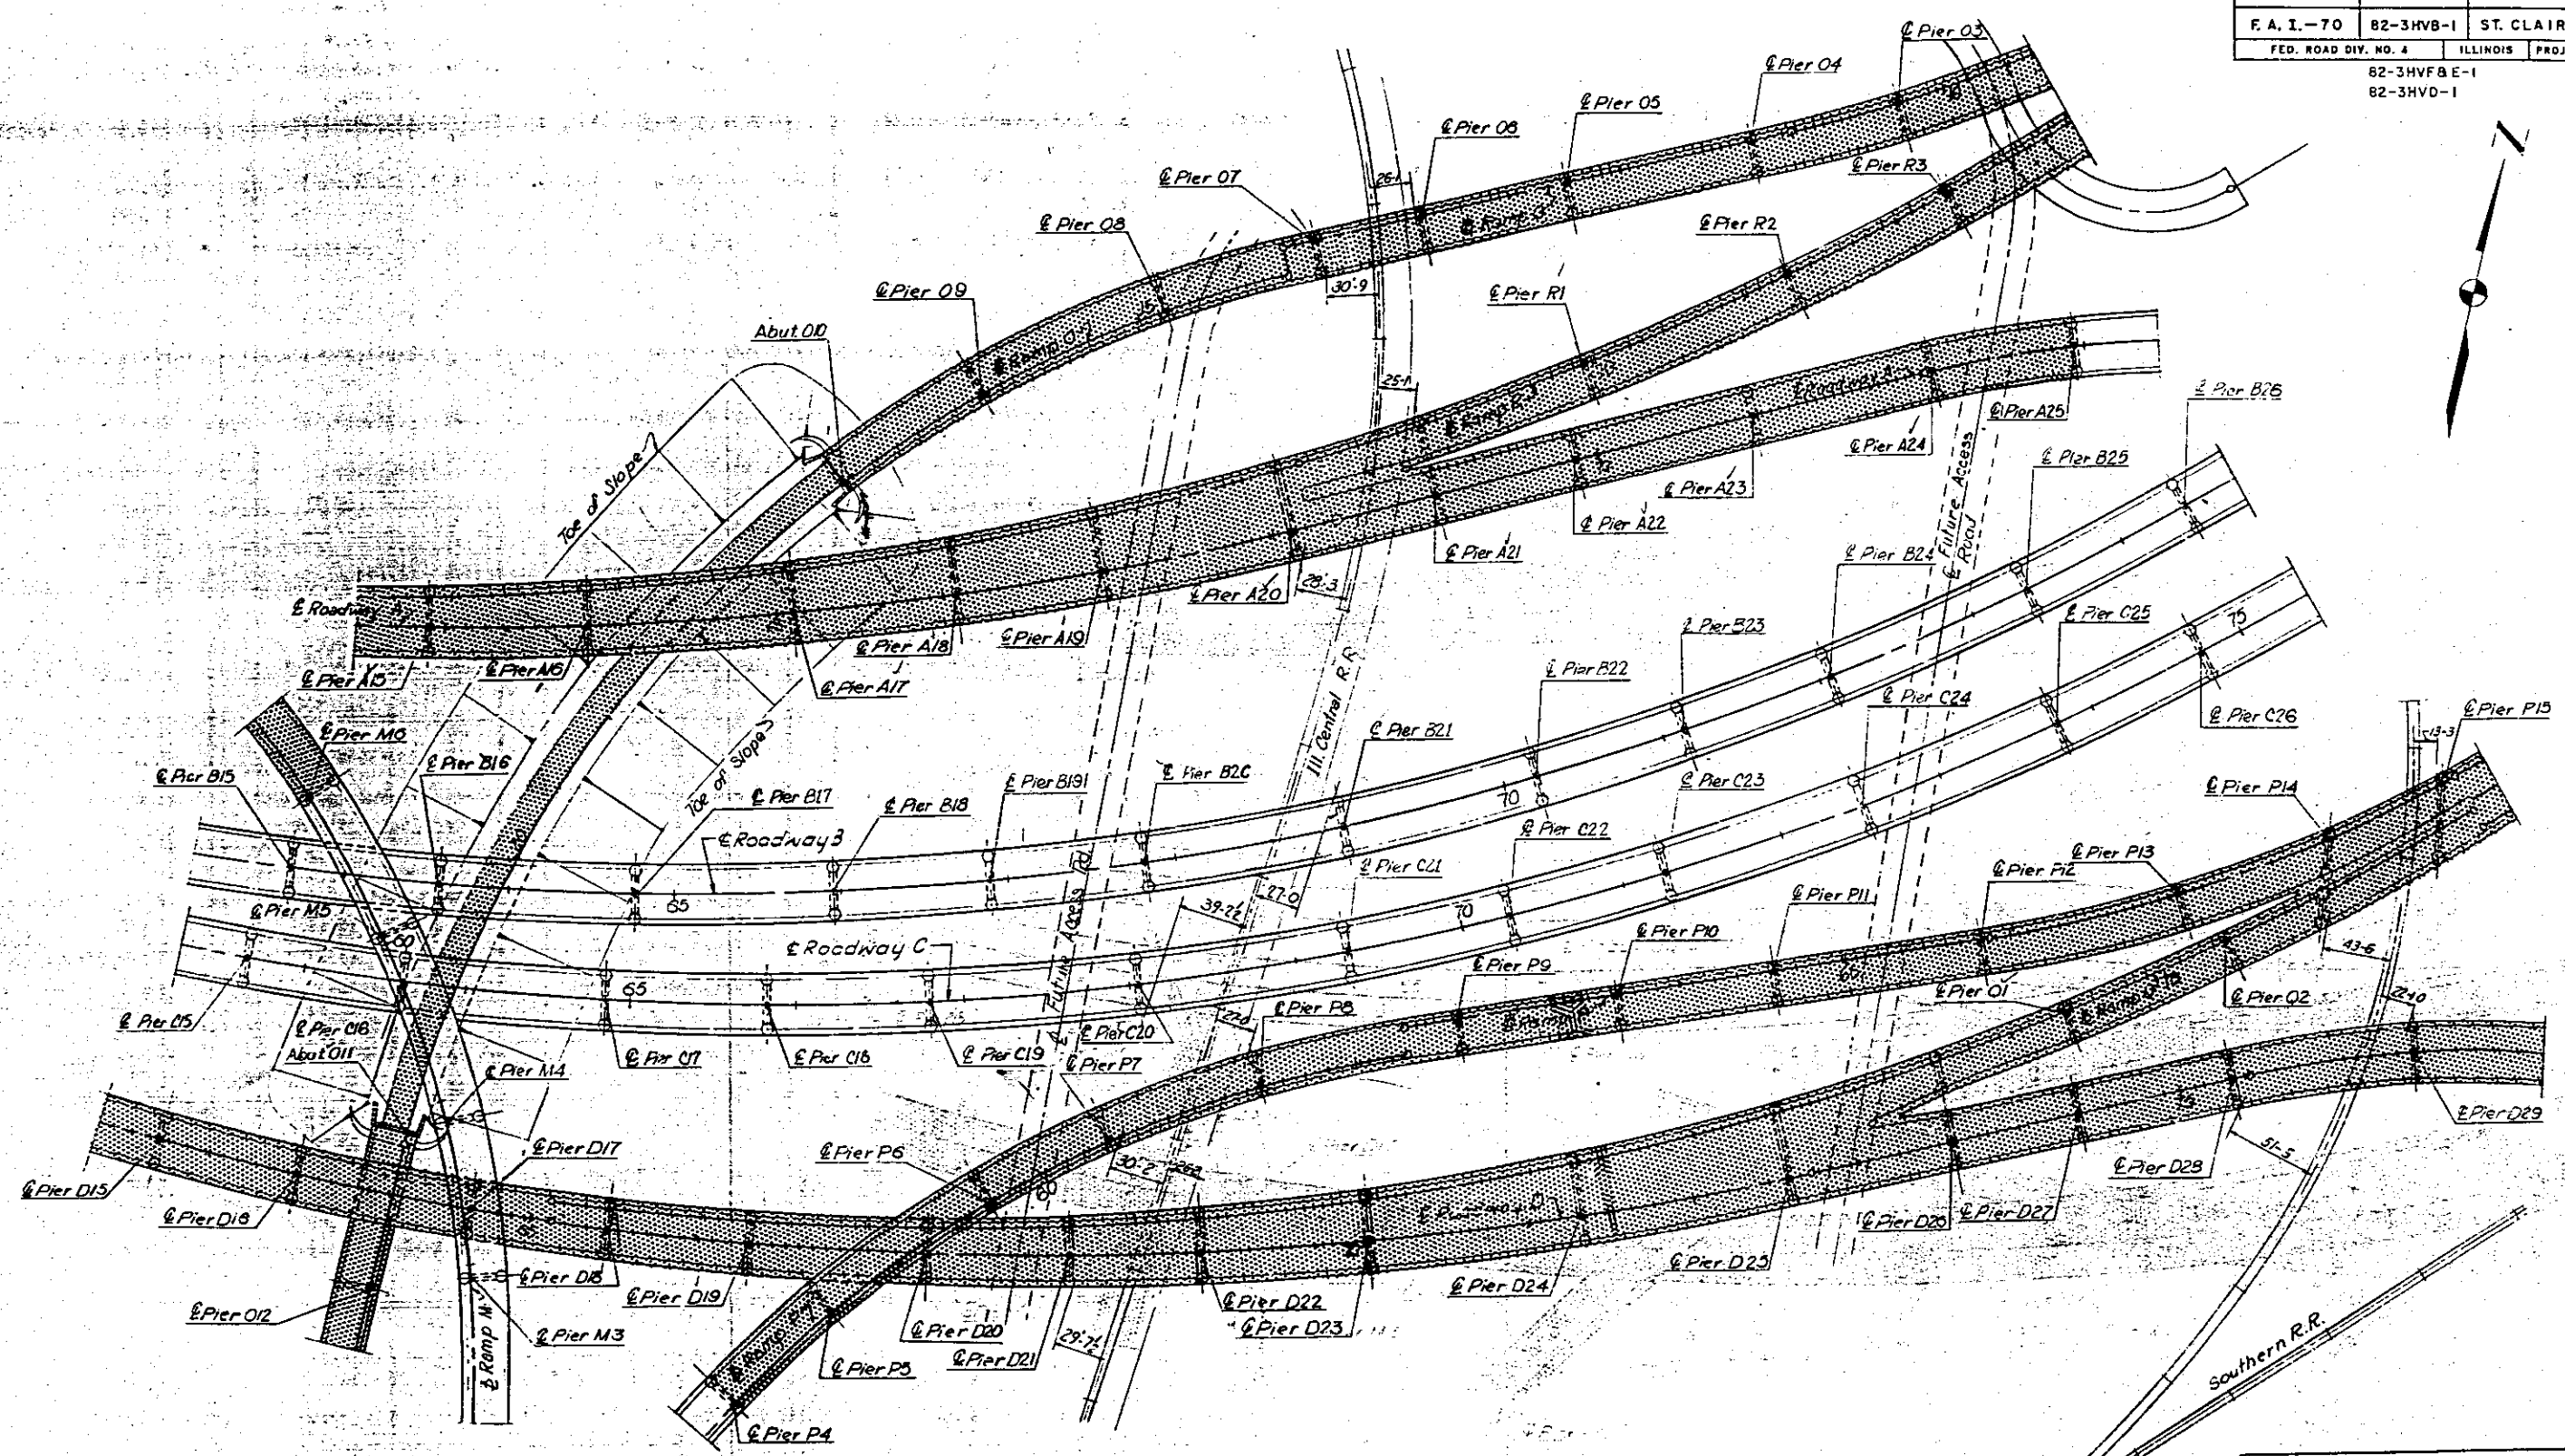

 - Indicates Portion included in Sections 82-3HVB-1, 82-3HVF & E-1 and 82-3HVD-1.

STATE OF ILLINOIS
DEPARTMENT OF PUBLIC WORKS & BLDGS.
DIVISION OF HIGHWAYS

GENERAL PLAN
POPLAR STREET BRIDGE APPROACHES


SECTIONS 82-3HVB-1
82-3HVF&E-1
82-3HVD-1

F. A. I. RT. 70 ST. CLAIR CO.
H. W. LOCHNER, INC.
ENGINEERS
CHICAGO, ILLINOIS

SHEET
3 of 56

DESIGNED BY RMR
DRAWN BY JH
CHECKED BY RMR
APPROVED BY KA

ROUTE NO.	SECTION	COUNTY	TOTAL SHEETS	SHEET NO.
F. A. I. - 70	82-3HVB-1	ST. CLAIR	207	23
FED. ROAD DIV. NO. 4	ILLINOIS	PROJECT		
	82-3HVB-E-1			22
	82-3HVD-1			57

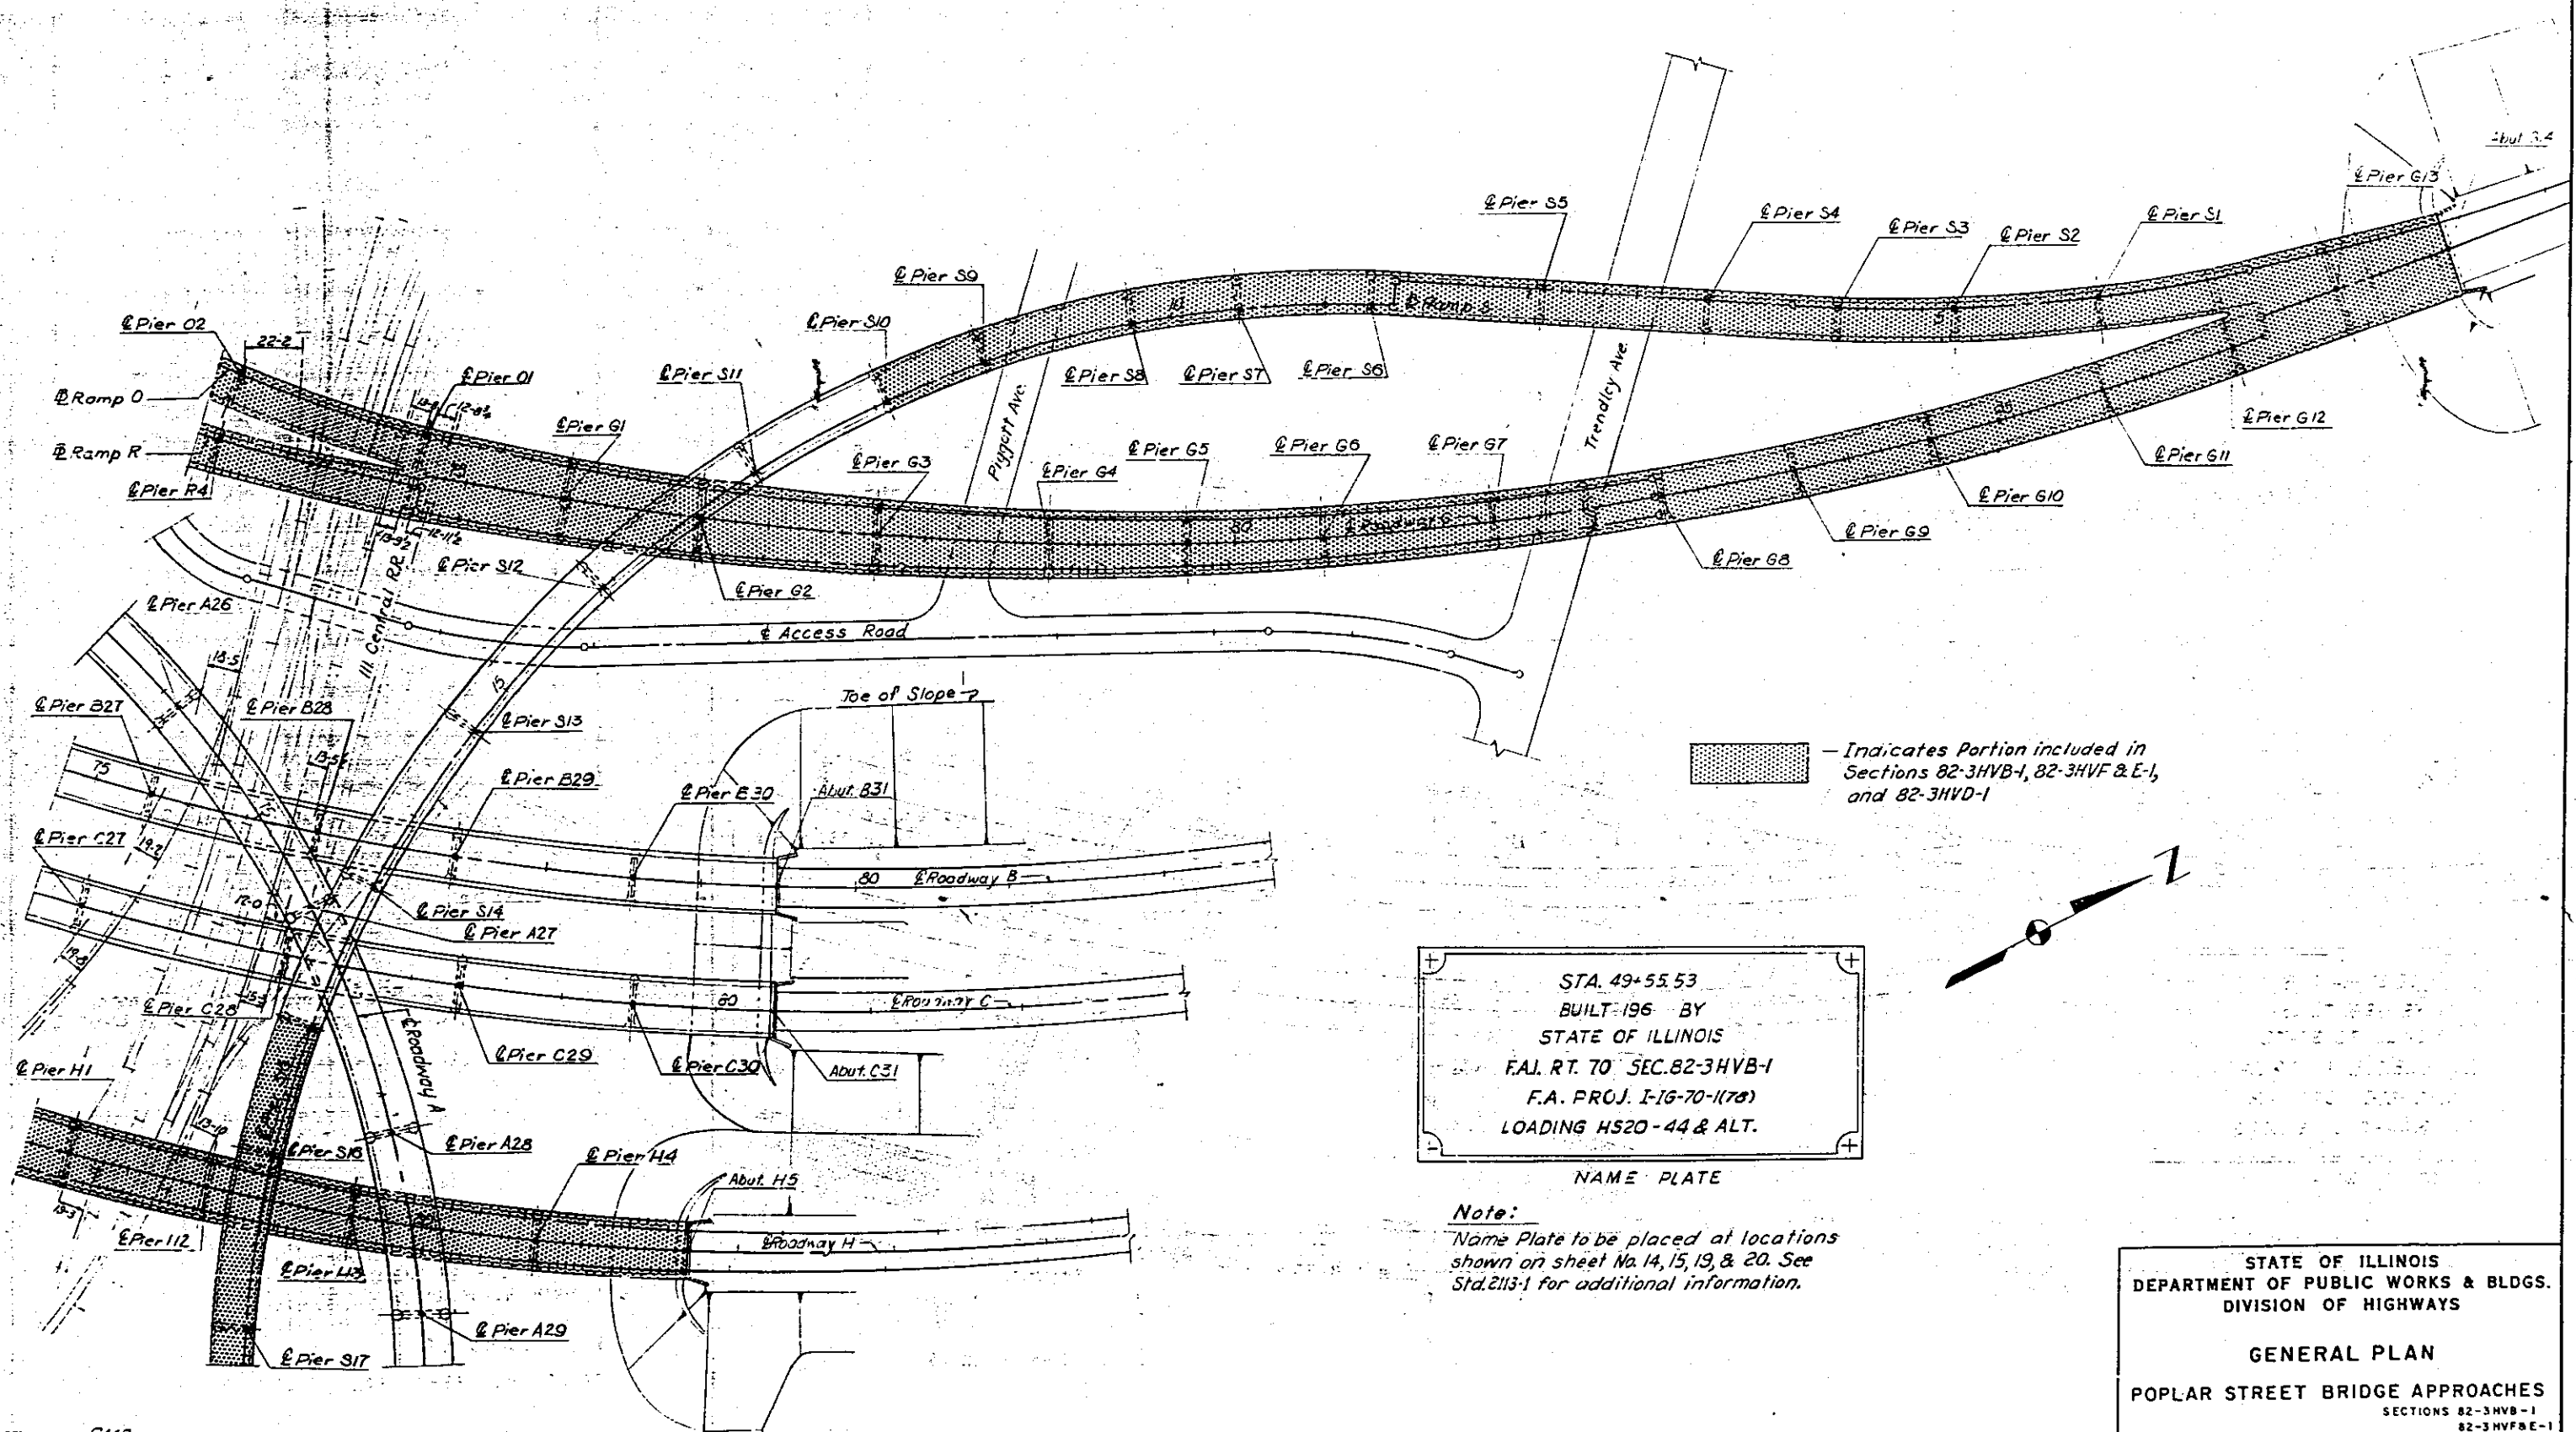

— Indicates Portion included in Sections 82-3HVB-1, 82-3HVB-E-1, and 82-3HVD-1

STA. 49+55.53
 BUILT 196 BY
 STATE OF ILLINOIS
 F.A. RT. 70 SEC. 82-3HVB-1
 F.A. PROJ. I-16-70-1(70)
 LOADING HS20-44 & ALT.

NAME PLATE

Note:
 Name Plate to be placed at locations shown on sheet No. 14, 15, 19, & 20. See Std. 2113-1 for additional information.

DESIGNED BY EMR
 DRAWN BY SH
 CHECKED BY RMR
 APPROVED BY KA


STATE OF ILLINOIS
 DEPARTMENT OF PUBLIC WORKS & BLDGS.
 DIVISION OF HIGHWAYS

GENERAL PLAN
 POPLAR STREET BRIDGE APPROACHES
 SECTIONS 82-3HVB-1
 82-3HVB-E-1
 82-3HVD-1

F.A. I. RT. 70 ST. CLAIR CO.
 H. W. LOCHNER, INC.
 ENGINEERS
 CHICAGO, ILLINOIS

SHEET
 4 of 509

ROUTE NO.	SECTION	COUNTY	TOTAL SHEETS	SHEET NO.
F. A. I. - 70	82-3HVB-1	ST. CLAIR	207	24
FED. ROAD DIV. NO. 4	ILLINOIS	PROJECT		
	82-3HVF&E-1			23
	82-3HVD-1			58

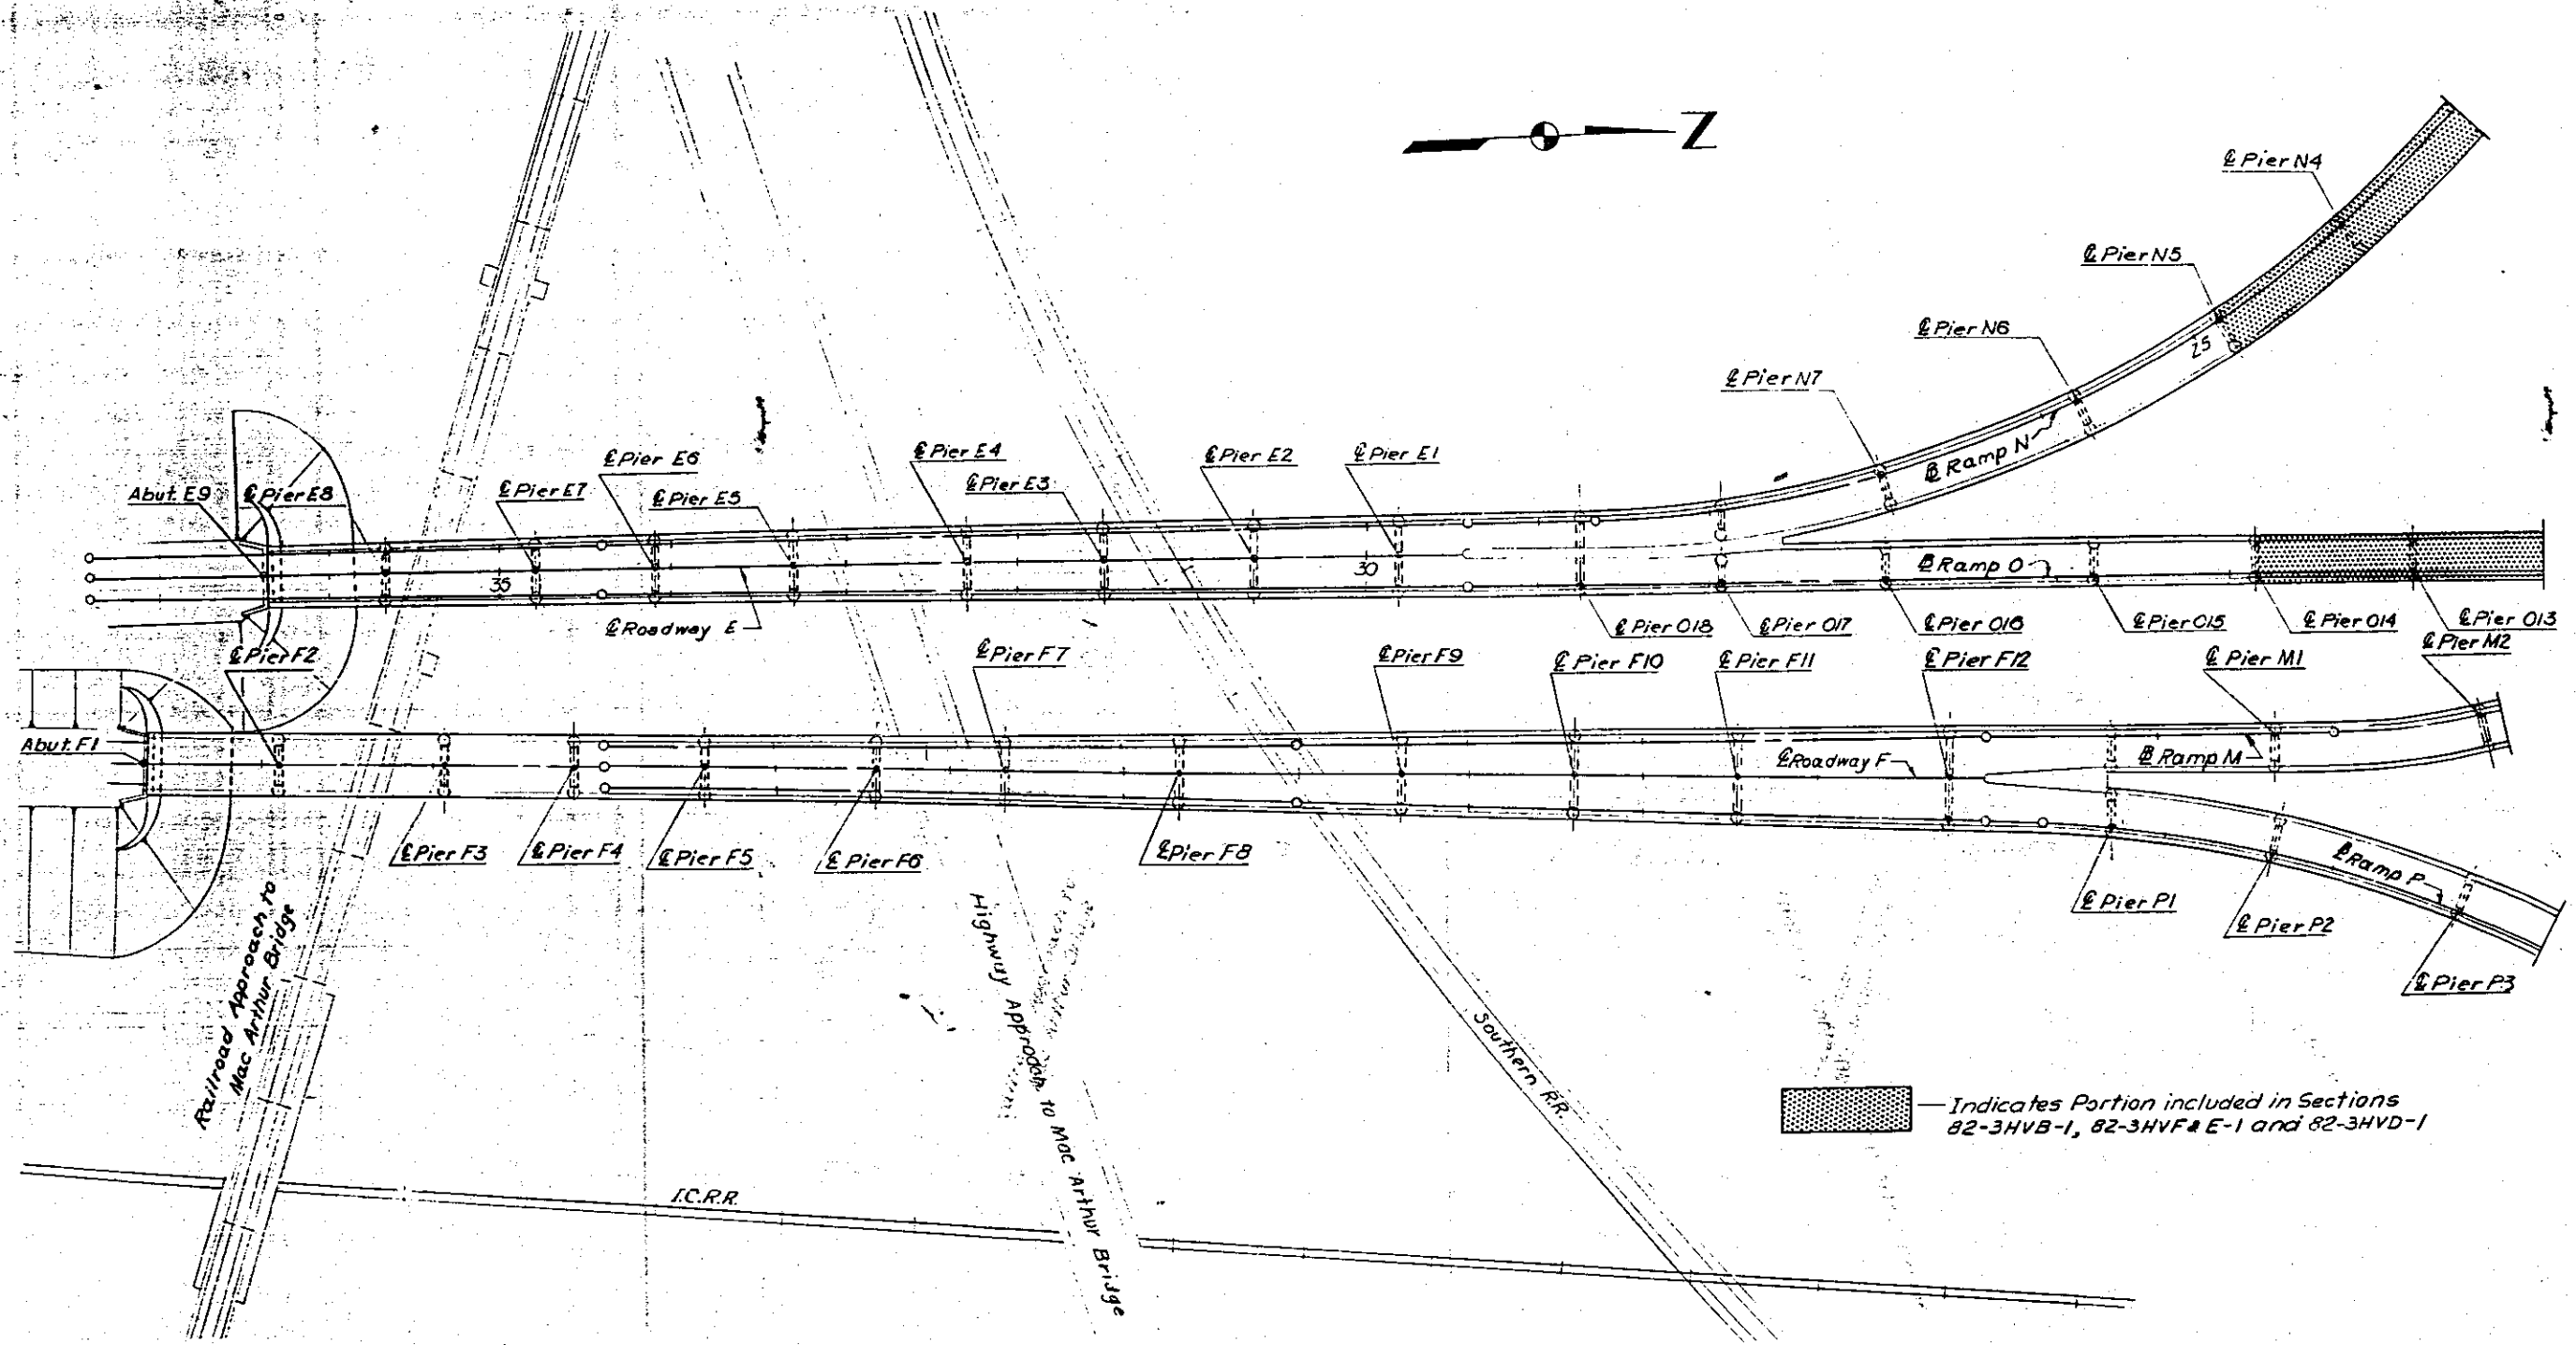

Indicates Portion included in Sections 82-3HVB-1, 82-3HVF&E-1 and 82-3HVD-1

DESIGNED BY RMR
 DRAWN BY WJ
 CHECKED BY RMR
 APPROVED BY KA



STATE OF ILLINOIS
 DEPARTMENT OF PUBLIC WORKS & BLDGS.
 DIVISION OF HIGHWAYS


GENERAL PLAN
 POPLAR STREET BRIDGE APPROACHES
 SECTIONS 82-3HVB-1
 82-3HVF&E-1
 82-3HVD-1

F. A. I. RT. 70 ST. CLAIR CO.
 H. W. LOCHNER, INC.
 ENGINEERS
 CHICAGO, ILLINOIS

SHEET
 5 OF 53

ROUTE NO.	SECTION	COUNTY	TOTAL SHEETS	SHEET NO.
F. A. I. - 70	82-3HVB-1	ST. CLAIR	207	25
FED. ROAD DIV. NO. 4	ILLINOIS PROJECT			
	82-3HVF8 E-1			24
	82-3HVD-1			59

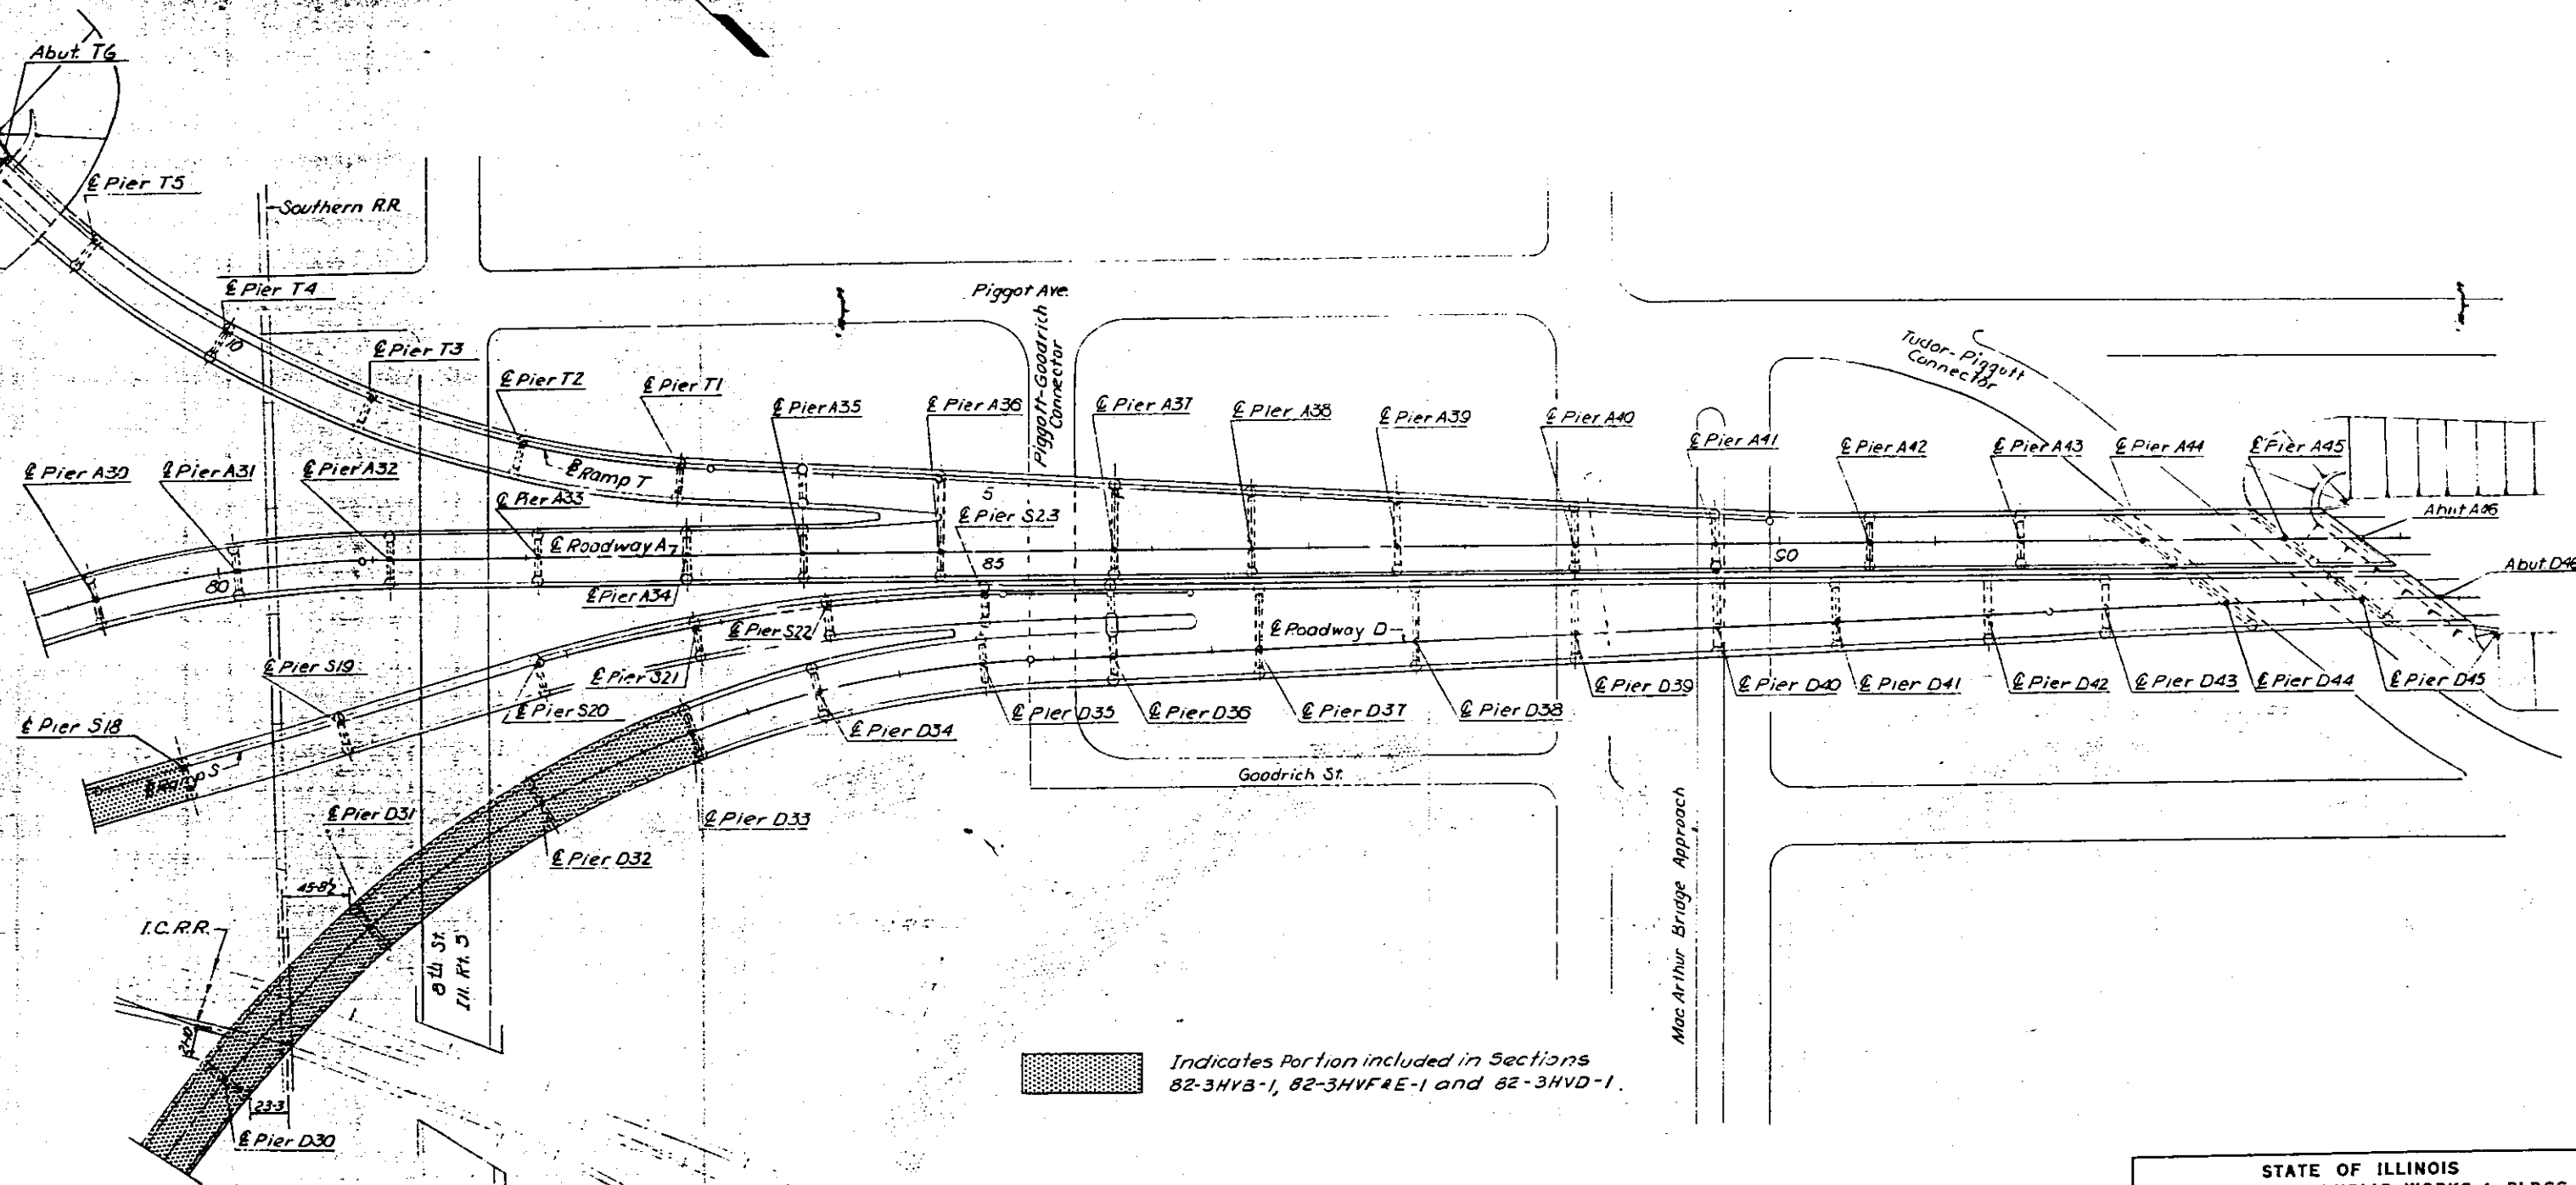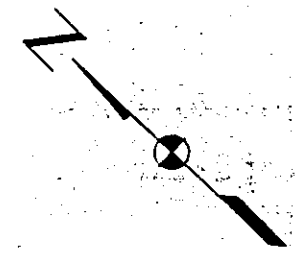


 Indicates Portion included in Sections
 82-3HVB-1, 82-3HVF8 E-1 and 82-3HVD-1.

DESIGNED BY RMR
 DRAWN BY JH
 CHECKED BY RMR
 APPROVED BY KA

STATE OF ILLINOIS
 DEPARTMENT OF PUBLIC WORKS & BLDGS.
 DIVISION OF HIGHWAYS

GENERAL PLAN
POPLAR STREET BRIDGE APPROACHES
 SECTIONS 82-3HVB-1
 82-3HVF8 E-1
 82-3HVD-1
 F. A. I. RT. 70 ST. CLAIR CO.


H. W. LOCHNER, INC.
 ENGINEERS
 CHICAGO, ILLINOIS

SHEET
 6 of 56


ROUTE NO.	SECTION	COUNTY	TOTAL SHEETS	SHEET NO.
F.A.I. 70	82-3HVB-1	ST. CLAIR	207	34
FED. ROAD DIV. NO. 4	ILLINOIS	PROJECT		

82-3HVFBE-1 33
82-3HVD-1 68


Direction of Traffic

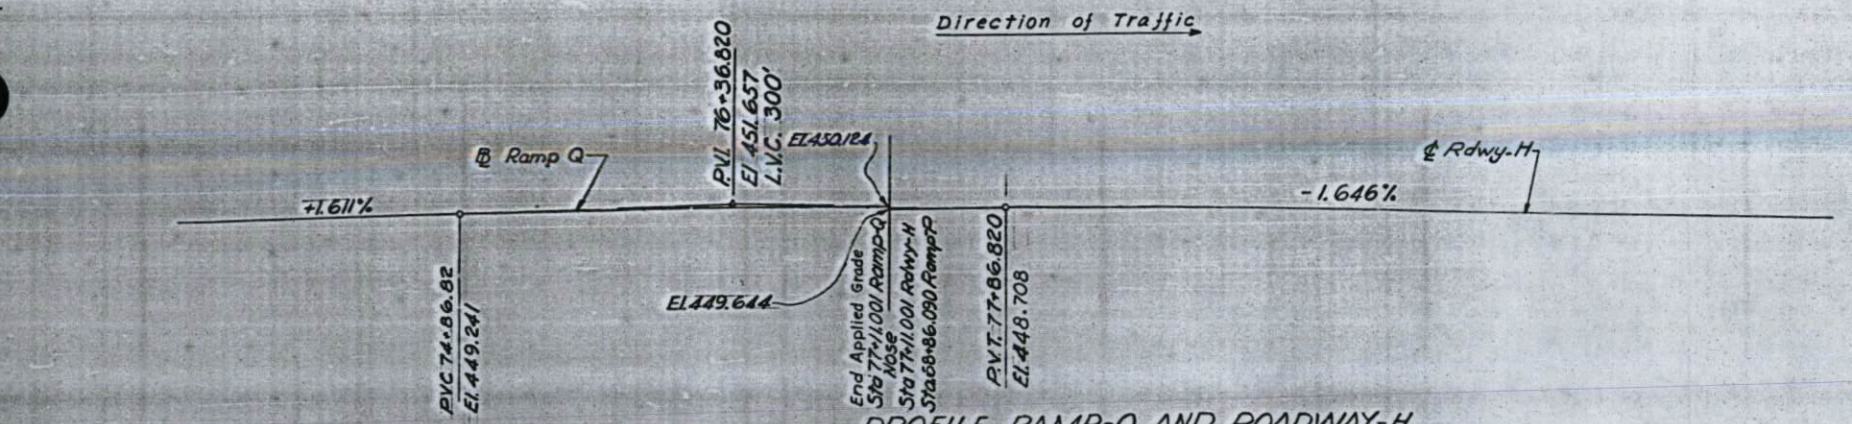


PROFILE RAMP-Q AND ROADWAY-H

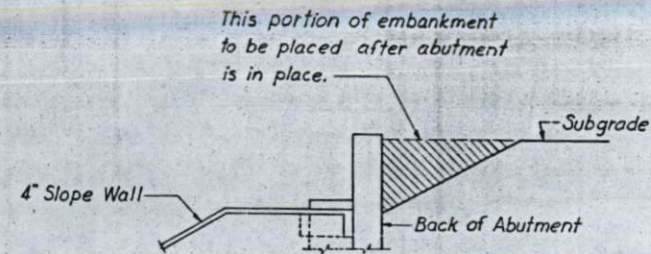

SECTION A-A

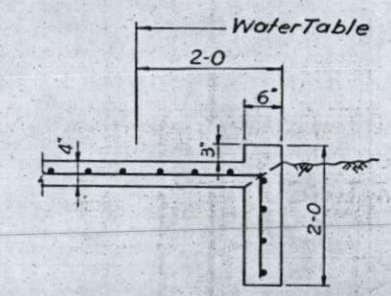


SECTION B-B

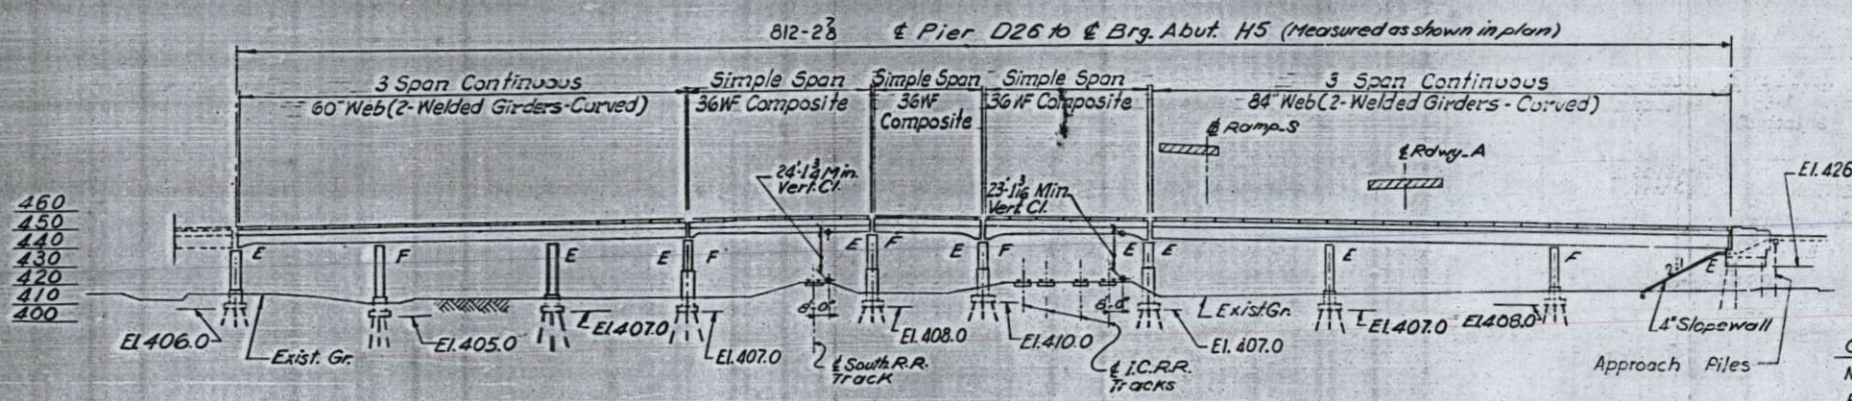


ELEVATION
DEVELOPED LENGTH ALONG RAMP-Q & ROADWAY-H

Creosoted Approach Piles
Number Required - 6
Estimated Length - 25'
See Special Provisions

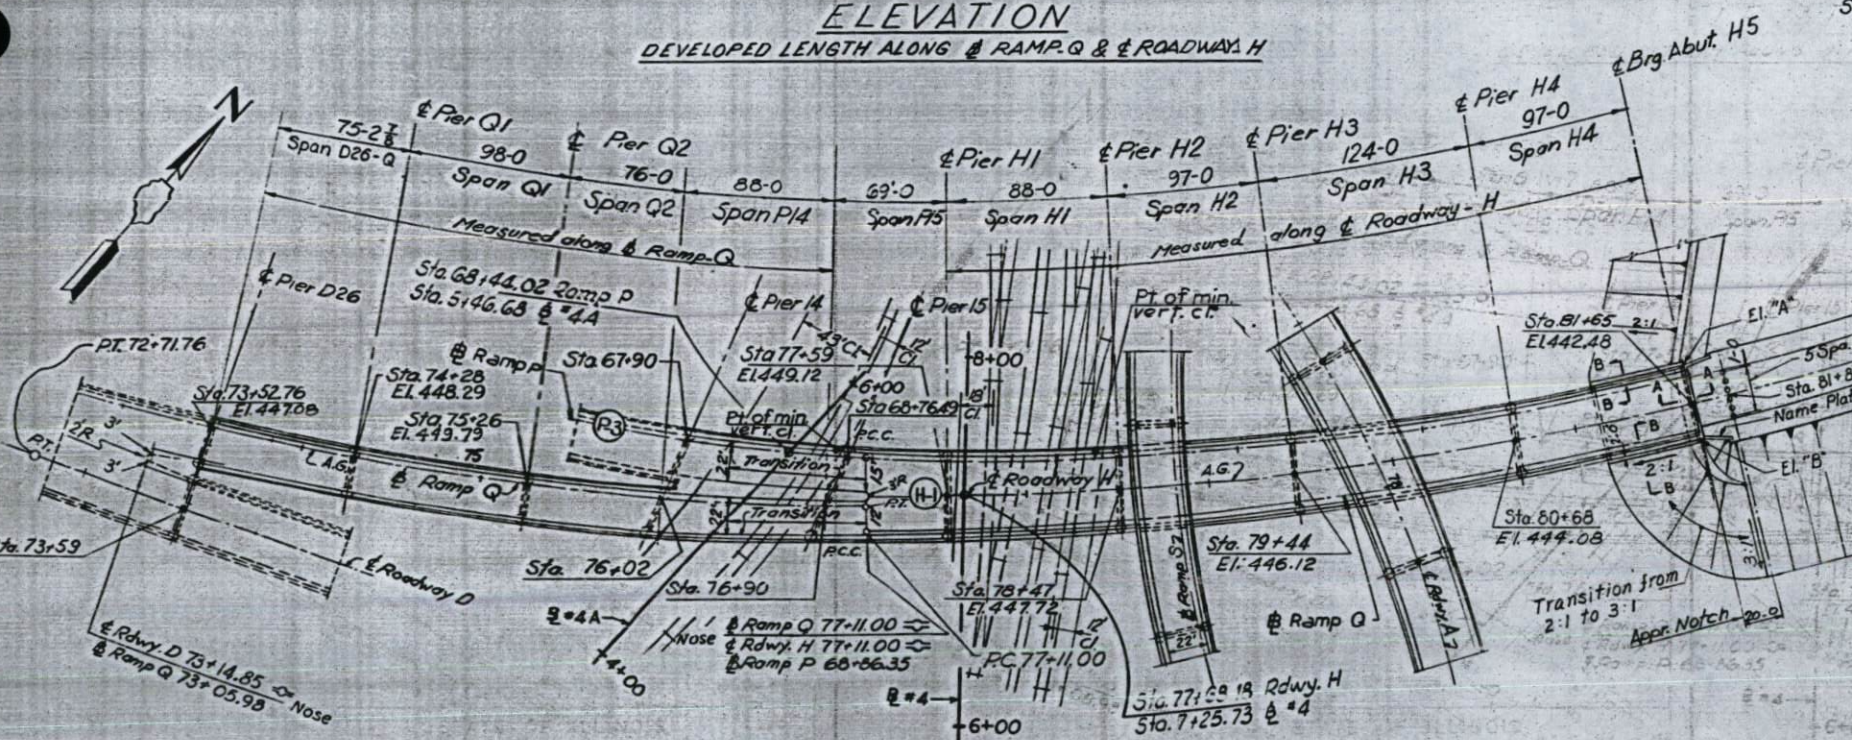

PLAN

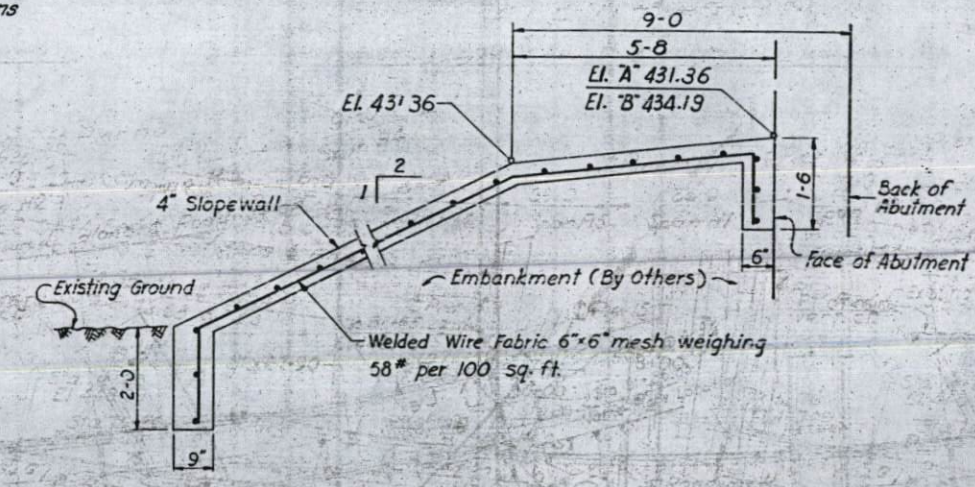

TYPICAL CROSS SECTION OF SLOPE WALL

BILL OF MATERIAL		
Item	Unit	Quantity
Slope Wall 4"	S.Y.	282
Name Plate	Ea.	1
Embankment	C.Y.	100

STATE OF ILLINOIS
DEPARTMENT OF PUBLIC WORKS & BLDGS.
DIVISION OF HIGHWAYS
PLAN AND ELEVATION
SPANS D26-Q, Q1, Q2, P14, P15, H1 THRU H4
POPLAR STREET BRIDGE APPROACHES
ROADWAY "H" AND RAMP "Q"
SECTIONS 82-3HVB-1
82-3HVFBE-1
82-3HVD-1
F.A.I. RT. 70 ST. CLAIR CO.
H. W. LOCHNER, INC.
ENGINEERS
CHICAGO, ILLINOIS

SHEET
15 OF 526



DESIGNED BY J.J.N.
DRAWN BY S.A.B.
CHECKED BY R.M.R.
APPROVED BY K.A.

ROUTE NO.	SECTION	COUNTY	TOTAL SHEETS	SHEET NO.
F.A.I. 70	82-3HVB-1	ST. CLAIR	207	50
FED. ROAD DIV. NO. 4			ILLINOIS PROJECT	
			82-3HVB-E-1	43
			82-3HVD-1	54

Curve P2
 P.I. 58+31.46
 Δ 65°23'55"
 D 8°11'06"
 R 700.00'
 L 798.99'
 T 449.38'
 E 131.83'

Curve P3
 P.I. 67+33.03
 Δ 21°04'14"
 D 7°01'18"
 R 816.00'
 L 300.03'
 T 151.76'
 E 13.99'

Curve Q1
 P.I. 71+34.70
 Δ 33°09'55"
 D 3°10'59"
 R 1,300.00'
 L 1,199.00'
 T 622.70'
 E 104.67'

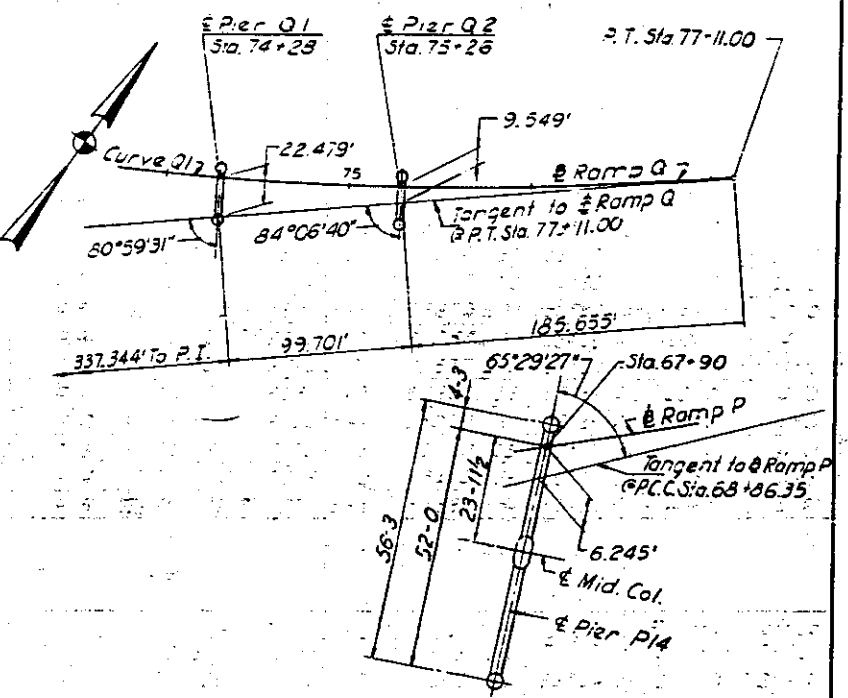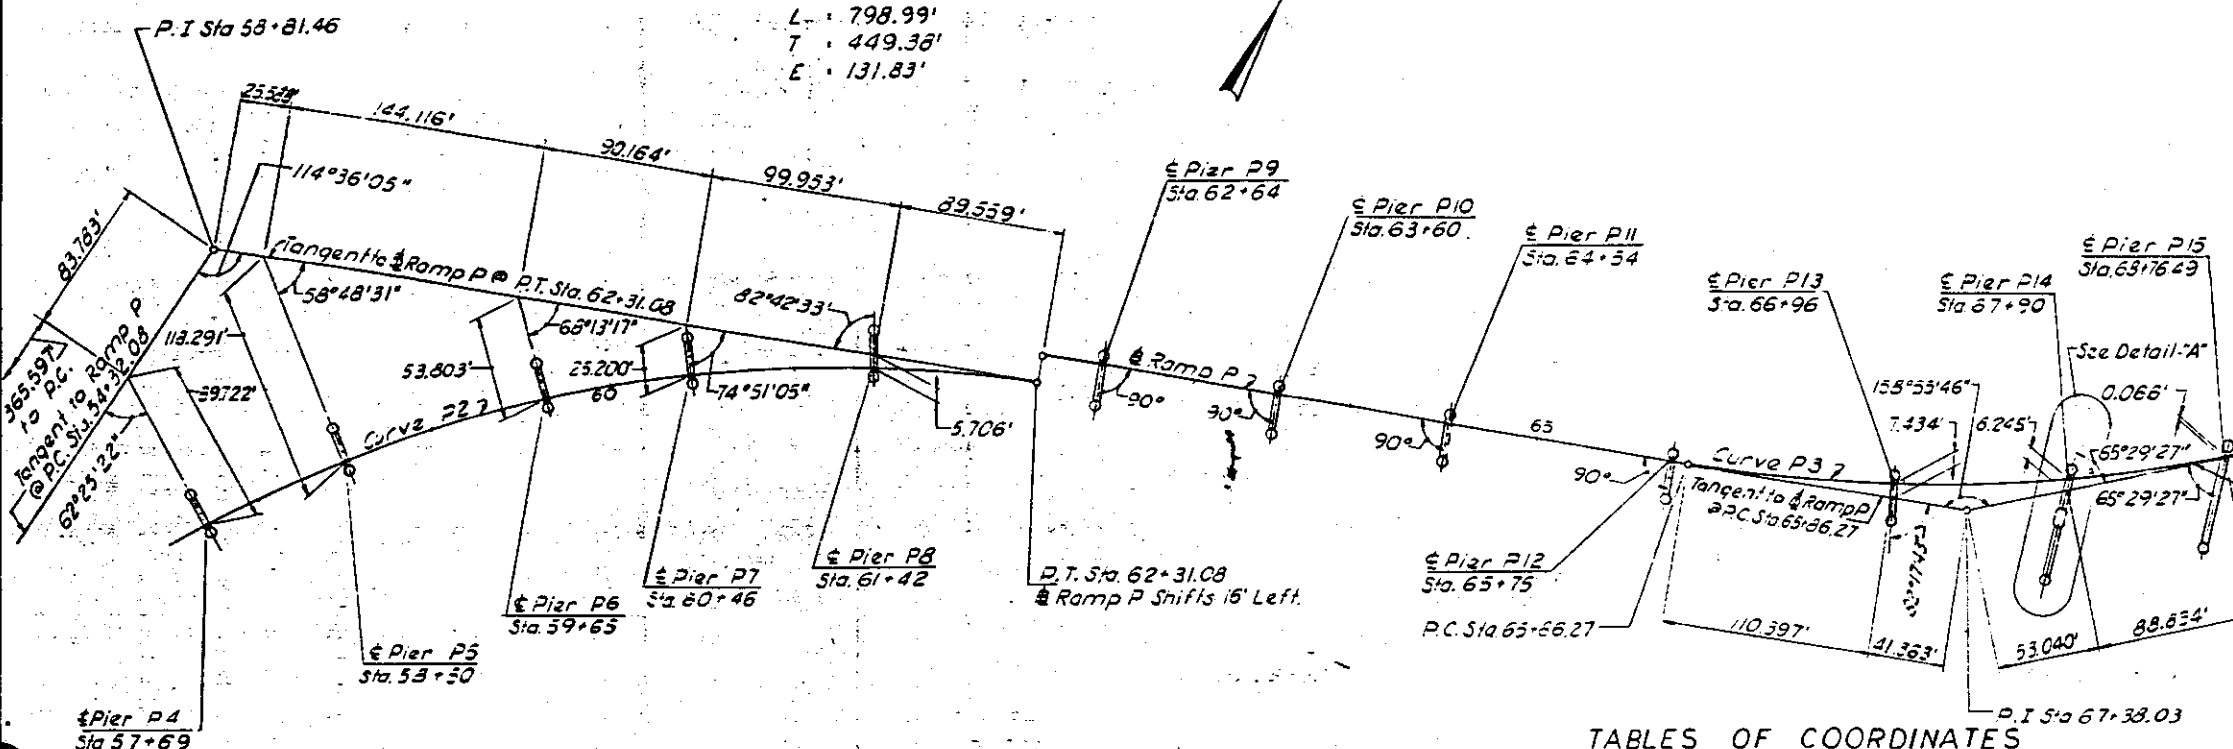


TABLES OF COORDINATES

Pier No.	Ramp P			Azimuth	Right Col. Offset	Left Col. Offset
	Sta.	N. Coordinate	E. Coordinate			
P4	57+69	2704.826	32408.504	122°10'24"	4-0	20-0
P5	55+50	2770.742	32455.501	128°48'12"	4-0	20-0
P6	59+65	2854.053	32534.587	138°12'58"	4-0	20-0
P7	60+46	2904.414	32597.970	144°50'46"	4-0	20-0
P8	61+42	2954.141	32679.299	152°42'14"	4-0	20-0
P9	62+64	3016.149	32787.002	159°59'41"	20-0	4-0
P10	63+60	3048.991	32877.210	159°59'41"	20-0	4-0
P11	64+54	3081.149	32965.538	159°59'41"	20-0	4-0
P12	65+75	3122.544	33079.237	159°59'41"	20-0	4-0
P13	66+96	3170.748	33190.105	152°17'24"	20-0	4-0
P14	67+90	3219.149	33270.626	163°26'00"	52-0	4-3
P15	68+76+9	3271.595	33339.354	163°26'00"	45-4	3-4

Pier No.	Roadway H			Azimuth	Right Col. Offset	Left Col. Offset
	Sta.	N. Coordinate	E. Coordinate			
H1	77+59	9296.990	33393.945	136°34'31"	21-4	21-4
H2	78+47	9359.004	33456.369	133°48'11"	20-2	20-2
H3	79+44	9430.767	33521.613	130°44'51"	19-0 1/2	19-0 1/2
H4	80+68	9527.394	33599.287	126°50'28"	17-10 1/2	17-10 1/2
Br. Abut. H5	81+65	9606.537	33655.351	123°47'07"	17-1 1/2	17-2

Pier No.	Ramp Q			Azimuth	Right Col. Offset	Left Col. Offset
	Sta.	N. Coordinate	E. Coordinate			
Q1	74+28	9038.251	33133.097	147°05'44"	20-0	4-0
Q2	75+26	9143.701	33219.586	143°58'35"	20-0	4-0

Curve H1
 P.I. 83+18.82
 Δ 36°57'31"
 D 3°09'01"
 R 1,818.76'
 L 1,173.19'
 T 607.82'
 E 98.83'

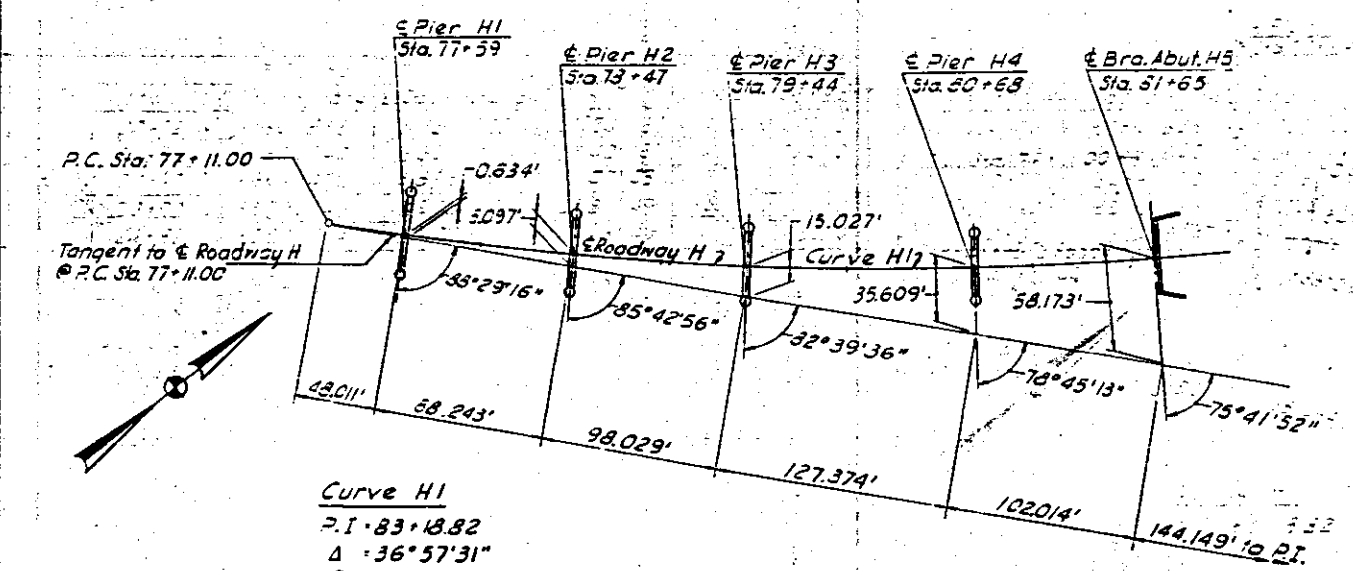

DESIGNED BY R.M.R.
 DRAWN BY L.M.
 CHECKED BY S.Q.B.
 APPROVED BY K.A.

STATE OF ILLINOIS
 DEPARTMENT OF PUBLIC WORKS & BLDGS.
 DIVISION OF HIGHWAYS
GEOMETRIC LAYOUT
 PIERS P4 THRU P15, Q1 & Q2, H1 THRU H5
 POPLAR STREET BRIDGE APPROACHES
 RAMPS P&Q AND ROADWAY "H"
 SECTIONS 82-3HVB-1
 82-3HVB-E-1
 82-3HVD-1
 F.A.I. RT. 70 ST. CLAIR CO.
 M. W. LOCHNER, INC.
 ENGINEERS
 CHICAGO, ILLINOIS
 SHEET
 31 OF 526

ROUTE NO.	SECTION	COUNTY	TOTAL SHEETS	SHEET NO.
F. A. I. 70	B2-3HVB-1 B2-3HVF BE-1	ST. CLAIR	207	54
FED. ROAD DIV. NO. 4	ILLINOIS	PROJECT		246

ROADWAY A		
Pier No.	Girder	
	A 1	A 2
A1 - Span A1	441.30	442.11
A2	437.51	438.35
A3	435.03	436.06
A4	434.50	436.54
A5 - Span A4	433.94	437.69
A5 - Span A5	433.39	437.69
A6	437.02	439.47
A7	437.11	439.67
A8 - Span A7	438.17	440.73
A8 - Span A8	438.17	440.73
A9	437.44	440.00
A10	438.76	441.32
A11 - Span A10	439.73	442.29
A11 - Span A11	439.73	442.29
A12 - Span A11	440.09	442.68
A12 - Span A12	440.09	442.68
A13	440.03	442.68
A14	439.78	442.58
A15 - Span A14	439.97	442.93
A15 - Span A15	439.97	442.93
A16	438.89	442.06
A17	440.29	443.79
A18 - Span A17	440.71	444.52
A18 - Span A18	440.71	444.52
A19	439.40	443.52
A20	441.75	445.69
A21 - Span A20	444.51	447.74
A21 - Span A21	444.51	447.74
A22	451.09	451.40
A23	454.57	453.85
A24	458.39	456.60
A25 - Span A24	462.10	459.54

ROADWAY D		
Pier No.	Girder	
	D1	D2
D1 - Span D1	442.44	441.90
D2	438.99	438.49
D3	437.00	436.50
D4	436.90	436.40
D5 - Span D4	437.45	436.95
D5 - Span D5	437.45	436.95
D6	437.46	436.91
D7	437.25	436.64
D8 - Span D7	438.07	438.28
D8 - Span D8	438.07	438.28
D9	436.62	438.15
D10	437.64	440.58
D11 - Span D10	438.26	440.85
D11 - Span D11	438.26	441.09
D12 - Span D11	439.99	442.55
D12 - Span D12	439.99	442.55
D13	439.97	442.53
D14	439.73	442.29
D15 - Span D14	441.06	443.62
D15 - Span D15	441.06	443.62
D16	440.27	442.83
D17	440.20	442.76
D18 - Span D17	439.36	441.61
D18 - Span D18	439.36	441.61
D19	438.51	440.88
D20	437.12	439.63
D21 - Span D20	437.63	440.29
D21 - Span D21	437.63	440.29
D22 - Span D21	436.70	439.57
D22 - Span D22	436.70	439.57
D23	434.48	437.66
D24	433.67	437.36
D25	435.28	439.06
D26 - Span D25	437.16	439.79
D26 - Span D26	440.66	439.79
D27	441.71	441.13
D28 - Span D27	443.50	441.85
D28 - Span D28	443.50	441.85
D29	443.31	440.75
D30	444.67	442.11
D31	447.16	444.60
D32	447.42	444.86
D33 - Span D32	449.80	447.24

ROADWAY G		
Pier No.	Girder	
	G1	G2
G1 - Span G1	449.15	453.38
G2	445.64	452.61
G3	447.18	450.75
G4	447.29	450.47
G5 - Span G4	448.09	451.01
G5 - Span G5	448.09	451.01
G6	446.60	449.35
G7	446.09	448.70
G8	446.29	448.85
G9 - Span G8	446.26	448.82
G9 - Span G9	446.26	448.82
G10	444.90	447.46
G11	441.74	444.30
G12 - Span G11	439.77	441.63
G12 - Span G12	437.61	441.63
G13	434.53	436.43
G14 (Abutment)	433.68	433.84

ROADWAY H		
Pier No.	Girder	
	H1	H2
H1 - Span H1	439.71	443.12
H2 - Span H1	436.51	439.73
H2 - Span H2	436.51	439.73
H3	433.66	436.77
H4	432.84	435.70
H5 (Abutment)	431.86	434.61

RAMP P		
Pier No.	Girder	
	P1	P2
P4 - Span P4	464.26	462.34
P5	464.48	462.56
P6	464.93	463.01
P7 - Span P6	464.59	462.67
P7 - Span P7	464.59	462.67
P8	462.25	460.33
P9	457.37	456.33
P10 - Span P9	453.77	453.43
P10 - Span P10	453.77	453.43
P11	448.74	447.07
P12	444.13	445.36
P13	441.66	443.58
P14 - Span P13	440.25	442.80
P14 - Span P14	440.25	443.63
P15 - Span P14	440.11	443.76
P15 - Span P15	440.11	443.76
H1 - Span P15	439.71	443.12

RAMP S		
Pier No.	Girder	
	S1	S2
G12 - Span S1	437.61	441.43
S1	441.42	443.34
S2	445.03	446.95
S3 - Span S3	443.55	450.14
S3 - Span S4	448.55	450.14
S4	452.31	453.04
S5	457.31	456.96
S6	462.53	461.10
S7 - Span S7	466.93	465.01
S7 - Span S8	466.93	465.01
S8	469.43	467.51
S9	473.31	471.39
S10 - Span S10	476.32	474.20
S15 - Span S16	489.01	487.09
S16	487.55	485.63
S17	484.70	483.11
S18 - Span S18	481.49	480.68

RAMP M		
Pier No.	Girder	
	M1	M2
M6 - Span M7	470.48	468.56
M7	467.78	465.86
M8	463.79	461.87
M9 - Span M9	459.85	457.93
M9 - Span M10	459.85	457.93
M10	454.00	452.30
M11	446.10	445.56
M12 - Span M12	441.66	442.18
M12 - Span M13	441.66	442.18
M13	437.90	439.25
M14	436.00	437.92
A5 - Span A5M	433.94	437.39

RAMP N		
Pier No.	Girder	
	N1	N2
D11 - Span D11N	441.09	440.85
N1 - Span D11N	442.09	441.13
N1 - Span N1	442.09	441.13
N2	442.37	440.63
N3	441.61	439.69
N4	440.62	438.70
N5 - Span N4	440.46	438.54

RAMP O		
Pier No.	Girder	
	O1	O2
G1 - Span O1	452.89	449.15
O1	452.71	450.78
O2	452.51	450.59
O3 - Span O3	452.51	450.59
O3 - Span O4	452.51	450.59
O4	449.47	448.40
O5	445.44	445.30
O6 - Span O6	441.53	442.15
O6 - Span O7	441.53	442.15
O7 - Span O7	437.73	438.87
O7 - Span O8	437.73	438.87
O8	430.89	432.74
O9	424.22	426.18
O10 (Abutment)	420.30	422.22
O11 (Abutment)	416.96	418.45
O12	419.62	420.27
O13	424.05	424.54
O14 - Span O14	428.53	429.02




RAMP R		
Pier No.	Girder	
	R1	R2
A21 - Span A21R	444.51	448.22
R1	443.74	450.60
R2	451.46	453.32
R3 - Span R2	453.75	455.61
R3 - Span R3	453.75	455.61
R4	453.46	455.32
O1	453.41	455.31
G1 - Span O1R	452.69	453.38

RAMP Q		
Pier No.	Girder	
	Q1	Q2
D26 - Span D26Q	437.16	440.66
Q1	440.38	442.30
Q2	441.65	443.57
P14 - Span Q2	442.80	443.63

Note: Bearing Elevations are to Top of Concrete Piers or Abutments.




DESIGNED BY: D.C.
 DRAWN BY: G.G.
 CHECKED BY: A.T.
 APPROVED BY: K.A.

STATE OF ILLINOIS
 DEPARTMENT OF PUBLIC WORKS & BLDGS.
 DIVISION OF HIGHWAYS
 BEARING ELEVATIONS
 POPLAR STREET BRIDGE APPROACHES
 F. A. I. RT. 70 ST. CLAIR CO. SECTION B2-3HVB-1
 B2-3HVF BE-1
 N. W. LOCHNER, INC.
 ENGINEERS
 CHICAGO, ILLINOIS
 SHEET
 378 of 528

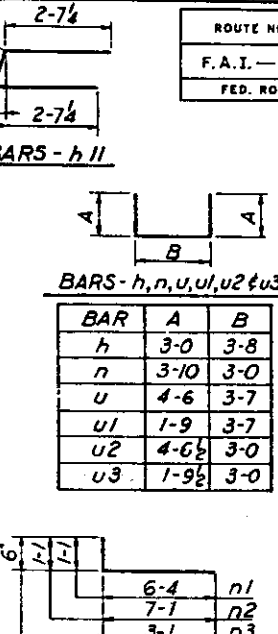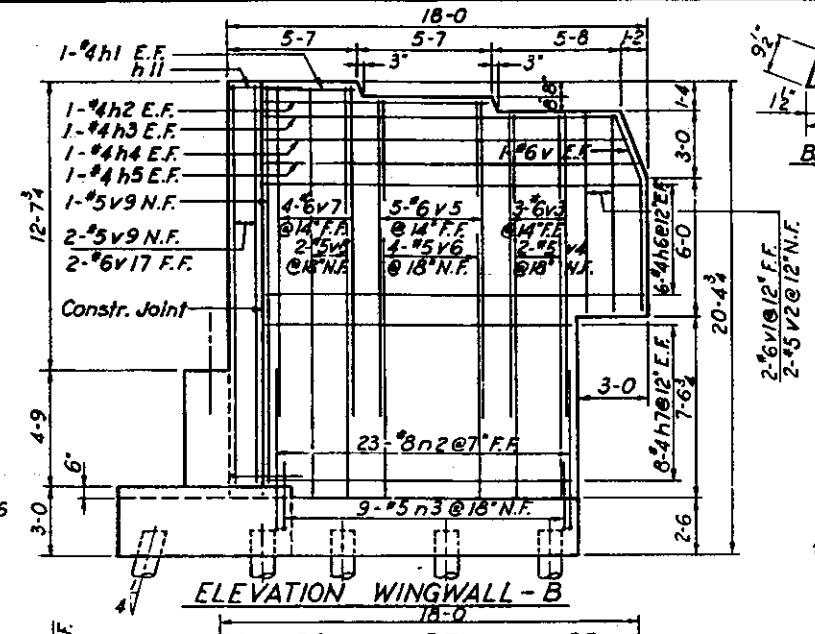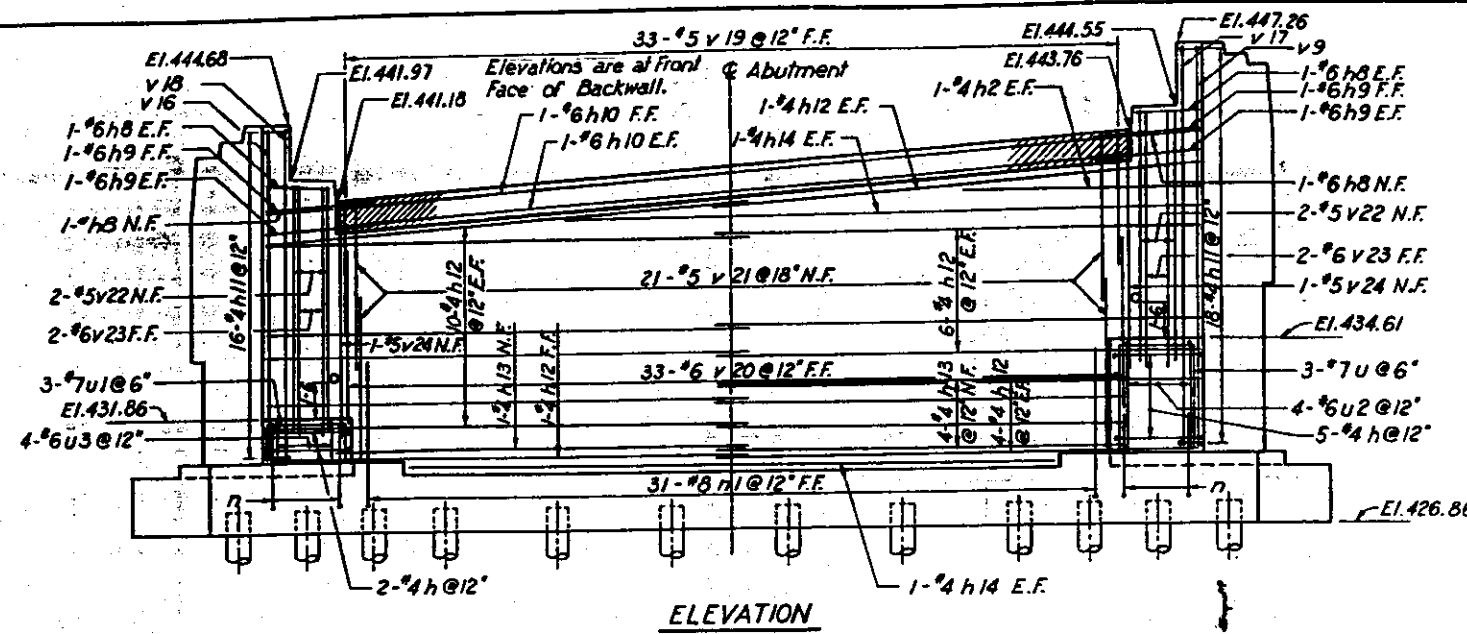

BILL OF MATERIAL




BAR NO.	SIZE	LENGTH	SHAPE
h	#4	9-8	
h1	#4	4-0	
h2	#4	9-7	
h3	#4	15-3	
h4	#4	15-7	
h5	#4	15-11	
h6	#4	16-4	
h7	#4	13-4	
h8	#6	2-10	
h9	#6	4-3	
h10	#6	32-2	
h11	#4	6-0	
h12	#4	19-7	
h13	#4	16-2	
h14	#4	25-7	
n	#6	10-8	
n1	#8	7-5	
n2	#8	8-2	
n3	#5	3-7	
u	#7	12-7	
u1	#7	7-1	
u2	#6	12-1	
u3	#6	6-7	
v	#6	9-0	
v1	#6	8-10	
v2	#5	8-10	
v3	#6	13-5	
v4	#5	16-6	
v5	#6	14-1	
v6	#5	17-2	
v7	#6	14-9	
v8	#5	17-10	
v9	#5	17-4	
v10	#6	10-10	
v11	#5	13-11	
v12	#6	11-6	
v13	#5	14-7	
v14	#6	12-2	
v15	#5	13-3	
v16	#5	14-9	
v17	#6	17-4	
v18	#6	14-9	
v19	#5	6-0	
v20	#6	7-9	
v21	#5	7-4	
v22	#5	11-2	
v23	#6	11-4	
v24	#5	10-4	
w	#6	7-2	
w1	#4	7-2	
w2	#4	13-3	
w3	#4	8-6	
w4	#6	9-6	
w5	#4	22-3	
w6	#4	28-10	
ITEM	UNIT	TOTAL	
Class "X" Concrete	Cu. Yds.	94.9	
Reinforcement Bars	Lbs.	6,130	
Concrete Piles	Lin. Ft.	1,630	
Test Piles (Concrete)	Each	1	

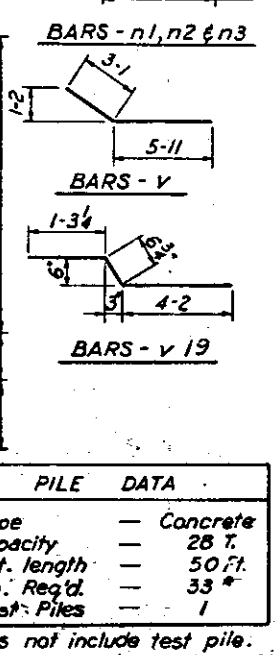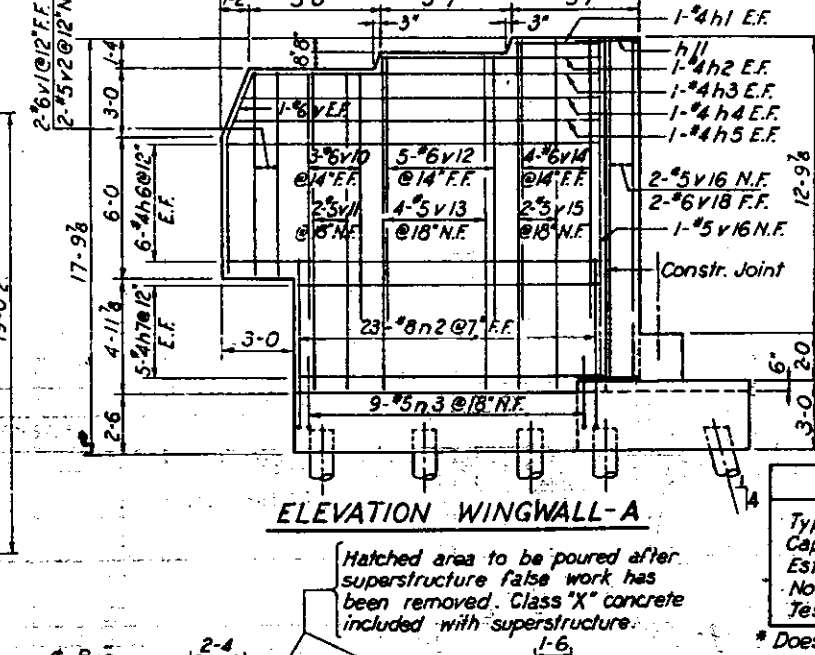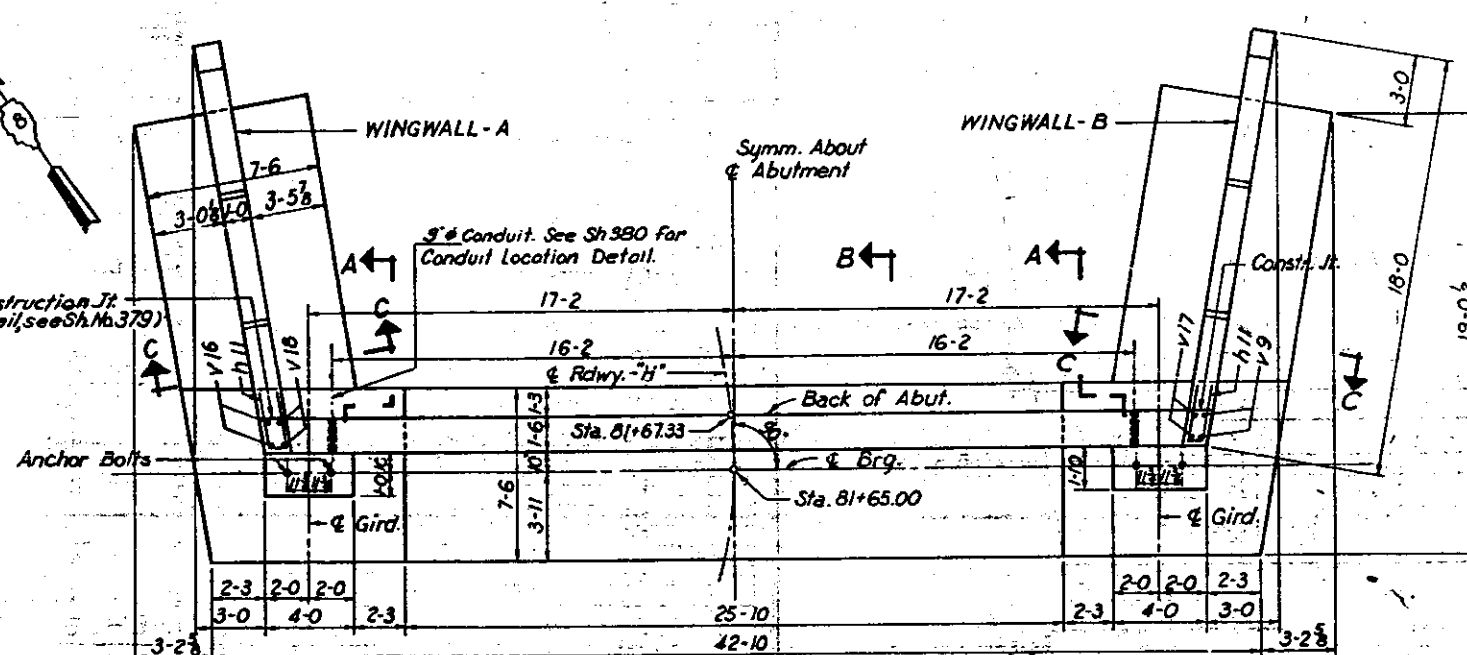

PILE DATA

Type	Concrete
Capacity	28 T.
Est. length	50 Ft.
No. Req'd.	33 *
Test Piles	1

* Does not include test pile.
For Expansion Device Details, see Sh. No. 362-10 (Not applicable to 82-3HV-B-1)

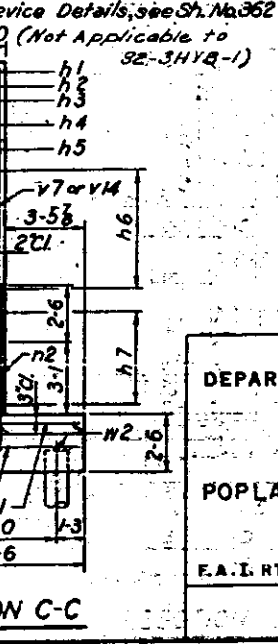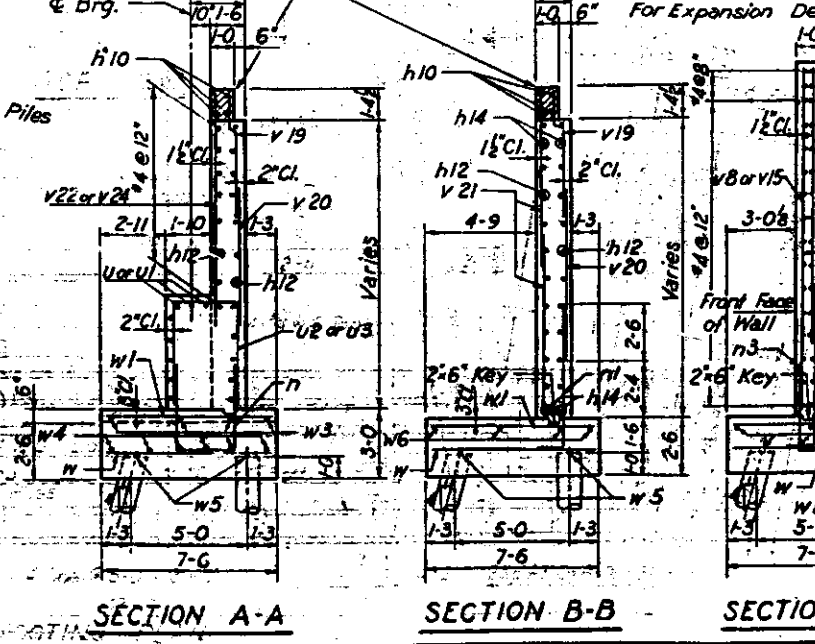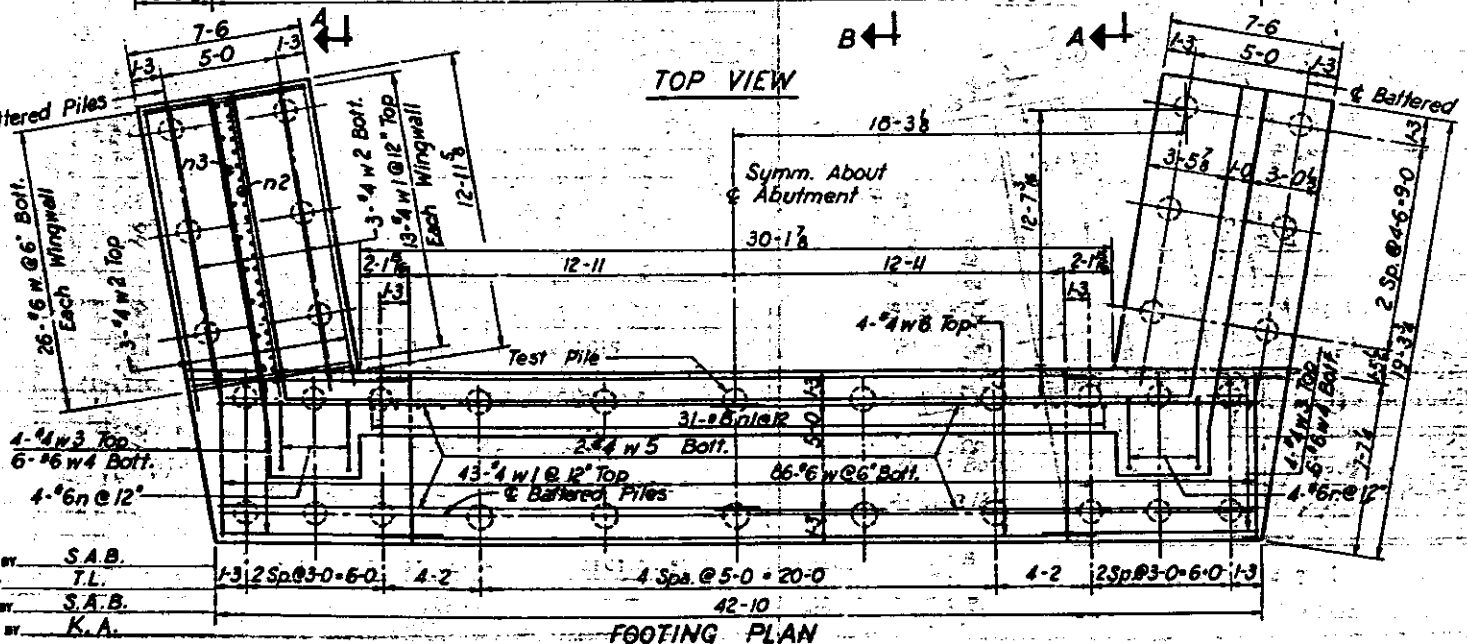











DESIGNED BY S.A.B.
DRAWN BY T.L.
CHECKED BY S.A.B.
APPROVED BY K.A.

ROUTE NO.	SECTION	COUNTY	TOTAL SHEETS	SHEET NO.
F.A.I-70	82-3HVB-1	ST. CLAIR	207	104
FED. ROAD DIV. NO. 4		ILLINOIS	PROJECT	

BILL OF MATERIAL				
* Mark	No. Reqd.	Size	Length	Shape
426 h1	10	#11	43-8	—
426 h2	44	#5	22-8	—
426 n1	22	#6	4-11	□
426 S1	33	#4	12-9	○
426 S2	39	#6	6-0	□
426 S3	39	#6	11-10	□
426 t1	51	#7	9-8	—
426 U1	26	#5	9-5	C
426 V1	20	#9	14-3	—
426 V2	20	#9	17-8	—
426 V3	40	#9	6-8	—
426 V4	100	#6	12-1	—
426 W1	22	#6	25-11	—
426 W2	6	#4	25-7	—

*See Note "X" Sp. No. 35

Item	Unit	Total
Class "X" Concrete	C.Y.	162.6
Reinforcement Bars	Lbs.	11,960
Concrete Piles	L.F.	1421 *
Test Piles (Concrete)	Ea.	1

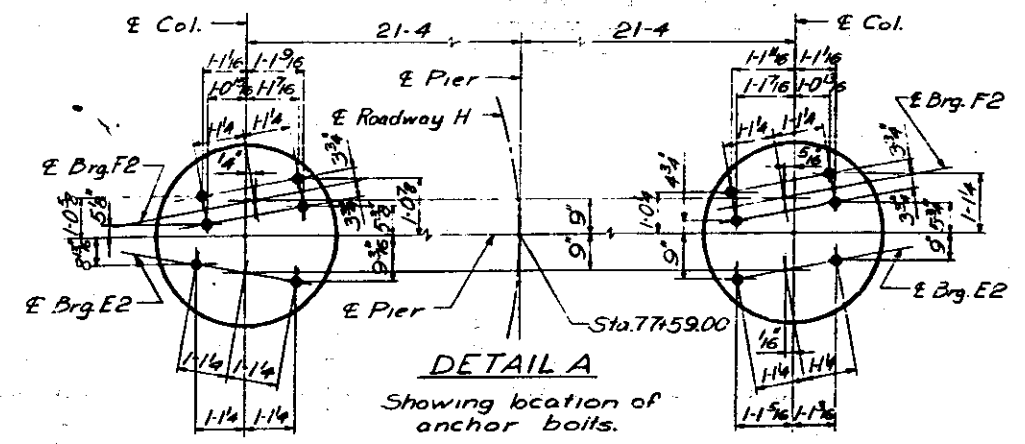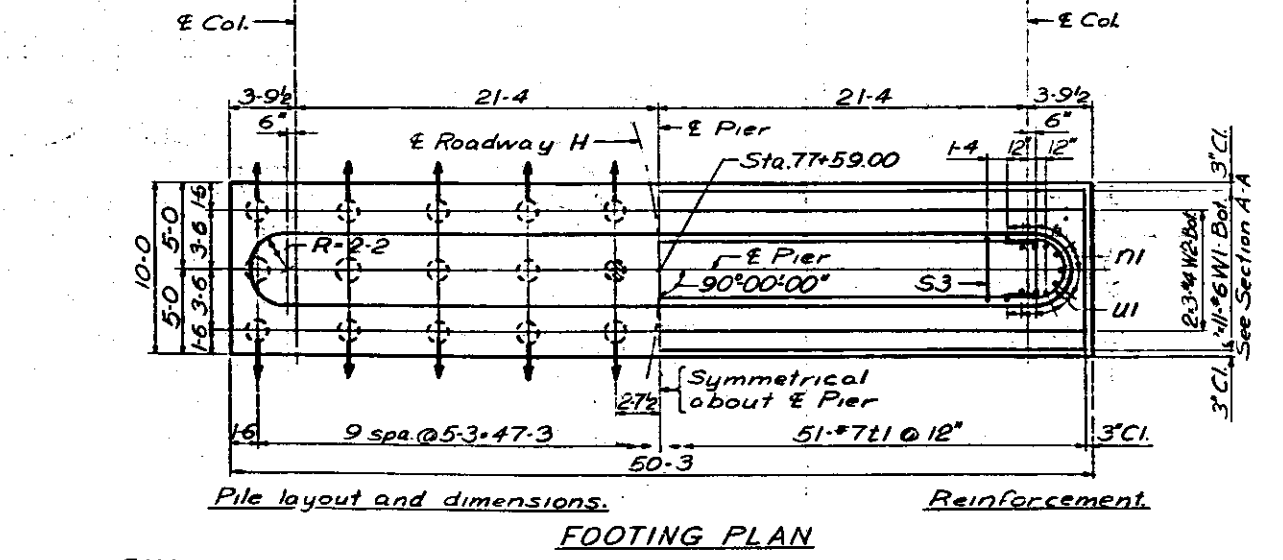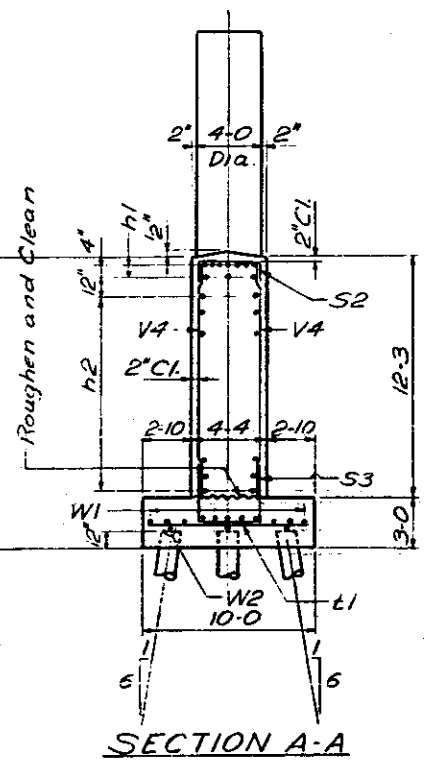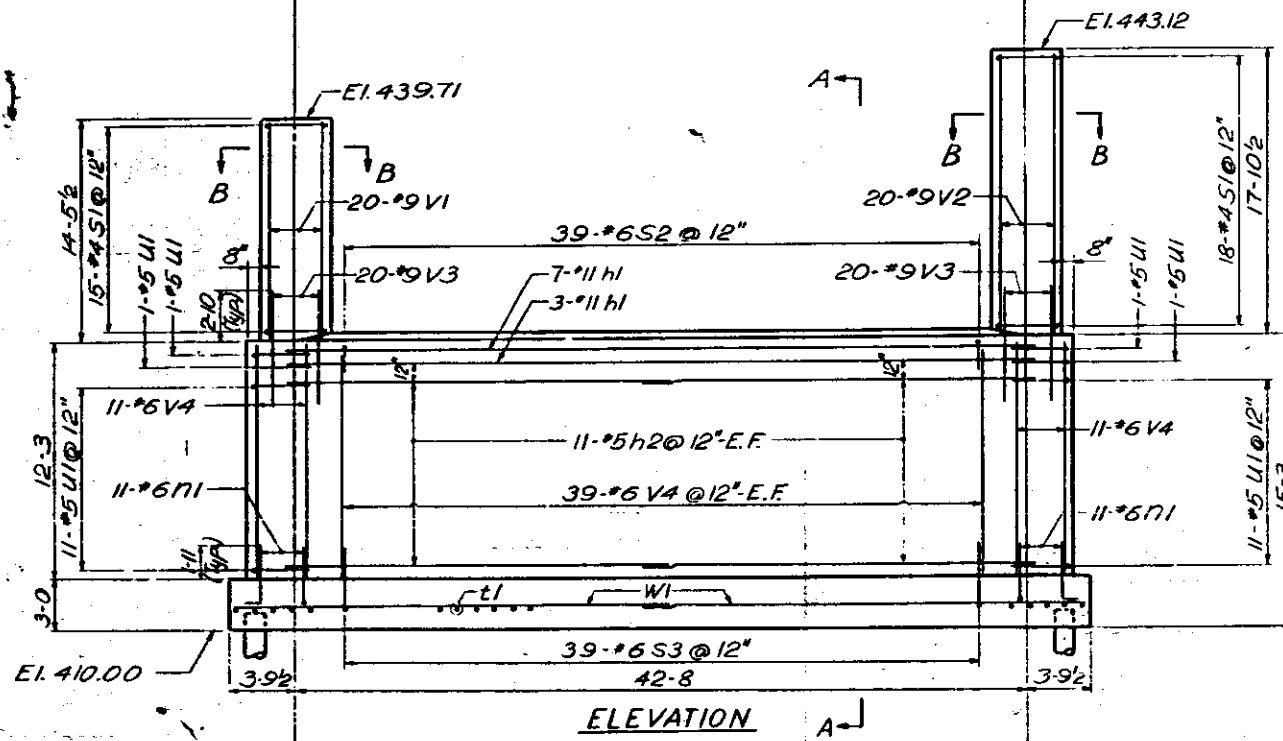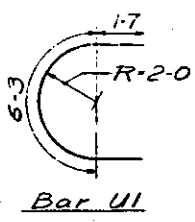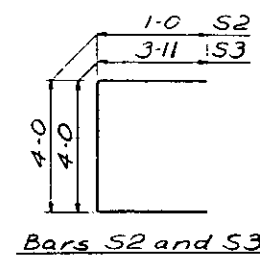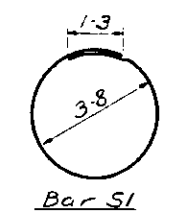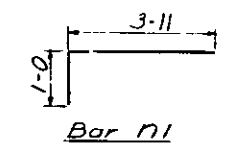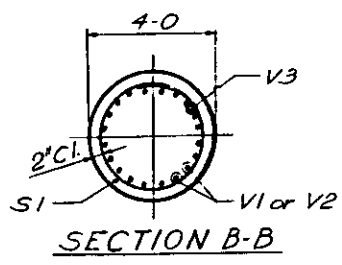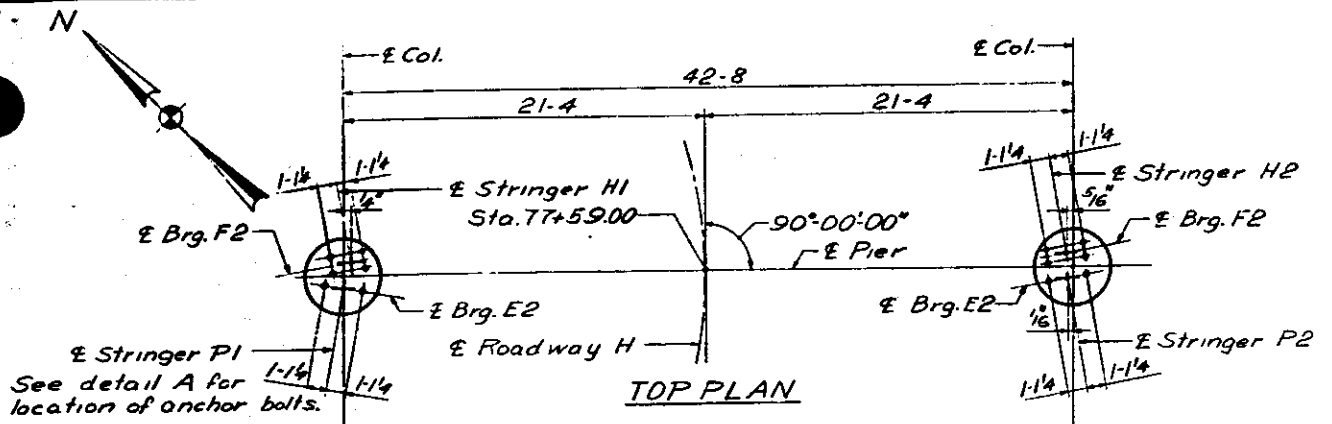

PILE DATA:
 Type: Concrete.
 Req'd Capacity: 33T
 Est. Length: 49-0
 No. Req'd: 29*
 Test Piles: 1







* Does not include test pile.

DESIGNED BY E.W.
 DRAWN BY S.A.
 CHECKED BY S.K.
 APPROVED BY K.A.

○ Indicates battered pile.
 ⊙ Indicates test pile.

STATE OF ILLINOIS
 DEPARTMENT OF PUBLIC WORKS & BLDGS.
 DIVISION OF HIGHWAYS
 PIER HI
 POPLAR STREET BRIDGE APPROACHES
 ROADWAY "H"
 F.A.I. RT. 70 ST. CLAIR CO SECTION 82-3HVB-1
 H. W. LOCHNER, INC.
 ENGINEERS
 CHICAGO, ILLINOIS
 SHEET
 426 of 526

ROUTE NO.	SECTION	COUNTY	TOTAL SHEETS	SHEET NO.
F.A.I.-70	82-3HVB-1	ST. CLAIR	207	105
FED. ROAD DIV. NO. 4		ILLINOIS	PROJECT	

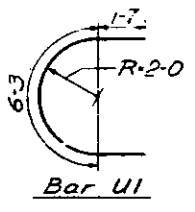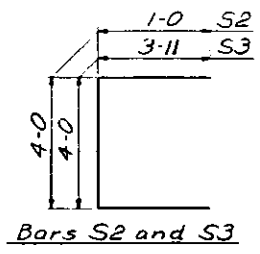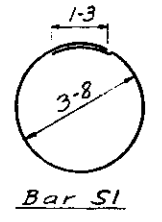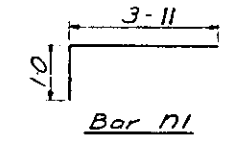
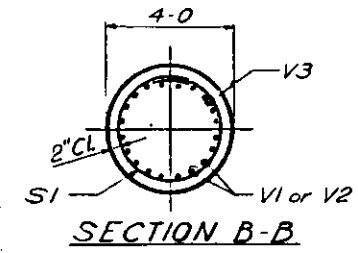
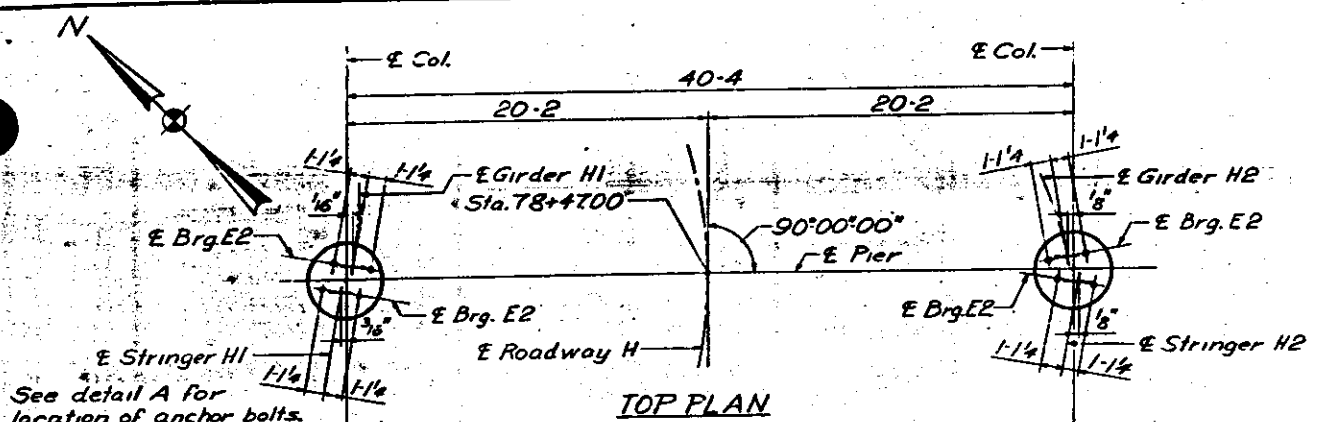


BILL OF MATERIAL

Mark	No. Req'd	Size	Length	Shape
427h1	10	#10	41-4	—
427h2	56	#5	21-6	—
427N1	22	#6	4-11	□
427S1	27	#4	12-9	○
427S2	37	#6	6-0	□
427S3	37	#6	11-10	□
427t1	49	#7	8-8	—
427U1	32	#5	9-5	⌒
427V1	20	#9	11-1	—
427V2	20	#9	14-3	—
427V3	40	#9	6-8	—
427V4	95	#6	15-1	—
427W1	18	#6	25-0	—
427W2	6	#4	24-8	—


*See Note "X" Sh. No. 35

Item	Unit	Total
Class "X" Concrete	C.Y.	169.5
Reinforcement Bars	Lbs.	11,180
Concrete Piles	L.F.	1040*
Test Piles (Concrete)	Ea.	1

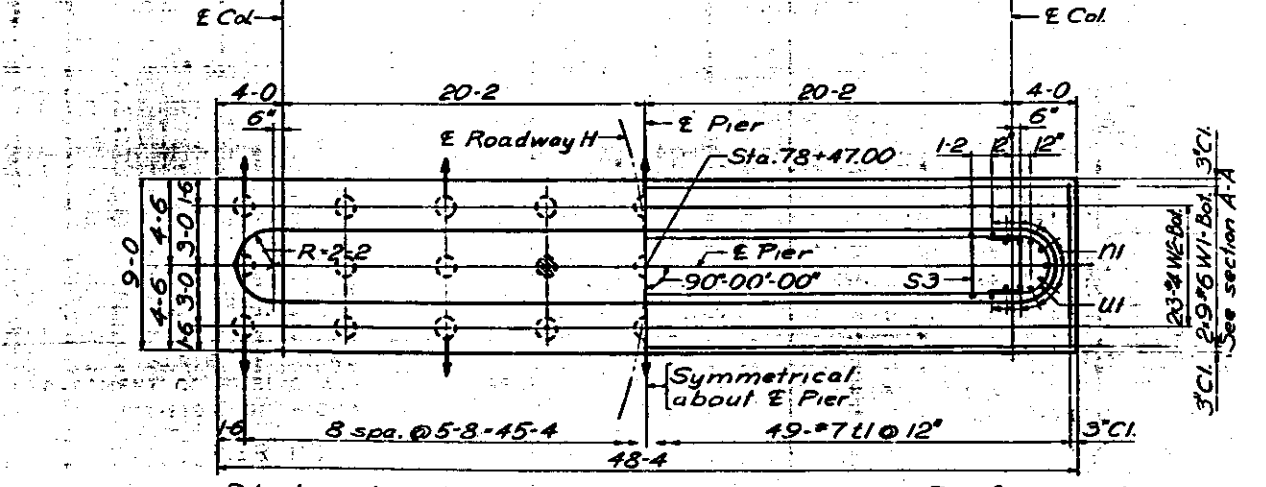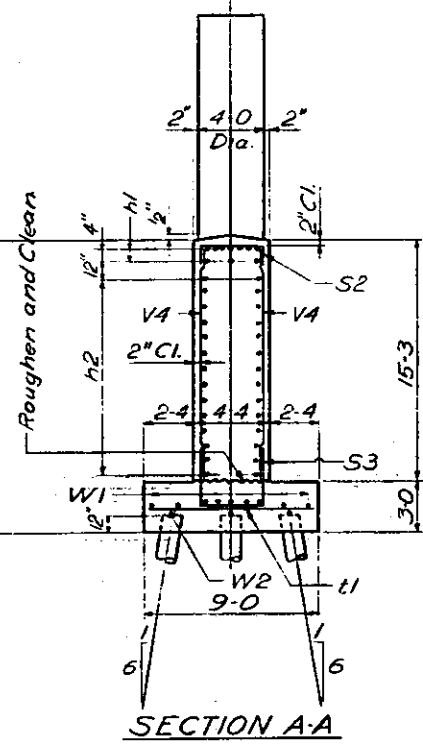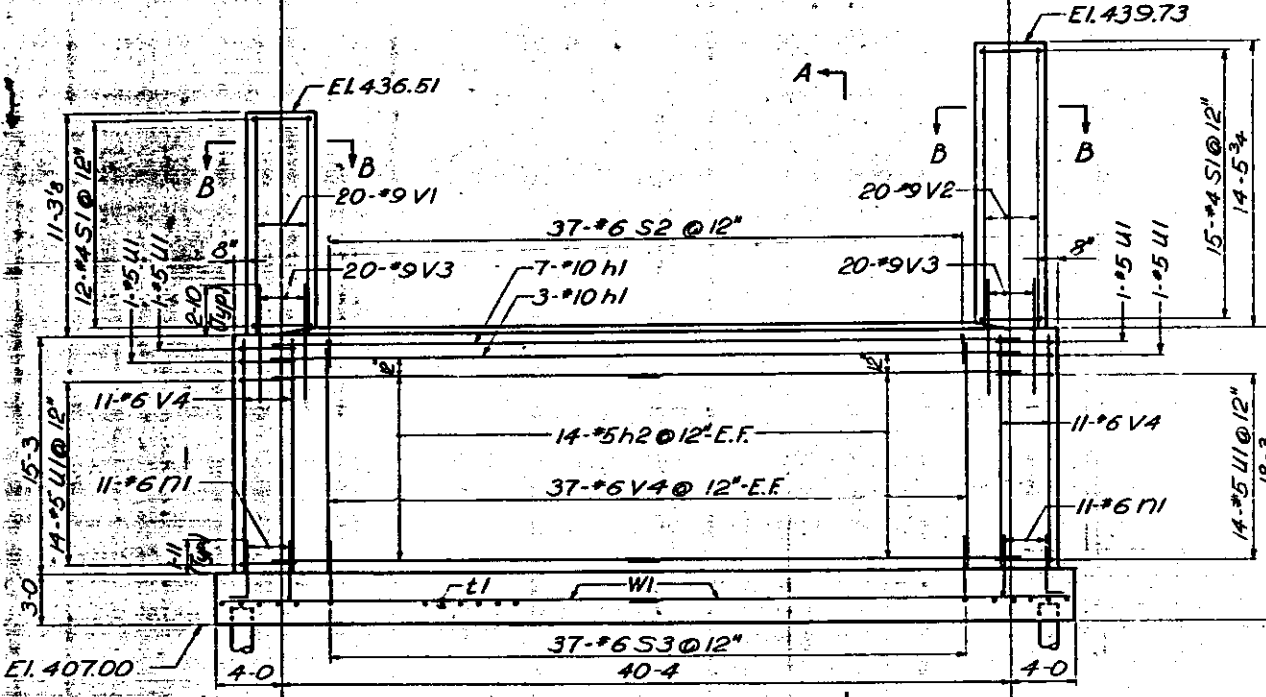

PILE DATA:
 Type: Concrete.
 Req'd. Capacity: 35'
 Est. Length: 40-0
 No. Req'd: 26*
 Test Piles: 1

* Does not include test pile.

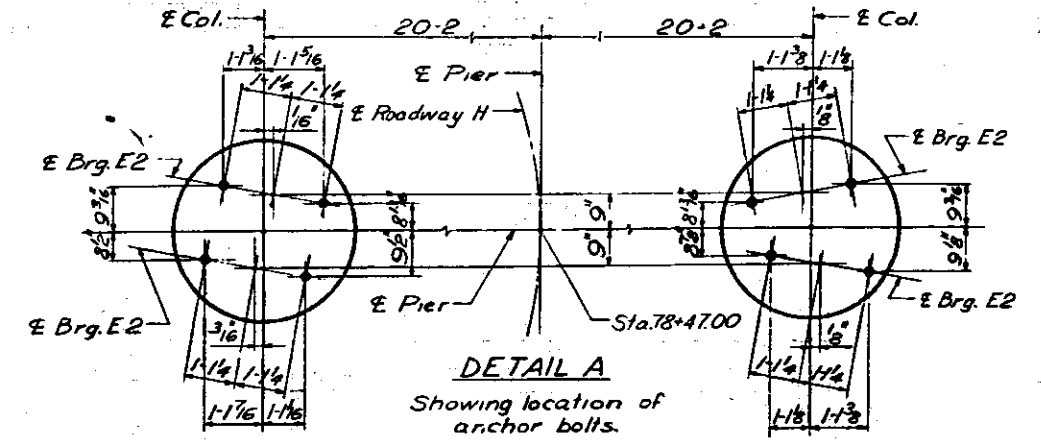

DESIGNED BY: E.W.
 DRAWN BY: S.A.
 CHECKED BY: S.K.
 APPROVED BY: K.A.

○ Indicates battered pile. ● Indicates test pile.

STATE OF ILLINOIS
 DEPARTMENT OF PUBLIC WORKS & BLDGS.
 DIVISION OF HIGHWAYS

PIER H2



POPLAR STREET BRIDGE APPROACHES
 ROADWAY "H"

F.A.I. RT. 70 ST. CLAIR CO. SECTION 82-3HVB-1

N. W. LOCHNER, INC.
 ENGINEERS
 CHICAGO, ILLINOIS

SHEET
 427 of 526

ROUTE NO.	SECTION	COUNTY	TOTAL SHEETS	SHEET NO.
F. A. I.-70	82-3HVB-1	ST. CLAIR	207	138
FED. ROAD DIV. NO. 4		ILLINOIS	PROJECT	

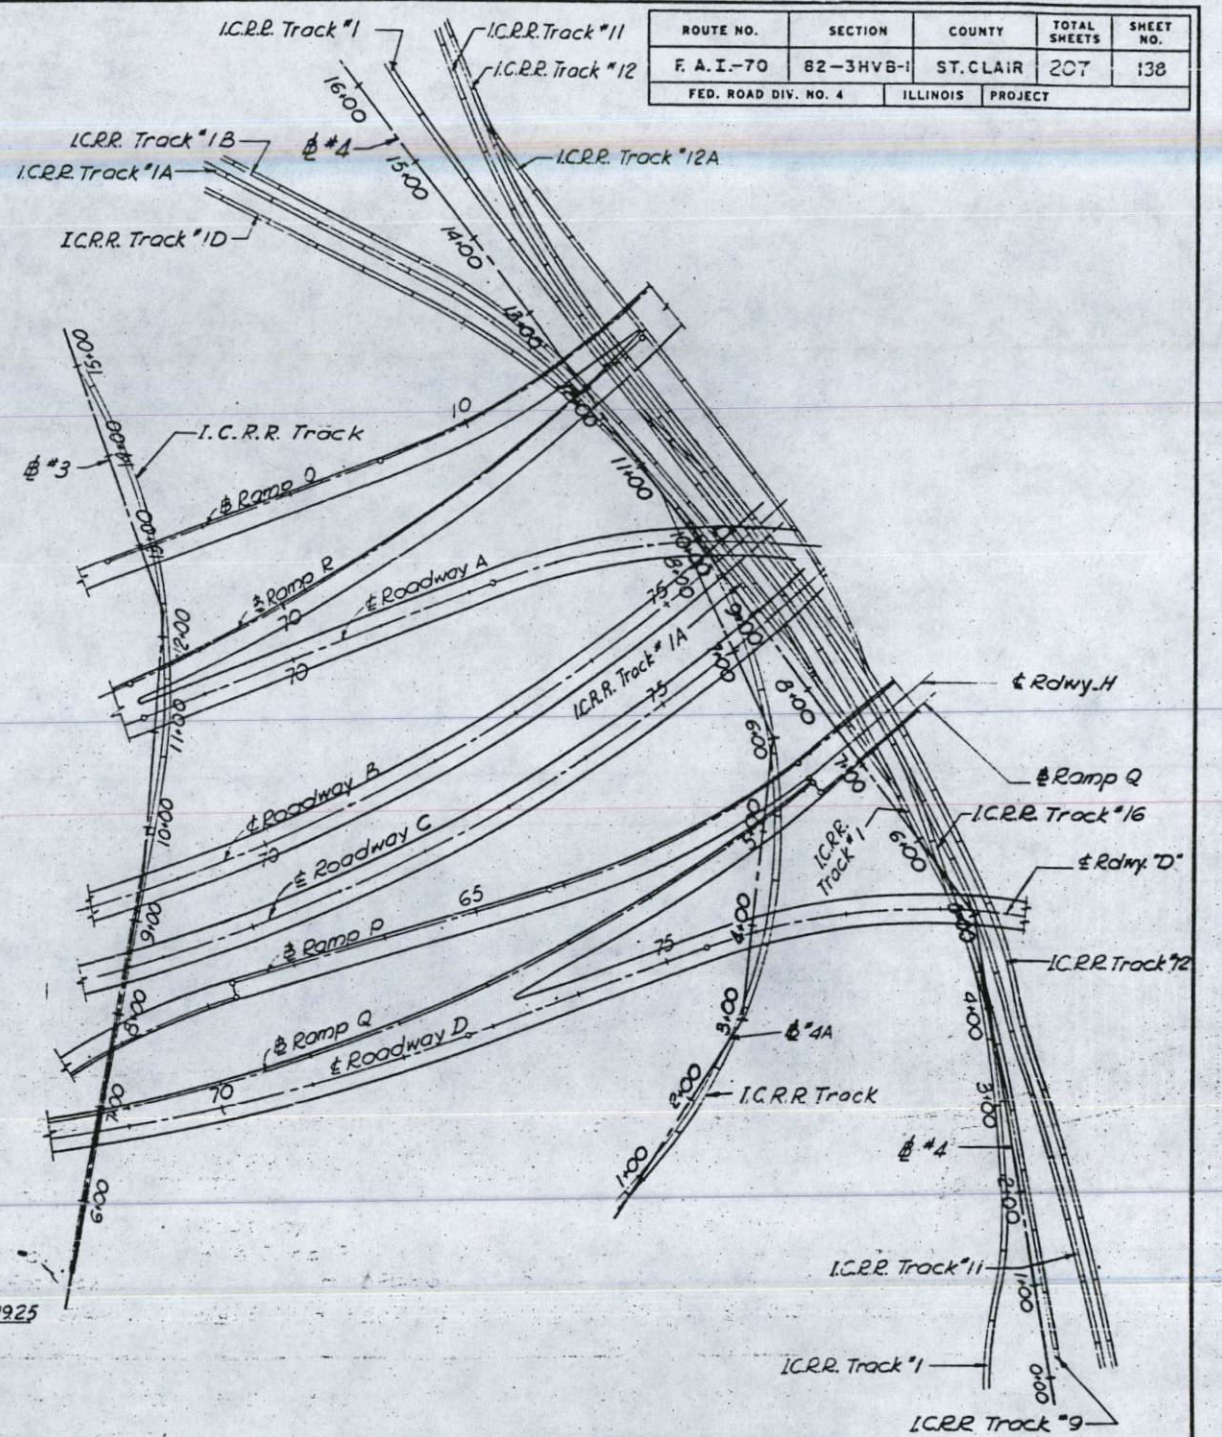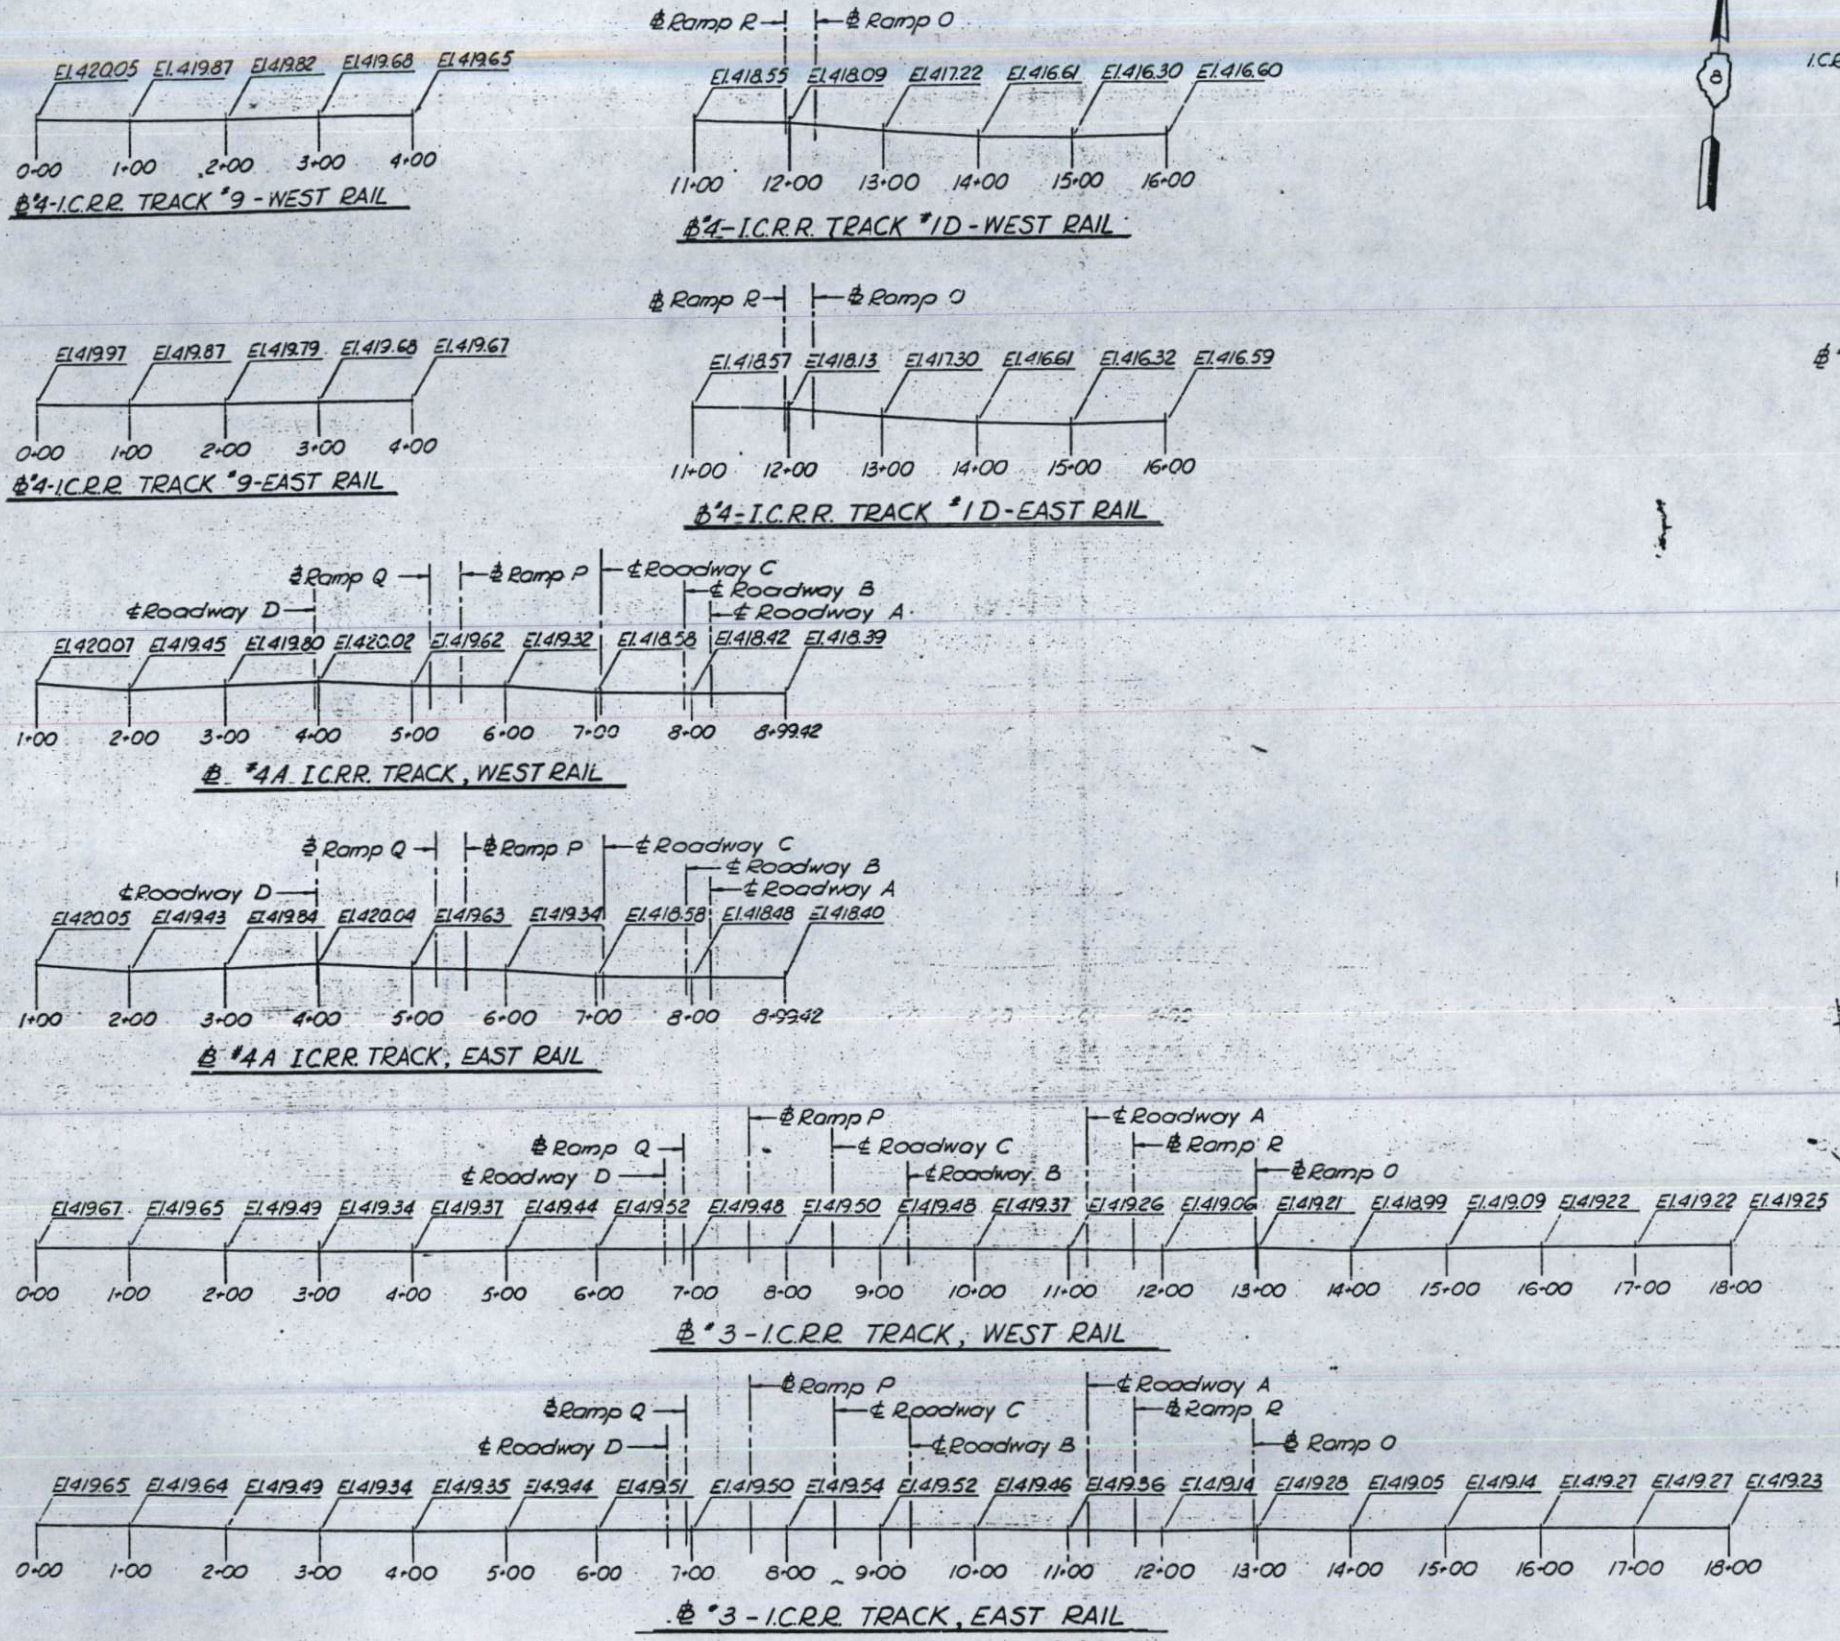

PLAN-I.C.R.R. TRACKS
 Scale: 1"=100'
 For Track #1, #11, #12, #1A, #1B & #12A
 Profiles see Sheet No. 178

STATE OF ILLINOIS
 DEPARTMENT OF PUBLIC WORKS & BLDGS.
 DIVISION OF HIGHWAYS
 ILLINOIS CENTRAL RAILROAD













PROFILES

F.A.I.R.T 70 ST. CLAIR CO. SECTION 82-3HVB-1

H. W. LOCHNER, INC.
 ENGINEERS
 CHICAGO, ILLINOIS

SHEET
 4600 525

ROUTE NO.	SECTION	COUNTY	TOTAL SHEETS	SHEET NO.
F. A. I. - 70	82-3HVB-1	ST. CLAIR	207	139
FED. ROAD DIV. NO. 4	ILLINOIS PROJECT			

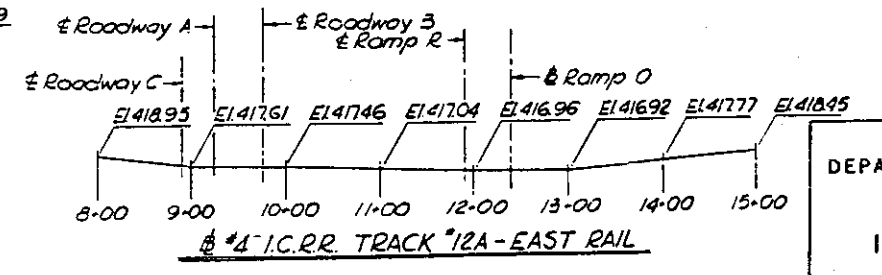
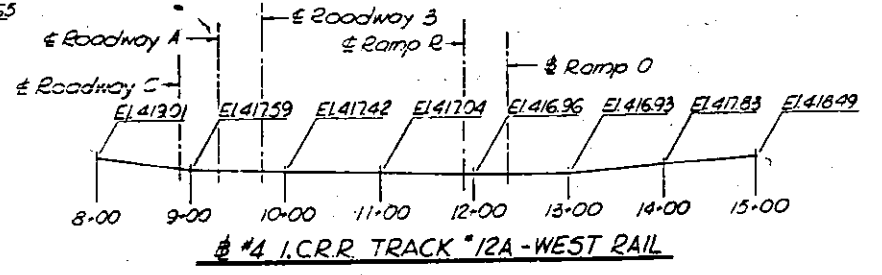
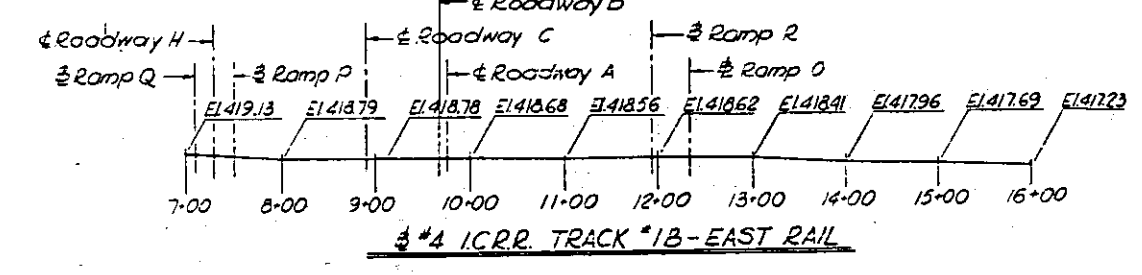
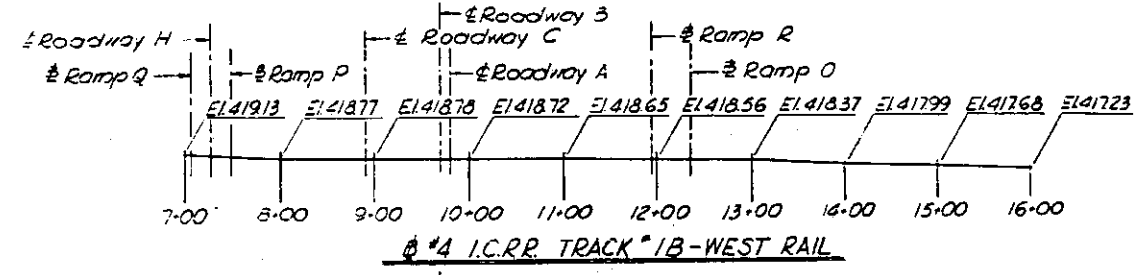
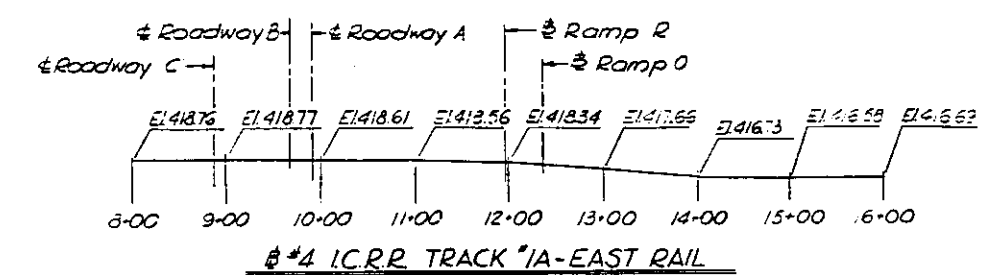
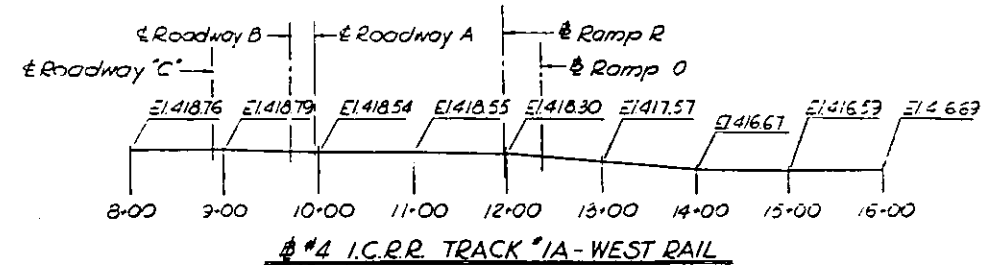
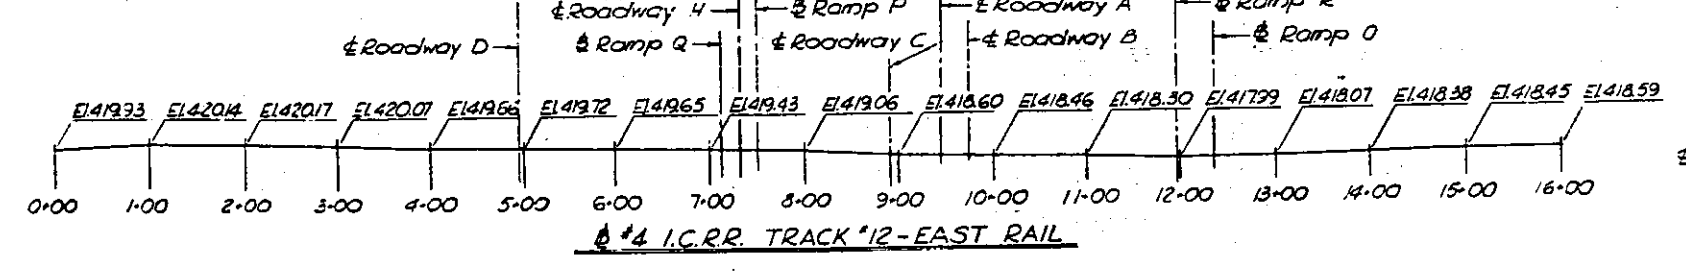
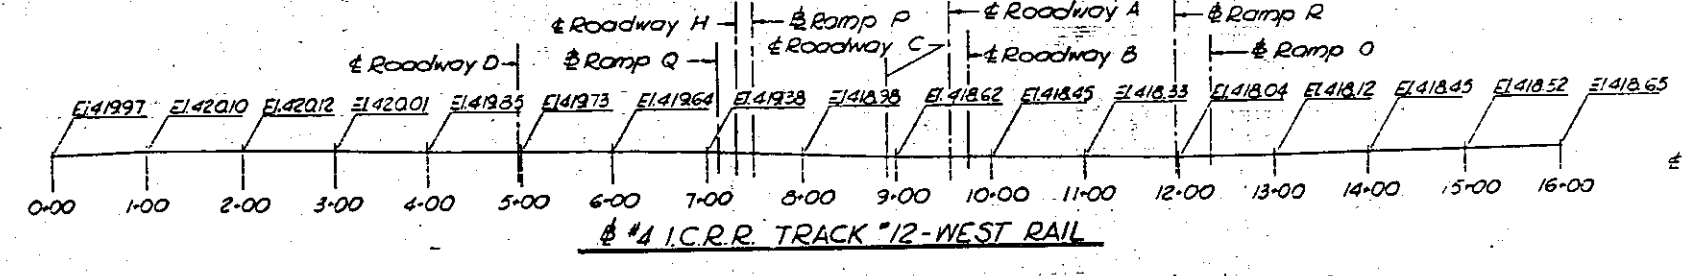
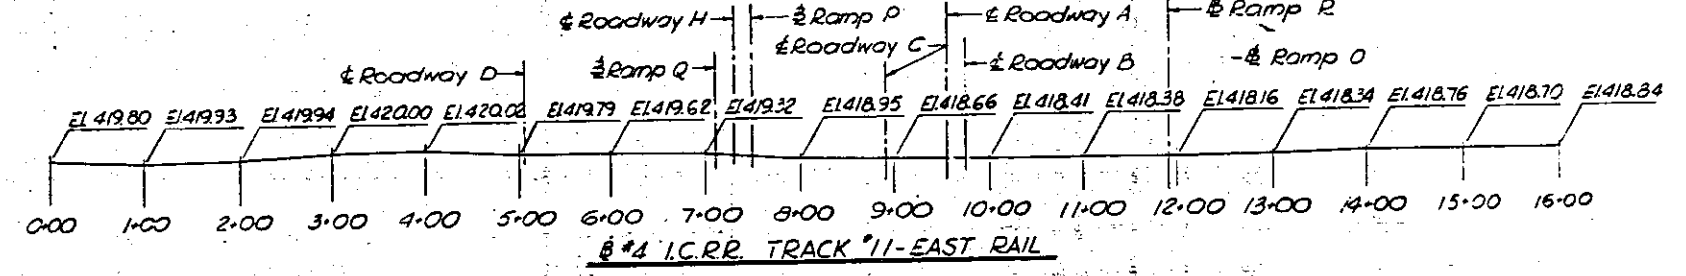
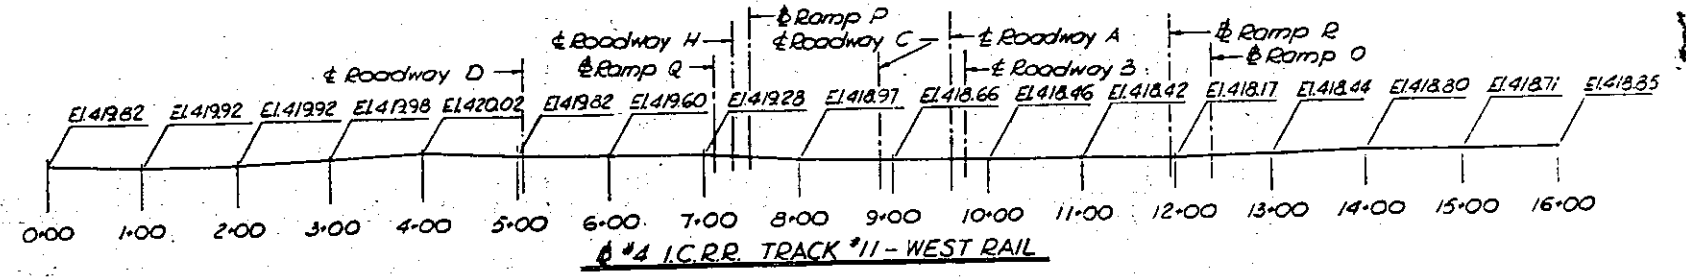
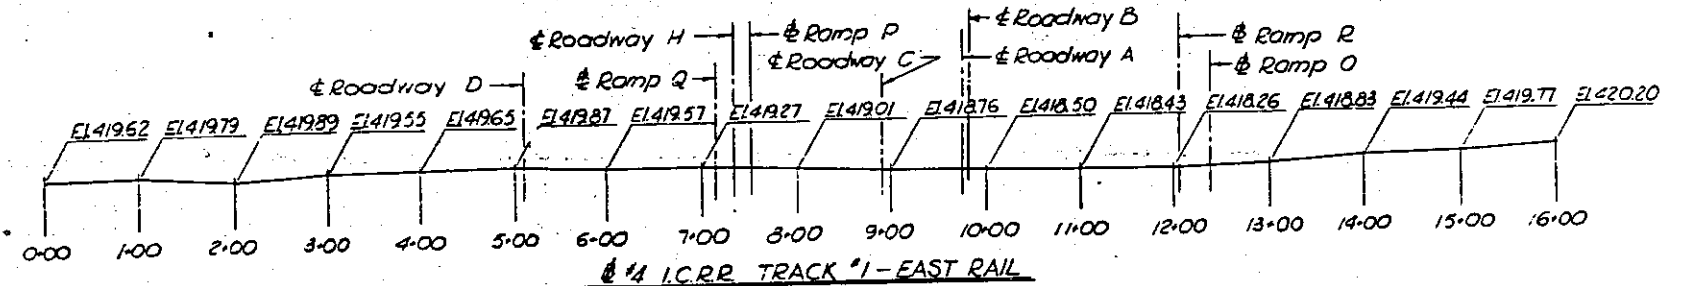
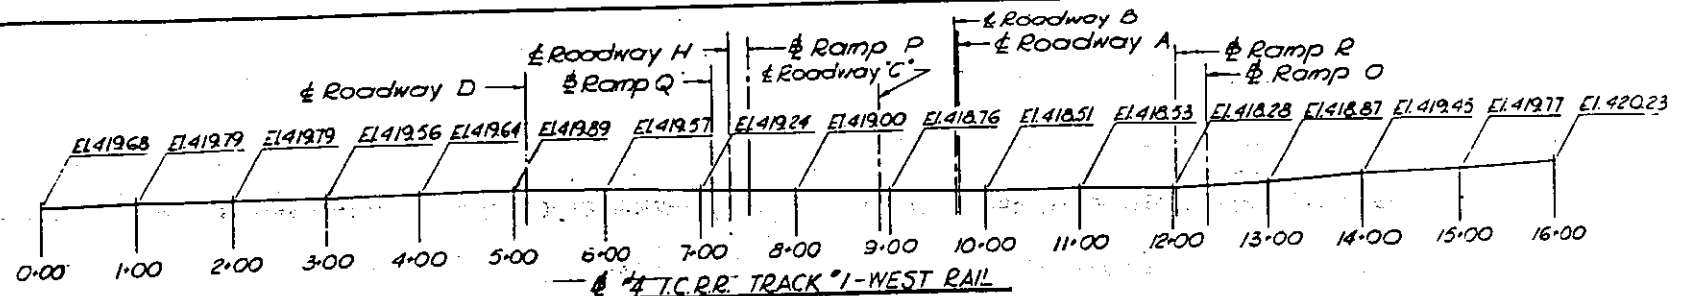


STATE OF ILLINOIS
DEPARTMENT OF PUBLIC WORKS & BLDGS.
DIVISION OF HIGHWAYS

ILLINOIS CENTRAL RAILROAD
PROFILES

F. A. I. RT. 70 ST. CLAIR CO. SECTION 82-3HVB-1
H. W. LOCHNER, INC. ENGINEERS CHICAGO, ILLINOIS SHEET 461 of 526

ROUTE NO.	SECTION	COUNTY	TOTAL SHEETS	SHEET NO.
F. A. I. 70	B2-3HVB-1	ST. CLAIR	207	140
FED. ROAD DIV. NO. 4		ILLINOIS	PROJECT	

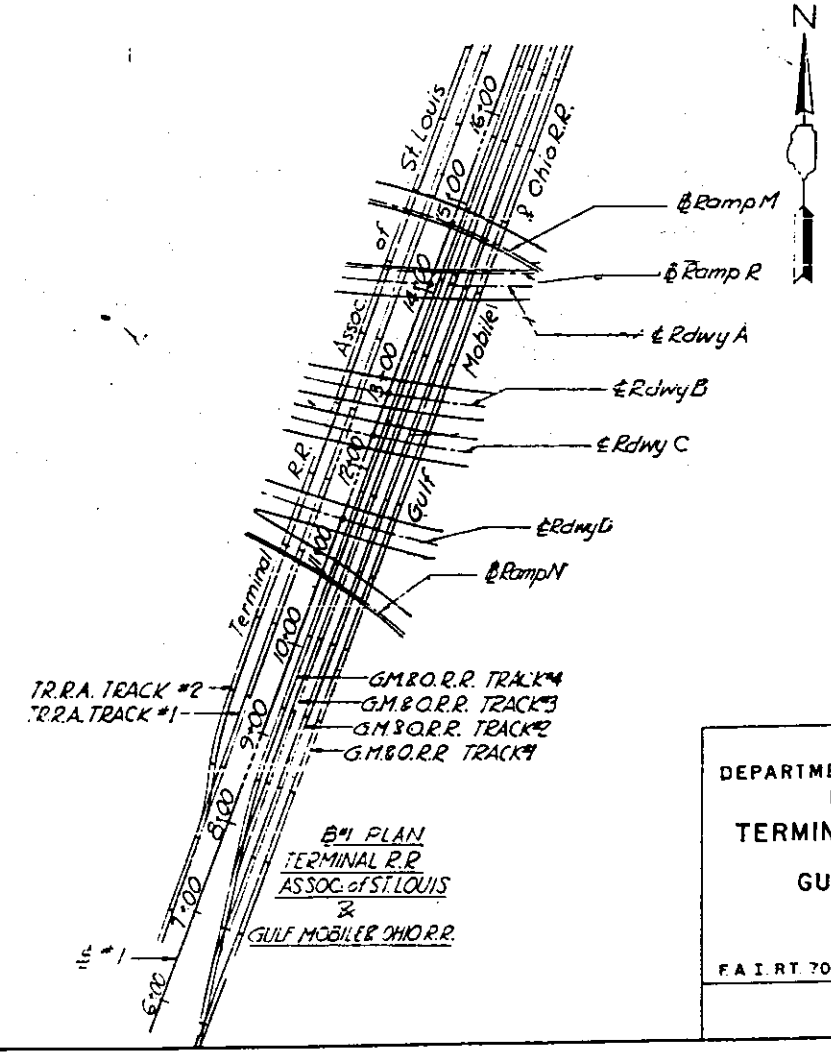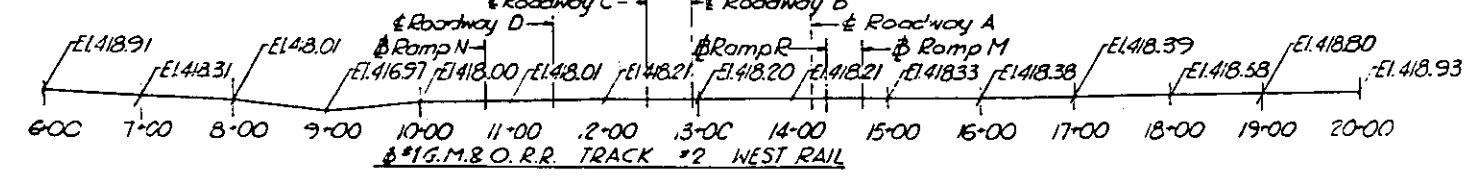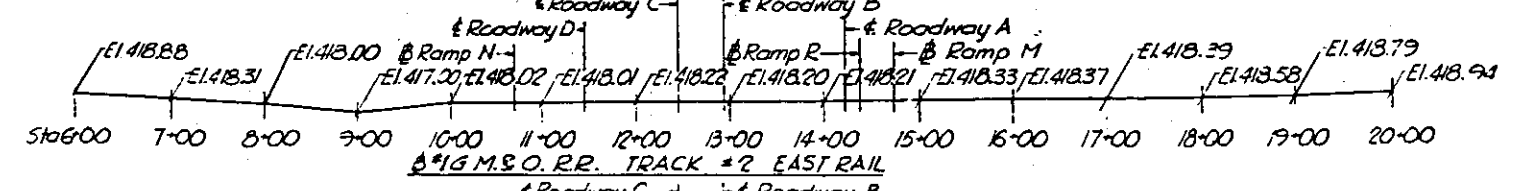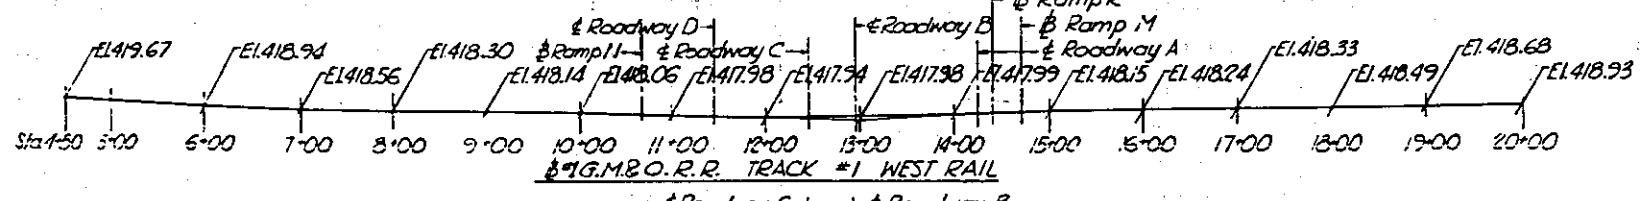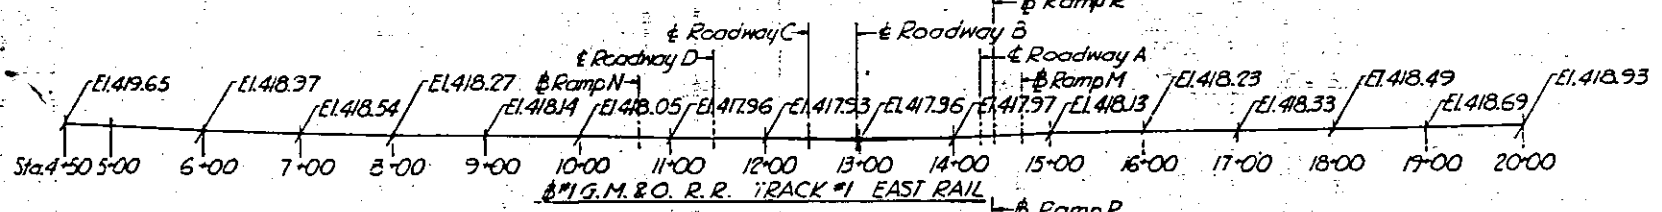
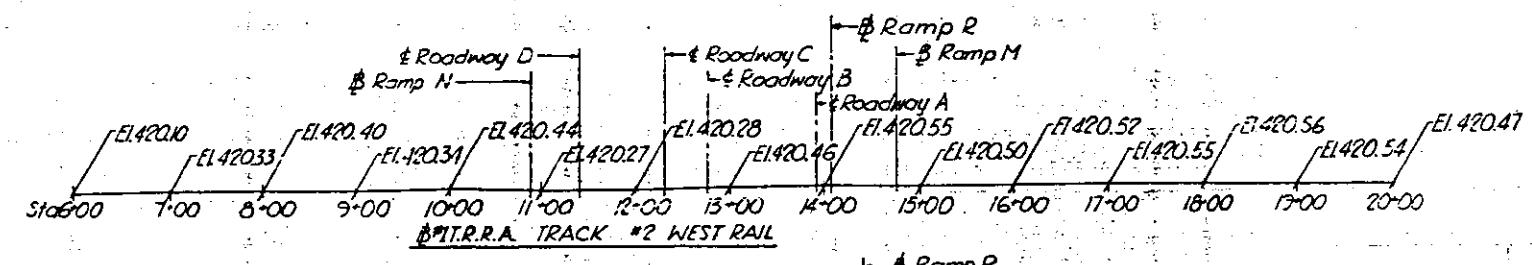
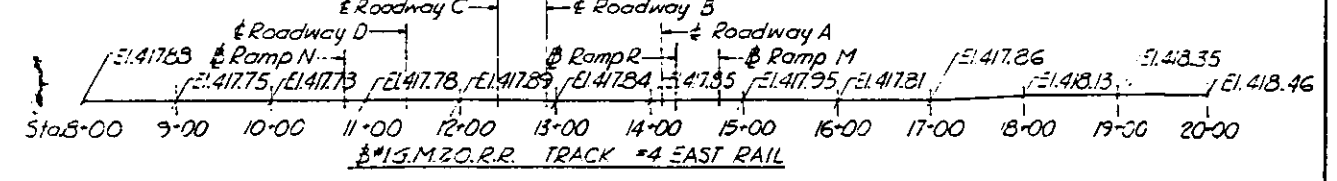
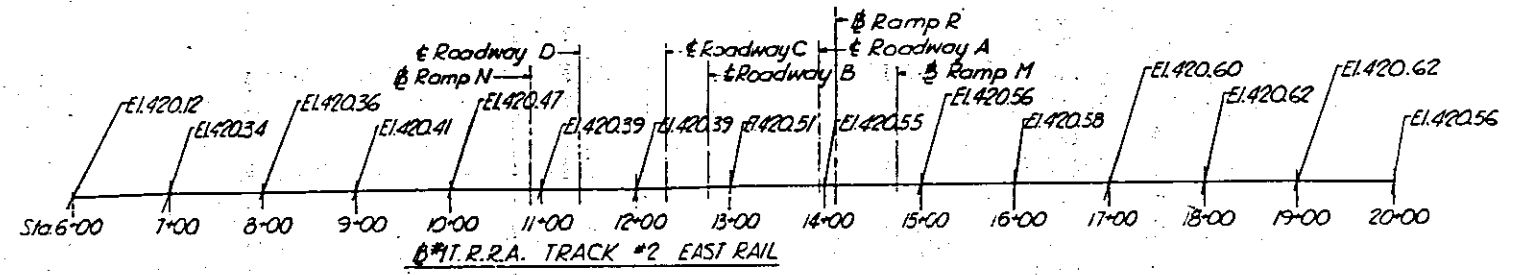
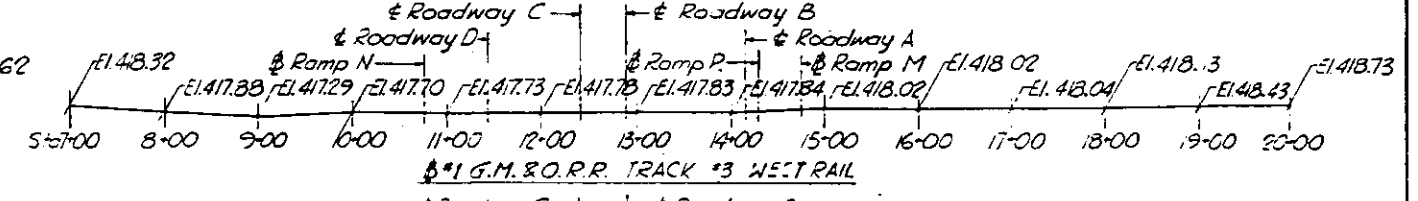
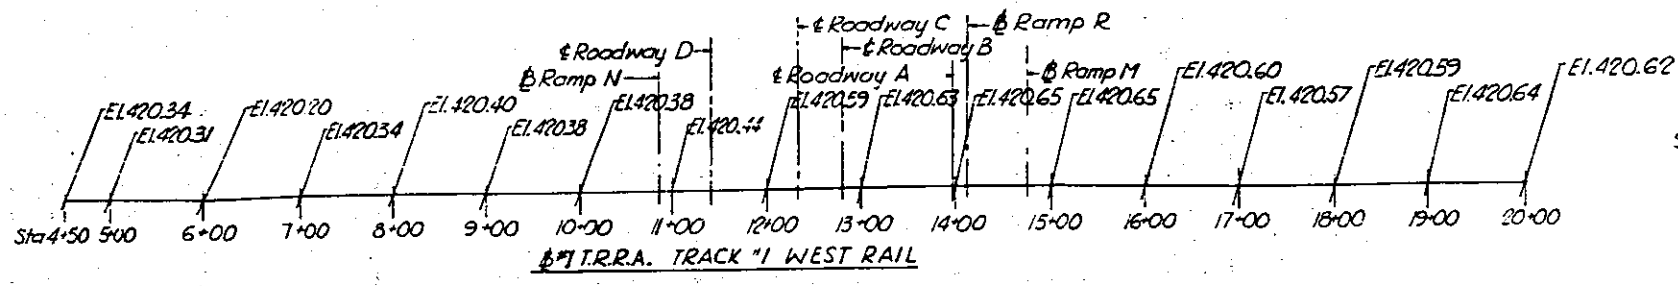
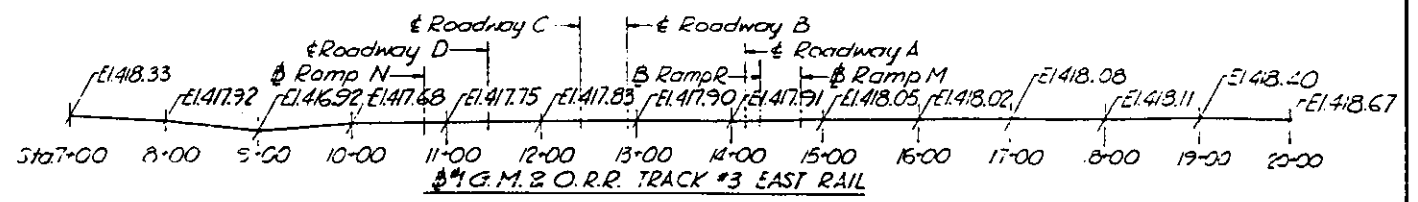
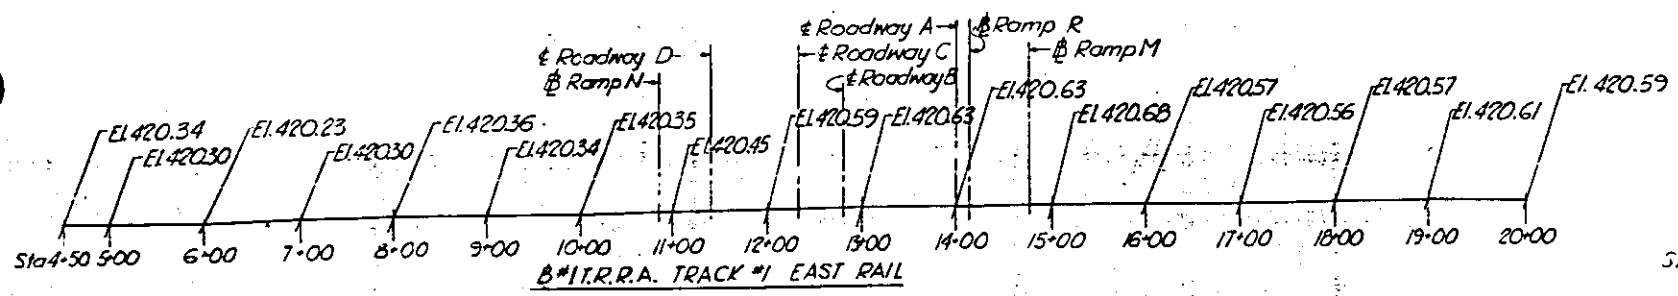


STATE OF ILLINOIS
DEPARTMENT OF PUBLIC WORKS & BLDGS.
DIVISION OF HIGHWAYS
TERMINAL R.R. ASSOC. OF ST. LOUIS
AND
GULF MOBILE & OHIO R.R.
PROFILES

F. A. I. RT. 70 ST. CLAIR CO. SECTION B2-3HVB-1
H. W. LOCHNER, INC.
ENGINEERS
CHICAGO, ILLINOIS

SHEET 140 OF 207

ROUTE NO.	SECTION	COUNTY	TOTAL SHEETS	SHEET NO.
F.A.I. 70	82-3HVB-1	ST. CLAIR	207	141
FED. ROAD DIV. NO. 4	ILLINOIS	PROJECT		

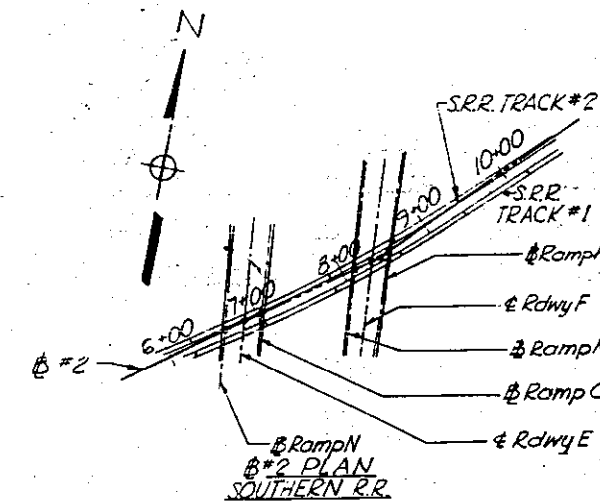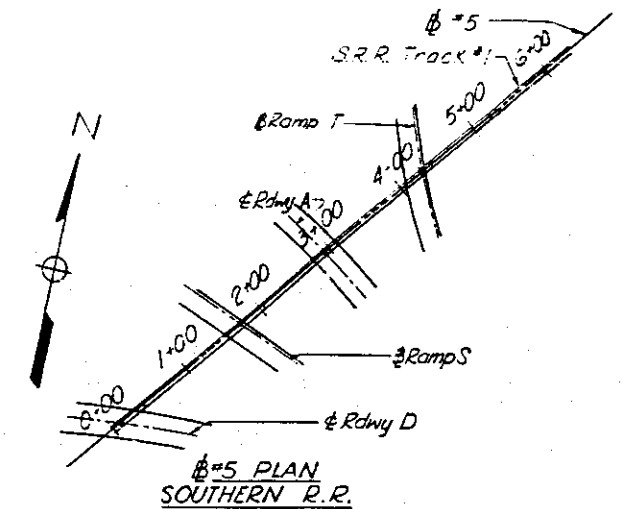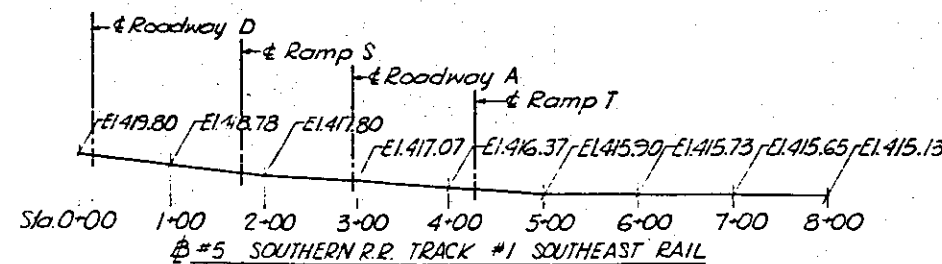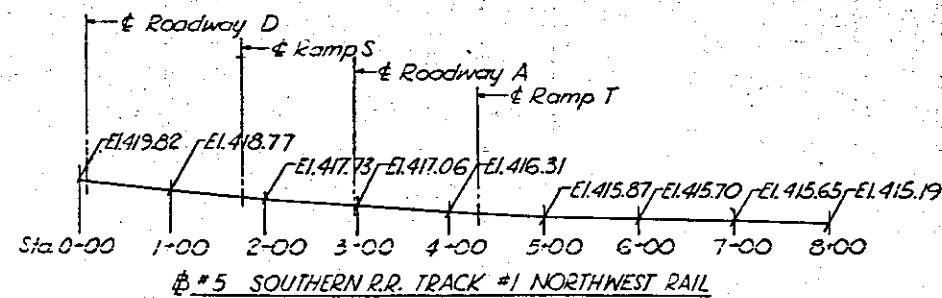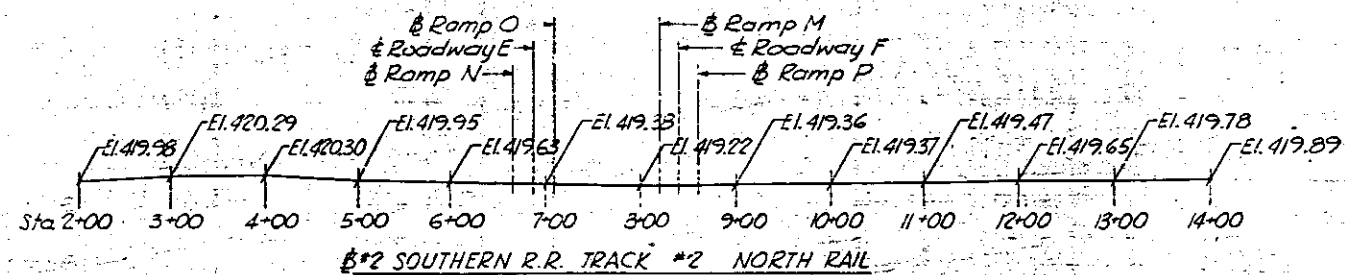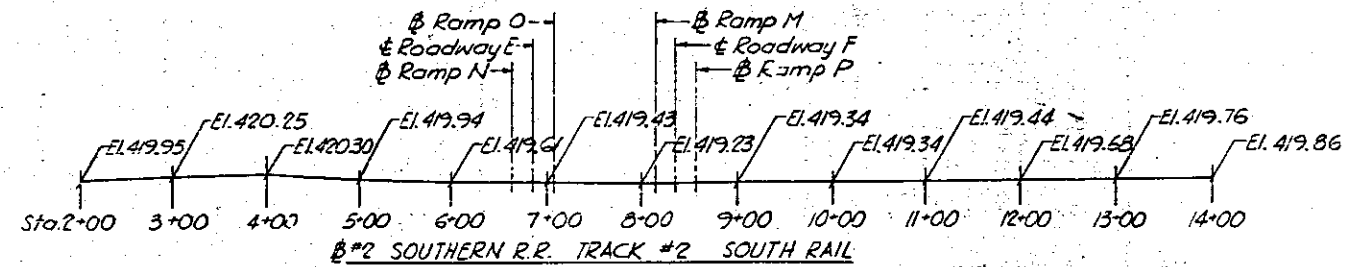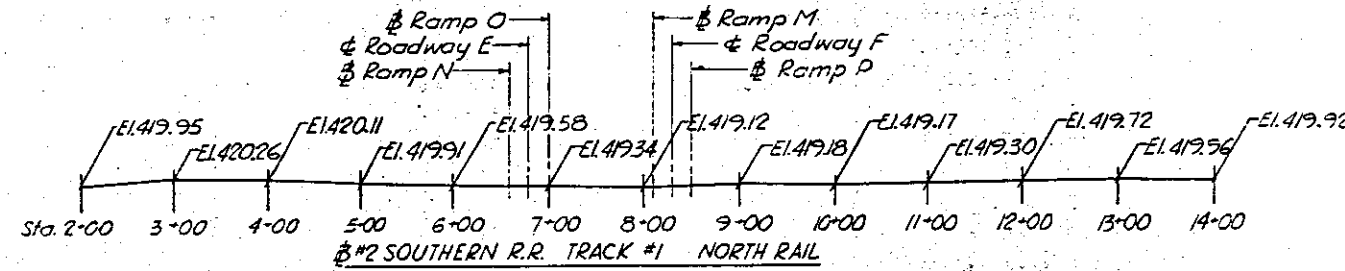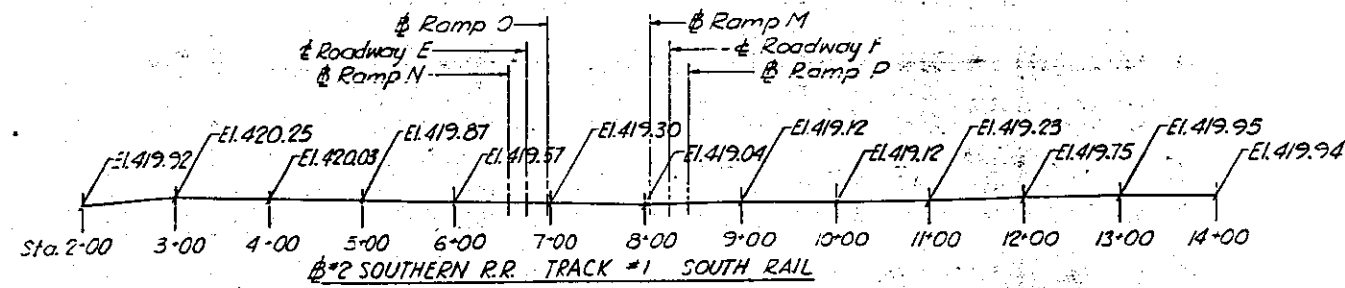


STATE OF ILLINOIS
DEPARTMENT OF PUBLIC WORKS & BLDGS.
DIVISION OF HIGHWAYS

SOUTHERN RAILROAD
PROFILES

F.A.I. RT. 70 ST. CLAIR CO. SECTION 82-3HVB-1
H. W. LOCHNER, INC.
ENGINEERS
CHICAGO, ILLINOIS

SHEET
463 of 525

ROUTE NO.	SECTION	COUNTY	TOTAL SHEETS	SHEET NO.
F. A. I. - 70	82-3HVB-1	ST. CLAIR	207	142
FED. ROAD DIV. NO. 4	ILLINOIS	PROJECT		

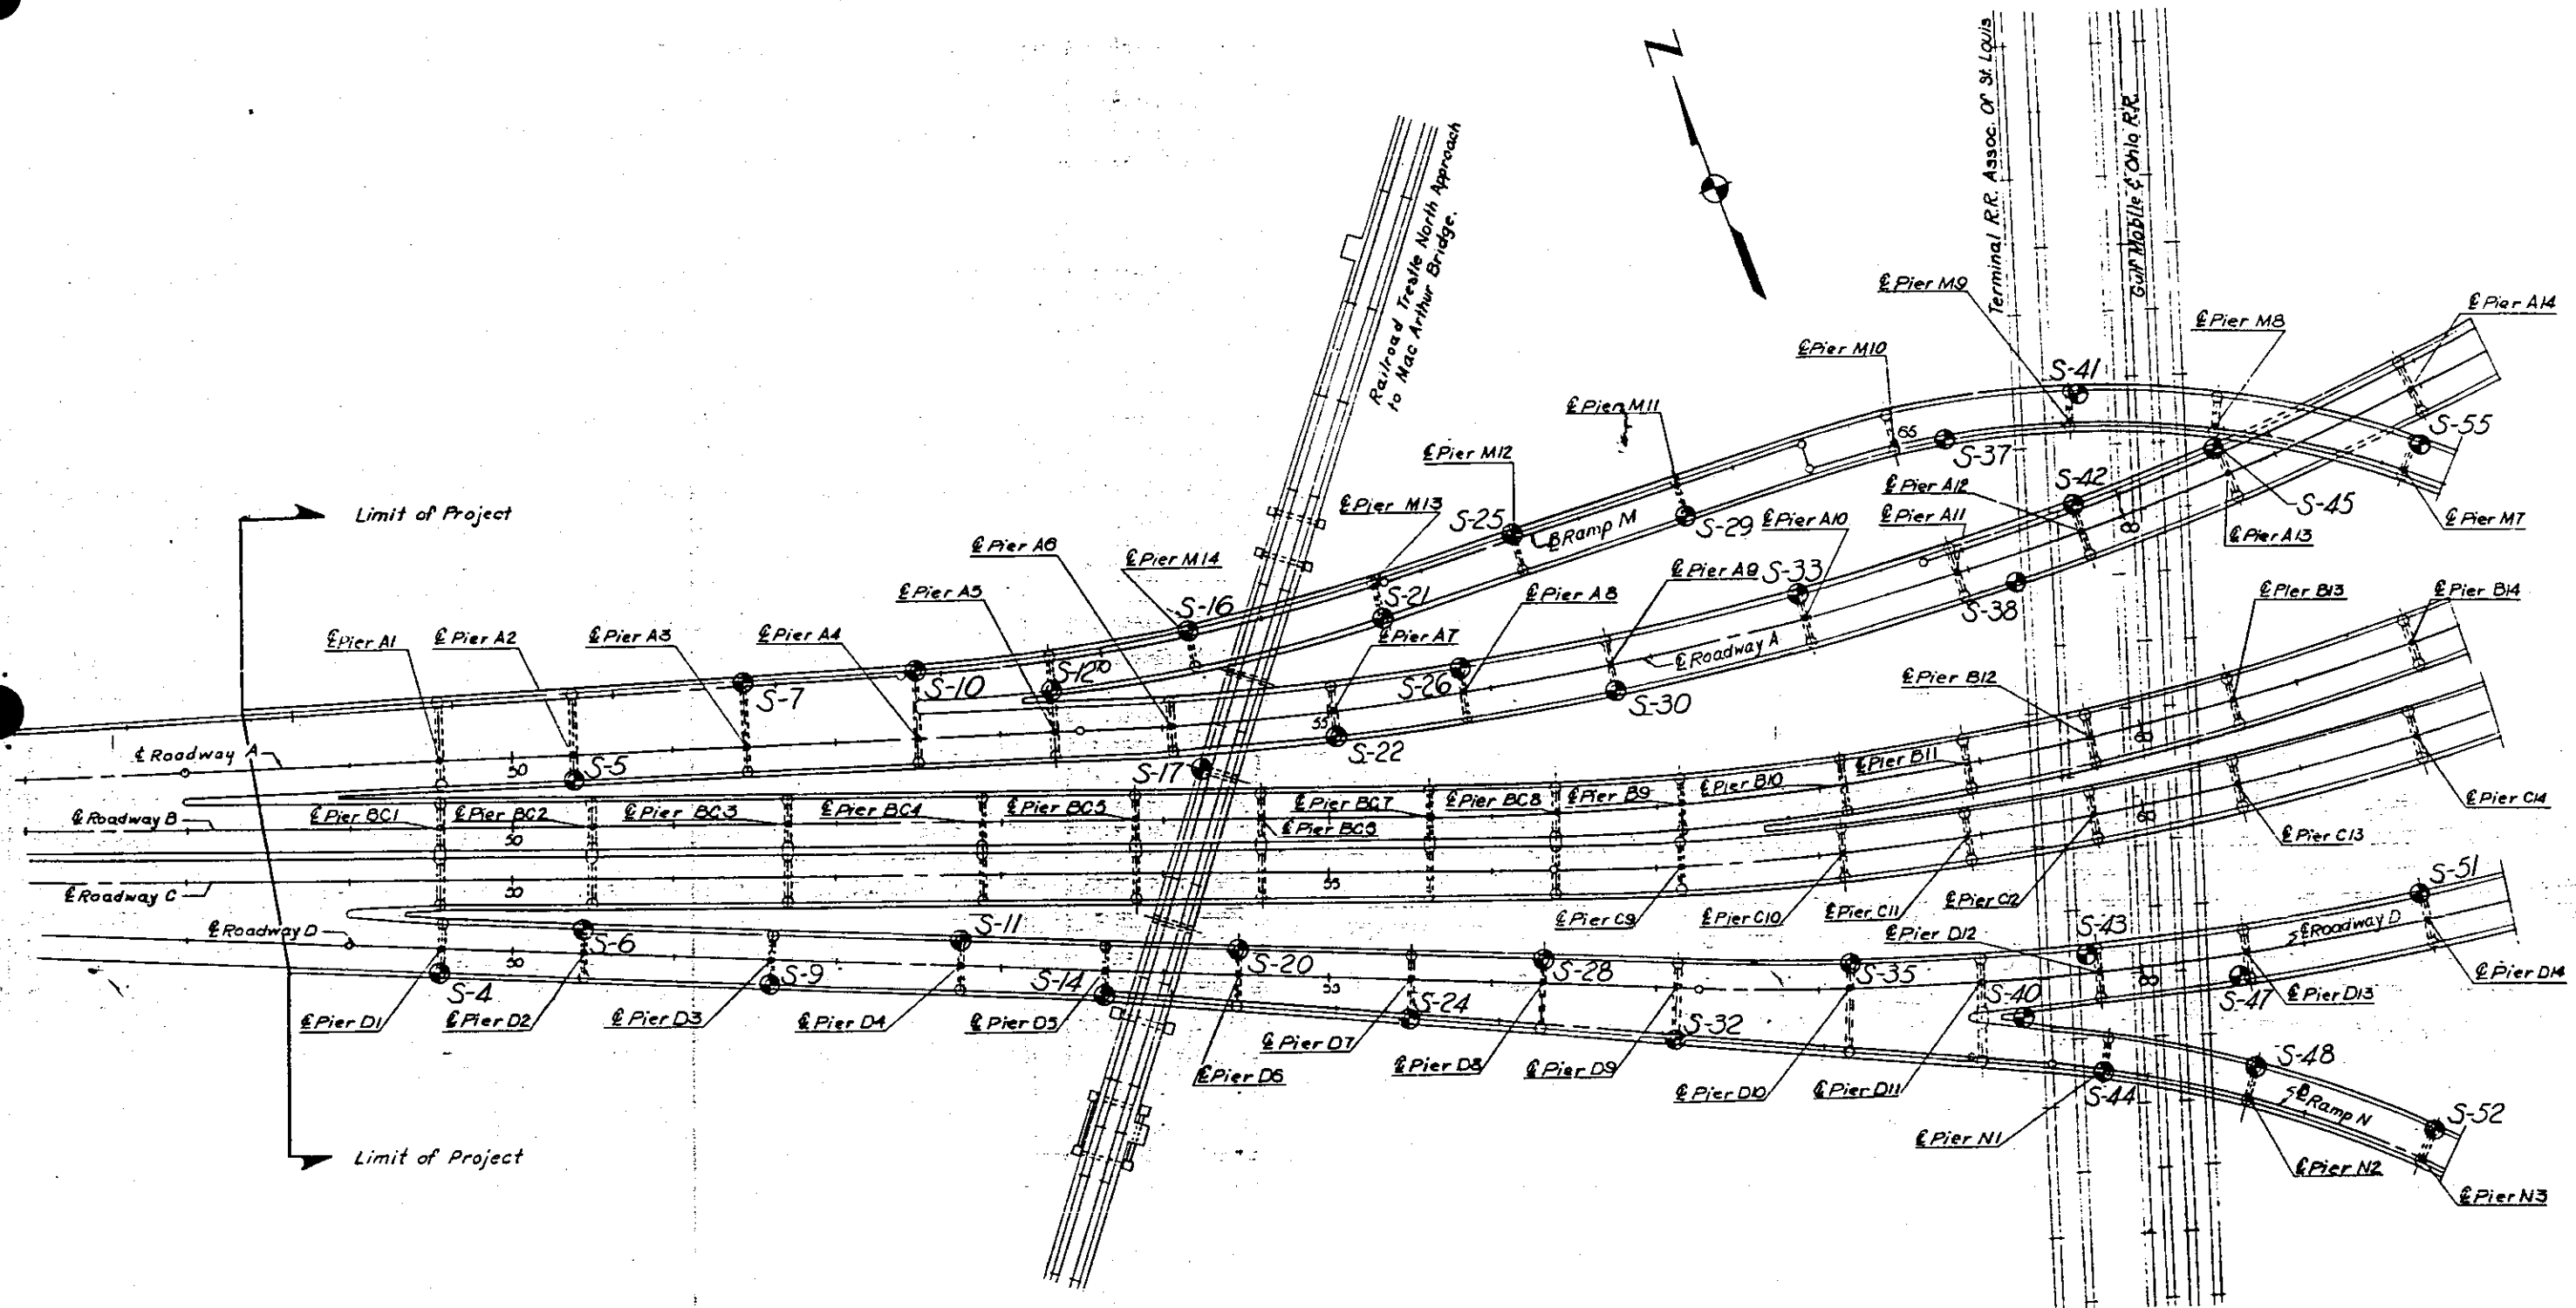


STATE OF ILLINOIS
DEPARTMENT OF PUBLIC WORKS & BLDGS.
DIVISION OF HIGHWAYS

POPLAR STREET BRIDGE APPROACHES
BORING LOCATIONS

F. A. I. RT. 70 ST. CLAIR CO. SECTION 82-3HVB-1
H. W. LOCHNER, INC.
ENGINEERS
CHICAGO, ILLINOIS

SHEET
142 OF 207

ROUTE NO.	SECTION	COUNTY	TOTAL SHEETS	SHEET NO.
F.A.I. - 70	82-3HVB-1	ST. CLAIR	207	143
FED. ROAD DIV. NO. 4		ILLINOIS PROJECT		

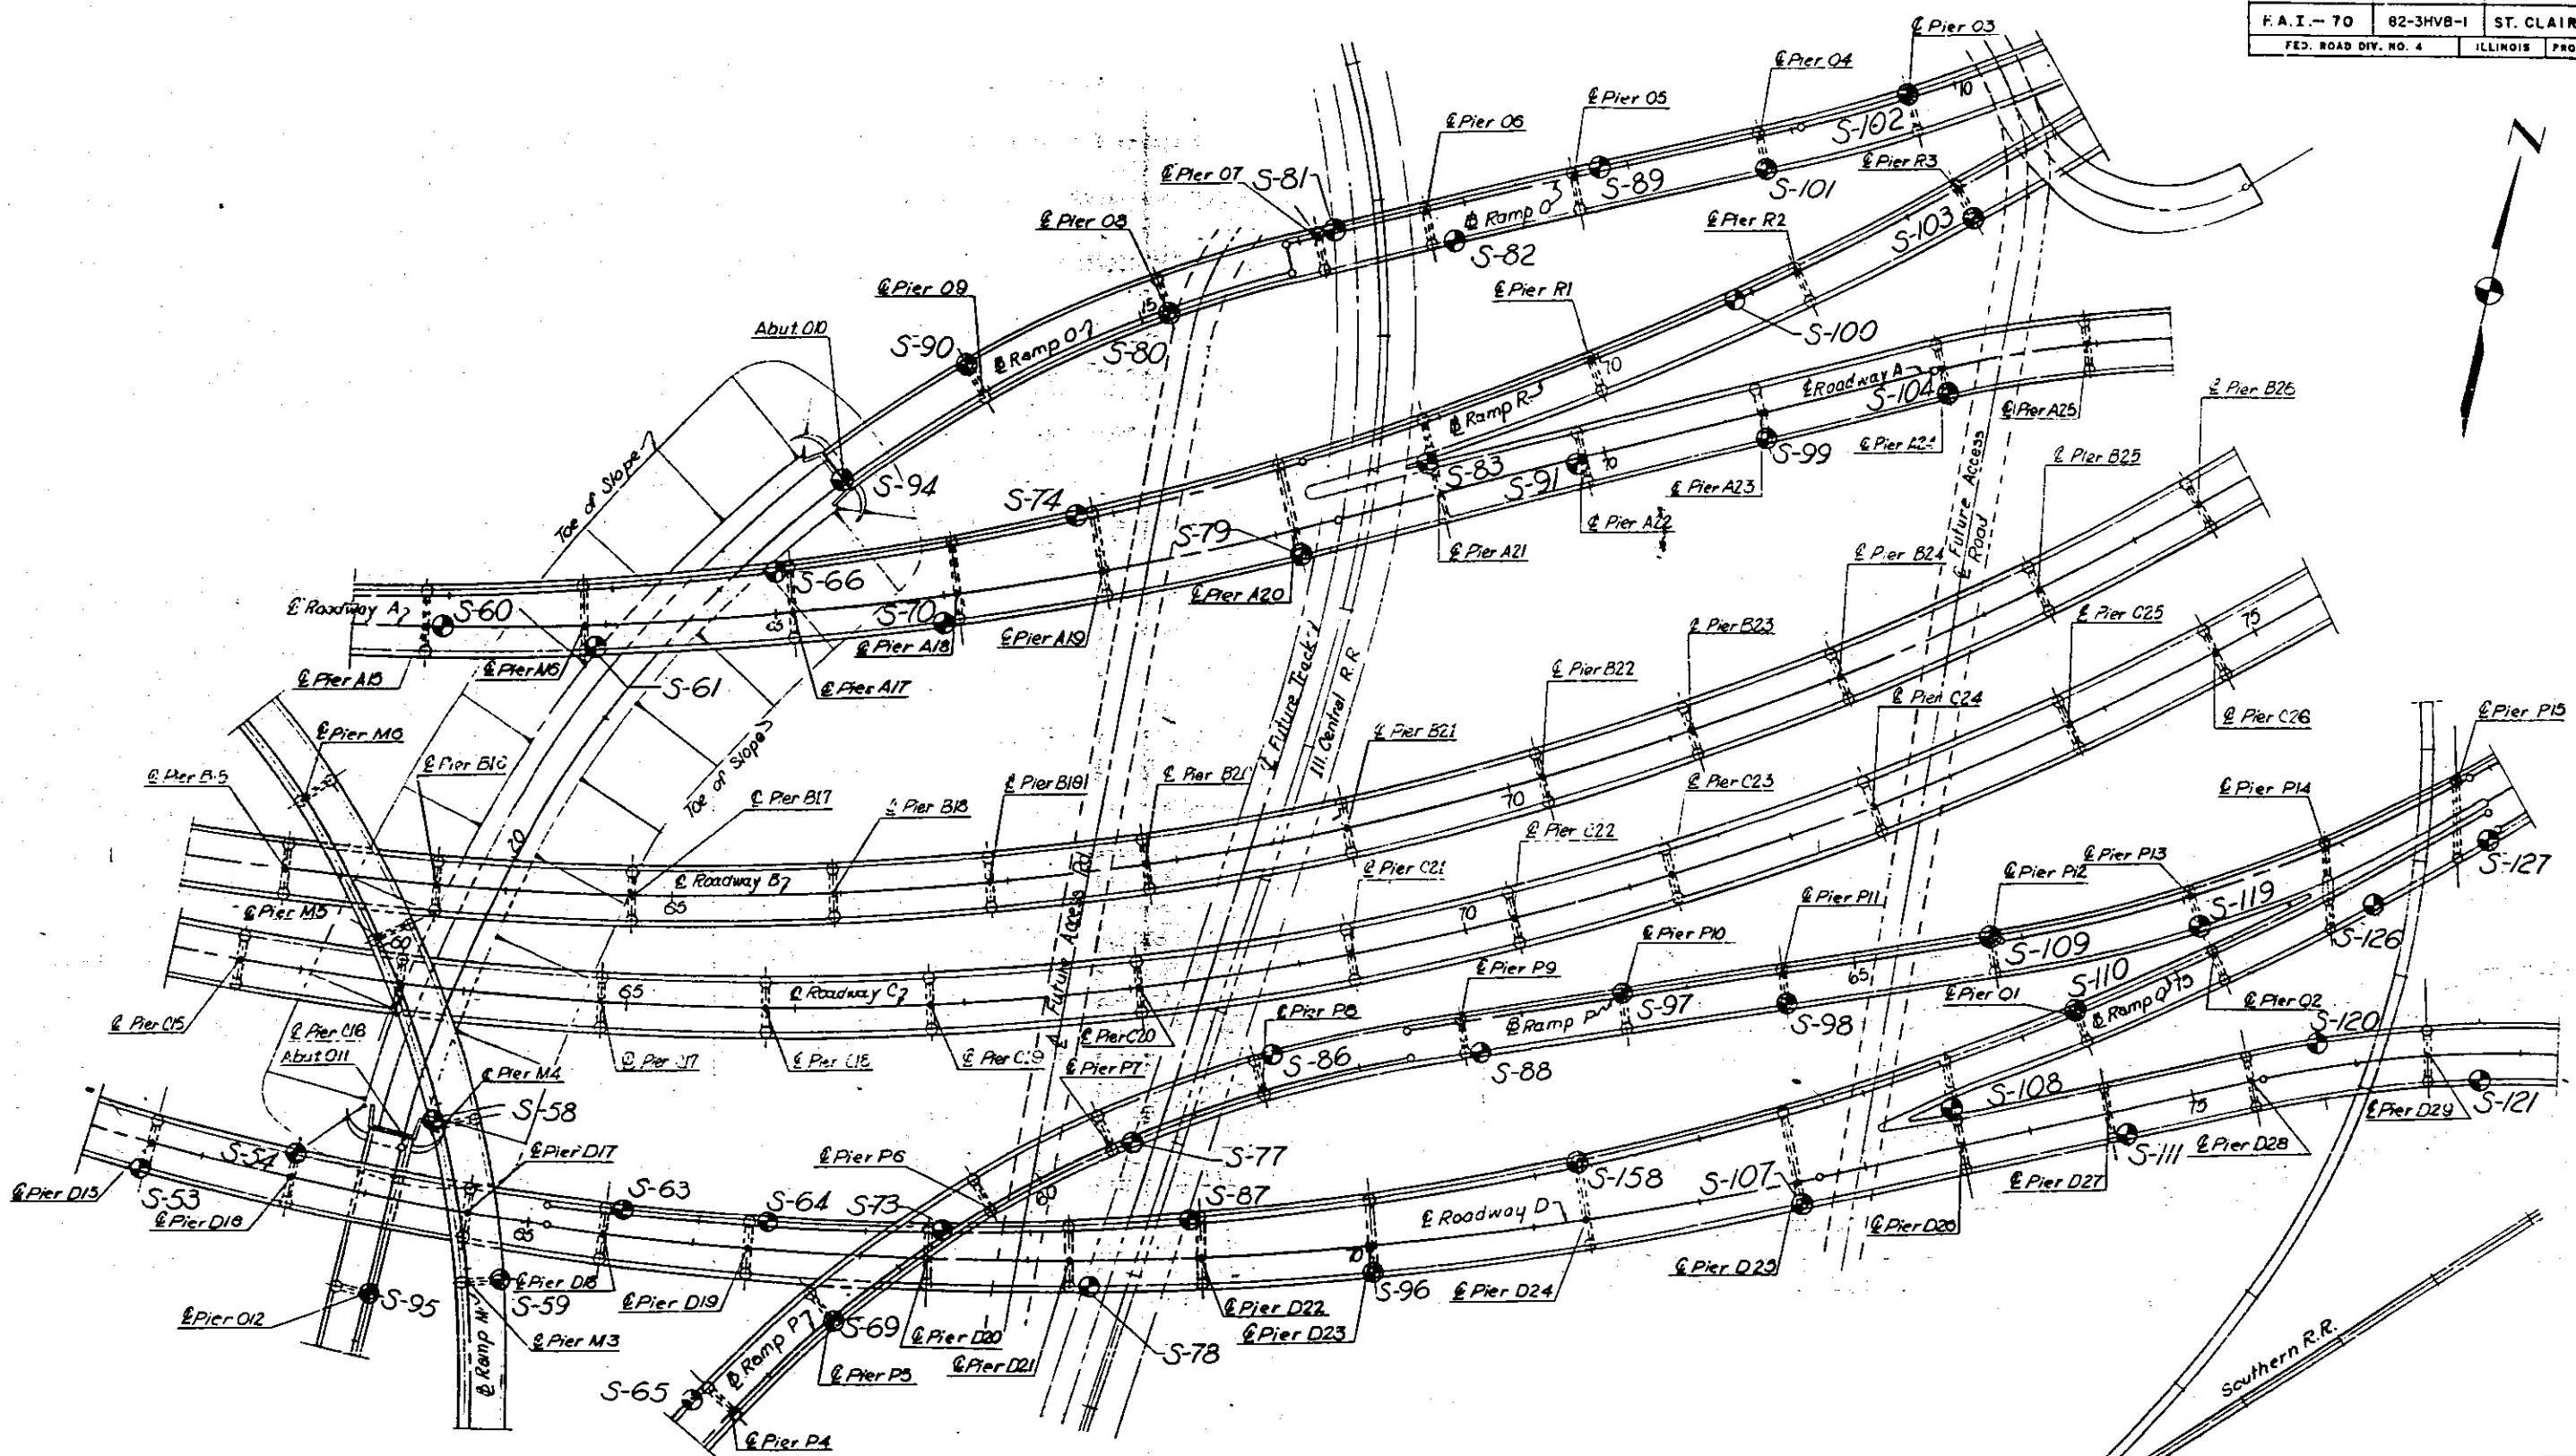

STATE OF ILLINOIS
DEPARTMENT OF PUBLIC WORKS & BLDGS.
DIVISION OF HIGHWAYS


POPLAR STREET BRIDGE APPROACHES
BORING LOCATIONS

F.A.I. RT. 70 ST. CLAIR CO. SECTION 82-3HVB-1

R. W. LOCHNER, INC.
ENGINEERS
CHICAGO, ILLINOIS

SHEET
143 OF 207

ROUTE NO.	SECTION	COUNTY	TOTAL SHEETS	SHEET NO.
F. A. I. - 70	82-3MV8-1	ST. CLAIR	207	144
FED. ROAD DIV. NO. 4		ILLINOIS	PROJECT	

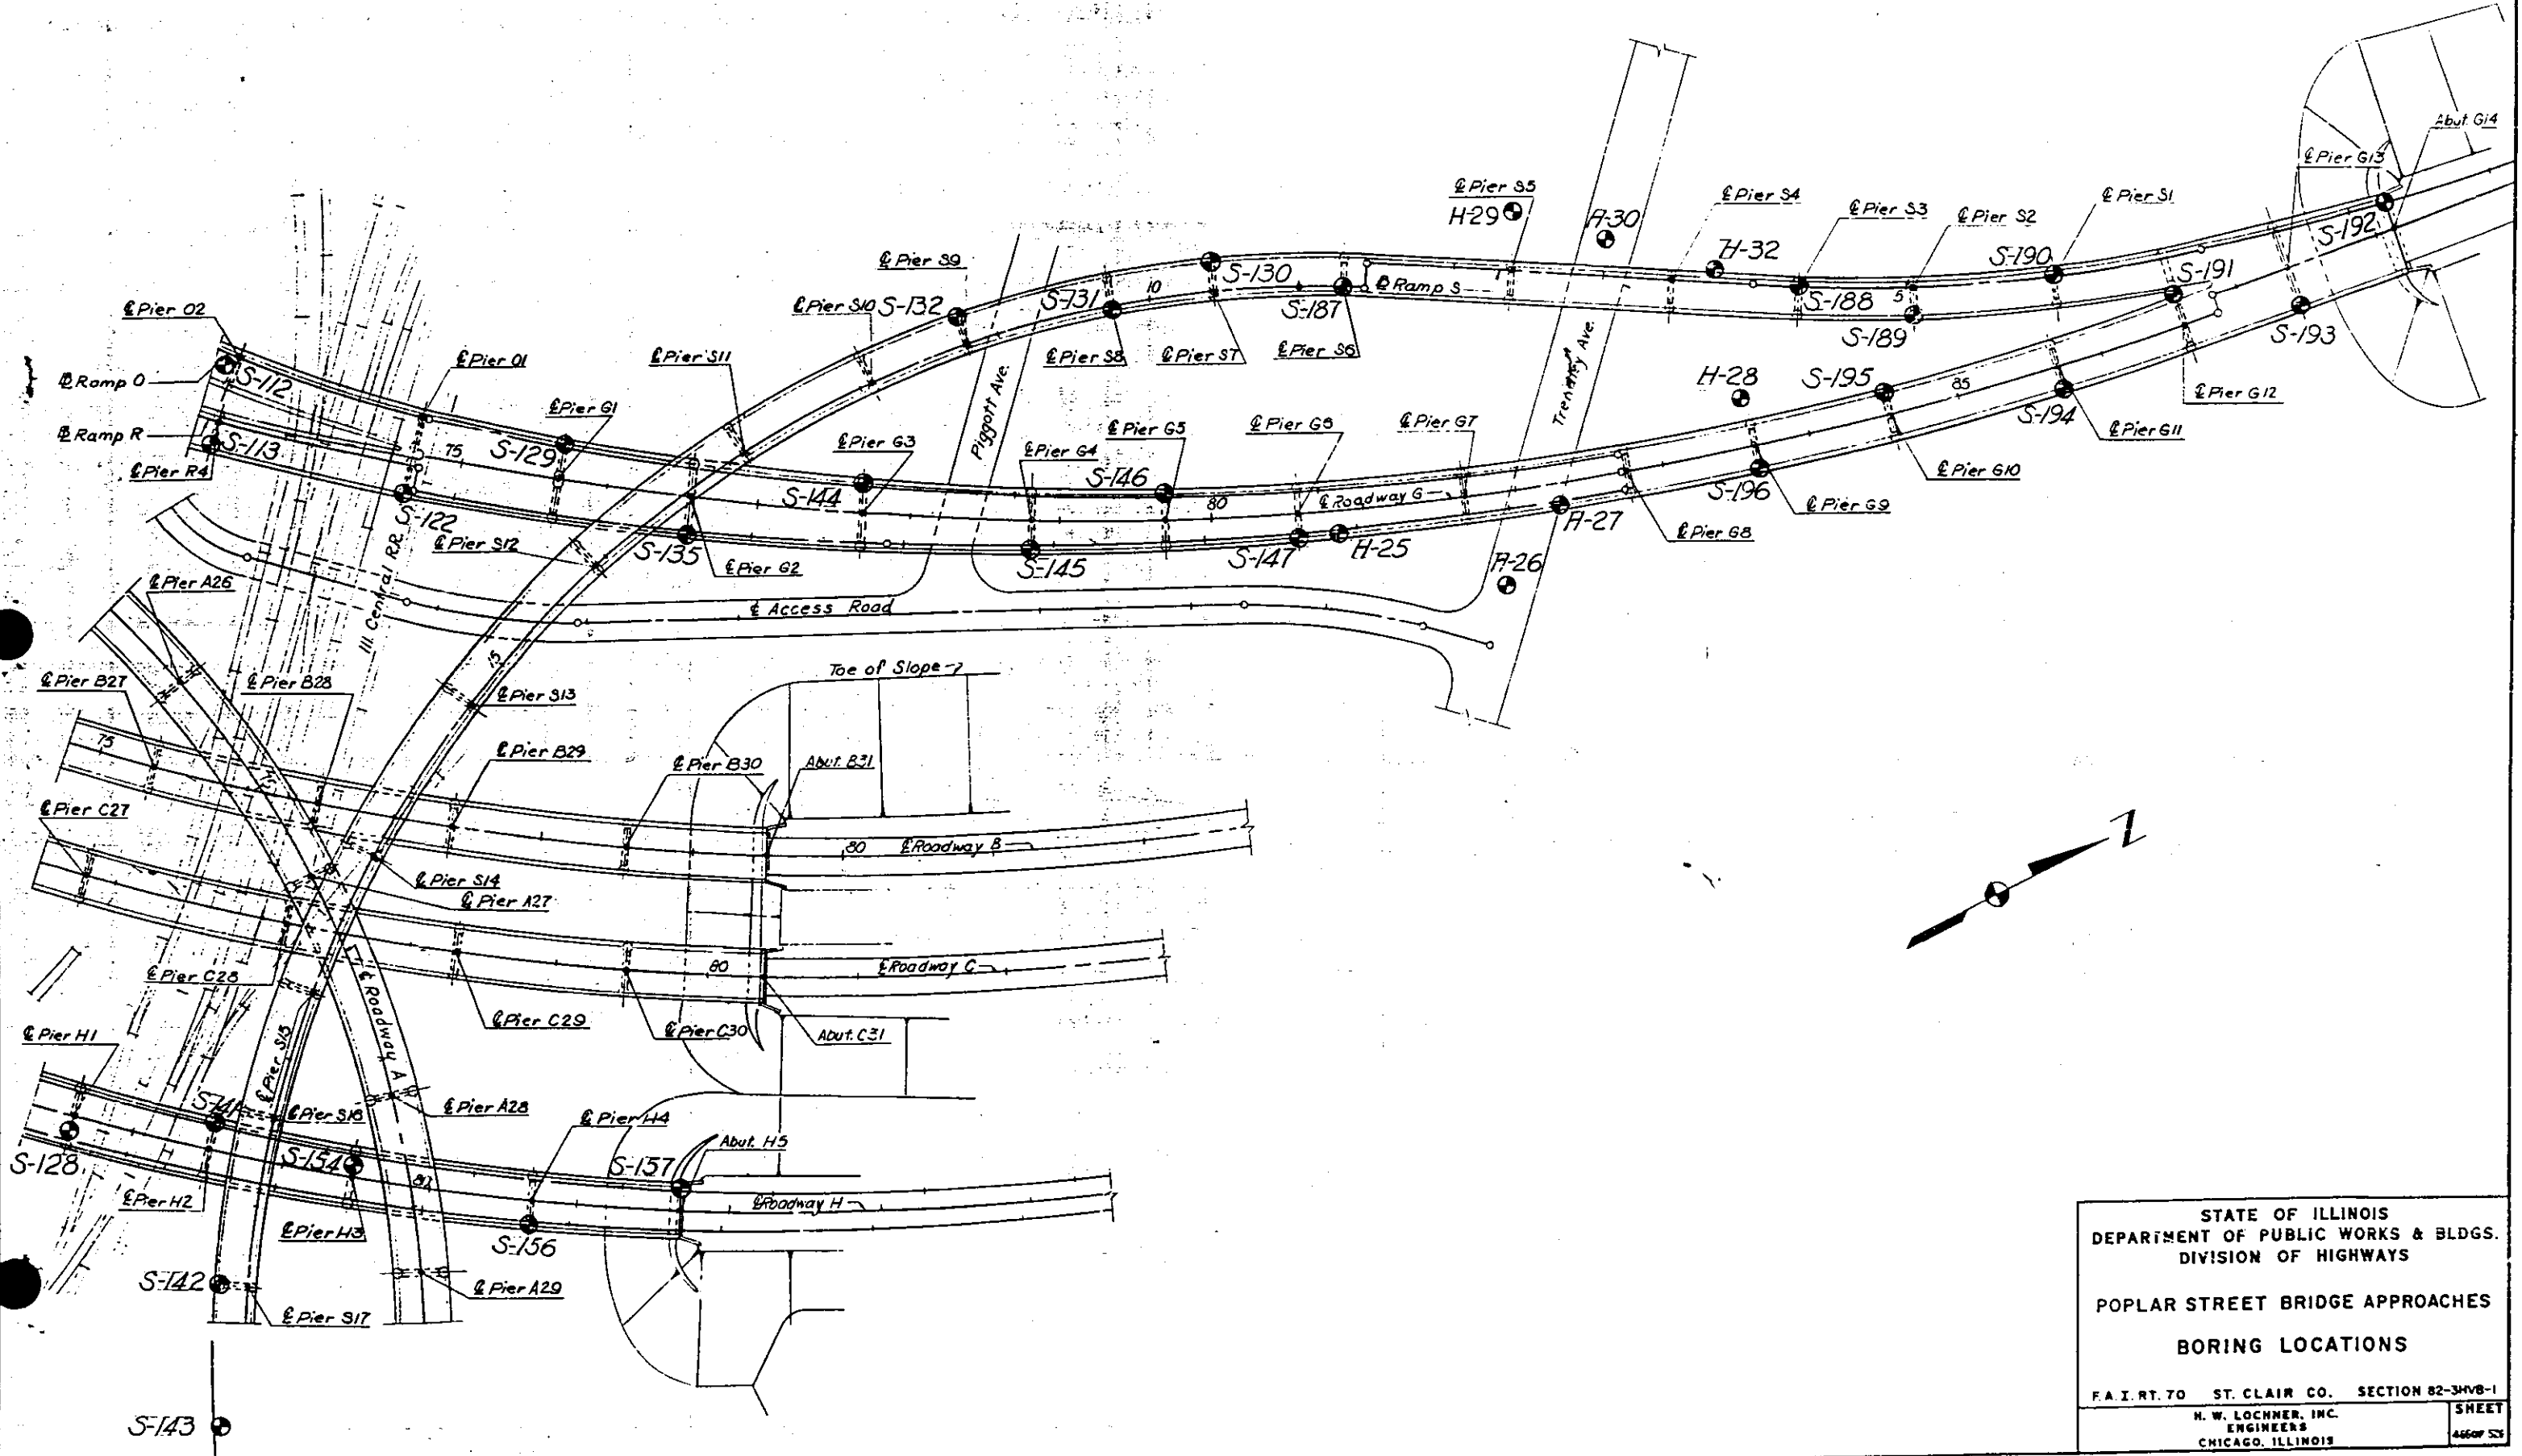

STATE OF ILLINOIS
DEPARTMENT OF PUBLIC WORKS & BLDGS.
DIVISION OF HIGHWAYS



POPLAR STREET BRIDGE APPROACHES
BORING LOCATIONS

F. A. I. RT. 70 ST. CLAIR CO. SECTION 82-3MV8-1

H. W. LOCHNER, INC.
ENGINEERS
CHICAGO, ILLINOIS

SHEET
466 OF 53

ROUTE NO.	SECTION	COUNTY	TOTAL SHEETS	SHEET NO.
F.A.I. 70	82-3HVB-1	ST. CLAIR	207	145
FED. ROAD DIV. NO. 4	ILLINOIS	PROJECT		

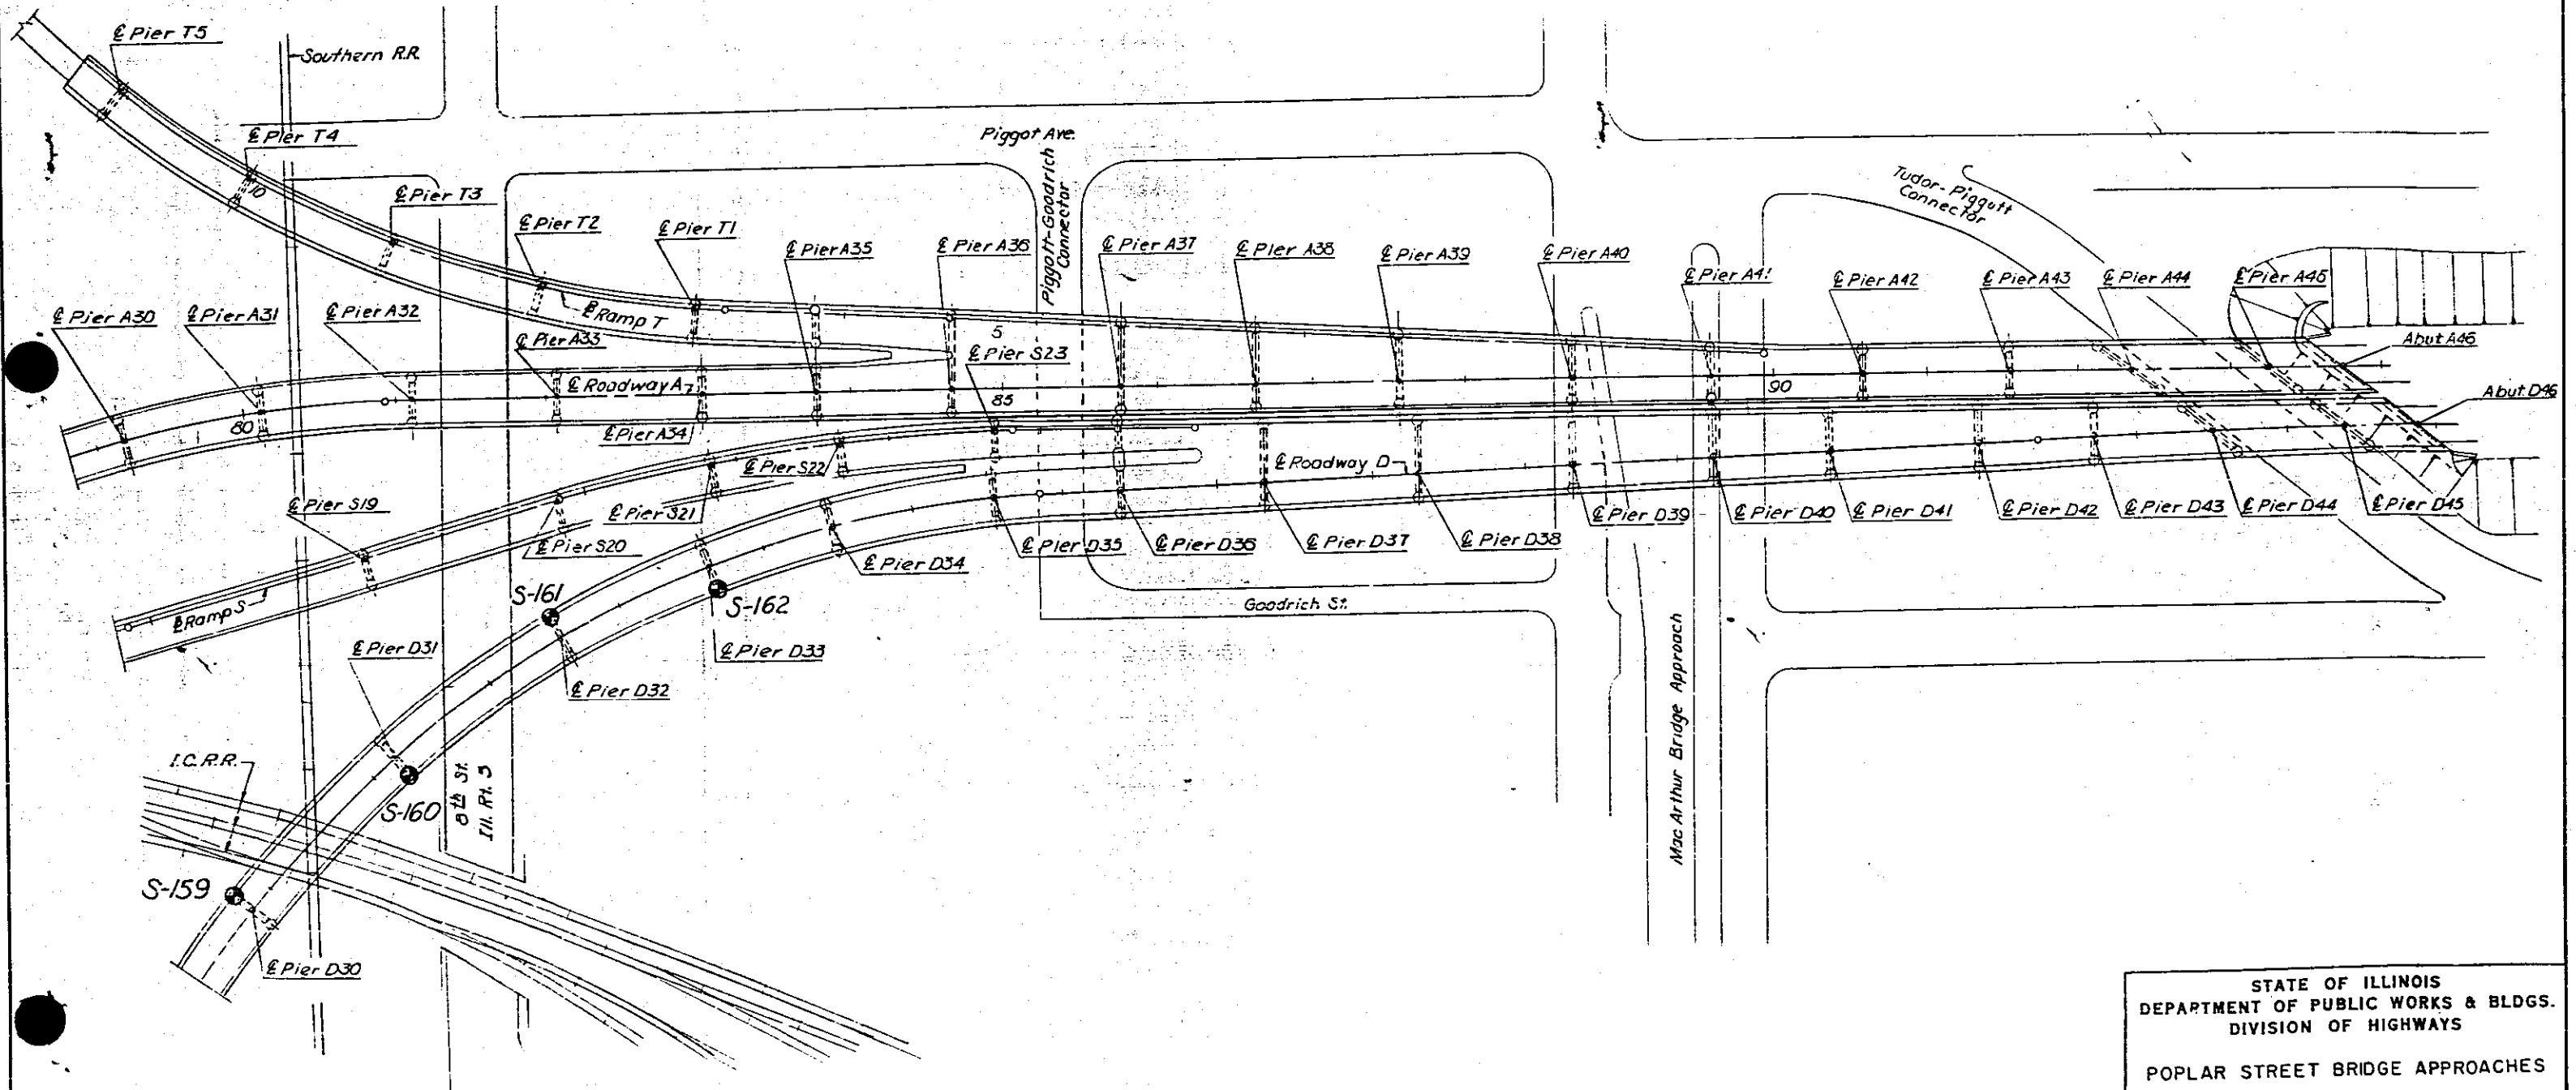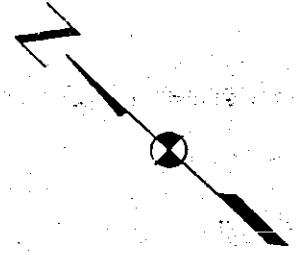

DESIGNED BY _____
 DRAWN BY _____
 CHECKED BY _____

STATE OF ILLINOIS
 DEPARTMENT OF PUBLIC WORKS & BLDGS.
 DIVISION OF HIGHWAYS


POPLAR STREET BRIDGE APPROACHES
 BORING LOCATIONS

F.A.I. RT. 70 ST. CLAIR CO. SECTION 82-3HVB-1

H. W. LOCHNER, INC.
 ENGINEERS
 CHICAGO, ILLINOIS

SHEET
 467 of 526

ROUTE NO.	SECTION	COUNTY	TOTAL SHEETS	SHEET NO.
F.A.I. 70	82-3HVB-1	ST. CLAIR	207	146
FED. ROAD DIV. NO. 4		ILLINOIS	PROJECT	

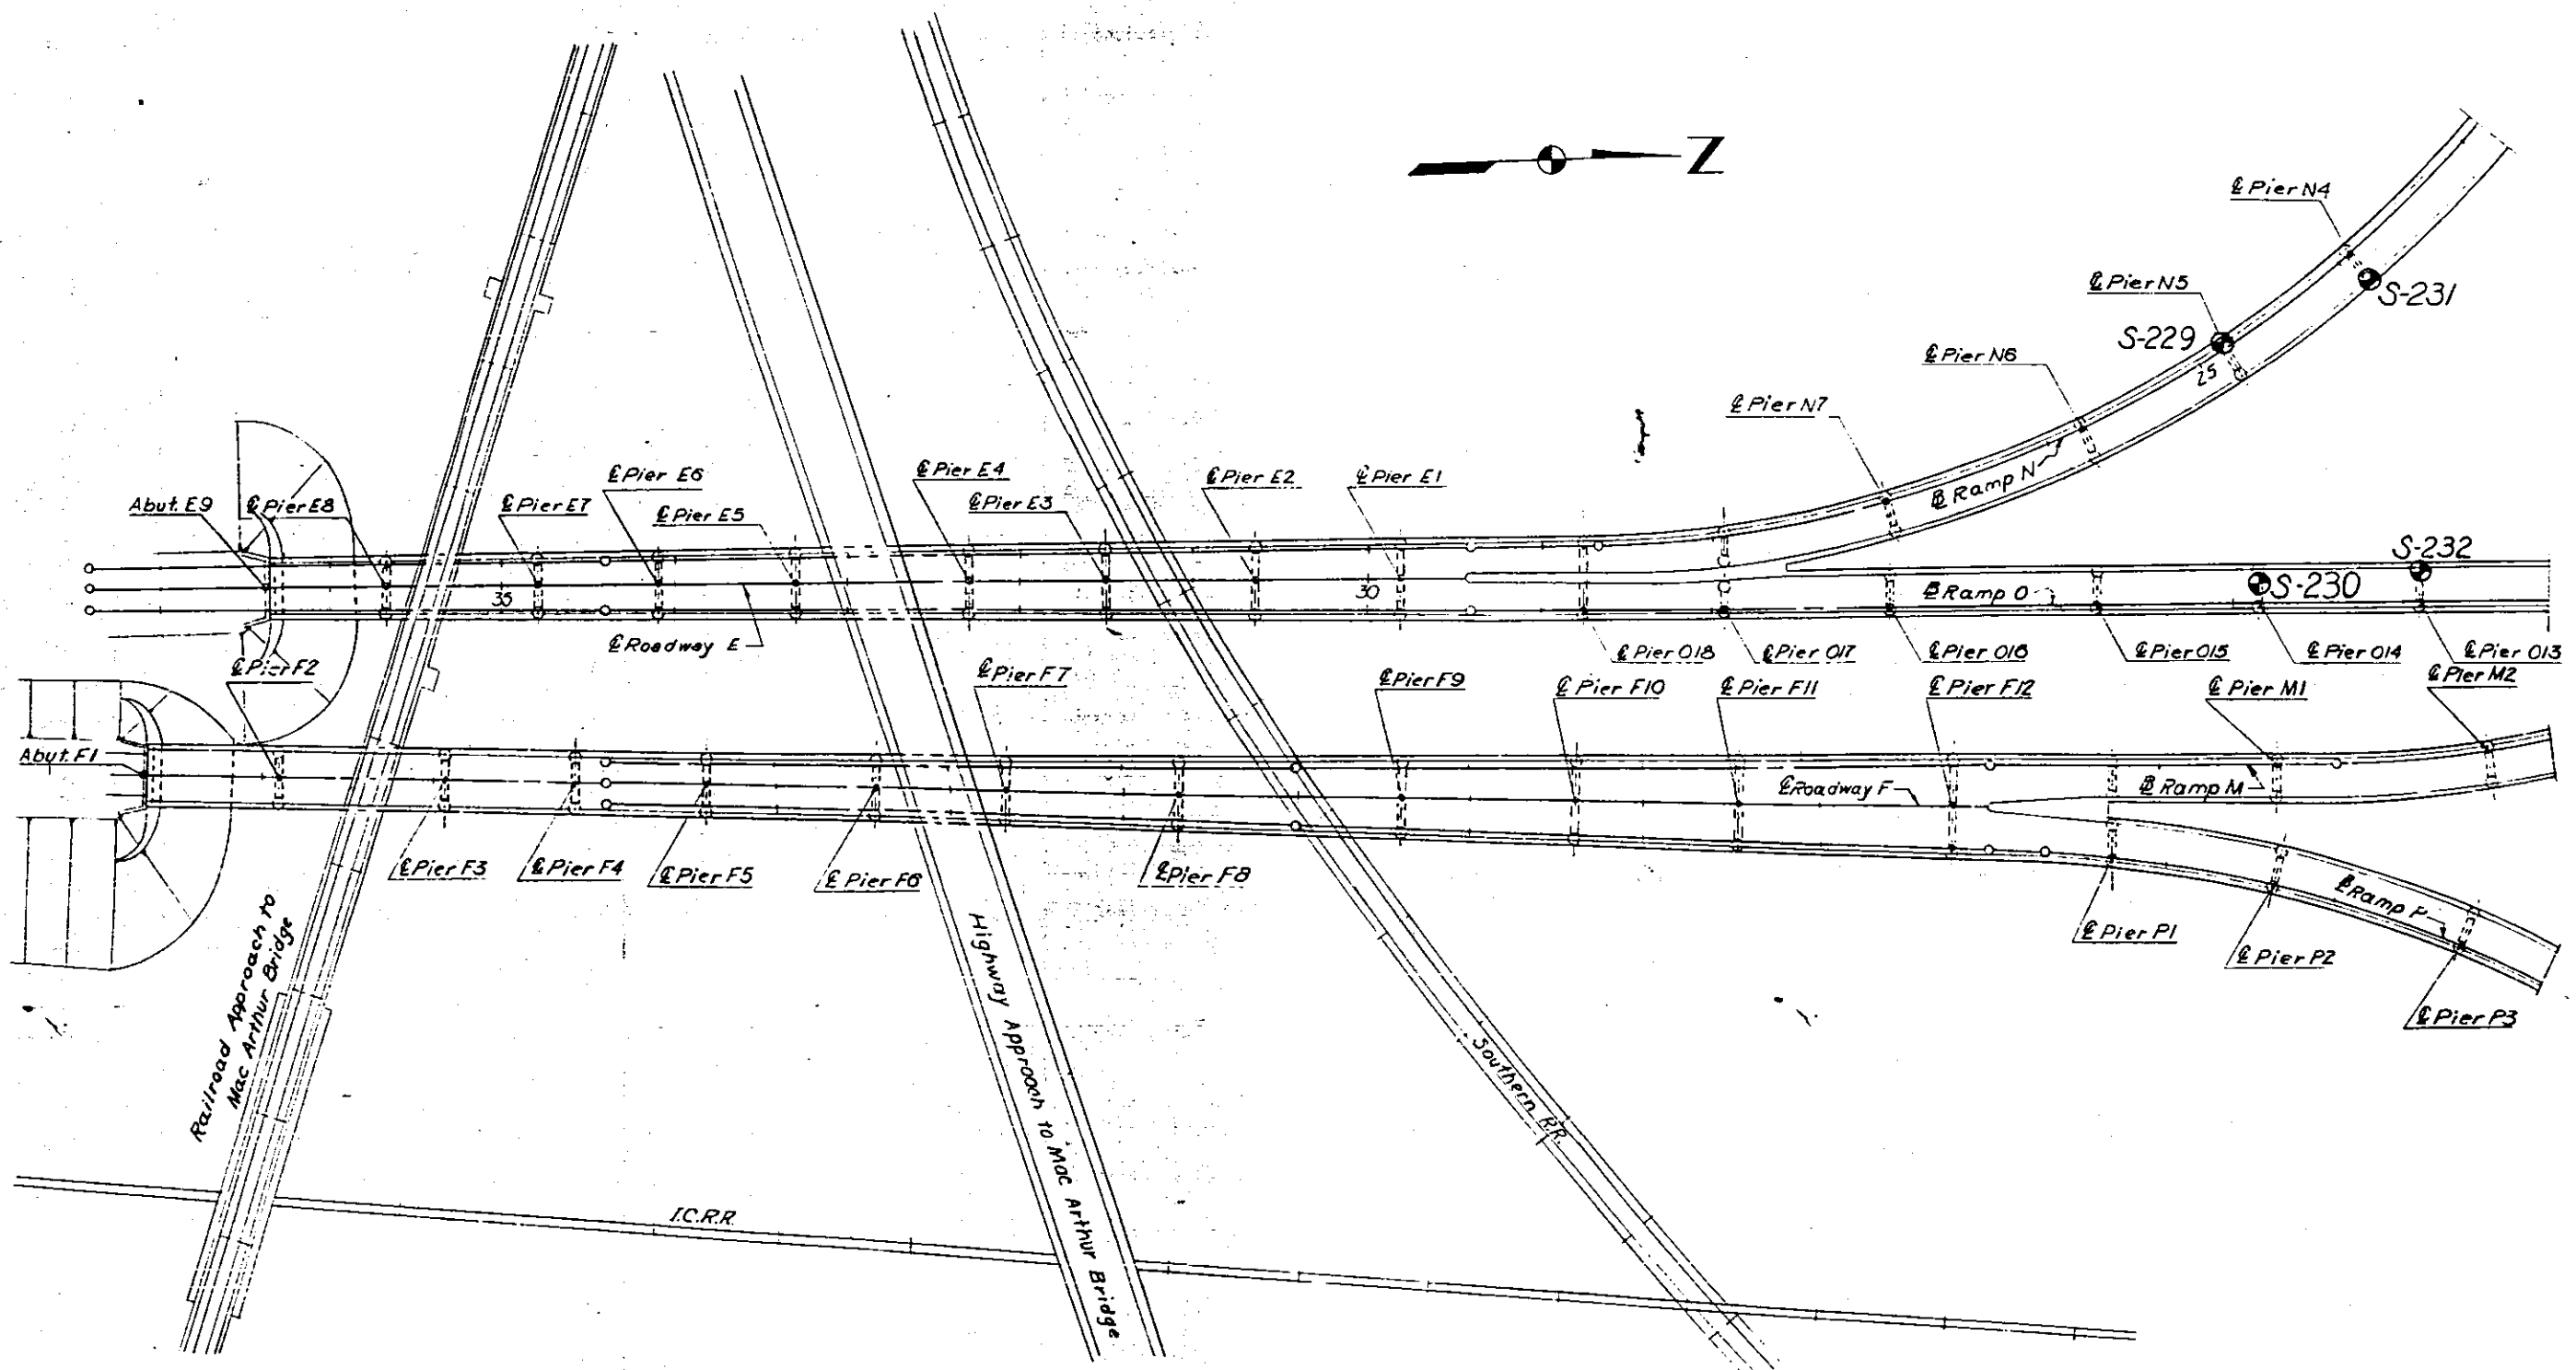

DESIGNED BY _____
 DRAWN BY _____
 CHECKED BY _____
 APPROVED BY _____

STATE OF ILLINOIS
 DEPARTMENT OF PUBLIC WORKS & BLDGS.
 DIVISION OF HIGHWAYS

POPLAR STREET BRIDGE APPROACHES
 BORING LOCATIONS

F.A.I. RT. 70 ST. CLAIR CO. SECTION 82-3HVB-1

H. W. LOCHNER, INC.
 ENGINEERS
 CHICAGO, ILLINOIS

SHEET
 448 OF 526

BORING No. S-154

IDENTIFICATION	ELEV. DEPTH	H BLOWS	QU T.S.P.	W %	IDENTIFICATION (continued)	ELEV. DEPTH	H BLOWS	QU T.S.P.	W %
Ground Surface	412.5 0				(continued)	47			
Cinders, silt, sand	411.7				Sand,	24			
Soft brown sandy silt, some clay.	409.0	4			trace	28			
Medium brown clay, some silt.	406.5	7			silt.	26			
Medium brown sandy silt, some clay.	403.5	7	2.0	27	Dense gray fine to medium Sand, little silt, trace clay.	38			
Medium brown	401.0	14				29			
very fine	399.0	24			Medium gray fine to medium Sand, trace silt.	25			
Sand,	397.0	15			Medium gray coarse	20			
trace	395.0	11			Sand,	26			
silt	393.0	25			trace	14			
and	391.0	24			silt	14			
clay.	389.0	20			and	18			
	379.5	10			small	31			
Dense gray fine Sand, trace silt.	379.5	15	4.6		Very dense gray fine to medium Sand, trace silt.	63			
Medium	376.5	18			Boring stopped by Inspector.	62			
gray	374.5	17			WATER LEVEL 34.5				
fine	372.5	17							
to	370.5	11							

BORING No. S-155

IDENTIFICATION	ELEV. DEPTH	H BLOWS	QU T.S.P.	W %	IDENTIFICATION (continued)	ELEV. DEPTH	H BLOWS	QU T.S.P.	W %
Ground Surface	413.2 0				(continued)	47			
Cinders, bricks, concrete, and miscellaneous fill	409.2				trace silt.	11			
Medium brown clayey silt, trace very fine sand.	406.7	5	15	2.5	Medium gray medium to coarse Sand, some small gravel trace silt.	25			
Medium	404.0	11				28			
brown	402.0	20			Medium	25			
fine	400.0	15			gray	46			
to	398.0	11			fine	24			
Sand,	396.0	20			to	23			
some	394.0	11			coarse	20			
silt.	392.0	25			Sand,	17			
Dense brown medium Sand, trace silt.	377.2	15	3.3		some	9			
Dense gray medium Sand, trace silt.	372.2	15	3.3		small gravel.	11			
Medium gray medium Sand.	371.2	25			Medium gray coarse Sand, some gravel.	22			
Medium gray fine to coarse Sand.	371.2	25			Medium gray medium Sand.	22			
Very dense gray medium Sand, and some gravel with trace silt.	332.2	10	10.5		Very dense gray medium Sand, and some gravel with trace silt.	80			
Dense	332.2	13			Dense	49			
gray	330.0	33			gray	49			
coarse	327.2	36			coarse	52			
and	324.2	33			Sand,	54			
small	321.2	25			and	54			
gravel,	318.2	25			trace	44			
trace	316.2	14			silt.	37			
	314.2	14			Medium fine to coarse Sand, trace silt, some small (continued)	17			
	312.2	14				13			
	310.2	14				13			
	62.2								

BORING No. S-157

IDENTIFICATION	ELEV. DEPTH	N BLOWS	QU T.S.P.	W %
Ground Surface	413.9 0			
Topsoil, Sand, and cinder Fill	409.5	9		
Soft to medium gray and brown Silt and very fine Sand	404.5	6		
Loose to medium gray fine Sand, trace silt.	387.5	18, 12, 9, 9, 14, 25, 25		
Loose gray silty very fine Sand.	385.0	8		
Medium dense gray fine to medium Sand, little	35.0	32, 21, 24, 28, 35, 49		
(continued)				

BORING No. S-158


IDENTIFICATION	ELEV. DEPTH	N BLOWS	QU T.S.P.	W %
Ground Surface	414.9 0			
Cinder and miscellaneous Fill	403.4	8, 10, 5, 10		
Medium brown very fine Sand, trace silt.	390.9	11, 14, 11, 17, 15, 21		
Medium dense brown fine Sand, trace silt.	378.9	28, 23, 35, 52		
Medium brown fine to coarse Sand, trace small gravel and silt.	373.4	17, 50		
Dense gray fine Sand	371.4	31		
Medium	45	11		
(continued)				

BORING No. S-159

IDENTIFICATION	ELEV. DEPTH	N BLOWS	QU T.S.P.	W %
Ground Surface	418.7 0			
Cinders, Sand, and miscellaneous Fill	363.7	3, 4, 7, 4, 3		
Soft brown silty Clay trace very fine sand	400.7	5	1.0	30
Medium brown clay, trace silt and very fine sand	397.7	10		
Medium brown clayey silt, trace very fine sand	395.7	10	2.0	26
Loose gray fine silty Sand	387.7	10, 8		
Dense gray fine to medium Sand, trace silt.	377.7	31, 36		
Dense gray fine to coarse Sand, trace Clay, Silt, & some small gravel.	372.7	47, 32		
(continued)				

N - STANDARD PENETRATION TEST NUMBER - BLOWS TO DRIVE 2" O.D. SPLIT SPOON SAMPLER 12" WITH 140# WT. FALLING 20"
 QU - UNCONFINED COMPRESSIVE STRENGTH
 W - WATER CONTENT % OVER DRY WEIGHT
 TYPE FAILURE
 B - BULGE
 S - SHEAR
 E - ESTIMATED VALUE

STATE OF ILLINOIS
 DEPARTMENT OF PUBLIC WORKS & BLDGS.
 DIVISION OF HIGHWAYS
 POPLAR STREET BRIDGE APPROACHES
 BORING LOGS
 F.A.I. RT. 70 ST. CLAIR CO. SECTION 82-3HVB-1
 H. W. LOCHNER, INC.
 ENGINEERS
 CHICAGO, ILLINOIS
 SHEET 58 OF 526

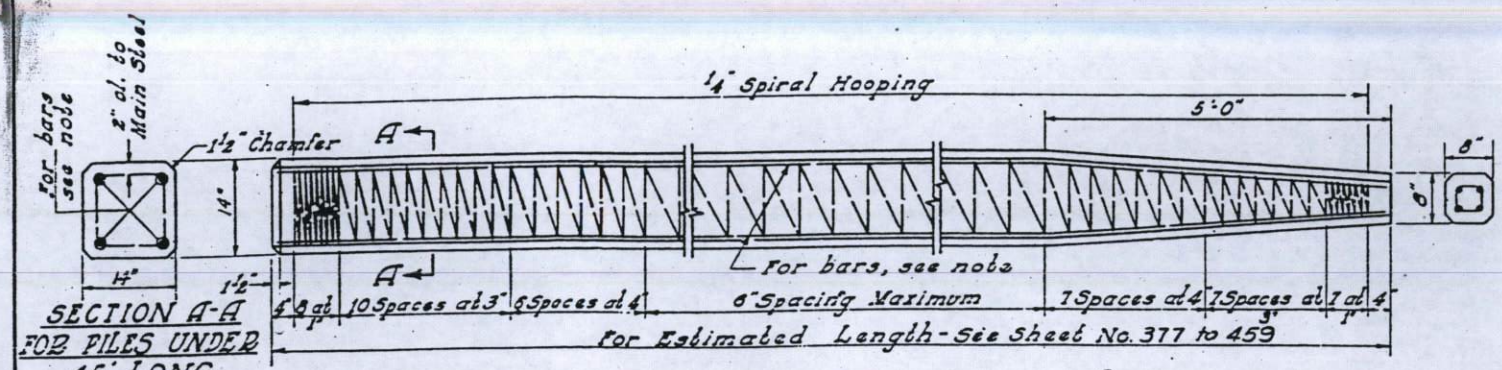


SECTION A-A
FOR PILES UNDER
45' LONG

SECTION A-A
FOR PILES 45'
OR MORE


NOTE:-
For 14" Piles 45' long or more use 6-#6 bars - 4 for the full length and 4 to the point of bevel. For 14" Piles under 45'-0" long use 4-#9 bars the full length.

HANDLING:- For Pile lengths up to 45 ft. use slings placed at a distance of 0.21 L* from each end. For Piles longer than 45 ft., use three slings placed at a distance of 0.12 L* from each end and at mid-point of pile.
*L = Over all length of pile to be handled

DETAIL OF PRECAST CONCRETE PILES

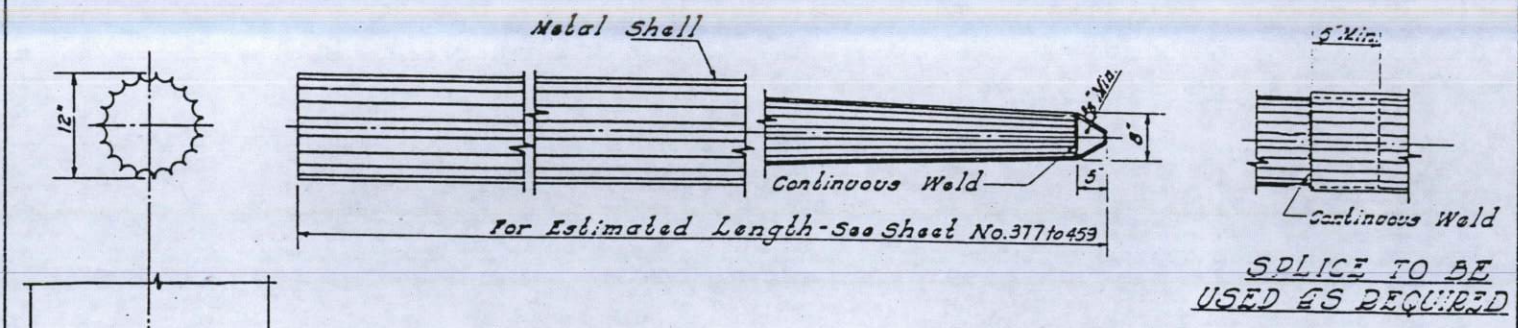


- ALLOWABLE TAPERS**
- 1- Taper 1/2"-6" for 10' + 12" Cylindrical Section Extension
 - 2- Taper 1/4"-0" for 17' + 12" Cylindrical Section Extension
 - 3- Taper 1/7"-0" for 30' + 12" Cylindrical Section Extension


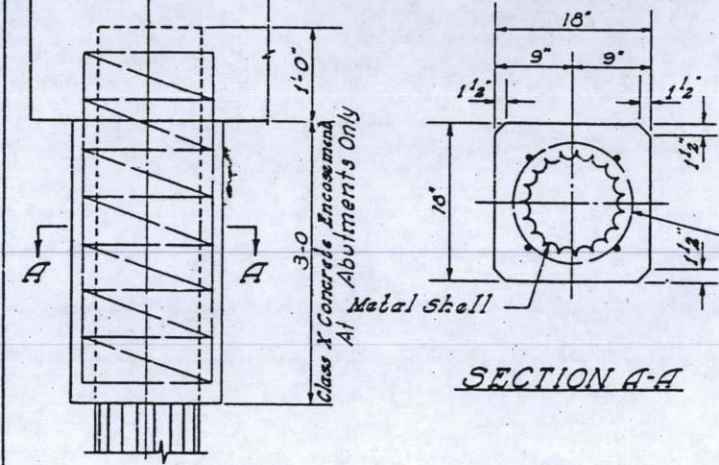


Welded wire fabric 6"x6" mesh
#4 wire - weight 58 lbs. per 100 sq. ft.
4-#4 Tie Bars. The cost of Class X Concrete Encasement and Reinforcement is incidental to the cost of furnishing Piles.
The thickness of the shell shall be .1793 inches with a tolerance of 5%.

DETAIL OF TAPERED METAL SHELL FOR CAST IN PLACE CONG. PILES.

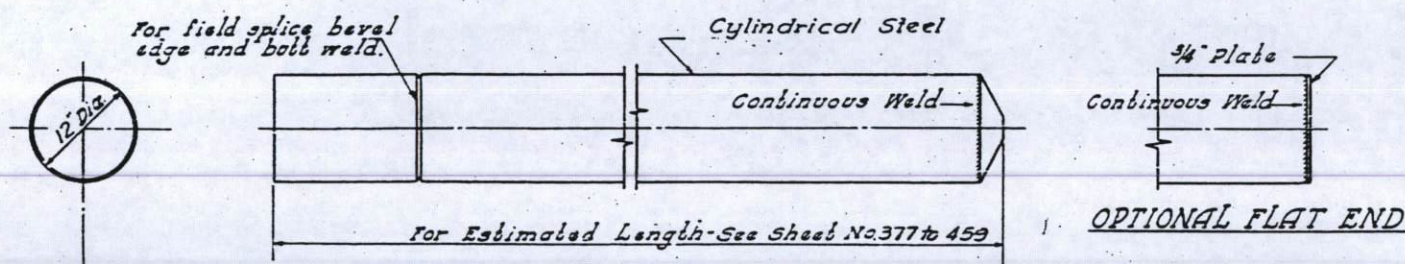


OPTIONAL FLAT END

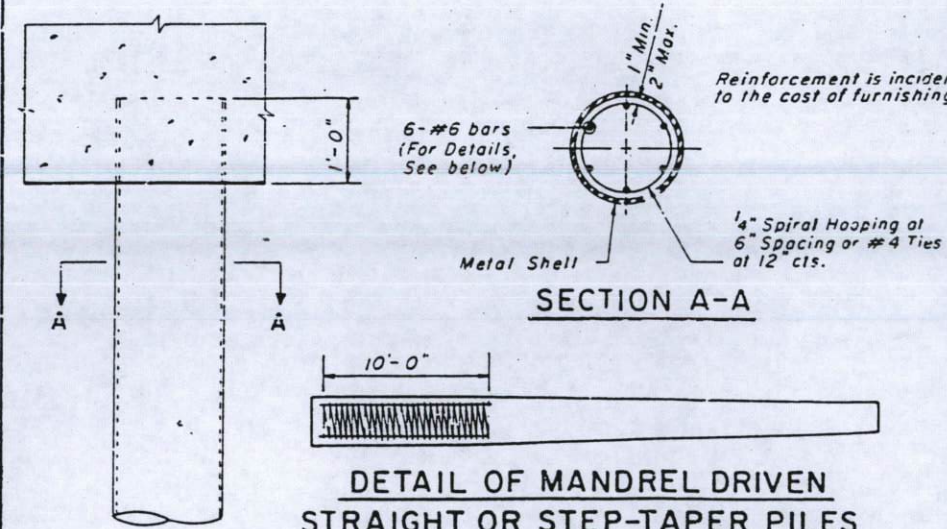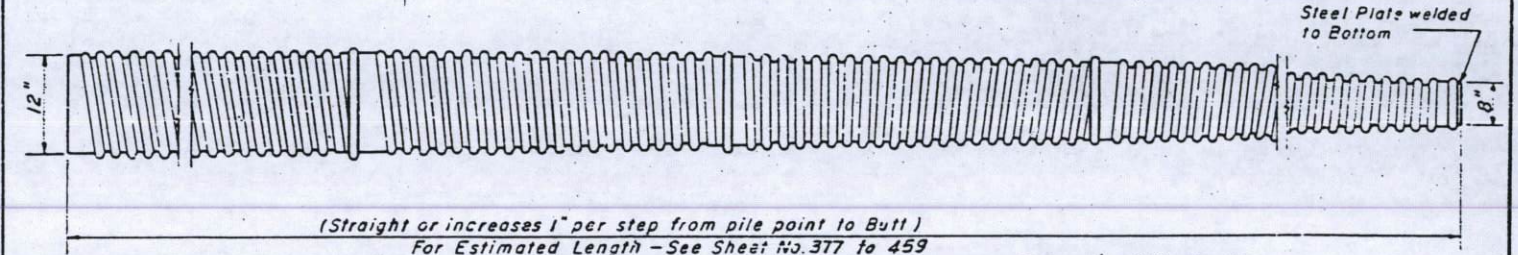

SECTION A-A

DETAIL OF MANDREL DRIVEN STRAIGHT OR STEP-TAPER PILES FOR CAST IN PLACE CONCRETE PILES

At least 1/4 of the length of pile shall have a Butt diameter equal to or greater than 12".
Gages are furnished to suit soil conditions (14 Gage Min.)

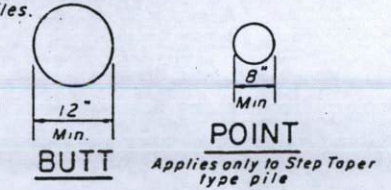

Reinforcement is incidental to the cost of furnishing piles.

Welded wire fabric 6"x6" mesh
#4 wire - weight 58 lbs. per 100 sq. ft.
4-#4 Tie Bars. The cost of Class X Concrete Encasement and Reinforcement is incidental to the cost of furnishing Piles.
The thickness of the shell shall be .1793 inches with a tolerance of 5%.

Note:- Driving and Bearing ends of Pipe shall be cut square.

DETAIL OF CYLINDRICAL STEEL SHELL FOR CAST IN PLACE CONCRETE PILES

DESIGNED BY
DRAWN BY
CHECKED BY
APPROVED BY