


FOR INFORMATION ONLY

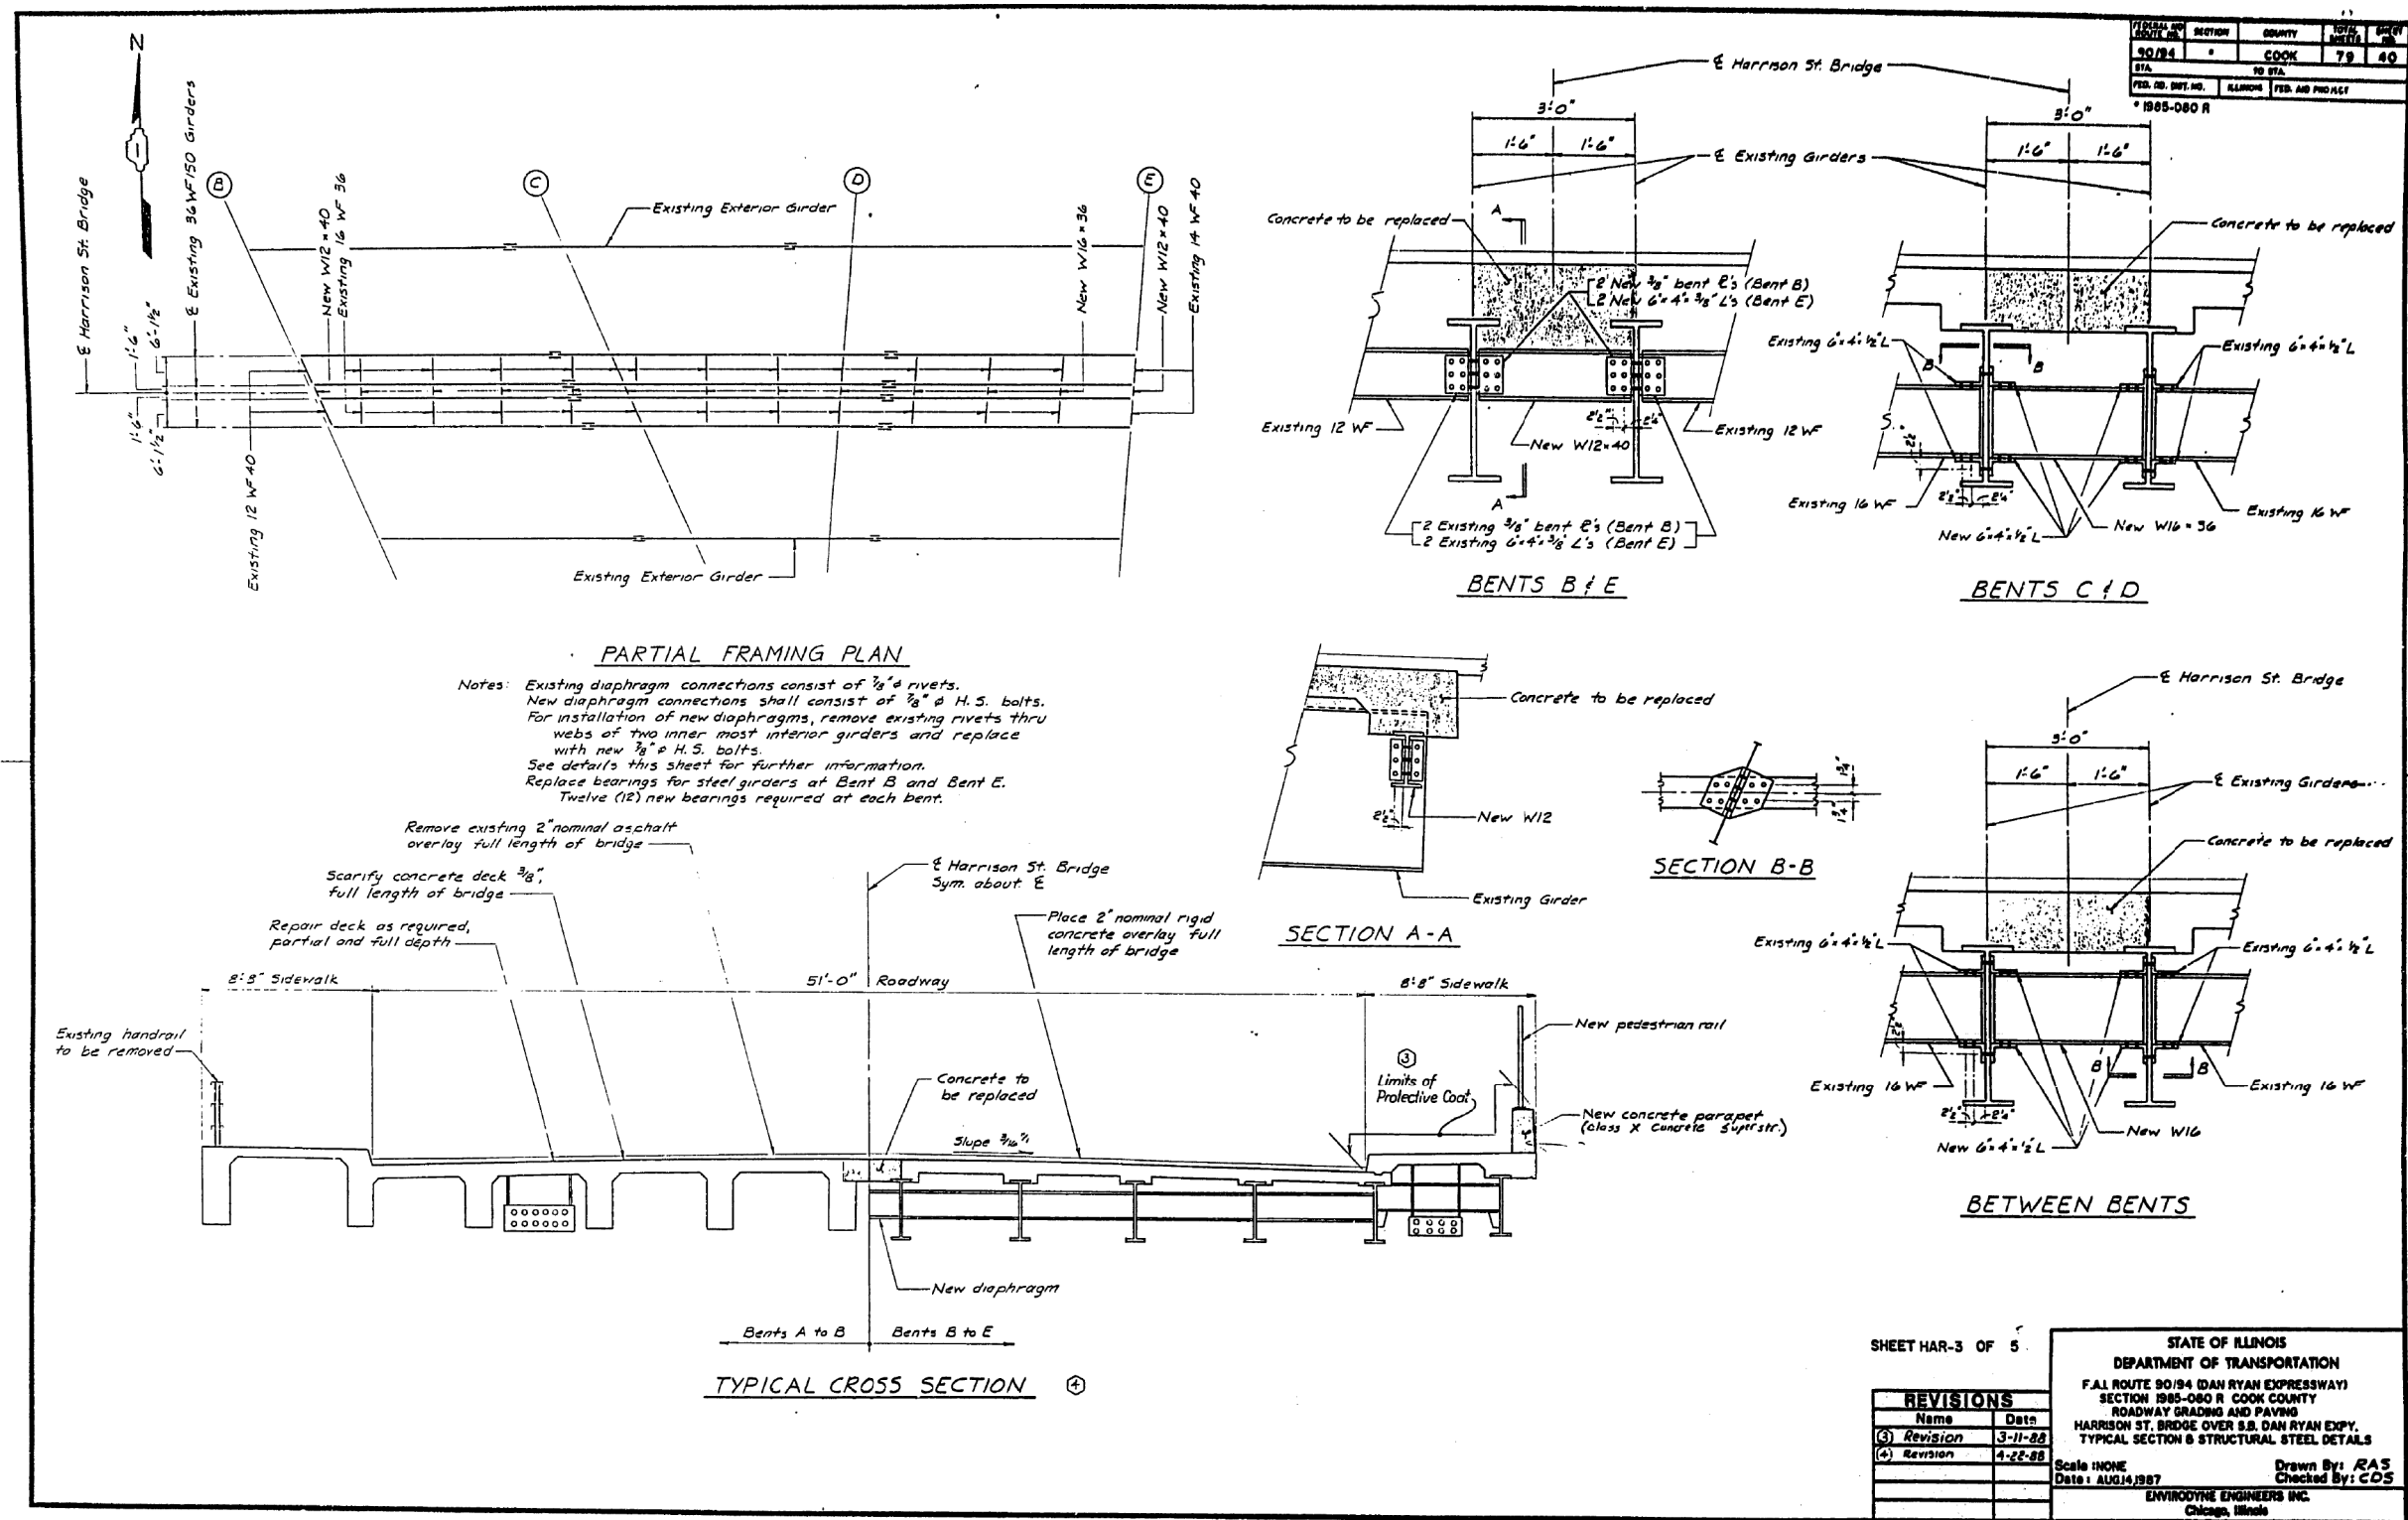

FISCAL YEAR	SECTION	COUNTY	TOTAL SHEETS	SHEET NO.
90/94	2013-008R	COOK	559	303
STA.	TO STA.		CONTRACT NO.	
	1985-080 R		60W26	

SHEET HAR-3 OF 5

STATE OF ILLINOIS
DEPARTMENT OF TRANSPORTATION
F.A.I. ROUTE 90/94 (DAN RYAN EXPRESSWAY)
SECTION 1985-080 R COOK COUNTY
ROADWAY GRADING AND PAVING
HARRISON ST. BRIDGE OVER S.B. DAN RYAN EXPY.
TYPICAL SECTION B STRUCTURAL STEEL DETAILS

REVISIONS	
Name	Date
(3) Revision	3-11-88
(4) Revision	4-22-88

Scale: NONE
Date: AUG 14, 1987
Drawn By: RAS
Checked By: GDS
ENVIRODYNE ENGINEERS INC.
Chicago, Illinois

FILE PATH = C:\Projects\19-0820 - Circle 60W26 As-Built.dgn

D160W26-sht-AS-BUILT-05.dgn	DESIGNED -	REVISED -
USER NAME = auyeungh	DRAWN -	REVISED -
PLOT SCALE = 1:8000 / in.	CHECKED -	REVISED -
PLOT DATE = 8/16/2013	DATE - 07/15/13	REVISED -

STATE OF ILLINOIS
DEPARTMENT OF TRANSPORTATION

EXISTING AS-BUILTS SN 016-1087

SCALE: NTS SHEET AS-05 OF AS-62 SHEETS STA. TO STA.

F.A.I. RTE.	SECTION	COUNTY	TOTAL SHEETS	SHEET NO.
90/94/290	2013-008R	COOK	559	303
CONTRACT NO. 60W26			ILLINOIS FED. AID PROJECT	