


FOR INFORMATION ONLY

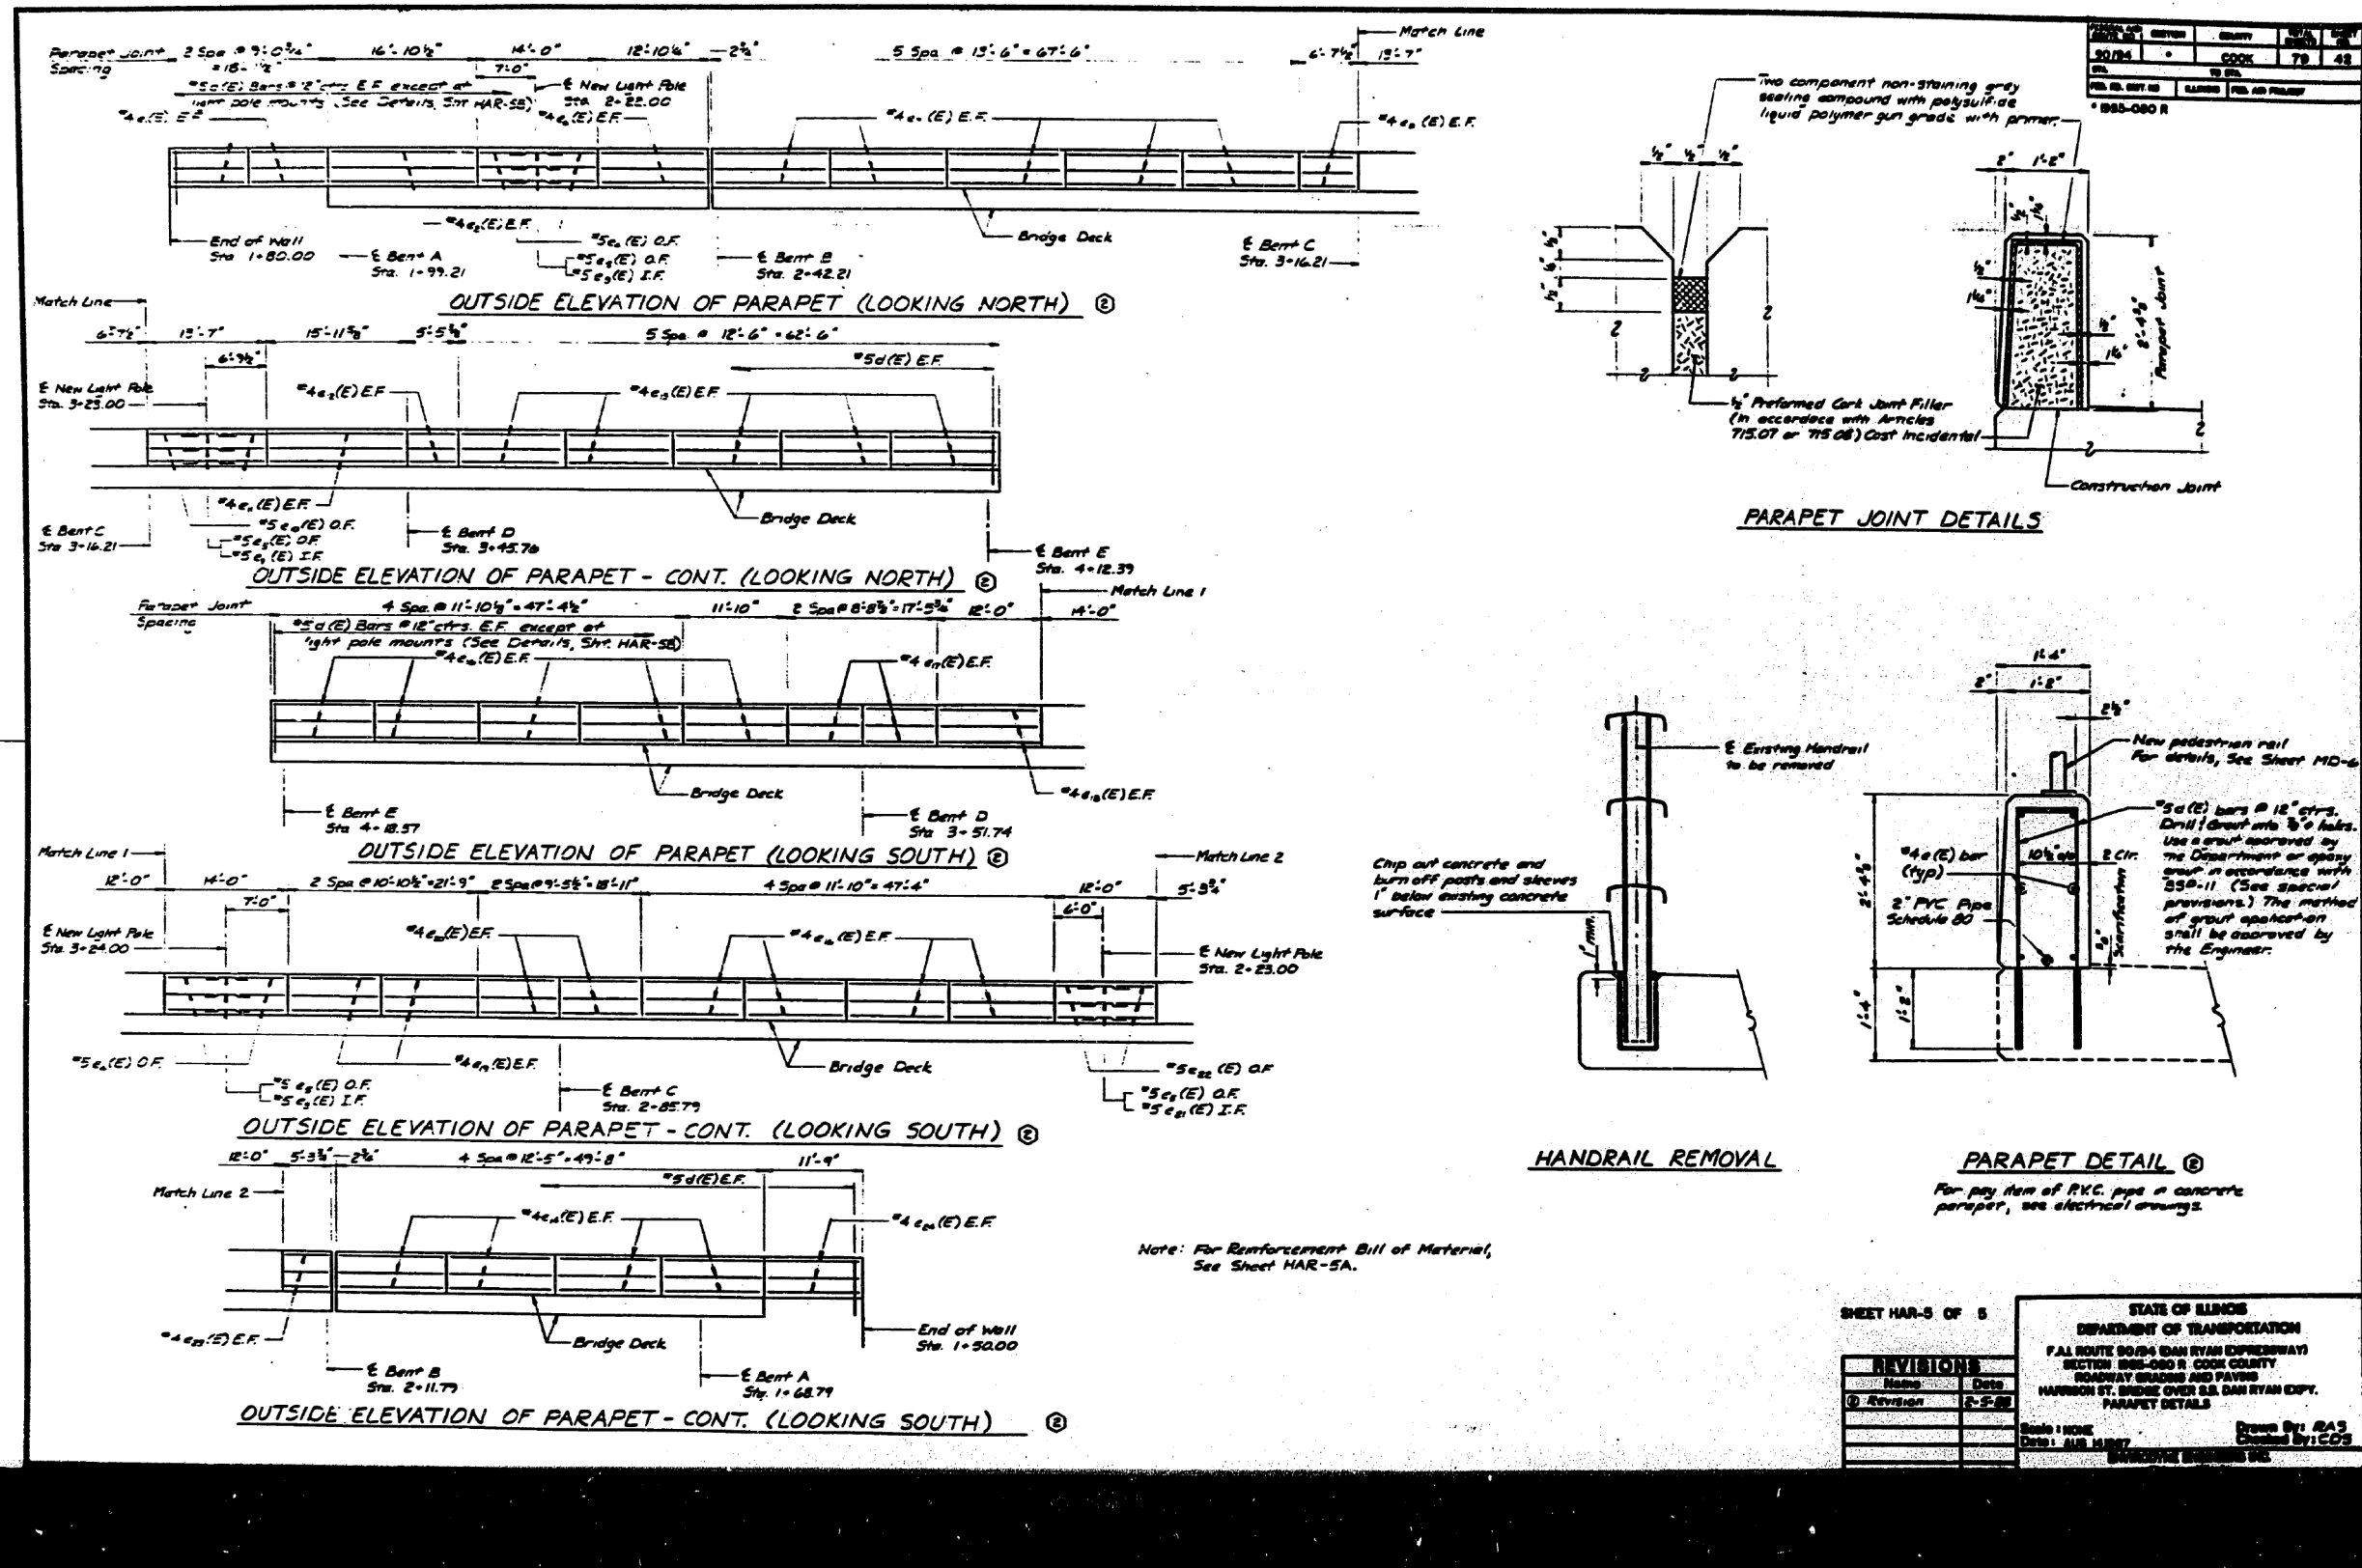

NO.	DATE	BY	CHKD
50784		COOK	79
101			48

REVISIONS	
No.	Date
1	7-5-82

STATE OF ILLINOIS
DEPARTMENT OF TRANSPORTATION
F.A.I. ROUTE 50/54 DAN RYAN EXPRESSWAY
SECTION 806-080 R COOK COUNTY
ROADWAY GRADINGS AND PAVES
HAWKINS ST. BRIDGE OVER S.A. DAN RYAN EXPY.
PARAPET DETAILS

Scale: NONE
Date: AUG 1987
Drawn By: RAS
Checked By: EDS

FILE PATH = C:\Projects\15-0820 - Circle 60W26 As-Built\Final\0160W26-sht-AS-BUILT-07.dgn

D160W26-sht-AS-BUILT-07.dgn	DESIGNED -	REVISED -
USER NAME = auyeungh	DRAWN -	REVISED -
PLOT SCALE = 1:8000 / 1"	CHECKED -	REVISED -
PLOT DATE = 8/16/2013	DATE = 07/15/13	REVISED -

STATE OF ILLINOIS
DEPARTMENT OF TRANSPORTATION

EXISTING AS-BUILTS SN 016-1087		F.A.I. R.T.E.	SECTION	COUNTY	TOTAL SHEETS	SHEET NO.
SCALE: NTS	SHEET AS-07 OF AS-62 SHEETS	90/94/290	2013-008R	COOK	559	305
TO STA.		ILLINOIS FED. AID PROJECT		CONTRACT NO. 60W26		