


FOR INFORMATION ONLY

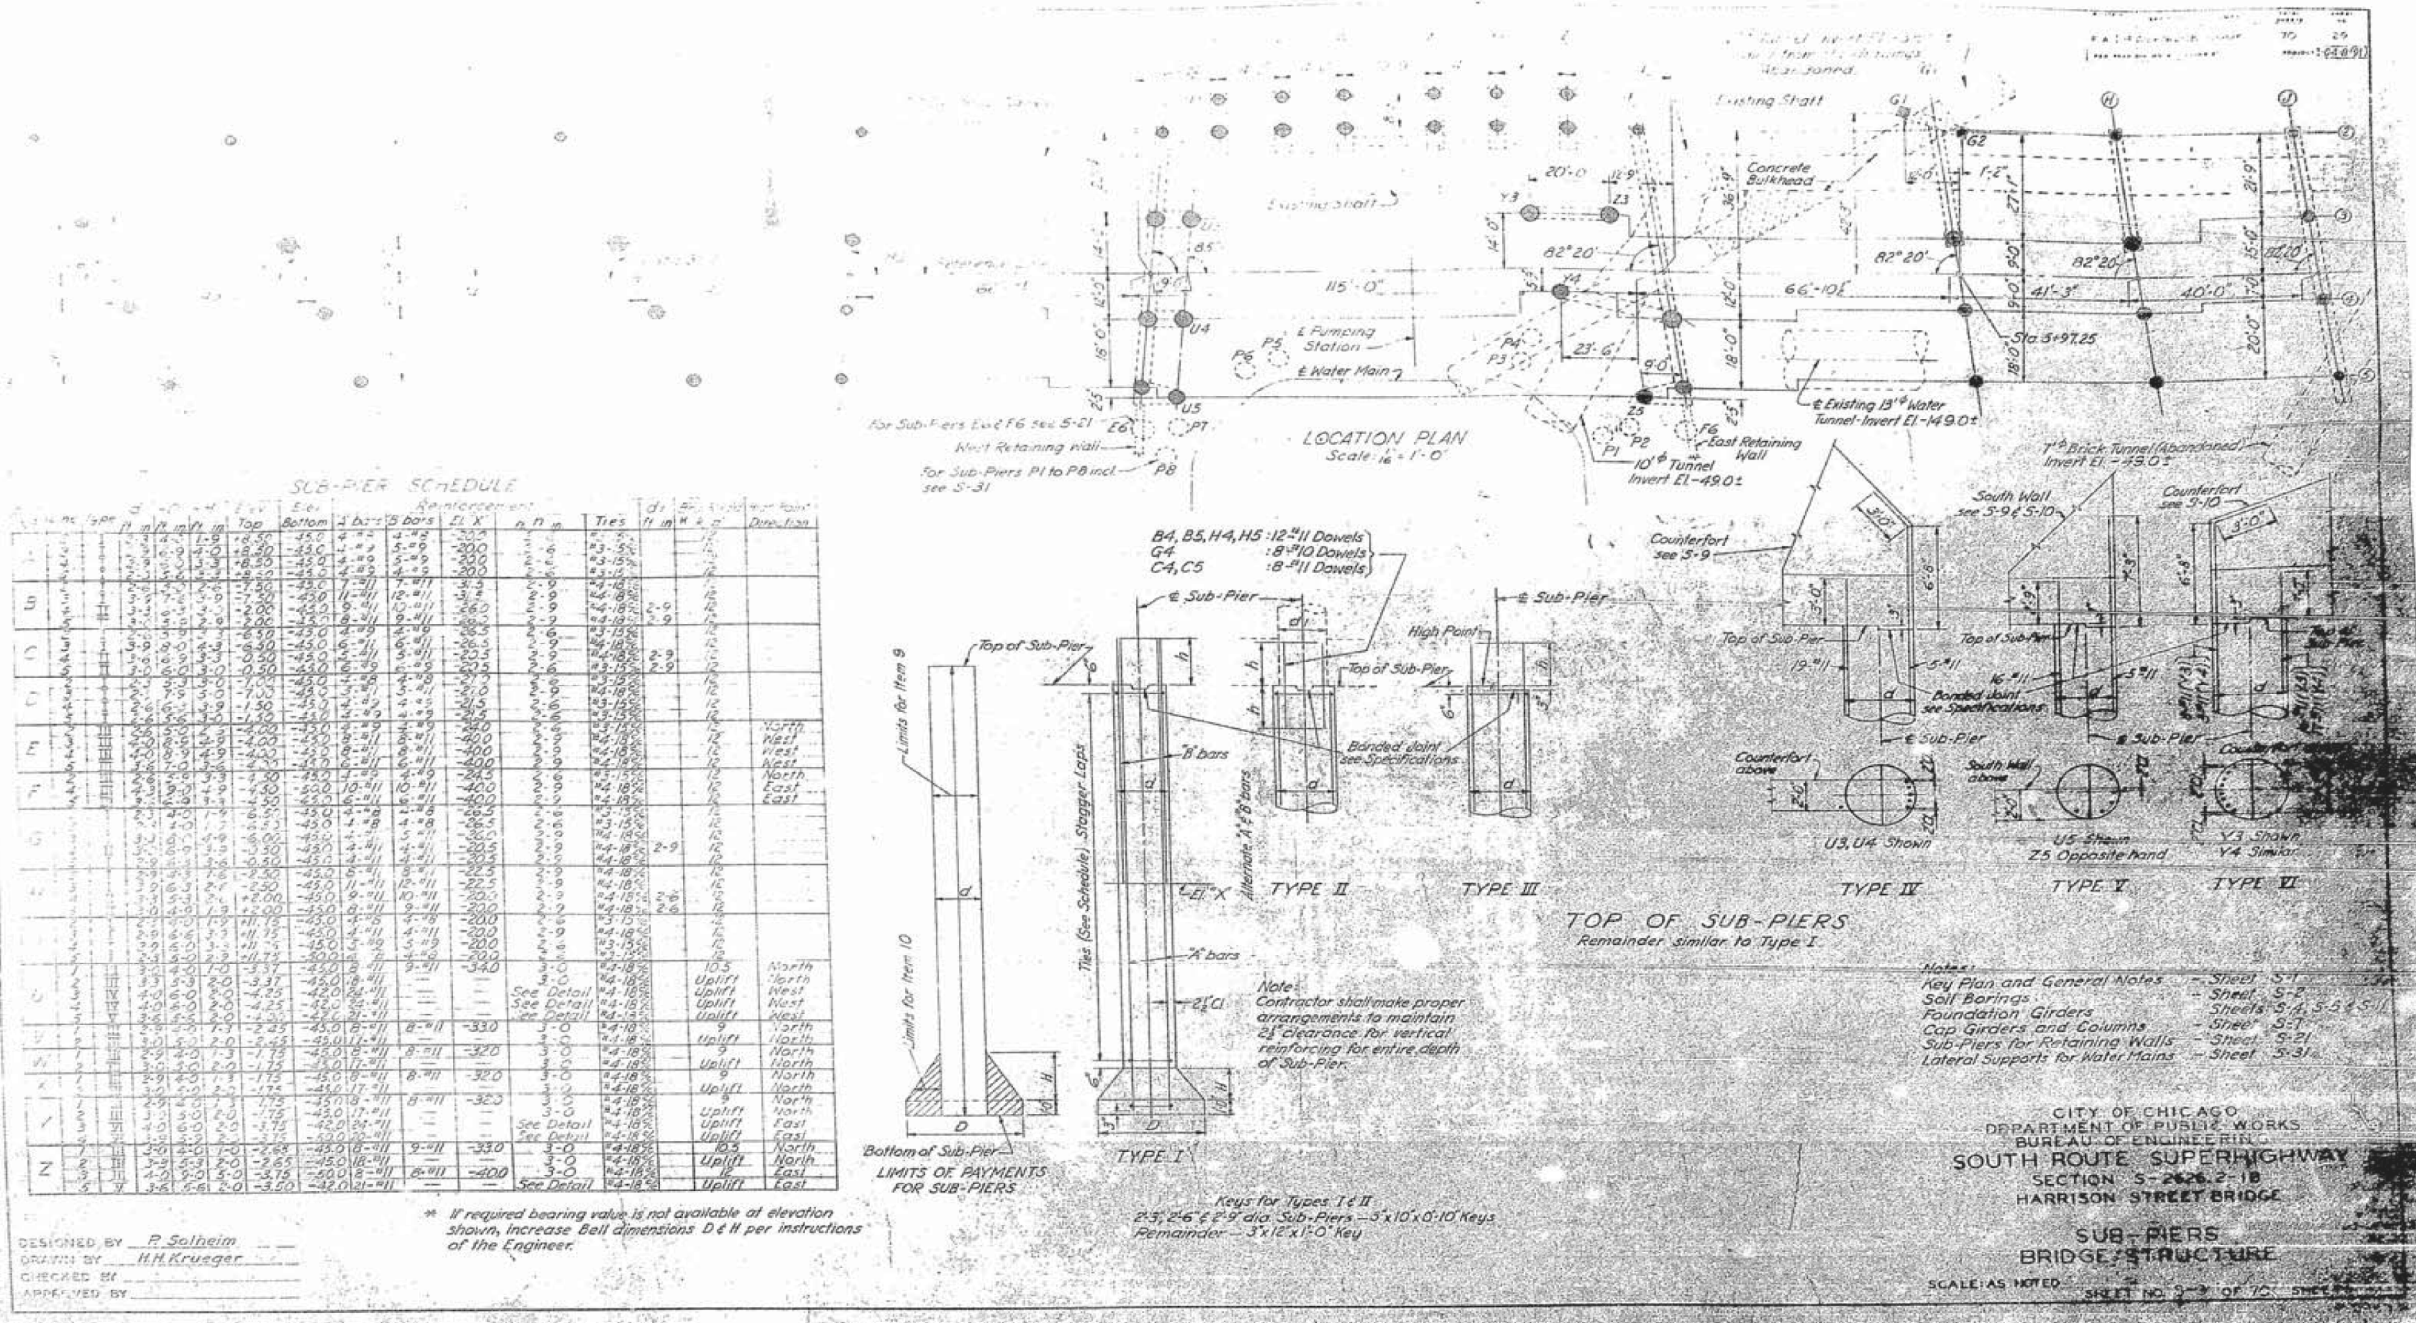

FILE PATH = C:\Projects\15-0820 - Circle 60W26 AS-Built - Circle 60W26 AS-Built - BUILT-22.dgn

DESIGNED BY P. Solheim
DRAWN BY H.M. Krueger
CHECKED BY
APPROVED BY

* If required bearing value is not available at elevation shown, increase Bell dimensions D & H per instructions of the Engineer.

D160W26-sht-AS-BUILT-22.dgn	DESIGNED -	REVISED -
USER NAME = auyeung	DRAWN -	REVISED -
PLOT SCALE = 1:8000 / 1"	CHECKED -	REVISED -
PLOT DATE = 8/16/2013	DATE - 07/15/13	REVISED -

STATE OF ILLINOIS
DEPARTMENT OF TRANSPORTATION

EXISTING AS-BUILTS SN 016-1087

SCALE: NTS SHEET AS-22 OF AS-62 SHEETS STA. TO STA.

F.A.I. R.E.	SECTION	COUNTY	TOTAL SHEETS	SHEET NO.
90/94/290	2013-008R	COOK	559	320
CONTRACT NO. 60W26				
ILLINOIS FED. AID PROJECT				