


FOR INFORMATION ONLY

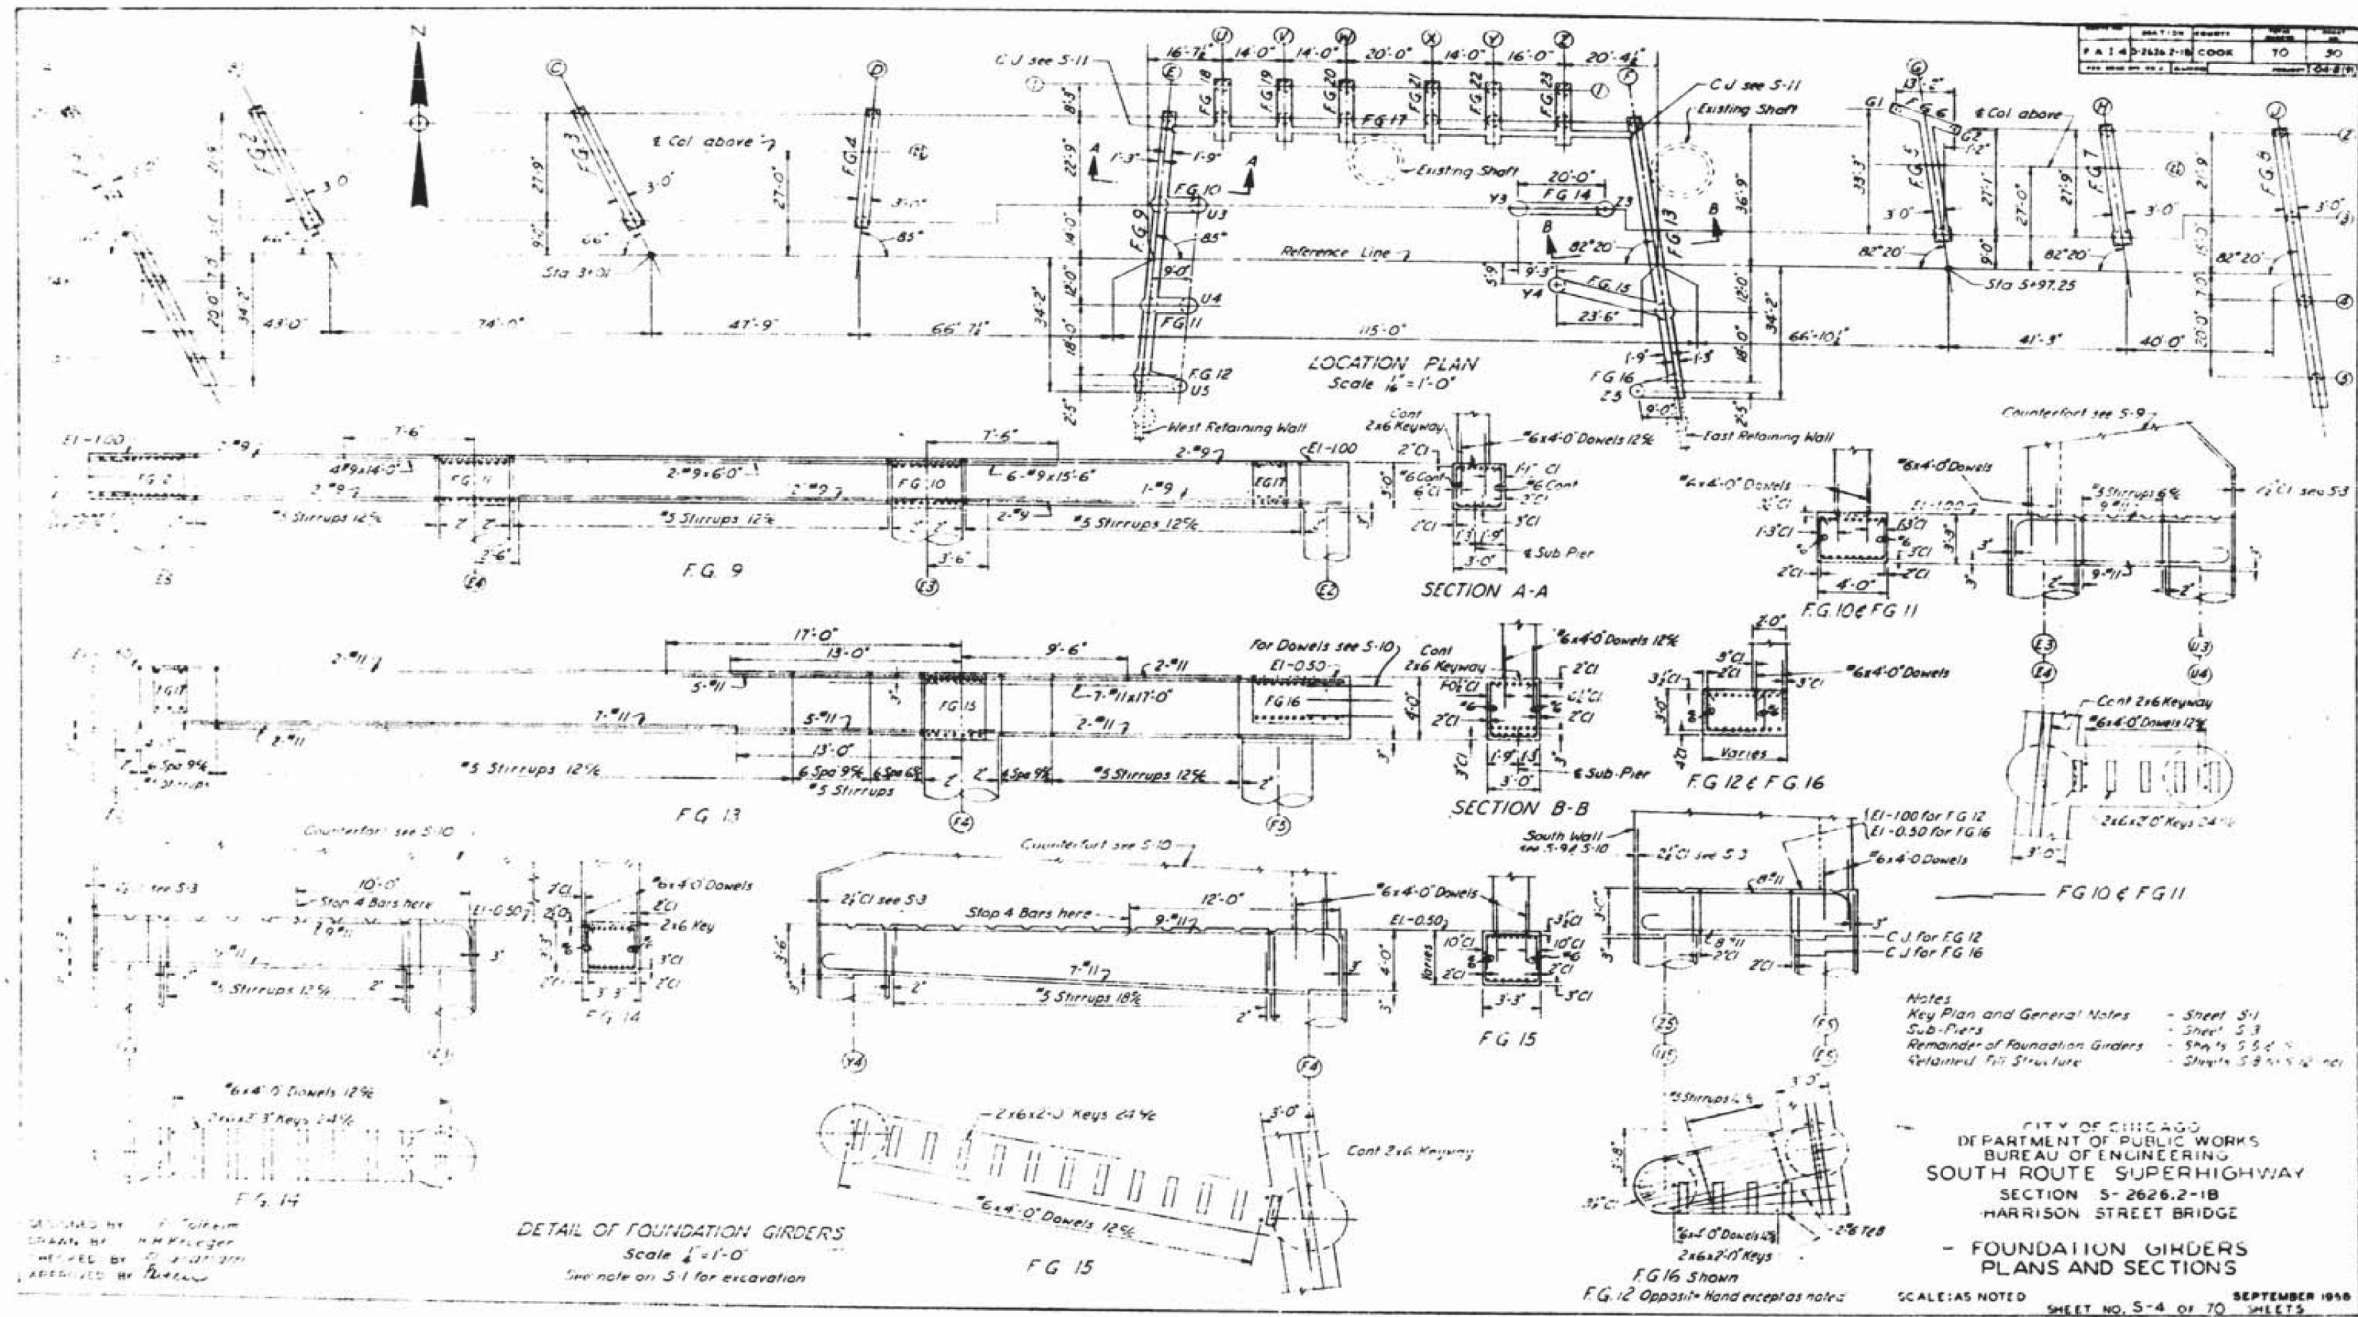

FILE PATH = C:\Projects\15-0820 - Circle 60W26 AS-Built\15-0820 - Circle 60W26 AS-Built\AS-BUILT-23.dgn

|                          |            |           |
|--------------------------|------------|-----------|
| DESIGNED BY: [Signature] | DESIGNED - | REVISED - |
| DRAWN BY: [Signature]    | DRAWN -    | REVISED - |
| CHECKED BY: [Signature]  | CHECKED -  | REVISED - |
| DATE: 07/15/13           | DATE -     | REVISED - |

STATE OF ILLINOIS  
DEPARTMENT OF TRANSPORTATION

|                               |                             |
|-------------------------------|-----------------------------|
| EXISTING AS-BUILT SN 016-1087 |                             |
| SCALE: NTS                    | SHEET AS-23 OF AS-62 SHEETS |
| STA.                          | TO STA.                     |

|                           |           |        |              |           |
|---------------------------|-----------|--------|--------------|-----------|
| F.A.I. R.E.               | SECTION   | COUNTY | TOTAL SHEETS | SHEET NO. |
| 90/94/290                 | 2013-008R | COOK   | 559          | 321       |
| CONTRACT NO. 60W26        |           |        |              |           |
| ILLINOIS FED. AID PROJECT |           |        |              |           |