


FOR INFORMATION ONLY

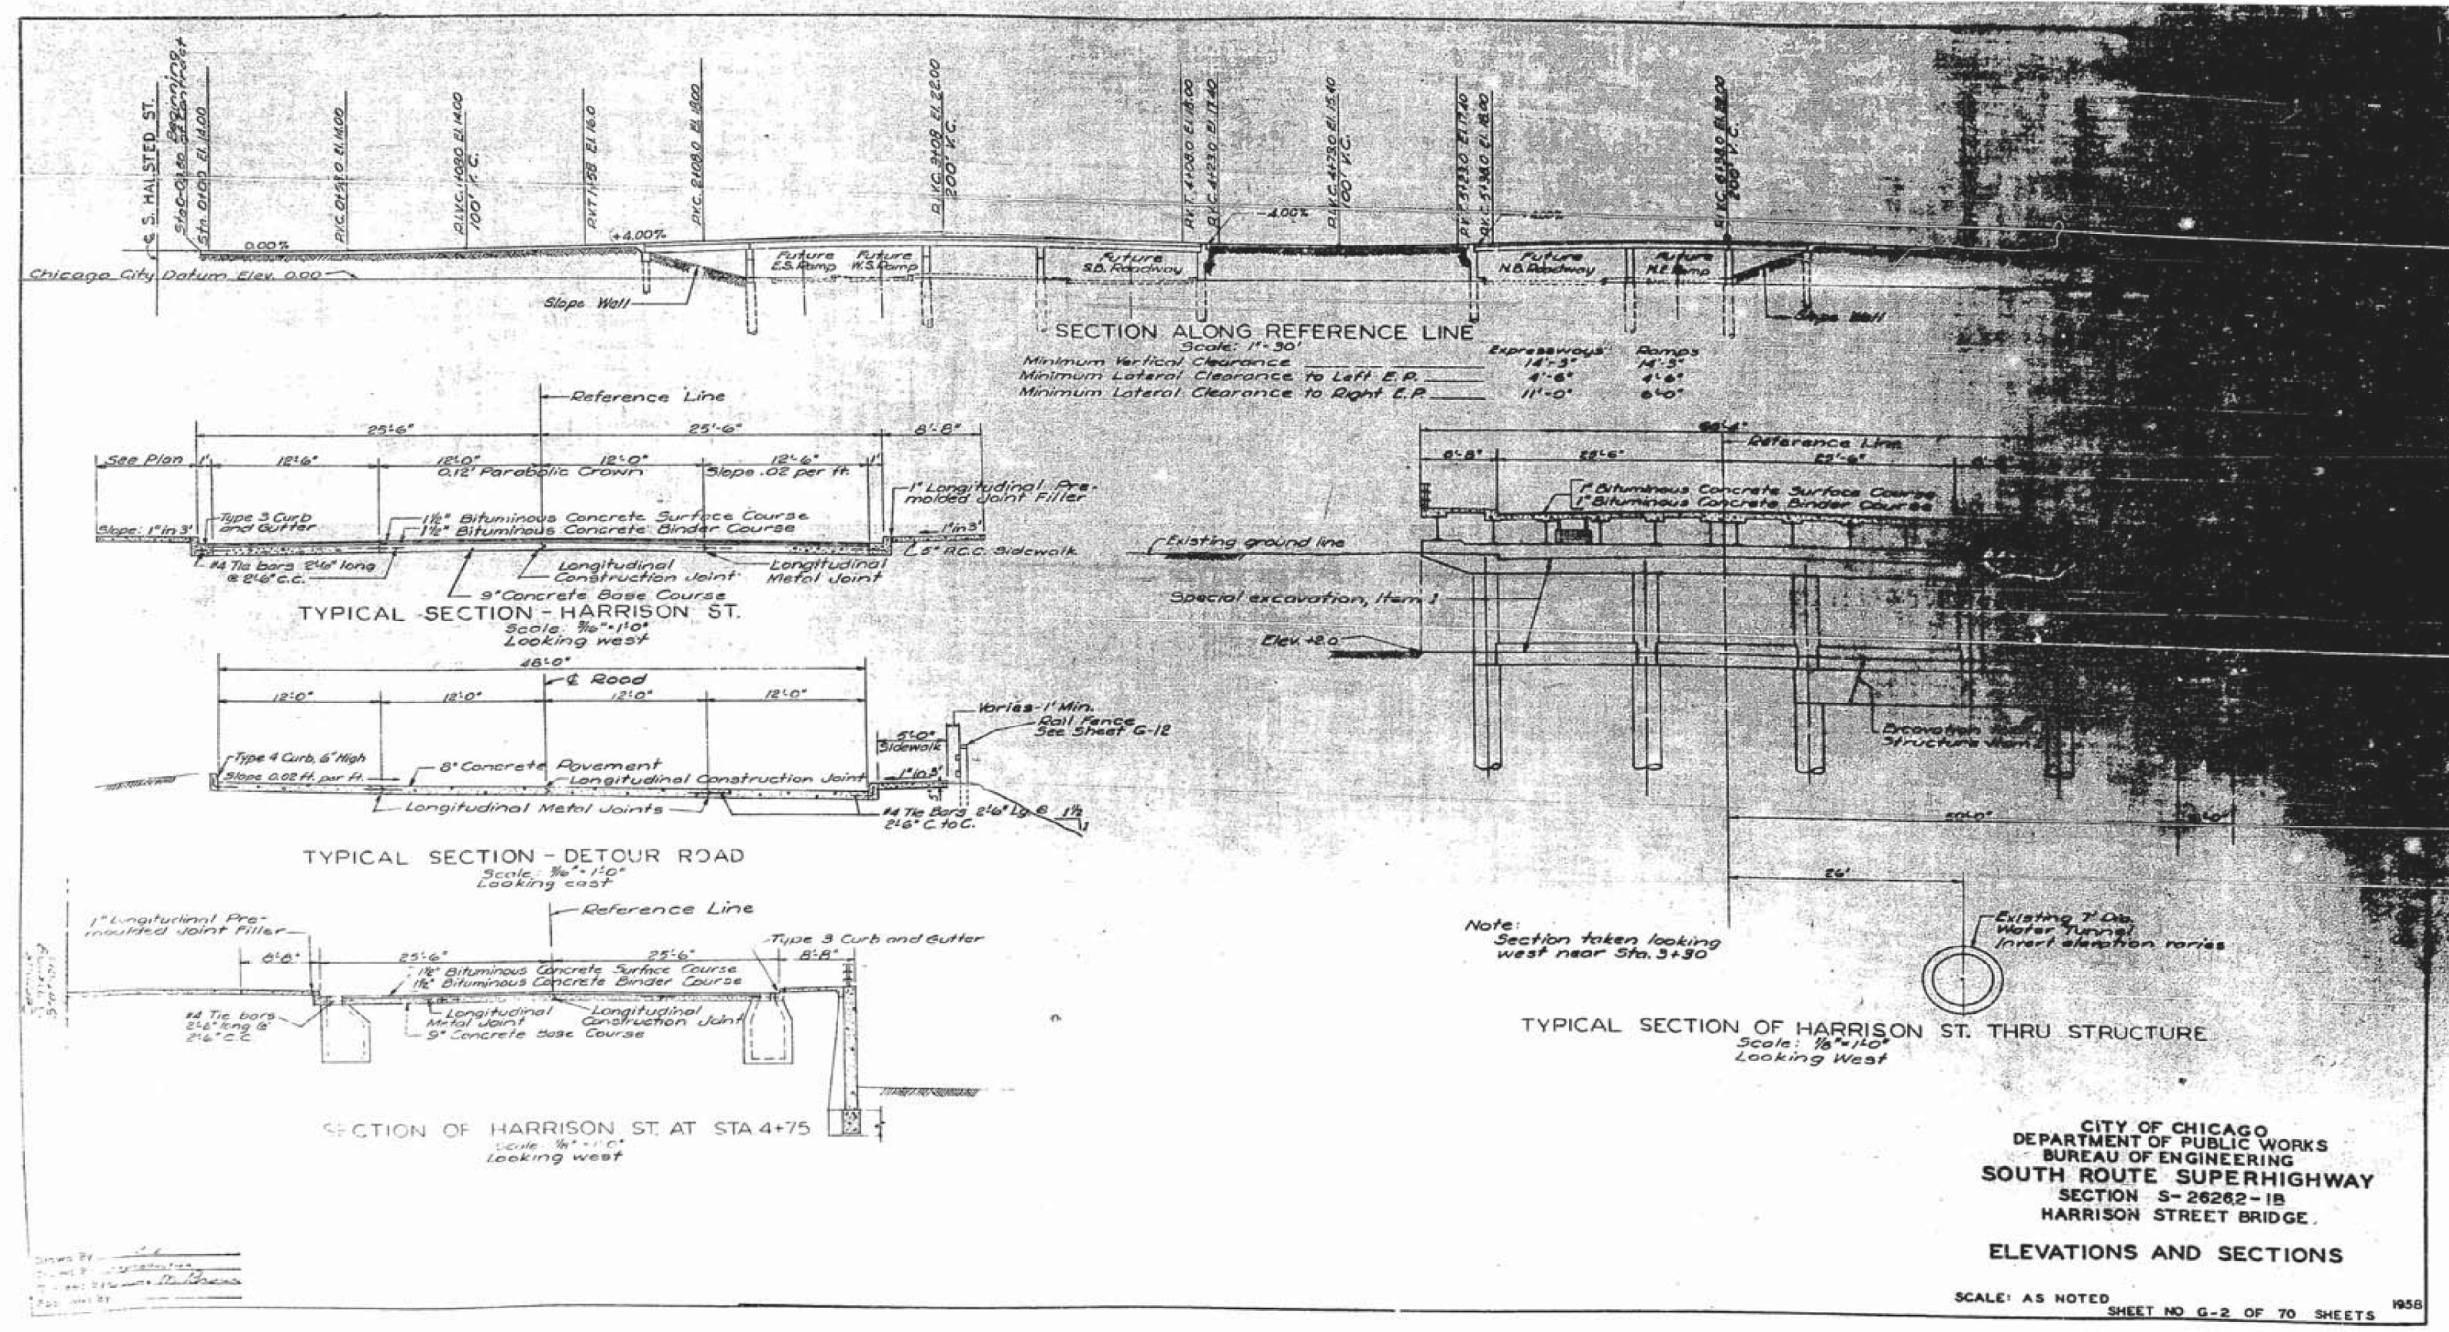

CITY OF CHICAGO  
 DEPARTMENT OF PUBLIC WORKS  
 BUREAU OF ENGINEERING  
 SOUTH ROUTE SUPERHIGHWAY  
 SECTION S-2622-1B  
 HARRISON STREET BRIDGE  
 ELEVATIONS AND SECTIONS  
 SCALE: AS NOTED  
 SHEET NO G-2 OF 70 SHEETS 1958

FILE PATH = C:\Project\15-0820 - Circle 60W26 AS-Built\Final\0160W26-sht-AS-BUILT-30.dgn

D:\0160W26-sht-AS-BUILT-30.dgn	DESIGNED -	REVISED -
USER NAME = auyeungh	DRAWN -	REVISED -
PLOT SCALE = 1.0000' / in.	CHECKED -	REVISED -
PLOT DATE = 8/16/2013	DATE - 07/15/13	REVISED -

STATE OF ILLINOIS  
 DEPARTMENT OF TRANSPORTATION

EXISTING AS-BUILTS SN 016-1087  
 SCALE: NTS SHEET AS-30 OF AS-62 SHEETS STA. TO STA.

F.A.I. RTE.	SECTION	COUNTY	TOTAL SHEETS	SHEET NO.
90/94/290	2013-008R	COOK	559	328
CONTRACT NO. 60W26				
ILLINOIS FED. AID PROJECT				