


FOR INFORMATION ONLY

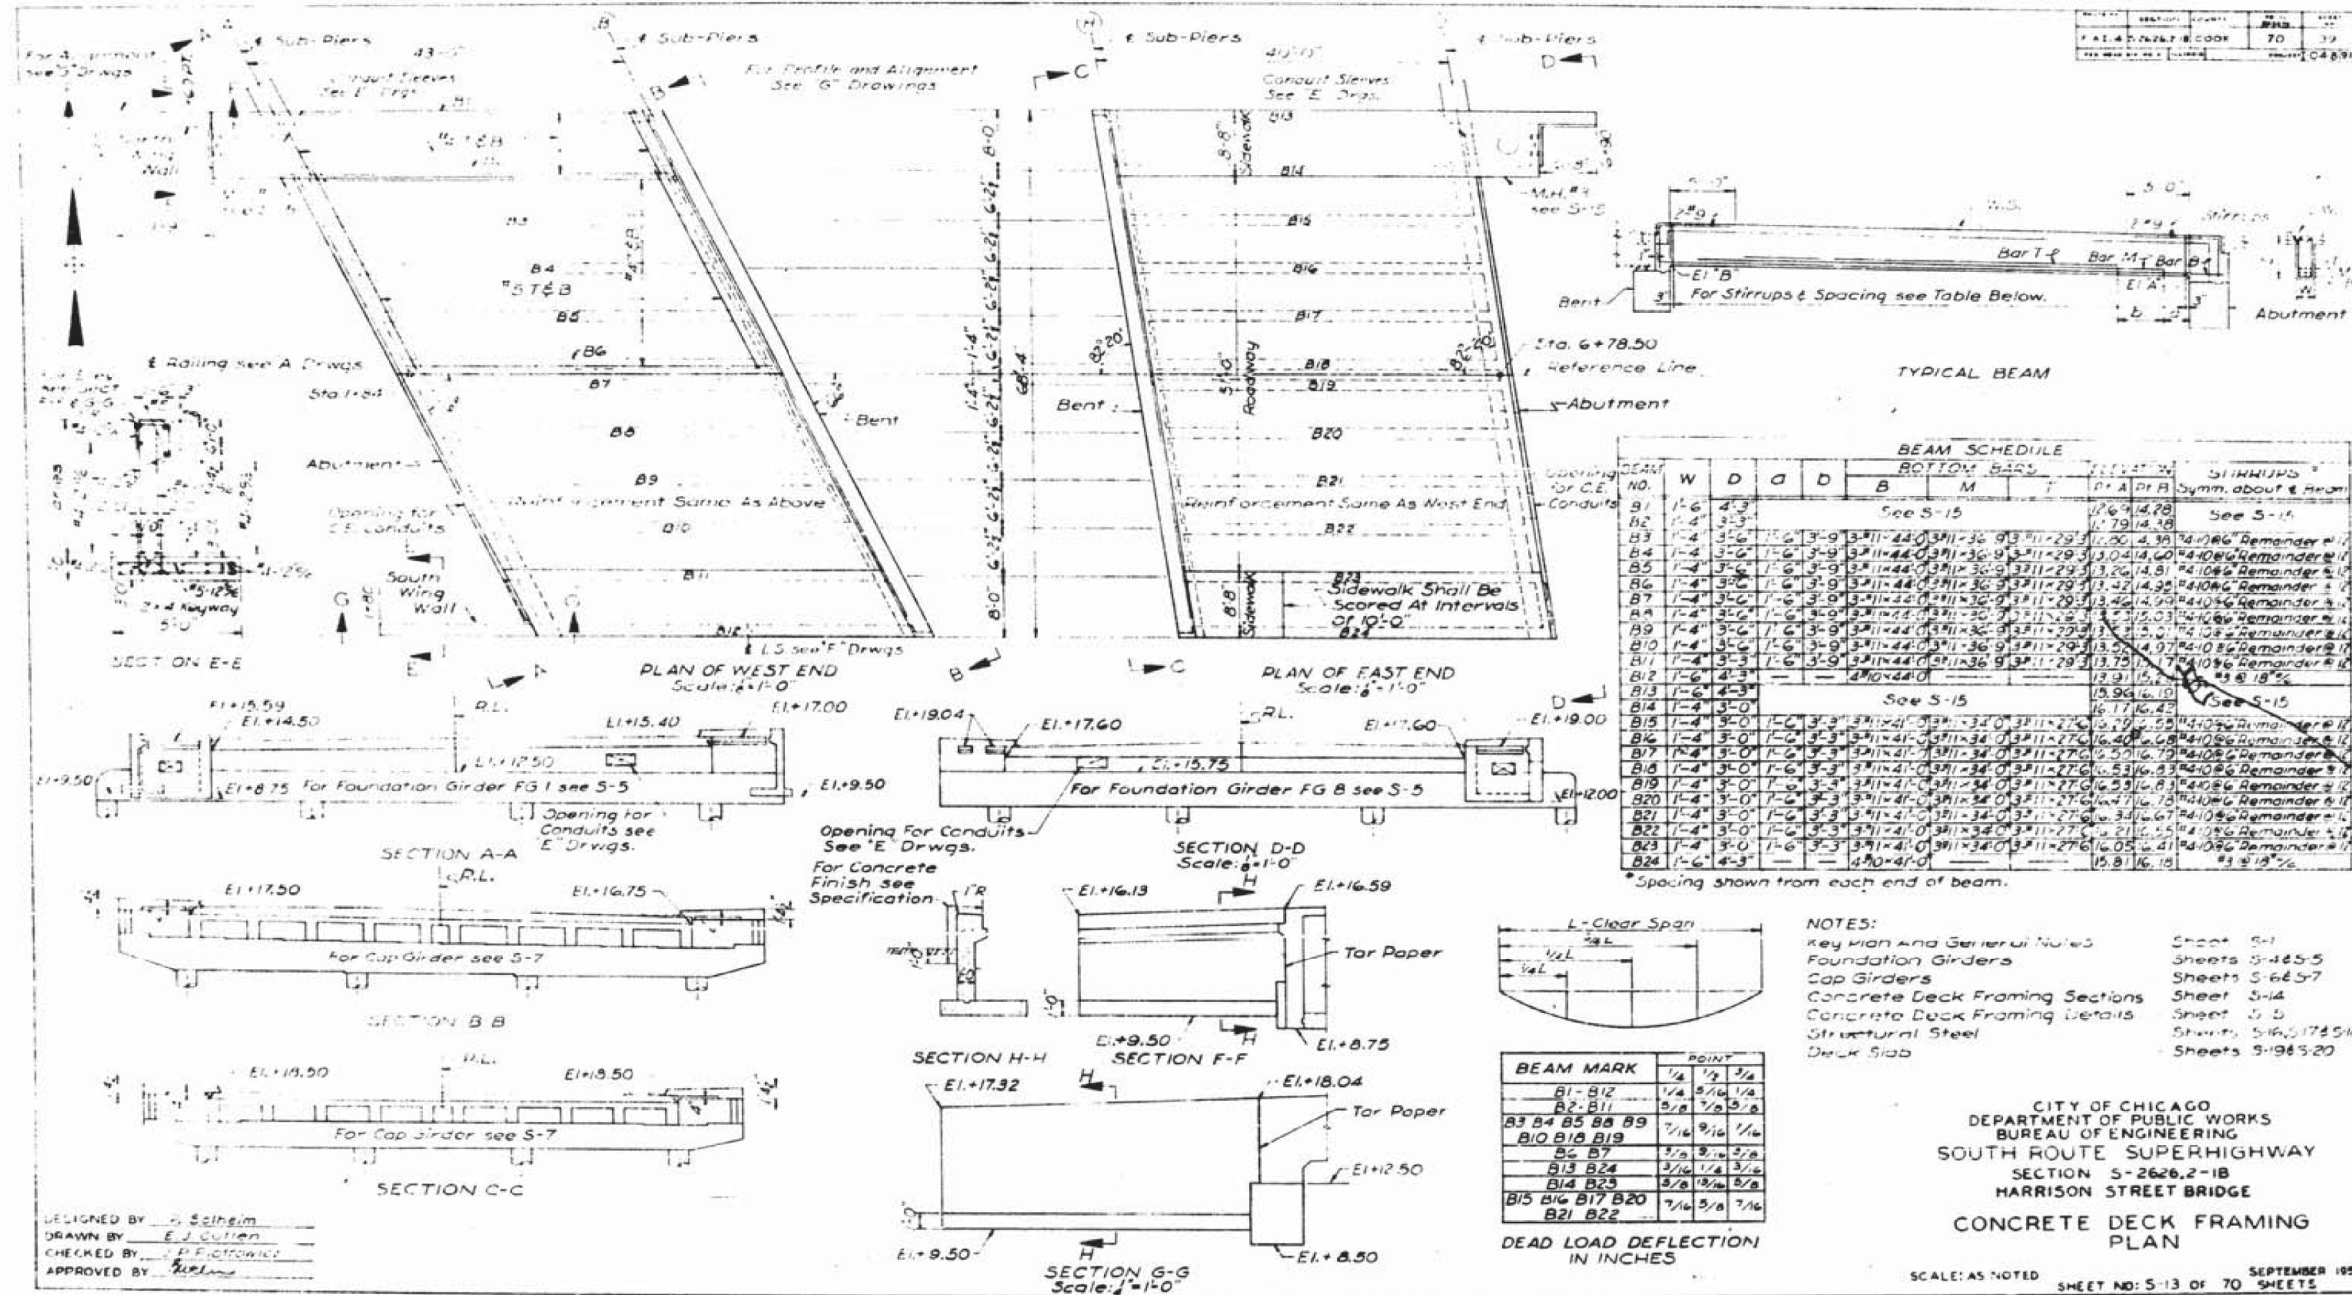

FILE PATH = C:\Projects\15-0820 - Circle 60W26 As-Built\Final\0160W26-sht-AS-BUILT-33.dgn

DESIGNED BY: S. Selheim  
 DRAWN BY: E. J. Cullen  
 CHECKED BY: P. F. Foltzowicz  
 APPROVED BY: [Signature]

CITY OF CHICAGO  
 DEPARTMENT OF PUBLIC WORKS  
 BUREAU OF ENGINEERING  
 SOUTH ROUTE SUPERHIGHWAY  
 SECTION 5-2626.2-1B  
 HARRISON STREET BRIDGE  
**CONCRETE DECK FRAMING PLAN**  
 SCALE: AS NOTED SHEET NO: 5-13 OF 70 SHEETS SEPTEMBER 1958