


FOR INFORMATION ONLY

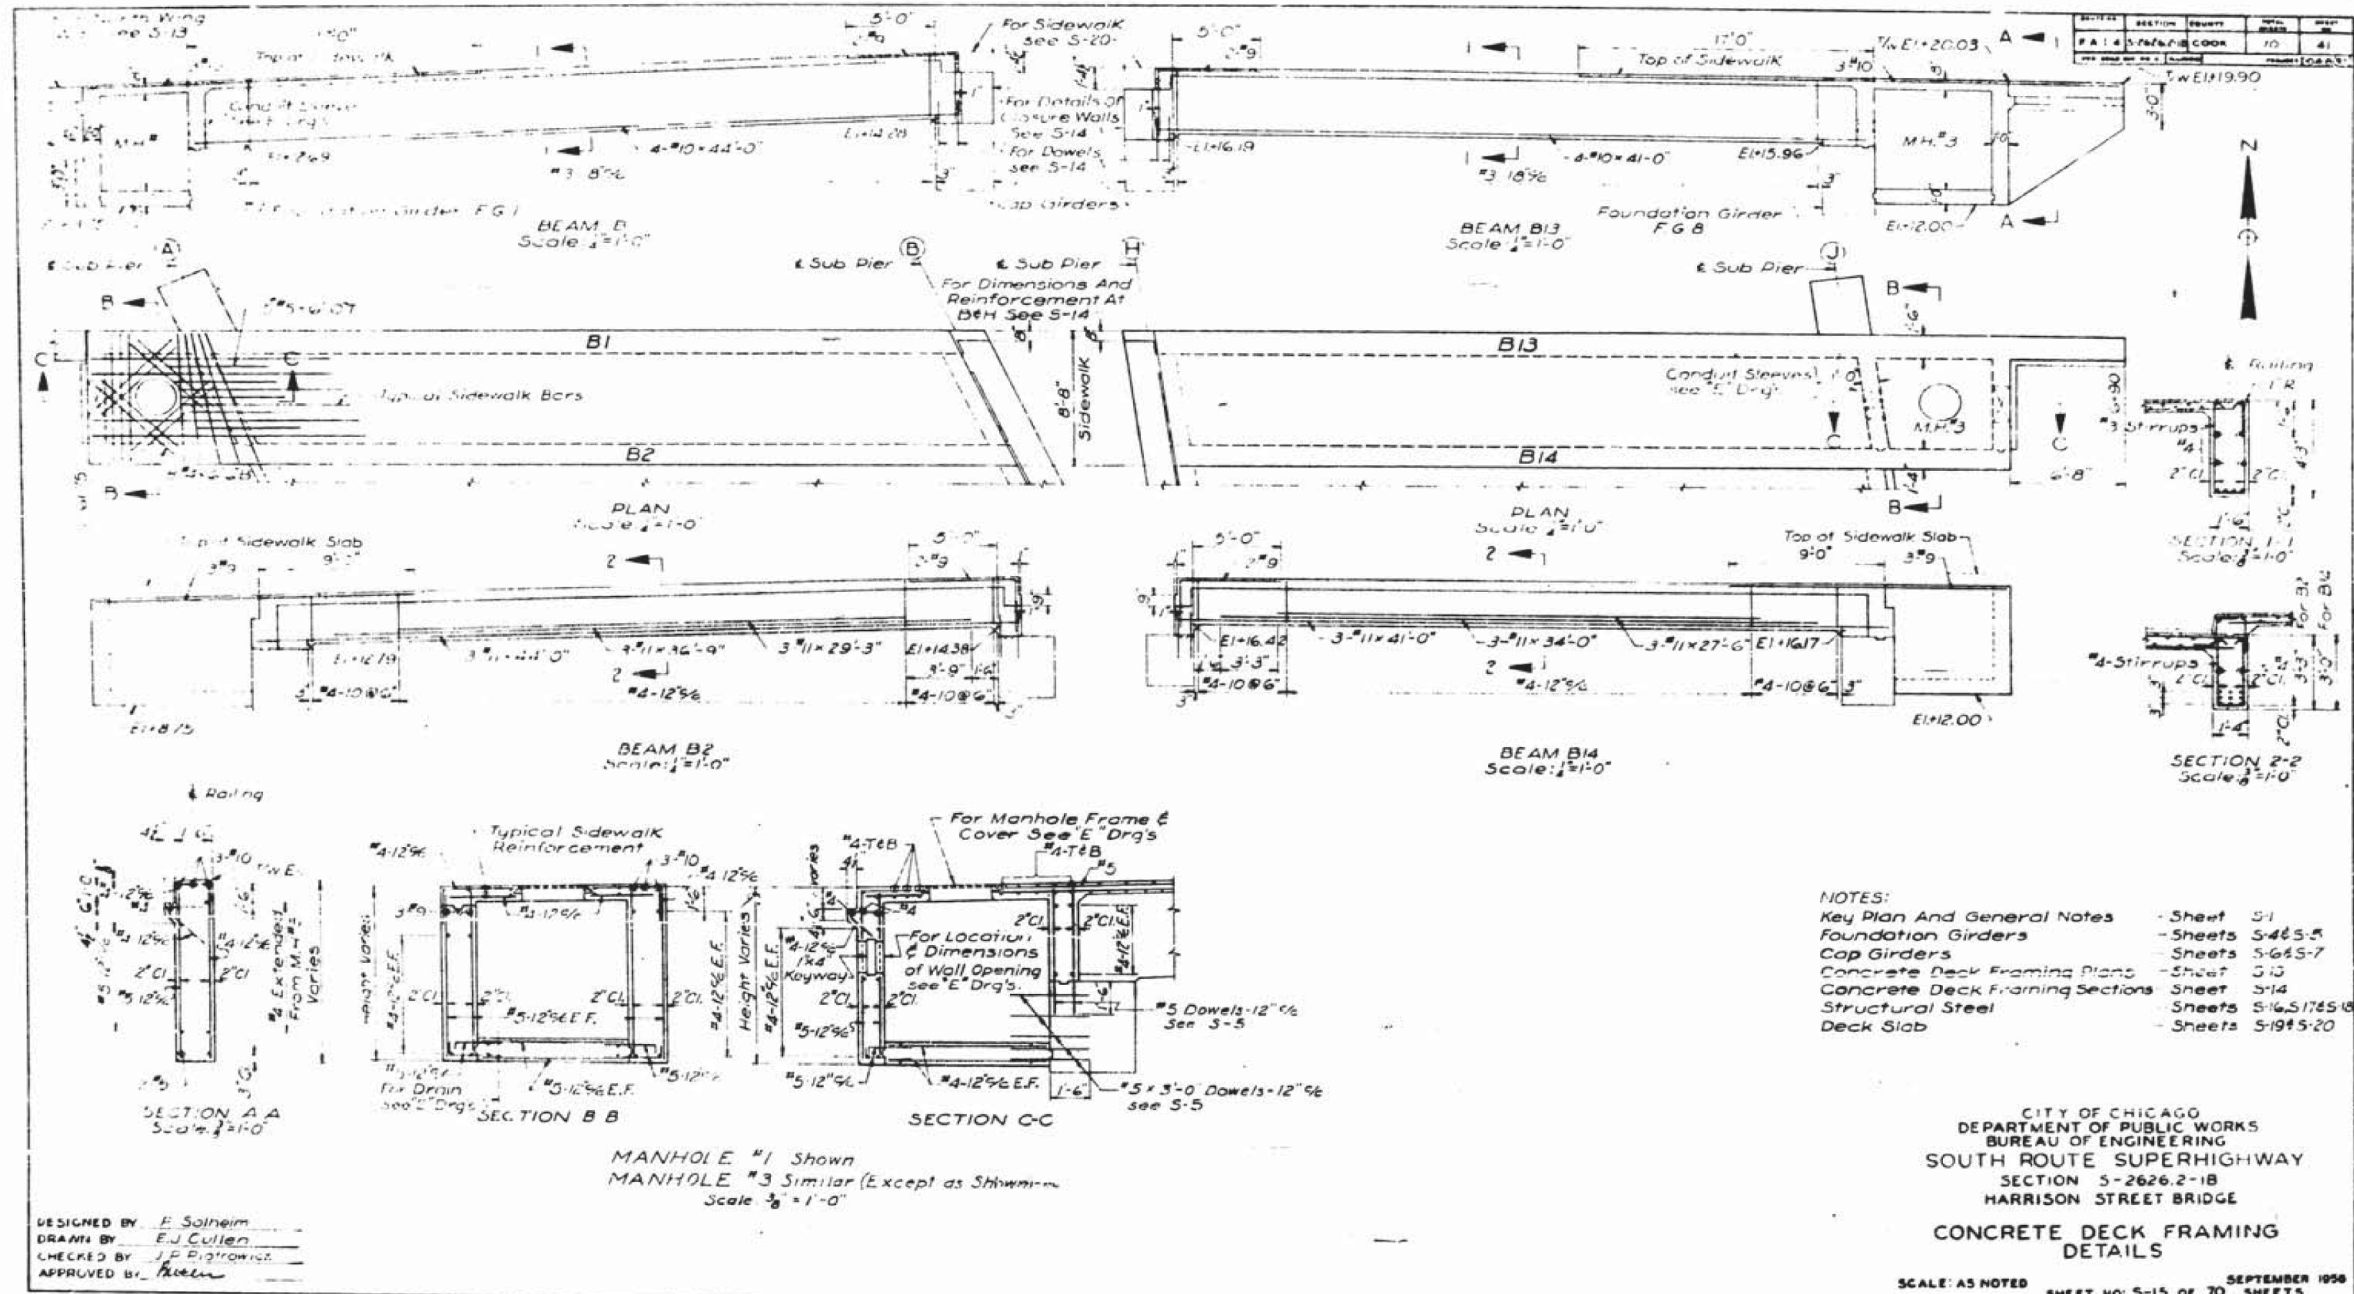

FILE PATH = C:\Projects\15-0820 - Circle 60W26 AS-Built - Final\0160W26-sht-AS-BUILT-35.dgn

D160W26-sht-AS-BUILT-35.dgn	DESIGNED -	REVISED -	STATE OF ILLINOIS DEPARTMENT OF TRANSPORTATION	EXISTING AS-BUILTS SN 016-1087		F.A.I. R.T.E.	SECTION	COUNTY	TOTAL SHEETS	SHEET NO.	
USER NAME = ouyeungh	DRAWN -	REVISED -		90/94/290	2013-008R	COOK	559	333			
PLOT SCALE = 1:8000 / 1 in.	CHECKED -	REVISED -		SCALE: NTS		SHEET AS-35 OF AS-62 SHEETS		STA. TO STA.		CONTRACT NO. 60W26	
PLOT DATE = 8/16/2013	DATE - 07/15/13	REVISED -						ILLINOIS FED. AID PROJECT			