


FOR INFORMATION ONLY

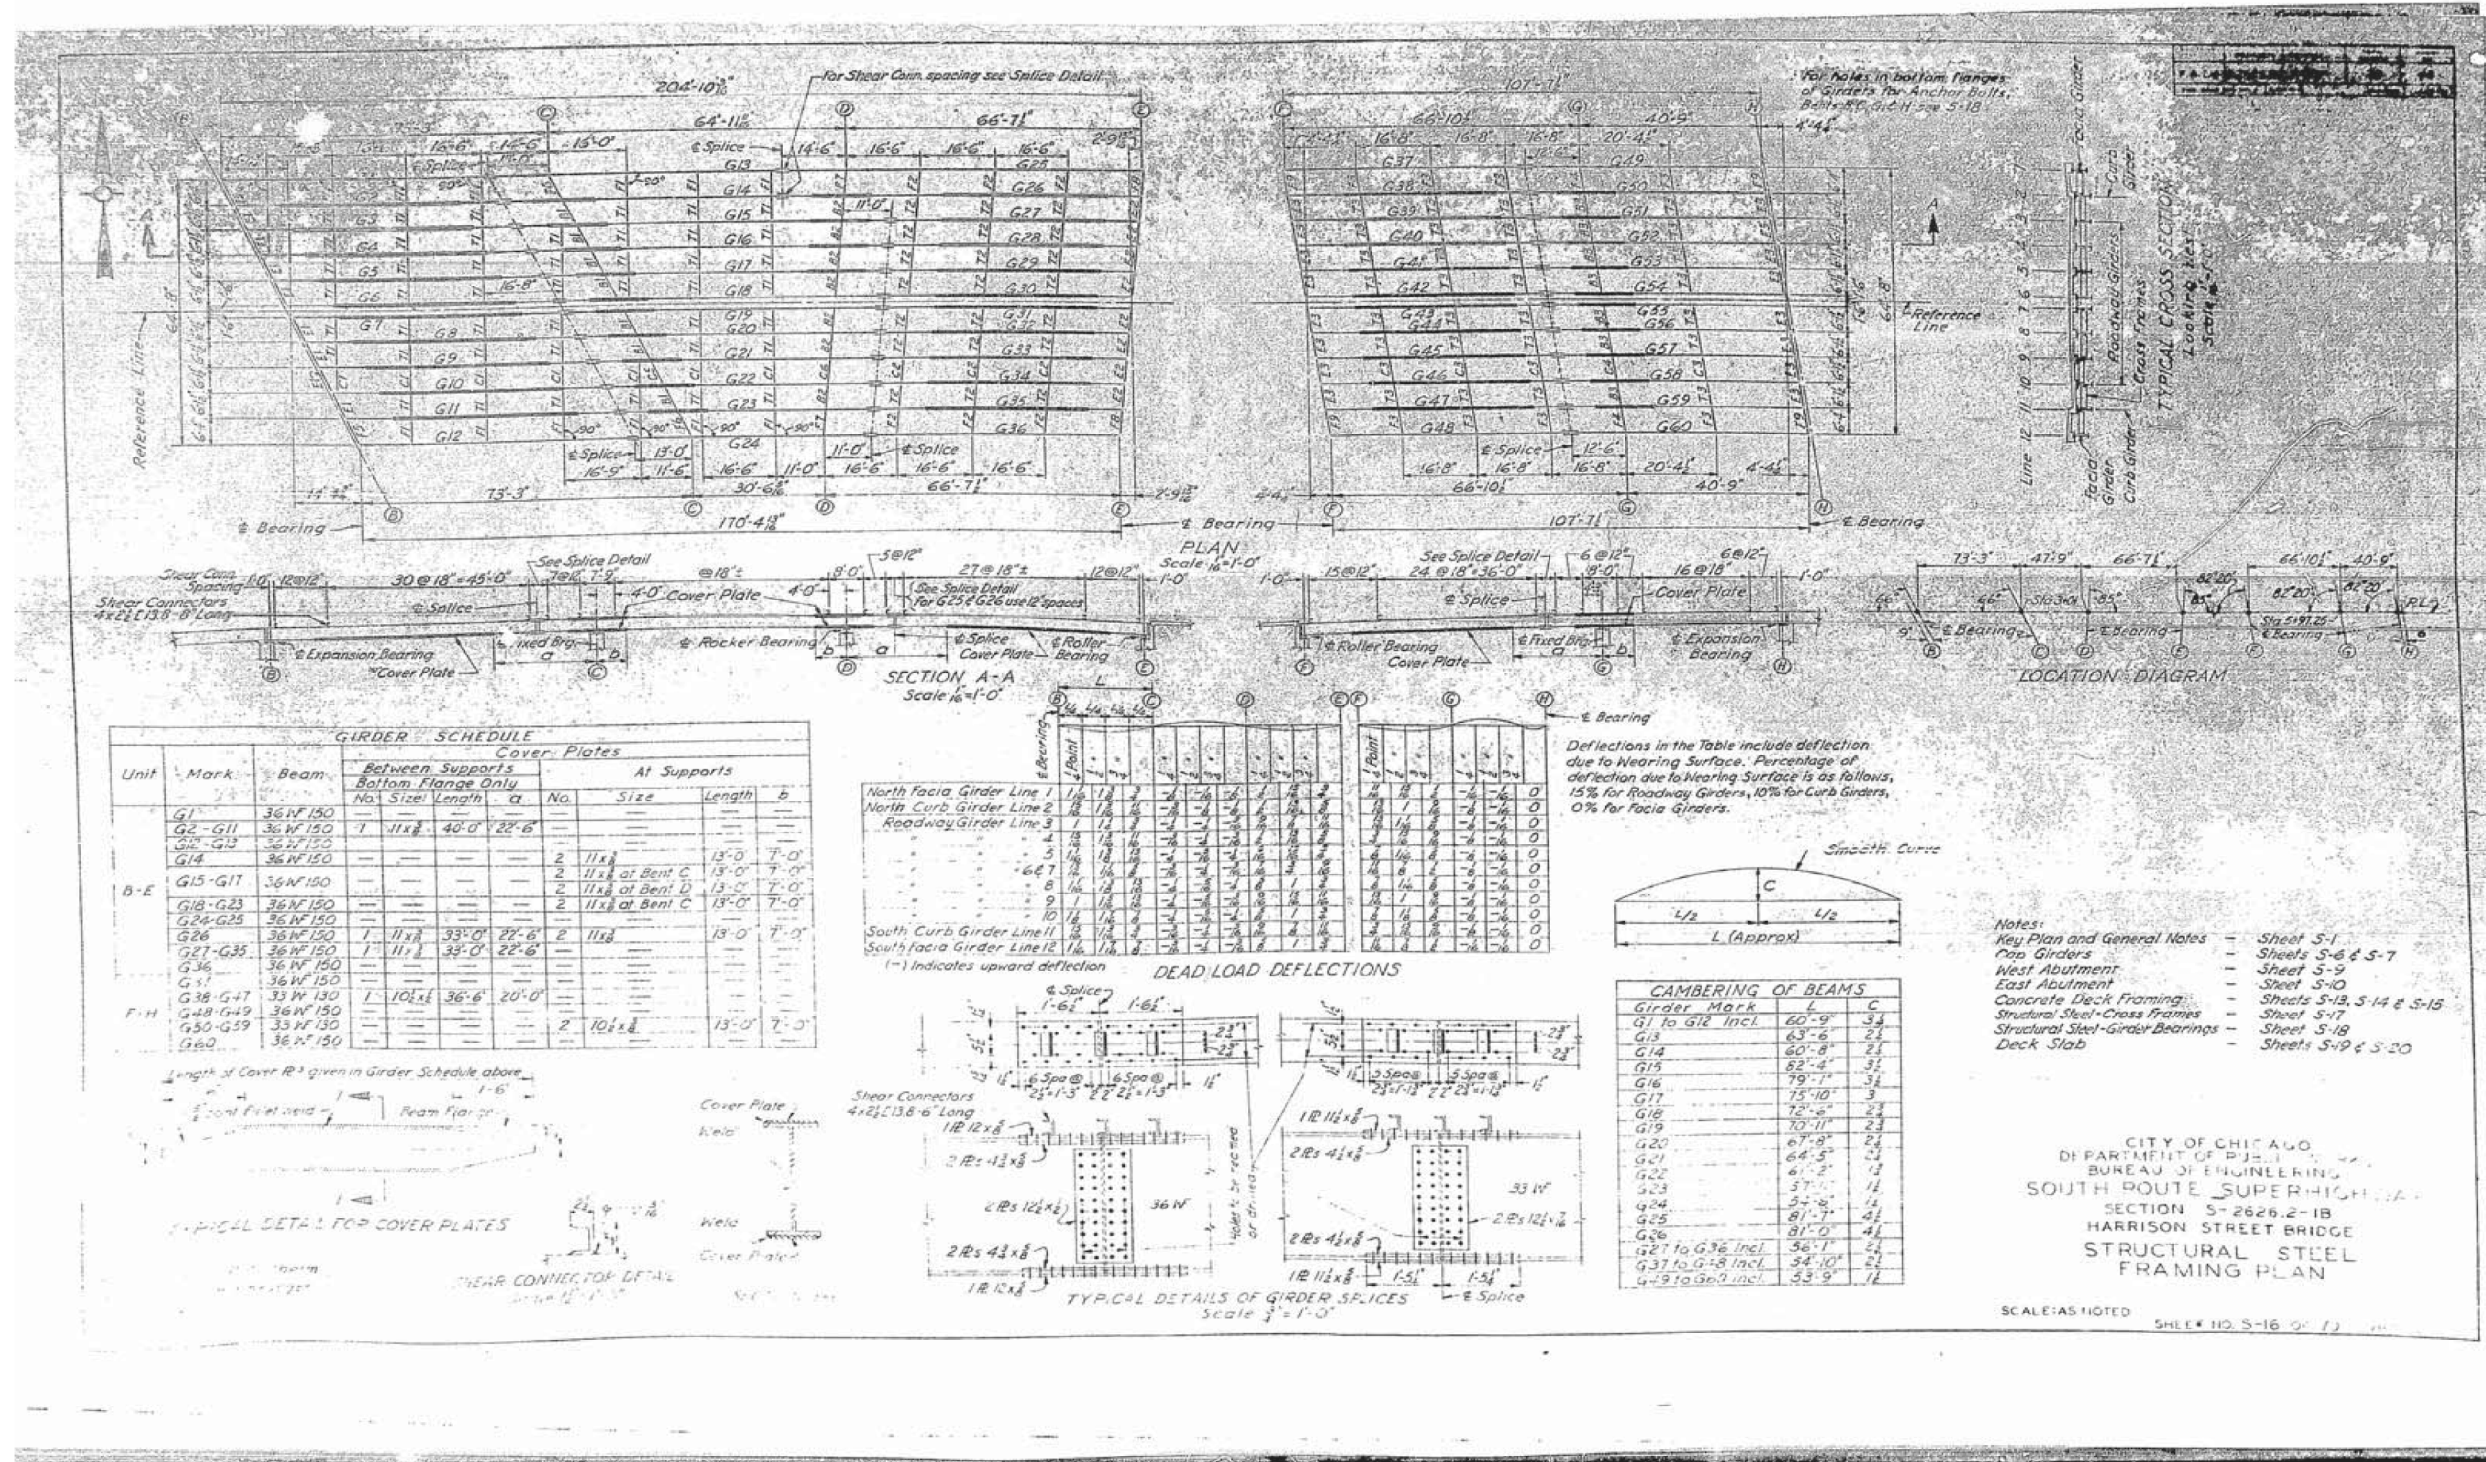

FILE PATH = C:\Projects\15-0820 - Circle 60W26 As-Built\Final\0160W26-sht-AS-BUILT-36.dgn

D160W26-sht-AS-BUILT-36.dgn  
 USER NAME = ayeungh  
 PLOT SCALE = 1:8000 / 1"  
 PLOT DATE = 8/16/2013

DESIGNED -  
 DRAWN -  
 CHECKED -  
 DATE - 07/15/13

REVISED -  
 REVISED -  
 REVISED -  
 REVISED -

STATE OF ILLINOIS  
 DEPARTMENT OF TRANSPORTATION

EXISTING AS-BUILTS SN 016-1087  
 SCALE: NTS SHEET AS-36 OF AS-62 SHEETS STA. TO STA.

F.A.I. RTE.	SECTION	COUNTY	TOTAL SHEETS	SHEET NO.
90/94/290	2013-008R	COOK	559	334
CONTRACT NO. 60W26				
ILLINOIS FED. AID PROJECT				