


FOR INFORMATION ONLY

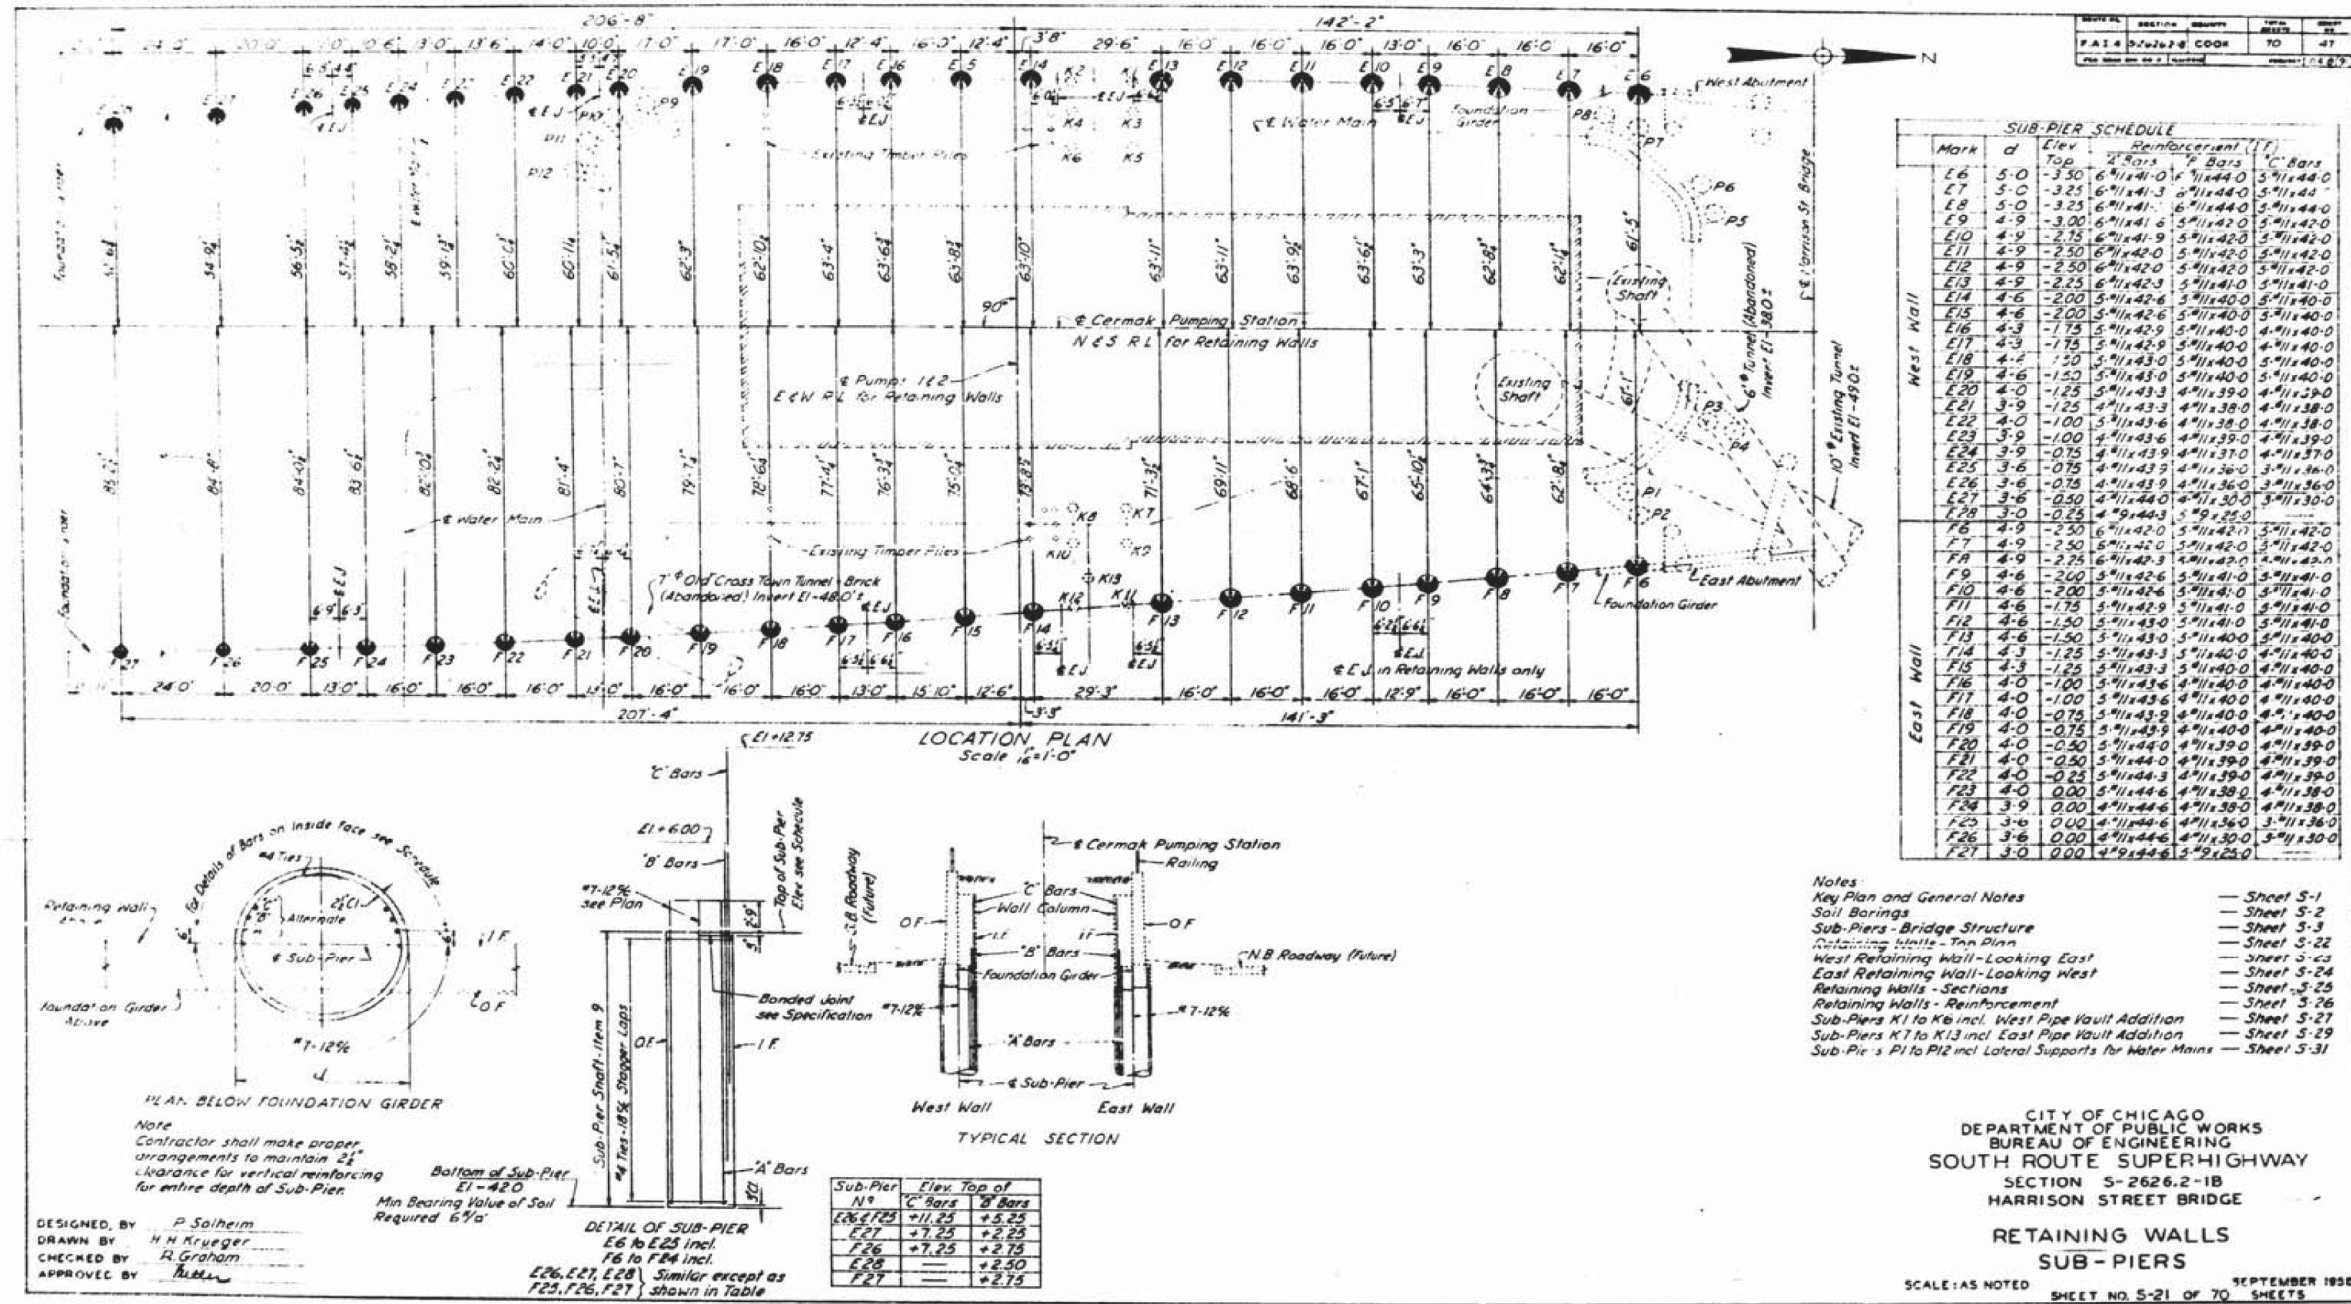

- Notes
- Key Plan and General Notes — Sheet S-1
 - Sail Borings — Sheet S-2
 - Sub-Piers - Bridge Structure — Sheet S-3
 - Retaining Walls - Twp Plan — Sheet S-22
 - West Retaining Wall - Looking East — Sheet S-23
 - East Retaining Wall - Looking West — Sheet S-24
 - Retaining Walls - Sections — Sheet S-25
 - Retaining Walls - Reinforcement — Sheet S-26
 - Sub-Piers K1 to K6 incl. West Pipe Vault Addition — Sheet S-27
 - Sub-Piers K7 to K13 incl. East Pipe Vault Addition — Sheet S-29
 - Sub-Piers P1 to P12 incl. Lateral Supports for Water Mains — Sheet S-31

CITY OF CHICAGO
 DEPARTMENT OF PUBLIC WORKS
 BUREAU OF ENGINEERING
 SOUTH ROUTE SUPERHIGHWAY
 SECTION 5-262.2-1B
 HARRISON STREET BRIDGE
**RETAINING WALLS
 SUB-PIERS**
 SCALE: AS NOTED
 SHEET NO. 5-21 OF 70 SHEETS
 SEPTEMBER 1938

DESIGNED BY P. Solheim
 DRAWN BY H. H. Krueger
 CHECKED BY R. Graham
 APPROVED BY [Signature]

DETAIL OF SUB-PIER
 E6 to E25 incl.
 F6 to F24 incl.
 E26, E27, E28
 F25, F26, F27 shown in table

Sub-Pier No.	Elev. Top of C' Bars	Elev. Top of B' Bars
E6 to E25	+11.25	+5.25
E27	+7.25	+2.25
F26	+7.25	+2.75
E28	—	+2.50
F27	—	+2.75

FILE PATH = C:\Projects\119-0820 - Circle 60W26 AS-Built - Final\0160W26-sht-AS-BUILT-42.dgn