


FOR INFORMATION ONLY

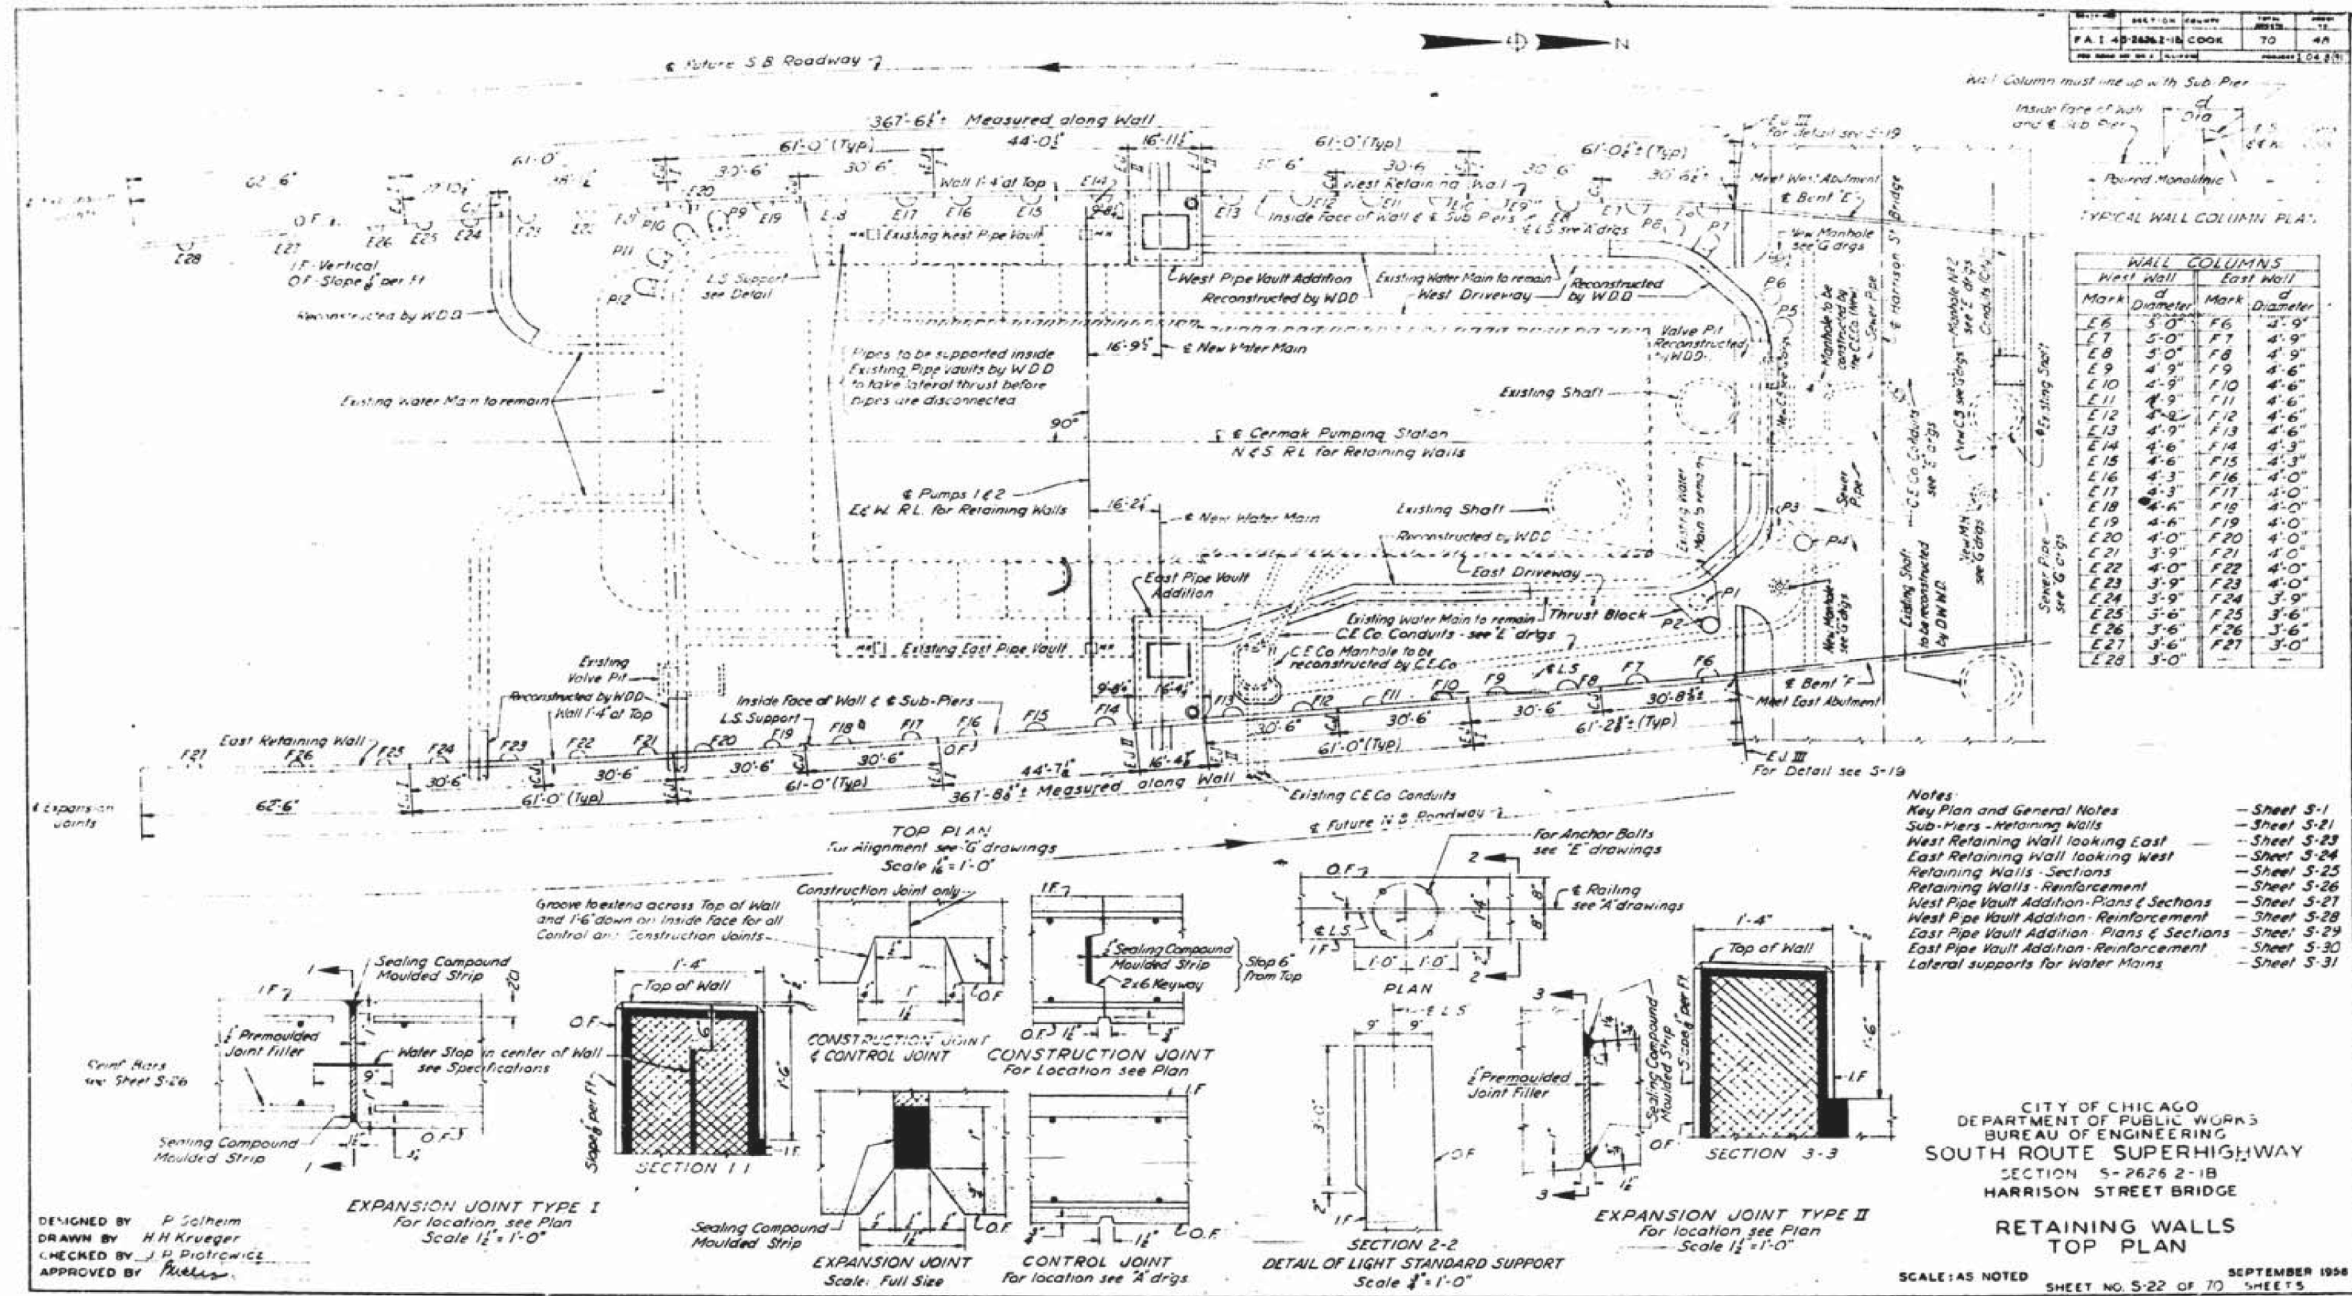

DESIGNED BY P. Solheim  
DRAWN BY H.H. Krueger  
CHECKED BY J.H. Piotrowicz  
APPROVED BY [Signature]

CITY OF CHICAGO  
DEPARTMENT OF PUBLIC WORKS  
BUREAU OF ENGINEERING  
SOUTH ROUTE SUPERHIGHWAY  
SECTION 5-2626 2-1B  
HARRISON STREET BRIDGE  
RETAINING WALLS  
TOP PLAN  
SCALE: AS NOTED  
SEPTEMBER 1996  
SHEET NO. S-22 OF 70 SHEETS

STATE OF ILLINOIS  
DEPARTMENT OF TRANSPORTATION

EXISTING AS-BUILTS SN 016-1087

D160W26-sht-AS-BUILT-43.dgn	DESIGNED -	REVISED -	F.A.I. RTE.	SECTION	COUNTY	TOTAL SHEETS	SHEET NO.
USER NAME = ayeuengh	DRAWN -	REVISED -	90/94/290	2013-008R	COOK	559	341
PLOT SCALE = 1:8000 1/4" = 1'	CHECKED -	REVISED -	CONTRACT NO. 60W26				
PLOT DATE = 8/16/2013	DATE - 07/15/13	REVISED -	SCALE: NTS	SHEET AS-43 OF AS-62 SHEETS	STA.	TO STA.	ILLINOIS FED. AID PROJECT

FILE PATH = C:\Project\15-0820 - Circle 60W26 As-Built - Final\016W26-sht-AS-BUILT-43.dgn