


FOR INFORMATION ONLY

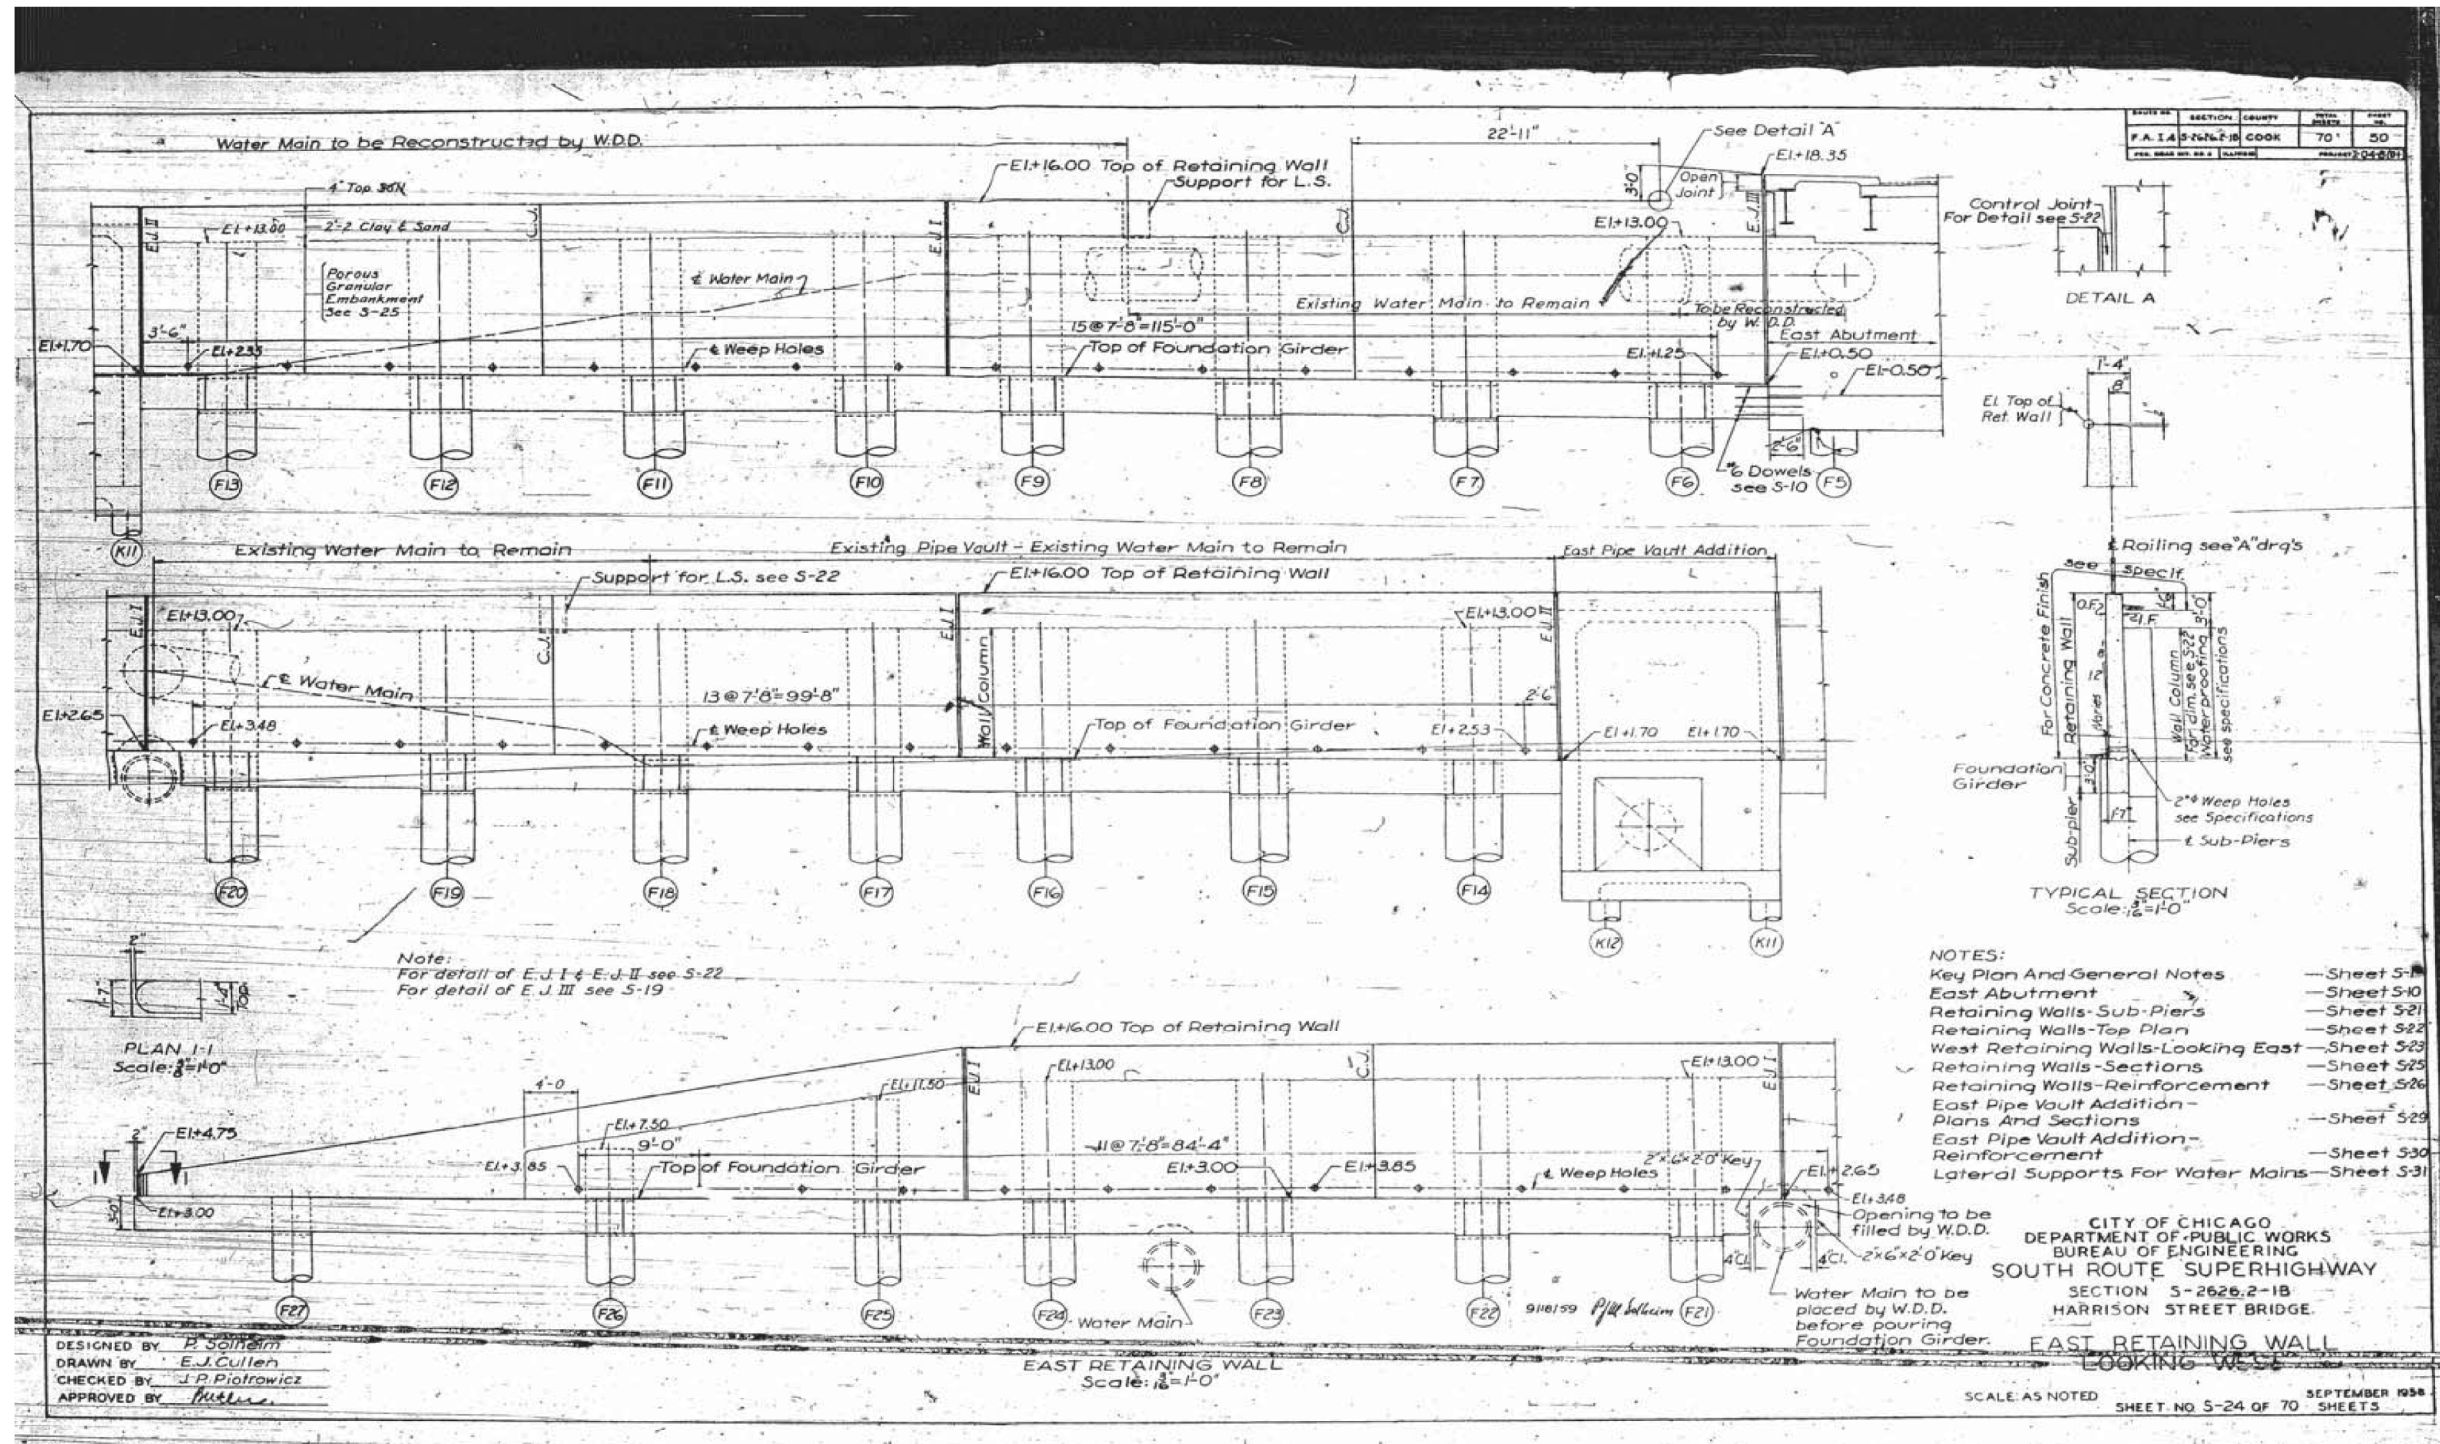

DESIGNED BY P. Scifrim
 DRAWN BY E.J. Cullen
 CHECKED BY J.P. Piotrowicz
 APPROVED BY *[Signature]*

- NOTES:
- Key Plan And General Notes — Sheet 5-1
 - East Abutment — Sheet 5-10
 - Retaining Walls-Sub-Piers — Sheet 5-21
 - Retaining Walls-Top Plan — Sheet 5-22
 - West Retaining Walls-Looking East — Sheet 5-23
 - Retaining Walls-Sections — Sheet 5-25
 - Retaining Walls-Reinforcement — Sheet 5-26
 - East Pipe Vault Addition — Sheet 5-29
 - Plans And Sections — Sheet 5-30
 - Reinforcement — Sheet 5-30
 - Lateral Supports For Water Mains — Sheet 5-31

CITY OF CHICAGO
 DEPARTMENT OF PUBLIC WORKS
 BUREAU OF ENGINEERING
 SOUTH ROUTE SUPERHIGHWAY
 SECTION 5-2626.2-1B
 HARRISON STREET BRIDGE.

EAST RETAINING WALL
 LOOKING WEST

SCALE: AS NOTED
 SHEET NO. 5-24 OF 70 SHEETS
 SEPTEMBER 1958

FILE PATH = C:\Projects\15-0820 - Circle 60W26 AS-BUILT - Circle 60W26 AS-BUILT - Circle 60W26 AS-BUILT - 45.dgn

D160W26-sht-AS-BUILT-45.dgn	DESIGNED -	REVISED -	STATE OF ILLINOIS DEPARTMENT OF TRANSPORTATION	EXISTING AS-BUILTS SN 016-1087		F.A.I. R.E.	SECTION	COUNTY	TOTAL SHEETS	SHEET NO.		
USER NAME = ayeung	DRAWN -	REVISED -		SCALE: NTS	SHEET AS-45 OF AS-62 SHEETS	STA.	TO STA.	90/94/290	2013-008R	COOK	559	343
PLOT SCALE = 1.0000' / in.	CHECKED -	REVISED -						CONTRACT NO. 60W26				
PLOT DATE = 8/16/2013	DATE - 07/15/13	REVISED -		ILLINOIS FED. AID PROJECT								