


FOR INFORMATION ONLY

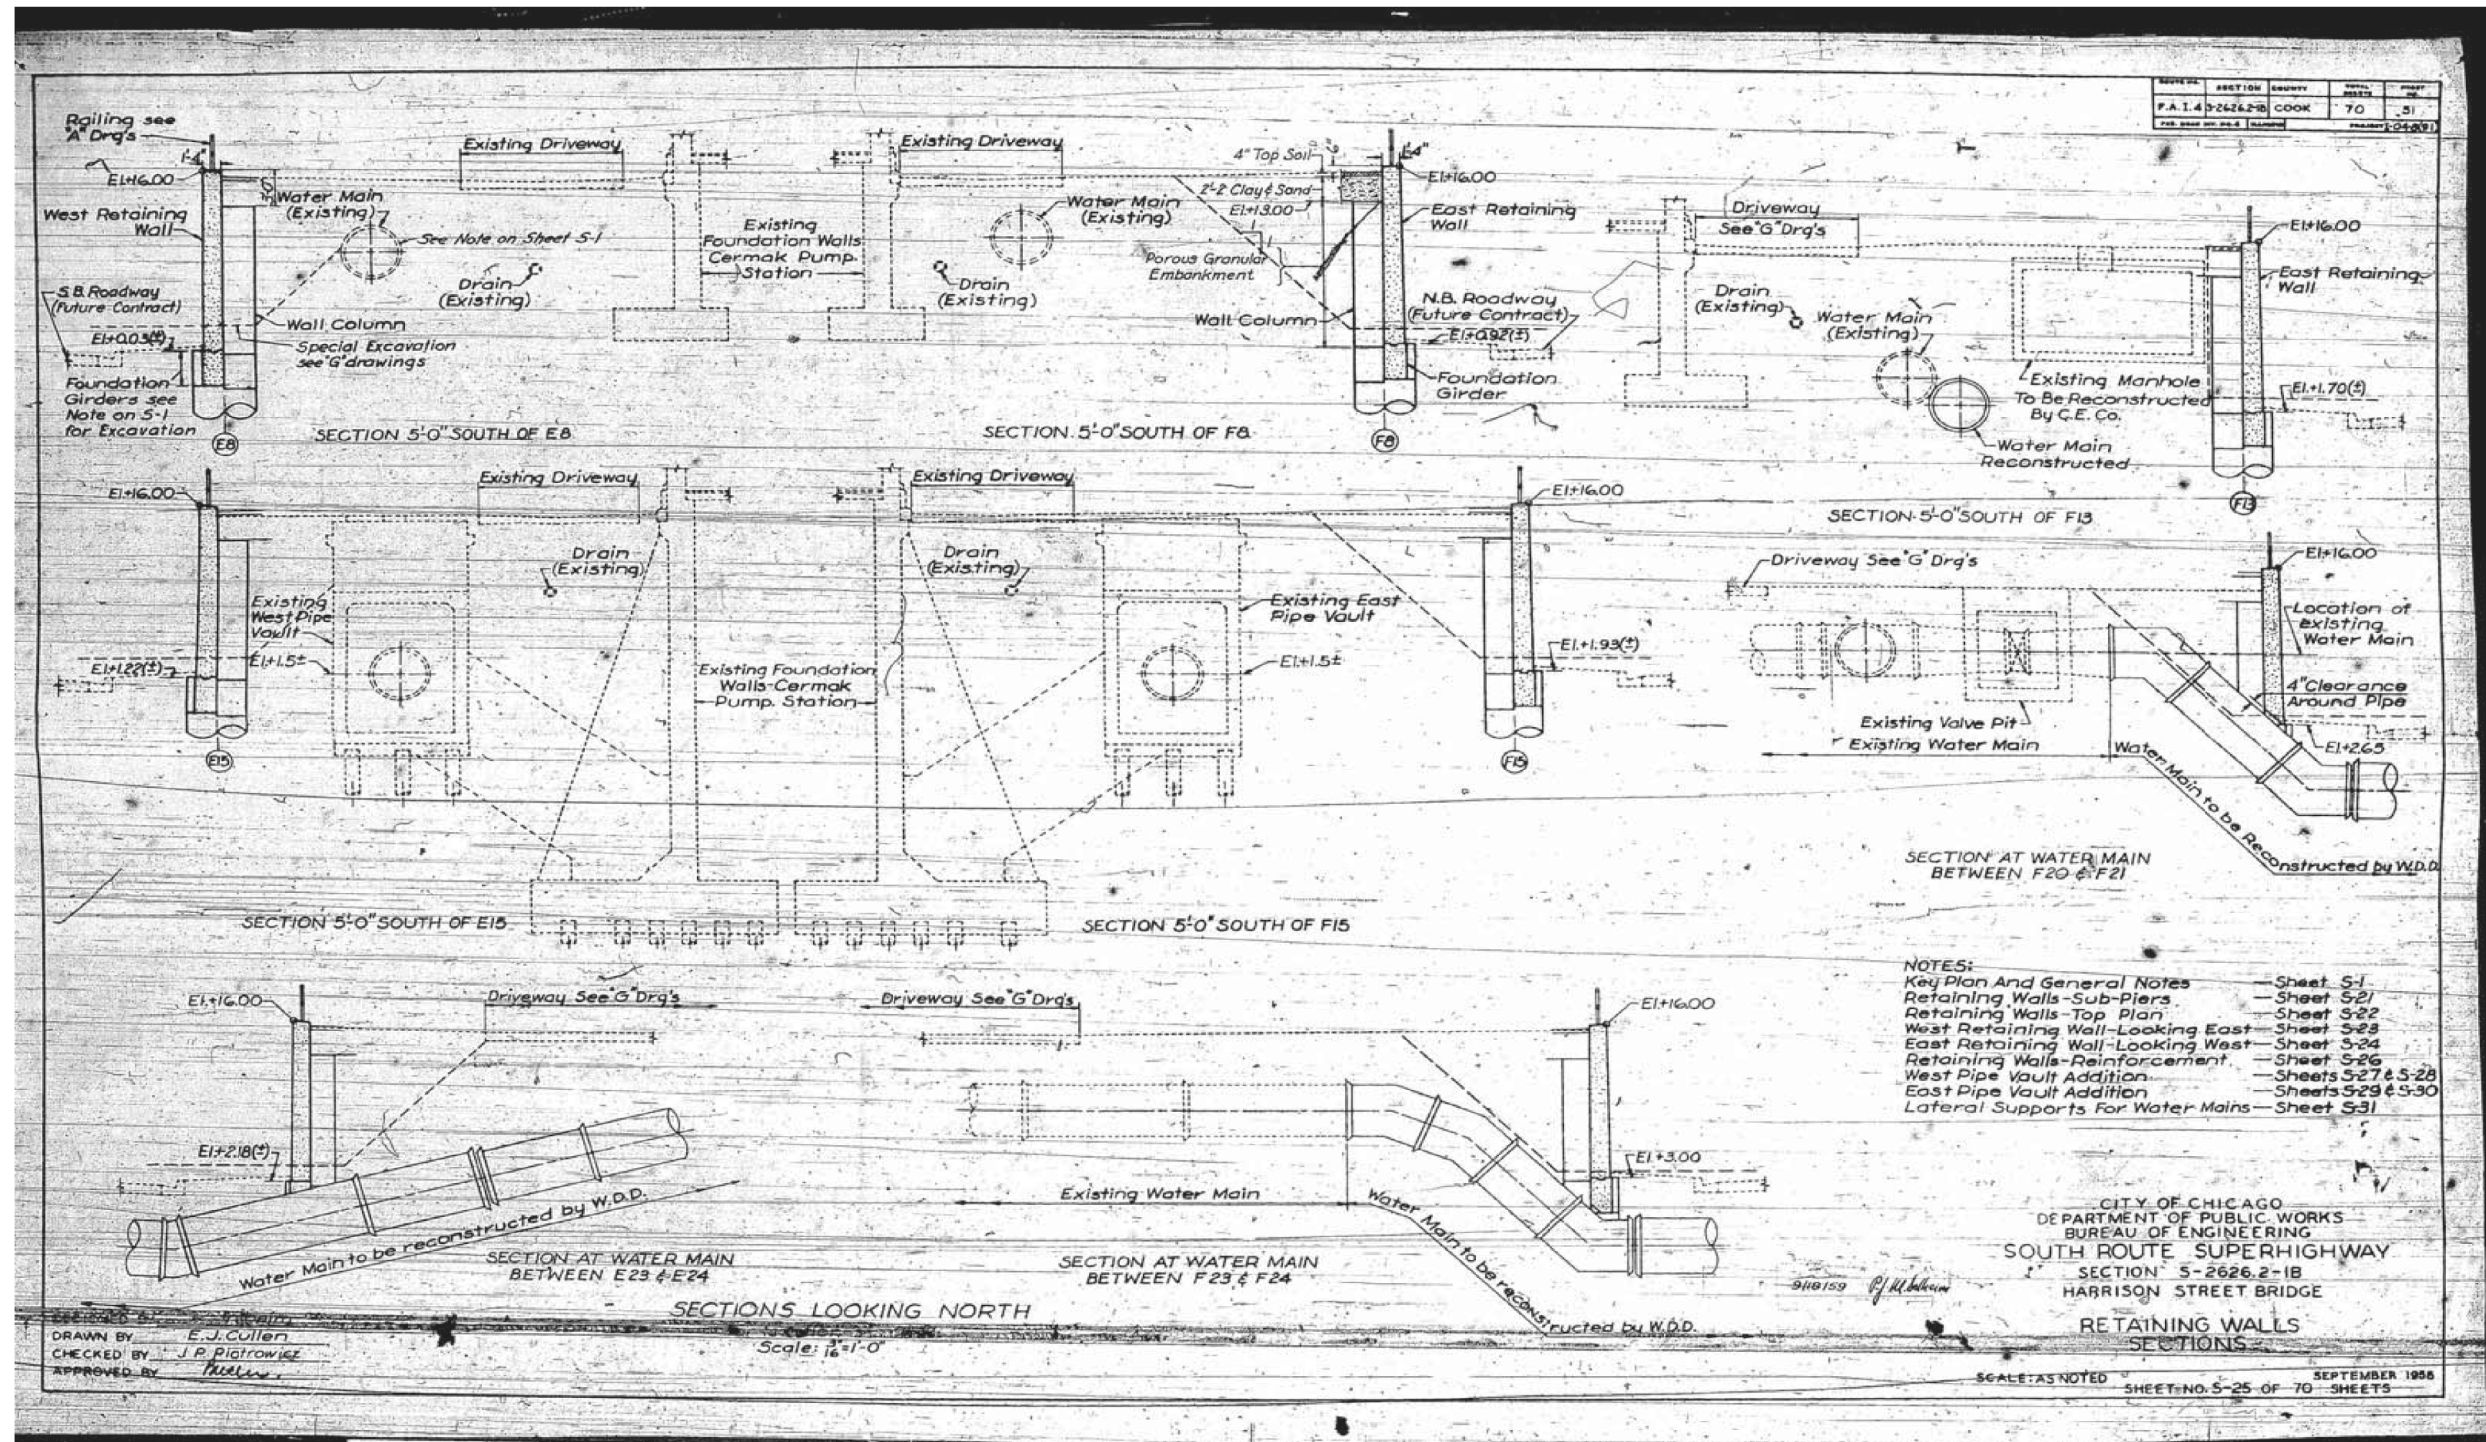

- NOTES:
- Key Plan And General Notes — Sheet S-1
 - Retaining Walls-Sub-Piers — Sheet S-21
 - Retaining Walls-Top Plan — Sheet S-22
 - West Retaining Wall-Looking East — Sheet S-23
 - East Retaining Wall-Looking West — Sheet S-24
 - Retaining Walls-Reinforcement — Sheet S-25
 - West Pipe Vault Addition — Sheets S-27 & S-28
 - East Pipe Vault Addition — Sheets S-29 & S-30
 - Lateral Supports For Water Mains — Sheet S-31

CITY OF CHICAGO
 DEPARTMENT OF PUBLIC WORKS
 BUREAU OF ENGINEERING
 SOUTH ROUTE SUPERHIGHWAY
 SECTION 5-2626.2-1B
 HARRISON STREET BRIDGE

RETAINING WALLS
 SECTIONS

SCALE: AS NOTED SHEET NO. 5-25 OF 70 SHEETS

DRAWN BY E.J. Cullen
 CHECKED BY J.P. Piotrowicz
 APPROVED BY [Signature]

Scale: 1/4"=1'-0"

FILE PATH = C:\Projects\119-0820 - Circle 60W26 AS-BUILT - Circle 60W26 AS-BUILT-46.dgn

D160W26-sht-AS-BUILT-46.dgn	DESIGNED -	REVISED -	STATE OF ILLINOIS DEPARTMENT OF TRANSPORTATION	EXISTING AS-BUILT SN 016-1087		F.A.I. R.E.	SECTION	COUNTY	TOTAL SHEETS	SHEET NO.
USER NAME = ayeunggh	DRAWN -	REVISED -		90/94/290	2013-008R	COOK	559	344		
PLOT SCALE = 1,0000' / in.	CHECKED -	REVISED -		SCALE: NTS SHEET AS-46 OF AS-62 SHEETS STA. TO STA.			CONTRACT NO. 60W26			
PLOT DATE = 8/16/2013	DATE - 07/15/13	REVISED -		ILLINOIS FED. AID PROJECT						