


FOR INFORMATION ONLY

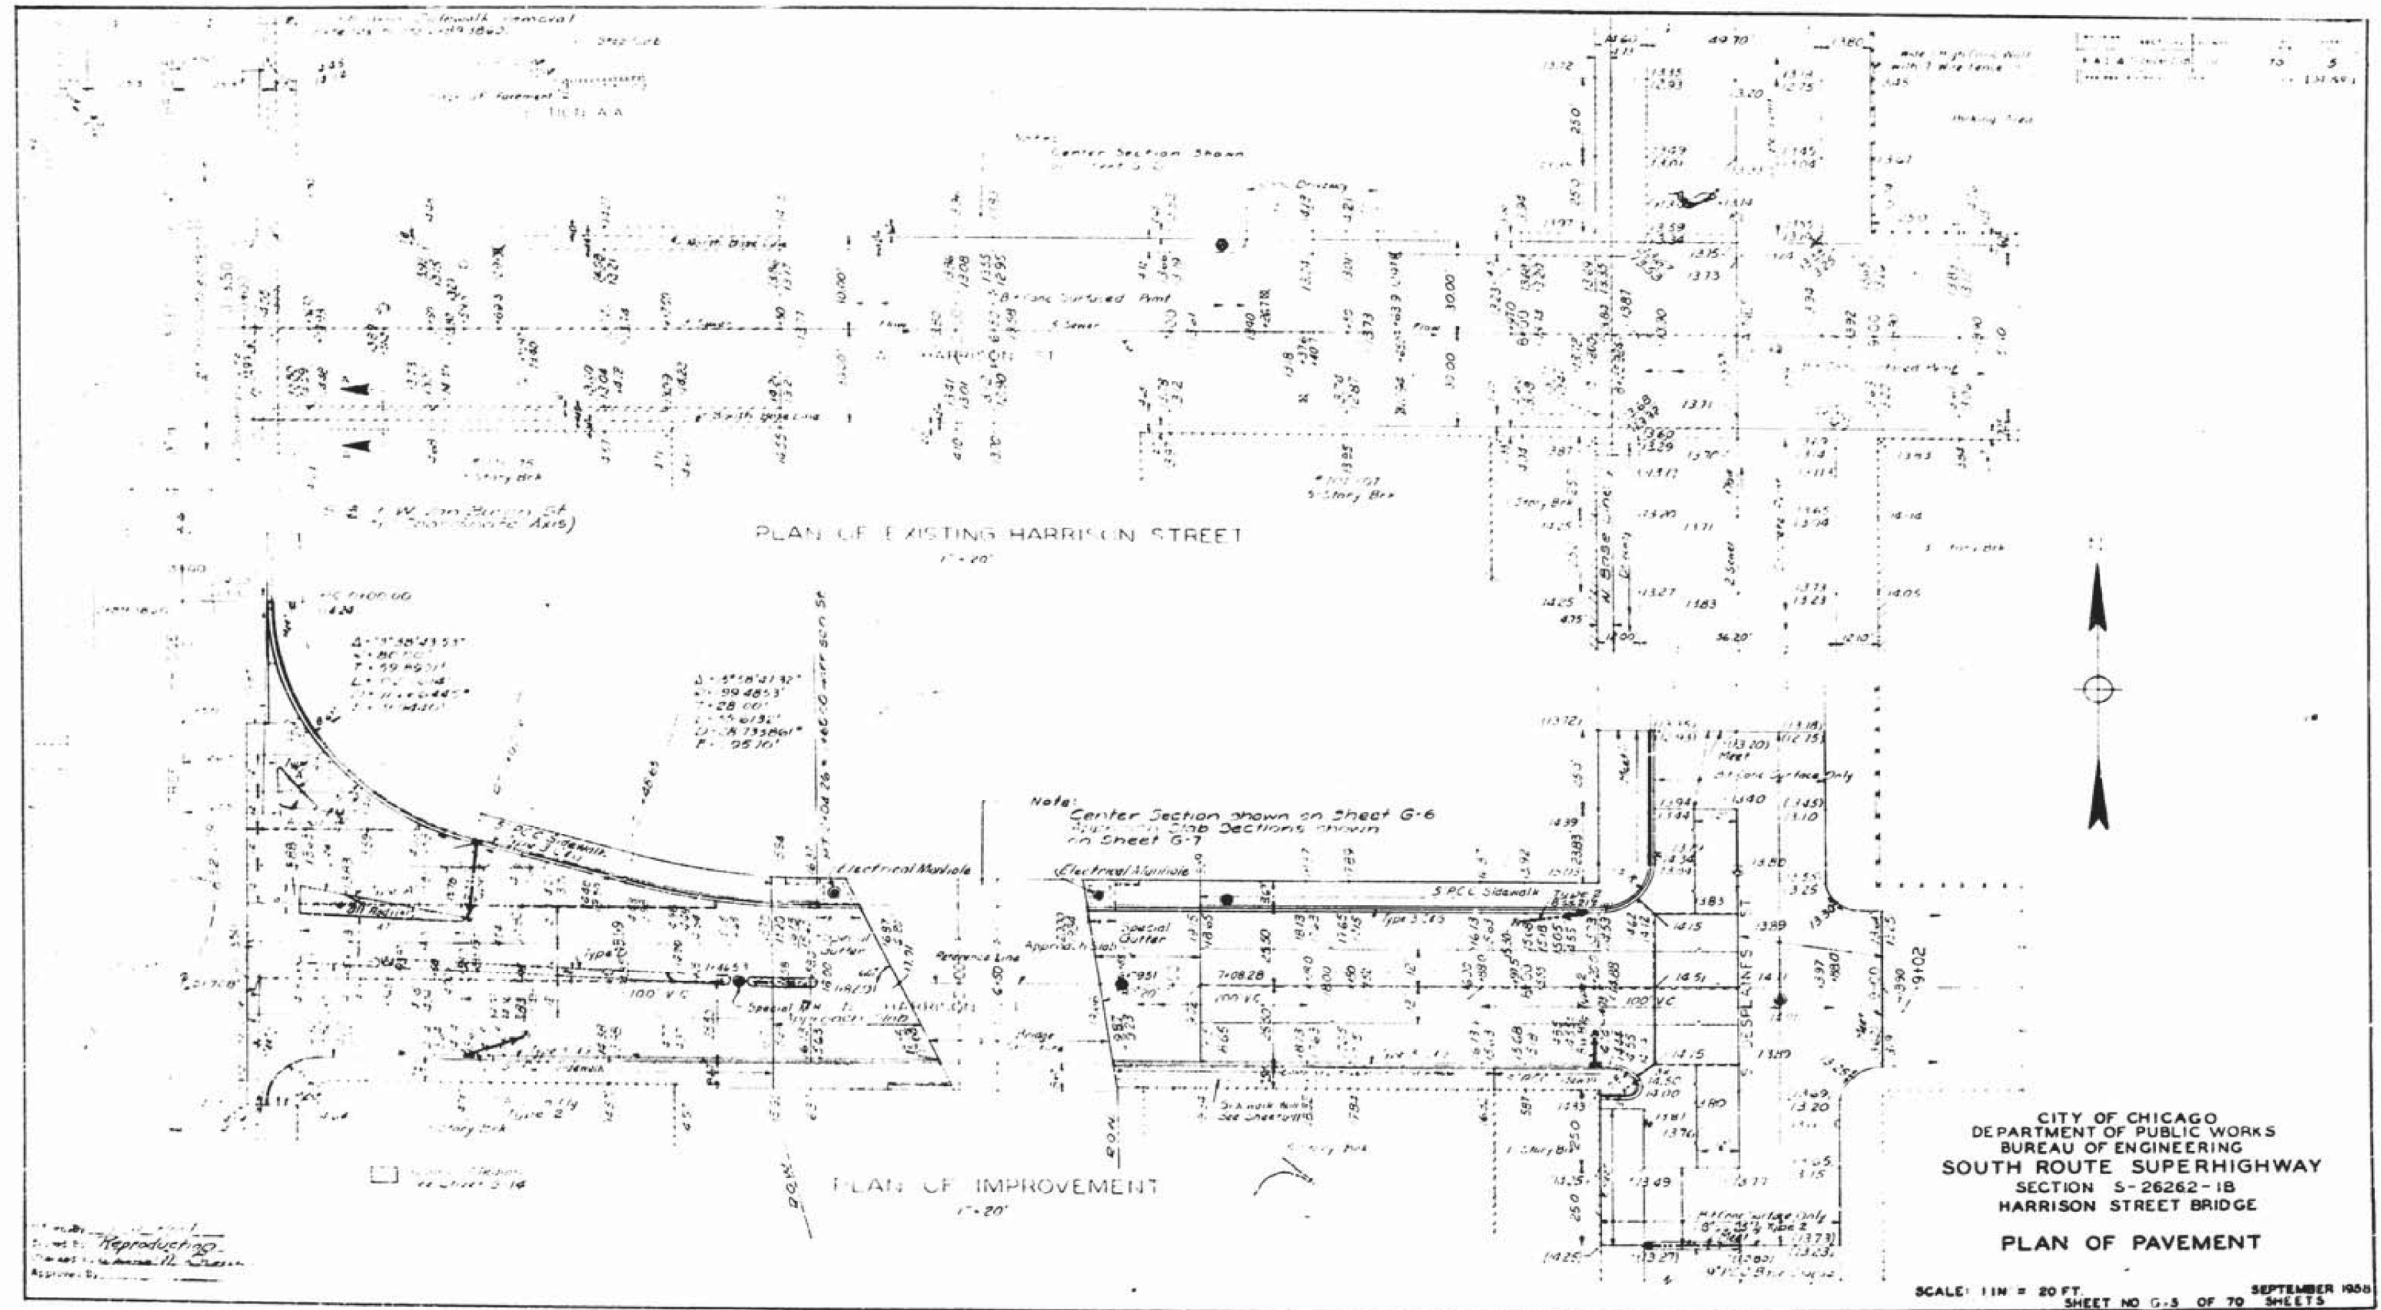

FILE PATH = C:\Projects\13-0820 - Circle 60W26 AS-Built\Final\016W26-sht-AS-BUILT-58.dgn

D160W26-sht-AS-BUILT-58.dgn	DESIGNED -	REVISED -
USER NAME = ayejeungh	DRAWN -	REVISED -
PLOT SCALE = 1.0000' / in.	CHECKED -	REVISED -
PLOT DATE = 8/16/2013	DATE - 07/15/13	REVISED -

STATE OF ILLINOIS
DEPARTMENT OF TRANSPORTATION

EXISTING AS-BUILT SN 016-1087

SCALE: NTS SHEET AS-58 OF AS-62 SHEETS STA. TO STA.

F.A.I. RTE.	SECTION	COUNTY	TOTAL SHEETS	SHEET NO.
90/94/290	2013-008R	COOK	559	356
CONTRACT NO. 60W26				
ILLINOIS FED. AID PROJECT				