


FOR INFORMATION ONLY

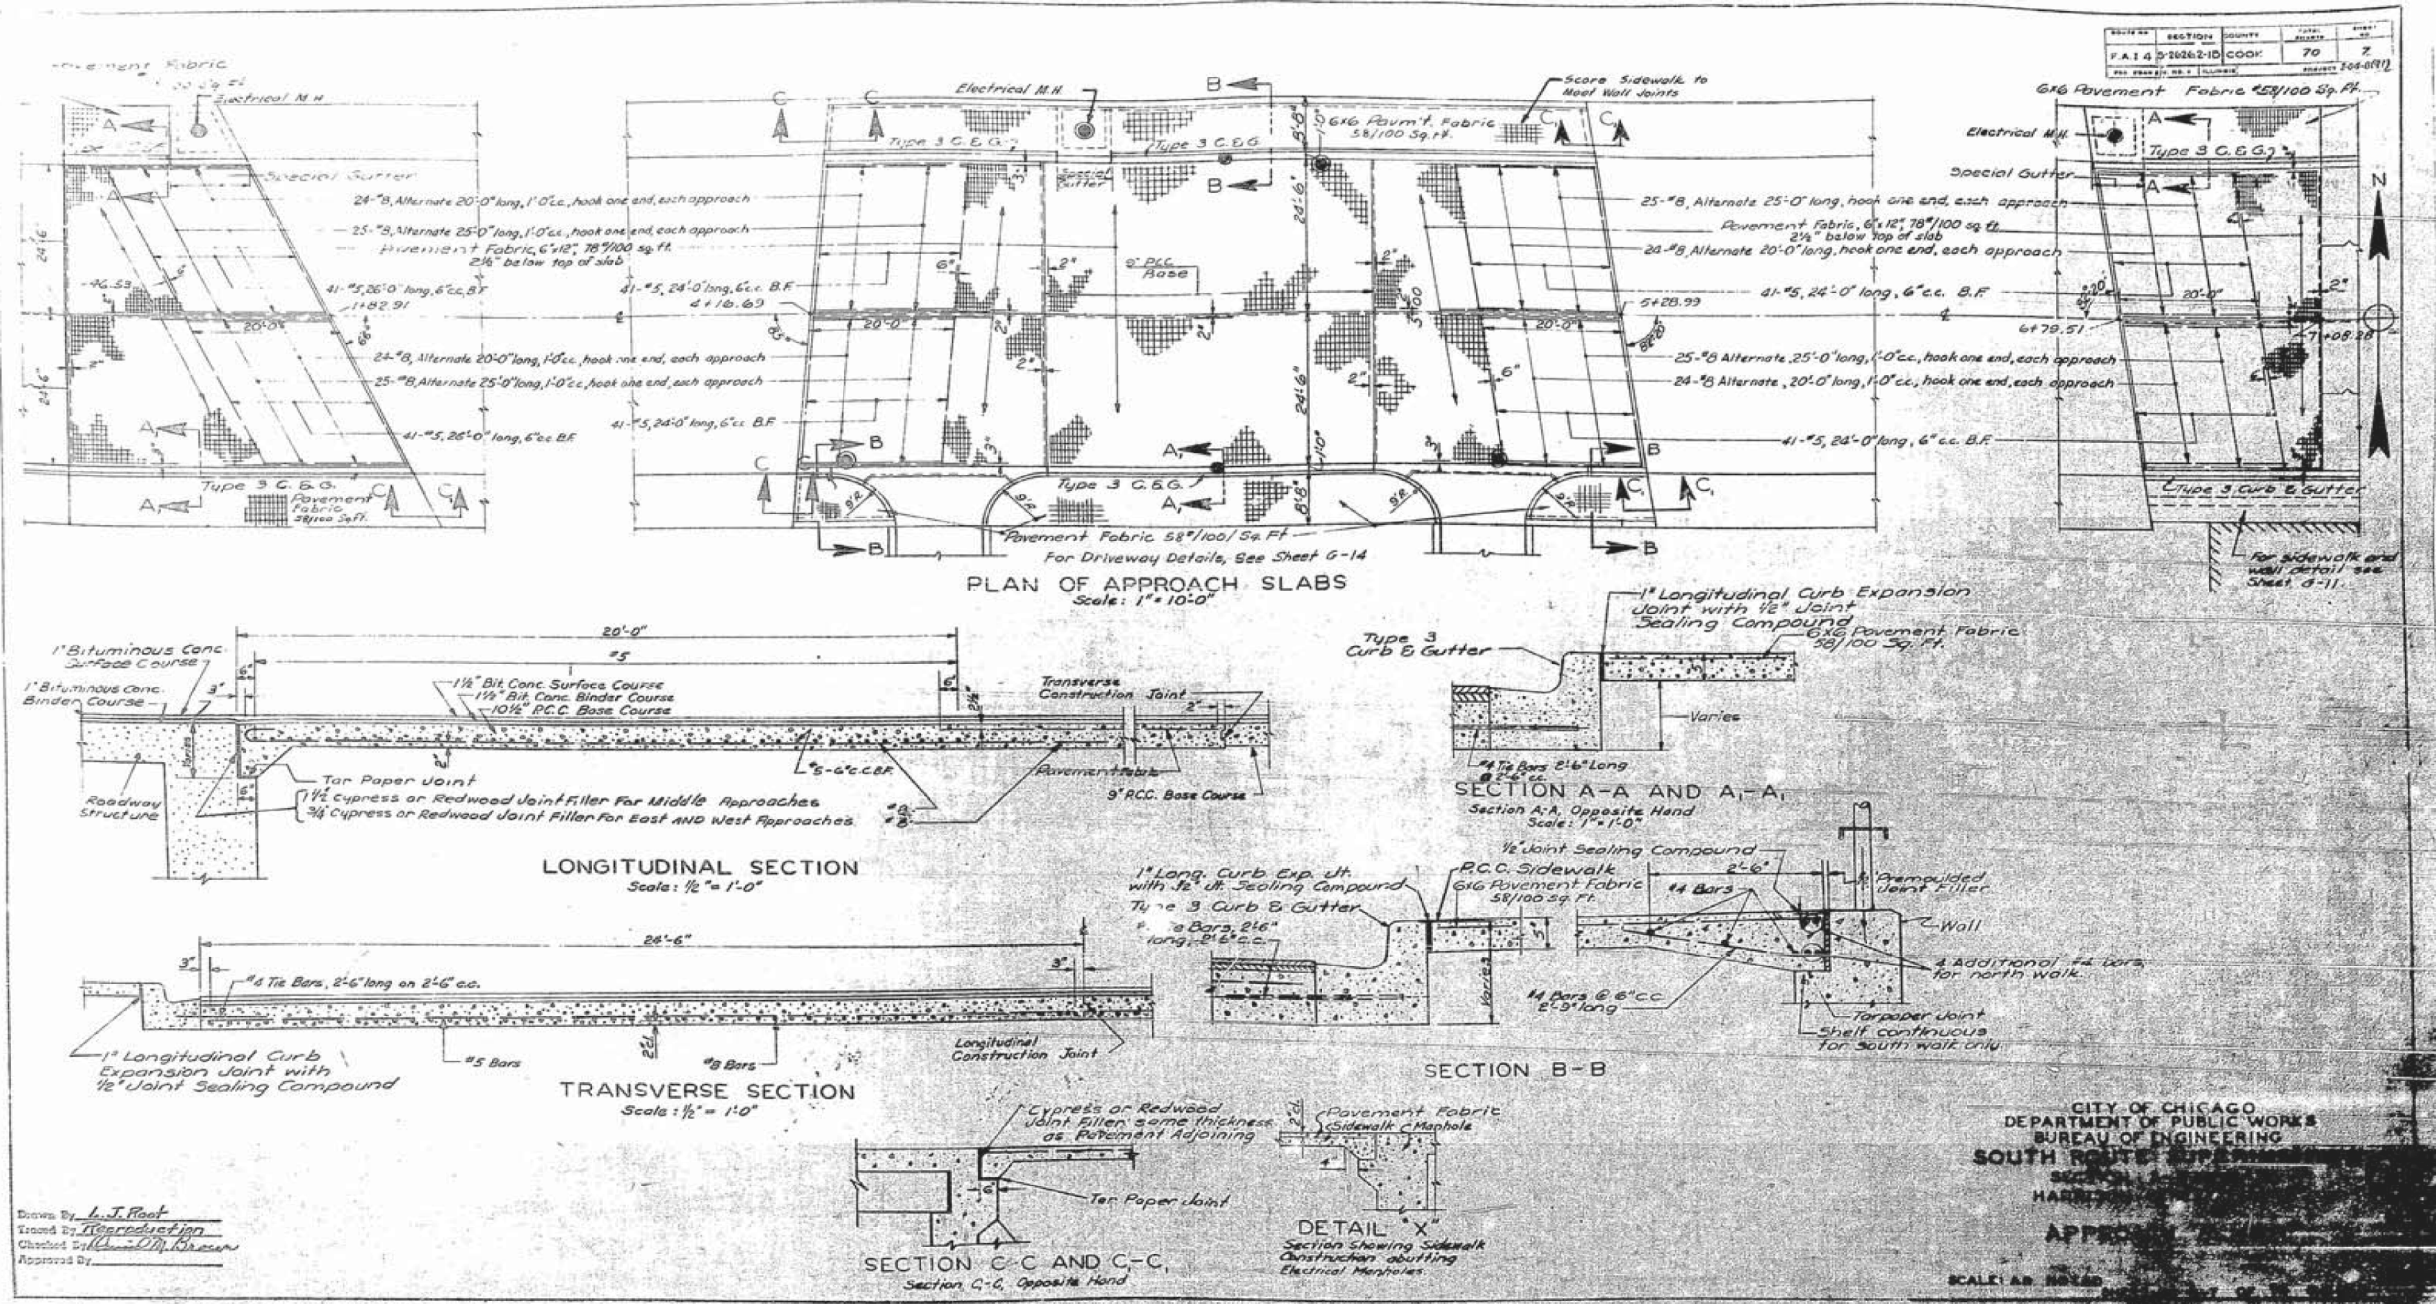

Drawn By: L.J. Root  
 Traced By: Reproduction  
 Checked By: [Signature]  
 Approved By: [Signature]

CITY OF CHICAGO  
 DEPARTMENT OF PUBLIC WORKS  
 BUREAU OF ENGINEERING  
 SOUTH ROUTE 1  
 HARRISBURG, ILL.

STATE OF ILLINOIS  
 DEPARTMENT OF TRANSPORTATION

EXISTING AS-BUILTS SN 016-1087

D160W26-sht-AS-BUILT-60.dgn	DESIGNED -	REVISED -
USER NAME = ayeueungh	DRAWN -	REVISED -
PLOT SCALE = 1:8000 / 1 in.	CHECKED -	REVISED -
PLOT DATE = 8/16/2013	DATE - 07/15/13	REVISED -

SCALE: NTS	SHEET AS-60 OF AS-62 SHEETS	STA.	TO STA.
------------	-----------------------------	------	---------

F.A.I. R.T.E.	SECTION	COUNTY	TOTAL SHEETS	SHEET NO.
90/94/290	2013-008R	COOK	559	358
CONTRACT NO. 60W26				
ILLINOIS FED. AID PROJECT				

FILE PATH = C:\Project\ase\15-0820 - Circle 60W26 As-Built - Circle 60W26-sht-AS-BUILT-60.dgn