


STATE OF ILLINOIS
 DEPARTMENT OF PUBLIC WORKS & BUILDINGS
 DIVISION OF HIGHWAYS

DESIGNER	DATE	SHEET NO.	TOTAL SHEETS
ASA	44	26	6

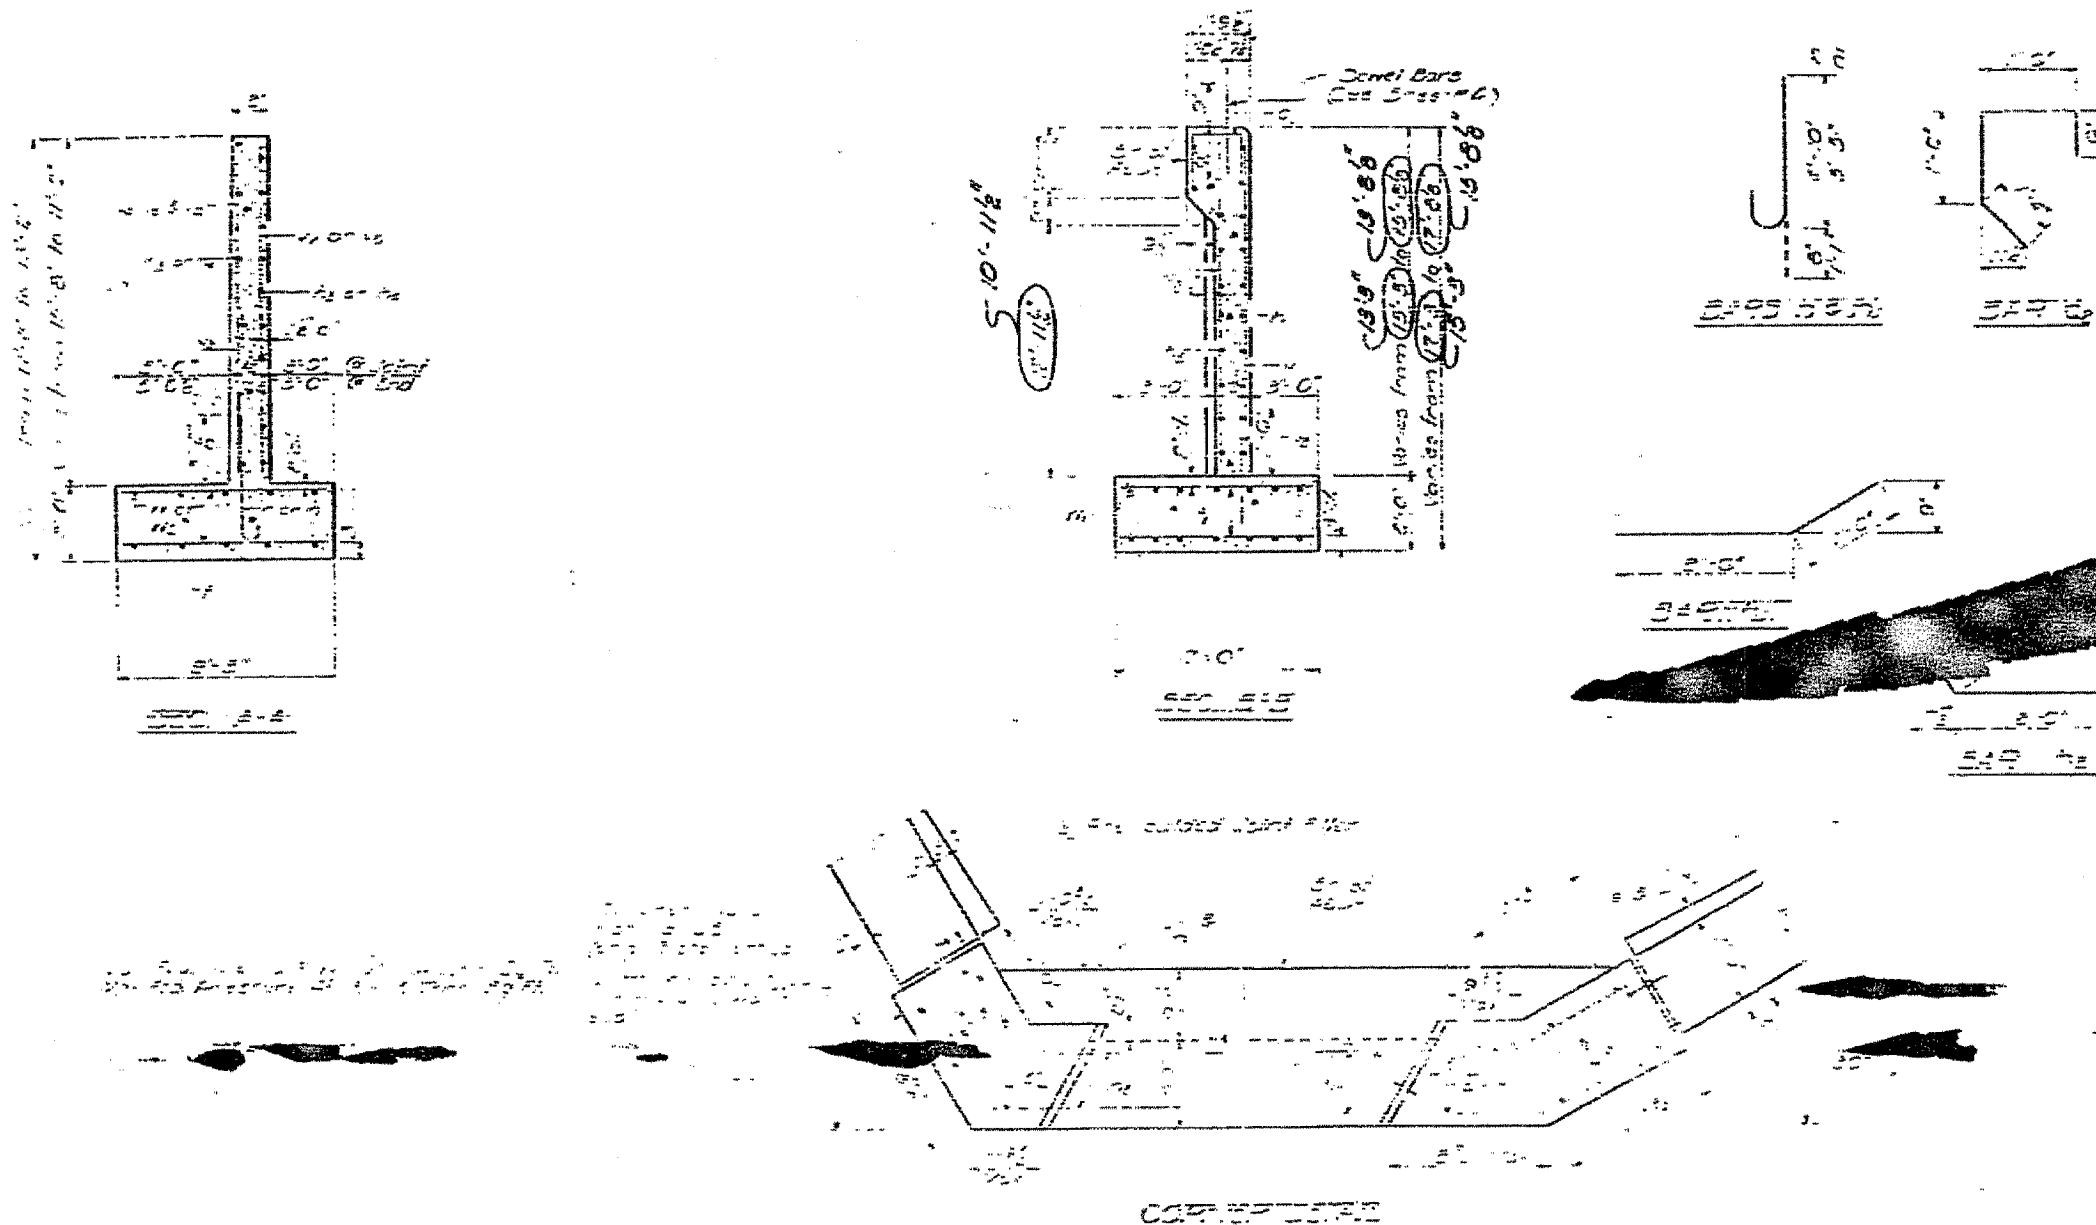

THE REINFORCEMENTS
LIST OF MATERIAL

NO.	QTY	SIZE	LENGTH	REMARKS
1	20	1/2"	25'-0"	
2	20	1/2"	25'-0"	
DESIGNED	DATE	BY
CHECKED	DATE	BY
APPROVED	DATE	BY

DRAWN BY: ASA
 DATE: 12-15-44
 APPROVED: [Signature]
 DATE: 12-15-44

FOR INFORMATION ONLY
AS BUILT