


F.A.I. RTE.	SECTION	COUNTY	TOTAL SHEETS	SHEET NO.
74	.	VERMILION	13	4

*92(11,12,12-1)RS-1.I

AS-BUILT TYPICAL RAMP CROSS SECTION BOWMAN AVENUE INTERCHANGE

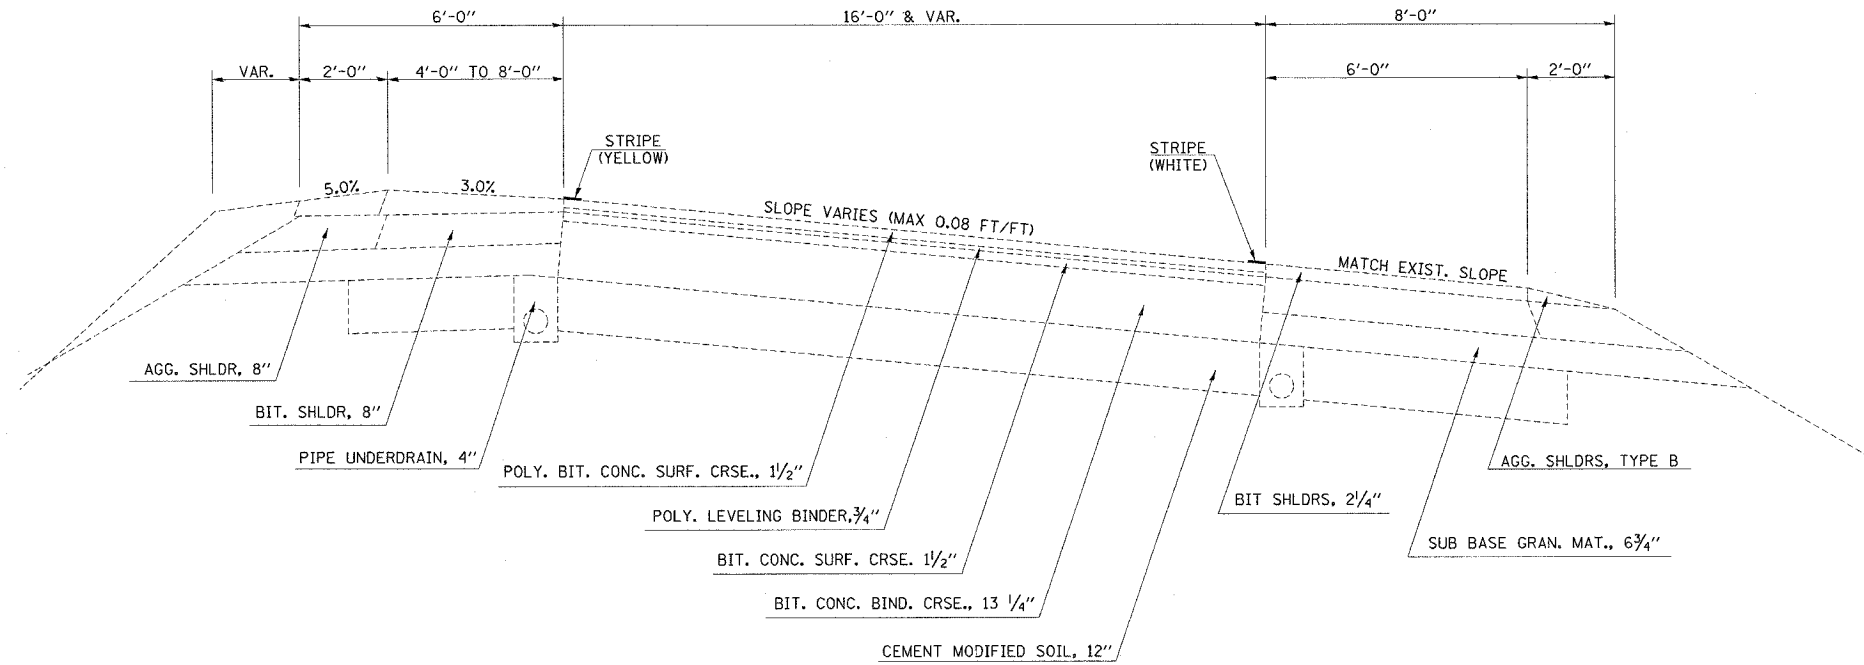

PROPOSED TYPICAL RAMP CROSS SECTION BOWMAN AVENUE INTERCHANGE

