


F.A.P. RTE.	SECTION	COUNTY	TOTAL SHEETS	SHEET NO.
309	7HBR-1 & 7VBR	WHITESIDE	146	90
STA.		TO STA.		
FED. ROAD DIST. NO.		ILLINOIS FED. AID PROJECT		

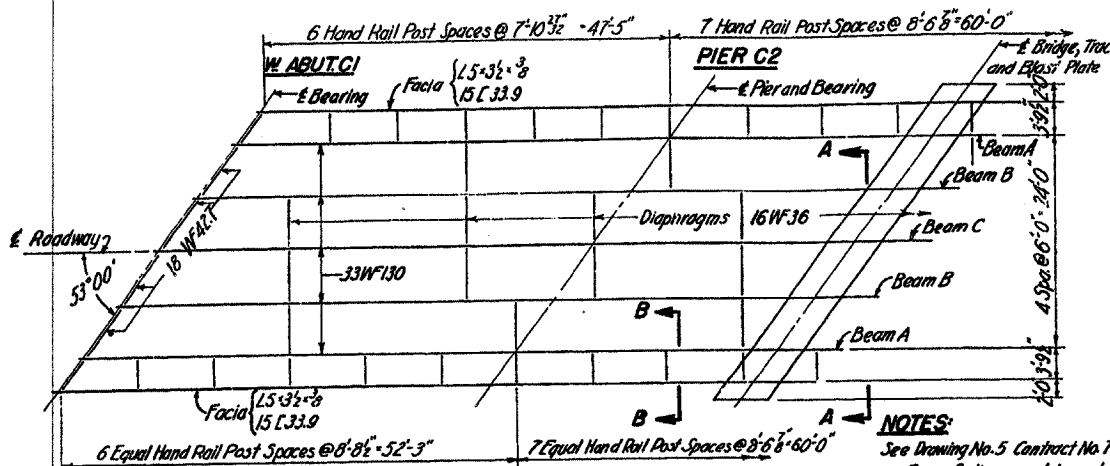

PLAN OF STEEL LAYOUT
Symmetrical by Rotation About ϵ of Bridge Except for Splice.
Scale: 1" = 10'-0"

W. ABUT. C1 REACTION		PIER C2 REACTION		ELEVATION BEAM A	
DL	20	65	65	DL	154
LL	23	28	28	LL	207
I	7	8	8	I	56
SW	4	11	11	SW	41
TOTAL	54	112	112	TOTAL	458



0.4L MOMENT		0.5L MOMENT	
DL	189	DL	154
LL	210	LL	207
I	60	I	56
SW	41	SW	41
TOTAL	500	TOTAL	458

Use 33WF130 S.M. Furnished = 335
With 4 Pls. 4x8 S.M. Furnished = 400


W. ABUT. C1 REACTION		PIER C2 REACTION		ELEVATION BEAMS B & C	
DL	13	41	41	DL	97
LL	33	40	40	LL	298
I	9	11	11	I	81
TOTAL	55	92	92	TOTAL	476

0.4L MOMENT		0.5L MOMENT	
DL	120	DL	97
LL	302	LL	298
I	86	I	81
TOTAL	508	TOTAL	476

Use 33WF130 S.M. Furnished = 404

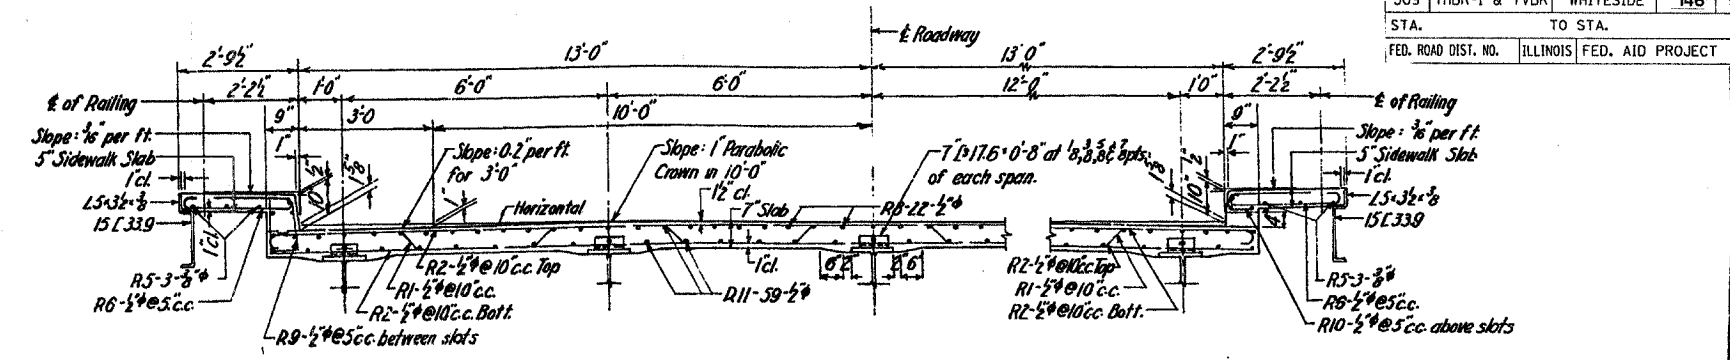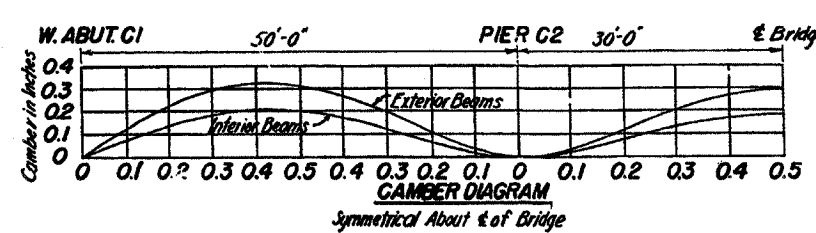


CROSS SECTION OF ROADWAY
Scale: 1/2" = 1'-0"

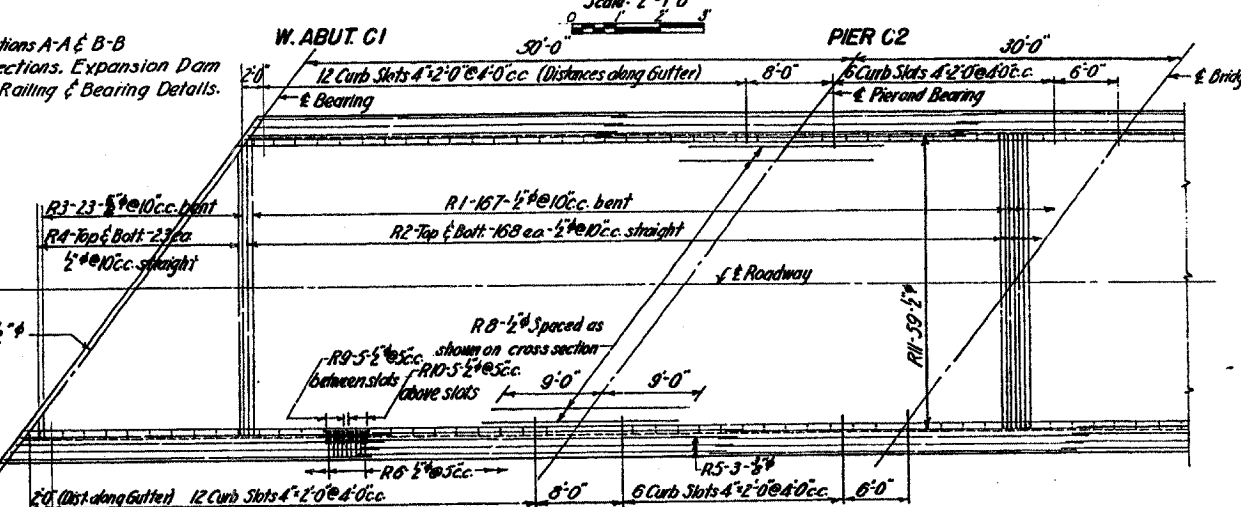

PLAN SHOWING REINFORCEMENT & LOCATION OF CURB SLOTS
Symmetrical by Rotation About ϵ of Bridge
Scale: 5/8" = 1'-0"

Mark	No.	Stock	Bend
R1	167	1/2" x 29'-8"	Bent - See Detail
R2	336	1/2" x 27'-4"	Straight
R3	46	5/8" x 15'-6 1/2" ax	Bent - See Detail
R4	92	1/2" x 14'-1"	Straight - See Detail
R5	30	3/8" x 33'-10"	Straight
R6	780	1/2" x 3'-0 1/2"	Bent - See Detail
R7	4	1/2" x 34'-0"	Straight
R8	44	1/2" x 18'-0"	Straight
R9	434	1/2" x 4'-8"	Bent - See Detail
R10	380	1/2" x 2'-8 1/2"	Bent - See Detail
R11	295	1/2" x 33'-10"	Straight
R12	60	3/8" x 2'-8"	Bent - See Detail

GENERAL NOTES:
Live Load: H20-S16 applied in accordance with the 1949 A.A.S.H.O. Specifications.
Unit Stresses: in accordance with the 1949 A.A.S.H.O. Specifications, except as noted below.
Rivet Blanks: Shear 12,000 lbs. per sq. inch.
Bearing 24,000 lbs. per sq. inch.
Material: All material is medium carbon steel A.S.T.M. Designation A7-50T.
Camber: Beams shall be cambered for dead load in accordance with camber diagram.
Reactions are given in kips.
Moments are given in kip-feet.
Diaphragms and expansion dams are normal to grade.
Rivets are 5/8" except as noted.
Concrete in roadway shall be Class A.
All reinforcing bars shall be of deformed type A.S.T.M. A305-50T. Lapped 40 diameters at splices.
1/2" top coverage over roadway steel includes 1/2" integral wearing surface.
Blast plate is Wrought Iron

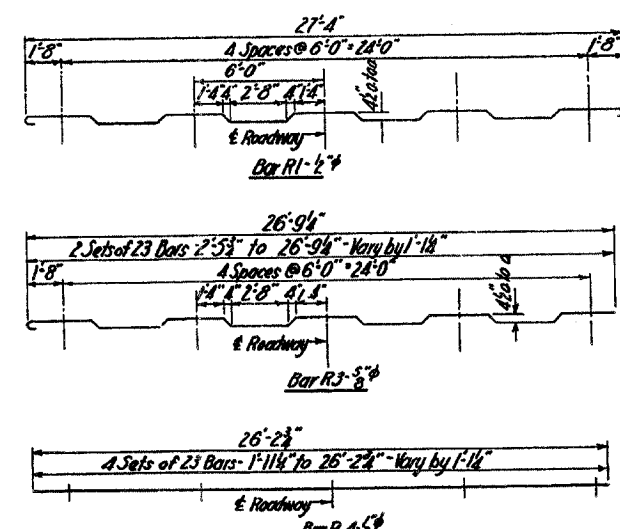

BAR DETAILS

STANDARD HOOK DETAIL

APPROVED: *F. M. Masters*
FOR MODJESKI & MASTERS

MISSISSIPPI RIVER BRIDGE
AT CLINTON, IOWA
CITY OF CLINTON BRIDGE COMMISSION
SUPERSTRUCTURE
C. & N.W. R.R. OVERPASS

CONTRACT NO. 7 DRAWING NO. 10
MODJESKI & MASTERS ENGINEERS
OCTOBER, 1951

THIS DRAWING REVISED JAN 1957 TO SHOW THE WORK AS CONSTRUCTED