


# FOR INFORMATION ONLY

STATE OF ILLINOIS  
DEPARTMENT OF PUBLIC WORKS & BUILDINGS  
DIVISION OF HIGHWAYS

PROJECT	SECTION	PLAN	TOTAL SHEETS	SHEET NO.
62-ZB	MCLEAN	8	5	3 SHEETS

B.M. #1 - Top of Fire Hydrant at S.W. Corner of Main and Virginia Streets - Elev. 53.83 (Normal City Datum)  
Existing Bridge: 3 R.C. Slab spans @ 18'1" 30'4" Rdwy. on R.C. Piers and closed Abuts. Remove Superstructure and other concrete as shown on plans.

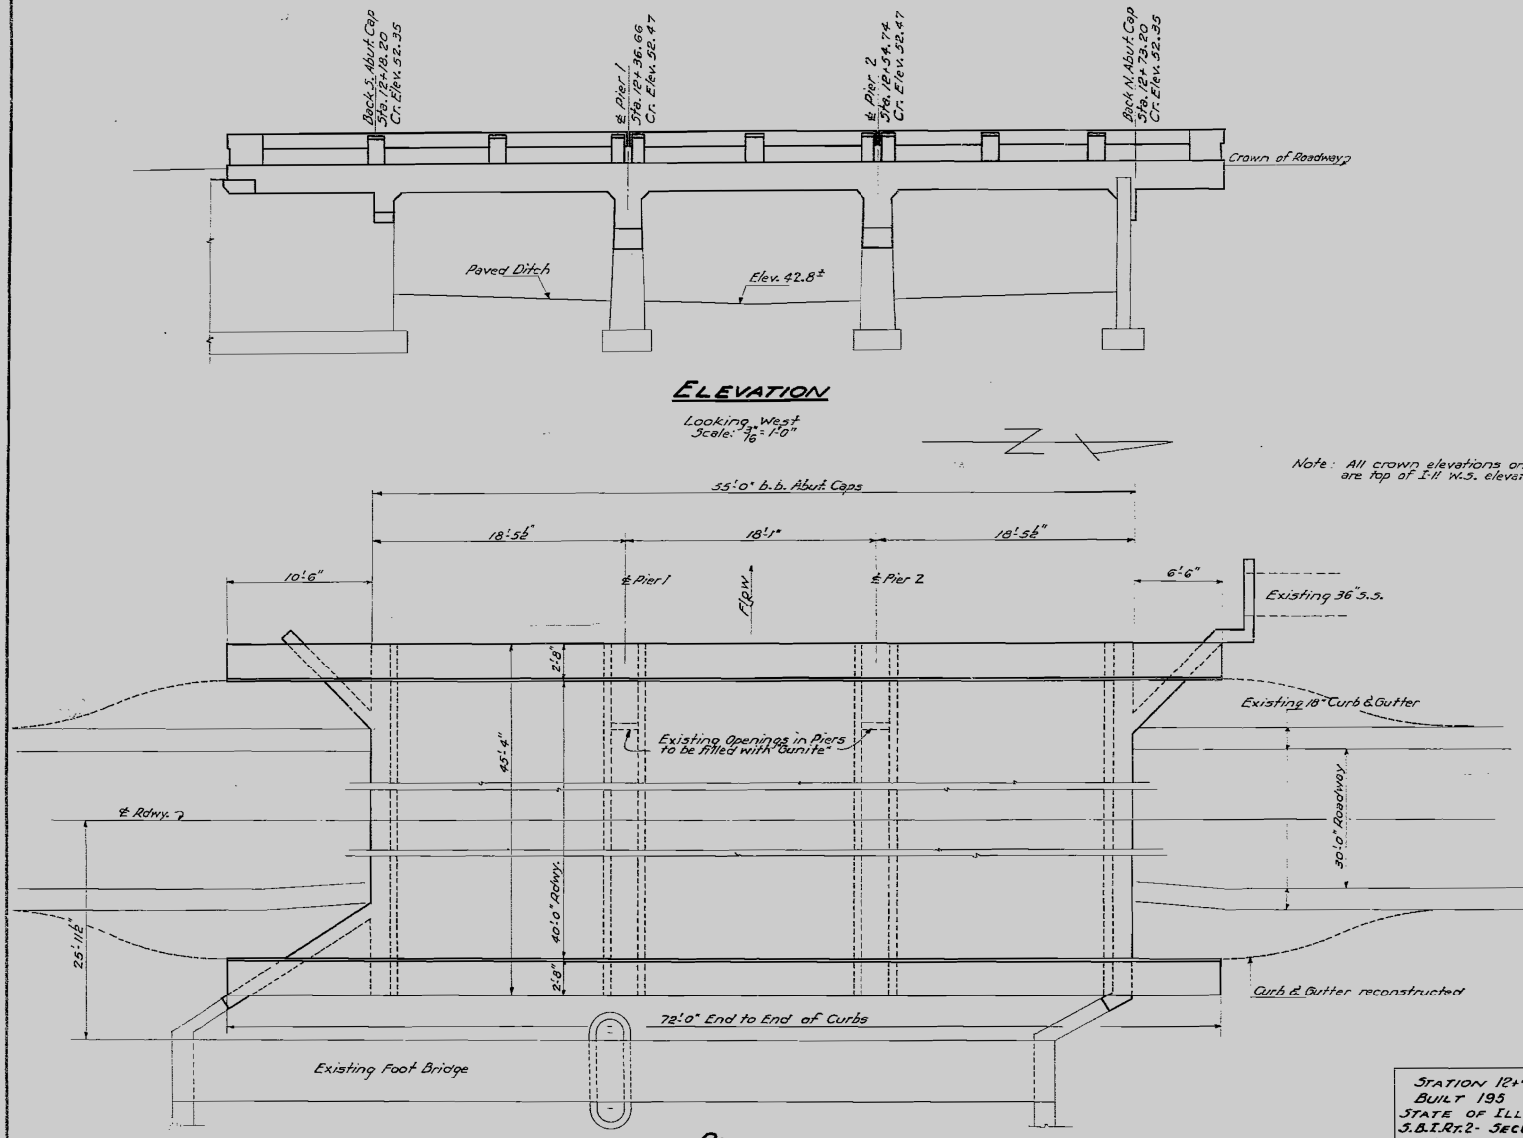


**GENERAL NOTES**  
Class-X Concrete shall be used throughout except in Handrails. Handrail Concrete shall be used in Handrails. This Concrete Floor Slab shall be finished in accordance with the applicable provisions of Section 28 of the Standard Specifications. Floor slab, curbs, abutment and pier caps shall be poured monolithically. For Expansion Bolts see Special Provisions.

**TOTAL BILL OF MATERIAL**

ITEM	UNIT	TOTAL
Class-X Concrete	Cu. Yds.	136.0
Handrail Concrete	Cu. Yds.	3.5
Reinforcement Bars	Lbs.	32290
Expansion Bolts	Each	5
Masonry Removal	Cu. Yds.	16
Removal of Existing Superstructure	Each	1
Bituminous Surface Course, Subclass E-II	Tons	20.2
Name Plates	Each	1
Cement	Sacks	10

STATION 12+45.70  
BUILT 195 BY  
STATE OF ILLINOIS  
S.B.I.Rt.2 - SEC 62-ZB  
LOADING 120-316

LETTERING FOR NAME PLATE  
See Standard 213

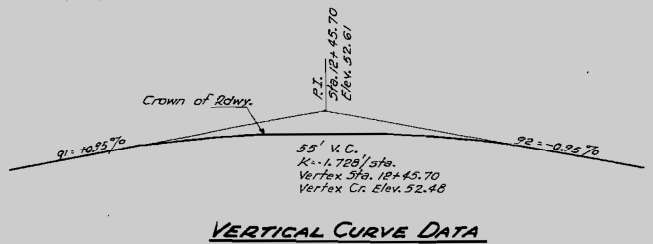

**STRESSES**  
f<sub>c</sub> - 1400 PSI - Sub. & Super  
f<sub>s</sub> - 20000 PSI - Reinforcement Bars  
n - 10

**GENERAL PLAN & ELEVATION  
MAIN STREET BRIDGE IN NORMAL  
S.B.I. RT. 2 - SECTION 62-ZB  
MCLEAN COUNTY  
STA. 12+45.70**

DESIGNED	J. S. Harris	EXAMINED	[Signature]
CHECKED	[Signature]	PASSED	[Signature]
DRAWN	J. S. H. Miller	APPROVED	[Signature]
CHECKED	[Signature]		



USER NAME = ceorlockjd  
FILE NAME = #FILES#  
PLOT SCALE = 2.0000' / in.  
PLOT DATE = 8/12/2014

DESIGNED - MRS  
DRAWN - MRS  
CHECKED - AJK  
DATE - 1/25/13

REVISED - BJH 7/28/2014  
REVISED  
REVISED  
REVISED

STATE OF ILLINOIS  
DEPARTMENT OF TRANSPORTATION

EXISTING GENERAL PLAN AND ELEVATION (FROM AS-BUILT PLANS)

SCALE: NTS SHEET NO. 1 OF 1 SHEETS STA. 195+16 TO STA. 199+76.4

F.A.P. RTE.	SECTION	COUNTY	TOTAL SHEETS	SHEET NO.
730	62-ZBR	MCLEAN	65	51
CONTRACT NO. 70540				

ILLINOIS FED. AID PROJECT