


PROJECT NO.	SECTION	DATE	BY
F.A.I. 26-2626.5-3D	COOK	41	M-2
FILE NAME	DATE	PROJECT	NO.
		2-26-09	1240

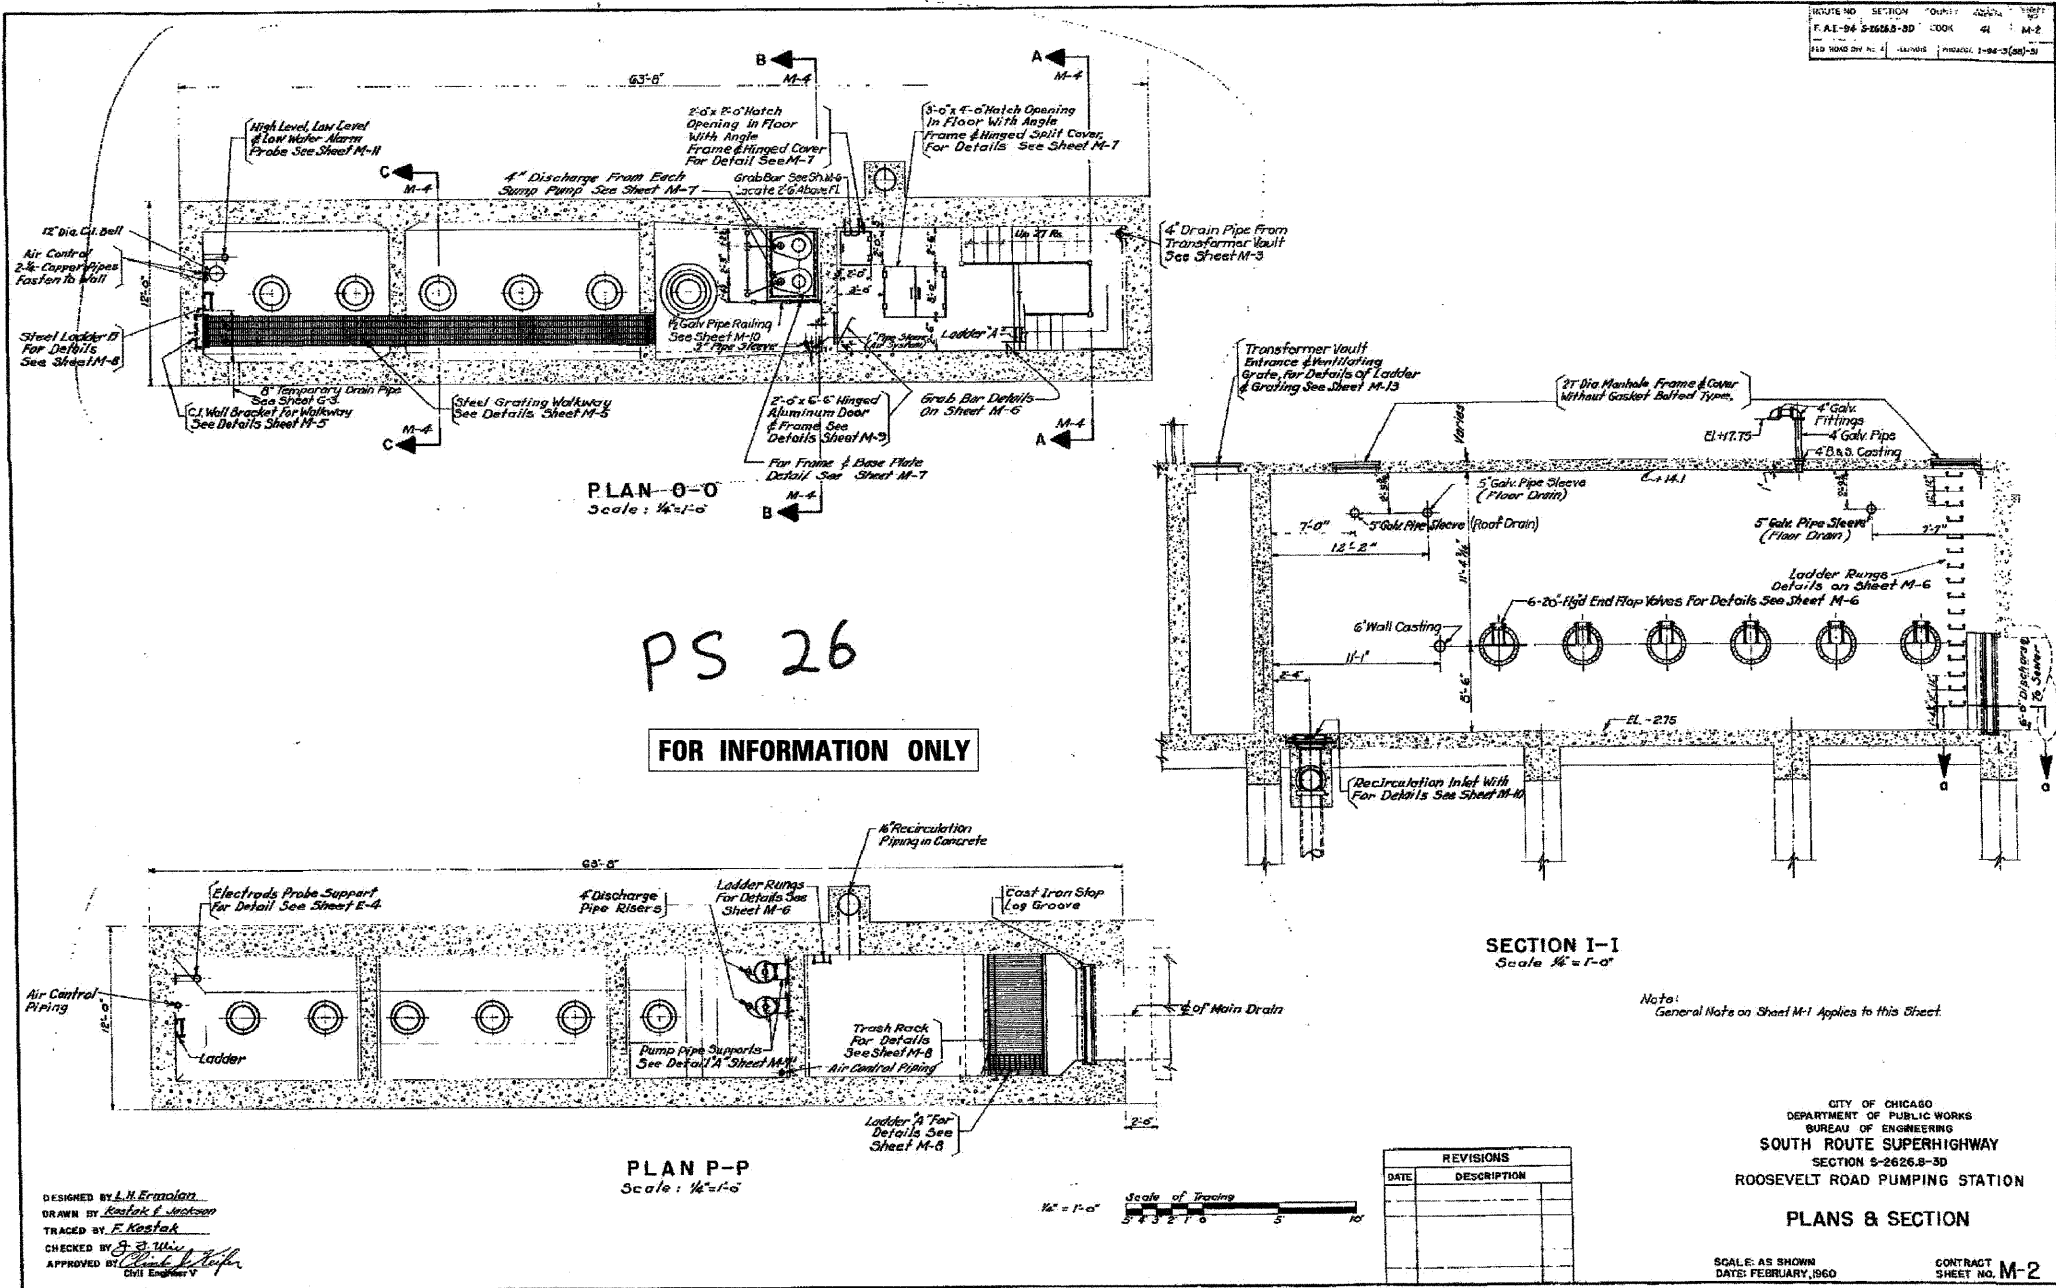

PS 26
FOR INFORMATION ONLY

DESIGNED BY L.H. Ermolen
DRAWN BY Kostik I. Jackson
TRACED BY F. Kostik
CHECKED BY S. Z. W...
APPROVED BY [Signature]
Civil Engineer

REVISIONS	
DATE	DESCRIPTION

Note:
General Note on Sheet M-1 Applies to this Sheet

CITY OF CHICAGO
DEPARTMENT OF PUBLIC WORKS
BUREAU OF ENGINEERING
SOUTH ROUTE SUPERHIGHWAY
SECTION 5-2626.5-3D
ROOSEVELT ROAD PUMPING STATION
PLANS & SECTION

SCALE: AS SHOWN
DATE: FEBRUARY, 1960
CONTRACT SHEET NO. M-2

Added Sheet 12/21/2009, LIN

FILE NAME *	DESIGNED - SGL	REVISED 12/21/2009		STATE OF ILLINOIS DEPARTMENT OF TRANSPORTATION	PUMP STATION NO. 26 RECORD DRAWINGS	F.A.I. RTE.	SECTION	COUNTY	TOTAL SHEETS	SHEET NO.
#FILE#	DRAWN - SGL	REVISED -				290	(2828B,D, ETC., 3031, IRS-6	COOK	185	1240
USER NAME = #USER#	CHECKED - FML	REVISED -				CONTRACT NO. 60653				
DATE = #DATE#	DATE - 12/2009	REVISED -	SCALE:	SHEET NO. 2 OF 2 SHEETS	STA. TO STA.	ILLINOIS FED. AID PROJECT				