


SUMMARY OF QUANTITIES (THIS SHEET)		
DESCRIPTION	UNIT	QUANTITY
ELECTRIC CABLE IN CONDUIT, LEAD-IN, NO. 18 4/C, TWISTED, SHIELDED	LF	108
INDUCTION LOOP	LF	263

NOTE:
 IDOT RECORD PLANS PROVIDED FOR INFORMATIONAL PURPOSES ONLY. THE CONTRACTOR IS RESPONSIBLE FOR VERIFYING THE LOCATION AND EXTENT OF WORK ASSOCIATED WITH REPLACEMENT OF INDUCTION LOOPS, LEAD-IN CABLE AND RELATED WORK.

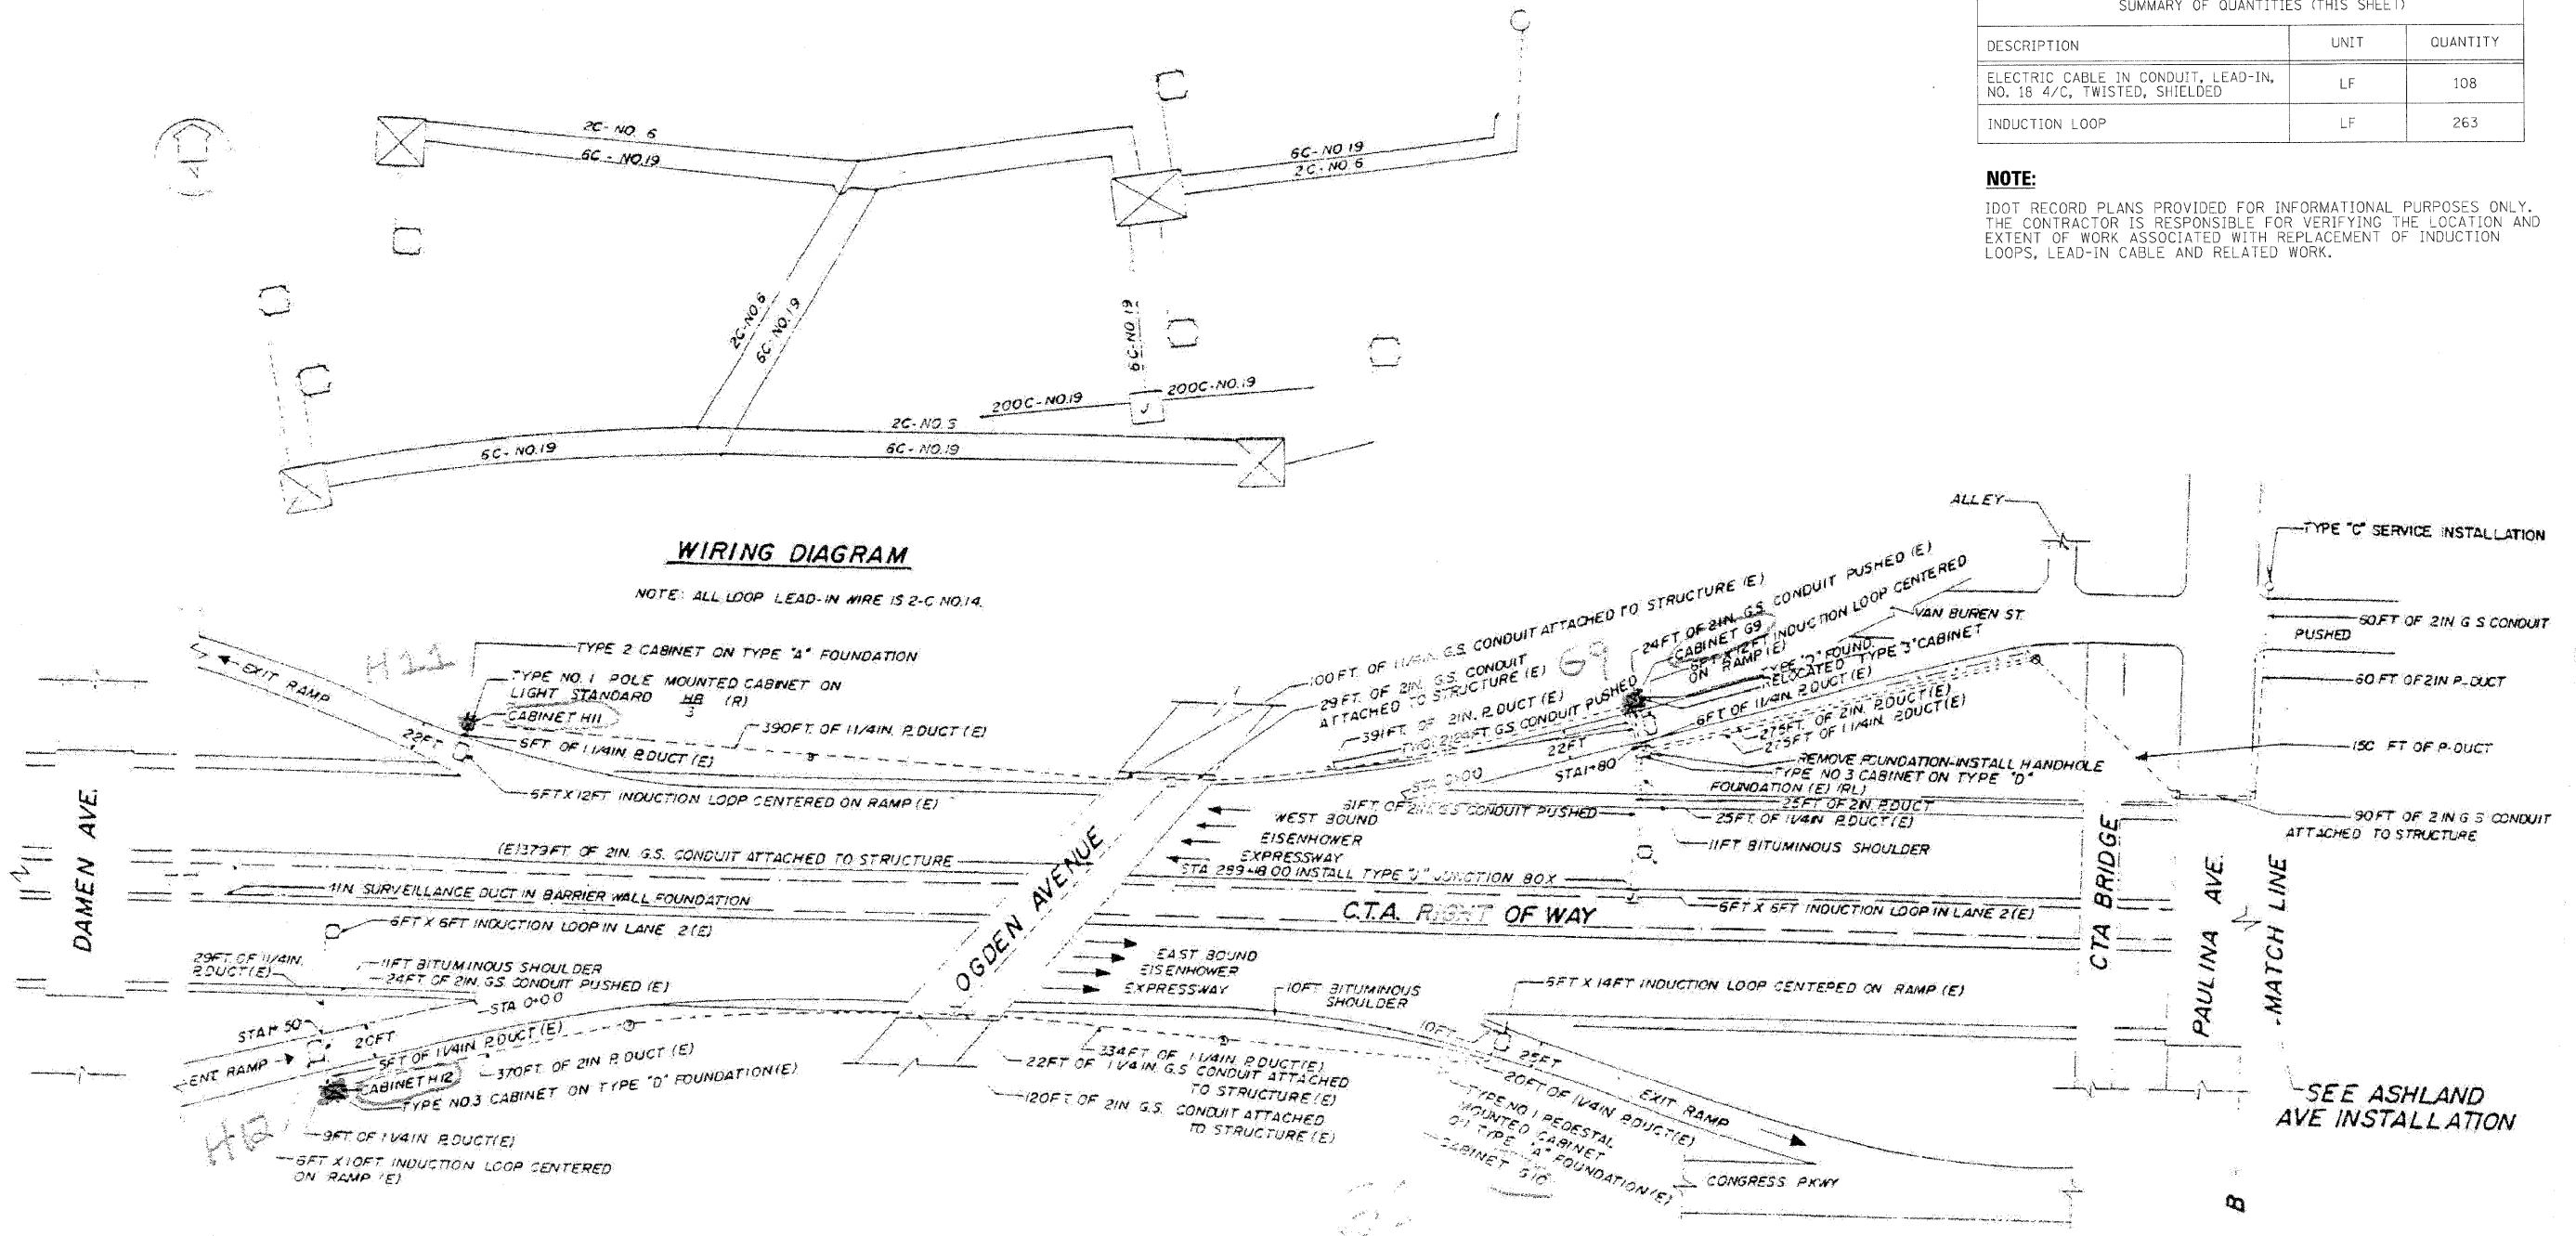

- LEGEND**
- INDUCTION LOOP
 - CABINET
 - ⊕ JUNCTION BOX
 - PULL POINT
 - HANDHOLE
 - SERVICE INSTALLATION
 - - - CONDUIT
 - DUCT
 - - - FENCE
 - (E) EXISTING FACILITIES
 - (P) REMOVE EXISTING FACILITIES
 - (RL) RELOCATE EXISTING FACILITIES

FOR INFORMATION ONLY

INBOUND S4

FILE NAME =	DESIGNED - GHT	REVISED -	benesch	STATE OF ILLINOIS DEPARTMENT OF TRANSPORTATION	TRAFFIC SURVEILLANCE DAMEN AVE AND PAULINA ST INSTALLATION	F.A.I. RTE.	SECTION	COUNTY	TOTAL SHEETS	SHEET NO.
USER NAME = tblank	DRAWN - DMS	REVISED -				290	(2828B,D, ETC., 3031.DRS-6	COOK	185	144
PLOT DATE = 11/12/2009	CHECKED - WPM	REVISED -				CONTRACT NO. 60G53				
DATE - 10/16/09	REVISED -	FED. ROAD DIST. NO. [ILLINOIS] FED. AID PROJECT								

SCALE: N.T.S. SHEET NO. 4 OF 15 SHEETS STA. TO STA.