

STATE OF ILLINOIS
DEPARTMENT OF TRANSPORTATION
DIVISION OF HIGHWAYS

**PROPOSED
HIGHWAY PLANS**

F.A.S. ROUTE 1517 (US 150)
SECTION 12VBR-1
PROJECT ACBRM-1517(III)
US 150 OVER NSRR IN MANSFIELD
PIATT COUNTY
C-95-032-04

F.A.S. RTE.	SECTION	COUNTY	TOTAL SHEETS	SHEET NO.
1517	12VBR-1	PIATT	168	1
FED. ROAD DIST. NO.	ILLINOIS	CONTRACT NO. 70388		

FOR INDEX OF SHEETS, SEE SHEET NO. 2
FOR SUMMARY OF QUANTITIES, SEE SHEET NO. 6-10


CURRENT TRAFFIC DATA

F. A. S. ROUTE 1517 (US 150)

2009 ADT = 1,550
PV % = 93.5
SU % = 5.2
MU % = 1.3

DESIGN DESIGNATION

RURAL MAJOR COLLECTOR

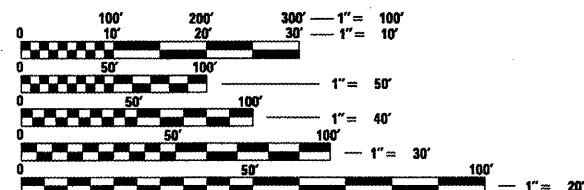

FULL SIZE PLANS HAVE BEEN PREPARED USING STANDARD ENGINEERING SCALES. REDUCED SIZED PLANS WILL NOT CONFORM TO STANDARD SCALES. IN MAKING MEASUREMENTS ON REDUCED PLANS, THE ABOVE SCALES MAY BE USED.


J.U.L.E.
JOINT UTILITY LOCATION INFORMATION FOR EXCAVATION
1-800-892-0123
OR 811

PROJECT ENGINEER: KEVIN TRAPP
SQUAD LEADER: JEFF M. SHERER

PHONE: 217-465-4181
CONTRACT NO. 70388

EXIST. S.N. 074-0009 STA. 289+23.00
5 SPAN PPC DECK BEAMS ON
SPILL-THRU COUNTER-FORT
ABUTMENTS AND MULTI-COLUMN
PIERS

PROP. S.N. 074-0086 STA. 289+22.38
CONTINUOUS STEEL BEAM BRIDGE
3 SPAN W/ INTEGRAL ABUTMENTS
SKEW 9°-42'-41" RT FORWARD

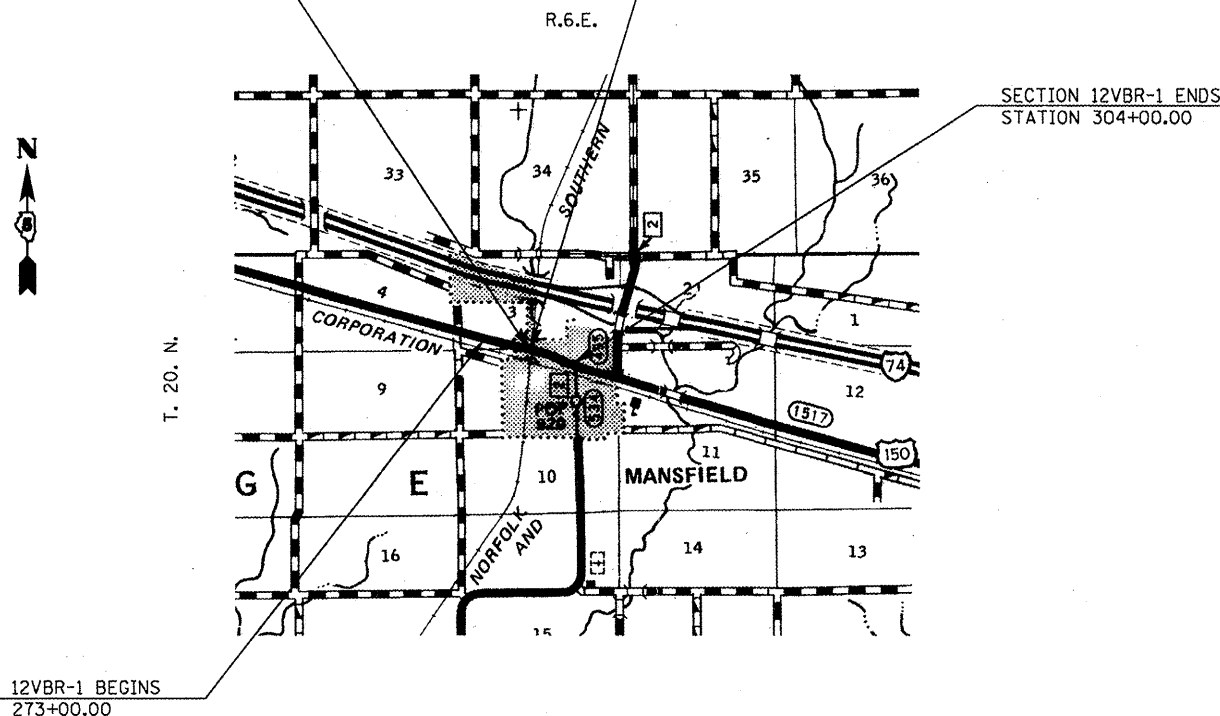

TOTAL LENGTH OF SECTION & PROJECT = 3,100.00 FEET = 0.587 MILES
NET LENGTH OF SECTION & PROJECT = 3,100.00 FEET = 0.587 MILES



STATE OF ILLINOIS
DEPARTMENT OF TRANSPORTATION
DIVISION OF HIGHWAYS

SUBMITTED 10/20 2009
Jason E. Gowen
DEPUTY DIRECTOR OF HIGHWAYS, REGION 3 ENGINEER

December 4, 2009
Charles J. Ingersoll
ENGINEER OF DESIGN AND ENVIRONMENT

December 4, 2009
Christine M. Reed
DIRECTOR OF HIGHWAYS, CHIEF ENGINEER

**PRINTED BY THE AUTHORITY
OF THE STATE OF ILLINOIS**

INDEX OF SHEETS

SHEET NO.	ITEM
1	COVER SHEET
2	INDEX OF SHEETS/ HIGHWAY STANDARDS
3-5	GENERAL NOTES
5	STRUCTURAL PAVEMENT DESIGN INFORMATION
6-10	SUMMARY OF QUANTITIES
11-13	EXISTING AND PROPOSED TYPICAL CROSS-SECTIONS
14	ALIGNMENT TIES AND BENCHMARKS
15-18	SCHEDULE OF PLAN PAY ITEMS
19-30	PLAN AND PROFILE SHEETS US 150
31-33	PLAN AND PROFILE SHEETS ALLEY/ACCESS ROAD
34-39	PLAN AND PROFILE SHEETS NORFOLK-SOUTHERN RAILROAD
38-39	DETOUR PLANS
42-50	AS-BUILT STRUCTURE PLANS, S.N. 074-0009
51-52	SCHEDULES OF REMOVAL
53-58	REMOVAL DETAILS
59	SCHEDULES OF EROSION CONTROL
60-67	EROSION CONTROL DETAILS
68	SCHEDULES OF DRAINAGE
69-71	DRAINAGE DETAILS
72-73	GUARDRAIL DETAILS
74-75	PRIVATE AND COMMERCIAL ENTRANCE DETAILS
76-77	SIDEROAD AND SIDESTREET (RURAL) DETAILS
78	TRAFFIC CONTROL AND PROTECTION DEVICES (ROAD AND SIDESTREET CLOSURE) DETAIL
79	TREATMENT OF EXISTING FIELD TILE SYSTEMS DETAIL
80	DETAILS FOR SHOULDER INLETS WITH CURB MANHOLES DETAIL
81-84	PAVEMENT MARKING DETAILS
85	SURVEY MARKERS TYPE 1 AND TYPE 2 DETAILS
86-110	PROPOSED STRUCTURE PLANS
111	RIGHT OF WAY PLANS
112-147	CROSS-SECTIONS US 150
148-162	CROSS-SECTIONS PROPOSED ALLEY RE-ALIGNMENT
163-168	CROSS-SECTIONS ACCESS ROAD

LIST OF STANDARDS

STANDARD NO.	DESCRIPTION
000001-05	STANDARD SYMBOLS, ABBREVIATIONS AND PATTERNS
001001-02	AREAS OF REINFORCEMENT BARS
001006	DECIMAL OF AN INCH AND OF A FOOT
280001-05	TEMPORARY EROSION CONTROL SYSTEMS
420001-07	PAVEMENT JOINTS
420401-08	BRIDGE APPROACH PAVEMENT CONNECTOR
421001-02	BAR REINFORCEMENT FOR CRC PAVEMENT
482001-02	HMA SHOULDER ADJACENT TO FLEXIBLE PAVEMENT
515001-03	NAME PLATE FOR BRIDGES
542101-02	REINFORCED CONCRETE END SECTIONS FOR PIPE CULVERTS 15" (375 mm) THRU 36" (900 mm) DIAMETER AT RIGHT ANGLES WITH ROADWAY
542401-01	METAL END SECTION FOR PIPE CULVERTS
601101-01	CONCRETE HEADWALL FOR PIPE DRAIN
602011-01	CATCH BASIN TYPE C
604091-02	FRAME AND GRATE TYPE 24
606101-04	TYPE A GUTTER, INLET, OUTLET & ENTR.
610001-05	SHOULDER INLET WITH CURB
630001-08	STEEL PLATE BEAM GUARDRAIL
630201-06	PCC/HMA STABILIZATION AT STEEL PLATE BEAM GUARDRAIL
630301-05	SHOULDER WIDENING FOR TYPE 1 (SPECIAL) GUARDRAIL TERMINALS
631031-08	TRAFFIC BARRIER TERMINAL, TYPE 6
635006-03	REFLECTOR FOR TERMINAL MARKER PLACEMENT
635011-02	REFLECTOR MARKER AND MOUNTING DETAILS
666001-01	RIGHT OF WAY MARKERS
667101-01	PERMANENT SURVEY MARKERS
701001-02	OFF-RD OPERATIONS, 2L, 2W, MORE THAN 15' (4.5 m) AWAY
701006-03	OFF-RD OPERATIONS, 2L, 2W, 15' (4.5 m) TO 24" (600 mm) FROM PAVEMENT EDGE
701011-02	OFF-RD MOVING OPERATIONS, 2L, 2W, DAY ONLY
701201-03	LANE CLOSURE, 2L, 2W, DAY ONLY, FOR SPEEDS \diamond 45 MPH
701301-03	LANE CLOSURE, 2L, 2W, SHORT TIME OPERATIONS
701306-02	LANE CLOSURE, 2L, 2W, SLOW MOVING OPERATIONS DAY ONLY, FOR SPEEDS 45 MPH
701311-03	LANE CLOSURE, 2L, 2W, MOVING OPERATIONS-DAY ONLY
701901-01	TRAFFIC CONTROL DEVICES
780001-02	TYPICAL PAVEMENT MARKINGS
781001-03	TYPICAL APPLICATIONS RAISED REFLECTIVE PAVEMENT MARKERS

FILE NAME = c:\pwork\PIWIDOT\SHERERJM\dms86674\DS	USER NAME = shererjm 0388-shr-gennote.dgn	DESIGNED - JMS	REVISED -
	PLOT SCALE = 100.0000 ' / IN.	DRAWN - JMS	REVISED -
	PLOT DATE = 10/13/2009	CHECKED - JMS	REVISED -
		DATE - 050609	REVISED -

**STATE OF ILLINOIS
DEPARTMENT OF TRANSPORTATION**

INDEX OF SHEETS /HIGHWAY STANDARDS

SCALE: N/A SHEET NO. 1 OF 1 SHEETS STA. TO STA.

F.A.P. RTE. 1517	SECTION 12VBR-1	COUNTY PIATT	TOTAL SHEETS 168	SHEET NO. 2
FED. ROAD DIST. NO. ILLINOIS FED. AID PROJECT			CONTRACT NO. 70388	

G.N.-100

ENGLISH UNITS OF MEASUREMENT SHALL GOVERN OVER AND SUPERSEDE ANY METRIC UNITS SHOWN IN THIS CONTRACT. WHERE INCLUDED, METRIC UNITS ARE FOR INFORMATION ONLY.

G.N.-105.07B

EXISTING STATE-OWNED AND MAINTAINED UTILITY LINES ARE SHOWN ON THE PLANS TO INDICATE THEIR PRESENCE AND APPROXIMATE LOCATION. THE CONTRACTOR SHALL SECURE AN APPROVED LOCATING FIRM TO LOCATE STATE-OWNED UTILITIES PRIOR TO COMMENCING ANY EXCAVATION IN THE VICINITY OF THESE LINES IN ACCORDANCE TO SECTION 803 OF THE STANDARD SPECIFICATIONS. SHOULD ANY OF THE LINES BE DAMAGED BY THE CONTRACTOR'S OPERATION, THE CONTRACTOR SHALL REPAIR THEM TO THE SATISFACTION OF THE ENGINEER AT NO COST TO THE STATE.

ALSO THERE MAY BE UTILITIES PRESENT WHICH WERE INSTALLED BY THE STATE BUT ARE MAINTAINED BY OTHERS (CITY, TOWN, ETC.) THE APPROXIMATE LOCATIONS OF THESE LINES ARE ALSO SHOWN ON THE PLANS ALONG WITH THE NAME OF THE MAINTAINING AGENCY. THE CONTRACTOR SHALL COORDINATE THE LOCATION OF THESE LINES WITH THE LOCAL AGENCY PRIOR TO COMMENCING ANY EXCAVATION OR BORING IN THEIR VICINITY. SHOULD THESE LINES BE DAMAGED BY THE CONTRACTOR'S OPERATIONS, THE CONTRACTOR SHALL REPAIR THEM TO THE SATISFACTION OF, AND AT NO COST TO, THE LOCAL AGENCY AND THE STATE.

G.N.-105.09A

ALL ELEVATIONS SHOWN IN THE PLANS ARE BASED ON NORTH AMERICAN VERTICAL DATUM OF 1988. (NAVD 88)

G.N.-107.12

THE NAME, ADDRESS AND TELEPHONE NUMBER OF THE LOCAL RAILROAD CONTACT IS:

Mrs. Kathy Miles
 Division Office Manager-Illinois Division
 Norfolk Southern Railway Company
 1735 East Condit Street
 Decatur, IL. 62521
 (217) 425-2042

SPECIAL ATTENTION IS CALLED TO ARTICLE 107.12 REGARDING RAILROAD FLAGGERS. THE NAME, ADDRESS AND TELEPHONE NUMBER OF THE RAILROAD CONTACT PERSON FOR FLAGGERS IS:

Mr. Howard Swanson
 Asst. Division Engineer-Bridges Illinois Division
 Norfolk Southern Railway Company
 (217) 425-2066
 1735 East Condit Street
 Decatur, IL. 62521
 Illinois Division

G.N.-107.31

UTILITY LINES WERE PLOTTED FROM INFORMATION FURNISHED BY THE VARIOUS UTILITY COMPANIES INVOLVED (QUALITY LEVEL C &/OR QUALITY LEVEL D) AND THE ACCURACY SHOULD BE CONSIDERED APPROXIMATE ONLY.

UTILITY COMPANIES MAY BE ADJUSTING THEIR FACILITIES DURING CONSTRUCTION. THE CONTRACTOR SHALL COOPERATE WITH THESE ORGANIZATIONS WHILE THESE ADJUSTMENTS ARE BEING PERFORMED. J.U.L.I.E. - JOINT UTILITY LOCATION INFORMATION FOR EXCAVATORS SYSTEM (800)892-0123 OR 811.

THE CONTRACTOR SHOULD CONTACT NORFOLK SOUTHERN (NS) TO LOCATE THEIR UTILITIES. THE NSRR CONTACT FOR LOCATING UTILITIES ON NSRR RIGHT OF WAY IS MR. RON MILLER (404-527-2873), E-MAIL: ron.miller@nscop.com

FILE NAME =	USER NAME = shererjm	DESIGNED - JMS	REVISED -	STATE OF ILLINOIS DEPARTMENT OF TRANSPORTATION	GENERAL NOTES /COMMITMENTS			F.A.P. RTE.	SECTION	COUNTY	TOTAL SHEETS	SHEET NO.	
c:\pwork\PWJDOT\SHERERJM\dms86674\DS	0388-sht-gennote.dgn	DRAWN - JMS	REVISED -					1517	12VBR-1	PIATT	168	3	
	PLOT SCALE = 100.0000 ' / IN.	CHECKED - JMS	REVISED -		SCALE: N/A			SHEET NO. 1 OF 3 SHEETS		STA.	TO STA.	CONTRACT NO. 70388	
	PLOT DATE = 10/13/2009	DATE - 050609	REVISED -		FED. ROAD DIST. NO.		ILLINOIS FED. AID PROJECT						

G.N.-667

THE RESIDENT ENGINEER SHALL CONTACT THE PROGRAM DEVELOPMENT CHIEF OF SURVEYS PRIOR TO THE PRE-CONSTRUCTION CONFERENCE FOR INSTRUCTION AS TO SETTING OF TEMPORARY OR PERMANENT TIES FOR CENTERLINE ALIGNMENT CONTROL SURVEY MARKERS (PC S, PT S, AND P S). PROJECT IMPLEMENTATION PERSONNEL WILL BE RESPONSIBLE FOR SETTING THESE MARKERS.

G.N.-703A

SHORT TERM PAVEMENT MARKING SHALL BE APPLIED TO THE PAVEMENT AFTER ANY OF THE FOLLOWING: COLD MILLING AND/OR PLACING BITUMINOUS MATERIALS (PRIME COAT), LEVELING BINDER (MACHINE METHOD), BINDER AND SURFACE COURSES. SHORT TERM PAVEMENT MARKING PLACED ON THE SURFACE, SHALL COINCIDE WITH THE FINAL PAVEMENT STRIPING. SHORT TERM PAVEMENT MARKING PLACED PRIOR TO THE SURFACE SHALL COINCIDE WITH THE EXISTING PAVEMENT MARKINGS. USE 4 FEET PER 40 FEET (OR 10% PER STATION).

G.N.-781

RAISED REFLECTIVE PAVEMENT MARKERS SHALL BE PLACED IN ACCORDANCE WITH STANDARD 781001, AND THE DETAILS SHOWN IN THE PLANS. IF THERE IS ANY DISCREPANCY BETWEEN THE STANDARD AND THE DETAILS IN THE PLANS, THE DETAILS IN THE PLANS SHALL GOVERN. THE FINAL PAVEMENT MARKINGS SHALL BE IN PLACE PRIOR TO PLACING THE RAISED REFLECTIVE PAVEMENT MARKERS AND THE RAISED REFLECTIVE PAVEMENT MARKERS SHALL BE PLACED MIDWAY IN STRIPES (WHEN APPLICABLE).

G.N.-1004.01

COARSE AGGREGATE GRADATION CA-10 MAY BE USED WHENEVER COARSE AGGREGATE CA-6 IS SPECIFIED IN THE STANDARD SPECIFICATIONS.

G.N.-Z0038

AN ALUMINUM TABLET OF THE TYPE SHOWN ON STANDARD 667101 SHALL BE PLACED ON THE PROPOSED STRUCTURE AS DIRECTED BY THE ENGINEER. THE BENCH MARK ELEVATION WILL BE ESTABLISHED AND MARKED BY THE DEPARTMENT. THIS WORK WILL BE PAID FOR AT THE CONTRACT UNIT PRICE EACH FOR PERMANENT BENCH MARKS.

STRUCTURAL PAVEMENT DESIGN INFORMATION

STRUCTURAL DESIGN TRAFFIC: 2,000 **YEAR:** 2025
PV = 1,786 **SU =** 88 **MU =** 36

ROAD/STREET CLASSIFICATION: Major Collector

P = 50% **S =** 50% **M =** 50%

TRAFFIC FACTOR: Actual TF = 0.32 AC Type = 20

Minimum TF = 5.45

PG GRADE: Binder = PG 64-22

Surface = PG 64-22

PAVEMENT TYPE: Hot-Mix Asphalt Concrete Pavement
(Full Depth), 13"

SUBGRADE SUPPORT RATING: Poor

Construction Year 2010

Design Period 20 years

FILE NAME =	USER NAME = shererjm	DESIGNED - JMS	REVISED -	STATE OF ILLINOIS DEPARTMENT OF TRANSPORTATION	GENERAL NOTES /COMMITMENTS	F.A.P. RTE.	SECTION	COUNTY	TOTAL SHEETS	SHEET NO.	
ca:\pwork\PI\DOT\SHERERJH\dms86674\0570388-shr-genrnote.dgn	PLOT SCALE = 100.0000' / IN.	DRAWN - JMS	REVISED -			1517	12VBR-1	PIATT	168	5	
PLOT DATE = 10/13/2009	DATE - 050609	CHECKED - JMS	REVISED -			CONTRACT NO. 70388					
						SCALE: N/A	SHEET NO. 3 OF 3 SHEETS	STA.	TO STA.	FED. ROAD DIST. NO. ILLINOIS FED. AID PROJECT	

LOCATION OF WORK:

FAS 1517
 BRIDGE
 SN 074-0086
 STA. 288+40.38
 TO
 STA. 290+04.38
 FED 80%
 STATE 20%
 I000-2A

CONSTRUCTION TYPE CODE:

FAS 1517
 BRIDGE
 SN 074-0086
 STA. 288+40.38
 TO
 STA. 290+04.38
 FED 80%
 STATE 20%
 X171-2A

CODE NO	ITEM	UNIT	TOTAL QUANTITY	QUANTITY	QUANTITY
35100700	AGGREGATE BASE COURSE, TYPE A 8"	SQ YD	592.0	592.0	
35101800	AGGREGATE BASE COURSE, TYPE B 6"	SQ YD	26.0	26.0	
40200800	AGGREGATE SURFACE COURSE, TYPE B	TON	676.0	676.0	
40600100	BITUMINOUS MATERIALS (PRIME COAT)	GALLON	830.0	830.0	
40600300	AGGREGATE (PRIME COAT)	TON	17.0	17.0	
40603310	HOT-MIX ASPHALT SURFACE COURSE, MIX "C", N50	TON	98.0	98.0	
40701941	HOT-MIX ASPHALT PAVEMENT (FULL-DEPTH), 13"	SQ YD	7,118.0	7,118.0	
40800010	BITUMINOUS MATERIALS (PRIME COAT)	GALLON	80.0	80.0	
40800030	AGGREGATE (PRIME COAT)	TON	2.0	2.0	
40800050	INCIDENTAL HOT-MIX ASPHALT SURFACING	TON	89.0	89.0	
44000100	PAVEMENT REMOVAL	SQ YD	7,100.0	7,100.0	
44000155	HOT-MIX ASPHALT SURFACE REMOVAL, 1 1/2"	SQ YD	1,156.0	1,156.0	
44000196	HOT-MIX ASPHALT SURFACE REMOVAL, SPECIAL	SQ YD	193.0	193.0	
44000700	APPROACH SLAB REMOVAL	SQ YD	86.0	86.0	
44004250	PAVED SHOULDER REMOVAL	SQ YD	345.0	345.0	
48101200	AGGREGATE SHOULDERS, TYPE B	TON	60.0	60.0	
48101500	AGGREGATE SHOULDERS, TYPE B 6"	SQ YD	912.0	912.0	
48203029	HOT-MIX ASPHALT SHOULDERS, 8"	SQ YD	694.0	694.0	
50100100	REMOVAL OF EXISTING STRUCTURES	EACH	1.0		1.0
50104000	BRIDGE RAIL REMOVAL	FOOT	438.0		438.0

* SPECIALTY ITEM

(CONTINUED NEXT SHEET)

FILE NAME =	USER NAME = shererjm	DESIGNED - JMS	REVISED -	STATE OF ILLINOIS DEPARTMENT OF TRANSPORTATION	SUMMARY OF QUANTITIES			F.A.P. RTE.	SECTION	COUNTY	TOTAL SHEETS	SHEET NO.	
ca:\ppl_work\PW1001\SHERRERJM\dms86674\050388-shr-500.dgn	DRAWN - JMS	REVISOR -						1517	12VBR-1	PIATT	168	7	
	PLOT SCALE = 100.0000' / IN.	CHECKED - JMS	REVISED -		SCALE: N/A			SHEET NO. 2 OF 5 SHEETS		STA.	TO STA.	FED. ROAD DIST. NO. ILLINOIS FED. AID PROJECT	
	PLOT DATE = 10/13/2009	DATE - 050609	REVISED -		CONTRACT NO. 70388								

LOCATION OF WORK:

FAS 1517
 RURAL
 2L2W
 STA. 273+00.00 TO 288+04.38
 STA. 290+40.38 TO 296+45.15
 FED 80%
 STATE 20%
 I000-2A

FAS 1517
 BRIDGE
 SN 074-0086
 STA. 288+40.38
 TO
 STA. 290+04.38
 FED 80%
 STATE 20%
 X171-2A

CONSTRUCTION TYPE CODE:

CODE NO	ITEM	UNIT	TOTAL QUANTITY	QUANTITY	QUANTITY
50104650	SLOPE WALL REMOVAL	SQ YD	542.0		542.0
50105200	REMOVE EXISTING CULVERTS	EACH	2.0	2.0	
50157300	PROTECTIVE SHIELD	SQ YD	230.0		230.0
50200100	STRUCTURE EXCAVATION	CU YD	250.0		250.0
50300225	CONCRETE STRUCTURES	CU YD	258.2		258.2
50300255	CONCRETE SUPERSTRUCTURE	CU YD	319.4		319.4
50300260	BRIDGE DECK GROOVING	SQ YD	697.0		697.0
50300280	CONCRETE ENCASEMENT	CU YD	4.2		4.2
50300300	PROTECTIVE COAT	SQ YD	967.0		967.0
50500105	FURNISHING AND ERECTING STRUCTURAL STEEL	L SUM	1.0		1.0
50500505	STUD SHEAR CONNECTORS	EACH	3,654.0		3,654.0
50800205	REINFORCEMENT BARS, EPOXY COATED	POUND	109,850.0		109,850.0
50800515	BAR SPLICERS	EACH	64.0		64.0
51100100	SLOPE WALL 4 INCH	SQ YD	482.0		482.0
51201600	FURNISHING STEEL PILES HP12X53	FOOT	2,348.0		2,348.0
51202305	DRIVING PILES	FOOT	2,348.0		2,348.0
51203600	TEST PILE STEEL HP12X53	EACH	2.0		2.0
51500100	NAME PLATES	EACH	1.0		1.0
52100010	ELASTOMERIC BEARING ASSEMBLY, TYPE I	EACH	12.0		12.0
52100520	ANCHOR BOLTS, 1"	EACH	24.0		24.0

* SPECIALTY ITEM

(CONTINUED NEXT SHEET)

FILE NAME =	USER NAME = shorerjm	DESIGNED - JMS	REVISED -	STATE OF ILLINOIS DEPARTMENT OF TRANSPORTATION	SUMMARY OF QUANTITIES			F.A.P. RTE.	SECTION	COUNTY	TOTAL SHEETS	SHEET NO.
0388-sht-500.dgn		DRAWN - JMS	REVISED -		1517	12VBR-1	PIATT	168	8			
PLOT SCALE = 100.0000' / IN.		CHECKED - JMS	REVISED -		SCALE: N/A SHEET NO. 3 OF 5 SHEETS STA. TO STA.			CONTRACT NO. 70388				
PLOT DATE = 10/16/2009		DATE - 050609	REVISED -		FED. ROAD DIST. NO. ILLINOIS FED. AID PROJECT							

LOCATION OF WORK:

FAS 1517
 BRIDGE
 SN 074-0086
 STA. 288+40.38
 TO
 STA. 290+04.38
 FED 80%
 STATE 20%
 I000-2A
 X171-2A

CONSTRUCTION TYPE CODE:

CODE NO	ITEM	UNIT	TOTAL QUANTITY	QUANTITY	QUANTITY
52100540	ANCHOR BOLTS, 1 1/2"	EACH	24.0		24.0
54213447	END SECTIONS 12"	EACH	12.0	12.0	
54213450	END SECTIONS 15"	EACH	2.0	2.0	
54215418	CAST-IN-PLACE REINFORCED CONCRETE END SECTIONS 18"	EACH	4.0	4.0	
542A0223	PIPE CULVERTS, CLASS A, TYPE 1 18"	FOOT	21.0	21.0	
542A1063	PIPE CULVERTS, CLASS A, TYPE 2 18"	FOOT	104.0	104.0	
542D0220	PIPE CULVERTS, CLASS D, TYPE 1 15"	FOOT	21.0	21.0	
59100100	GEOCOMPOSITE WALL DRAIN	SQ YD	56.8		56.8
60100060	CONCRETE HEADWALL FOR PIPE DRAINS	EACH	4.0		4.0
60100945	PIPE DRAINS 12"	FOOT	790.0	790.0	
60109580	PIPE UNDERDRAINS FOR STRUCTURES 4"	FOOT	137.0		137.0
60208240	CATCH BASINS, TYPE C, TYPE 24 FRAME AND GRATE	EACH	12.0	12.0	
60500065	REMOVING INLETS, SPECIAL	EACH	4.0	4.0	
60602500	CONCRETE GUTTER, TYPE A	FOOT	213.0	213.0	
60900515	CONCRETE THRUST BLOCKS	EACH	12.0	12.0	
* 63000001	STEEL PLATE BEAM GUARD RAIL, TYPE A, 6 FOOT POSTS	FOOT	1,825.0	1,825.0	
* 63100085	TRAFFIC BARRIER TERMINAL, TYPE 6	EACH	4.0	4.0	
* 63100167	TRAFFIC BARRIER TERMINAL, TYPE 1 (SPECIAL) TANGENT	EACH	4.0	4.0	
63200310	GUARDRAIL REMOVAL	FOOT	2,349.0	2,349.0	
66101150	HOT-MIX ASPHALT SHOULDER CURB	FOOT	2,078.0	2,078.0	

* SPECIALTY ITEM

(CONTINUED NEXT SHEET)

FILE NAME *	USER NAME * shererjm	DESIGNED - JMS	REVISED -	STATE OF ILLINOIS DEPARTMENT OF TRANSPORTATION	SUMMARY OF QUANTITIES				F.A.P. RTE.	SECTION	COUNTY	TOTAL SHEETS	SHEET NO.
c:\pwwork\FWIDOT\SHERERJM\dms86674\0570388-shr-500.dgn		DRAWN - JMS	REVISED -		1517	12VBR-1	PIATT	168	9				
PLOT SCALE = 100.0000' / IN.		CHECKED - JMS	REVISED -		CONTRACT NO. 70388								
PLOT DATE = 10/13/2009		DATE - 050609	REVISED -		SCALE: N/A	SHEET NO. 4 OF 5 SHEETS	STA.	TO STA.	FED. ROAD DIST. NO.	ILLINOIS FED. AID PROJECT			

LOCATION OF WORK:

FAS 1517
 BRIDGE
 SN 074-0086
 STA. 288+40.38
 TO
 STA. 290+04.38
 FED 80%
 STATE 20%
 I000-2A
 X171-2A

CONSTRUCTION TYPE CODE:


CODE NO	ITEM	UNIT	TOTAL QUANTITY	QUANTITY	QUANTITY
66600105	FURNISHING AND ERECTING RIGHT-OF-WAY MARKERS	EACH	9.0	9.0	
67000400	ENGINEER'S FIELD OFFICE, TYPE A	CAL MS	10.0	10.0	
67100100	MOBILIZATION	L SUM	1.0	1.0	
70100450	TRAFFIC CONTROL AND PROTECTION, STANDARD 701201	L SUM	1.0	1.0	
70100460	TRAFFIC CONTROL AND PROTECTION, STANDARD 701306	L SUM	1.0	1.0	
* 78001110	PAINT PAVEMENT MARKING - LINE 4"	FOOT	9,683.0	9,683.0	
* 78001180	PAINT PAVEMENT MARKING - LINE 24"	FOOT	22.0	22.0	
* 78100100	RAISED REFLECTIVE PAVEMENT MARKER	EACH	36.0	36.0	
* 78100105	RAISED REFLECTIVE PAVEMENT MARKER (BRIDGE)	EACH	3.0	3.0	
* 78200405	GUARDRAIL MARKERS	EACH	24.0	24.0	
* 78200500	BARRIER WALL MARKERS	EACH	4.0	4.0	
* 78201000	TERMINAL MARKER - DIRECT APPLIED	EACH	4.0	4.0	
78300200	RAISED REFLECTIVE PAVEMENT MARKER REMOVAL	EACH	36.0	36.0	
X0320870	BRACED EXCAVATION	CU YD	112.0		112.0
X0324865	DIAMOND GRINDING (BRIDGE SECTION)	SQ YD	734.0		734.0
X0324952	DETOUR SIGNING	L SUM	1.0	1.0	
X0326268	REINFORCED SOIL SLOPE SYSTEM	SQ FT	5,660.0		5,660.0
X7015005	CHANGEABLE MESSAGE SIGN	CAL DA	28.0	28.0	
* XZ193300	SURVEY MARKER, TYPE 1 (SPECIAL)	EACH	4.0	4.0	
Z0038700	PERMANENT BENCH MARKS	EACH	2.0	2.0	
Z0048665	RAILROAD PROTECTIVE LIABILITY INSURANCE	L SUM	1.0	1.0	
*	SPECIALTY ITEM				

FILE NAME =	USER NAME = shererjm	DESIGNED - JMS	REVISED -	STATE OF ILLINOIS DEPARTMENT OF TRANSPORTATION	SUMMARY OF QUANTITIES				F.A.P. RTE.	SECTION	COUNTY	TOTAL SHEETS	SHEET NO.
c:\pwwork\FWIDOT\SHERERJM\dms86674\05	0388-sht-500.dgn	DRAWN - JMS	REVISED -		1517	12VBR-1	PIATT	168	10				
	PLOT SCALE = 100.0000' / IN.	CHECKED - JMS	REVISED -		CONTRACT NO. 70388								
	PLOT DATE = 10/13/2009	DATE - 050609	REVISED -		SCALE: N/A	SHEET NO. 5 OF 5 SHEETS	STA.	TO STA.	FED. ROAD DIST. NO.	ILLINOIS FED. AID PROJECT			

EXISTING ROADWAY CROSS SECTION

STA. 273+00.00 TO STA. 288+10.76
 STA. 290+29.42 TO STA. 304+00.00


STA. 288+10.76 TO STA. 290+29.42 (EXIST. S.N. 074-009)

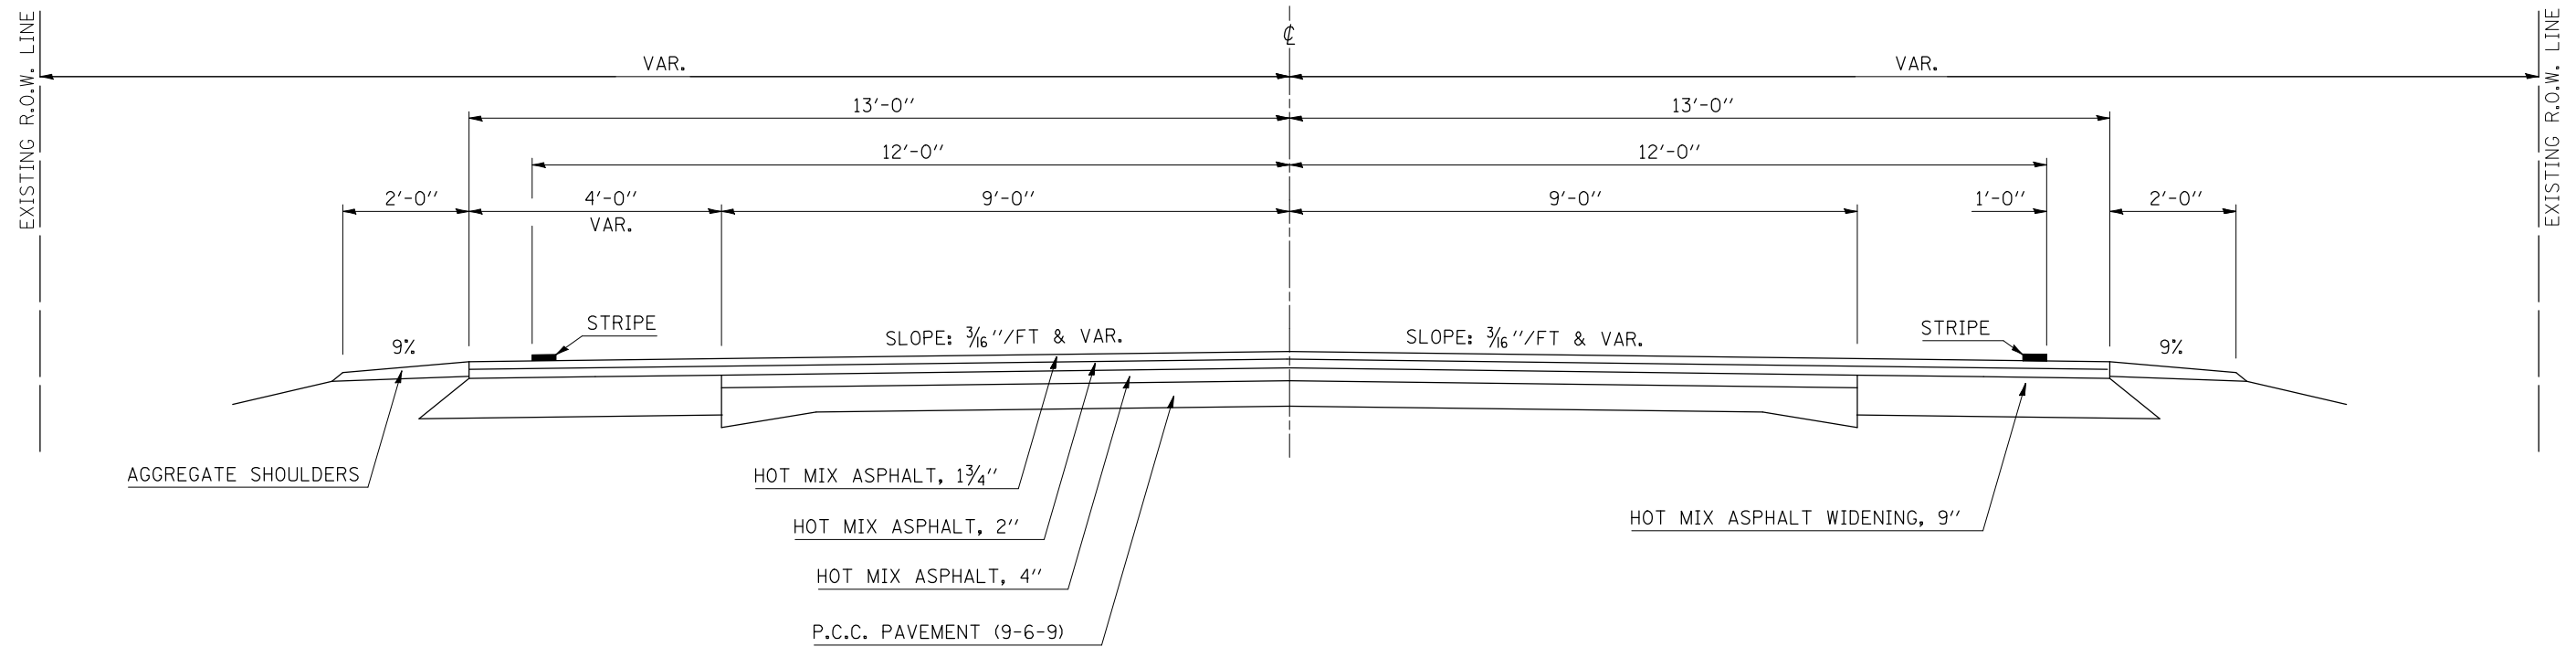

1 PROPOSED TYPICAL SECTION

STA. 273+00 TO STA. 276+00 2

2 STA. 303+00 TO STA. 304+00

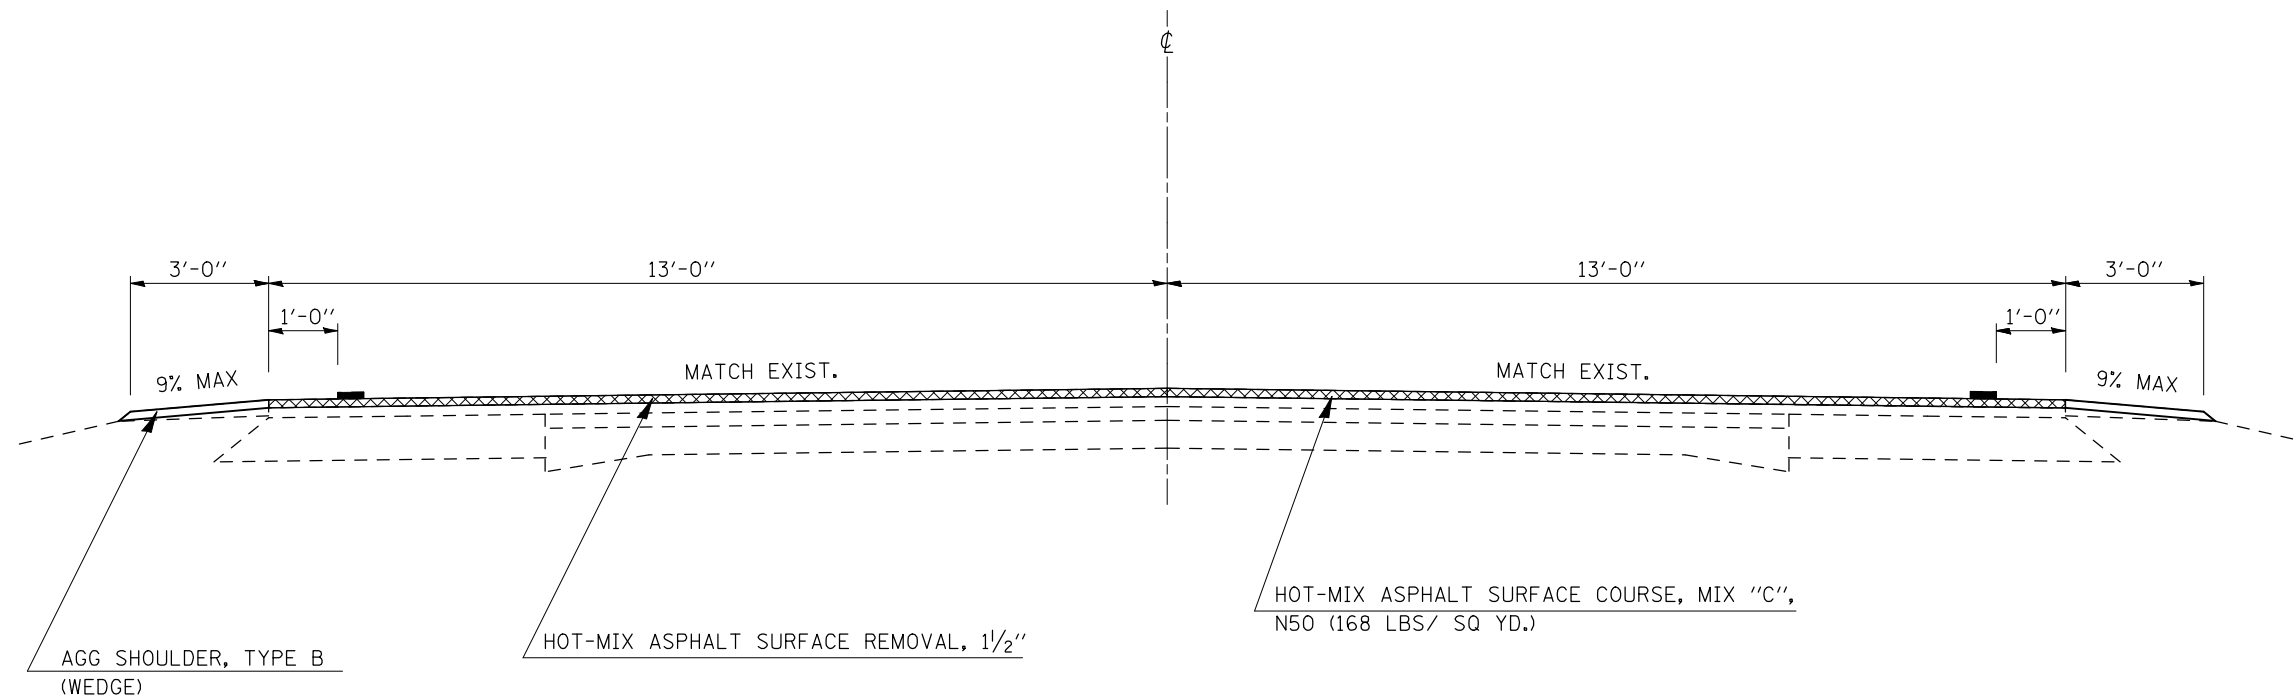

FILE NAME =	USER NAME = shererjm	DESIGNED - JMS	REVISED -
ct:\pw\work\PIWIDOT\SHERERJM\dms86674\d570388-shr-typical.dgn		DRAWN - JMS	REVISED -
PLOT SCALE = 40.0000' / IN.		CHECKED - JMS	REVISED -
PLOT DATE = 10/13/2009		DATE - 061109	REVISED -

STATE OF ILLINOIS
 DEPARTMENT OF TRANSPORTATION

TYPICAL CROSS SECTIONS


SCALE: SHEET NO. 1 OF 3 SHEETS STA. TO STA.

F.A.S. RTE.	SECTION	COUNTY	TOTAL SHEETS	SHEET NO.
1517	12VBR-1	PIATT	168	11
CONTRACT NO. 70388				
FED. ROAD DIST. NO. ILLINOIS FED. AID PROJECT				

② PROPOSED TYPICAL SECTION

① STA. 276+00.00 TO STA. 283+00.00 ③

③ STA. 296+45.15 TO STA. 303+00.00 ①

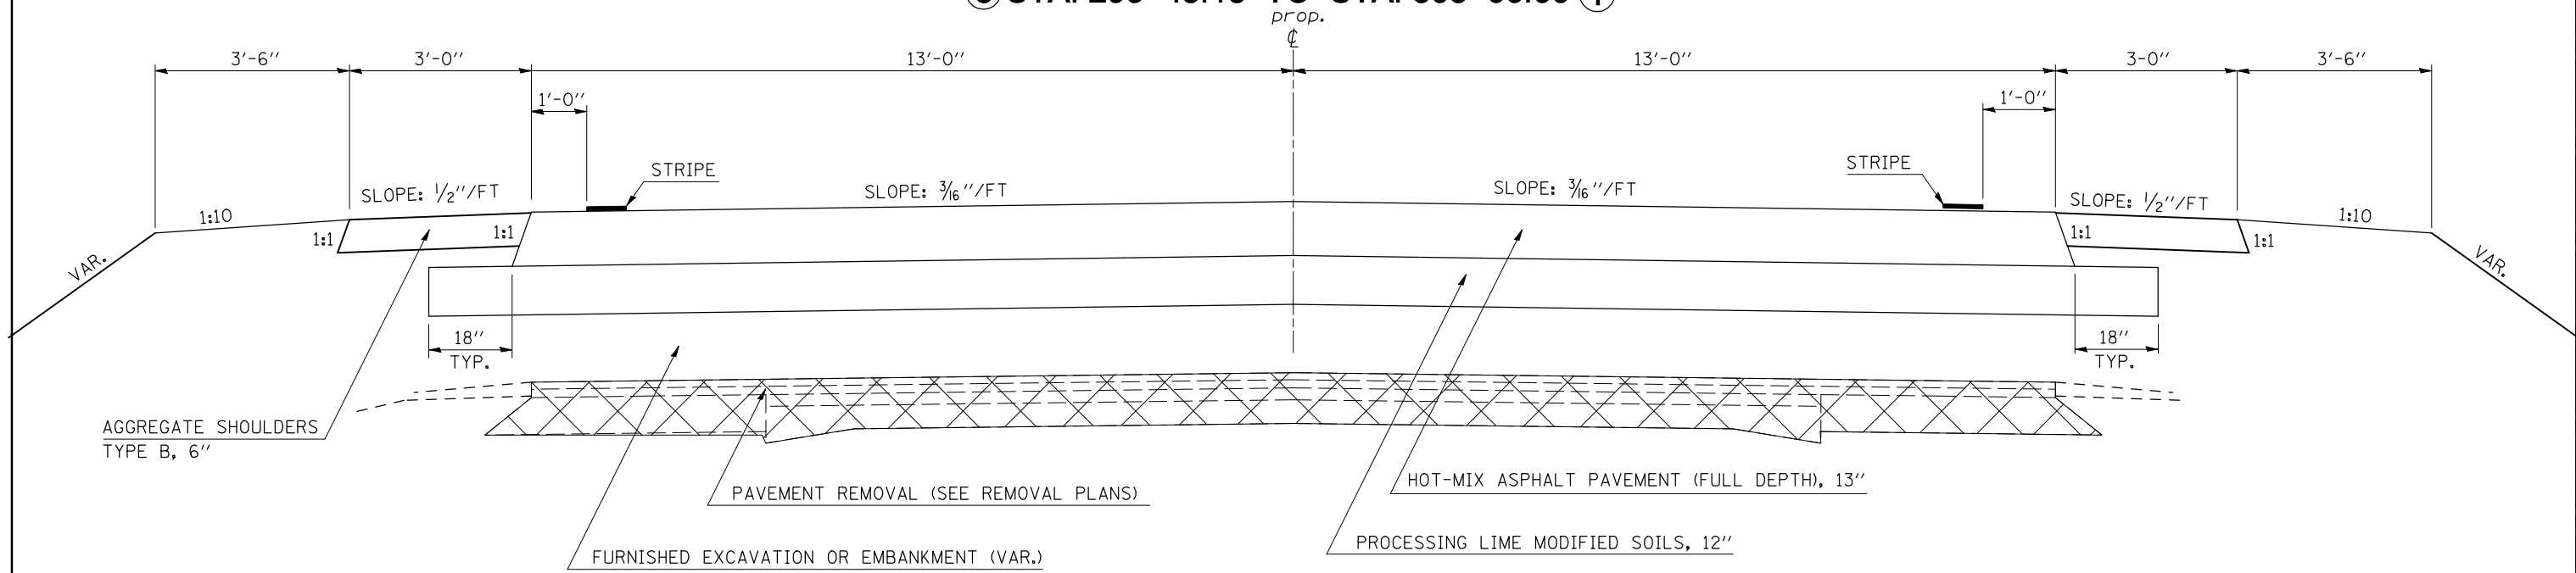


③ PROPOSED TYPICAL SECTION

② STA. 283+00.00 TO STA. 288+04.38 ④

④ STA. 290+40.38 TO STA. 296+45.15 ②

SEE STRUCTURE PLANS FOR
STA. 288+04.38 TO 288+40.38
STA. 290+04.38 TO 290+40.38

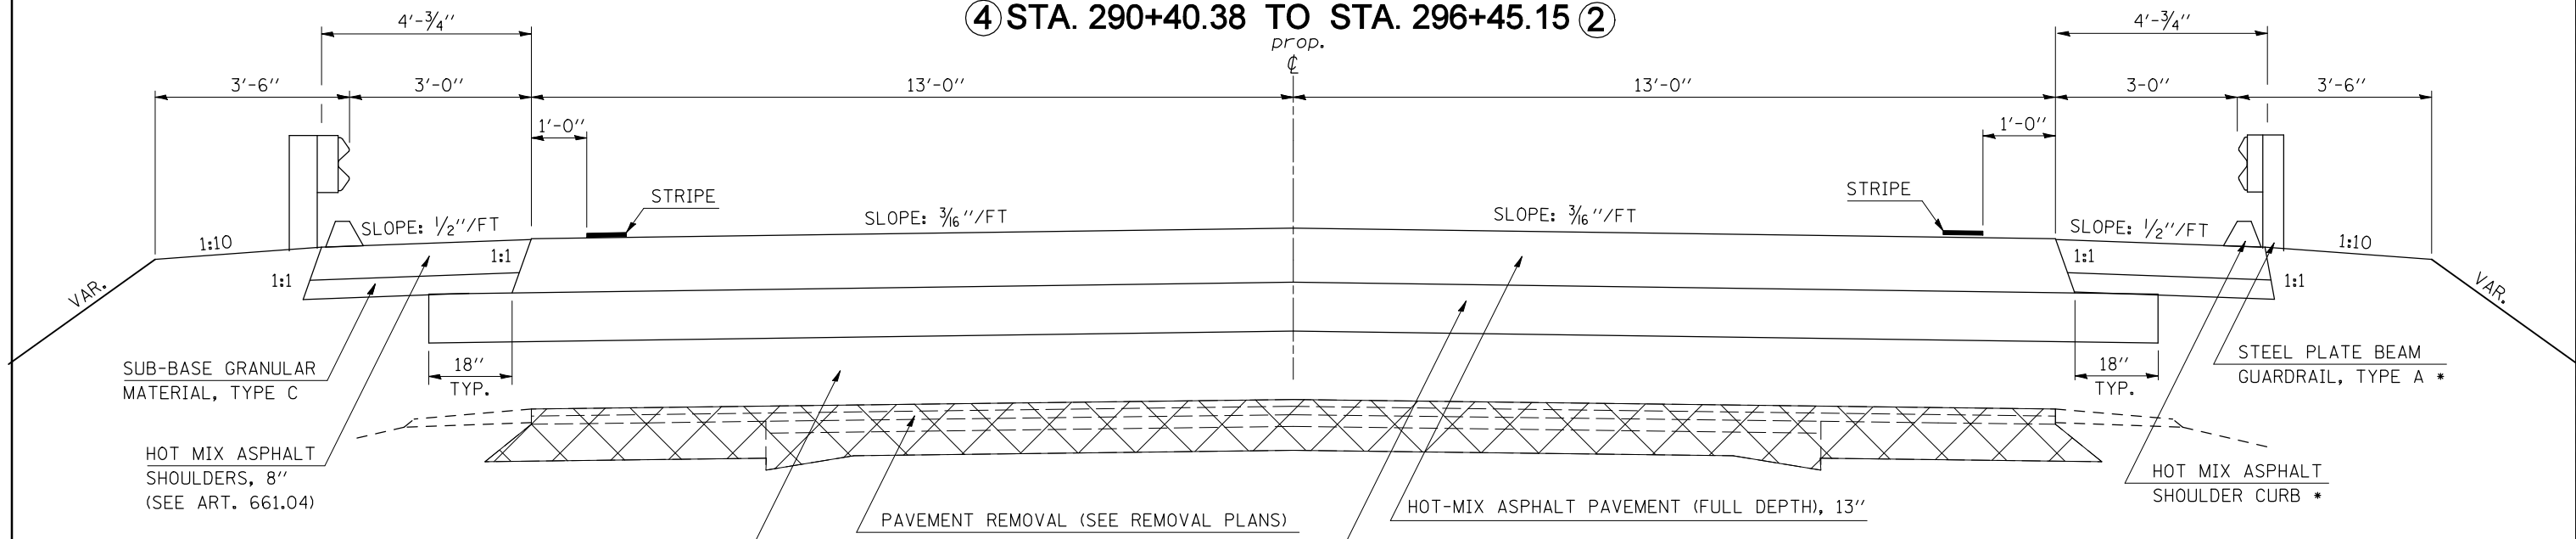


LIFT THICKNESS & MIXTURE REQUIREMENT

1:1	2"	HMA SURFACE CSE., MIX "C", N50
	2 1/4"	HMA BINDER CSE., IL 19.0, N50
	8 3/4"	HMA BINDER CSE., IL 19.0, N50
		BINDER LIFTS 2 1/2" MIN. TO 6" MAX. LIFT THICKNESS

EXISTING BRIDGE CROSS SECTION

STA. 288+10.76 TO STA. 290+29.42


S.N. 074-009

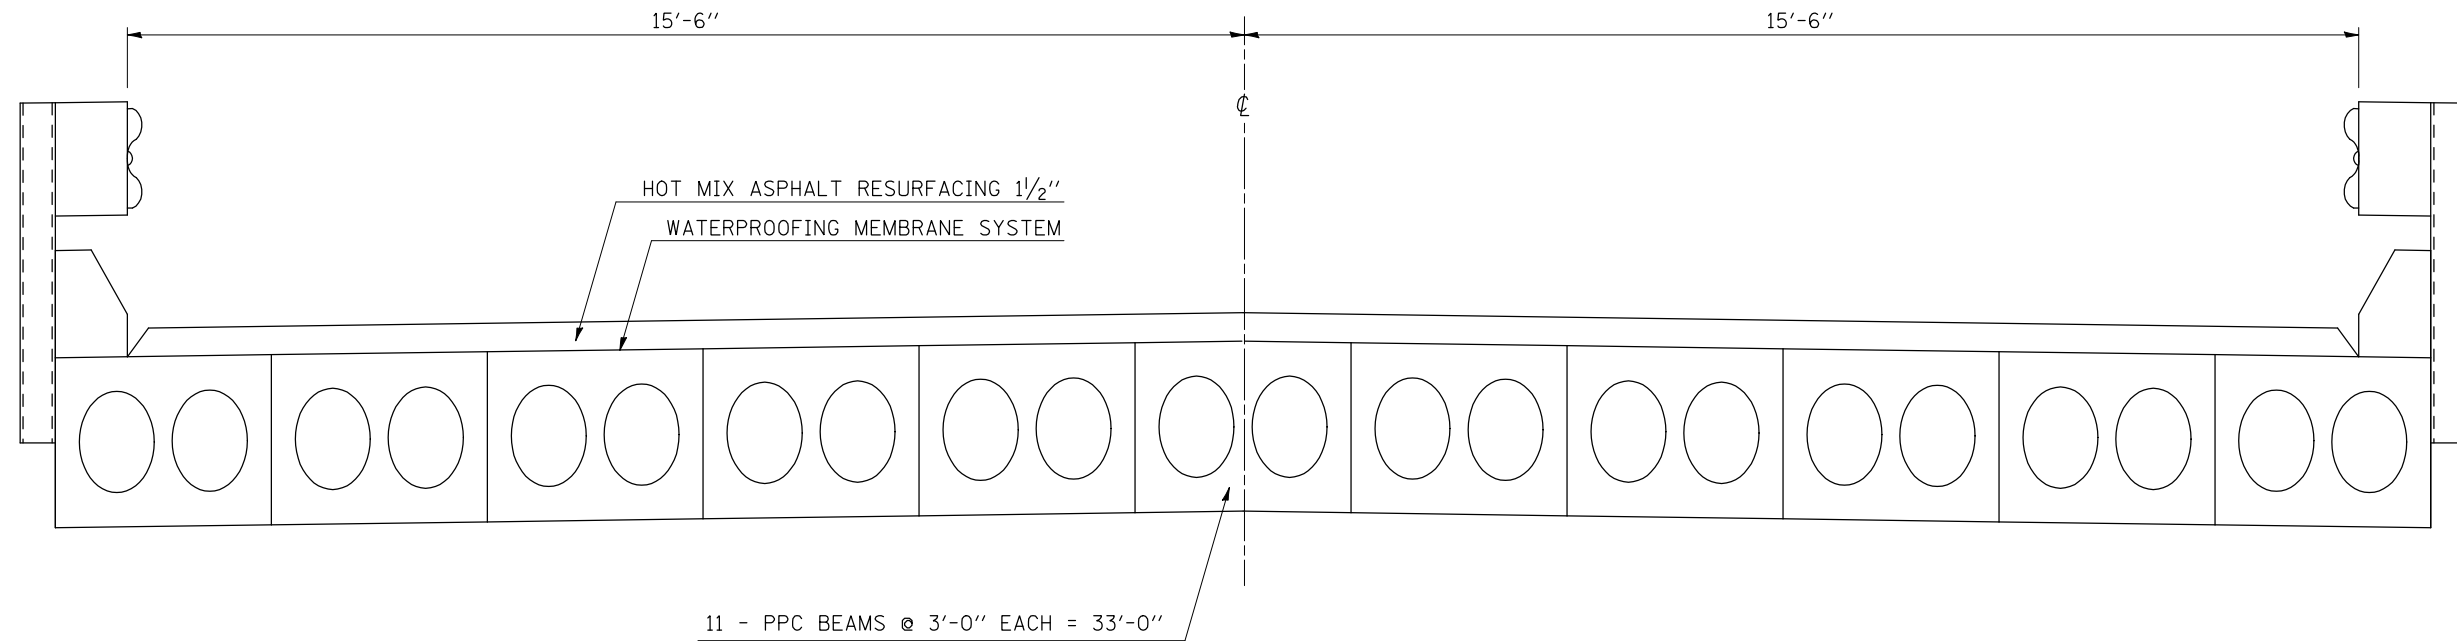

4 PROPOSED TYPICAL SECTION

3 STA. 288+40.38 TO STA. 290+04.38 3


SN 074-0086

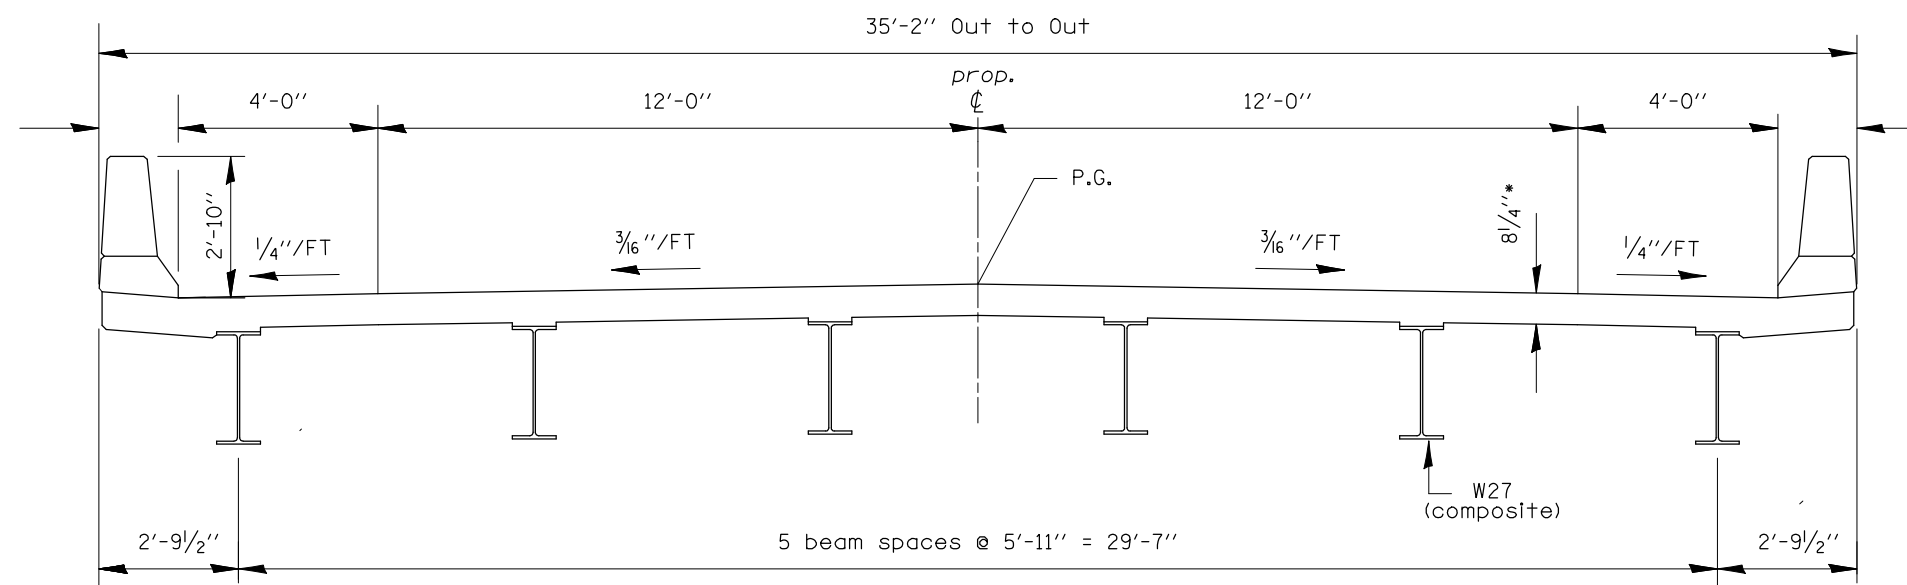


* PRIOR TO DIAMOND GRINDING AND SURFACE TESTING OF BRIDGE SECTIONS.

FILE NAME =	USER NAME = shererjm	DESIGNED - JMS	REVISED -	STATE OF ILLINOIS DEPARTMENT OF TRANSPORTATION	TYPICAL CROSS SECTIONS			F.A.S. RTE.	SECTION	COUNTY	TOTAL SHEETS	SHEET NO.
ct:\pw\work\PIWIDOT\SHERERJM\dms86674\d570388-sh-t\typical.dgn		DRAWN - JMS	REVISED -		1517	12VBR-1	PIATT	168	13			
PLOT SCALE = 40.0000' / IN.		CHECKED - JMS	REVISED -		CONTRACT NO. 70388							
PLOT DATE = 10/13/2009		DATE - 061109	REVISED -		SCALE:	SHEET NO. 3 OF 3 SHEETS	STA.	TO STA.	FED. ROAD DIST. NO.	ILLINOIS FED. AID PROJECT		


EXISTING P.O.T. STATION 266 + 33.87

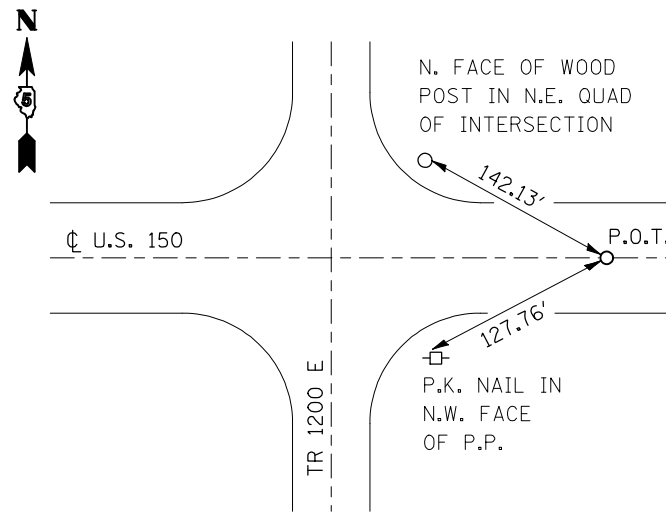


EXISTING P.I. STATION 276 + 75.36

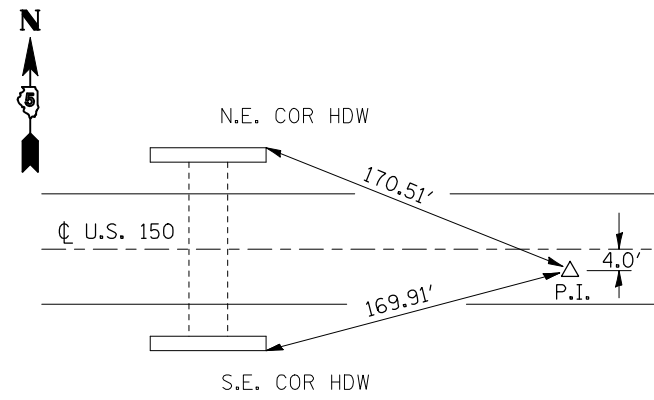


EXISTING P.T. STATION 279 + 90.12

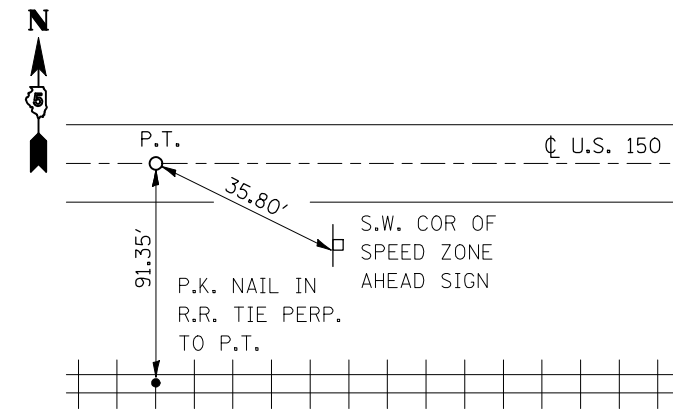


EXISTING P.I. KINK STATION 287 + 70.85

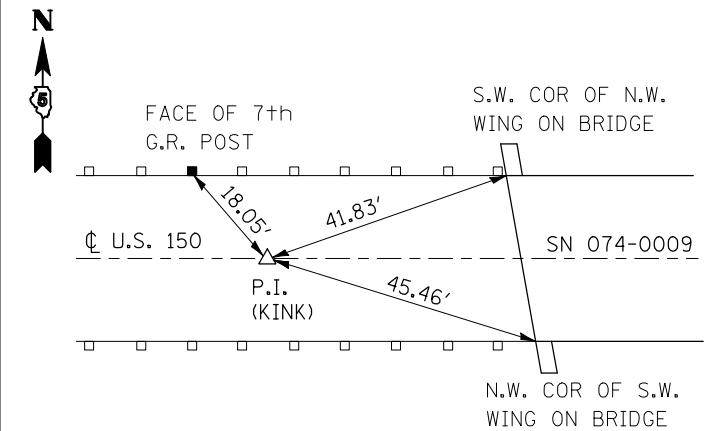


EXISTING P.C. STATION 290 + 04.11

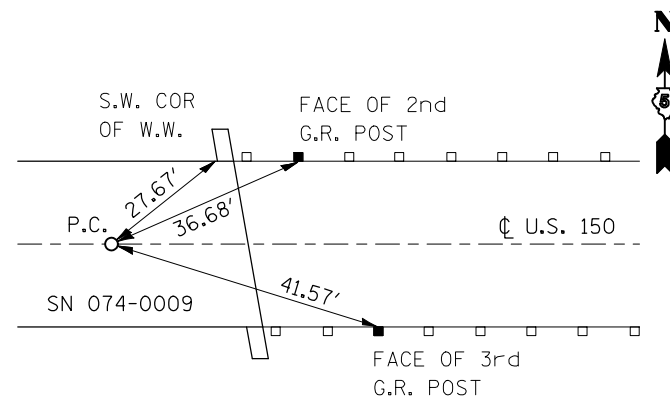


EXISTING P.I. STATION 291 + 82.62

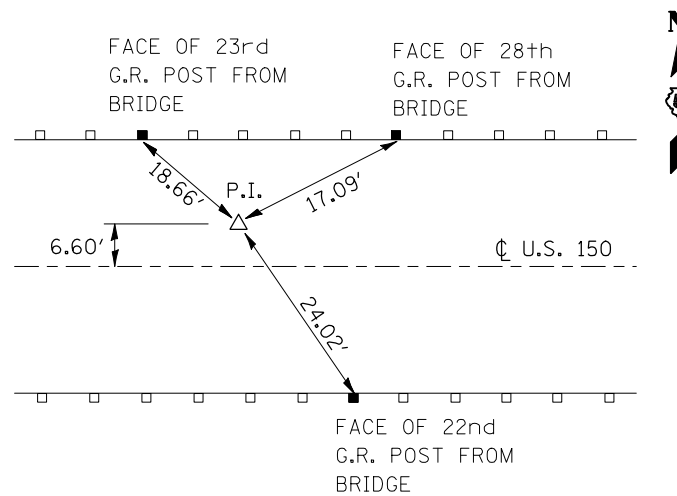


EXISTING P.T. STATION 293 + 61.14

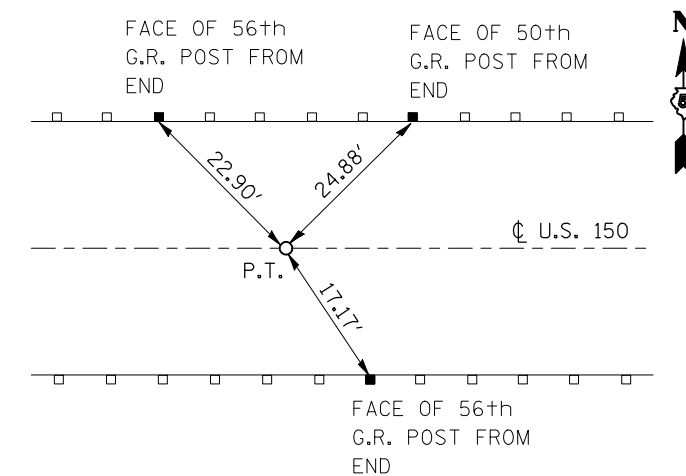


EXISTING P.C. STATION 296 + 02.89

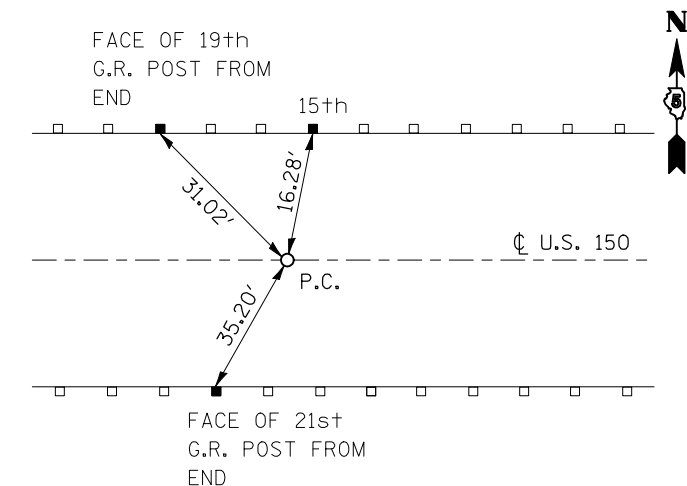


EXISTING P.I. STATION 297 + 18.38

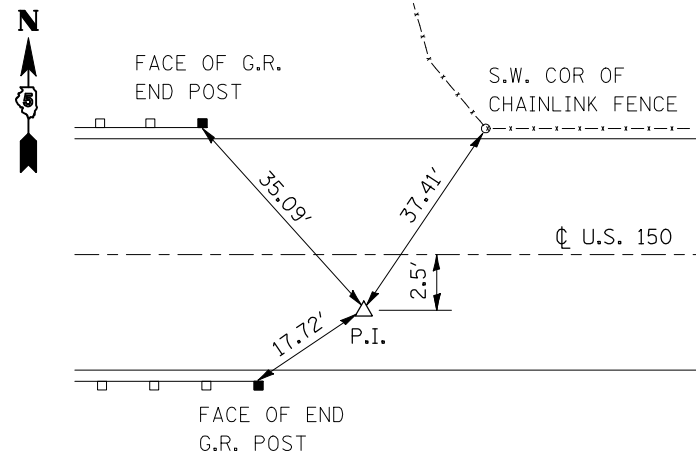

EXISTING P.T. STATION 298 + 33.86

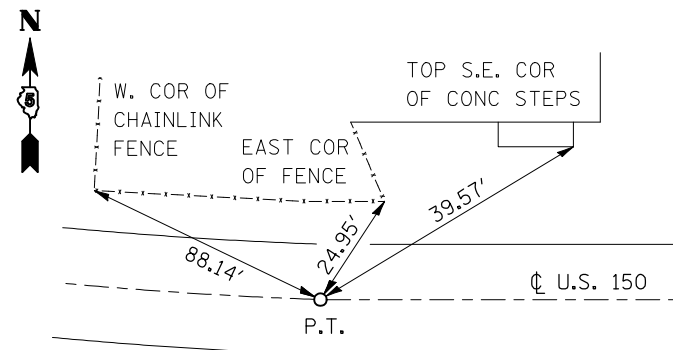

EXISTING P.I. KINK STATION 303 + 43.16

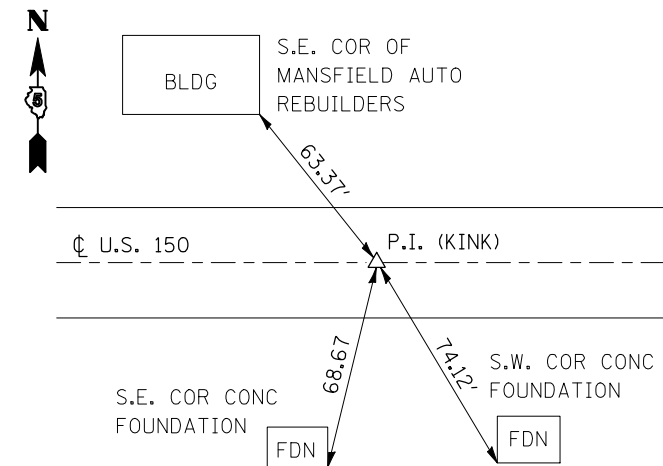

- BM 4696-1 - CHISELED SQUARE ON EDGE OF 2' ROUND SIGNAL FDN FOR ABANDONED RAILROAD STATION 286+79.00, 142.00' RT. ELEVATION = 730.975
- BM 4696-2 - CHISELED SQUARE ON FLAT TOP (SW) CORNER OF SOUTHWEST WINGWALL OF BRIDGE STATION 288+13.00, 17.65' RT. ELEVATION = 755.435
- BM 4696-3 - CHISELED SQUARE ON FLAT TOP (NE COR) OF NORTHEAST WINGWALL OF BRIDGE STATION 290+27.00, 17.80' LT. ELEVATION = 755.560
- BM 4696-4 - CHISELED SQUARE ON TOP HEADWALL FOR AN A.R. PIPE CULVERT STATION 296+76.00, 21.35' RT. ELEVATION = 727.365

FILE NAME =	USER NAME = shererjm	DESIGNED -	REVISED -
ct:\pw\work\PIWIDOT\SHERERJM\dms86674\0570388-sh1-ATB.dgn		DRAWN -	REVISED -
	PLOT SCALE = 40.0000' / IN.	CHECKED -	REVISED -
	PLOT DATE = 10/13/2009	DATE -	REVISED -

STATE OF ILLINOIS
 DEPARTMENT OF TRANSPORTATION

ALIGNMENT CROSS TIES & BENCHMARKS

SCALE: NONE SHEET NO. 1 OF 1 SHEETS STA. TO STA.

F.A.S. RTE.	SECTION	COUNTY	TOTAL SHEETS	SHEET NO.
1517	12VBR-1	PIATT	168	14
CONTRACT NO. 70388				
FED. ROAD DIST. NO. ILLINOIS FED. AID PROJECT				

EARTHWORK SCHEDULE

STATION	TO	STATION	20200100	EARTH EX	20400800		
			EARTH	ADJUSTED	FURNISHED		
			EXCAVATION	FOR	EXCAVATION		
			(CU YD)	SHRINKAGE	EMBANKMENT	(CU YD)	
				(CU YD)	(CU YD)		
US 150							
LT	276+00.00	LT	288+87.17	7457.0	5592.8	5950.0	-357.3
RT	276+00.00	RT	288+87.17	558.0	418.5	16241.2	-15822.7
LT	289+57.17	LT	302+50.00	11990.0	8992.5	9927.2	-934.7
RT	289+57.17	RT	302+50.00	517.0	387.8	22552.2	-22164.5
SUB-TOTAL =			20522.0	15391.5	54670.6	-39279.1	
ALLEY RE-ALIGNMENT							
LT	0+38.00	LT	3+75.00	218.0	163.5	507.0	-343.5
RT	0+38.00	RT	3+75.00	81.0	60.8	336.0	-275.3
SUB-TOTAL =			299.0	224.3	843.0	-618.8	
TOTAL =			20821.0	15615.8	55513.6	-39897.9	
USE =			20821.0	15616.0	55514.0	39898.0	

*FURNISHED EXCAVATION = EARTH EXCAVATION X ADJUSTMENT FACTOR (0.75) - EMBANKMENT

SEE CROSS-SECTIONS FOR CUT AND FILL AREAS

30200650 PROCESSING MODIFIED SOIL 12"

STATION	STATION	LENGTH	WIDTH	AREA	30201500	
					LIME	
		FT	FT	SQ YD	TON	
276+00.00	288+04.37	1204.37	29.0	3881.0	87.0	
288+04.37	288+40.37	36.00	29.0	116.0	3.0	
290+04.37	290+40.37	36.00	29.0	116.0	3.0	
290+40.37	303+00.00	1259.63	29.0	4059.0	91.0	
TOTAL =					8172.0	184.0

31100300 SUB-BASE GRANULAR MATERIAL, TYPE A 4"

STATION	TO	STATION	LENGTH	WIDTH	AREA
			FT	FT	SQ YD
288+04.37		288+40.37	36.0	35.0	140.0
290+04.37		290+40.37	36.0	35.0	140.0
TOTAL =			280.0		

31102100 SUB-BASE GRANULAR MATERIAL, TYPE C 4"

STATION	TO	STATION	LENGTH	WIDTH	AREA
			FT	FT	SQ YD
LT	283+08.38	288+04.37	496.0	4.27	236.0
RT	283+08.38	288+04.37	496.0	4.27	236.0
LT	290+40.37	295+44.38	504.0	4.27	240.0
RT	290+40.37	296+07.80	567.4	4.27	270.0
TOTAL =			982.0		

35100700 AGGREGATE BASE COURSE, TYPE A 8"

STATION	TO	STATION	LENGTH	WIDTH	AREA
			FT	FT	SQ YD
LT	0+12.85	0+69.00	56.0	VAR	384.0
RT	200+00.00	200+25.00	25.0	VAR	153.0
LT	299+12.88	300+14.83	VAR	5.0	55.0
TOTAL =			592.0		

35101800 AGGREGATE BASE COURSE, TYPE B 6"

STATION	LENGTH	WIDTH	AREA	
	FT	FT	SQ YD	
RT	301+25.80	VAR	3.0	26.0
TOTAL =			26.0	

FILE NAME =	USER NAME = shererjm	DESIGNED - CMS	REVISED -
ct:\pw\work\PIWIDOT\SHERRERJM\dms86674\70888plansheets.dgn		DRAWN - JRP	REVISED -
	PLOT SCALE = 40.0000' / IN.	CHECKED -	REVISED -
	PLOT DATE = 10/13/2009	DATE - 03-25-2008	REVISED -

**STATE OF ILLINOIS
DEPARTMENT OF TRANSPORTATION**

SCHEDULES OF PLAN PAY ITEMS

SCALE: 1" = 20' SHEET NO. 1 OF 3 SHEETS STA. 269+25.00 TO STA. 275+25.00

F.A.S. RTE.	SECTION	COUNTY	TOTAL SHEETS	SHEET NO.
1517	12VBR-1	PIATT	168	15
CONTRACT NO. 70388			ILLINOIS FED. AID PROJECT	

40200800 AGGREGATE SURFACE COURSE, TYPE B

	STATION	TO	STATION	LENGTH FT	WIDTH FT	THICKNESS INCHES	TONS
LT	0+69.00		3+75.00	306.0	VAR	6.0	201.0
LT	3+75.00		9+00.00	525.0	VAR	6.0	257.0
RT	200+25.00		205+11.60	486.6	12.0	6.0	195.0
RT	301+25.80		-	VAR	VAR	6.0	23.0
TOTAL =							676.0

HOT-MIX ASPHALT CALCULATIONS

STATION	TO	STATION	LENGTH FT	WIDTH FT	AREA SQ YD	THICKNESS INCHES	40600100	40600300	40603310	40701941
							BIT MATLS PR CT	AGG PR CT	HMA SC "C" N50	HMA PVT FD, 13"
							GAL	TON	TON	SQ YD
273+00.00		276+00.00	300.0	26.0	866.7	1.5	86.7	1.7	72.8	-
276+00.00		288+04.37	1204.4	26.0	3479.3	13.0	350.0	7.0	-	3479.0
290+40.37		303+00.00	1259.6	26.0	3638.9	13.0	363.9	7.3	-	3639.0
303+00.00		304+00.00	100.0	26.0	288.9	1.5	28.9	0.6	24.3	-
TOTAL =							829.4	16.5	97.1	7118.0
USE =							830.0	17.0	98.0	7118.0

INCIDENTAL HMA SURFACE

STATION		AREA SQ YD	4080010	4080030	40800050
			BIT MATLS PR GALLON	AGG PR CT TON	INCD HMA TON
296+75.00	LT	384.0	38.4	0.8	43.0
299+51.00	LT	232.1	23.2	0.5	26.0
300+75.09	RT	153.0	15.3	0.3	17.1
301+25.80	RT	26.0	2.6	0.1	2.9
TOTAL =			79.5	1.6	89.1
USE =			80.0	2.0	89.0

48101200 AGGREGATE SHOULDERS, TYPE B

	STATION	TO	STATION	LENGTH FT	WIDTH FT	THICKNESS INCHES	TONS
LT/RT	273+00.00		276+00.00	300.0	3.0	1.5	45.0
LT/RT	303+00.00		304+00.00	100.0	3.0	1.5	15.0
TOTAL =							60.0

48203029 HOT-MIX ASPHALT SHOULDERS, 8"

	STATION	TO	STATION	LENGTH FT	WIDTH FT	AREA SQ YD
LT	283+08.38		285+50.38	242.00	3.0	81.0
RT	283+08.38		285+50.38	242.0	3.0	81.0
LT	285+58.38		288+04.37	246.0	3.0	82.0
RT	285+58.38		288+04.37	246.0	3.0	82.0
LT	290+40.37		292+86.38	246.0	3.0	82.0
RT	290+40.37		292+86.38	246.0	3.0	82.0
LT	292+94.38		295+36.40	242.0	3.0	81.0
RT	292+94.38		295+36.40	242.0	3.0	81.0
RT	295+44.40		296+07.38	63.0	3.0	42.0
TOTAL =						694.0

66101150 HOT-MIX ASPHALT SHOULDERS CURB

	STATION	TO	STATION	LENGTH FT
LT	283+08.38		285+50.38	242.0
RT	283+08.38		285+50.38	242.0
LT	285+58.38		288+04.37	246.0
RT	285+58.38		288+04.37	246.0
LT	290+40.37		292+86.38	246.0
RT	290+40.37		292+86.38	246.0
LT	292+94.38		295+36.40	242.0
RT	292+94.38		295+36.40	242.0
RT	295+44.40		296+07.38	63.0
TOTAL =				2078.0

EXTRA SHOULDER MATERIAL TO CONSTRUCT
THE HMA SHOULDER CURB SHALL NOT BE
PAID FOR SEE ART. 661.04

48101500 AGGREGATE SHOULDERS, TYPE B 6"

	STATION	TO	STATION	LENGTH FT	WIDTH FT	THICKNESS INCHES	TONS
LT/RT	276+00.00		283+08.38	708.4	3.0	6.0	472.0
RT	296+45.15		299+04.70	259.5	3.0	6.0	87.0
LT	297+44.57		299+13.00	168.4	3.0	6.0	56.0
RT	299+94.70		300+84.20	89.5	3.0	6.0	30.0
LT	300+13.00		304+00.00	387.0	3.0	6.0	129.0
RT	301+74.00		304+00.00	226.0	3.0	6.0	75.0
LT	0+13.00		0+56.00	120.0	3.0	6.0	40.0
RT	0+13.00		0+56.00	70.0	3.0	6.0	23.0
TOTAL =							912.0

66600105 FURNISHING AND ERECTING RIGHT-OF-WAY MARKERS

STATION	O/S	EACH
273+00.18	29.80' RT	1.0
283+00.00	51.20' RT	1.0
285+50.00	73.71' RT	1.0
289+09.24	77.31' RT	1.0
289+76.31	77.99' RT	1.0
294+50.00	82.74' RT	1.0
269+20.00	84.45' RT	1.0
300+08.78	88.35' RT	1.0
299+99.95	56.26' RT	1.0
TOTAL =		9.0

CARE SHALL BE TAKEN NOT TO DISTURB ANY R.O.W. MARKERS NOT SHOWN ON THIS LIST. SHOULD THE CONTRACTOR DISTURB ANY ADDITIONAL MARKERS, THEY SHALL BE REPLACED AT THE CONTRACTOR'S EXPENSE.

XZ193300 SURVEY MARKER, TYPE 1(SPECIAL)

STATION	DESCR.	EACH
273+00.18	PC	1.0
274+21.01	PT	1.0
302+91.47	PC	1.0
303+88.57	PT	1.0
TOTAL =		4.0

RAISED REFLECTIVE PAVEMENT MARKERS

STATION	TO	STATION	LENGTH FOOT	78100100 RAISED REF PVT MKRS EACH	78100105 RRPM BRIDGE EACH	78300200 RRPM REM EACH
273+00.00		304+00.00	3100.00	36.0	3.0	36.0
TOTAL =				36.0	3.0	36.0

78001110 PAINT PAVEMENT MARKING LINE 4"

STATION	TO	STATION	LENGTH FOOT	WHITE EDGE LINE FOOT	YELLOW CENTER LINE SKIP DASH FOOT	YELLOW NO PASSING ZONE FOOT
273+00.00		304+00.00	3100.0	6200.0	1023.0	
LT 278+00.00		291+00.00	1300.0			1300.0
RT 287+90.00		299+50.00	1160.0			1160.0
SUB-TOTAL =				6200.0	1023.0	2460.0
TOTAL =				9683.0		

78001180 PAINT PAVEMENT MARKING LINE 24"

STATION	WHITE STOP BAR LENGTH FOOT	
0+35.73	22.0	
TOTAL =		22.0

ADDITIONAL SCHEDULE NOTES:

SEE G.N. Z0038 FOR INFORMATION CONCERNING PERMANENT BENCH MARKS

SEE SCHEDULES OF REMOVAL SHEET(S) 51-52

SEE SCHEDULES OF EROSION CONTROL SHEET(S) 59


SEE SCHEDULES OF DRAINAGE SHEET(S) 68

SEE GUARDRAIL DETAILS SHEET(S) 72


SEE SCHEDULES OF REMOVAL SHEET(S) 51-52
 SEE SCHEDULES OF EROSION CONTROL SHEET(S) 59
 SEE SCHEDULES OF DRAINAGE SHEET(S) 68
 SEE GUARDRAIL DETAILS SHEET(S) 72

SECTION 3, T20N, R6E, 3RD PM

PROP. CURVE U.S. 150
 PI STA. = 273+60.59
 Δ = 0° 36' 13" (LT)
 D = 0° 29' 58"
 R = 11,470.00'
 T = 60.41'
 L = 120.83'
 E = 0.16'
 e = -----
 T.R. = -----
 S.E. RUN = -----
 P.C. STA = 273+00.18
 P.T. STA = 274+21.01

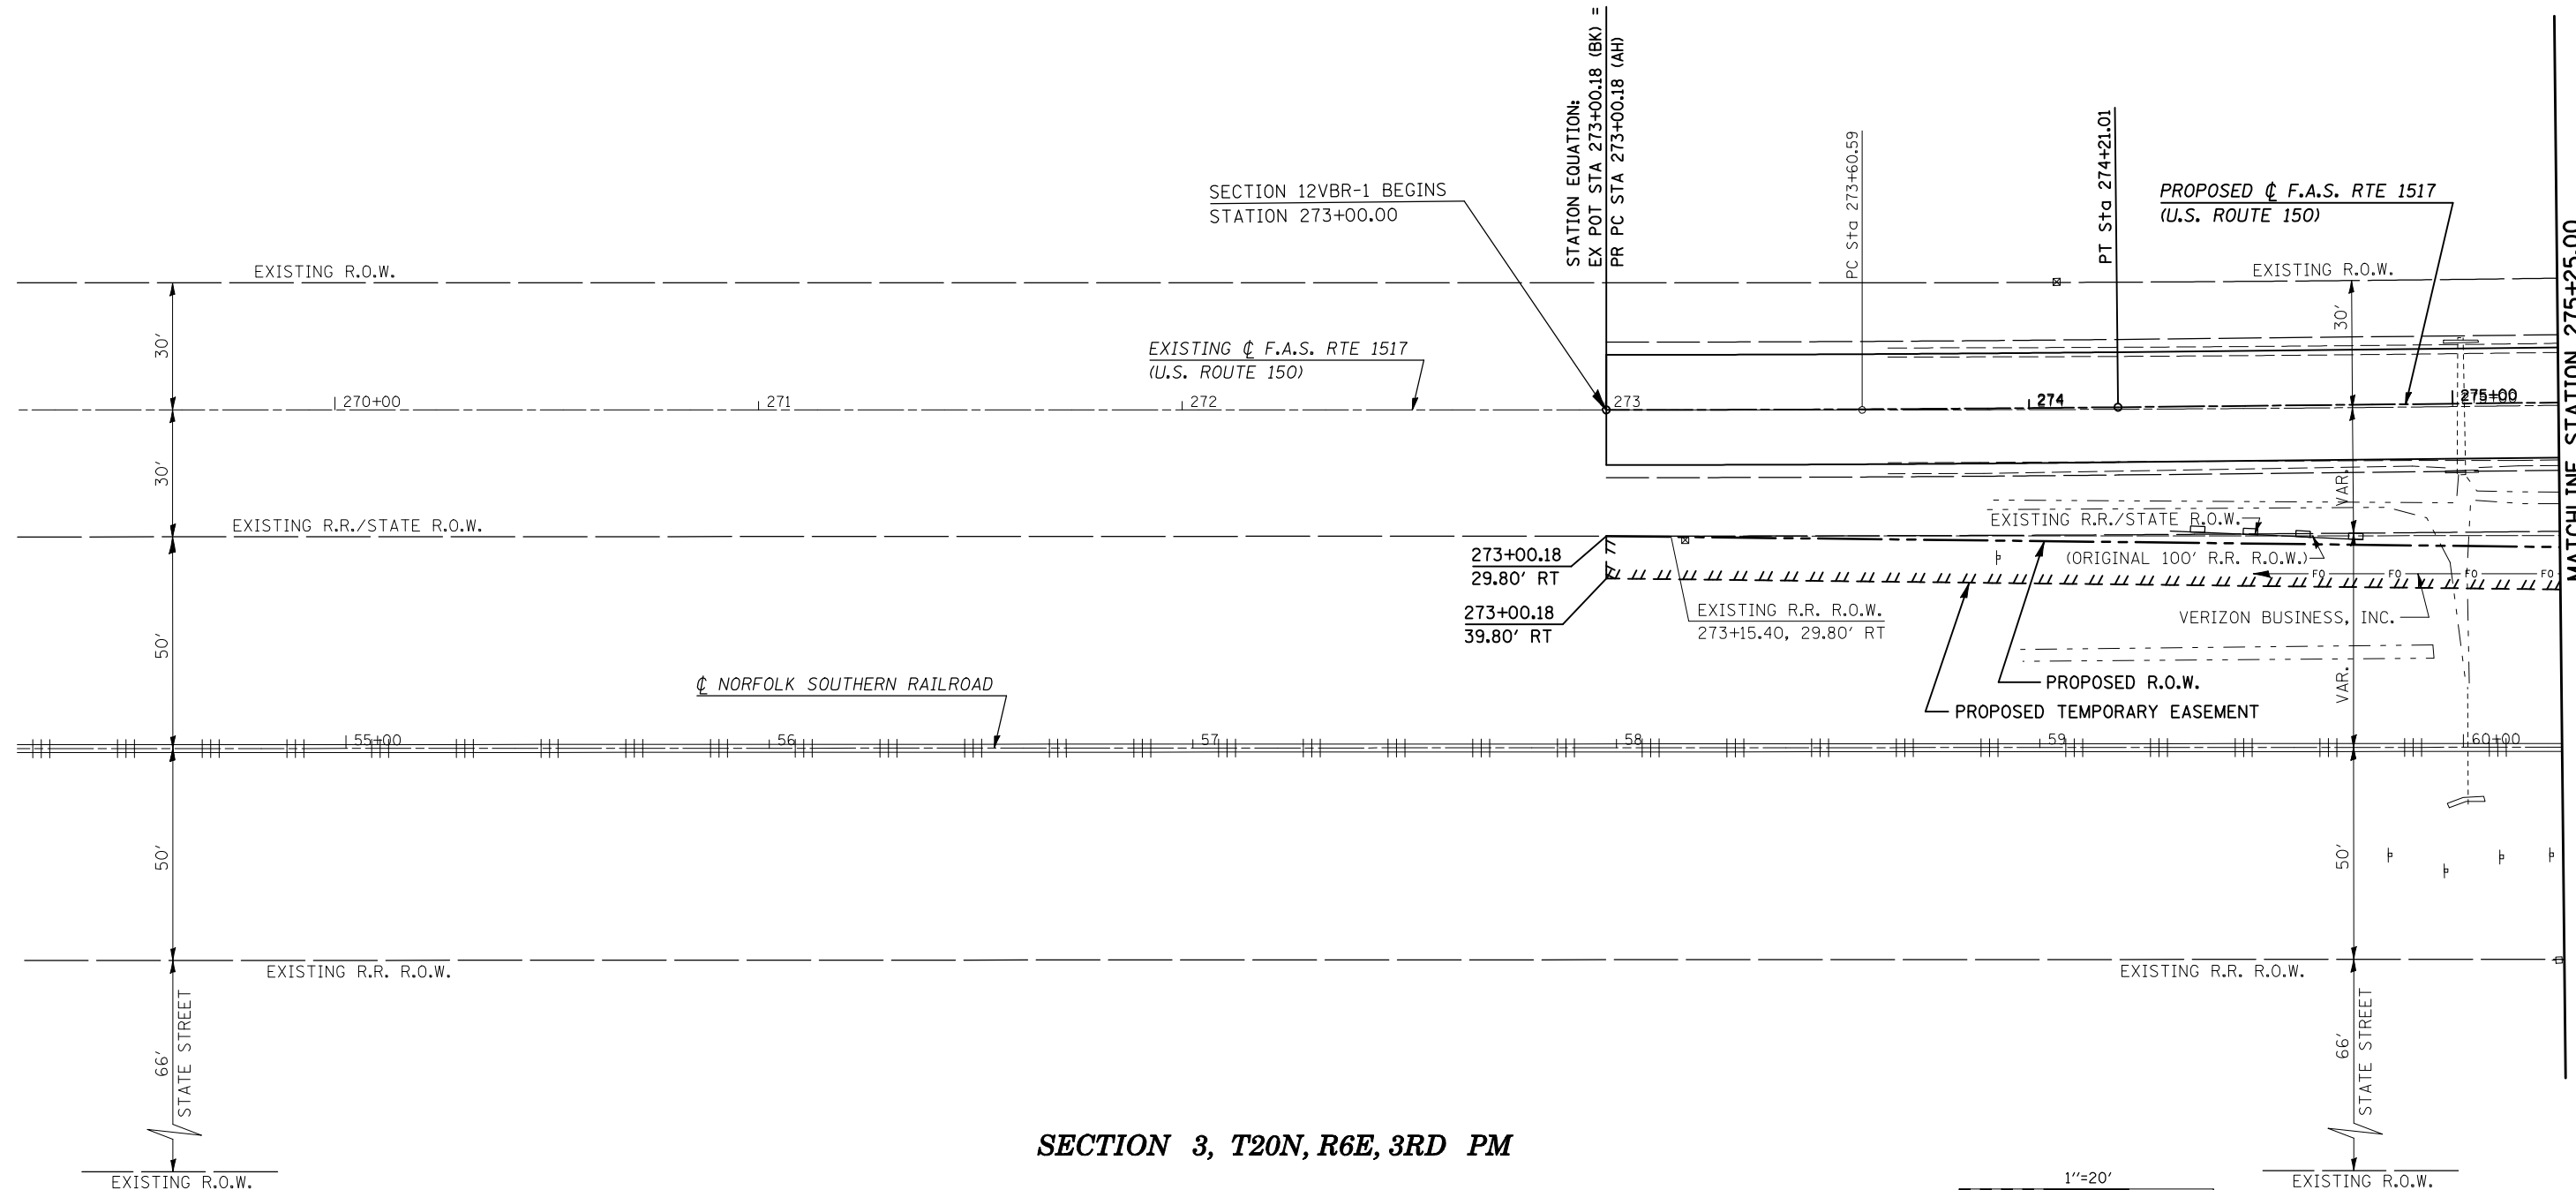

SECTION 3, T20N, R6E, 3RD PM

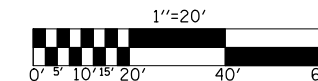

FILE NAME =	USER NAME = shererjm	DESIGNED - CMS	REVISED -
ct:\pw\work\PWIDOT\SHERERJM\dms86674\70388plansheets.dgn		DRAWN - JRP	REVISED -
	PLOT SCALE = 40.0000' / IN.	CHECKED -	REVISED -
	PLOT DATE = 10/13/2009	DATE - 03-25-2008	REVISED -

**STATE OF ILLINOIS
 DEPARTMENT OF TRANSPORTATION**

PLAN (U.S. ROUTE 150)
 SCALE: 1" = 20' SHEET NO. 1 OF 12 SHEETS STA. 269+25.00 TO STA. 275+25.00

F.A.S. RTE.	SECTION	COUNTY	TOTAL SHEETS	SHEET NO.
1517	12VBR-1	PIATT	168	18
CONTRACT NO. 70388				
FED. ROAD DIST. NO. ILLINOIS FED. AID PROJECT				

PLAN	SURVEYED	BY	DATE
NOTE BOOK NO.	PLOTTED		
	GRADES CHECKED		
	STRUCTURE NOTATIONS OK'D		

PROFILE	SURVEYED	BY	DATE
NOTE BOOK NO.	PLOTTED		
	GRADES CHECKED		
	STRUCTURE NOTATIONS OK'D		



FILE NAME =	USER NAME = shererjm	DESIGNED - CMS	REVISED -
ct:\pw\work\PWIDOT\SHERERJM\dms86674\70388\plan\shets.dgn		DRAWN -	REVISED -
PLOT SCALE = 40.0000' / IN.		CHECKED -	REVISED -
PLOT DATE = 10/13/2009		DATE -	REVISED -

**STATE OF ILLINOIS
DEPARTMENT OF TRANSPORTATION**

PROFILE (U.S. ROUTE 150)


SCALE: V=5 H=20 SHEET NO. 2 OF 12 SHEETS STA. 269+25.00 TO STA. 275+25.00

F.A.S. RTE.	SECTION	COUNTY	TOTAL SHEETS	SHEET NO.
1517	12VBR-1	PIATT	168	19
FED. ROAD DIST. NO.			ILLINOIS FED. AID PROJECT	
			CONTRACT NO. 70388	


SEE SCHEDULES OF REMOVAL SHEET(S) 51-52
 SEE SCHEDULES OF EROSION CONTROL SHEET(S) 59
 SEE SCHEDULES OF DRAINAGE SHEET(S) 68
 SEE GUARDRAIL DETAILS SHEET(S) 72

SECTION 3, T20N, R6E, 3RD PM

EXIST. CURVE US 150
 P.I. STA. = 276+75.42
 $\Delta = 2^\circ 54' 42''$ (LT)
 $D = 0^\circ 27' 45''$
 $R = 12,387.92'$
 $T = 314.83'$
 $L = 629.53'$
 $E = 4.00'$
 $e = \text{-----}$
 $T.R. = \text{-----}$
 $S.E. \text{ RUN} = \text{-----}$
 P.C. STA. = 273+60.59
 P.T. STA. = 279+90.12

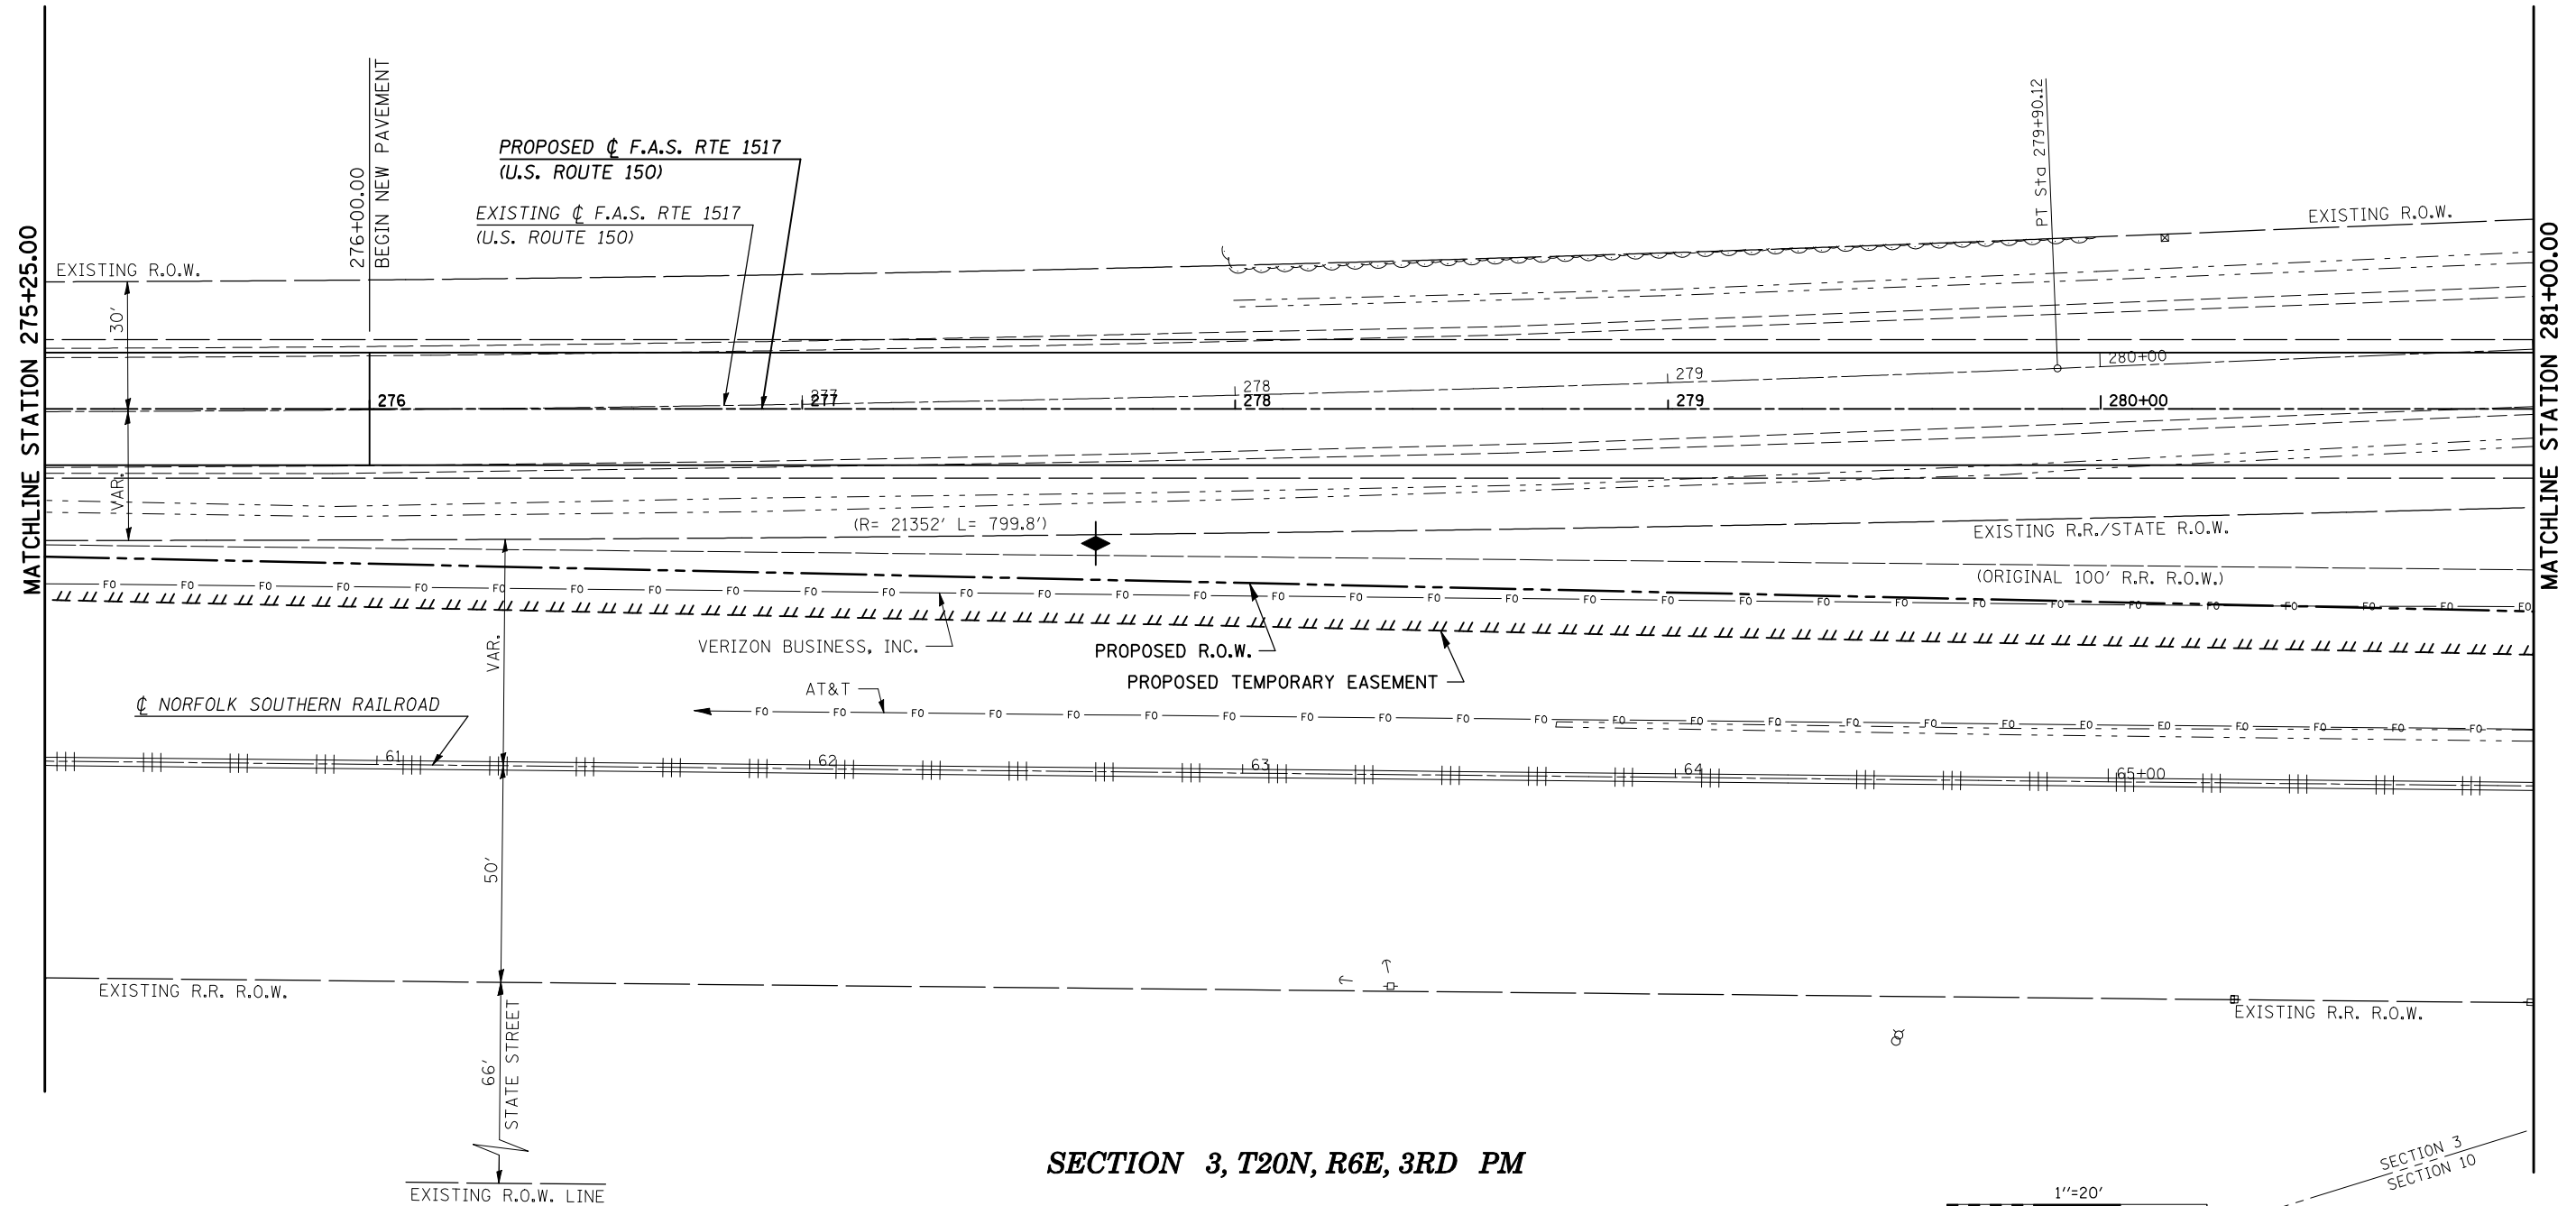

SECTION 3, T20N, R6E, 3RD PM

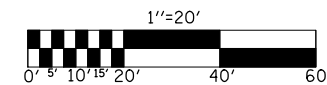


SECTION 3
 SECTION 10

FILE NAME = c:\pw\work\PIWID01\SHERERJM\dms86674\70388plansheets.dgn	USER NAME = shererjm	DESIGNED - CMS	REVISED -	STATE OF ILLINOIS DEPARTMENT OF TRANSPORTATION	PLAN (U.S. ROUTE 150)			F.A.S. RTE. 1517	SECTION 12VBR-1	COUNTY PIATT	TOTAL SHEETS 168	SHEET NO. 20
	PLOT SCALE = 40.0000' / IN.	CHECKED -	REVISED -		SCALE: 1" = 20'	SHEET NO. 3 OF 12 SHEETS	STA. 275+25.00 TO STA. 281+00.00	CONTRACT NO. 70388				
	PLOT DATE = 10/13/2009	DATE - 03-25-2008	REVISED -		FED. ROAD DIST. NO. ILLINOIS FED. AID PROJECT							

PLAN	SURVEYED	BY	DATE
	PLOTTED		
	NOTED		
	CHECKED		
	NO. _____		
	CADD FILE NAME		

PROFILE	SURVEYED	BY	DATE
	PLOTTED		
	GRABES CHECKED		
	STRUCTURE NOTATION CHKD		
	NO. _____		

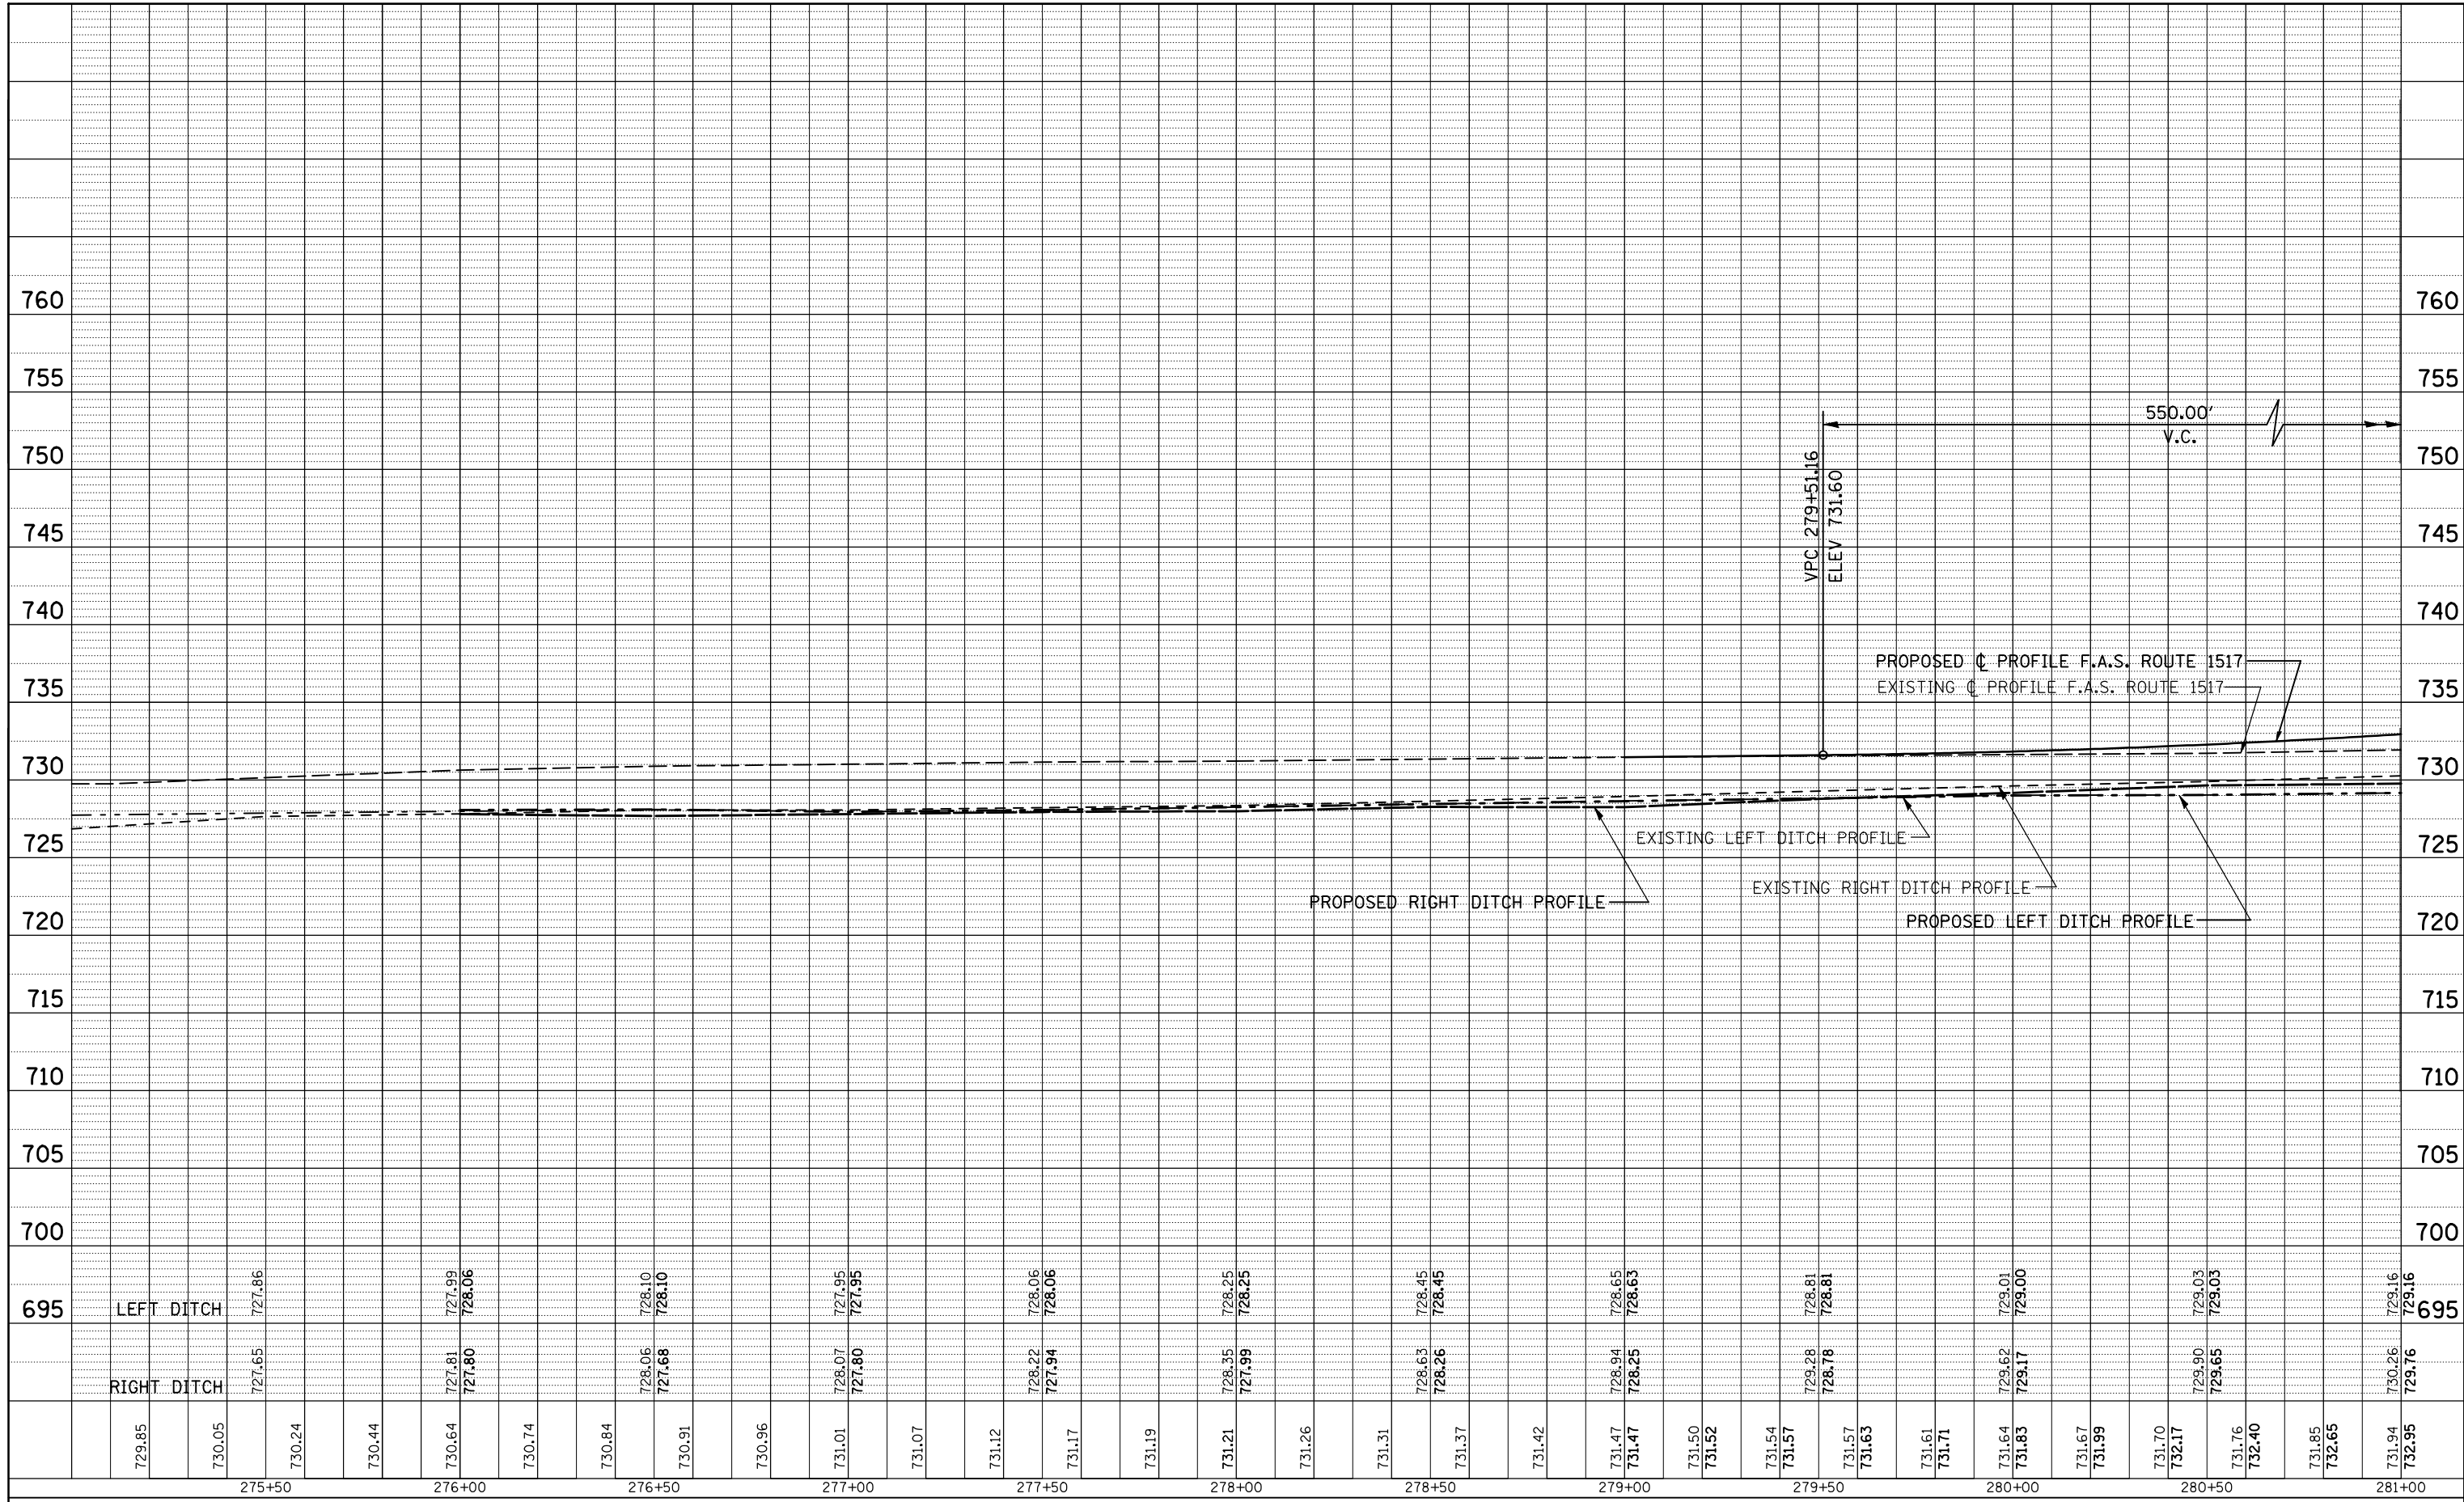

FILE NAME =	USER NAME = shererjm	DESIGNED - CMS	REVISED -
ct:\pw_work\PWIDOT\SHERERJM\dms86674\70388\plan sheets.dgn		DRAWN -	REVISED -
	PLOT SCALE = 40.0000' / IN.	CHECKED -	REVISED -
	PLOT DATE = 10/13/2009	DATE -	REVISED -


**STATE OF ILLINOIS
DEPARTMENT OF TRANSPORTATION**

PROFILE (U.S. ROUTE 150)		
SCALE: V=5 H=20	SHEET NO. 4 OF 12 SHEETS	STA. 275+25.00 TO STA. 281+00.00


F.A.S. RTE.	SECTION	COUNTY	TOTAL SHEETS	SHEET NO.
1517	12VBR-1	PIATT	168	21
CONTRACT NO. 70388				
FED. ROAD DIST. NO. ILLINOIS FED. AID PROJECT				

SECTION 3, T20N, R6E, 3RD PM

SEE SCHEDULES OF REMOVAL SHEET(S) 51-52
 SEE SCHEDULES OF EROSION CONTROL SHEET(S) 59
 SEE SCHEDULES OF DRAINAGE SHEET(S) 68
 SEE GUARDRAIL DETAILS SHEET(S) 72
 SEE STRUCTURE PLANS SHEET(S) 86-109

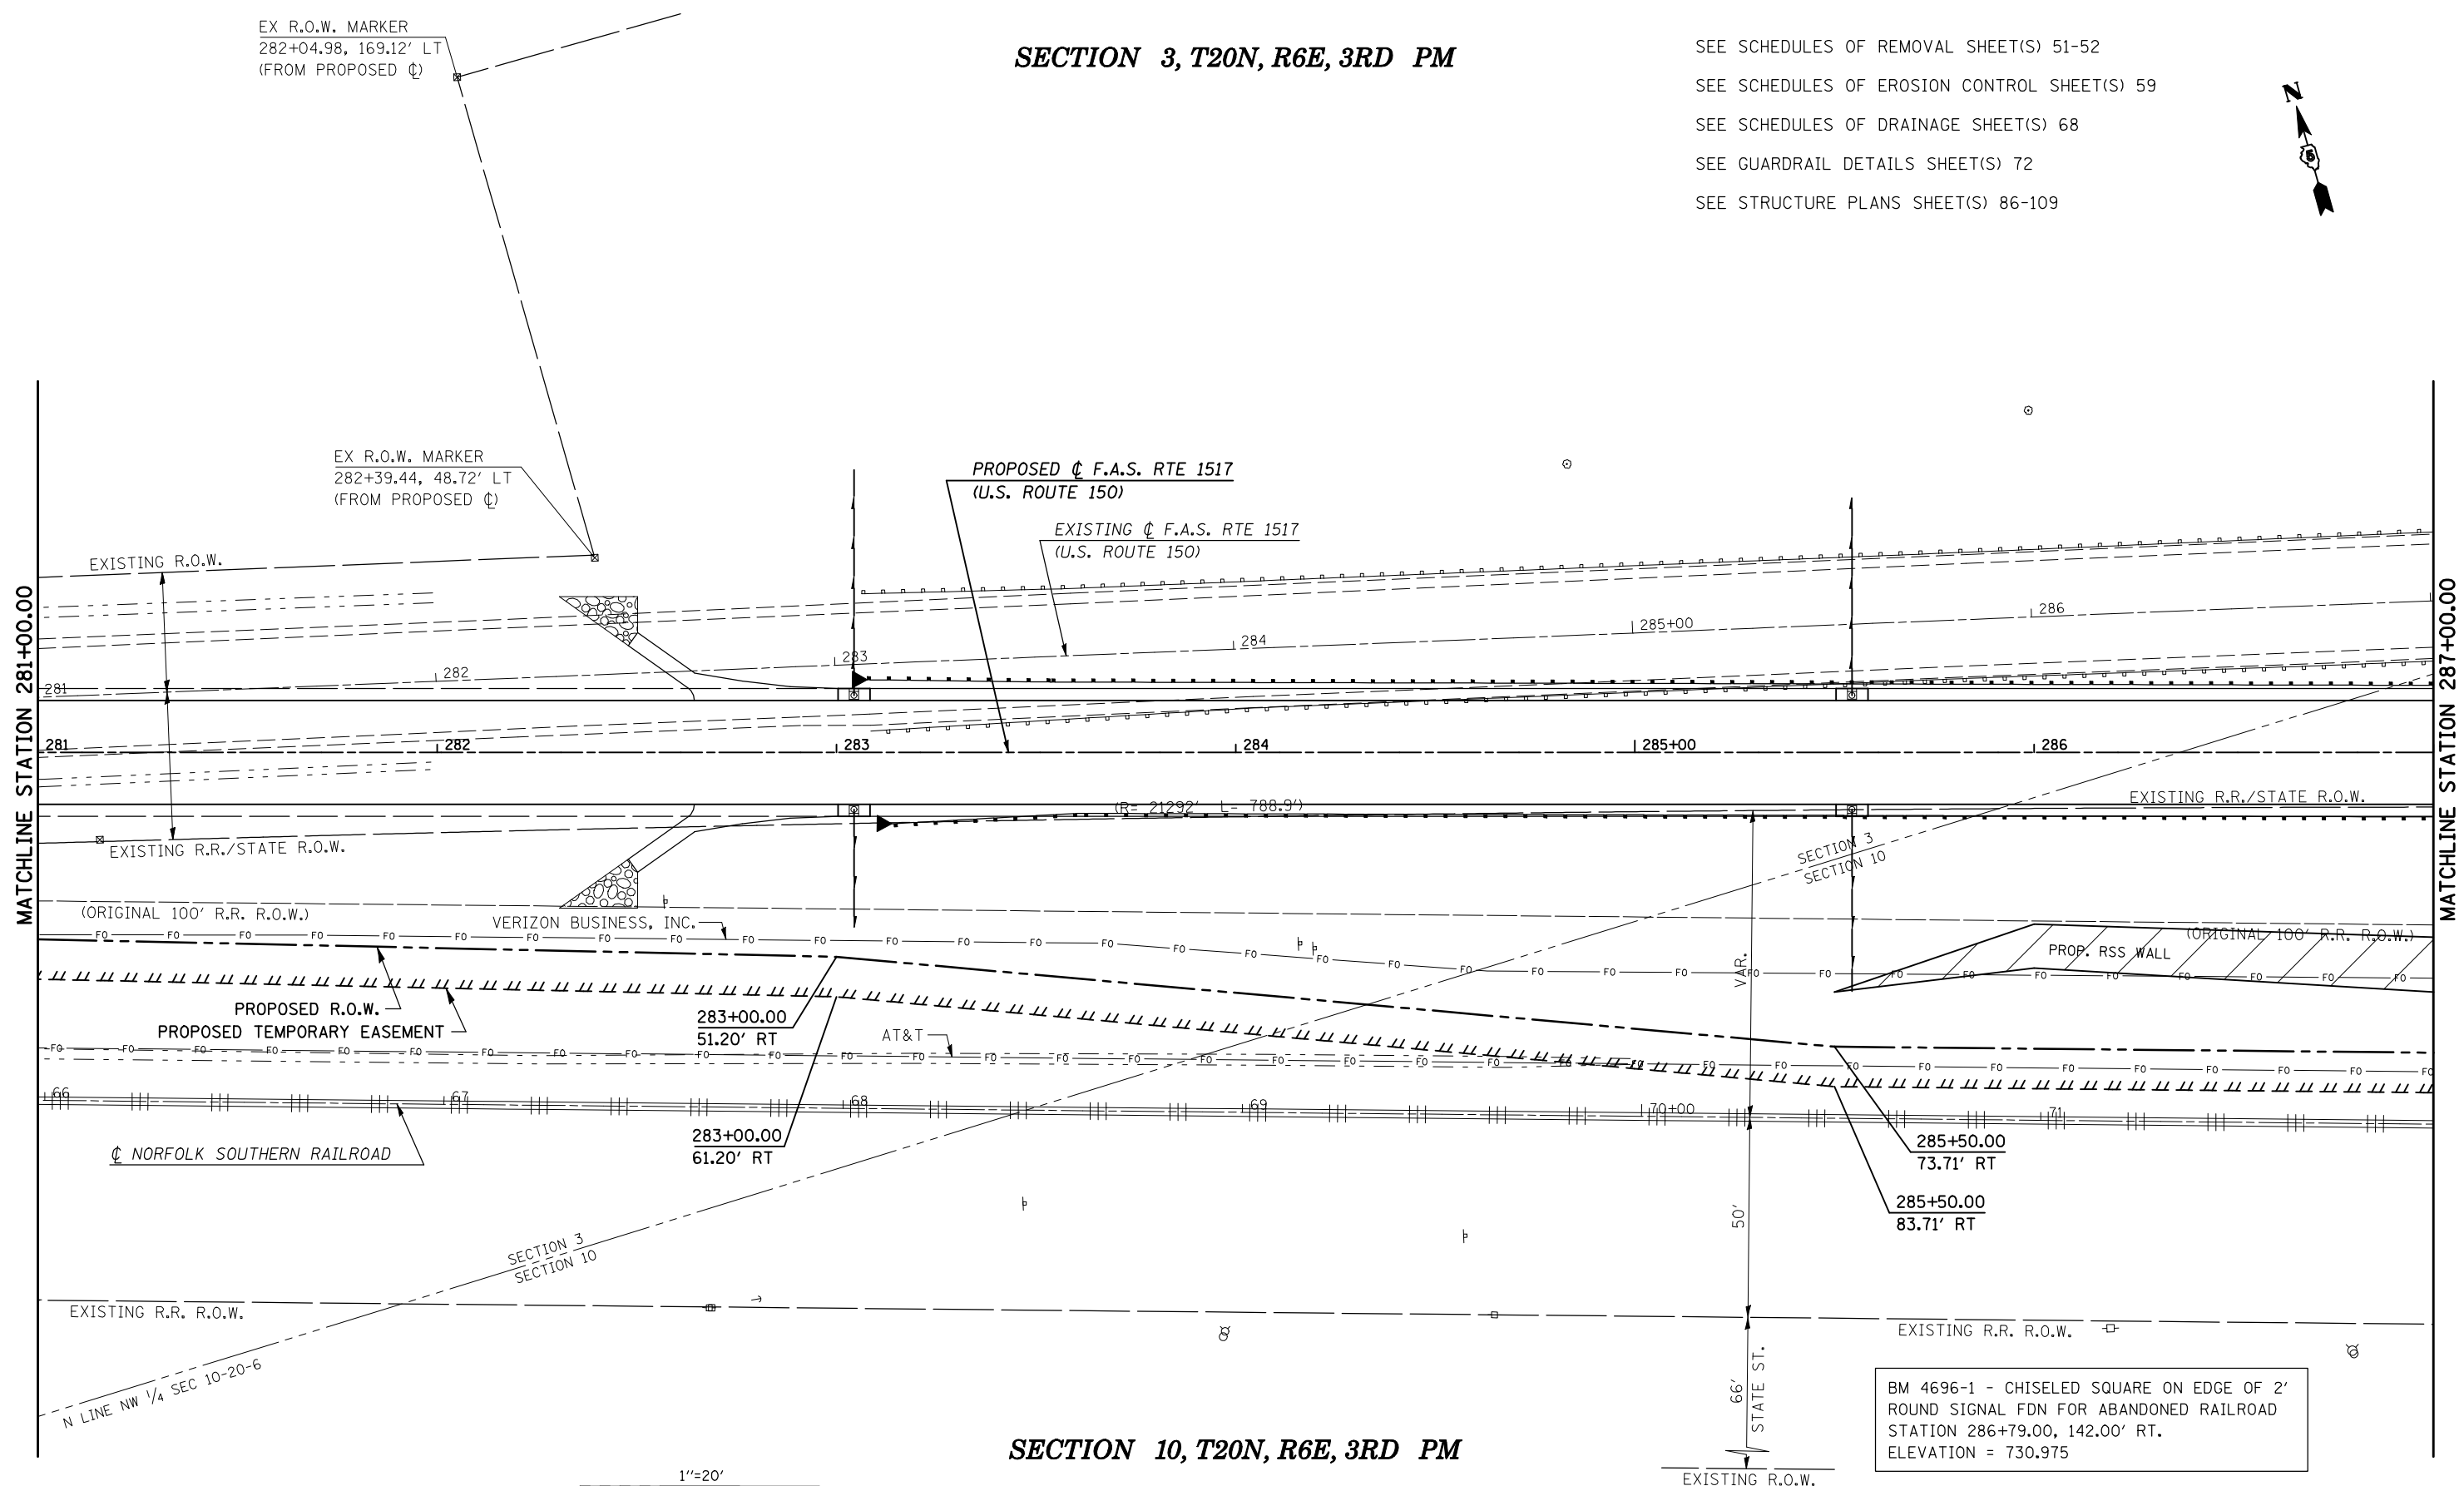


SECTION 10, T20N, R6E, 3RD PM

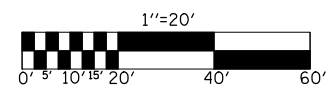

FILE NAME =	USER NAME = shererjm	DESIGNED - CMS	REVISED -	STATE OF ILLINOIS DEPARTMENT OF TRANSPORTATION	PLAN (U.S. ROUTE 150)	F.A.S. RTE.	SECTION	COUNTY	TOTAL SHEETS	SHEET NO.
ct:\pw\work\PIWIDOT\SHERERJM\dms86674\70888plansheets.dgn	DRAWN - JRP	REVISED -	1517			12VBR-1	PIATT	168	22	
PLOT SCALE = 40.0000' / IN.	CHECKED -	REVISED -	CONTRACT NO. 70388							
PLOT DATE = 10/13/2009	DATE - 03-25-2008	REVISED -	FED. ROAD DIST. NO. ILLINOIS FED. AID PROJECT							
					SCALE: 1" = 20'	SHEET NO. 5 OF 12 SHEETS	STA. 281+00.00 TO STA. 287+00.00			

PLAN	SURVEYED	BY	DATE
	PLOTTED		
	CHECKED		
	DATE		
	NO.		

PROFILE	SURVEYED	BY	DATE
	PLOTTED		
	CHECKED		
	DATE		
	NO.		

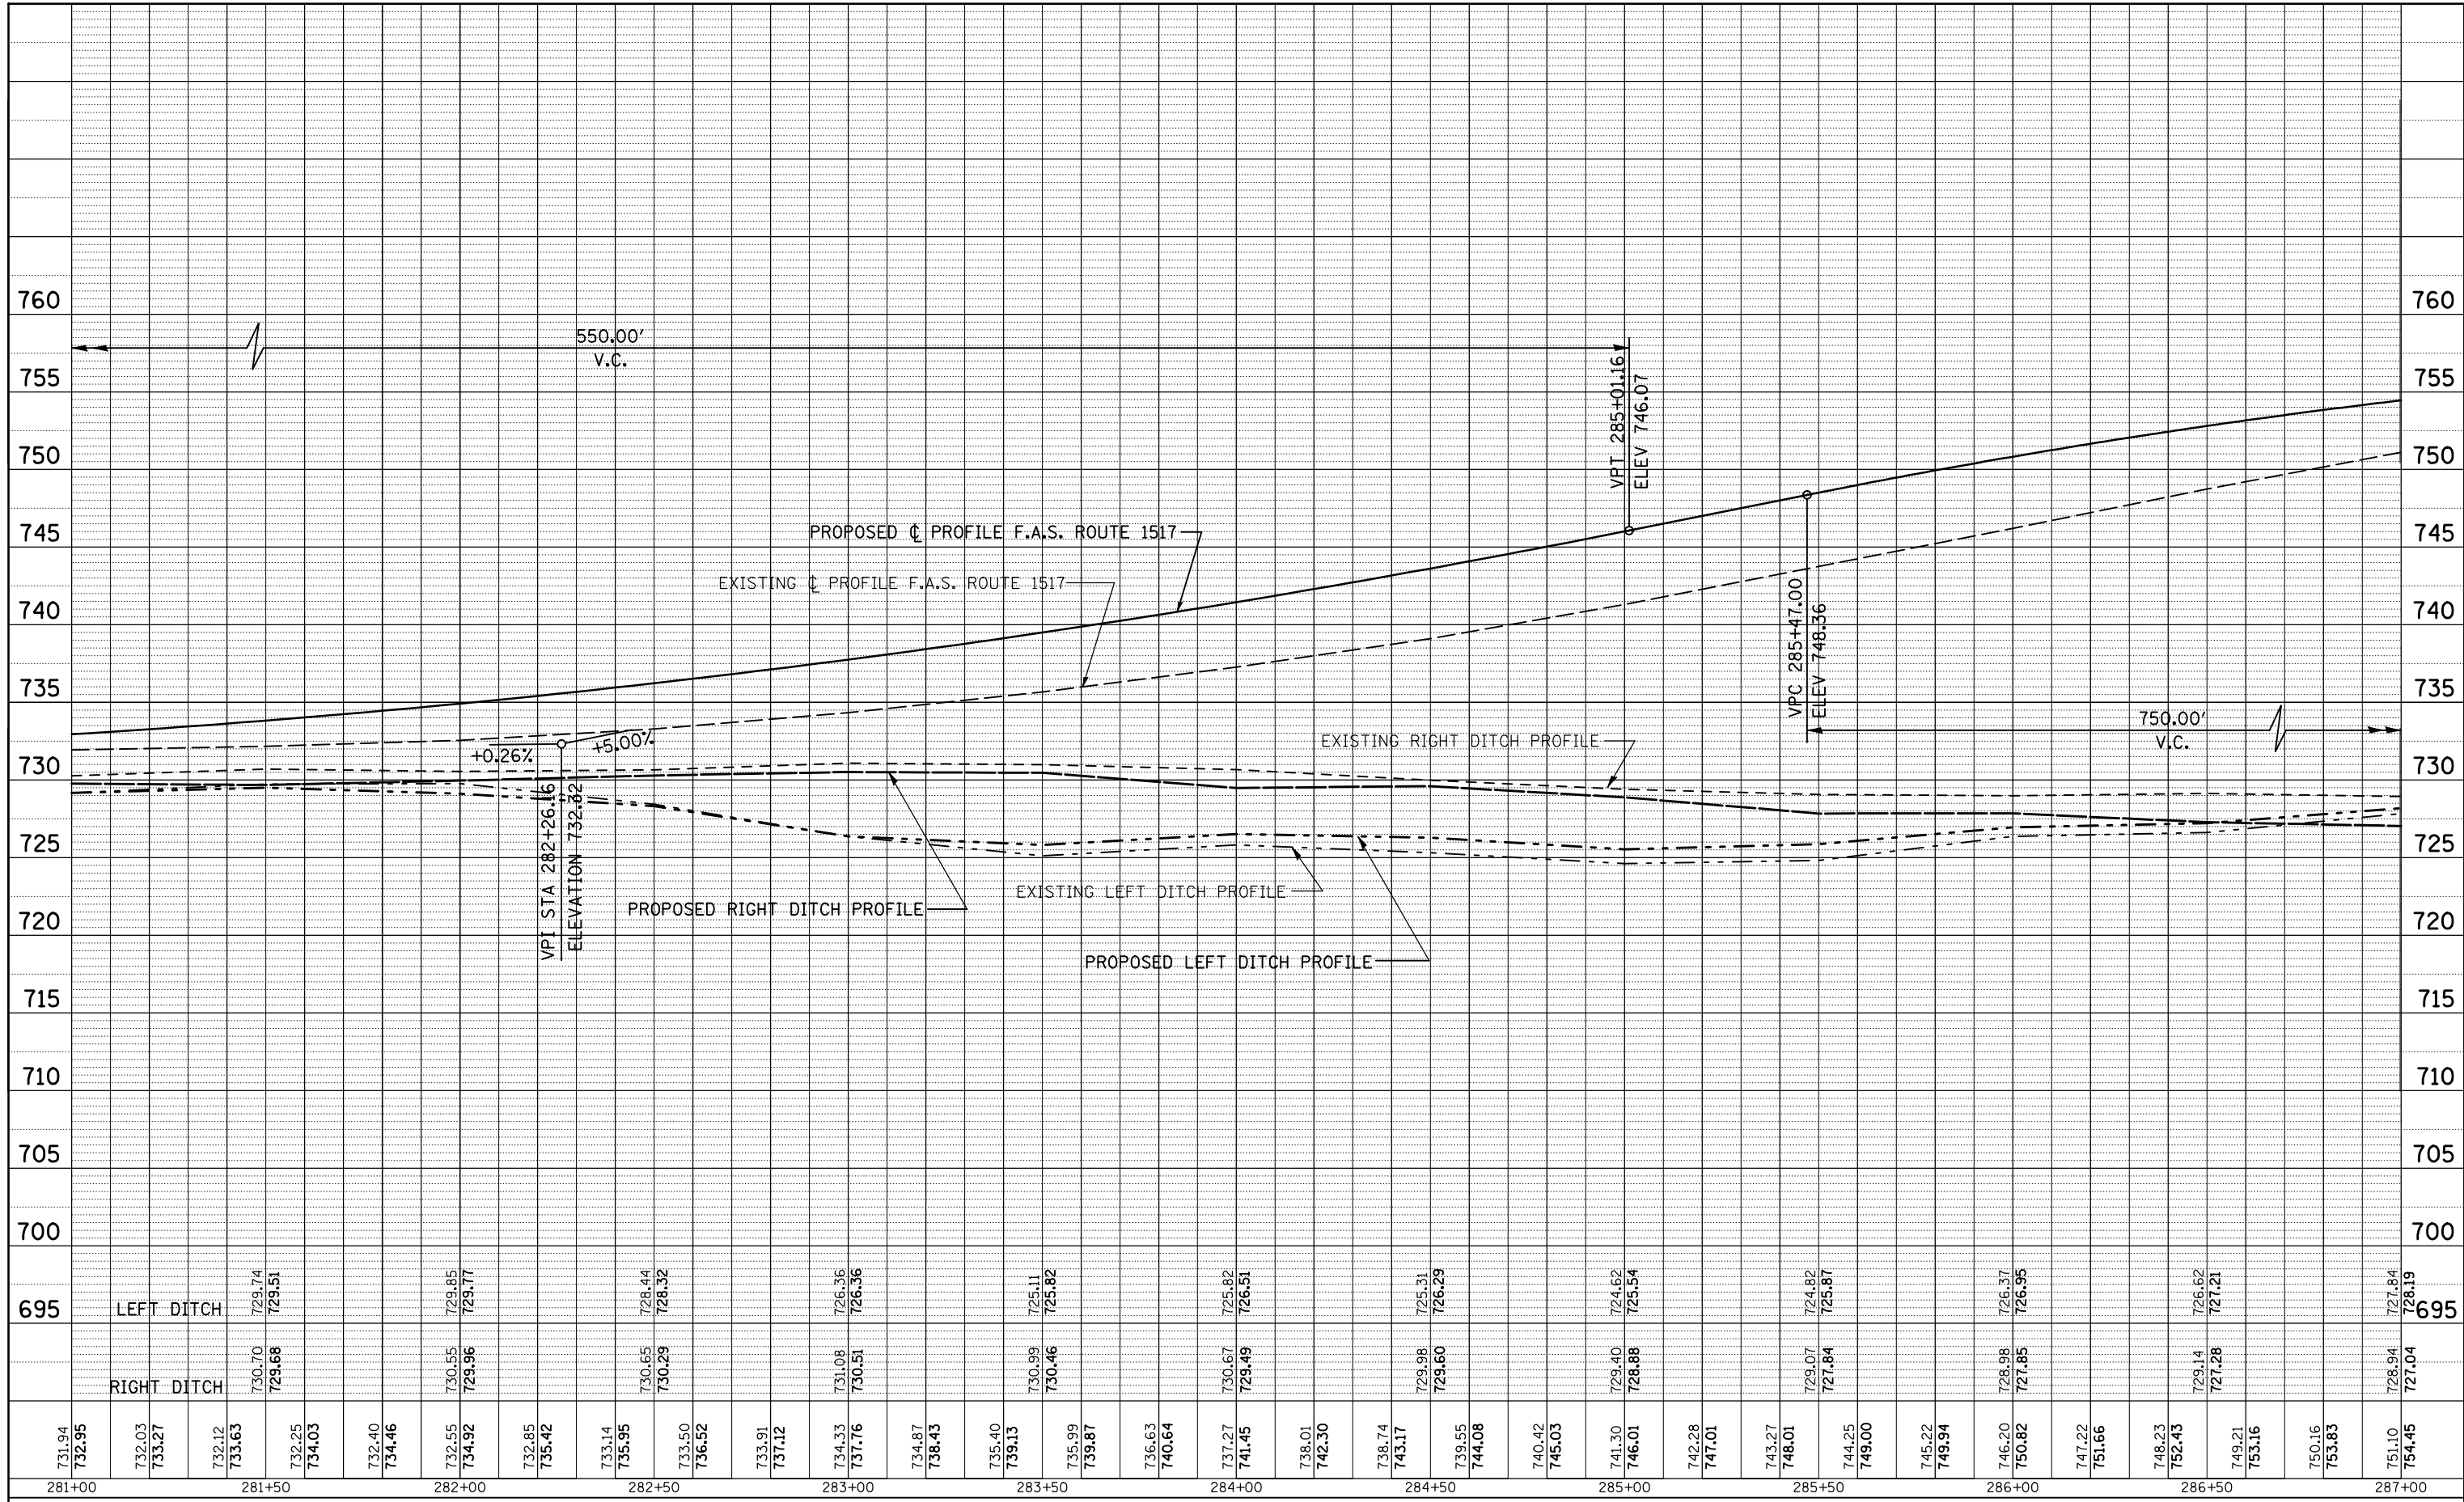

FILE NAME =	USER NAME = shererjm	DESIGNED - CMS	REVISED -
ct:\pwork\PWIDOT\SHERERJM\dms86674\70388\plan\sheet.dgn		DRAWN -	REVISED -
		CHECKED -	REVISED -
		DATE -	REVISED -

**STATE OF ILLINOIS
DEPARTMENT OF TRANSPORTATION**

PROFILE (U.S. ROUTE 150)


SCALE: V=5 H=20 SHEET NO. 6 OF 12 SHEETS STA. 281+00.00 TO STA. 287+00.00

F.A.S. RTE. 1517	SECTION 12VBR-1	COUNTY PIATT	TOTAL SHEETS 168	SHEET NO. 23
FED. ROAD DIST. NO.		ILLINOIS FED. AID PROJECT		
		CONTRACT NO. 70388		


SECTION 3, T20N, R6E, 3RD PM

SEE SCHEDULES OF REMOVAL SHEET(S) 51-52
 SEE SCHEDULES OF EROSION CONTROL SHEET(S) 59
 SEE SCHEDULES OF DRAINAGE SHEET(S) 68
 SEE GUARDRAIL DETAILS SHEET(S) 72
 SEE STRUCTURE PLANS SHEET(S) 86-109

EXIST. CURVE U.S. 150
 PI STA. = 291+82.95
 $\Delta = 8^\circ 27' 16''$ (RT)
 $D = 2^\circ 22' 05''$
 $R = 2,419.60'$
 $T = 178.84'$
 $L = 357.03'$
 $E = 6.60'$
 $e = \dots$
 $T.R. = \dots$
 $S.E. RUN = \dots$
 $P.C. STA. = 290+04.11$
 $P.T. STA. = 293+61.14$

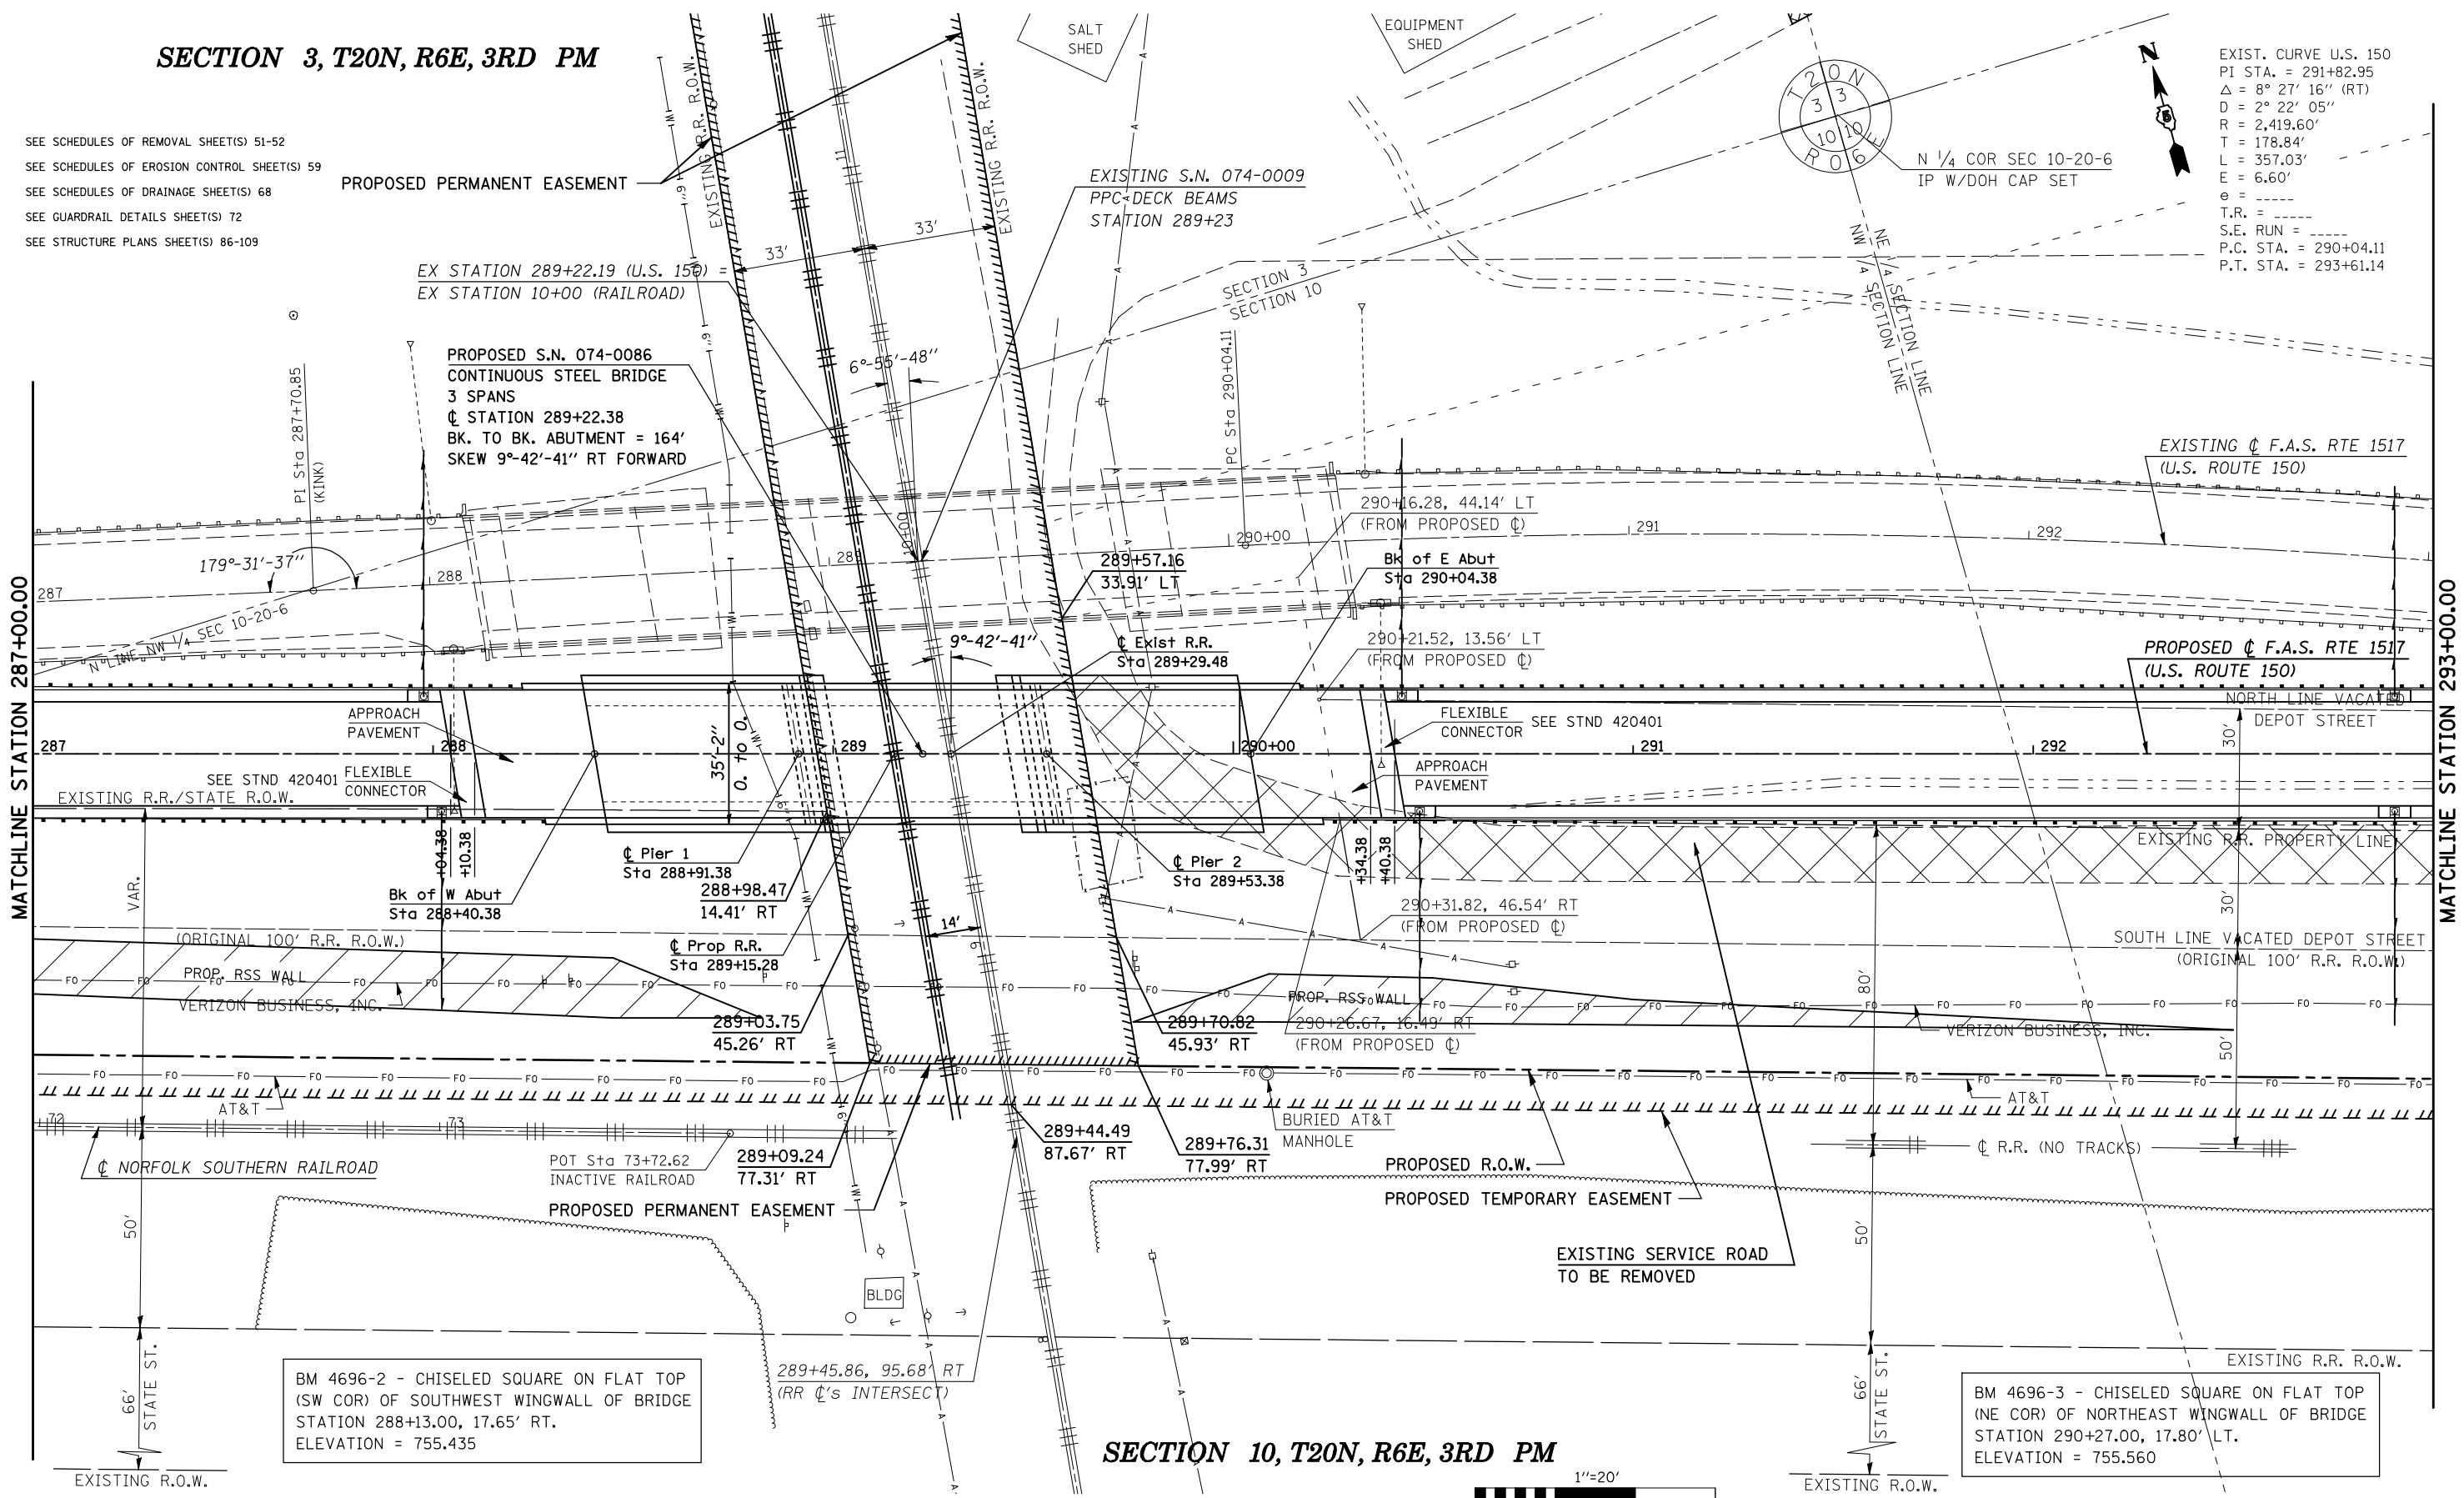

SECTION 10, T20N, R6E, 3RD PM

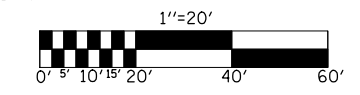

FILE NAME =	USER NAME = shererjm	DESIGNED - CMS	REVISED -
ca:\pw\work\PWID01\SHERRERJM\dms86674\70888plansheets.dgn		DRAWN - JRP	REVISED -
PLOT SCALE = 40.0000' / IN.		CHECKED -	REVISED -
PLOT DATE = 10/13/2009		DATE - 03-25-2008	REVISED -

**STATE OF ILLINOIS
 DEPARTMENT OF TRANSPORTATION**

PLAN (U.S. ROUTE 150)

SCALE: 1" = 20' SHEET NO. 7 OF 12 SHEETS STA. 287+00.00 TO STA. 293+00.00


F.A.S. RTE.	SECTION	COUNTY	TOTAL SHEETS	SHEET NO.
1517	12VBR-1	PIATT	168	24
CONTRACT NO. 70388				
FED. ROAD DIST. NO. ILLINOIS FED. AID PROJECT				

SEE SCHEDULES OF REMOVAL SHEET(S) 51-52
 SEE SCHEDULES OF EROSION CONTROL SHEET(S) 59
 SEE SCHEDULES OF DRAINAGE SHEET(S) 68
 SEE GUARDRAIL DETAILS SHEET(S) 72

EXIST. CURVE U.S. 150
 PI STA. = 297+18.45
 $\Delta = 4^\circ 57' 27''$ (LT)
 $D = 2^\circ 08' 47''$
 $R = 2,669.42'$
 $T = 115.56'$
 $L = 230.97'$
 $E = 2.50'$
 $e = \text{-----}$
 T.R. = -----
 S.E. RUN = -----
 P.C. STA. = 296+02.89
 P.T. STA. = 298+33.86

SECTION 10, T20N, R6E, 3RD PM

FOR PROPOSED ALLEY IMPROVEMENT
 INFORMATION SEE SHEET NO. 31-33

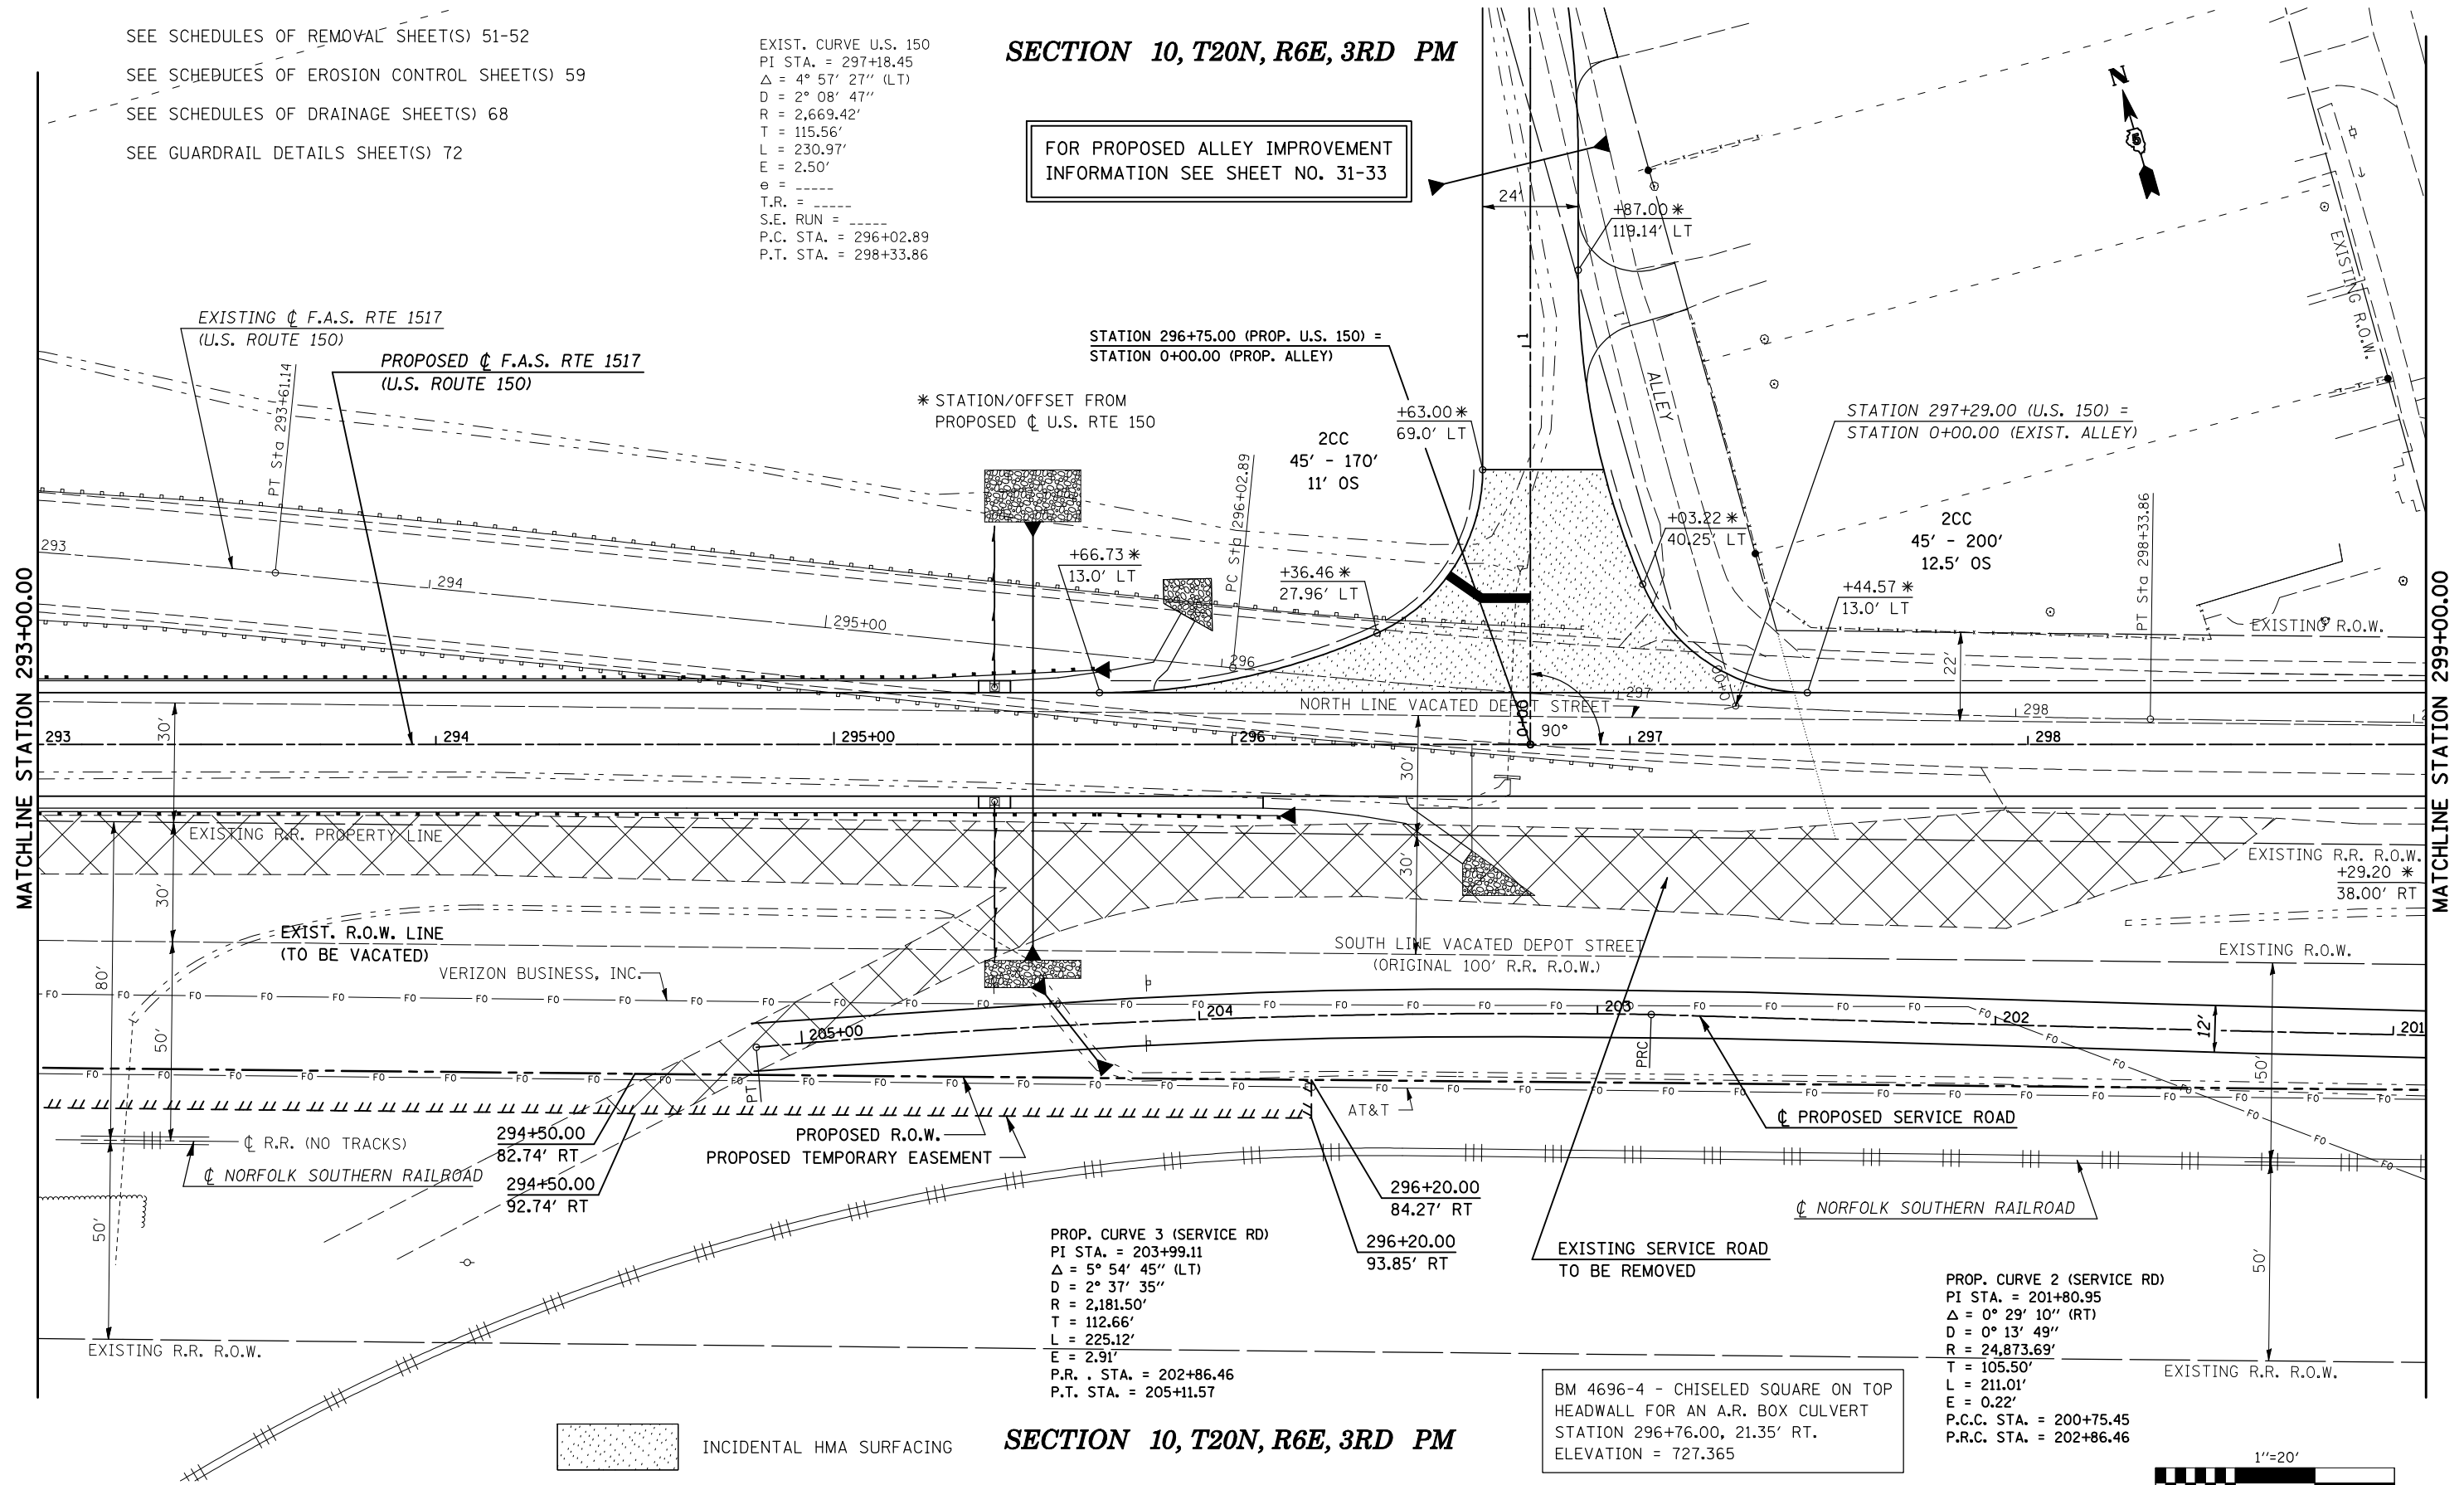

SECTION 10, T20N, R6E, 3RD PM


STATE OF ILLINOIS
 DEPARTMENT OF TRANSPORTATION

PLAN (U.S. ROUTE 150)

SCALE: 1" = 20' SHEET NO. 9 OF 12 SHEETS STA. 293+00.00 TO STA. 299+00.00

F.A.S. RTE.	SECTION	COUNTY	TOTAL SHEETS	SHEET NO.
1517	12VBR-1	PIATT	168	26
CONTRACT NO. 70388				
FED. ROAD DIST. NO. ILLINOIS FED. AID PROJECT				

FILE NAME =	USER NAME = shererjm	DESIGNED - CMS	REVISED -
ct:\pw\work\PWIDOT\SHERRERJM\dms86674\70388plansheets.dgn		DRAWN - JRP	REVISED -
PLOT SCALE = 40.0000' / IN.		CHECKED -	REVISED -
PLOT DATE = 10/13/2009		DATE - 03-25-2008	REVISED -

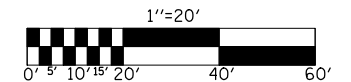

INCIDENTAL HMA SURFACING


BM 4696-4 - CHISELED SQUARE ON TOP
 HEADWALL FOR AN A.R. BOX CULVERT
 STATION 296+76.00, 21.35' RT.
 ELEVATION = 727.365

PROP. CURVE 3 (SERVICE RD)
 PI STA. = 203+99.11
 $\Delta = 5^\circ 54' 45''$ (LT)
 $D = 2^\circ 37' 35''$
 $R = 2,181.50'$
 $T = 112.66'$
 $L = 225.12'$
 $E = 2.91'$
 P.R. STA. = 202+86.46
 P.T. STA. = 205+11.57

PROP. CURVE 2 (SERVICE RD)
 PI STA. = 201+80.95
 $\Delta = 0^\circ 29' 10''$ (RT)
 $D = 0^\circ 13' 49''$
 $R = 24,873.69'$
 $T = 105.50'$
 $L = 211.01'$
 $E = 0.22'$
 P.C.C. STA. = 200+75.45
 P.R.C. STA. = 202+86.46

PLAN	SURVEYED	BY	DATE
	PLOTTED		
	ALIGNED		
	CHECKED		
	CAD FILE NAME		
	NO.		

PROFILE	SURVEYED	BY	DATE
	PLOTTED		
	GRADES CHECKED		
	STRUCTURE NOTATION OK'D		
	NO.		

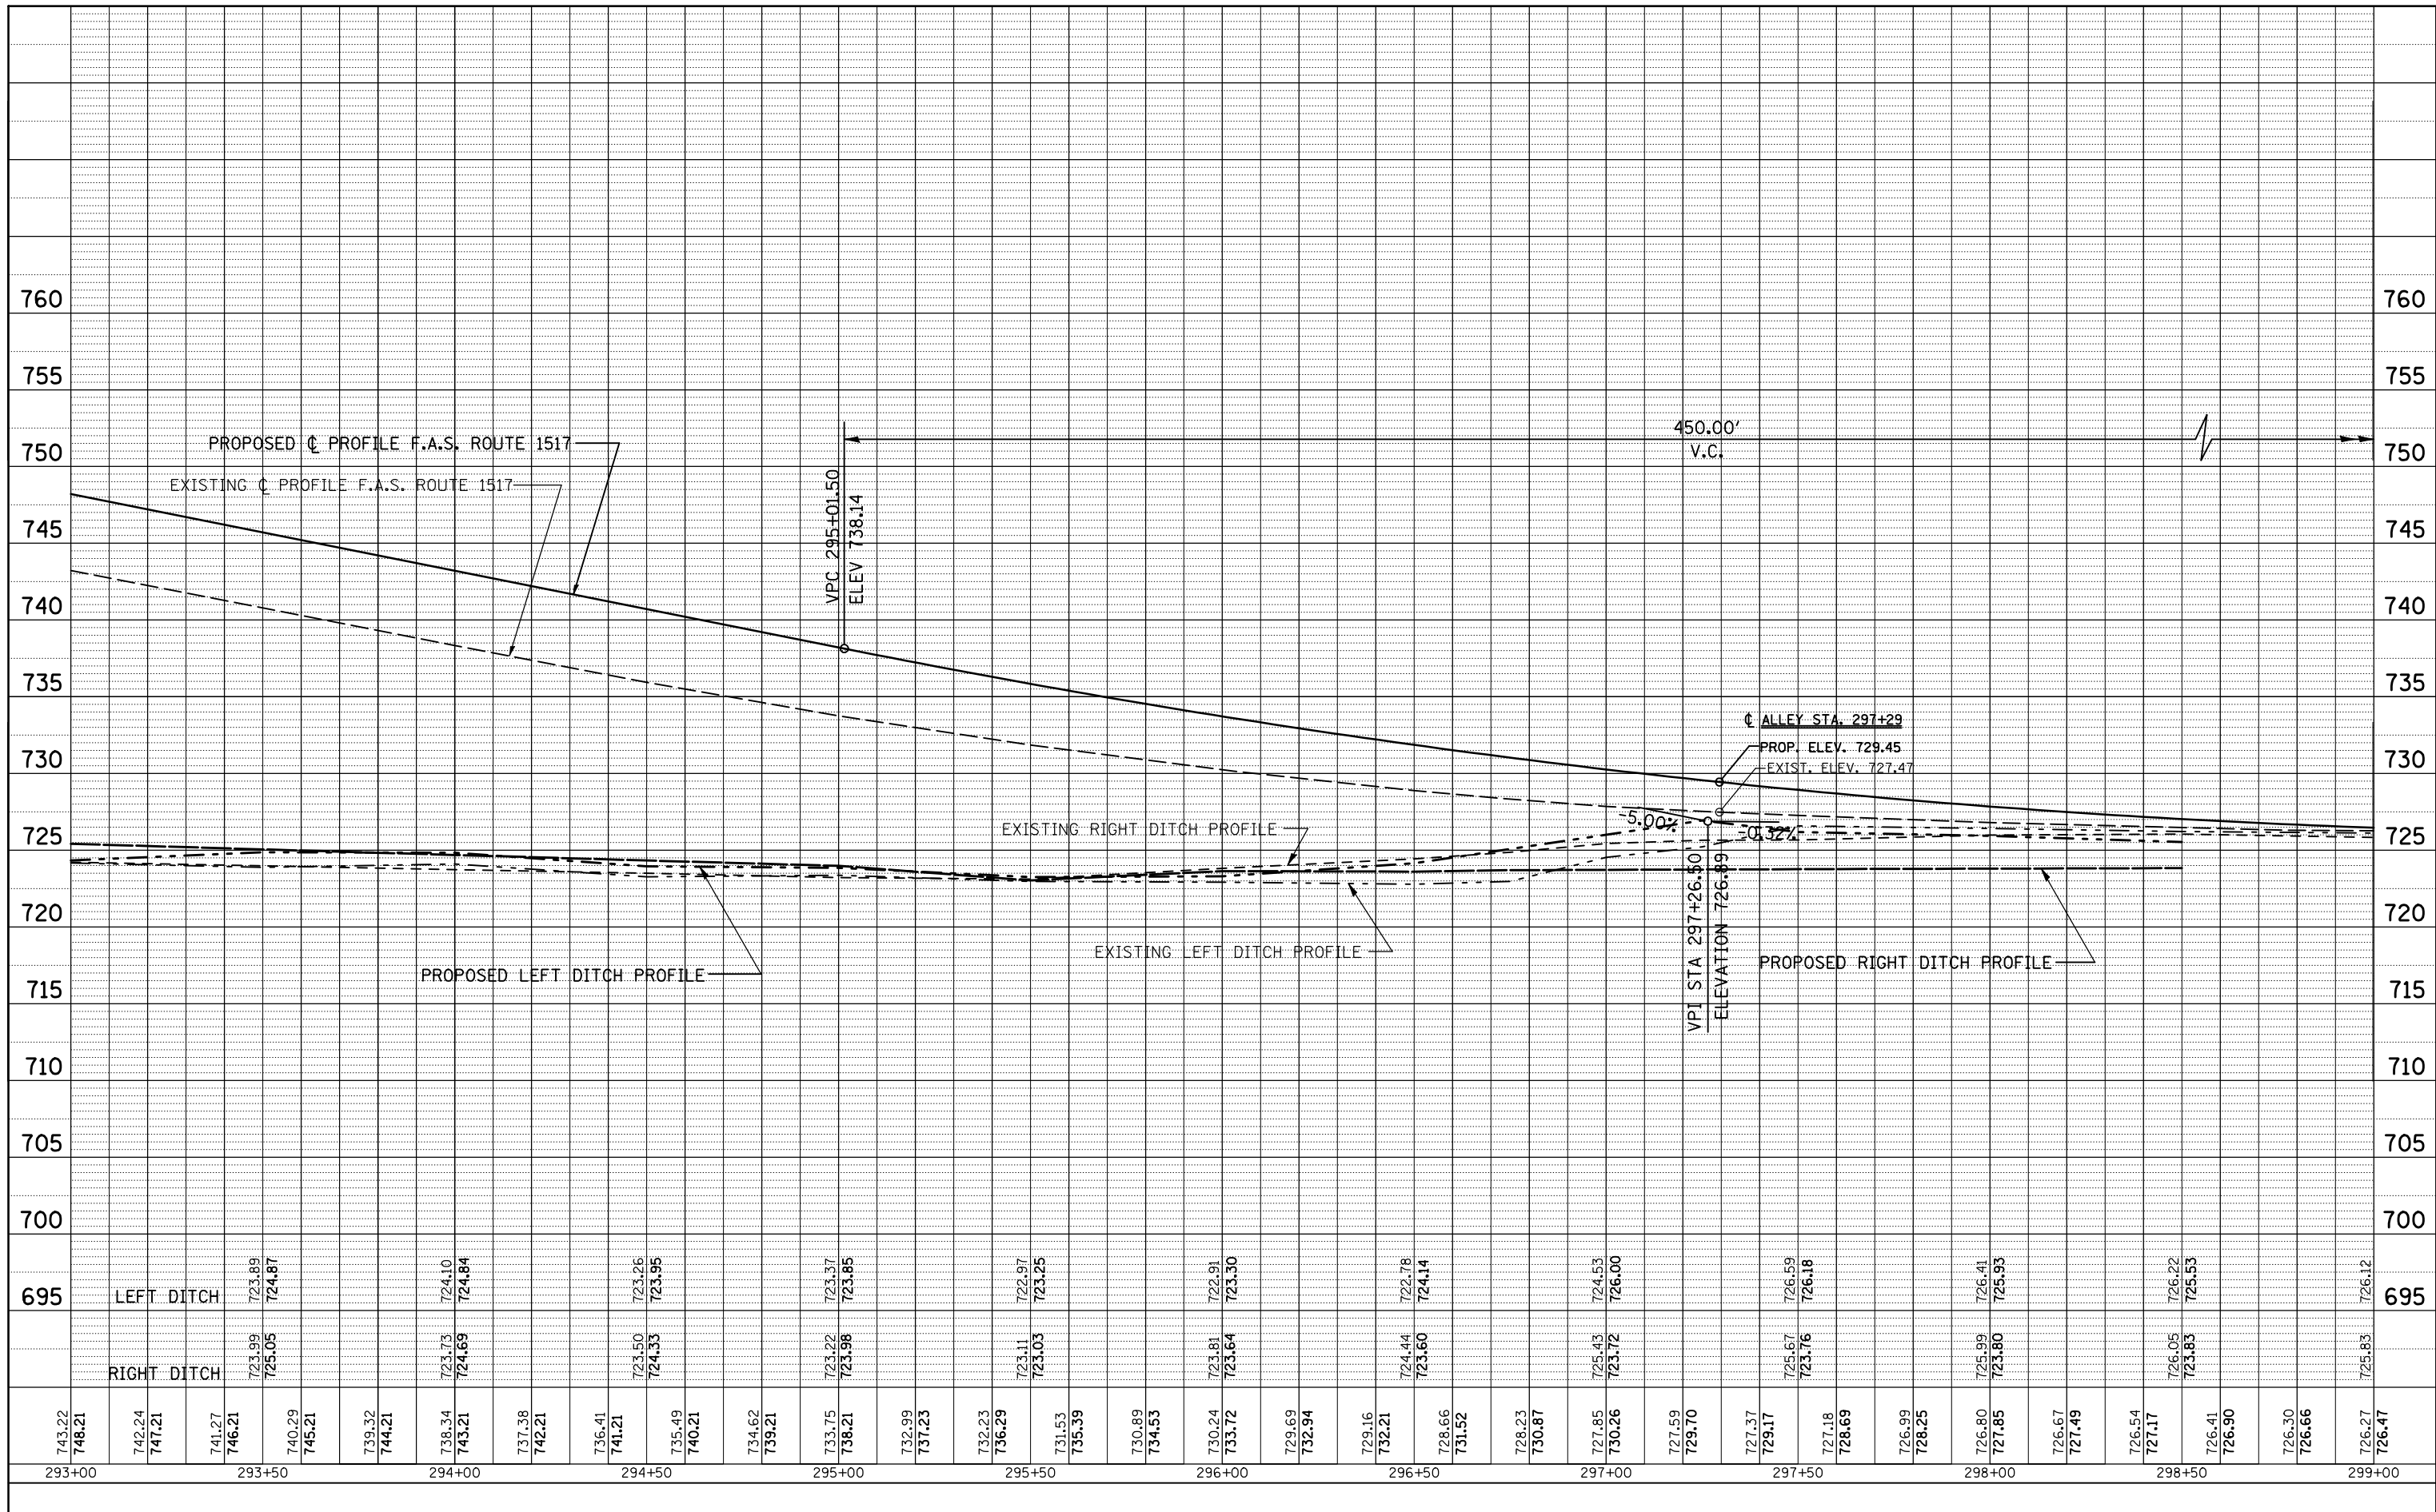

FILE NAME =
 USER NAME = shererjm
 DESIGNED - CMS
 DRAWN -
 CHECKED -
 DATE -

REVISIED -
 REVISIED -
 REVISIED -
 REVISIED -

STATE OF ILLINOIS
DEPARTMENT OF TRANSPORTATION

SCALE: V=5 H=20 SHEET NO. 10 OF 12 SHEETS STA. 293+00.00 TO STA. 299+00.00

PROFILE (U.S. ROUTE 150)


F.A.S. RTE.	SECTION	COUNTY	TOTAL SHEETS	SHEET NO.
1517	12VBR-1	PIATT	168	27
CONTRACT NO. 70388				
FED. ROAD DIST. NO. ILLINOIS FED. AID PROJECT				

SECTION 10, T20N, R6E, 3RD PM



VILLAGE OF MANSFIELD

PROP. CURVE U.S. 150
 PI STA. = 303+40.02
 $\Delta = 0^\circ 29' 06''$ (RT)
 $D = 0^\circ 29' 58''$
 $R = 11,470.00'$
 $T = 48.55'$
 $L = 97.10'$
 $E = 0.10'$
 $e = \text{-----}$
 $T.R. = \text{-----}$
 $S.E. \text{ RUN} = \text{-----}$
 P.C. STA = 302+91.47
 P.T. STA = 303+88.57

INCIDENTAL HMA SURFACING

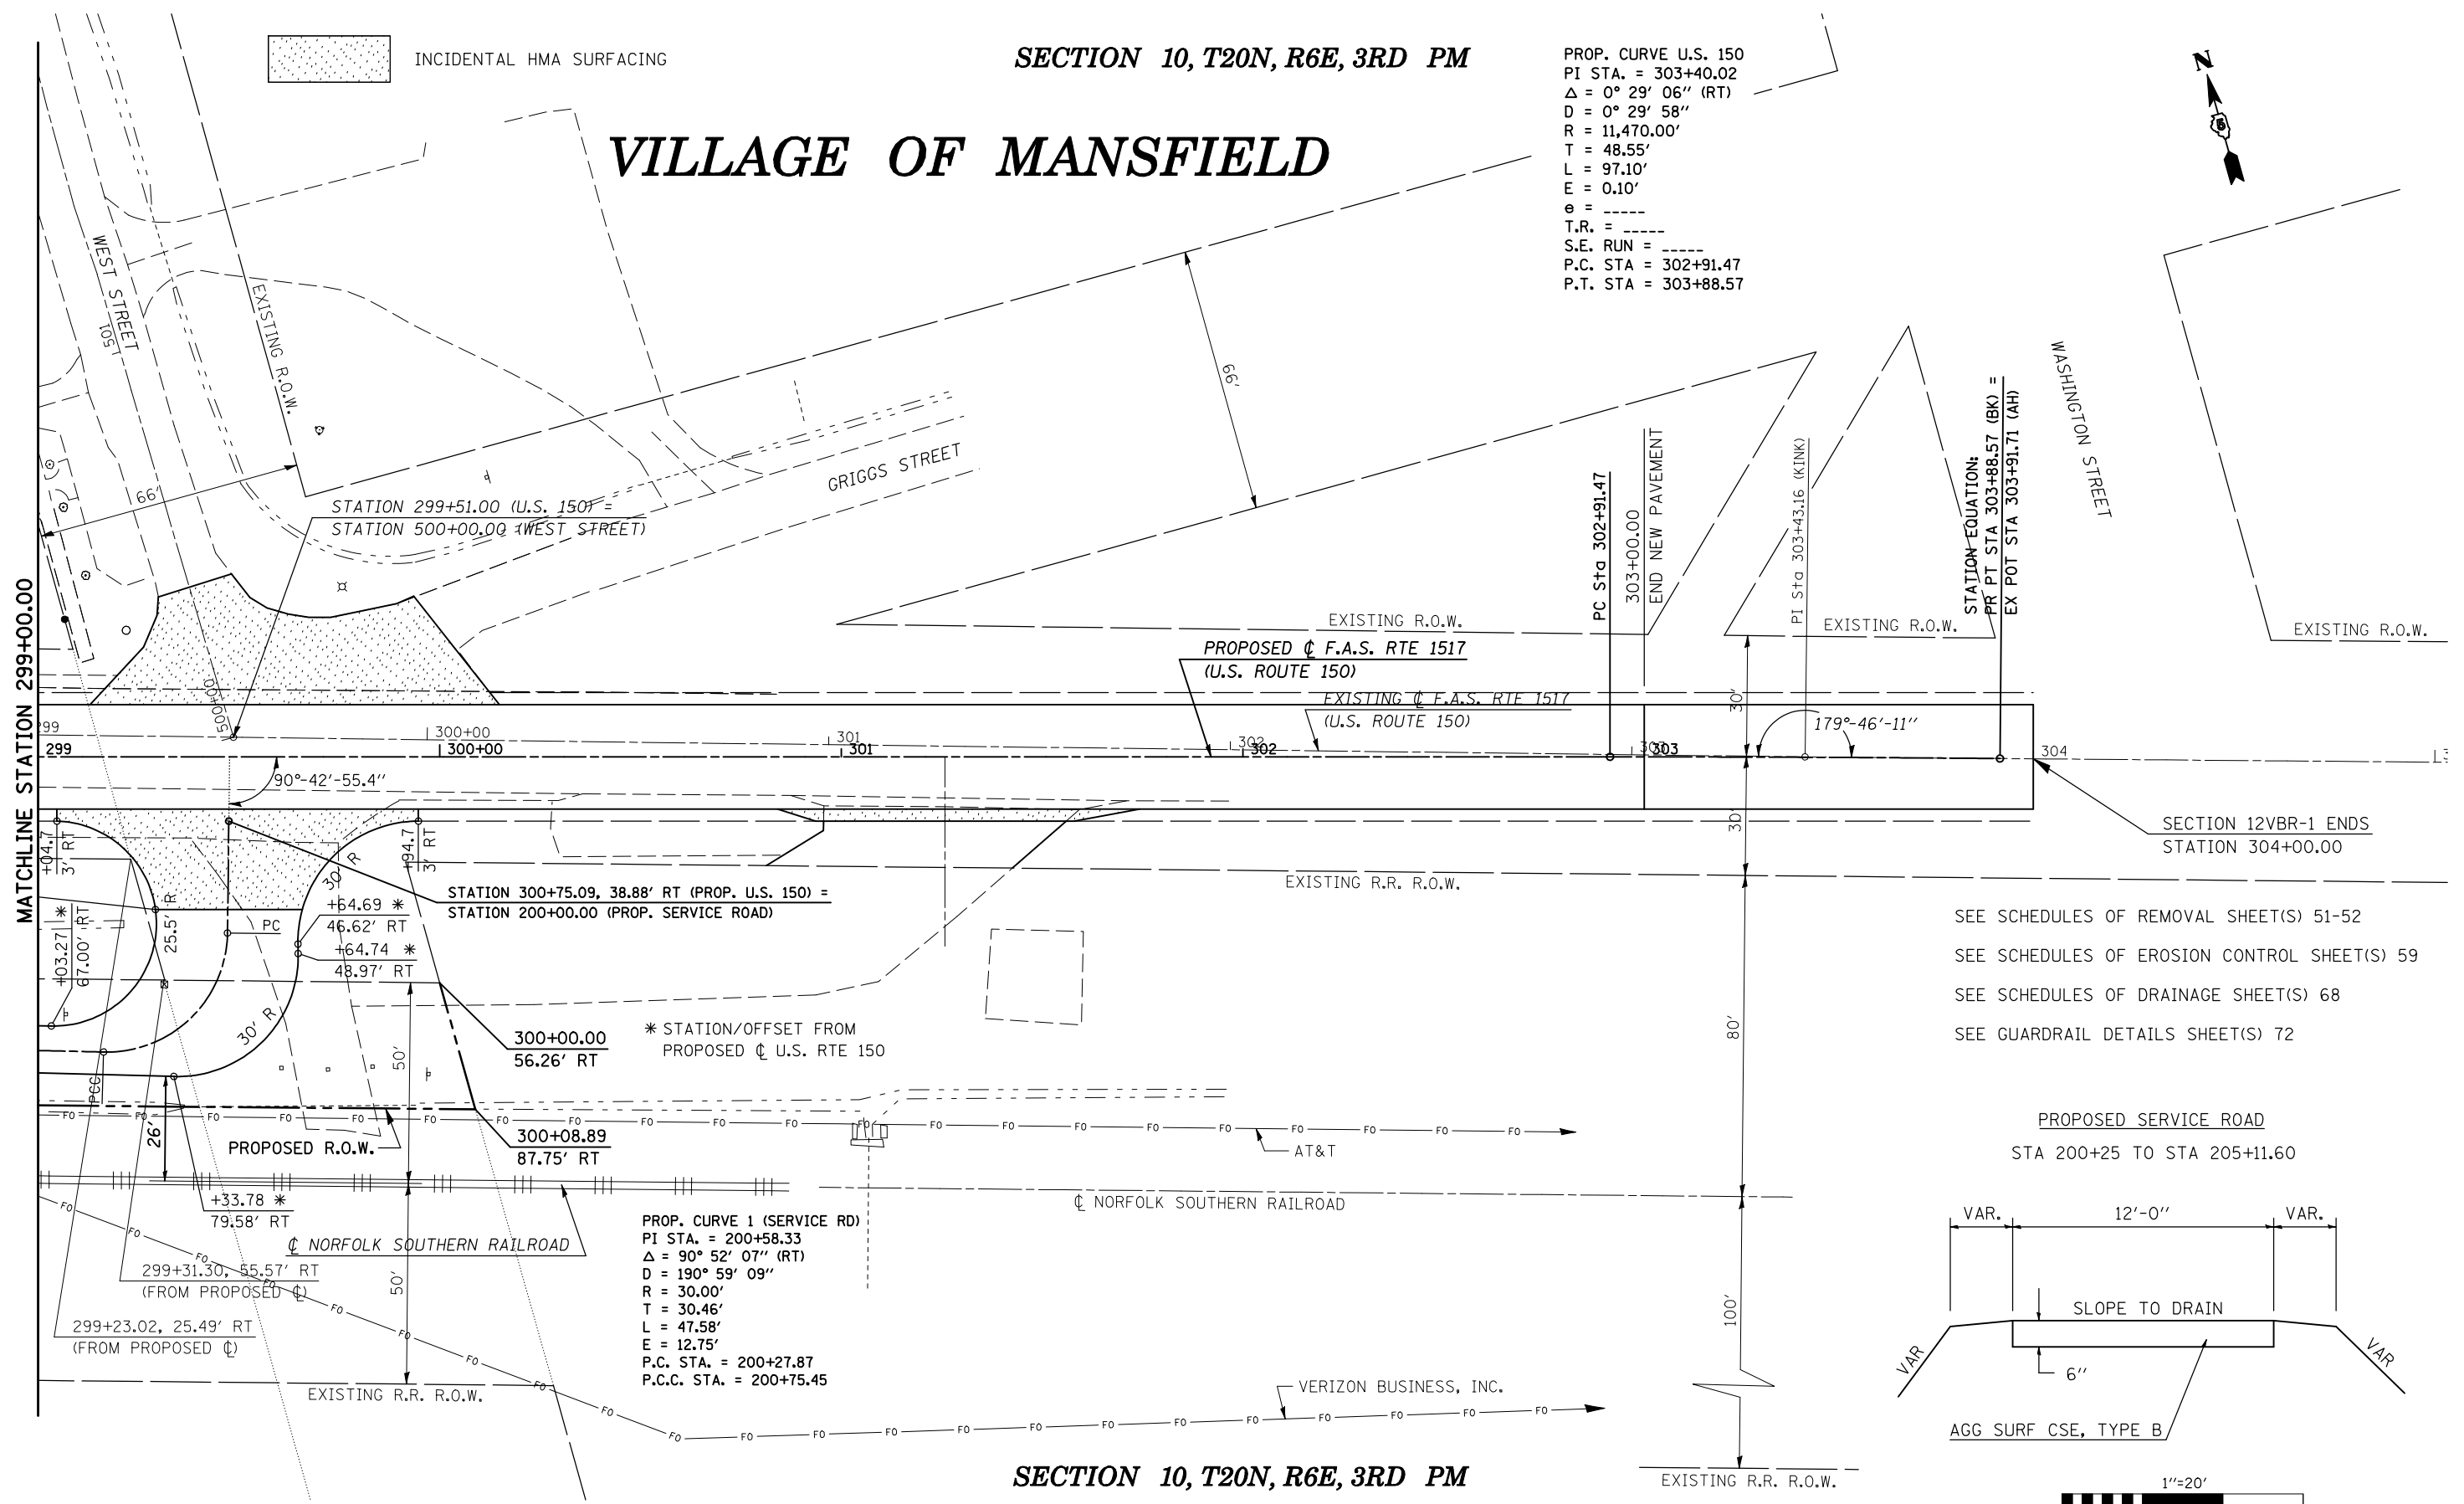

SEE SCHEDULES OF REMOVAL SHEET(S) 51-52
 SEE SCHEDULES OF EROSION CONTROL SHEET(S) 59
 SEE SCHEDULES OF DRAINAGE SHEET(S) 68
 SEE GUARDRAIL DETAILS SHEET(S) 72

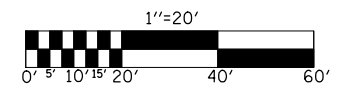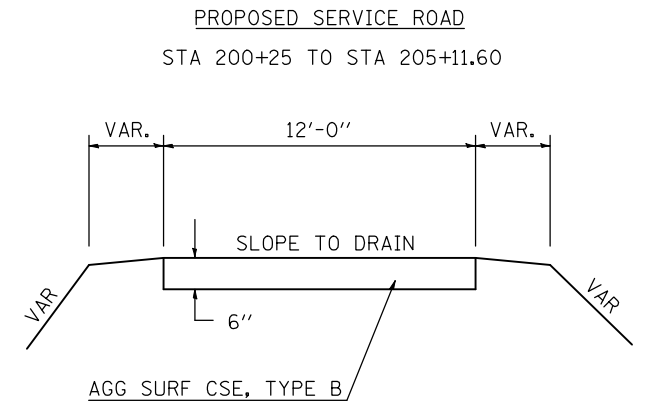

SECTION 10, T20N, R6E, 3RD PM

FILE NAME =	USER NAME = shererjm	DESIGNED - CMS	REVISED -
ct:\pw\work\PIWID01\SHERRERJM\dms86674\70888plansheets.dgn		DRAWN - JRP	REVISED -
PLOT SCALE = 40.0000' / IN.		CHECKED -	REVISED -
PLOT DATE = 10/13/2009		DATE - 03-25-2008	REVISED -

STATE OF ILLINOIS
 DEPARTMENT OF TRANSPORTATION


PLAN (U.S. ROUTE 150)

SCALE: 1" = 20' SHEET NO. 11 OF 12 SHEETS STA. 299+00.00 TO STA. 305+00.00

F.A.S. RTE.	SECTION	COUNTY	TOTAL SHEETS	SHEET NO.
1517	12VBR-1	PIATT	168	28
CONTRACT NO. 70388				
FED. ROAD DIST. NO. ILLINOIS FED. AID PROJECT				

PLAN	SURVEYED	BY	DATE
	PLOTTED		
	NOTED		
	CHECKED		
	FILE NAME		

PROFILE	SURVEYED	BY	DATE
	PLOTTED		
	NOTED		
	CHECKED		
	FILE NAME		

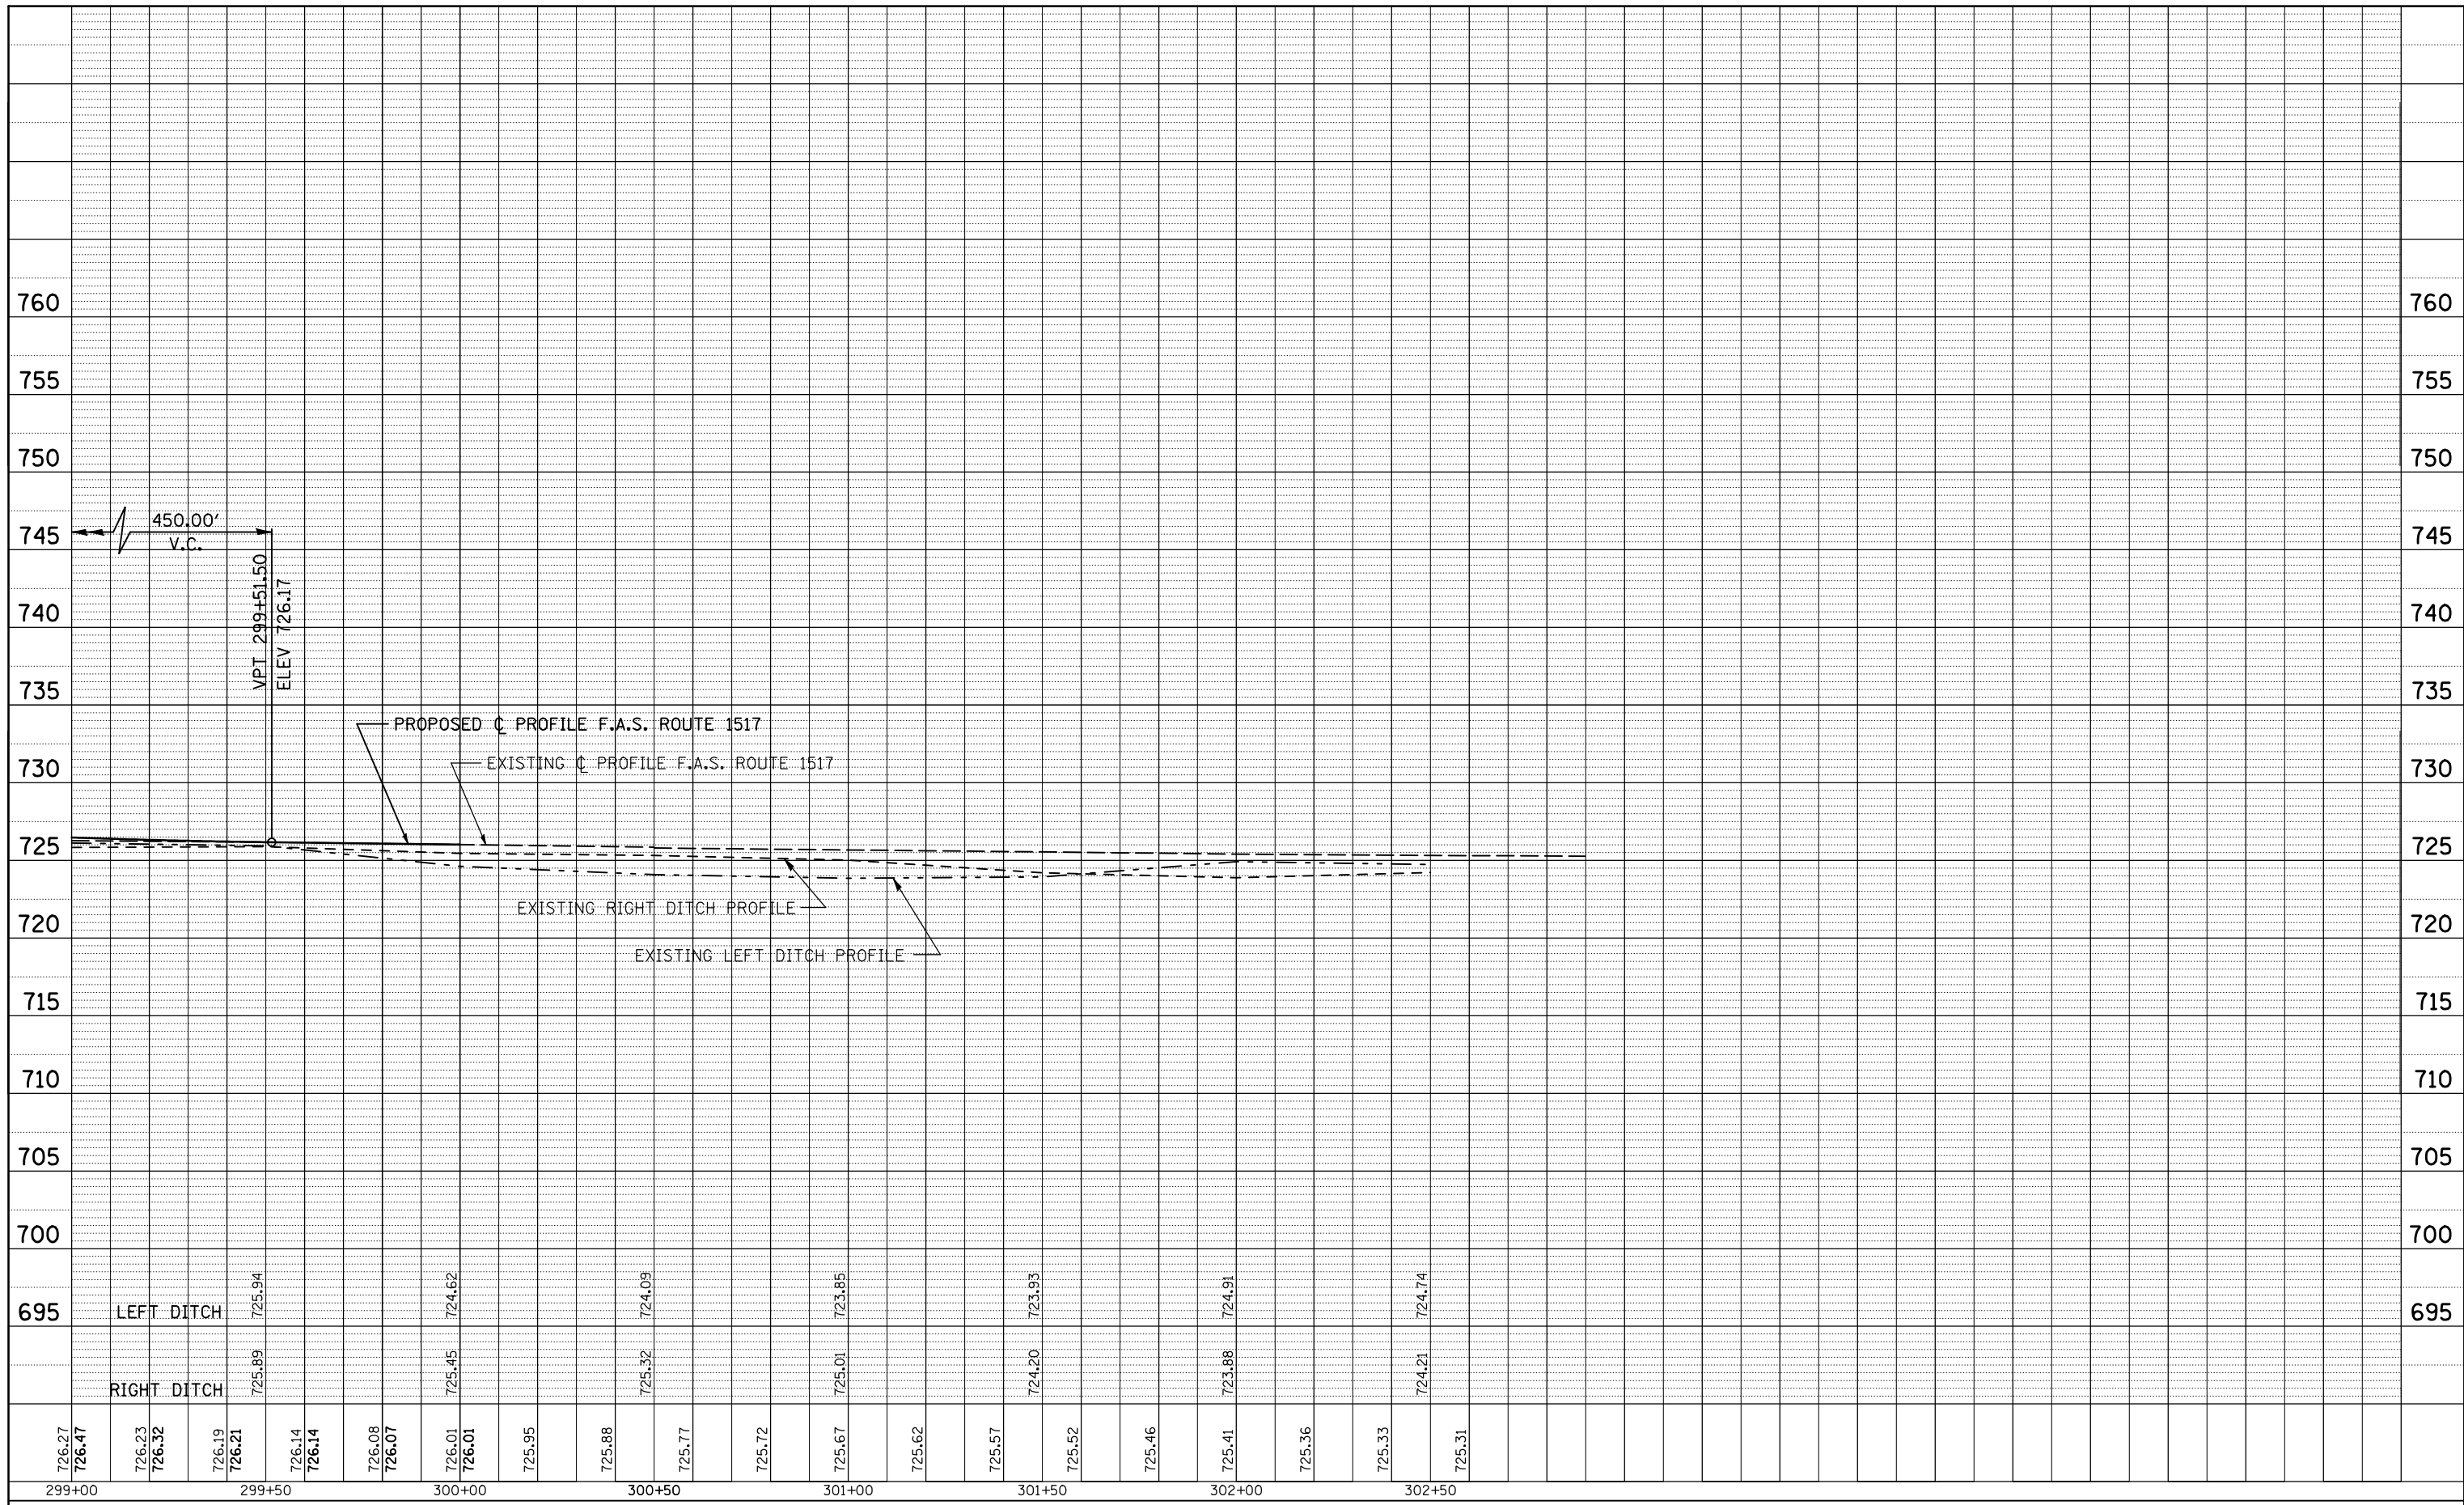

726.27	726.47	726.23	726.32	726.19	726.21	726.14	726.14	726.08	726.07	726.01	726.01	725.95	725.88	725.77	725.72	725.67	725.62	725.57	725.52	725.46	725.41	725.36	725.33	725.31
299+00	299+50	300+00	300+50	301+00	301+50	302+00	302+50																	

FILE NAME =	USER NAME = shererjm	DESIGNED - CMS	REVISED -
ct:\pw_work\PWIDOT\SHERERJM\dms86674\70388\plansheets.dgn		DRAWN -	REVISED -
		CHECKED -	REVISED -
		DATE -	REVISED -

**STATE OF ILLINOIS
DEPARTMENT OF TRANSPORTATION**



PROFILE (U.S. ROUTE 150)		
SCALE: V=5 H=20	SHEET NO. 12 OF 12 SHEETS	STA. 299+00.00 TO STA. 305+00.00

F.A.S. RTE.	SECTION	COUNTY	TOTAL SHEETS	SHEET NO.
1517	12VBR-1	PIATT	168	29
CONTRACT NO. 70388				
FED. ROAD DIST. NO. ILLINOIS FED. AID PROJECT				



PROP. CURVE - ALLEY
 PI STA. = 2+09.87
 Δ = 15° 13' 13" (LT)
 D = 19° 05' 55"
 R = 300.00'
 T = 40.08'
 L = 79.69'
 E = 2.67'
 e = -----
 T.R. = -----
 S.E. RUN = -----
 P.C. STA. = 1+69.78
 P.T. STA. = 2+49.48

EXIST. CURVE ALLEY
 PI STA. = 3+98.00
 Δ = 88° 15' 17" (LT)
 D = 100° 31' 08"
 R = 57.00'
 T = 55.29'
 L = 87.80'
 E = 22.41'
 e = -----
 T.R. = -----
 S.E. RUN = -----
 P.C. STA. = 3+42.71
 P.T. STA. = 4+30.51

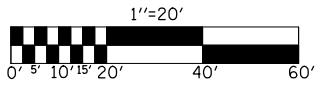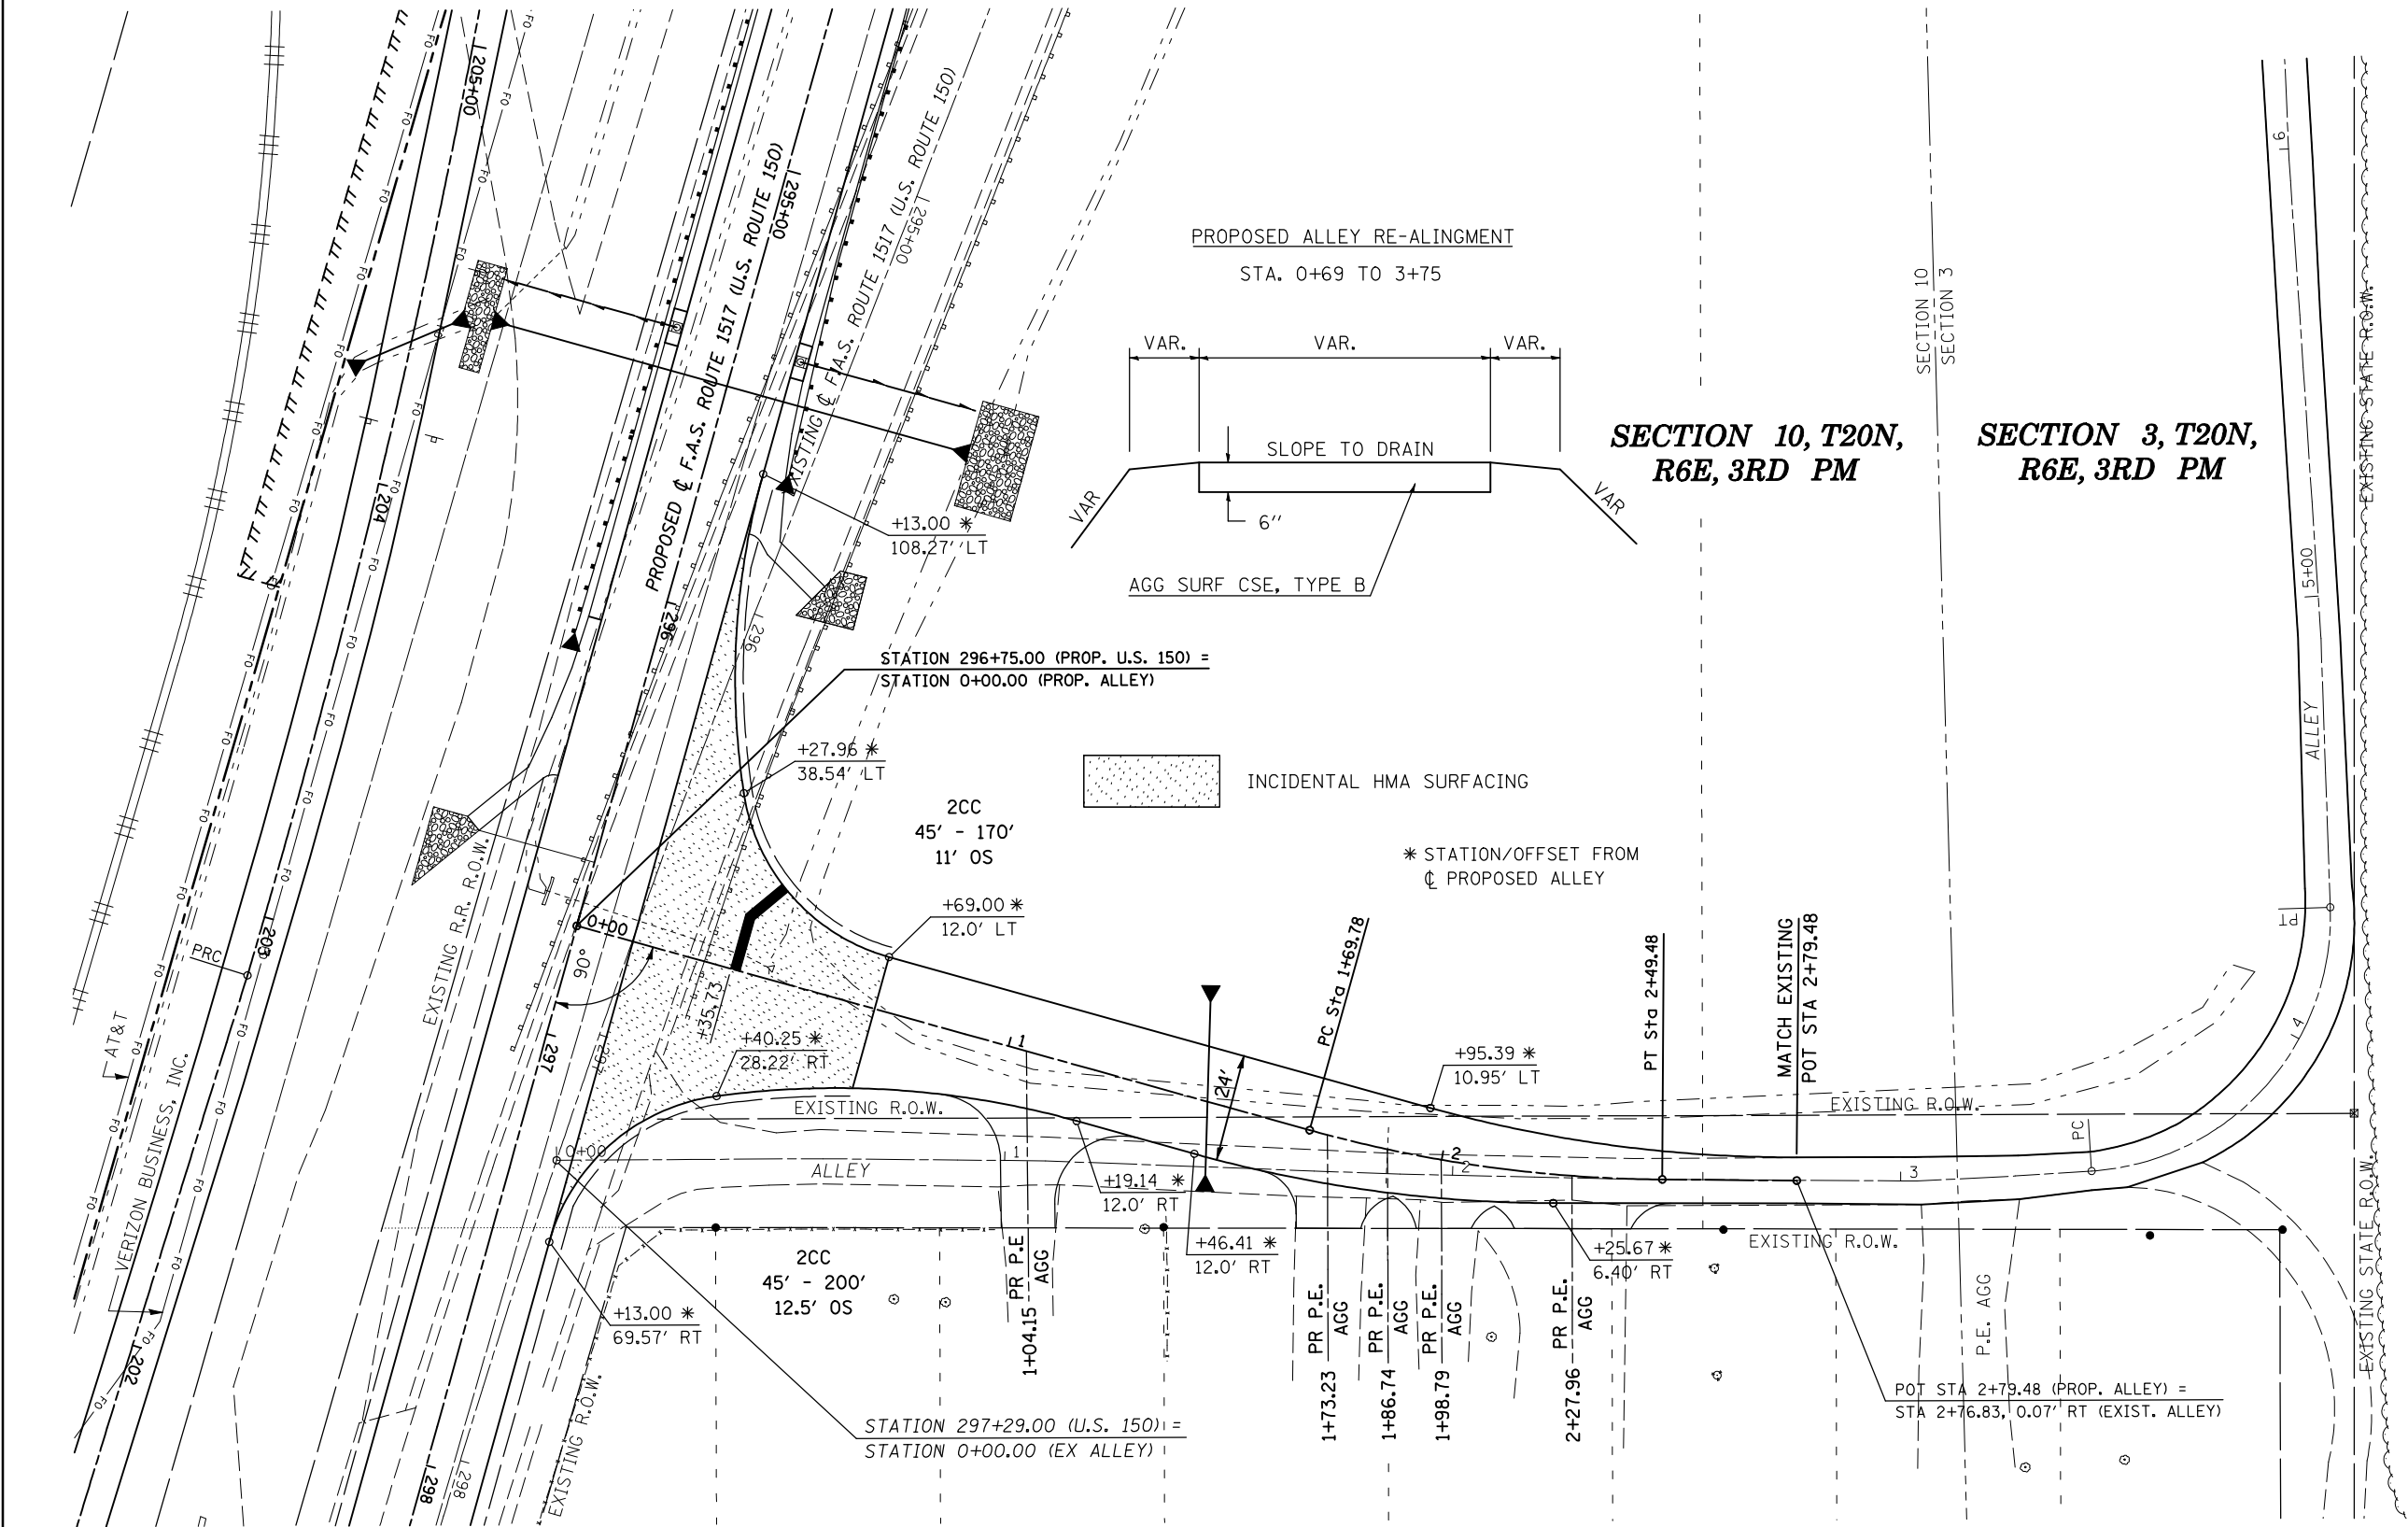

FILE NAME =	USER NAME = shererjm	DESIGNED - CMS	REVISED -
ct:\pw\work\PIWIDOT\SHERERJM\dms86674\70388\plansheets.dgn		DRAWN - JRP	REVISED -
PLOT SCALE = 40.0000' / IN.		CHECKED -	REVISED -
PLOT DATE = 10/13/2009		DATE - 04-07-2008	REVISED -

**STATE OF ILLINOIS
 DEPARTMENT OF TRANSPORTATION**


PLAN (ALLEY)

SCALE: 1" = 20' SHEET NO. 1 OF 4 SHEETS STA. 0+00.00 TO STA. 6+20.00

F.A.S. RTE.	SECTION	COUNTY	TOTAL SHEETS	SHEET NO.
1517	12VBR-1	PIATT	168	30
CONTRACT NO. 70388				
FED. ROAD DIST. NO. ILLINOIS FED. AID PROJECT				

PLAN	SURVEYED	BY	DATE
NOTE BOOK NO.	PLOTTED		
	AT		
	FORM		
	CHECKED		
	NO.		
	CADD FILE NAME		

PROFILE	SURVEYED	BY	DATE
NOTE BOOK NO.	GRADES CHECKED		
	STRUCTURE		
	NOTATIS		
	ORVD		

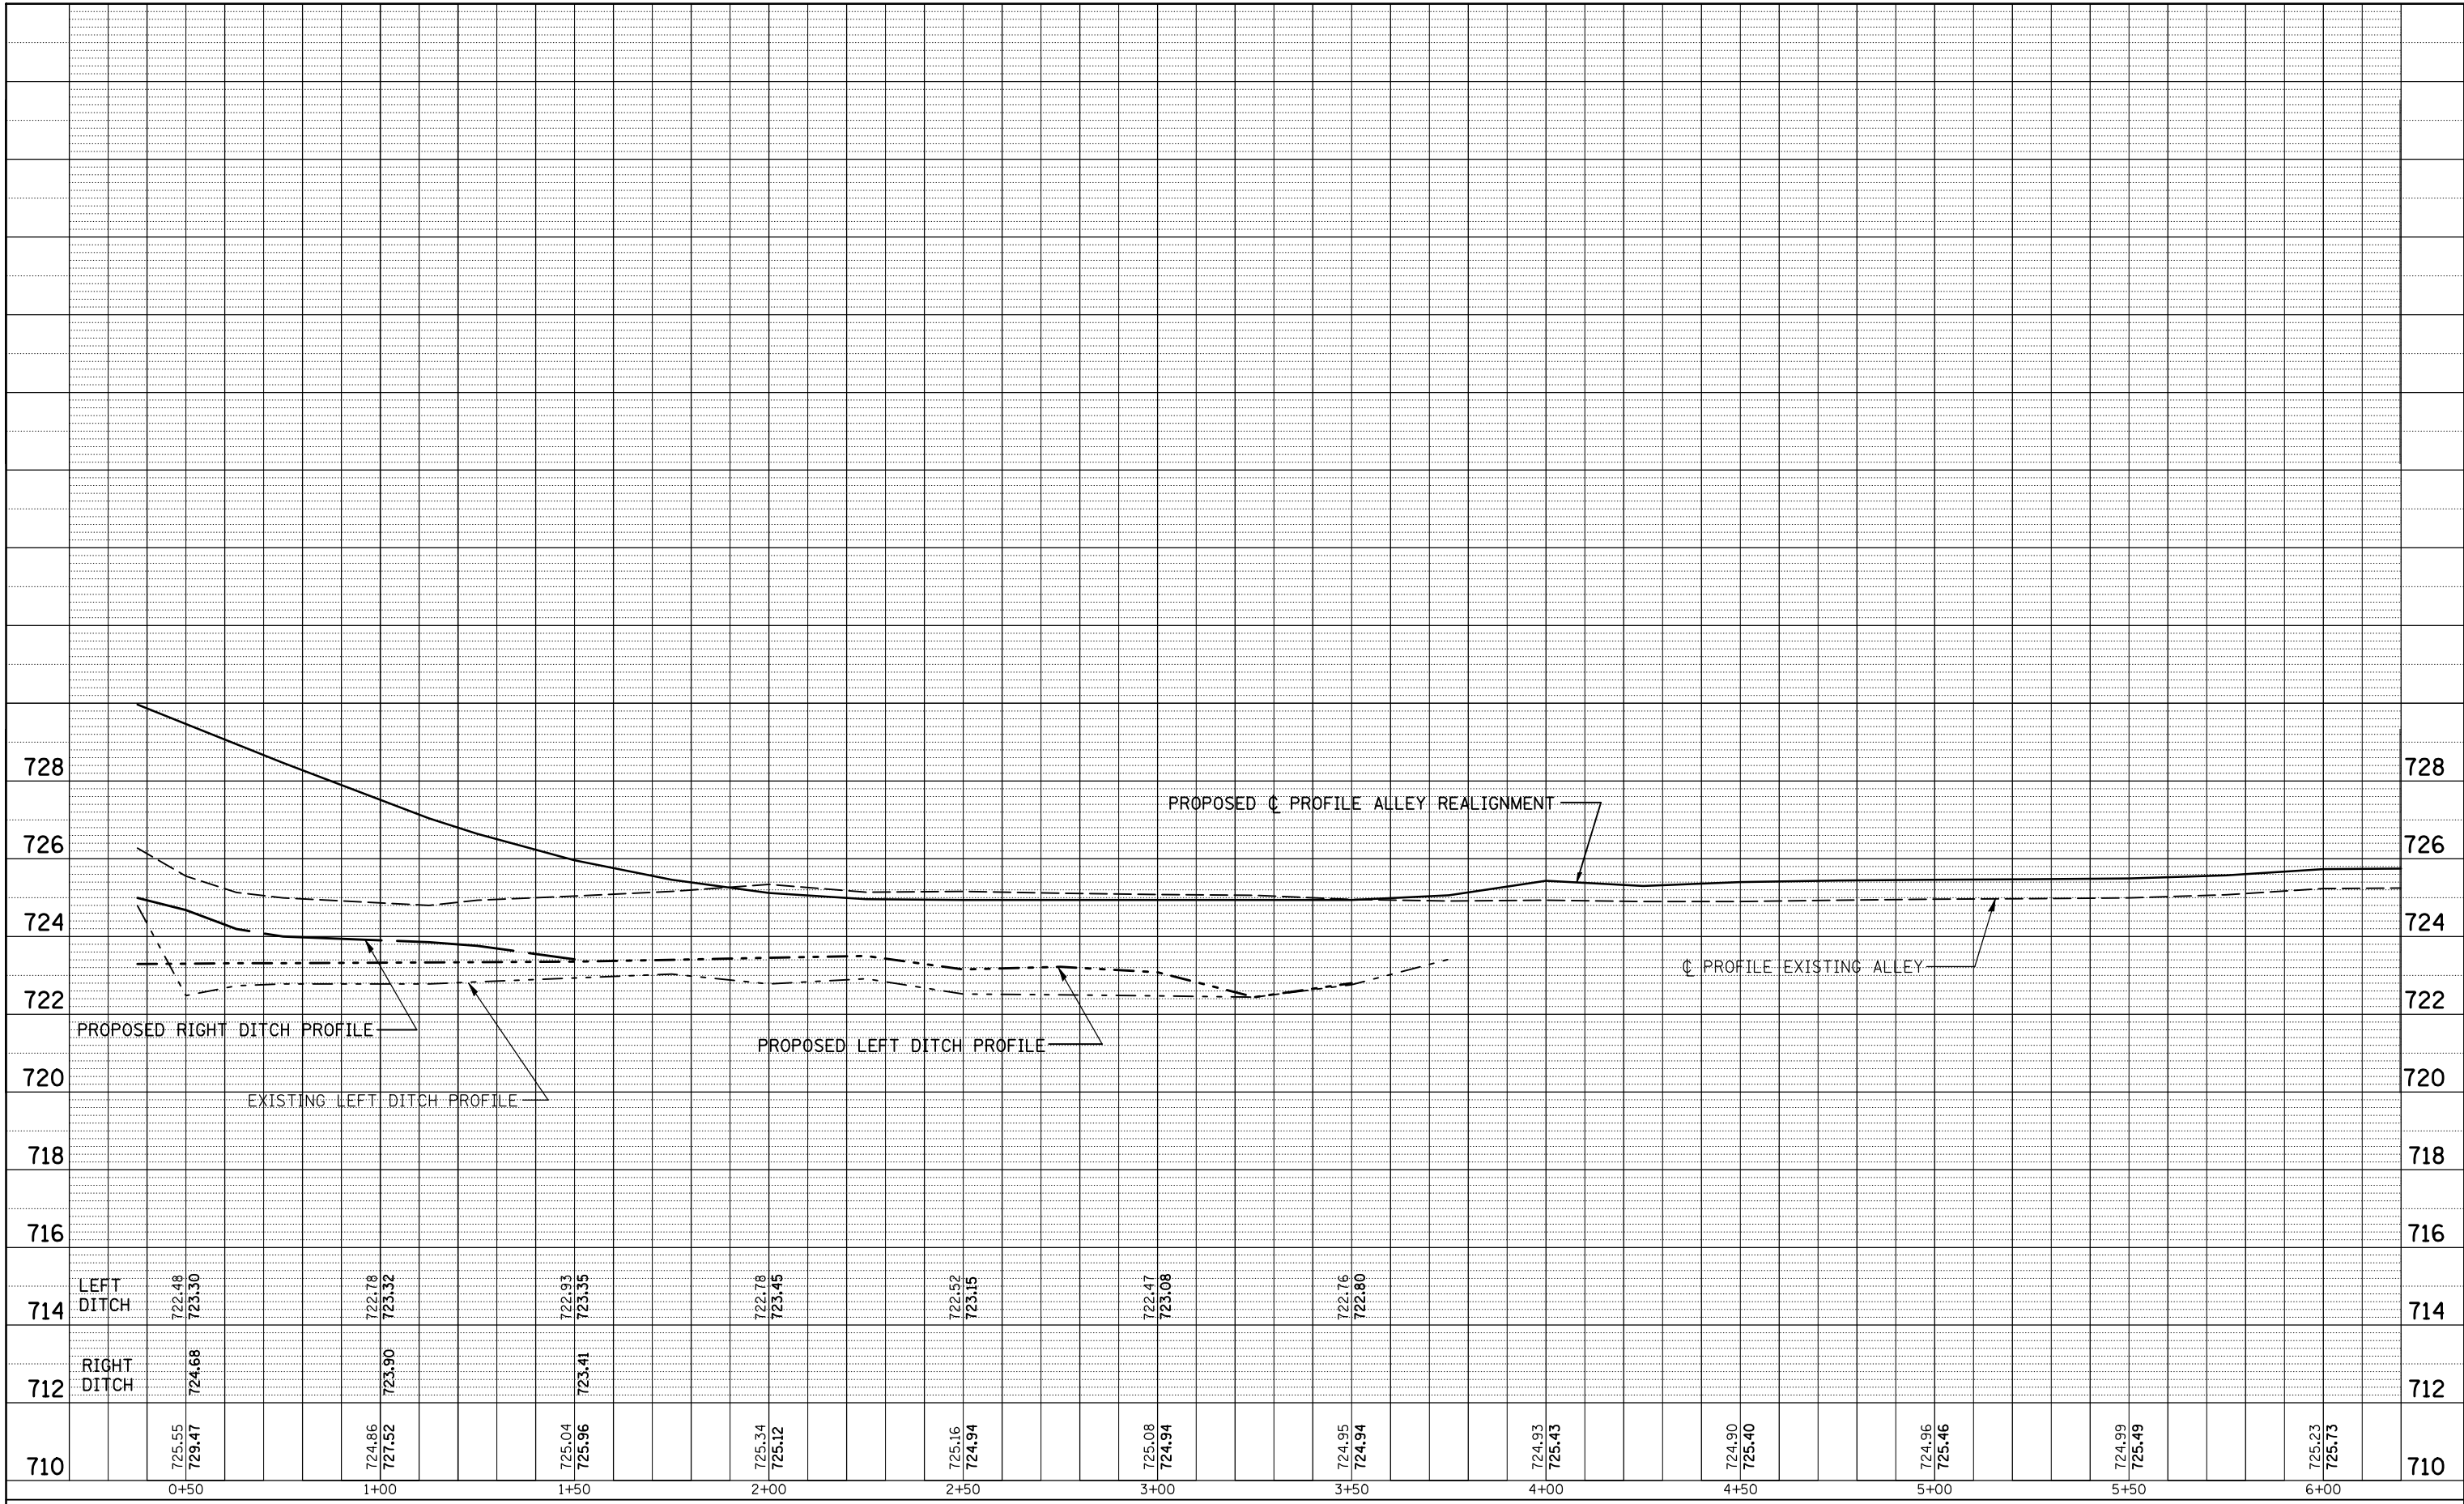

710		725.55 729.47		724.86 727.52		725.04 725.96		725.34 725.12		725.16 724.94		725.08 724.94		724.95 724.94		724.93 725.43		724.90 725.40		724.96 725.46		724.99 725.49		725.23 725.73	710
712	RIGHT DITCH	724.68		723.90		723.41																			712
714	LEFT DITCH	722.48		722.78		722.93		722.78		722.52		722.47		722.76											714
716																									716
718																									718
720																									720
722																									722
724																									724
726																									726
728																									728

FILE NAME =	USER NAME = shererjm	DESIGNED - CMS	REVISED -
ct:\pwork\PWIDOT\SHERERJM\dms86674\70388\plansheets.dgn		DRAWN -	REVISED -
PLOT SCALE = 40.0000' / IN.		CHECKED -	REVISED -
PLOT DATE = 10/13/2009		DATE -	REVISED -

**STATE OF ILLINOIS
DEPARTMENT OF TRANSPORTATION**





SCALE: SHEET NO. 2 OF 4 SHEETS STA. 0+00.00 TO STA. 6+20.00

PROFILE (ALLEY)

F.A.S. RTE.	SECTION	COUNTY	TOTAL SHEETS	SHEET NO.
1517	12VBR-1	PIATT	168	31
CONTRACT NO. 70388				
FED. ROAD DIST. NO.	ILLINOIS FED. AID PROJECT			

SECTION 10, T20N, R6E, 3RD PM

SECTION 3, T20N, R6E, 3RD PM

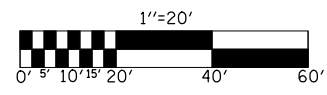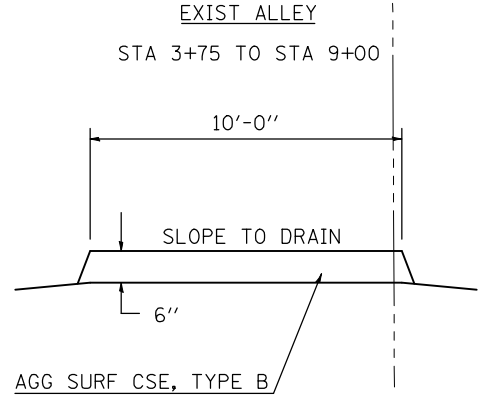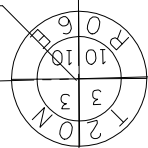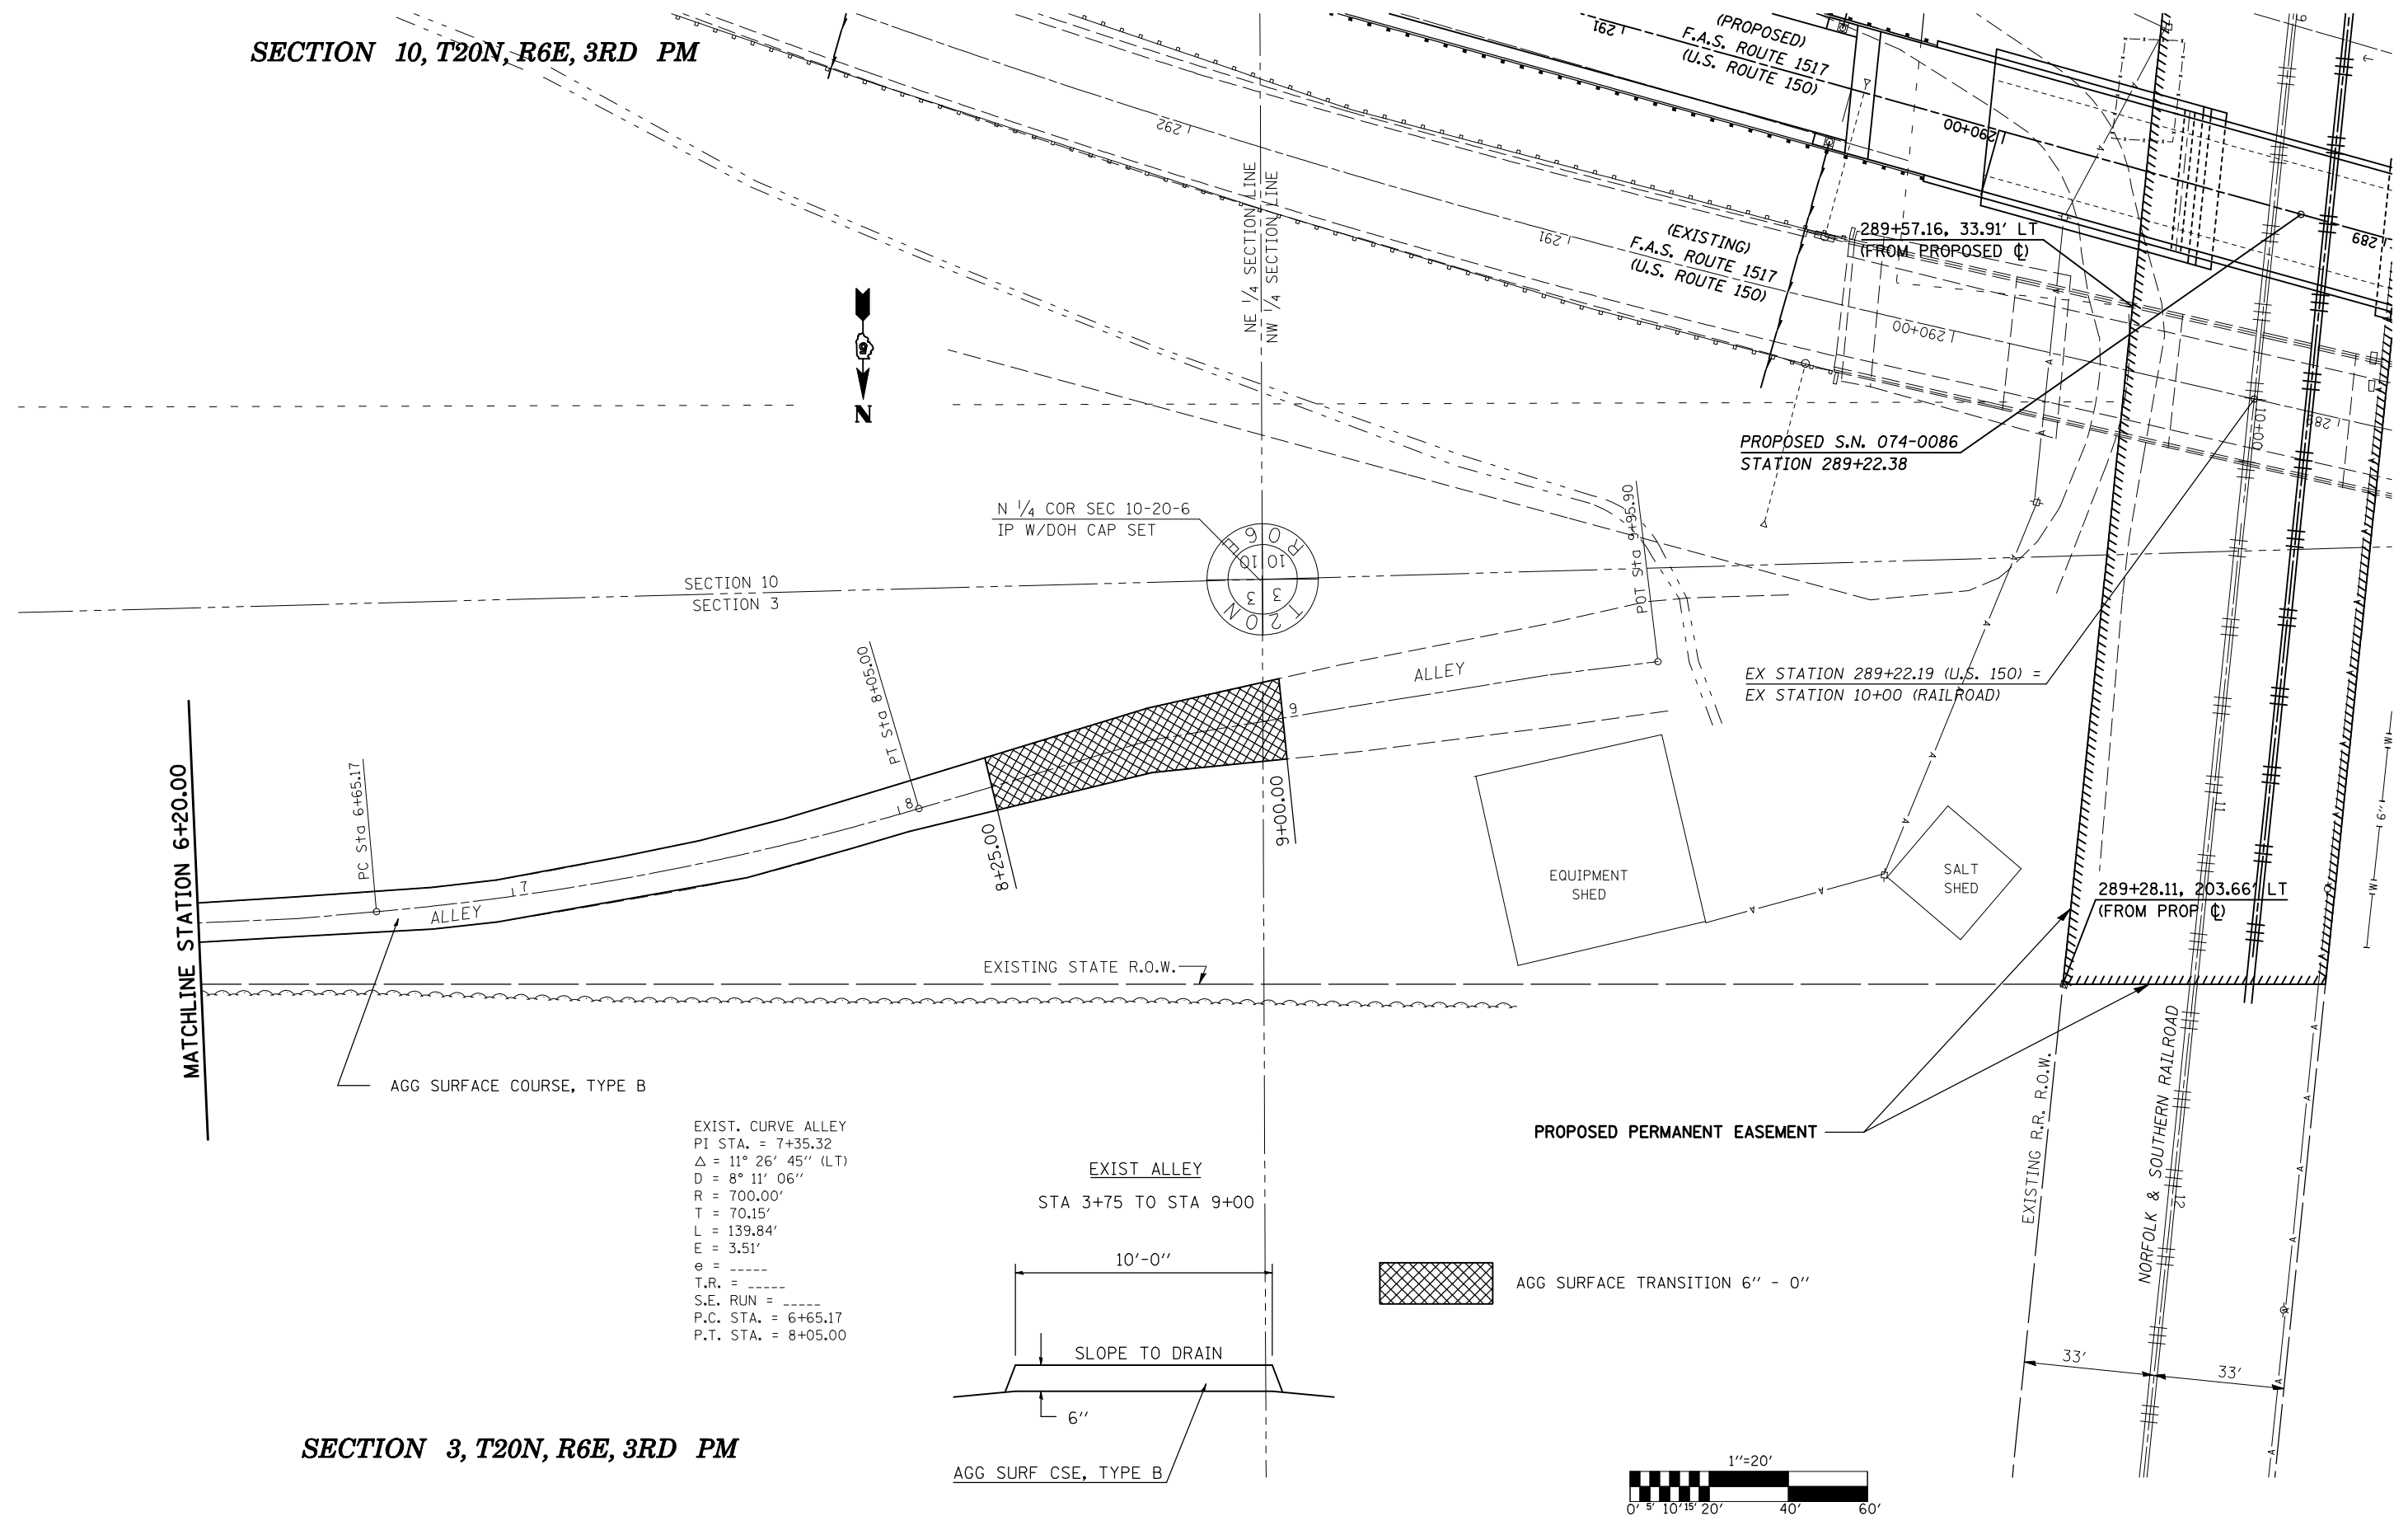

FILE NAME =	USER NAME = shererjm	DESIGNED - CMS	REVISED -
ct:\pw\work\PIWIDOT\SHERERJM\dms86674\70888plansheets.dgn	DRAWN - JRP	REVISIONS -	REVISIONS -
PLOT SCALE = 40.0000' / IN.	CHECKED -	REVISIONS -	REVISIONS -
PLOT DATE = 10/13/2009	DATE - 04-07-2008	REVISIONS -	REVISIONS -

STATE OF ILLINOIS
DEPARTMENT OF TRANSPORTATION


PLAN (ALLEY)

SCALE: 1" = 20' SHEET NO. 3 OF 4 SHEETS STA. 6+20.00 TO STA. 9+95.90

F.A.S. RTE.	SECTION	COUNTY	TOTAL SHEETS	SHEET NO.
1517	12VBR-1	PIATT	168	32
CONTRACT NO. 70388				
FED. ROAD DIST. NO. ILLINOIS FED. AID PROJECT				

PLAN	SURVEYED	BY	DATE
NOTE BOOK NO.	PLOTTED		
	GRADES CHECKED		
	STRUCTURE NOTATION		
	CAD FILE NAME		

PROFILE	SURVEYED	BY	DATE
NOTE BOOK NO.	PLOTTED		
	GRADES CHECKED		
	STRUCTURE NOTATION		
	CAD FILE NAME		

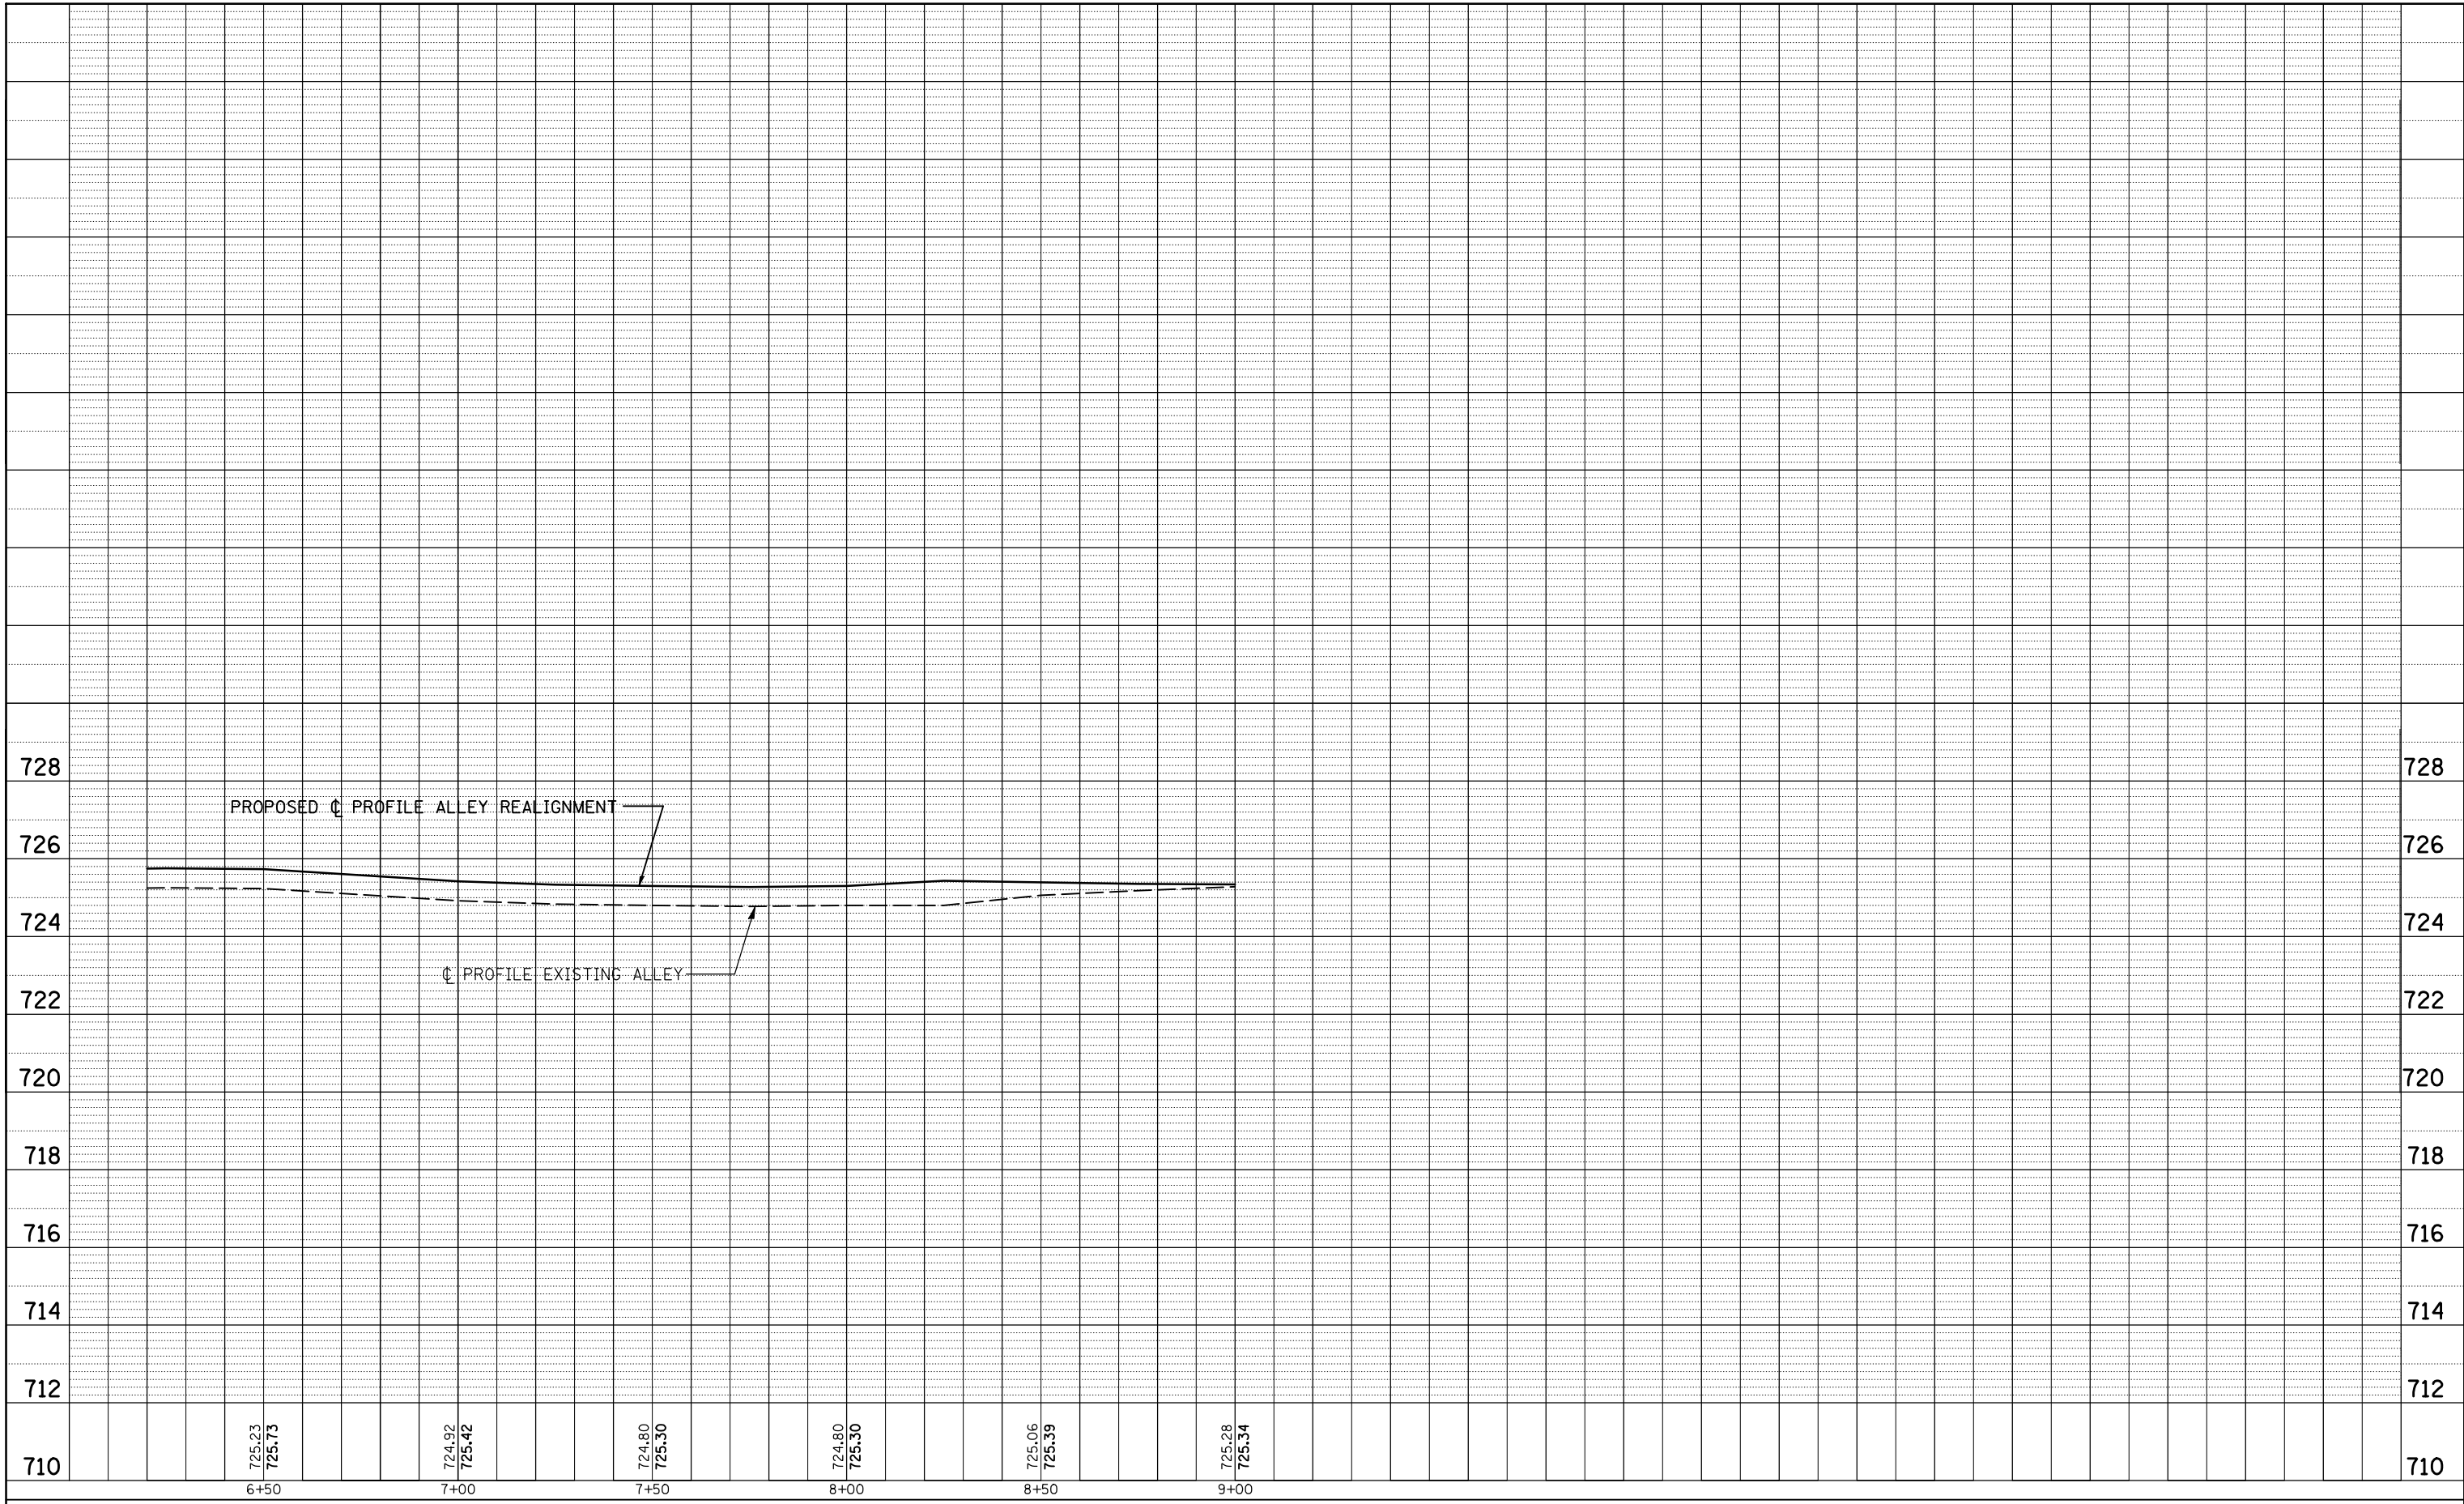

FILE NAME =	USER NAME = shererjm	DESIGNED - CMS	REVISED -
ct:\pwork\PWIDOT\SHERERJM\dms86674\70388\plansheets.dgn		DRAWN -	REVISED -
	PLOT SCALE = 40.0000' / IN.	CHECKED -	REVISED -
	PLOT DATE = 10/13/2009	DATE -	REVISED -


**STATE OF ILLINOIS
DEPARTMENT OF TRANSPORTATION**

PROFILE (ALLEY)

SCALE: SHEET NO. 4 OF 4 SHEETS STA. 6+20.00 TO STA. 9+95.90

F.A.S. RTE.	SECTION	COUNTY	TOTAL SHEETS	SHEET NO.
1517	12VBR-1	PIATT	168	33
FED. ROAD DIST. NO. ILLINOIS FED. AID PROJECT			CONTRACT NO. 70388	

SECTION 10, T20N, R6E, 3RD PM

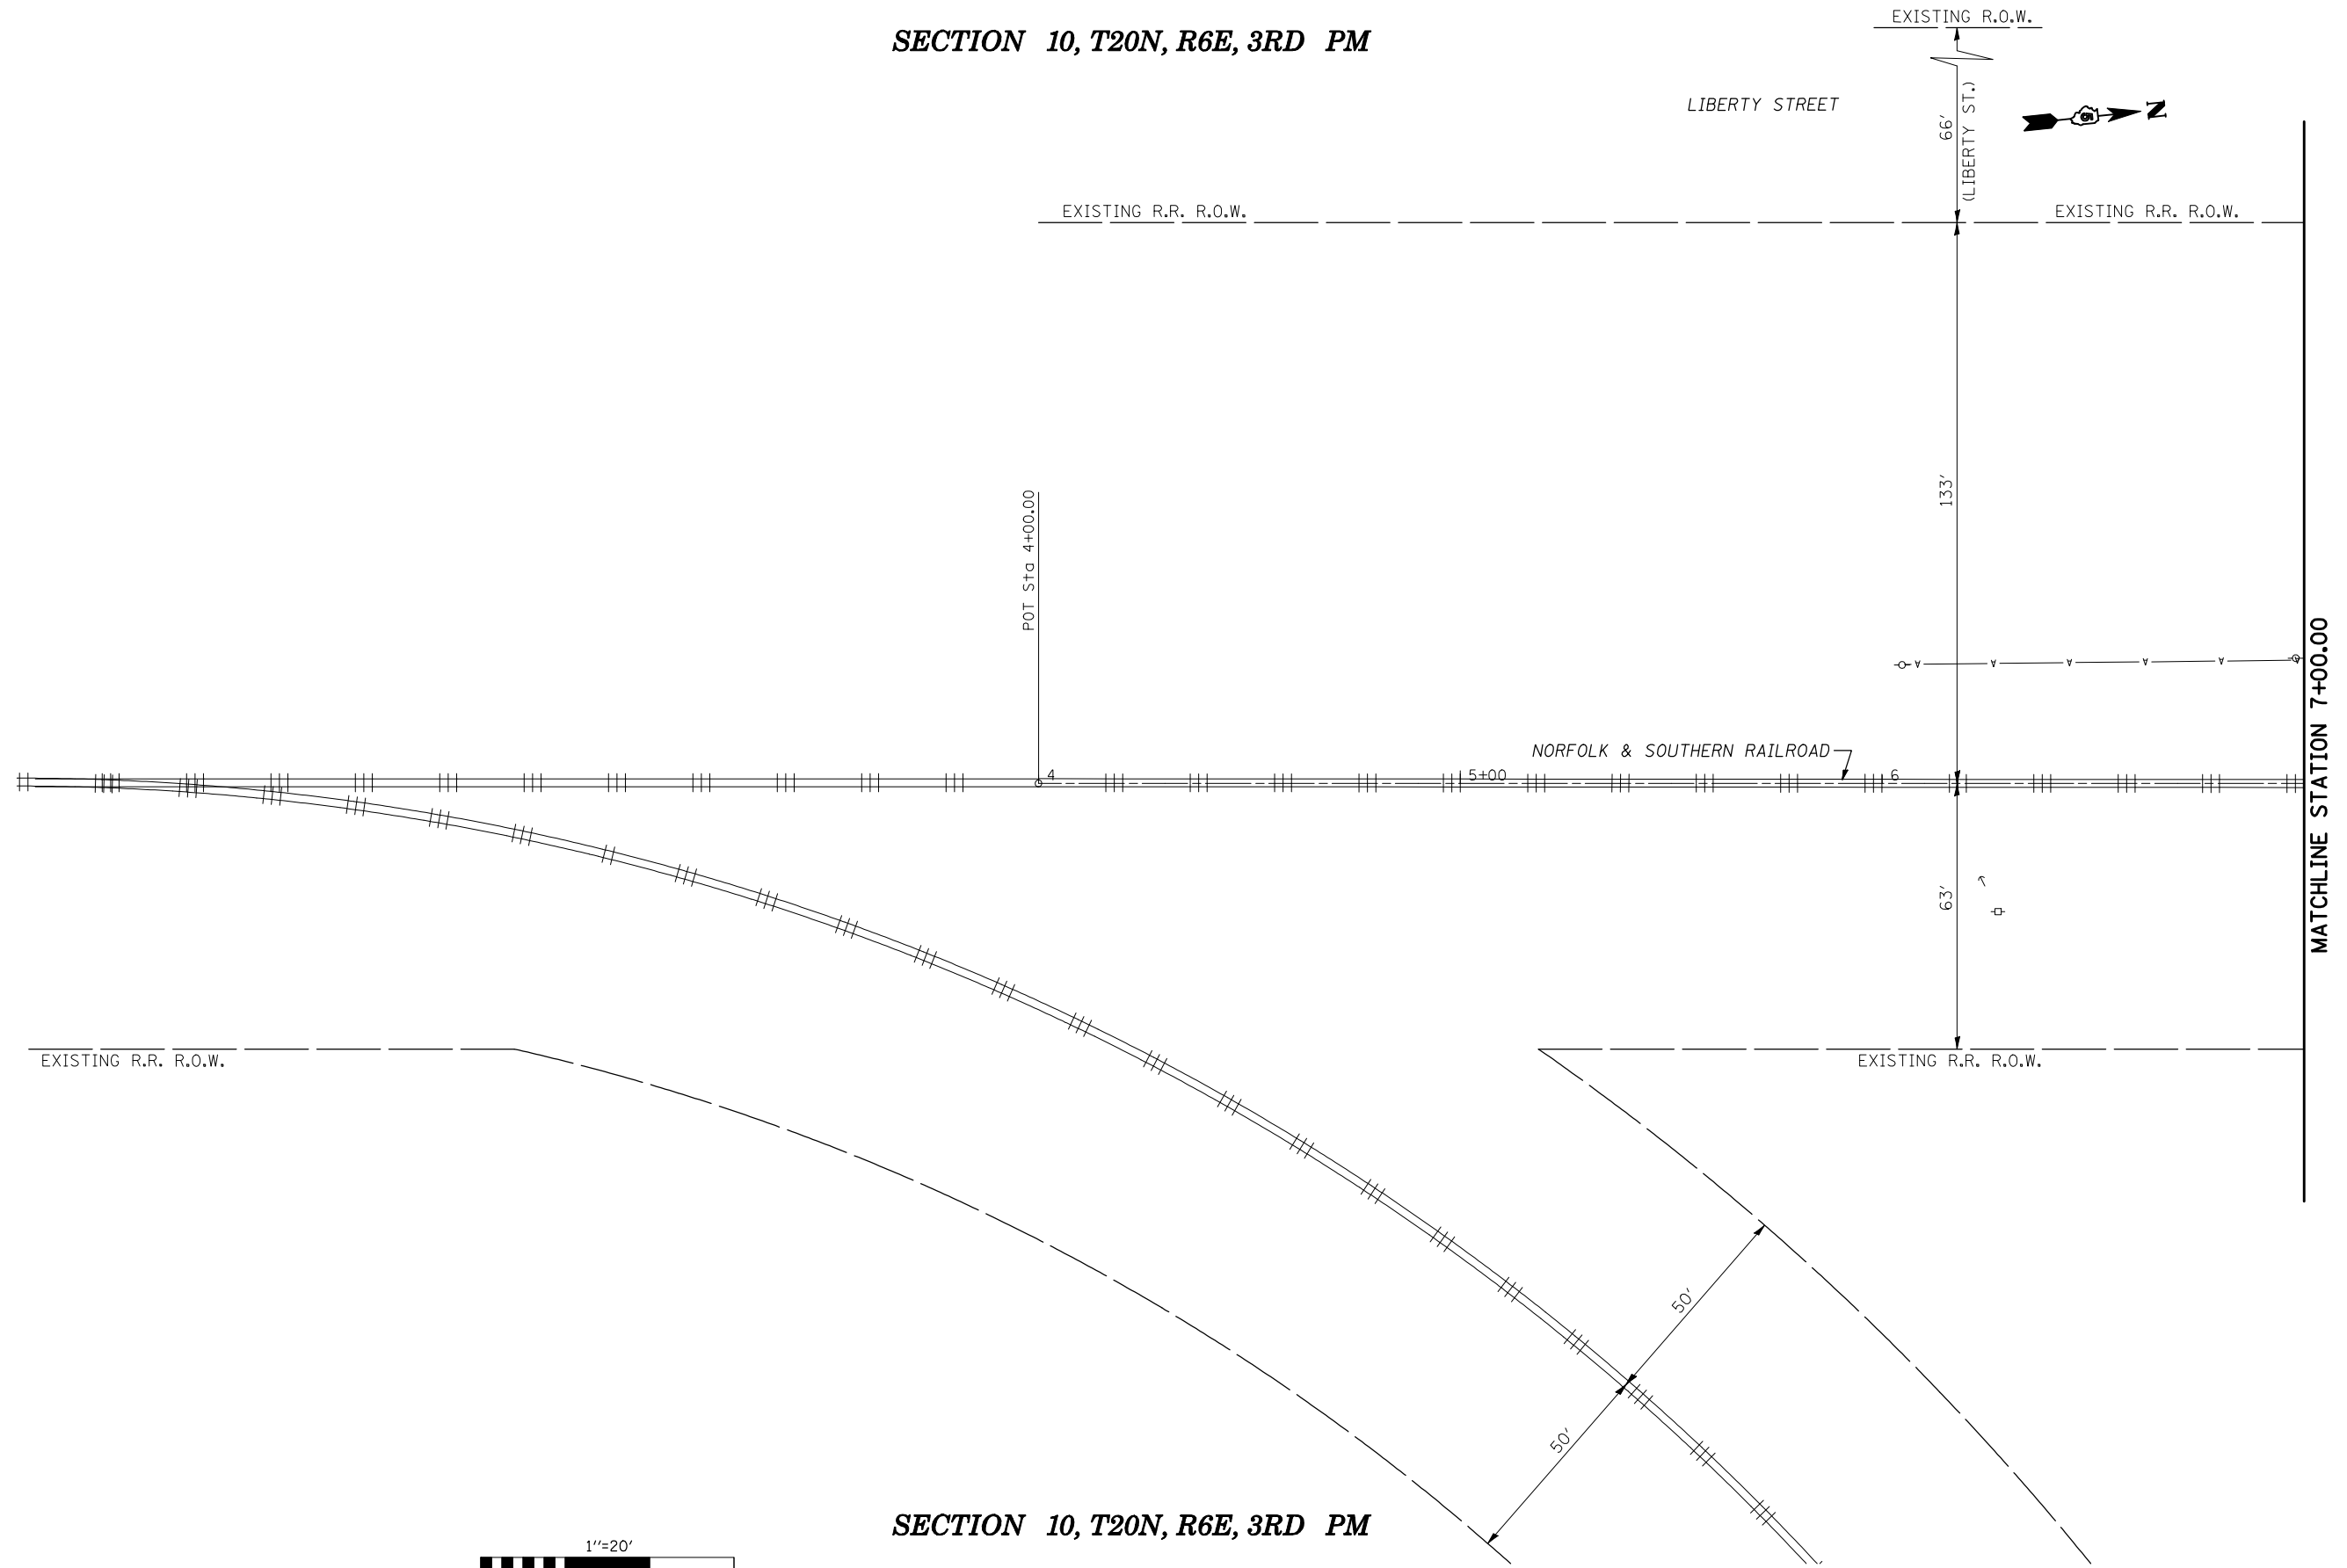

SECTION 10, T20N, R6E, 3RD PM

FILE NAME =	USER NAME = shererjm	DESIGNED - CMS	REVISED -
ct:\pw\work\PWIDOT\SHERERJM\dms86674\70888plansheets.dgn		DRAWN - JRP	REVISED -
	PLOT SCALE = 40.0000' / IN.	CHECKED -	REVISED -
	PLOT DATE = 10/13/2009	DATE - 04-07-2008	REVISED -

STATE OF ILLINOIS
DEPARTMENT OF TRANSPORTATION


PLAN (NORFOLK & SOUTHERN RAILROAD)

SCALE: 1" = 20' SHEET NO. 1 OF 3 SHEETS STA. 4+00.00 TO STA. 7+00.00

F.A.S. RTE.	SECTION	COUNTY	TOTAL SHEETS	SHEET NO.
1517	12VBR-1	PIATT	168	34
FED. ROAD DIST. NO. ILLINOIS FED. AID PROJECT			CONTRACT NO. 70388	

PLAN	SURVEYED	BY	DATE
	PLOTTED		
	GRADES CHECKED		
	STRUCTURE NOTATION		
	NOTE BOOK NO.		
	CADD FILE NAME		

PROFILE	SURVEYED	BY	DATE
	PLOTTED		
	GRADES CHECKED		
	STRUCTURE NOTATION		
	NOTE BOOK NO.		
	CADD FILE NAME		

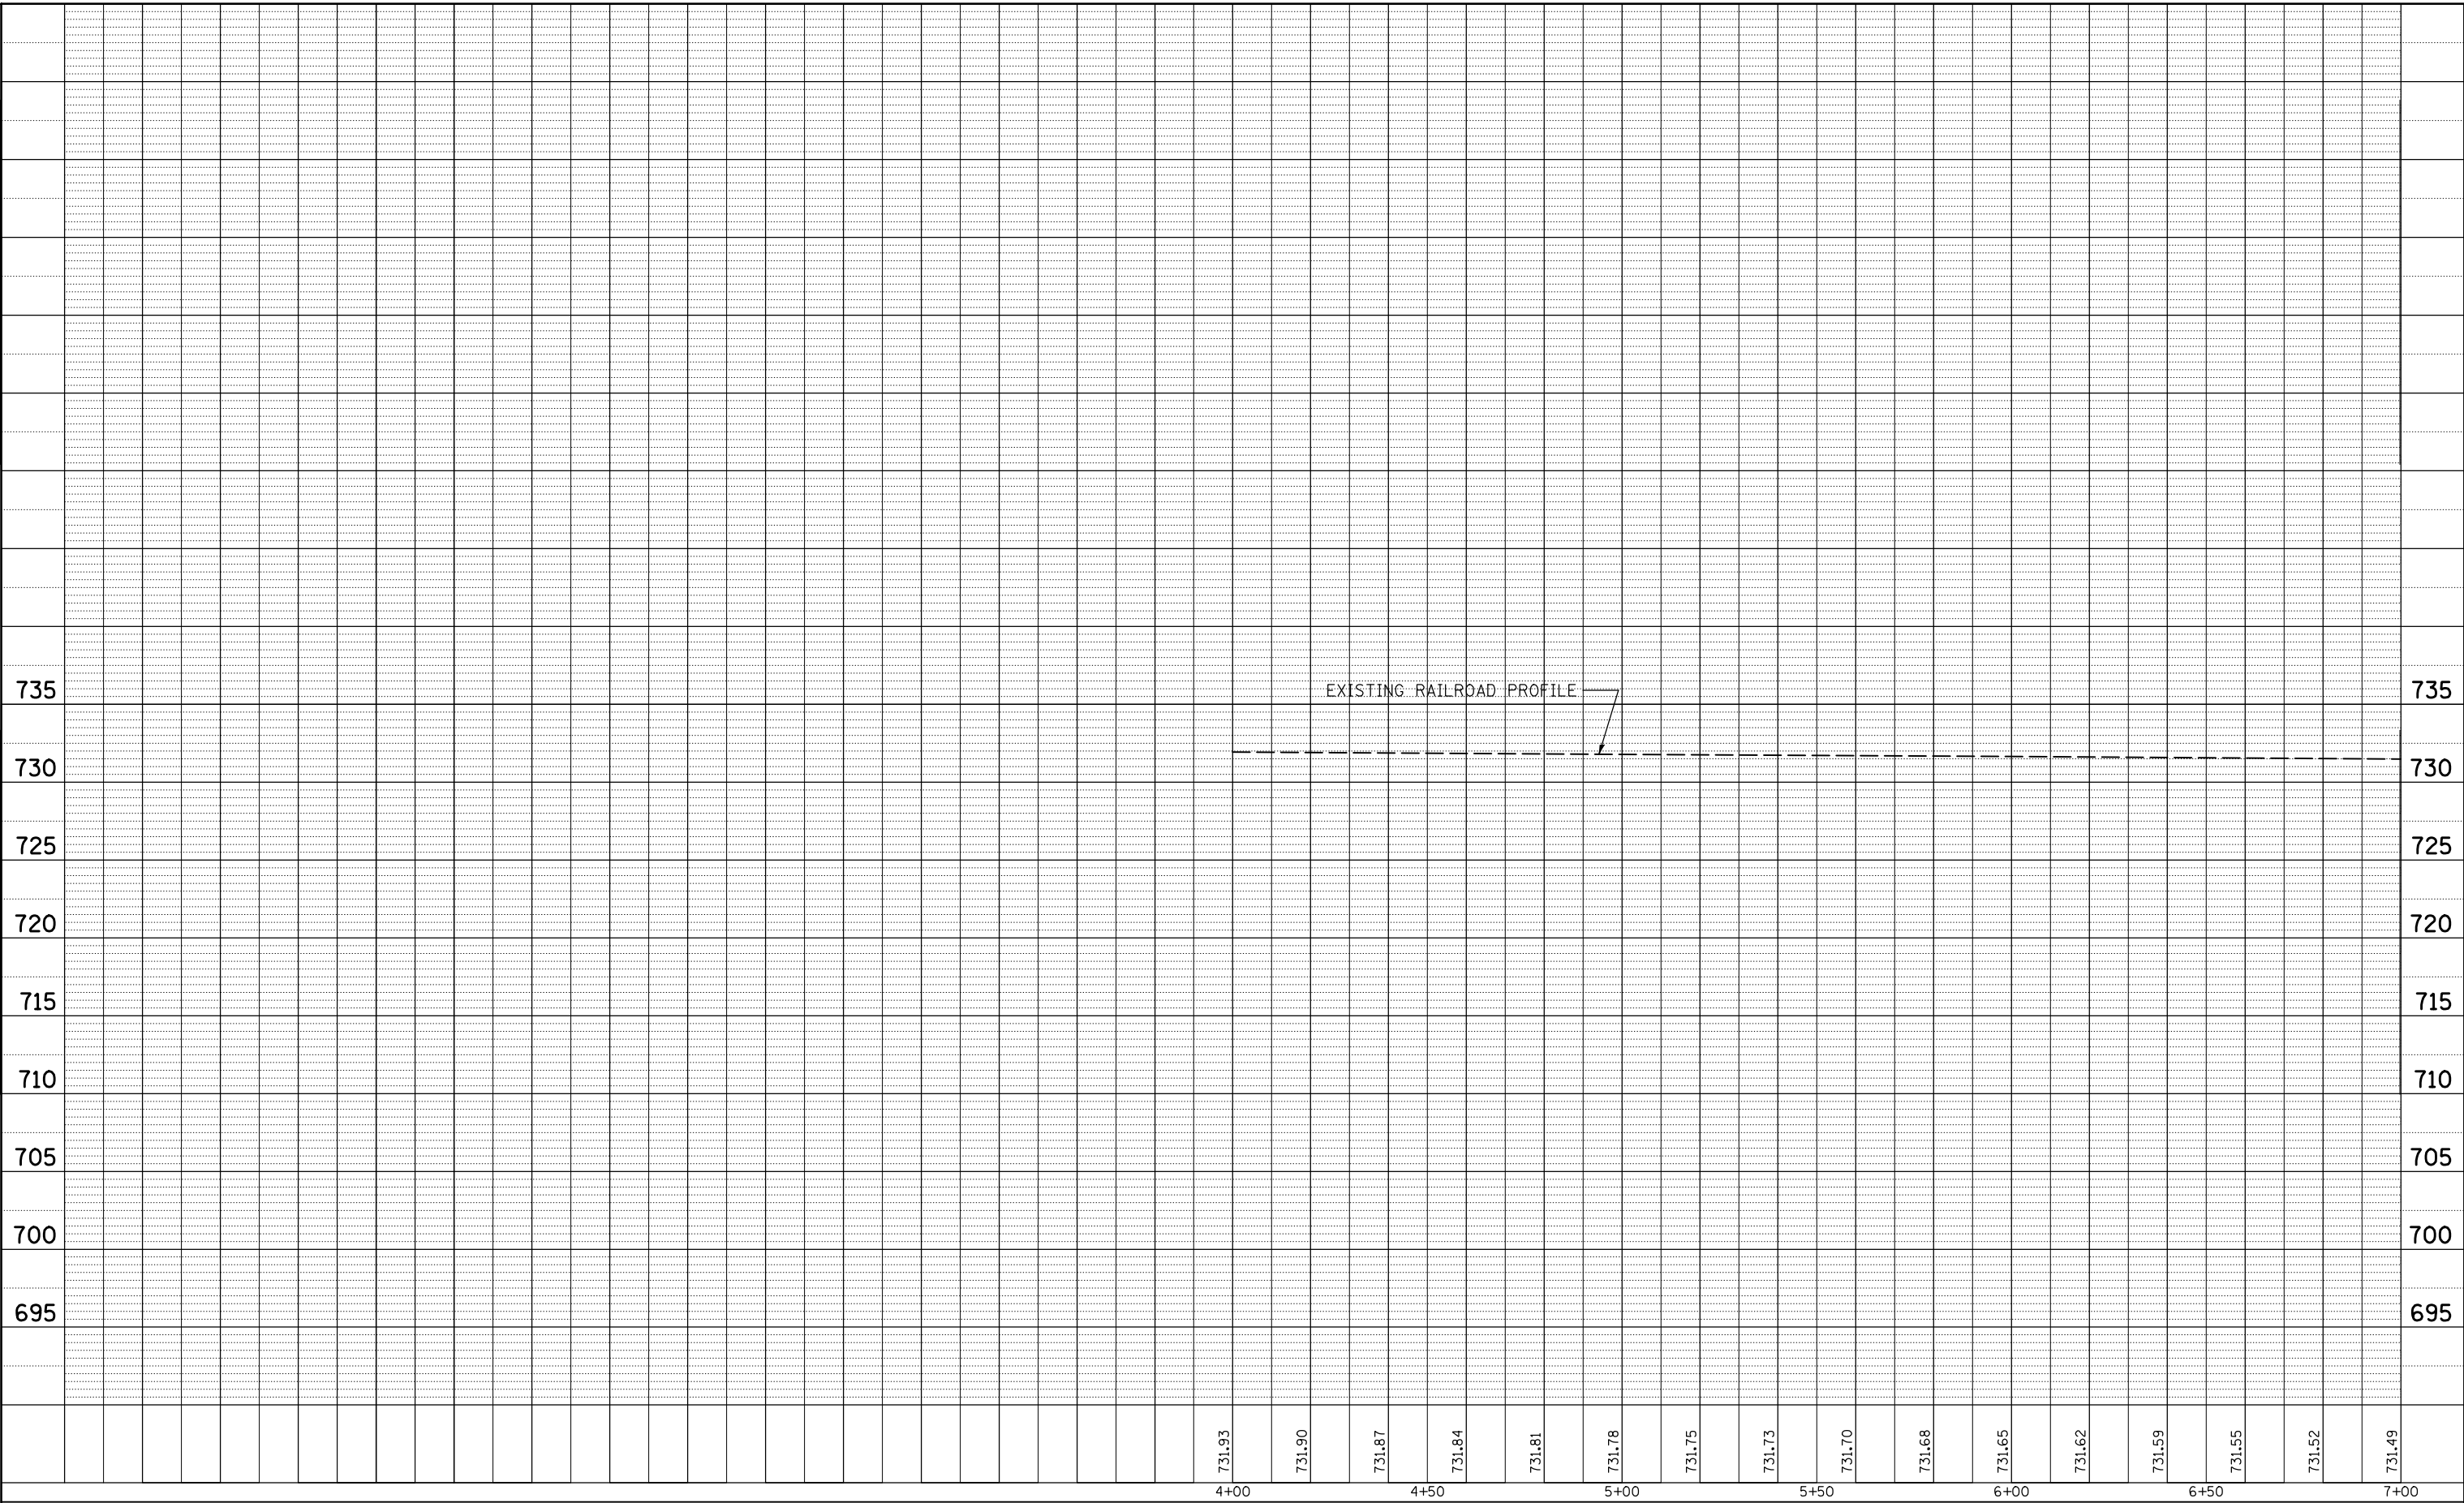

731.93	731.90	731.87	731.84	731.81	731.78	731.75	731.73	731.70	731.68	731.65	731.62	731.59	731.55	731.52	731.49			
4+00			4+50			5+00			5+50			6+00			6+50			7+00

FILE NAME =	USER NAME = shererjm	DESIGNED - CMS	REVISED -
ct:\pw\work\PWIDOT\SHERERJM\dms86674\70388\planisheets.dgn		DRAWN -	REVISED -
PLOT SCALE = 40.0000 ' / IN.		CHECKED -	REVISED -
PLOT DATE = 10/13/2009		DATE -	REVISED -

**STATE OF ILLINOIS
DEPARTMENT OF TRANSPORTATION**


PROFILE (NORFOLK & SOUTHERN RAILROAD)

SCALE: SHEET NO. OF SHEETS STA. 4+00.00 TO STA. 7+00.00

F.A.S. RTE.	SECTION	COUNTY	TOTAL SHEETS	SHEET NO.
1517	12VBR-1	PIATT	168	35
FED. ROAD DIST. NO. ILLINOIS FED. AID PROJECT			CONTRACT NO. 70388	


SECTION 10, T20N, R6E, 3RD PM

SECTION 3, T20N, R6E, 3RD PM

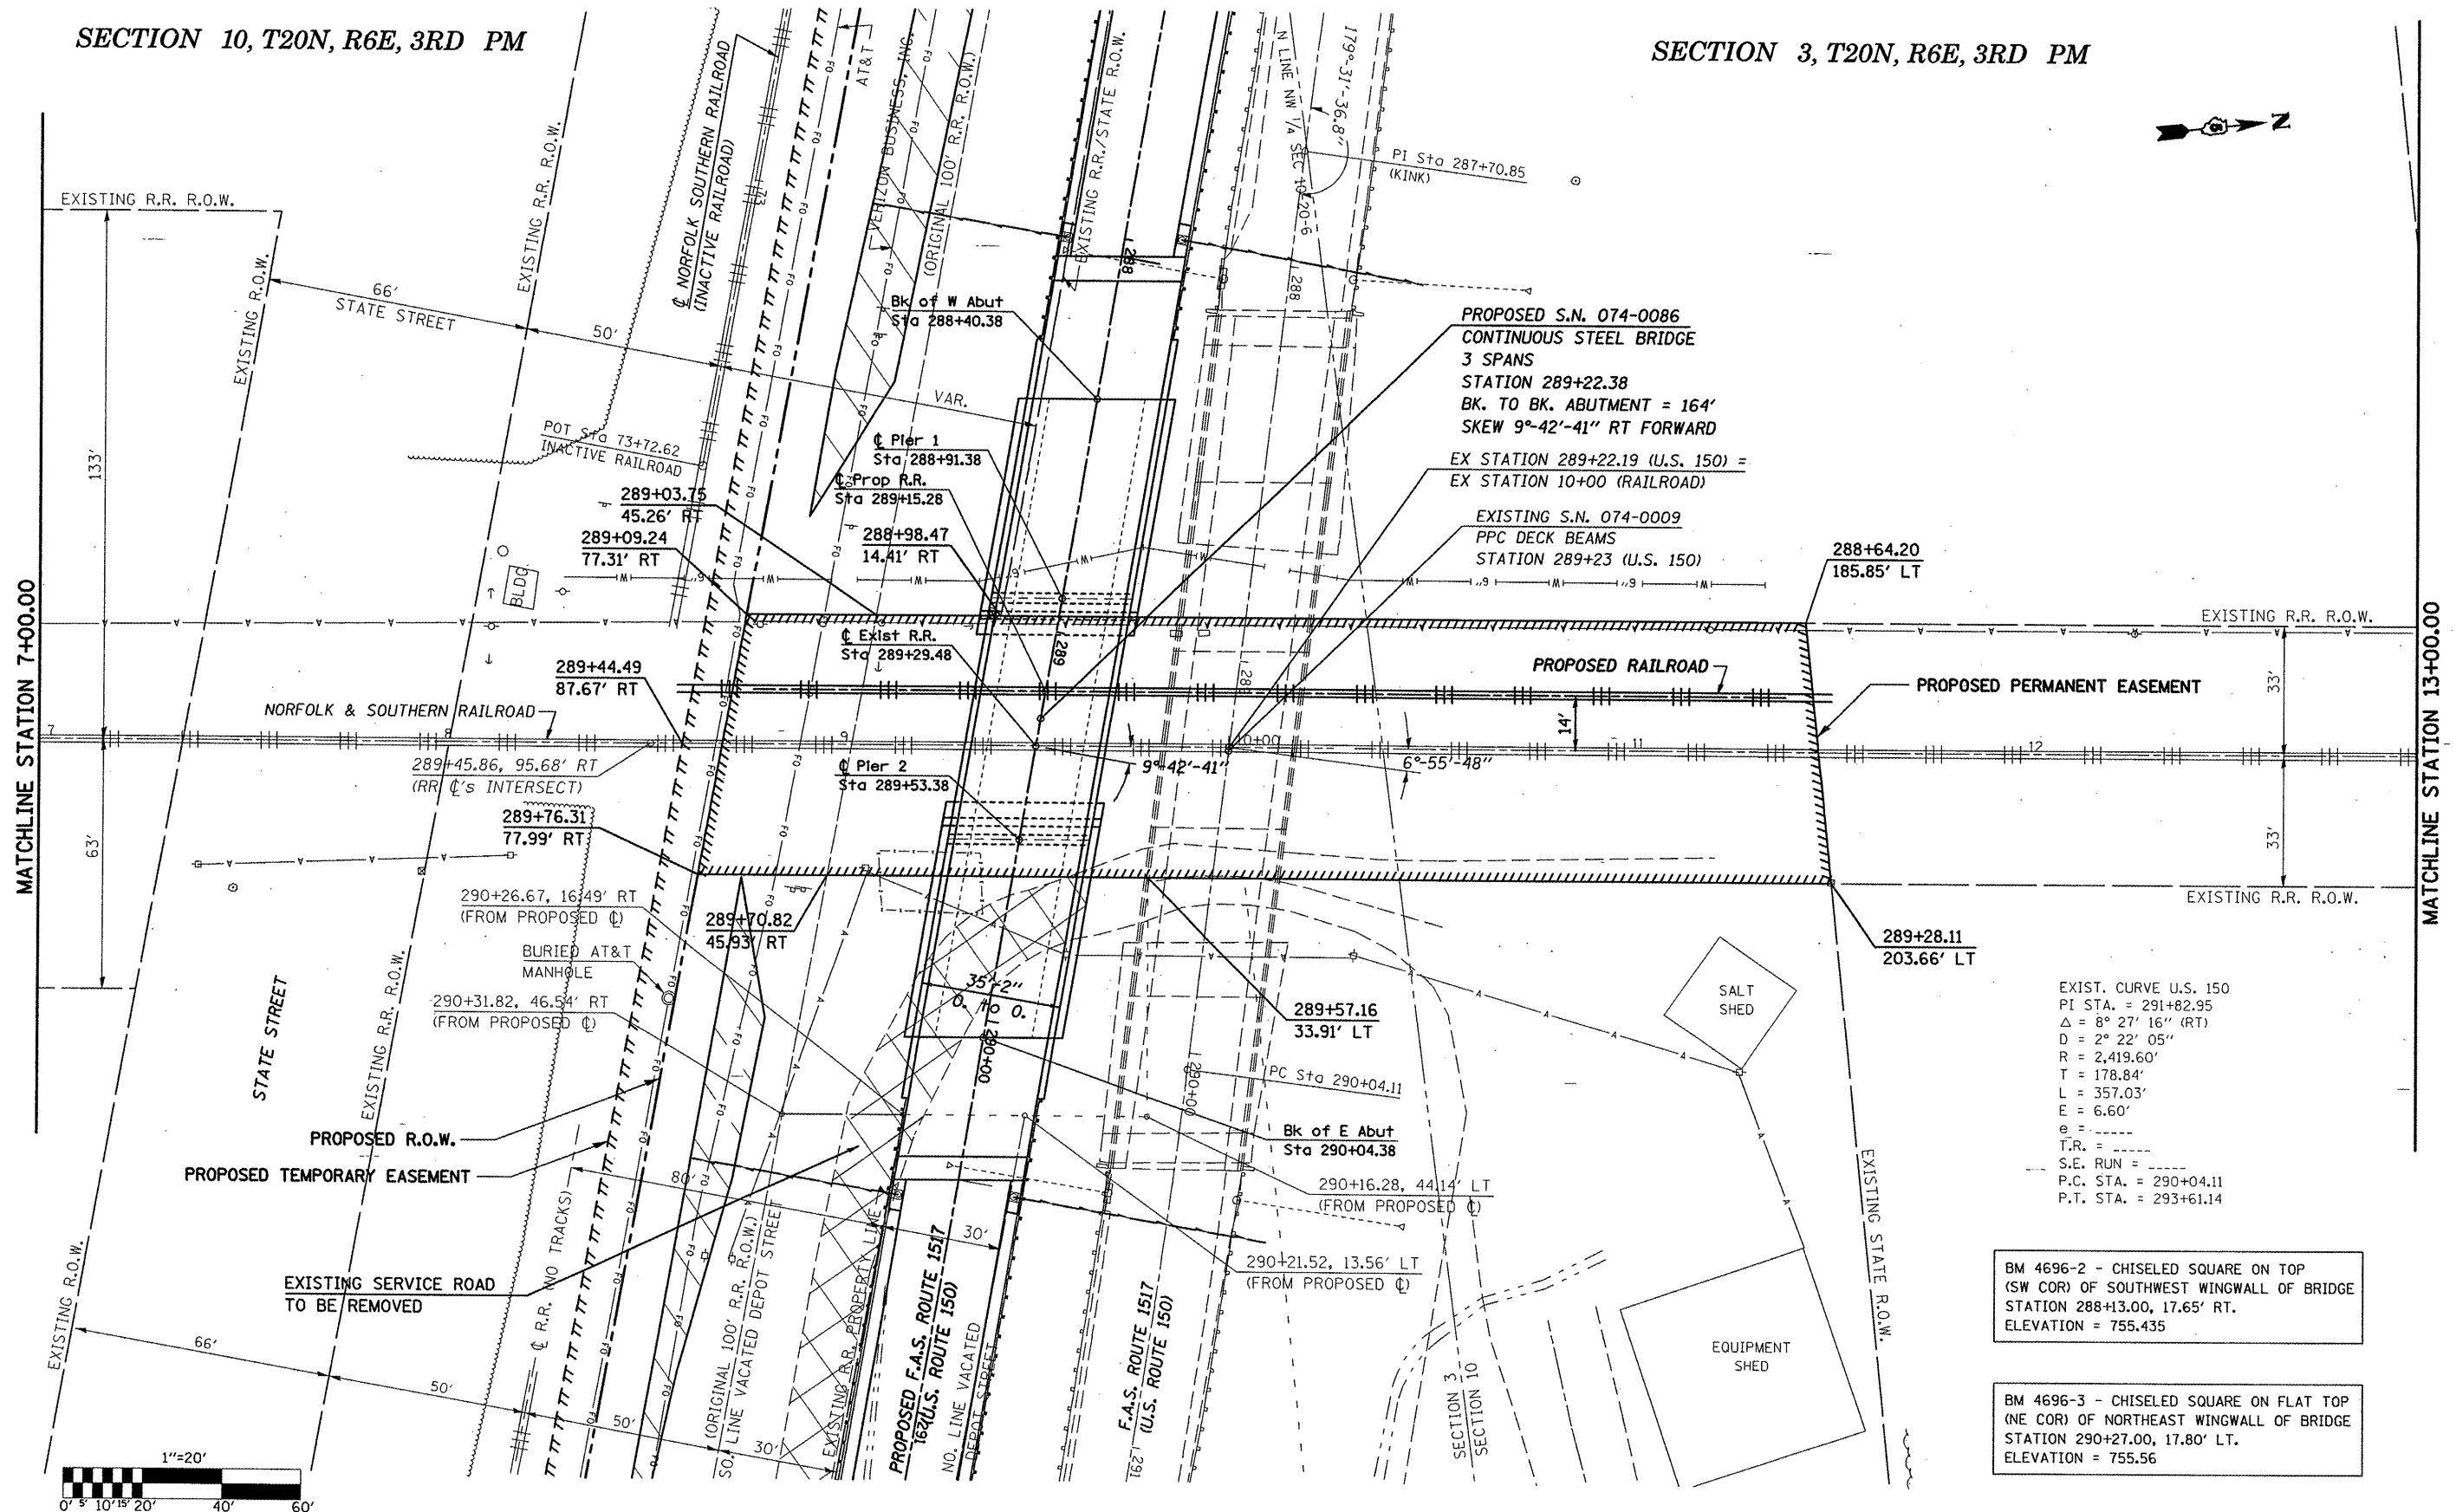

BM 4696-2 - CHISELED SQUARE ON TOP (SW COR) OF SOUTHWEST WINGWALL OF BRIDGE STATION 288+13.00, 17.65' RT. ELEVATION = 755.435

BM 4696-3 - CHISELED SQUARE ON FLAT TOP (NE COR) OF NORTHEAST WINGWALL OF BRIDGE STATION 290+27.00, 17.80' LT. ELEVATION = 755.56

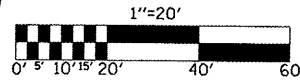

FILE NAME =	USER NAME = sherer_jm	DESIGNED - CMS	REVISED -
c:\pwwork\p\WIDOT\SHERERJM\dms86674\7888plonaheeta.dgn		DRAWN - JRP	REVISED -
		CHECKED -	REVISED -
		DATE - 04-07-2008	REVISED -

**STATE OF ILLINOIS
 DEPARTMENT OF TRANSPORTATION**


PLAN (NORFOLK & SOUTHERN RAILROAD)

SCALE: 1" = 20' SHEET NO. 2 OF 3 SHEETS STA. 7+00.00 TO STA. 13+00.00

F.A.S. RTE.	SECTION	COUNTY	TOTAL SHEETS	SHEET NO.
1517	12VBR-1	PIATT	168	36
FED. ROAD DIST. NO. ILLINOIS FED. AID PROJECT			CONTRACT NO. 70388	

PLAN	SURVEYED	BY	DATE
NOTE BOOK NO.	PLOTTED		
	CHECKED		
	AT		
	CAD FILE NAME		

PROFILE	SURVEYED	BY	DATE
NOTE BOOK NO.	GRADES CHECKED		
	STRUCTURE NOTATIONS OK'D		

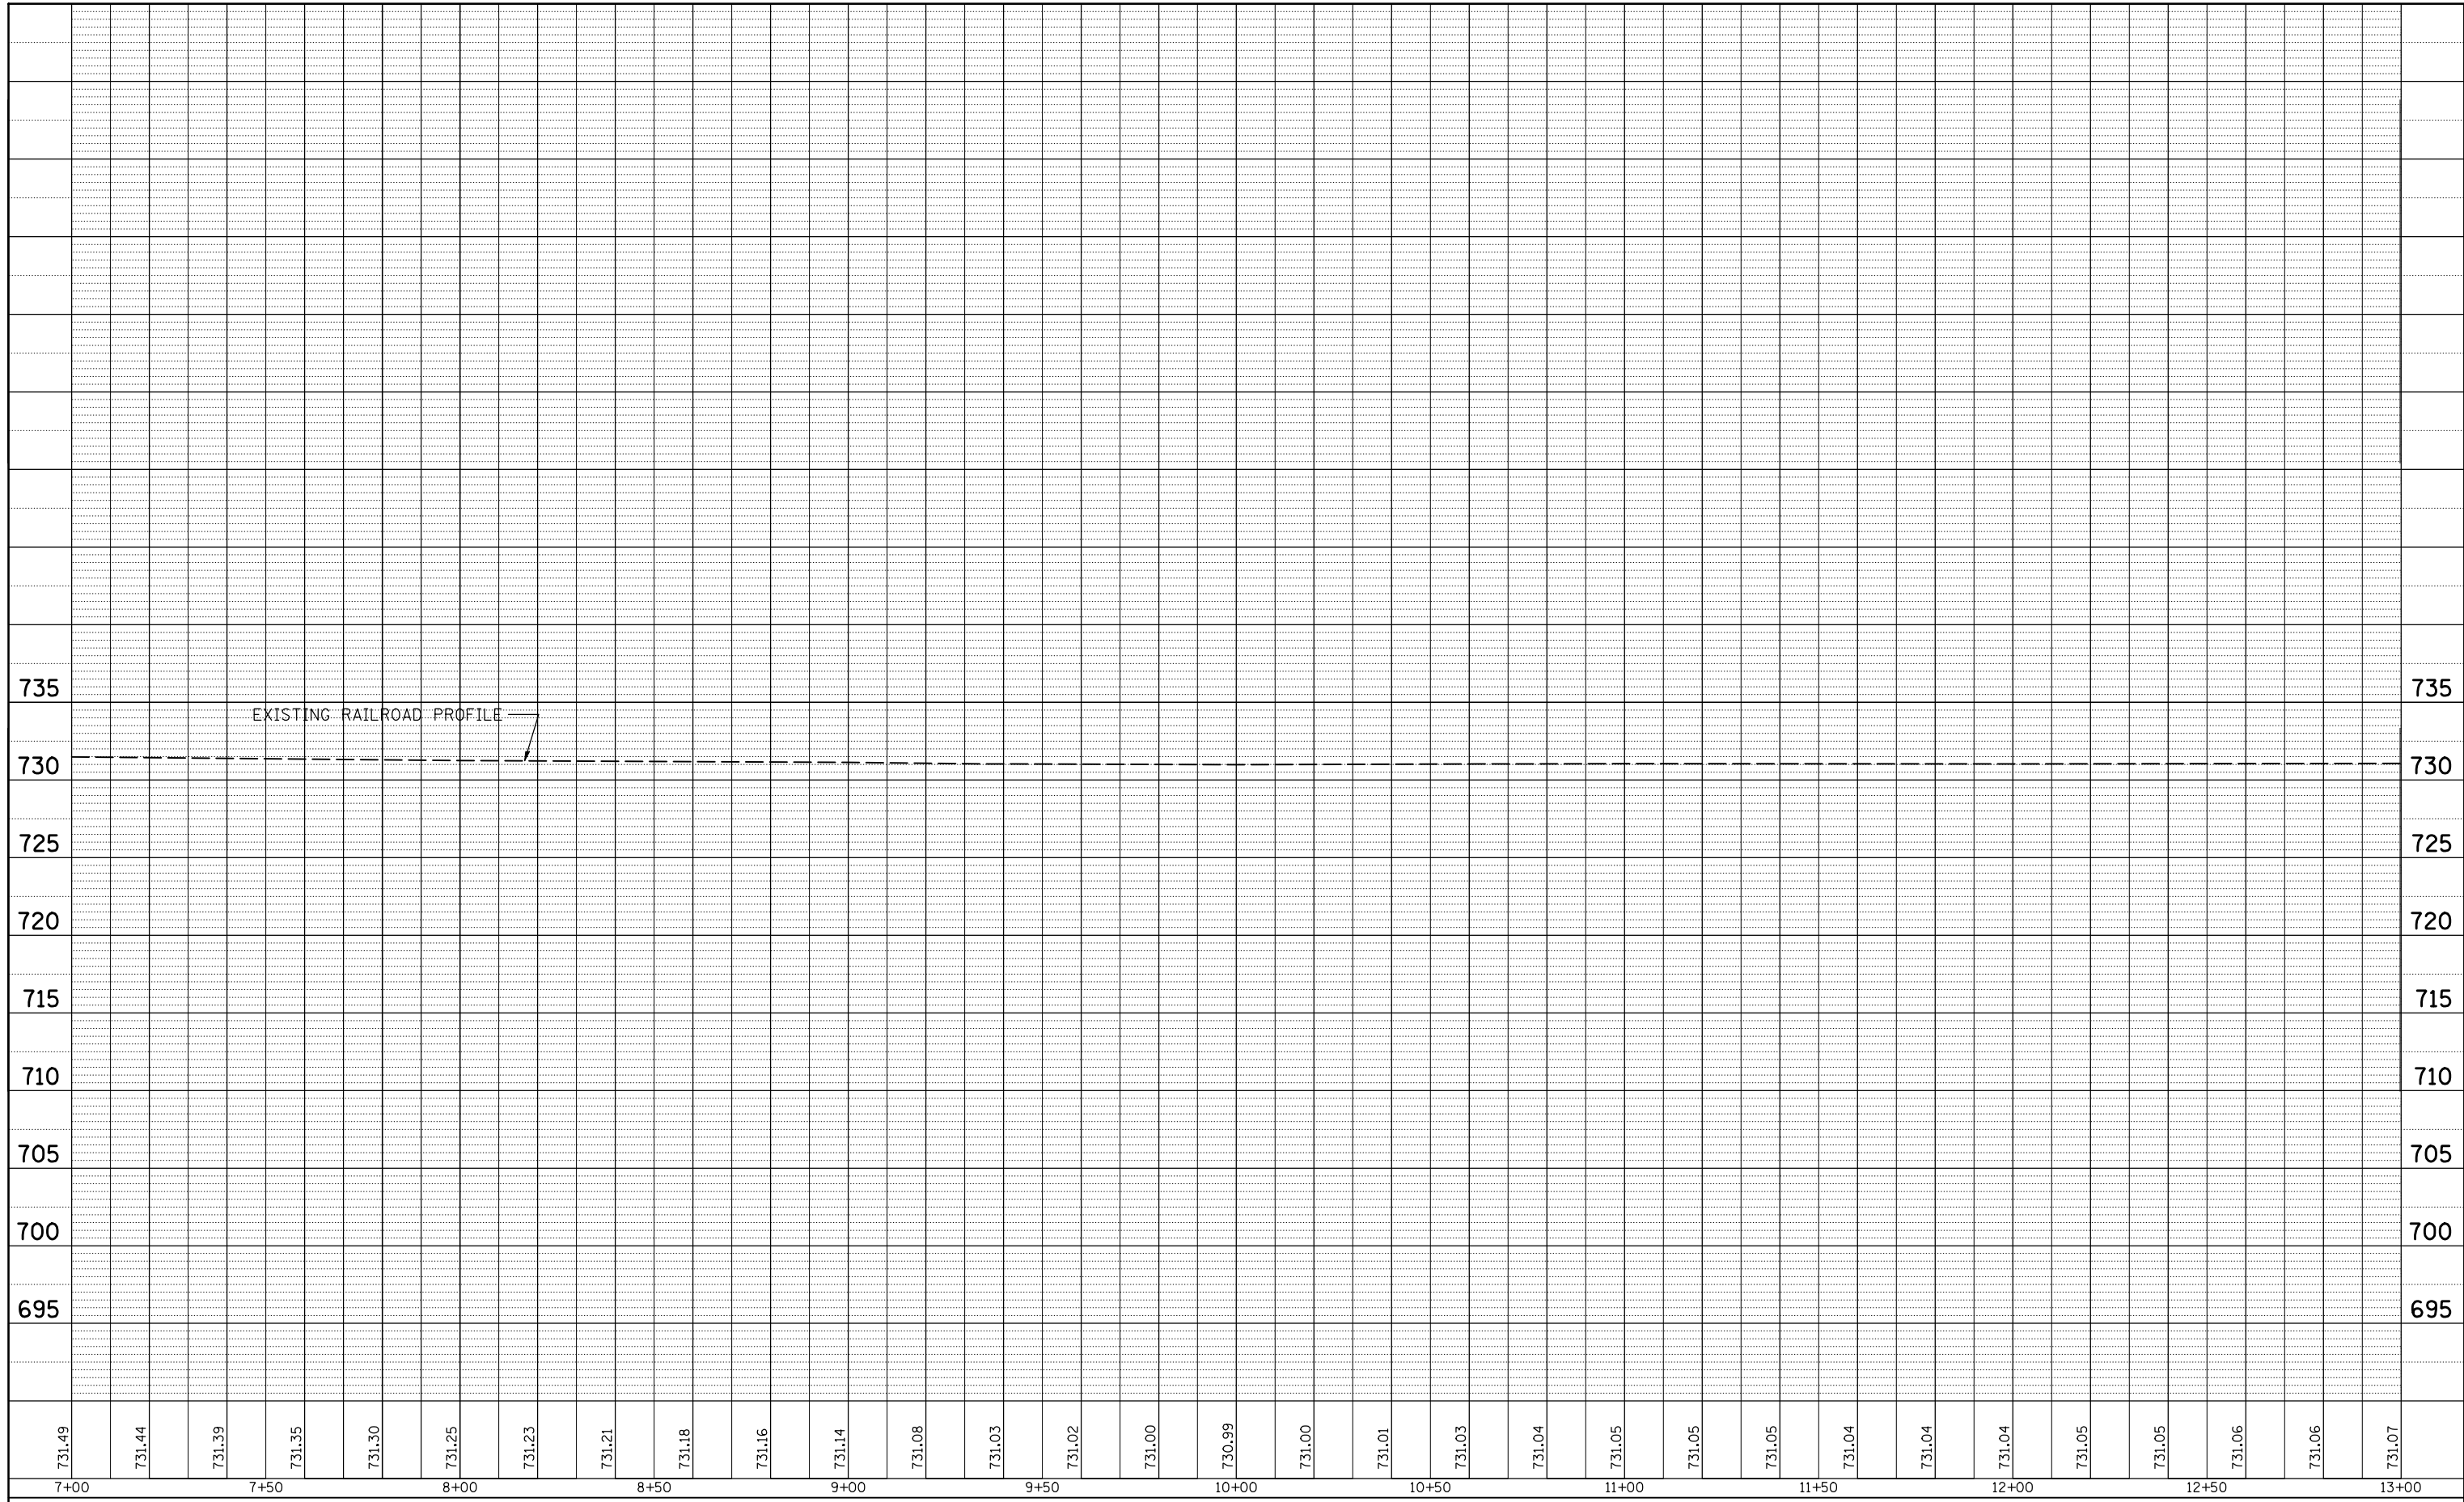

731.49	731.44	731.39	731.35	731.30	731.25	731.23	731.21	731.18	731.16	731.14	731.08	731.03	731.02	731.00	730.99	731.00	731.01	731.03	731.04	731.05	731.05	731.05	731.04	731.04	731.04	731.05	731.05	731.06	731.06	731.07
7+00	7+50	8+00	8+50	9+00	9+50	10+00	10+50	11+00	11+50	12+00	12+50	13+00																		

FILE NAME =	USER NAME = shererjm	DESIGNED - CMS	REVISED -
ct:\pw\work\PWIDOT\SHERERJM\dms86674\70388\plan\sheet.dgn		DRAWN -	REVISED -
	PLOT SCALE = 40.0000' / IN.	CHECKED -	REVISED -
	PLOT DATE = 10/13/2009	DATE -	REVISED -


**STATE OF ILLINOIS
DEPARTMENT OF TRANSPORTATION**

PROFILE (NORFOLK & SOUTHERN RAILROAD)

SCALE: SHEET NO. OF SHEETS STA. 7+00.00 TO STA. 13+00.00


F.A.S. RTE.	SECTION	COUNTY	TOTAL SHEETS	SHEET NO.
1517	12VBR-1	PIATT	168	37
FED. ROAD DIST. NO.			ILLINOIS FED. AID PROJECT	
			CONTRACT NO. 70388	

SECTION 3, T20N, R6E, 3RD PM

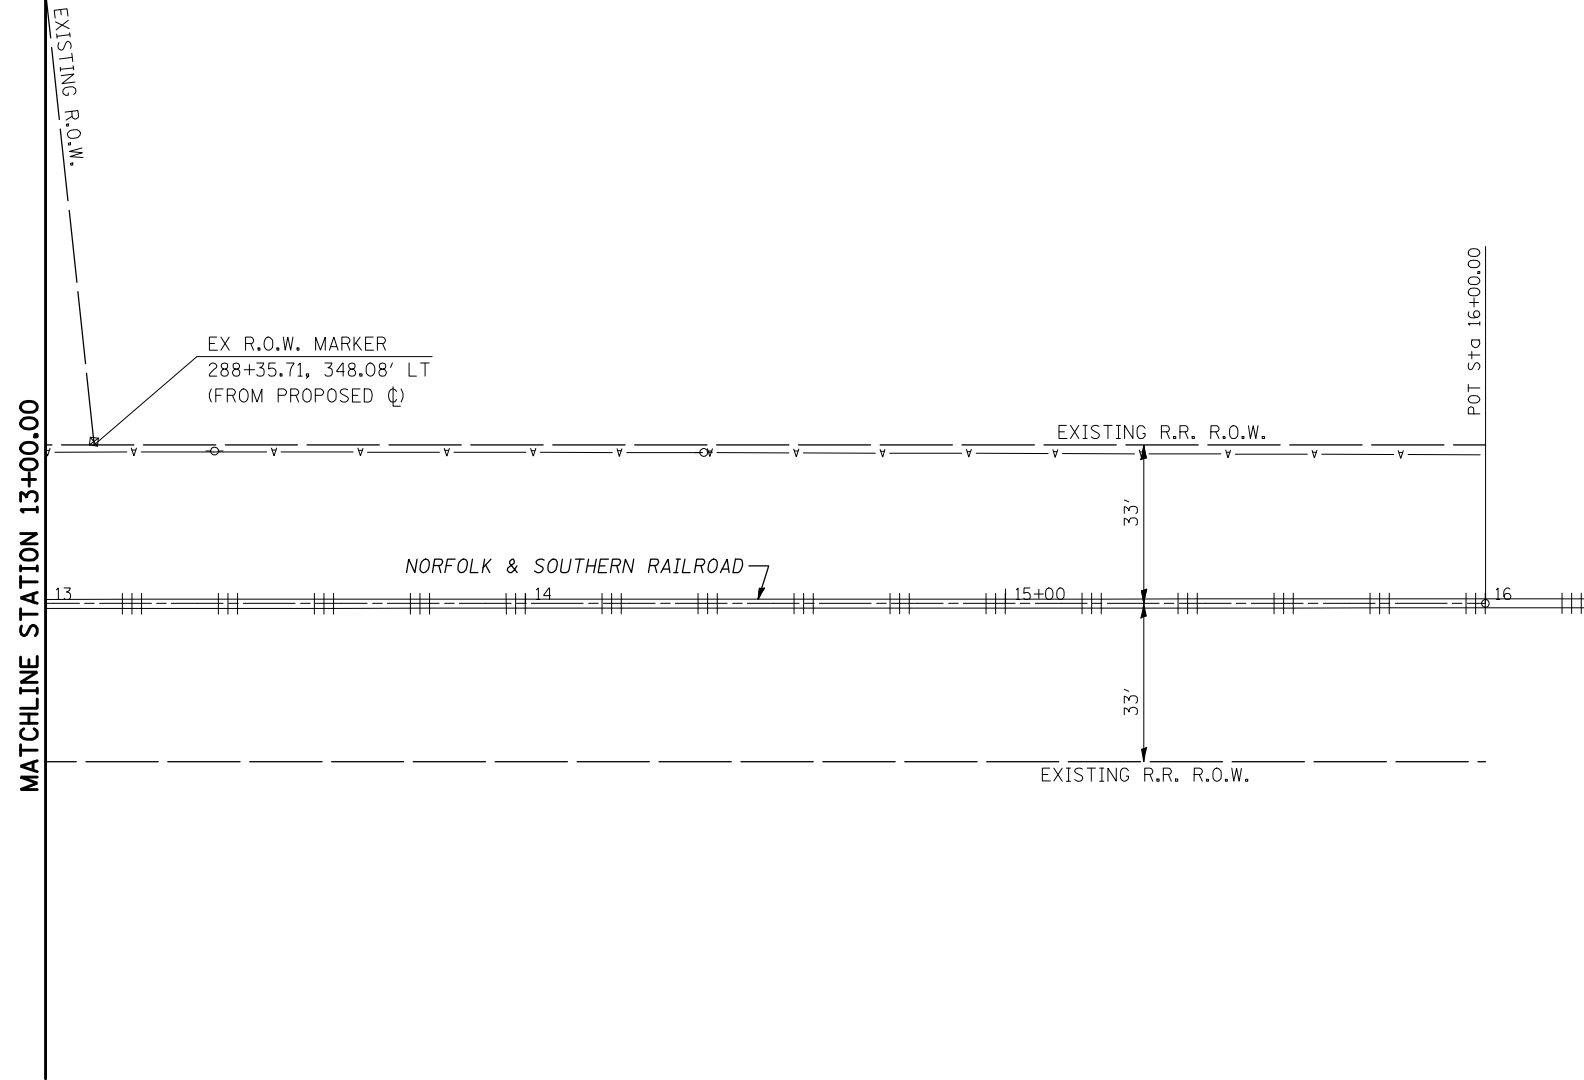

SECTION 3, T20N, R6E, 3RD PM

NW 1/4 SECTION LINE
NE 1/4 SECTION LINE

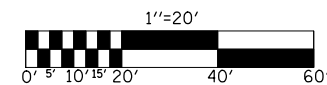

FILE NAME =	USER NAME = shererjm	DESIGNED - CMS	REVISED -
ct:\pw\work\PWIDOT\SHERERJM\dms86674\70388plansheets.dgn		DRAWN - JRP	REVISED -
	PLOT SCALE = 40.0000' / IN.	CHECKED -	REVISED -
	PLOT DATE = 10/13/2009	DATE - 04-07-2008	REVISED -

STATE OF ILLINOIS
DEPARTMENT OF TRANSPORTATION


PLAN (NORFOLK & SOUTHERN RAILROAD)

SCALE: 1" = 20' SHEET NO. 3 OF 3 SHEETS STA. 13+00.00 TO STA. 16+00.00

F.A.S. RTE.	SECTION	COUNTY	TOTAL SHEETS	SHEET NO.
1517	12VBR-1	PIATT	168	36
FED. ROAD DIST. NO. ILLINOIS FED. AID PROJECT			CONTRACT NO. 70388	

PLAN	SURVEYED	BY	DATE
NOTE BOOK NO.	PLOTTED		
	GRADES CHECKED		
	STRUCTURE NOTATION		
	CAD FILE NAME		

PROFILE	SURVEYED	BY	DATE
NOTE BOOK NO.	PLOTTED		
	GRADES CHECKED		
	STRUCTURE NOTATION		
	CAD FILE NAME		

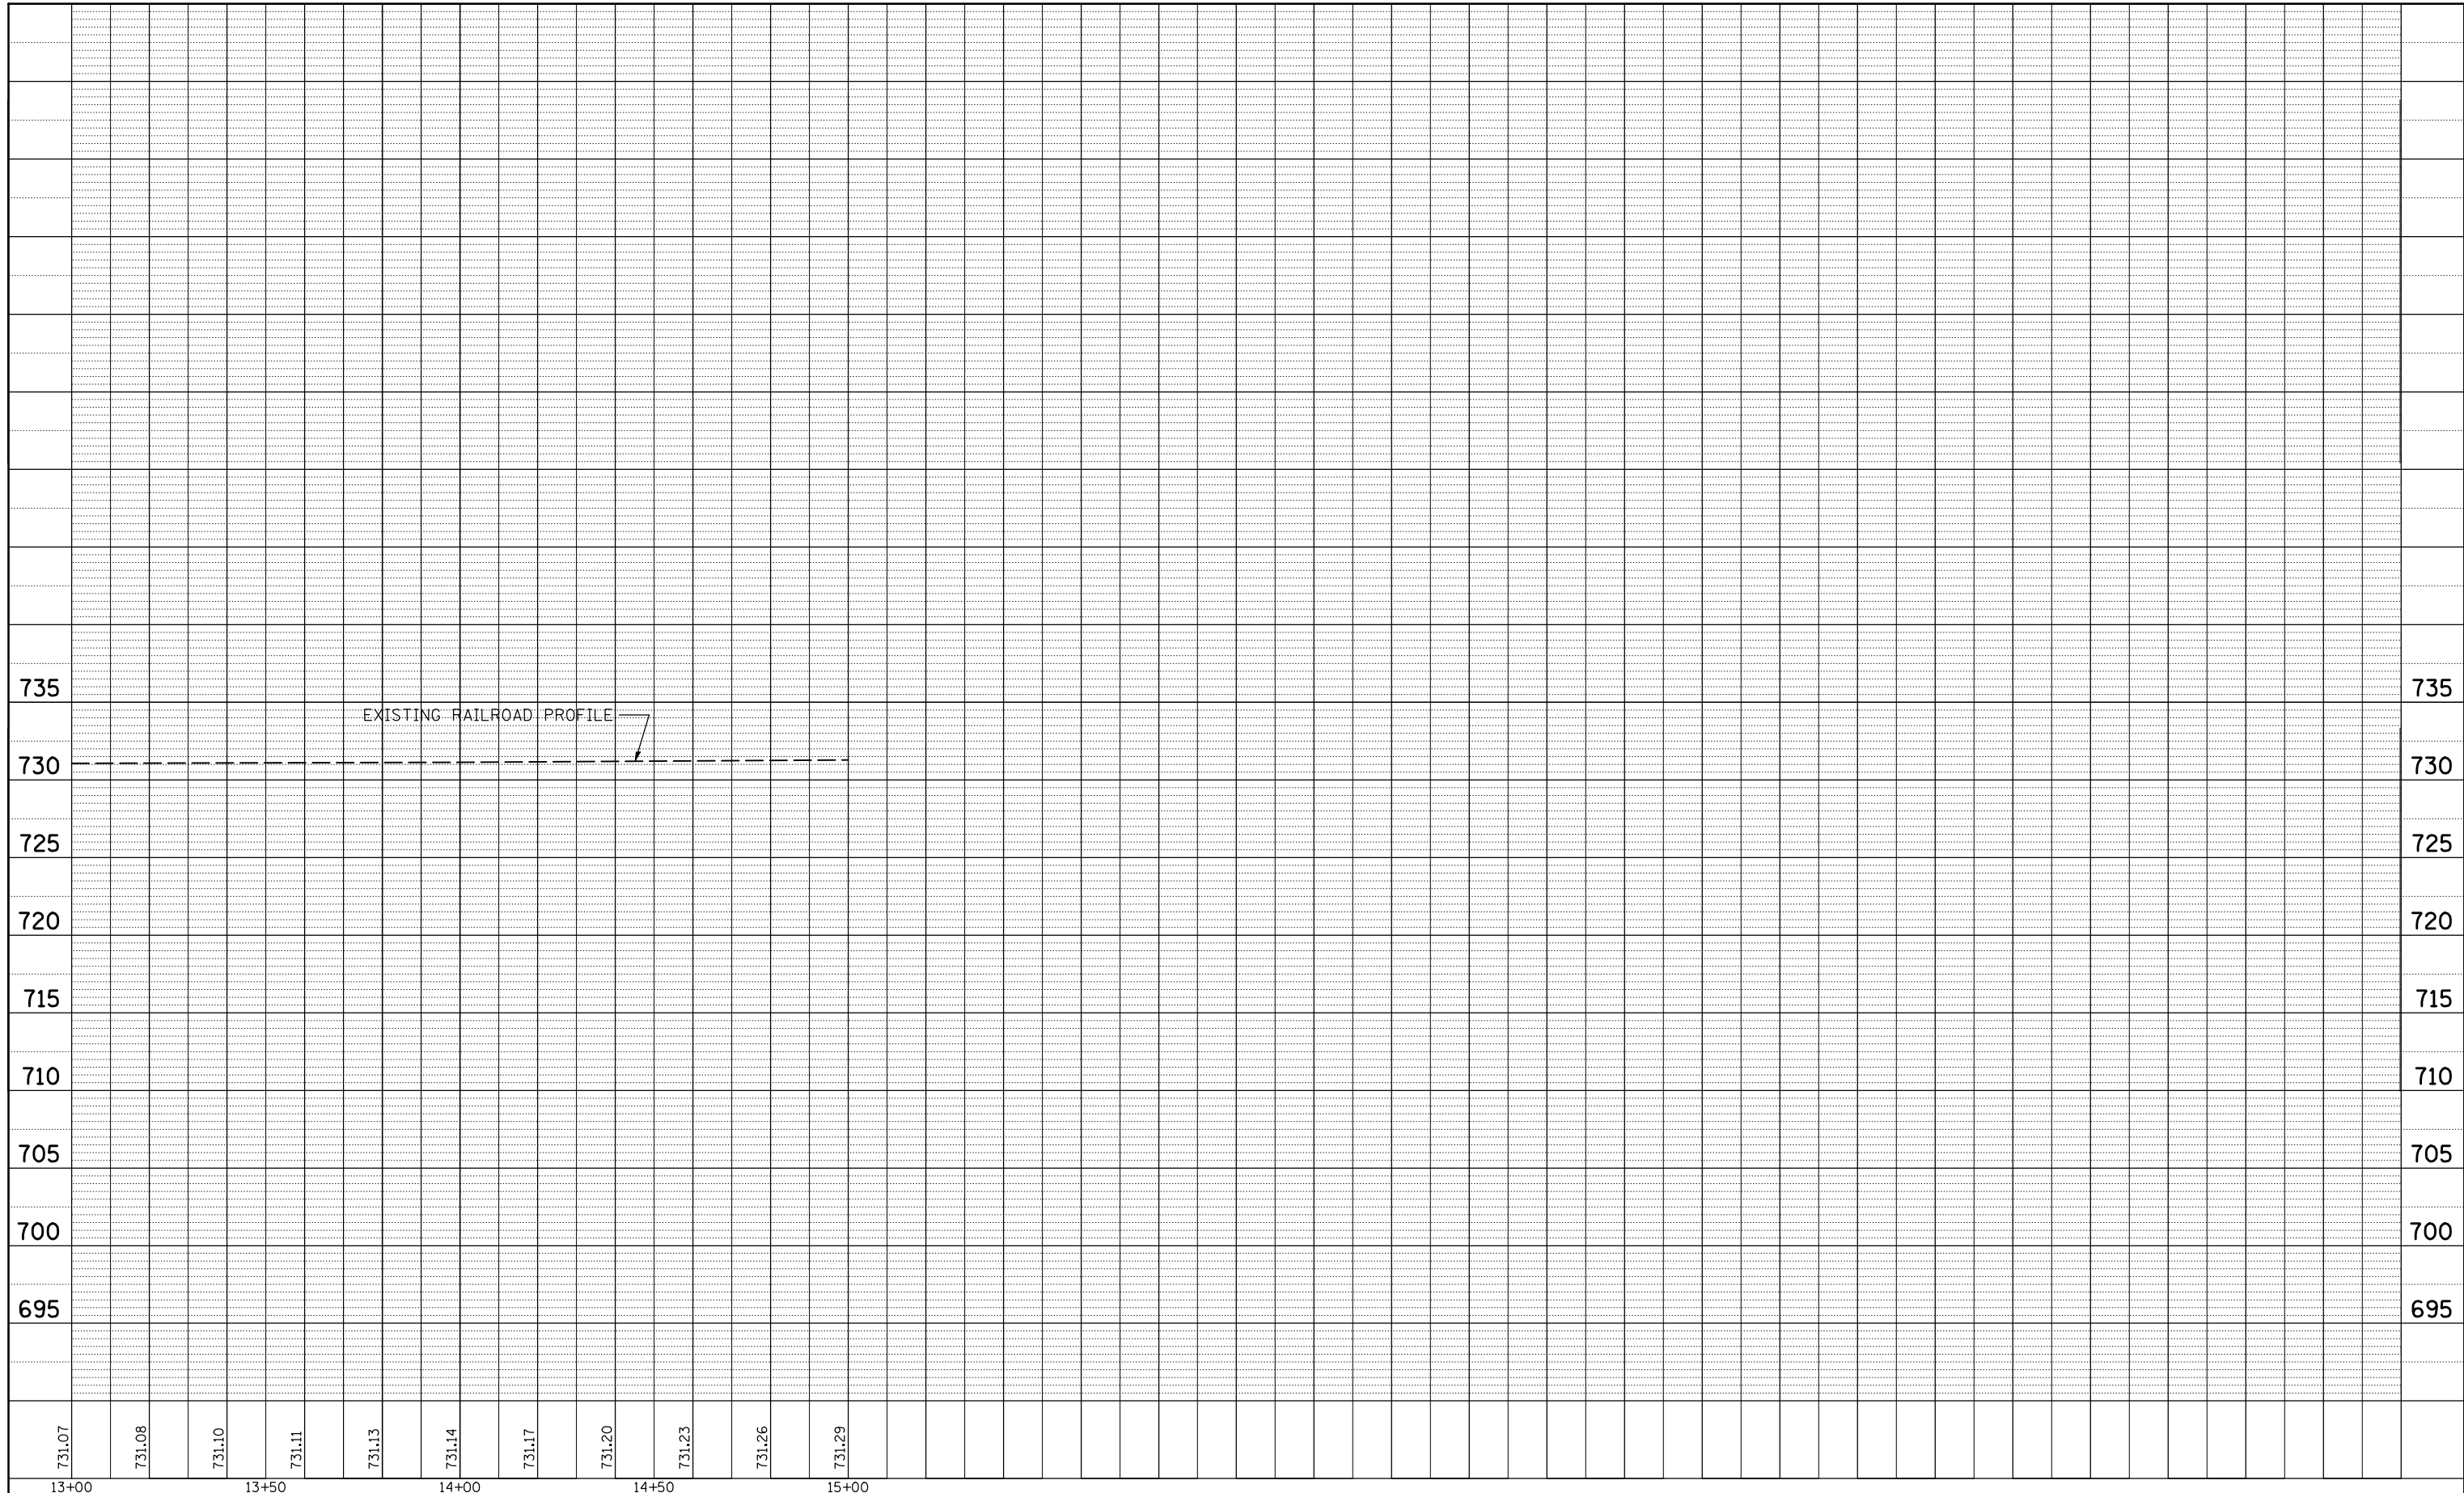

FILE NAME =	USER NAME = shererjm	DESIGNED - CMS	REVISED -	STATE OF ILLINOIS DEPARTMENT OF TRANSPORTATION	PROFILE (NORFOLK & SOUTHERN RAILROAD)	F.A.S. RTE.	SECTION	COUNTY	TOTAL SHEETS	SHEET NO.
ct:\pwork\PWIDOT\SHERERJM\dms86674\70388\planisheets.dgn	PLOT SCALE = 40.0000' / IN.	DRAWN -	REVISED -			1517	12VBR-1	PIATT	168	39
PLOT DATE = 10/13/2009	DATE -	CHECKED -	REVISED -			CONTRACT NO. 70388				
		DATE -	REVISED -			SCALE:	SHEET NO.	OF	SHEETS	STA. 13+00.00 TO STA. 16+00.00

DETAIL NOTES:


ALL DETOUR SIGN LOCATIONS ARE SUBJECT TO FIELD ADJUSTMENT IN CASE OF CONFLICTS. ANY ADJUSTMENTS WILL BE COORDINATED BY THE ENGINEER, THE CONTRACTOR, AND THE BUREAU OF OPERATIONS (CLARK PIPER) PRIOR TO ROAD CLOSURE.

CMS BOARD PLACEMENT SHALL BE COORDINATED WITH THE ENGINEER AND TRAFFIC CONTROL SUPERVISOR PRIOR TO CONSTRUCTION.


FURNISHING, PLACEMENT AND REMOVAL OF ALL DETOUR SIGNS SHALL BE IN ACCORDANCE WITH THE SPECIAL PROVISION FOR DETOUR SIGNING

REFER TO THE DETAIL FOR TRAFFIC CONTROL & PROTECTION DEVICES (ROAD & SIDEROAD/STREET CLOSURES) FOR ALL OTHER SIGNING AND PLACEMENT NOT SHOWN HEREIN THIS DETAIL

FARMER CITY

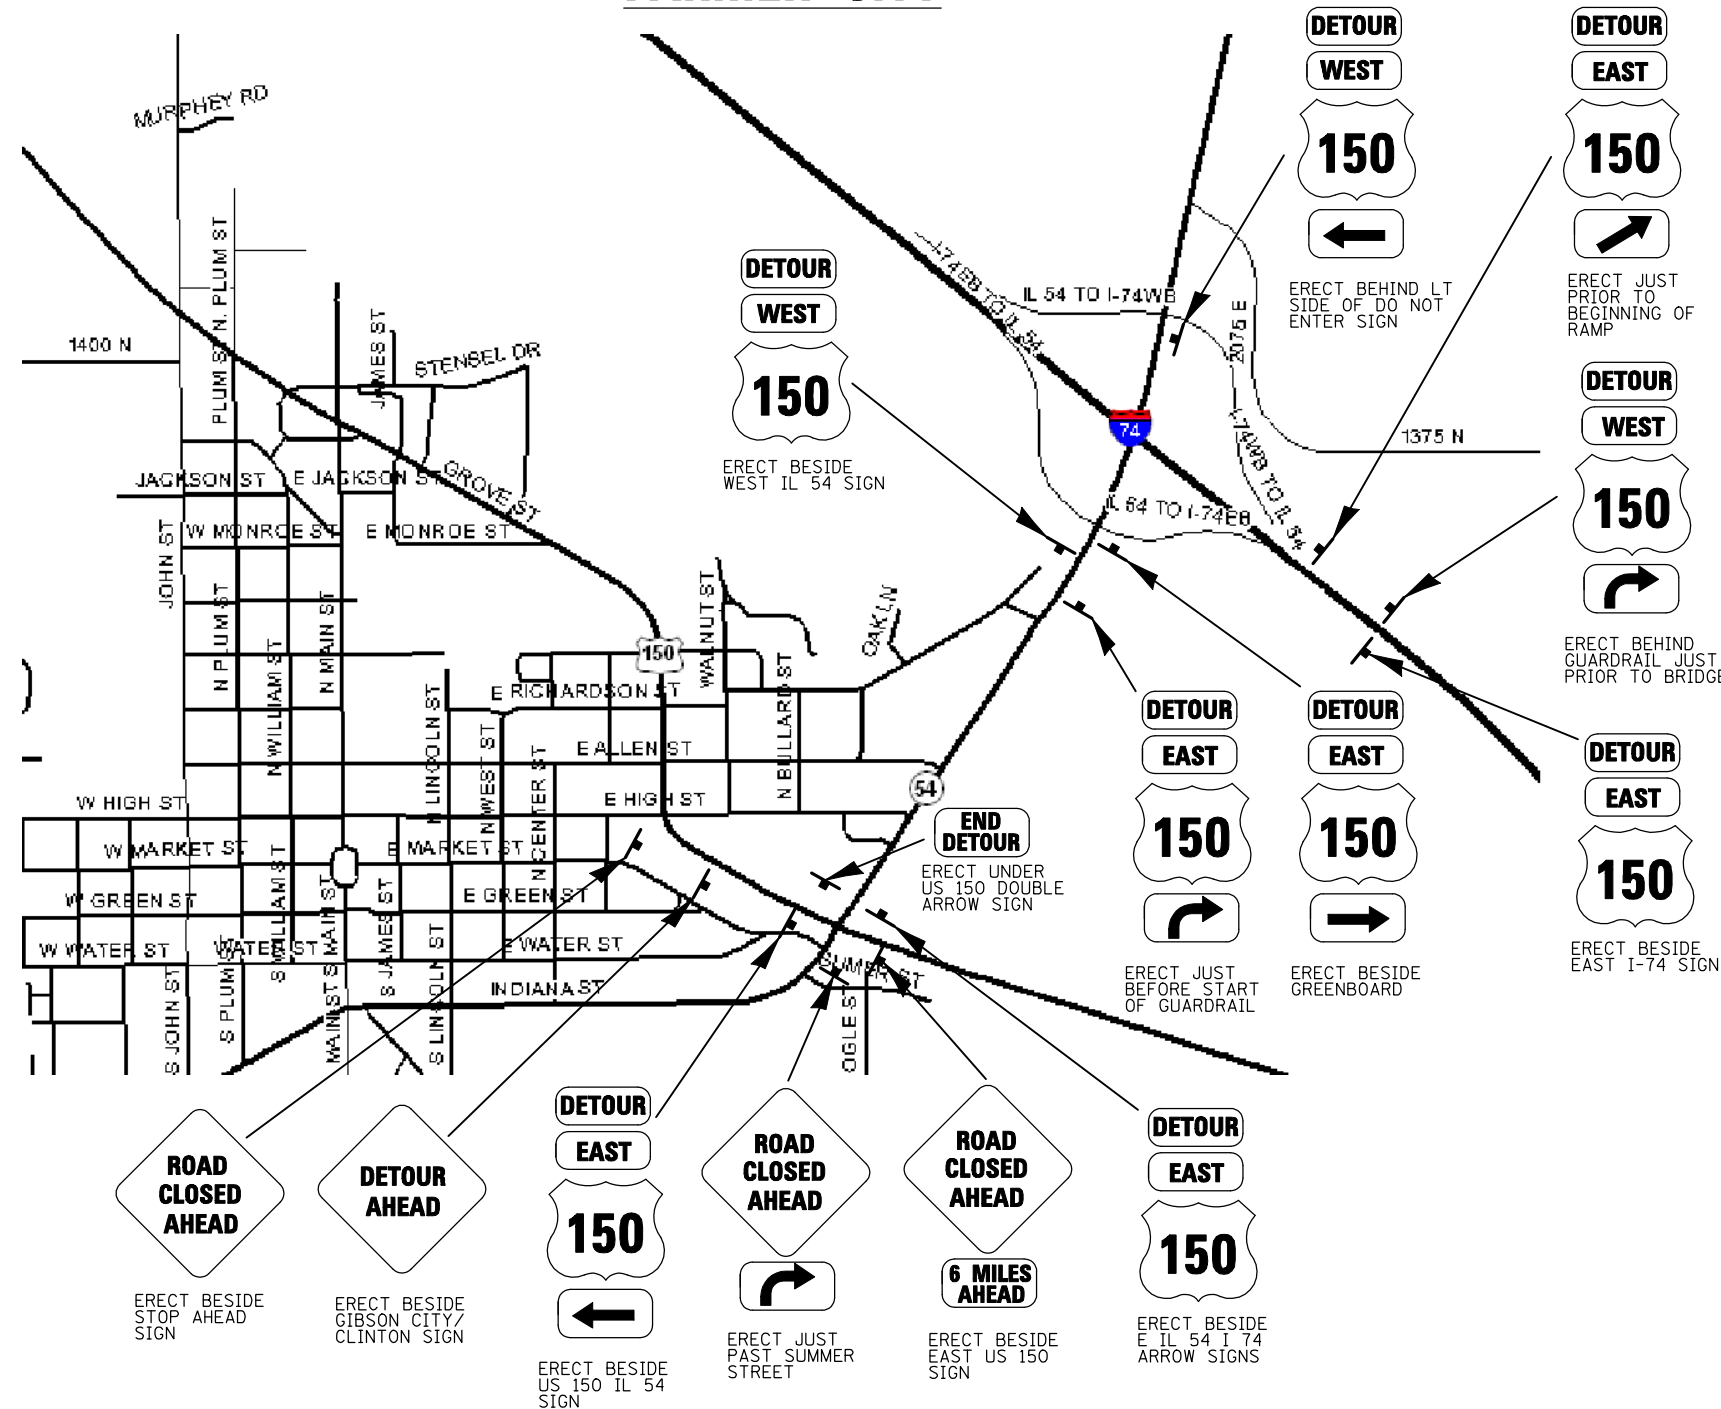

N900E RD 3 MI. EAST OF FARMER CITY

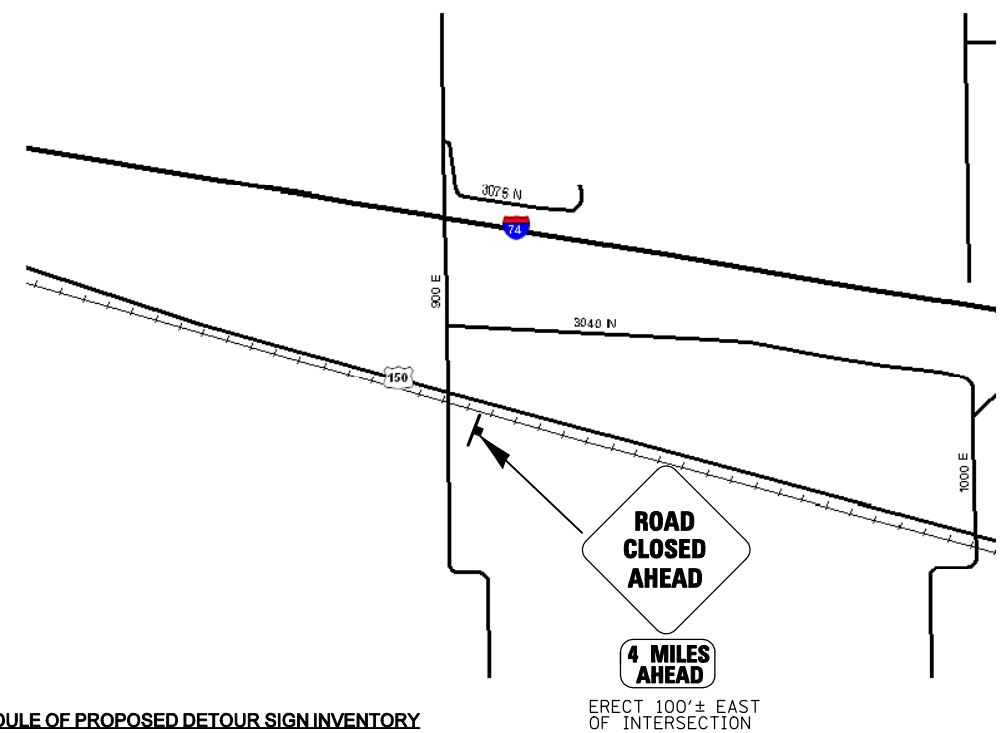

SCHEDULE OF PROPOSED DETOUR SIGN INVENTORY

NUMBER OF SIGNS EACH		NUMBER OF SIGNS EACH	
SIGN TYPE		SIGN TYPE	
	7		2
	2		3
	18		3
	9		5
	9		2
	2		1
	18		1

TOTAL SIGNS = 65

TOTAL SIGNS = 17

SCHEDULE OF PROPOSED DETOUR SIGN INVENTORY IS FOR INFORMATION ONLY. NUMBER AND LOCATION OF SIGNS MAY VARY DUE TO FIELD CONFLICTS. ANY CHANGES SHALL BE CONSIDERED INCLUDED IN THE PAY ITEM FOR DETOUR SIGNING.


FILE NAME =	USER NAME = shererjm	DESIGNED - JMS	REVISED -
et:\pw\work\PWIDOT\SHERRERJM\dms86674\0570388-shr-DetourPlan.dgn		DRAWN - JMS	REVISED -
		CHECKED - JMS	REVISED -
		DATE - 061109	REVISED -

**STATE OF ILLINOIS
DEPARTMENT OF TRANSPORTATION**

DETOUR PLAN

SCALE: SHEET NO. 1 OF 2 SHEETS STA. TO STA.

F.A.S. RTE.	SECTION	COUNTY	TOTAL SHEETS	SHEET NO.
1517	12VBR-1	PIATT	168	40
CONTRACT NO. 70388				
ILLINOIS FED. AID PROJECT				

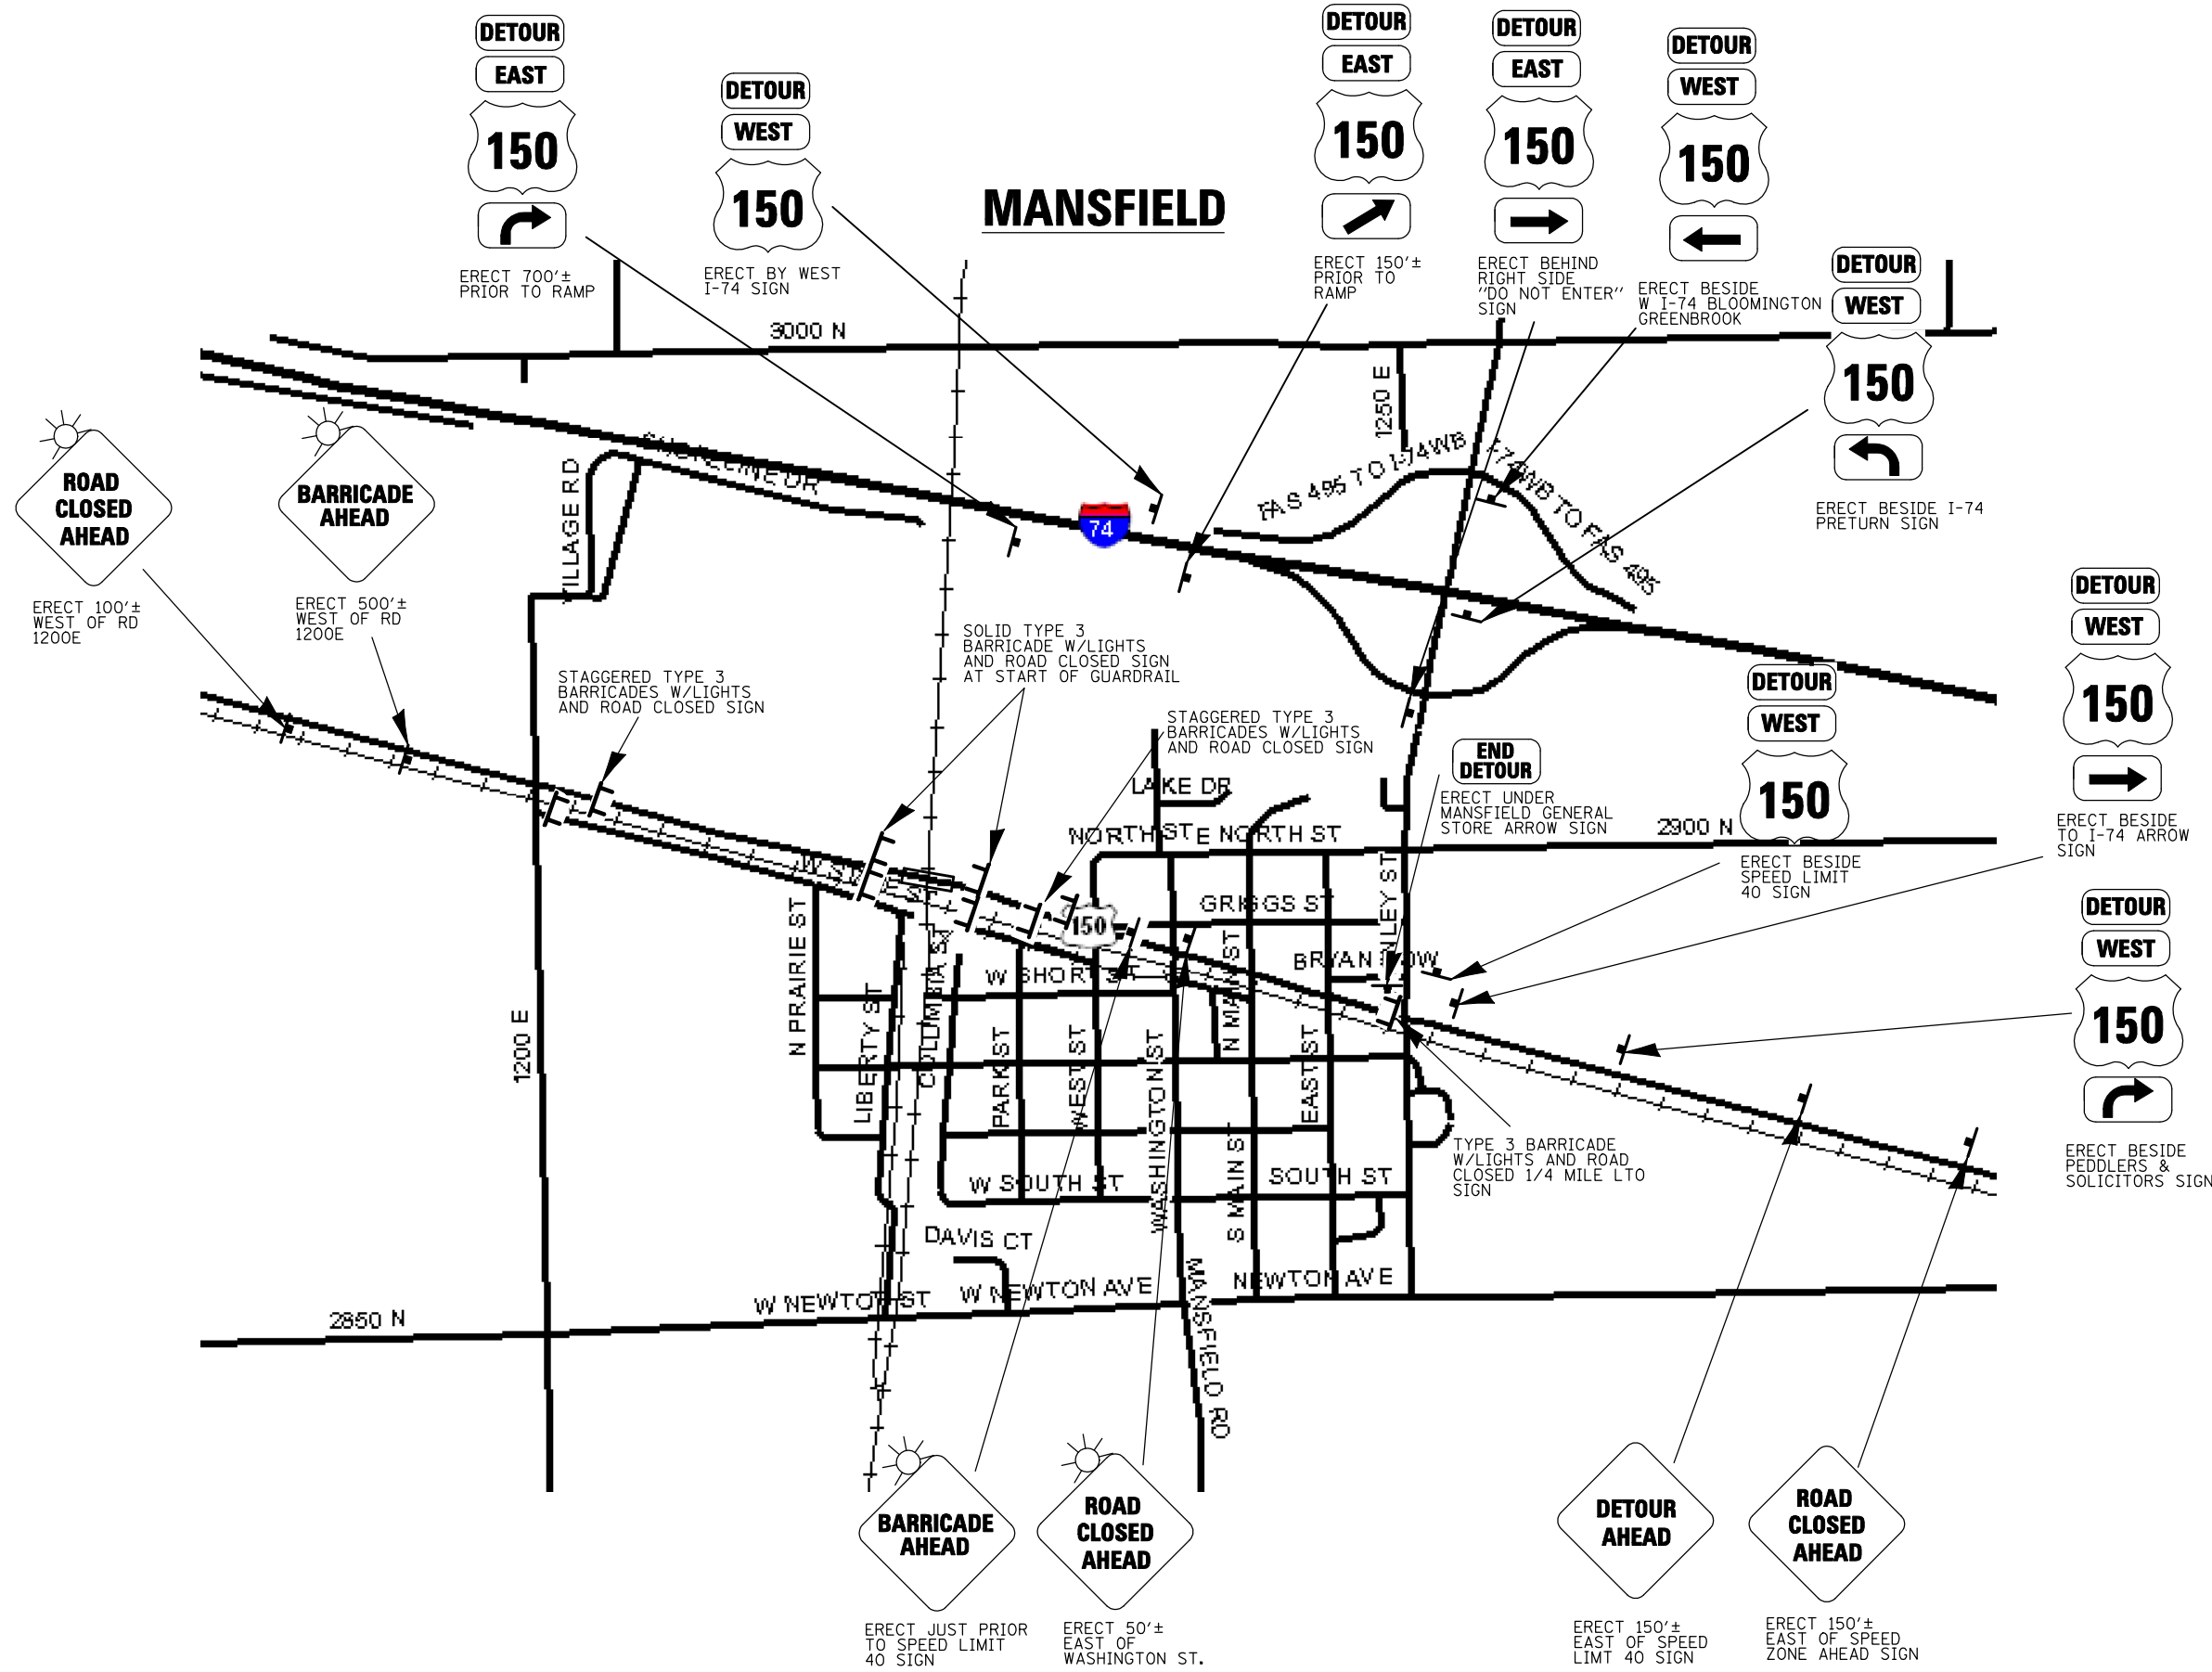

FILE NAME =	USER NAME = shererjm	DESIGNED - JMS	REVISED -
ct:\pw\work\PIWIDOT\SHERRJ\ms86674\0570388-sht-DetourPlan.dgn		DRAWN - JMS	REVISED -
	PLOT SCALE = 100.0000' / IN.	CHECKED - JMS	REVISED -
	PLOT DATE = 10/13/2009	DATE - 061109	REVISED -

**STATE OF ILLINOIS
DEPARTMENT OF TRANSPORTATION**

DETOUR PLAN	
SCALE:	STATION TO STATION
SHEET NO. 2 OF 2 SHEETS	STA. TO STA.


F.A.S. RTE.	SECTION	COUNTY	TOTAL SHEETS	SHEET NO.
1517	12VBR-1	PIATT	168	41
CONTRACT NO. 70388				
ILLINOIS FED. AID PROJECT				

Existing Structure Built as S.B.I. RT. 39 of Sta. 289+23, Sec. 12 V.
 12/13/83 Existing R.C.C. to be removed and replaced with

traffic over the structure at all times, protected with traffic
 signals. No Solvite.
 BM - USC&GS 4'x6.5" Top Conc. Base, between two southern legs
 Pier No. 3 Elev. 723.53E

STATE OF ILLINOIS
 DEPARTMENT OF TRANSPORTATION

DATE	BY	REVISION	TOTAL SHEETS	SHEET NO.
12/13/83	PIATT		12	6
7 SHEETS				

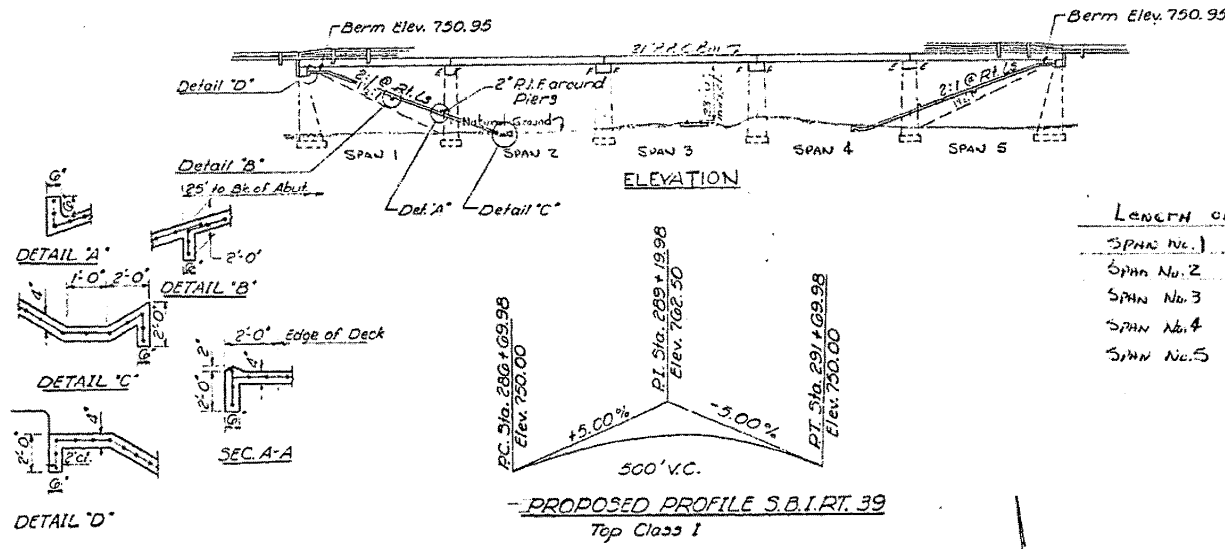

LENGTH OF PRECAST BEAMS

SPAN No. 1	43'-0 3/4"
SPAN No. 2	43'-3 5/8"
SPAN No. 3	44'-11 3/4"
SPAN No. 4	43'-2 3/4"
SPAN No. 5	43'-1 3/8"


GENERAL NOTES
 All reinforcement bars shall be lapped 2d diameters unless otherwise shown.
 It shall be the responsibility of the Contractor to verify all dimensions and conditions existing in the field prior to construction and ordering of materials.
 An alternate strand pattern using Extra High Strength Prestressing strand (EHS) is permitted.
 Expansion bolts shall consist of self-drilling expansion anchors and 3/8" hooked bolts. Hooked bolts shall extend a minimum of 12" into new concrete unless otherwise shown.
 Protective Coat shall not be applied to surfaces to which Waterproofing Membrane System is applied.
 All Structural Steel shall be shop painted with two coats of basic lead-silico chromate paint.
 Expansion guards shall be fabricated in accordance with Article 503.07(C) of the Std. Specs. and are included in quantity of structural steel.

TOTAL BILL OF MATERIAL

Item	Unit	Super.	Sub.	Total
* Bituminous Concrete Surface Crst., Class I	Tons	140		140
Concrete Removal	Cu. Yds.		22	22
Expansion Bolts (3/8")	Each		144	144
Class X Concrete	Cu. Yds.	17.4	5389.52.8	75.2
Precast Prestressed Conc. Dk. Beams (21")	Sq. Ft.	7153		7153
Steel Railings, Type T	Lin. Ft.	437		437
Reinforcement Bars	Lbs.	1000	7350	8350
Pavement Rem. & R.C.C. Replacement, T2(10')	Sq. Yds.			8
Removal of Existing Superstructures	Each			1
Waterproofing Membrane System	Sq. Yds.	781		781
Name Plates	Each			1
Preformed Joint Sealer (2 1/2")	Lin. Ft.	66		66
Temporary Guard Rail	Lin. Ft.	219		219
Protective Coat	Sq. Yds.	73		73
Slope Wall (4')	Sq. Yds.	550		550
Structural Steel	Lbs.	4650		4650

As Built

140
 21.51
 144
 77.39
 7188
 8350
 11.95
 1
 781.84
 1
 66
 219
 687.50
 4650

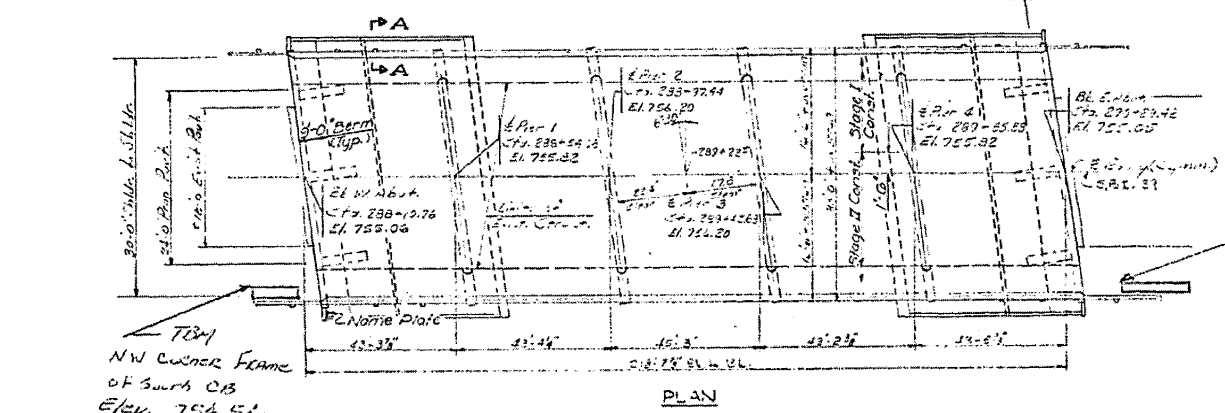

TBM NW CORNER FRAME
 OF C13
 Elev. 754.45

STATION 289+23
 REBUILT 197 BY
 STATE OF ILLINOIS
 S.B.I. RT. 39 SEC. 12 V.
 LOADING HS20

NAME PLATE
 See Std. 213


PRECAST PRESTRESSED UNITS
 Fc = 5000 psi
 Fti = 4000 psi
 Fc = 23000 psi (Strands)
 Fti = 173,600 psi (Strands)

FIELD UNITS
 Fc = 1400 psi
 Fc = 20,000 psi Reinf.
 n = 10


LOADING HS 20-44
 Allow 25% Split for future WS.
 Design Specifications AASHTO 1963 as applicable

DESIGNED: Aug W. Banta
 CHECKED: James L. Jones
 DRAWN: JMS
 CHECKED: JP

EXAMINED: [Signature]
 PASSED: [Signature]
 APPROVED: [Signature]
 DIRECTOR OF HIGHWAYS

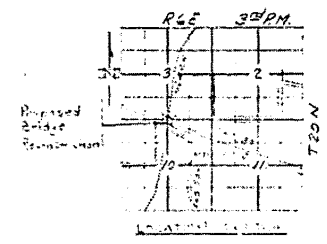


GENERAL PLAN & ELEVATION
 S.B.I. RT. 39 OVER N.G.H.R.
 S.B.I. RT. 39 SEC. 12 V.
 PIATT COUNTY
 STA. 289+23

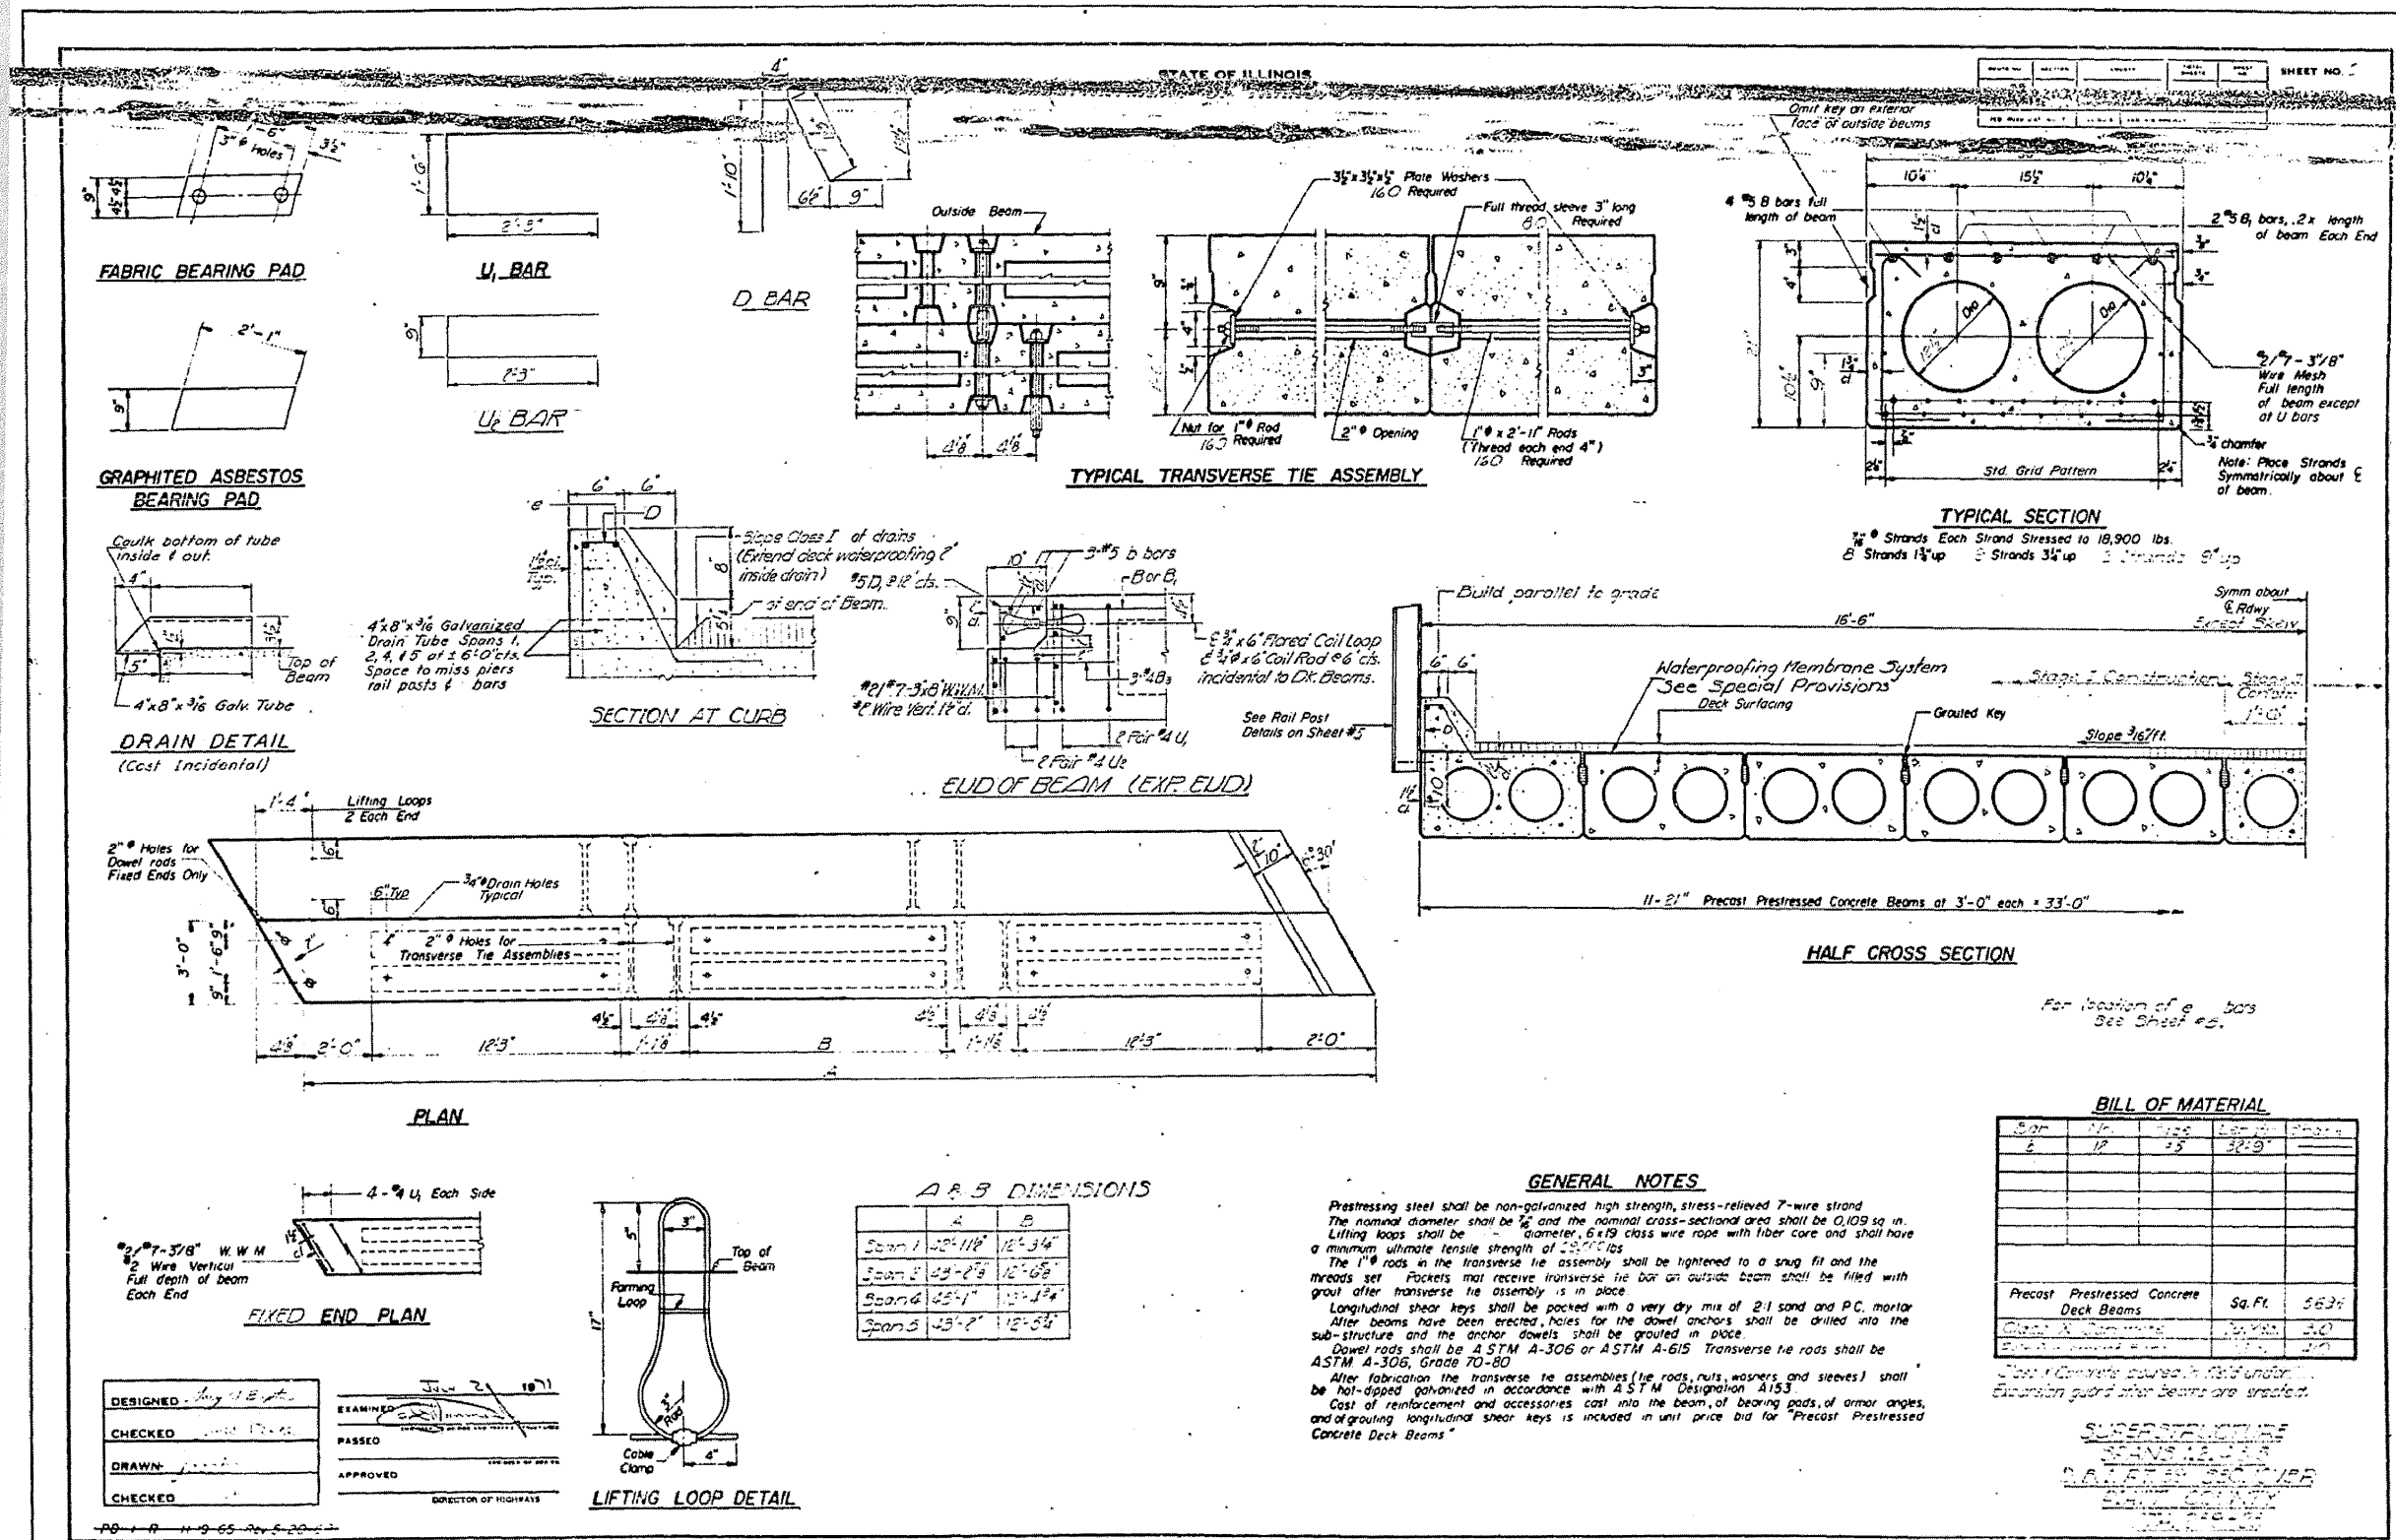


STATE OF ILLINOIS

PROJECT NO.	SECTION	COUNTY	TOTAL SHEETS	SHEET NO.
1517	12VBR-1	PIATT	168	43


FABRIC BEARING PAD

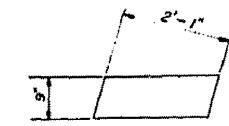


GRAPHITED ASBESTOS BEARING PAD

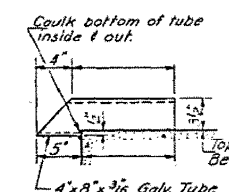

DRAIN DETAIL (Cost incidental)

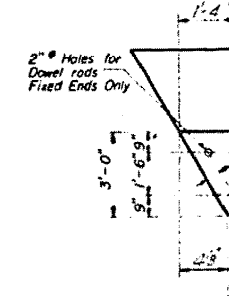


PLAN

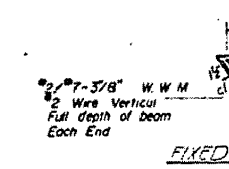


DESIGNED	EXAMINED
CHECKED	PASSED
DRAWN	APPROVED
CHECKED	


U₁ BAR

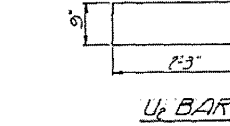


U₂ BAR

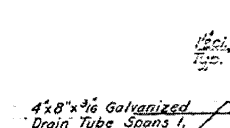

SECTION AT CURB

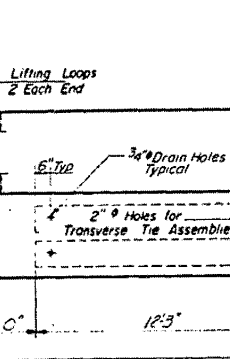


END OF BEAM (EXP. END)

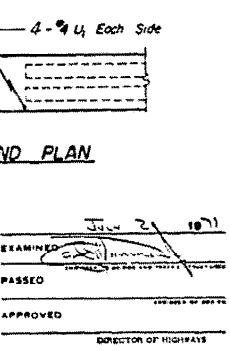


D BAR




TYPICAL TRANSVERSE TIE ASSEMBLY

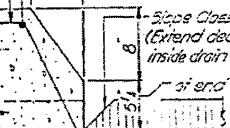

TYPICAL SECTION

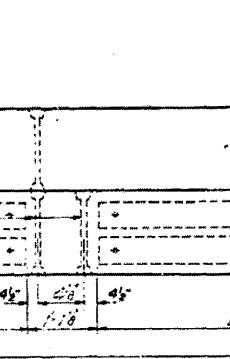


HALF CROSS SECTION

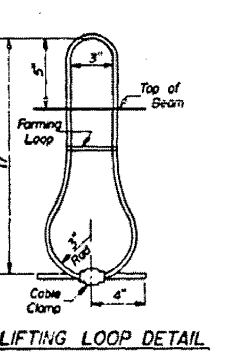

A & B DIMENSIONS

	A	B
Span 1	22'-11 1/2"	12'-3 1/4"
Span 2	23'-2 3/8"	12'-6 3/8"
Span 4	25'-1"	12'-2 3/4"
Span 5	23'-2"	12'-5 3/4"

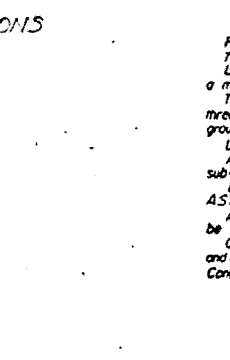

GENERAL NOTES

Prestressing steel shall be non-galvanized high strength, stress-relieved 7-wire strand. The nominal diameter shall be 1/2" and the nominal cross-sectional area shall be 0.109 sq. in. Lifting loops shall be 1/2" diameter, 6 x 19 class wire rope with fiber core and shall have a minimum ultimate tensile strength of 22,000 lbs.

The 1/4" rods in the transverse tie assembly shall be lightened to a snug fit and the threads set. Pockets that receive transverse tie bar on outside beam shall be filled with grout after transverse tie assembly is in place.

Longitudinal shear keys shall be packed with a very dry mix of 2:1 sand and P.C. mortar. After beams have been erected, holes for the dowel anchors shall be drilled into the sub-structure and the anchor dowels shall be grouted in place.

Dowel rods shall be ASTM A-306 or ASTM A-615. Transverse tie rods shall be ASTM A-306, Grade 70-80.

After fabrication the transverse tie assemblies (tie rods, nuts, washers and sleeves) shall be hot-dipped galvanized in accordance with ASTM Designation A153.

Cast of reinforcement and accessories cast into the beam, of bearing pads, of armor angles, and of grouting longitudinal shear keys is included in unit price bid for "Precast Prestressed Concrete Deck Beams".




BILL OF MATERIAL

Item	Qty	Unit	Ext. Qty	Ext. Price
Bar	12	25	32.9	
Precast Prestressed Concrete Deck Beams		Sq. Ft.	563 1/2	
Grout & Sanding		Cu. Yds.	3.0	
Expansion Guard		Linear Ft.	2.0	

SUPERSTRADE
 SPANS 12, 13, 4, 5
 D. A. F. B. S. CO. INC.
 1000 S. W. 10th St.
 Miami, Florida 33135





STATE OF ILLINOIS
DEPARTMENT OF TRANSPORTATION

PROJECT NO.	12VBR	PIATT	12	8	SHEET NO.	7	SHEETS
-------------	-------	-------	----	---	-----------	---	--------

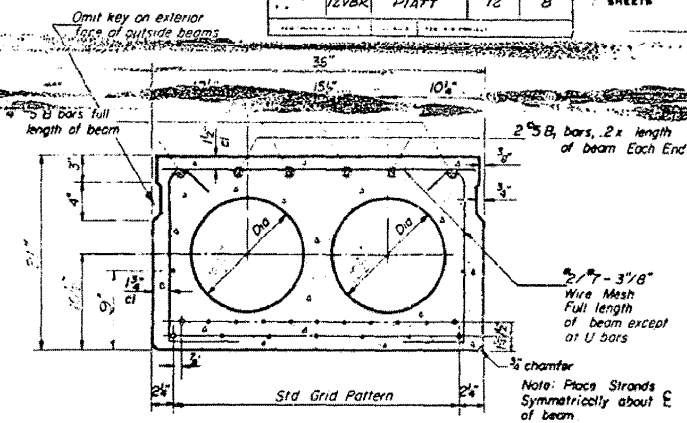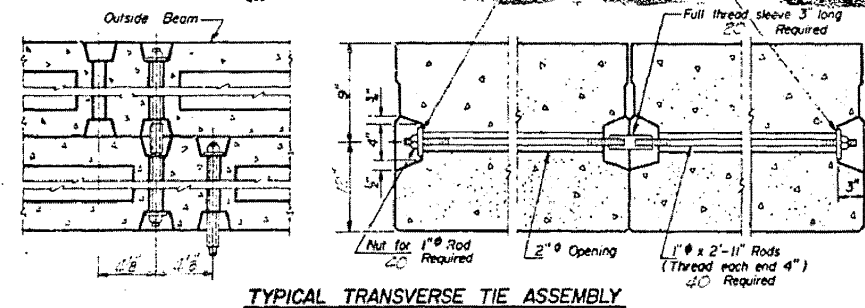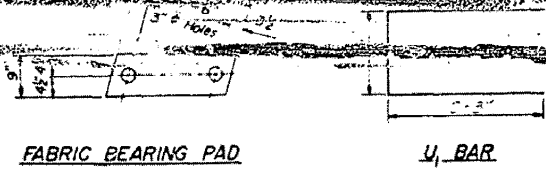

For details of Bar D see Sheet #3.

7/8" Strands Each Strand Stressed to 18,900 lbs.
7" Strands 1 1/4" up 1" Strands 3/4" up 2" Strands 9" up

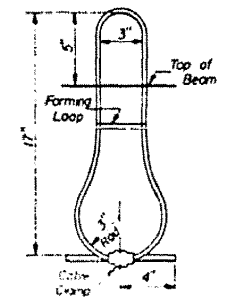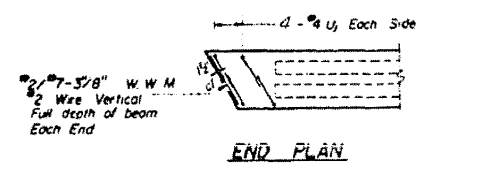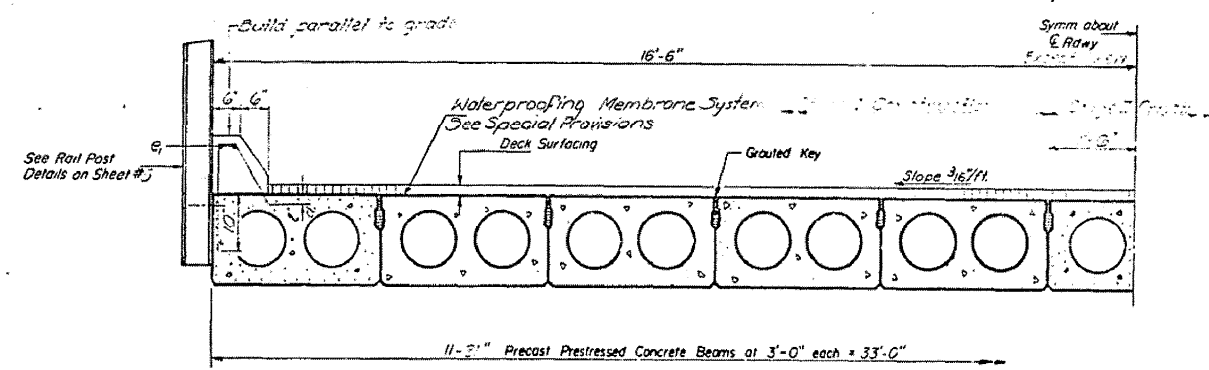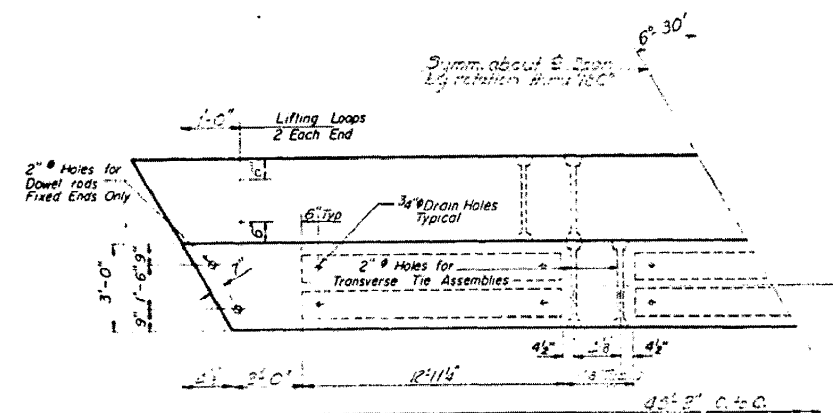

DESIGNED	EXAMINED
CHECKED	PASSED
DRAWN	APPROVED
CHECKED	DIRECTOR OF HIGHWAYS

July 2 1971

GENERAL NOTES

Prestressing steel shall be non-galvanized high strength, stress-relieved 7-wire strand. The nominal diameter shall be 7/8" and the nominal cross-sectional area shall be 0.109 sq in. Lifting loops shall be 1/2" diameter, 6 x 19 class wire rope with fiber core and shall have a minimum ultimate tensile strength of 22,000 lbs.

The 1" rods in the transverse tie assembly shall be tightened to a snug fit and the threads set. Points that receive transverse tie bar on outside beam shall be filled with grout after transverse tie assembly is in place.

Longitudinal shear keys shall be packed with a very dry mix of 2-1 sand and P.C. mortar. After beams have been erected, holes for the dowel anchors shall be drilled into the sub-structure and the anchor dowels shall be grouted in place.

Dowel rods shall be ASTM A-306 or ASTM A-615. Transverse tie rods shall be ASTM A-306, Grade 70-80.

After fabrication the transverse tie assemblies (tie rods, nuts, washers and sleeves) shall be hot-dipped galvanized in accordance with ASTM Designation A153.

Cost of reinforcement and accessories cast into the beam, of bearing pads, of armor angles, and of grouting longitudinal shear keys is included in unit price bid for "Precast Prestressed Concrete Deck Beams".

BILL OF MATERIAL

Item	Quantity	Unit	Notes
Precast Prestressed Concrete Deck Beams		Sq. Ft.	

FILE NAME =	USER NAME = shererjm	DESIGNED - JMS	REVISED -
ca:\pwk\work\PIWIDOT\SHERERJM\dms86674\0570388-sht-esbu1ts.dgn		DRAWN - JMS	REVISED -
		CHECKED - JMS	REVISED -
		DATE - 090309	REVISED -

STATE OF ILLINOIS
DEPARTMENT OF TRANSPORTATION


**AS-BUILT PLANS SN 074-0009
INFORMATION ONLY**

SCALE:	SHEET NO.	OF SHEETS	STA.	TO STA.
--------	-----------	-----------	------	---------


F.A.S. RTE.	SECTION	COUNTY	TOTAL SHEETS	SHEET NO.
1517	12VBR-1	PIATT	168	44
CONTRACT NO. 70388				
ILLINOIS FED. AID PROJECT				

STATE OF ILLINOIS
DEPARTMENT OF TRANSPORTATION


ROUTE NO.	SECTION	COUNTY	TOTAL SHEETS	SHEET NO.	SHEET NO.
39	12VBR	PIATT	12	9	7 SHEETS
FILE NAME	DATE	PROJECT			

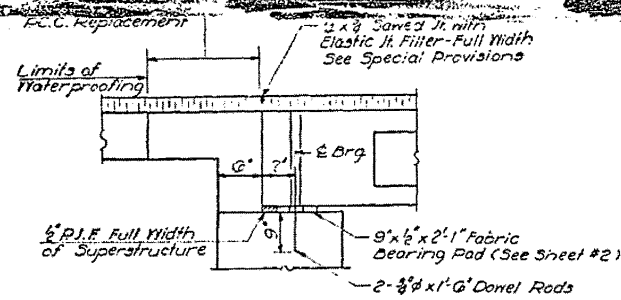

SECTION THRU ABUT.

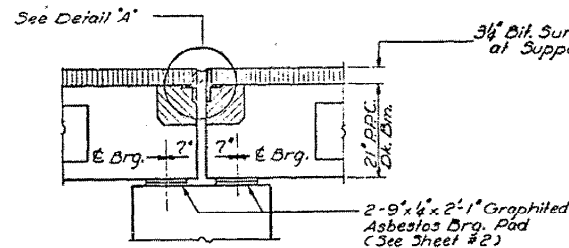


SECTION THRU PIERS 1 & 4

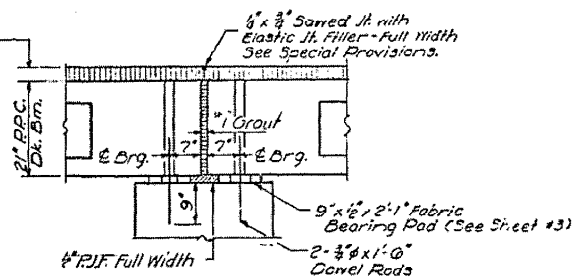


SECTION THRU PIERS 2 & 3

* 1" Joint shall be packed with a very dry mix of 6:1 sand and P.C. mortar. This dimension may vary plus or minus to accommodate tolerance in beam lengths.

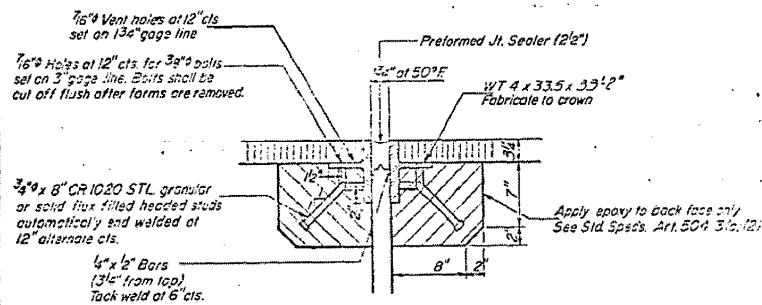


DETAIL "A"


NOTE: Dimensions are at right angles.
Hatched areas to be poured after beams have been erected and joints grouted.
Ends of beams shall be aligned at the expansion joints. Any linear variation in the beam lengths shall be placed at the fixed joint. See End of Beam Detail for reinforcement.

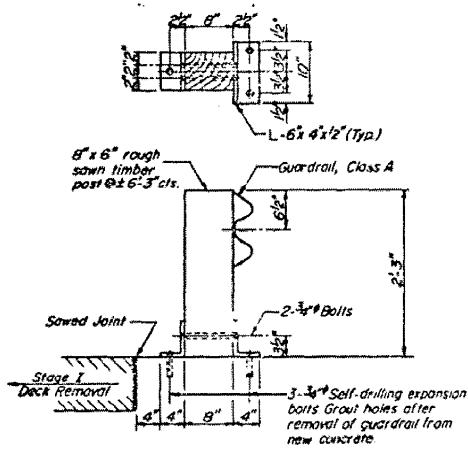

TEMPORARY GUARDRAIL DETAIL
See Special Provisions

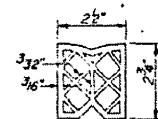

PREFORMED JOINT SEALER (2'x2')

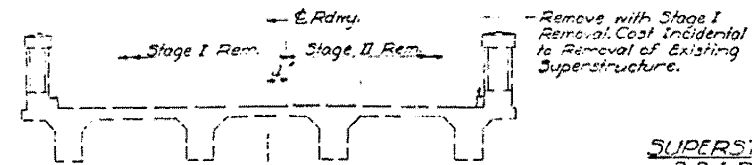

EXISTING CROSS SECTION

SUPERSTRUCTURE DETAILS
S.B.I.R.T. 39 30C. 12VBR
PIATT COUNTY
STA. 269+23

DESIGNED	EXAMINED
CHECKED	PASSED
DRAWN	APPROVED
CHECKED	DIRECTOR OF HIGHWAYS

FILE NAME =	USER NAME = shererjm	DESIGNED - JMS	REVISED -
et\pw\work\PIWIDOT\SHERERJM\dms86674\0570388-sht-esbu1ts.dgn		DRAWN - JMS	REVISED -
		CHECKED - JMS	REVISED -
		DATE - 090309	REVISED -

STATE OF ILLINOIS
DEPARTMENT OF TRANSPORTATION


AS-BUILT PLANS SN 074-0009
INFORMATION ONLY

SCALE:	SHEET NO.	OF SHEETS	STA.	TO STA.
--------	-----------	-----------	------	---------


F.A.S. RTE.	SECTION	COUNTY	TOTAL SHEETS	SHEET NO.
1517	12VBR-1	PIATT	168	45
CONTRACT NO. 70388				
ILLINOIS FED. AID PROJECT				

STATE OF ILLINOIS
DEPARTMENT OF TRANSPORTATION

DESIGNED	SECTION	COUNTY	TOTAL SHEETS	SHEET NO.
JMS	12VBR	PIATT	12	10
				7 SHEETS

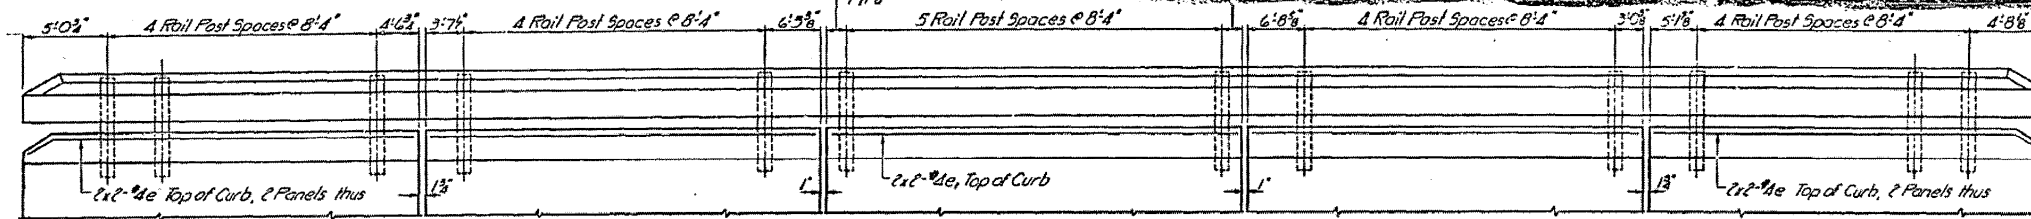


ELEVATION
All dimensions along inside face of rail

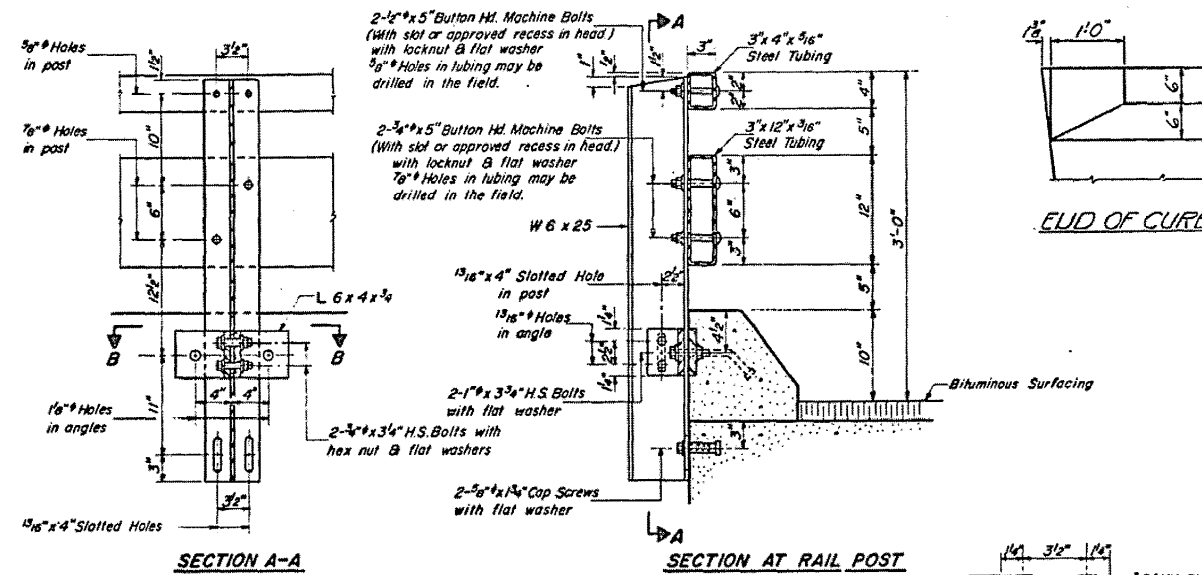


SECTION A-A


SECTION AT RAIL POST

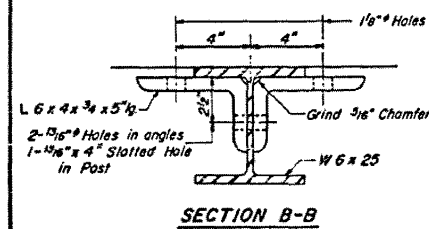


SECTION B-B

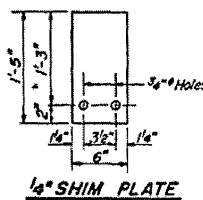


1/2" SHIM PLATE

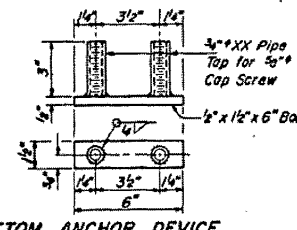


BOTTOM ANCHOR DEVICE

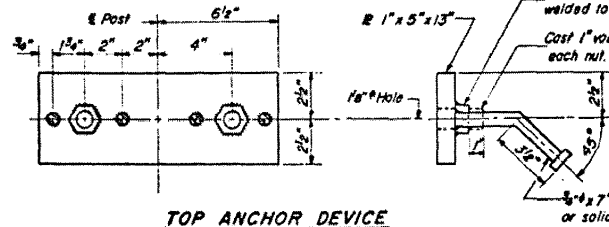


TOP ANCHOR DEVICE

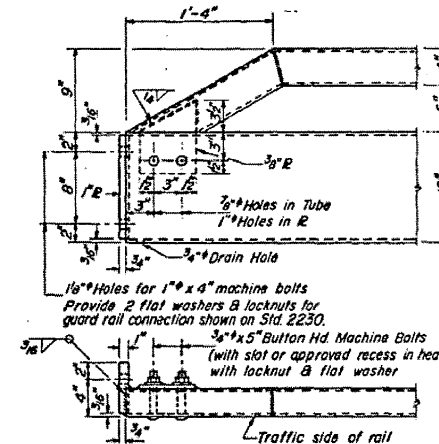


END OF RAIL DETAILS

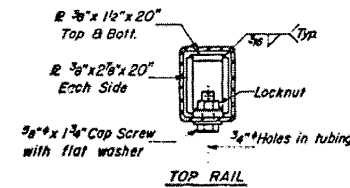

TOP RAIL

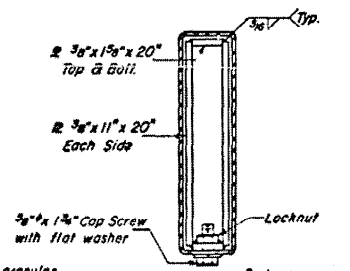

BOTTOM RAIL
SECTIONS AT RAIL SPLICE

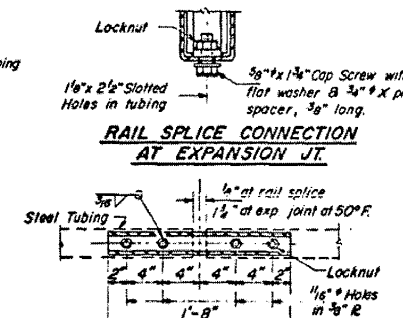

RAIL SPLICE CONNECTION
AT EXPANSION JT.

PLAN-BOTT. SPLICE R
TYPICAL

NOTES

- Hollow structural steel tubing shall conform to the requirements of ASTM designation A-500 Grade B or A-501 Structural Steel Tubing.
- All other steel shapes and plates shall conform to the requirements of ASTM designation A-36 except posts shall conform to ASTM A-441.
- Bolts, cap screws, and nuts shall conform to the requirement of ASTM designation A-307 except for high strength bolts, nuts and washers noted which shall conform to ASTM designation A-325.
- All bolts, nuts, cap screws, washers and lock washers shall be galvanized in accordance with ASTM designation A-153.
- All posts, railing, rail splices, anchor devices and angles shall be galvanized after shop fabrication in accordance with ASTM designation A-123 and A-385. Galvanized rail shall not be painted.
- Railing shall be in accordance with Section 50B of the Standard Specifications, except as noted, and shall be paid for at the contract unit price per linear foot for STEEL RAILING, TYPE T.
- All field drilled holes shall be coated with an approved zinc rich paint before erection.
- The lower portion of the post flange in contact with concrete shall receive two coats of asphalt paint conforming to Section 714.09 Type B or place 1/2" fabric bearing pad between the post and concrete.
- The 3/8" high strength bolts used to connect the 6 x 4 x 3/8 angles to the post shall be tightened in accordance with Article 50704(g)(3) of the Standard Specifications. The 1" high strength bolts connecting the angles to the concrete shall be tightened to a snug fit and given an additional 1/2 turn.
- For multi-span bridges, sufficient 4" x 6" x 1-5" galvanized steel shims shall be provided to align rail between adjacent spans. Cost incidental to Steel Railing.

CURB & RAIL
BILL OF MATERIAL

Bar	No.	Size	Length	Shape
a	32	#4	22'-0"	
e	8	#4	23'-0"	
Reinforcement Bars	Lbs.	590		
Glass X Concrete	Cu Yds.	14.4		
Steel Railing, Type T	Lin. Ft.	237		

TYPE T
STEEL RAILING
SBI RT.39 SEC.12 VBR
PIATT COUNTY
STA. 289+23

DESIGNED	EXAMINED	10
CHECKED	PASSED	
DRAWN	APPROVED	
CHECKED	DICTIONARY OF HIGHWAY	

R-24 12-10-71 (9'-0" Maximum Post Spacing)

FILE NAME =
c:\pwwork\PIWIDOT\SHERRERJM\dms86674\0570388-sht-esbuils.dgn

USER NAME = sherrerjm
PLOT SCALE = 100.0000' / IN.
PLOT DATE = 10/13/2009

DESIGNED - JMS
DRAWN - JMS
CHECKED - JMS
DATE - 090309

REVISED -
REVISED -
REVISED -
REVISED -

STATE OF ILLINOIS
DEPARTMENT OF TRANSPORTATION


AS-BUILT PLANS SN 074-0009
INFORMATION ONLY

SCALE: SHEET NO. OF SHEETS STA. TO STA.


F.A.S. RTE.	SECTION	COUNTY	TOTAL SHEETS	SHEET NO.
1517	12VBR-1	PIATT	168	46
				CONTRACT NO. 70388
ILLINOIS FED. AID PROJECT				

STATE OF ILLINOIS
DEPARTMENT OF TRANSPORTATION


PROJECT NO.	SECTION	DATE	TOTAL SHEETS	SHEET NO.	SHEET NO.
59	12VBR	PIATT	12	11	7 SHEETS

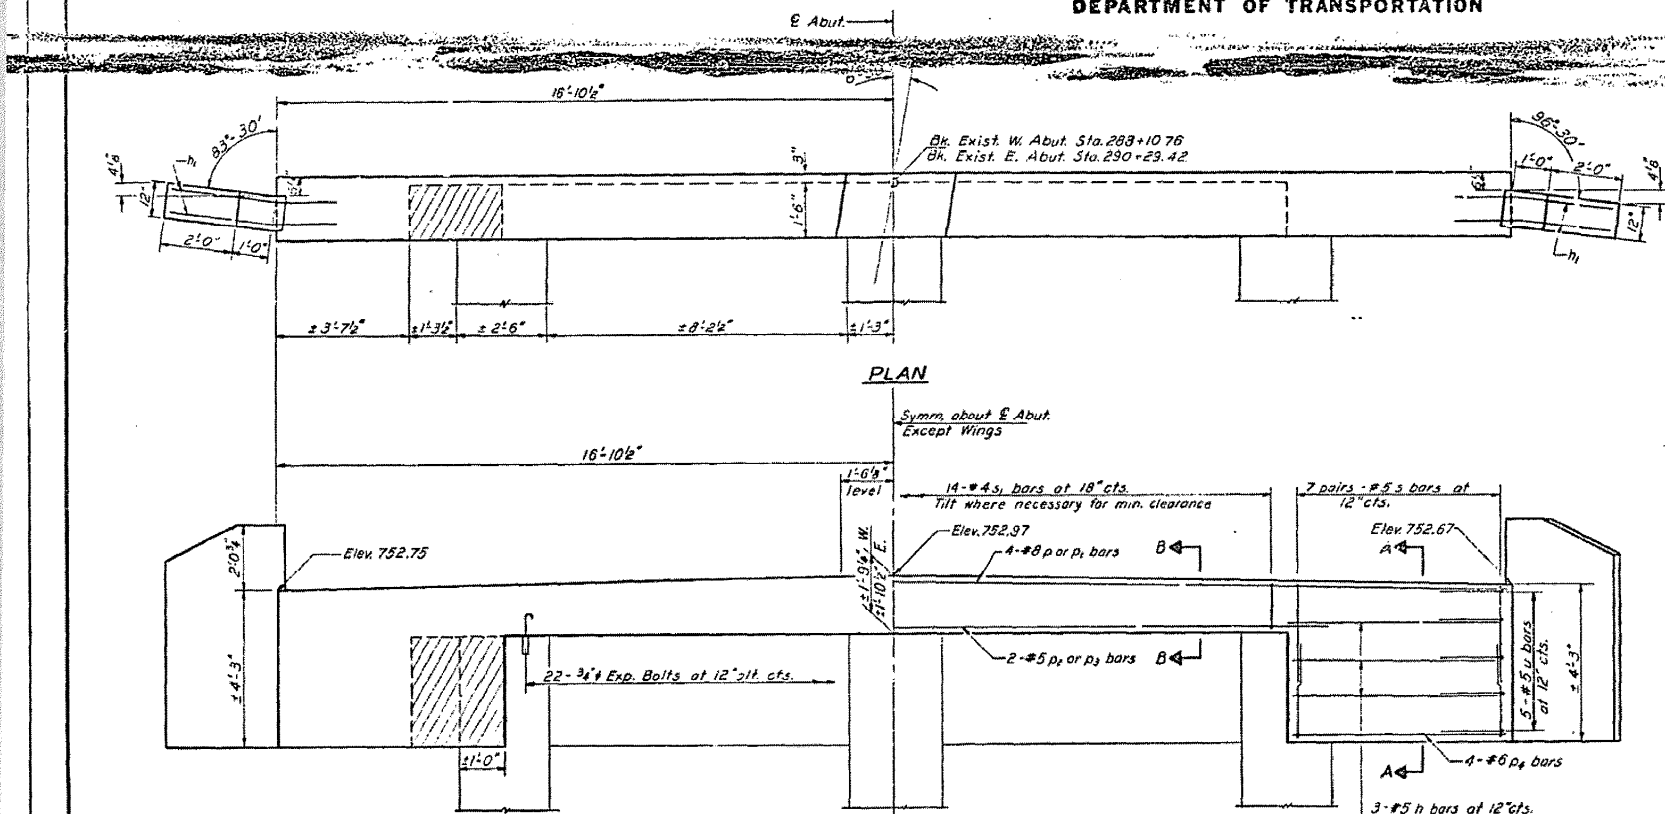

PLAN

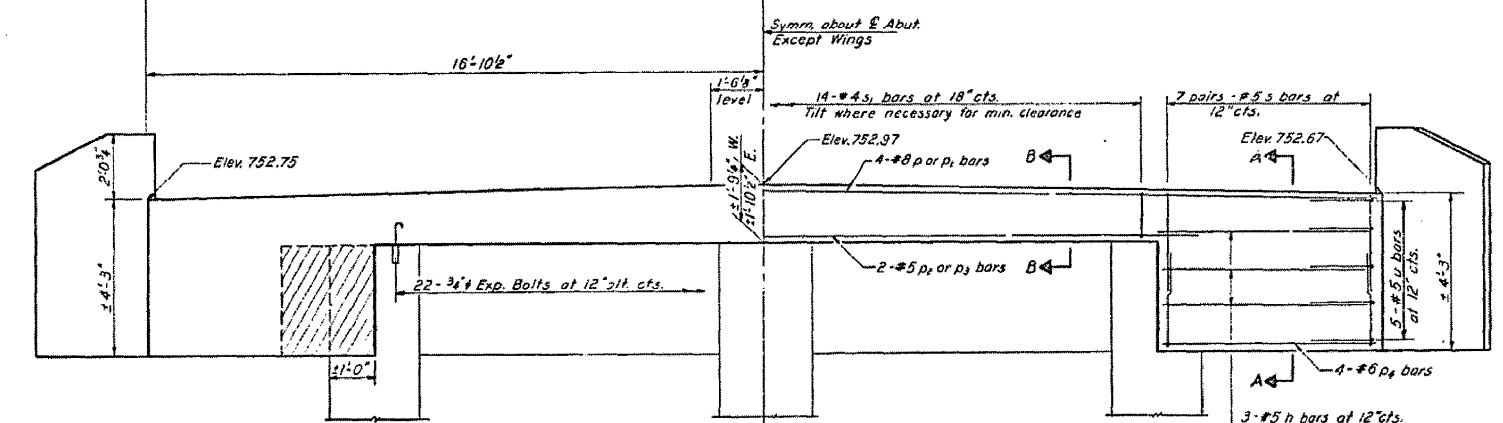


ELEVATION

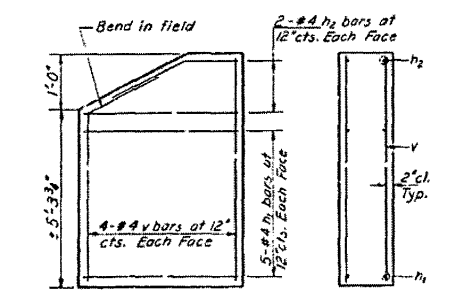


WING WALL DETAIL


Wing Wall shall be poured after Deck Beams are in place

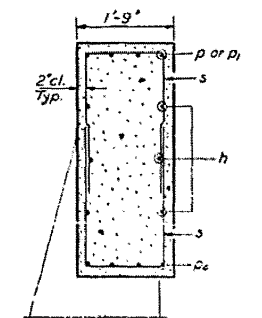


SECTION A-A

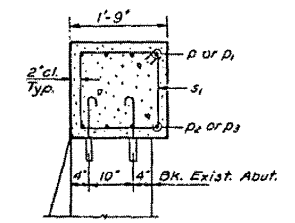


SECTION B-B

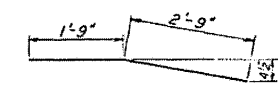


BAR h1

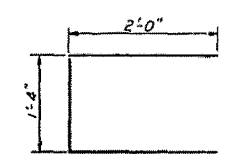

BAR u

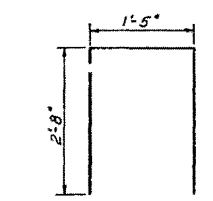

BAR s

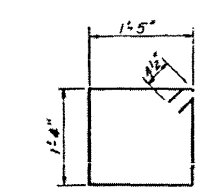

BAR s1

Notes:
Hatched area indicates Concrete Removal. Reinforcement extending into removed area shall be cleaned and incorporated into the new construction.
Expansion bolts shall be anchored in sound concrete.
All edges shall have standard 3/4" chamfers.

TWO ABUTMENTS
BILL OF MATERIAL

Bar	No.	Size	Length	Shape
h	24	#5	5'-9"	—
h1	40	#4	4'-6"	—
h2	16	#4	2'-5"	—
p	8	#8	17'-6"	—
p1	8	#8	18'-3"	—
p2	4	#5	13'-6"	—
p3	4	#5	10'-9"	—
p4	16	#8	5'-9"	—
s	56	#5	6'-3"	□
s1	28	#4	6'-3"	□
u	20	#5	5'-4"	—
v	32	#4	5'-9"	—
Class X Concrete			Cu Yds.	14.5
Reinforcement Bars			Lbs	1027
Expansion Bolts 3/4"			Each	24
Concrete Removal			Cu Yds.	2



ABUTMENTS
S.B.I. RT.39 SEC.12VBR
PIATT COUNTY
STATION 289+23

DESIGNED	JMS	EXAMINED	JMS
CHECKED	R. P. Summer	PASSED	JMS
DRAWN	R. P. Summer	APPROVED	JMS
CHECKED	JP	DIRECTOR OF HIGHWAYS	JMS


STATE OF ILLINOIS
DEPARTMENT OF TRANSPORTATION

Sta. 288+54.08 Pier 1
Sta. 288+97.44 Pier 2
Sta. 289+42.69 Pier 3
Sta. 289+85.88 Pier 4


Hatched area indicates Concrete Removal.
Expansion Bolts shall be anchored in sound concrete.

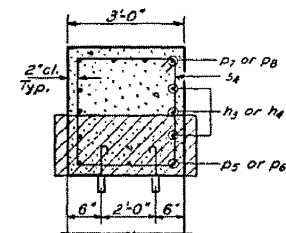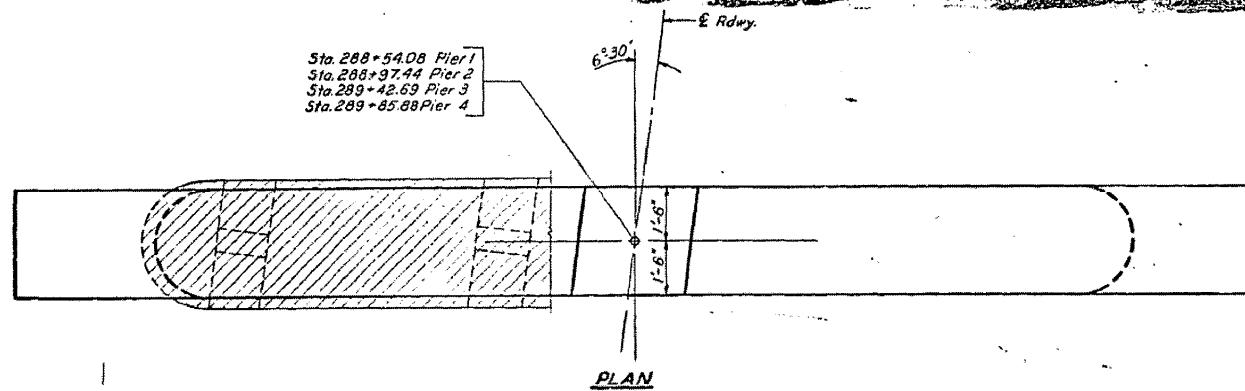

SECTION A-A

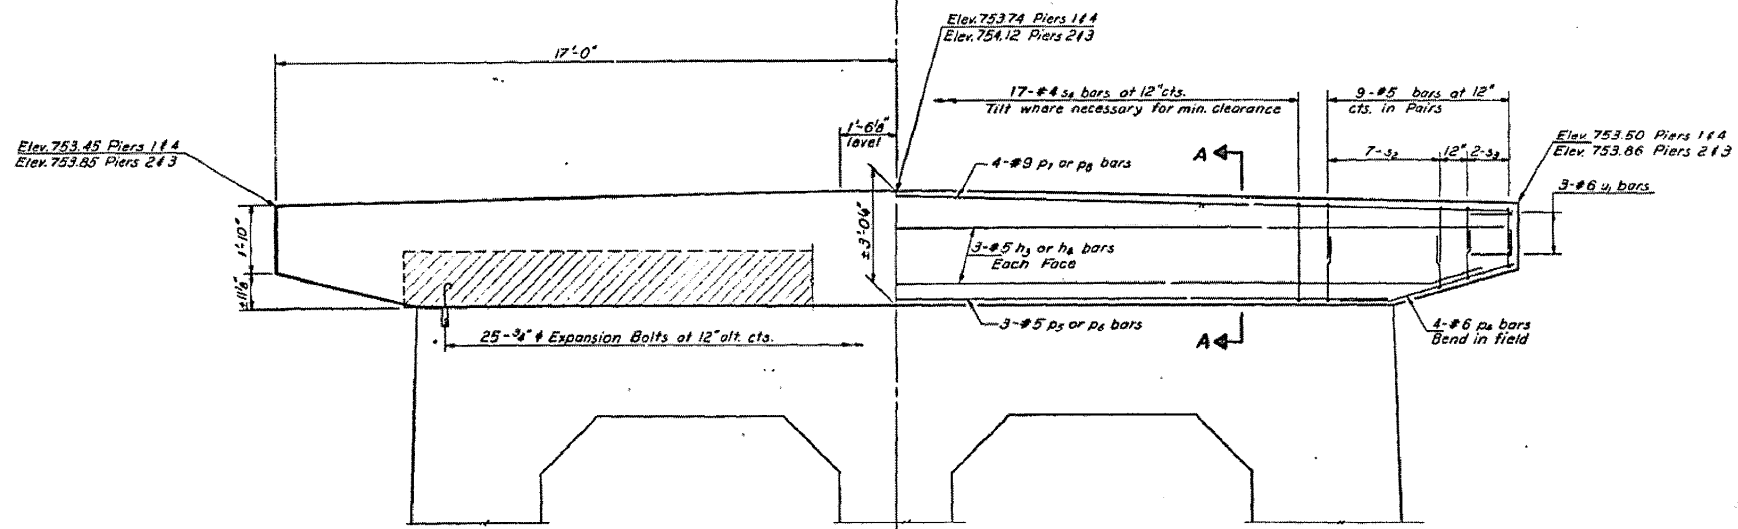

ELEVATION
Looking East Piers 1 & 2
Looking West Piers 3 & 4

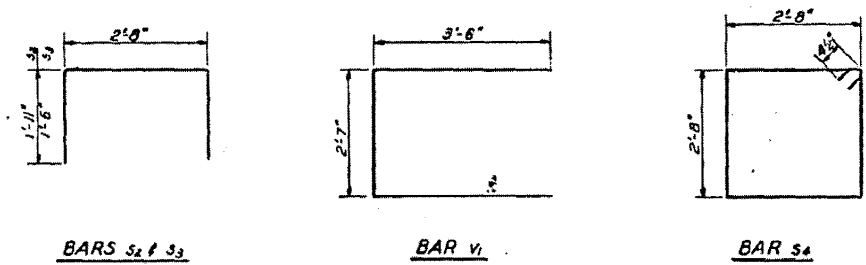

FOUR PIERS
BILL OF MATERIAL

Bar	No.	Size	Length	Shape
s4	17	#4	17'-3"	—
s3	9	#5	18'-3"	—
p1	4	#9	5'-9"	—
p8	4	#9	13'-6"	—
h3	3	#5	14'-6"	—
h4	3	#5	17'-3"	—
p5	3	#5	6'-6"	□
p6	3	#5	5'-8"	□
u	2	#6	9'-7"	□
Class X Concrete			Cu. Yds.	43.3
Reinforcement Bars			Lbs.	5,310
Expansion Bolts #4			Each	100
Concrete Removal			Cu. Yds.	20

PIERS
S.B.I. RT.39 SEC.12VBR
PIATT COUNTY
STATION 289+23

DESIGNED: *Ray W. Burt*
CHECKED: *James Pince*
DRAWN: *R. P. Sumner*
CHECKED: *JP*

EXAMINED: _____
PASSED: _____
APPROVED: _____
DIRECTOR OF HIGHWAYS


B.M. - 5&W in T.P. right Sta. 295+00
Elev. 215.17

No existing structure.

Notes

Pockets as shown in piers 1&2
Pockets in East side of pier 2 only.
Omit pockets in pier 3.

Elev. Piers 1&4 - 244.19
Elev. Piers 2&3 - 244.53
Crown of Finished Roadway - 7

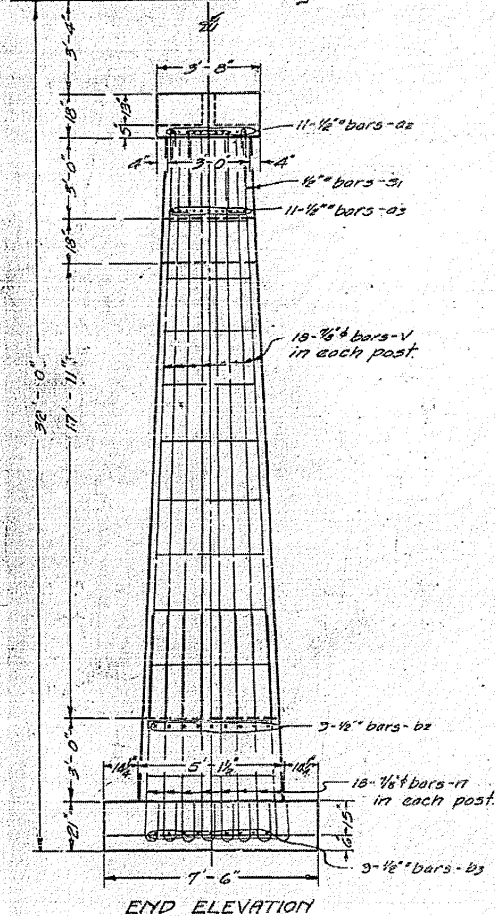

Class A Concrete shall be used throughout.
Proportions - 1:2 1/2:4.





All reinforcing steel shall be wired securely in place before concrete is poured.

STANDARD	COMPUTED	- <i>[Signature]</i>
	CHECKED	- <i>[Signature]</i>
SPECIAL	DRAWN	- <i>[Signature]</i>
	CHECKED	- <i>[Signature]</i>
	ASSEMBLED	-
	CHECKED	-



EXAMINED *[Signature]* 10/28
DESIGNED *[Signature]* 10/28
PASSED *[Signature]*
APPROVED *[Signature]*
CHIEF DESIGN ENGINEER
Revised - Oct. 26, 1928
[Signature]

STATE OF ILLINOIS
DEPARTMENT OF PUBLIC WORKS & BUILDINGS
DIVISION OF HIGHWAYS

PROJECT NO.	SECTION	SHEET NO.	SHEET NO.
39	12V	6	4

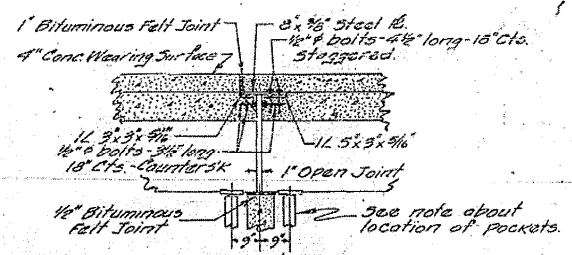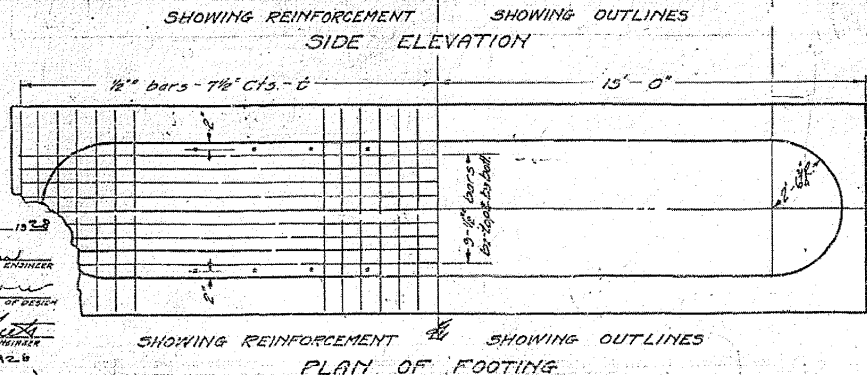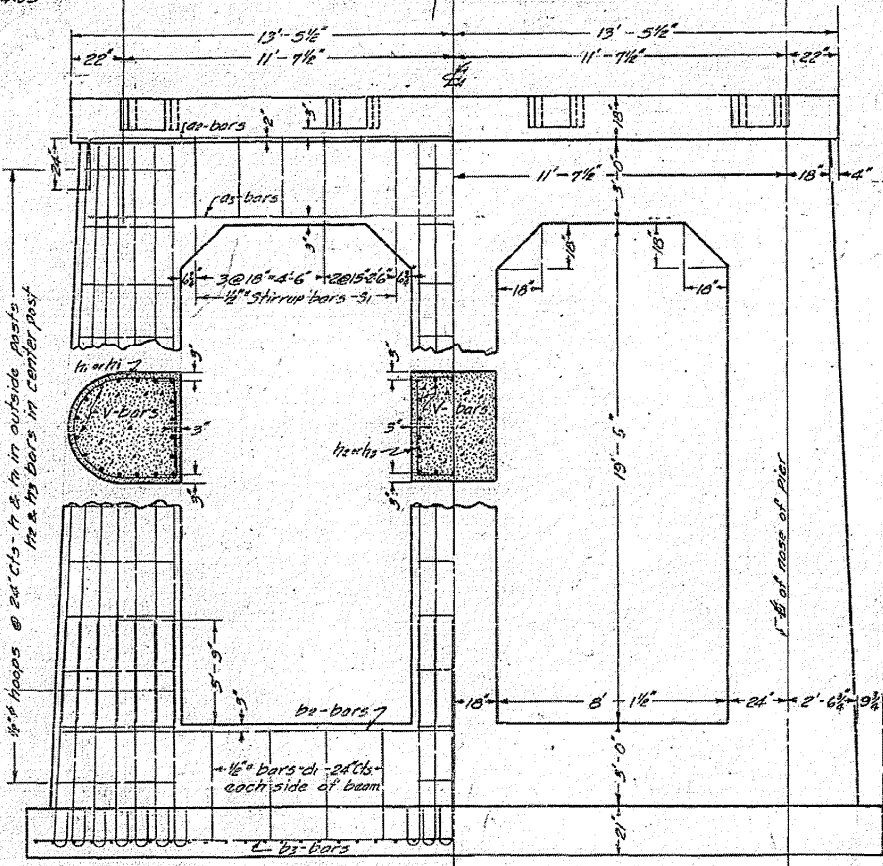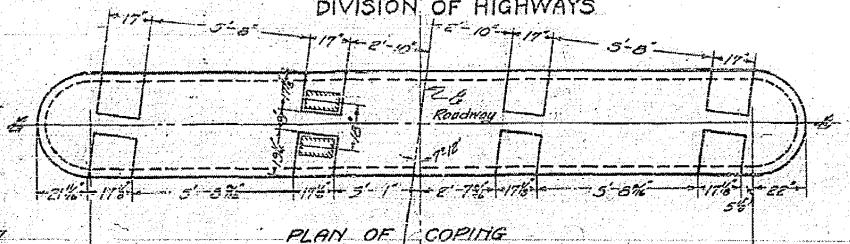

DETAILS OF EXPANSION GUARD
4 REQUIRED
STRUCTURAL STEEL - LBS - 2400

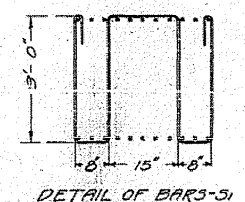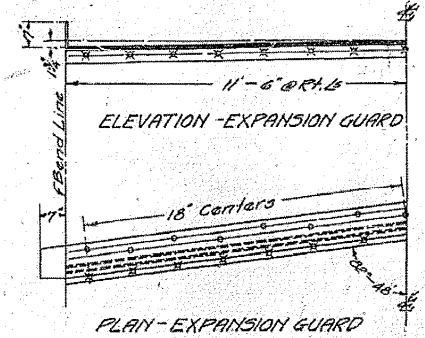

BILL OF MATERIAL - 4 PIERS

Bar No.	Size	Length	Bar No.	Size	Length
a2	1 1/2"	28'-6"	n	10"	15'-0"
a3	1 1/2"	24'-6"	v	10"	17'-0"
b2	1 1/2"	26'-0"	b3	10"	18'-0"
b3	1 1/2"	29'-6"	d1	1 1/2"	16'-0"
d1	1 1/2"	4'-0"			
n	10"	9'-0"			
v	10"	22'-6"			
Class A Concrete - Cu. Yds. - 295.8					
Reinforcing Steel - Lbs. - 21310					

WABASH OVERHEAD
AT HANFIELD
S.B.I. ROUTE 29 - SECTION 12V
PIATT COUNTY
STATION 295+23

FILE NAME =
c:\pw\work\PIWIDOT\SHERERJM\dms86674\0570388-sht-esbuils.dgn

USER NAME = shererjm
PLOT SCALE = 100.0000' / IN.
PLOT DATE = 10/13/2009

DESIGNED - JMS
DRAWN - JMS
CHECKED - JMS
DATE - 090309

REVISED -
REVISED -
REVISED -
REVISED -

STATE OF ILLINOIS
DEPARTMENT OF TRANSPORTATION

AS-BUILT PLANS SN 074-0009
INFORMATION ONLY

SCALE: SHEET NO. OF SHEETS STA. TO STA.


F.A.S. RTE.	SECTION	COUNTY	TOTAL SHEETS	SHEET NO.
1517	12VBR-1	PIATT	168	49
CONTRACT NO. 70388				
ILLINOIS FED. AID PROJECT				

B.M. - S&W in T.P. right Sta. 295+00
 H.W. 215.17
 No existing structure.


STATE OF ILLINOIS
 DEPARTMENT OF PUBLIC WORKS & BUILDINGS
 DIVISION OF HIGHWAYS

ROUTE NO.	COUNTY	REG.	SHEET	SHEET NO.
39	Piatt	12V	6	5

Plan of Finished Roadway

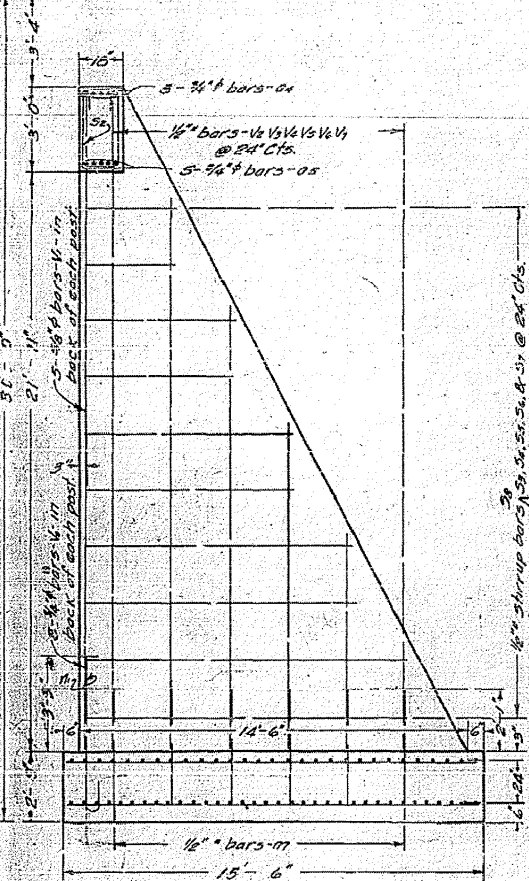

END ELEVATION

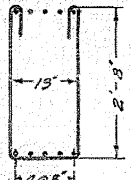


DETAIL OF BAR 3s


STANDARD	COMPUTED - <i>[Signature]</i>	EXAMINED - <i>[Signature]</i> 10/28
	CHECKED - <i>[Signature]</i>	APPROVED - <i>[Signature]</i>
	DRAWN - <i>[Signature]</i>	
SPECIAL	CHECKED - <i>[Signature]</i>	
	ASSEMBLED - <i>[Signature]</i>	
	CHECKED - <i>[Signature]</i>	

APPROVED
[Signature]
 CHIEF HIGHWAY ENGINEER
 Revised - Oct 28 1929
[Signature]

Cr. Elev. 243.417

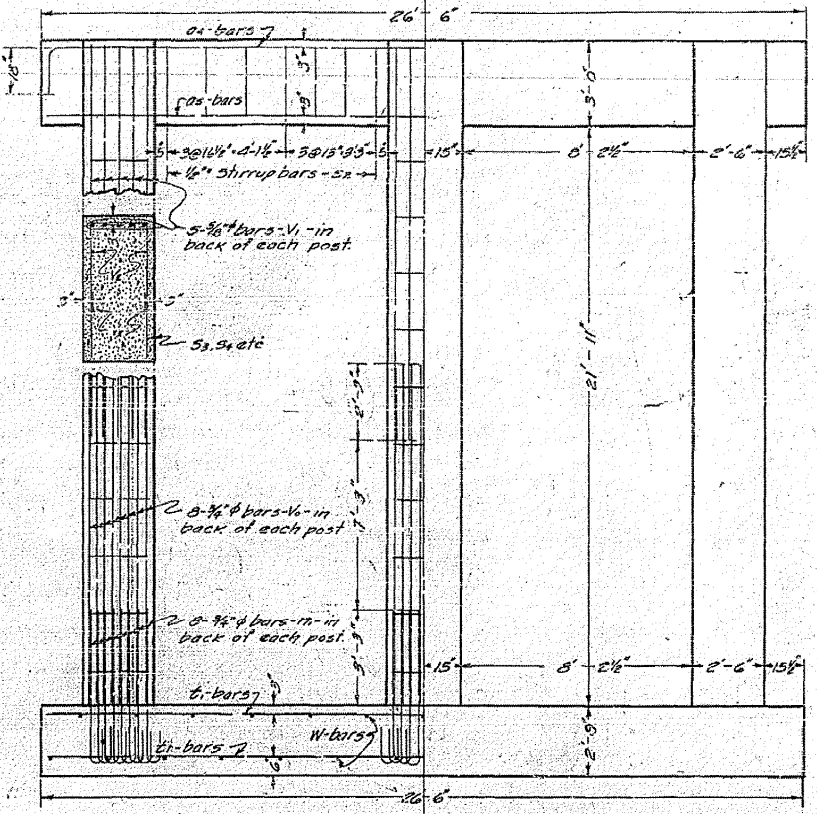

SHOWING REINFORCEMENT SHOWING OUTLINES
 FRONT ELEVATION

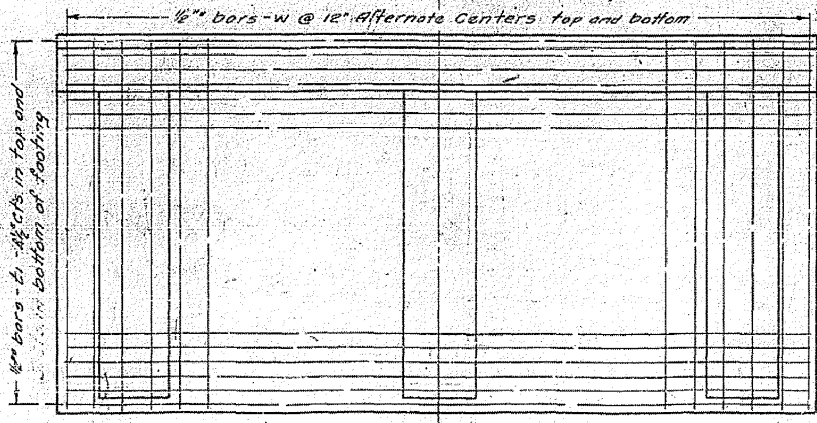

PLAN

BILL OF MATERIAL - REBAR

Bar	No.	Size	Length
04	10	3/4"	29'-0"
05	10	3/4"	26'-0"
V0	48	3/8"	13'-0"
V1	30	3/8"	14'-0"
V2	12	1/2"	24'-0"
V3	12	1/2"	21'-0"
V4	12	1/2"	17'-0"
V5	12	1/2"	13'-0"
V6	12	1/2"	9'-0"
V7	12	1/2"	5'-0"
V8	48	3/8"	6'-6"
S2	28	1/2"	7'-6"
S3	12	1/2"	24'-0"
S4	12	1/2"	20'-0"
S5	12	1/2"	16'-6"
S6	12	1/2"	12'-0"
S7	12	1/2"	8'-0"
V7	72	1/2"	4'-0"
L1	168	1/2"	26'-0"
S8	6	1/2"	28'-0"
V1	54	1/2"	14'-3"

Class A Concrete - C.I. 200.7
 Reinforcing Steel - Lbs. 9250

Class A concrete shall be used throughout.
 Proportions - 1:2 1/2:4

All reinforcing steel shall be wired securely in place before concrete is poured.

WABASH OVERHEAD
 AT MANSFIELD
 S.B.I. ROUTE 39 SECTION 12V
 PIATT COUNTY
 STATION 282+23

FILE NAME =	USER NAME = shererjm	DESIGNED - JMS	REVISED -
et:\pw_work\PIWIDOT\SHERERJM\dms86674\0570388-sht-esbuilts.dgn		DRAWN - JMS	REVISED -
	PLOT SCALE = 100.0000' / IN.	CHECKED - JMS	REVISED -
	PLOT DATE = 10/13/2009	DATE - 090309	REVISED -

STATE OF ILLINOIS
 DEPARTMENT OF TRANSPORTATION

AS-BUILT PLANS SN 074-0009
 INFORMATION ONLY

SCALE: SHEET NO. OF SHEETS STA. TO STA.

F.A.S. RTE.	SECTION	COUNTY	TOTAL SHEETS	SHEET NO.
1517	12VBR-1	PIATT	168	50
CONTRACT NO. 70388				

ILLINOIS FED. AID PROJECT

44000100 PAVEMENT REMOVAL

STATION	TO	STATION	LENGTH	WIDTH	SQ YD
276+00.00		287+98.87	1198.9	26.0	3463.4
290+41.22		303+00.00	1258.8	26.0	3636.5
TOTAL =					7099.9
USE =					7100.0

44000700 APPROACH SLAB REMOVAL

STATION	TO	STATION	LENGTH	WIDTH	SQ YD
287+98.87		288+10.87	12.0	32.0	42.7
290+29.26		290+41.22	12.0	32.0	42.7
TOTAL =					85.4
USE =					86.0

44000155 HOT-MIX ASPHALT SURFACE REMOVAL, 1 1/2"

STATION	TO	STATION	LENGTH	WIDTH	SQ YD
273+00.00		276+00.00	300.0	26.0	866.7
303+00.00		304+00.00	100.0	26.0	288.9
TOTAL =					1155.6
USE =					1156.0

44004250 PAVED SHOULDER REMOVAL

STATION	TO	STATION	LENGTH	WIDTH	SQ YD
297+04.80		297+36.53	31.7	3.0	10.6
297+91.68		299+93.19	201.5	13.0	291.1
299+93.19		300+38.89	45.7	3.0	15.2
300+90.70		301+74.41	83.7	3.0	27.9
TOTAL =					344.8
USE =					345.0

44000196 HOT-MIX ASPHALT SURFACE REMOVAL, SPECIAL

STATION	TO	STATION	LENGTH	WIDTH	SQ YD
299+19.61		300+15.24	95.6	VAR.	192.9
TOTAL =					192.9
USE =					193.0

50104000 BRIDGE RAIL REMOVAL

	STATION	TO	STATION	LENGTH
LT	288+08.70		LT 290+27.10	219.1
RT	288+12.90		RT 290+31.20	219.1
TOTAL =				438.2
USE =				438.0

FILE NAME =	USER NAME = shererjm	DESIGNED - JMS	REVISED -
ct:\pw\work\PIWIDOT\SHERERJM\dms86674\0570388-shr-rem.dgn		DRAWN - JMS	REVISED -
	PLOT SCALE = 40.0000' / IN.	CHECKED -	REVISED -
	PLOT DATE = 10/13/2009	DATE - 051909	REVISED -

**STATE OF ILLINOIS
DEPARTMENT OF TRANSPORTATION**

SCHEDULES OF REMOVAL

SCALE: 1" = 20' SHEET NO. 1 OF 8 SHEETS STA. N/A TO STA. N/A

F.A.S. RTE.	SECTION	COUNTY	TOTAL SHEETS	SHEET NO.
1517	12VBR-1	PIATT	168	51
FED. ROAD DIST. NO. ILLINOIS FED. AID PROJECT			CONTRACT NO. 70388	

50104650 SLOPE WALL REMOVAL

LOCATION	SQ YD
EAST SLOPE WALL	269.6
WEST SLOPE WALL	271.9
TOTAL =	541.5
USE =	542.0

63200310 GUARD RAIL REMOVAL

	STATION	TO	STATION	LENGTH
LT	283+07.89		LT 288+10.87	503.0
RT	283+07.89		RT 288+10.87	503.0
LT	290+29.26		LT 296+90.23	665.5
RT	290+29.26		RT 297+09.65	677.0
TOTAL =				2348.5
USE =				2349.0

50105200 REMOVE EXISTING CULVERTS

STATION	EACH	CU YD
RT. 295+37.6	1.0	
LT. 296+73.16	1.0	26.0
TOTAL =	2.0	26.0

20800150
TRENCH
BACKFILL
CU YD

60500065 REMOVE INLETS, SPECIAL

STATION	EACH
LT 288+01.14	1.0
RT 288+05.15	1.0
LT 290+32.64	1.0
RT 290+37.38	1.0
TOTAL =	4.0

FILE NAME =	USER NAME = shererjm	DESIGNED - JMS	REVISED -
ct:\pw\work\PWIDOT\SHERERJM\dms86674\0570388-shr-rem.dgn		DRAWN - JMS	REVISED -
	PLOT SCALE = 40.0000' / IN.	CHECKED -	REVISED -
	PLOT DATE = 10/13/2009	DATE - 051909	REVISED -

**STATE OF ILLINOIS
DEPARTMENT OF TRANSPORTATION**

SCHEDULES OF REMOVAL


SCALE: 1" = 20' SHEET NO. 2 OF 8 SHEETS STA. N/A TO STA. N/A

F.A.S. RTE.	SECTION	COUNTY	TOTAL SHEETS	SHEET NO.
1517	12VBR-1	PIATT	168	52
FED. ROAD DIST. NO. ILLINOIS FED. AID PROJECT			CONTRACT NO. 70388	

SECTION 3, T20N, R6E, 3RD PM

DETAIL NOTES


- ① ALL REMOVAL ITEMS ARE BASED OFF THE OLD ALIGNMENT.
- ② THERE ARE AREAS WHERE MINOR TREE REMOVAL MAY BE NEEDED TO ESTABLISH THE PLAN CROSS-SLOPES. ANY TREE REMOVAL SHALL NOT BE PAID FOR SEPARATELY, BUT SHALL BE CONSIDERED INCIDENTAL TO THE VARIOUS REMOVAL AND EARTHWORK PAY ITEMS.
- ③ THE STORAGE AREA (FENCE COMPOUND) SHALL BE REMOVED BY THE CONTRACTOR DURING CONSTRUCTION. A NEW FENCE COMPOUND WILL BE BUILT BY OTHERS AT THE NS FACILITY IN MANSFIELD. THE COST OF THE NEW FENCE COMPOUND IS INCLUDED IN THE AGREEMENT IDOT HAS ENTERED INTO WITH NS FOR THIS PROJECT. COST OF REMOVAL SHALL BE CONSIDERED INCIDENTAL TO THE VARIOUS REMOVAL PAY ITEMS.
- ④ EXISTING SERVICE ROAD SHALL BE RECONSTRUCTED DURING CONSTRUCTION. THE REMOVAL OF THE EXISTING SERVICE ROAD SHALL BE CONSIDERED INCIDENTAL TO THE VARIOUS PAY ITEMS ASSOCIATED WITH REMOVAL AND EARTHWORK.
- ⑤ EXISTING ALLEY SHALL BE RECONSTRUCTED DURING CONSTRUCTION. THE REMOVAL OF THE EXISTING ALLEY SHALL BE CONSIDERED INCIDENTAL TO THE VARIOUS PAY ITEMS ASSOCIATED WITH REMOVAL AND EARTHWORK.
- ⑥ EXISTING AGGREGATE ENTRANCES SHALL BE REMOVED DURING THE RECONSTRUCTION OF THE NEW SERVICE ROAD. THE REMOVAL OF THE ENTRANCES SHALL BE CONSIDERED INCIDENTAL TO THE VARIOUS PAY ITEMS ASSOCIATED WITH REMOVAL AND EARTHWORK.
- ⑦ EXISTING SHOULDER DRAINS SHALL BE REMOVED IN THEIR ENTIRETY. THIS INCLUDES THE GRATES, CASTING, PIPE, END SECTIONS, AND ANY OTHER ITEMS ASSOCIATED WITH THE SHOULDER DRAINS. THIS WORK SHALL BE PAID FOR AT THE CONTRACT UNIT PRICE FOR EACH AS REMOVING INLETS, SPECIAL.
- ⑧ ANY ROW MARKERS, SIGNS, AND OTHER MINOR ITEMS THAT ARE TO BE REMOVED AS A RESULT OF THE CONSTRUCTION OF THE NEW ALIGNMENT SHALL BE CONSIDERED INCIDENTAL TO THE VARIOUS REMOVAL AND EARTHWORK ITEMS AND NO ADDITIONAL COMPENSATION SHALL BE ALLOWED.
- ⑨ THE VARIOUS QUANTITIES INCLUDED IN THE PLANS REPRESENT THE BEST INFORMATION AVAILABLE AT THE TIME OF COMPLETION OF THE PLANS FOR LETTING. VARIATIONS IN LOCATIONS MAY OCCUR.

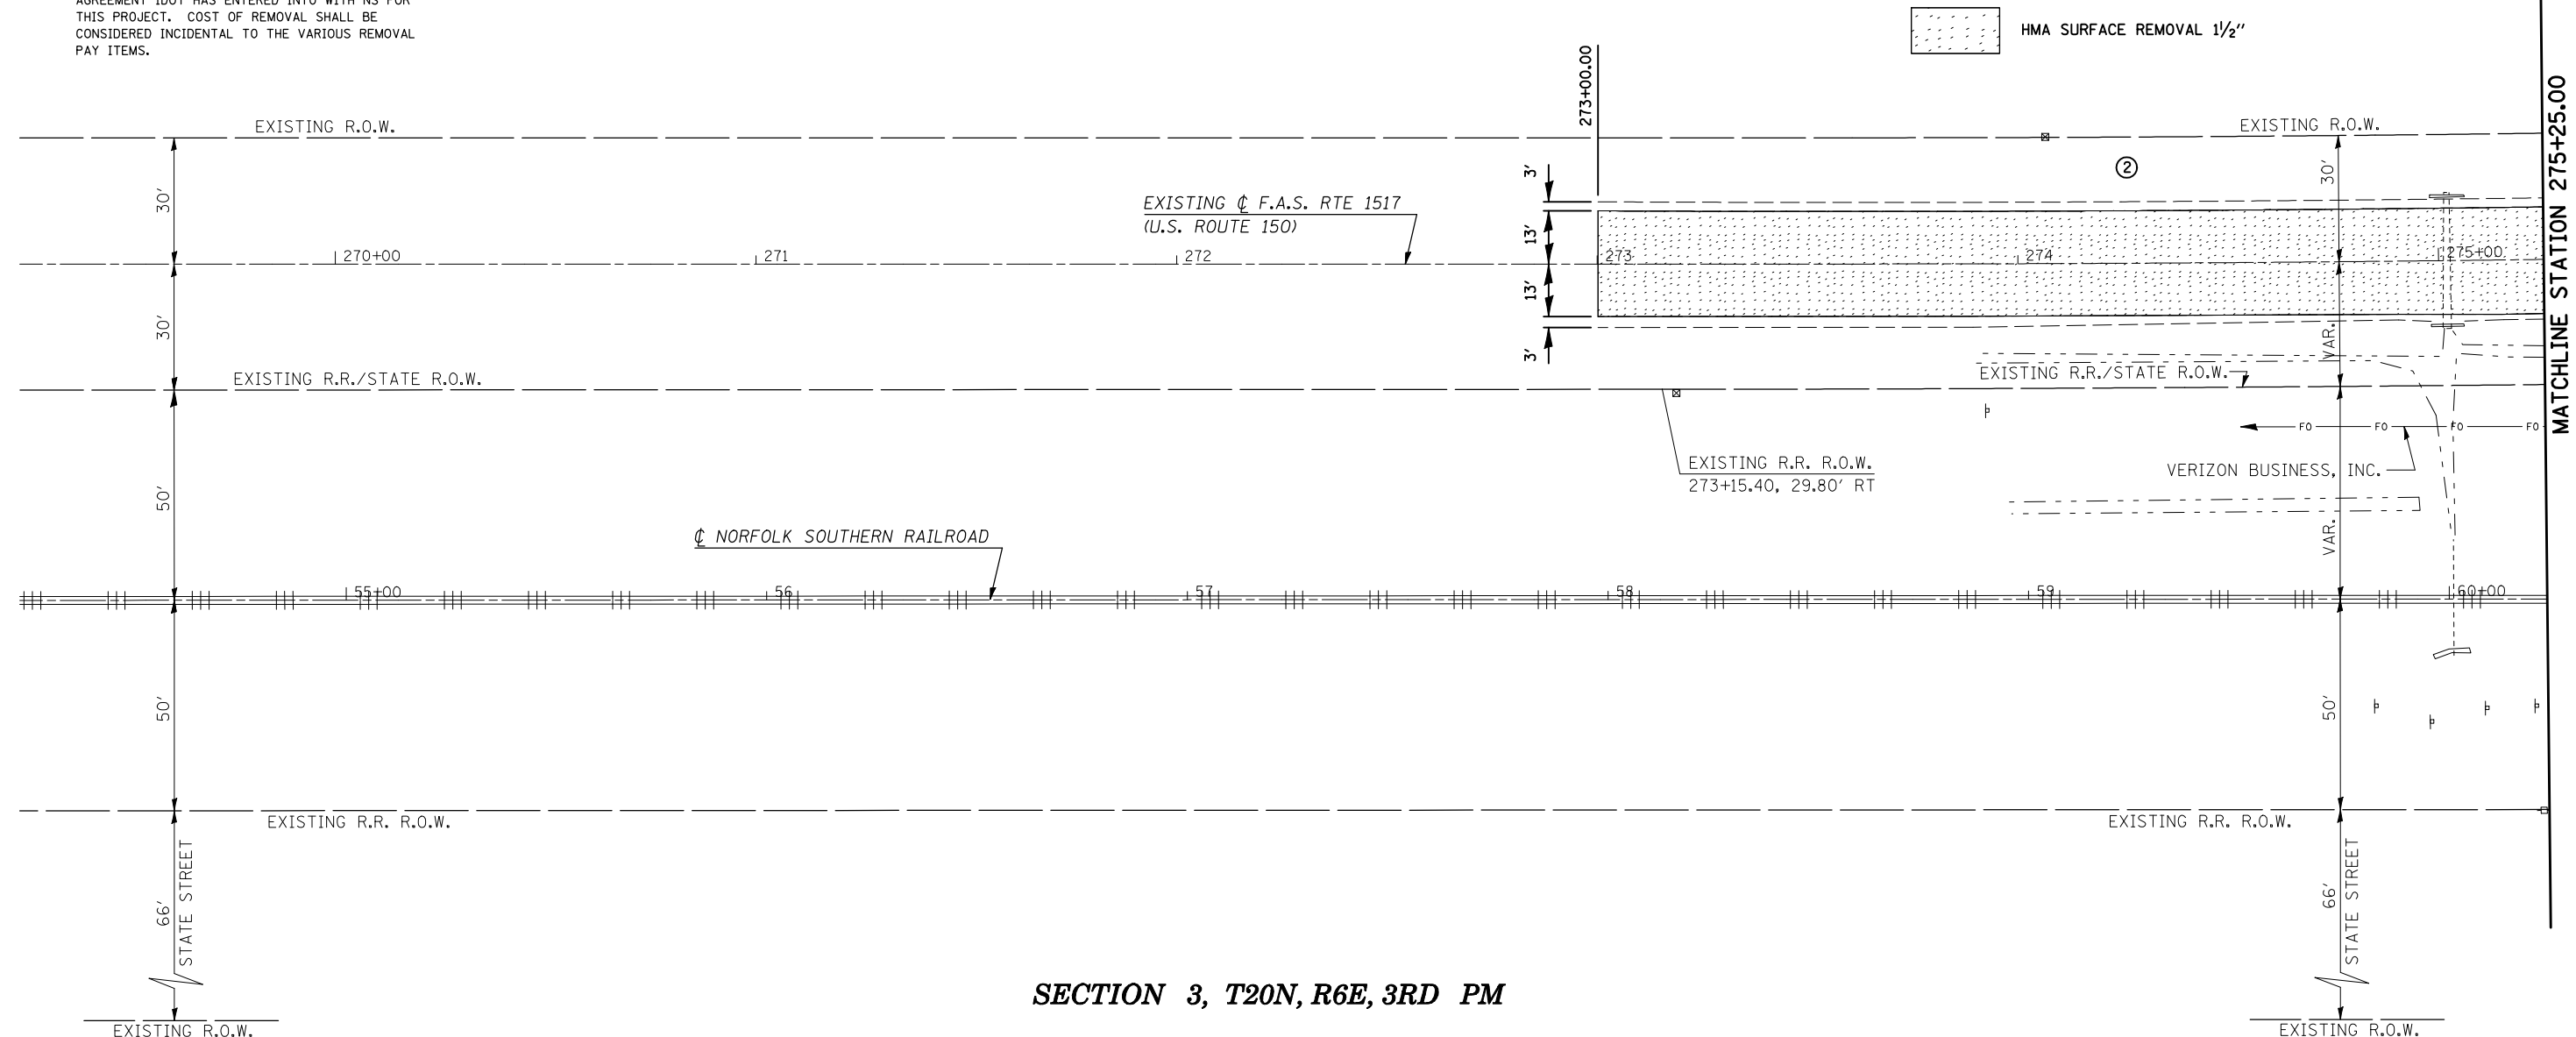



SECTION 3, T20N, R6E, 3RD PM

FILE NAME =	USER NAME = shererjm	DESIGNED - JMS	REVISED -	STATE OF ILLINOIS DEPARTMENT OF TRANSPORTATION	REMOVAL DETAILS	F.A.S. RTE. 1517	SECTION 12VBR-1	COUNTY PIATT	TOTAL SHEETS 168	SHEET NO. 53	
ct:\pw\work\PWIDOT\SHERERJM\dms86674\0570388-shr-rem.dgn	PLOT SCALE = 40.0000' / IN.	CHECKED -	REVISED -			CONTRACT NO. 70388					
	PLOT DATE = 10/13/2009	DATE - 051909	REVISED -			FED. ROAD DIST. NO. ILLINOIS FED. AID PROJECT					
						SCALE: 1" = 20'		SHEET NO. 3 OF 8 SHEETS		STA. 273+00.00 TO STA. 275+25.00	

SECTION 3, T20N, R6E, 3RD PM

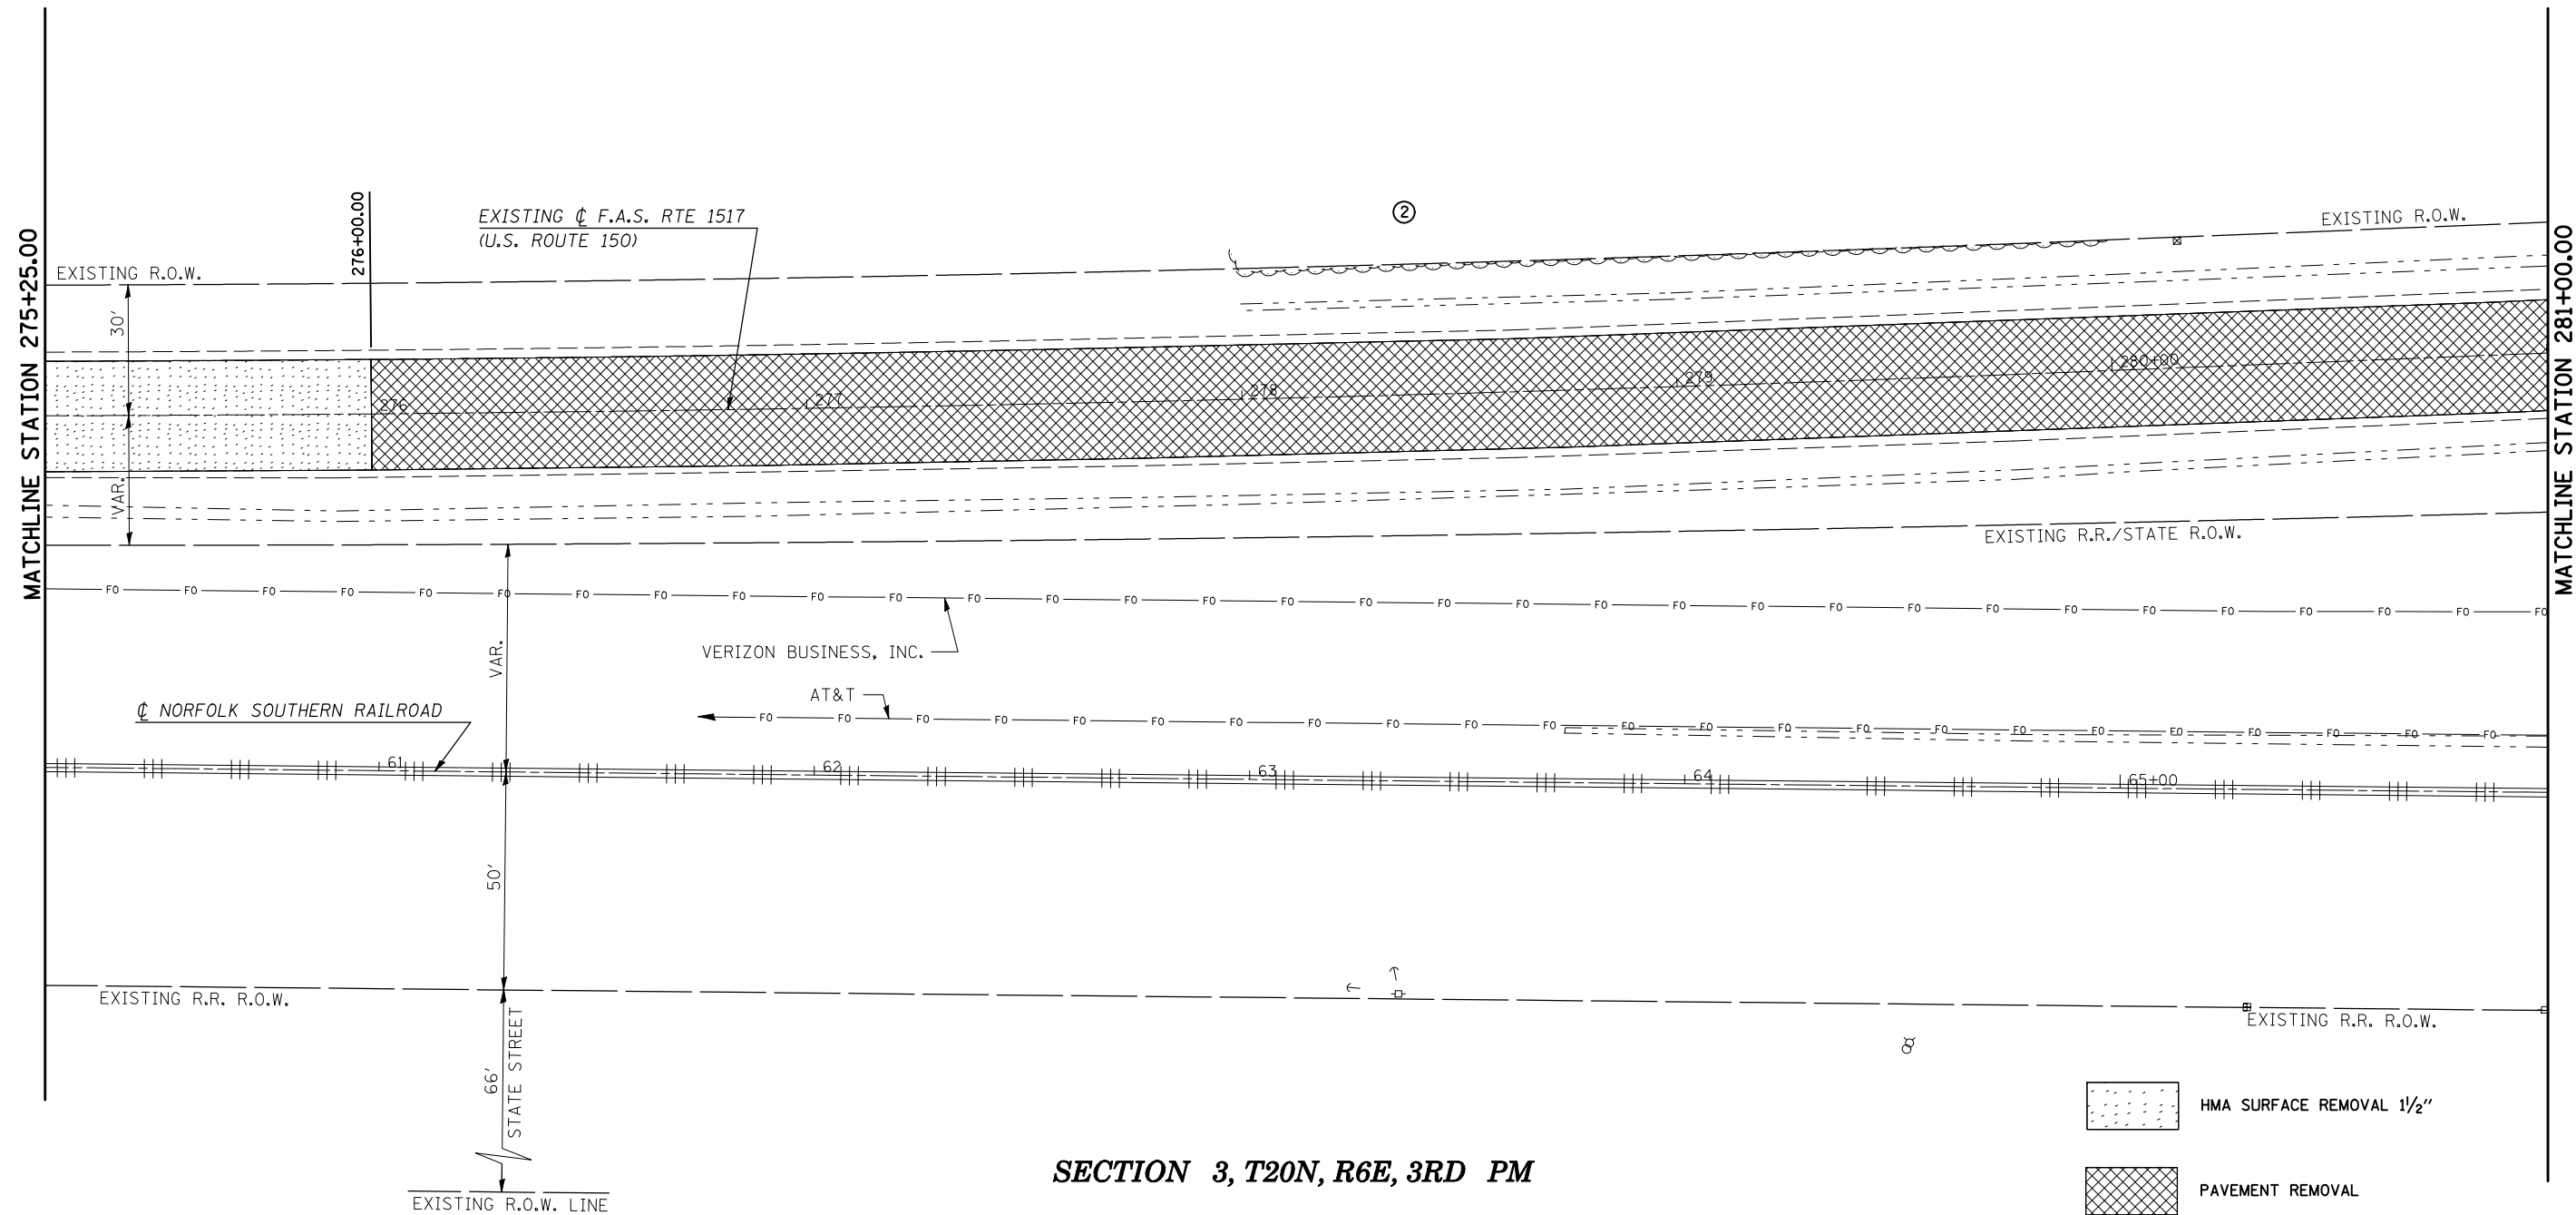

SECTION 3, T20N, R6E, 3RD PM

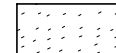-  HMA SURFACE REMOVAL 1 1/2"
-  PAVEMENT REMOVAL

FILE NAME =	USER NAME = shererjm	DESIGNED - JMS	REVISED -
ct:\pw\work\PIWIDOT\SHERERJM\dms86674\0570388-shr-rem.dgn		DRAWN - JMS	REVISED -
	PLOT SCALE = 40.0000' / IN.	CHECKED -	REVISED -
	PLOT DATE = 10/13/2009	DATE - 051909	REVISED -


STATE OF ILLINOIS
DEPARTMENT OF TRANSPORTATION

REMOVAL DETAILS

SCALE: 1" = 20' SHEET NO. 4 OF 8 SHEETS STA. 275+25.00 TO STA. 281+00.00

F.A.S. RTE.	SECTION	COUNTY	TOTAL SHEETS	SHEET NO.
1517	12VBR-1	PIATT	168	54
CONTRACT NO. 70388				
FED. ROAD DIST. NO. ILLINOIS FED. AID PROJECT				

SECTION 3, T20N, R6E, 3RD PM

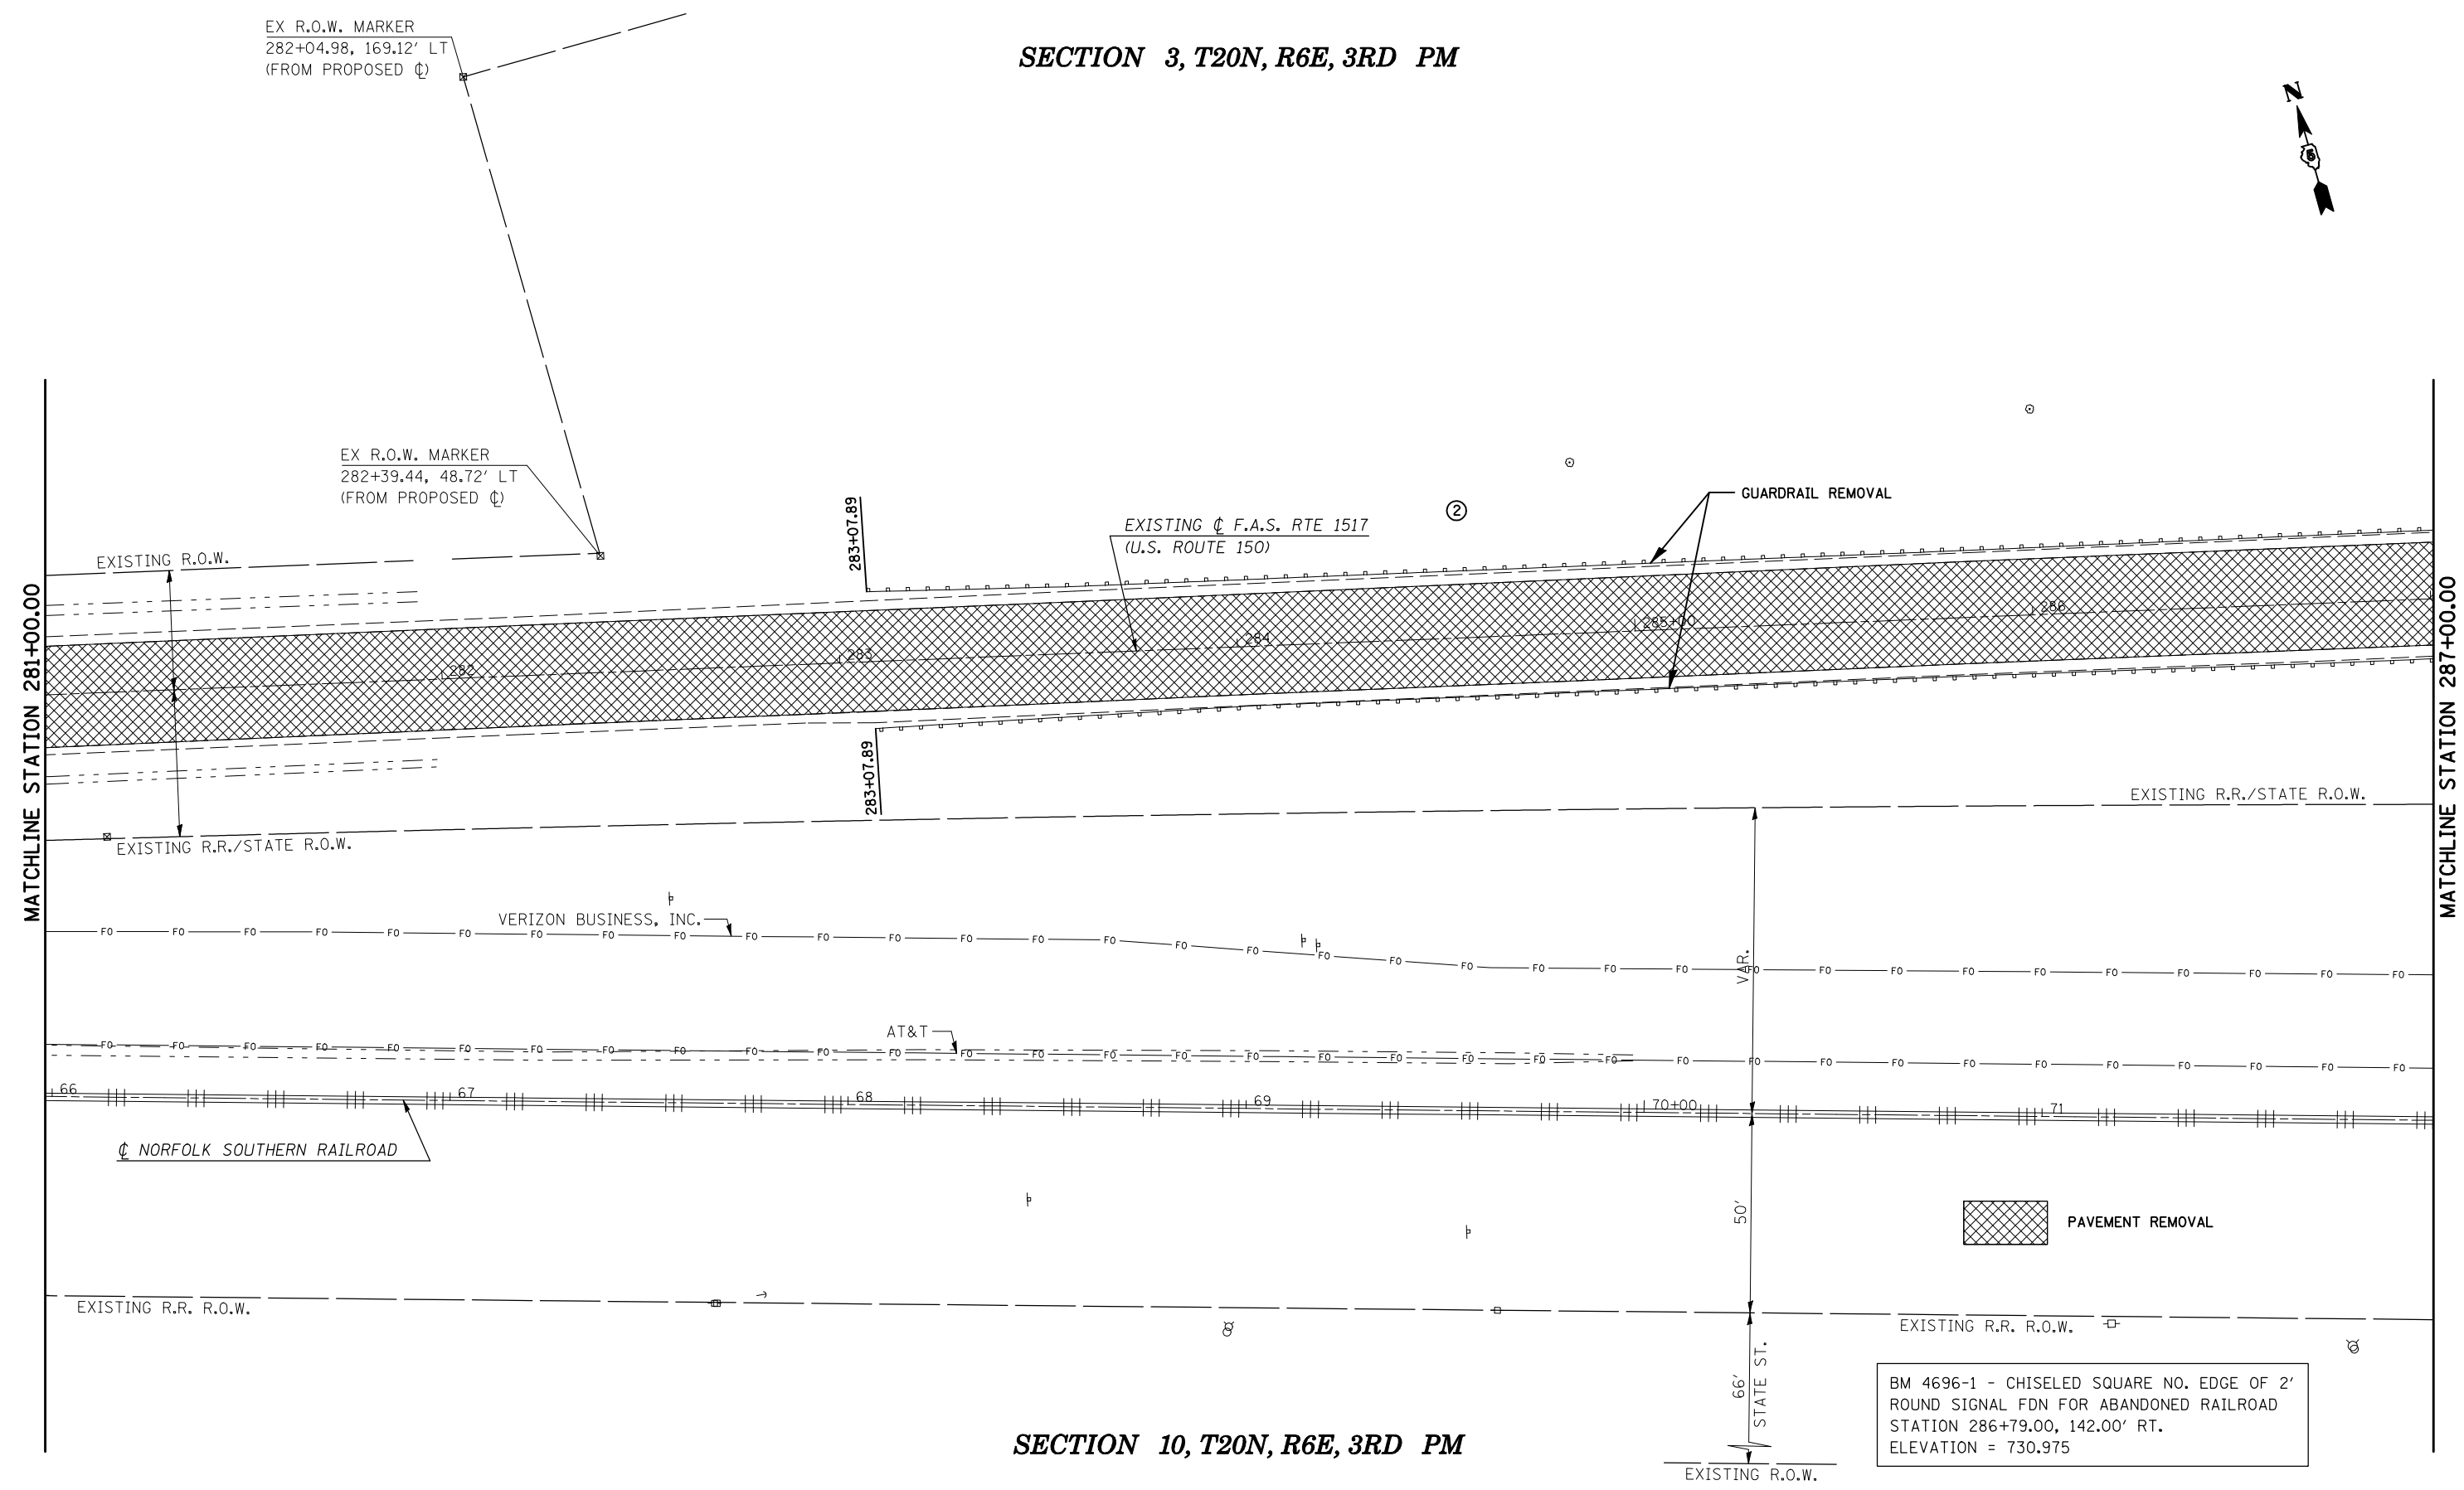

SECTION 10, T20N, R6E, 3RD PM

FILE NAME =	USER NAME = shererjm	DESIGNED - JMS	REVISED -
ct:\pw\work\PWIDOT\SHERERJM\dms86674\0570388-shr-rem.dgn		DRAWN - JMS	REVISED -
	PLOT SCALE = 40.0000' / IN.	CHECKED -	REVISED -
	PLOT DATE = 10/13/2009	DATE - 051909	REVISED -




STATE OF ILLINOIS
DEPARTMENT OF TRANSPORTATION


REMOVAL DETAILS

SCALE: 1" = 20' SHEET NO. 5 OF 8 SHEETS STA. 281+00.00 TO STA. 287+00.00

F.A.S. RTE.	SECTION	COUNTY	TOTAL SHEETS	SHEET NO.
1517	12VBR-1	PIATT	168	55
CONTRACT NO. 70388				
FED. ROAD DIST. NO. ILLINOIS FED. AID PROJECT				

SECTION 3, T20N, R6E, 3RD PM

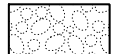-  PAVEMENT REMOVAL
-  REMOVE EXST. STRUCTURE
-  APPROACH SLAB REMOVAL

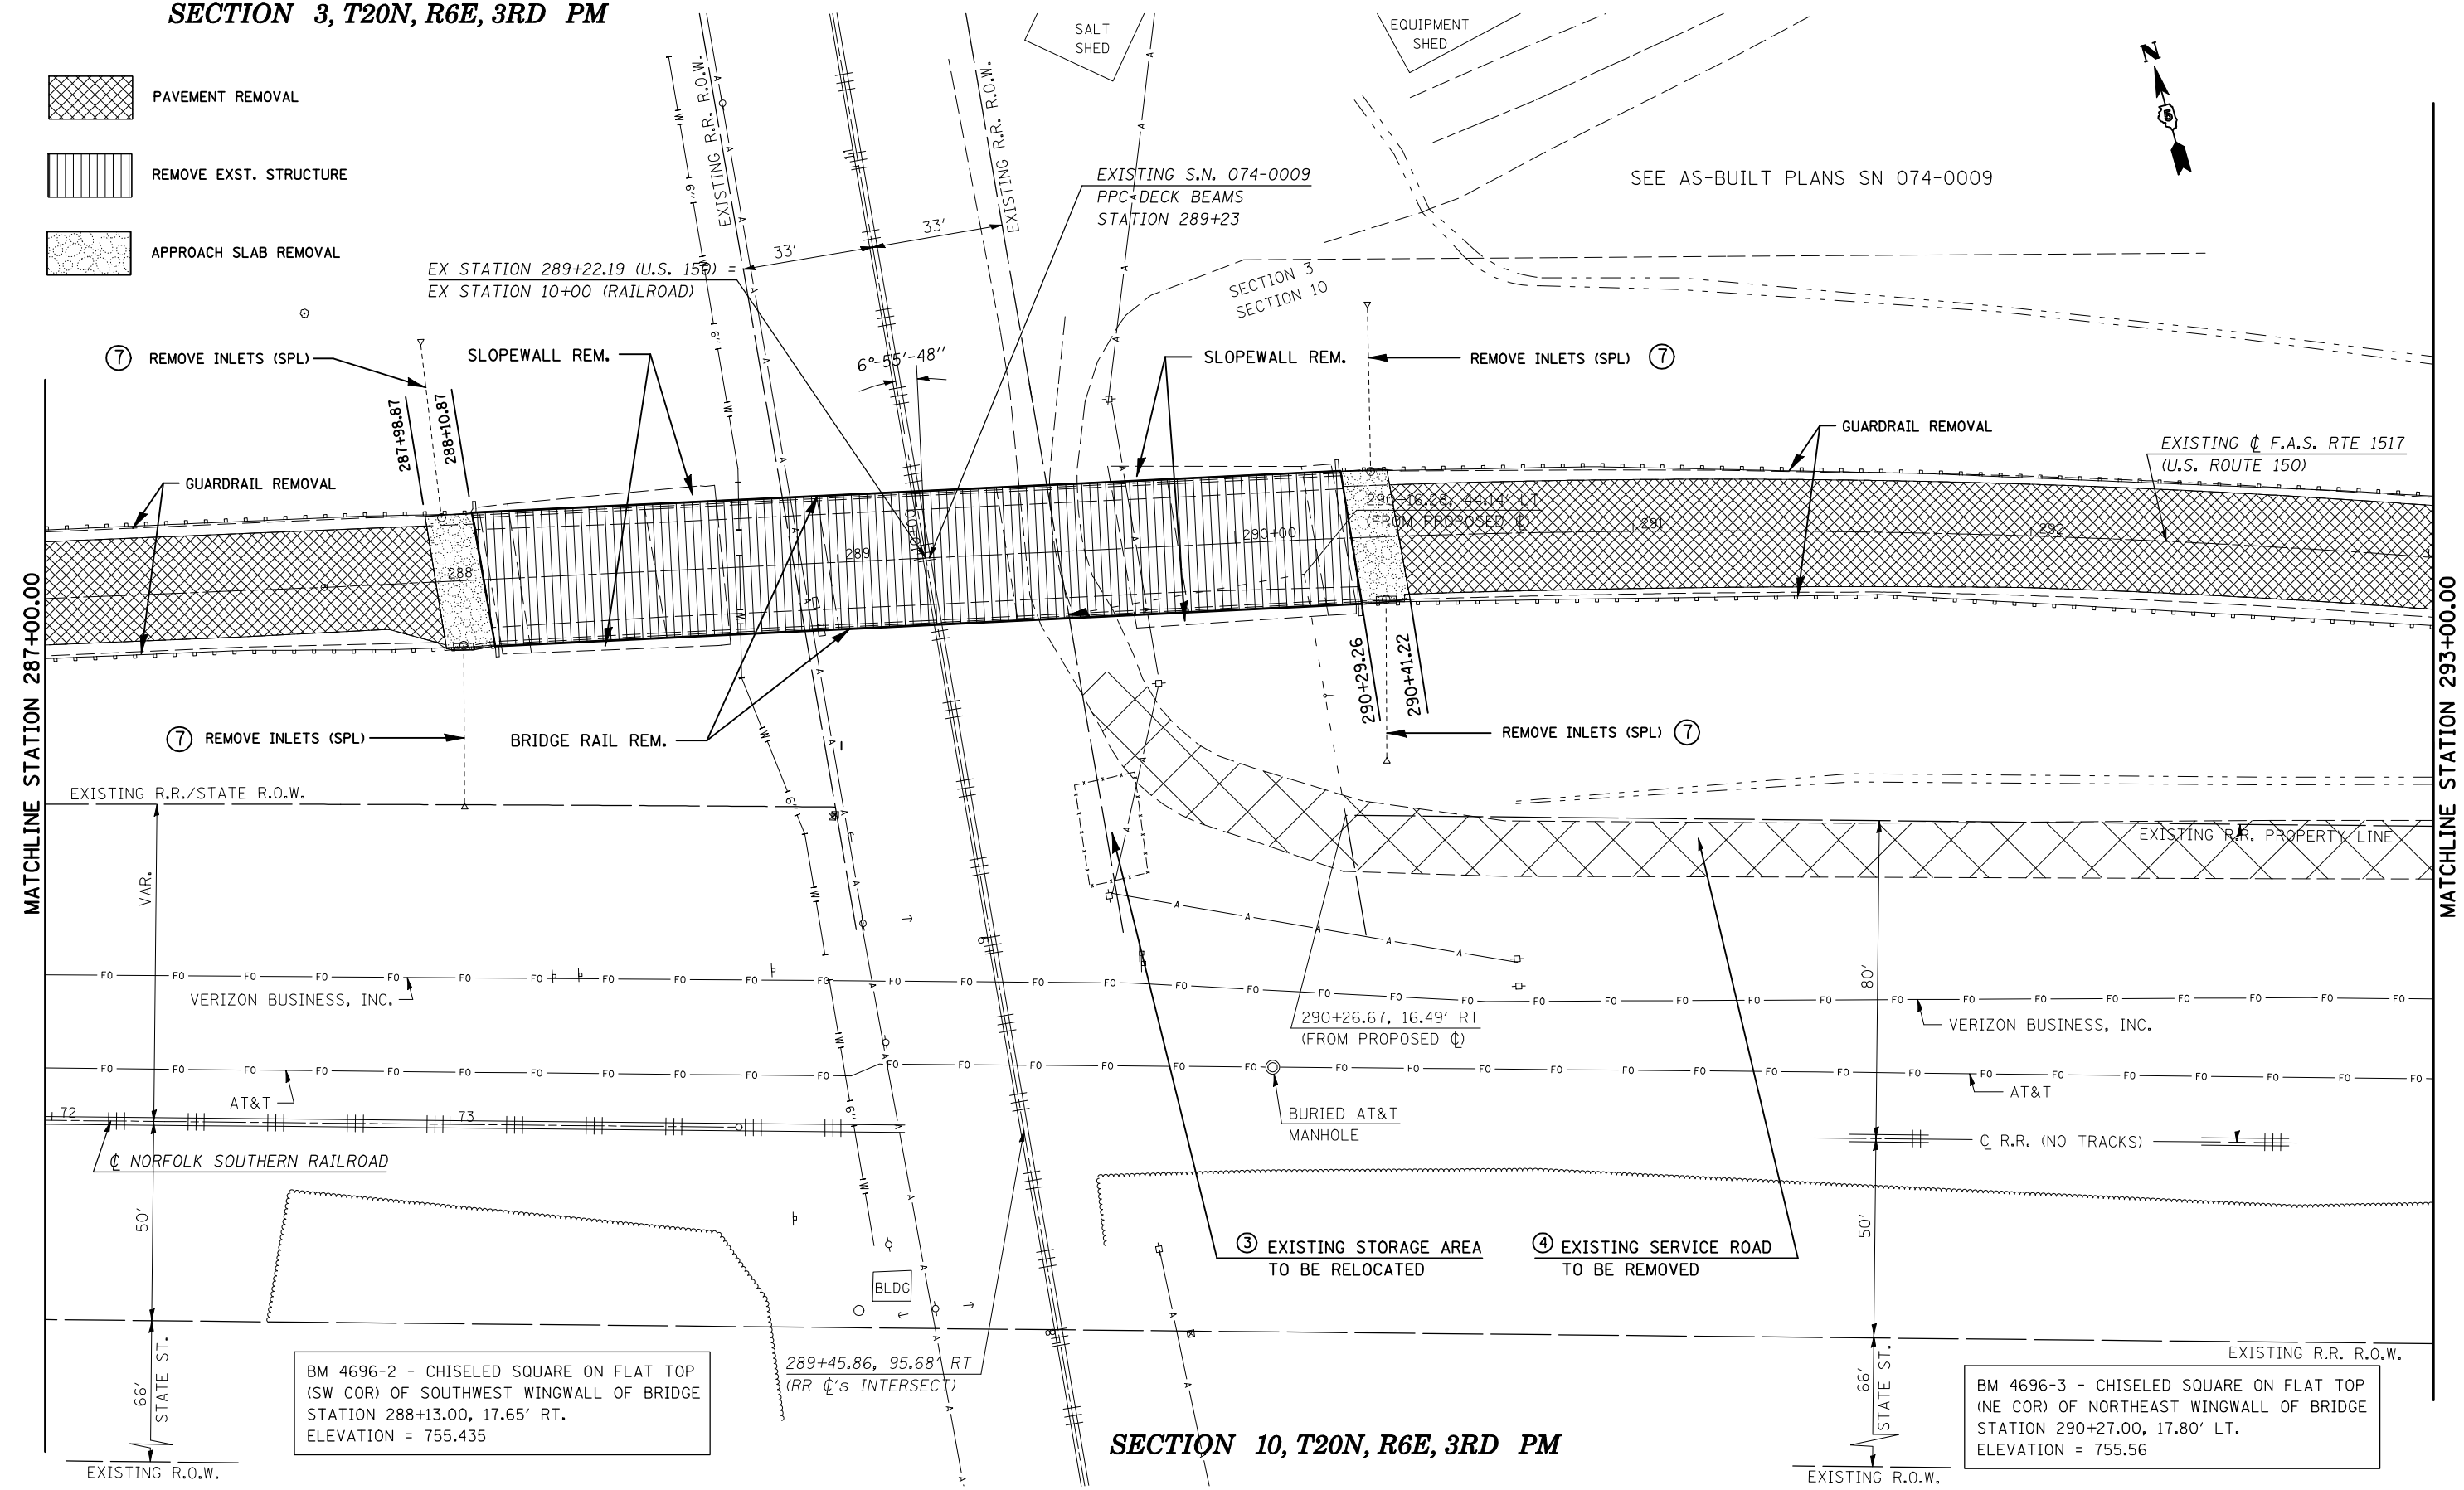

SECTION 10, T20N, R6E, 3RD PM

BM 4696-2 - CHISELED SQUARE ON FLAT TOP (SW COR) OF SOUTHWEST WINGWALL OF BRIDGE STATION 288+13.00, 17.65' RT. ELEVATION = 755.435

BM 4696-3 - CHISELED SQUARE ON FLAT TOP (NE COR) OF NORTHEAST WINGWALL OF BRIDGE STATION 290+27.00, 17.80' LT. ELEVATION = 755.56

FILE NAME =	USER NAME = shererjm	DESIGNED - JMS	REVISED -
ct:\pw\work\PIWIDOT\SHERERJM\dms86674\0570388-shr-rem.dgn		DRAWN - JMS	REVISED -
	PLOT SCALE = 40.0000' / IN.	CHECKED -	REVISED -
	PLOT DATE = 10/13/2009	DATE - 051909	REVISED -

**STATE OF ILLINOIS
DEPARTMENT OF TRANSPORTATION**



REMOVAL DETAILS


SCALE: 1" = 20' SHEET NO. 6 OF 8 SHEETS STA. 287+00.00 TO STA. 293+00.00

F.A.S. RTE.	SECTION	COUNTY	TOTAL SHEETS	SHEET NO.
1517	12VBR-1	PIATT	168	56
CONTRACT NO. 70388				

FED. ROAD DIST. NO. ILLINOIS FED. AID PROJECT

SECTION 10, T20N, R6E, 3RD PM

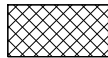-  PAVEMENT REMOVAL
-  APPROACH SLAB REMOVAL

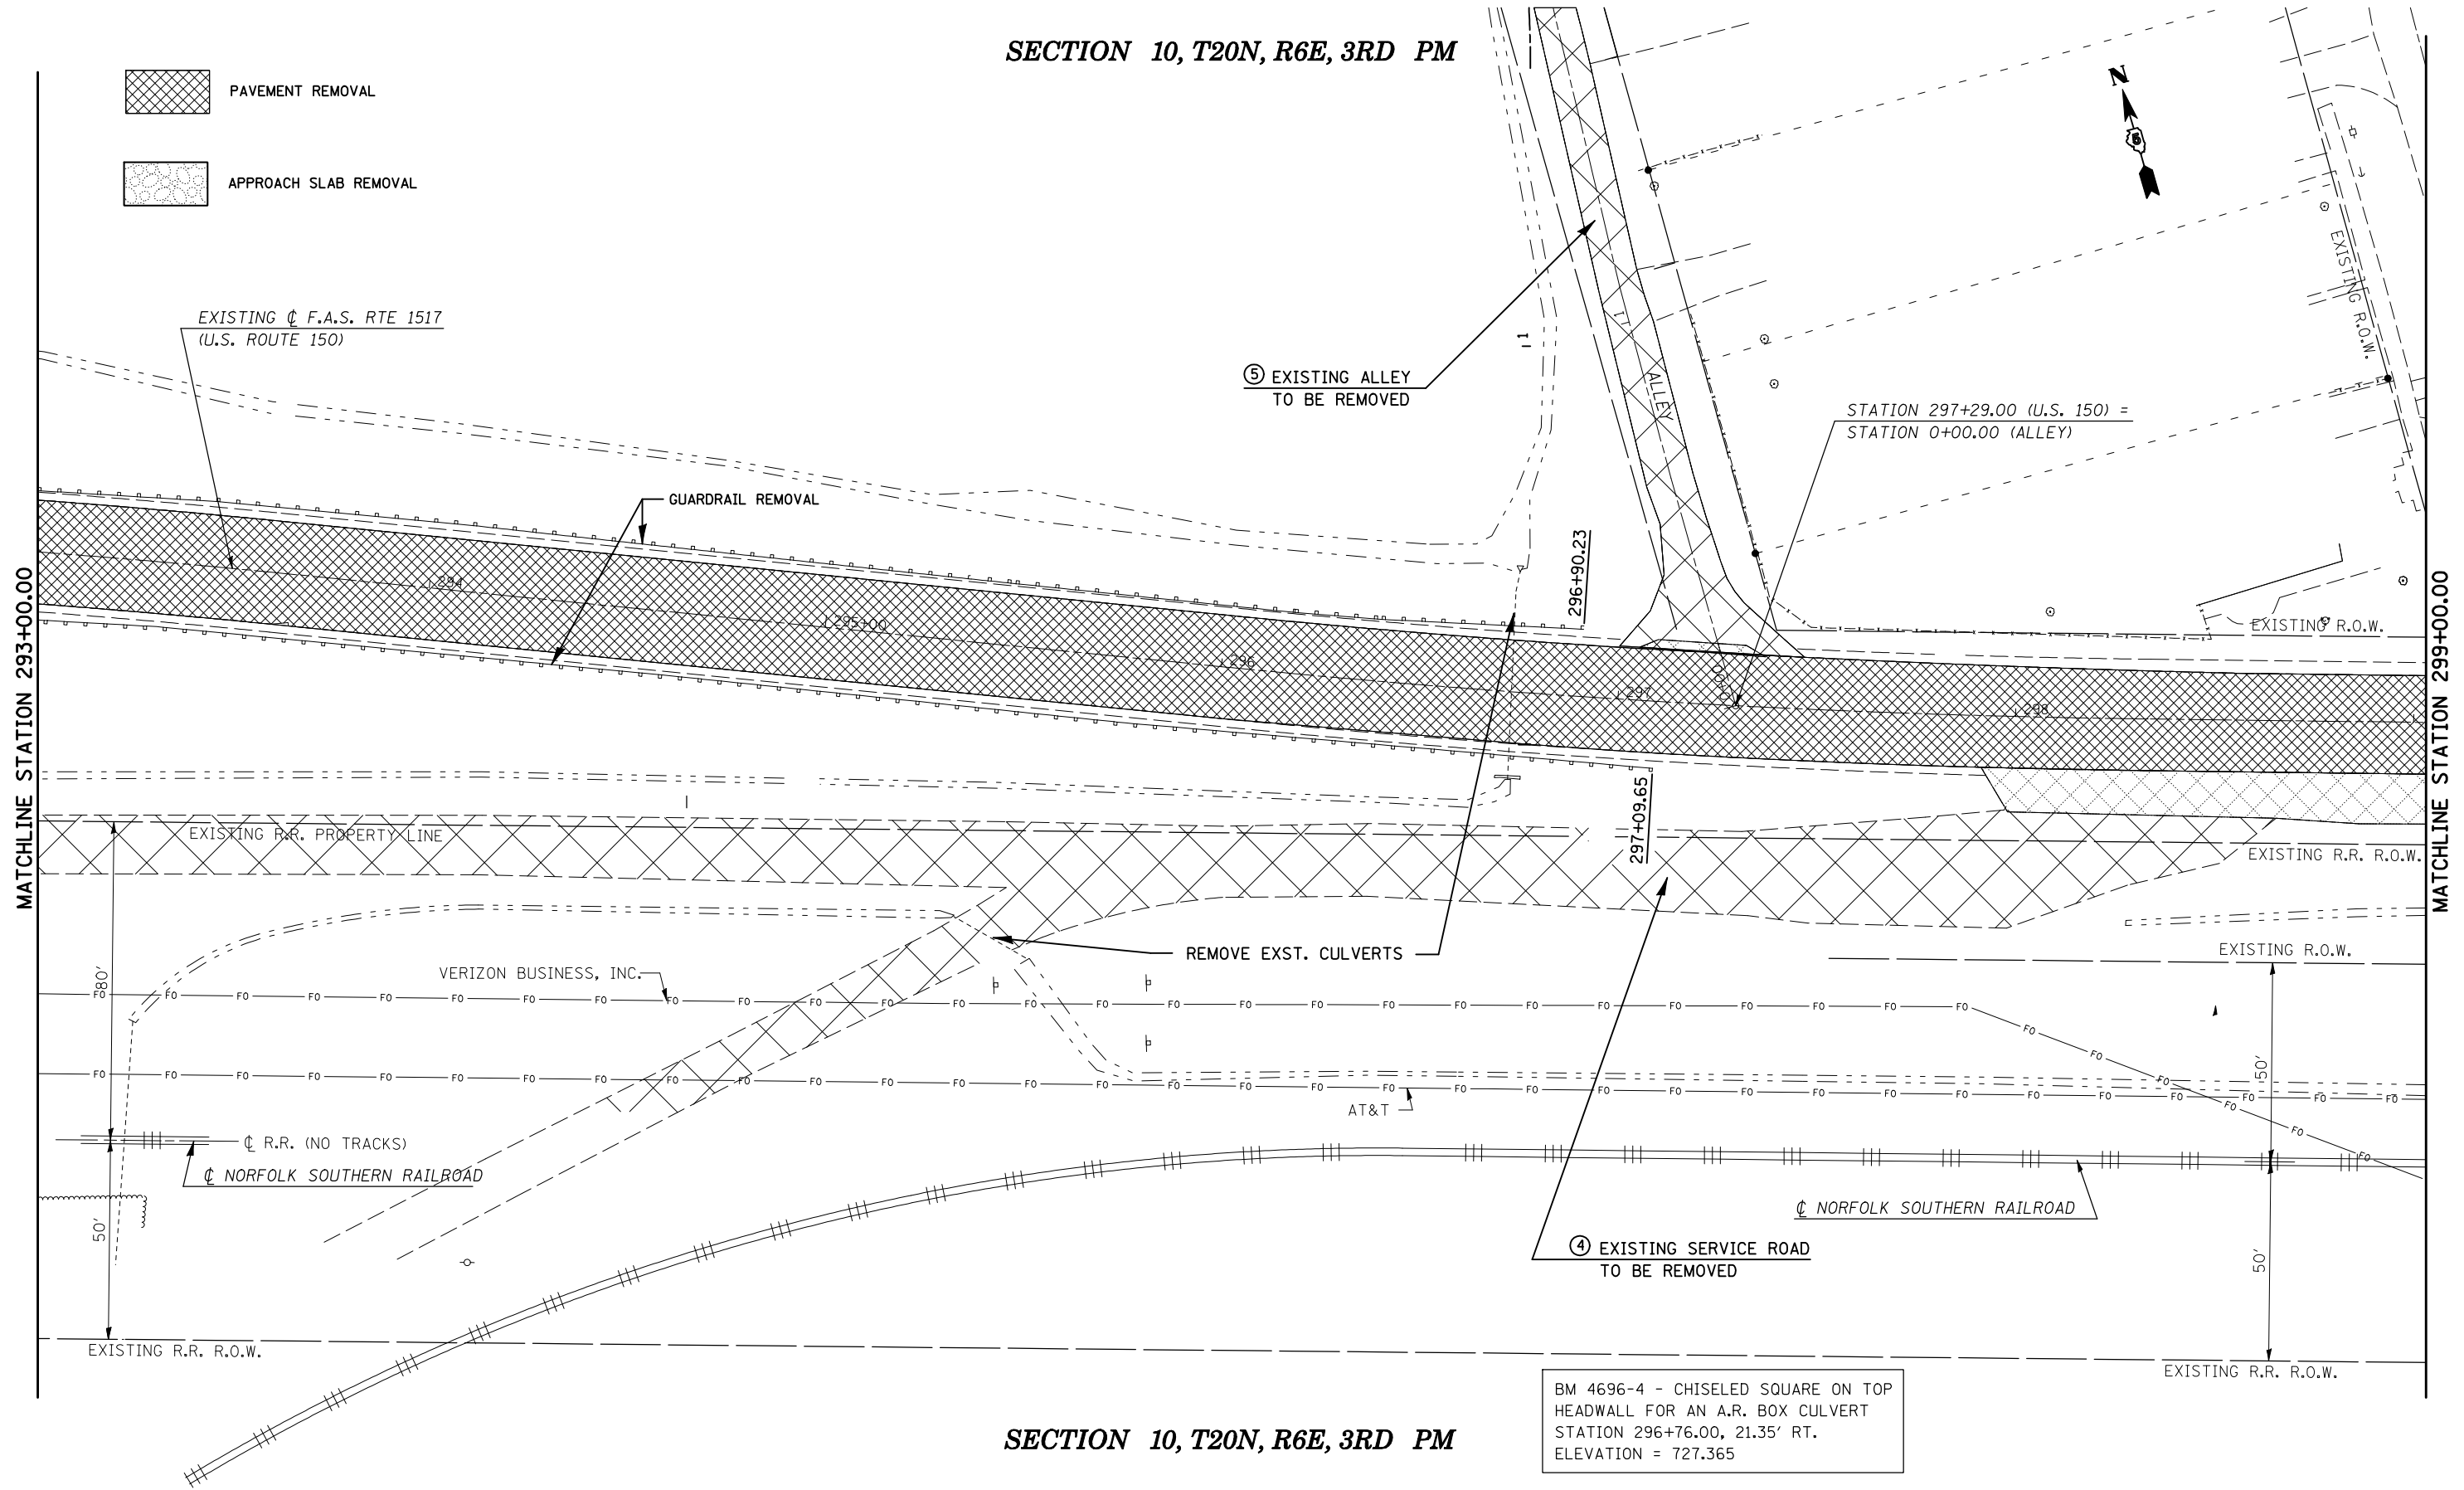

SECTION 10, T20N, R6E, 3RD PM

BM 4696-4 - CHISELED SQUARE ON TOP HEADWALL FOR AN A.R. BOX CULVERT
 STATION 296+76.00, 21.35' RT.
 ELEVATION = 727.365

FILE NAME =	USER NAME = shererjm	DESIGNED - JMS	REVISED -
ct:\pw\work\PWIDOT\SHERERJM\dms86674\0570388-shr-rem.dgn		DRAWN - JMS	REVISED -
	PLOT SCALE = 40.0000' / IN.	CHECKED -	REVISED -
	PLOT DATE = 10/13/2009	DATE - 051909	REVISED -

STATE OF ILLINOIS
 DEPARTMENT OF TRANSPORTATION


REMOVAL DETAILS

SCALE: 1" = 20' SHEET NO. 7 OF 8 SHEETS STA. 293+00.00 TO STA. 299+00.00


F.A.S. RTE.	SECTION	COUNTY	TOTAL SHEETS	SHEET NO.
1517	12VBR-1	PIATT	168	57
CONTRACT NO. 70388				
FED. ROAD DIST. NO. ILLINOIS FED. AID PROJECT				

SECTION 10, T20N, R6E, 3RD PM

VILLAGE OF MANSFIELD

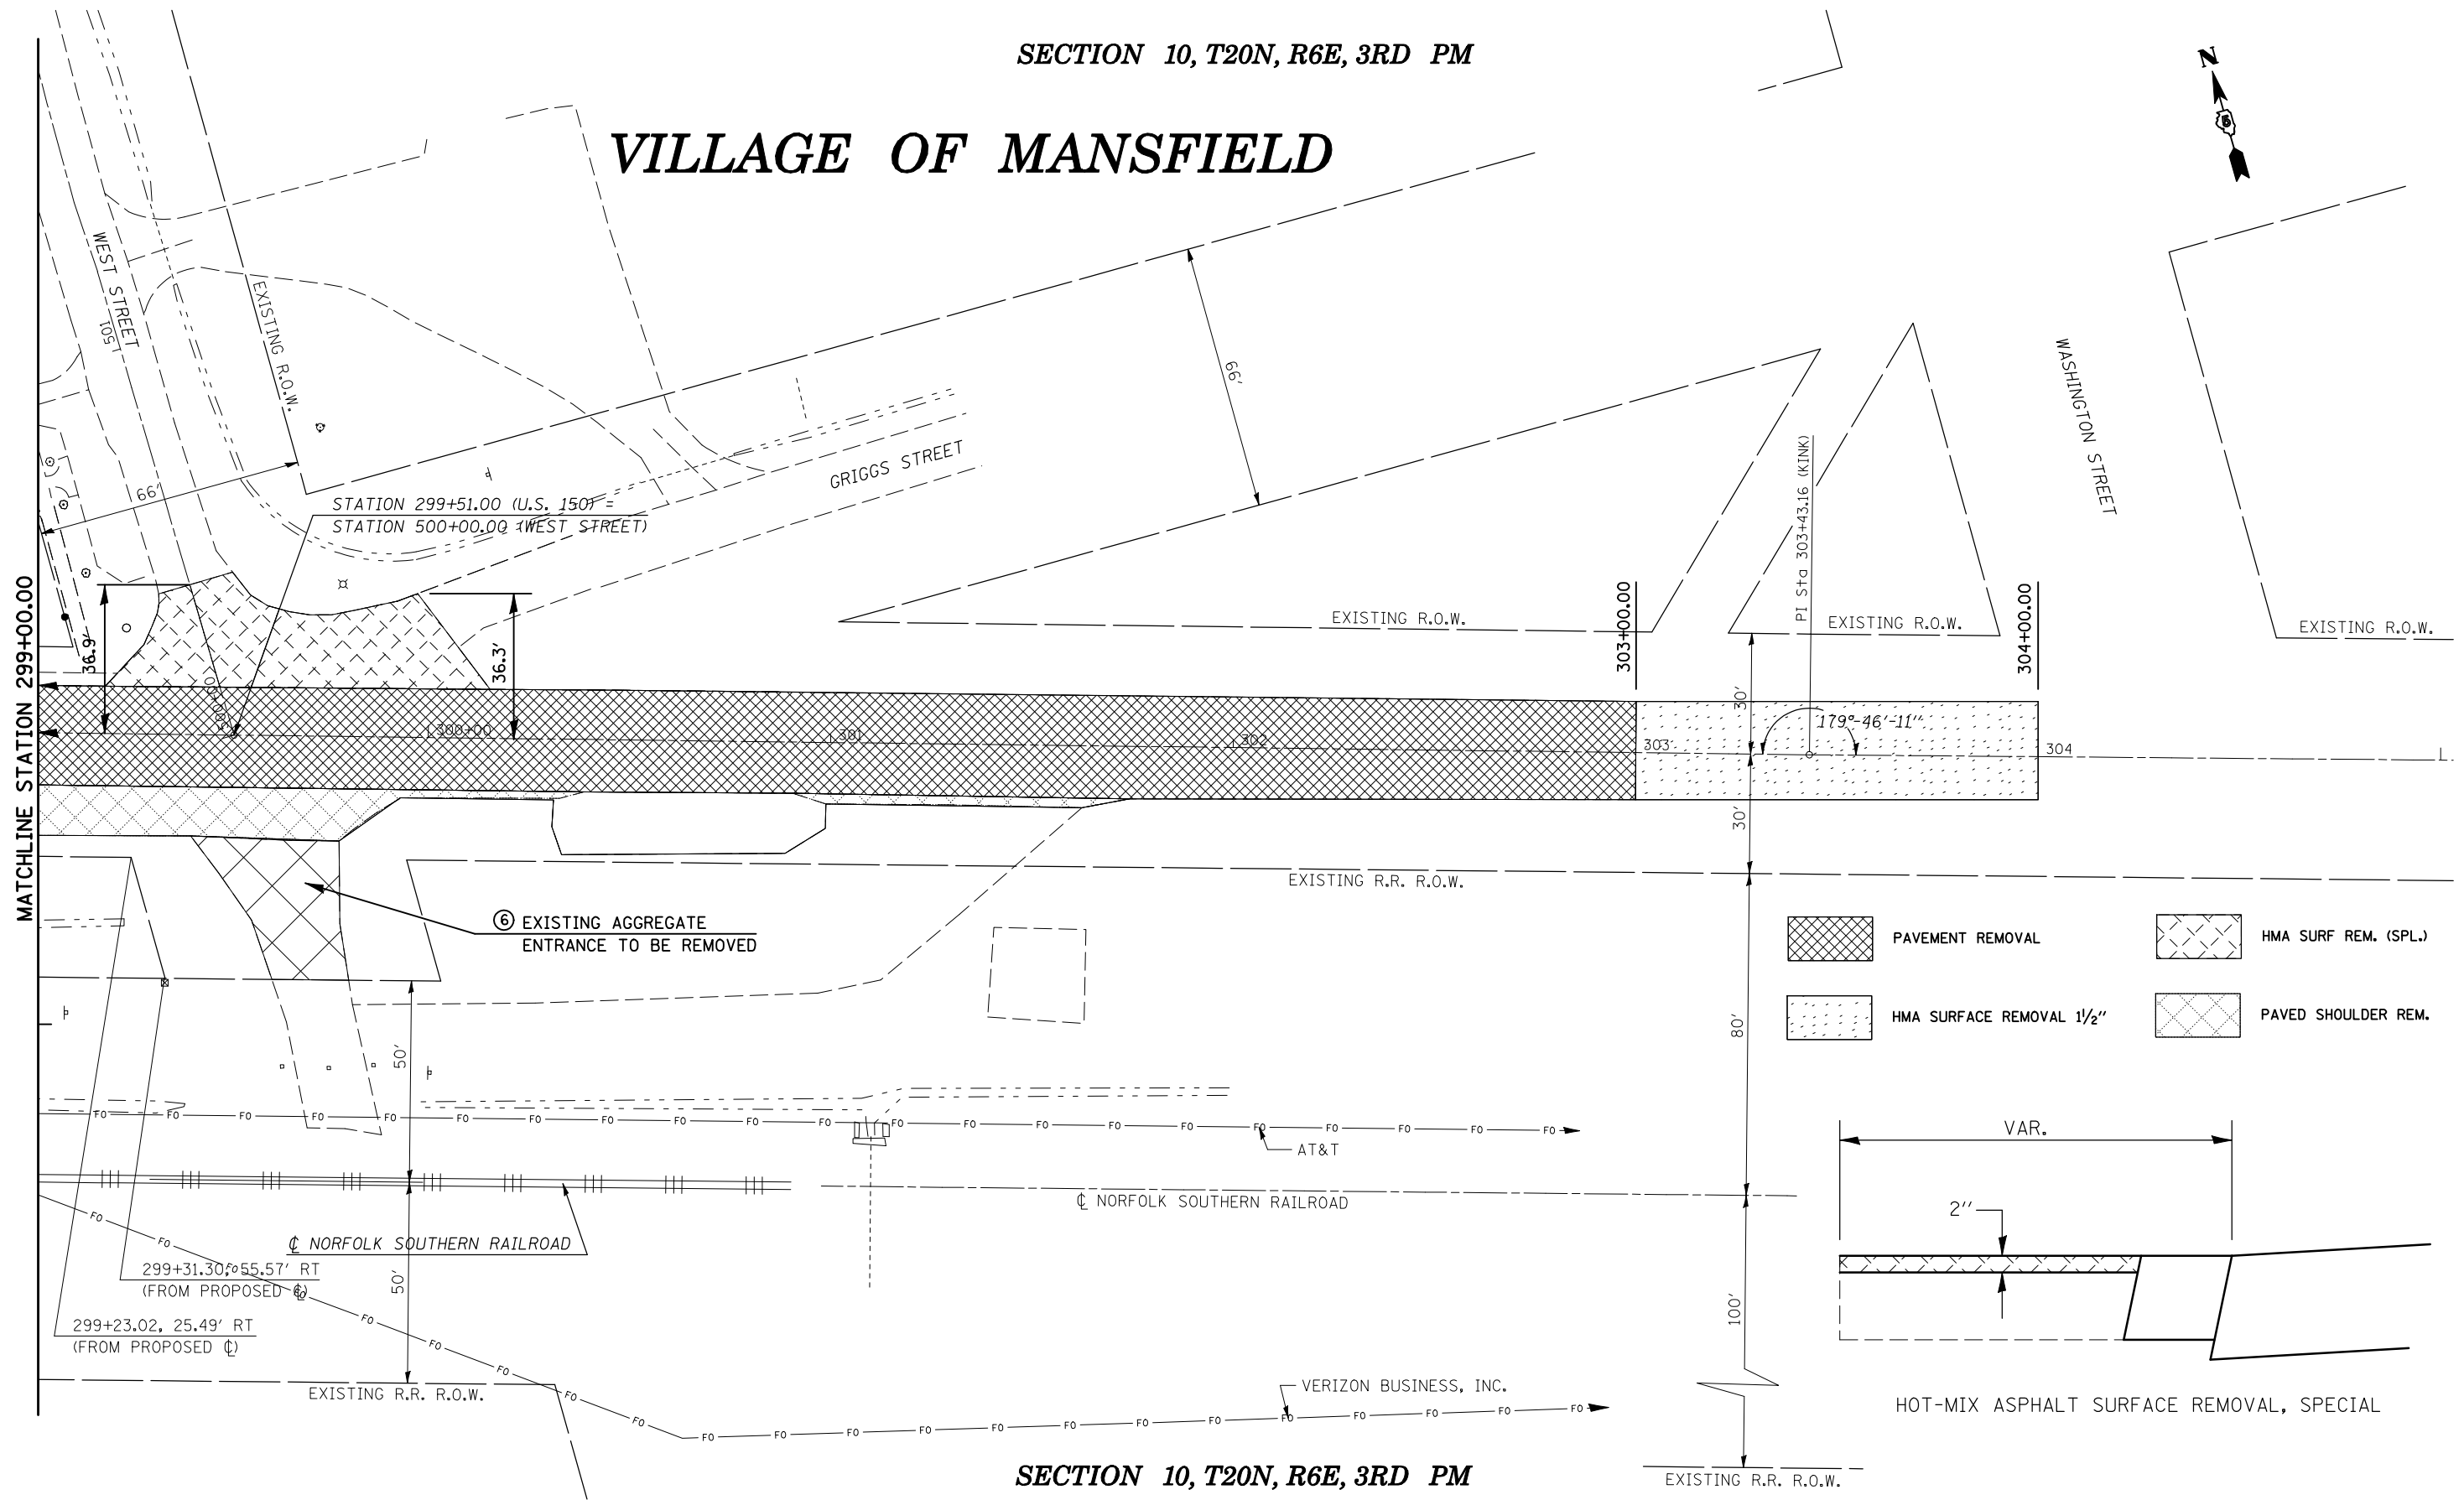

- PAVEMENT REMOVAL
- HMA SURF REM. (SPL.)
- HMA SURFACE REMOVAL 1/2"
- PAVED SHOULDER REM.

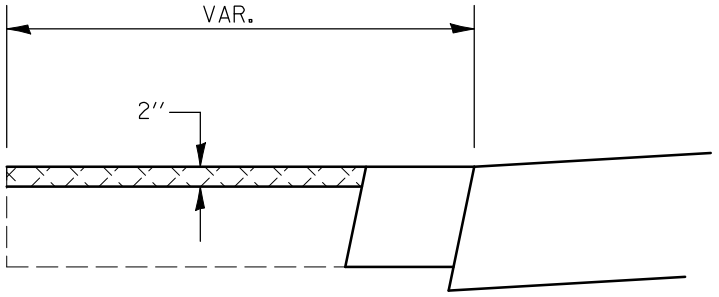

SECTION 10, T20N, R6E, 3RD PM

FILE NAME =	USER NAME = shererjm	DESIGNED - JMS	REVISED -
ct:\pw\work\PIWIDOT\SHERERJM\dms86674\0570388-sht-rem.dgn		DRAWN - JMS	REVISED -
	PLOT SCALE = 40.0000' / IN.	CHECKED -	REVISED -
	PLOT DATE = 10/13/2009	DATE - 051909	REVISED -

STATE OF ILLINOIS
DEPARTMENT OF TRANSPORTATION

REMOVAL DETAILS

SCALE: 1" = 20' SHEET NO. 8 OF 8 SHEETS STA. 299+00.00 TO STA. 304+00.00

F.A.S. RTE.	SECTION	COUNTY	TOTAL SHEETS	SHEET NO.
1517	12VBR-1	PIATT	168	58
CONTRACT NO. 70388				
FED. ROAD DIST. NO. ILLINOIS FED. AID PROJECT				

28000305 TEMPORARY DITCH CHECKS

DETAIL NOTES:

1. CLASS 7 SEEDING SHALL BE USED ALONG WITH CLASS 2 SEEDING. IT IS THE INTENT OF THE CLASS 7 SEEDING TO BE PLACED ALONG WITH THE CLASS 2 SEEDING TO PROMOTE ACCELERATED VEGETATION GROWTH.

2. THE LOCATIONS OF PERIMETER EROSION BARRIER AND THE TEMPORARY DITCH CHECKS MAY BE ADJUSTED BY THE ENGINEER DUE TO DIFFERING FIELD CONDITIONS.

3. EROSION CONTROL BLANKET SHALL BE USED IN THE AREAS WHERE THE FORESLOPES ARE 1:2 OR STEEPER. MULCH METHOD 2 SHALL BE USED IN ALL OTHER AREAS WHERE SEEDING IS SPECIFIED ON THE DETAILS AND AS SHOWN ON THE CROSS-SECTIONS.

STATION	O/S	EACH
US 150		
273+00.00	23.14' LT	1.0
273+00.00	23.40' RT	1.0
276+00.00	26.91' LT	1.0
276+00.00	28.90' RT	1.0
278+00.00	27.80' LT	1.0
278+00.00	28.60' RT	1.0
280+50.00	30.97' LT	1.0
280+50.00	26.48' RT	1.0
283+00.00	71.40' LT	1.0
283+00.00	45.45' RT	1.0
285+50.00	92.97' LT	1.0
285+50.00	63.21' RT	1.0
288+00.00	65.40' RT	1.0
290+50.00	71.50' RT	1.0
293+00.00	88.30' RT	1.0
295+00.00	77.06' LT	1.0
295+00.00	62.20' RT	1.0
297+50.00	29.70' RT	1.0
298+00.00	23.30' LT	1.0
301+50.00	18.07' LT	1.0
304+00.00	19.48' LT	1.0
304+00.00	29.93' RT	1.0
SUB-TOTAL =		22.0

STATION	O/S	EACH
ALLEY		
0+50.00	37.4' LT	1.0
3+00.00	19.27' LT	1.0
SUB-TOTAL =		2.0
TOTAL =		24.0

AVERAGE LENGTH = 6.0

TOTAL LENGTH = 144.0

28000400 PERIMETER EROSION BARRIER

STATION	TO	STATION	FOOT
US 150			
LT 273+00.00		LT 288+73.60	1678.6
RT 273+00.00		RT 289+12.99	1628.3
LT 297+36.86		LT 304+00.00	574.4
RT 289+75.00		RT 304+00.00	1448.8
SUB-TOTAL =			5330.1
ALLEY			
RT 0+28.63		RT 4+00.00	286.4
RT 4+00.00		RT 289+28.11	470.8
SUB-TOTAL =			757.2
TOTAL =			6087.3
USE =			6087.0

LANDSCAPING SCHEDULE

STATION	TO	STATION	AREA ACRE
US 150			
LT 276+00.00		LT 289+00.00	1.7
RT 276+00.00		RT 289+00.00	1.6
LT 289+50.00		LT 304+00.00	1.8
RT 289+50.00		RT 304+00.00	2.0

STATION	TO	STATION	AREA ACRE
ALLEY			
LT 0+37.50		LT 3+75.00	0.2
RT 0+37.50		RT 3+75.00	0.1

SUB-TOTAL =

SUB-TOTAL =

TOTAL =

USE =

28000500 INLET AND PIPE PROTECTION

STATION	O/S	EACH
US 150		
275+00.00	20.72' LT	1.0
ALLEY		
1+52.04	23.00' RT	1.0
TOTAL =		2.0

28000250 TEMPORARY EROSION SEEDING	25000200 SEEDING CLASS 2	25000350 SEEDING CLASS 7	25000400 NITROGEN FERT. NUT. POUNDS	25000500 PHOSP. FERT. NUT. POUNDS	25000600 POTAS. FERT. NUT. POUNDS	25100115 MULCH METHOD 2 ACRE	25100630 EROSION CONTROL BLANKET SQ YD
SUB-TOTAL =							
TOTAL =							
USE =							

FILE NAME =	USER NAME = shererjm	DESIGNED - CMS	REVISED -
ct:\pw\work\PIWIDOT\SHERERJM\dms86674\0570388-shr-eros.dgn		DRAWN - JRP	REVISED -
	PLOT SCALE = 40.0000' / IN.	CHECKED -	REVISED -
	PLOT DATE = 10/13/2009	DATE - 03-25-2008	REVISED -


STATE OF ILLINOIS
DEPARTMENT OF TRANSPORTATION

SCHEDULE OF EROSION CONTROL


SCALE: 1" = 20' SHEET NO. 1 OF 9 SHEETS STA. TO STA.

F.A.S. RTE.	SECTION	COUNTY	TOTAL SHEETS	SHEET NO.
1517	12VBR-1	PIATT	168	59
FED. ROAD DIST. NO.			ILLINOIS FED. AID PROJECT	
			CONTRACT NO. 70388	

SECTION 3, T20N, R6E, 3RD PM

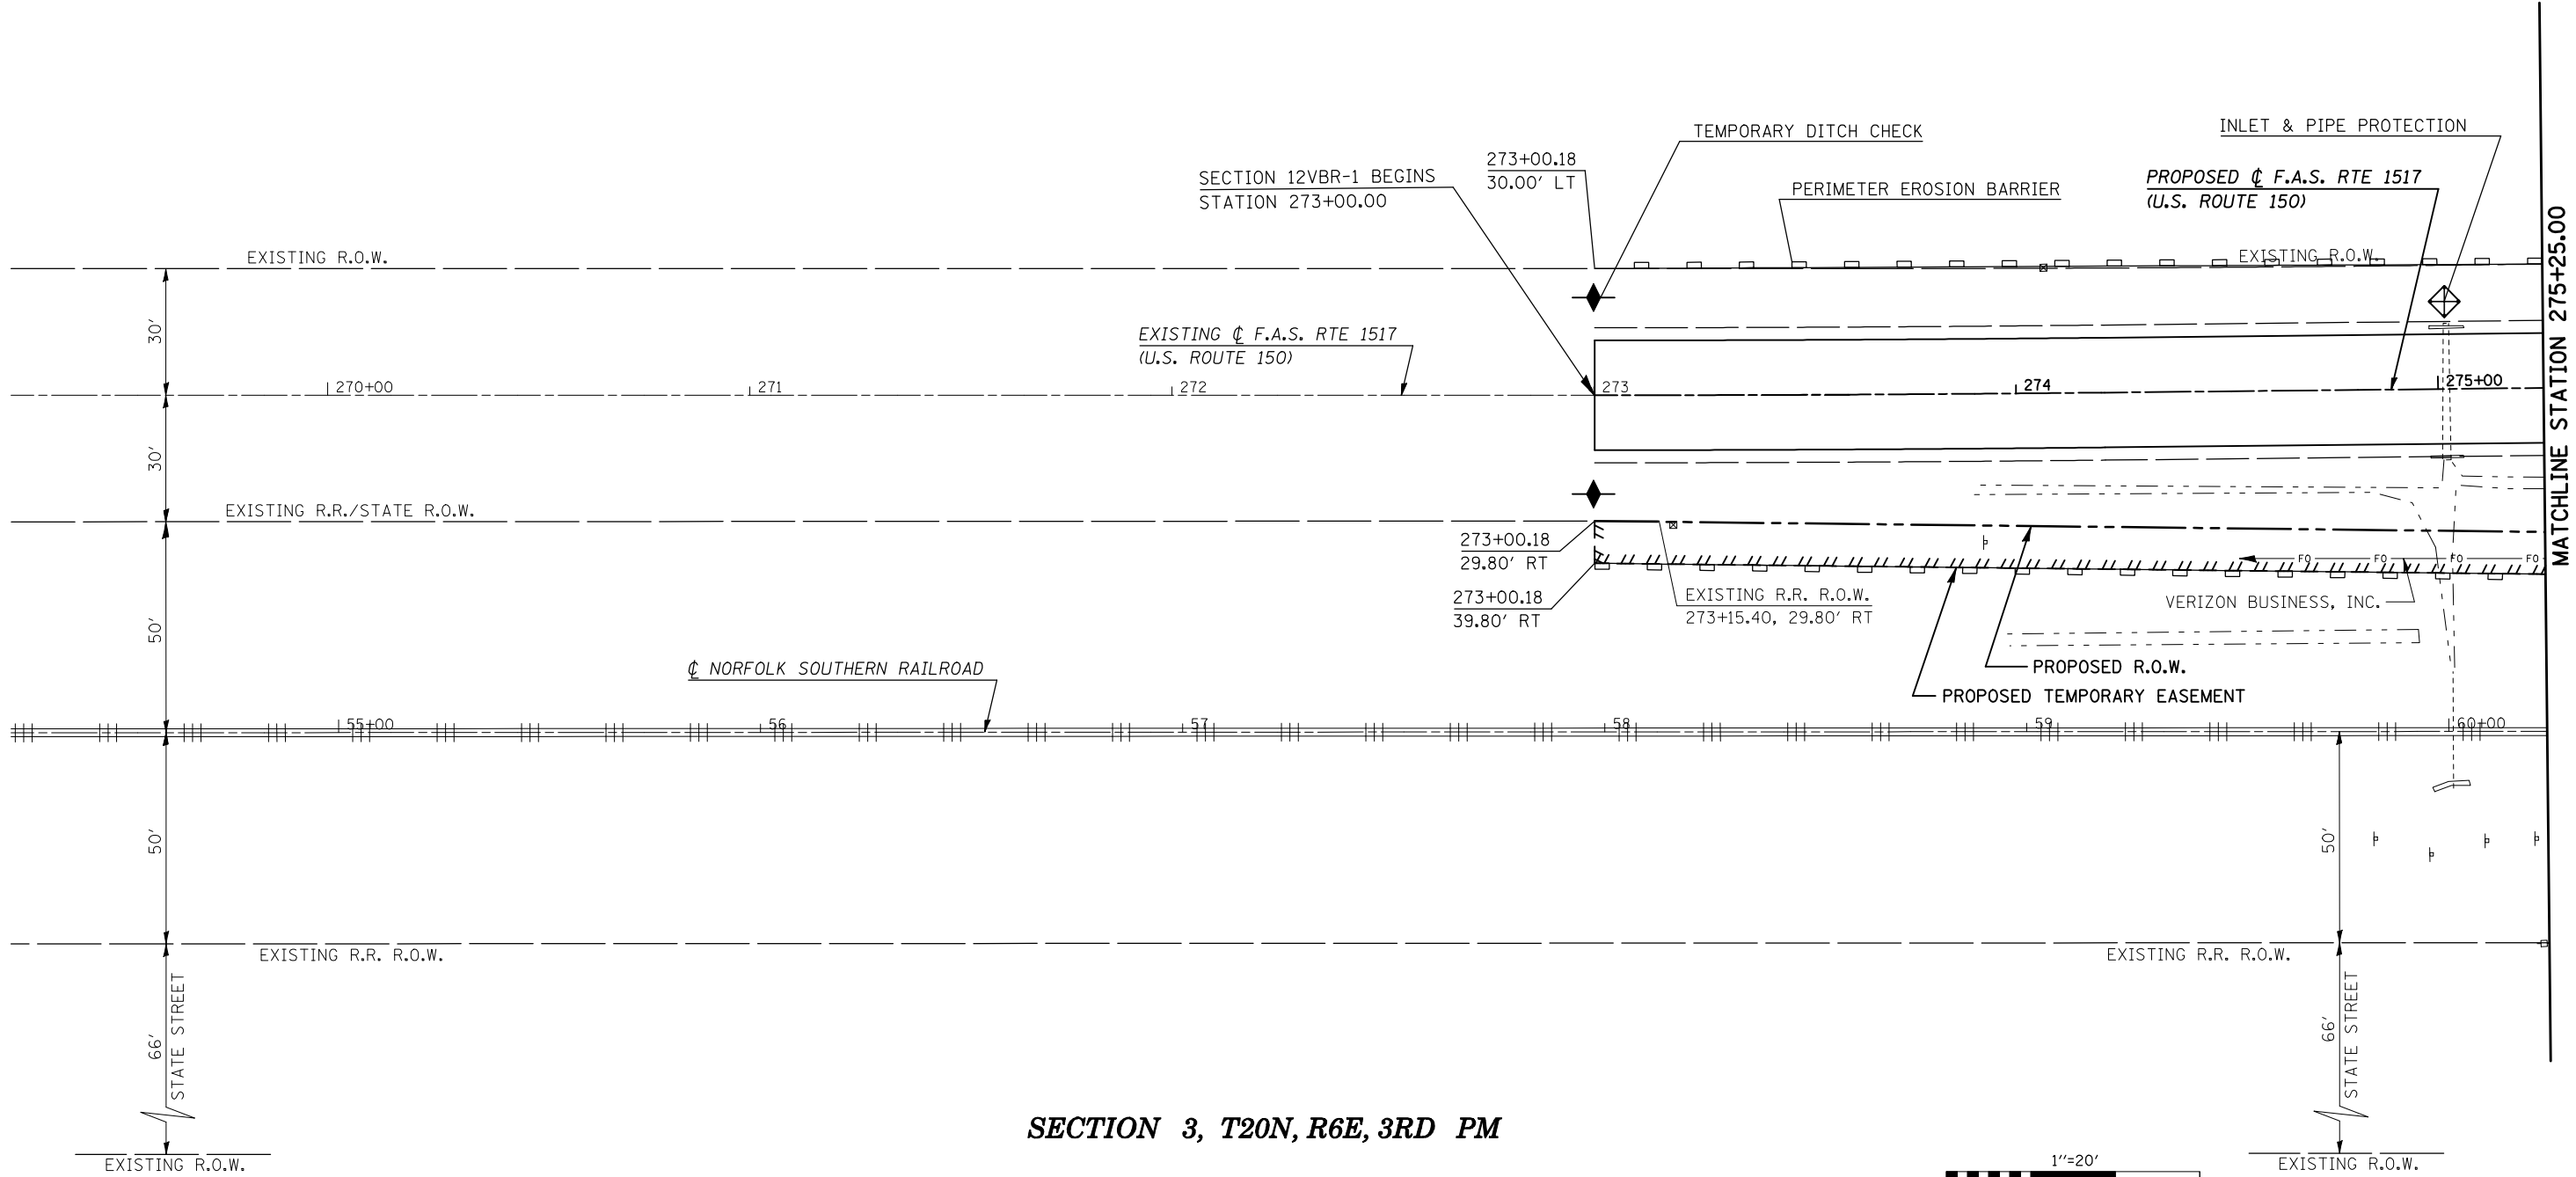

SECTION 3, T20N, R6E, 3RD PM

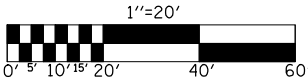


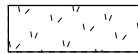

FILE NAME =	USER NAME = shererjm	DESIGNED - CMS	REVISED -
ct:\pw\work\PIWIDOT\SHERERJM\dms86674\0570388-shr-eros.dgn		DRAWN - JRP	REVISED -
	PLOT SCALE = 40.0000' / IN.	CHECKED -	REVISED -
	PLOT DATE = 10/13/2009	DATE - 03-25-2008	REVISED -

STATE OF ILLINOIS
DEPARTMENT OF TRANSPORTATION


EROSION CONTROL DETAILS

SCALE: 1" = 20' SHEET NO. 2 OF 9 SHEETS STA. TO STA.


F.A.S. RTE.	SECTION	COUNTY	TOTAL SHEETS	SHEET NO.
1517	12VBR-1	PIATT	168	60
CONTRACT NO. 70388				
FED. ROAD DIST. NO. ILLINOIS FED. AID PROJECT				

-  SEEDING, CLASS 2
-  SEEDING, CLASS 7
-  MULCH, METHOD 2

SECTION 3, T20N, R6E, 3RD PM

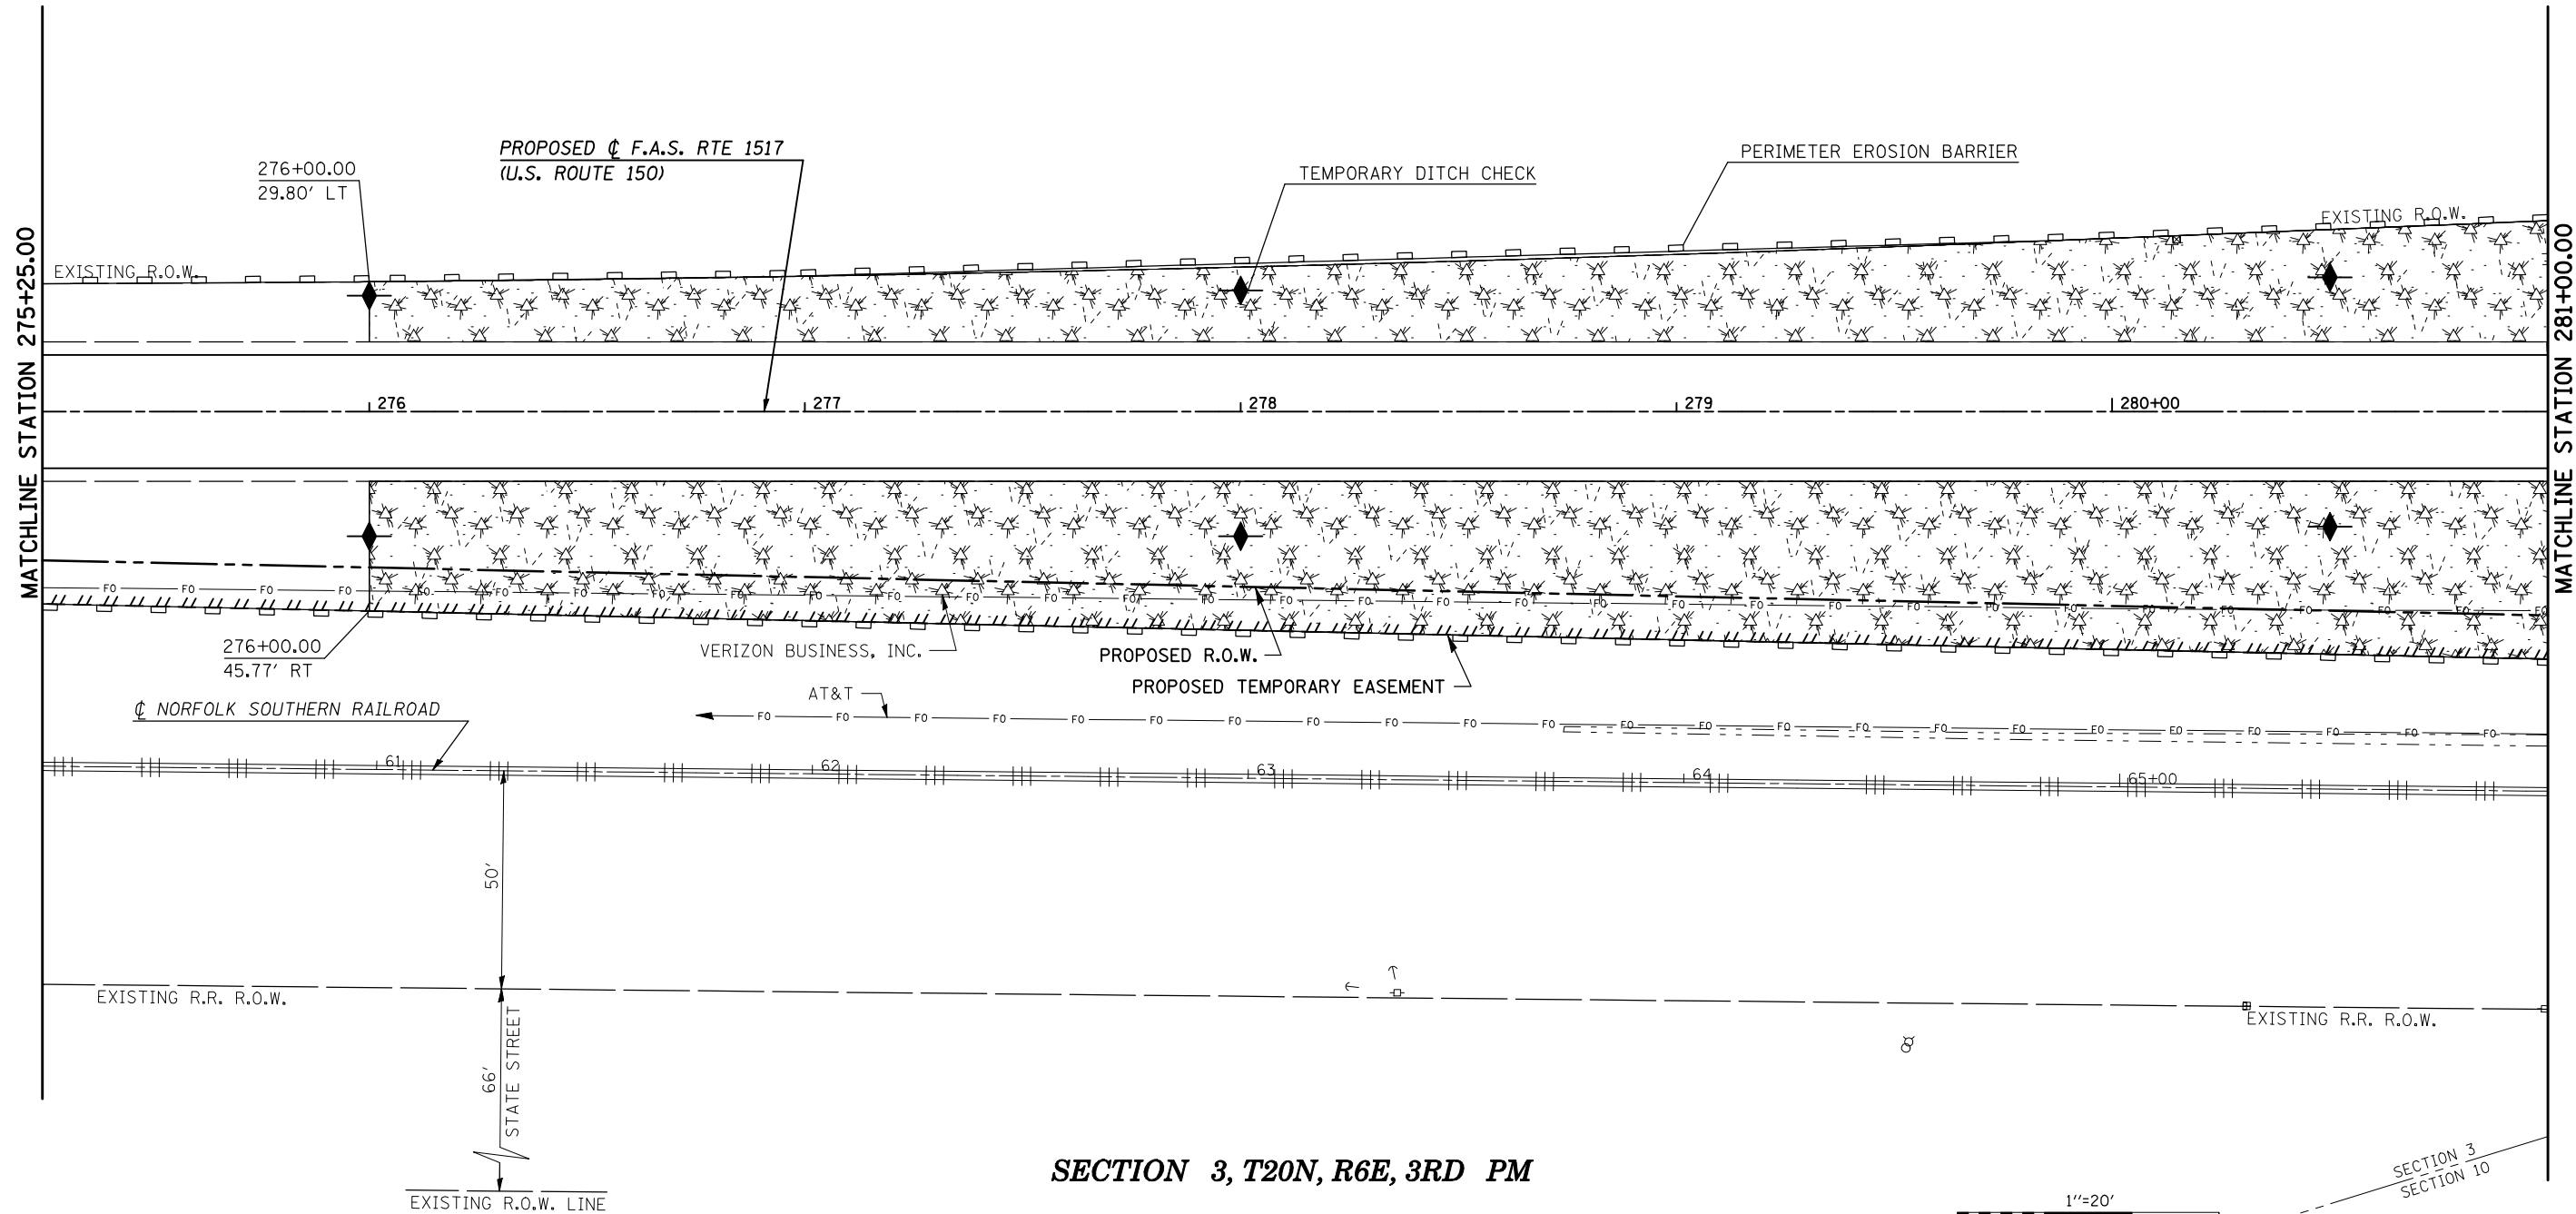

SECTION 3, T20N, R6E, 3RD PM

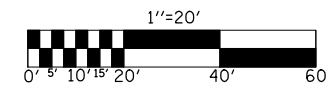

SECTION 3
SECTION 10

FILE NAME = ct:\pw\work\PIWIDOT\SHERERJM\dms86674\0570388-sht-eros.dgn	USER NAME = shererjm	DESIGNED - CMS	REVISED -
		DRAWN - JRP	REVISED -
	PLOT SCALE = 40.0000' / IN.	CHECKED -	REVISED -
	PLOT DATE = 10/13/2009	DATE - 03-25-2008	REVISED -



**STATE OF ILLINOIS
DEPARTMENT OF TRANSPORTATION**

EROSION CONTROL DETAILS


SCALE: 1" = 20' SHEET NO. 3 OF 9 SHEETS STA. TO STA.

F.A.S. RTE.	SECTION	COUNTY	TOTAL SHEETS	SHEET NO.
1517	12VBR-1	PIATT	168	61
CONTRACT NO. 70388				
FED. ROAD DIST. NO. ILLINOIS FED. AID PROJECT				

SECTION 3, T20N, R6E, 3RD PM

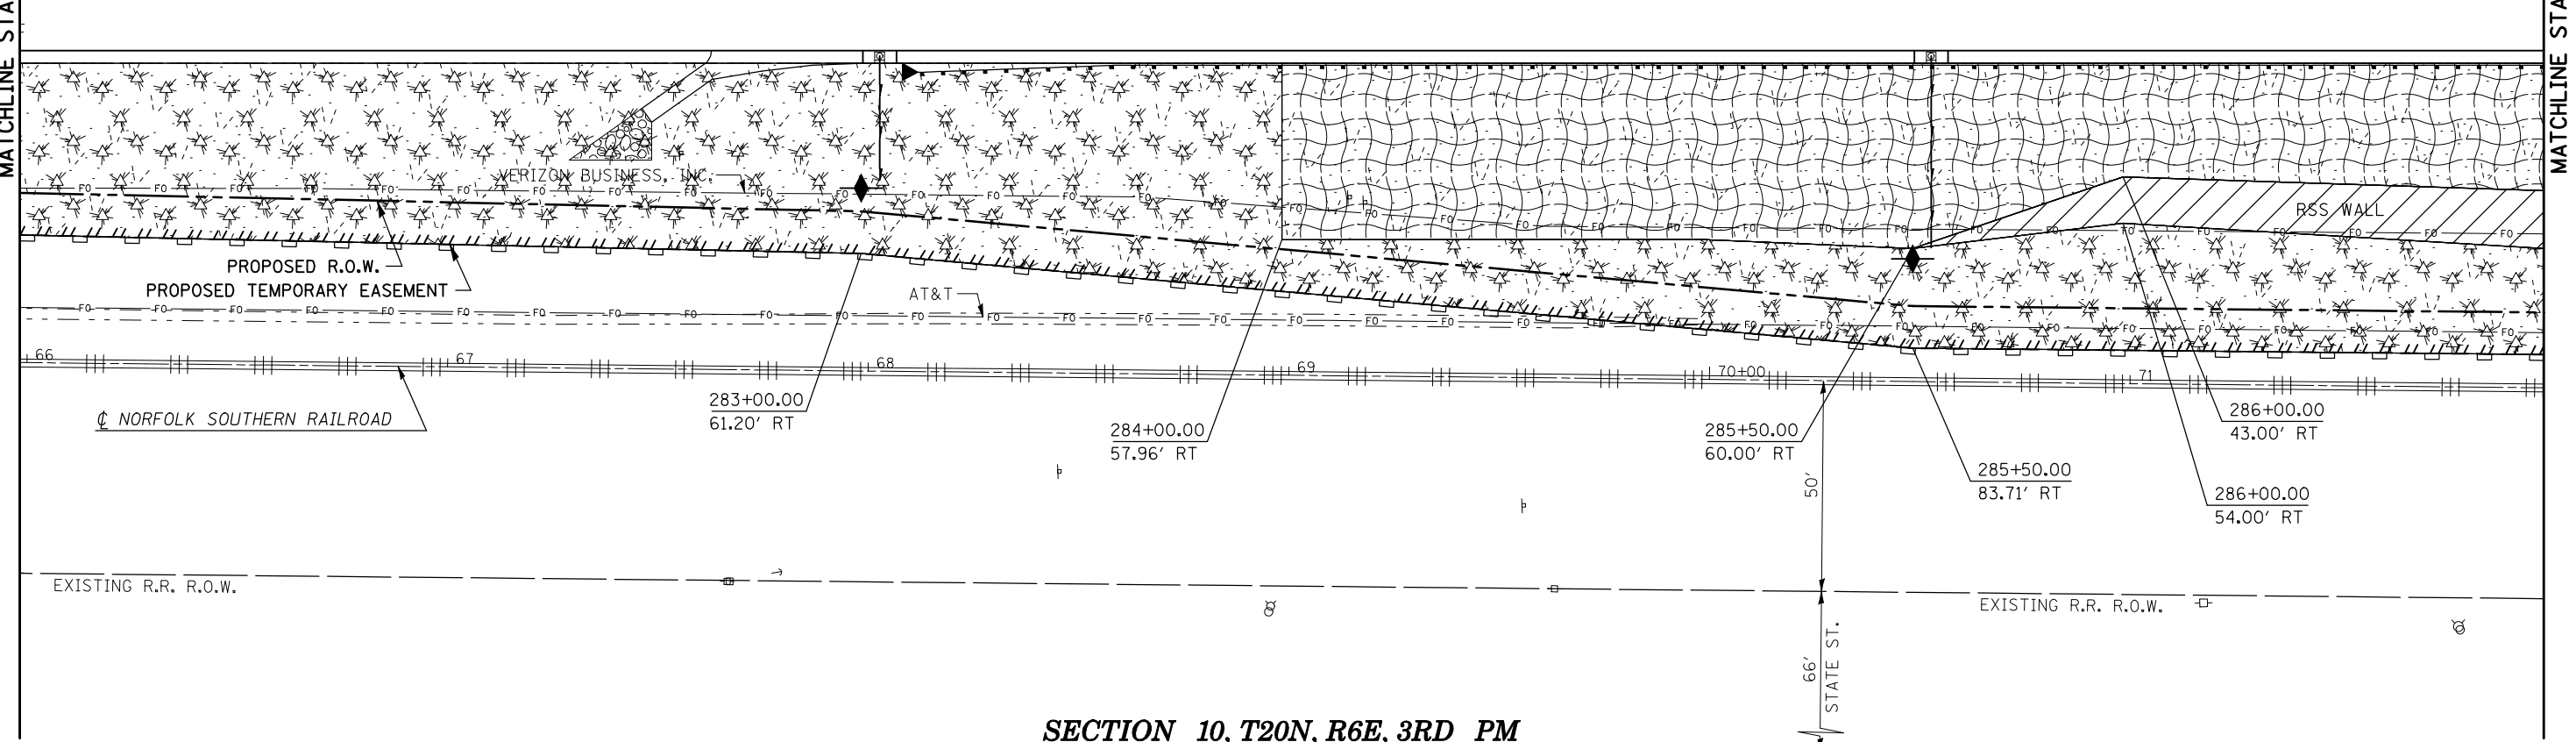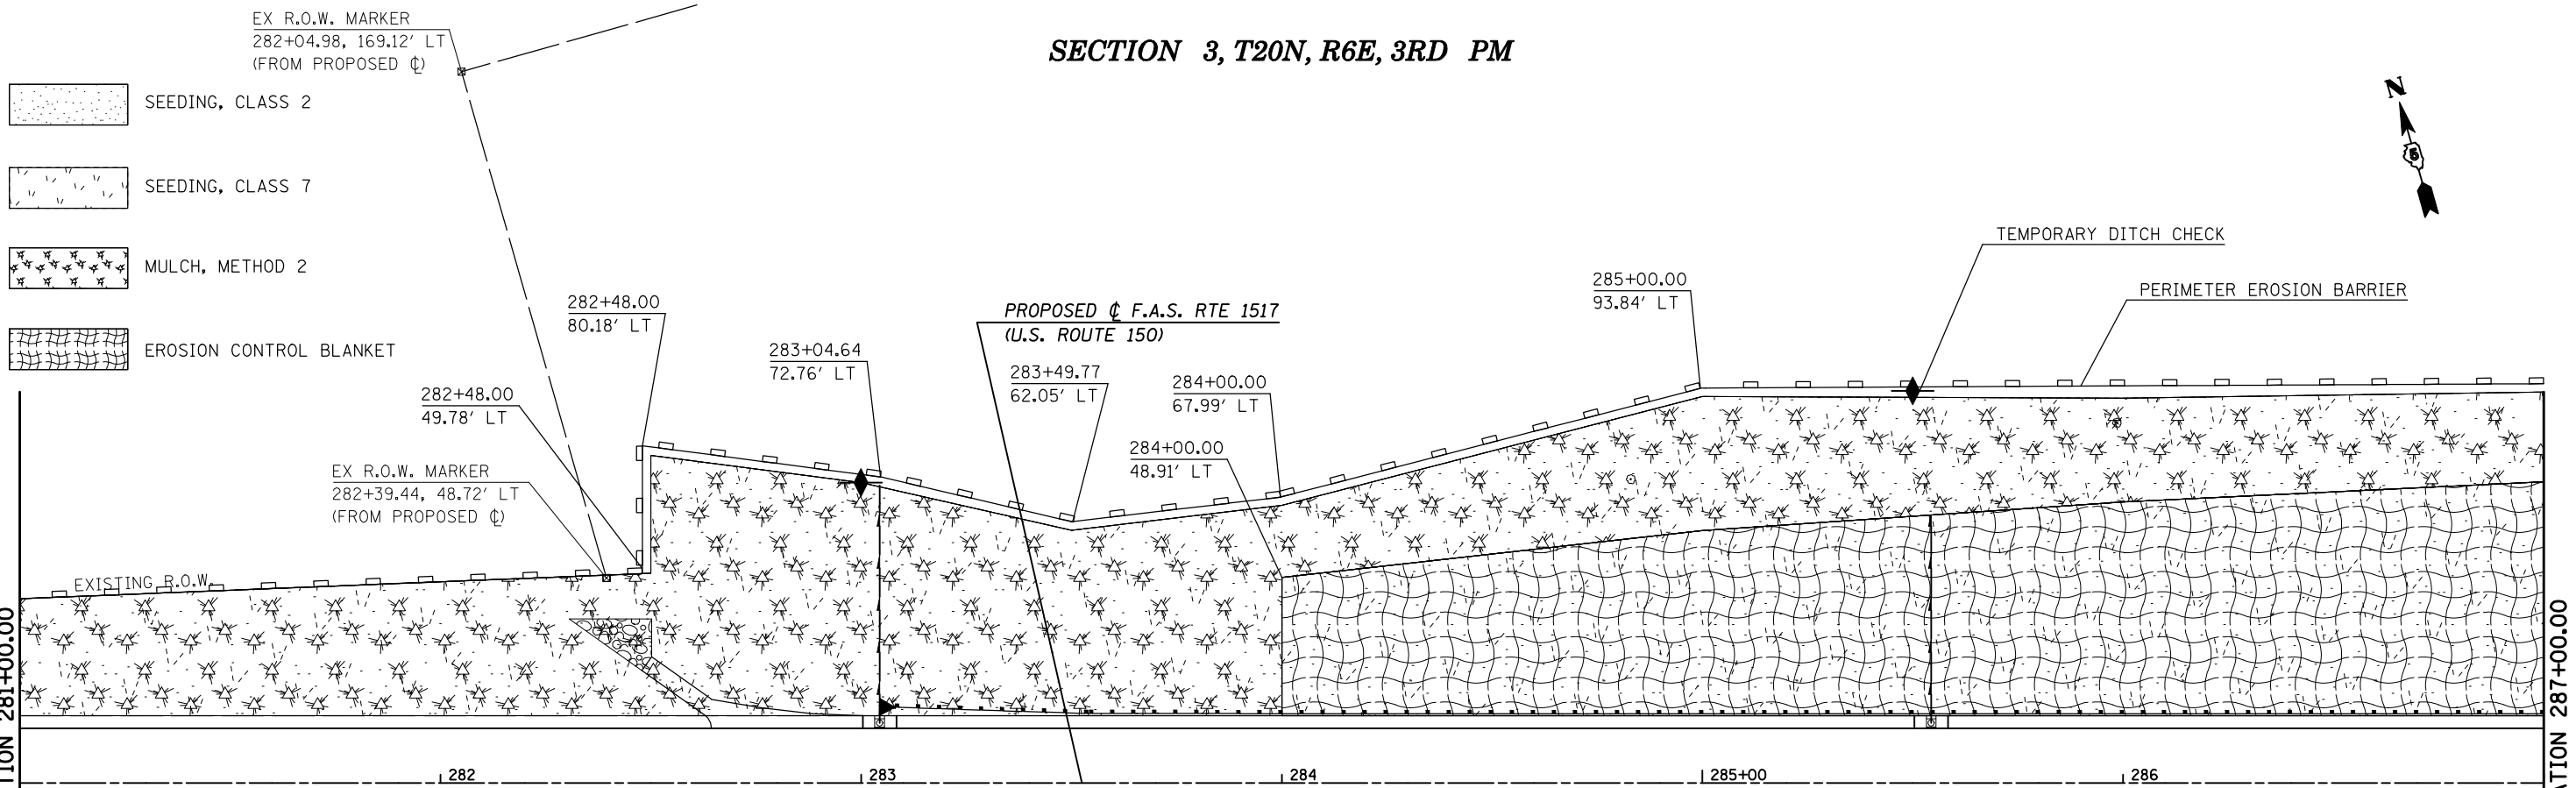

SECTION 10, T20N, R6E, 3RD PM

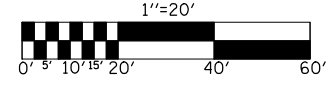

FILE NAME =	USER NAME = shererjm	DESIGNED - CMS	REVISED -
ct:\pw\work\PIWIDOT\SHERRERJM\dms86674\0570388-shr-eros.dgn		DRAWN - JRP	REVISED -
	PLOT SCALE = 40.0000 ' / IN.	CHECKED -	REVISED -
	PLOT DATE = 10/13/2009	DATE - 03-25-2008	REVISED -

**STATE OF ILLINOIS
DEPARTMENT OF TRANSPORTATION**


EROSION CONTROL DETAILS





SCALE: 1" = 20' SHEET NO. 4 OF 9 SHEETS STA. TO STA.



F.A.S. RTE.	SECTION	COUNTY	TOTAL SHEETS	SHEET NO.
1517	12VBR-1	PIATT	168	62
CONTRACT NO. 70388				
FED. ROAD DIST. NO. ILLINOIS FED. AID PROJECT				

SECTION 3, T20N, R6E, 3RD PM

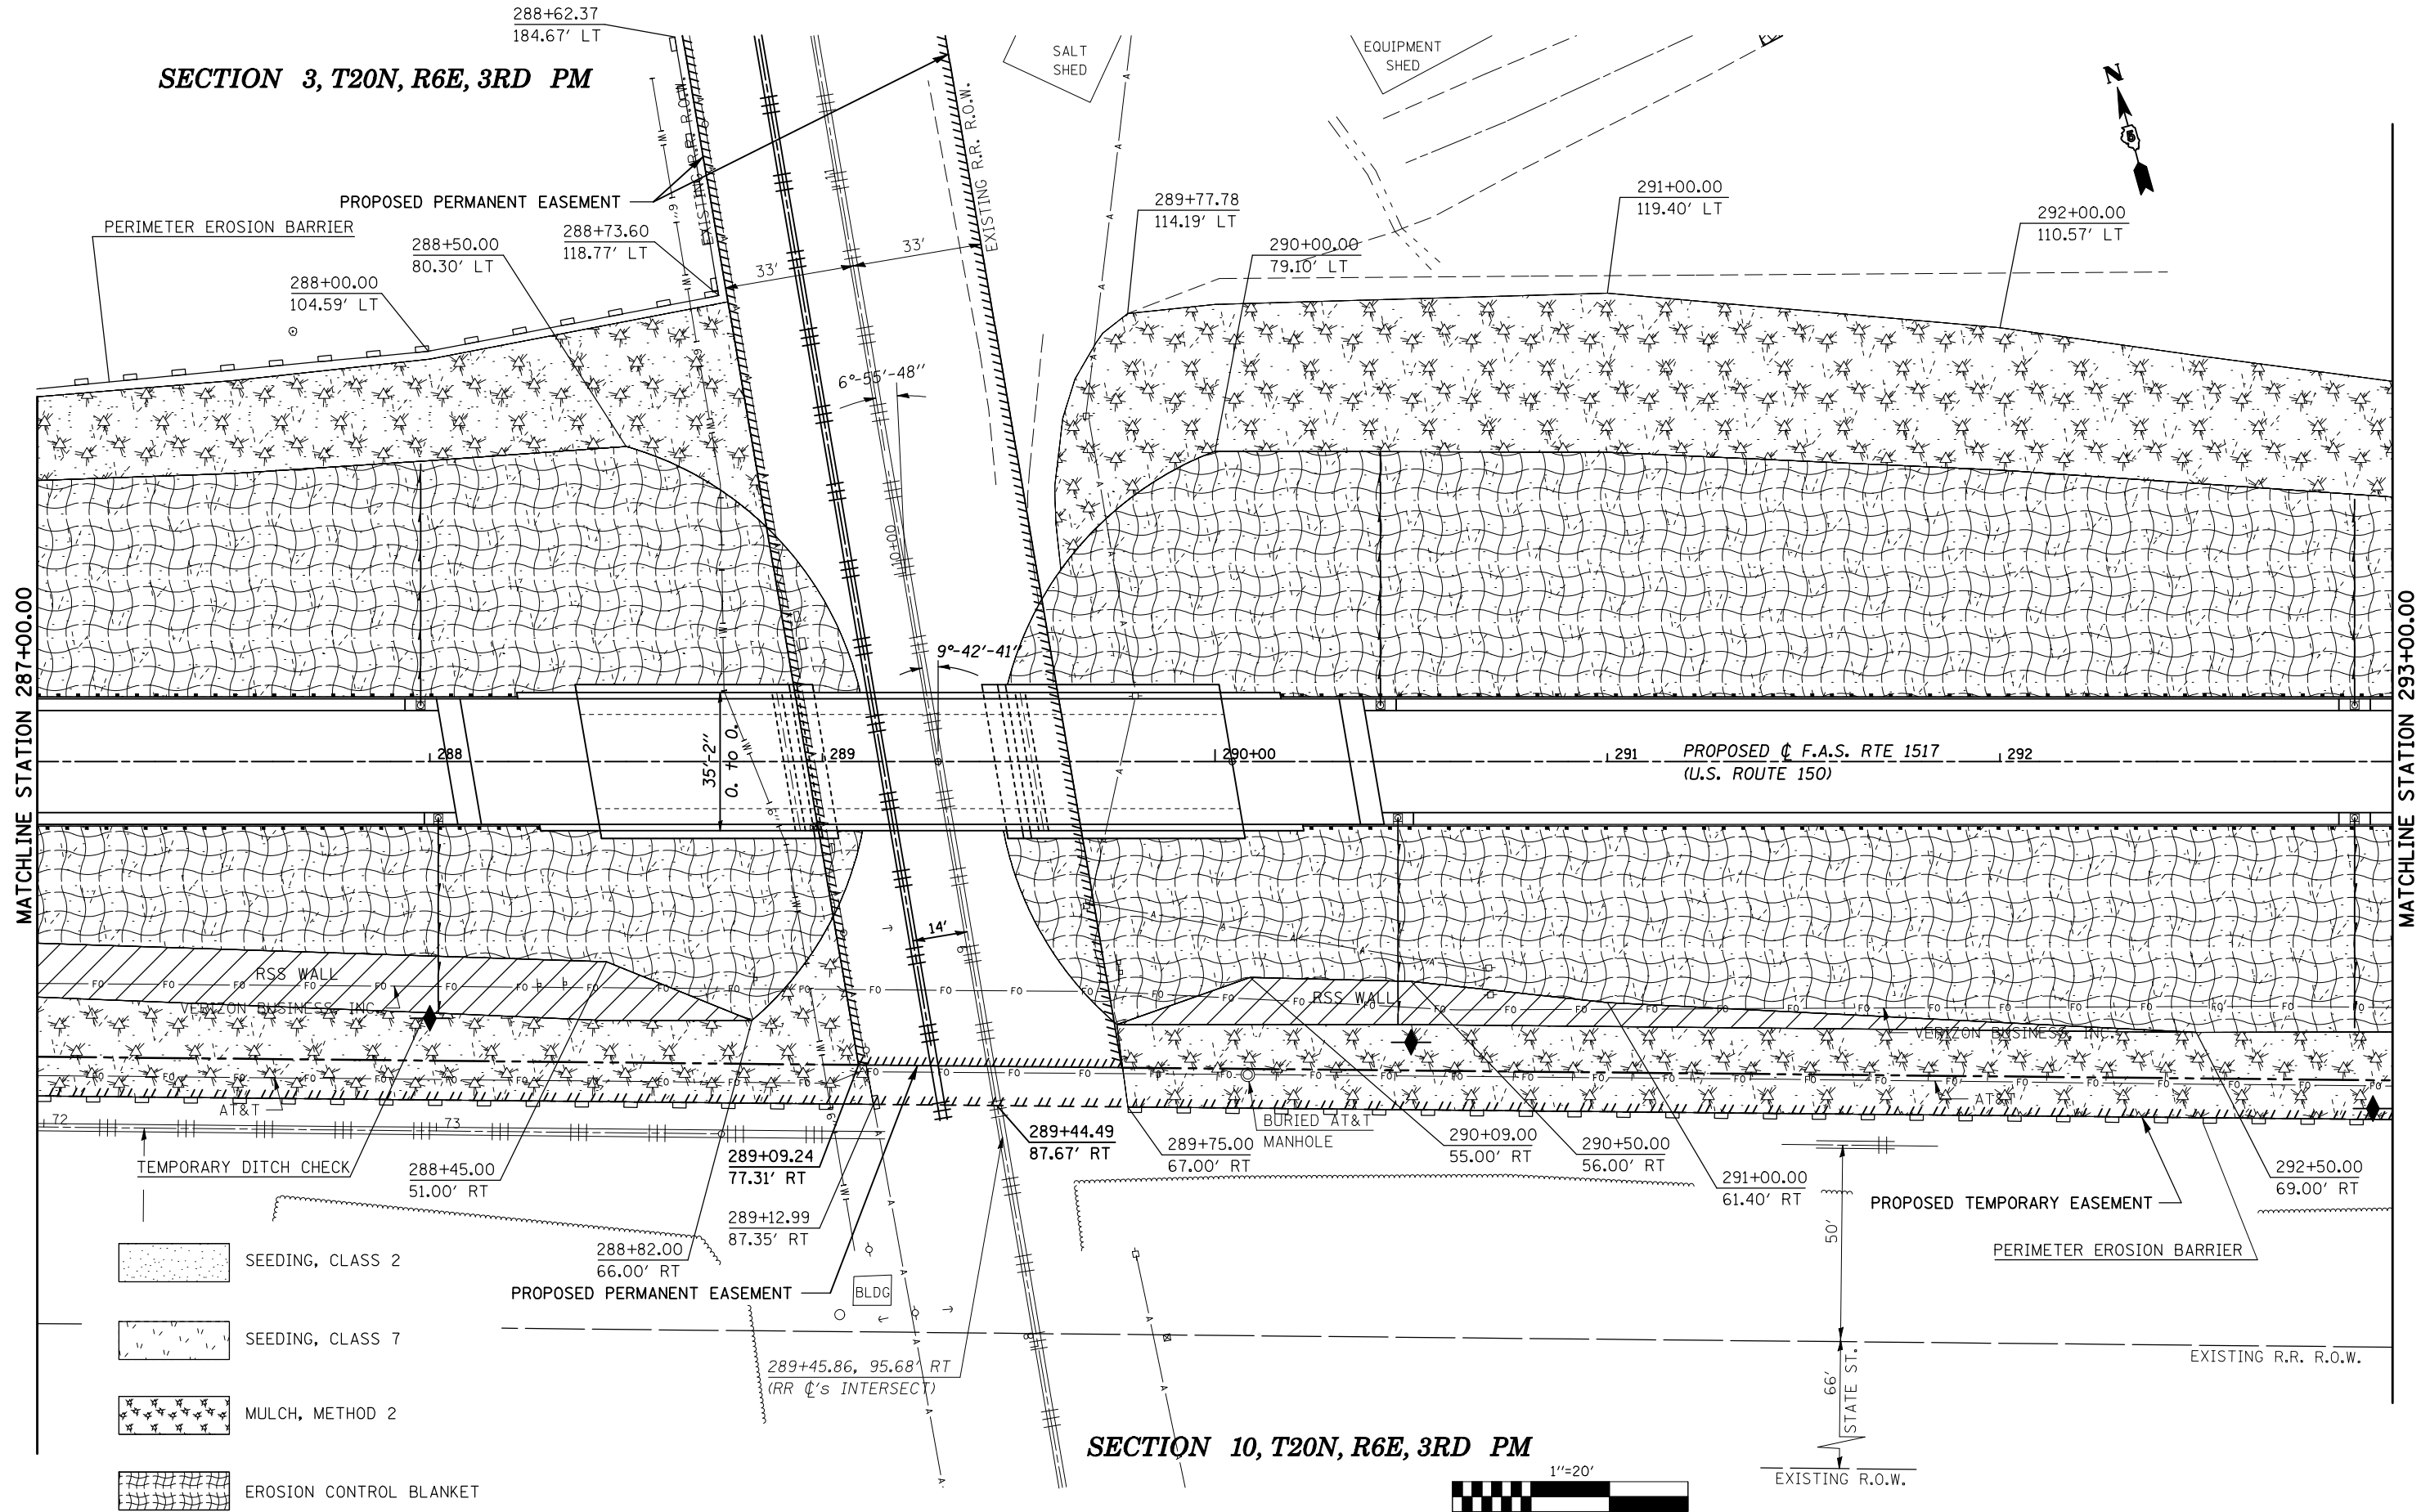SECTION 10, T20N, R6E, 3RD PM

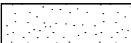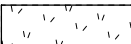

-  SEEDING, CLASS 2
-  SEEDING, CLASS 7
-  MULCH, METHOD 2
-  EROSION CONTROL BLANKET

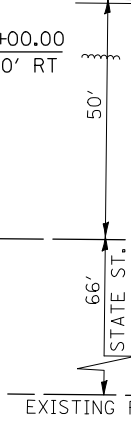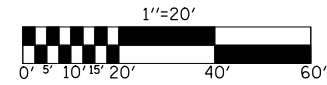

FILE NAME =	USER NAME = shererjm	DESIGNED - CMS	REVISED -
ct:\pw\work\PWIDOT\SHERERJM\dms86674\0570388-sht-eros.dgn	70388-sht-eros.dgn	DRAWN - JRP	REVISED -
PLOT SCALE = 40.0000' / IN.		CHECKED -	REVISED -
PLOT DATE = 10/13/2009		DATE - 03-25-2008	REVISED -


**STATE OF ILLINOIS
DEPARTMENT OF TRANSPORTATION**

EROSION CONTROL DETAILS

SCALE: 1" = 20' SHEET NO. 5 OF 9 SHEETS STA. TO STA.

F.A.S. RTE.	SECTION	COUNTY	TOTAL SHEETS	SHEET NO.
1517	12VBR-1	PIATT	168	63
CONTRACT NO. 70388				
FED. ROAD DIST. NO. ILLINOIS FED. AID PROJECT				

SECTION 10, T20N, R6E, 3RD PM

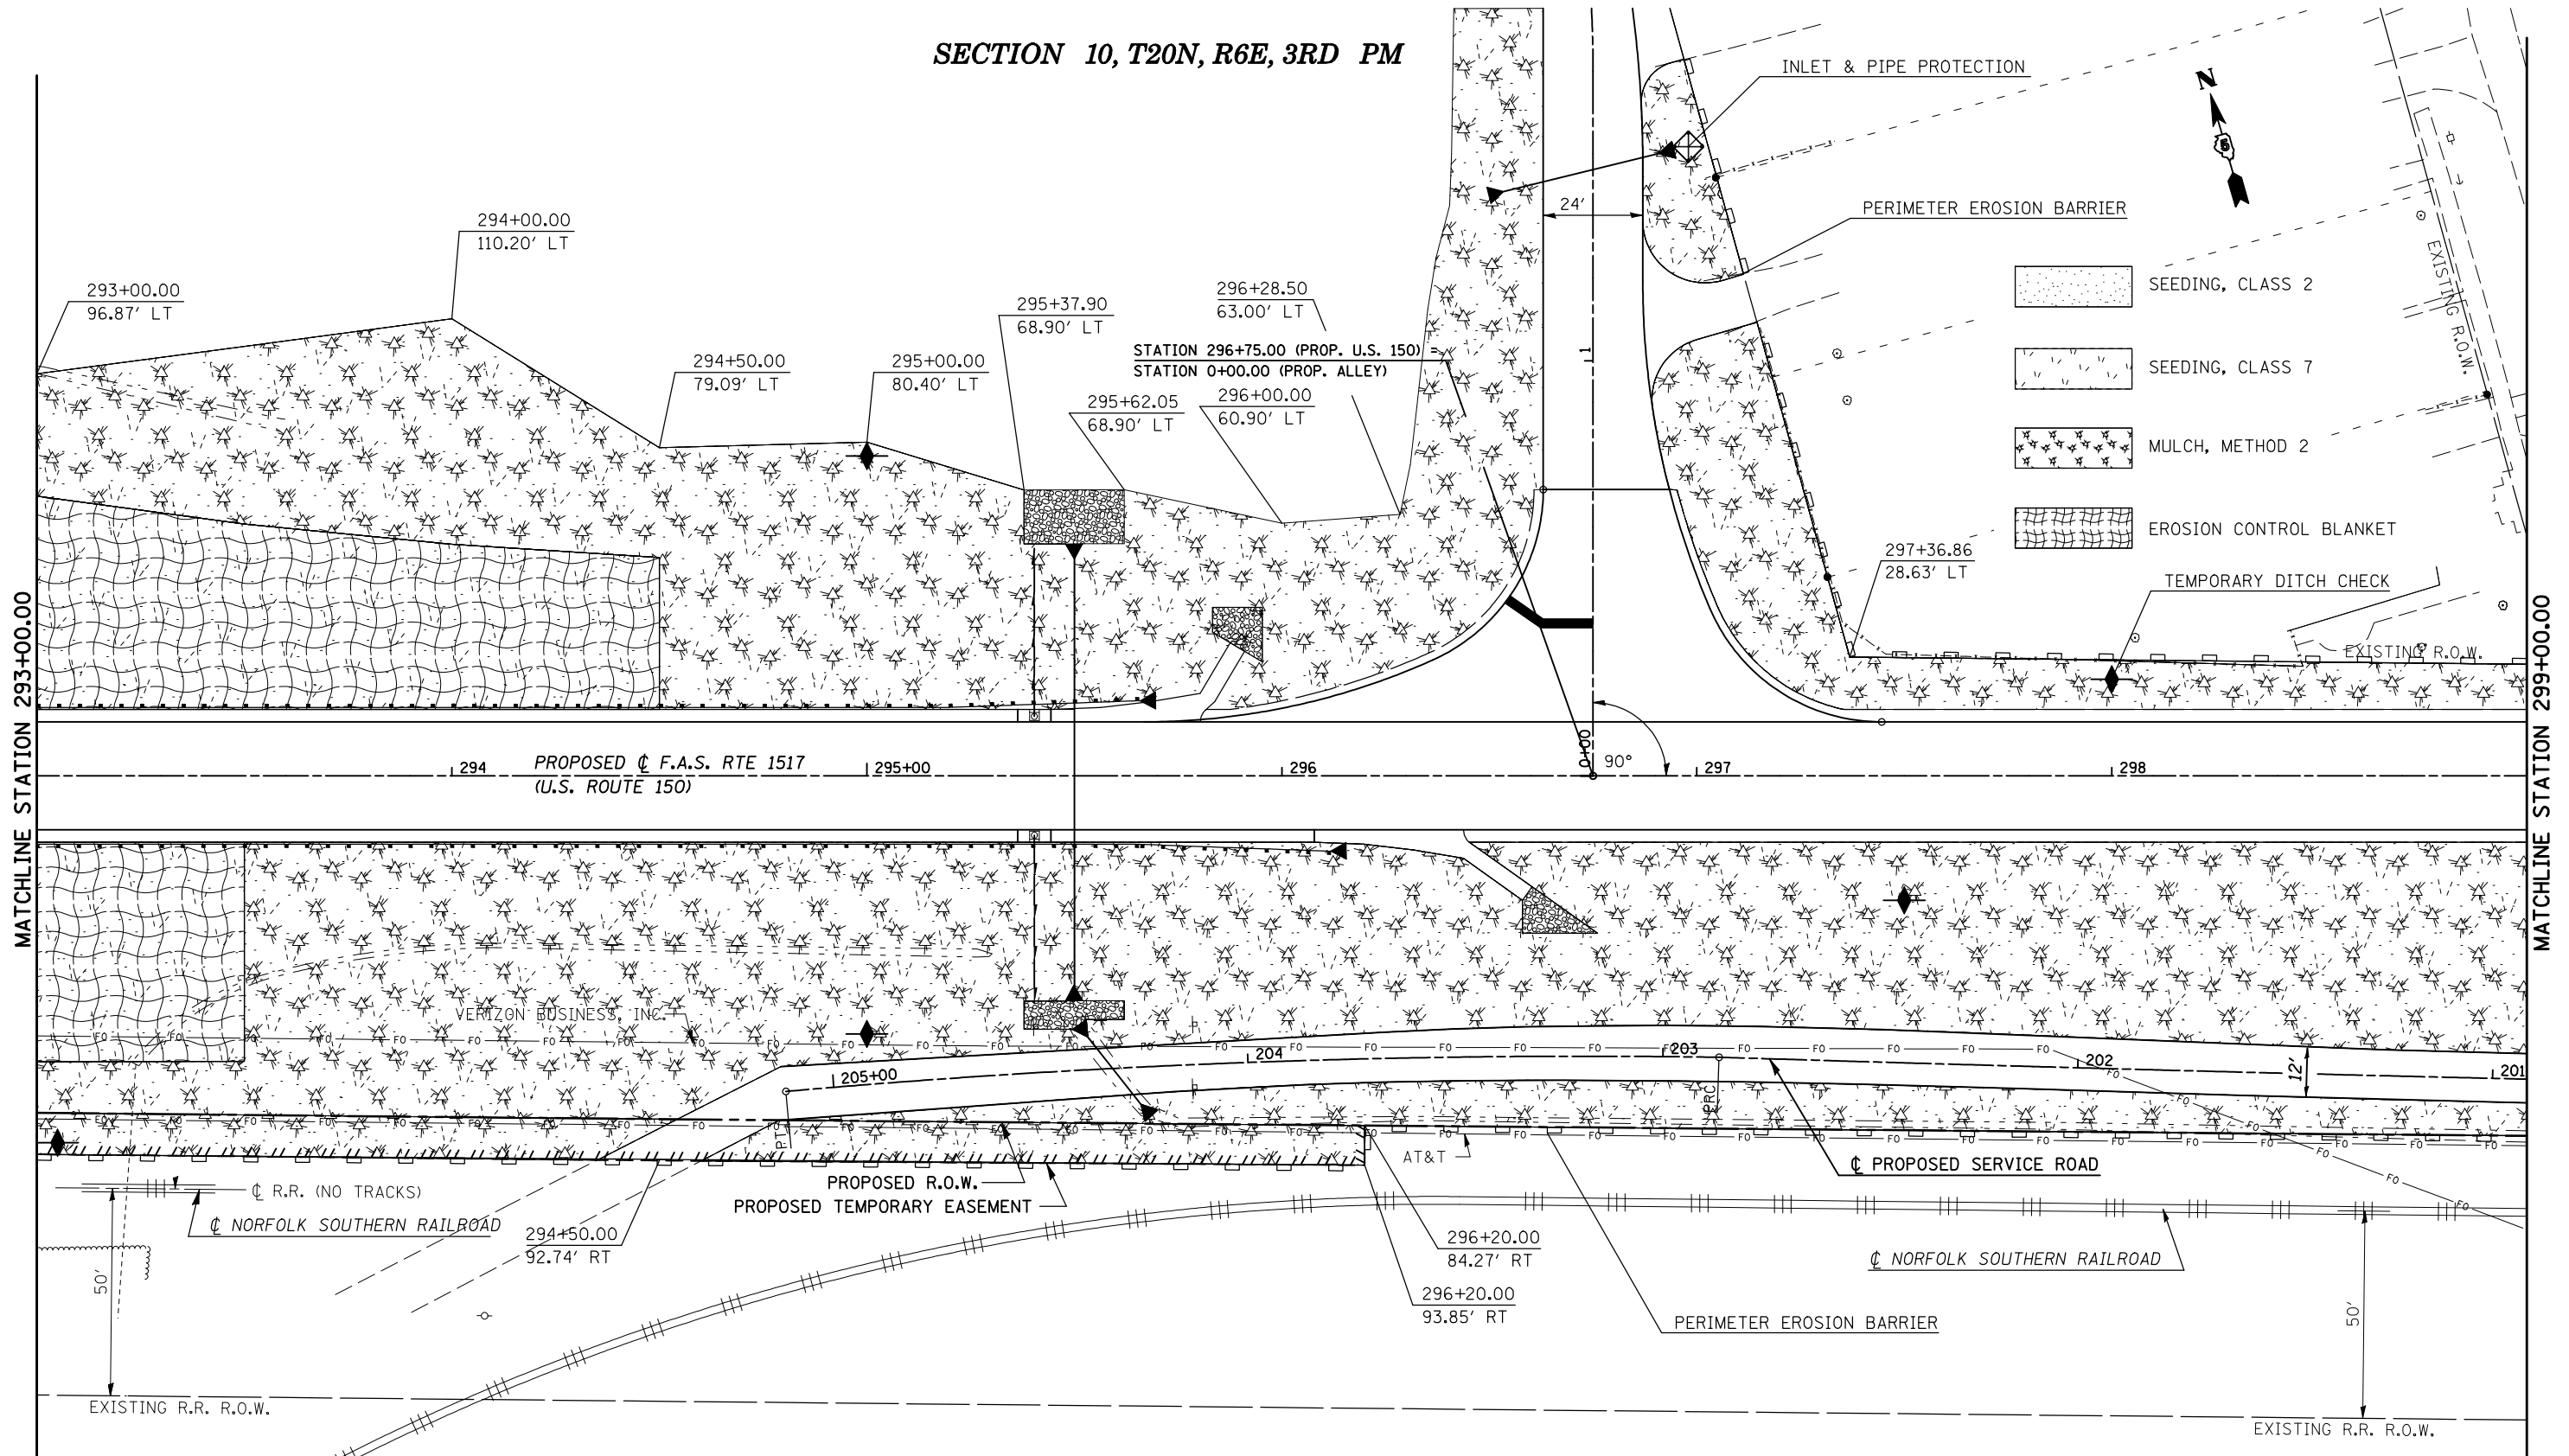

SECTION 10, T20N, R6E, 3RD PM

FILE NAME =	USER NAME = shererjm	DESIGNED - CMS	REVISED -
ct:\pw\work\PWIDOT\SHERERJM\dms86674\0570388-sht-eros.dgn		DRAWN - JRP	REVISED -
	PLOT SCALE = 40.0000' / IN.	CHECKED -	REVISED -
	PLOT DATE = 10/13/2009	DATE - 03-25-2008	REVISED -

STATE OF ILLINOIS
DEPARTMENT OF TRANSPORTATION


EROSION CONTROL DETAILS

SCALE: 1" = 20' SHEET NO. 6 OF 9 SHEETS STA. TO STA.

F.A.S. RTE.	SECTION	COUNTY	TOTAL SHEETS	SHEET NO.
1517	12VBR-1	PIATT	168	64
CONTRACT NO. 70388				
FED. ROAD DIST. NO. ILLINOIS FED. AID PROJECT				

SECTION 10, T20N, R6E, 3RD PM

VILLAGE OF MANSFIELD

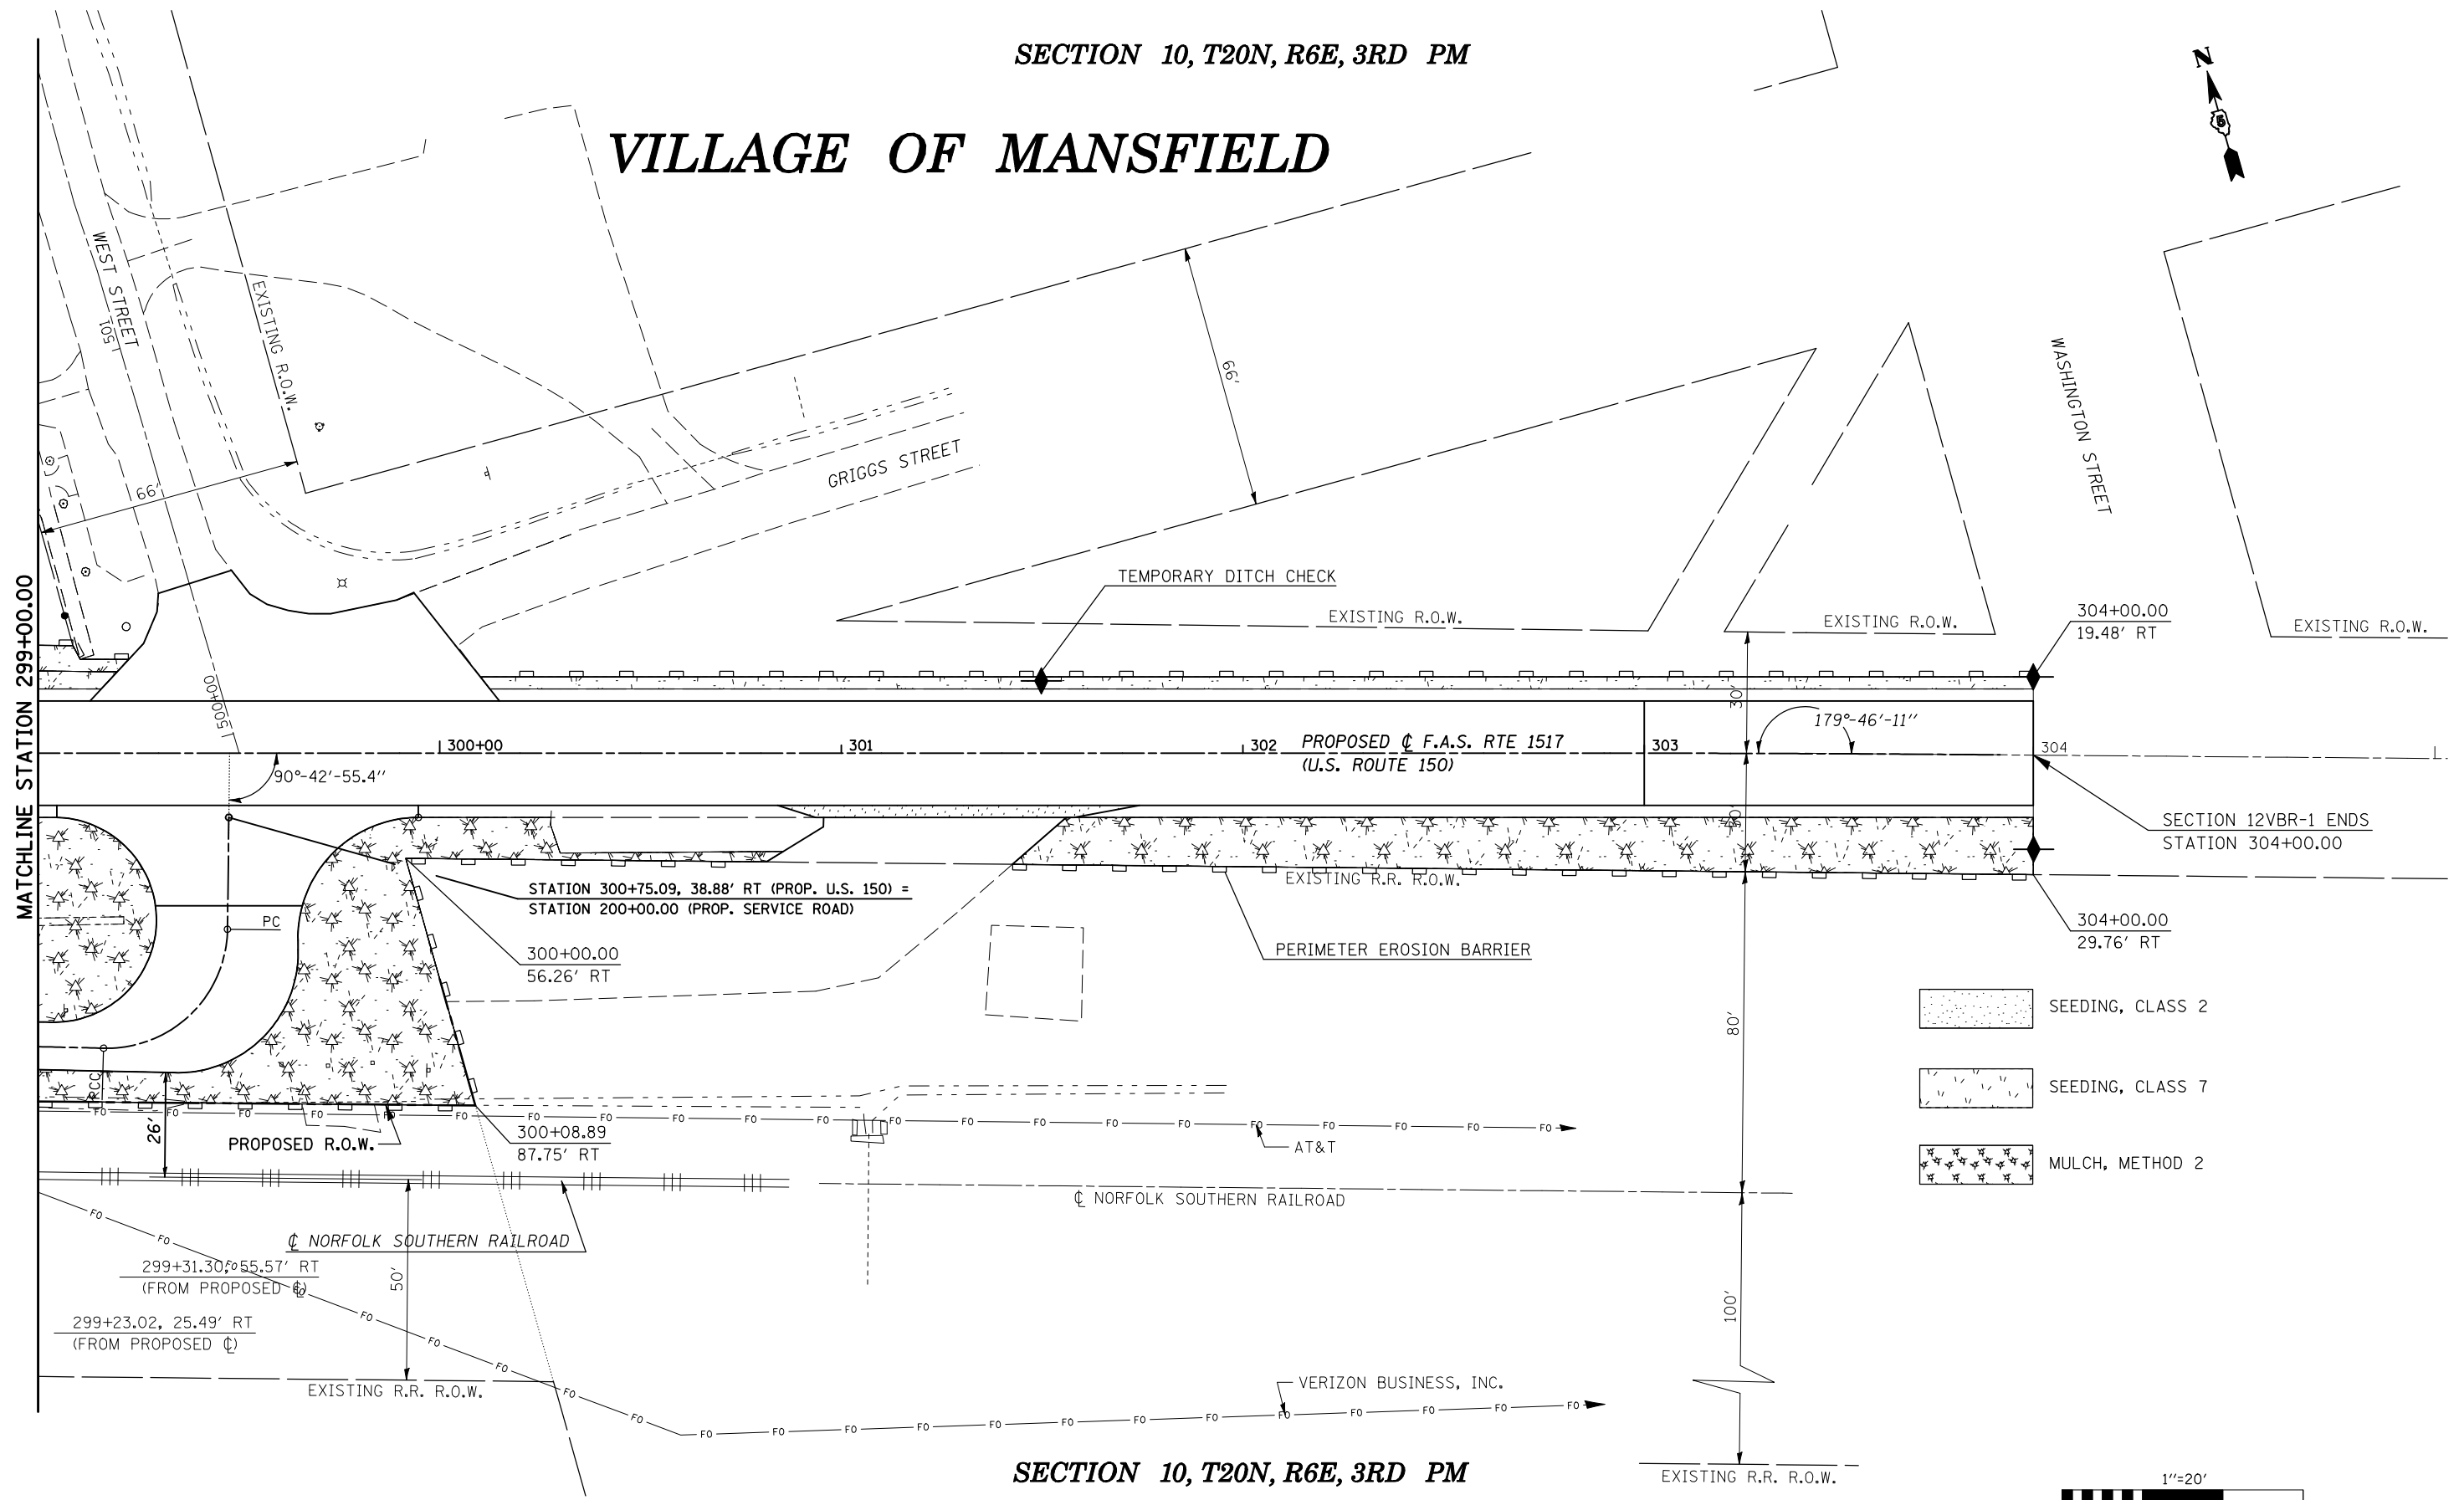

SECTION 10, T20N, R6E, 3RD PM


FILE NAME =	USER NAME = shererjm	DESIGNED - CMS	REVISED -
ct:\pw\work\PIWIDOT\SHERERJM\dms86674\0570388-sht-eros.dgn	DRAWN - JRP	REVIS	REVISED -
	CHECKED -	REVIS	REVISED -
	DATE - 03-25-2008	REVIS	REVISED -
	PLOT SCALE = 40.0000 ' / IN.		
	PLOT DATE = 10/13/2009		


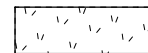
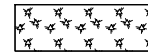
STATE OF ILLINOIS
DEPARTMENT OF TRANSPORTATION

EROSION CONTROL DETAILS

SCALE: 1" = 20' SHEET NO. 7 OF 9 SHEETS STA. TO STA.

F.A.S. RTE.	SECTION	COUNTY	TOTAL SHEETS	SHEET NO.
1517	12VBR-1	PIATT	168	65
CONTRACT NO. 70388				
FED. ROAD DIST. NO. ILLINOIS FED. AID PROJECT				

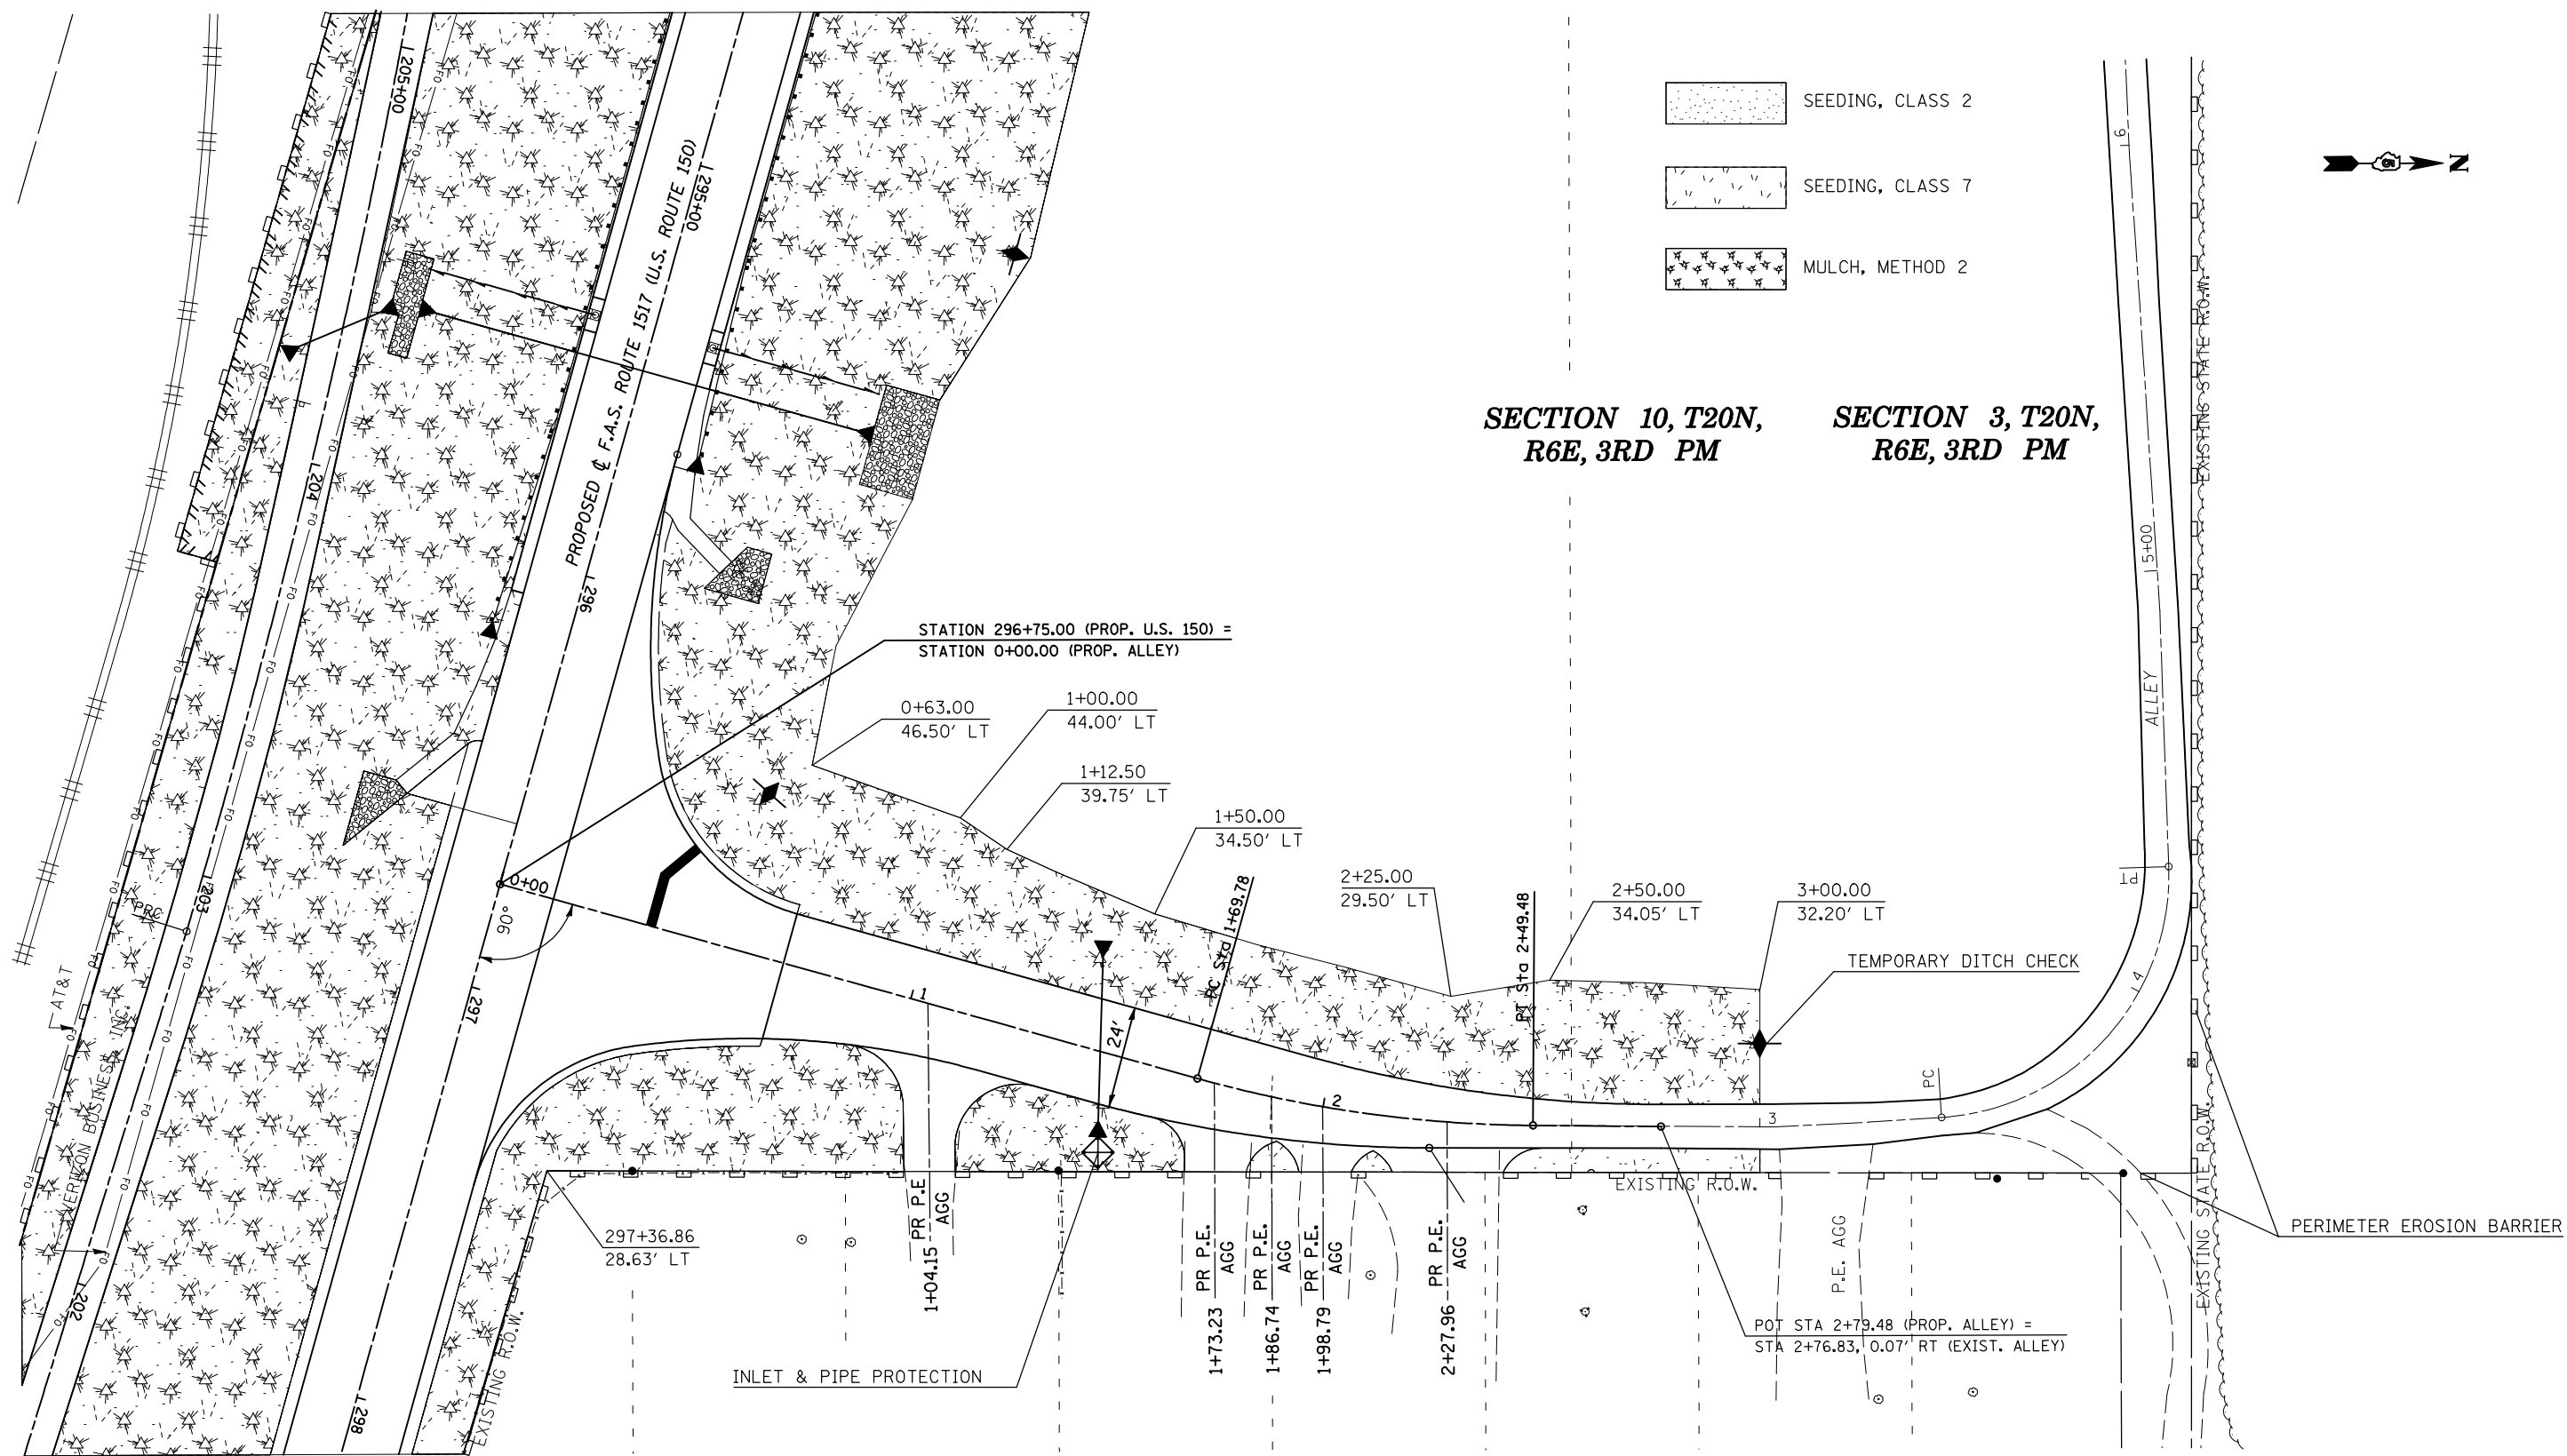

-  SEEDING, CLASS 2
-  SEEDING, CLASS 7
-  MULCH, METHOD 2

**SECTION 10, T20N,
R6E, 3RD PM** **SECTION 3, T20N,
R6E, 3RD PM**

STATION 296+75.00 (PROP. U.S. 150) =
STATION 0+00.00 (PROP. ALLEY)

0+63.00
46.50' LT

1+00.00
44.00' LT

1+12.50
39.75' LT

1+50.00
34.50' LT

2+25.00
29.50' LT

2+50.00
34.05' LT

3+00.00
32.20' LT

TEMPORARY DITCH CHECK

297+36.86
28.63' LT

1+04.15
PR P.E.
AGG


1+73.23
PR P.E.
AGG

1+86.74
PR P.E.
AGG

1+98.79
PR P.E.
AGG

2+27.96
PR P.E.
AGG

POT STA 2+79.48 (PROP. ALLEY) =
STA 2+76.83, 0.07' RT (EXIST. ALLEY)

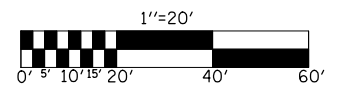

FILE NAME =	USER NAME = shererjm	DESIGNED - CMS	REVISED -
ct:\pw\work\PIWIDOT\SHERRERJM\dms86674\0570388-sht-eros.dgn	DRAWN - JRP	CHECKED -	REVISED -
PLOT SCALE = 40.0000' / IN.	DATE - 03-25-2008		
PLOT DATE = 10/13/2009			


**STATE OF ILLINOIS
DEPARTMENT OF TRANSPORTATION**

EROSION CONTROL DETAILS


SCALE: 1" = 20' SHEET NO. 8 OF 9 SHEETS STA. TO STA.

F.A.S. RTE.	SECTION	COUNTY	TOTAL SHEETS	SHEET NO.
1517	12VBR-1	PIATT	168	66
CONTRACT NO. 70388				
FED. ROAD DIST. NO. ILLINOIS FED. AID PROJECT				

SECTION 10, T20N, R6E, 3RD PM

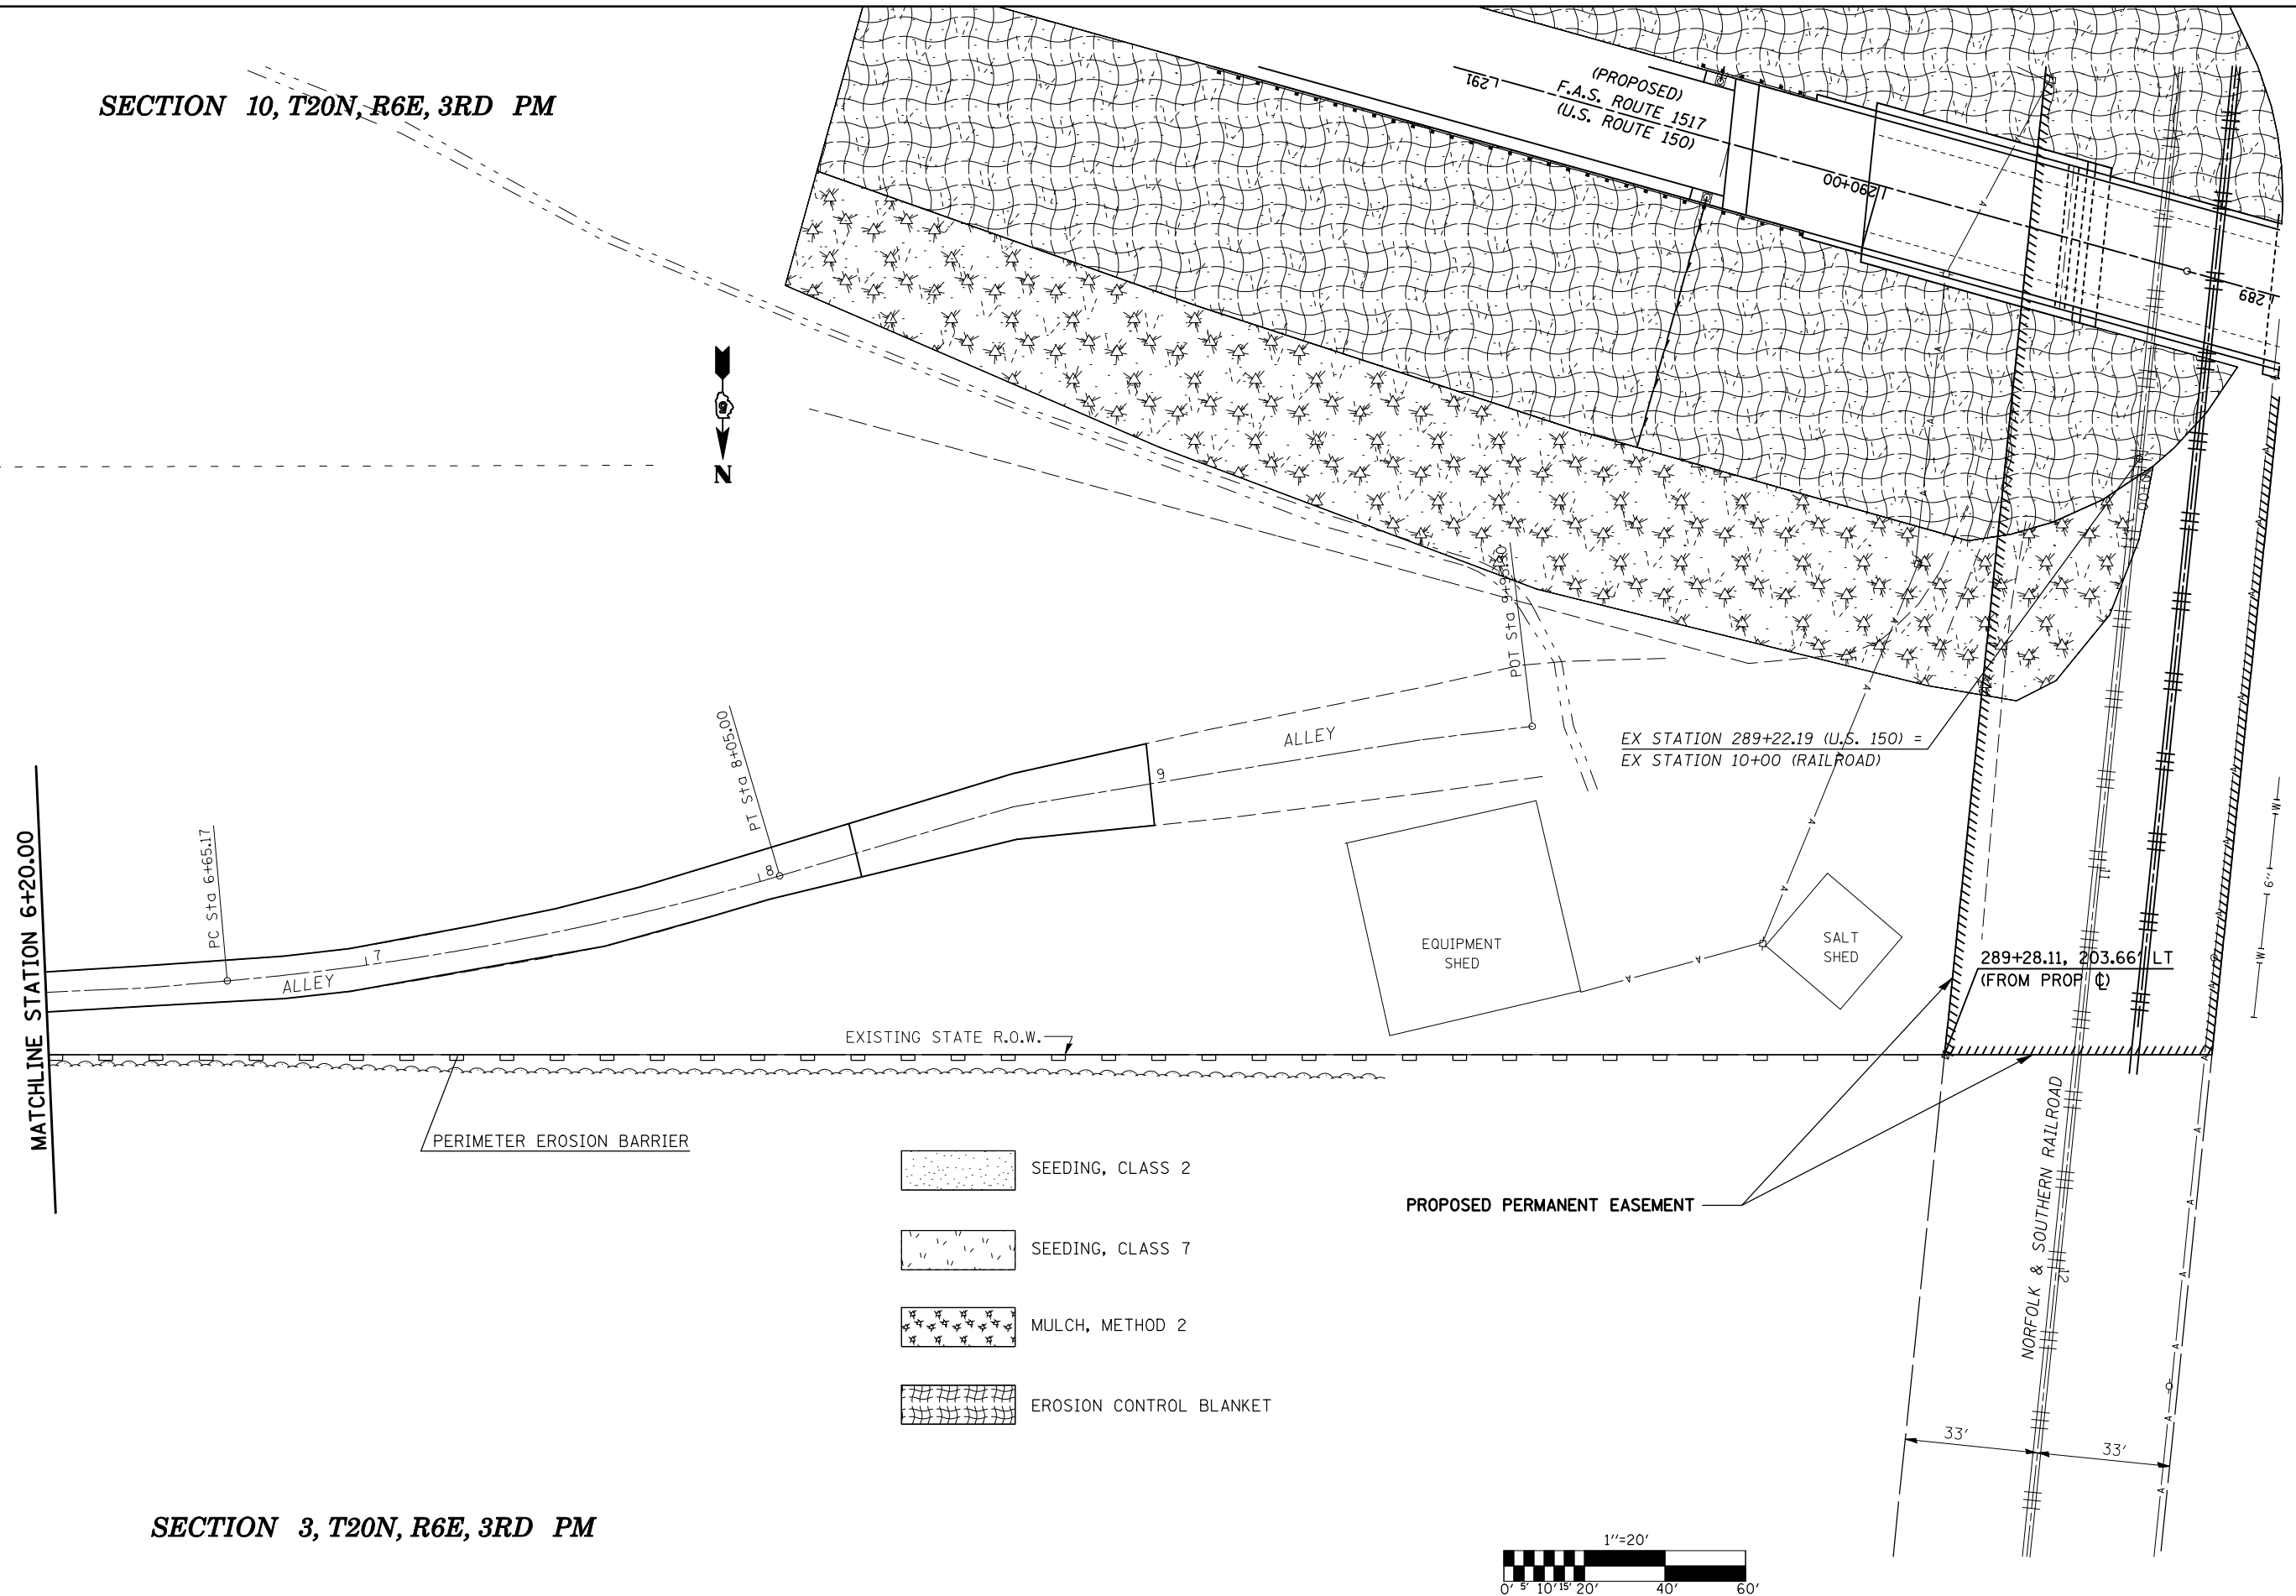

SECTION 3, T20N, R6E, 3RD PM

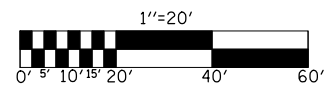

FILE NAME =	USER NAME = shererjm	DESIGNED - CMS	REVISED -
ct:\pw\work\PWIDOT\SHERERJM\dms86674\0570388-sht-eros.dgn		DRAWN - JRP	REVISED -
	PLOT SCALE = 40.0000' / IN.	CHECKED -	REVISED -
	PLOT DATE = 10/13/2009	DATE - 03-25-2008	REVISED -

STATE OF ILLINOIS
DEPARTMENT OF TRANSPORTATION

EROSION CONTROL DETAILS

SCALE: 1" = 20' SHEET NO. 9 OF 9 SHEETS STA. TO STA.

F.A.S. RTE.	SECTION	COUNTY	TOTAL SHEETS	SHEET NO.
1517	12VBR-1	PIATT	168	67
CONTRACT NO. 70388				
FED. ROAD DIST. NO. ILLINOIS FED. AID PROJECT				

SHOULDER DRAIN SCHEDULE

60208240 CATCH BASINS, TYPE C TYPE 24 FRAME & GRATE										
STATION	O/S	O/S RIM	RIM ELEV	INVERT ELEV	54213447 END SECTIONS 12" EACH	60100945 PIPE DRAINS 12" FOOT	60208240 CB TC T24 F&G EACH	60900515 CONC THRUS BLOCKS EACH		
1	283+04.38	15.33' LT	14.08'	737.48	732.78	1.0	57.0	1.0	1.0	
2	283+04.38	15.33' RT	14.08'	737.48	732.78	1.0	27.0	1.0	1.0	
3	285+54.38	15.33' LT	14.08'	748.24	743.54	1.0	67.0	1.0	1.0	
4	285+54.38	15.33' RT	14.08'	748.24	743.54	1.0	61.0	1.0	1.0	
5	287+97.64	15.33' LT	14.08'	756.47	751.77	1.0	86.0	1.0	1.0	
6	288+02.12	15.33' RT	14.08'	756.47	751.77	1.0	83.0	1.0	1.0	
7	290+42.16	15.33' LT	14.08'	756.37	751.67	1.0	93.0	1.0	1.0	
8	290+46.64	15.33' RT	14.08'	756.37	751.67	1.0	84.0	1.0	1.0	
9	292+90.38	15.33' LT	14.08'	747.94	743.24	1.0	72.0	1.0	1.0	
10	292+90.38	15.33' RT	14.08'	747.94	743.24	1.0	71.0	1.0	1.0	
11	295+40.38	15.33' LT	14.08'	735.56	730.86	1.0	44.0	1.0	1.0	
12	295+40.38	15.33' RT	14.08'	735.56	730.86	1.0	45.0	1.0	1.0	
TOTAL =					12.0	790.0	12.0	12.0		

28100105 STONE RIPRAP, CLASS A3

STATION	LENGTH FT	WIDTH FT	AREA SQ YD
282+47.87 LT	19.6	VAR	15.0
282+47.87 RT	19.6	VAR	15.0
295+50.00 LT	24.2	13.0	35.0
295+50.00 RT	24.2	VAR	15.0
295+89.31 LT	12.0	VAR	12.8
296+60.31 RT	18.1	VAR	13.0
TOTAL =			105.8
USE =			106.0

ACROSS ROAD/ ENTRANCE CULVERT SCHEDULE

STATION	54213447 END SECTIONS 15" EACH	54215418 CIP RC END SEC 18" EACH	542A0223 P CUL CL A 1 18" FOOT	542A1063 P CUL CL A 2 18" FOOT	542D0220 P CUL CL D 1 15" FOOT
US 150					
295+50.00	-	2.0	-	104.0	
ACCESS RD					
204+32.65	-	2.0	21.0	-	
ALLEY					
1+46.11	2.0	-	-	-	21
TOTAL =	2.0	4.0	21.0	104.0	21.0

60602500 CONCRETE GUTTER, TYPE A

STATION	TO	STATION	FOOT
LT 282+47.87		LT 283+00.00	54.0
RT 282+47.87		RT 283+00.00	54.0
LT 295+44.38		LT 295+91.02	51.0
RT 296+07.80		RT 296+60.31	54.0
TOTAL =			213.0


DETAIL NOTES:

SEE DETAIL FOR SHOULDER INLETS WITH CURB AND APPLICABLE PORTIONS OF HIGHWAY STANDARD 610001-04 FOR DETAILS ON TYPE 24 FRAME AND GRATE, PIPE DRAINS 12".


LOCATIONS AND DIMENSIONS FOR STONE RIP RAP, CLASS A3 MAY VARY AND BE ADJUSTED IN THE FIELD BY THE ENGINEER.

SEE SHEET 16 FOR LOCATIONS OF HMA SHOULDER CURB

SECTION 3, T20N, R6E, 3RD PM

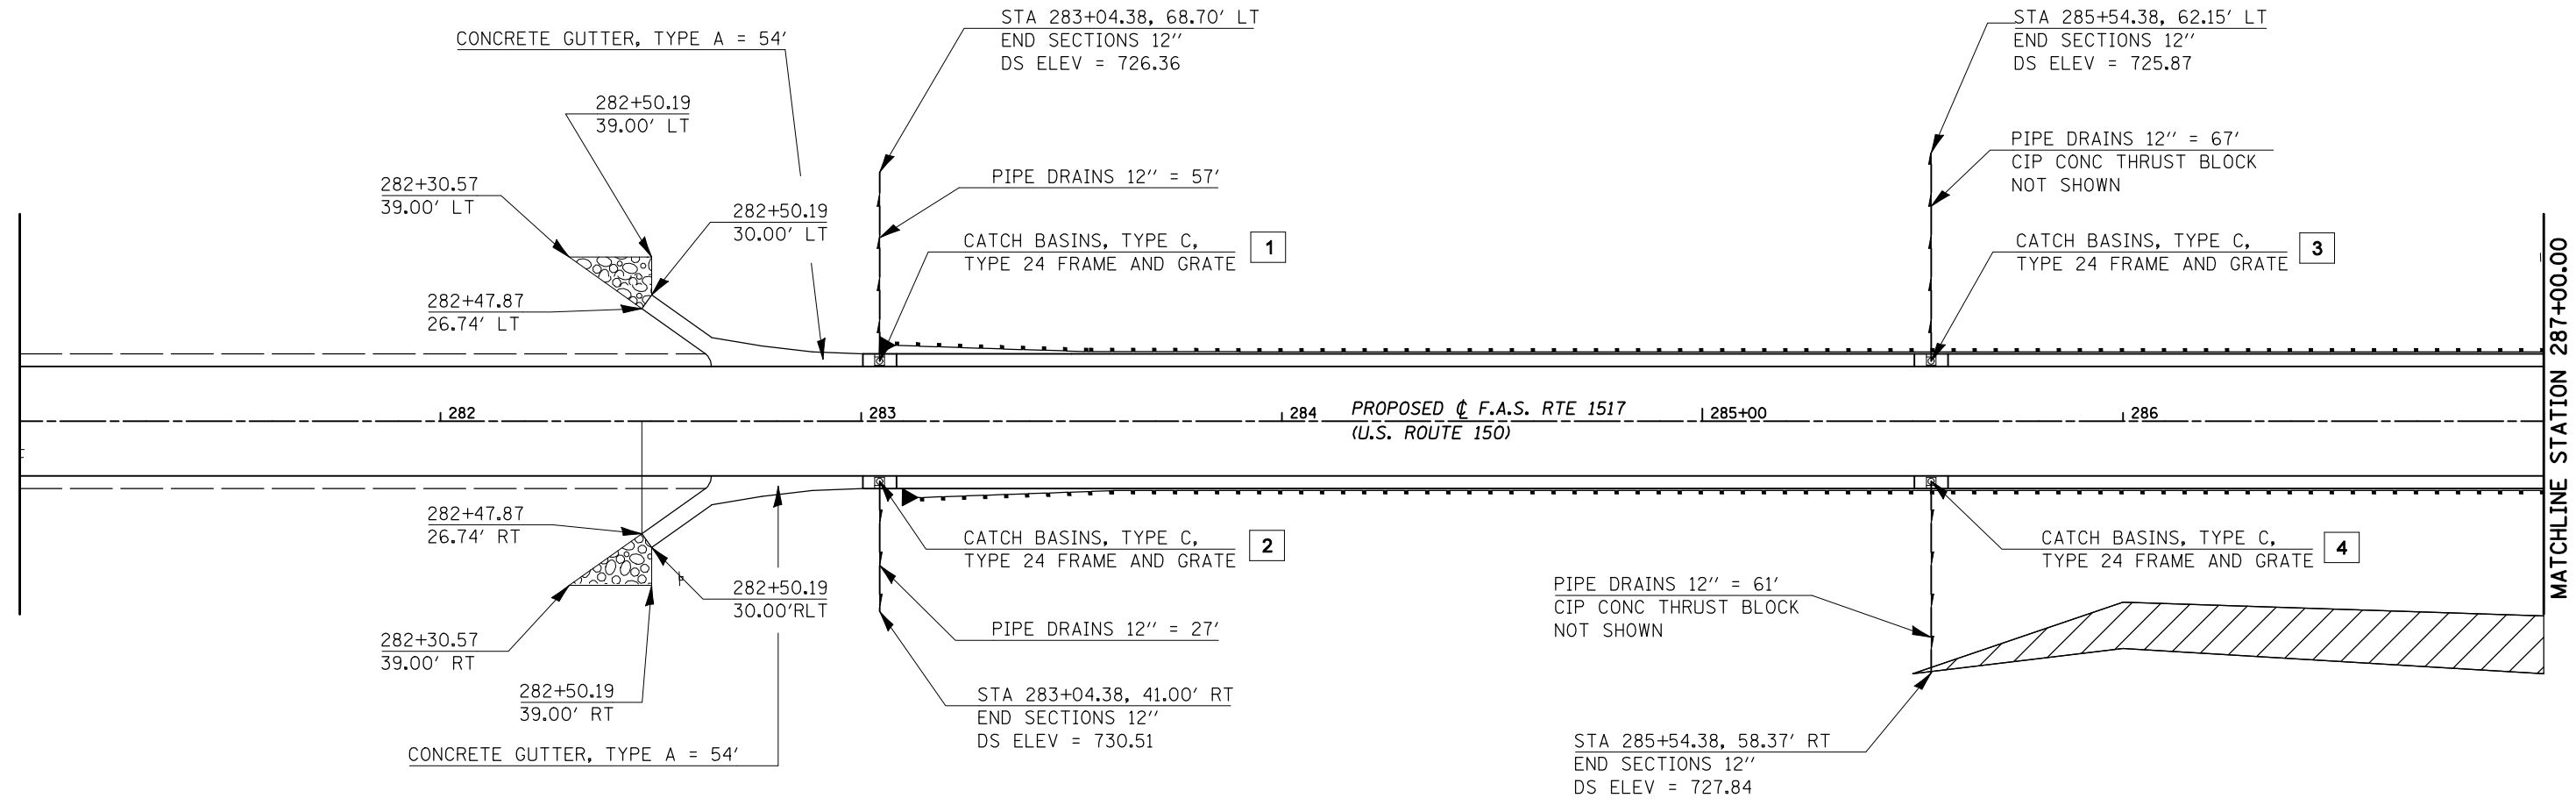


 STONE RIP RAP, CLASS A3

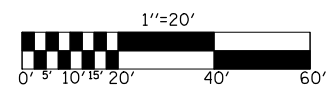

SECTION 10, T20N, R6E, 3RD PM

FILE NAME = c:\pwwork\pwwid\DOT\SHERERJM\dms86674\0570388-sheet-Drainage.dgn	USER NAME = shererjm	DESIGNED - JMS	REVISED -	STATE OF ILLINOIS DEPARTMENT OF TRANSPORTATION	DRAINAGE DETAILS	F.A.S. RTE.	SECTION	COUNTY	TOTAL SHEETS	SHEET NO.
	PLOT SCALE = 40.0000' / IN.	CHECKED -	REVISED -			1517	12VBR-1	PIATT	168	69
PLOT DATE = 10/13/2009	DATE - 071409	REVISED -		SCALE: 1" = 20'	SHEET NO. 2 OF 4 SHEETS	STA. 281+00.00 TO STA. 287+00.00		CONTRACT NO. 70388		
						FED. ROAD DIST. NO. ILLINOIS FED. AID PROJECT				

SECTION 3, T20N, R6E, 3RD PM

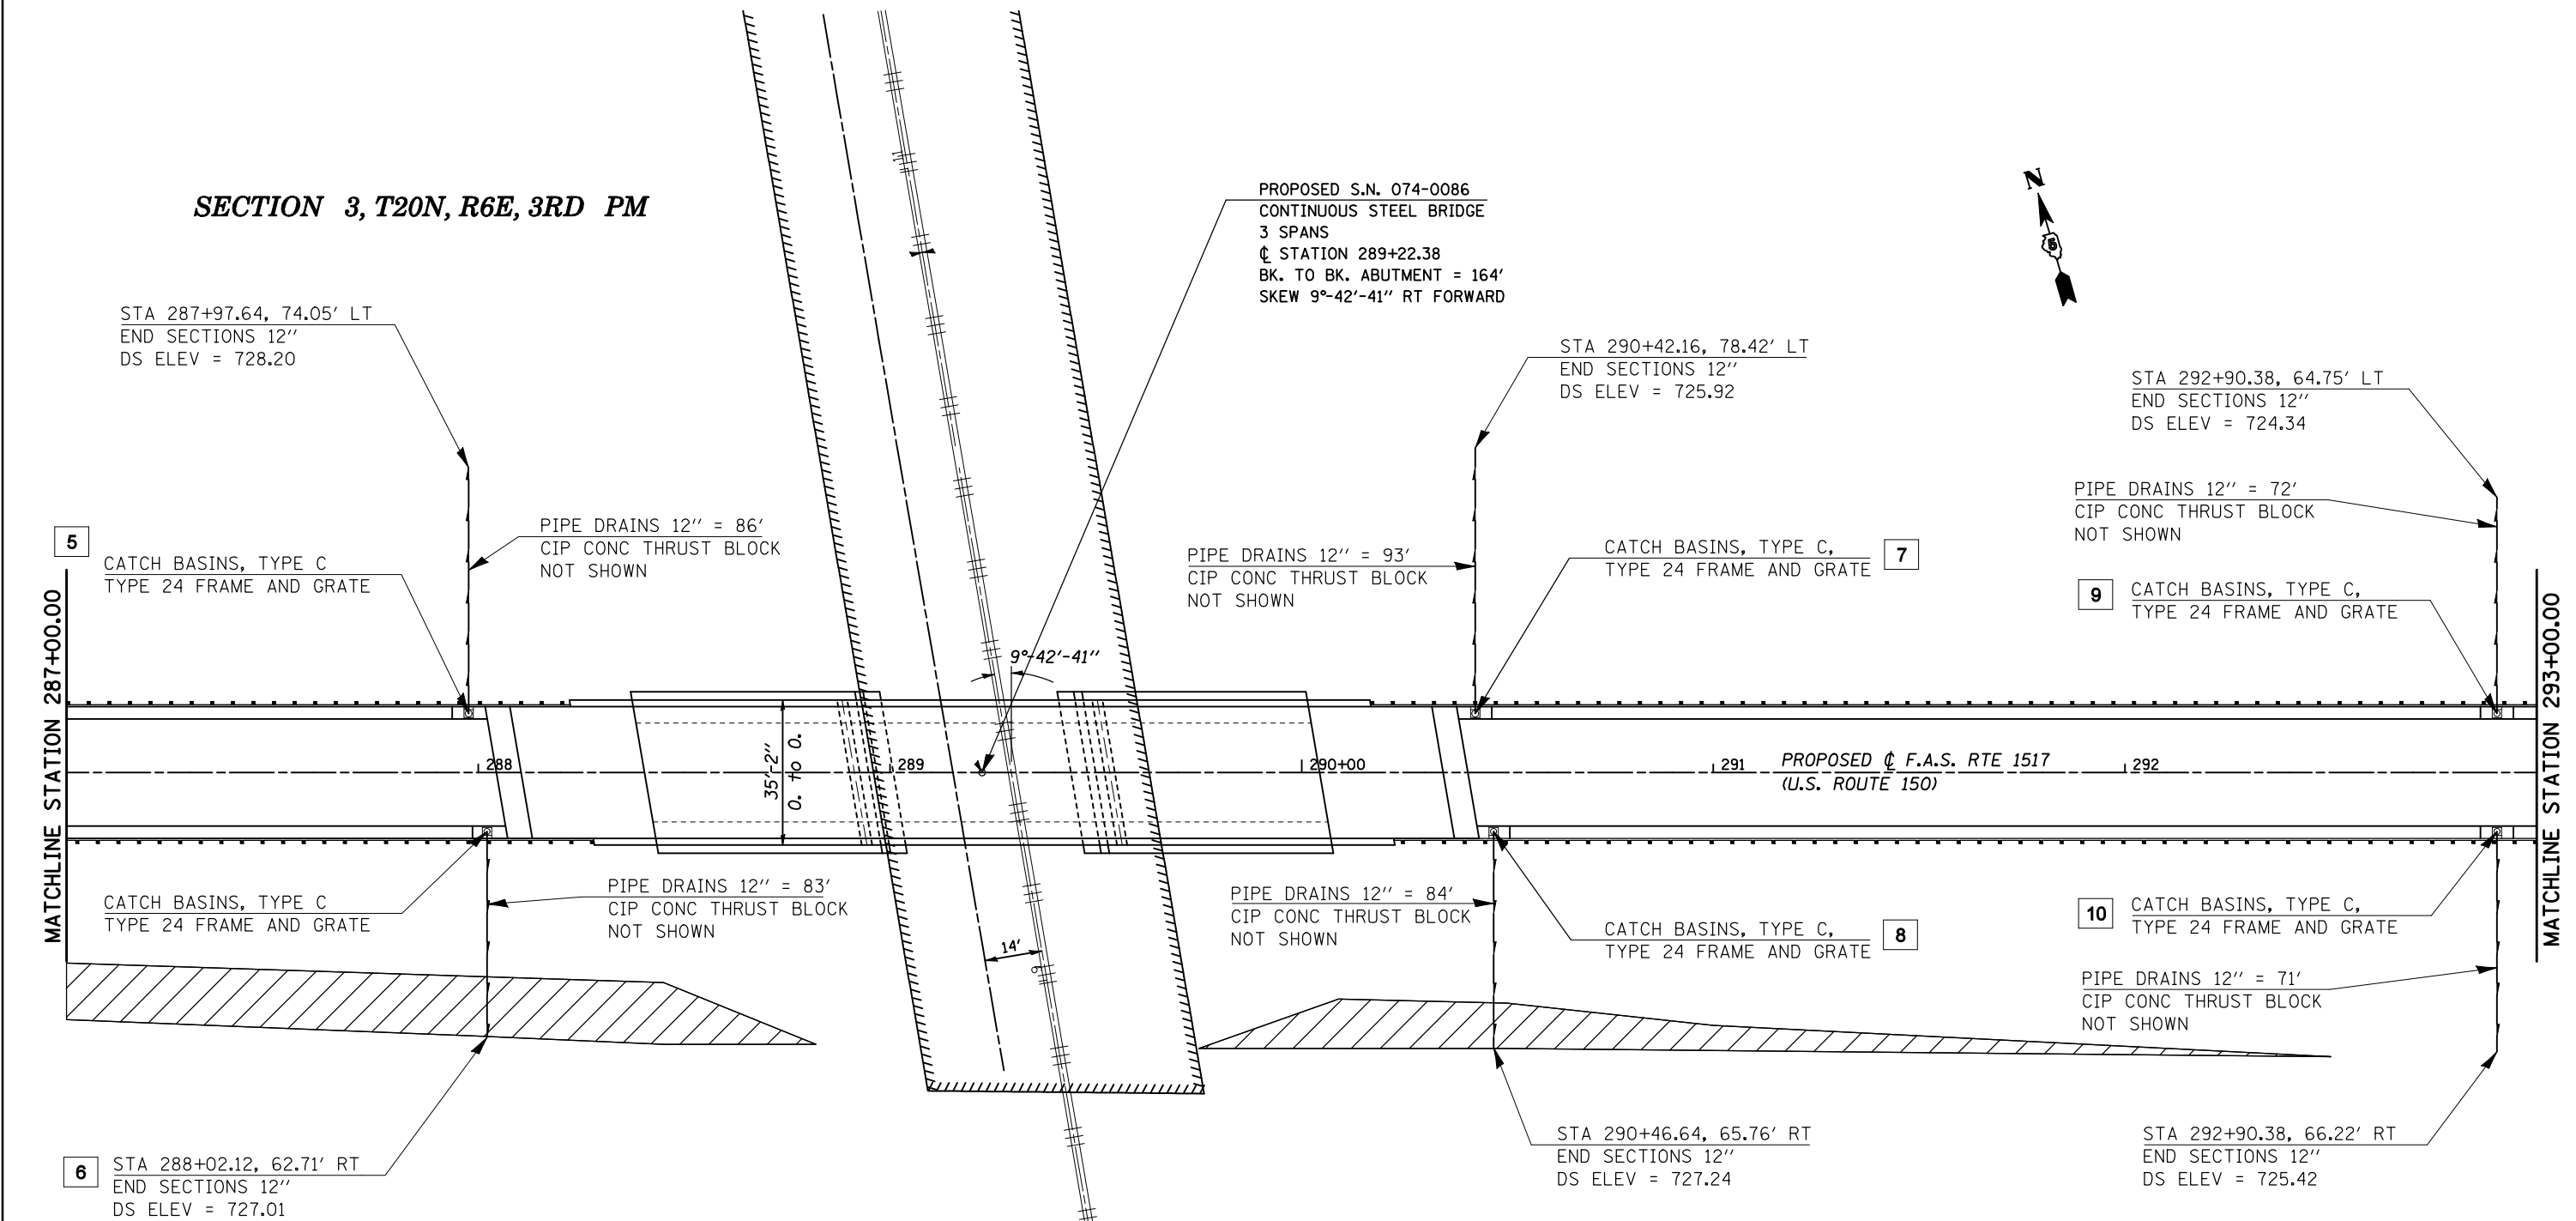


SECTION 10, T20N, R6E, 3RD PM

DETAIL NOTES:

SEE DETAIL FOR SHOULDER INLETS WITH CURB AND APPLICABLE PORTIONS OF HIGHWAY STANDARD 610001-04 FOR DETAILS ON TYPE 24 FRAME AND GRATE, PIPE DRAINS 12".

SEE SHEET 16 FOR LOCATIONS OF HMA SHOULDER CURB

LOCATIONS AND DIMENSIONS FOR STONE RIP RAP, CLASS A3 MAY VARY AND BE ADJUSTED IN THE FIELD BY THE ENGINEER.

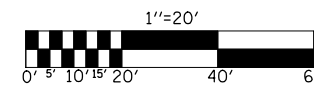

FILE NAME =	USER NAME = shererjm	DESIGNED - JMS	REVISED -
ct:\pw\work\PIWIDOT\SHERERJM\dms86674\0570388-sheet-Drainage.dgn		DRAWN - JMS	REVISED -
	PLOT SCALE = 40.0000' / IN.	CHECKED -	REVISED -
	PLOT DATE = 10/13/2009	DATE - 071409	REVISED -



**STATE OF ILLINOIS
DEPARTMENT OF TRANSPORTATION**

DRAINAGE DETAILS

SCALE: 1" = 20' SHEET NO. 3 OF 4 SHEETS STA. 287+00.00 TO STA. 293+00.00

F.A.S. RTE.	SECTION	COUNTY	TOTAL SHEETS	SHEET NO.
1517	12VBR-1	PIATT	168	70
CONTRACT NO. 70388				
FED. ROAD DIST. NO. ILLINOIS FED. AID PROJECT				

SECTION 10, T20N, R6E, 3RD PM

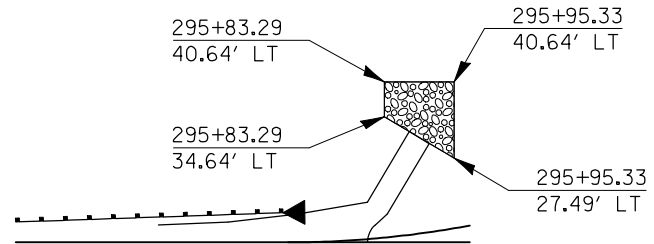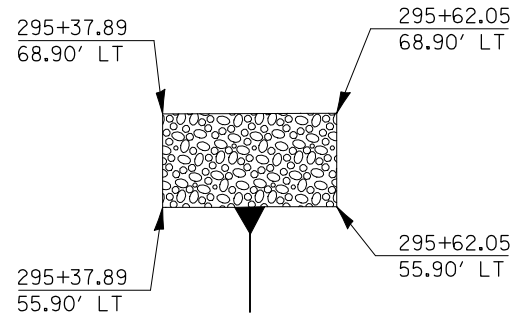

DETAIL NOTES:

SEE DETAIL FOR SHOULDER INLETS WITH CURB AND APPLICABLE PORTIONS OF HIGHWAY STANDARD 610001-04 FOR DETAILS ON TYPE 24 FRAME AND GRATE, PIPE DRAINS 12".

LOCATIONS AND DIMENSIONS FOR STONE RIP RAP, CLASS A3 MAY VARY AND BE ADJUSTED IN THE FIELD BY THE ENGINEER.

SEE SHEET 16 FOR LOCATIONS OF HMA SHOULDER CURB

STA 1+40.83, 21.50' LT
END SECTIONS 15"
DS ELEV = 723.35

STA 1+50.00, 15.82' RT
END SECTIONS 15"
US ELEV = 723.41

PIPE CULVERTS, CLASS D, TYPE 1 15" = 21'

STATION 296+75.00 (PROP. U.S. 150) =
STATION 0+00.00 (PROP. ALLEY)

STA 295+40.38, 52.50' LT
END SECTIONS 12"
DS ELEV = 723.25

PIPE DRAINS 12" = 44'

CONCRETE GUTTER, TYPE A = 25'

11 CATCH BASINS, TYPE C,
TYPE 24 FRAME AND GRATE



294 PROPOSED ϕ F.A.S. RTE 1517
(U.S. ROUTE 150) 295+00 296 297 298

CATCH BASINS, TYPE C,
TYPE 24 FRAME AND GRATE

PIPE DRAINS 12" = 45'

CONCRETE GUTTER, TYPE A = 54'

12 STA 295+40.38, 54.16' RT
END SECTIONS 12"
DS ELEV = 723.03

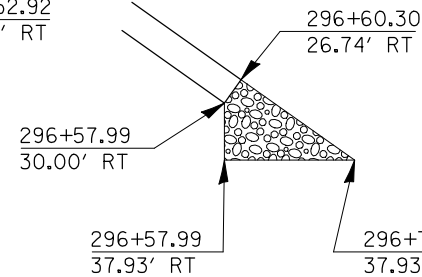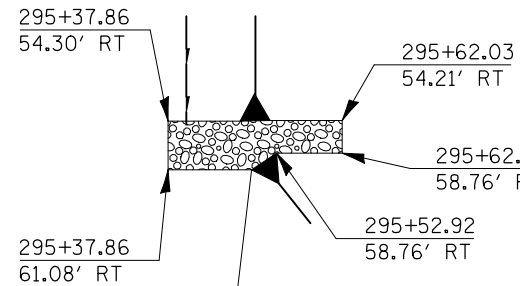


STA 295+50.00 PROPOSED A.R. CULVERT
PIPE CULVERTS, CLASS A, TYPE 2 18" = 104'
USFL 51.67' LT, ELEV = 723.25
DSFL 50.06' RT, ELEV = 723.03
CAST-IN-PLACE REINFORCED CONCRETE
END SECTIONS 18" = 2 EACH

STA 204+32.65 PROP. A.R. CULVERT
PIPE CULVERTS, CLASS A, TYPE 1 18" = 21'
USFL 204+38.18, 8.40' RT, ELEV = 723.08
DSLFL 204+26.24, 8.94' LT, ELEV = 723.08
CAST-IN-PLACE REINFORCED CONCRETE
END SECTIONS 18" = 2 EACH

STONE RIP RAP, CLASS A3

SECTION 10, T20N, R6E, 3RD PM

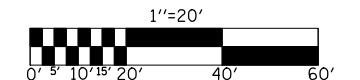

FILE NAME =	USER NAME = shererjm	DESIGNED - JMS	REVISED -
ct:\pw\work\PIWIDOT\SHERERJM\dms86674\0570388-sheet-Drainage.dgn		DRAWN - JMS	REVISED -
PLOT SCALE = 40.0000' / IN.		CHECKED -	REVISED -
PLOT DATE = 10/13/2009		DATE - 071409	REVISED -

**STATE OF ILLINOIS
DEPARTMENT OF TRANSPORTATION**

DRAINAGE DETAILS

SCALE: 1" = 20' SHEET NO. 4 OF 4 SHEETS STA. 293+00.00 TO STA. 299+00.00

F.A.S. RTE.	SECTION	COUNTY	TOTAL SHEETS	SHEET NO.
1517	12VBR-1	PIATT	168	71
CONTRACT NO. 70388				
FED. ROAD DIST. NO. ILLINOIS FED. AID PROJECT				

63000001 STEEL PLATE BEAM GUARD RAIL, TYPE A, 6 FOOT POSTS

63100085 TRAFFIC BARRIER TERMINAL, TYPE 6

63100167 TRAFFIC BARRIER TERMINAL, TYPE 1 (SPECIAL) TANGENT

STATION	TO	STATION	LENGTH FT	MRKS EACH
LT	283+54.22	287+79.22	425.00	6.0
RT	283+59.75	287+84.75	425.00	5.0
LT	290+60.01	295+22.51	462.50	6.0
RT	290+65.49	295+77.99	512.50	7.0
TOTAL =			1825.00	24.00

	STATION	TO	STATION	EACH
LT	287+79.22		288+24.92	1.0
RT	287+84.75		288+30.40	1.0
LT	290+14.36		290+60.01	1.0
RT	290+19.84		290+65.49	1.0
TOTAL =				4.0

	STATION	TO	STATION	EACH	78201000 TERM MK DA EACH
LT	283+04.22		283+54.22	1.0	1.0
RT	283+09.75		283+59.75	1.0	1.0
LT	295+22.51		295+72.51	1.0	1.0
RT	295+77.99		296+27.99	1.0	1.0
TOTAL =				4.0	4.0

78200500 BARRIER WALL MARKERS

	STATION	TO	STATION	EACH
LT	288+39.68		289+99.14	2.0
RT	288+45.15		290+04.62	2.0
TOTAL =				4.0

DETAIL NOTES

Drawings are not to scale. Engineer shall verify all existing guardrail quantities in the field prior to beginning work.

All guardrail work shown in the details shall conform to various specifications, details, standards and specifications.

Shoulder Widening for Type 1 (Special) Terminals shall be constructed prior to construction of new guardrail. See Standard 630301-05 for Details.


Shoulder Widening shall be seeded with Class 2A and Class 7 Seed after completion.

No rock, stones, millings, or broken concrete shall be permitted within a vertical distance of 12" from the surface of the finished grade of the shoulder widening.

- (A) TRAFFIC BARRIER TERMINAL, TYPE 1 (SPECIAL) TANGENT
- (B) STEEL PLATE BEAM GUARDRAIL, TYPE A 6 FT POST
- (C) TRAFFIC BARRIER TERMINAL, TYPE 6

- * GUARDRAIL MARKERS
- ◁ GUARDRAIL MARKERS
- ◄ BARRIER WALL MARKERS
- ◄ TERMINAL MARKER DA

* SEE STD(S): 635006-03
635011-02

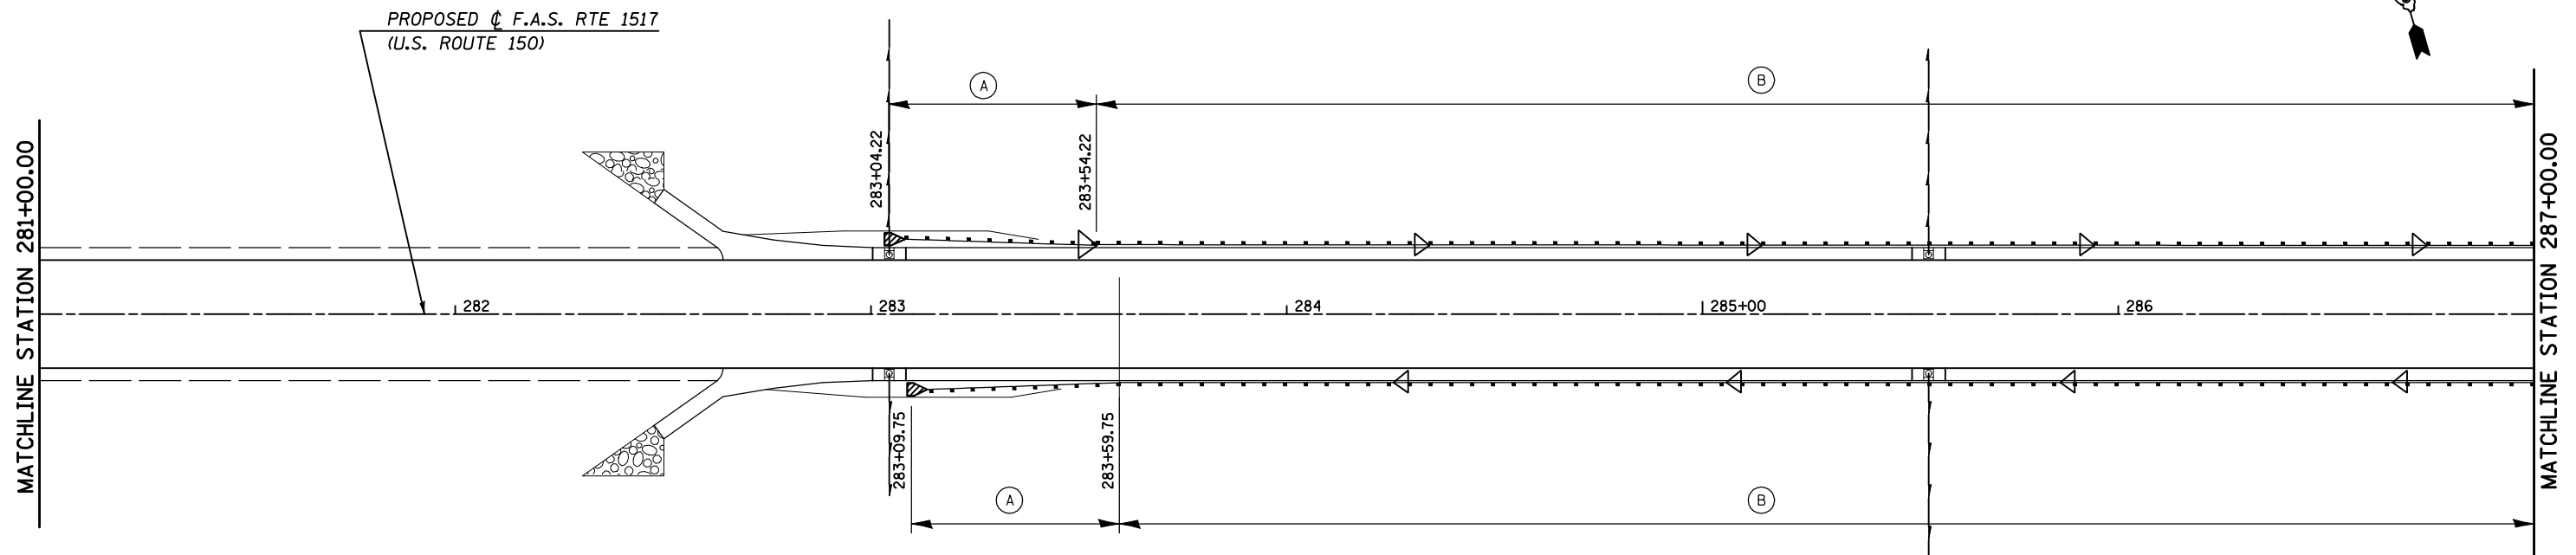


FILE NAME =	USER NAME = shererjm	DESIGNED - JMS	REVISED -
ct:\pwork\PIWIDOT\SHERERJM\dms86674\0570388-sht-Guardrail.dgn		DRAWN - JMS	REVISED -
PLOT SCALE = 40.0000' / IN.		CHECKED -	REVISED -
PLOT DATE = 10/13/2009		DATE - 070909	REVISED -

STATE OF ILLINOIS
DEPARTMENT OF TRANSPORTATION

GUARDRAIL DETAILS

SCALE: 1" = 20' SHEET NO. 1 OF 2 SHEETS STA. TO STA.

F.A.S. RTE.	SECTION	COUNTY	TOTAL SHEETS	SHEET NO.
1517	12VBR-1	PIATT	168	72
FED. ROAD DIST. NO.			ILLINOIS FED. AID PROJECT	
			CONTRACT NO. 70388	

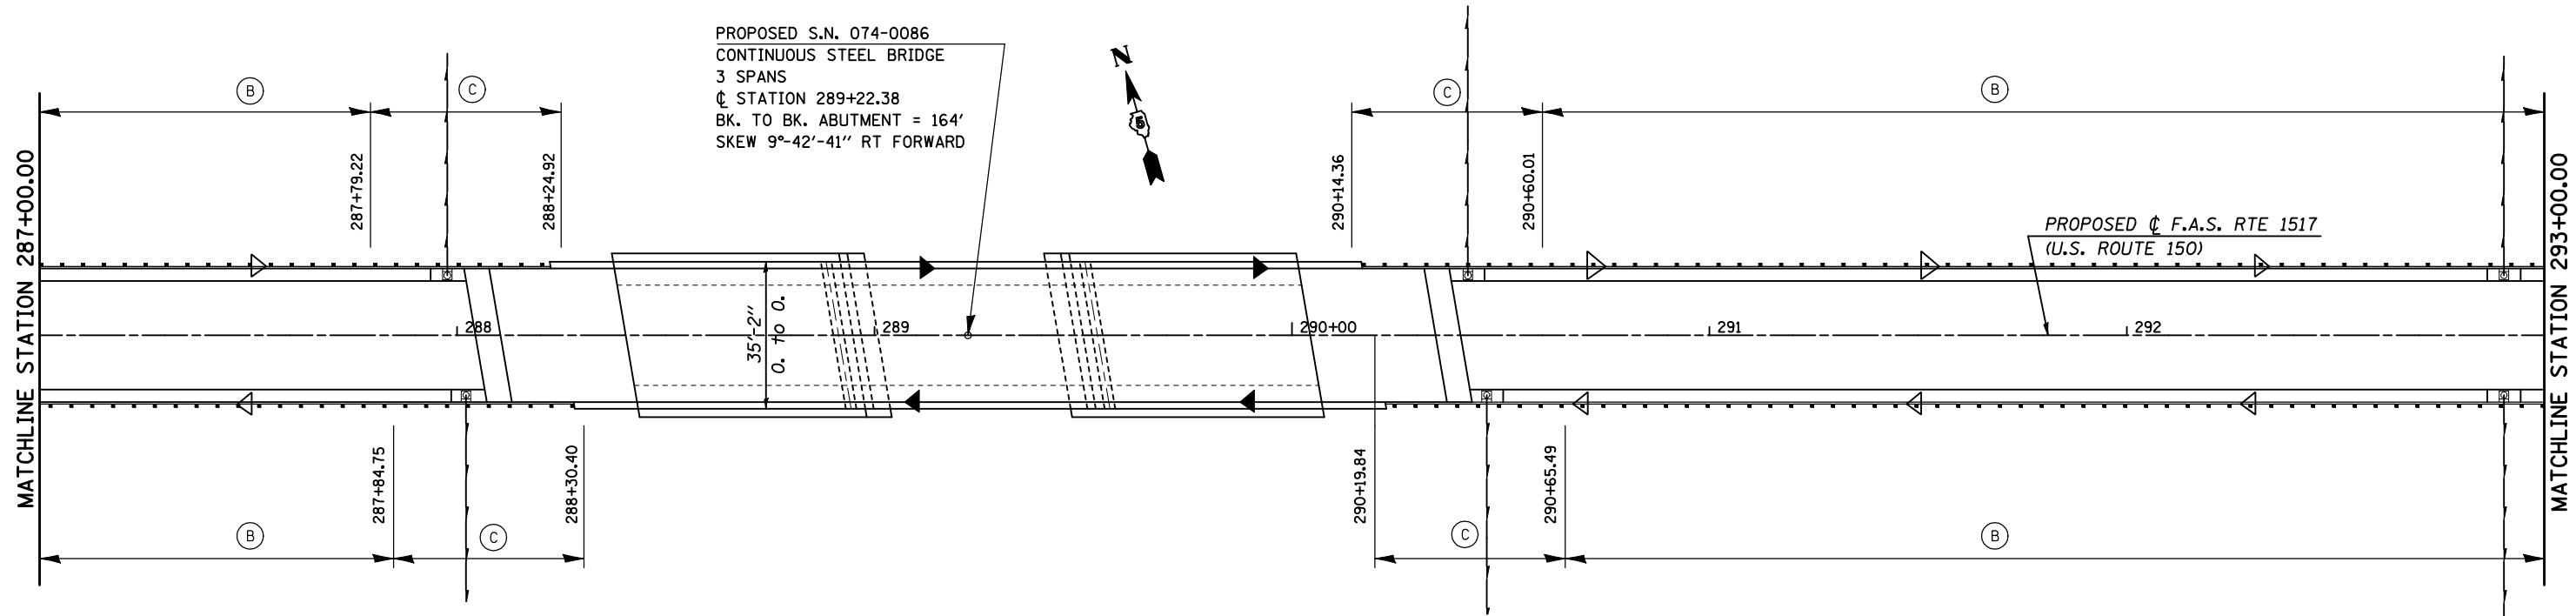

PROPOSED S.N. 074-0086
 CONTINUOUS STEEL BRIDGE
 3 SPANS
 CL STATION 289+22.38
 BK. TO BK. ABUTMENT = 164'
 SKEW 9°-42'-41" RT FORWARD

PROPOSED CL F.A.S. RTE 1517
 (U.S. ROUTE 150)

DETAIL NOTES

Drawings are not to scale.

Engineer shall verify all existing guardrail quantities in the field prior to beginning work.

All guardrail work shown in the details shall conform to various specifications, details, standards and specifications.

Shoulder Widening for Type 1 (Special) Terminals shall be constructed prior to construction of new guardrail. See Standard 630301-05 for Details.


Shoulder Widening shall be seeded with Class 2A and Class 7 Seed after completion.

No rock, stones, millings, or broken concrete shall be permitted within a vertical distance of 12" from the surface of the finished grade of the shoulder widening.

- (A) TRAFFIC BARRIER TERMINAL, TYPE 1 (SPECIAL) TANGENT
- (B) STEEL PLATE BEAM GUARDRAIL, TYPE A 6 FT POST
- (C) TRAFFIC BARRIER TERMINAL, TYPE 6

- * GUARDRAIL MARKERS
- ◁ GUARDRAIL MARKERS
- ◄ BARRIER WALL MARKERS
- ▴ TERMINAL MARKER DA

* SEE STD(S): 635006-03
 635011-02

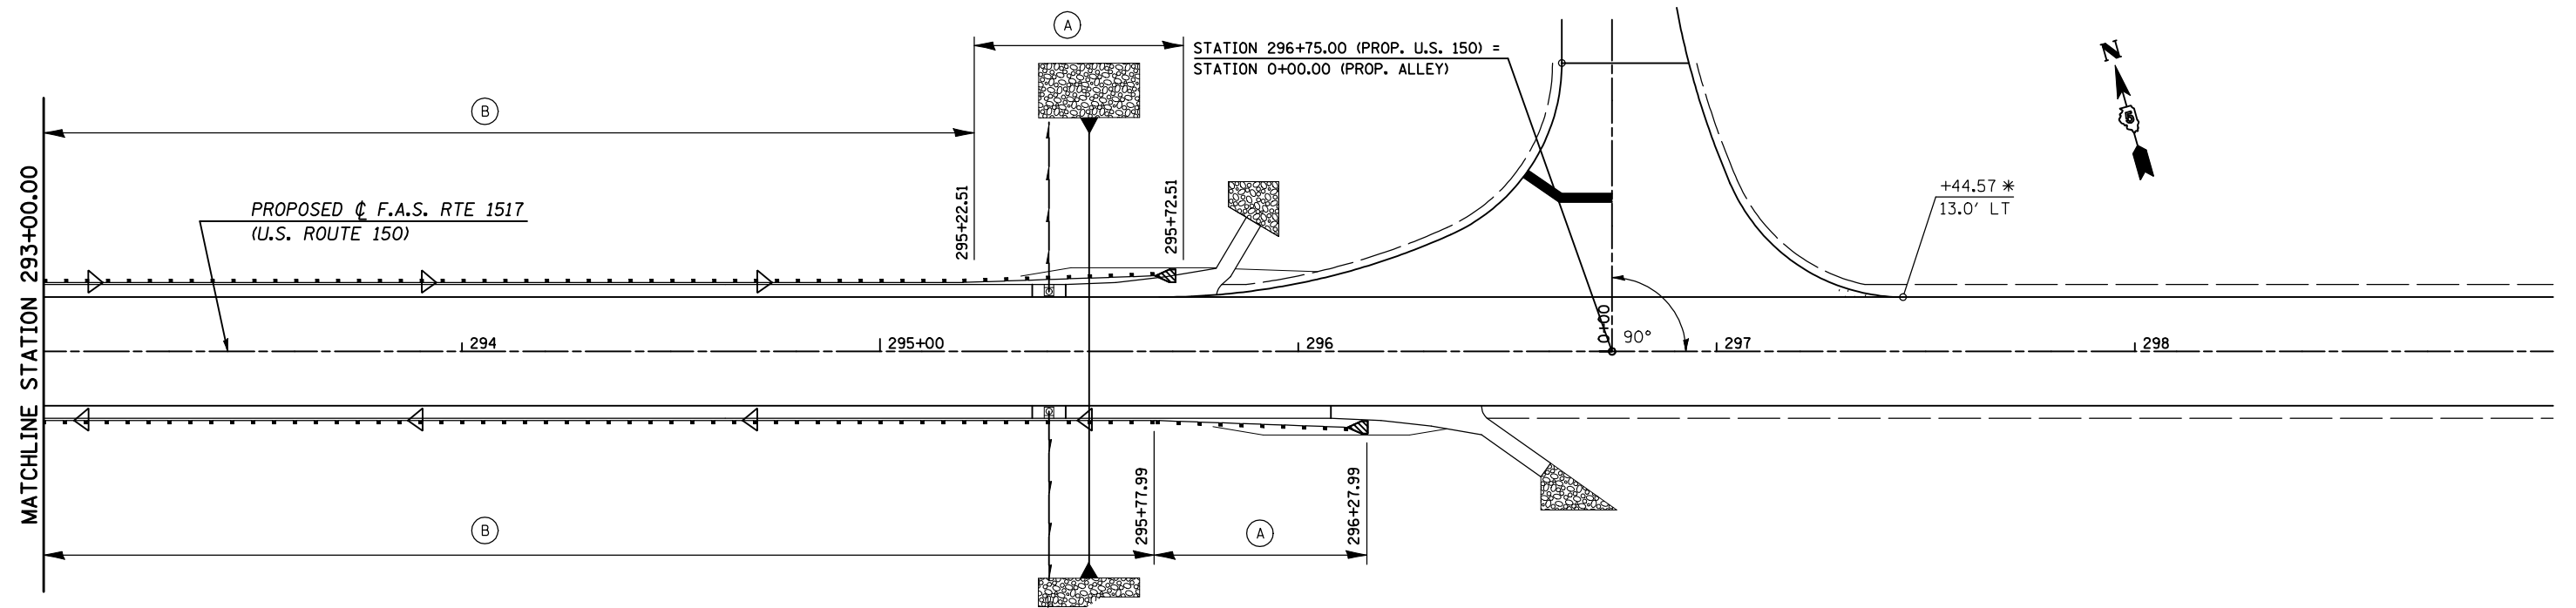

**STATE OF ILLINOIS
 DEPARTMENT OF TRANSPORTATION**


GUARDRAIL DETAILS

SCALE: 1" = 20' SHEET NO. 2 OF 2 SHEETS STA. TO STA.


FILE NAME =	USER NAME = shererjm	DESIGNED - JMS	REVISED -
ct:\pw\work\PWID01\SHERRERJM\dms86674\0570388-sht-Guardrail.dgn		DRAWN - JMS	REVISED -
	PLOT SCALE = 40.0000' / IN.	CHECKED -	REVISED -
	PLOT DATE = 10/13/2009	DATE - 070909	REVISED -

F.A.S. RTE.	SECTION	COUNTY	TOTAL SHEETS	SHEET NO.
1517	12VBR-1	PIATT	168	73
CONTRACT NO. 70388				
FED. ROAD DIST. NO. ILLINOIS FED. AID PROJECT				


PROJECTS WITHOUT RECONSTRUCTION

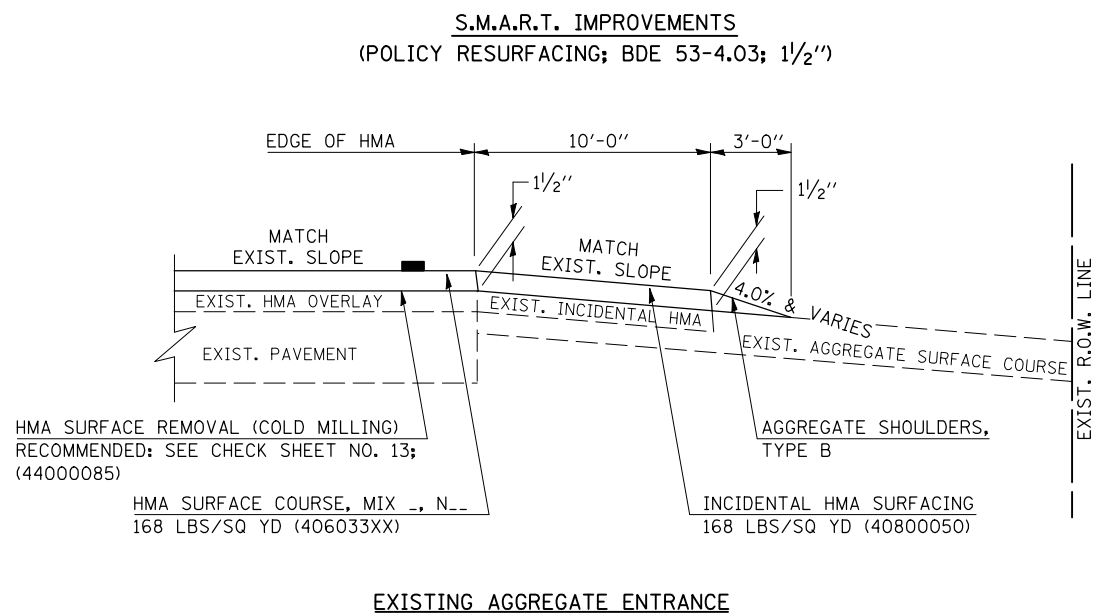


EXISTING AGGREGATE ENTRANCE

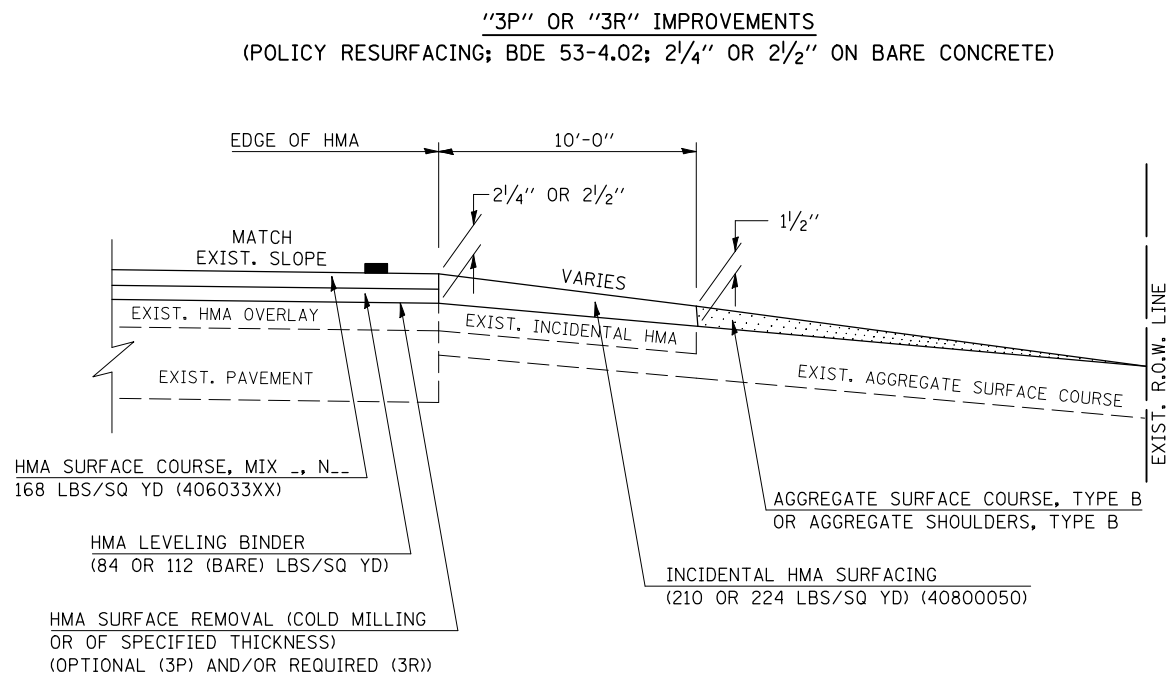

EXISTING AGGREGATE ENTRANCE

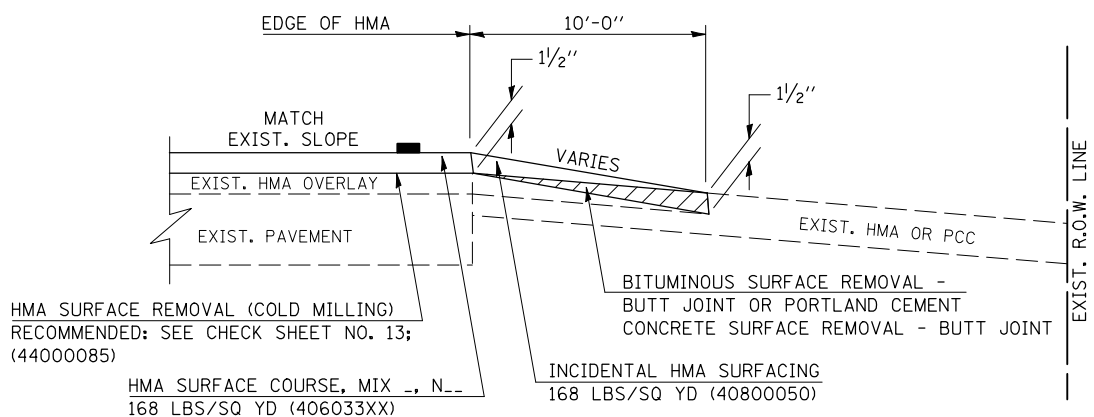

EXISTING HMA OR PCC ENTRANCE

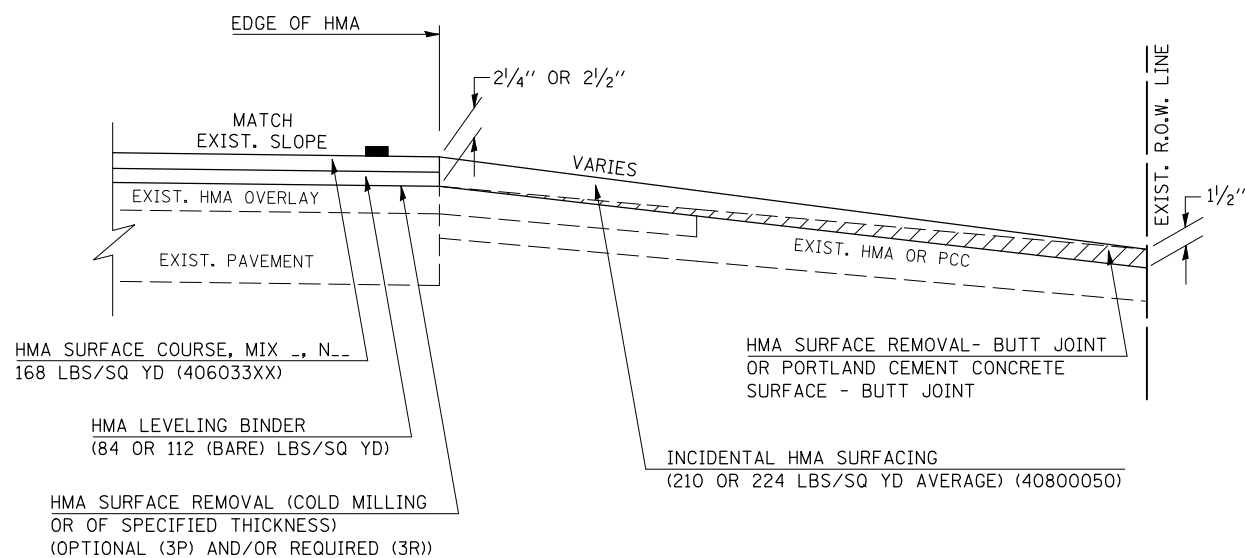

EXISTING HMA OR PCC ENTRANCE

Note: All dimensions are in INCHES (millimeters) unless otherwise shown.

DISTRICT 5 DETAIL NO. 40800050C

FILE NAME =	USER NAME = shererjm	DESIGNED -	REVISED - 12/08/06 TJB
ct:\pw\work\PIWIDOT\SHERERJM\dms86674\0570388-shr-details.dgn		DRAWN -	REVISED - 09/21/07 KAG
		CHECKED -	REVISED - 05/02/08 KJT
		DATE -	REVISED -

**STATE OF ILLINOIS
DEPARTMENT OF TRANSPORTATION**

**PRIVATE AND COMMERCIAL ENTRANCES
(NONCOMMERCIAL AND COMMERCIAL RURAL)**

SCALE: NA SHEET NO. 1 OF 2 SHEETS STA. TO STA.





F.A.S. RTE.	SECTION	COUNTY	TOTAL SHEETS	SHEET NO.
1517	12VBR-1	PIATT	168	74
CONTRACT NO. 70388				
FED. ROAD DIST. NO. ILLINOIS FED. AID PROJECT				

DESIGNER NOTE: SEE PLAN PREPARATION MEMORANDUM 40-09

DESIGNER NOTE: SEE PLAN PREPARATION MEMORANDUM 40-09

PROJECTS WITH RECONSTRUCTION

(3R IMPROVEMENTS)

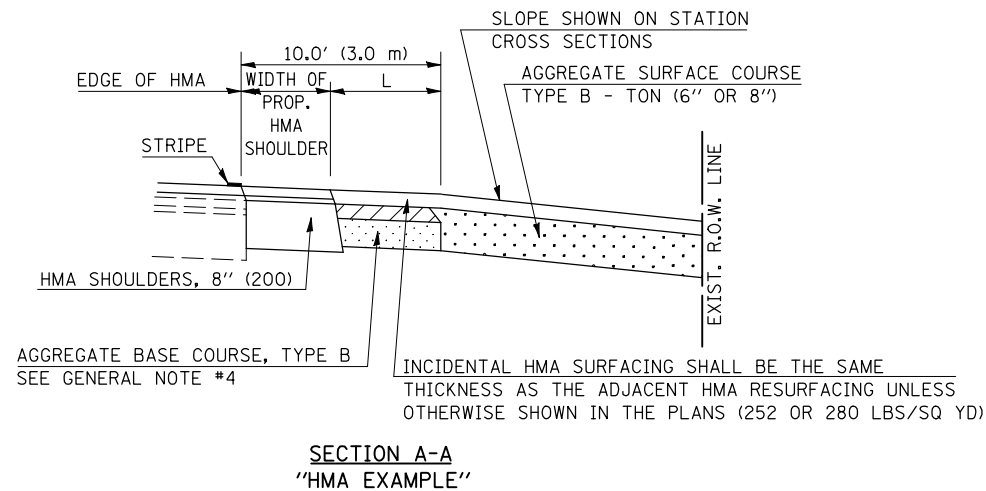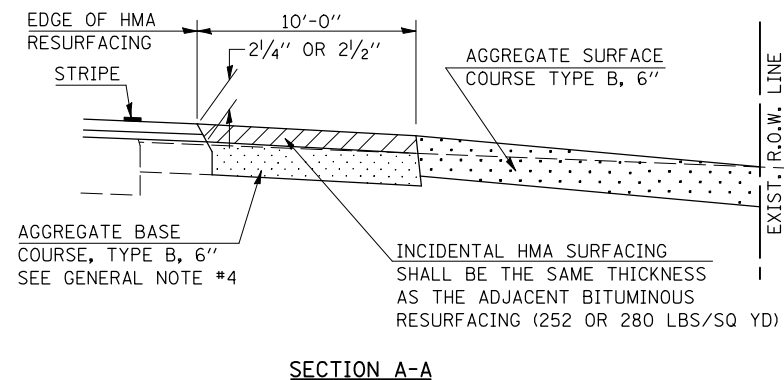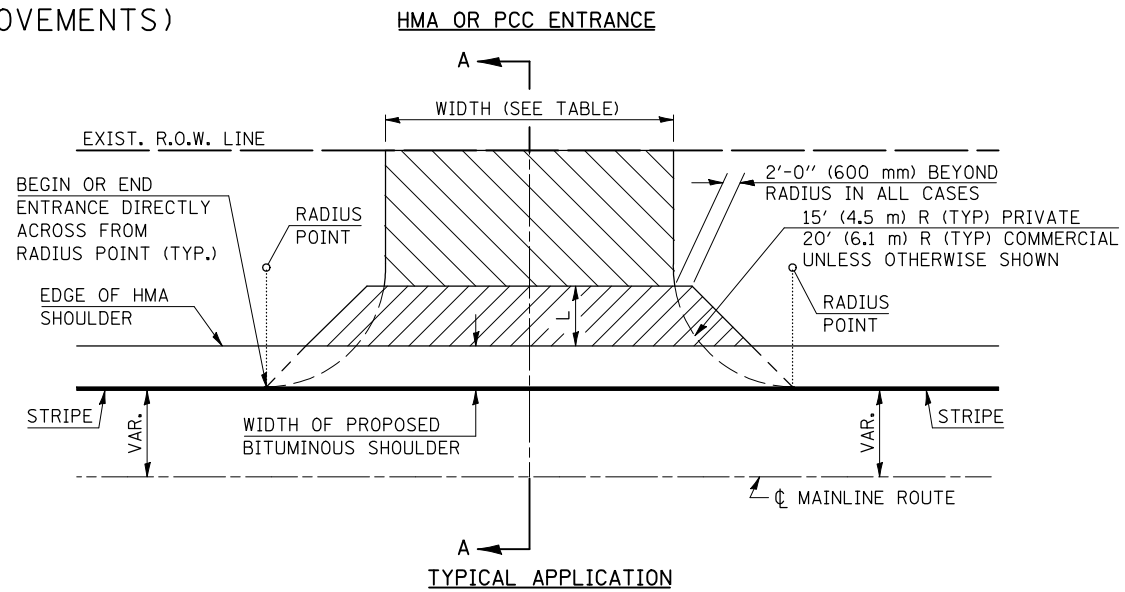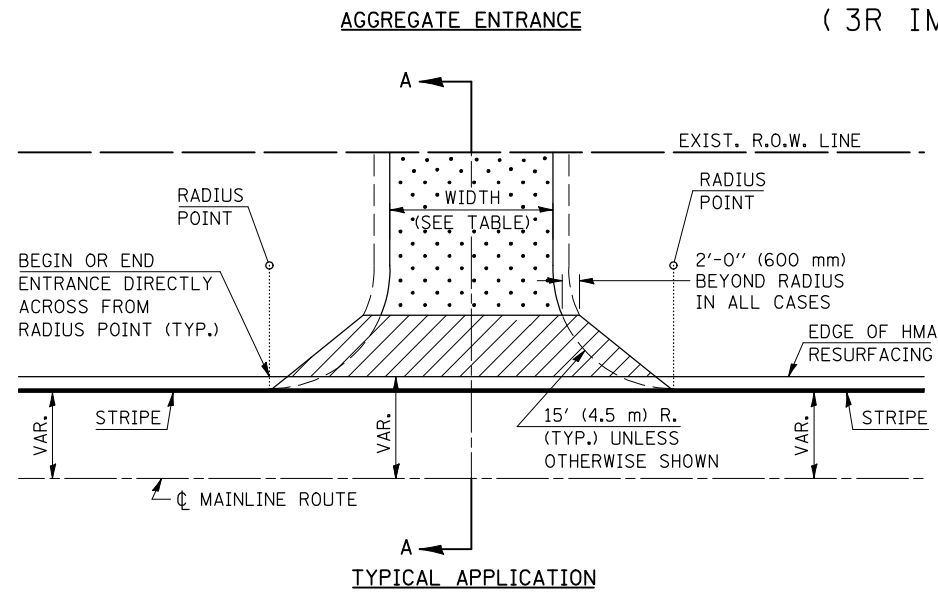

GENERAL NOTES

1. THE EXISTING SURFACE SHALL BE PREPARED IN ACCORDANCE WITH SECTION 408 OF THE STANDARD SPECIFICATIONS.
2. ANY NECESSARY WORK BEHIND THE HMA SHOULDER OR THE INCIDENTAL HMA SURFACING SHALL BE AS SHOWN IN THE PLANS AND/OR AS DIRECTED BY THE ENGINEER.
3. EARTH EXCAVATION REQUIRED FOR THE CONSTRUCTION OF THE AGGREGATE SURFACE COURSE SHALL BE INCLUDED IN THE COST OF AGGREGATE SURFACE COURSE.
4. AGGREGATE BASE COURSE, TYPE B, 6" (150 mm) MIN. SHALL BE USED WHERE IN THE OPINION OF THE ENGINEER THERE IS NOT SUFFICIENT BASE MATERIAL FOR THE PROPOSED ENTRANCES. THIS MATERIAL SHALL GENERALLY BE USED TO WIDEN ANY EXISTING RETURN OR TO CONSTRUCT NEW ENTRANCES WHERE NONE NOW EXISTS.
5. THE AGGREGATE BASE COURSE SHALL BE CONSTRUCTED 12" (300 mm) WIDER THAN THE SURFACE DIMENSIONS AS SHOWN ABOVE.
6. EXISTING FIELD ENTRANCES OF AGGREGATE OR EARTH WITH NO HMA APRON SHALL NOT RECEIVE A NEW HMA APRON WITHOUT PROPER APPROVAL THROUGH THE BUREAU OF OPERATIONS "POLICY ON PERMITS FOR ACCESS DRIVEWAYS TO STATE HIGHWAYS".
7. TO ASSURE APPROPRIATE ACCESS POLICIES ARE FOLLOWED ALL NEW ACCESS SHALL BE APPLIED FOR THROUGH THE BUREAU OF OPERATIONS PERMIT APPLICATION PROCESS. PLAN PREPARATION MEMORANDUMS 40-09 AND 40-11 ALONG WITH DISTRICT CONSTRUCTION MEMORANDUM 03/14 DISCUSS THIS PROCEDURE.

RURAL ENTRANCE DESIGN STANDARDS (PPM 40-09)														
DESIGN ELEMENT	NEW CONSTRUCTION & 3R with RECONSTRUCTION						3R w/out RECONSTRUCTION, 3P, SMART & CM							
	NONCOMMERCIAL						NONCOMMERCIAL							
	PRIVATE & FIELD			FIELD W/ FARM IMPLEMENTS			COMMERCIAL			PRIVATE & FIELD			COMMERCIAL	
	min.	des.	max.	min.	max.	min.	des.	max.	min.	des.	max.	min.	des.	max.
SURFACE WIDTH (FT)	12	16	24	24	30	1 LANE, 1 WAY			1 LANE, 1 WAY			1 LANE, 1 WAY		
						14	16	24						
RADIUS (FT)	15	25	40	30		2 LANE, 2 WAY			2 LANE, 2 WAY			2 LANE, 2 WAY		
						24	30	35						
SHOULDER WIDTH (FT)	2	2		2		1	3		resurface existing configuration; existing hma or pcc entrances shall have "butt joints" constructed; existing aggregate or earth entrances shall have the continuation of aggregate shoulders placed behind them					
SHOULDER SLOPE (%)	2	4	6	4		2	4	6						
ENTRANCE GRADE (%)	0	2 to 5	10 or 12	2 to 5	10 or 12	0	2 to 5	8 or 10						
SIDE SLOPE (FT)	1:10	1:6	1:4	1:6	1:4	1:10	1:6	1:4						
SURFACE TYPE														
INCIDENTAL HMA SURFACING (INCH)		2		2		3 or 4			taper from hma resurfacing thickness (2 1/2", 2 1/4" or 1 1/2") to 1 1/2" for "butt joints" and to minimize aggregate shoulder					
AGGREGATE SURFACE COURSE, TYPE B (INCH)		6		6		8			if applicable use items: Preparation of Base & Aggregate Base Repair; see PPM 30-02					
PCC DRIVEWAY PAVEMENT (INCH)		6							6 or 8					

Note: All dimensions are in INCHES (millimeters) unless otherwise shown.

DISTRICT 5 DETAIL NO. 4080050C



FILE NAME =	USER NAME = shererjm	DESIGNED -	REVISED - 12/08/06 TJB
ct:\pw\work\PIWIDOT\SHERERJM\dms86674\0570388-shr-detail1.dgn		DRAWN -	REVISED - 09/21/07 KAG
	PLOT SCALE = 40.0000' / IN.	CHECKED -	REVISED - 05/02/08 KJT
	PLOT DATE = 10/13/2009	DATE -	REVISED -

**STATE OF ILLINOIS
DEPARTMENT OF TRANSPORTATION**



PRIVATE AND COMMERCIAL ENTRANCES (NONCOMMERCIAL AND COMMERCIAL RURAL)			
SCALE: NA	SHEET NO. 2 OF 2 SHEETS	STA.	TO STA.

F.A.S. RTE.	SECTION	COUNTY	TOTAL SHEETS	SHEET NO.
1517	12VBR-1	PIATT	168	75
CONTRACT NO. 70388				
FED. ROAD DIST. NO. ILLINOIS FED. AID PROJECT				

PROJECTS WITHOUT RECONSTRUCTION

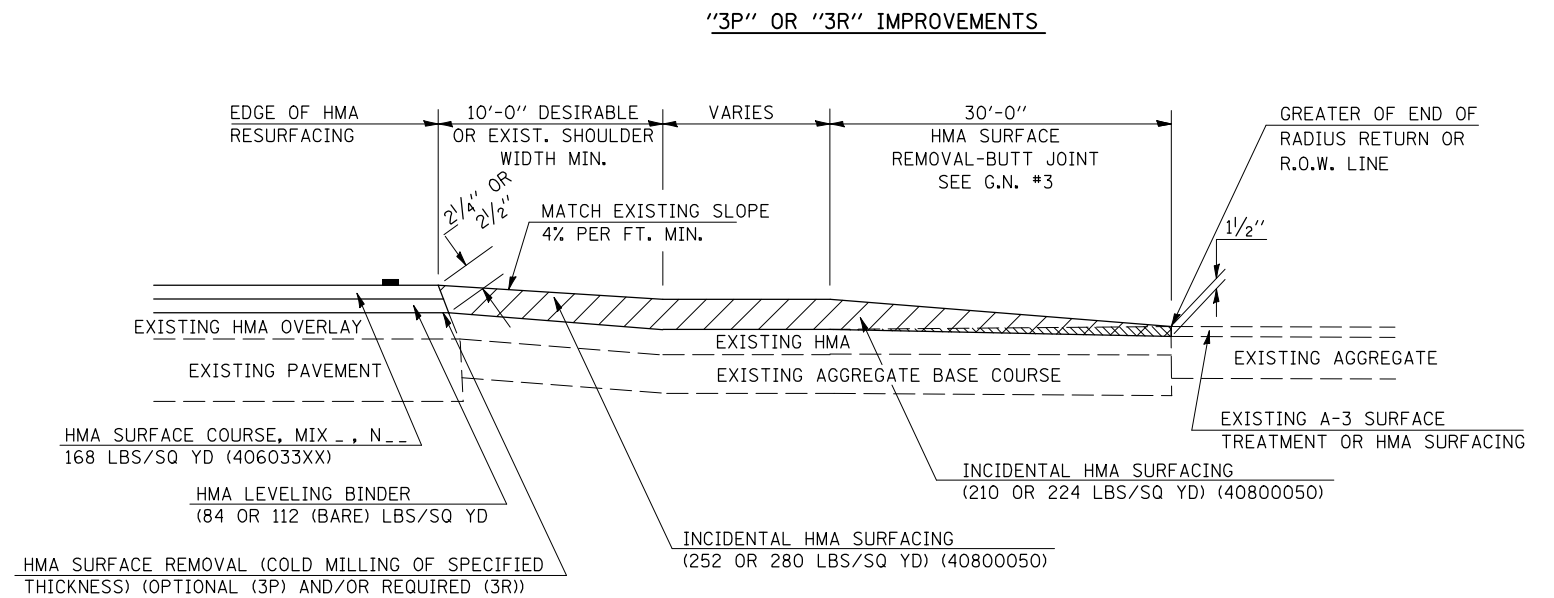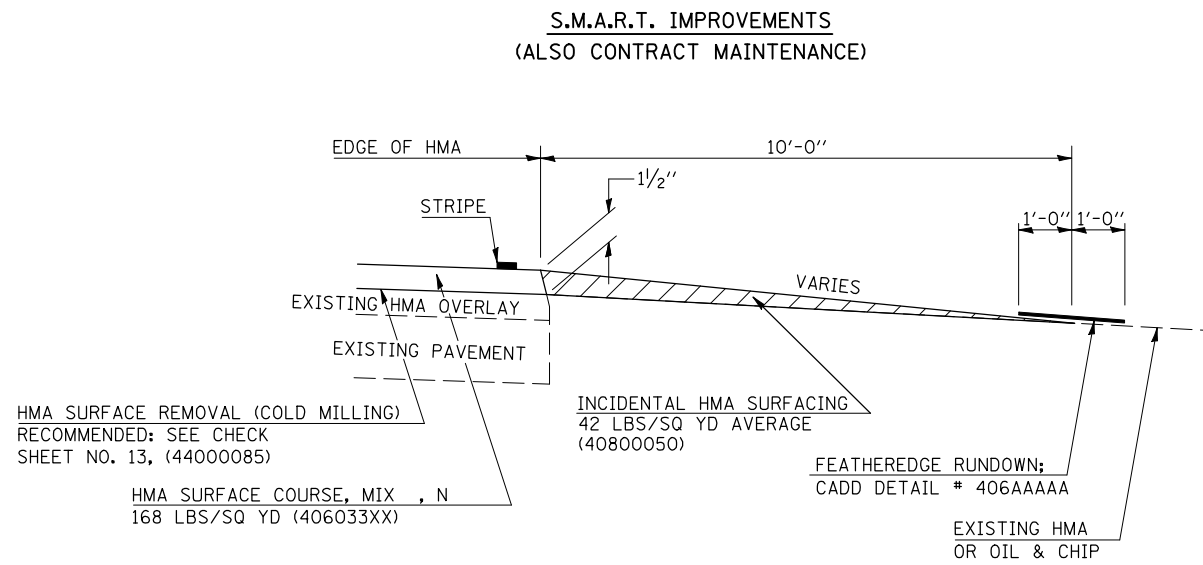

PROJECTS WITH RECONSTRUCTION ("3R" IMPROVEMENTS)

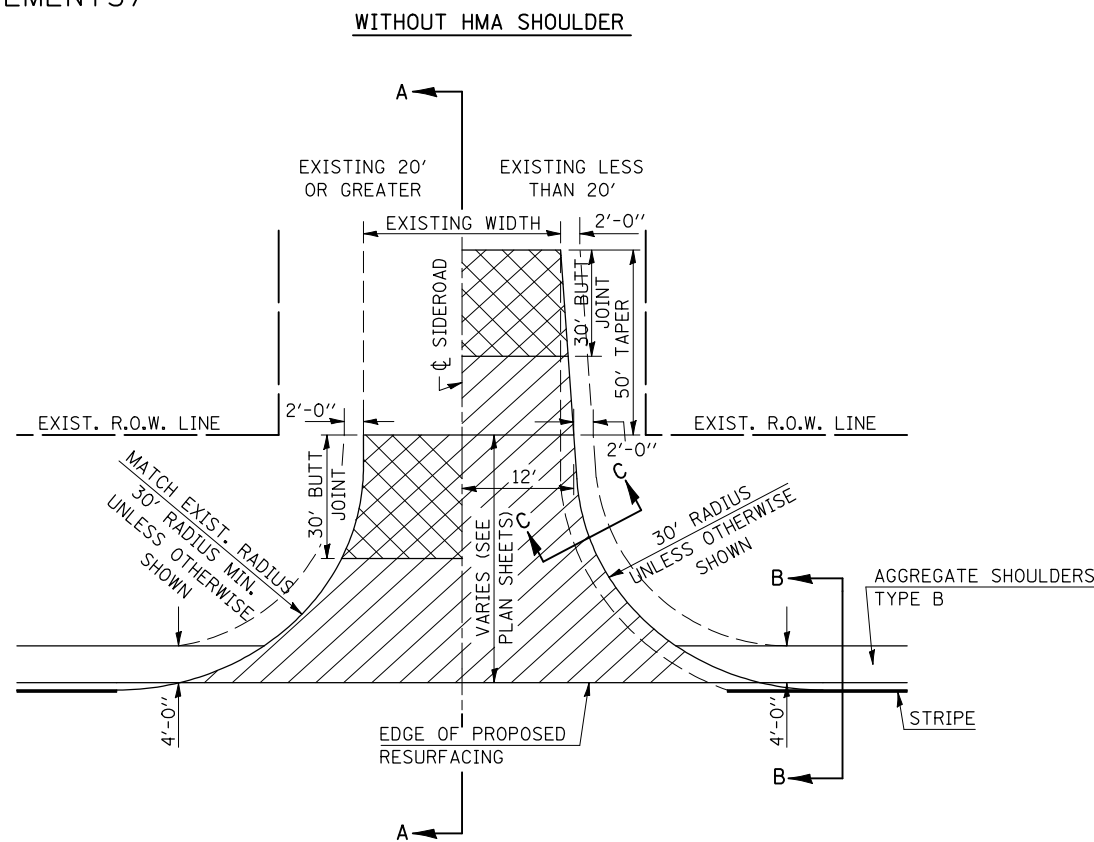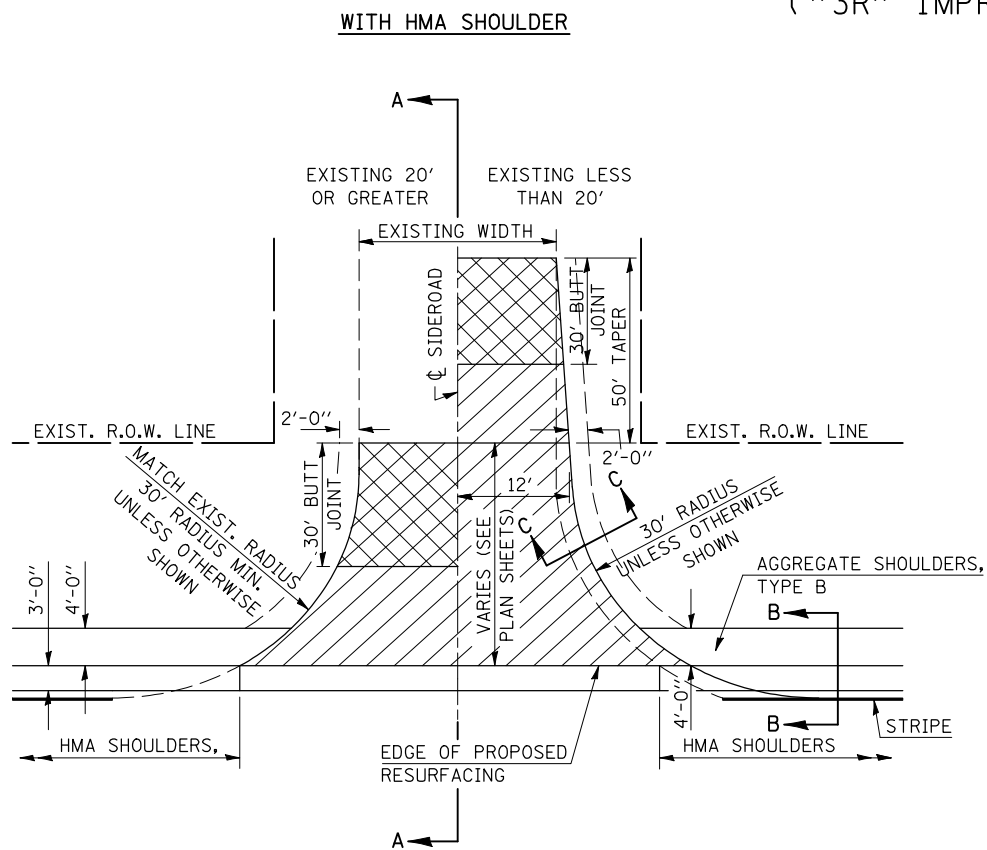

GENERAL NOTES

1. THE EXISTING SURFACE SHALL BE PREPARED IN ACCORDANCE WITH SECTION 408 OF THE STANDARD SPECIFICATIONS
2. PROPOSED SIDEROAD GRADES SHALL BE AS SHOWN IN THE PLANS AND/OR AS DIRECTED BY THE ENGINEER.
3. MAJOR SIDEROAD/SIDESTREETS (>400 ADT) SHALL HAVE "BUTT JOINTS" CONSTRUCTED WHETHER THE EXISTING ENTRANCE IS HMA OR PCC. MINOR SIDEROAD/SIDESTREETS (<400 ADT) SHALL HAVE "FEATHEREDGE RUNDOWNS".
4. AGGREGATE BASE COURSE, TYPE B OF THE THICKNESS SPECIFIED IN THE PLANS 6" MIN. SHALL BE USED WHERE IN THE OPINION OF THE ENGINEER THERE IS NOT 6" EXISTING BASE MATERIAL FOR THE PROPOSED SIDEROAD RETURNS. THIS MATERIAL SHALL BE USED TO WIDEN SIDEROAD RETURNS.
5. THE AGGREGATE BASE COURSE SHALL BE CONSTRUCTED 1' WIDER THAN THE SURFACE DIMENSIONS.
6. AGGREGATE SHOULDERS, TYPE B WILL BE WRAPPED AROUND THE SIDEROAD RETURNS. TAPER WIDTH FROM 4' ALONG MAINLINE TO 2' AT BACK OF RETURN.

Note: All dimensions are in INCHES (millimeters) unless otherwise shown.

DISTRICT 5 DETAIL NO. 408000AA

FILE NAME =	USER NAME = shererjm	DESIGNED -	REVISED - 12/13/06 TJB
ct:\pw\work\PWID01\SHERRERJM\dms86674\0570388-shr-detail1.dgn		DRAWN -	REVISED - 09/21/07 KAG
		CHECKED -	REVISED -
		DATE -	REVISED -

STATE OF ILLINOIS
DEPARTMENT OF TRANSPORTATION

SIDEROADS & SIDESTREETS (RURAL)


SCALE: NA SHEET NO. 1 OF 2 SHEETS STA. TO STA.

F.A.S. RTE.	SECTION	COUNTY	TOTAL SHEETS	SHEET NO.
1517	12VBR-1	PIATT	168	76
CONTRACT NO. 70388				
FED. ROAD DIST. NO. ILLINOIS FED. AID PROJECT				


DESIGNER NOTE: SEE PLAN PREPARATION MEMORANDUM 40-06 CONSULT CHAPTER 49 OF BDE MANUAL

DESIGNER NOTE: SEE PLAN PREPARATION MEMORANDUM 40-06 CONSULT CHAPTER 49 OF BDE MANUAL


SECTION A-A
EXISTING HMA OR PCC SIDEROAD (>400 ADT)

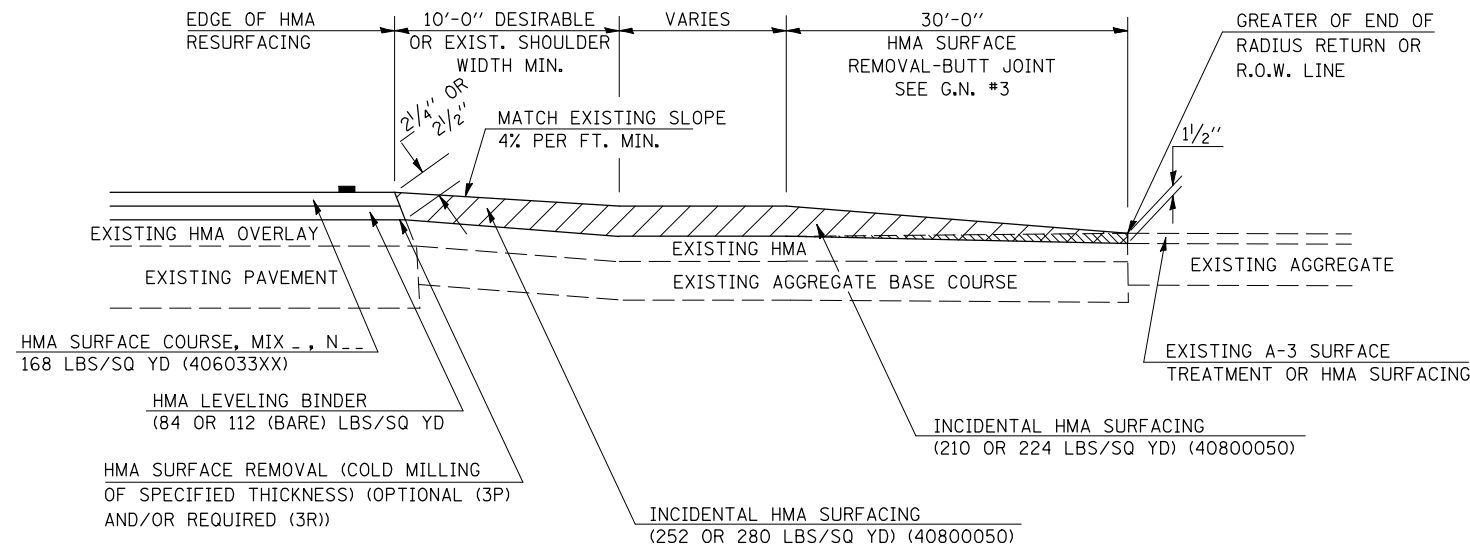


SECTION A-A
EXISTING AGGREGATE OR SEAL COAT SIDEROAD (<400 ADT)

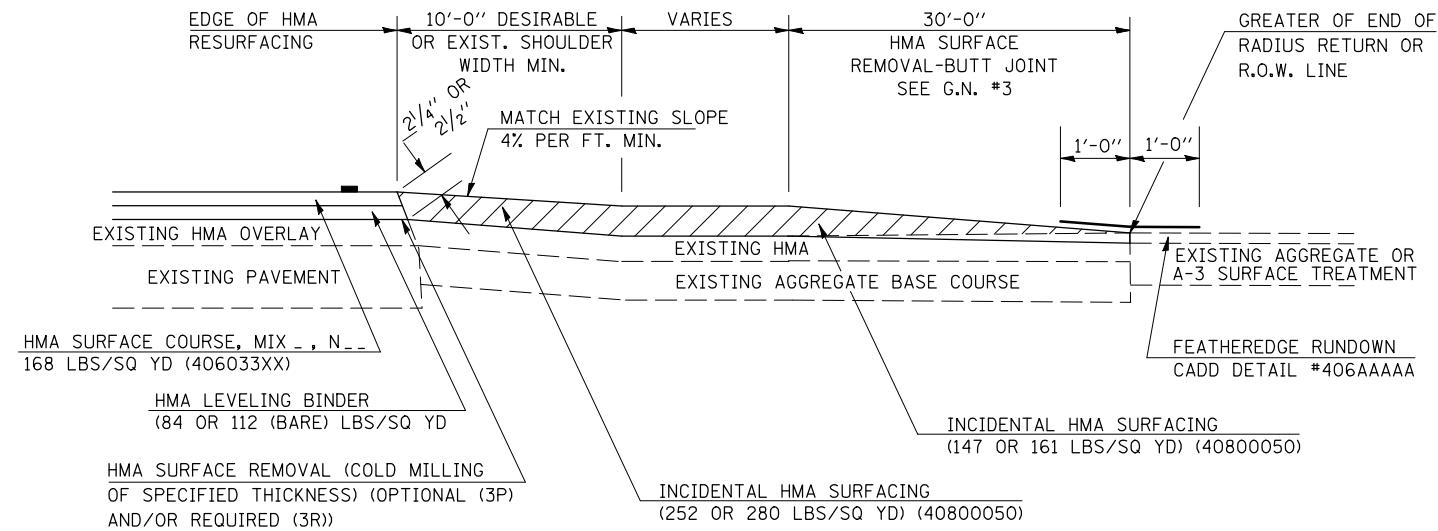

RURAL SIDEROAD DESIGN STANDARDS (PPM 40-06)											
DESIGN ELEMENT	New Construction & 3R (Existing Width Less Than 20 ft)			3R (Existing Width 20 ft or Greater) & 3P			SMART & Contract Maintenance				
	min.	des.	max.	min.	des.	max.	min.	des.	max.		
SURFACE WIDTH (FT); (measured at end of radius or row line; greatest distance from edge of traveled way)	24	24	Coordinate with Geometrics Engineer	resurface existing configuration to completion of radius return or row line; greatest distance from edge of traveled way; major sideroads (> 400 adt) shall have "butt joints" constructed whether the entrance is hma or pcc; minor sideroads (< 400 adt) shall have "featheredge rundown" as shown in district cadd detail 406AAAAA						resurface existing configuration with the completion of a 10 ft. featheredge rundown for ALL sideroads as shown in district cadd detail 406AAAAA	
RADIUS (FT)	30	30									
SHOULDER WIDTH (FT)	4	8	10								
SHOULDER SLOPE (%)	2	4	12								
ENTRANCE GRADE (%)	1	1 to 4	4								
BREAKOVER (%)	0	5	10								
SIDE SLOPE	1:10	1:6	1:4								
INTERSECTION ANGLE	60	75 to 90									
SURFACE TYPE											
INCIDENTAL HMA SURFACING (INCH)	4			taper from 2 1/4" to 1 1/2" or featheredge			taper from 1 1/2" to featheredge				
AGGREGATE BASE COURSE, TYPE A (INCH)	8	4		if applicable use item: 35800100 Preparation of Base							
PCC PAVEMENT (INCH)		8									

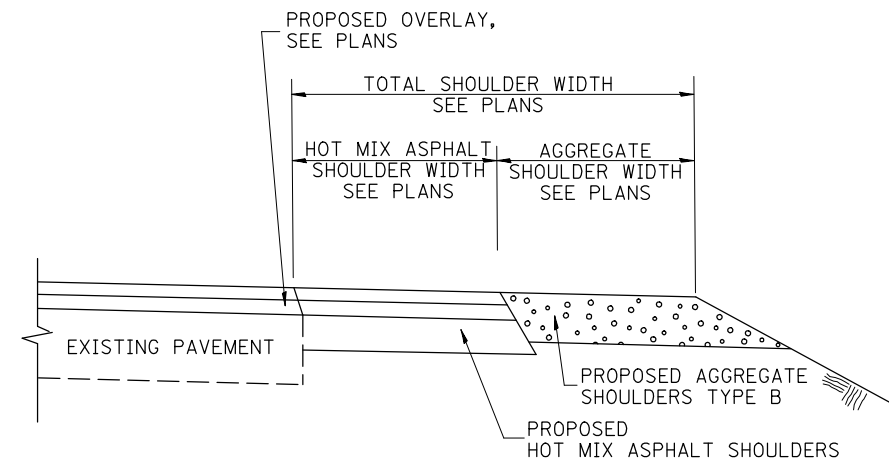

SECTION B-B
MAINLINE SHOULDER TREATMENT

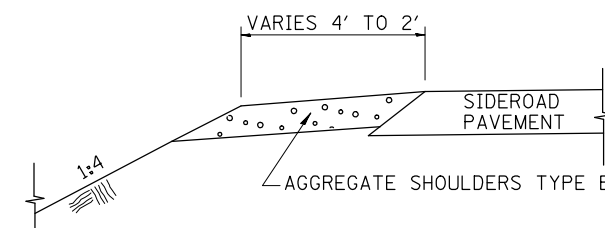

SECTION C-C
SIDEROAD SHOULDER TREATMENT

Note: All dimensions are in INCHES (millimeters) unless otherwise shown.

DISTRICT 5 DETAIL NO. 40800AA

FILE NAME =	USER NAME = shererjm	DESIGNED -	REVISED - 12/13/06 TJB
ct:\pw\work\PIWIDOT\SHERRERJM\dms86674\0570388-sh1-details.dgn		DRAWN -	REVISED - 09/21/07 KAG
	PLOT SCALE = 40.0000' / IN.	CHECKED -	REVISED -
	PLOT DATE = 10/13/2009	DATE -	REVISED -

STATE OF ILLINOIS
DEPARTMENT OF TRANSPORTATION

SIDEROADS & SIDESTREETS (RURAL)


SCALE: NA SHEET NO. 2 OF 2 SHEETS STA. TO STA.

F.A.S. RTE.	SECTION	COUNTY	TOTAL SHEETS	SHEET NO.
1517	12VBR-1	PIATT	168	77
CONTRACT NO. 70388				
FED. ROAD DIST. NO. ILLINOIS FED. AID PROJECT				

ROAD CLOSURE

SIDEROAD / STREET CLOSURE


SYMBOLS	
	TYPE III BARRICADE (SEE NOTE 1)
	FLASHING AMBER LIGHT (TYPE A)

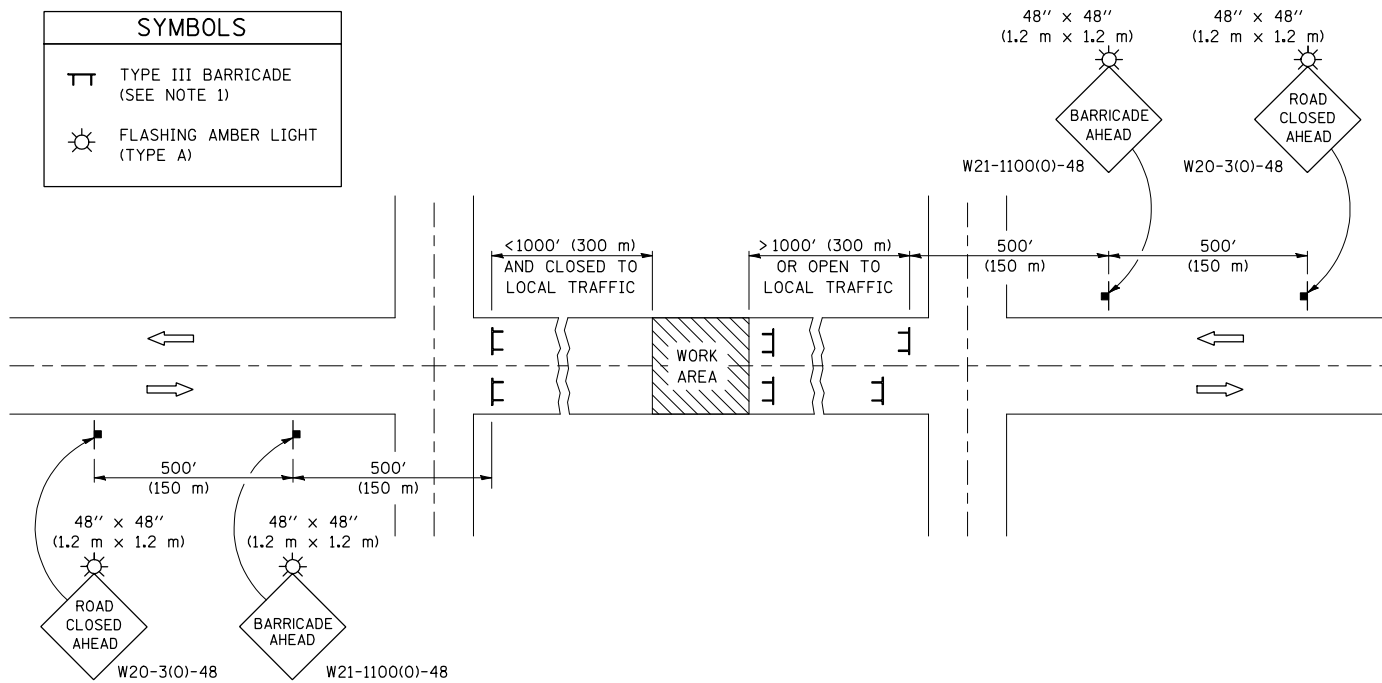

GENERAL NOTES

- TYPE III BARRICADES SHALL BE AS SHOWN ON STANDARD 701901 "TYPICAL APPLICATIONS OF TYPE III BARRICADES CLOSING A ROAD". EACH TYPE III BARRICADE SHALL HAVE TWO FLASHING AMBER LIGHTS MOUNTED ABOVE IT.
- IF THE ROAD IS OPEN TO LOCAL TRAFFIC OR EXCEEDS 1000' (300 m), ANOTHER SET OF TYPE III BARRICADES, EQUIPPED AS IN NOTE 1 ABOVE, SHALL BE PLACED AT EACH END OF THE WORK AREA.
- WHEN A STOP CONDITION EXISTS, NO SIGNS ARE REQUIRED IN ADVANCE OF THE "STOP" SIGN WHEN THE ROAD IS CLOSED WITHIN 100' (30 m) OF THE INTERSECTION.
- STANDARD 701901 SHALL APPLY FOR THE PLACEMENT & DESIGN OF TYPE III BARRICADES.
- IF A TYPE III BARRICADE WITH AN ATTACHED SIGN PANEL WHICH MEETS NCHRP 350 IS NOT AVAILABLE, THE SIGNS MAY BE MOUNTED ON AN NCHRP 350 TEMPORARY SIGN SUPPORT DIRECTLY IN FRONT OF THE BARRICADE.
- REFLECTORIZED STRIPING SHALL APPEAR ON BOTH SIDES OF THE TY III BARRICADES IF ROAD IS OPEN TO LOCAL TRAFFIC.
- ALL SIGNS SHALL BE POST MOUNTED IF THE CLOSURE TIME EXCEEDS FOUR DAYS.
- A MINIMUM OF TWO FLASHING LIGHTS SHALL BE USED AT NIGHT ON EACH APPROACH IN ADVANCE OF THE WORK AREA. FLASHING LIGHTS SHALL BE INSTALLED ABOVE THE FIRST TWO SIGNS IN THE SERIES.
- LONGITUDINAL DIMENSIONS MAY BE ADJUSTED SLIGHTLY TO FIT FIELD CONDITIONS.
- FORMS BT. 725 AND BT. 726 ARE REQUIRED.
- WHEN A SIDEROAD INTERSECTS THE HIGHWAY ON WHICH WORK IS BEING PERFORMED, ADDITIONAL TRAFFIC DEVICES SHALL BE ERECTED AND PROVIDED AS DIRECTED BY THE ENGINEER.
- AN ADDITIONAL SIGN MAY BE REQUIRED AT A MAJOR INTERSECTING ROAD IN ADVANCE OF THE CLOSURE. THE ADDITIONAL SIGN SHALL GIVE THE DISTANCE TO THE BARRICADE IN MILES OR FRACTIONS OF A MILE.

SYMBOLS	
	TYPE III BARRICADE (SEE NOTE)
	FLASHING LIGHT
	FLAGGER WITH TRAFFIC CONTROL SIGN (WHILE WORK IS BEING PERFORMED)
	CONE (DAYLIGHT HOURS ONLY), DRUM, TYPE I OR TYPE II BARRICADE
	WORK AREA
	TRAFFIC FLOW

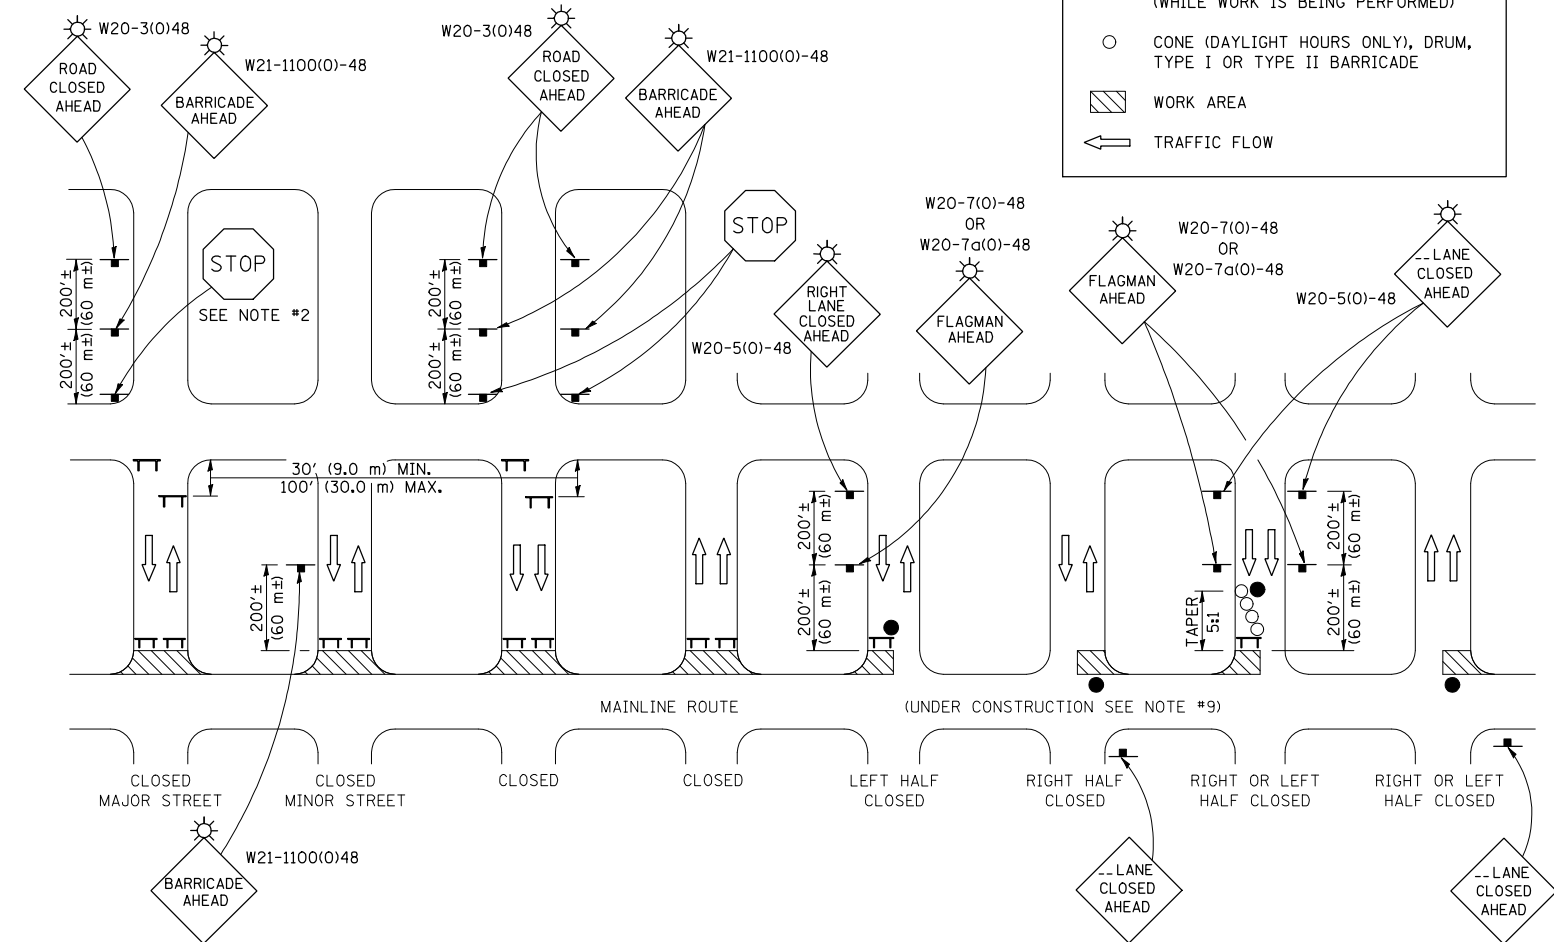

GENERAL NOTES

- TYPE III BARRICADES SHALL BE AS SHOWN ON "TYPICAL APPLICATIONS OF TYPE III BARRICADES CLOSING A ROAD". EACH TYPE III BARRICADE SHALL HAVE TWO FLASHING AMBER LIGHTS MOUNTED ABOVE IT.
- WHERE A STOP CONDITION EXISTS, AS SHOWN ABOVE, WARNING SIGNS MAY BE OMITTED IN ADVANCE OF THE "STOP" SIGN.
- STANDARD 701901 SHALL APPLY FOR THE PLACEMENT & MANUFACTURE OF TYPE III BARRICADES.
- ALL SIGNS SHALL BE POST MOUNTED IF THE CLOSURE TIME EXCEEDS FOUR DAYS.
- ONE FLASHING LIGHT IS REQUIRED ABOVE EACH ADVANCE WARNING SIGN DURING HOURS OF DARKNESS.
- LONGITUDINAL DIMENSIONS MAY BE ADJUSTED SLIGHTLY TO FIT FIELD CONDITIONS.
- FORMS BT 725 AND BT 726 ARE REQUIRED.
- THE MAINLINE ROUTE TEMPORARY TRAFFIC CONTROL SHALL BE IN ACCORDANCE WITH THE PLANS, SPECIAL PROVISIONS AND STANDARD SPECIFICATIONS.
- THIS WORK WILL NOT BE PAID FOR SEPARATELY BUT SHALL BE CONSIDERED INCLUDED IN THE VARIOUS PAY ITEMS INVOLVING THE RECONSTRUCTION OF ALL APPLICABLE SIDE STREETS AND NO ADDITIONAL COMPENSATION WILL BE ALLOWED.

Note: All dimensions are in INCHES (millimeters) unless otherwise shown.

DISTRICT 5 DETAIL NO. 7020000


FILE NAME =	USER NAME = shererjm	DESIGNED -	REVISED - 11/06
ct:\pw\work\PWIDOT\SHERERJM\dms86674\0570388-shr-details.dgn		DRAWN -	REVISED - 12/07
	PLOT SCALE = 40.0000' / IN.	CHECKED -	REVISED -
	PLOT DATE = 10/13/2009	DATE -	REVISED -

STATE OF ILLINOIS
DEPARTMENT OF TRANSPORTATION

TRAFFIC CONTROL & PROTECTION DEVICES
(ROAD & SIDEROAD/STREET CLOSURES)


SCALE: SHEET NO. OF SHEETS STA. TO STA.

F.A.S. RTE.	SECTION	COUNTY	TOTAL SHEETS	SHEET NO.
1517	12VBR-1	PIATT	168	78
CONTRACT NO. 70388				
FED. ROAD DIST. NO. ILLINOIS FED. AID PROJECT				

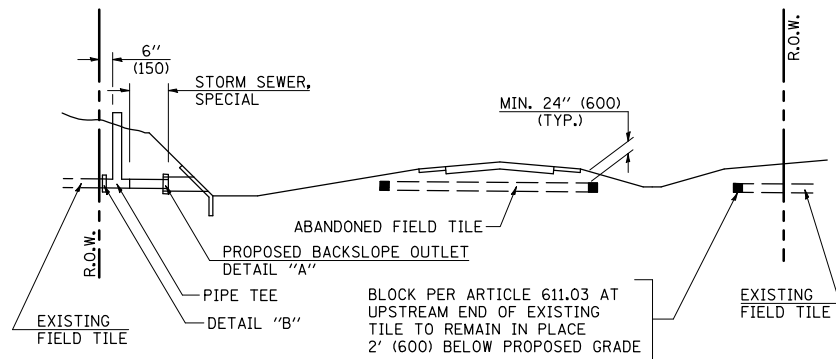


METHOD 'A' (2 LANE)

STORM SEWER FLOW LINE ABOVE PROPOSED DITCH FLOW LINE

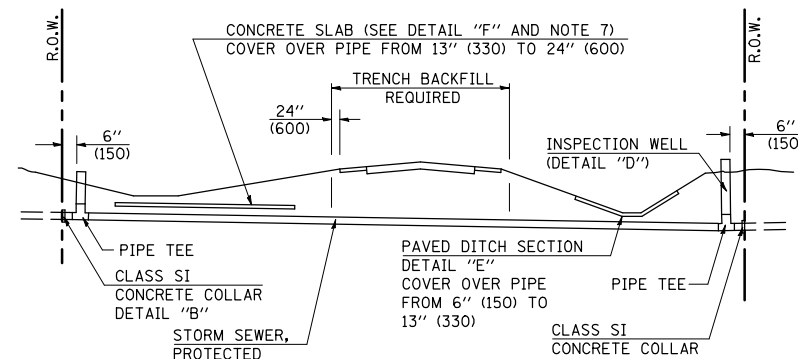


METHOD 'B' (2 LANE)

STORM SEWER LESS THAN 2' (600 mm) BELOW DITCH FLOW LINE AND STORM SEWERS CROSSING UNDER PAVEMENT AND PAVED DITCH

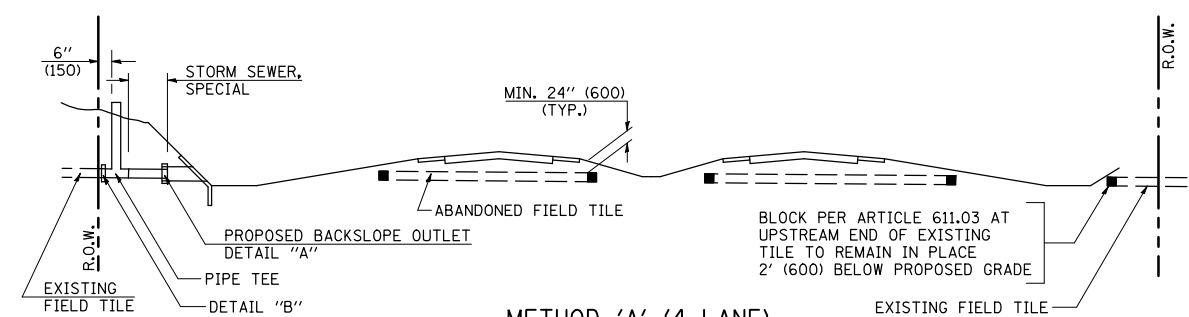


METHOD 'A' (4 LANE)

STORM SEWER FLOW LINE ABOVE PROPOSED DITCH FLOW LINE

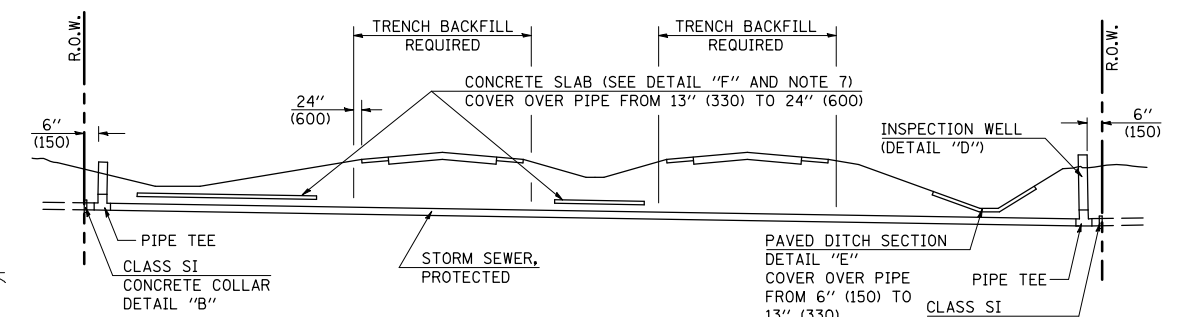


METHOD 'B' (4 LANE)


STORM SEWER LESS THAN 2' (600 mm) BELOW DITCH FLOW LINE AND STORM SEWERS CROSSING UNDER PAVEMENTS AND PAVED DITCHES

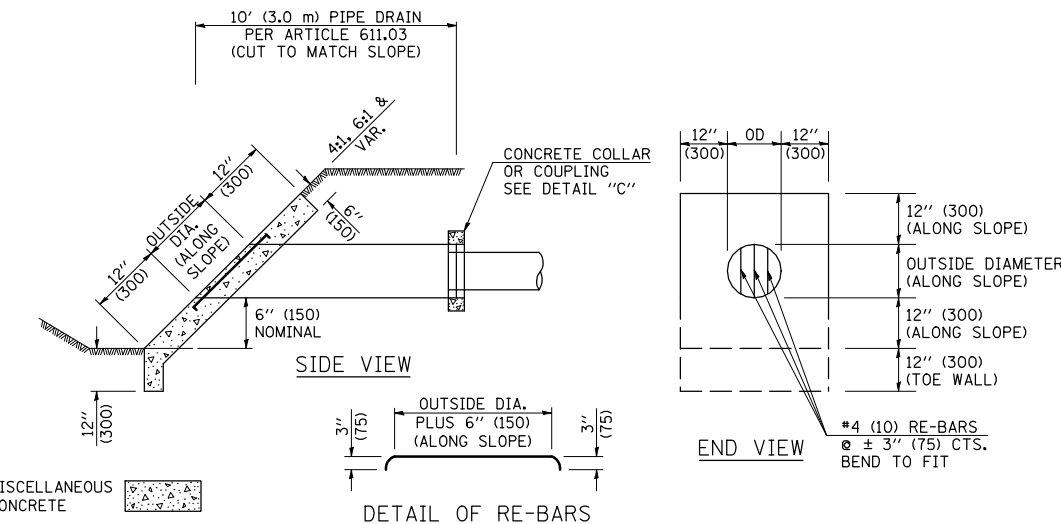


HEADWALL FOR BACKSLOPE OUTLET DETAIL 'A'

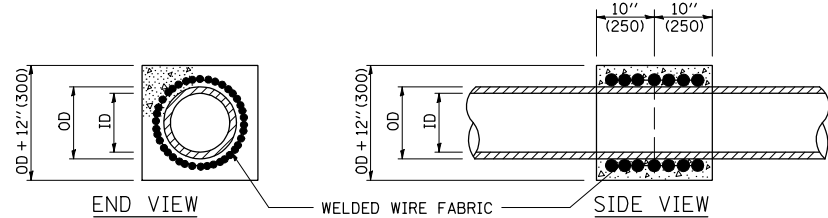

CONCRETE COLLAR DETAIL 'B'

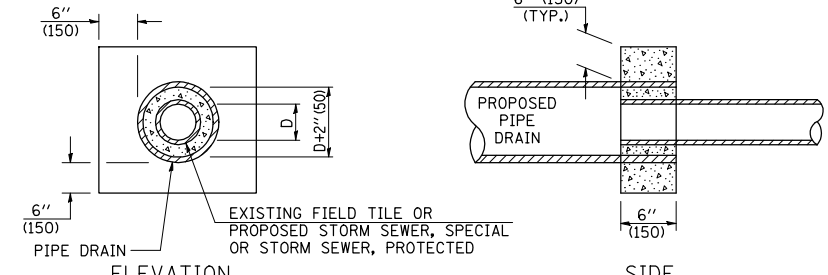


CLASS SI COLLAR DETAIL 'C'

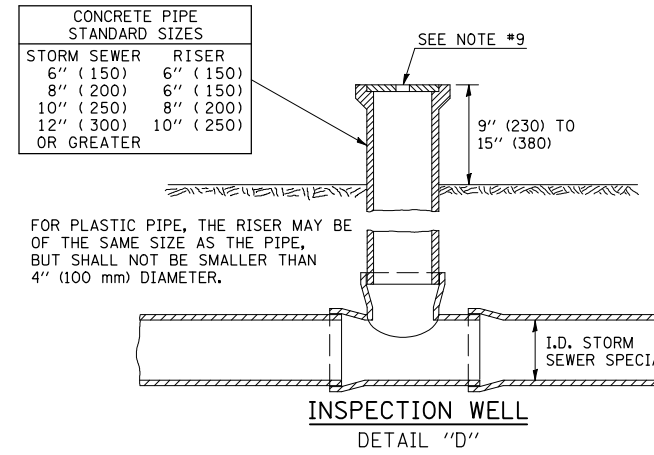


GENERAL NOTES

- EXISTING FIELD TILE ENCOUNTERED BY EXPLORATION TRENCH SHALL BE INSPECTED BY THE ENGINEER FOR UNOBSTRUCTED FLOW WITHIN THE LIMITS OF THE RIGHT-OF-WAY.
- ONLY FIELD TILE THAT DOES NOT HAVE SATISFACTORY FLOW AND OR HAS VISIBLE SIGNS OF DETERIORATION (SINK HOLES, ETC.) SHALL BE REPLACED WITHIN THE LIMITS OF THE RIGHT-OF-WAY IN ACCORDANCE WITH METHOD "B".
- INSPECTION WELLS SHALL BE CONSTRUCTED APPROXIMATELY 6" (150 mm) INSIDE OF BOTH RIGHT-OF-WAY LINES AT ALL FIELD TILE LOCATIONS.
- EXISTING FIELD TILE ABANDONED UNDER EXISTING PAVEMENTS OR PAVED SHOULDERS SHALL BE FILLED WITH FLOWABLE GROUT AS DIRECTED BY THE ENGINEER. THIS WORK WILL BE PAID FOR ACCORDING TO ARTICLE 109.04.
- NON-CIRCULAR FIELD TILE SHALL BE REPLACED WITH STORM SEWER, SPECIAL OF AT LEAST THE SAME CROSS SECTIONAL AREA. ALL EXISTING FIELD TILE SHALL BE REPLACED WITH STORM SEWER OF THE TYPE REQUIRED FOR THE MINIMUM DEPTH OF COVER.
- THE 6" (150 mm) CONCRETE SLAB OR DITCH LINING SHALL BE POURED THE LENGTH OF THE TRENCH AT ALL DITCH FLOW LINE LOCATIONS WITHIN THE RIGHT-OF-WAY WITH LESS THAN 2' (600 mm) OF EARTH COVER. MISCELLANEOUS CONCRETE SHALL BE USED ACCORDING TO SECTION 611.
- ALL MISCELLANEOUS SLABS, APRONS AND DITCH LININGS SHALL BE REINFORCED WITH WELDED WIRE FABRIC AS SHOWN FOR PAVED DITCH IN STANDARD 606401.
- HEADWALL FOR BACKSLOPE OUTLET MAY BE USED FOR PIPE DRAIN DIAMETERS UP TO 10" (250 mm). SPECIAL DESIGNS WILL BE REQUIRED FOR LARGER SIZES.
- THE INSPECTION WELL LID FOR P.C.C. PIPE SHALL BE CONSTRUCTED OF 3/8" (10 mm) CAST IRON AND PROVIDED WITH A 1" (25 mm) DIAMETER HOLE IN CENTER. THE LID FOR THE OTHER PIPE MATERIALS SHALL BE A GRATE ASSEMBLY PREFABRICATED FOR AND COMPATIBLE WITH THE PIPE SYSTEM.

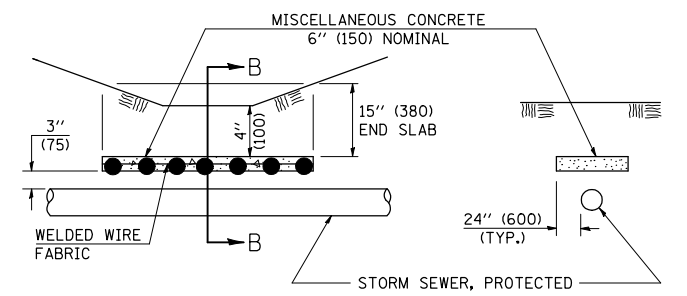


SLAB ELEVATION

CONCRETE SLAB DETAIL 'F'

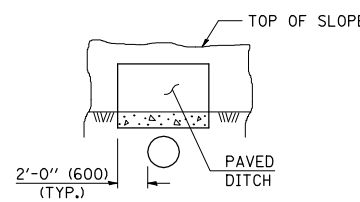

PAVED DITCH DETAIL 'E'

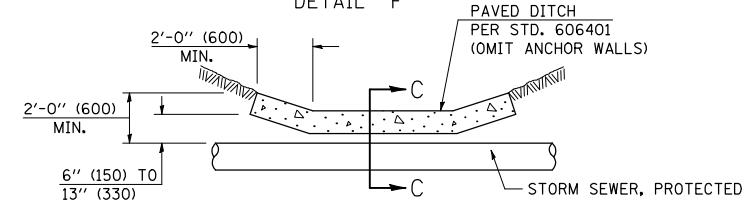

PAVED DITCH ELEVATION

Note: All dimensions are in INCHES (millimeters) unless otherwise shown.

DISTRICT 5 DETAIL NO. 61101011A


FILE NAME =	USER NAME = shererjm	DESIGNED -	REVISED - 11/06
et:\pw\work\PWIDOT\SHERRERJM\dms86674\0570388-shr-deta1.dgn		DRAWN -	REVISED -
	PLOT SCALE = 40.0000' / IN.	CHECKED -	REVISED -
	PLOT DATE = 10/13/2009	DATE -	REVISED -

STATE OF ILLINOIS DEPARTMENT OF TRANSPORTATION


FIELD TILE SYSTEMS (TREATMENT OF EXISTING)

SCALE:	SHEET NO.	OF SHEETS	STA.	TO STA.
--------	-----------	-----------	------	---------


F.A.S. RTE.	SECTION	COUNTY	TOTAL SHEETS	SHEET NO.
1517	12VBR-1	PIATT	168	79
CONTRACT NO. 70388				
FED. ROAD DIST. NO.	ILLINOIS	FED. AID PROJECT		

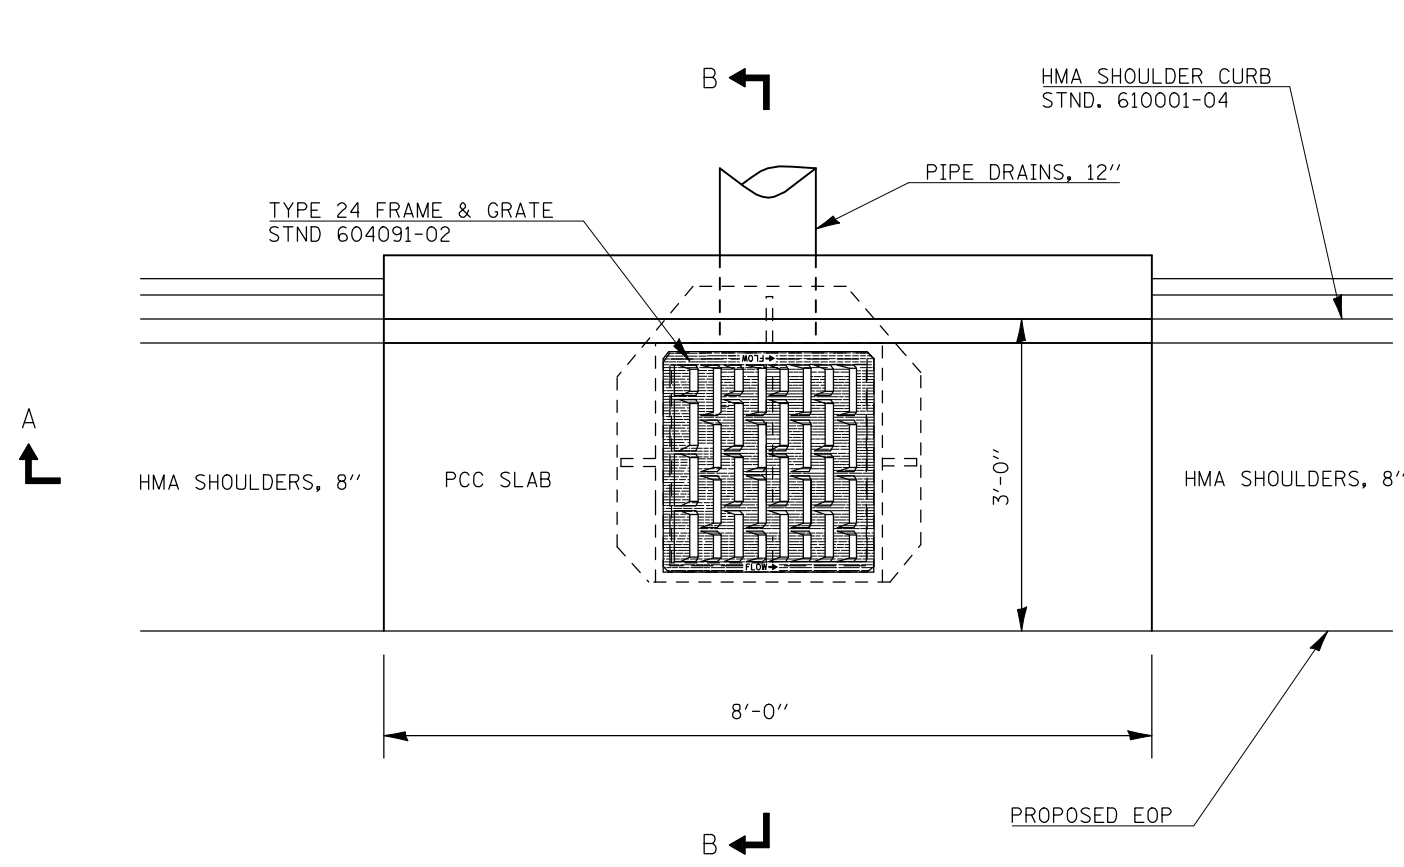

PLAN

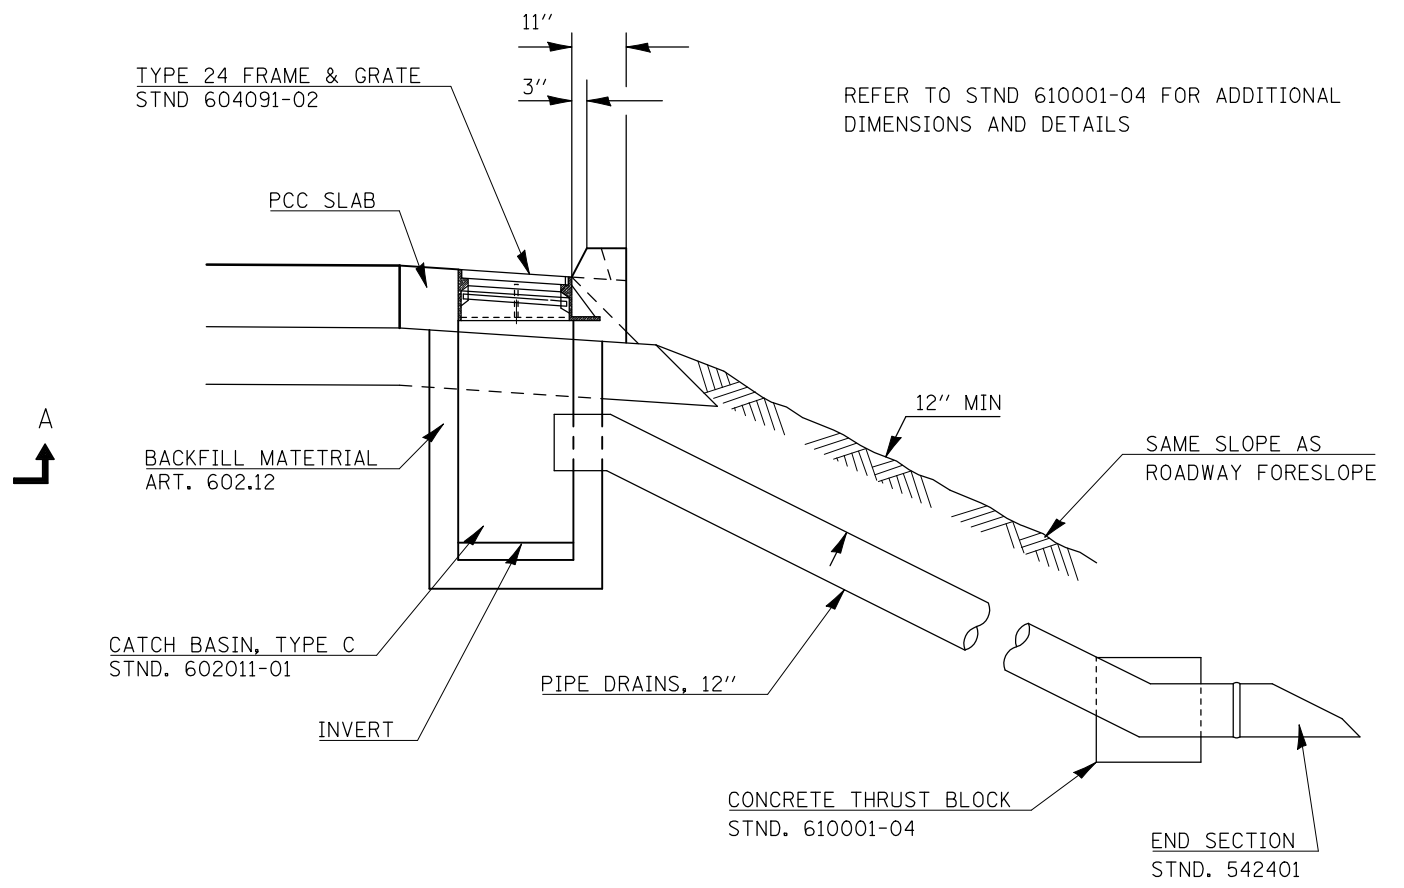

SEC. B-B

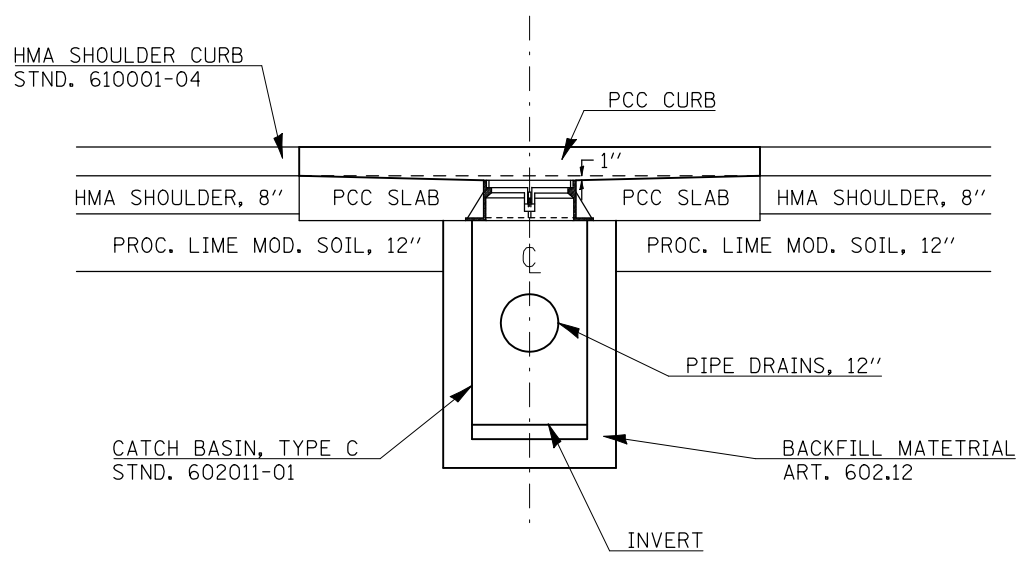

SEC. A-A

GENERAL NOTES


SEE STANDARD 610001-04 FOR HMA SHOULDER CURB DETAILS.

THE GUTTER GRADE SHALL BE DEPRESSED AT ALL INLETS.

THE COST OF THIS WORK SHALL BE INCLUDED IN THE COST OF THE VARIOUS PAY ITEMS OF THE WORK INVOLVED.

SEE SHEET 68 FOR SCHEDULE OF SHOULDER DRAINS.

FILE NAME =	USER NAME = shererjm	DESIGNED - JMS	REVISED -	STATE OF ILLINOIS DEPARTMENT OF TRANSPORTATION	DETAIL FOR SHOULDER INLETS WITH CURB			F.A.S. RTE.	SECTION	COUNTY	TOTAL SHEETS	SHEET NO.	
ct:\pw\work\PIWIDOT\SHERERJM\dms86674\0570388-sht-details.dgn		DRAWN - JMS	REVISED -		SCALE:	SHEET NO. 1 OF 1 SHEETS	STA.	TO STA.	1517	12VBR-1	PIATT	168	80
	PLOT SCALE = 40.0000' / IN.	CHECKED -	REVISED -					CONTRACT NO. 70388					
	PLOT DATE = 10/13/2009	DATE - 092509	REVISED -					FED. ROAD DIST. NO. ILLINOIS FED. AID PROJECT					

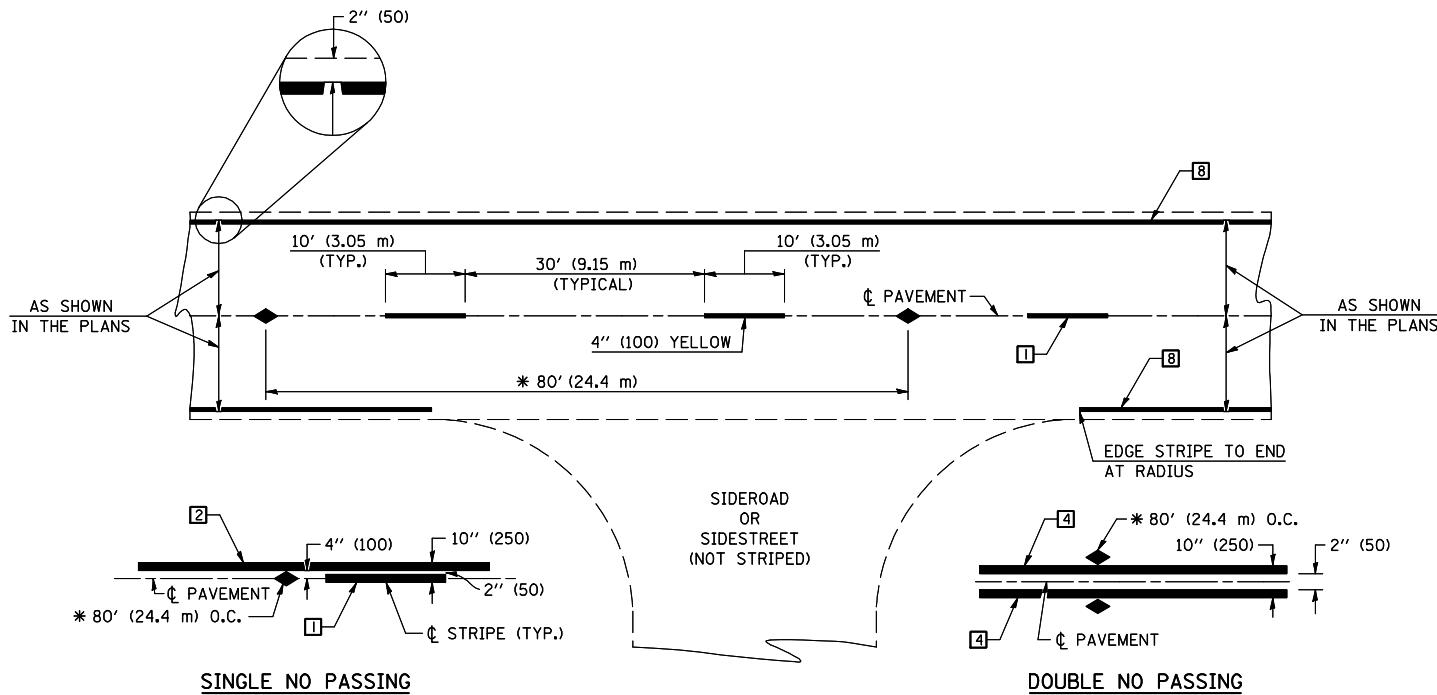

* REDUCE TO 40' (12.2 m) O.C. ON CURVES WITH POSTED OR ADVISORY SPEEDS OF 45 mph (70 km/h) OR LESS.

TWO LANE/TWO WAY


TYPICAL PAVEMENT MARKING LEGEND

- 1 4" (100) SKIP-DASH (YELLOW)
 - 2 4" (100) SOLID (YELLOW)
 - 3 12" (300) DIAGONAL (YELLOW)
 - 4 4" (100) DOUBLE YELLOW (NARROW)
 - 5 RESERVED
 - 6 RESERVED
 - 7 4" (100) SKIP-DASH (WHITE)
 - 8 4" (100) SOLID (WHITE)
 - 9 12" (300) DIAGONAL (WHITE)
 - 10 6" (150) SOLID (WHITE)
 - 11 24" (600) STOP BAR (WHITE)
 - 12 8" (200) SOLID (WHITE)
 - 13 4" (100) LANE LINE EXTENSIONS (WHITE)
 - 14 4" (100) PARKING WHITE
-

TYPICAL PAVEMENT MARKERS LEGEND

- ◆ TWO-WAY AMBER MARKER
- ▶ ONE-WAY AMBER MARKER
- ▷ ONE-WAY CRYSTAL MARKER

RURAL LEFT TURN

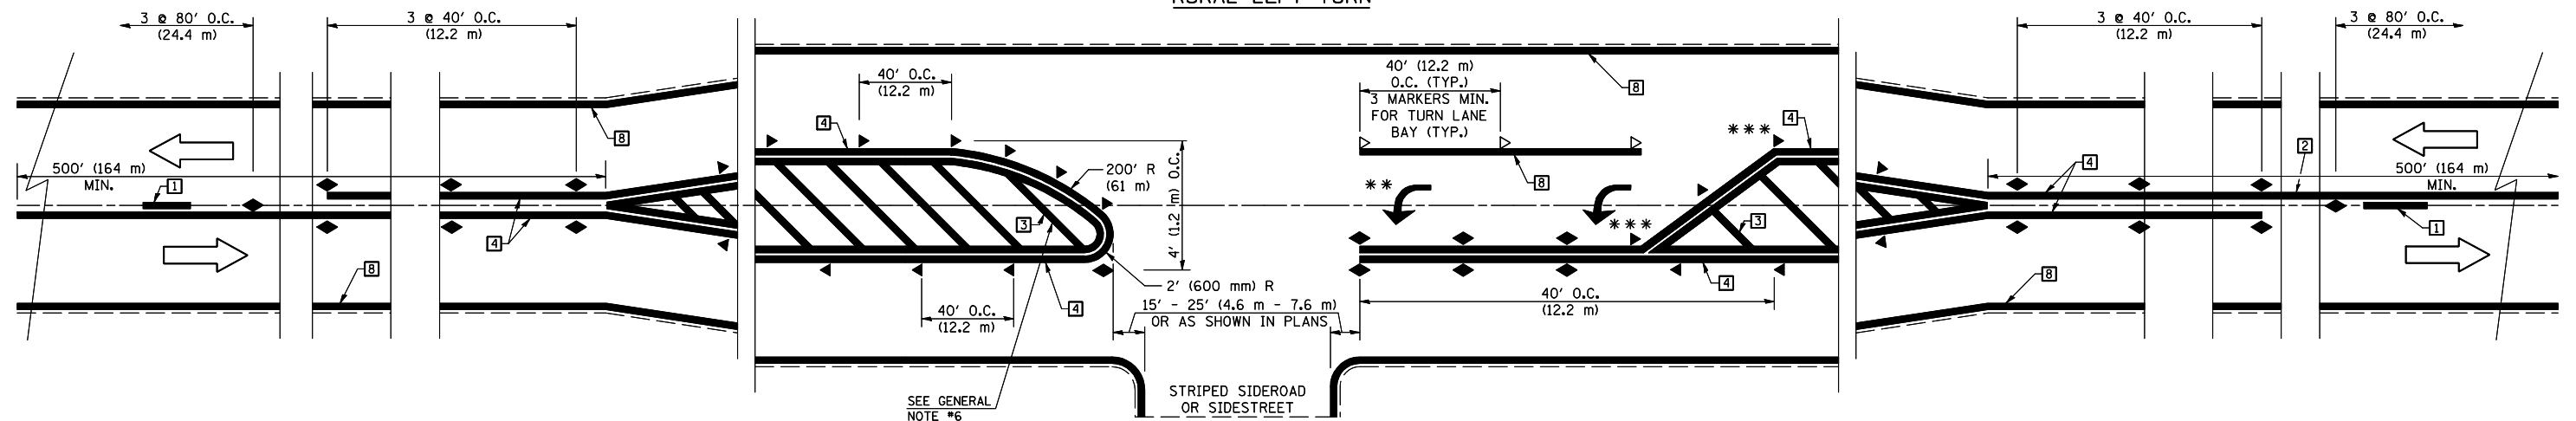

*** REDUCE SPACING IF NECESSARY TO ASSURE MARKERS AT CORNER POINTS.

** TURN ARROWS SHALL BE PLACED AS SHOWN ON SHEET #2.

Note: All dimensions are in INCHES (millimeters) unless otherwise shown.

DISTRICT 5 DETAIL NO. 7800AAA


FILE NAME =	USER NAME = shererjm	DESIGNED -	REVISED - 11/06
ct:\pw\work\PWIDOT\SHERERJM\dms86674\0570388-sht-details.dgn		DRAWN -	REVISED -
	PLOT SCALE = 40.0000' / IN.	CHECKED -	REVISED -
	PLOT DATE = 10/13/2009	DATE -	REVISED -

**STATE OF ILLINOIS
DEPARTMENT OF TRANSPORTATION**

**PAVEMENT MARKING AND MARKERS
(RURAL & URBAN APPLICATIONS)**

SCALE: SHEET NO. 1 OF 4 SHEETS STA. TO STA.

F.A.S. RTE.	SECTION	COUNTY	TOTAL SHEETS	SHEET NO.
1517	12VBR-1	PIATT	168	81
CONTRACT NO. 70388				
FED. ROAD DIST. NO. ILLINOIS FED. AID PROJECT				

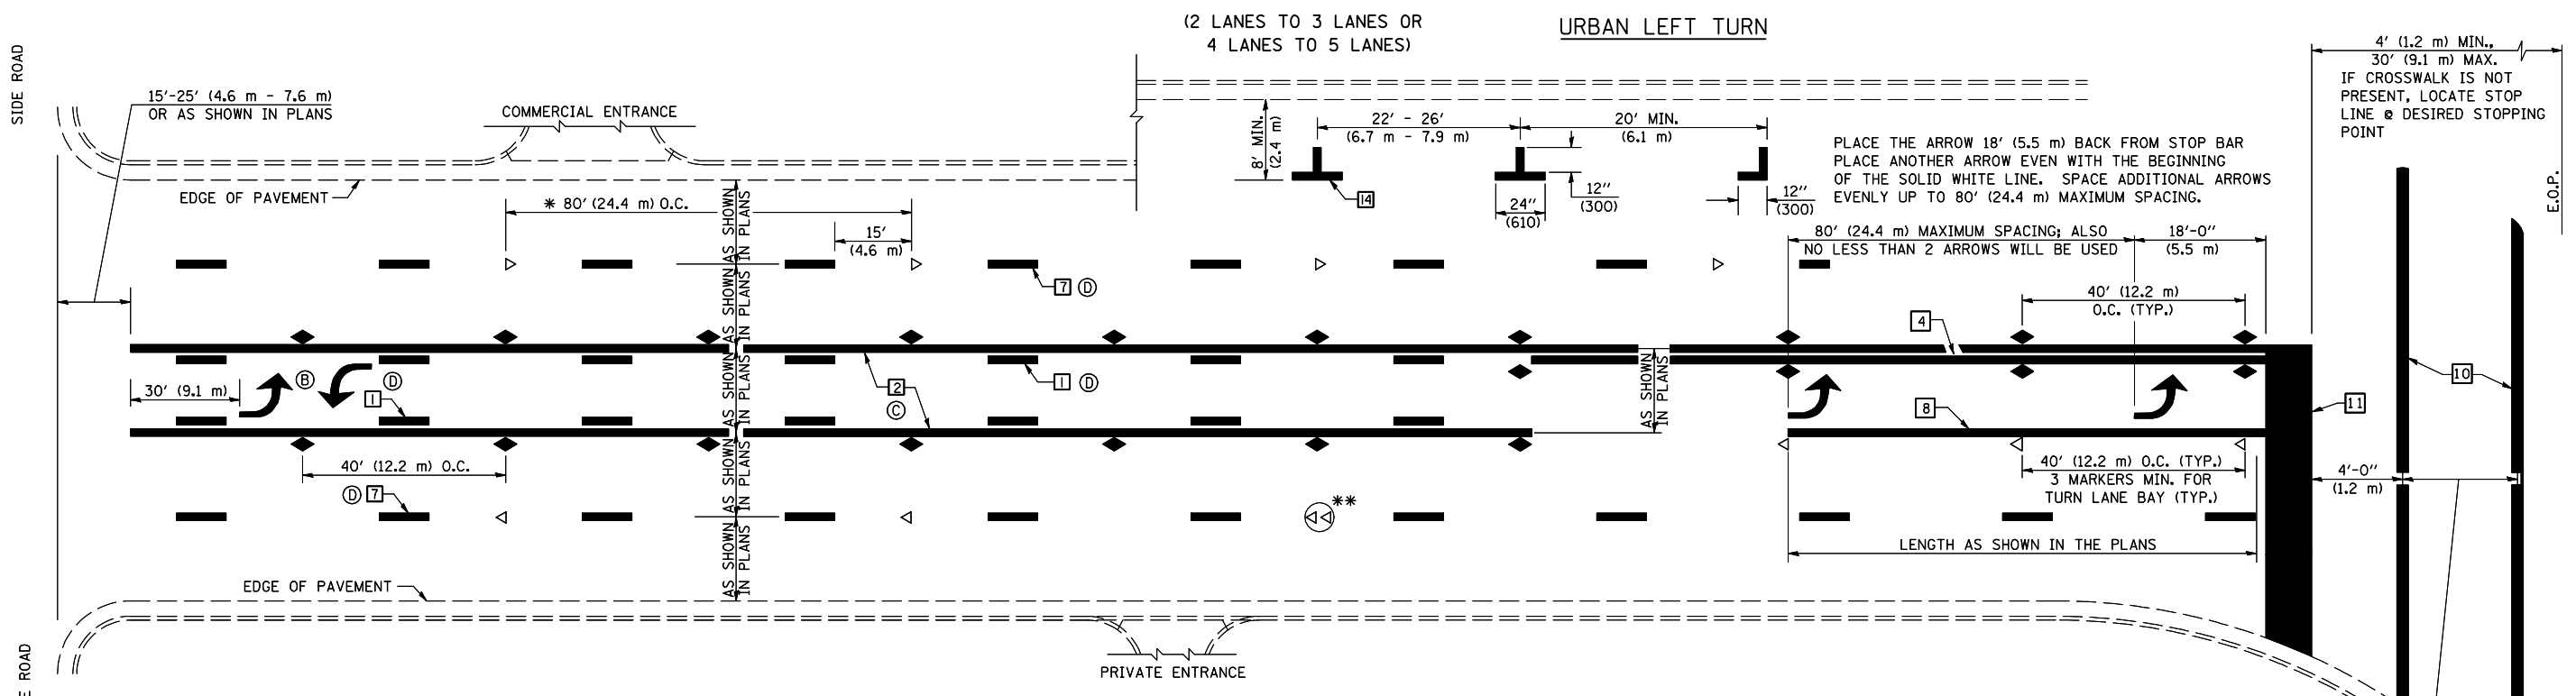


* REDUCE TO 40 FEET (12.2 METERS) ON CENTER ON CURVES WHERE ADVISORY SPEEDS ARE 10 MPH (15 km/h) LOWER THAN POSTED SPEEDS.

** DOUBLE LANE LINE MARKERS SHALL BE SPECIFIED AND SPACED AS SHOWN IN HIGHWAY STANDARD 781001 FOR MULTI-LANE DIVIDED AND UNDIVIDED HIGHWAYS.


GENERAL NOTES:

- (B) TURN ARROW PAIRS SHALL BE PLACED AT 250' (75 m) INTERVALS AND SHALL BE EVENLY SPACED BETWEEN BOTH ENDS OF THE BIDIRECTIONAL LEFT TURN LANE.
- (C) THE SOLID YELLOW PAVEMENT MARKINGS [2] SHOULD GENERALLY START OR END NEAR THE RADIUS POINT OF EACH STREET RETURN EXCEPT WHERE ONE OR BOTH ENDS WOULD INCLUDE STOP BARS.
- (D) THE SKIP-DASH PAVEMENT MARKINGS [1] OR [7] SHOULD BE CENTERED BETWEEN BOTH ENDS OF EACH CITY BLOCK AND SHALL BE PLACED SO THEY LINE UP ACROSS FROM EACH OTHER. SEE EXAMPLE ON SHEET 2 OF 3.
- (E) USE LARGE ARROW SIZE FOR BOTH RURAL AND URBAN LOCATIONS. (SEE LAST PAGE OF SECTION 780x FOR SYMBOLS TABLE)

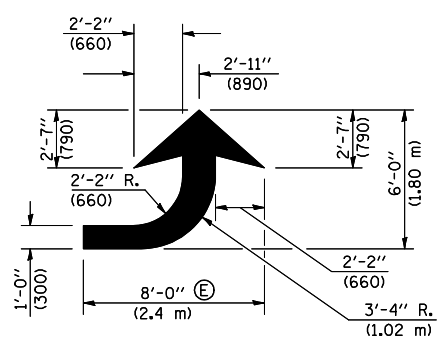


LEFT ARROW

REVERSE FOR RIGHT ARROW
AREA = 15.6 SQ. FT. (1.47 m²)
(WHITE)

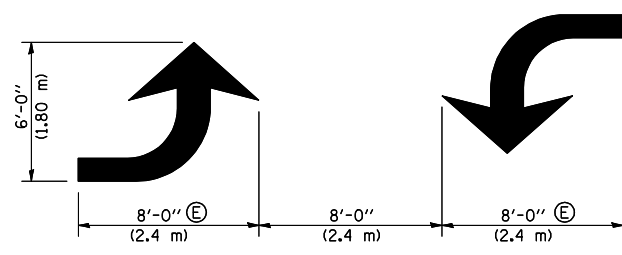


TYPICAL DOUBLE TURN ARROWS (WHITE)


BLOOMINGTON-NORMAL CITY LIMITS ONLY

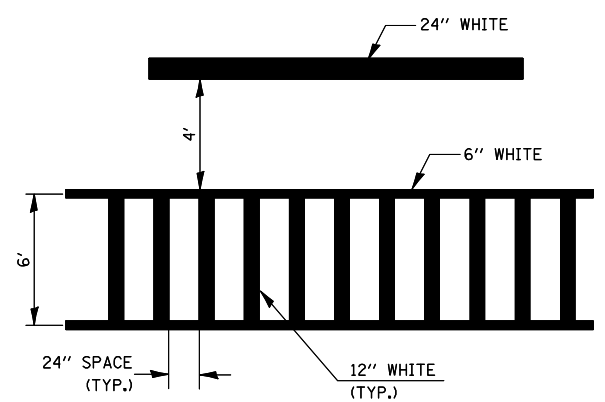

TYPICAL SPACING FOR CROSSWALKS & STOP BARS

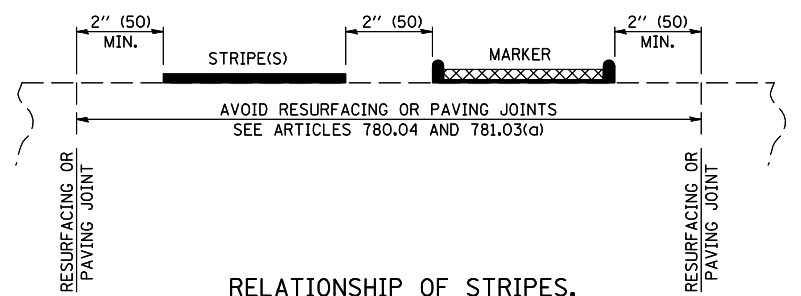

RELATIONSHIP OF STRIPES, MARKERS AND JOINTS

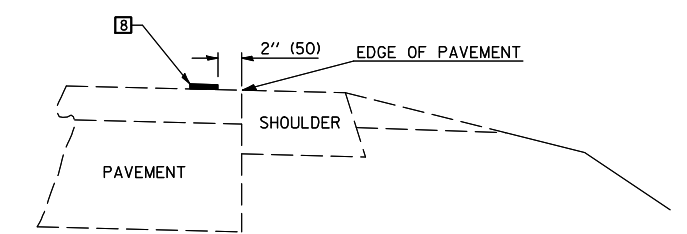


RELATIONSHIP OF EDGE LINE TO EDGE OF PAVEMENT (SAFETY SHOULDER OR PAVED SURFACE) SEE ARTICLE 780.04

CROSSWALK WIDTH 6'-0" (1.8 m) OR AS SHOWN IN THE PLANS

Note: All dimensions are in INCHES (millimeters) unless otherwise shown.

FILE NAME =		USER NAME = shererjm		DESIGNED -		REVISED - 11/06		STATE OF ILLINOIS DEPARTMENT OF TRANSPORTATION		PAVEMENT MARKING AND MARKERS (RURAL & URBAN APPLICATIONS)																									
DRAWN -		DRAWN -		CHECKED -		REVISED -																													
PLOT SCALE = 40.0000' / IN.		PLOT DATE = 10/13/2009		DATE -		REVISED -																													
PLOT DATE = 10/13/2009		DATE -		REVISED -		REVISED -																													
SCALE:		SHEET NO. 2 OF 4 SHEETS		STA.		TO STA.		<table border="1" style="width: 100%;"> <tr> <th colspan="4" style="text-align: center;">DISTRICT 5 DETAIL NO. 7800AAA</th> </tr> <tr> <td>F.A.S. RTE.</td> <td>SECTION</td> <td>COUNTY</td> <td>TOTAL SHEETS</td> <td>SHEET NO.</td> </tr> <tr> <td>1517</td> <td>12VBR-1</td> <td>PIATT</td> <td>168</td> <td>82</td> </tr> <tr> <td colspan="4" style="text-align: center;">CONTRACT NO. 70388</td> <td></td> </tr> <tr> <td colspan="2">FED. ROAD DIST. NO.</td> <td colspan="3">ILLINOIS FED. AID PROJECT</td> </tr> </table>				DISTRICT 5 DETAIL NO. 7800AAA				F.A.S. RTE.	SECTION	COUNTY	TOTAL SHEETS	SHEET NO.	1517	12VBR-1	PIATT	168	82	CONTRACT NO. 70388					FED. ROAD DIST. NO.		ILLINOIS FED. AID PROJECT		
DISTRICT 5 DETAIL NO. 7800AAA																																			
F.A.S. RTE.	SECTION	COUNTY	TOTAL SHEETS	SHEET NO.																															
1517	12VBR-1	PIATT	168	82																															
CONTRACT NO. 70388																																			
FED. ROAD DIST. NO.		ILLINOIS FED. AID PROJECT																																	

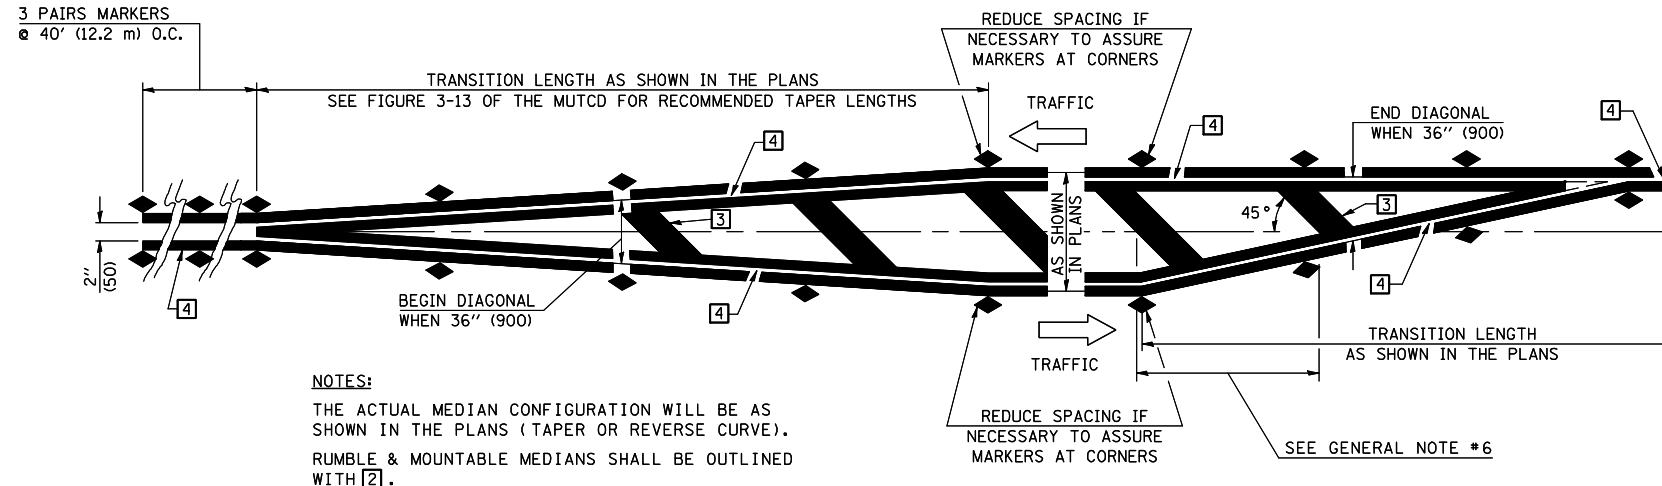


NOTES:
 THE ACTUAL MEDIAN CONFIGURATION WILL BE AS SHOWN IN THE PLANS (TAPER OR REVERSE CURVE).
 RUMBLE & MOUNTABLE MEDIANS SHALL BE OUTLINED WITH [2].


TYPICAL MEDIAN TRANSITIONS

GENERAL NOTES

1. WHEN MEDIANS ARE PRESENT, PAVEMENT MARKINGS ARE TO BE PLACED ADJACENT TO MEDIANS.
2. SOME OF THE INFORMATION INCLUDED WITH THIS DETAIL MAY NOT BE APPLICABLE TO THIS IMPROVEMENT.
3. PAVEMENT MARKINGS ARE TO BE EXTENDED THROUGH OMISSIONS WHEN APPLICABLE.
4. A STRIPING KEY IS AVAILABLE ELSEWHERE AND SHALL BE SHOWN WHERE THE QUANTITIES ARE LISTED.
5. FINAL PAVEMENT MARKINGS SHALL BE IN PLACE PRIOR TO PLACING ANY RAISED REFLECTIVE PAVEMENT MARKERS.
6. THE FOLLOWING CRITERIA SHALL BE USED FOR SELECTING THE DIAGONAL PAVEMENT MARKING SPACING,
 < 30 MPH USE 15' (< 50 km/h USE 4.5 m)
 30-45 MPH USE 20' (50-75 km/h USE 6.0 m)
 > 45 MPH USE 30' (> 75 km/h USE 9.0 m)

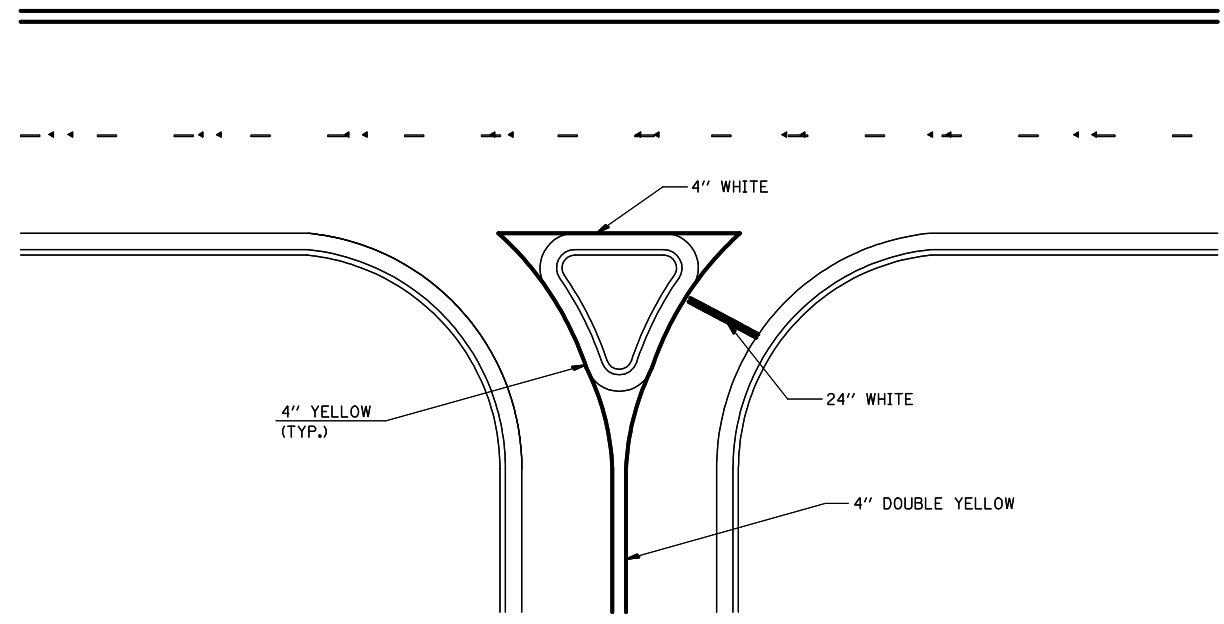

RIGHT IN - RIGHT OUT ACCESS

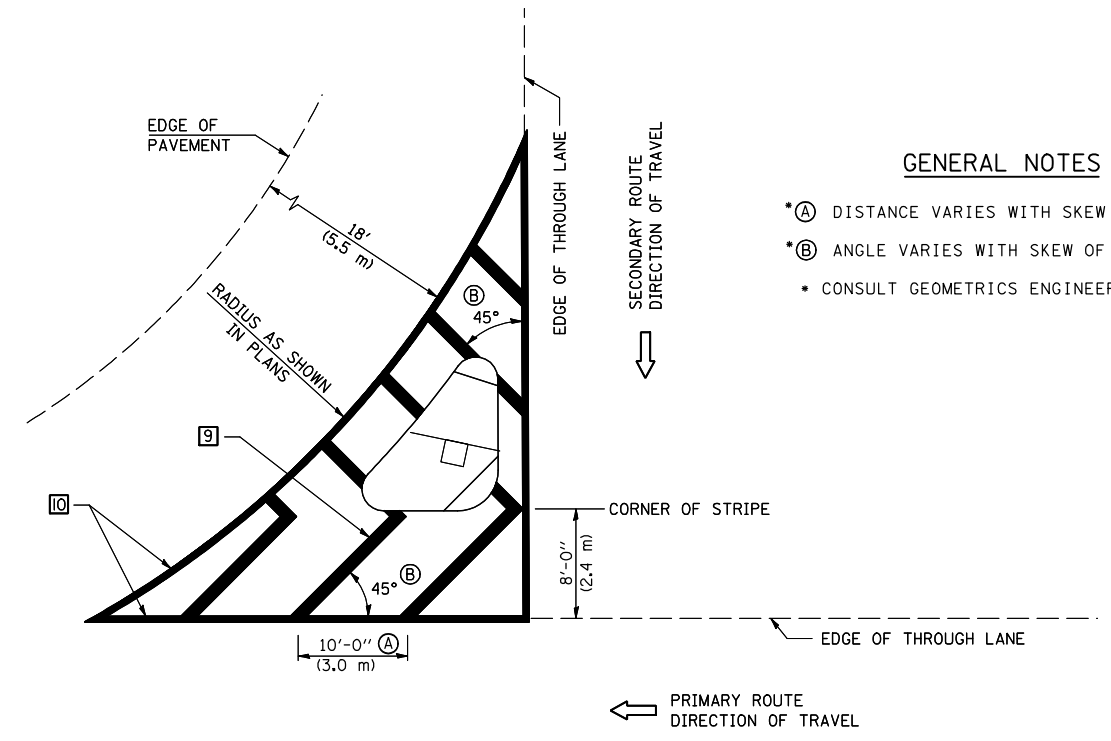

GENERAL NOTES

- *A DISTANCE VARIES WITH SKEW OF INTERSECTION.
- *B ANGLE VARIES WITH SKEW OF INTERSECTION.
- CONSULT GEOMETRICS ENGINEER

ISLAND

Note: All dimensions are in INCHES (millimeters) unless otherwise shown.

FILE NAME =	USER NAME = shererjm	DESIGNED -	REVISED - 11/06
ct:\pw\work\PIWIDOT\SHERERJM\dms86674\0570388-sht-details.dgn		DRAWN -	REVISED -
	PLOT SCALE = 40.0000' / IN.	CHECKED -	REVISED -
	PLOT DATE = 10/13/2009	DATE -	REVISED -

**STATE OF ILLINOIS
 DEPARTMENT OF TRANSPORTATION**

**PAVEMENT MARKING AND MARKERS
 (RURAL & URBAN APPLICATIONS)**


SCALE: SHEET NO. 3 OF 4 SHEETS STA. TO STA.

DISTRICT 5 DETAIL NO. 7800AAA

F.A.S. 1517	SECTION	COUNTY	TOTAL SHEETS	SHEET NO.
	12VBR-1	PIATT	168	83
CONTRACT NO. 70388				
FED. ROAD DIST. NO. ILLINOIS FED. AID PROJECT				

RAILROAD CROSSING WITH INTERCONNECT ONLY

RAILROAD CROSSING WITH INTERCONNECT AND PRE-SIGNALS

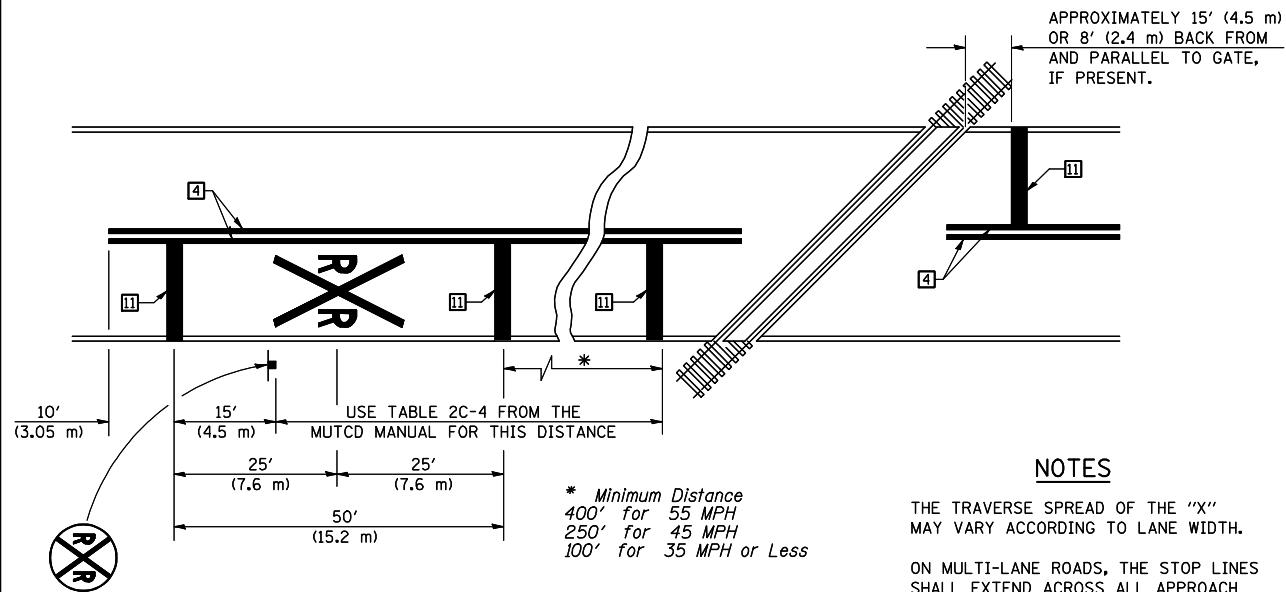

PAVEMENT MARKINGS AT RAILROAD-HIGHWAY GRADE CROSSING

NOTES



APPROXIMATELY 15' (4.5 m) OR 8' (2.4 m) BACK FROM AND PARALLEL TO GATE, IF PRESENT.

THE TRAVERSE SPREAD OF THE "X" MAY VARY ACCORDING TO LANE WIDTH.

ON MULTI-LANE ROADS, THE STOP LINES SHALL EXTEND ACROSS ALL APPROACH LANES AND SEPARATE RXR SYMBOLS SHALL BE PLACED ADJACENT TO EACH OTHER IN EACH LANE.

WHEN THE PAVEMENT MARKING SYMBOL IS USED, A PORTION OF THE SYMBOL SHOULD BE LOCATED DIRECTLY ADJACENT TO THE ADVANCE WARNING SIGN (W10-1) AS PLACED BY TABLE II-1, CONDITION B OF THE MUTCD.


* Minimum Distance
400' for 55 MPH
250' for 45 MPH
100' for 35 MPH or Less

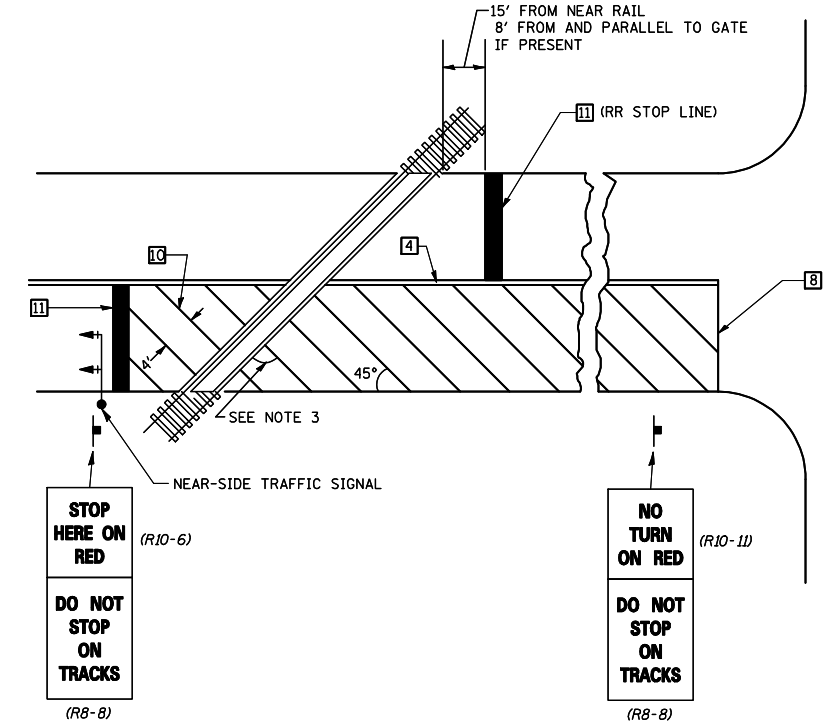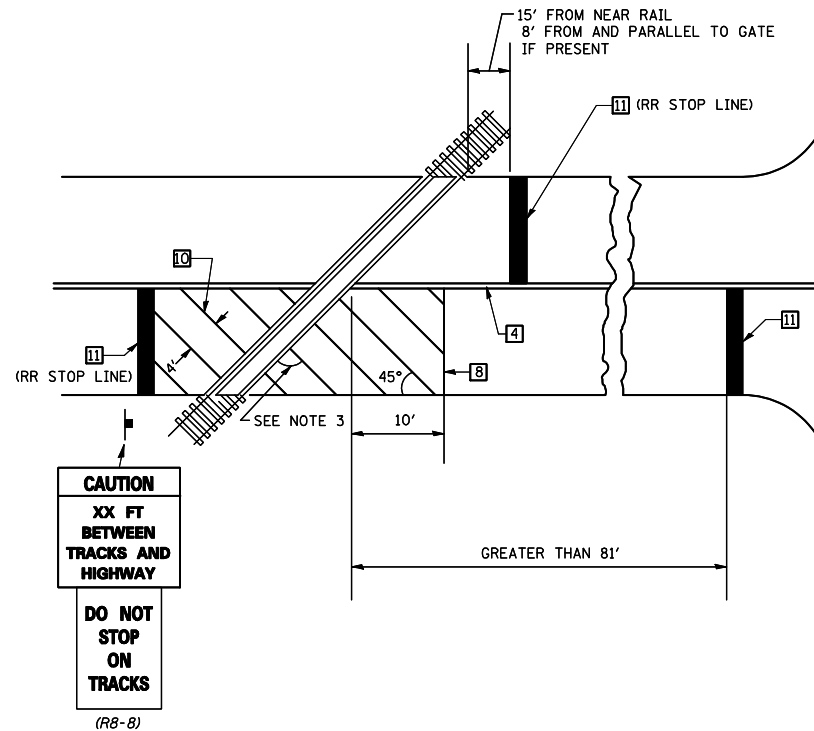

SUPPLEMENTAL PAVEMENT MARKING TREATMENT FOR RAILROAD-HIGHWAY GRADE CROSSING

GENERAL NOTES

- SUPPLEMENTAL PAVEMENT MARKINGS TO BE INSTALLED ONLY ON APPROACHES TO INTERSECTIONS CONTROLLED BY TRAFFIC SIGNALS WHICH ARE INTERCONNECTED WITH THE RAILROAD WARNING SIGNALS.
- EXTEND PAVEMENT MARKINGS TO THE INTERSECTION ONLY WHERE NEAR-SIDE TRAFFIC SIGNALS ARE USED.
- WHERE THE ANGLE BETWEEN THE DIAGONAL PAVEMENT MARKINGS AND THE TRACK WOULD BE LESS THAN 20°, THE PAVEMENT MARKINGS SHOULD BE PLACED IN THE OPPOSITE DIRECTION FROM THAT SHOWN.

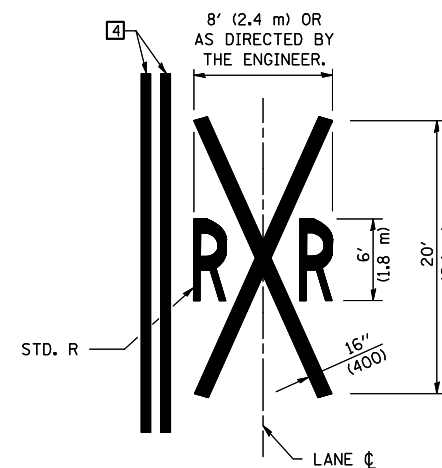

Note: All dimensions are in INCHES (millimeters) unless otherwise shown.

FILE NAME =	USER NAME = shererjm	DESIGNED -	REVISED - 11/06
ct:\pw\work\PWIDOT\SHERERJM\dms86674\0570388-shr-details.dgn		DRAWN -	REVISED -
	PLOT SCALE = 40.0000' / IN.	CHECKED -	REVISED -
	PLOT DATE = 10/13/2009	DATE -	REVISED -

STATE OF ILLINOIS
DEPARTMENT OF TRANSPORTATION

PAVEMENT MARKING AND MARKERS
(RURAL & URBAN APPLICATIONS)

SCALE: SHEET NO. 4 OF 4 SHEETS STA. TO STA.


DISTRICT 5 DETAIL NO. 7800AAAA

F.A.S. RTE.	SECTION	COUNTY	TOTAL SHEETS	SHEET NO.
1517	12VBR-1	PIATT	168	84
FED. ROAD DIST. NO. ILLINOIS FED. AID PROJECT			CONTRACT NO. 70388	

DESIGNER NOTE: BDE 58-8.02 "PLACE MARKERS AT THE PT'S AND PC'S OF ALL HORIZONTAL CURVES AND SPACE THEM ALONG TANGENTS SO THAT TWO MARKERS ARE ALWAYS INTERVISIBLE."

XZ193300 – SURVEY MARKER, TYPE 1 (SPECIAL)

TO BE INSTALLED IN FLEXIBLE PAVEMENT OR SHOULDER, BITUMINOUS TREATED SURFACE AND TURF AREAS WITHIN THE RIGHT-OF-WAY FOR PRESERVING PERMANENT SURVEY MARKERS (PI'S, PT'S, PC'S, POC'S, & POT'S)

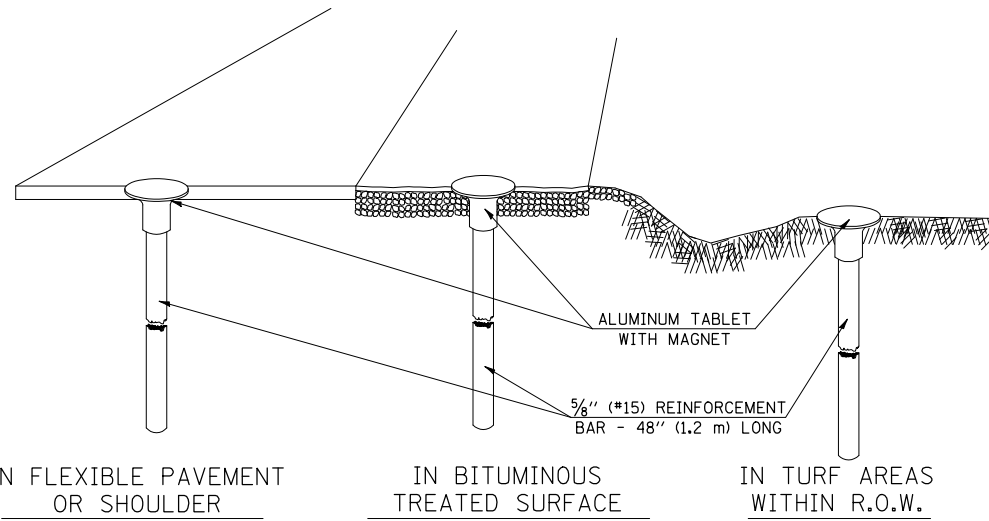

SPECIFICATIONS FOR ALUMINUM TABLET


SURVEY CAP FOR REBAR. 3/4" (83 mm) CONVEX SURVEY CAP FOR 5/8" (15 mm) REBAR WITH ILLINOIS DEPARTMENT OF TRANSPORTATION LOGO. THIS LOGO SHALL PROVIDE LETTERS RECESSED INTO THE SURFACE A MINIMUM OF 1/32" (0.8 mm) FOR EASY AND LONG-TERM LEGIBILITY. THE ALUMINUM CAP FOR REBAR SHALL BE PRODUCED BY THE PROCESS OF ORBITAL FORGING TO PRODUCE A HIGH-STRENGTH AND DURABLE MARKER CAP WHICH WILL NOT CHIP OR BREAK AND PROVIDE A SMOOTH FINISH FOR STAMPING OF DATA IN THE FIELD. THE ALUMINUM CAP FOR REBAR SHALL BE TAPERED FOR A PERFECT COMPRESSION FIT. A SPECIAL PLASTIC INSULATOR SHALL BE INSTALLED TO PREVENT DISSIMILAR METAL CONTACT AND CORROSION. THE PLASTIC INSULATOR SHALL FORM READILY TO THE OUTER SHAPE OF THE REBAR AND TO THE INNER SHAPE OF THE ALUMINUM CAP SOCKET. THE PLASTIC INSULATOR SHALL BE LOW DENSITY POLYETHYLENE, A MINIMUM 1 1/2" (38 mm) LONG AND CONFORM TO FEDERAL SPECIFICATION L-P 390.

COMPOSITION: ALUMINUM 98.3-98.7%; OTHER 1.3-1.7%; STRENGTH: YIELD 28 KSI (193 MPa), ULTIMATE 32 KSI (221 MPa). ELONGATION 15% [IN 2" (50 mm)]. SPECIFICATIONS: ALUMINUM ALLOY 6101-0; ASTM B317-83 (EXCEPT TEMPER) AS FORGED. NO EXCEPTIONS.

SPECIFICATIONS FOR REBAR

REBAR FOR ALUMINUM TABLET. REINFORCEMENT BAR SHALL BE 5/8" (#15) X 48" (1.2 m) (DEFORMED).

INSPECTION OF REINFORCEMENT BAR 5/8" (#15) SHALL BE DONE BY DISTRICT PERSONNEL OF THE ILLINOIS DEPARTMENT OF TRANSPORTATION, DIVISION OF HIGHWAYS.

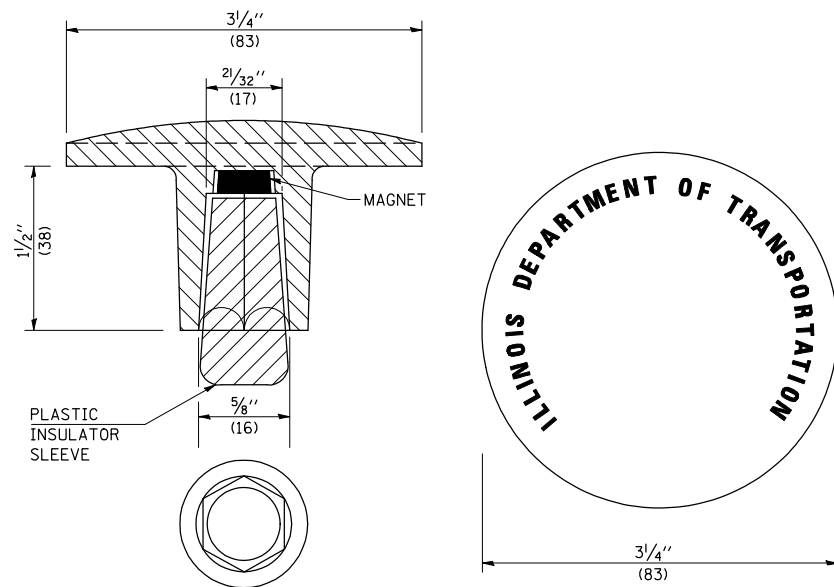


THE DIMENSIONS SHOWN SHALL BE EXACT, OTHERS MAY VARY, BUT SHALL BE SHOWN ON SHOP DRAWINGS.

GENERAL NOTES

1. THE CONTRACT UNIT PRICE, EACH, FOR SURVEY MARKER, TYPE I, (SPECIAL) SHALL BE PAYMENT IN FULL FOR FURNISHING THE SURVEY MARKER.
2. ALL SURVEY MARKERS, TYPE I, (SPECIAL) SHALL BE PLACED ± 1/4" (6 mm) BELOW THE FINAL SURFACE.
3. WHEN THE TABLET AND REBAR ARE PLACED AS PART OF A SURVEY MARKER VAULT, THEY SHALL BE CONSIDERED AS INCLUDED IN THAT PAY ITEM AND THERE WILL BE NO PAYMENT FOR THE SURVEY MARKER, TYPE I, (SPECIAL).

XZ193400 – SURVEY MARKER, TYPE 2 (SPECIAL)


TO BE INSTALLED IN RIGID OR COMPOSITE PAVEMENT FOR PRESERVING PERMANENT SURVEY MARKERS (PI'S, PT'S, PC'S, POC'S, & POT'S)

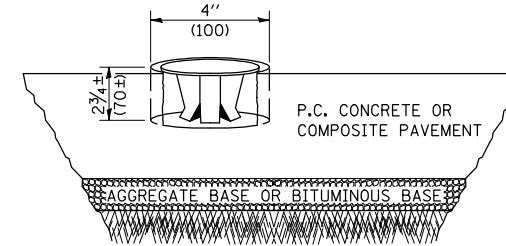

SPECIFICATIONS FOR ALUMINUM TABLET (FORKED)

ALUMINUM TABLET (FORKED) FOR USE WITH "SURVEY MARKER, TYPE 2, (SPECIAL)" SHALL BE AS SHOWN ON THE DETAIL FOR THE 3/4" (83 mm) CONVEX SURVEY TABLET WITH ILLINOIS DEPARTMENT OF TRANSPORTATION LOGO. THIS LOGO SHALL PROVIDE FOR LETTERS RECESSED INTO THE SURFACE A MINIMUM OF 1/32" (0.8 mm) FOR EASY AND LONG-TERM LEGIBILITY. THE ALUMINUM TABLET SHALL BE PRODUCED BY THE PROCESS OF ORBITAL FORGING TO PRODUCE A HIGH-STRENGTH AND DURABLE MARKER CAP WHICH WILL NOT CHIP OR BREAK AND PROVIDE A SMOOTH FINISH FOR STAMPING OF DATA IN THE FIELD. THE ALUMINUM TABLET SHALL BE DESIGNED NOT TO TURN OR ROTATE. THREE PRONGS ON A 2 1/2" (63 mm) STEM SHALL BE SUCH THAT THE ALUMINUM TABLET CANNOT BE EASILY REMOVED.

COMPOSITION: ALUMINUM 92-93%; MAGNESIUM 6.5-7.5%. STRENGTH: YIELD 19,000-21,000 PSI (131-145 MPa); TENSILE 38,000-44,000 PSI (262-303 MPa); ELONGATION 10-15% [IN 2" (50 mm)]. SPECIFICATIONS: ALLOY 535.0; QQ-A-601ES. NO EXCEPTIONS.

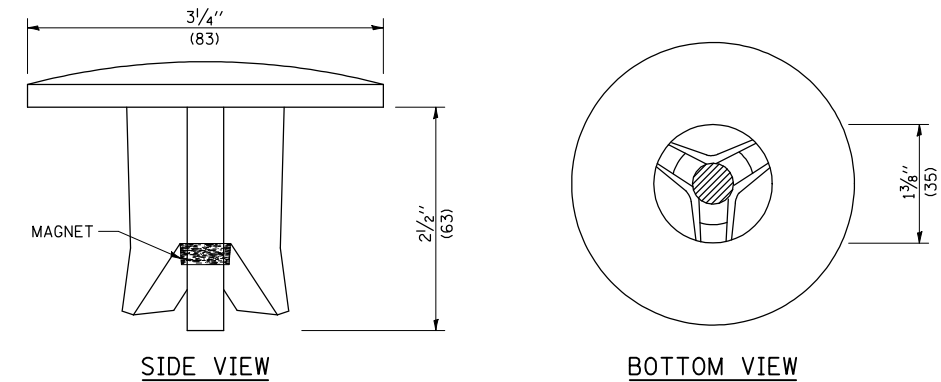

THE DIMENSIONS SHOWN SHALL BE EXACT, OTHERS MAY VARY, BUT SHALL BE SHOWN ON SHOP DRAWINGS.

GENERAL NOTES

1. WORK ON THIS ITEM SHALL NOT START UNTIL THE FINAL SURFACE IS COMPLETED.
2. THE ALUMINUM TABLET (FORKED) SHALL REST UPON THE BOTTOM OF THE 4" (100 mm) CORE HOLE. IF THE HOLE IS TOO DEEP, EPOXY GROUT MUST BE USED TO DECREASE THE DEPTH AND ALLOWED TO HARDEN BEFORE PROCEEDING.
3. THE ALUMINUM TABLET SHALL BE ANCHORED IN THE 4" (100 mm) DIAMETER HOLE IN THE NEW PAVEMENT WITH TWO-COMPONENT EPOXY CONFORMING TO APPLICABLE PORTIONS OF ARTICLE 1025.01 OF THE STANDARD SPECIFICATIONS.
4. THE 4" (100 mm) CORE HOLE SHALL BE SUBJECT TO THE APPROVAL OF THE ENGINEER.
5. THE CONTRACT PRICE, EACH, FOR SURVEY MARKER, TYPE 2 (SPECIAL) SHALL BE PAYMENT IN FULL FOR FURNISHING THE ALUMINUM TABLET AND ALL LABOR AND MATERIAL TO SET THE MARKER IN PLACE, AS SPECIFIED, INCLUDING CORING THE NEW PAVEMENT.
6. ALL SURVEY MARKERS, TYPE 2 (SPECIAL) SHALL BE PLACED ± 1/4" (6 mm) BELOW THE FINAL SURFACE.

Note: All dimensions are in INCHES (millimeters) unless otherwise shown.

FILE NAME =	USER NAME = shererjm	DESIGNED -	REVISED - 11/06
ct:\pw\work\PIWIDOT\SHERERJM\dms86674\0570388-sht-details.dgn		DRAWN -	REVISED -
		CHECKED -	REVISED -
		DATE -	REVISED -

STATE OF ILLINOIS
DEPARTMENT OF TRANSPORTATION

SURVEY MARKERS TYPE 1 & 2 (SPECIAL)

SCALE: SHEET NO. OF SHEETS STA. TO STA.

DISTRICT 5 DETAIL NO. XZ193AAA

S. 1517	SECTION	COUNTY	TOTAL SHEETS	SHEET NO.
	12VBR-1	PIATT	168	85
CONTRACT NO. 70388				
FED. ROAD DIST. NO. ILLINOIS FED. AID PROJECT				

Bench Mark: Chiseled square on top of the southwest wingwall, 17.65' Rt. at Station 288+13. Elevation = 755.435



Existing Structure: S.N. 074-0009 built in 1928 as S.B.I. Route 39, Section 12V at Sta. 289+23.00. Superstructure replaced in 1975 as S.B.I. Route 39, Section 12VBR. Structure consists of five span PPC deck beams on spill-thru counter-fort abutments and multi-column piers. 218'-7 7/8" back-to-back abutments. 33'-0" out-to-out deck. SN 074-0086 to be built on new alignment approximately 49' south of existing bridge. Road closed and traffic detoured during construction.

No Salvage.

STATE OF ILLINOIS
DEPARTMENT OF TRANSPORTATION



INDEX OF SHEETS

- 1 General Plan & Elevation
- 2 General Data
- 3 Reinforced Soil Slope Details
- 4-5 Top of Slab Elevations
- 6 Top of West Approach Pavement Elevation
- 7 Top of East Approach Pavement Elevation
- 8 Superstructure
- 9 Superstructure Details
- 10 Diaphragm Details
- 11-12 Bridge Approach Slab Details
- 13 Structural Steel
- 14 Structural Steel Details
- 15 Bearing Details
- 16 West Abutment
- 17 East Abutment
- 18 Pier 1
- 19 Pier 2
- 20 Cantilevered Forming Brackets for Superstructure with W27 Beams and Smaller
- 21 Bar Splicer Assembly Details
- 22 HP Pile Details
- 23-25 Soil Boring Logs

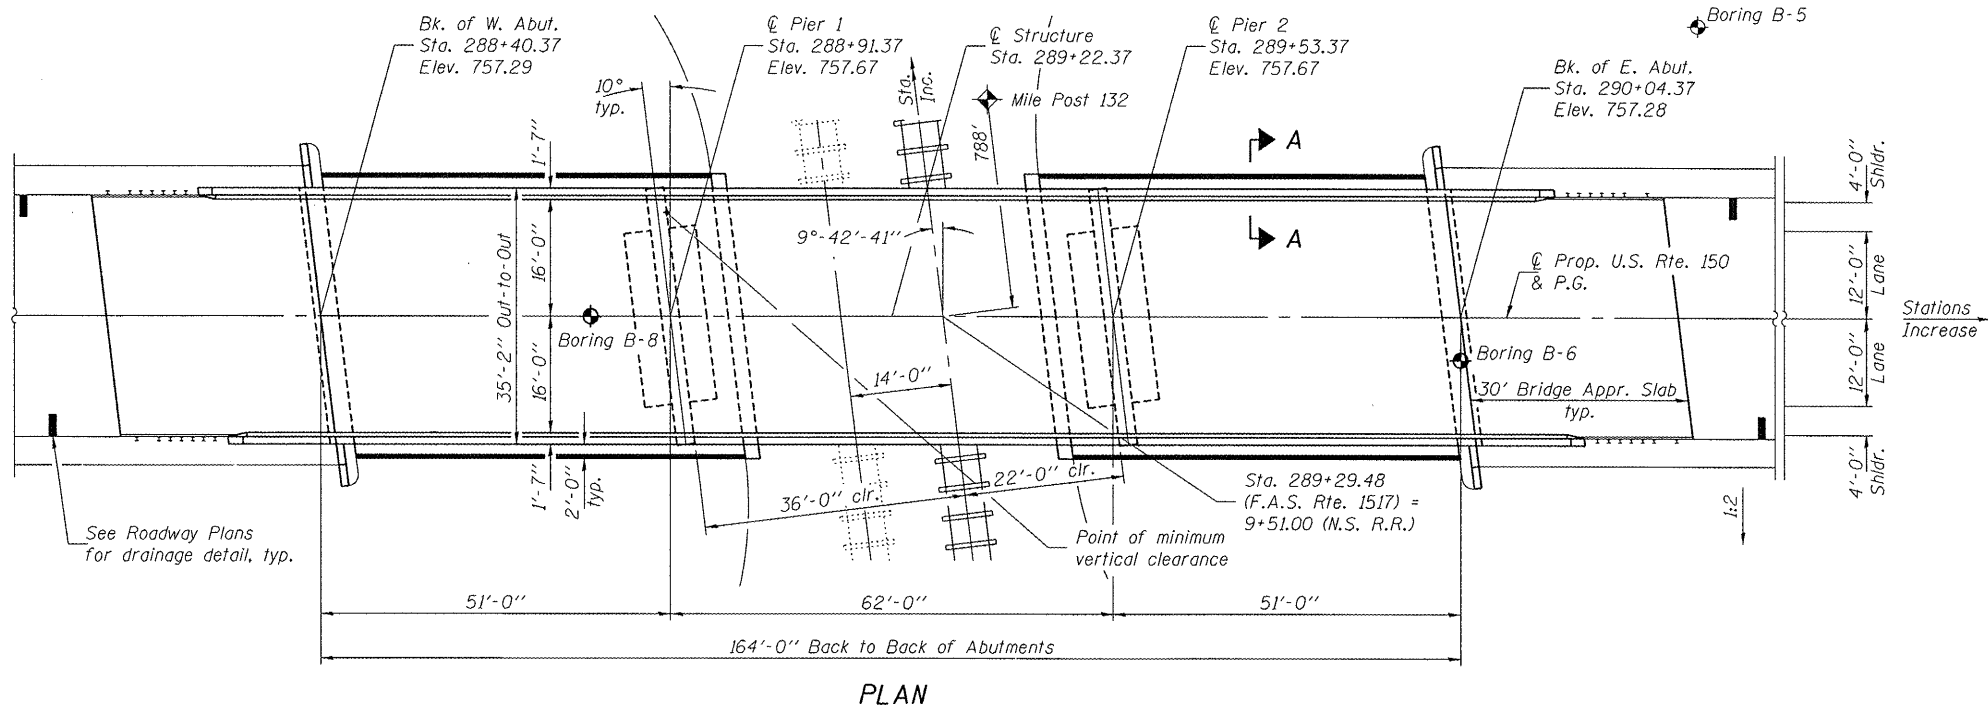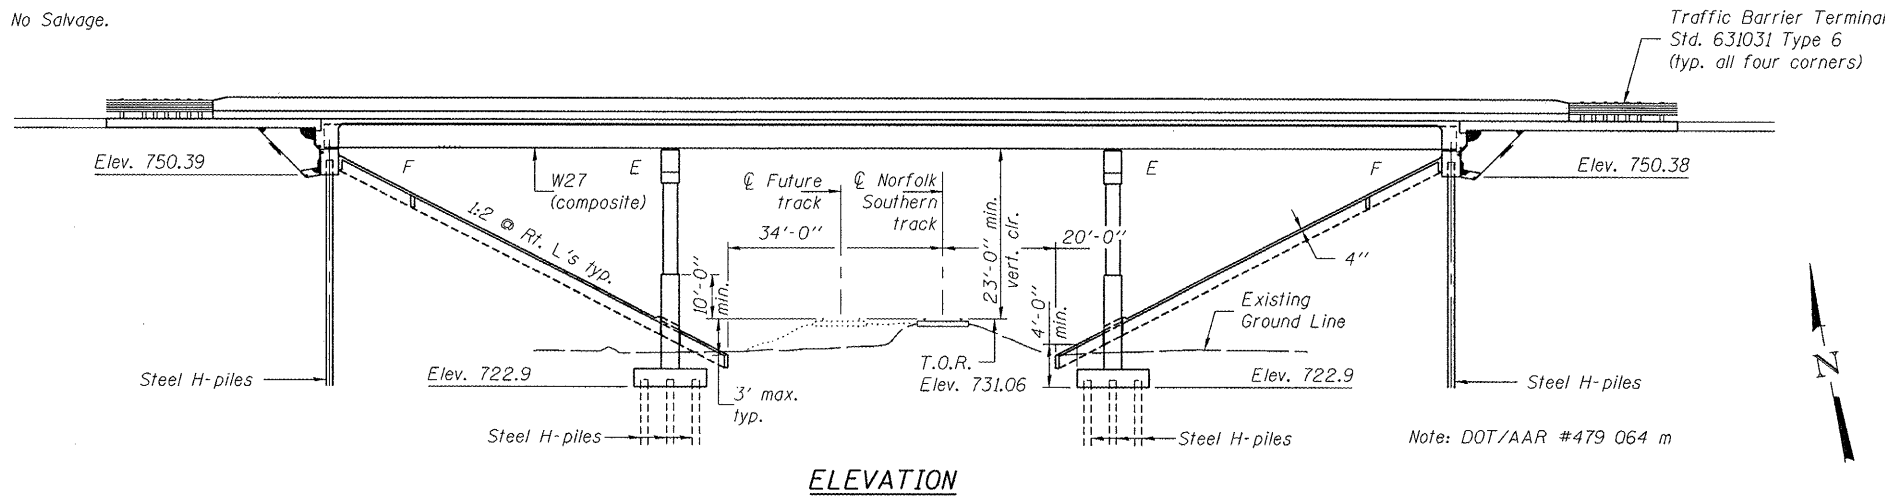


STATION 289+22.37
BUILT 20 BY
STATE OF ILLINOIS
F.A.S. RTE. 1517 SEC. 12VBR-1
LOADING HL-93
STRUCTURE NO. 074-0086

NAME PLATE
See Std. 515001

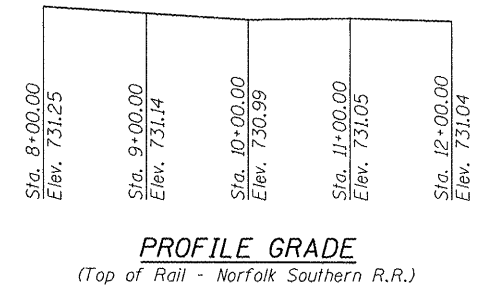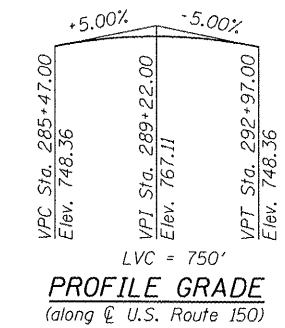


Notes: The profile grade shows the final elevations after grinding. Up to 1/4" will be ground off the bridge slab, approach pavement and connector pavement.

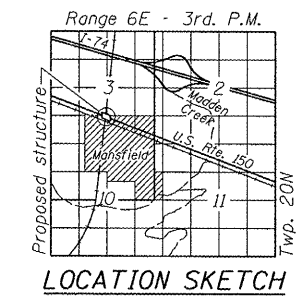

GENERAL PLAN & ELEVATION
U.S. ROUTE 150 OVER
NORFOLK SOUTHERN R.R.
F.A.S. RTE. 1517 - SEC. 12VBR-1
PIATT COUNTY
STATION 289+22.37
STRUCTURE NO. 074-0086

DESIGNED: Phum P. Naitiwat
CHECKED: Stephen M. Ryan
DRAWN: h.t. duong
CHECKED: /SMR

EXAMINED: November 25, 2009
PASSED: Ralph E. Anderson
ENGINEER OF BRIDGES AND STRUCTURES

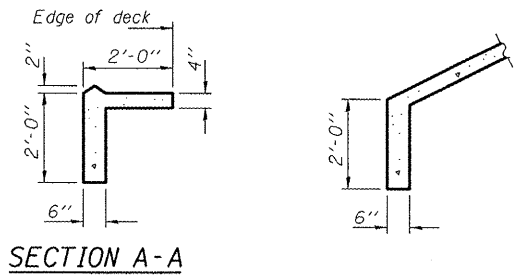

LOADING HL-93
Allow 50#/sq. ft. for future wearing surface.
DESIGN SPECIFICATIONS
2007 LRFD AASHTO 4th Edition
DESIGN STRESSES
FIELD UNITS
f_c' = 3,500 psi
f_y = 60,000 psi (reinforcement)
f_y = 50,000 psi (AASHTO M270 Grade 50W)
SEISMIC DATA
Seismic Performance Zone (SPZ) = 1
Design Spectral Acceleration at 1.0 sec (S_{D1}) = 0.10g
Design Spectral Acceleration at 0.2 sec (S_{D5}) = 0.17g
Soil Site Class = C

SHEET NO. 1 25 SHEETS	F.A.S. RTE.	SECTION	COUNTY	TOTAL SHEETS	SHEET NO.
	1517	12VBR-1	PIATT	168	86
FED. ROAD DIST. NO. - ILLINOIS			FED. AID PROJECT		
CONTRACT NO. 70388					

STATE OF ILLINOIS
DEPARTMENT OF TRANSPORTATION

GENERAL NOTES


Fasteners shall be AASHTO M164 Type 1, mechanically galvanized bolts.
Bolts 3/4" ϕ , holes 5/8" ϕ , unless otherwise noted.
Calculated weight of Structural Steel = 108170 lbs. (AASHTO M 270 Gr. 50W).
All structural steel shall be AASHTO M 270 Grade 50W.
No field welding is permitted except as specified in the contract documents.
Reinforcement bars shall conform to the requirements of ASTM A 706 Gr. 60 (IL Modified). See Special Provisions.
Reinforcement bars designated (E) shall be epoxy coated.
Bearing seat surfaces shall be constructed or adjusted to their designated elevations within a tolerance of 1/8 inch (0.01 ft.). Adjustment shall be made either by grinding the surface or by shimming the bearings.
Structural steel shall only be painted for a distance equal to the depth of embedment into the concrete cap plus 3 inches. Those areas shall be primed in the shop with a Department approved zinc rich primer. No field painting shall be required. All structural steel shall be cleaned as specified in the Special Provision for "Surface Preparation and Painting Requirements for Weathering Steel".
Slipforming of parapets will not be allowed.
Sloped wall shall be reinforced with welded wire fabric, 6"x 6" - W4.0 x W4.0, weighing 58 lbs. per 100 sq. ft.
The embankment configuration shown shall be the minimum that must be placed and compacted prior to construction of the abutments.
The Contractor shall drive two test piles, one each at West Abutment and Pier 2 to 110% of the nominal required bearing specified in respective locations before ordering the remainder of piles.
The Contractor shall submit Structural Assessment Report(s) as required for the Contractor's Means and Methods of Construction. See Special Provisions.

Current Ratings of File for Existing Structure

Inventory: HS 17.3
Operating: HS 28.9
Live Load Restrictions: No

Inventory and Operating Ratings and Live Load Restrictions are provide for information only. Inventory and Operating Ratings are based on HS loading and configuration. Live Load Restrictions are based on Illinois legal loads and configurations. The Ratings and Live Load Restrictions are not necessarily representative of capacities to support the Contractor's equipment.

The Contractor is advised that the existing structure contains members (including piers) that are in a deteriorated condition with reduced load carrying capacity. It is the Contractor's responsibility to account for the condition of the existing structure when developing construction procedures for the complete or partial removal, or replacement of the structure. An Existing Structure Information Package is available upon request as noted in the special provisions.

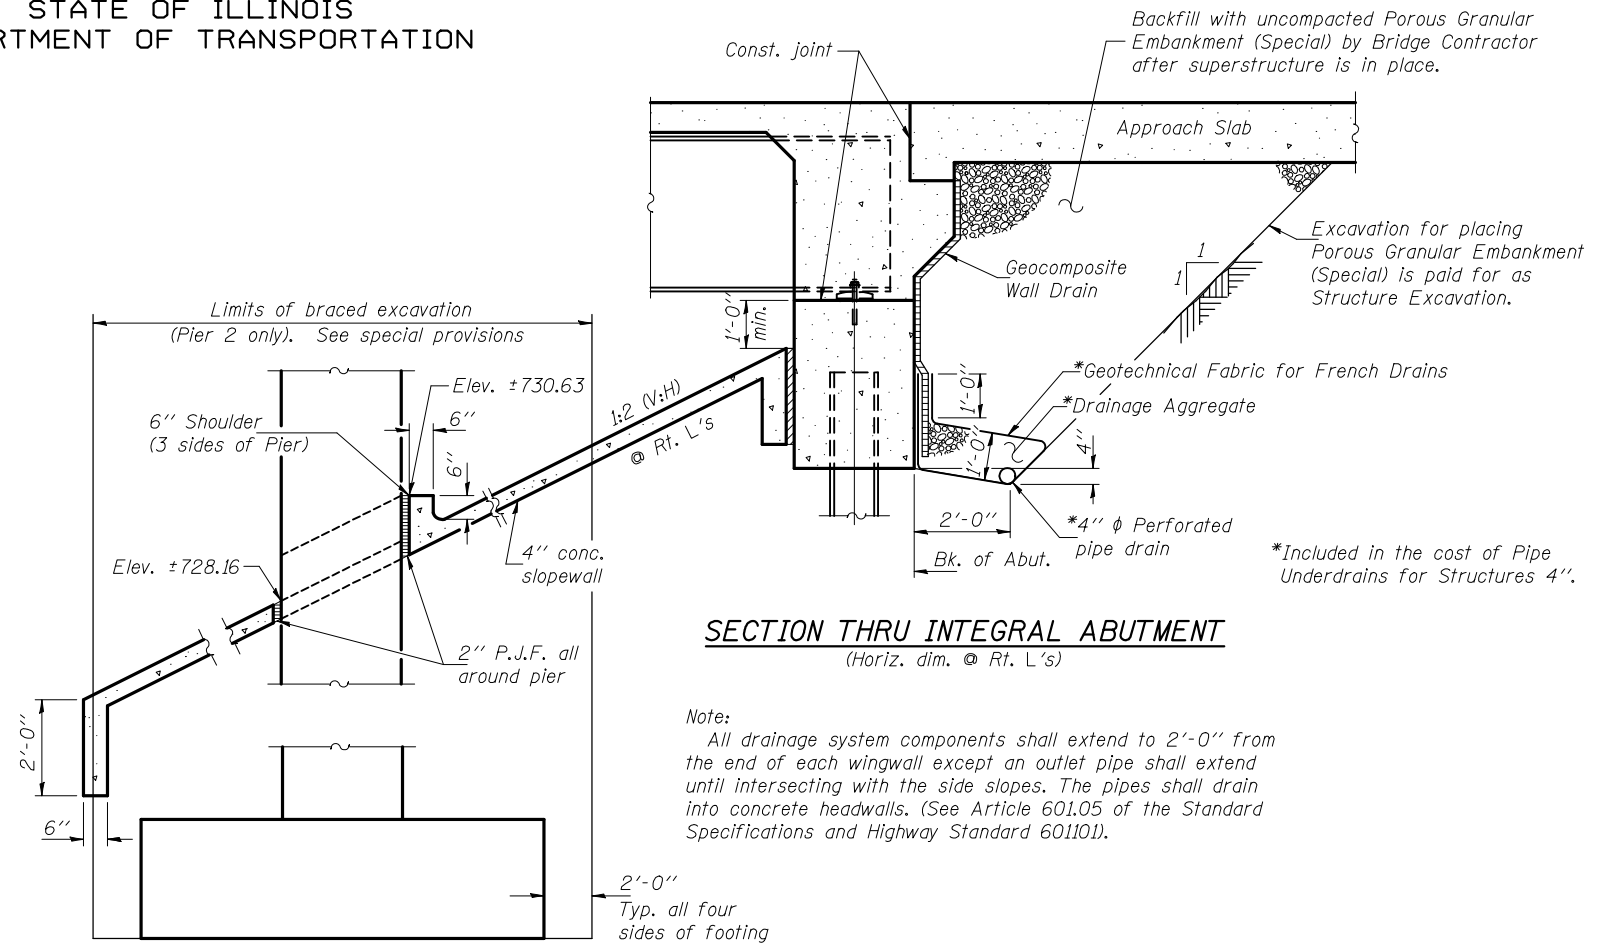

TOTAL BILL OF MATERIAL

ITEM	UNIT	SUPER	SUB	TOTAL
Porous Granular Embankment (Special)	Cu. Yd.	92.4		92.4
Removal of Existing Structures	Each	1		1
Structure Excavation	Cu. Yd.		250	250
Concrete Structures	Cu. Yd.		258.2	258.2
Concrete Superstructure	Cu. Yd.		319.4	319.4
Bridge Deck Grooving	Sq. Yd.	697		697
Concrete Encasement	Cu. Yd.		4.2	4.2
Protective Coat	Sq. Yd.	967		967
Furnishing and Erecting Structural Steel	L. Sum	1		1
Stud Shear Connectors	Each	3654		3654
Reinforcement Bars, Epoxy Coated	Pound	76250	33600	109850
Bar Splicers	Each	64		64
Sloped wall 4"	Sq. Yd.		482	482
Furnishing Steel Piles HP12x53	Foot		2348	2348
Driving Piles	Foot		2348	2348
Test Pile Steel HP12x53	Each		2	2
Name Plates	Each	1		1
Elastomeric Bearing Assembly, Type I	Each		12	12
Anchor Bolt 1" ϕ	Each		24	24
Anchor Bolt 1 1/2" ϕ	Each		24	24
Braced Excavation	Cu. Yd.		112	112
Geocomposite Wall Drain	Sq. Yd.		56.8	56.8
Pipe Underdrains for Structures 4"	Foot		137	137
Diamond Grinding (Bridge Section)	Sq. Yd.	734		734
Reinforced Soil Slope System	Sq. Ft.		5660	5660
Asbestos Bearing Pad Removal	Each		88	88

**Includes bridge approach slab and connector pavement.


DESIGNED	D.P. Narielwala
CHECKED	S.M. Ryan
DRAWN	h.t. duong
CHECKED	DPN/SMR

November 25, 2009
 EXAMINED *Thomas J. Domagala*
 ENGINEER OF BRIDGE DESIGN
 PASSED *Ralph E. Anderson*
 ENGINEER OF BRIDGES AND STRUCTURES


GENERAL DATA
STRUCTURE NO. 074-0086

SHEET NO. 2	F.A.S. RTE.	SECTION	COUNTY	TOTAL SHEETS	SHEET NO.
	1517	12VBR-1	PIATT	168	87
25 SHEETS	CONTRACT NO. 70388				
FED. ROAD DIST. NO. _ ILLINOIS FED. AID PROJECT					


STATE OF ILLINOIS
DEPARTMENT OF TRANSPORTATION

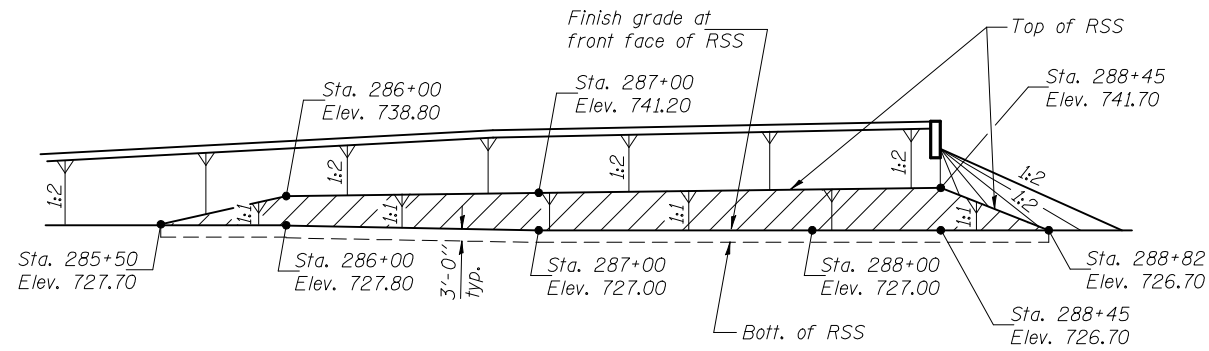


ELEVATION

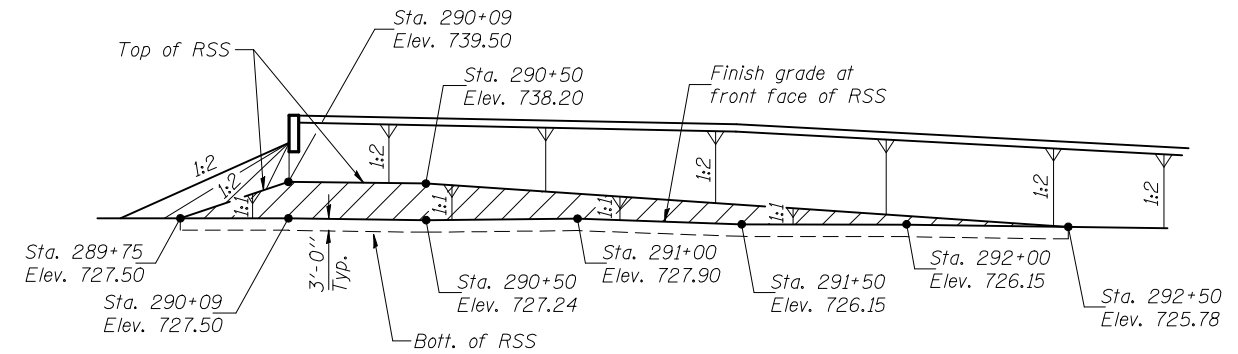


ELEVATION

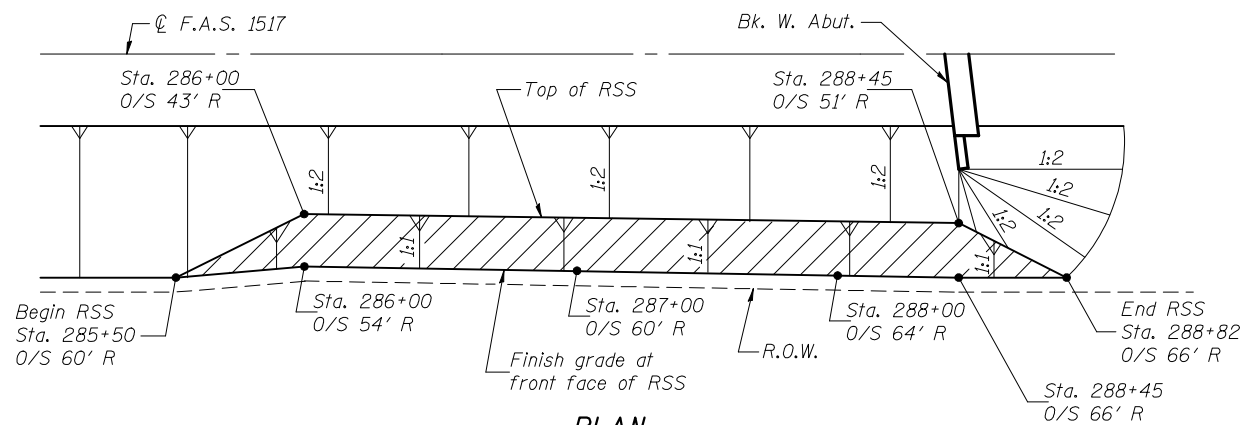

PLAN
WEST END - SOUTH SIDE

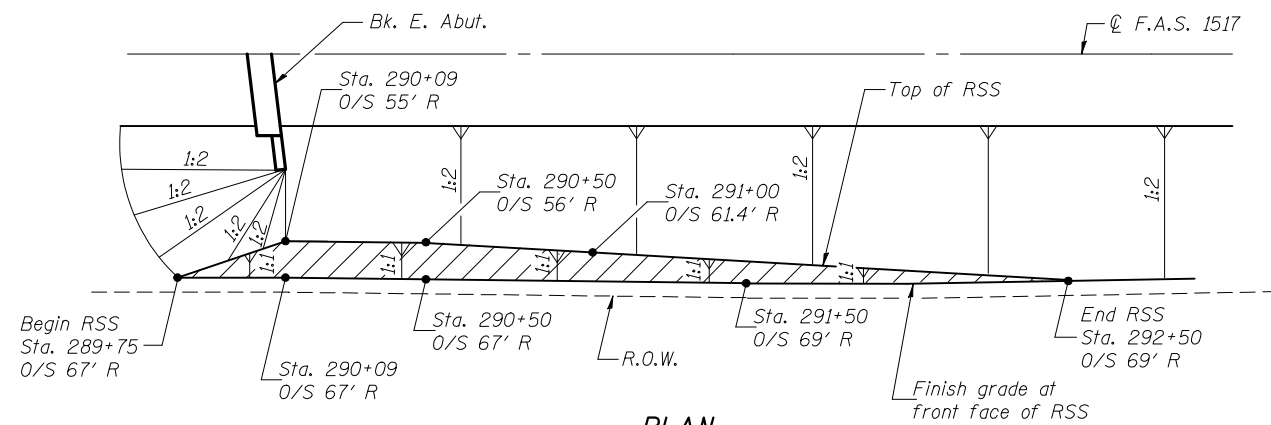

PLAN
EAST END - SOUTH SIDE

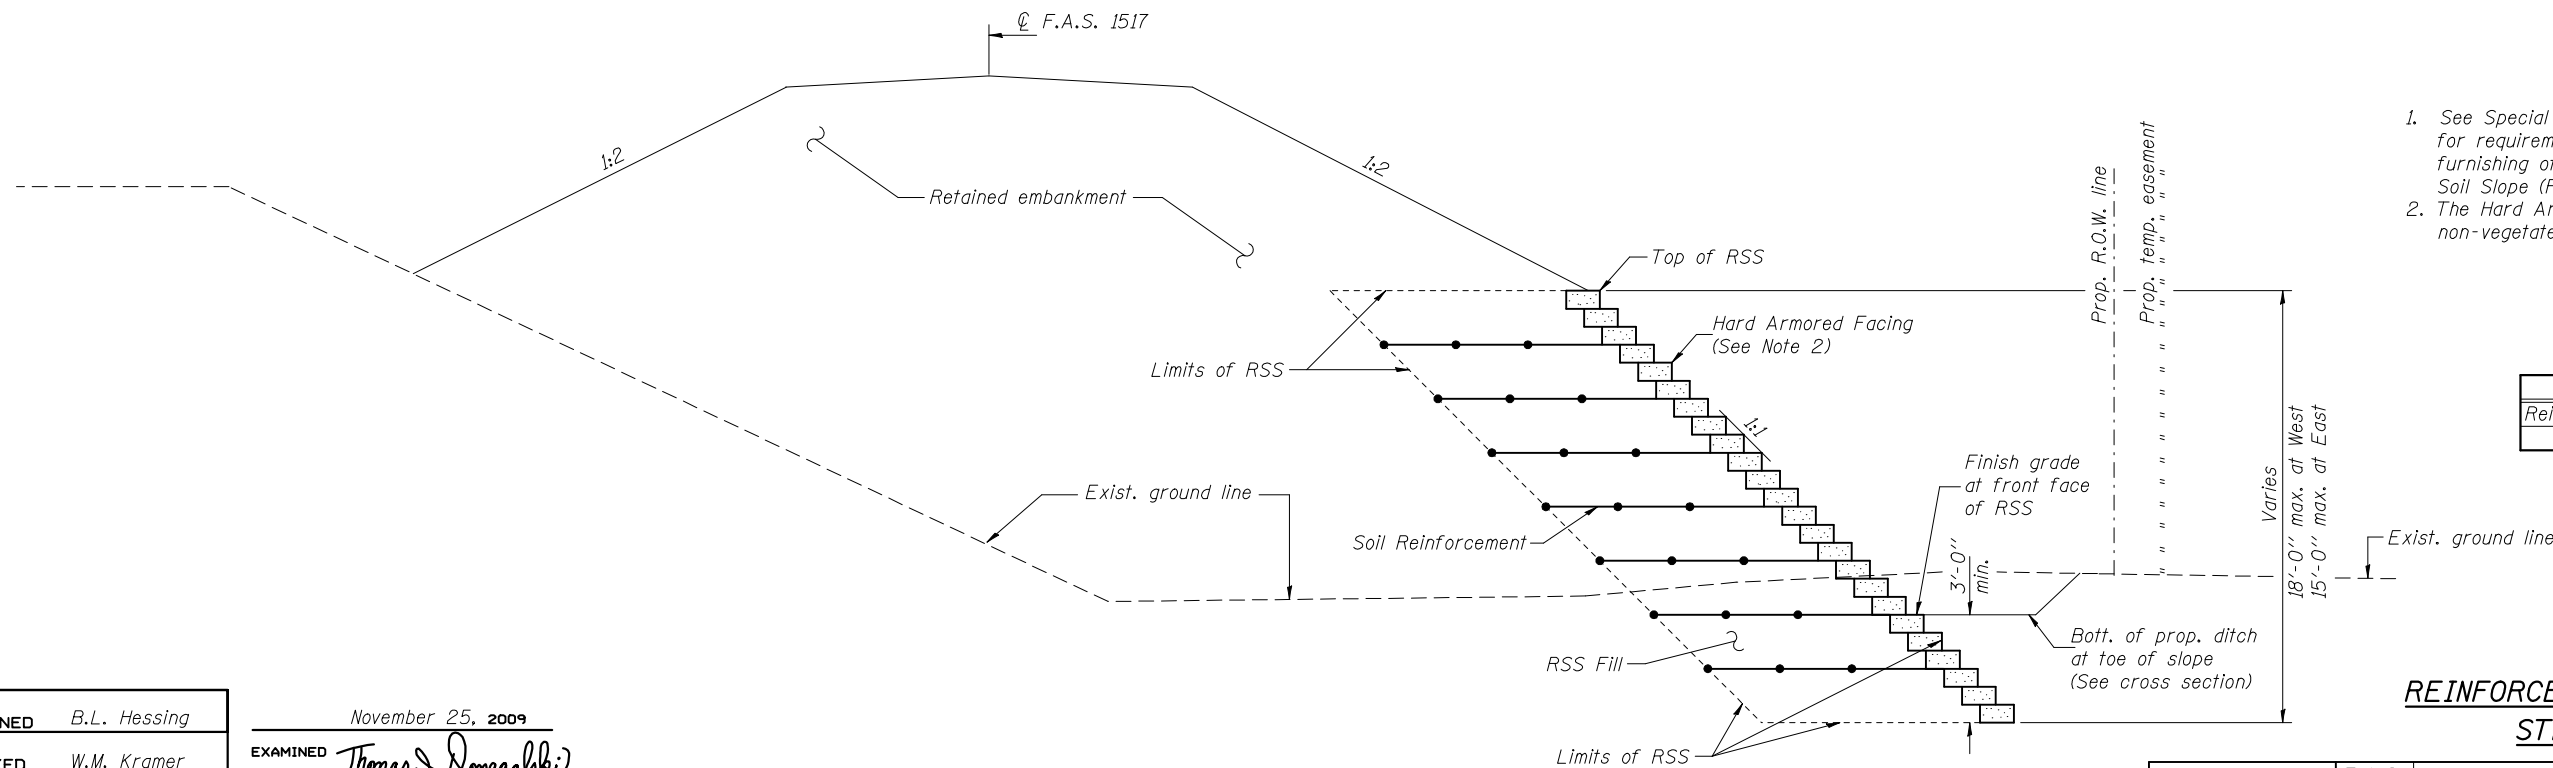

TYPICAL SECTION
(Looking east)

NOTES:

- See Special Provisions, "Reinforced Soil Slope System" for requirements pertaining to the design preparation, furnishing of materials, and construction of the Reinforced Soil Slope (RSS).
- The Hard Armored Facing shall be limited to the use of non-vegetated geocell or non-vegetated precast elements.

BILL OF MATERIAL

Item	Unit	Total
Reinforced Soil Slope System	Sq. Ft.	5660

REINFORCED SOIL SLOPE (RSS) DETAILS
STRUCTURE NO. 074-0086

DESIGNED	B.L. Hessing
CHECKED	W.M. Kramer
DRAWN	h.t. duong
CHECKED	BLH/WMK


November 25, 2009
 EXAMINED *Thomas J. Domagala*
 ENGINEER OF BRIDGE DESIGN
 PASSED *Ralph E. Anderson*
 ENGINEER OF BRIDGES AND STRUCTURES

SHEET NO. 3 25 SHEETS	F.A.S. RTE.	SECTION	COUNTY	TOTAL SHEETS	SHEET NO.
	1517	12VBR-1	PIATT	168	88
CONTRACT NO. 70388					
FED. ROAD DIST. NO. _ ILLINOIS FED. AID PROJECT					

STATE OF ILLINOIS
DEPARTMENT OF TRANSPORTATION

BEAM 1


Location	Station	Offset	Theoretical Grade Elevations	Theoretical Grade Elevations Adjusted For Dead Load Deflection and Grinding
Bk. W. Abut.	28837.76	-14.79	757.02	757.04
☉ Brg. W. Abut.	28839.03	-14.79	757.03	757.05
C	28849.03	-14.79	757.14	757.18
D	28859.03	-14.79	757.23	757.28
E	28869.03	-14.79	757.30	757.35
F	28879.03	-14.79	757.37	757.40
☉ Brg. Pier 1	28888.76	-14.79	757.42	757.44
G	28898.76	-14.79	757.45	757.49
H	28908.76	-14.79	757.48	757.53
I	28918.76	-14.79	757.49	757.56
J	28928.76	-14.79	757.49	757.54
K	28938.76	-14.79	757.47	757.51
☉ Brg. Pier 2	28950.76	-14.79	757.43	757.45
L	28960.76	-14.79	757.39	757.42
M	28970.76	-14.79	757.33	757.38
N	28980.76	-14.79	757.26	757.31
O	28990.76	-14.79	757.17	757.22
☉ Brg. E. Abut.	29000.49	-14.79	757.08	757.10
Bk. E. Abut.	29001.76	-14.79	757.07	757.09

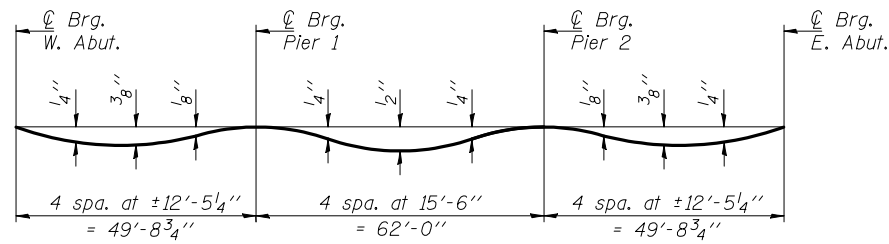

DEAD LOAD DEFLECTION DIAGRAM

(Includes weight of concrete only.)


Note: The above deflections are not to be used in the field if the engineer is working from the grade elevations adjusted for dead load deflections and grinding as shown below & on sheet 5 of 25.

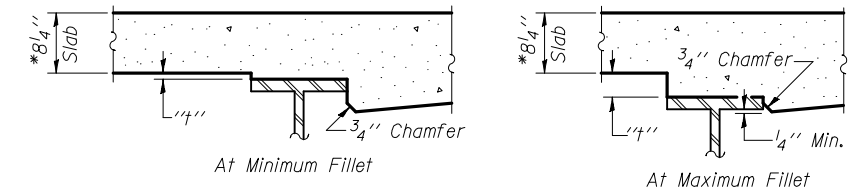

To determine "t": After all structural steel has been erected, elevations of the top flanges of the beams shall be taken at intervals shown below. These elevations subtracted from the "Theoretical Grade Elevations Adjusted for Dead Load Deflection and Grinding" shown below and on sheet 5 of 25, minus 8 1/4" deck thickness, equals the fillet height "t" above top flange of beams.
The slab is to be ground after curing to achieve smoothness, but the slab is not to be ground to elevations below the "Theoretical Grade Elevations" shown on this sheet and sheet 5 of 25. For grinding the deck, see Special Provisions.

FILLET HEIGHTS

*Prior to grinding

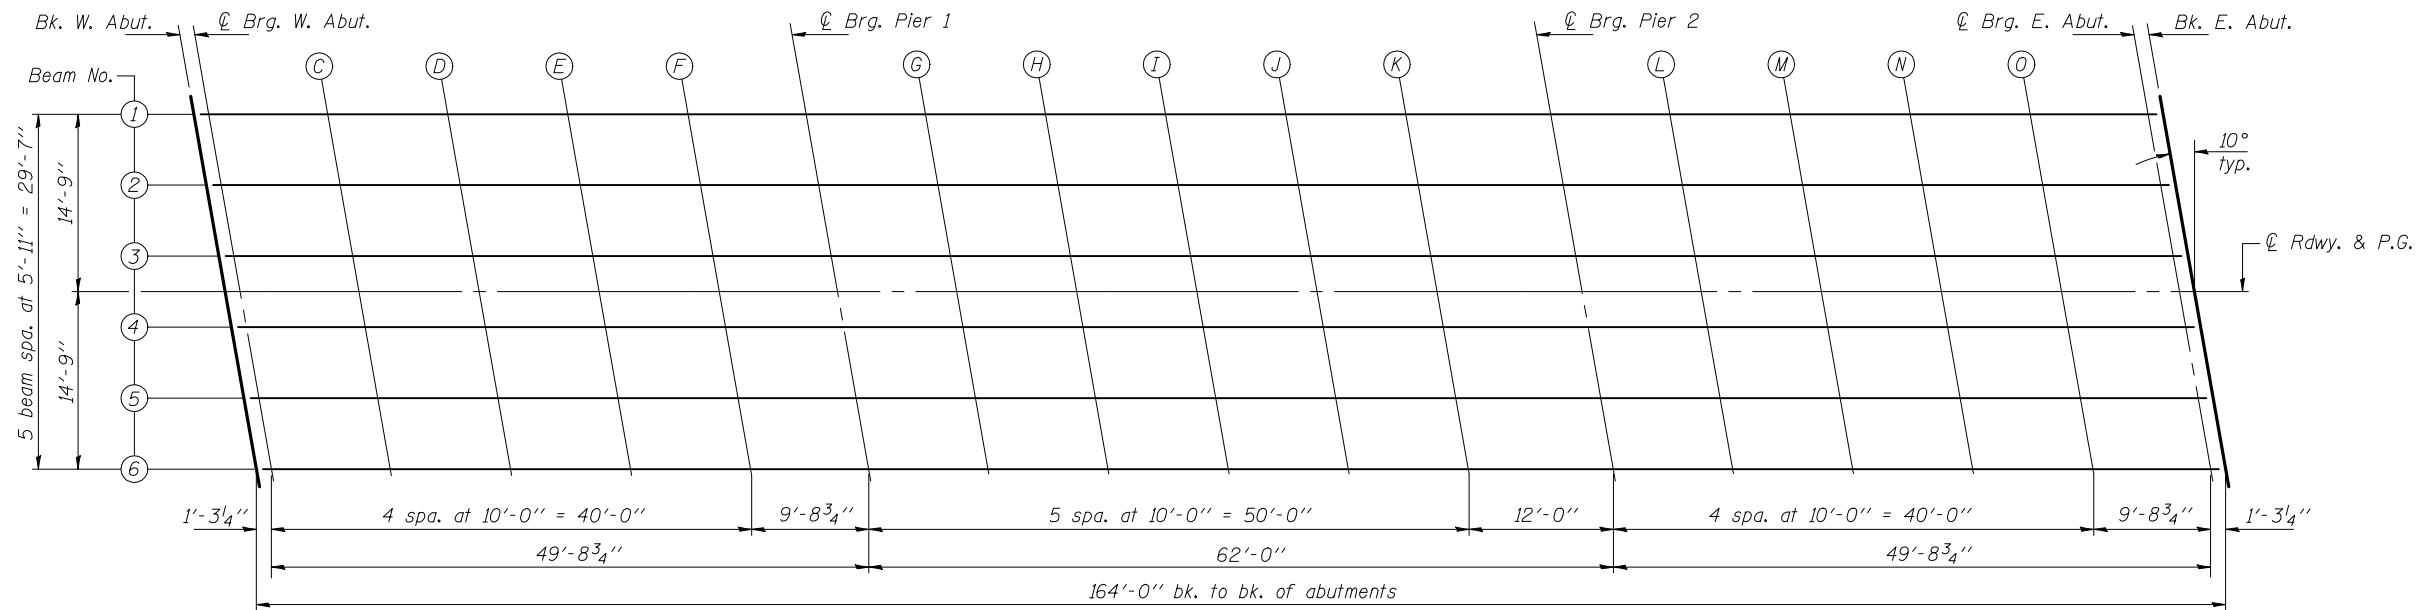

PLAN

TOP OF SLAB ELEVATIONS
STRUCTURE NO. 074-0086

DESIGNED	D.P. Narielwala
CHECKED	S.M. Ryan
DRAWN	h.t. duong
CHECKED	DPN/SMR

November 25, 2009
EXAMINED *Thomas J. Domagala*
PASSED *Ralph E. Anderson*
ENGINEER OF BRIDGE DESIGN
ENGINEER OF BRIDGES AND STRUCTURES

SHEET NO. 4 25 SHEETS	F.A.S. RTE.	SECTION	COUNTY	TOTAL SHEETS	SHEET NO.
	1517	12VBR-1	PIATT	168	89
			CONTRACT NO. 70388		
FED. ROAD DIST. NO. _ ILLINOIS FED. AID PROJECT					

STATE OF ILLINOIS
DEPARTMENT OF TRANSPORTATION

BEAM 2

Location	Station	Offset	Theoretical Grade Elevations	Theoretical Grade Elevations Adjusted For Dead Load Deflection and Grinding
Bk. W. Abut.	28838.81	-8.88	757.13	757.15
☉ Brg. W. Abut.	28840.07	-8.88	757.15	757.17
C	28850.07	-8.88	757.25	757.30
D	28860.07	-8.88	757.34	757.39
E	28870.07	-8.88	757.42	757.46
F	28880.07	-8.88	757.48	757.51
☉ Brg. Pier 1	28889.81	-8.88	757.53	757.55
G	28899.81	-8.88	757.56	757.60
H	28909.81	-8.88	757.59	757.64
I	28919.81	-8.88	757.60	757.66
J	28929.81	-8.88	757.59	757.65
K	28939.81	-8.88	757.58	757.62
☉ Brg. Pier 2	28951.81	-8.88	757.54	757.56
L	28961.81	-8.88	757.49	757.52
M	28971.81	-8.88	757.43	757.48
N	28981.81	-8.88	757.36	757.41
O	28991.81	-8.88	757.27	757.32
☉ Brg. E. Abut.	29001.54	-8.88	757.17	757.19
Bk. E. Abut.	29002.81	-8.88	757.16	757.18

BEAM 3

Location	Station	Offset	Theoretical Grade Elevations	Theoretical Grade Elevations Adjusted For Dead Load Deflection and Grinding
Bk. W. Abut.	28839.85	-2.96	757.24	757.26
☉ Brg. W. Abut.	28841.12	-2.96	757.25	757.27
C	28851.12	-2.96	757.35	757.40
D	28861.12	-2.96	757.44	757.50
E	28871.12	-2.96	757.52	757.56
F	28881.12	-2.96	757.58	757.61
☉ Brg. Pier 1	28890.85	-2.96	757.62	757.64
G	28900.85	-2.96	757.66	757.70
H	28910.85	-2.96	757.68	757.73
I	28920.85	-2.96	757.69	757.76
J	28930.85	-2.96	757.68	757.74
K	28940.85	-2.96	757.67	757.71
☉ Brg. Pier 2	28952.85	-2.96	757.63	757.65
L	28962.85	-2.96	757.58	757.61
M	28972.85	-2.96	757.52	757.56
N	28982.85	-2.96	757.44	757.50
O	28992.85	-2.96	757.35	757.40
☉ Brg. E. Abut.	29002.58	-2.96	757.26	757.28
Bk. E. Abut.	29003.85	-2.96	757.24	757.26

☉ ROADWAY & PROFILE GRADE

Location	Station	Offset	Theoretical Grade Elevations	Theoretical Grade Elevations Adjusted For Dead Load Deflection and Grinding
Bk. W. Abut.	28840.37	0.00	757.29	757.31
☉ Brg. W. Abut.	28841.64	0.00	757.30	757.32
C	28851.64	0.00	757.40	757.45
D	28861.64	0.00	757.49	757.55
E	28871.64	0.00	757.57	757.61
F	28881.64	0.00	757.63	757.66
☉ Brg. Pier 1	28891.37	0.00	757.67	757.69
G	28901.37	0.00	757.71	757.74
H	28911.37	0.00	757.73	757.78
I	28921.37	0.00	757.73	757.80
J	28931.37	0.00	757.73	757.79
K	28941.37	0.00	757.71	757.75
☉ Brg. Pier 2	28953.37	0.00	757.67	757.69
L	28963.37	0.00	757.62	757.65
M	28973.37	0.00	757.56	757.61
N	28983.37	0.00	757.48	757.54
O	28993.37	0.00	757.40	757.44
☉ Brg. E. Abut.	29003.10	0.00	757.30	757.32
Bk. E. Abut.	29004.37	0.00	757.28	757.30

BEAM 4

Location	Station	Offset	Theoretical Grade Elevations	Theoretical Grade Elevations Adjusted For Dead Load Deflection and Grinding
Bk. W. Abut.	28840.89	2.96	757.25	757.27
☉ Brg. W. Abut.	28842.16	2.96	757.26	757.28
C	28852.16	2.96	757.36	757.41
D	28862.16	2.96	757.45	757.50
E	28872.16	2.96	757.52	757.57
F	28882.16	2.96	757.58	757.62
☉ Brg. Pier 1	28891.89	2.96	757.63	757.65
G	28901.89	2.96	757.66	757.70
H	28911.89	2.96	757.68	757.74
I	28921.89	2.96	757.69	757.76
J	28931.89	2.96	757.68	757.74
K	28941.89	2.96	757.66	757.70
☉ Brg. Pier 2	28953.89	2.96	757.62	757.64
L	28963.89	2.96	757.57	757.61
M	28973.89	2.96	757.51	757.56
N	28983.89	2.96	757.43	757.49
O	28993.89	2.96	757.34	757.39
☉ Brg. E. Abut.	29003.62	2.96	757.24	757.26
Bk. E. Abut.	29004.89	2.96	757.23	757.25

BEAM 5

Location	Station	Offset	Theoretical Grade Elevations	Theoretical Grade Elevations Adjusted For Dead Load Deflection and Grinding
Bk. W. Abut.	28841.93	8.88	757.17	757.19
☉ Brg. W. Abut.	28843.20	8.88	757.18	757.20
C	28853.20	8.88	757.28	757.33
D	28863.20	8.88	757.37	757.42
E	28873.20	8.88	757.44	757.49
F	28883.20	8.88	757.50	757.53
☉ Brg. Pier 1	28892.93	8.88	757.54	757.56
G	28902.93	8.88	757.57	757.61
H	28912.93	8.88	757.59	757.65
I	28922.93	8.88	757.60	757.66
J	28932.93	8.88	757.59	757.65
K	28942.93	8.88	757.57	757.61
☉ Brg. Pier 2	28954.93	8.88	757.52	757.54
L	28964.93	8.88	757.47	757.51
M	28974.93	8.88	757.41	757.46
N	28984.93	8.88	757.33	757.39
O	28994.93	8.88	757.24	757.29
☉ Brg. E. Abut.	29004.67	8.88	757.14	757.16
Bk. E. Abut.	29005.93	8.88	757.13	757.15

BEAM 6

Location	Station	Offset	Theoretical Grade Elevations	Theoretical Grade Elevations Adjusted For Dead Load Deflection and Grinding
Bk. W. Abut.	28842.98	14.79	757.07	757.09
☉ Brg. W. Abut.	28844.25	14.79	757.09	757.11
C	28854.25	14.79	757.18	757.23
D	28864.25	14.79	757.27	757.32
E	28874.25	14.79	757.34	757.38
F	28884.25	14.79	757.39	757.43
☉ Brg. Pier 1	28893.98	14.79	757.44	757.46
G	28903.98	14.79	757.47	757.51
H	28913.98	14.79	757.49	757.54
I	28923.98	14.79	757.49	757.56
J	28933.98	14.79	757.48	757.54
K	28943.98	14.79	757.46	757.50
☉ Brg. Pier 2	28955.98	14.79	757.41	757.43
L	28965.98	14.79	757.36	757.39
M	28975.98	14.79	757.30	757.34
N	28985.98	14.79	757.22	757.27
O	28995.98	14.79	757.13	757.17
☉ Brg. E. Abut.	29005.71	14.79	757.02	757.04
Bk. E. Abut.	29006.98	14.79	757.01	757.03

DESIGNED	D.P. Narielwala
CHECKED	S.M. Ryan
DRAWN	h.t. duong
CHECKED	DPN/SMR

November 25, 2009
 EXAMINED *Thomas J. Domagala*
 ENGINEER OF BRIDGE DESIGN
 PASSED *Ralph E. Anderson*
 ENGINEER OF BRIDGES AND STRUCTURES

TOP OF SLAB ELEVATIONS
STRUCTURE NO. 074-0086

SHEET NO. 5 25 SHEETS	F.A.S. RTE.	SECTION	COUNTY	TOTAL SHEETS	SHEET NO.
	1517	12VBR-1	PIATT	168	90
CONTRACT NO. 70388					
FED. ROAD DIST. NO. _ ILLINOIS FED. AID PROJECT					

STATE OF ILLINOIS
DEPARTMENT OF TRANSPORTATION

NORTH CURB LINE

Location	Station	Offset	Theoretical Grade Elevations	Theoretical Grade Elevations Adjusted For Grinding
West end of W. Appr. Slab	28807.55	-16.00	756.59	756.61
A	28817.55	-16.00	756.74	756.76
B	28827.55	-16.00	756.87	756.89
East end of W. Appr. Slab	28837.55	-16.00	756.99	757.01

NORTH EDGE OF APPROACH SLAB

Location	Station	Offset	Theoretical Grade Elevations	Theoretical Grade Elevations Adjusted For Grinding
West end of W. Appr. Slab	28808.25	-12.00	756.68	756.70
A	28818.25	-12.00	756.83	756.85
B	28828.25	-12.00	756.96	756.98
East end of W. Appr. Slab	28838.25	-12.00	757.08	757.10

℄ ROADWAY & PROFILE GRADE


Location	Station	Offset	Theoretical Grade Elevations	Theoretical Grade Elevations Adjusted For Grinding
West end of W. Appr. Slab	28810.37	0.00	756.90	756.92
A	28820.37	0.00	757.05	757.07
B	28830.37	0.00	757.18	757.20
East end of W. Appr. Slab	28840.37	0.00	757.29	757.31

SOUTH EDGE OF APPROACH SLAB

Location	Station	Offset	Theoretical Grade Elevations	Theoretical Grade Elevations Adjusted For Grinding
West end of W. Appr. Slab	28812.49	12.00	756.75	756.77
A	28822.49	12.00	756.89	756.91
B	28832.49	12.00	757.01	757.03
East end of W. Appr. Slab	28842.49	12.00	757.13	757.15

SOUTH CURB LINE

Location	Station	Offset	Theoretical Grade Elevations	Theoretical Grade Elevations Adjusted For Grinding
West end of W. Appr. Slab	28813.19	16.00	756.68	756.70
A	28823.19	16.00	756.81	756.83
B	28833.19	16.00	756.94	756.96
East end of W. Appr. Slab	28843.19	16.00	757.05	757.07

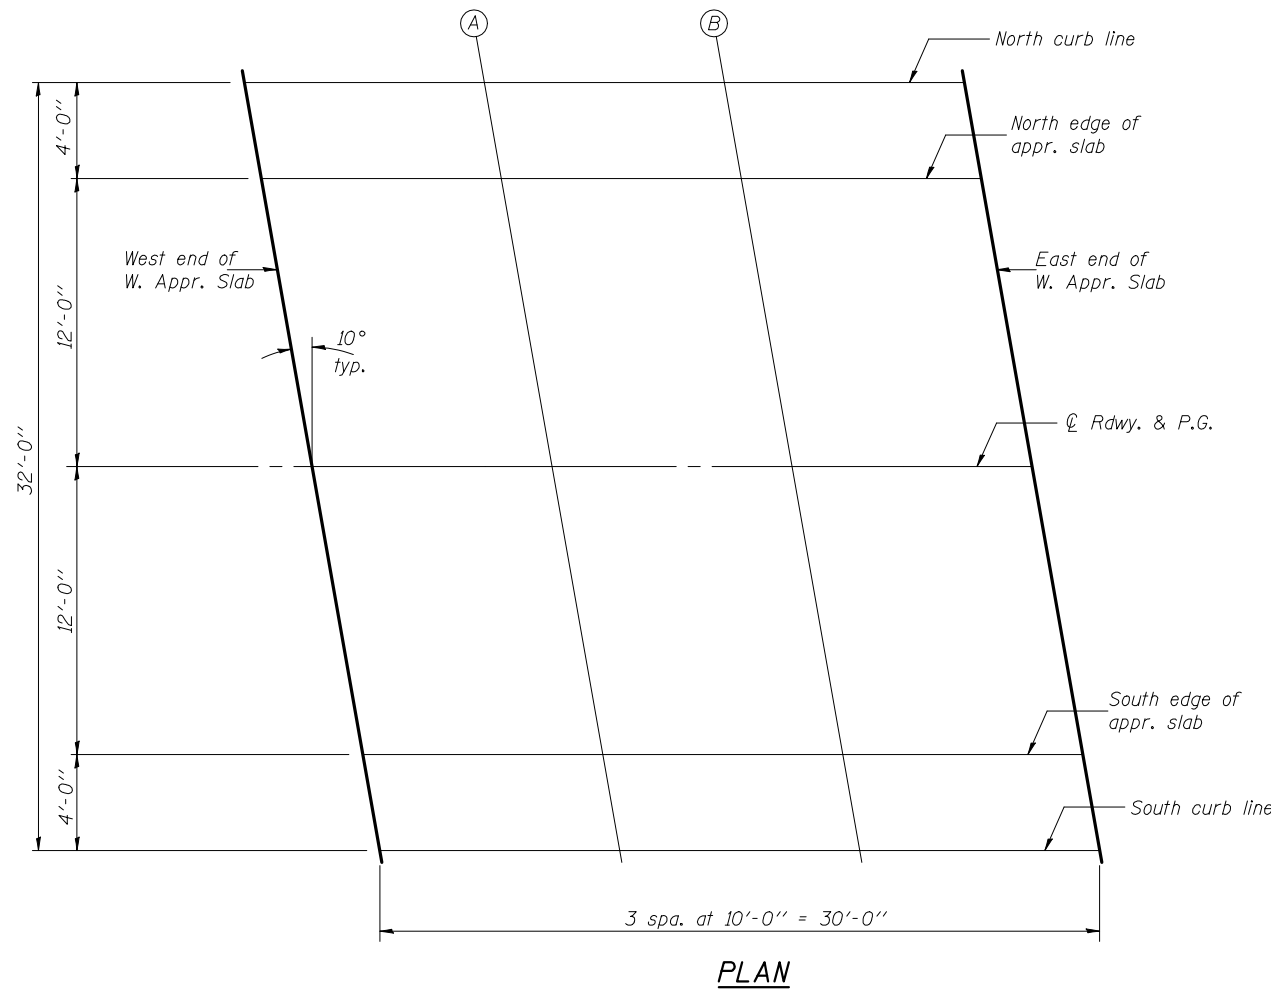

PLAN

DESIGNED	D.P. Narielwala
CHECKED	S.M. Ryan
DRAWN	h.t. duong
CHECKED	DPN/SMR

November 25, 2009
 EXAMINED *Thomas J. Domagala*
 ENGINEER OF BRIDGE DESIGN
 PASSED *Ralph E. Anderson*
 ENGINEER OF BRIDGES AND STRUCTURES

E-AS1 10-1-08

TOP OF WEST APPROACH SLAB ELEVATIONS
STRUCTURE NO. 074-0086

SHEET NO. 6	F.A.S. RTE.	SECTION	COUNTY	TOTAL SHEETS	SHEET NO.
	1517	12VBR-1	PIATT	168	91
25 SHEETS	CONTRACT NO. 70388				
FED. ROAD DIST. NO. _ ILLINOIS FED. AID PROJECT					

STATE OF ILLINOIS
DEPARTMENT OF TRANSPORTATION

NORTH CURB LINE

Location	Station	Offset	Theoretical Grade Elevations	Theoretical Grade Elevations Adjusted For Grinding
West end of E. Appr. Slab	29001.55	-16.00	757.04	757.06
P	29011.55	-16.00	756.93	756.95
Q	29021.55	-16.00	756.80	756.82
East end of E. Appr. Slab	29031.55	-16.00	756.66	756.68

NORTH EDGE OF APPROACH SLAB

Location	Station	Offset	Theoretical Grade Elevations	Theoretical Grade Elevations Adjusted For Grinding
West end of E. Appr. Slab	29002.25	-12.00	757.12	757.14
P	29012.25	-12.00	757.00	757.02
Q	29022.25	-12.00	756.88	756.90
East end of E. Appr. Slab	29032.25	-12.00	756.74	756.76

☉ ROADWAY & PROFILE GRADE


Location	Station	Offset	Theoretical Grade Elevations	Theoretical Grade Elevations Adjusted For Grinding
West end of E. Appr. Slab	29004.37	0.00	757.28	757.30
P	29014.37	0.00	757.17	757.19
Q	29024.37	0.00	757.04	757.06
East end of E. Appr. Slab	29034.37	0.00	756.89	756.91

SOUTH EDGE OF APPROACH SLAB

Location	Station	Offset	Theoretical Grade Elevations	Theoretical Grade Elevations Adjusted For Grinding
West end of E. Appr. Slab	29006.49	12.00	757.07	757.09
P	29016.49	12.00	756.95	756.97
Q	29026.49	12.00	756.82	756.84
East end of E. Appr. Slab	29036.49	12.00	756.67	756.69

SOUTH CURB LINE

Location	Station	Offset	Theoretical Grade Elevations	Theoretical Grade Elevations Adjusted For Grinding
West end of E. Appr. Slab	29007.19	16.00	756.98	757.00
P	29017.19	16.00	756.86	756.88
Q	29027.19	16.00	756.73	756.75
East end of E. Appr. Slab	29037.19	16.00	756.58	756.60

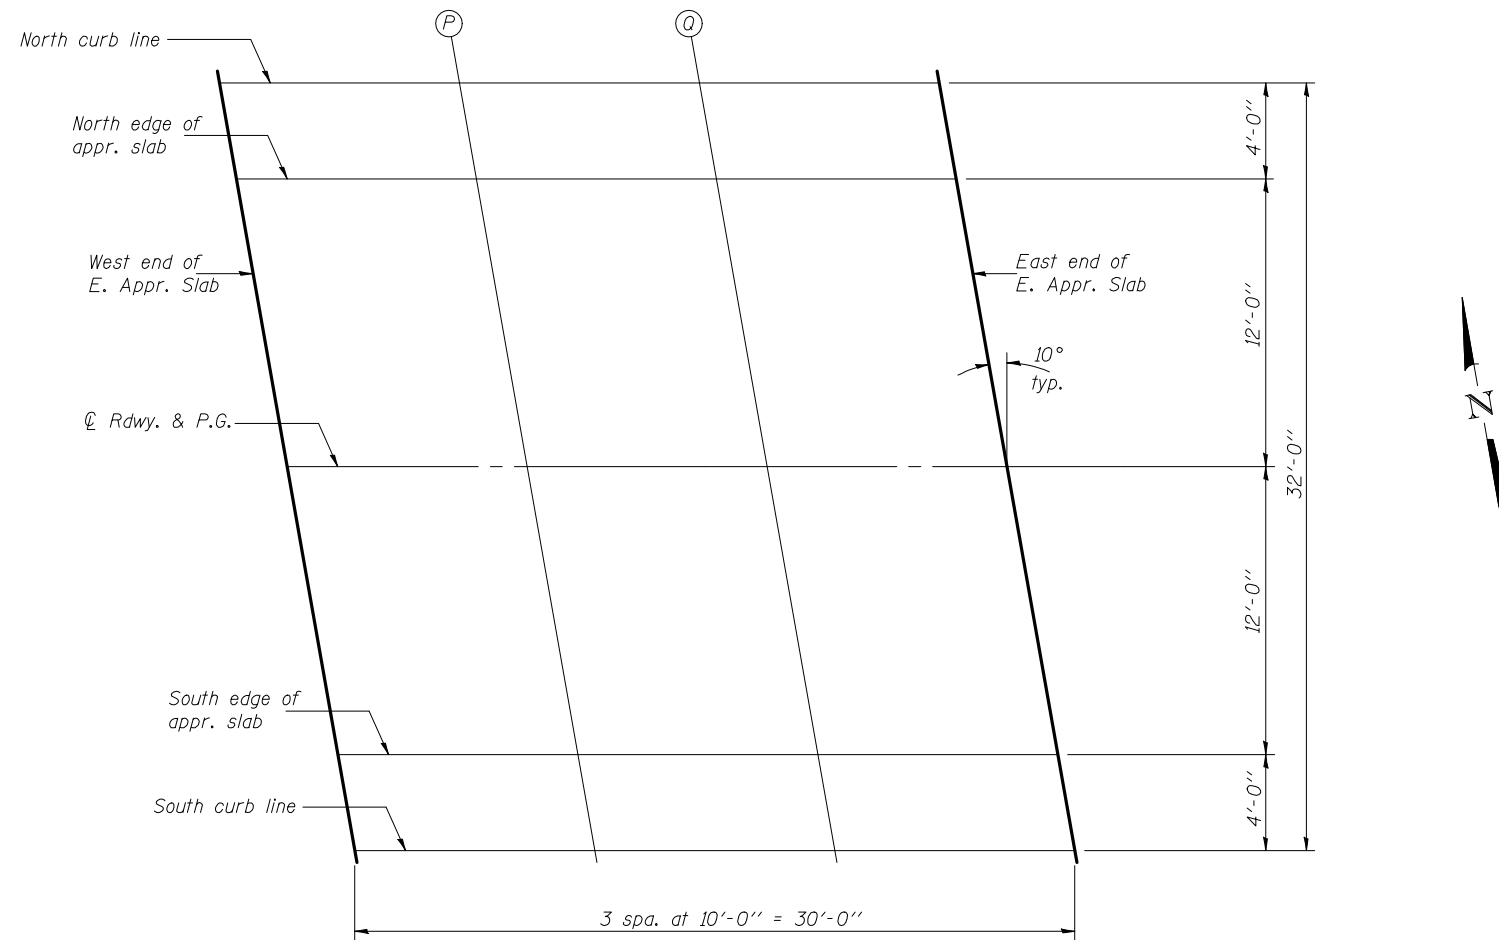

PLAN

DESIGNED	D.P. Narielwala
CHECKED	S.M. Ryan
DRAWN	h.t. duong
CHECKED	DPN/SMR

November 25, 2009
 EXAMINED *Thomas J. Domagala*
 ENGINEER OF BRIDGE DESIGN
 PASSED *Ralph E. Anderson*
 ENGINEER OF BRIDGES AND STRUCTURES


E-AS1 10-1-08

TOP OF EAST APPROACH SLAB ELEVATIONS
STRUCTURE NO. 074-0086

SHEET NO. 7 25 SHEETS	F.A.S. RTE.	SECTION	COUNTY	TOTAL SHEETS	SHEET NO.
	1517	12VBR-1	PIATT	168	92
			CONTRACT NO. 70388		
FED. ROAD DIST. NO. _ ILLINOIS FED. AID PROJECT					

STATE OF ILLINOIS
DEPARTMENT OF TRANSPORTATION


*Order a(E) and a₁(E) bars full length.
Cut to fit skew and use remainder of
bars in opposite end.

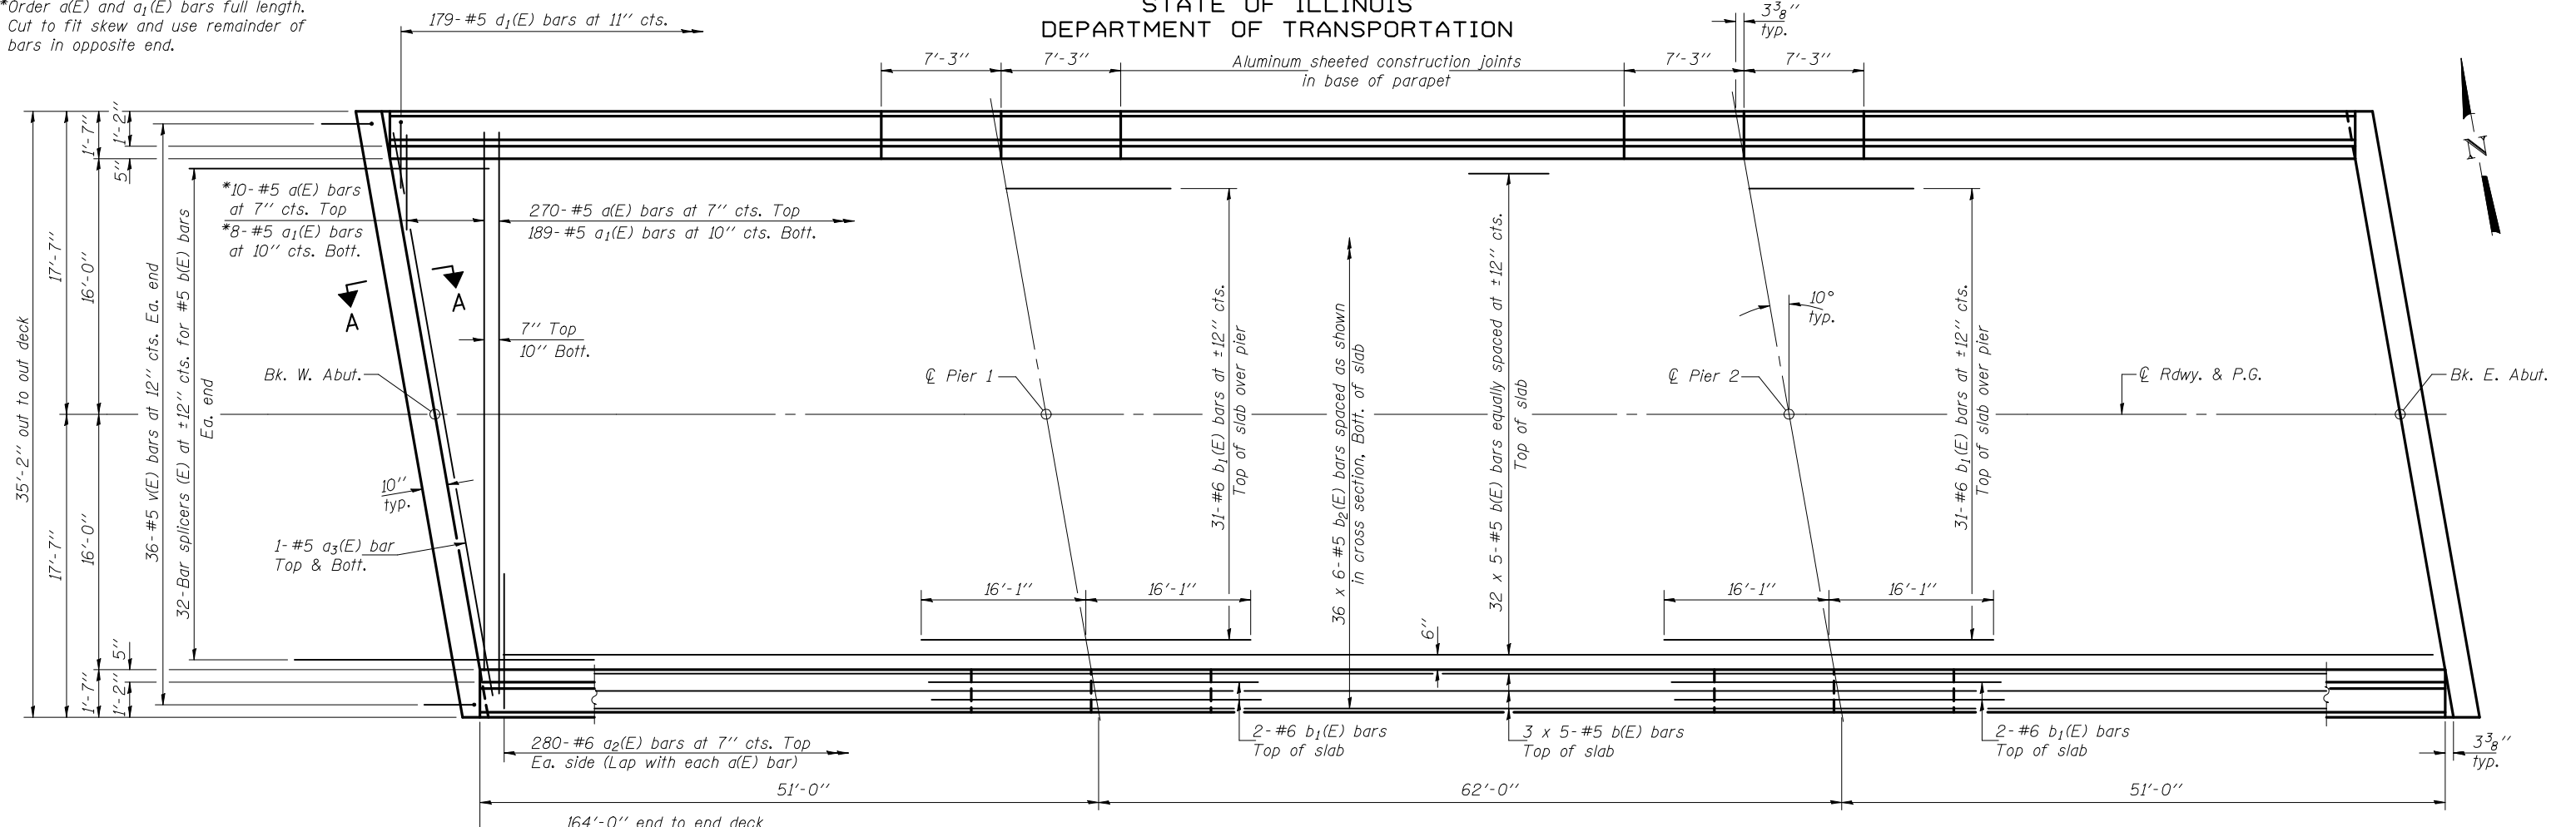

PLAN

MIN. BAR LAP
#5 bar = 2'-2"

Notes: See sheet 9 of 25 for superstructure details
and Bill of Material.
Bars indicated thus 32 x 5- #5 etc. indicates
32 lines of bars with 5 lengths per line.
See sheet 9 of 25 for parapet reinforcement.
See sheet 10 of 25 for Section A-A.

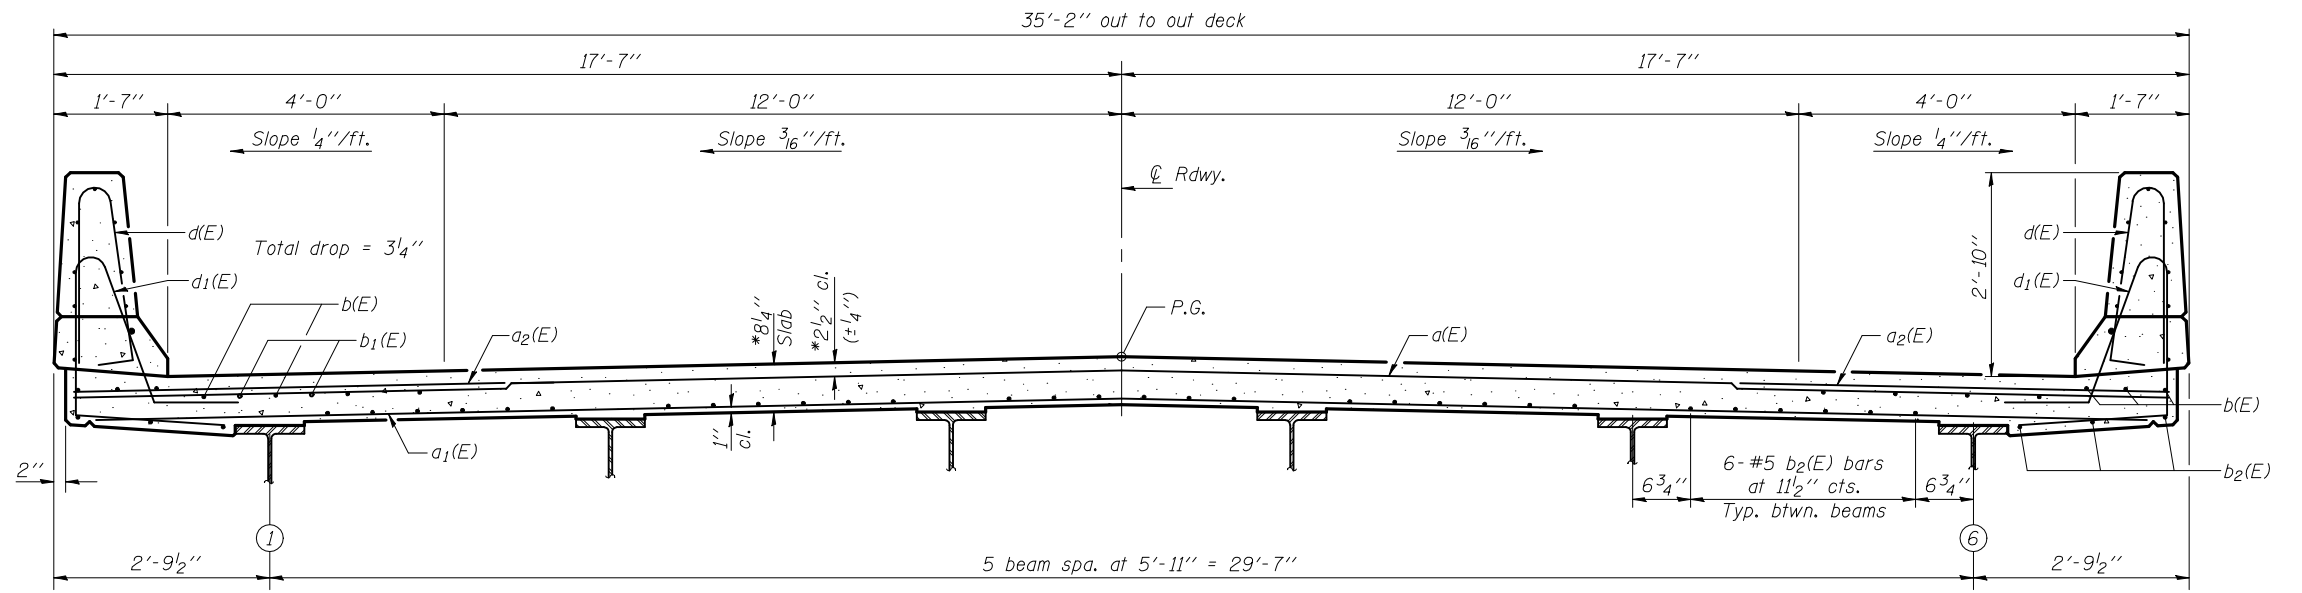

CROSS SECTION
(Looking east)

SUPERSTRUCTURE
STRUCTURE NO. 074-0086

DESIGNED	D.P. Narielwala
CHECKED	S.M. Ryan
DRAWN	h.t. duong
CHECKED	DPN/SMR

November 25, 2009


EXAMINED *Thomas J. Domagala*
ENGINEER OF BRIDGE DESIGN

PASSED *Ralph E. Anderson*
ENGINEER OF BRIDGES AND STRUCTURES

*Prior to grinding.


SHEET NO. 8 25 SHEETS	F.A.S. RTE.	SECTION	COUNTY	TOTAL SHEETS	SHEET NO.
	1517	12VBR-1	PIATT	168	93
CONTRACT NO. 70388					
FED. ROAD DIST. NO. _ ILLINOIS FED. AID PROJECT					

STATE OF ILLINOIS
DEPARTMENT OF TRANSPORTATION

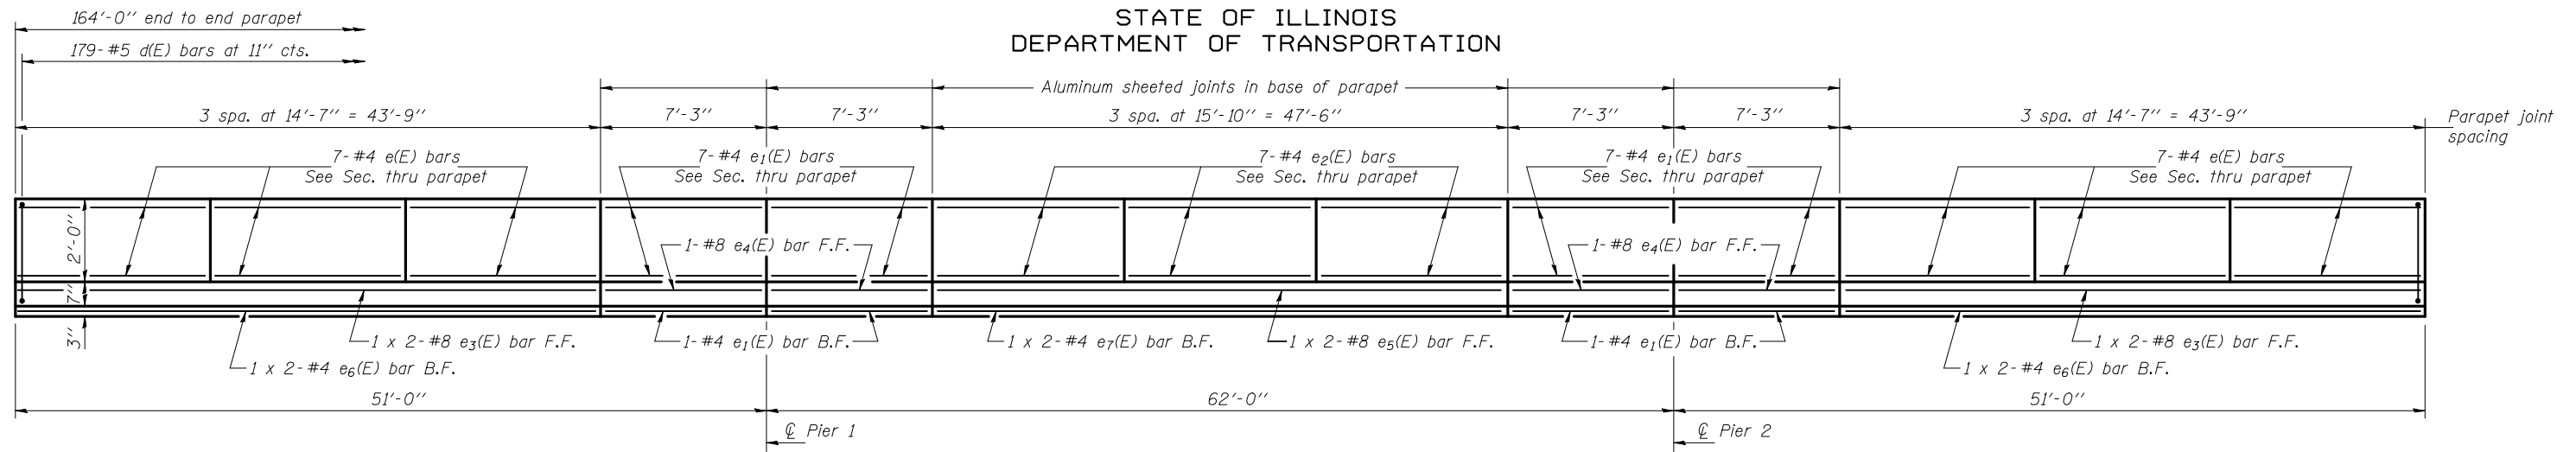


INSIDE ELEVATION OF PARAPET

MIN. BAR LAP
(Parapet)
#4 bar = 1'-4"
#8 bar = 3'-5"

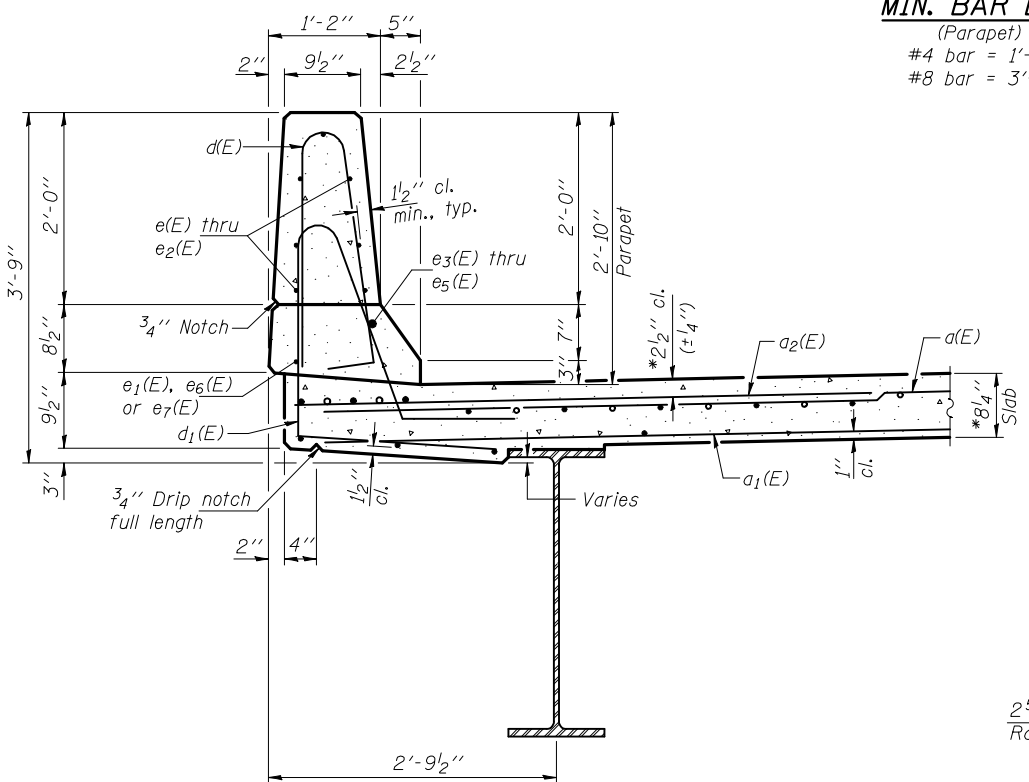


SECTION THRU PARAPET


*Prior to grinding.

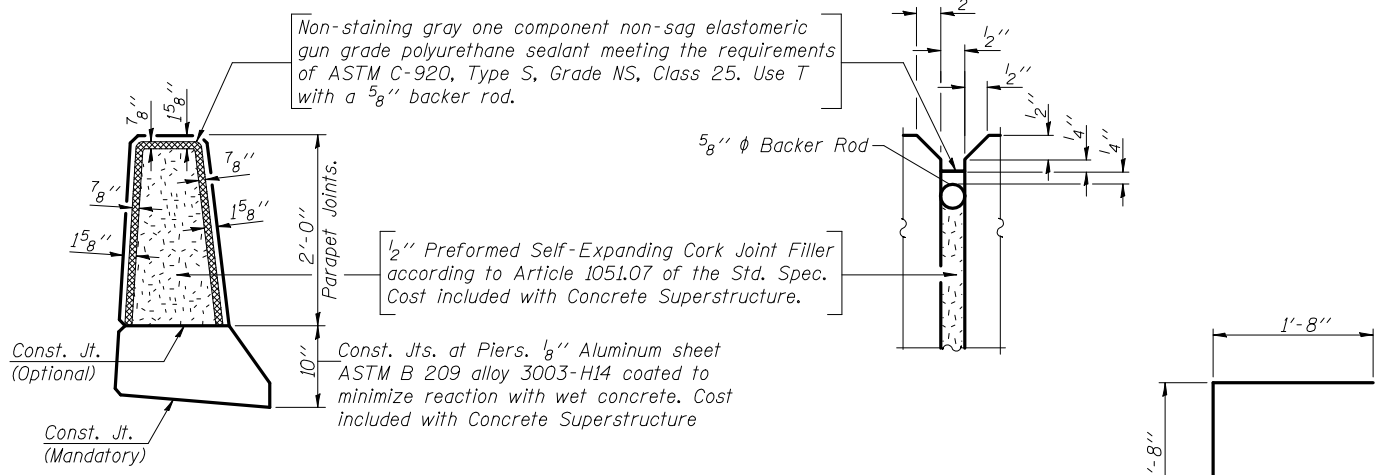


PARAPET JOINT DETAILS

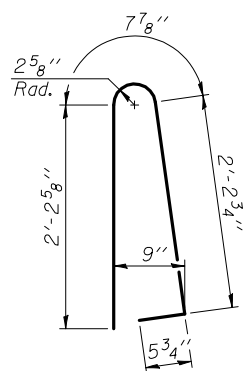


BAR d(E)

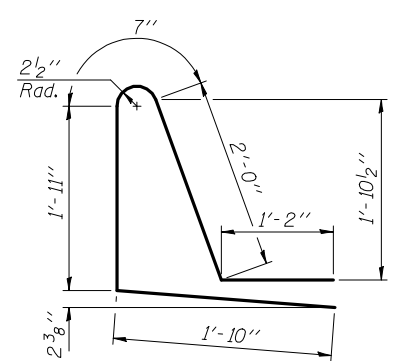

BAR d1(E)

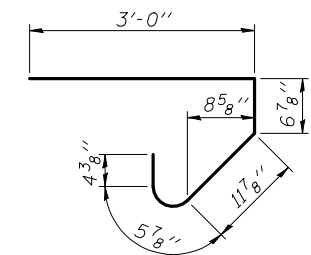

BAR s(E)

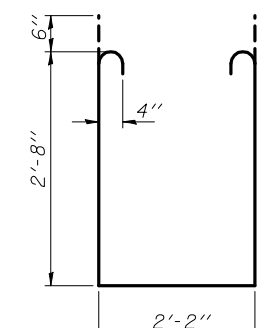

BAR s1(E)

**SUPERSTRUCTURE
BILL OF MATERIAL**

Bar	No.	Size	Length	Shape
d(E)	280	#5	34'-7"	—
a1(E)	197	#5	34'-0"	—
a2(E)	560	#6	6'-0"	—
a3(E)	4	#5	35'-0"	—
b(E)	190	#5	34'-6"	—
b1(E)	70	#6	32'-2"	—
b2(E)	216	#5	29'-1"	—
d(E)	358	#5	5'-7"	┘
d1(E)	358	#5	7'-6"	┘
e(E)	84	#4	14'-4"	—
e1(E)	64	#4	7'-0"	—
e2(E)	42	#4	15'-7"	—
e3(E)	8	#8	23'-6"	—
e4(E)	8	#8	7'-0"	—
e5(E)	4	#8	25'-4"	—
e6(E)	8	#4	22'-5"	—
e7(E)	4	#4	24'-4"	—
m(E)	10	#6	35'-4"	—
m1(E)	24	#6	8'-3"	—
m2(E)	10	#6	5'-8"	—
m3(E)	4	#6	2'-6"	—
s(E)	82	#5	5'-5"	┘
s1(E)	72	#4	8'-6"	┘
v(E)	72	#5	3'-4"	┘
Reinforcement Bars, Epoxy Coated		Pound		48630
Concrete Superstructure		Cu. Yds.		210.1

Bars indicated thus 1 x 2-#5 etc. indicates 1 line of bars with 2 lengths per line.


**SUPERSTRUCTURE DETAILS
STRUCTURE NO. 074-0086**

DESIGNED	D.P. Narielwala
CHECKED	S.M. Ryan
DRAWN	h.t. duong
CHECKED	DPN/SMR


November 25, 2009
EXAMINED *Thomas J. Domagala*
PASSED *Ralph E. Anderson*

SHEET NO. 9 25 SHEETS	F.A.S. RTE.	SECTION	COUNTY	TOTAL SHEETS	SHEET NO.
	1517	12VBR-1	PIATT	168	94
			CONTRACT NO. 70388		
FED. ROAD DIST. NO. _ ILLINOIS FED. AID PROJECT					

STATE OF ILLINOIS
DEPARTMENT OF TRANSPORTATION

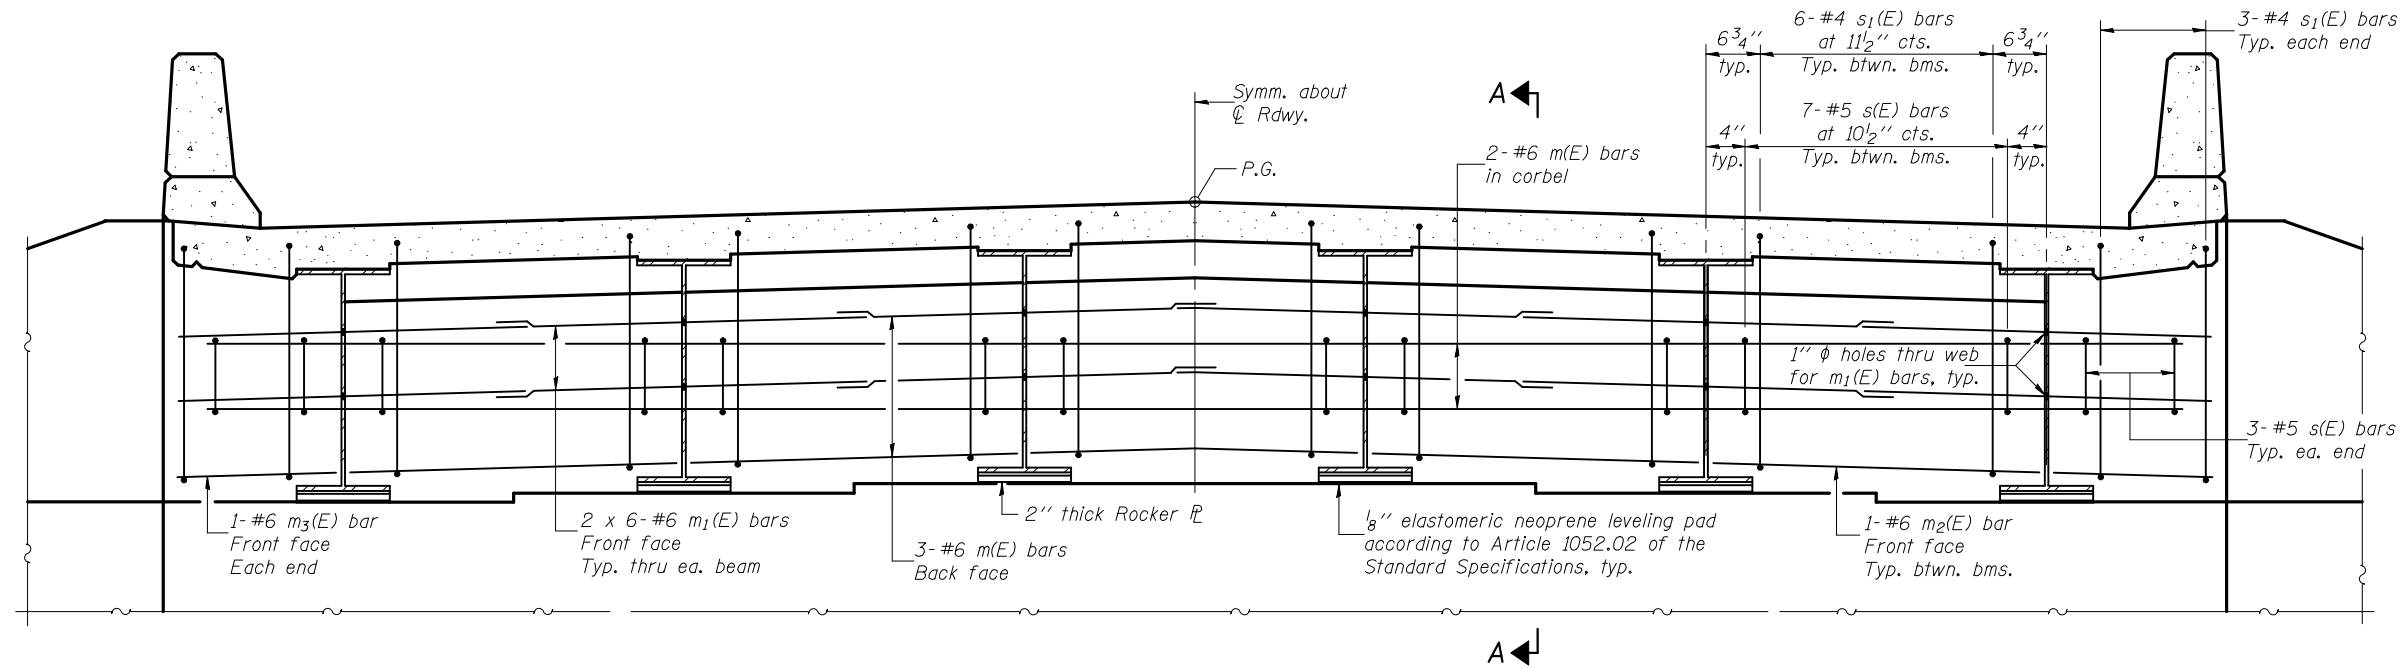

DIAPHRAGM ELEVATION AT ABUTMENT

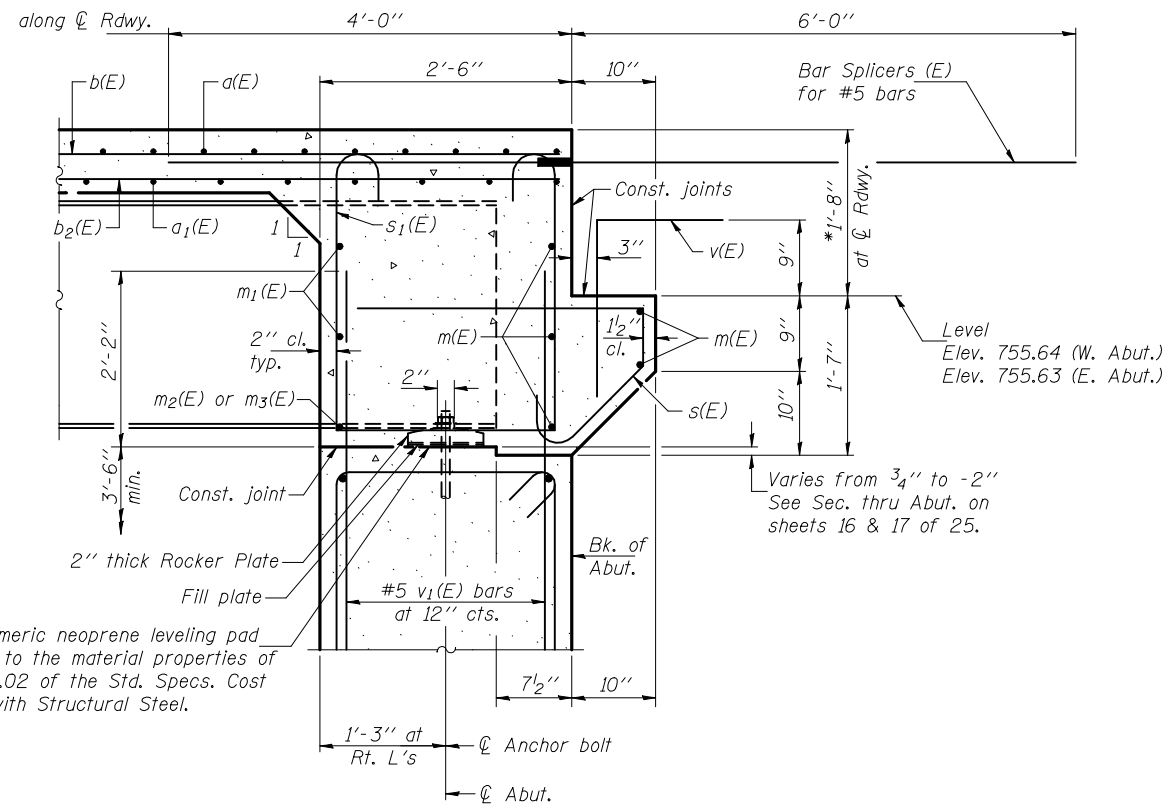

MIN. BAR LAP
#6 bar = 2'-9"

Notes: Reinforcement bars in diaphragm are billed with superstructure on sheet 9 of 25.
Concrete in diaphragm is included with Concrete Superstructure on sheet 9 of 25.
For details of bars s(E) & s1(E) see sheet 9 of 25.
The s(E) and s1(E) bars shall be placed parallel to the beams.
Spacing for these bars shall be at right angles to the beams.

SECTION A-A

Dimensions at right L's to abutment, except as shown.

*Prior to grinding.

DESIGNED	D.P. Narielwala
CHECKED	S.M. Ryan
DRAWN	h.t. duong
CHECKED	DPN/SMR



November 25, 2009
EXAMINED *Thomas J. Domagalicki*
ENGINEER OF BRIDGE DESIGN
PASSED *Ralph E. Anderson*
ENGINEER OF BRIDGES AND STRUCTURES

DIAPHRAGM DETAILS
STRUCTURE NO. 074-0086


SHEET NO. 10 25 SHEETS	F.A.S. RTE.	SECTION	COUNTY	TOTAL SHEETS	SHEET NO.
	1517	12VBR-1	PIATT	168	95
CONTRACT NO. 70388					
FED. ROAD DIST. NO. _ ILLINOIS FED. AID PROJECT					

STATE OF ILLINOIS
DEPARTMENT OF TRANSPORTATION

Notes:
See sheet 12 of 25 for Sections C-C & D-D and View E-E.
a₁₀₀(E), a₁₀₁(E), and w₁₀₀(E) bar spacings measured perpendicular to \varnothing Rdwy.

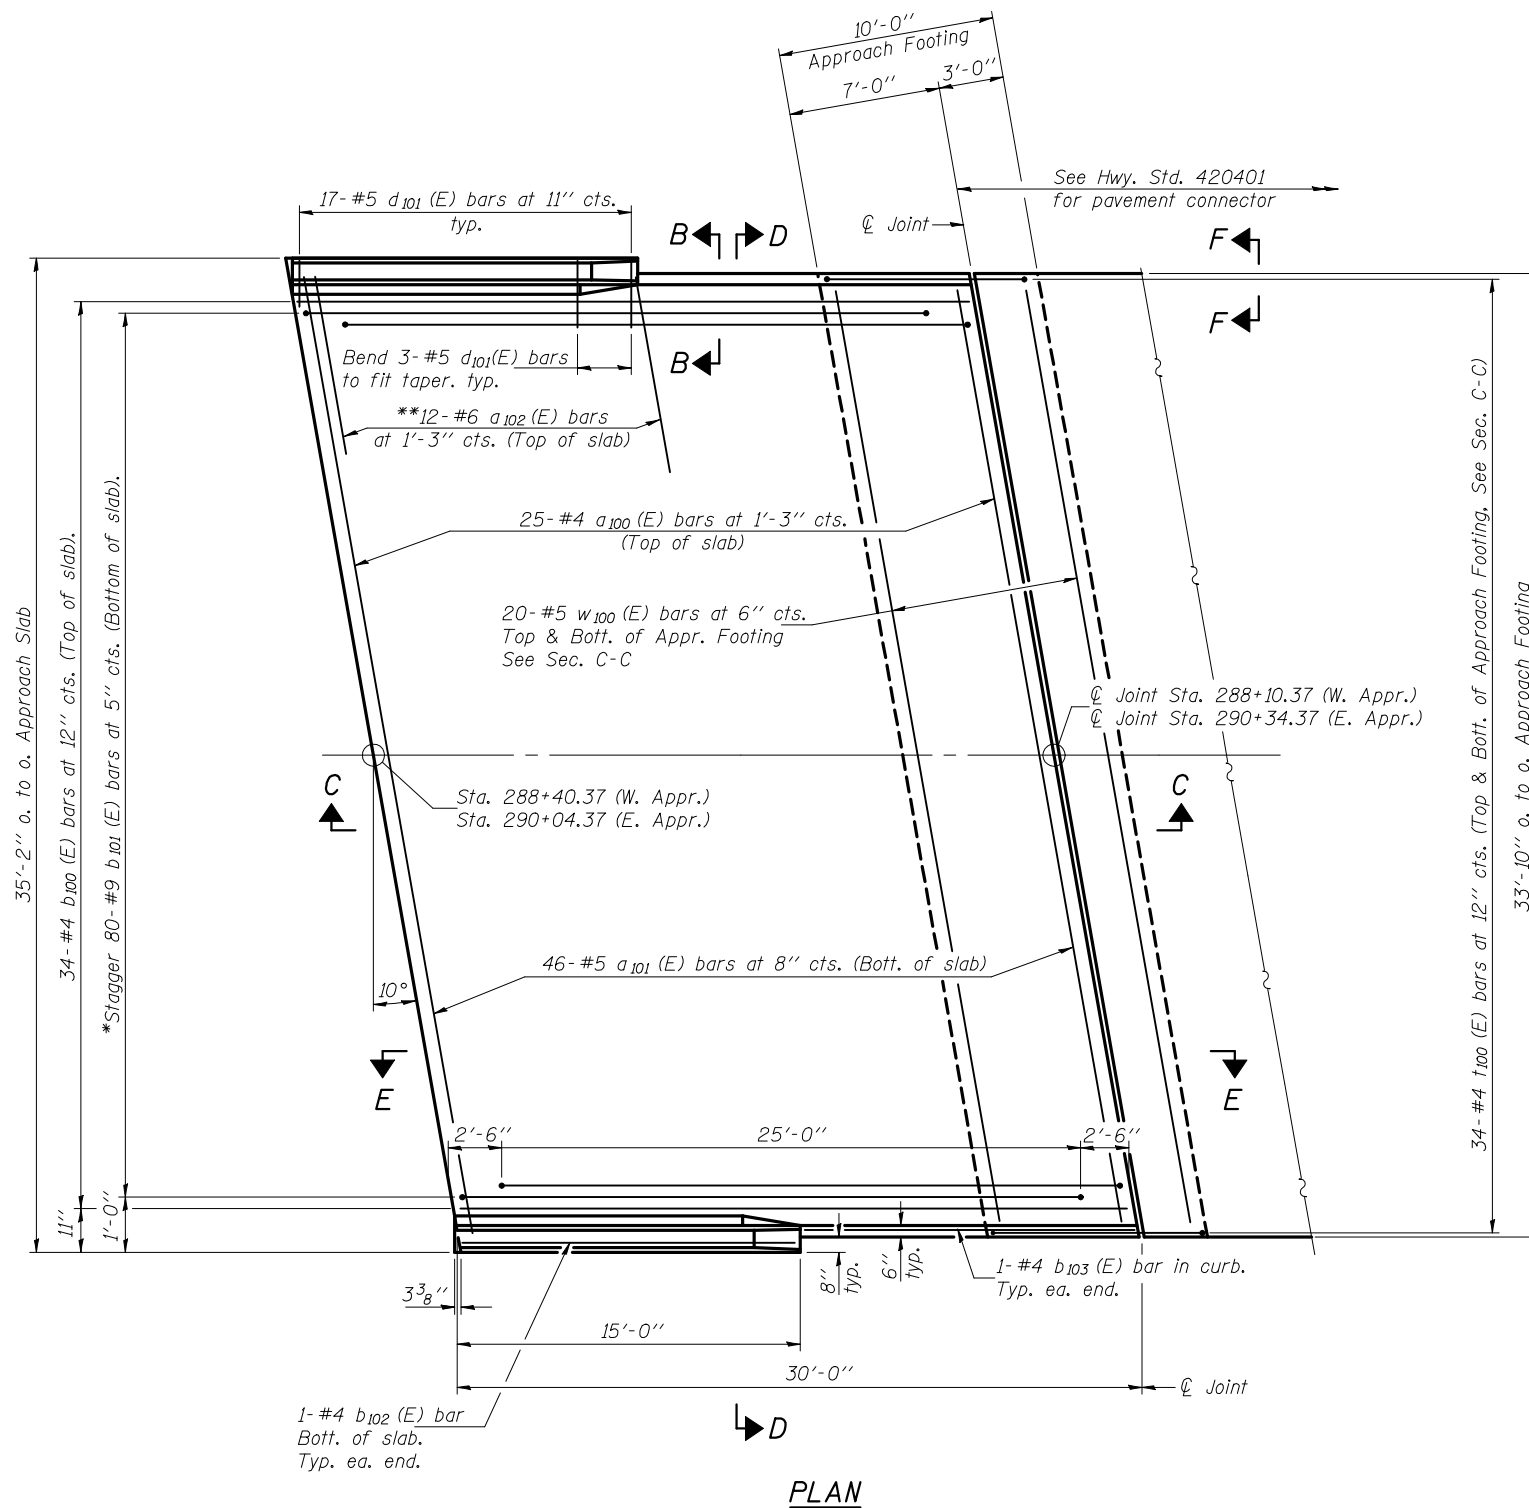
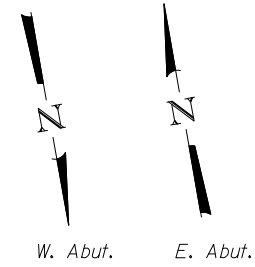


*Tilt #9 b₁₀₁(E) bars as required to maintain clearance.
**Alternate with a₁₀₀(E) bars, typ. each parapet.

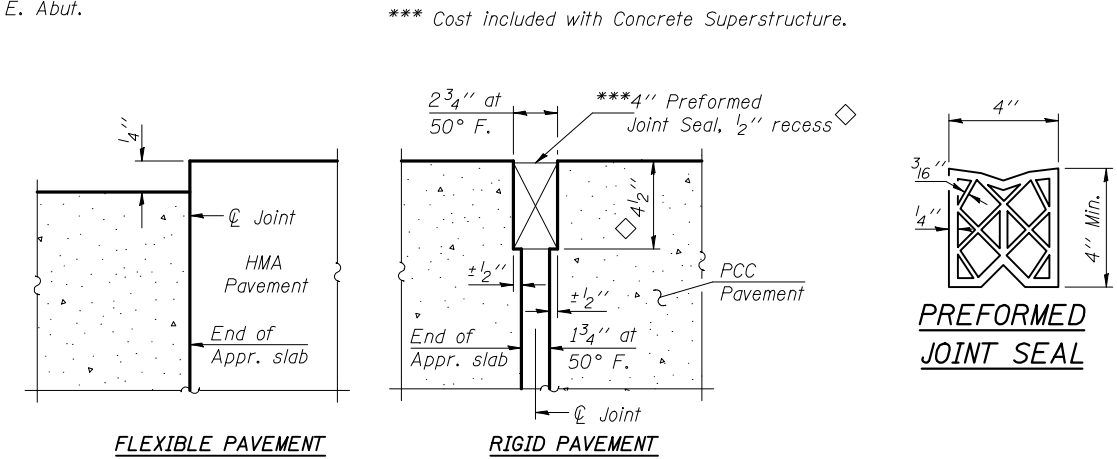

DETAIL A

◇ Prior to grinding

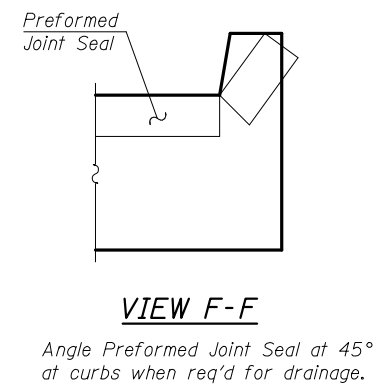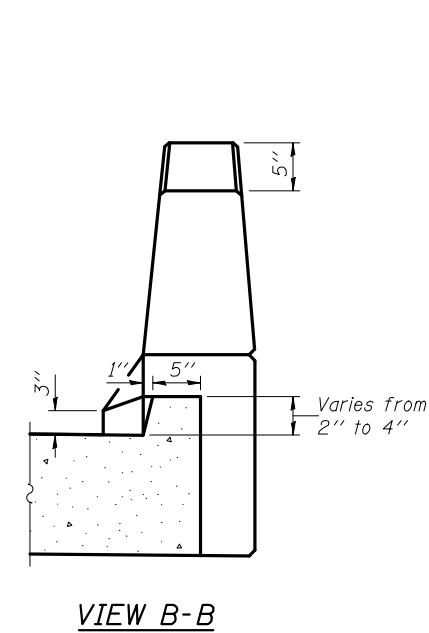

DESIGNED	D.P. Narielwala
CHECKED	S.M. Ryan
DRAWN	h.t. duong
CHECKED	DPN/SMR

November 25, 2009

EXAMINED *Thomas J. Domagala*
ENGINEER OF BRIDGE DESIGN

PASSED *Ralph E. Anderson*
ENGINEER OF BRIDGES AND STRUCTURES


BRIDGE APPROACH SLAB DETAILS
STRUCTURE NO. 074-0086

SHEET NO. 11 25 SHEETS	F.A.S. RTE.	SECTION	COUNTY	TOTAL SHEETS	SHEET NO.
	1517	12VBR-1	PIATT	168	96
			CONTRACT NO. 70388		
FED. ROAD DIST. NO. _ ILLINOIS FED. AID PROJECT					


STATE OF ILLINOIS
DEPARTMENT OF TRANSPORTATION

Notes:

See sheet 11 of 25 for Detail A and View B-B.
Approach slab and parapet concrete shall be paid for as Concrete Superstructure.
Approach footing concrete shall be paid for as Concrete Structures.
Reinforcement shall be paid for as Reinforcement Bars, Epoxy Coated.
For v(E) bar details, see sheet 9 of 25.
The approach footing maximum applied service bearing pressure (Qmax) = 2.0 ksf.
For bar splicer details, see sheet 21 of 25.
Cost of excavation for approach footing included with Concrete Structures.
For Porous Granular Embankment (Special) and drainage treatment details, see sheet 2 of 25.

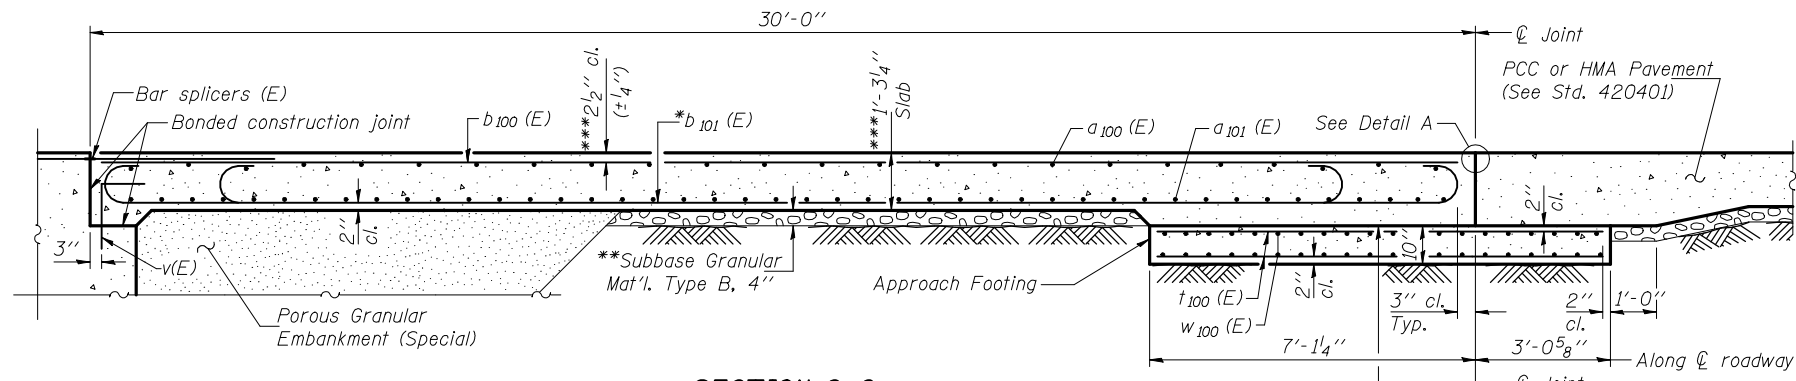

SECTION C-C

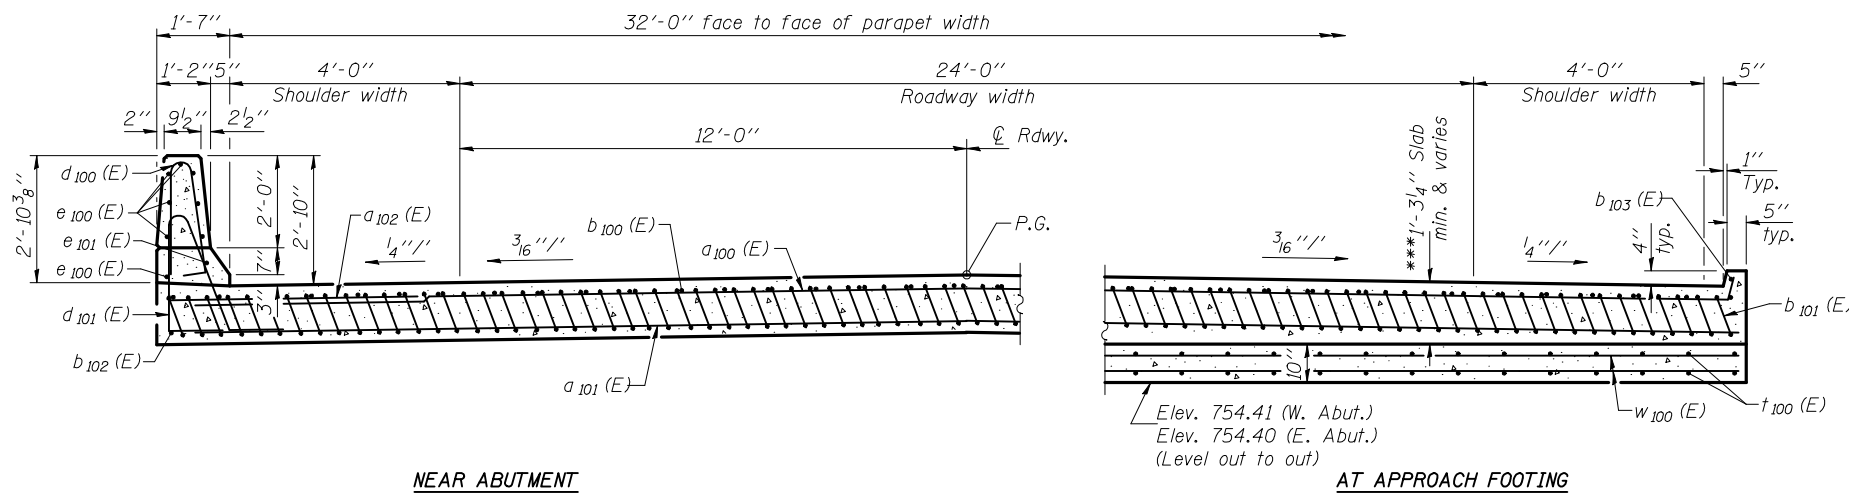


NEAR ABUTMENT

SECTION D-D


(See Plan for dimensions not shown)

AT APPROACH FOOTING

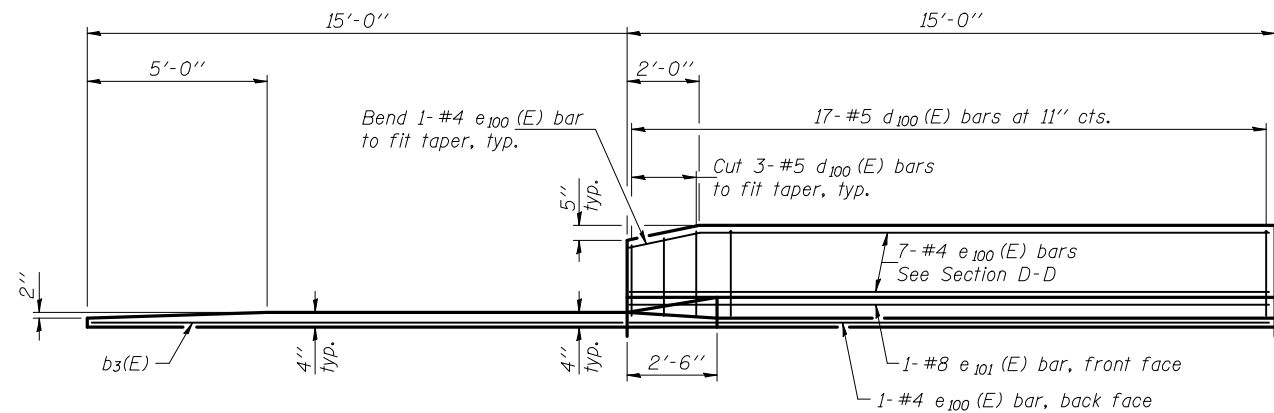


VIEW E-E

*Tilt #9 b101 (E) bars as required to maintain clearance.
**Cost included with Concrete Superstructure.
***Prior to grinding.

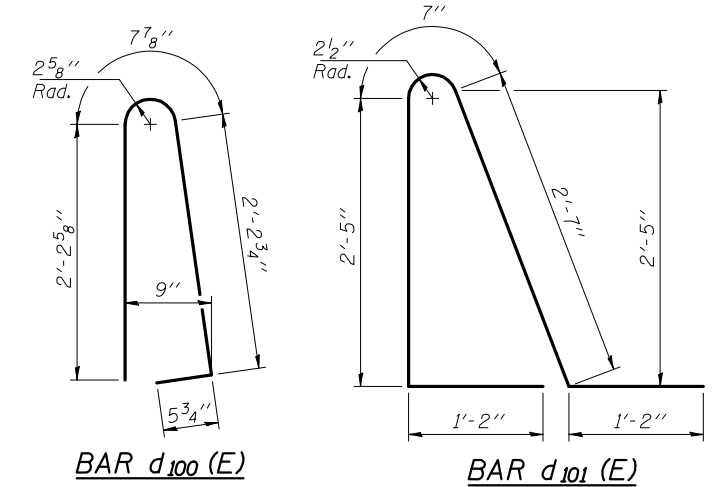


TWO APPROACHES
BILL OF MATERIAL

Bar	No.	Size	Length	Shape
a100 (E)	50	#4	34'-9"	—
a101 (E)	92	#5	34'-0"	—
a102 (E)	48	#6	6'-0"	—
b100 (E)	68	#4	29'-8"	—
b101 (E)	160	#9	29'-9"	—
b102 (E)	4	#4	14'-8"	—
b103 (E)	4	#4	14'-9"	—
d100 (E)	68	#5	5'-7"	—
d101 (E)	68	#5	7'-11"	—
e100 (E)	32	#4	14'-8"	—
e101 (E)	4	#8	14'-8"	—
t100 (E)	136	#4	9'-10"	—
w100 (E)	80	#5	34'-0"	—
Concrete Superstructure		Cu. Yd.	109.3	
Concrete Structures		Cu. Yd.	21.2	
Reinforcement Bars, Epoxy Coated		Pound	27620	

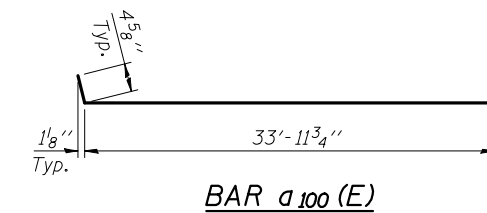

BAR a100 (E)

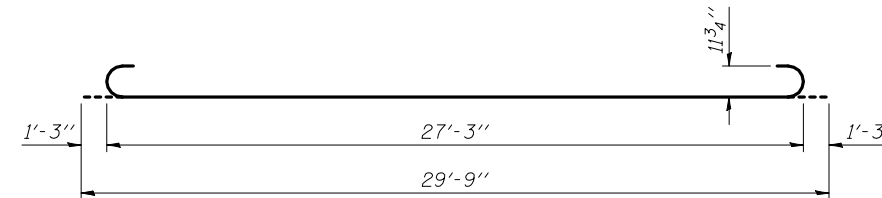

BAR b101 (E)


DESIGNED	D.P. Narielwala
CHECKED	S.M. Ryan
DRAWN	h.t. duong
CHECKED	DPN/SMR

DATE	November 25, 2009
EXAMINED	Thomas J. Domagala ENGINEER OF BRIDGE DESIGN
PASSED	Ralph E. Anderson ENGINEER OF BRIDGES AND STRUCTURES

BRIDGE APPROACH SLAB DETAILS
STRUCTURE NO. 074-0086


SHEET NO. 12 25 SHEETS	F.A.S. RTE.	SECTION	COUNTY	TOTAL SHEETS	SHEET NO.
	1517	12VBR-1	PIATT	168	97
CONTRACT NO. 70388					
FED. ROAD DIST. NO. _ ILLINOIS FED. AID PROJECT					

STATE OF ILLINOIS
DEPARTMENT OF TRANSPORTATION

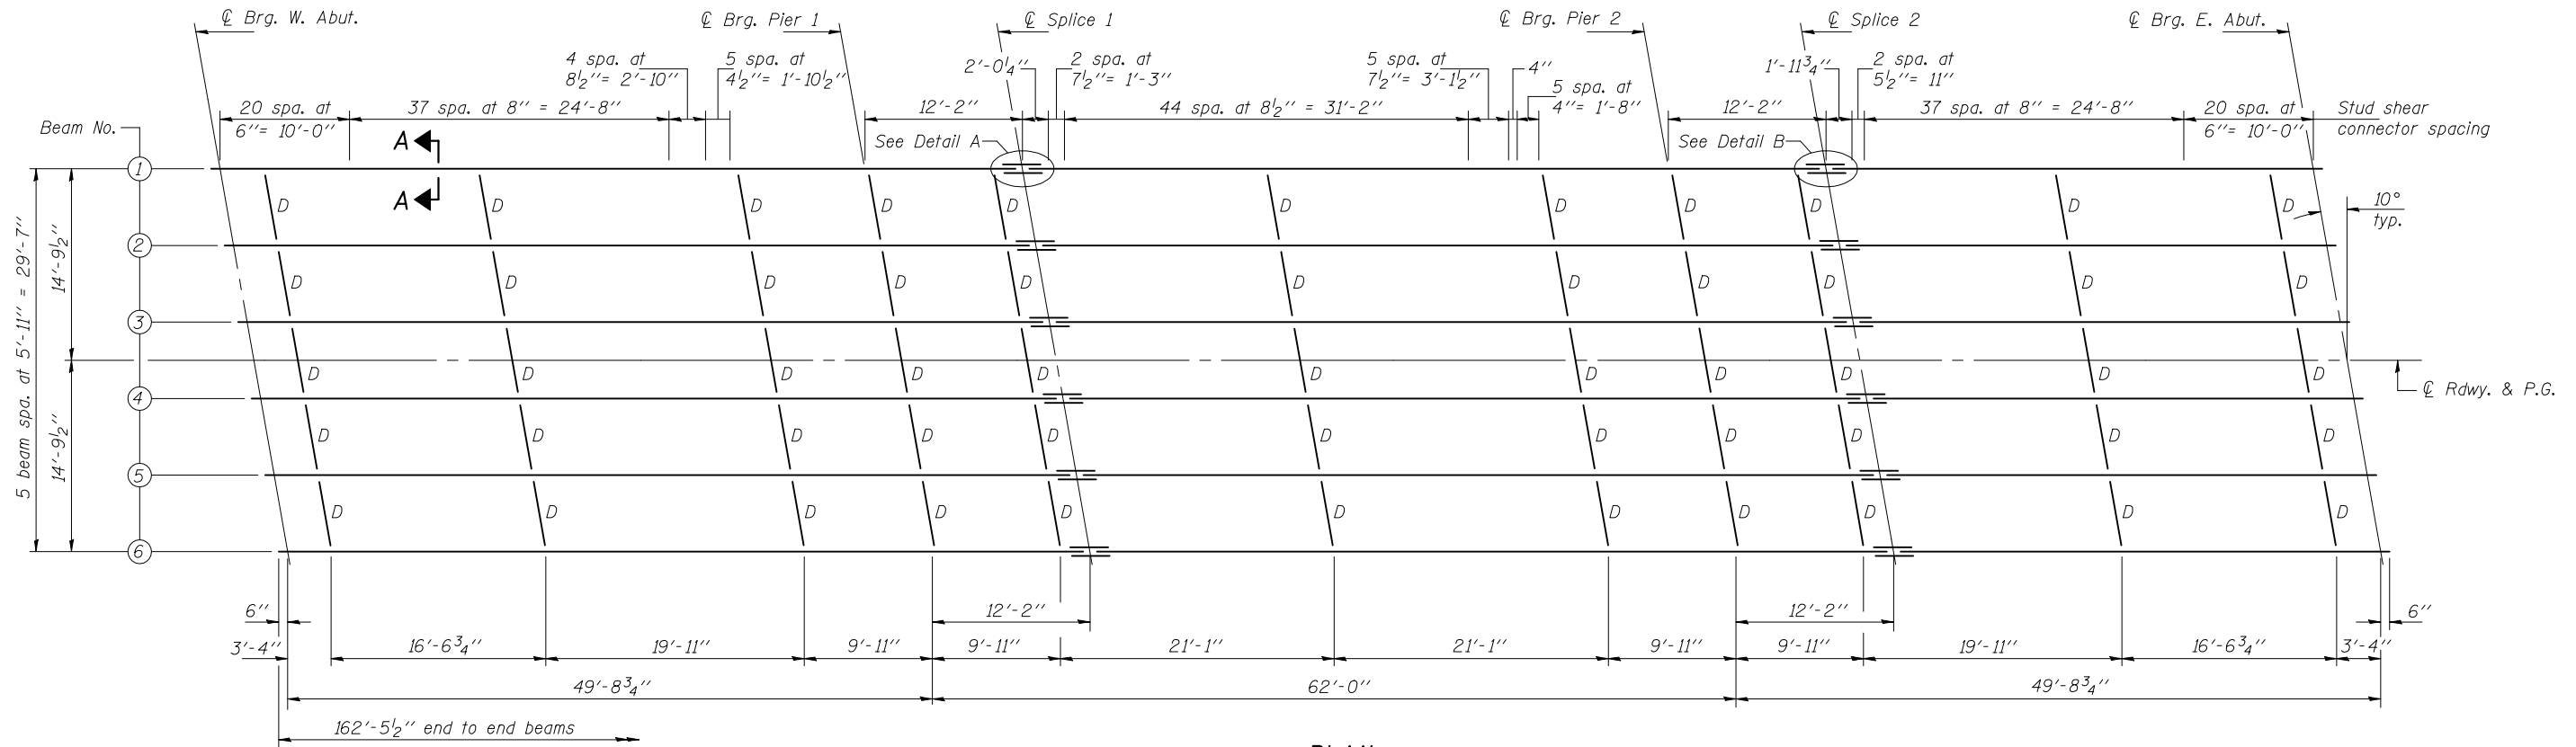


PLAN

(All beams are W27x94 AASHTO Grade 50W and NTR.)

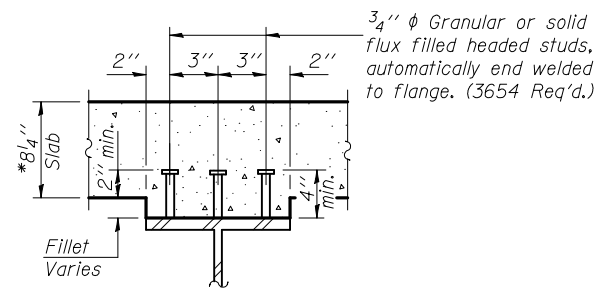


SECTION A-A

*Prior to grinding

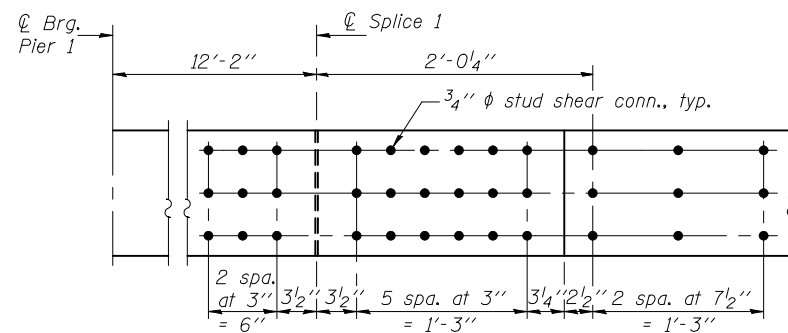


DETAIL A

(Splice bolts are not shown for clarity.)

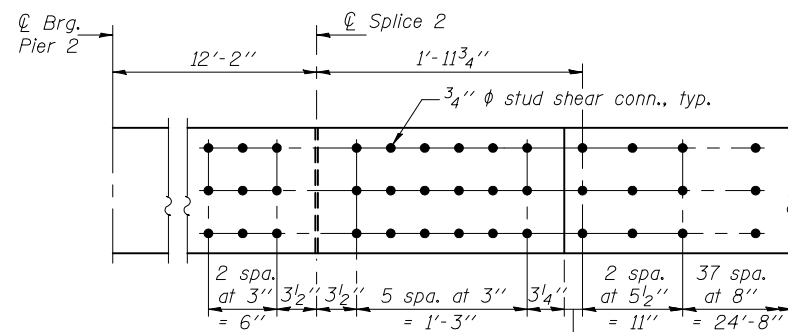

DETAIL B

(Splice bolts are not shown for clarity.)

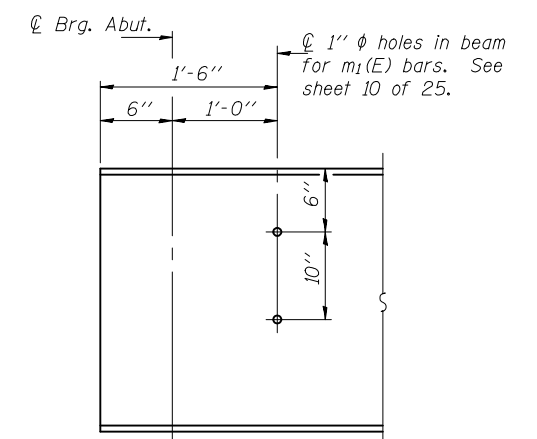

END OF BEAM ELEVATION

DESIGNED	D.P. Narielwala
CHECKED	S.M. Ryan
DRAWN	h.t. duong
CHECKED	DPN/SMR

November 25, 2009
 EXAMINED *Thomas J. Domagala*
 ENGINEER OF BRIDGE DESIGN
 PASSED *Ralph E. Anderson*
 ENGINEER OF BRIDGES AND STRUCTURES

**STRUCTURAL STEEL
STRUCTURE NO. 074-0086**

SHEET NO. 13 25 SHEETS	F.A.S. RTE.	SECTION	COUNTY	TOTAL SHEETS	SHEET NO.
	1517	12VBR-1	PIATT	168	98
FED. ROAD DIST. NO. _			ILLINOIS	FED. AID PROJECT	
CONTRACT NO. 70388					

STATE OF ILLINOIS
DEPARTMENT OF TRANSPORTATION

		0.4 Sp. 1 0.6 Sp. 3	Pier 1 or Pier 2	0.5 Sp. 2
I_s	(in ⁴)	3270	3270	3270
$I_c(n)$	(in ⁴)	9809	—	9809
$I_c(3n)$	(in ⁴)	7235	—	7235
S_s	(in ³)	243	243	243
$S_c(n)$	(in ³)	378	—	378
$S_c(3n)$	(in ³)	341	—	341
DC1	(k/ft)	0.72	0.72	0.72
M _{DC1}	(k)	123.0	228.8	118.6
DC2	(k/ft)	0.15	0.15	0.15
M _{DC2}	(k)	30.2	35.7	36.3
DW	(k/ft)	0.30	0.30	0.30
M _{DW}	(k)	59.7	70.5	71.7
M _{± + imp}	(k)	458.2	254.4	499.0
M _u (Strength I)	(k)	1083	882	1174
$\phi_f M_n$, $\phi_f M_{nc}$	(k)	2159	1158	2159
f_s DC1	(ksi)	6.1	11.3	5.9
f_s DC2	(ksi)	1.1	1.8	1.3
f_s DW	(ksi)	2.1	3.5	2.5
f_s 1.3(I+I)	(ksi)	18.9	16.3	20.6
f_s (Service II)	(ksi)	28.2	32.9	30.3
V _r	(k)	24.5	—	20.6


		Abutments	Piers
R _{DC1}	(k)	13.4	45.0
R _{DC2}	(k)	3.0	9.1
R _{DW}	(k)	5.9	17.9
R _{± + imp}	(k)	62.8	86.6
R _{Total}	(k)	85.1	158.6

I_s , S_s : Non-composite moment of inertia and section modulus of the steel section used for computing f_s (Total-Strength I, and Service II) due to non-composite dead loads (in.⁴ and in.³).

$I_c(n)$, $S_c(n)$: Composite moment of inertia and section modulus of the steel and deck based upon the modular ratio, "n", used for computing f_s (Total-Strength I, and Service II) due to short-term composite live loads (in.⁴ and in.³).

$I_c(3n)$, $S_c(3n)$: Composite moment of inertia and section modulus of the steel and deck based upon 3 times the modular ratio, "3n", used for computing f_s (Total-Strength I, and Service II) due to long-term composite (superimposed) dead loads (in.⁴ and in.³).



DC1: Un-factored non-composite dead load (kips/ft.).
M_{DC1}: Un-factored moment due to non-composite dead load (kip-ft.).
DC2: Un-factored long-term composite (superimposed excluding future wearing surface) dead load (kips/ft.).
M_{DC2}: Un-factored moment due to long-term composite (superimposed excluding future wearing surface) dead load (kip-ft.).
DW: Un-factored long-term composite (superimposed future wearing surface only) dead load (kips/ft.).
M_{DW}: Un-factored moment due to long-term composite (superimposed future wearing surface only) dead load (kip-ft.).
M_{± + imp}: Un-factored live load moment plus dynamic load allowance (impact) (kip-ft.).
M_u (Strength I): Factored design moment (kip-ft.).
1.25 (M_{DC1} + M_{DC2}) + 1.5 M_{DW} + 1.75 M_{± + imp}
 $\phi_f M_n$: Compact composite positive moment capacity computed according to Article 6.10.7.1 (kip-ft.).
 $\phi_f M_{nc}$: Compact non-composite negative moment capacity computed according to Article A6.1.1 (kip-ft.).
 f_s (Service II): Sum of stresses as computed from the moments below (ksi).
M_{DC1} + M_{DC2} + M_{DW} + 1.3 M_{± + imp}
V_r: Factored shear range in span computed according to Art. 6.10.10.

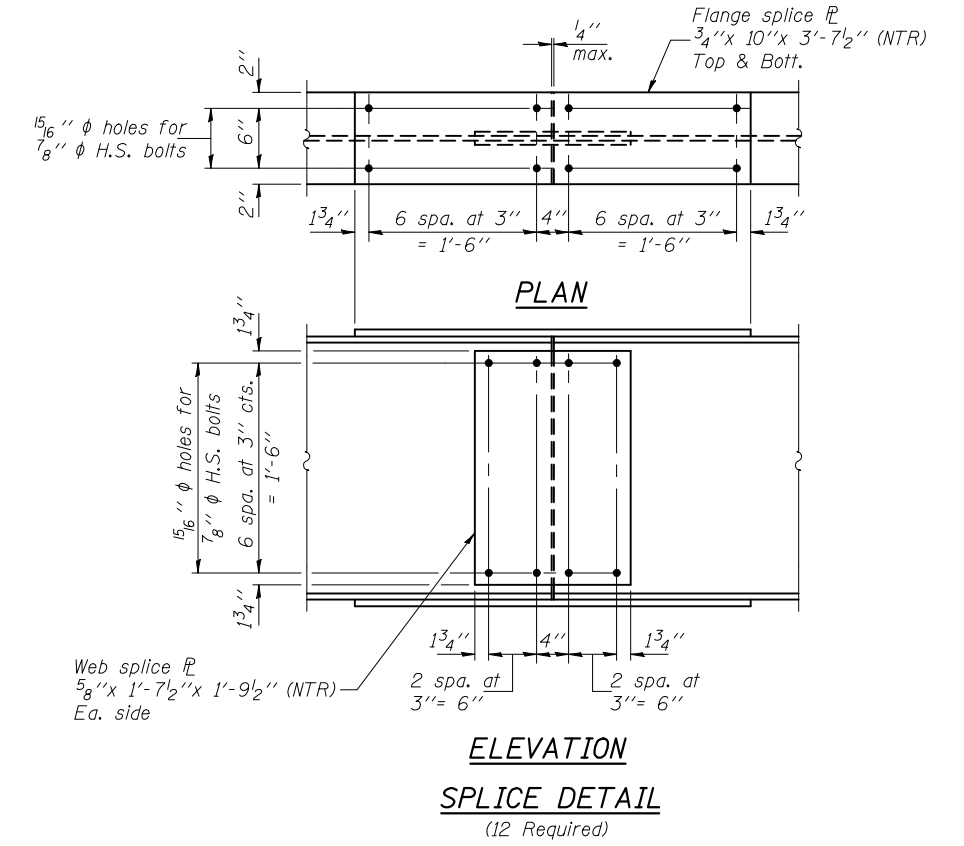

***TOP OF BEAM ELEVATIONS**

Location	℄ Brg. W. Abut.	℄ Brg. Pier 1	℄ Splice 1	℄ Brg. Pier 2	℄ Splice 2	℄ Brg. E. Abut.
Beam 1	756.31	756.62	756.70	756.64	756.62	756.36
Beam 2	756.43	756.74	756.81	756.74	756.73	756.46
Beam 3	756.54	756.83	756.91	756.83	756.82	756.54
Beam 4	756.56	756.84	756.91	756.83	756.81	756.53
Beam 5	756.47	756.75	756.82	756.73	756.71	756.42
Beam 6	756.37	756.65	756.71	756.62	756.60	756.30

*For fabrication use only.

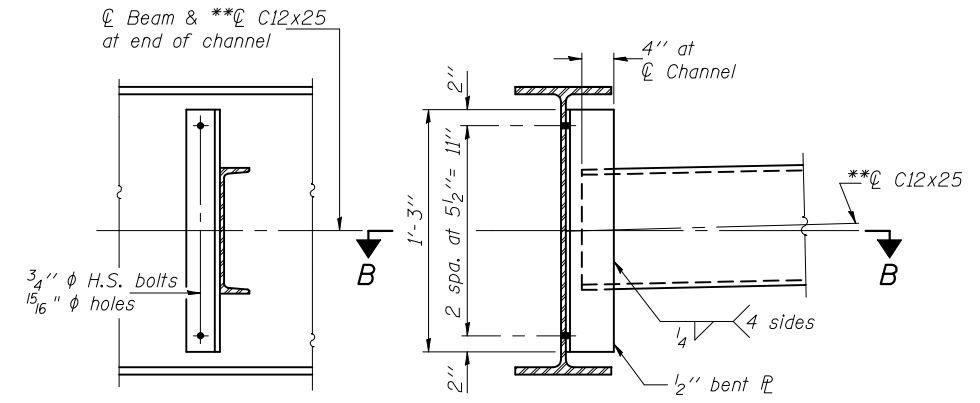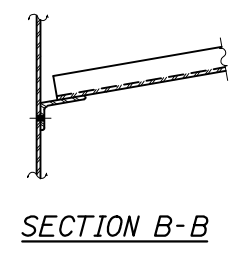

DIAPHRAGM D
(55 Required)

**Alternate channel C12x30 may be used to facilitate material acquisition. Calculated weight of structural steel is based on the lighter section, C12x25. The alternate channel C12x30, if utilized, shall be provided at no extra cost to the Department.

Notes: Load carrying components designated "NTR" shall conform to the Supplemental Requirements for Notch Toughness, Zone 2.
All diaphragms shall be installed as steel is erected and secured with erection pins and bolts except as otherwise noted. Individual diaphragms at supports may be temporarily disconnected to install bearing anchor rods.
All splice plate material shall be AASHTO M 270 Grade 50W.


DESIGNED	D.P. Narielwala
CHECKED	S.M. Ryan
DRAWN	h.f. duong
CHECKED	DPN/SMR

November 25, 2009
EXAMINED *Thomas J. Domagala*
PASSED *Ralph E. Anderson*
ENGINEER OF BRIDGE DESIGN
ENGINEER OF BRIDGES AND STRUCTURES


STRUCTURAL STEEL DETAILS
STRUCTURE NO. 074-0086

SHEET NO. 14 25 SHEETS	F.A.S. RTE.	SECTION	COUNTY	TOTAL SHEETS	SHEET NO.
	1517	12VBR-1	PIATT	168	99
CONTRACT NO. 70388			FED. ROAD DIST. NO. _ ILLINOIS FED. AID PROJECT		


STATE OF ILLINOIS
DEPARTMENT OF TRANSPORTATION

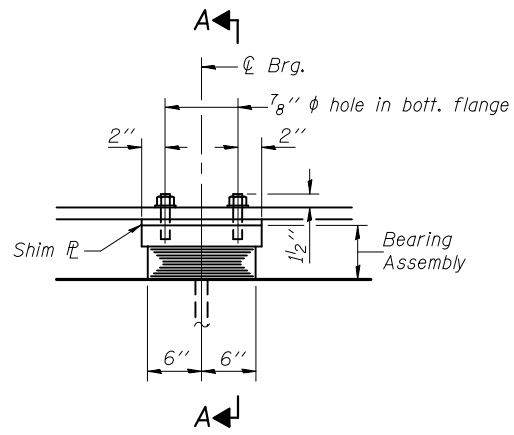


ELEVATION AT PIERS 1 & 2

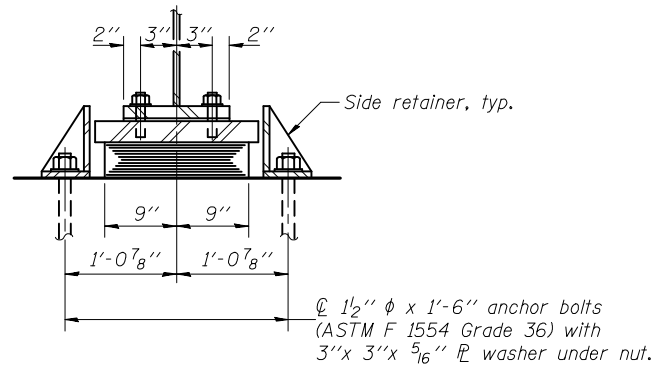

SECTION A-A

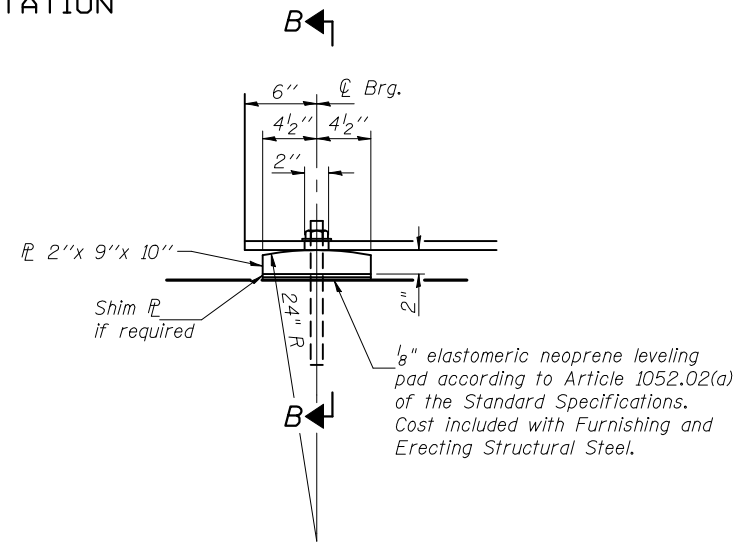


ELEVATION AT ABUTMENTS

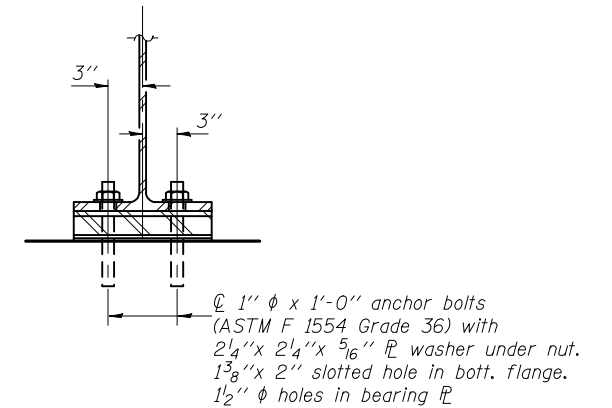


SECTION B-B

TYPE I ELASTOMERIC EXP. BRG.
(12 Required)

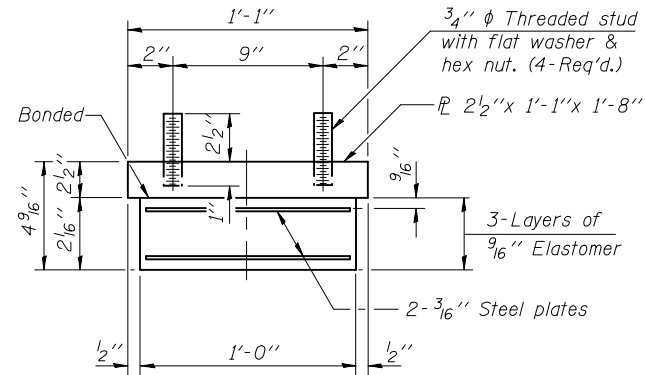

BEARING ASSEMBLY

Note: Shim plates shall not be placed under Bearing Assembly.

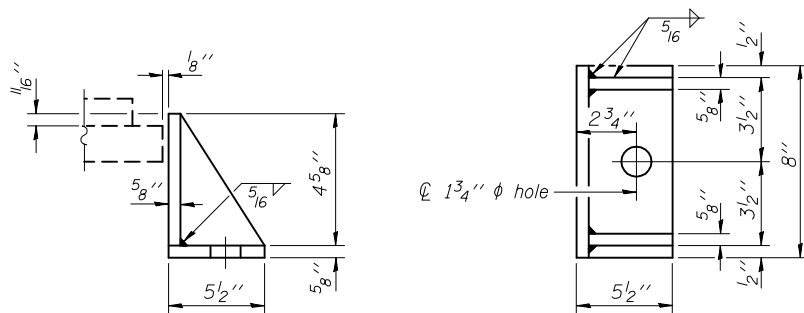

SIDE RETAINER

Equivalent rolled angle with stiffeners will be allowed in lieu of welded plates.

FIXED BEARING
(12 Required)

Notes:

Anchor bolts shall be ASTM F1554 all-thread (or an Engineer-approved alternate material) of the grade(s) and diameter(s) specified. ASTM A307 Grade C anchor bolts may be used in lieu of ASTM F1554 Grade 36 (Fy=36ksi). The corresponding specified grade of AASHTO M314 anchor bolts may be used in lieu of ASTM F1554.

Anchor bolts at fixed bearings may be either cast in place or installed in holes drilled after the supported member is in place.

Anchor bolts for side retainers may be cast in place or installed in holes drilled before or after members are in place.

Drilled and set anchor bolts shall be installed according to Article 521.06 of the Standard Specifications.

Side retainers and other steel members required for the bearing assembly shall be included in the cost of Elastomeric Bearing Assembly, Type I.

All bearing plates shall be AASHTO M 270 Grade 50W.

Two 1/8 in. adjusting shims shall be provided for each bearing in addition to all other plates or shims and placed as shown on bearing details.

BILL OF MATERIAL

Item	Unit	Total
Elastomeric Bearing Assembly Type I	Each	12
Anchor Bolts 1 1/2"	Each	24
Anchor Bolts 1"	Each	24

BEARING DETAILS
STRUCTURE NO. 074-0086

DESIGNED	D.P. Narielwala
CHECKED	S.M. Ryan
DRAWN	h.t. duong
CHECKED	DPN/SMR

EXAMINED	November 25, 2009
PASSED	Thomas J. Domagala ENGINEER OF BRIDGE DESIGN
	Ralph E. Anderson ENGINEER OF BRIDGES AND STRUCTURES

SHEET NO. 15	F.A.S. RTE.	SECTION	COUNTY	TOTAL SHEETS	SHEET NO.
	1517	12VBR-1	PIATT	168	100
25 SHEETS	CONTRACT NO. 70388				
FED. ROAD DIST. NO. _ ILLINOIS FED. AID PROJECT					