

FINAL

FOR INDEX OF SHEETS AND HIGHWAY STANDARDS, SEE SHEET NO. G-3

STATE OF ILLINOIS 01-16-2026 LETTING ITEM 021

F.A.I. RTE.	SECTION	COUNTY	TOTAL SHEETS	SHEET NO.
290	2019-189-BR	COOK	250	1
ILLINOIS CONTRACT NO. 62K62				
* 250 + 2 = 252 TOTAL SHEETS				

CENTRAL PARK AVENUE
FUNCTIONAL CLASSIFICATION
MAJOR COLLECTOR
2022 ADT = 8,450
TRUCKS = 5.0%
DESIGN SPEED = 30 MPH
POSTED SPEED = 30 MPH

INTERSTATE 290 (EISENHOWER)
FUNCTIONAL CLASSIFICATION
INTERSTATE
2022 ADT = 199,700
TRUCKS = 4.0%
DESIGN SPEED = 55 MPH
POSTED SPEED = 55 MPH

DEPARTMENT OF TRANSPORTATION

PROPOSED
HIGHWAY PLANS

FAI 290 (INTERSTATE 290)
AT CENTRAL PARK AVENUE
SECTION: 2019-189-BR
PROJECT NHPP-G73E(408)
BRIDGE REPLACEMENT
COOK COUNTY

DBS DB STERLIN CONSULTANTS, INC.
123 N. Wacker Drive, Suite 2000
Chicago, Illinois 60606
312.857.1006

Jacobs

PARSONS

SINGH
SINGH + ASSOCIATES, INC.
CONSULTING ENGINEERS

C-91-169-20

R 13 E

END IMPROVEMENTS
STA. 606+27.00

BRIDGE REPLACEMENT
CENTRAL PARK AVE OVER I-290
STA. 602+68.93 TO STA. 605+14.18
PROP. S.N. 016-2091
EXIST. S.N. 016-2072


BEGIN IMPROVEMENTS
STA. 601+47.38



LOCATION MAP
(NOT TO SCALE)

GROSS LENGTH = 479.62 FT. = 0.0908 MILE
NET LENGTH = 479.62 FT. = 0.0908 MILE

PROJECT LOCATED IN
THE CITY OF CHICAGO

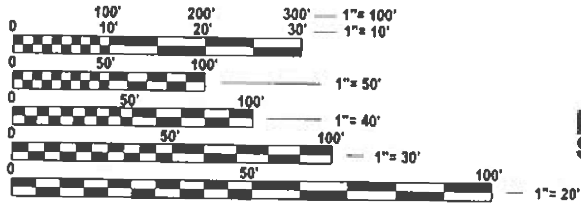

FULL SIZE PLANS HAVE BEEN PREPARED USING STANDARD
ENGINEERING SCALES. REDUCED SIZED PLANS WILL NOT
CONFORM TO STANDARD SCALES. IN MAKING MEASUREMENTS
ON REDUCED PLANS, THE ABOVE SCALES MAY BE USED.

J.U.L.I.E.
JOINT UTILITY LOCATION INFORMATION FOR EXCAVATION
1-800-892-0123
OR 811



MEADE ELECTRIC CO. DISTRICT ONE MAINTENANCE
CONTRACTOR LOCATES IDOT ELECTRICAL EQUIPMENT AND
UNDERGROUND CABLES (773) 287-7672

D.I.G.G.E.R.
312-744-7000

PROJECT MANAGER: PRAVEEN KAINI, PE (847) 705-4237
CONTRACT NO. 62K62



LOCATION OF SECTION INDICATED THUS: -

STATE OF ILLINOIS
DEPARTMENT OF TRANSPORTATION

SUBMITTED September 22, 2025

December 5, 2025
REGIONAL ENGINEER

December 5, 2025
ENGINEER OF DESIGN AND ENVIRONMENT

December 5, 2025
DIRECTOR OF HIGHWAYS PROJECT IMPLEMENTATION

REVISED SHEET 1/2/2026

PRINTED BY THE AUTHORITY
OF THE STATE OF ILLINOIS
FINAL SUBMITTAL REV-SEP

FILE NAME: \\cam-dbsstepw21\CS_pnf_work_dfr\103915420_61062K62-0003-Hdrev.dgn

INDEX OF SHEETS

1	G-1	COVER SHEET
2	G-2	PROFESSIONAL SEALS
3	G-3	INDEX OF DRAWINGS
4	G-4	STANDARDS
5-6	G-5 - G-6	GENERAL NOTES
7-24	G-7 - G-24	SUMMARY OF QUANTITIES
25-30	C-1 - C-6	TYPICAL SECTIONS
31	C-7	ALIGNMENTS, TIES, AND BENCHMARKS
32-34	C-8 - C-10	REMOVAL PLAN
35-36	C-11 - C-12	PLAN AND PROFILE - CENTRAL PARK AVENUE
37	C-13	PLAN AND PROFILE - W CONGRESS PARKWAY
38	C-14	PLAN AND PROFILE - W HARRISON STREET
39	C-15	PROPOSED PLAN - I-290
40	C-16	MAINTENANCE OF TRAFFIC - GENERAL NOTES
41	C-17	SUGGESTED CONSTRUCTION SEQUENCE AND STAGING NARRATIVE
42	C-18	SUGGESTED DETOUR PLAN - CENTRAL PARK AVENUE
43	C-19	SUGGESTED DETOUR PLAN - CENTRAL PARK AVENUE & HARRISON ST ON RAMP EB I-290
44	C-20	SUGGESTED BIKE DETOUR PLAN - CENTRAL PARK AVENUE
45	C-21	SUGGESTED PEDESTRIAN DETOUR PLAN - CENTRAL PARK AVENUE
46-47	C-22 - C-23	MAINTENANCE OF TRAFFIC - TYPICAL SECTIONS I-290 & CENTRAL PARK AVENUE
48	C-24	MAINTENANCE OF TRAFFIC - STAGE 1 - EASTBOUND I-290 AT CENTRAL PARK AVENUE
49	C-25	MAINTENANCE OF TRAFFIC - STAGE 1 - WESTBOUND I-290 AT CENTRAL PARK AVENUE
50-51	C-26 - C-27	MAINTENANCE OF TRAFFIC - STAGE 2 - EASTBOUND I-290 AT CENTRAL PARK AVENUE
52	C-28	MAINTENANCE OF TRAFFIC - STAGE 2 - WESTBOUND I-290 AT CENTRAL PARK AVENUE
53	C-29	MAINTENANCE OF TRAFFIC - STAGE 3 - EASTBOUND I-290 AT CENTRAL PARK AVENUE
54	C-30	MAINTENANCE OF TRAFFIC - STAGE 3 - WESTBOUND I-290 AT CENTRAL PARK AVENUE
55	C-31	MAINTENANCE OF TRAFFIC - STAGE 4 - W CONGRESS PARKWAY
56	C-32	MAINTENANCE OF TRAFFIC - STAGE 4 - W HARRISON STREET
57	C-33	MAINTENANCE OF TRAFFIC - STAGE 5 - W CONGRESS PARKWAY
58	C-34	MAINTENANCE OF TRAFFIC - STAGE 5 - W HARRISON STREET
59	C-35	MAINTENANCE OF TRAFFIC - STAGE 6 - W CONGRESS PARKWAY
60	C-36	MAINTENANCE OF TRAFFIC - STAGE 6 - W HARRISON STREET
61-73	C-37 - C49	IDOT DISTRICT 1 TC STANDARD DETAILS
74	C-50	EARTHWORK AND EROSION AND SEDIMENT CONTROL SCHEDULES
75	C-51	EROSION AND SEDIMENT CONTROL PLAN - CENTRAL PARK AVENUE @ W HARRISON STREET
76	C-52	EROSION AND SEDIMENT CONTROL PLAN - CENTRAL PARK AVENUE @ W CONGRESS PARKWAY
77	C-53	EROSION AND SEDIMENT CONTROL PLAN - I-290
78	C-54	DRAINAGE SCHEDULES
79	C-55	DRAINAGE AND UTILITY PLAN AND PROFILE - CENTRAL PARK AVENUE @ W HARRISON STREET
80	C-56	DRAINAGE AND UTILITY PLAN AND PROFILE - CENTRAL PARK AVENUE @ W CONGRESS PARKWAY
81	C-57	DRAINAGE AND UTILITY PLAN - I-290
81a	C-57a	WATER MAIN PLAN AND PROFILE - CENTRAL PARK AVENUE @ W HARRISON STREET
81b	C-57b	WATER MAIN PLAN AND PROFILE - CENTRAL PARK AVENUE @ W CONGRESS PARKWAY
82	C-58	EXISTING UTILITIES - CENTRAL PARK AVENUE
83	C-59	ADA RAMP DETAILS - NW & SW CORNERS OF S CENTRAL PARK AVENUE AND W HARRISON ST
84	C-60	ADA RAMP DETAILS - NE & SE CORNERS OF S CENTRAL PARK AVENUE AND W HARRISON ST
85	C-61	ADA RAMP DETAILS - NW & SW CORNERS OF S CENTRAL PARK AVENUE AND W CONGRESS PARKWAY
86	C-62	ADA RAMP DETAILS - NE & SE CORNERS OF S CENTRAL PARK AVENUE AND W CONGRESS PARKWAY
87	C-63	PAVEMENT MARKING PLAN - CENTRAL PARK AVENUE @ W HARRISON STREET
88	C-64	PAVEMENT MARKING PLAN - CENTRAL PARK AVENUE @ W CONGRESS PARKWAY
89	C-65	PAVEMENT MARKING PLAN - I-290
90	C-66	SIGNING PLAN - CENTRAL PARK AVENUE @ W HARRISON STREET
91	C-67	SIGNING PLAN - CENTRAL PARK AVENUE @ W CONGRESS PARKWAY
92	C-68	SIGNING PLAN - I-290
93	C-69	SIGN SCHEDULES
94	C-70	SIGN DETAILS
95-97	C-71 - C-73	BRIDGE MOUNT SIGN STRUCTURES
98-104	C-74 - C-80	CITY OF CHICAGO - CIVIL STANDARD DETAILS
105-109	C-81 - C-85	CITY OF CHICAGO - ADA STANDARD DETAILS
110-125	C-86 - C101	IDOT DISTRICT 1 BD STANDARD DETAILS
126	C-102	IDOT DISTRICT 1 TS STANDARD DETAIL
127	E-1	IDOT LIGHTING LEGEND, ABBREVIATION AND GENERAL NOTES
128	E-2	IDOT UNDERPASS LIGHTING TEMPORARY AND REMOVAL PLAN
129	E-3	IDOT UNDERPASS LIGHTING PROPOSED PLAN
130	E-4	MODIFIED IDOT LIGHTING CONTROLLER "I" WIRING DIAGRAM
131-141	E-5 - E-15	IDOT DISTRICT 1 BE STANDARD DETAILS
142	E-16	CDOT ELECTRICAL LEGEND
143	E-17	CDOT GENERAL NOTES
144	E-18	CDOT UNDERGROUND CONDUIT FACILITIES PLAN - S CENTRAL PARK AVENUE
145	E-19	CDOT LIGHTING INSTALLATION AND REMOVAL PLAN - S CENTRAL PARK AVENUE
146-166	E-20 - E-40	CDOT ELECTRICAL STANDARD DETAILS
167-168	E-41 - E-42	CDOT ELECTRICAL RECORD DRAWINGS
169-170	E-43 - E-44	TRAFFIC SIGNAL REQUIREMENT
171-176	E-45 - E-50	TRAFFIC CONTROL SIGNALS
177-178	E-51 - E-52	TIMING SCHEDULE
179	E-53	ITS PROPOSED PLAN - I-290
180-181	E-54 - E-55	ITS DETAILS - I-290
182-186	E-56 - E-60	ITS EXISTING PLANS - I-290
187	E-61	UTILITY ATTACHED TO STRUCTURE DETALS

INDEX OF SHEETS (CONT.)

188	S-1	GENERAL PLAN AND ELEVATION
189	S-2	ALIGNMENTS, INDEX OF SHEETS, AND TOTAL BILL OF MATERIALS
190	S-3	GENERAL NOTES AND DATA
191	S-4	EXISTING STRUCTURE REMOVAL PLAN AND ELEVATION
192	S-5	EXISTING STRUCTURE REMOVAL DETAILS
193	S-6	SUBSTRUCTURE LAYOUT PLAN AND TEMPORARY SOIL RETENSION SYSTEM DETAILS
194	S-7	TEMPORARY SOIL RETENSION SYSTEM DETALS
195	S-8	TOP OF DECK ELEVATION LOCATIONS
196-197	S-9 - S-10	TOP OF DECK ELEVATIONS
198	S-11	TOP OF NORTH APPROACH SLAB ELEVATIONS
199	S-12	TOP OF SOUTH APPROACH SLAB ELEVATIONS
200	S-13	DECK PLAN AND CROSS SECTION
201-202	S-14 - S-15	DECK DETAILS
203	S-16	PARAPET ELEVATIONS AND DETAILS
204	S-17	CONCRETE DIAPHRAGM DETAILS
205-206	S-18 - S-19	NORTH APPROACH SLAB DETAILS
207-208	S-20 - S-21	SOUTH APPROACH SLAB DETAILS
209	S-22	TYPICAL APPROACH SLAB DETAILS
210-211	S-23 - S-24	BRIDGE FENCE RAILING, CURVED
212-213	S-25 - S-26	BRIDGE FENCE RAILING
214	S-27	FRAMING PLAN AND GIRDER ELEVATION
215	S-28	STRUCTURAL STEEL DETAILS
216	S-29	GIRDER MOMENT AND REACTION TABLES
217	S-30	ELASTOMERIC BEARING TYPE I AND FIXED BEARING DETAILS
218	S-31	NORTH ABUTMENT PLAN AND ELEVATION
219	S-32	NORTH ABUTMENT FOUNDATION PLAN, SECTION, AND DETAILS
220	S-33	NORTH WINGWALLS PLAN AND ELEVATION
221	S-34	NORTH WINGWALLS FOUNDATION PLAN
222	S-35	NORTH WINGWALLS DETAILS
223	S-36	SOUTH ABUTMENT PLAN AND ELEVATION
224	S-37	SOUTH ABUTMENT FOUNDATION PLAN, SECTION, AND DETAILS
225	S-38	SOUTH WINGWALLS PLAN AND ELEVATION
226	S-39	SOUTH WINGWALLS FOUNDATION PLAN
227	S-40	SOUTH WINGWALLS DETAILS
228	S-41	TYPICAL ABUTMENT AND WINGWALL REVEAL ELEVATIONS
229	S-42	PIER 1 DETAILS
230	S-43	PIER 2 DETAILS
231	S-44	HP PILE DETAILS
232-237	S-45 - S-50	SOIL BORINGS
238-250	XS-1 - XS-13	CROSS SECTIONS



1 REVISED SHEET 1/2/2026



USER NAME	=	icsM-dbstepw21\$	DESIGNED	-	HJM	REVISED	-	12/19/2025	DJB
PLOT SCALE	=	0.16666667' / in.	DRAWN	-	OM	REVISED	-		
PLOT DATE	=	12/15/2025	CHECKED	-	HJM	REVISED	-		
PLOT TIME	=	11:09:58 PM	DATE	-		REVISED	-		

STATE OF ILLINOIS
DEPARTMENT OF TRANSPORTATION

INDEX OF DRAWINGS

SCALE:	SHEET NO. G-3 OF G-24 SHEETS	STA. 00+000 TO STA. 00+000
--------	------------------------------	----------------------------

F.A.I. RTE	SECTION	COUNTY	TOTAL SHEETS	SHEET NO.
290	2019-189-BR	COOK	250	3
CONTRACT NO. 62K62				
ILLINOIS		FED. AID PROJECT		

FILE NAME: \\cam-dbs\proj\21K62_120626\21K62-0010-S004.dgn

CODE NO.	ITEM	UNIT	TOTAL QUANTITY	CONSTRUCTION CODE					
				90% FED 10% STATE ROADWAY	90% FED 10% STATE BRIDGE	90% FED 10% STATE UTILITY	90% FED 10% STATE IDOT LIGHTING	90% FED 10% STATE CDOT LIGHTING	90% FED 10% STATE CDOT TRAFFIC SIGNALS
				0010	0010	0010	0021	0021	0021
				URBAN	016-2091	URBAN	URBAN	URBAN	URBAN
50157300	PROTECTIVE SHIELD	SQ YD	1,602		1,602				
50200100	STRUCTURE EXCAVATION	CU YD	4,835.4		4,835.4				
50200450	REMOVAL AND DISPOSAL OF UNSUITABLE MATERIAL FOR STRUCTURES	CU YD	1,208.9		1,208.9				
50300225	CONCRETE STRUCTURES	CU YD	1,482.9		1,482.9				
50300255	CONCRETE SUPERSTRUCTURE	CU YD	654.9		654.9				
50300260	BRIDGE DECK GROOVING	SQ YD	1,340.0		1,340.0				
50300285	FORM LINER TEXTURED SURFACE	SQ FT	2,832		2,832				
50300300	PROTECTIVE COAT	SQ YD	442		442				
50301350	CONCRETE SUPERSTRUCTURE (APPROACH SLAB)	CU YD	286		286				
50500105	FURNISHING AND ERECTING STRUCTURAL STEEL	L SUM	1		1				
50500505	STUD SHEAR CONNECTORS	EACH	11,360		11,360				
50800105	REINFORCEMENT BARS	POUND	58,480		58,480				
50800205	REINFORCEMENT BARS, EPOXY COATED	POUND	399,400		399,400				
50901730	BRIDGE FENCE RAILING	FOOT	188		188				

* SPECIALTY ITEMS

FILE NAME: \\cam-0batespw21\CS_pdfs\work\dl\6305420_130626K62-0011-SPO05.dgn

CODE NO.	ITEM	UNIT	TOTAL QUANTITY	CONSTRUCTION CODE					
				90% FED 10% STATE ROADWAY	90% FED 10% STATE BRIDGE	90% FED 10% STATE UTILITY	90% FED 10% STATE IDOT LIGHTING	90% FED 10% STATE CDOT LIGHTING	90% FED 10% STATE CDOT TRAFFIC SIGNALS
				0010	0010	0010	0021	0021	0021
				URBAN	016-2091	URBAN	URBAN	URBAN	URBAN
50901739	BRIDGE FENCE RAILING, CURVED	FOOT	489		489				
51100100	SLOPE WALL 4 INCH	SQ YD	333		333				
* 51201600	FURNISHING STEEL PILES HP12X53	FOOT	9,950		9,950				
* 51202305	DRIVING PILES	FOOT	9,950		9,950				
* 51203600	TEST PILE STEEL HP12X53	EACH	2		2				
* 51204650	PILE SHOES	EACH	199		199				
* 51500100	NAME PLATES	EACH	1		1				
* 51602000	PERMANENT CASING	FOOT	936		936				
* 51603000	DRILLED SHAFT IN SOIL	CU YD	170		170				
* 51604000	DRILLED SHAFT IN ROCK	CU YD	8		8				
* 52100010	ELASTOMERIC BEARING ASSEMBLY, TYPE I	EACH	30		30				
* 52100520	ANCHOR BOLTS, 1"	EACH	80		80				
52200020	TEMPORARY SOIL RETENTION SYSTEM	SQ FT	14,233		14,233				
55100500	STORM SEWER REMOVAL 12"	FOOT	235			235			

* SPECIALTY ITEMS

FILE NAME: \\cam-dbs\proj\21K62\proj_work\dl\6205420_140626\62-0012-5006.dgn

CODE NO.	ITEM	UNIT	TOTAL QUANTITY	CONSTRUCTION CODE					
				90% FED 10% STATE ROADWAY	90% FED 10% STATE BRIDGE	90% FED 10% STATE UTILITY	90% FED 10% STATE IDOT LIGHTING	90% FED 10% STATE CDOT LIGHTING	90% FED 10% STATE CDOT TRAFFIC SIGNALS
				0010	0010	0010	0021	0021	0021
				URBAN	016-2091	URBAN	URBAN	URBAN	URBAN
55100700	STORM SEWER REMOVAL 15"	FOOT	43			43			
56103300	DUCTILE IRON WATER MAIN 12"	FOOT	100			100	△1		
58600101	GRANULAR BACKFILL FOR STRUCTURES	CU YD	3,880		3,880				
56109404	DUCTILE IRON WATER MAIN FITTINGS 12" 11. 25 DEGREE BEND	EACH	2			2	△1		
58700300	CONCRETE SEALER	SQ FT	9,656		9,656				
56109412	DUCTILE IRON WATER MAIN FITTINGS 12" 22. 50 DEGREE BEND	EACH	1			1	△1		
59100100	GEOCOMPOSITE WALL DRAIN	SQ YD	615		615				
56109424	DUCTILE IRON WATER MAIN FITTINGS 12" 45.00 DEGREE BEND	EACH	3			3	△1		
60108206	PIPE UNDERDRAINS, TYPE 2, 6"	FOOT	587			587			
56109438	DUCTILE IRON WATER MAIN FITTINGS 12" 90.00 DEGREE BEND	EACH	4			4	△1		
60146304	PIPE UNDERDRAINS FOR STRUCTURES 4"	FOOT	305		305				
60200305	CATCH BASINS, TYPE A, 4'-DIAMETER, TYPE 3 FRAME AND GRATE	EACH	2			2			
60206602	CATCH BASINS, TYPE B, TYPE 8 GRATE	EACH	2			2			
60250200	CATCH BASINS TO BE ADJUSTED	EACH	8			8			
** 60255410	CATCH BASINS TO BE CLEANED	EACH	8			8			
60255500	MANHOLES TO BE ADJUSTED	EACH	13			13			
60265700	VALVE VAULTS TO BE ADJUSTED	EACH	7			7			
60500040	REMOVING MANHOLES	EACH	1			1			
60500050	REMOVING CATCH BASINS	EACH	8			8			

* SPECIALTY ITEMS
** NOT ELIGIBLE FOR FEDERAL FUNDING, 100% STATE FUNDED

FILE NAME: \\cam-database\21KCS_psf_work_016505420_17062602-2016-SQ09.dgn

CODE NO.	ITEM	UNIT	TOTAL QUANTITY	CONSTRUCTION CODE					
				90% FED 10% STATE ROADWAY	90% FED 10% STATE BRIDGE	90% FED 10% STATE UTILITY	90% FED 10% STATE IDOT LIGHTING	90% FED 10% STATE CDOT LIGHTING	90% FED 10% STATE CDOT TRAFFIC SIGNALS
				0010	0010	0010	0021	0021	0021
				URBAN	016-2091	URBAN	URBAN	URBAN	URBAN
70400125	PINNING TEMPORARY CONCRETE BARRIER	EACH	255	255					
70400200	RELOCATE TEMPORARY CONCRETE BARRIER	FOOT	1,375	1,375					
70600255	IMPACT ATTENUATORS, TEMPORARY (FULLY REDIRECTIVE, NARROW), TEST LEVEL 2	EACH	2	2					
70600260	IMPACT ATTENUATORS, TEMPORARY (FULLY REDIRECTIVE, NARROW), TEST LEVEL 3	EACH	2	2					
70600322	IMPACT ATTENUATORS, RELOCATE (FULLY REDIRECTIVE, NARROW), TEST LEVEL 2	EACH	4	4					
70600332	IMPACT ATTENUATORS, RELOCATE (FULLY REDIRECTIVE, NARROW), TEST LEVEL 3	EACH	4	4					
* 72000100	SIGN PANEL - TYPE 1	SQ FT	113	113					
* 72000300	SIGN PANEL - TYPE 3	SQ FT	201	201					
* 72400100	REMOVE SIGN PANEL ASSEMBLY - TYPE A	EACH	17	17					
* 72400200	REMOVE SIGN PANEL ASSEMBLY - TYPE B	EACH	11	11					
* 72800100	TELESCOPING STEEL SIGN SUPPORT	FOOT	48	48					
* 72900200	METAL POST - TYPE B	FOOT	68	68					
* 73100100	BASE FOR TELESCOPING STEEL SIGN SUPPORT	EACH	4	4					
* 73304000	OVERHEAD SIGN STRUCTURE - BRIDGE MOUNTED	FOOT	19	19					

* SPECIALTY ITEMS

 REVISED SHEET 1/2/2026



DB STERLIN CONSULTANTS, INC.
123 N. Wacker Drive, Suite 2000
Chicago, Illinois 60606
312.857.1006

USER NAME =	icsM-database\21KCS	DESIGNED =	JMM	REVISED =	
PLOT SCALE =	0.2" = 1' / in.	DRAWN =	MRK	REVISED =	
PLOT DATE =	10/10/2025	CHECKED =	HJM	REVISED =	
PLOT TIME =	9:08:34 PM	DATE =		REVISED =	

STATE OF ILLINOIS
DEPARTMENT OF TRANSPORTATION

SUMMARY OF QUANTITIES IX

SCALE: NTS SHEET NO. G-15 OF G-24 SHEETS

F.A.I. RTE	SECTION	COUNTY	TOTAL SHEETS	SHEET NO.
290	2019-189-BR	COOK	250	15
CONTRACT NO. 62K62				
ILLINOIS FED. AID PROJECT				

FILE NAME: \\cam-database\21K62\proj_work\dl\6305440_250626\62-0201-S0015.dgn

CODE NO.	ITEM	UNIT	TOTAL QUANTITY	CONSTRUCTION CODE					
				90% FED 10% STATE ROADWAY	90% FED 10% STATE BRIDGE	90% FED 10% STATE UTILITY	90% FED 10% STATE IDOT LIGHTING	90% FED 10% STATE CDOT LIGHTING	90% FED 10% STATE CDOT TRAFFIC SIGNALS
				0010	0010	0010	0021	0021	0021
				URBAN	016-2091	URBAN	URBAN	URBAN	URBAN
* X1700001	DRILL EXISTING MANHOLE, HEAVY DUTY HANDHOLE, OR MEDIAN WALL JUNCTION BOX	EACH	20					9	11
X2080251	TRENCH AND BACKFILL WITH SCREENINGS	FOOT	2,410						2,410
X2130010	EXPLORATION TRENCH (SPECIAL)	FOOT	50			50			
X4240116	TEMPORARY SIDEWALK RAMP	EACH	22	22					
* X4240800	DETECTABLE WARNINGS (SPECIAL)	SQ FT	193	193					
X4404400	PAVEMENT REMOVAL (SPECIAL)	SQ YD	527	527					
* X5080530	BAR TERMINATORS	EACH	444		444				
* X5120013	PILE REMOVAL	EACH	45		45				
X5504000	STORM SEWER, DUCTILE IRON PIPE, TYPE 2, 8 INCH	FOOT	43			43			
X5610712	WATER MAIN REMOVAL 12"	FOOT	100			100	1		
X6022505	CATCH BASINS, TYPE A, 4'-DIAMETER, TYPE 1 FRAME, OPEN LID (CITY OF CHICAGO)	EACH	3			3			
X5630012	CUT AND CAP EXISTING 12" WATER MAIN	EACH	4			4	1		
X6060045	COMBINATION CONCRETE CURB AND GUTTER, TYPE B-V.12 (CDOT)	FOOT	1,019	1,019					
X6640104	FENCE REMOVAL	FOOT	824	824					
X6700410	ENGINEER'S FIELD OFFICE, TYPE A (SPECIAL)	CAL MO	18	18					
X7010216	TRAFFIC CONTROL AND PROTECTION, (SPECIAL)	L SUM	1	1					

* SPECIALTY ITEMS

1 REVISD SHEET 1/2/2026

FILE NAME: 

DB STERLIN CONSULTANTS, INC.
123 N. Wacker Drive, Suite 2000
Chicago, Illinois 60606
312.857.1006

USER NAME	=	icsM-database\21K	DESIGNED	=	JMM	REVISED	=	
PLOT SCALE	=	0.2" / in.	DRAWN	=	MRK	REVISED	=	
PLOT DATE	=	10/10/2025	CHECKED	=	HJM	REVISED	=	
PLOT TIME	=	9:11:00 PM	DATE	=		REVISED	=	

STATE OF ILLINOIS
DEPARTMENT OF TRANSPORTATION

SCALE: NTS		SHEET NO. G-21 OF G-24 SHEETS		ILLINOIS FED. AID PROJECT	
------------	--	-------------------------------	--	-----------------------------	--

SUMMARY OF QUANTITIES XV					F.A.I. RTE	SECTION	COUNTY	TOTAL SHEETS	SHEET NO.
					290	2019-189-BR	COOK	250	21
					CONTRACT NO. 62K62				

FILE NAME: \\casM-dbsstepw21\GIS_pdfs\work_dbs\1045\5424_490\162K62-ah-removal\plan-CP-01.dgn



USER NAME	= icsM-dbsstepw21\$	DESIGNED	- RCH	REVISED	- 12/19/2025 KRW
PLOT SCALE	= 0.16666667' / 1 in.	DRAWN	- CS	REVISED	-
PLOT DATE	= 12/19/2025	CHECKED	- KRW	REVISED	-
PLOT TIME	= 4:13:52 PM	DATE	-	REVISED	-

STATE OF ILLINOIS
DEPARTMENT OF TRANSPORTATION

REMOVAL PLAN - CENTRAL PARK AVENUE @ W HARRISON STREET

SCALE: 1" = 20' SHEET NO. C-8 OF C-102 SHEETS BEGIN TO STA. 604+50.00

F.A.I. RTE	SECTION	COUNTY	TOTAL SHEETS	SHEET NO.
290	2019-189-BR	COOK	250	32
CONTRACT NO. 62K62				
ILLINOIS FED. AID PROJECT				

LEGEND

	COMBINATION CURB AND GUTTER REMOVAL (44000500)
	CONCRETE BARRIER REMOVAL (44001980)
	FENCE REMOVAL (Z0022800)
	PAVEMENT MARKING REMOVAL - WATER BLASTING (78300202)
	WATER MAIN REMOVAL, 12" (X5610712)
	PAVEMENT REMOVAL (44000100)
	PAVEMENT REMOVAL (SPECIAL) (X4404400)
	PAVED SHOULDER REMOVAL (44004250)
	SIDEWALK REMOVAL (44000600)

ITEM REMOVAL

- NOTES:
- PAVEMENT REMOVAL ABOVE EXISTING CAST IRON WATER MAIN TO BE PAID FOR AS PAVEMENT REMOVAL (SPECIAL).
 - WATER MAIN SHOWN FOR REMOVAL TO BE REPLACED AFTER WING WALL CONSTRUCTION. SEE PROPOSED WATER MAIN PLANS FOR DETAILS.


1. REVISED SHEET 1/2/2026

1.

1.

1.

MATCHLINE STA. 604+50.00

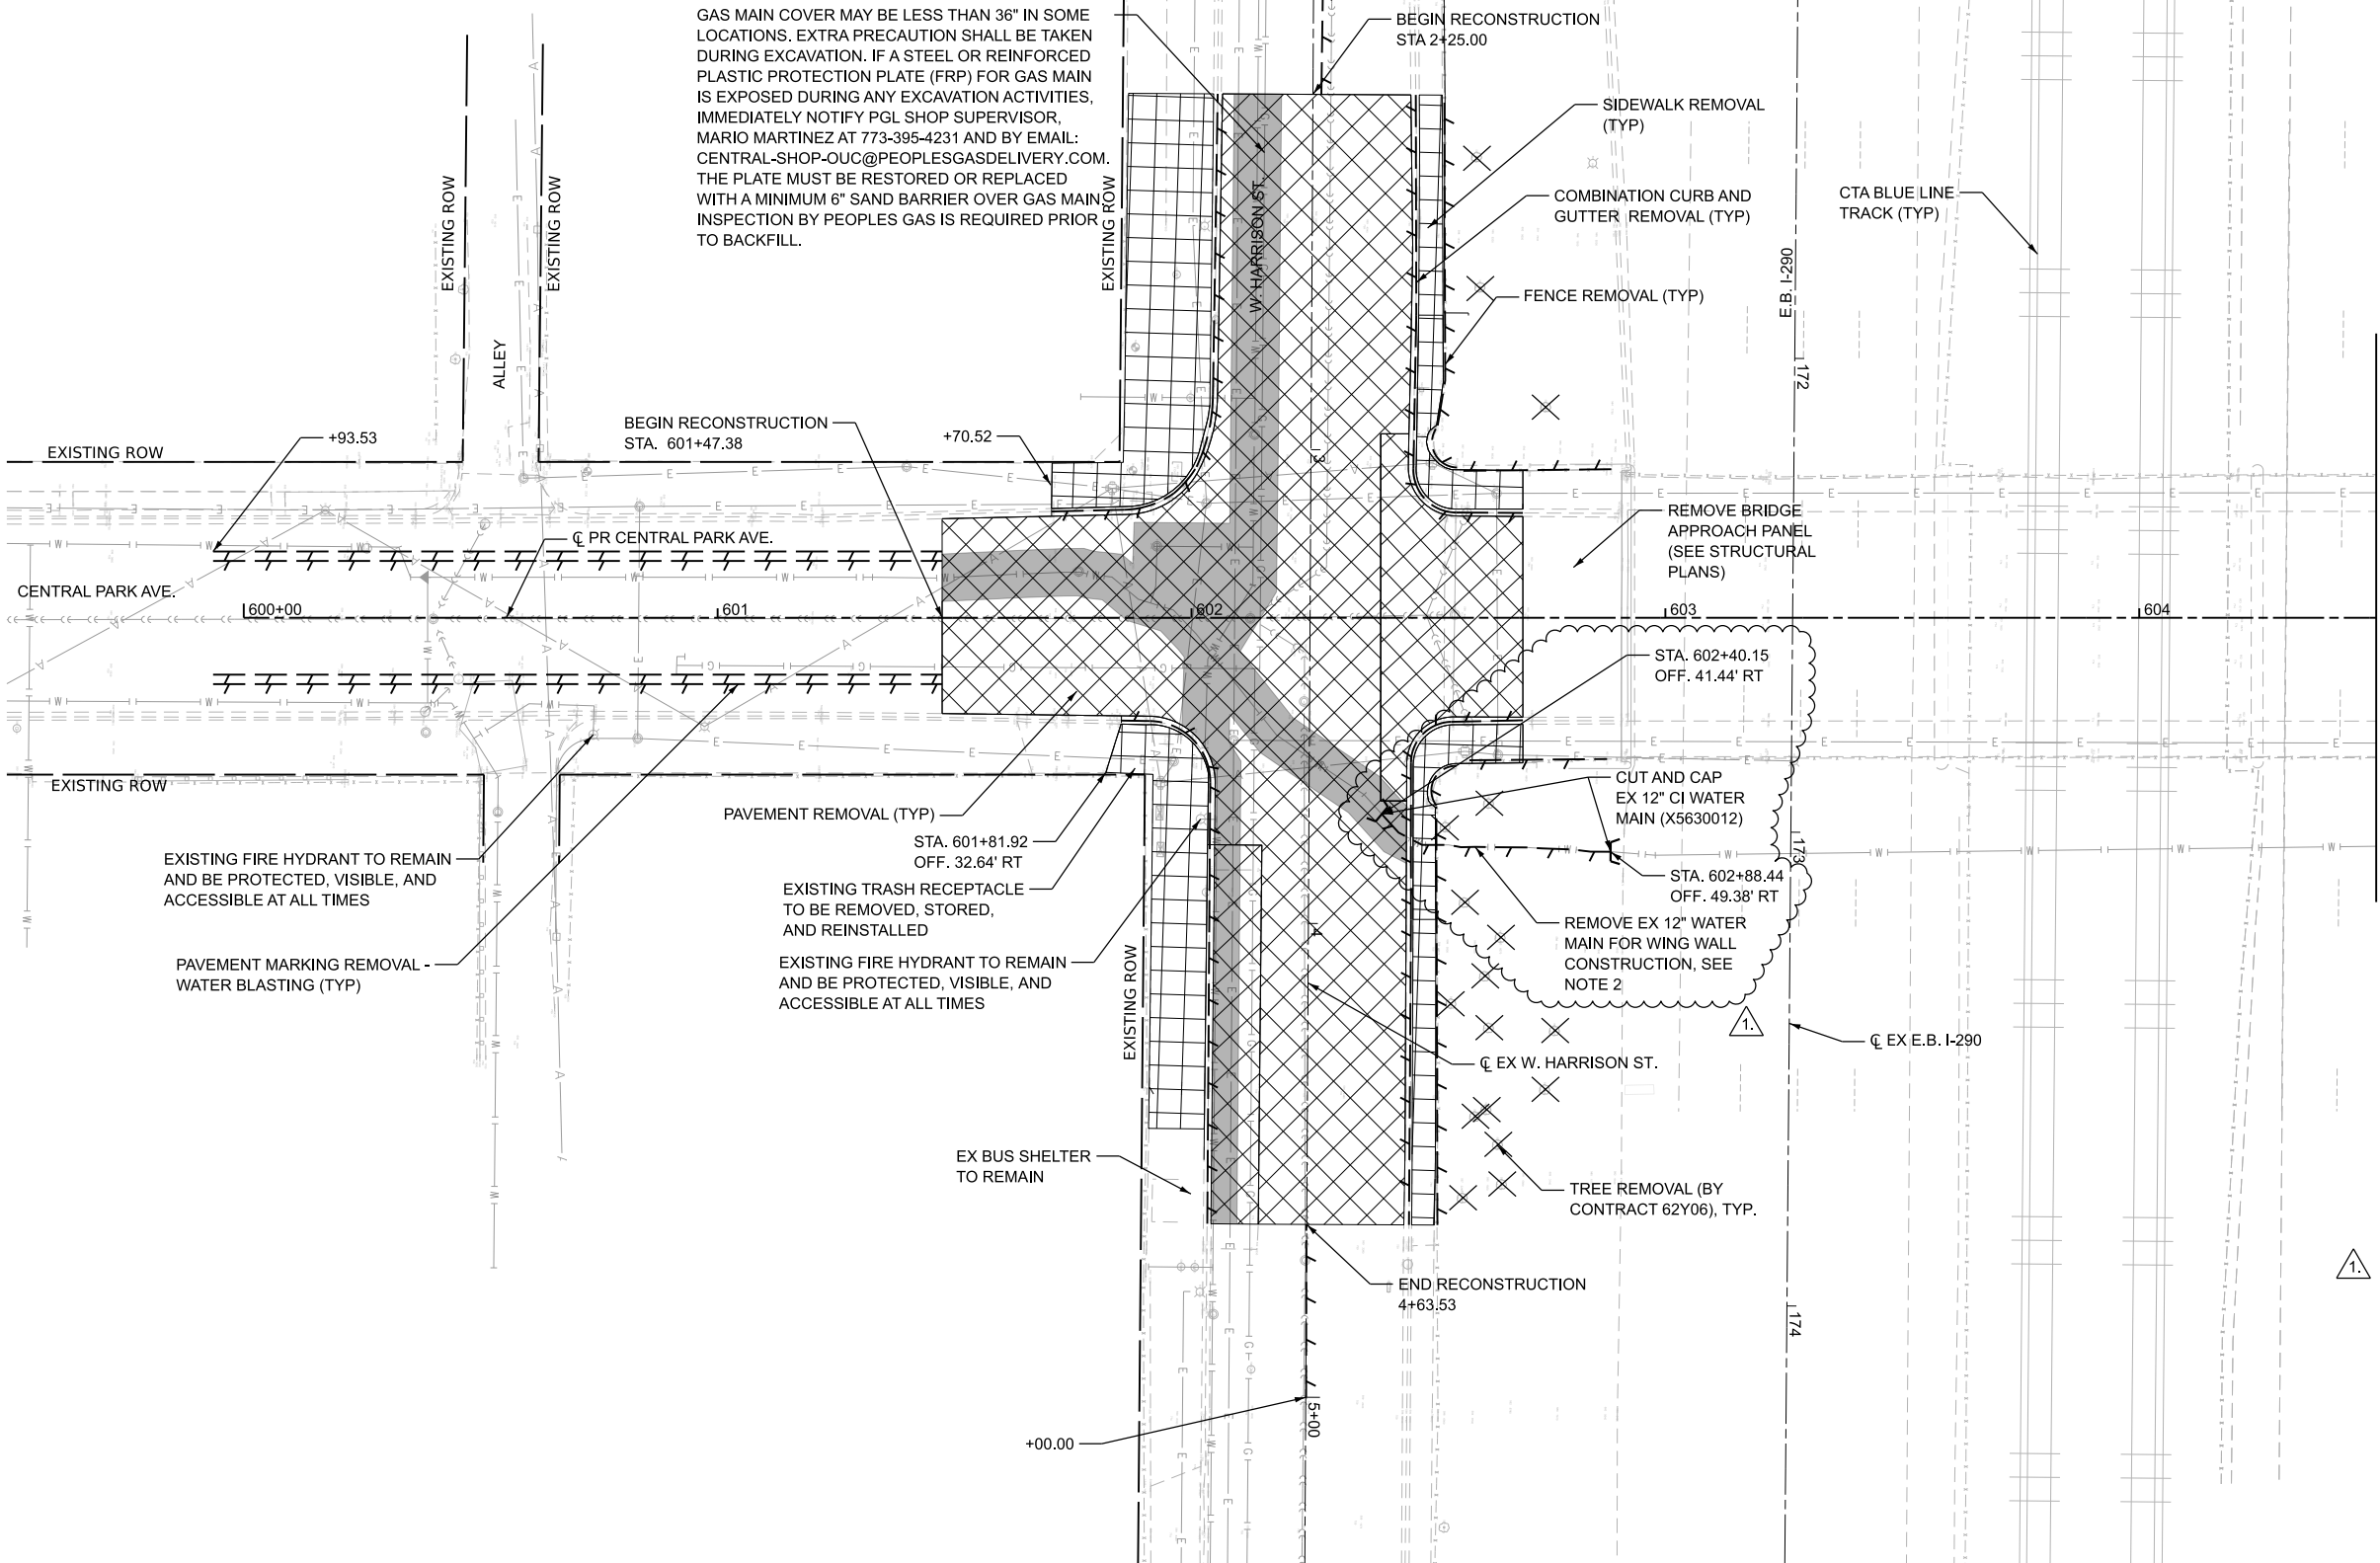

FILE NAME: \\casM-dbsstepw21\GIS_pnf_work_dfn\1048162\62-eh-removal\plan-CP-02.dgn



USER NAME	=	icsM-dbsstepw21\$
PLOT SCALE	=	0.16666667' / in.
PLOT DATE	=	12/19/2025
PLOT TIME	=	5:14:00 PM

DESIGNED	-	RCH
DRAWN	-	CS
CHECKED	-	KRW
DATE	-	

REVISED	-	12/19/2025	KRW
REVISED	-		
REVISED	-		
REVISED	-		

STATE OF ILLINOIS
DEPARTMENT OF TRANSPORTATION


REMOVAL PLAN - CENTRAL PARK AVENUE @ W CONGRESS PARKWAY

SCALE: 1" = 20'

SHEET NO. C-9 OF C-102 SHEETS

STA. 604+50.00 TO END

F.A.I. RTE	SECTION	COUNTY	TOTAL SHEETS	SHEET NO.
290	2019-189-BR	COOK	250	33
CONTRACT NO. 62K62				
ILLINOIS FED. AID PROJECT				

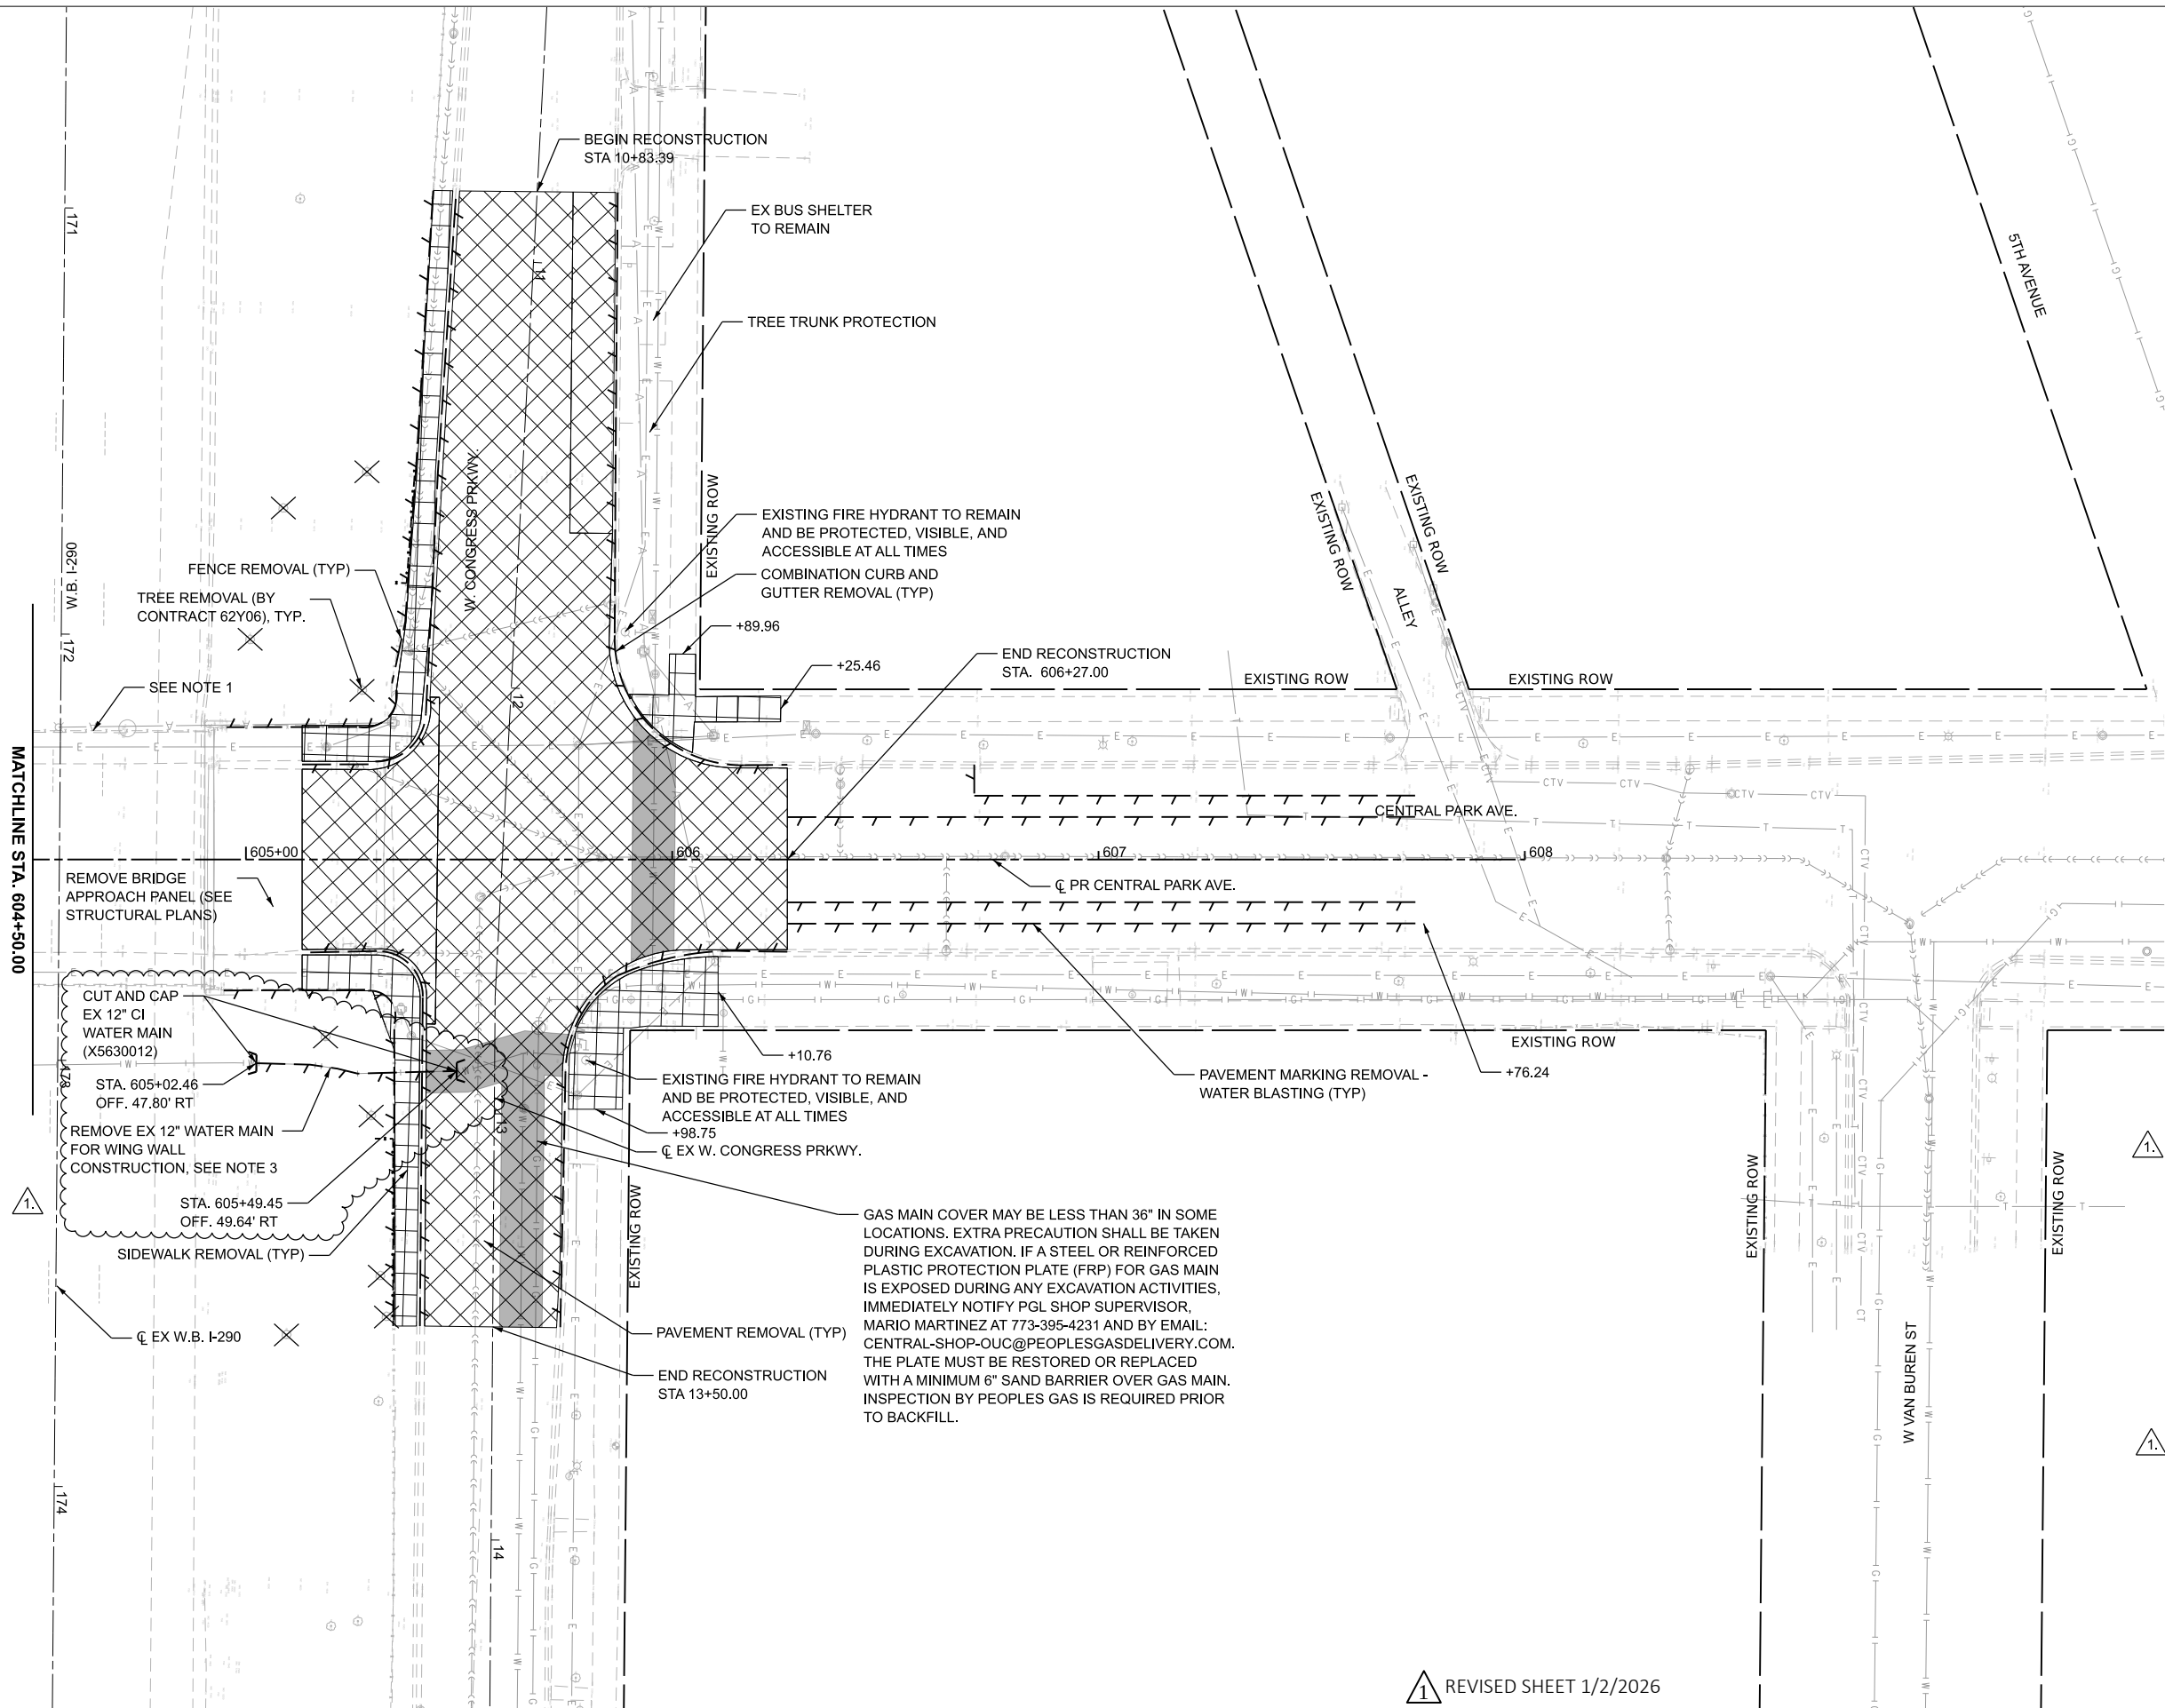

- NOTES:
- EXISTING ILLINOIS STATE POLICE (ISP) LICENSE PLATE READER (LPR), POWER FEED, RISER, AND ASSOCIATED HARDWARE AND APPURTENANCES TO BE REMOVED BY THE ISP CONTRACTOR. THE REMOVAL OF THE EXISTING ISP EQUIPMENT SHALL BE COORDINATED WITH THE STAGED BRIDGE REPLACEMENT. THE CONTRACTOR SHALL COORDINATE THE REMOVAL OF EXISTING CDOT LIGHTING/TRAFFIC SIGNAL EQUIPMENT AND STRUCTURE/ACCESS GATE WITH THE ISP CONTRACTOR.
 - PAVEMENT REMOVAL ABOVE EXISTING WATER MAIN TO BE PAID FOR AS PAVEMENT REMOVAL (SPECIAL).
 - WATER MAIN SHOWN FOR REMOVAL TO BE REPLACED AFTER WING WALL CONSTRUCTION. SEE PROPOSED WATER MAIN PLANS FOR DETAILS.

LEGEND

- COMBINATION CURB AND GUTTER REMOVAL (44000500)
- CONCRETE BARRIER REMOVAL (44001980)
- FENCE REMOVAL (Z0022800)
- PAVEMENT MARKING REMOVAL - WATER BLASTING (78300202)
- WATER MAIN REMOVAL, 12" (X5610712)
- PAVEMENT REMOVAL (44000100)
- PAVEMENT REMOVAL (SPECIAL) (X4404400)
- PAVED SHOULDER REMOVAL (44004250)
- SIDEWALK REMOVAL (44000600)

ITEM REMOVAL

REVISED SHEET 1/2/2026

SUGGESTED STAGING AND MAINTENANCE OF TRAFFIC

DETOUR

THIS IS A COMPLETE BRIDGE CLOSURE. CENTRAL PARK AVE TRAFFIC WILL BE DETOURED AS FOLLOWS:

NORTHBOUND S CENTRAL PARK AVE TO EASTBOUND W ROOSEVELT RD TO NORTHBOUND S HOMAN AVE TO WESTBOUND W MADISON ST TO NORTHBOUND S CENTRAL PARK AVE.

SOUTHBOUND S CENTRAL PARK AVE TO EASTBOUND W MADISON ST TO SOUTHBOUND S HOMAN AVE TO WESTBOUND W ROOSEVELT RD TO SOUTHBOUND S CENTRAL PARK AVE.

PRE STAGE

WORK PERFORMED: SUPERSTRUCTURE REMOVAL

MAINTENANCE OF TRAFFIC ALONG I-290

THIS WORK WILL BE ACCOMPLISHED WITH NO IMPACTS TO DAYTIME TRAFFIC; TRAFFIC WILL REMAIN IN ITS NORMAL CONFIGURATION. INTERMITTENT NIGHTTIME PARTIAL AND FULL CLOSURES WILL BE NECESSARY FOR PROTECTIVE SHIELD PLACEMENT, DECK DEMOLITION, AND DECK AND BEAM REMOVAL.

STAGE 1

WORK PERFORMED: ABUTMENT DEMOLITION AND RECONSTRUCTION; EXISTING WATER MAIN CUT, CAP, AND REMOVAL FOR WING WALL CONSTRUCTION; WING WALL CONSTRUCTION; OUTSIDE SHOULDER/AUXILIARY LANE REPLACEMENT AND ADJACENT CURB & GUTTER REPLACEMENT

MAINTENANCE OF TRAFFIC ALONG I-290

RIGHT SHOULDERS WILL BE CLOSED. TRAFFIC LANES ON BOTH EASTBOUND AND WESTBOUND I-290 WILL BE SHIFTED TO THE LEFT AND REDUCED FROM 12' TO 11' WIDTH. THE LEFT SHOULDERS WILL REMAIN IN THEIR NORMAL CONFIGURATION. IT IS RECOMMENDED THAT THE TEMPORARY CONCRETE BARRIER BE RELOCATED FROM THE EDGE OF THE SHOULDER TO THE EDGE OF THE WORK ZONE DURING ACTIVE DEMOLITION WORK TO PREVENT DEBRIS FROM ENTERING THE TRAFFIC LANES.

STAGE 2

WORK PERFORMED: PIER REMOVAL AND REPLACEMENT; INSIDE SHOULDER AND HALF LANE REPLACEMENT; SUPERSTRUCTURE REPLACEMENT

MAINTENANCE OF TRAFFIC ALONG I-290

PIER AND INSIDE SHOULDER AND LANE CONSTRUCTION:
THE LEFT SHOULDERS AND HALF THE INSIDE LANE (LANE 1) WILL BE REPLACED WITH NEW FULL DEPTH PAVEMENT. LANES WILL BE SHIFTED TO THE RIGHT AND NARROWED TO FOUR 11' LANES FOR BOTH EASTBOUND WESTBOUND I-290 TO CREATE A WORK ZONE ON THE LEFT SIDE OF THE ROADWAY. PIER CONSTRUCTION WILL BE UNDERTAKEN.

SUPERSTRUCTURE REPLACEMENT:

THIS WORK WILL BE ACCOMPLISHED WITH NO IMPACTS TO DAYTIME TRAFFIC; TRAFFIC WILL REMAIN IN THE SHIFTED AND NARROWED CONFIGURATION ESTABLISHED FOR PIER CONSTRUCTION. INTERMITTENT NIGHTTIME PARTIAL AND FULL CLOSURES WILL BE NECESSARY FOR PROTECTIVE SHIELD PLACEMENT, BEAM PLACEMENT, AND DECK CONSTRUCTION.

STAGE 3

WORK PERFORMED: SLOPEWALL CONSTRUCTION ADJACENT TO ABUTMENT AND I-290 EMBANKMENT FINAL GRADING

MAINTENANCE OF TRAFFIC ALONG I-290

RIGHT SHOULDERS WILL BE CLOSED. LANES WILL SHIFTED TO THE LEFT AND NARROWED TO FOUR 11' LANES FOR BOTH EASTBOUND AND WESTBOUND I-290 TO CREATE A WORK ZONE ON THE RIGHT SIDE OF THE ROADWAY.

STAGE 4

WORK PERFORMED: APPROACH SLAB CONSTRUCTION; ADA RAMPS, TRAFFIC SIGNALS, AND PAVEMENT AND CURB AND GUTTER REPLACEMENT AT CORNERS ADJACENT TO BRIDGE

MAINTENANCE OF TRAFFIC ON FRONTAGE ROADS

THE LEFT LANES ON W CONGRESS PARKWAY AND W HARRISON STREET WILL BE CLOSED AND TRAFFIC WILL BE SHIFTED TO THE RIGHT FOR THE CONSTRUCTION OF THE BRIDGE APPROACH SLABS, PAVEMENT, SIDEWALK, ADA RAMPS, TRAFFIC SIGNALS, DRAINAGE, AND CURB AND GUTTER AT THE SOUTH HALF OF THE INTERSECTION OF W CONGRESS PARKWAY AND S CENTRAL PARK AVE AND THE NORTH HALF OF THE INTERSECTION OF W HARRISON ST AND S CENTRAL PARK AVE. TO MINIMIZE THE DURATION OF THE CLOSURES, WORK PERFORMED SHALL BE PER STANDARD 701601 TO ACCOMMODATE TRAFFIC WHEN POSSIBLE.

STAGE 5

WORK PERFORMED: ADA RAMPS, TRAFFIC SIGNALS, AND PAVEMENT AND DRAINAGE CONSTRUCTION

MAINTENANCE OF TRAFFIC ON FRONTAGE ROADS


THE RIGHT LANES ON W CONGRESS PARKWAY AND W HARRISON STREET WILL BE CLOSED AND TRAFFIC WILL BE SHIFTED TO THE LEFT FOR THE CONSTRUCTION OF THE PAVEMENT, SIDEWALK, ADA RAMPS, TRAFFIC SIGNALS, DRAINAGE, AND CURB AND GUTTER AT THE NORTHEAST QUADRANT OF THE INTERSECTION OF W CONGRESS PARKWAY AND S CENTRAL PARK AVE AND THE SOUTHWEST QUADRANT OF THE INTERSECTION OF W HARRISON ST AND S CENTRAL PARK AVE. TO MINIMIZE THE DURATION OF THE CLOSURES, WORK PERFORMED SHALL BE PER STANDARD 701601 TO ACCOMMODATE TRAFFIC WHEN POSSIBLE.

STAGE 6

WORK PERFORMED: ADA RAMPS, TRAFFIC SIGNALS, AND PAVEMENT AND DRAINAGE CONSTRUCTION

MAINTENANCE OF TRAFFIC ON FRONTAGE ROADS

THE RIGHT LANES ON W CONGRESS PARKWAY AND W HARRISON STREET WILL BE CLOSED AND TRAFFIC WILL BE SHIFTED TO THE LEFT FOR THE CONSTRUCTION OF THE PAVEMENT, SIDEWALK, ADA RAMPS, TRAFFIC SIGNALS, DRAINAGE, AND CURB AND GUTTER AT THE NORTHWEST QUADRANT OF THE INTERSECTION OF W CONGRESS PARKWAY AND S CENTRAL PARK AVE AND THE SOUTHEAST QUADRANT OF THE INTERSECTION OF W HARRISON ST AND S CENTRAL PARK AVE. TO MINIMIZE THE DURATION OF THE CLOSURES, WORK PERFORMED SHALL BE PER STANDARD 701601 TO ACCOMMODATE TRAFFIC WHEN POSSIBLE.

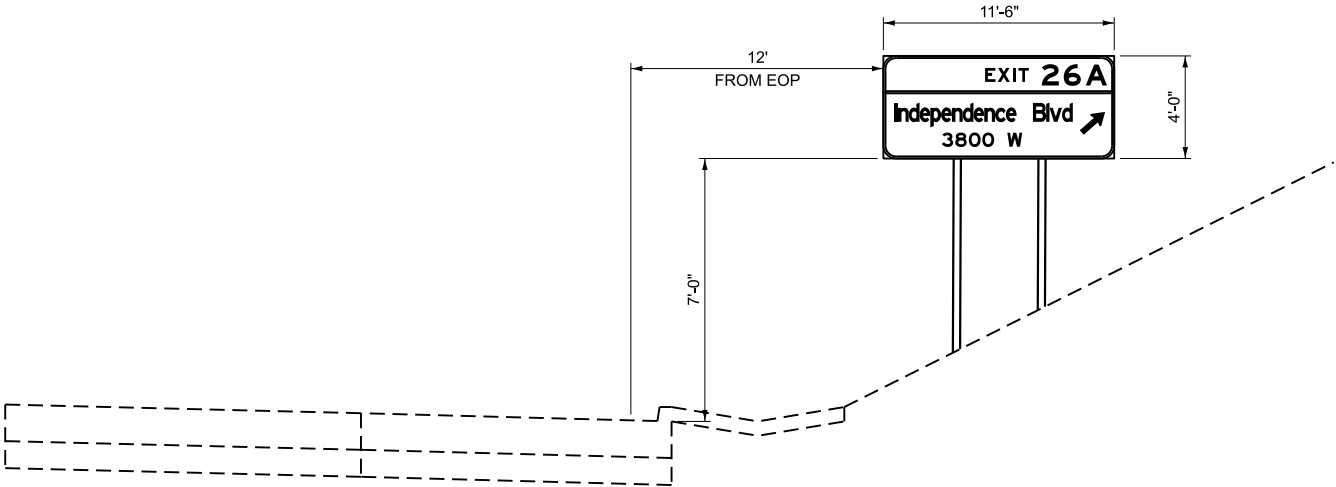

TEMPORARY SIGN
WB I-290 (LOOKING WEST)
STA 174+50

TEMPORARY SIGN NOTES

1. TEMPORARY SIGNAGE AND SIGN SUPPORTS TO BE PAID FOR UNDER PAY ITEM "TEMPORARY INFORMATION SIGNING"
2. WOOD SIGN SUPPORTS SHALL BE CRASH WORTHY

1. REVISED SHEET 1/2/2026

FILE NAME: \\cam-dbsstepw21\CS_pdf_work_dgn\10345424_110162K62-eh-MOT StageNote.dgn



DB STERLIN CONSULTANTS, INC.
123 N. Wacker Drive, Suite 2000
Chicago, Illinois 60606
312.857.1006

USER NAME	=	icsM-dbsstepw21\$	DESIGNED	-	HJM	REVISED	-	12/19/2025	HJM
PLOT SCALE	=	40,0000' / in.	DRAWN	-	DDC	REVISED	-		
PLOT DATE	=	12/15/2025	CHECKED	-	HJM	REVISED	-		
PLOT TIME	=	8:40:05 PM	DATE	-		REVISED	-		

STATE OF ILLINOIS
DEPARTMENT OF TRANSPORTATION

SUGGESTED CONSTRUCTION SEQUENCE AND STAGING NARRATIVE

SCALE: SHEET NO. C-17 OF C-102 SHEETS STA. 00+000 TO STA. 00+000



F.A.I. RTE	SECTION	COUNTY	TOTAL SHEETS	SHEET NO.
290	2019-189-BR	COOK	250	41
CONTRACT NO. 62K62				
		ILLINOIS	FED. AID PROJECT	

STAGING NOTES

1. CENTRAL PARK AVE. WILL BE FULLY CLOSED AND VEHICULAR, BIKE, AND PEDESTRIAN TRAFFIC WILL BE DETOURED. SEE DETOUR PLAN SHEETS FOR DETAILED SIGNAGE FOR ALL ADJACENT ROADWAYS.
2. THESE PLANS ARE SUGGESTED MAINTENANCE OF TRAFFIC PLANS. THE CONTRACTOR IS REQUIRED TO SUBMIT MOT PLANS, AND CONSTRUCTION SEQUENCING DETAILS TO IDOT FOR REVIEW AND APPROVAL. ALL MAINTENANCE OF TRAFFIC CLOSURES SHALL BE IN ACCORDANCE WITH IDOT DISTRICT ONE SPECIAL PROVISION "KEEPING THE EXPRESSWAY OPEN TO TRAFFIC."
3. TYPE II BARRICADES OR DRUMS ARE REQUIRED FOR ALL NIGHTTIME CLOSURES. TYPE II BARRICADES OR DRUMS WITH MONODIRECTIONAL STEADY BURN LIGHTS ARE REQUIRED FOR DELINEATING OBSTACLES, EXCAVATIONS, OR HAZARDS EXCEEDING 100 FT (30M) IN LENGTH AT NIGHT.
4. THE FLAGGER AND FLAGGER SIGN ARE REQUIRED AT THE WORK SITES WHEN:
A. FOUR OR MORE WORK VEHICLES ENTER THE TRAFFIC LANES IN ONE HOUR PERIOD.
B. THE WORK ACTIVITY REQUIRES FREQUENT ENCROACHMENT INTO THE LANE OPEN TO TRAFFIC.
5. THE FLAGGER SHALL BE STATIONED 500 FT IN ADVANCE OF OPENING WHERE CONTRACTOR'S VEHICLES ENTER AND EXIT THE WORK AREA.
6. RAISED REFLECTIVE PAVEMENT MARKERS WITHIN LIMITS OF PAVEMENT MARKING REMOVAL FOR MOT WILL BE REMOVED AND REPLACED AFTER THE FINAL STAGE ON I-290 IS COMPLETE.
7. WORK REQUIRING ENCROACHMENT OF OPEN LANES SHALL BE DONE PER NIGHTTIME ALLOWABLE HOURS. WORK ACTIVITY ENCROACHING ONTO LIVE LANES IS STRICTLY PROHIBITED.

TAPER LENGTH CALCULATIONS

EASTBOUND I-290 LANE SHIFT
I-290 SPEED LIMIT = 55 MPH
SHIFTING TAPER = 55:1
SHIFT DISTANCE = 4'
TAPER LENGTH (L) = 4*55 = 220'

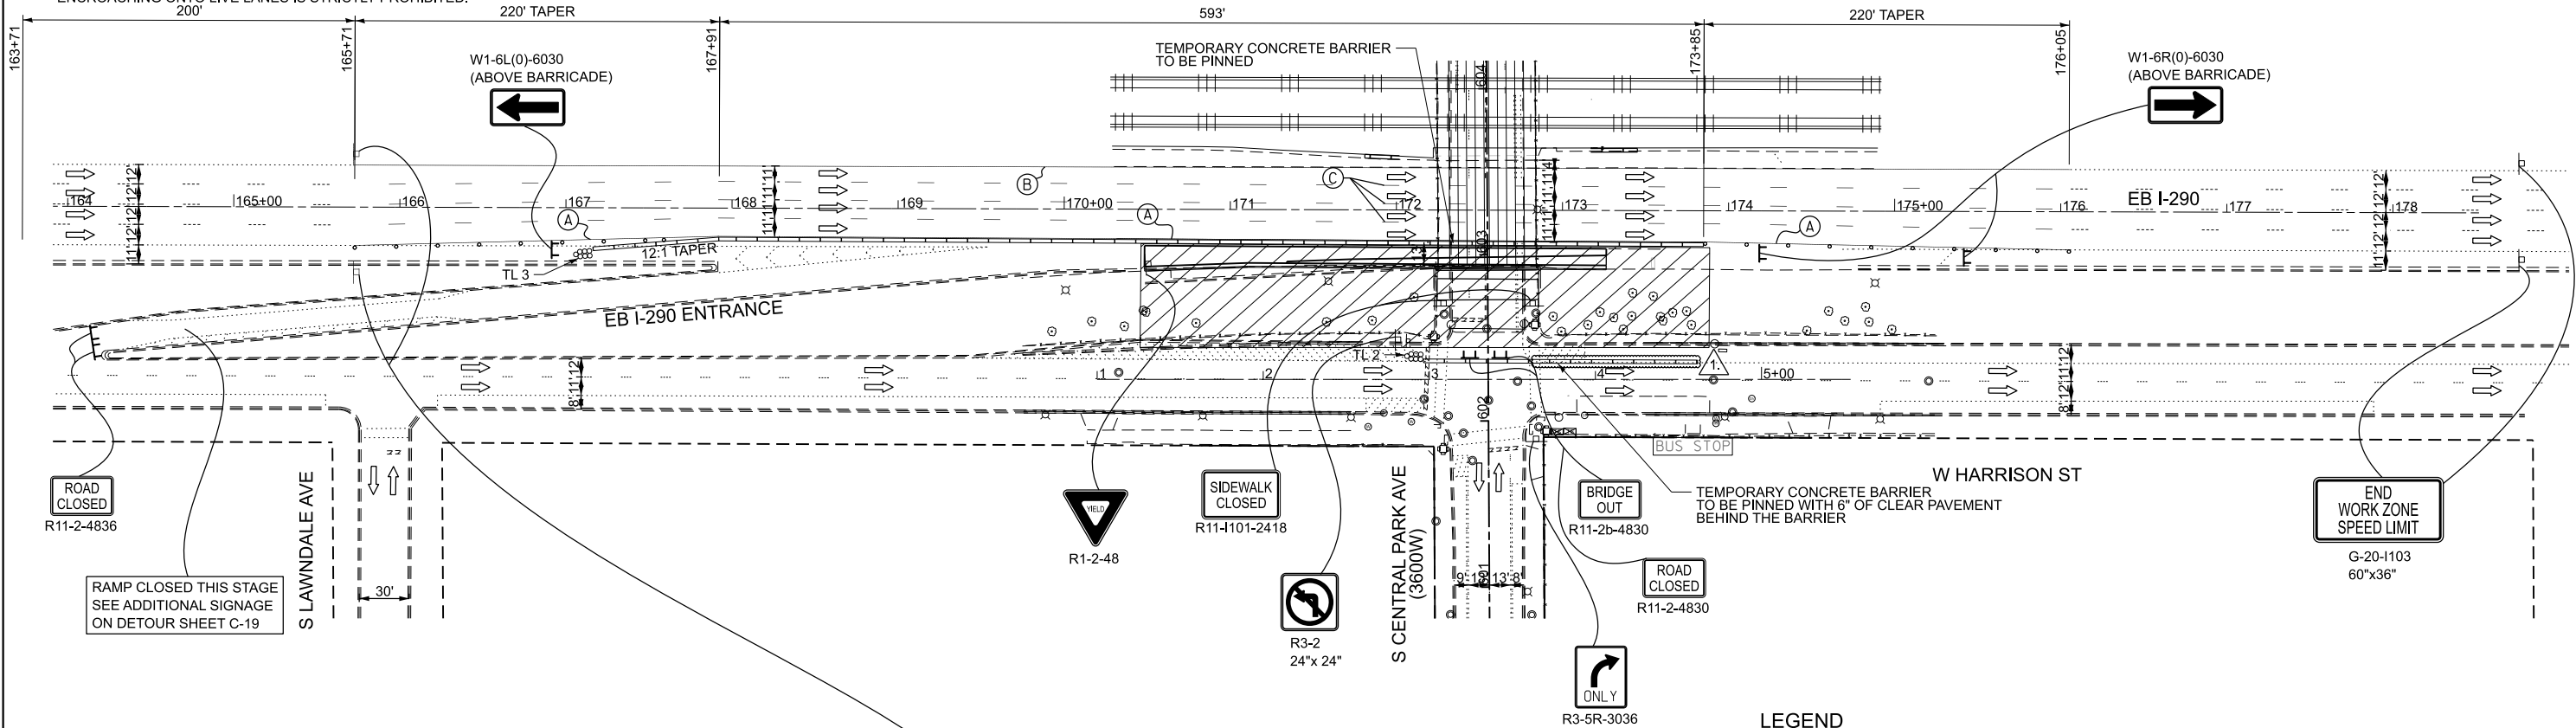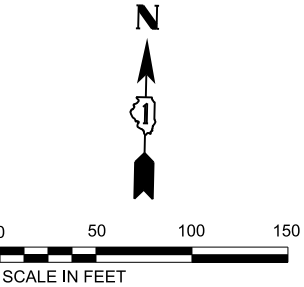

LEGEND

- WORK ZONE
- TEMPORARY CONCRETE BARRIER
- EXISTING PAVEMENT MARKING
- PROPOSED PAVEMENT MARKING
- DRUM OR TYPE I BARRICADE W/ FLASHING AMBER LIGHT @ 25' C-C
- DIRECTION INDICATOR BARRICADE
- TYPE III BARRICADE
- ARROW BOARD
- IMPACT ATTENUATOR, TEMPORARY (FULLY REDIRECTIVE, NARROW) TEST LEVEL 2 OR 3
- TRAFFIC DIRECTION

- (A) - 4" WHITE LINE (TEMPORARY PAVEMENT MARKING - LINE 4" TYPE IV TAPE)*
- (B) - 4" YELLOW LINE (TEMPORARY PAVEMENT MARKING - LINE 4" TYPE IV TAPE)*
- (C) - 5" WHITE LINE (TEMPORARY PAVEMENT MARKING - LINE 5" TYPE IV TAPE) (10' DASH - 30' SKIP)*
- (D) - 8" WHITE LINE (TEMPORARY PAVEMENT MARKING - LINE 8" TYPE IV TAPE)*
- (E) - 4" WHITE DOTTED LINE (TEMPORARY PAVEMENT MARKING - LINE 4" TYPE IV TAPE) (2' DASH - 6' SKIP)*
- (F) - 12" WHITE LINE (TEMPORARY PAVEMENT MARKING - LINE 12" TYPE IV TAPE)*
- (G) - 8" YELLOW LINE (TEMPORARY PAVEMENT MARKING - LINE 8" TYPE IV TAPE)*
- TEMPORARY TRAFFIC SIGN
- FLAGGER WITH TRAFFIC CONTROL SIGN

* NOTE: TEMPORARY PAVEMENT MARKING DURING WINTER STAGES SHALL BE MODIFIED URETHANE.

1 REVISED SHEET 1/2/2026

FILE NAME: \\cam-dbsstepw21\CS_pdf_work_dfr\103615424_750162K62-eh-MOT01-1-200EB.dgn



DB STERLIN CONSULTANTS, INC.
123 N. Wacker Drive, Suite 2000
Chicago, Illinois 60606
312.857.1006

USER NAME = icsM-dbsstepw215
PLOT SCALE = 100,000' / in.
PLOT DATE = 12/15/2025
PLOT TIME = 9:57:19 PM

DESIGNED - DDC
DRAWN - JH
CHECKED - HJM
DATE -

REVISED - 12/19/2025 HJM
REVISED -
REVISED -
REVISED -

STATE OF ILLINOIS
DEPARTMENT OF TRANSPORTATION

MAINTENANCE OF TRAFFIC
STAGE 1 - EASTBOUND I-290 AT CENTRAL PARK AVE

SCALE: SHEET NO. C-24 OF C-102 SHEETS STA. 00+000 TO STA. 00+000



F.A.I. RTE	SECTION	COUNTY	TOTAL SHEETS	SHEET NO.
290	2019-189-BR	COOK	250	48
CONTRACT NO. 62K62				
ILLINOIS FED. AID PROJECT				

STAGING NOTES

1. CENTRAL PARK AVE. WILL BE FULLY CLOSED AND VEHICULAR, BIKE, AND PEDESTRIAN TRAFFIC WILL BE DETOURED. SEE DETOUR PLAN SHEETS FOR DETAILED SIGNAGE FOR ALL ADJACENT ROADWAYS.
2. THESE PLANS ARE SUGGESTED MAINTENANCE OF TRAFFIC PLANS. THE CONTRACTOR IS REQUIRED TO SUBMIT MOT PLANS, AND CONSTRUCTION SEQUENCING DETAILS TO IDOT FOR REVIEW AND APPROVAL. ALL MAINTENANCE OF TRAFFIC CLOSURES SHALL BE IN ACCORDANCE WITH IDOT DISTRICT ONE SPECIAL PROVISION "KEEPING THE EXPRESSWAY OPEN TO TRAFFIC."
3. TYPE II BARRICADES OR DRUMS ARE REQUIRED FOR ALL NIGHTTIME CLOSURES. TYPE II BARRICADES OR DRUMS WITH MONODIRECTIONAL STEADY BURN LIGHTS ARE REQUIRED FOR DELINEATING OBSTACLES, EXCAVATIONS, OR HAZARDS EXCEEDING 100 FT (30M) IN LENGTH AT NIGHT.
4. THE FLAGGER AND FLAGGER SIGN ARE REQUIRED AT THE WORK SITES WHEN:
A. FOUR OR MORE WORK VEHICLES ENTER THE TRAFFIC LANES IN ONE HOUR PERIOD.
B. THE WORK ACTIVITY REQUIRES FREQUENT ENCROACHMENT INTO THE LANE OPEN TO TRAFFIC.
5. THE FLAGGER SHALL BE STATIONED 500 FT IN ADVANCE OF OPENING WHERE CONTRACTOR'S VEHICLES ENTER AND EXIT THE WORK AREA.
6. RAISED REFLECTIVE PAVEMENT MARKERS WITHIN LIMITS OF PAVEMENT MARKING REMOVAL FOR MOT WILL BE REMOVED AND REPLACED AFTER FINAL STAGE ON I-290 IS COMPLETE.
7. WORK REQUIRING ENCROACHMENT OF OPEN LANES SHALL BE DONE PER NIGHTTIME ALLOWABLE HOURS. WORK ACTIVITY ENCROACHING ONTO LIVE LANES IS STRICTLY PROHIBITED.

TAPER LENGTH CALCULATIONS

WESTBOUND I-290 LANE SHIFT
I-290 SPEED LIMIT = 55 MPH
SHIFTING TAPER = 55:1
SHIFT DISTANCE = 5'
TAPER LENGTH (L) = 5*55 = 275'

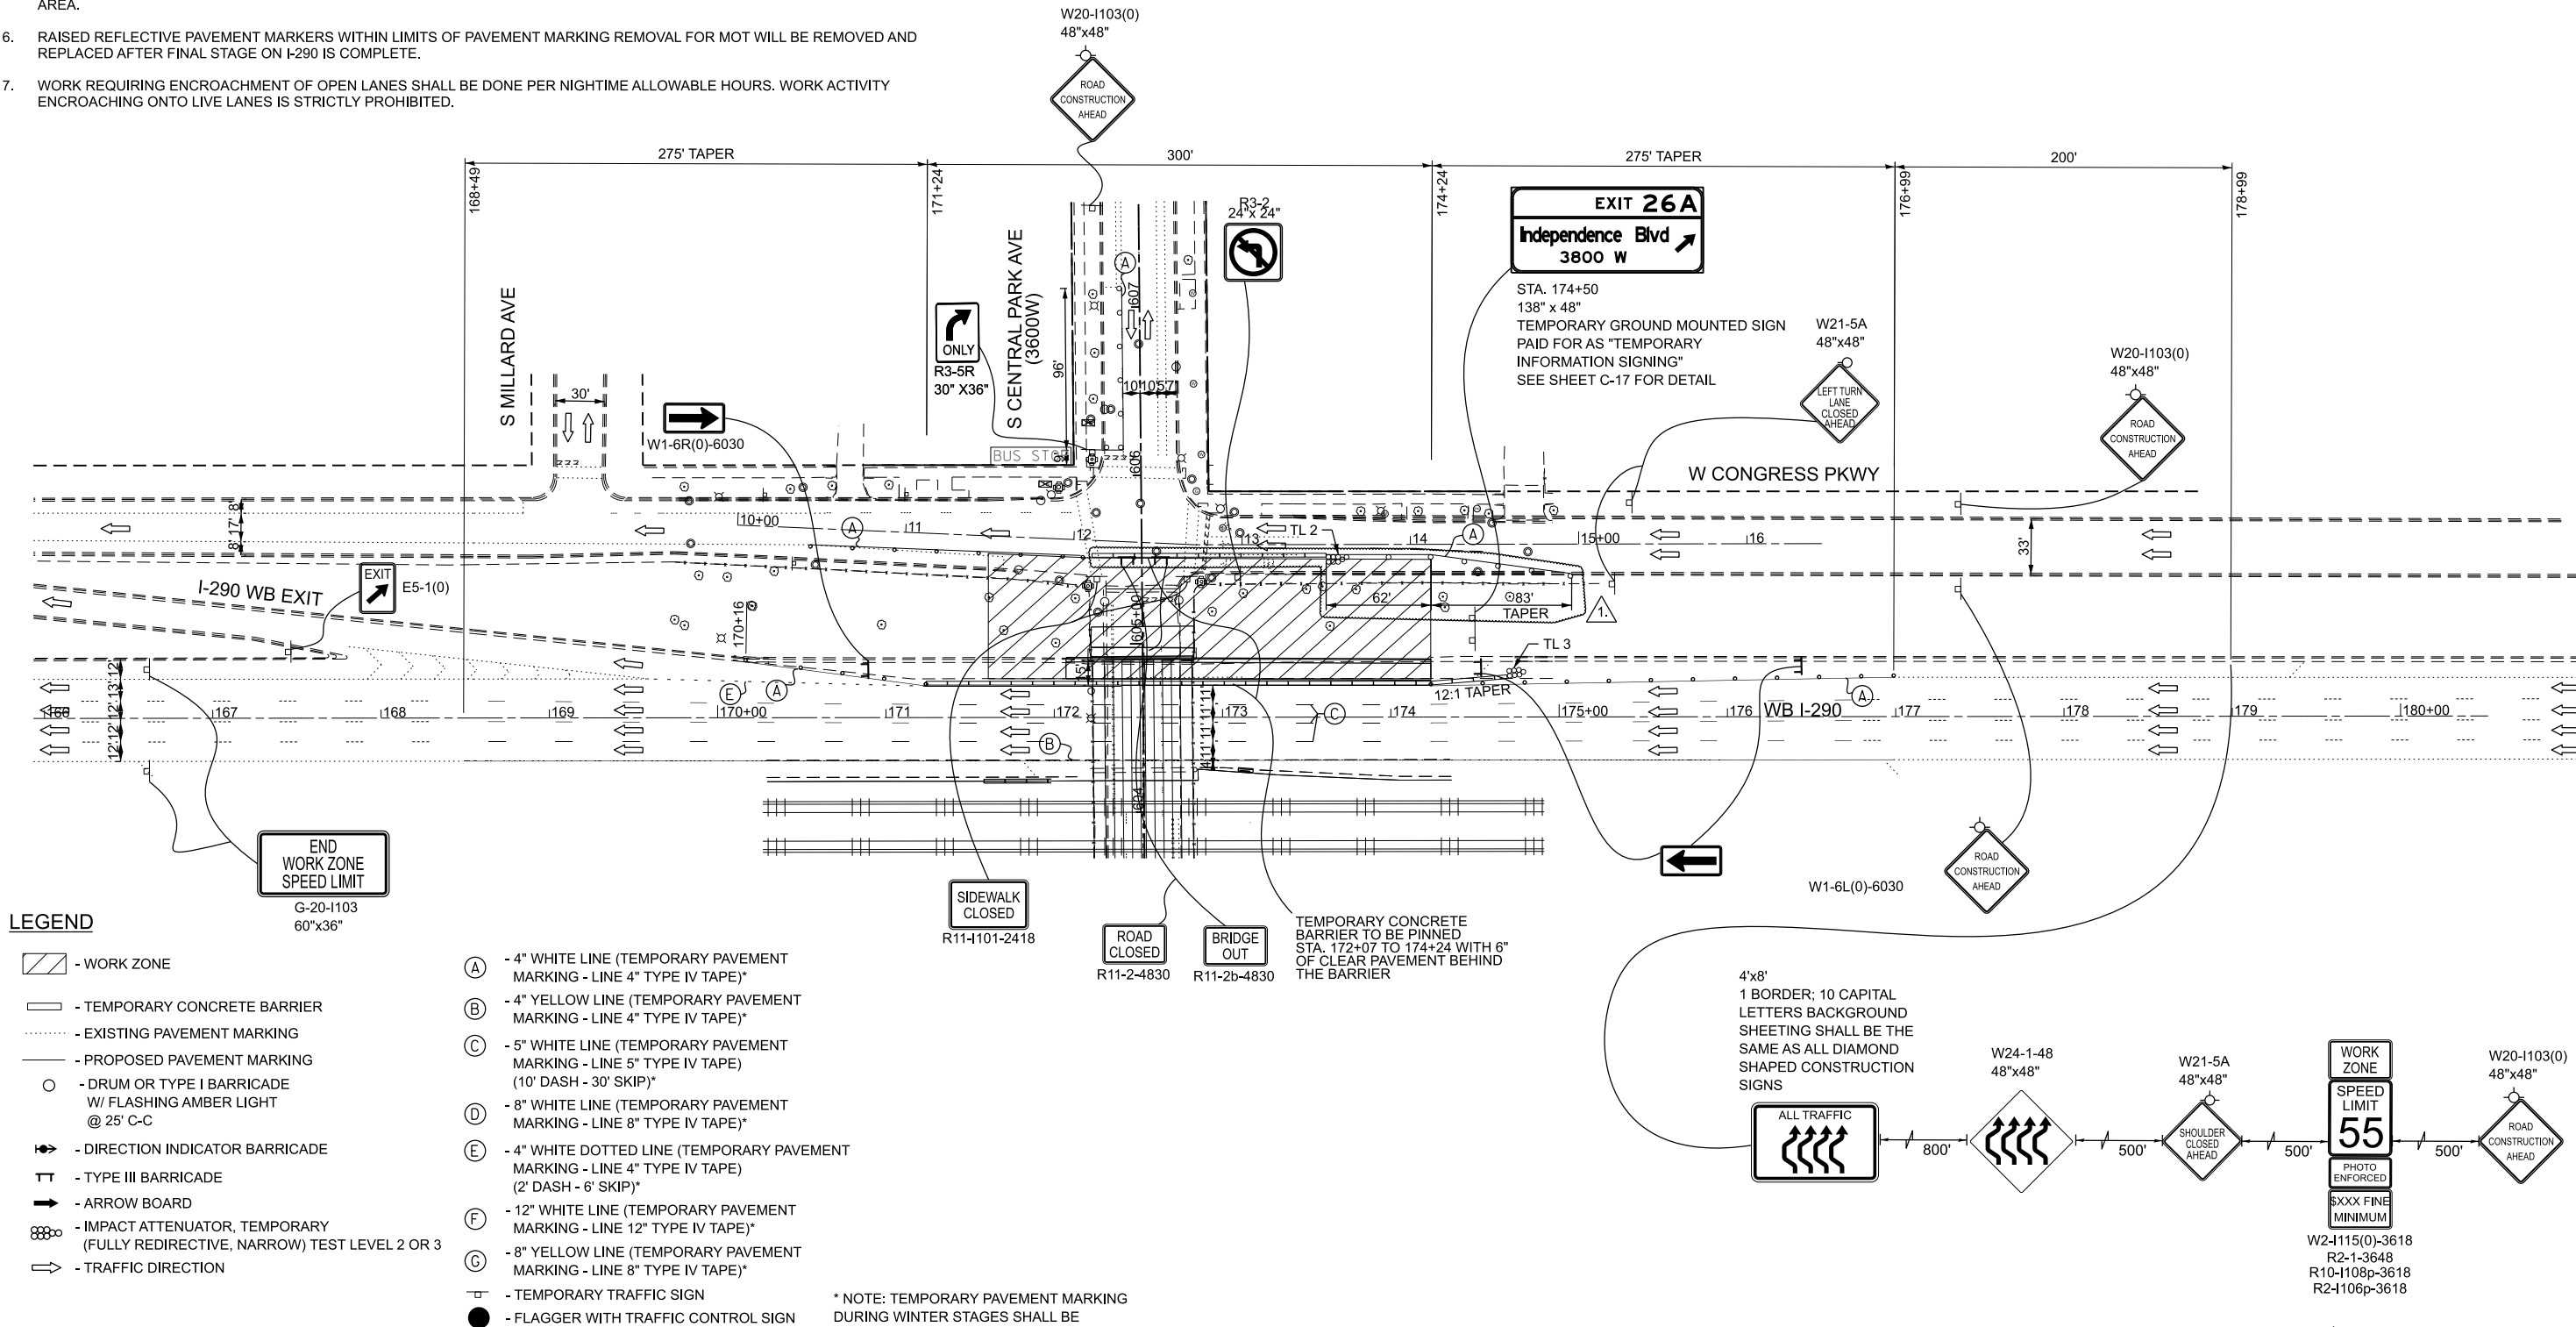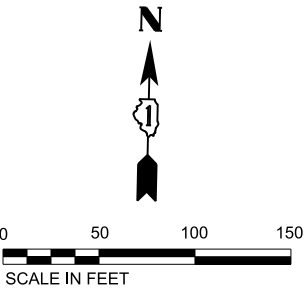

LEGEND

- WORK ZONE
- TEMPORARY CONCRETE BARRIER
- EXISTING PAVEMENT MARKING
- PROPOSED PAVEMENT MARKING
- DRUM OR TYPE I BARRICADE
W/ FLASHING AMBER LIGHT
@ 25' C-C
- DIRECTION INDICATOR BARRICADE
- TYPE III BARRICADE
- ARROW BOARD
- IMPACT ATTENUATOR, TEMPORARY
(FULLY REDIRECTIVE, NARROW) TEST LEVEL 2 OR 3
- TRAFFIC DIRECTION
- (A) - 4" WHITE LINE (TEMPORARY PAVEMENT MARKING - LINE 4" TYPE IV TAPE)*
- (B) - 4" YELLOW LINE (TEMPORARY PAVEMENT MARKING - LINE 4" TYPE IV TAPE)*
- (C) - 5" WHITE LINE (TEMPORARY PAVEMENT MARKING - LINE 5" TYPE IV TAPE)
(10' DASH - 30' SKIP)*
- (D) - 8" WHITE LINE (TEMPORARY PAVEMENT MARKING - LINE 8" TYPE IV TAPE)*
- (E) - 4" WHITE DOTTED LINE (TEMPORARY PAVEMENT MARKING - LINE 4" TYPE IV TAPE)
(2' DASH - 6' SKIP)*
- (F) - 12" WHITE LINE (TEMPORARY PAVEMENT MARKING - LINE 12" TYPE IV TAPE)*
- (G) - 8" YELLOW LINE (TEMPORARY PAVEMENT MARKING - LINE 8" TYPE IV TAPE)*
- TEMPORARY TRAFFIC SIGN
- FLAGGER WITH TRAFFIC CONTROL SIGN

* NOTE: TEMPORARY PAVEMENT MARKING DURING WINTER STAGES SHALL BE MODIFIED URETHANE.

 DB STERLIN CONSULTANTS, INC. 123 N. Wacker Drive, Suite 2000 Chicago, Illinois 60606 312.857.1006	USER NAME = icsM-dbstepw21\$	DESIGNED - DDC	REVISED -  12/19/2025 HJM	STATE OF ILLINOIS DEPARTMENT OF TRANSPORTATION	MAINTENANCE OF TRAFFIC STAGE 1 - WESTBOUND I-290 AT CENTRAL PARK AVE	F.A.I. RTE	SECTION	COUNTY	TOTAL SHEETS	SHEET NO.
	PLOT SCALE = 100,000' / in.	DRAWN - JH	REVISED -			290	2019-189-BR	COOK	250	49
	PLOT DATE = 12/15/2025	CHECKED - HJM	REVISED -			CONTRACT NO. 62K62				
	PLOT TIME = 9:57:19 PM	DATE -	REVISED -			SCALE:	SHEET NO. C-25 OF C-102 SHEETS	STA. 00+000 TO STA. 00+000	ILLINOIS FED. AID PROJECT	

1 REVISED SHEET 1/2/2026

FILE NAME: \\casM-dbsstepw21\GIS_pdf_work_dir\10475424_460D162K62-eh-dmschedule-01.dgn

PROPOSED DRAINAGE STRUCTURE SCHEDULE

STR I.D.	STATION (FEET)	OFFSET (FEET)	ALIGNMENT	RIM (ELEV)	N - INV (ELEV)	S - INV (ELEV)	E - INV (ELEV)	W - INV (ELEV)	CATCHBASINS, TYPE A, 4'-DIAMETER, TYPE 1 FRAME, OPEN LID (CITY OF CHICAGO) (EACH)	CATCHBASINS, TYPE-A, 4'-DIAMETER, TYPE 3 FRAME AND GRATE (EACH)	CATCHBASINS, TYPE B TYPE 8 GRATE (EACH)
S-01	02+88.6	11.8 LT	W. HARRISON ST	600.06	-	589.74	-	-	1	-	-
S-02	03+91.5	20.6 LT	W. HARRISON ST	599.74	-	585.41	-	-	1	-	-
S-03	12+81.5	16.0 RT	W. CONGRESS PRKW	600.26	585.61	-	-	-	1	-	-
S-04	173+27.4	44.5 LT	I-290 WESTBOUND	583.50	-	EXIST*	-	-	-	-	1
S-05	173+32.0	33.8 LT	I-290 WESTBOUND	581.84	-	EXIST*	-	-	-	1	-
S-06	173+58.0	32.9 LT	I-290 WESTBOUND	581.82	-	-	-	EXIST*	-	1	-
S-07	172+11.1	38.5 RT	I-290 EASTBOUND	584.40	-	-	-	579.66*	-	-	1
TOTAL:									3	2	2

* VERIFY AND MATCH EXISTING INVERT ELEV

PROPOSED DRAINAGE PIPE SCHEDULE

PIPE I.D.	UPSTREAM STRUCTURE	DOWNSTREAM STRUCTURE	UPSTREAM INVERT (ELEV)	DOWNSTREAM INVERT (ELEV)	PIPE DIA (IN)	PIPE LENGTH (FOOT)	PIPE SLOPE (%)	STORM SEW, DUCTILE IRON PIPE, TYPE 2, 8 INCH (FOOT)	TRENCH BACKFILL (CUYD)
P-01	S-01	EX 15" PIPE	592.57	592.40**	8	9	2.0	9	6.0
P-02	S-02	EX 24" PIPE	587.91	587.48**	8	22	2.0	22	14.7
P-03	S-03	EX 15" PIPE	588.44	588.19**	8	12	2.0	12	8.0
TOTAL:									28.7

** VERIFY DOWNSTREAM STRUCTURE TIE IN ELEV

EXISTING DRAINAGE STRUCTURE SCHEDULE

STATION (FEET)	OFFSET (FEET)	ALIGNMENT	CATCH BASINS TO BE ADJUSTED (EACH)	REMOVING CATCH BASINS (EACH)	REMOVING MANHOLES (EACH)	CATCH BASINS TO BE CLEANED (EACH)
602+12.0	00.0 LT	CENTRAL PARK	1	-	-	1
602+23.8	17.5 RT	CENTRAL PARK	1	-	-	1
602+55.0	00.6 LT	CENTRAL PARK	-	-	1	-
602+58.0	22.2 LT	CENTRAL PARK	-	1	-	-
602+59.0	21.8 RT	CENTRAL PARK	-	1	-	-
605+25.1	22.3 LT	CENTRAL PARK	-	1	-	-
605+25.6	21.8 RT	CENTRAL PARK	-	1	-	-
605+39.3	45.3 LT	CENTRAL PARK	1	-	-	1
605+44.5	73.3 LT	CENTRAL PARK	1	-	-	1
605+55.0	10.3 RT	CENTRAL PARK	1	-	-	1
605+83.3	00.5 LT	CENTRAL PARK	1	-	-	1
605+85.6	59.7 LT	CENTRAL PARK	1	-	-	1
173+27.4	44.5 LT	I-290 WESTBOUND	-	1	-	-
173+32.0	33.8 LT	I-290 WESTBOUND	-	1	-	-
173+58.0	32.9 LT	I-290 WESTBOUND	-	1	-	-
171+35.3	32.8 RT	I-290 EASTBOUND	-	1	-	-
172+11.1	38.5 RT	I-290 EASTBOUND	1	-	-	1
TOTAL:			8	8	1	8

EXISTING DRAINAGE PIPE SCHEDULE

FROM STATION (FEET)	FROM OFFSET (FEET)	TO STATION (FEET)	TO OFFSET (FEET)	ALIGNMENT	STORM SEWER REMOVAL 12" (FOOT)	STORM SEWER REMOVAL 15" (FOOT)	TRENCH BACKFILL (CUYD)
602+58.0	22.2 LT	602+49.5	00.6 LT	CENTRAL PARK	23	-	11.0
602+59.0	21.8 RT	602+49.5	00.6 LT	CENTRAL PARK	23	-	11.0
602+55.0	00.6 LT	602+12.0	00.0 RT	CENTRAL PARK	-	43	24.4
605+25.1	22.3 LT	605+83.3	00.5 LT	CENTRAL PARK	62	-	30.0
605+25.6	21.8 RT	605+55.0	22.0 RT	CENTRAL PARK	30	-	14.6
172+88.4	51.6 LT	173+29.7	34.8 LT	I-290 W.B.	45	-	13.5
172+86.3	55.3 RT	173+33.0	33.5 RT	I-290 E.B.	52	-	15.5
TOTAL:					235	43	120.0

PIPE UNDERDRAINS, TYPE 2, 6" SCHEDULE

LOCATION	FROM STATION (FEET)	FROM OFFSET (FEET)	TO STATION (FEET)	TO OFFSET (FEET)	PIPE UNDERDRAINS, TYPE 2, 6" (FOOT)
I-290 WB NORTH	172+06.99	23.99 LT	173+58.02	23.77 LT	151.0
I-290 WB NORTH	173+58.02	23.77 LT	173+58.02	31.19 LT	7.4
I-290 WB NORTH	174+23.81	23.77 LT	173+58.02	23.77 LT	65.8
I-290 WB SOUTH	173+13.57	25.76 RT	174+01.26	25.76 RT	87.7
I-290 EB NORTH	172+12.52	20.30 LT	172+96.38	20.29 LT	83.9
I-290 EB SOUTH	171+64.70	31.69 RT	173+26.44	27.55 RT	191.2

1. REVISED SHEET 1/2/2026





USER NAME =	icsM-dbsstepw21\$	DESIGNED -	SN	REVISED -	1. 12/19/2025 KRW
PLOT SCALE =	0.16666667' / in.	DRAWN -	SN	REVISED -	
PLOT DATE =	12/19/2025	CHECKED -	KRW	REVISED -	
PLOT TIME =	5:10:43 PM	DATE -		REVISED -	

STATE OF ILLINOIS
DEPARTMENT OF TRANSPORTATION

DRAINAGE SCHEDULES


SCALE: NTS SHEET NO. C-54 OF C-102 SHEETS STA. 00+000 TO STA. 00+000

F.A.I. RTE	SECTION	COUNTY	TOTAL SHEETS	SHEET NO.
290	2019-189-BR	COOK	250	78
CONTRACT NO. 62K62				
		ILLINOIS	FED. AID PROJECT	

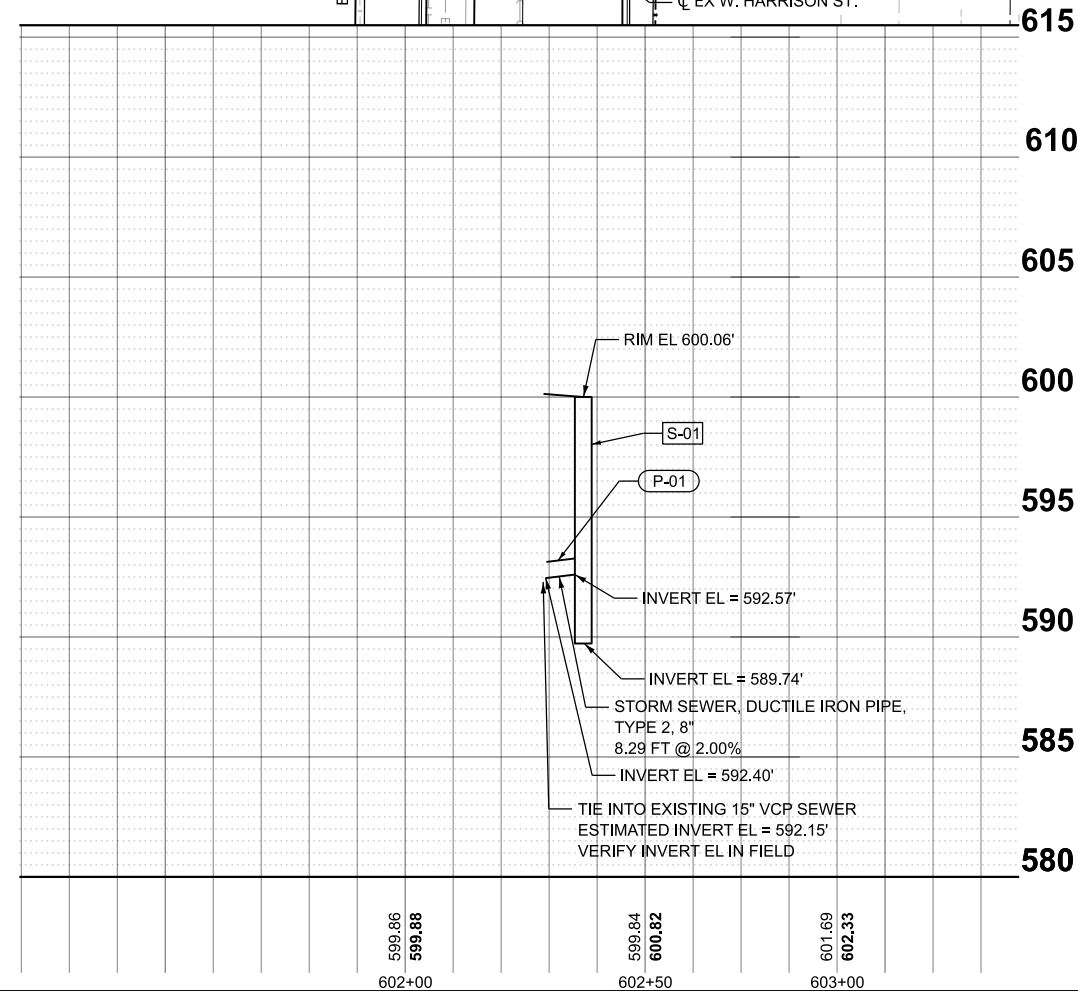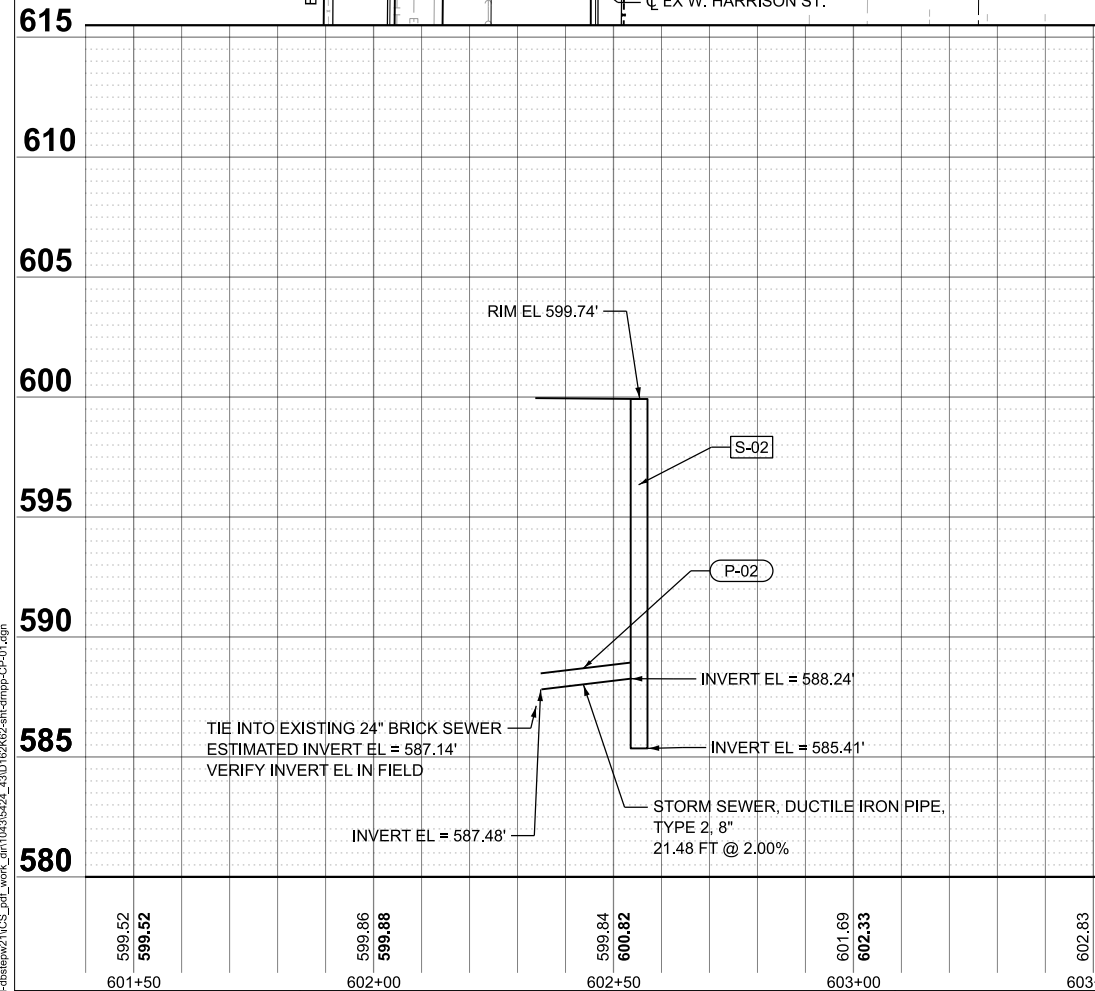


1. CUT AND CAP EXISTING WATER MAIN FOR WING WALL CONSTRUCTION, SEE WATER MAIN PLAN AND STRUCTURAL SHEETS FOR DETAILS. SEE REMOVAL PLAN FOR LIMITS OF REMOVAL.

FILE NAME: \\cam-dbsstepw21\GIS_pdfs\work_dfr\104315424_4\MD162K62-ah-dmnp-CP-02.dgn

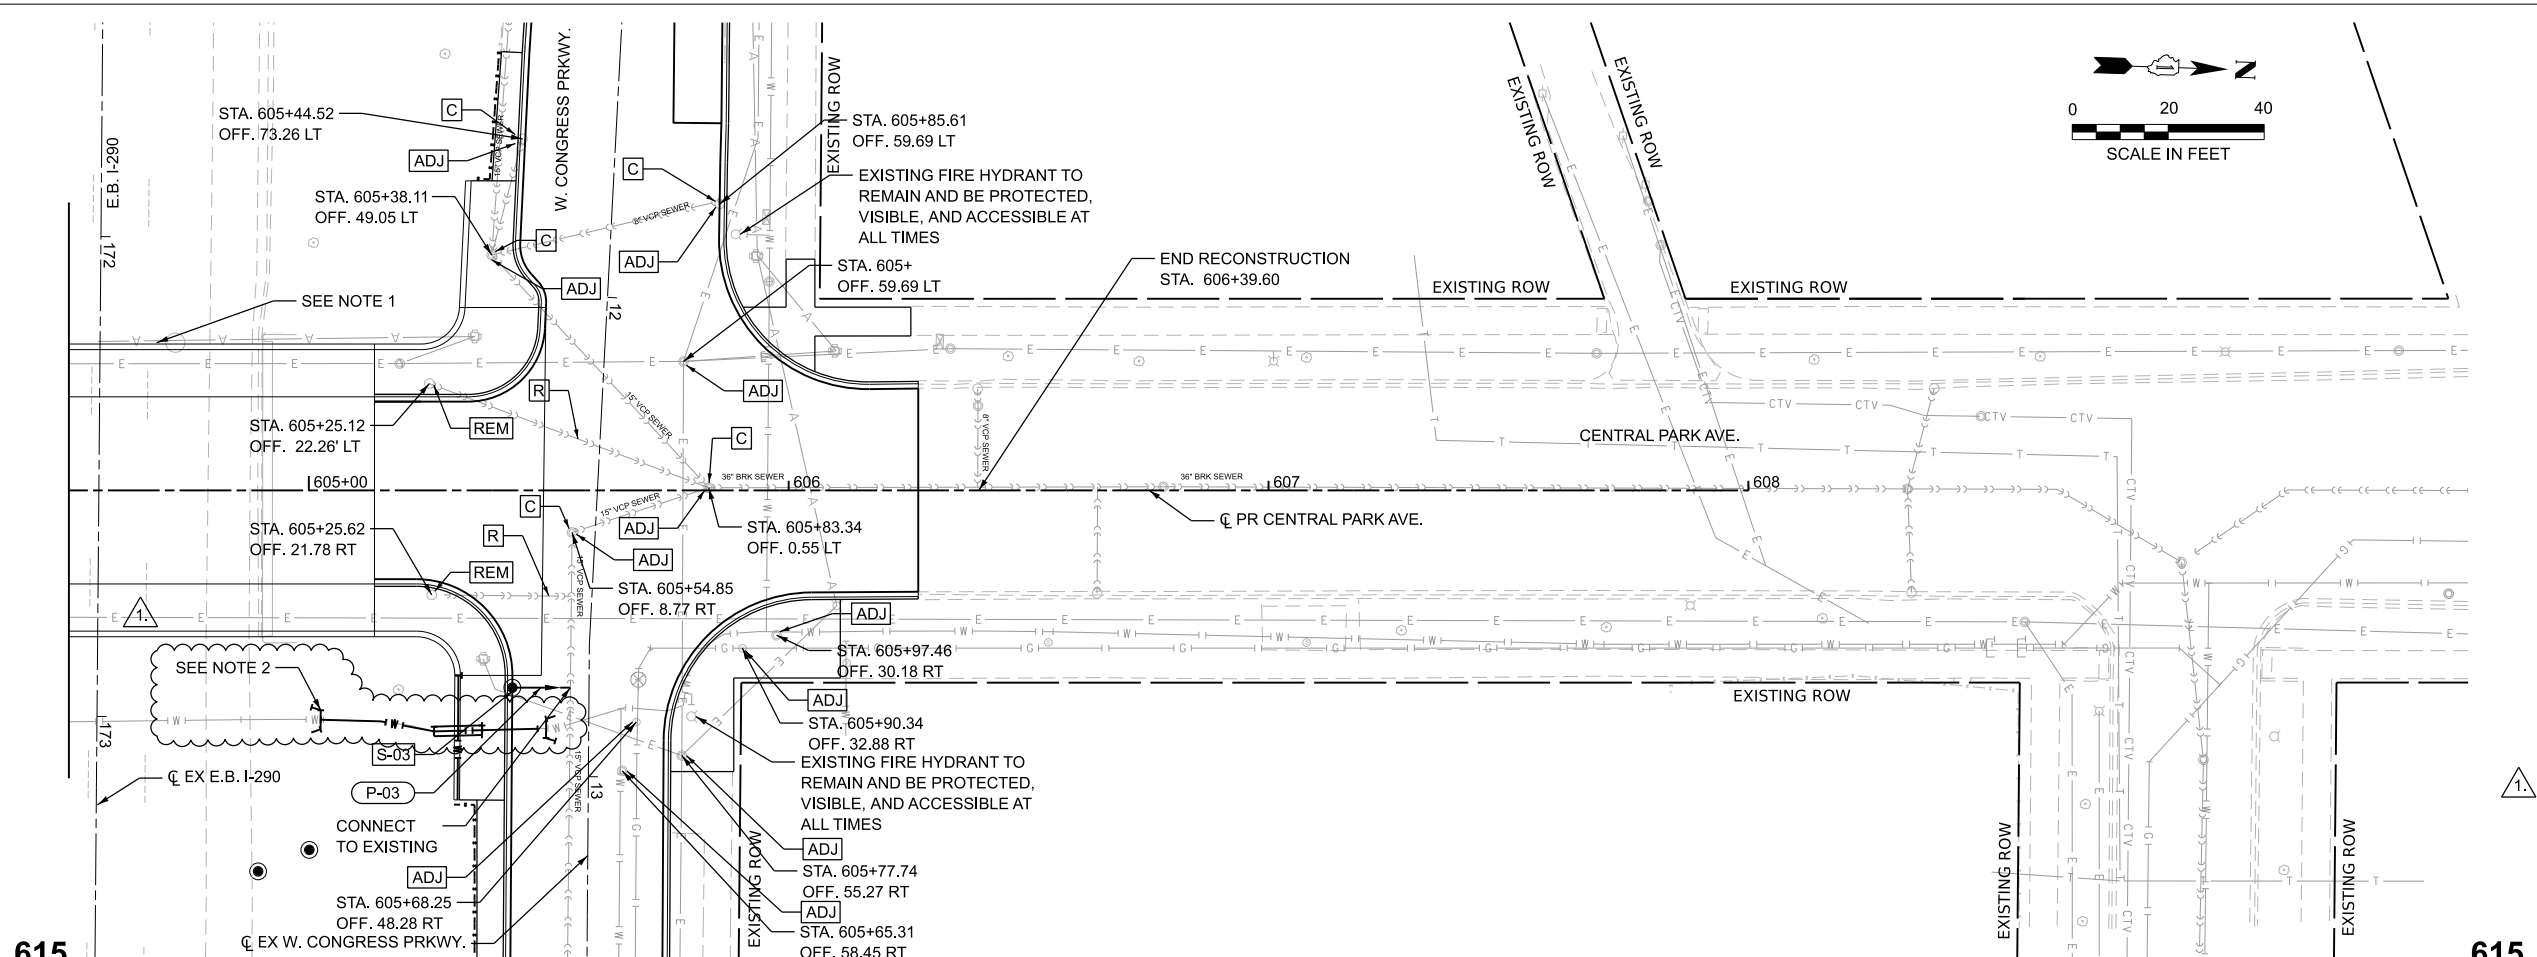

- DRAINAGE LEGEND**
- PROPOSED MANHOLE
 - PROPOSED CATCH BASIN
 - PROPOSED PIPE
 - PROPOSED PIPE UNDERDRAIN
 - [S-01] PROPOSED STRUCTURE I.D.
 - [P-02] PROPOSED PIPE I.D.
 - [ADJ] ADJUST EXISTING STRUCTURE
 - [REM] REMOVE EXISTING STRUCTURE
 - [C] CLEAN EXISTING STRUCTURE
 - [R] REMOVE EXISTING PIPE

- NOTES**
1. THE CONTRACTOR SHALL COORDINATE THE INSTALLATION OF THE NEW LICENSE PLATE READER (LPR), CONDUIT, CABLE, AND ASSOCIATED HARDWARE AND APPURTENANCES WITH THE ILLINOIS STATE POLICE (ISP) CONTRACTOR. THE INSTALLATION OF NEW ISP EQUIPMENT SHALL BE COORDINATED WITH THE STAGED BRIDGE REPLACEMENT AND ACCESS GATE INSTALLATION.
 2. CUT AND CAP EXISTING WATER MAIN FOR WING WALL CONSTRUCTION, SEE WATER MAIN PLAN AND STRUCTURAL SHEETS FOR DETAILS. SEE REMOVAL PLAN FOR LIMITS OF REMOVAL.

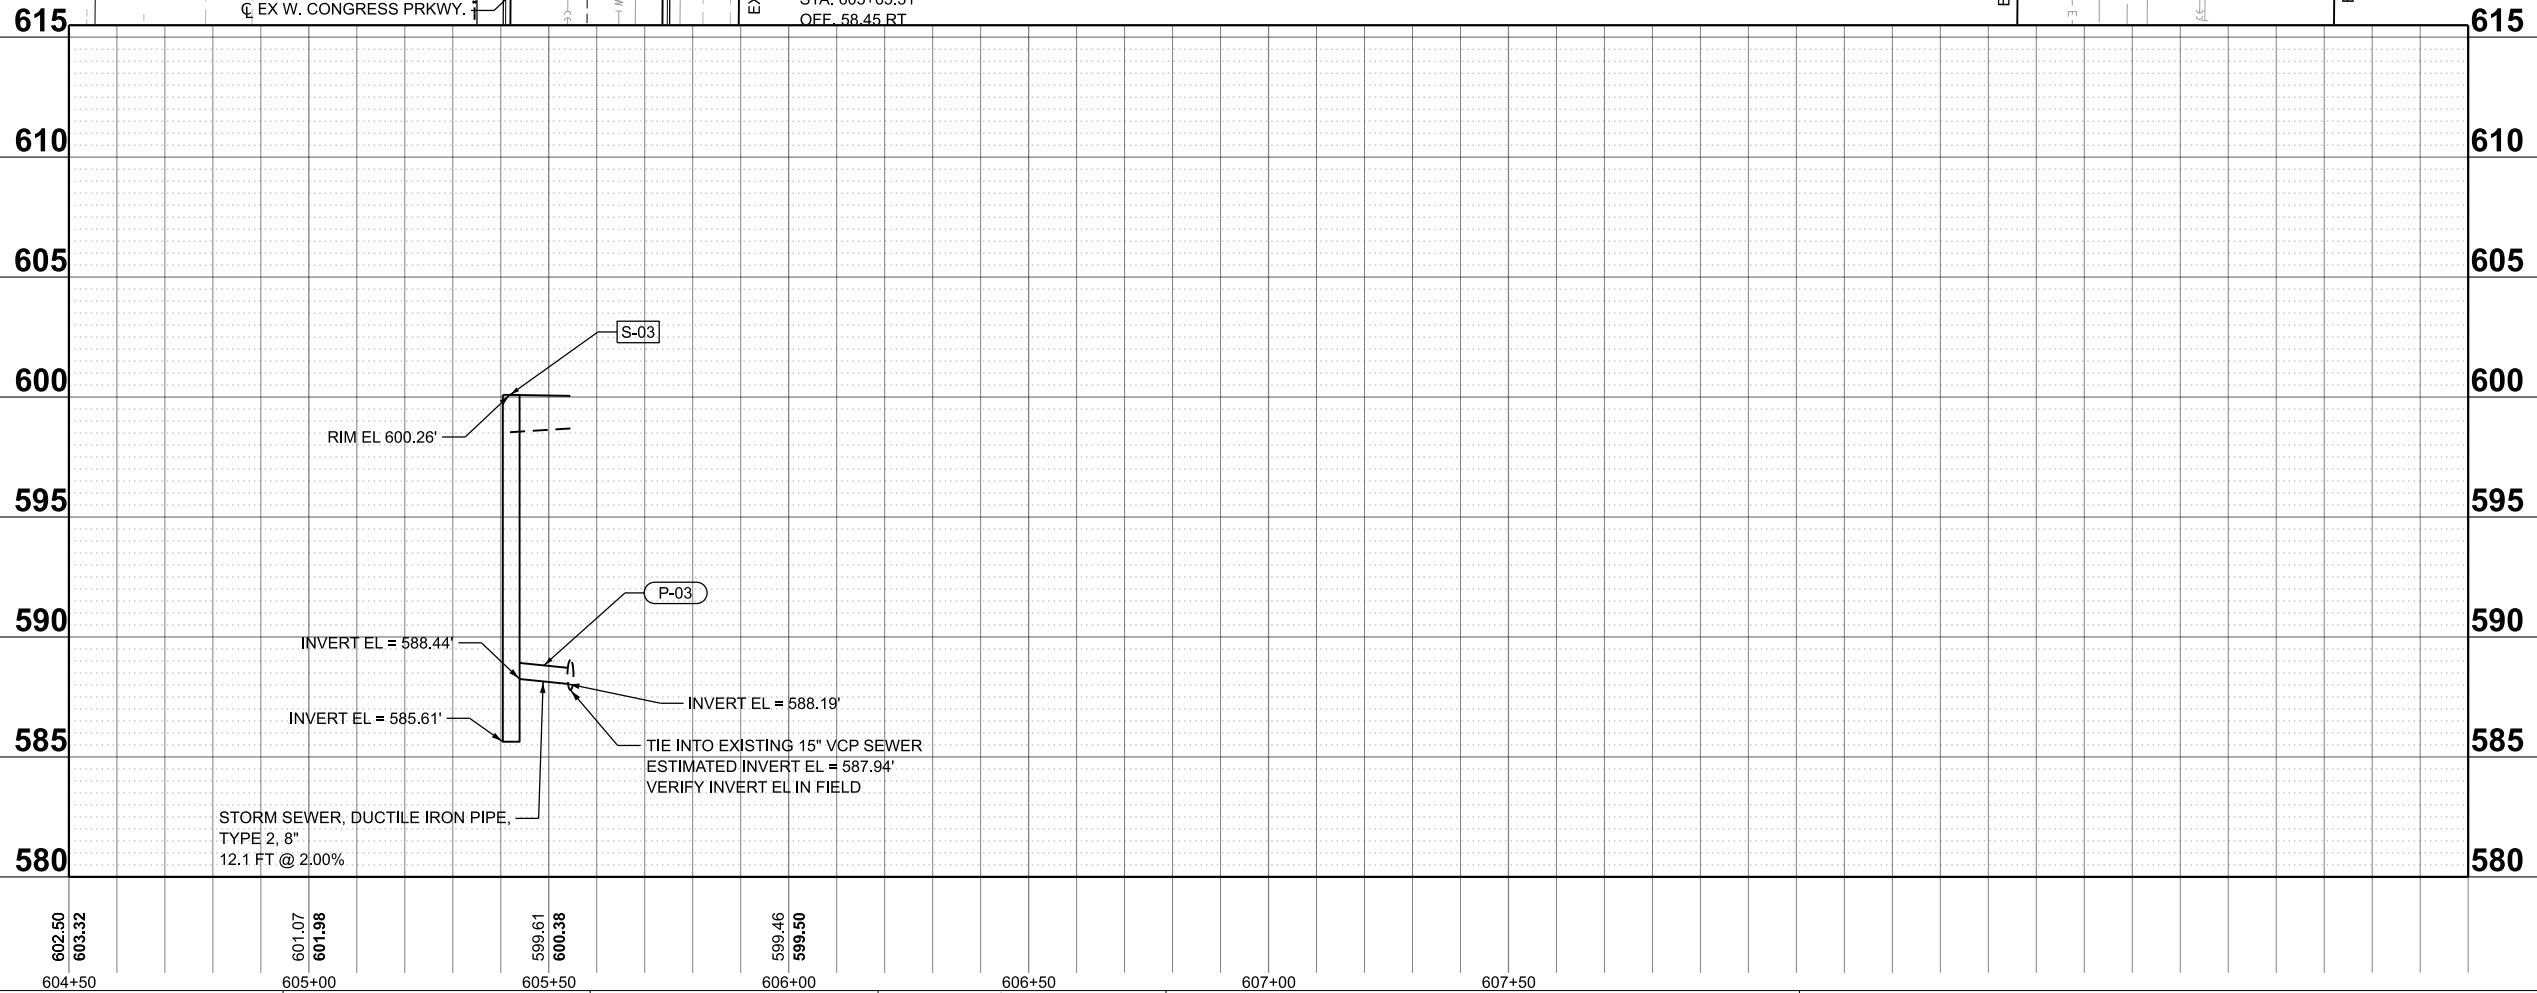

Jacobs

USER NAME = jcsM-dbsstepw215	DESIGNED - SN	REVISED -  12/19/2025 KRW
PLOT SCALE = 0.16666667' / in.	DRAWN - SN	REVISED -
PLOT DATE = 12/19/2025	CHECKED - KRW	REVISED -
PLOT TIME = 3:20:37 PM	DATE -	REVISED -

STATE OF ILLINOIS
DEPARTMENT OF TRANSPORTATION

DRAINAGE AND UTILITY PLAN AND PROFILE CENTRAL PARK AVENUE @ W CONGRESS PARKWAY		
SCALE: 1" = 20'	SHEET NO. C-56 OF C-102 SHEETS	STA. 604+50.00 TO STA. END

F.A.I. RTE	SECTION	COUNTY	TOTAL SHEETS	SHEET NO.
290	2019-189-BR	COOK	250	80
		CONTRACT NO. 62K62		
		ILLINOIS	FED. AID PROJECT	

FILE NAME: \\casM-dbsstepw21\CS_pwf_work_gf\10415424_510162K62-ah-dmplan-I-290-01.dgn




USER NAME	=	icsM-dbsstepw21\$	DESIGNED	-	SN	REVISED	-	12/19/2025	KRW
PLOT SCALE	=	0.16666667' / 1"	DRAWN	-	SN	REVISED	-		
PLOT DATE	=	12/19/2025	CHECKED	-	KRW	REVISED	-		
PLOT TIME	=	2:44:24 PM	DATE	-		REVISED	-		

STATE OF ILLINOIS
DEPARTMENT OF TRANSPORTATION



DRAINAGE AND UTILITY PLAN - I-290

SCALE: 1" = 20' SHEET NO. C-57 OF C-102 SHEETS STA. 00+00 TO STA. 00+000

F.A.I. RTE.	SECTION	COUNTY	TOTAL SHEETS	SHEET NO.
290	2019-189-BR	COOK	250	81
CONTRACT NO. 62K62				
ILLINOIS FED. AID PROJECT				

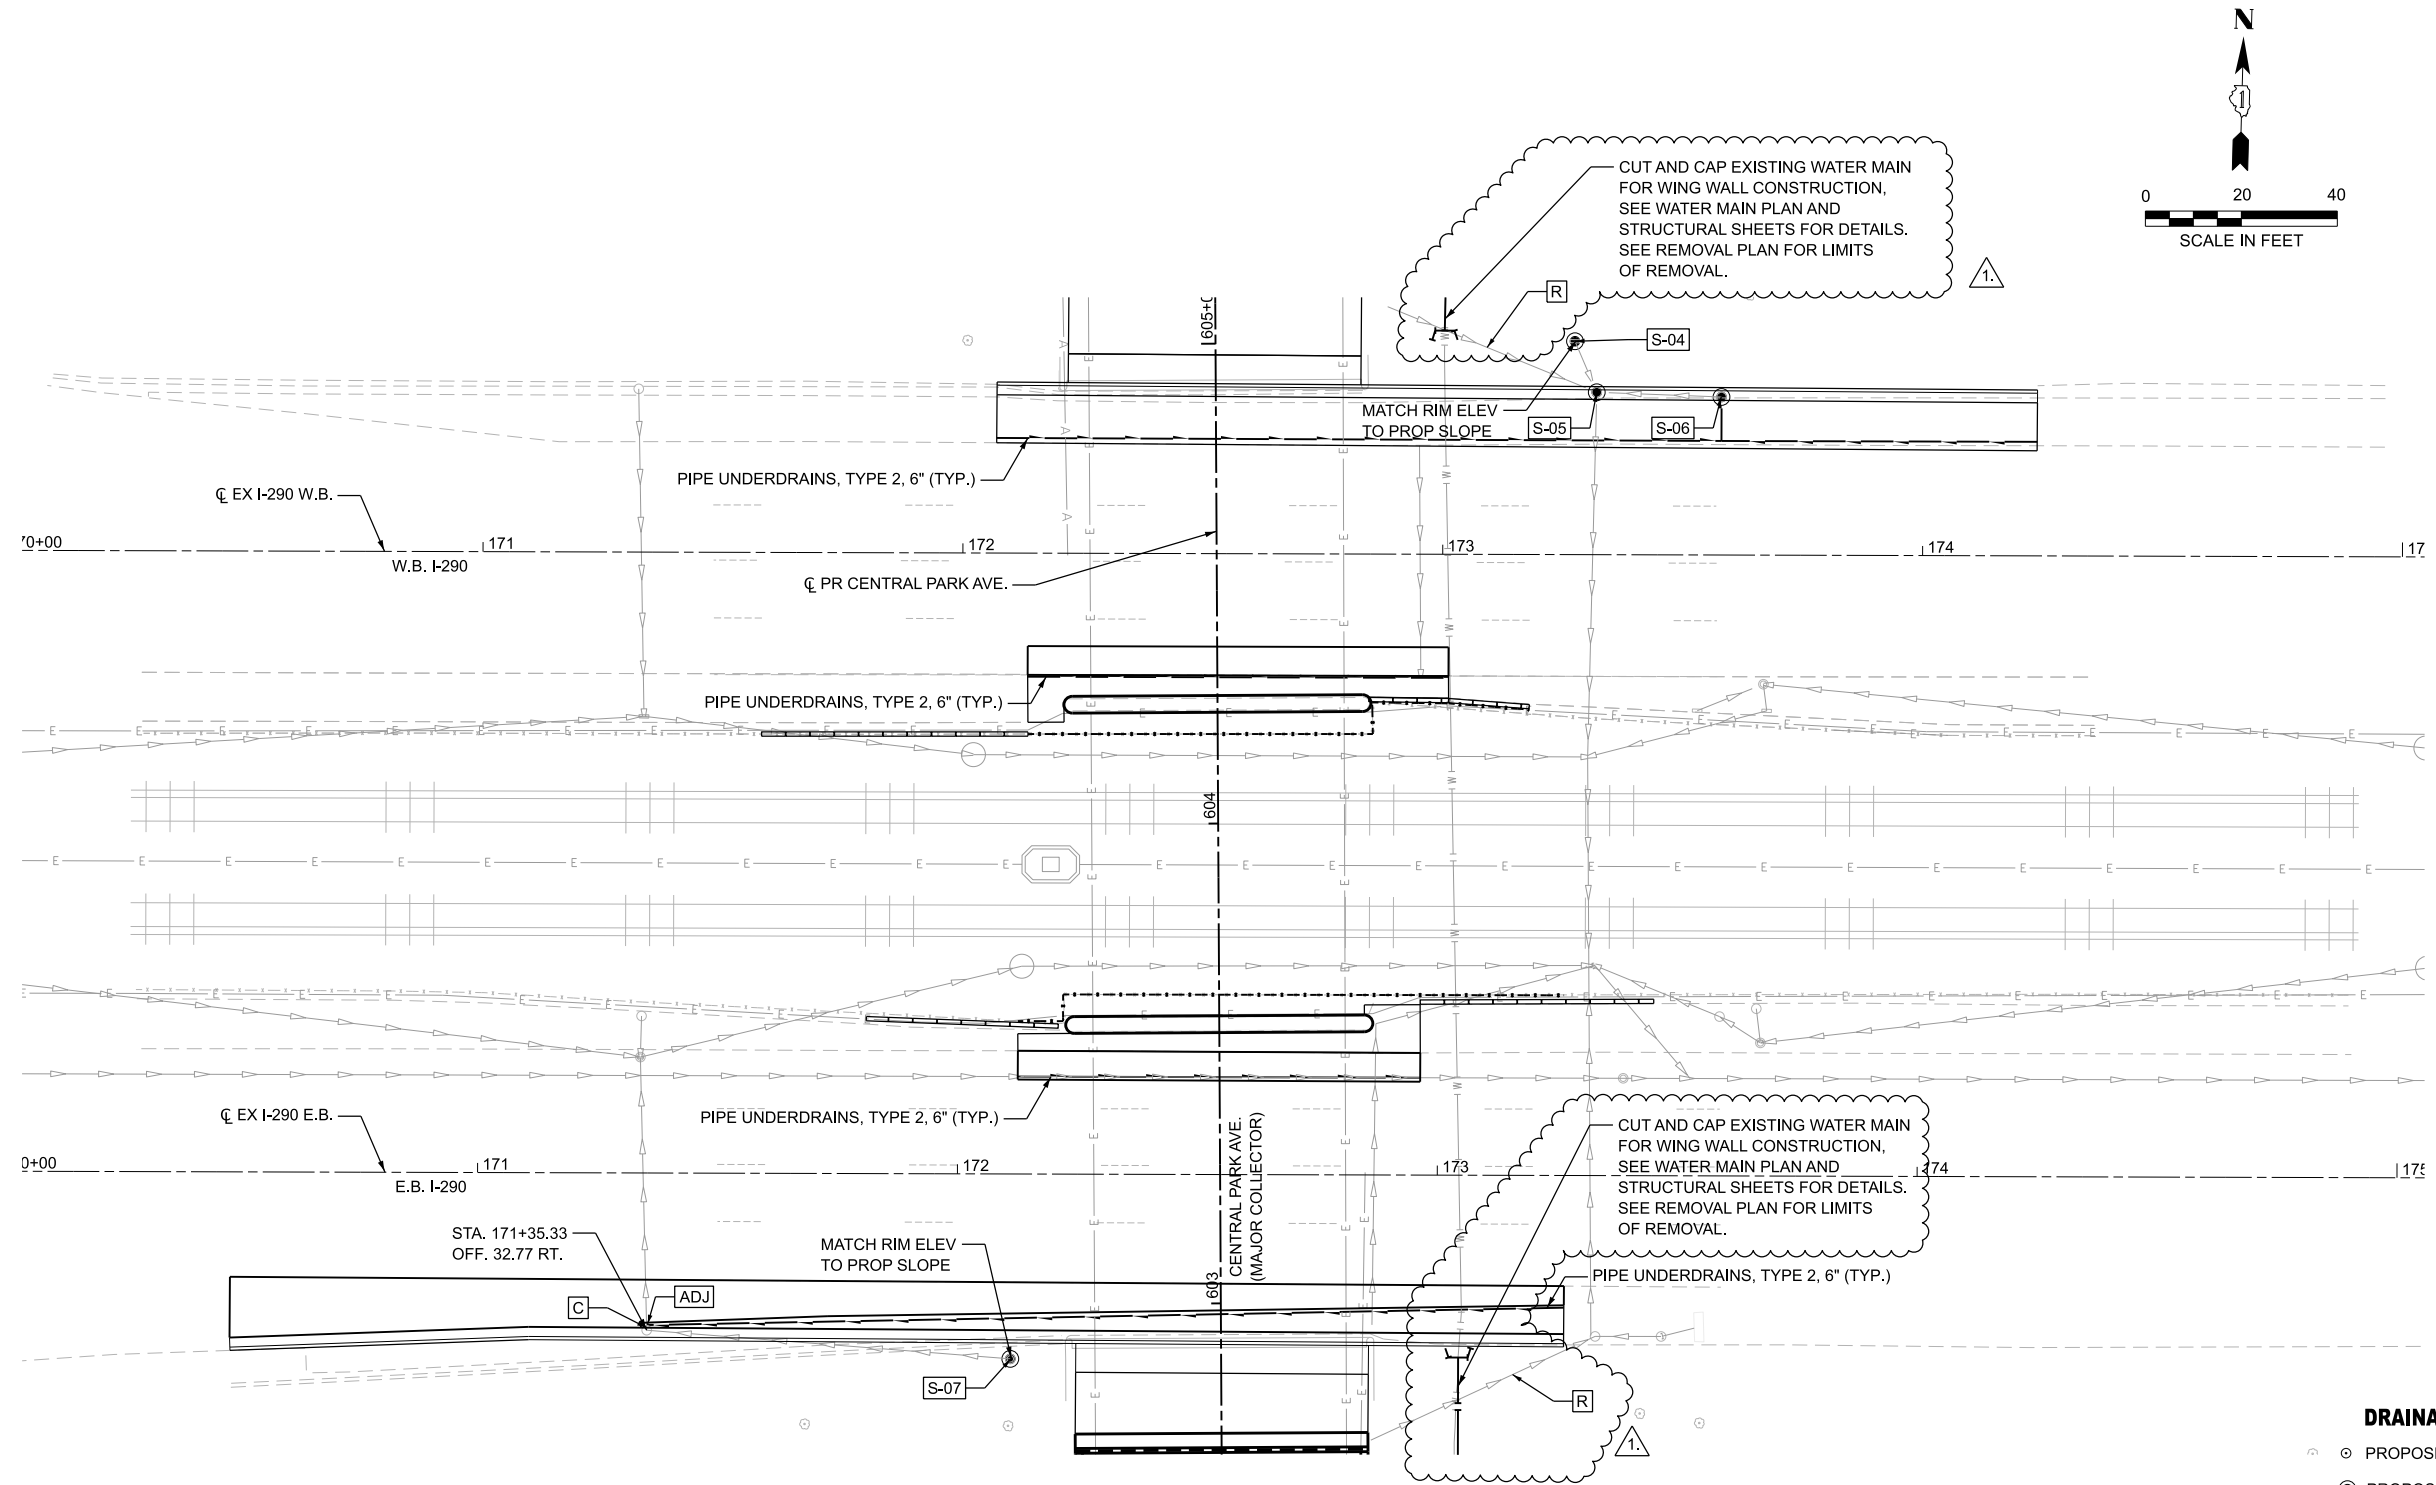

1. REVISED SHEET 1/2/2026

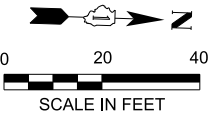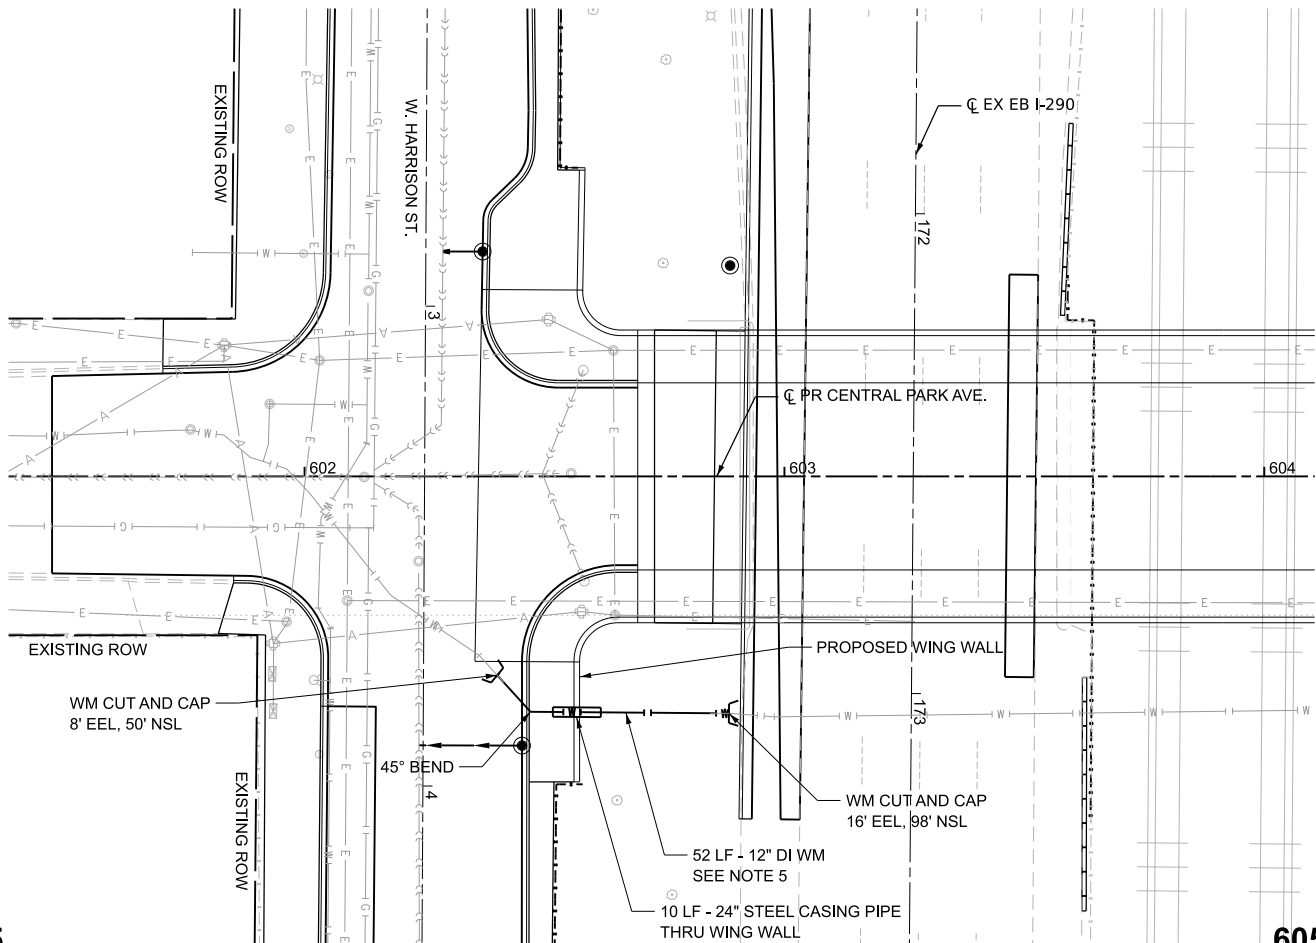


WATER MAIN LEGEND


- WM CUT AND CAP
- PROPOSED WATER MAIN

NOTES

- NOTATION "EEL" REFERS TO "EAST OF THE EAST ROW LINE". "NSL" REFERS TO "NORTH OF THE SOUTH ROW LINE". (TYPICAL CDWM WATER NOTATION)
- BEFORE WING WALL CONSTRUCTION, CUT, CAP, AND BRACE THE EXISTING 12" WATER MAIN TO THE SOUTH AT 8' EEL, 50' NSL AND TO THE NORTH AT 16' EEL, 98' NSL.
- AFTER WING WALL CONSTRUCTION, REMOVE THE TEMPORARY CAPS AND PLUG AND RECONNECT THE EXISTING 12" CI WATER MAIN TO THE SOUTH AND NORTH WITH:
 - 2 - 12" MJ SLEEVES
 - 52 L.F. OF 12" DI WATER MAIN PIPE (5610330)
 - 1 - HORIZONTAL 45° BEND (56109424)
 - 2 - VERTICAL 90° BENDS (56109438)
 - 1 - VERTICAL 45° BEND (56109424)
 - 1 - VERTICAL 22.5° BEND (56109412)
 - 10 L.F. OF 24" STEEL CASING PIPE THRU WING WALL (Z0067900)
- THE PROPOSED WATER MAIN MUST HAVE AT LEAST 5' DEPTH OF COVER.
- ALL BENDS IN THE DI WATER MAIN SHALL UTILIZE CDWM STANDARD THRUST BLOCKS. COST INCLUDED IN DUCTILE IRON WATER MAIN 12".
- SEE SPECIAL PROVISIONS FOR CDWM WATER REQUIREMENTS.

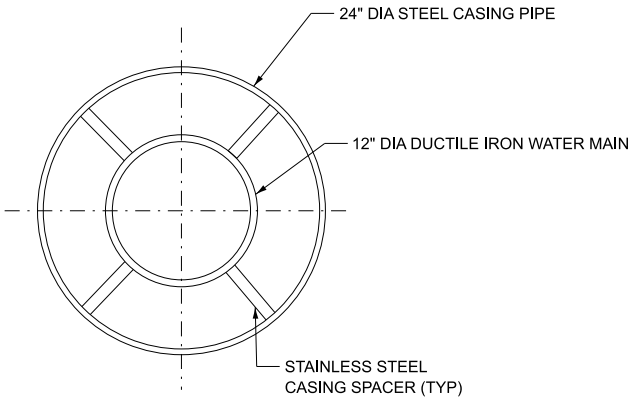

CASING PIPE DETAIL

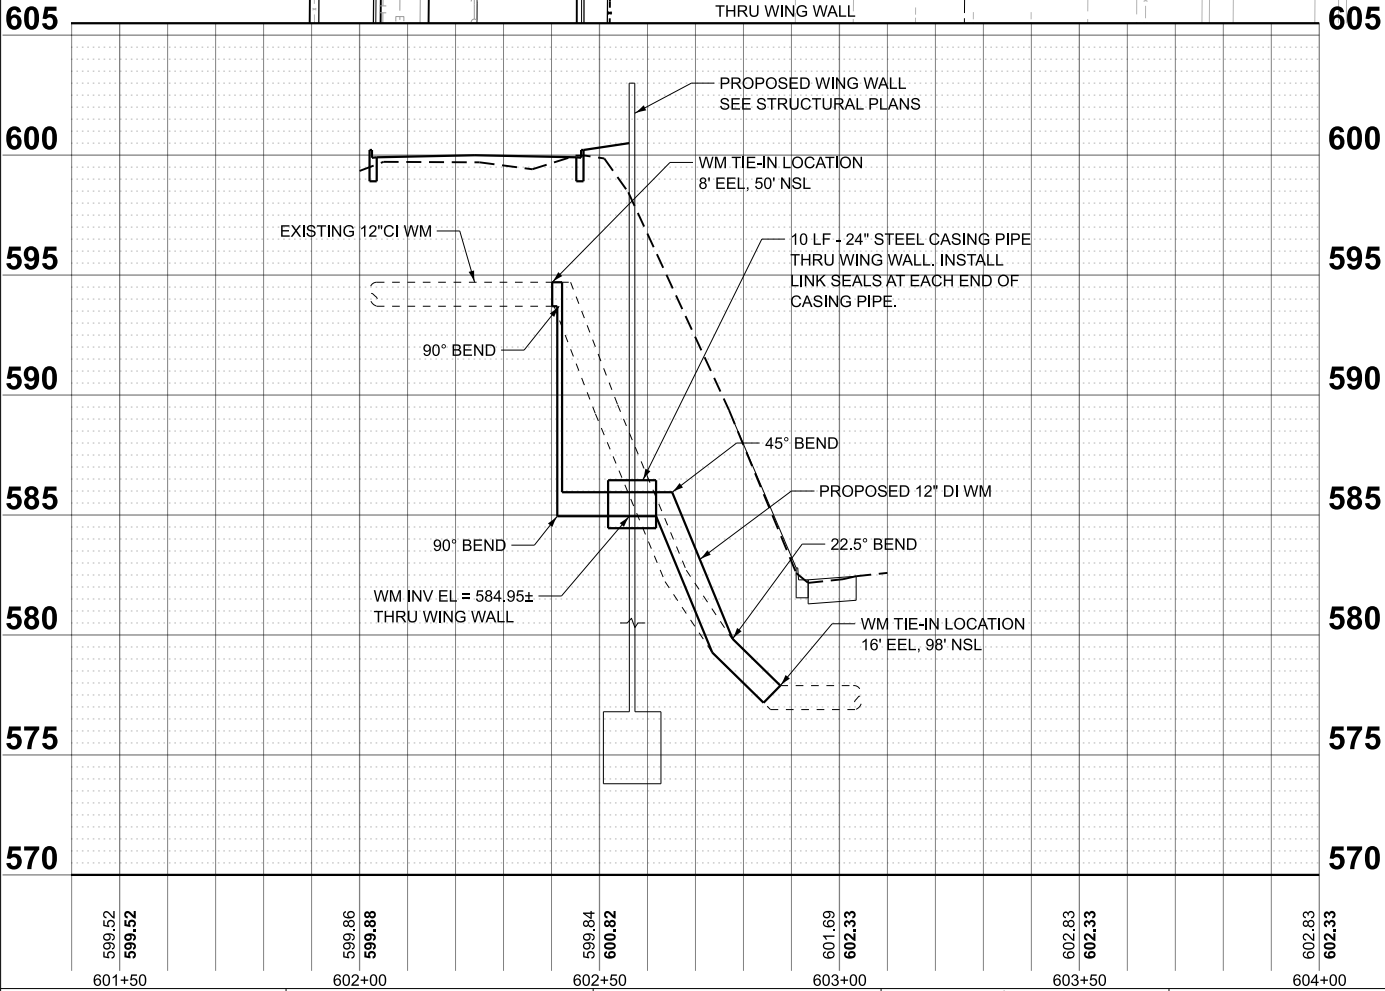

USER NAME =	icsM-dstepw215	DESIGNED -	HJM	REVISED -	12/19/2025	HJM
PLOT SCALE =	0.166667' / in.	DRAWN -	DJB	REVISED -		
PLOT DATE =	12/23/2025	CHECKED -	HJM	REVISED -		
PLOT TIME =	2:35:22 PM	DATE -		REVISED -		



STATE OF ILLINOIS
DEPARTMENT OF TRANSPORTATION

WATER MAIN PLAN AND PROFILE
CENTRAL PARK AVENUE @ W HARRISON STREET

SCALE: 1" = 20' SHEET NO. C-57a OF C-102 SHEETS BEGIN TO STA. 604+50.00

ADDED ENTIRE SHEET 1/2/2026

F.A.I. RTE	SECTION	COUNTY	TOTAL SHEETS	SHEET NO.
290	2019-189-BR	COOK	250	81a
CONTRACT NO. 62K62				
ILLINOIS FED. AID PROJECT				

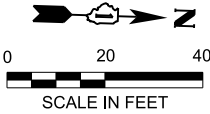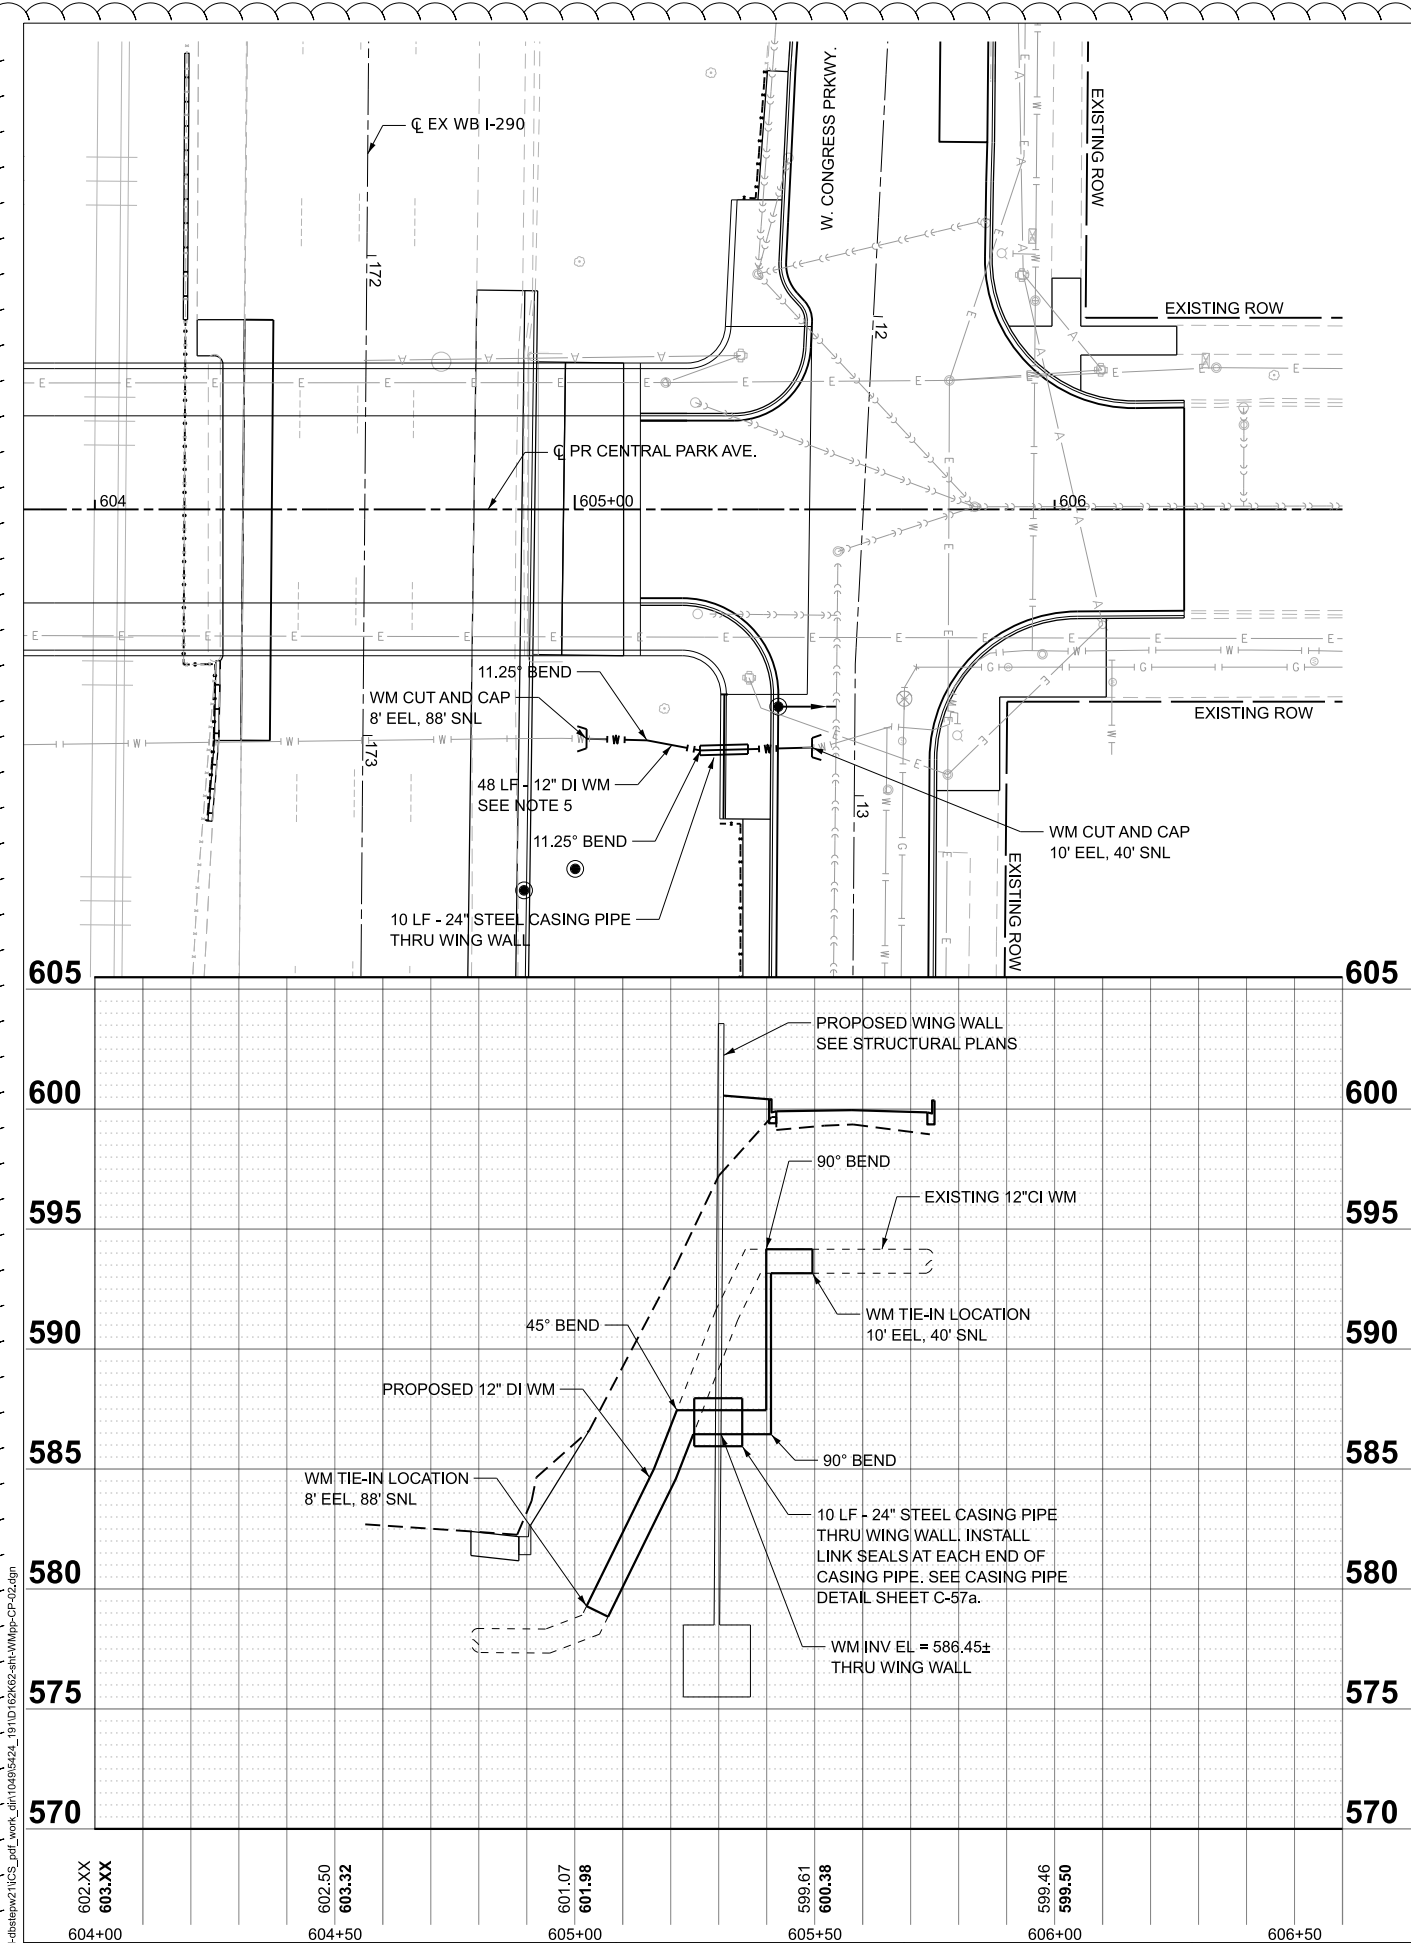

WATER MAIN LEGEND

- WM CUT AND CAP
- PROPOSED WATER MAIN


NOTES

- NOTATION "EEL" REFERS TO "EAST OF THE EAST ROW LINE".
"SNL" REFERS TO "SOUTH OF THE NORTH ROW LINE".
(TYPICAL CDWM WATER NOTATION)
- BEFORE WING WALL CONSTRUCTION, CUT, CAP, AND BRACE THE EXISTING 12" WATER MAIN TO THE SOUTH AT 10' EEL, 88' SNL AND TO THE NORTH AT 10' EEL, 40' SNL.
- AFTER WING WALL CONSTRUCTION, REMOVE THE TEMPORARY CAPS AND PLUG AND RECONNECT THE EXISTING 12" CI WATER MAIN TO THE SOUTH AND NORTH WITH:
 - 2 - 12" MJ SLEEVES
 - 48 L.F. OF 12" DI WATER MAIN PIPE (5610330)
 - 2 - HORIZONTAL 11.25° BENDS (56109404)
 - 2 - VERTICAL 90° BENDS (56109438)
 - 1 - VERTICAL 45° BEND (56109424)
 - 10 L.F. OF 24" STEEL CASING PIPE THRU WING WALL (Z0067900)
- THE PROPOSED WATER MAIN MUST HAVE AT LEAST 5' DEPTH OF COVER.
- ALL BENDS IN THE DI WATER MAIN SHALL UTILIZE CDWM STANDARD THRUST BLOCKS. COST INCLUDED IN DUCTILE IRON WATER MAIN 12".
- SEE SPECIAL PROVISIONS FOR CDWM WATER REQUIREMENTS.

B.M.: Benchmark CWA 6 is a 2 inch aluminum disk set on the east concrete curb south of the metal railing on south Central Ave. north of Fillmore Street Elev. 610.40

Existing Structure: S.N. 016-2072 was originally constructed in 1953 as Federal Aid Highway on F.A. Route 131, Project U.I. 261(57), Central Park Avenue Grade Separation over Congress Street Expressway, Section's 062-2828-M.F. The Structure is a 3-span continuous steel wide flange beam bridge with a 7" reinforced concrete deck, supported on reinforced concrete piers and abutments founded on creosote timber piles. The bridge was 61'-0" out-to-out of deck and 202'-9" long back-to-back abutments.

Traffic to be re-routed on a detour. Traffic on I-290 to be maintained utilizing lane shifts.
Salvage: None.

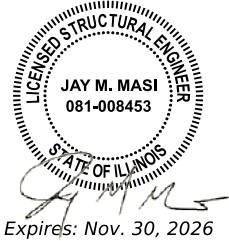

UTILITY LEGEND

— — —	Water (CDWM)
—>—>—>—>	Combined Sewer (CDWM)
—T—	Telephone (AT&T)
—E—	Electric (CDOT-DEO, ComEd)
—G—	Gas (Peoples Gas)
—CTV—	Cable TV (Comcast)
—A—	Aerial Wire
—FO—	Fiber Optic
—>—>—>	Storm Sewer

LOADING HL-93
Allow 50#/sq. ft. for future wearing surface.

LIVE LOAD DEFLECTION
Maximum deflection shall not exceed
Span Length / 1,000

DESIGN SPECIFICATIONS
2020 AASHTO LRFD Bridge Design
Specifications, 9th Edition

DESIGN STRESSES

FIELD UNITS

$f_c = 3,500$ psi (Substructure)
 $f_c = 4,000$ psi (Superstructure)
 $f_y = 60,000$ psi (Reinforcement)
 $f_y = 50,000$ psi (M270 Grade 50)
(All Structural Steel Shall be Metallized)

SEISMIC DATA

Seismic Performance Zone (SPZ) = 1
Design Spectral Acceleration at 1.0 sec. (SD1) = 0.096g
Design Spectral Acceleration at 0.2 sec. (SDS) = 0.146g
Soil Site Class D

* Offsets Measured from the F.F. of Wingwalls
** Dimensions Measured at Existing I-290.
*** Final Condition Only. See MOT Sheets.
**** Tapered Ramp Lane

PLAN



NOTES:

- For Profile Grade Lines, Index Sheets and Total Bill of Materials, see Sheet S-2.
- For General Notes, Section Thru Semi-Integral Abutment and CTA Train Clearance Diagram, see Sheet S-3.

1 REVISED SHEET 1/2/2026

**GENERAL PLAN AND ELEVATION
CENTRAL PARK AVENUE OVER I-290
(EISENHOWER EXPRESSWAY) AND CTA
F.A.I. RTE. 290 - SECTION 2019-189-BR
COOK COUNTY
STA. 603+91.56
STRUCTURE NO. 016-2091**



DB STERLIN CONSULTANTS, INC.
122 N. Wacker Drive, Suite 2000
Chicago, Illinois 60606
312.857.1006

USER NAME =	icsM-dstepw215	DESIGNED -	JMM	REVISED -	12/19/2025	JMM
PLOT SCALE =		DRAWN -	SFM	REVISED -		
PLOT DATE =	12/12/2025	CHECKED -	BJN	REVISED -		
PLOT TIME =	8:45:33 PM	DATE -		REVISED -		

**STATE OF ILLINOIS
DEPARTMENT OF TRANSPORTATION**

**GENERAL PLAN AND ELEVATION
STRUCTURE NO. 016-2091**

SCALE: NTS

SHEET NO. S-1 OF S-50 SHEETS

F.A.I. RTE.	SECTION	COUNTY	TOTAL SHEETS	SHEET NO.
290	2019-189-BR	COOK	250	188
CONTRACT NO. 62K62				
ILLINOIS FED. AID PROJECT				

FILE NAME: \\cs1\m-dbstepw2\mcs_pdf_work_dh\1008\5302_38\0162091+D162K62-S002-Gen Data 1.dgn

INDEX OF SHEETS

S-1	General Plan and Elevation
S-2	Alignments, Index of Sheets, and Total Bill of Materials
S-3	General Notes and Data
S-4	Existing Structure Removal Plan, Elevation, and Section
S-5	Existing Structure Removal Details
S-6	Substructure Layout Plan and TSRS Details
S-7	Temporary Soil Retention System Details
S-8	Top of Deck Elevation Locations
S-9	Top of Deck Elevations (1 of 2)
S-10	Top of Deck Elevations (2 of 2)
S-11	Top of North Approach Slab Elevations
S-12	Top of South Approach Slab Elevations
S-13	Deck Plan and Cross Section
S-14	Deck Details (1 of 2)
S-15	Deck Details (2 of 2)
S-16	Parapet Elevations and Details
S-17	Concrete Diaphragm Details
S-18	North Approach Slab Details (1 of 2)
S-19	North Approach Slab Details (2 of 2)
S-20	South Approach Slab Details (1 of 2)
S-21	South Approach Slab Details (2 of 2)
S-22	Typical Approach Slab Details
S-23	Bridge Fence Railing, Curved (1 of 2)
S-24	Bridge Fence Railing, Curved (2 of 2)
S-25	Bridge Fence Railing (1 of 2)
S-26	Bridge Fence Railing (2 of 2)
S-27	Framing Plan and Girder Elevation
S-28	Structural Steel Details
S-29	Girder Moment and Reaction Tables
S-30	Elastomeric Bearing Type I and Fixed Bearing Details
S-31	North Abutment Plan and Elevation
S-32	North Abutment Foundation Plan, Sections, and Details
S-33	North Wingwalls Plan and Elevation
S-34	North Wingwalls Foundation Plan
S-35	North Wingwalls Details
S-36	South Abutment Plan and Elevation


INDEX OF SHEETS (CONT.)

S-37	South Abutment Foundation Plan, Sections, and Details
S-38	South Wingwalls Plan and Elevation
S-39	South Wingwalls Foundation Plan
S-40	South Wingwalls Details
S-41	Typical Abutment and Wingwall Reveal Elevations
S-42	Pier 1 Details
S-43	Pier 2 Details
S-44	HP Pile Details
S-45	Soil Borings (1 of 6)
S-46	Soil Borings (2 of 6)
S-47	Soil Borings (3 of 6)
S-48	Soil Borings (4 of 6)
S-49	Soil Borings (5 of 6)
S-50	Soil Borings (6 of 6)

STA. 603+91.56
BUILT 20__ BY
STATE OF ILLINOIS
F.A.I. RT. 290 SEC. 2019-189-BR
LOADING HL-93
STR. NO. 016-2091

NAME PLATE

See Std. 515001

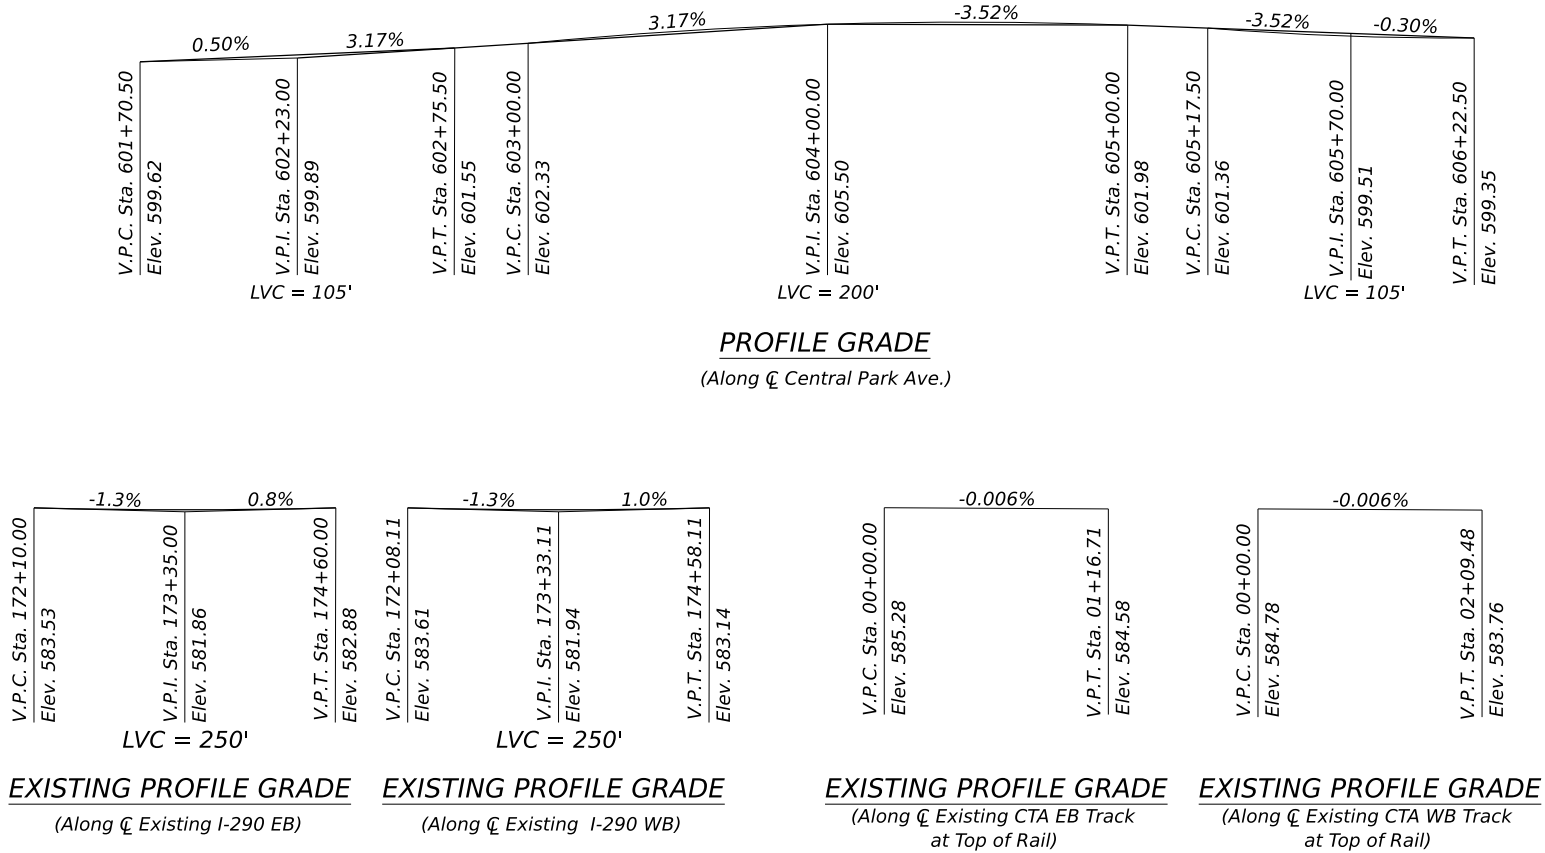

TOTAL BILL OF MATERIALS

ITEM	UNIT	SUPER	SUB	TOTAL
WELDED WIRE REINFORCEMENT	SQ YD	171		171
REMOVAL OF EXISTING STRUCTURES	EACH	1		1
PROTECTIVE SHIELD	SQ YD	1,602		1,602
STRUCTURE EXCAVATION	CU YD		4,835.4	4,835.4
REMOVAL AND DISPOSAL OF UNSUITABLE MATERIAL FOR STRUCTURES	CU YD		1,208.9	1,208.9
CONCRETE STRUCTURES	CU YD		1,482.9	1,482.9
CONCRETE SUPERSTRUCTURE	CU YD	654.9		654.9
BRIDGE DECK GROOVING	SQ YD	1,340		1,340
FORM LINER TEXTURED SURFACE	SQ FT		2,832	2,832
PROTECTIVE COAT	SQ YD	415	27	442
CONCRETE SUPERSTRUCTURE (APPROACH SLAB)	CU YD	286.2		286.2
FURNISHING AND ERECTING STRUCTURAL STEEL	L. SUM	1		1
STUD SHEAR CONNECTORS	EACH	11,360		11,360
REINFORCEMENT BARS	POUND		58,480	58,480
REINFORCEMENT BARS, EPOXY COATED	POUND	239,340	160,060	399,400
BRIDGE FENCE RAILING	FOOT	188		188
BRIDGE FENCE RAILING, CURVED	FOOT	489		489
SLOPE WALL 4 INCH	SQ YD		333	333
FURNISHING STEEL PILES HP12X53	FOOT		9,950	9,950
DRIVING PILES	FOOT		9,950	9,950
TEST PILE STEEL HP12X53	EACH		2	2
PILE SHOES	EACH		199	199
NAME PLATES	EACH	1		1
PERMANENT CASING	FOOT		936	936
DRILLED SHAFT IN SOIL	CU YD		169.5	169.5
DRILLED SHAFT IN ROCK	CU YD		8.4	8.4
ELASTOMERIC BEARING ASSEMBLY, TYPE I	EACH	30		30
ANCHOR BOLTS, 1"	EACH	80		80
TEMPORARY SOIL RETENTION SYSTEM	SQ FT		14,233	14,233
GRANULAR BACKFILL FOR STRUCTURES	CU YD		3,880.2	3,880.2
CONCRETE SEALER	SQ FT		9,656	9,656
GEOCOMPOSITE WALL DRAIN	SQ YD		615	615
PIPE UNDERDRAINS FOR STRUCTURES 4"	FOOT		305	305
CROSSHOLE SONIC LOGGING ACCESS DUCTS	FOOT		981	981
CROSSHOLE SONIC LOGGING TESTING	EACH		18	18
PILE REMOVAL	EACH		45	45
BAR TERMINATORS	EACH	444		444

REVISD SHEET 1/2/2026


STATE OF ILLINOIS
DEPARTMENT OF TRANSPORTATION

ALIGNMENTS, INDEX OF SHEETS, AND TOTAL BILL OF MATERIALS
STRUCTURE NO. 016-2091

SCALE: NTS

SHEET NO. S-2 OF S-50 SHEETS

F.A.I. RTE	SECTION	COUNTY	TOTAL SHEETS	SHEET NO.
290	2019-189-BR	COOK	250	189
CONTRACT NO. 62K62				
ILLINOIS		FED. AID PROJECT		

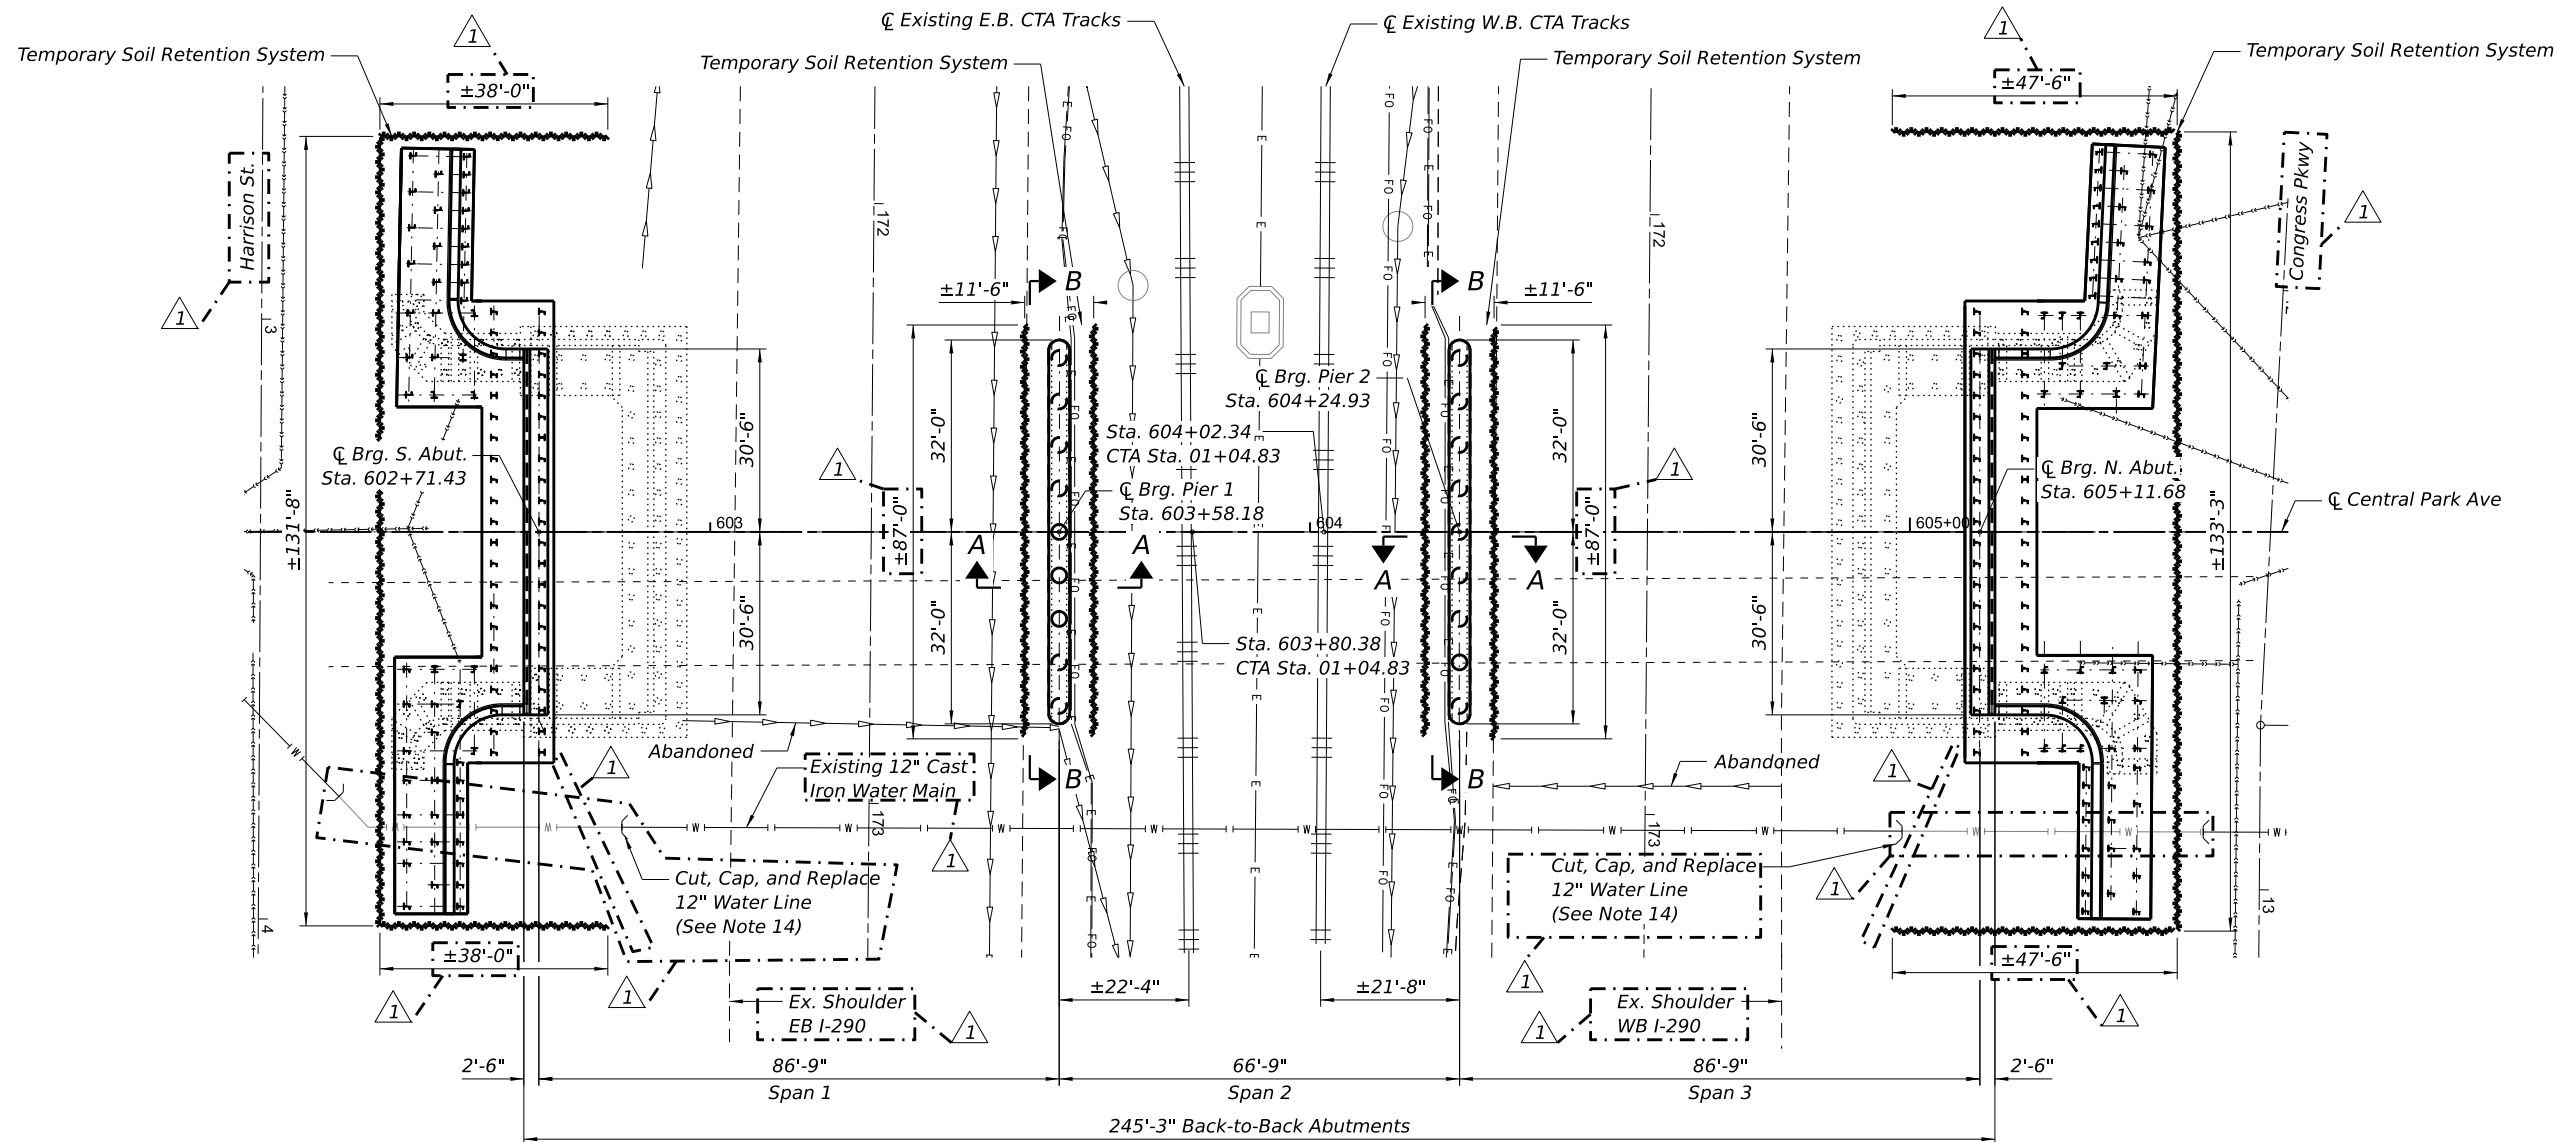

UTILITY LEGEND

— W —	Existing Underground Water Line (CDWM)
— S —	Existing Underground Combined Sewer (CDWM)
— T —	Existing Underground Telephone (AT&T)
— E —	Existing Electrical (DCOT-DEO, ComEd)
— G —	Existing Underground Gas (Peoples Gas)
— FO —	Existing Fiber Optic
— SS —	Existing Storm Sewer

SUBSTRUCTURE LAYOUT AND TSRS PLAN

NOTES

1. The Contractor shall locate and ensure that all existing utilities interfering with the Temporary Soil Retention System and/or open cut excavation are protected and temporarily supported to minimize vertical and horizontal movement of the utilities. Coordination with the Utility Owner will be required. Cost is included with Temporary Soil Retention System.
2. Any damage to the existing utilities that may incur during construction operations shall be paid for at the expense of the Contractor.
3. Peak Particle Velocity (PPV) of TSRS construction near existing CTA facilities shall not exceed 1-ft/sec. or CTA approved PPV value.
4. For minimum horizontal clearances to the CTA, see Sheet S-3.
6. For structure removal plan, elevation, sections, and details, see Sheets S-4 and S-5.
7. For Temporary Soil Retention System details, see Sheet S-7.

NOTES (CONT.)

8. For North Abutment foundation details, see Sheet S-32.
9. For Northeast and Northwest Wingwall foundation details, see Sheet S-34.
10. For South Abutment foundation details, see Sheet S-37.
11. For Southeast and Southwest Wingwall foundation details, see Sheet S-39.
12. For Pier 1 foundation details, see Sheet S-42.
13. For Pier 2 foundation details, see Sheet S-43.

14. The limits and procedure of the cutting and capping of the existing 12" water line shall be determined by CDWM.

FILE NAME: \\cs1m-dstepw2\mcs_pdf_work_dh\1008\5302_15\0162091-D162K62-S006-Sub-Layout Plan and TSRS Details.dgn



DB STERLIN CONSULTANTS, INC.
123 N. Wacker Drive, Suite 2000
Chicago, Illinois 60606
312.857.1006

USER NAME =	icsM-dstepw215	DESIGNED -	SFM	REVISED -	12/19/2025	SFM
PLOT SCALE =		DRAWN -	SFM	REVISED -		
PLOT DATE =	12/12/2025	CHECKED -	BJN	REVISED -		
PLOT TIME =	8:43:24 PM	DATE -		REVISED -		

STATE OF ILLINOIS
DEPARTMENT OF TRANSPORTATION






SUBSTRUCTURE LAYOUT PLAN AND TSRS DETAILS
STRUCTURE NO. 016-2091

SCALE: NTS

SHEET NO. S-6 OF S-50 SHEETS

F.A.I. RTE.	SECTION	COUNTY	TOTAL SHEETS	SHEET NO.
290	2019-189-BR	COOK	250	193
CONTRACT NO. 62K62				
ILLINOIS FED. AID PROJECT				

REVISED SHEET 1/2/2026

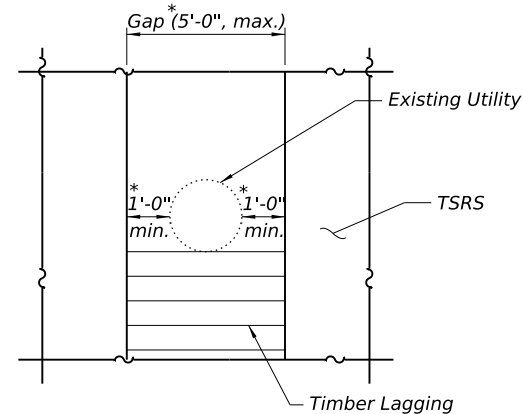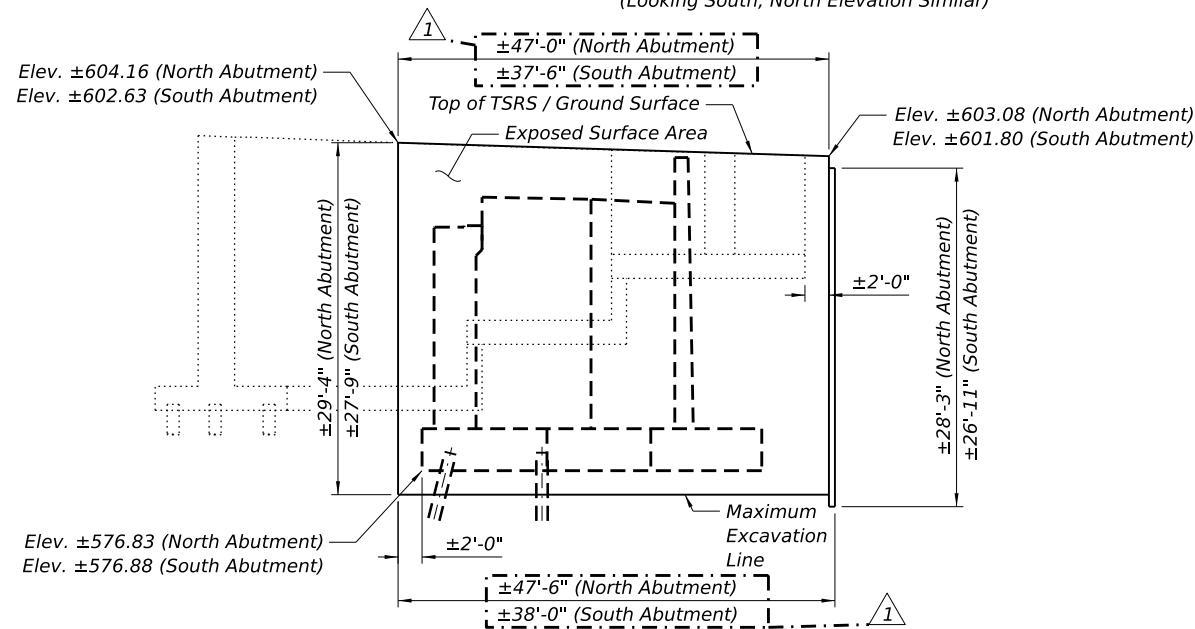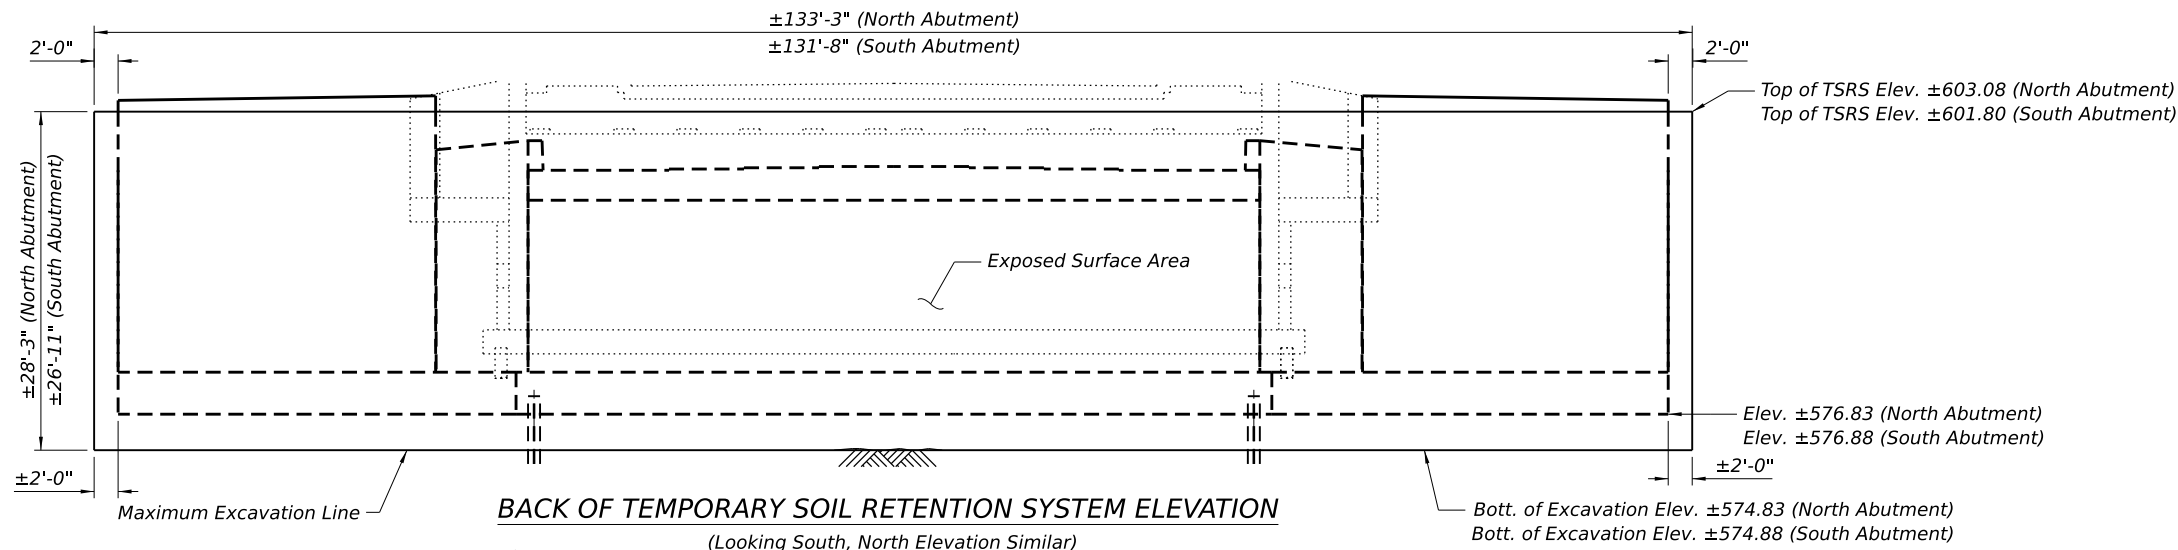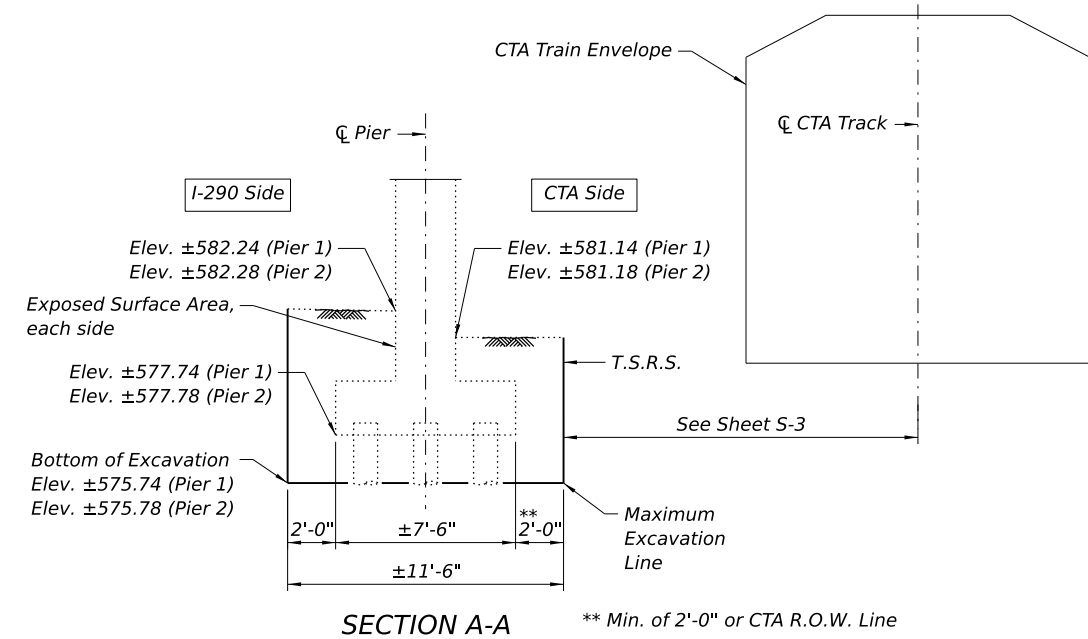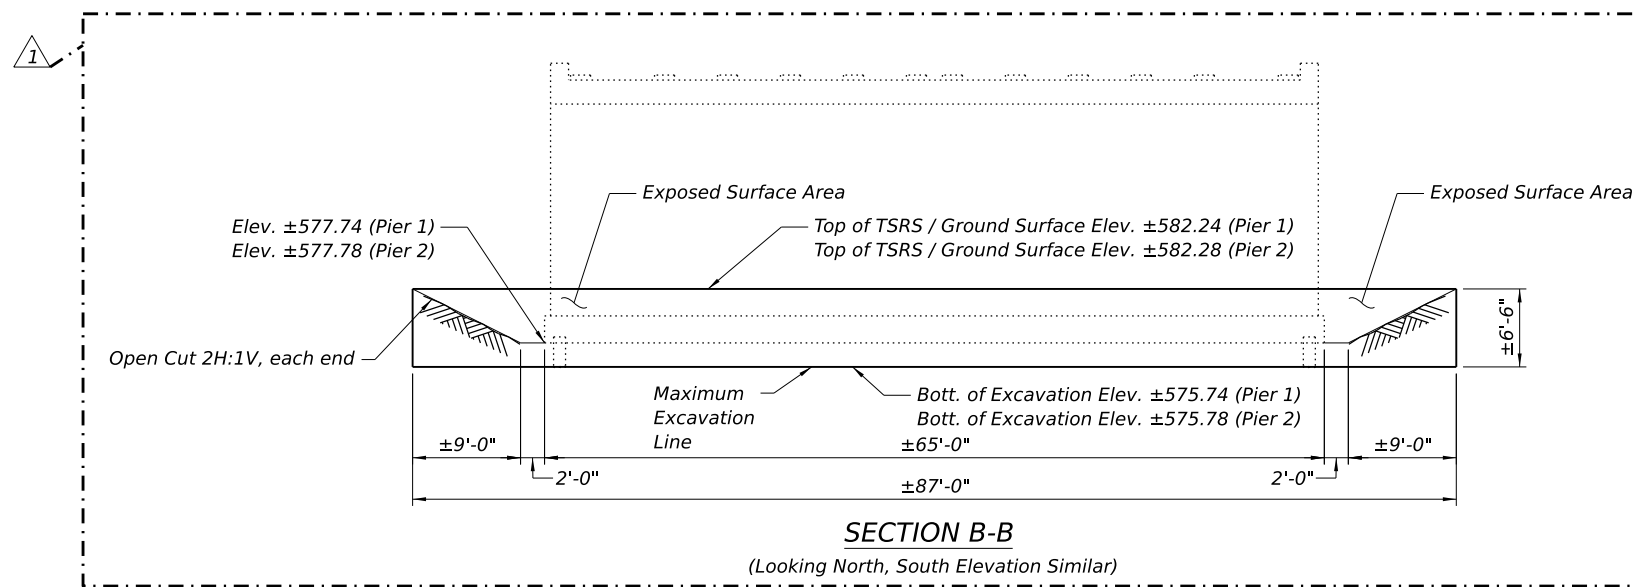

NOTES

1. A cantilevered sheet piling design does not appear feasible and additional members or other retention systems may be necessary. The Contractor shall submit a temporary soil retention system design including plan details and calculations for review and acceptance by the Engineer.
2. For locations of section, see Sheet S-6.

TOTAL BILL OF MATERIAL

DESCRIPTION	UNIT	TOTAL
Temporary Soil Retention System	Sq Ft	14,233

1 REVISED SHEET 1/2/2026

FILE NAME: \\cs\m-dstepw2\mcs_pdf_work_dh\1008\5302_87\0162091\0162K62-S007-TSRS Details.dgn



DB STERLIN CONSULTANTS, INC.
123 N. Wacker Drive, Suite 2000
Chicago, Illinois 60606
312.857.1006

USER NAME = icsM-dstepw215	DESIGNED - SFM	REvised - 12/19/2025 SFM
PLOT SCALE =	DRAWN - SFM	REvised -
PLOT DATE = 12/12/2025	CHECKED - BJN	REvised -
PLOT TIME = 8:46:29 PM	DATE -	REvised -


STATE OF ILLINOIS
DEPARTMENT OF TRANSPORTATION

TEMPORARY SOIL RETENTION SYSTEM DETAILS
STRUCTURE NO. 016-2091

SCALE: SHEET NO. S-7 OF S-50 SHEETS


F.A.I. RTE	SECTION	COUNTY	TOTAL SHEETS	SHEET NO.
290	2019-189-BR	COOK	250	194
CONTRACT NO. 62K62				
ILLINOIS FED. AID PROJECT				

Bridge Fence Railing,
Curved Post Spacing

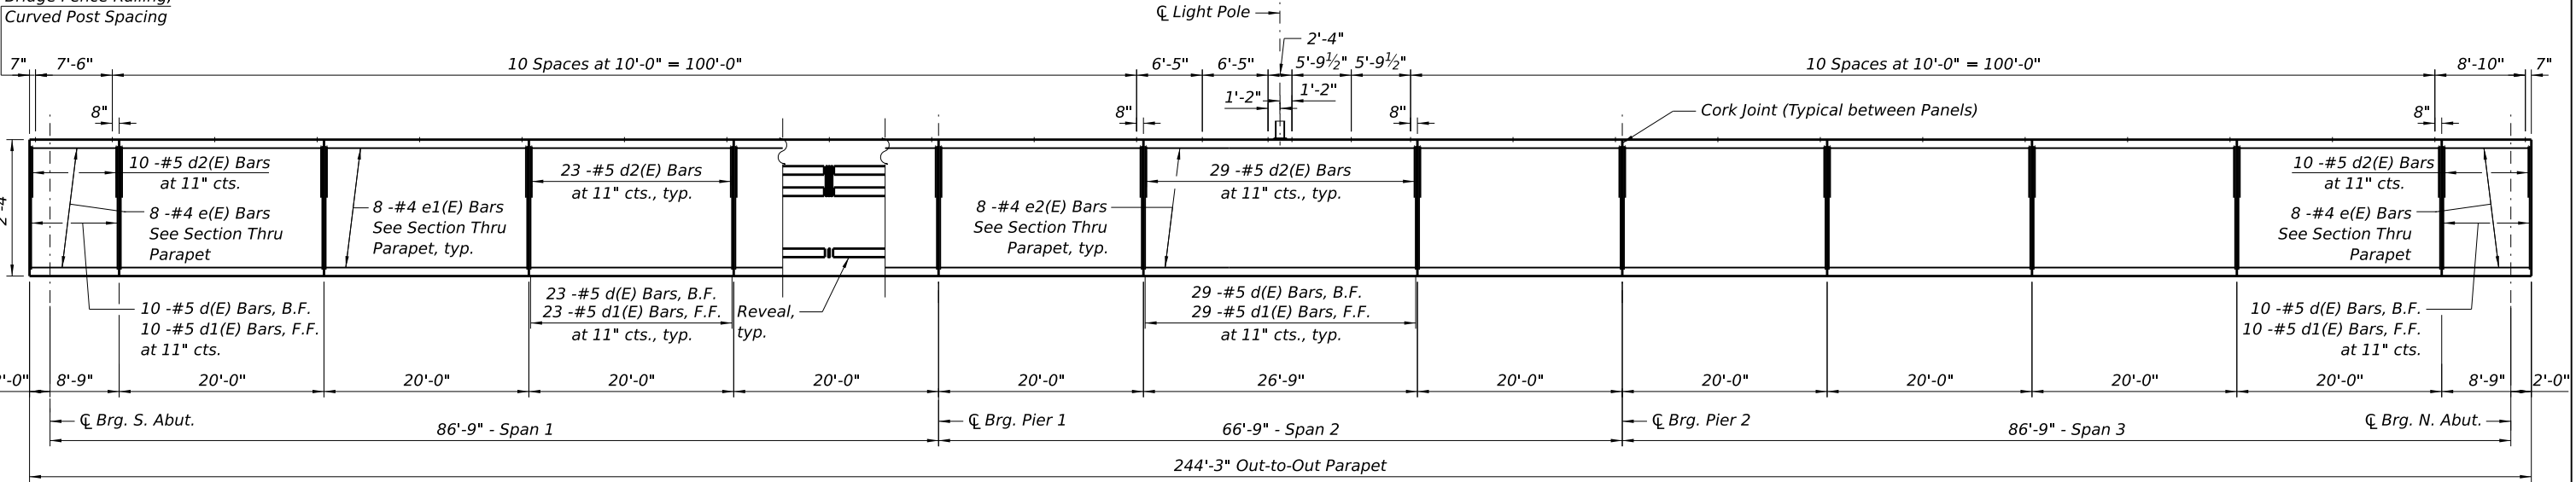


INSIDE ELEVATION OF WEST PARAPET
(Looking West)

Bridge Fence Railing,
Curved Post Spacing

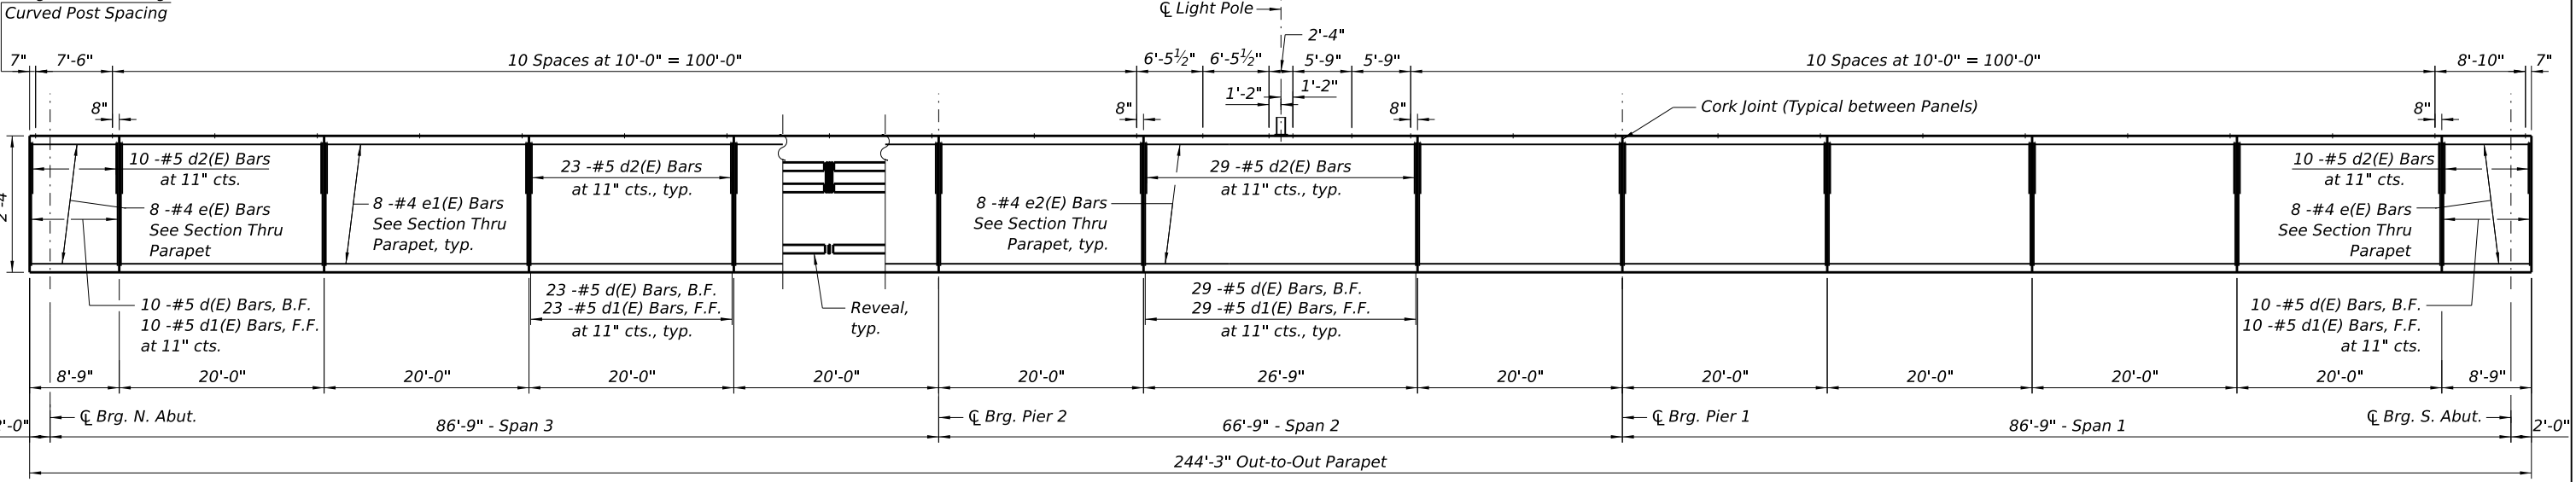

INSIDE ELEVATION OF EAST PARAPET
(Looking East)

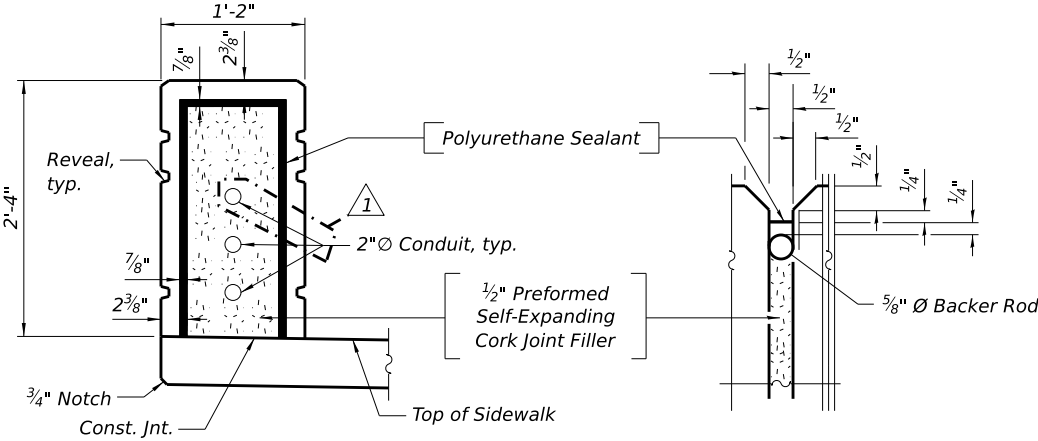


PARAPET JOINT DETAILS

NOTES:

1. The Polyurethane Sealant shall be according to Article 1050.04 of the Std. Spec. and the color shall be gray.
2. For lightpole bump out details, see Sheet S-14.
3. For notes, reveal pattern details, bar diagrams, and Bill of Material, see Sheet S-15.
4. All edges shall be chamfered 3/4".
5. For Bridge Fence Railing, Curved, see Sheets S-23 and S-24.

REVISED SHEET 1/2/2026

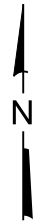


LEGEND

Traffic Signal Foundation


* Cut bars to fit. Maintain 2" min. clear cover.

PLAN

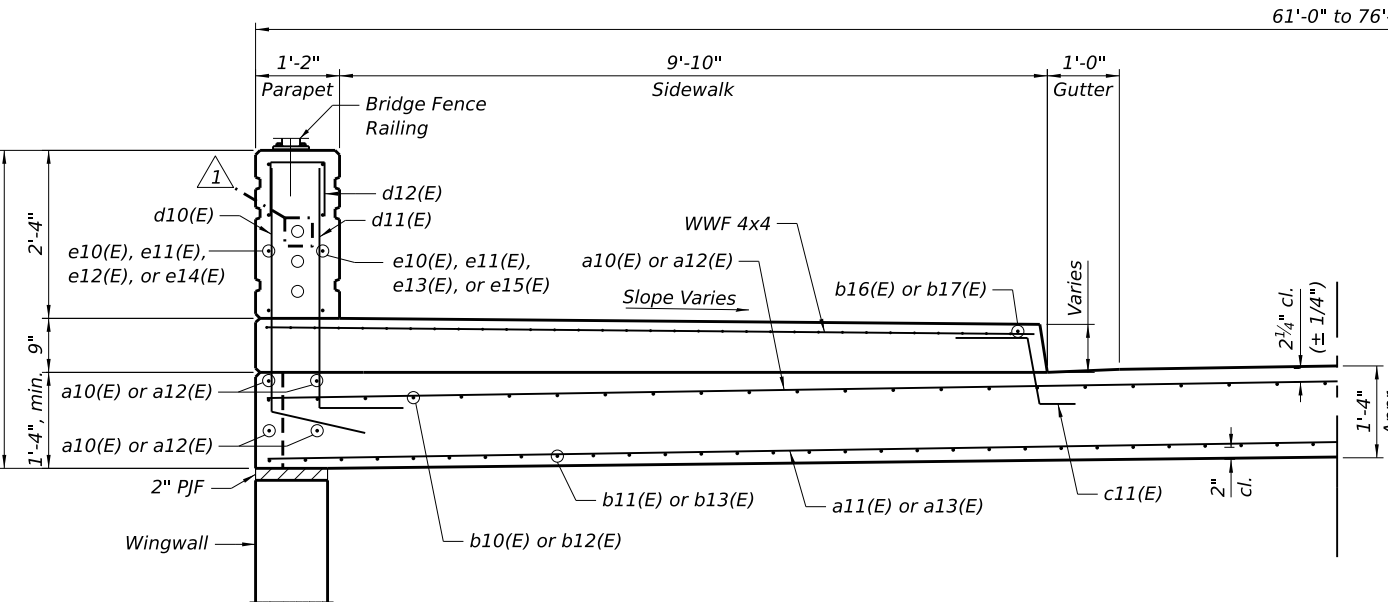

NEAR ABUTMENT

CROSS SECTION
(Looking North)

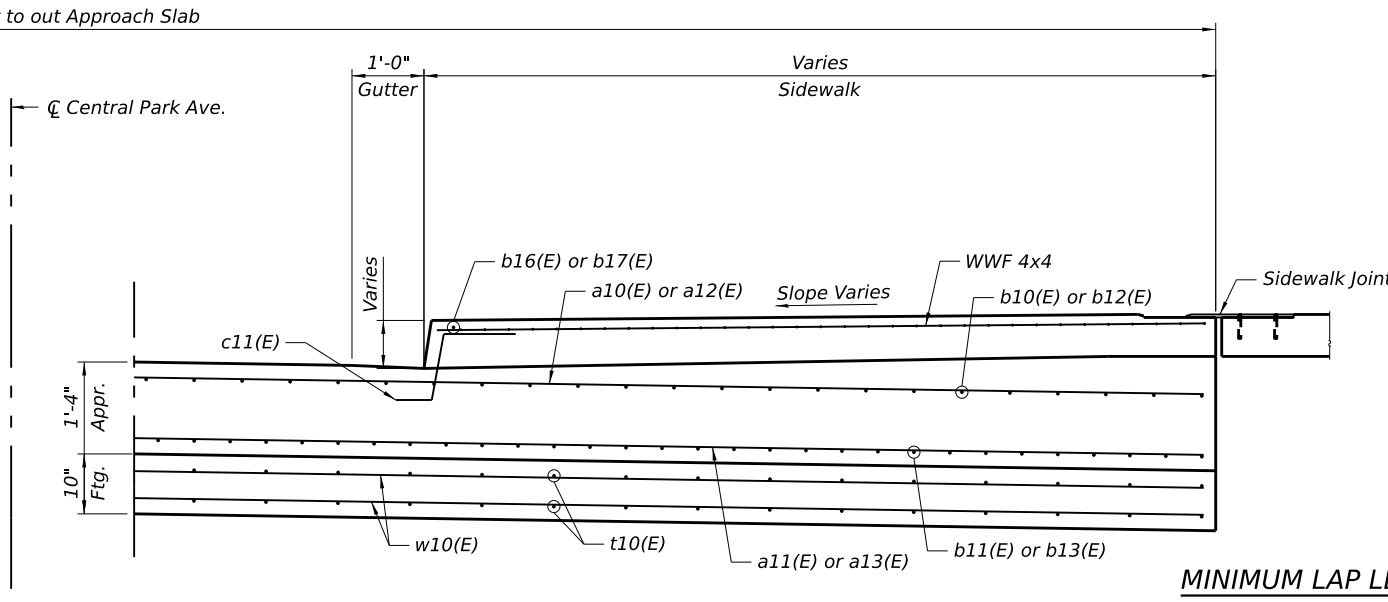

AT APPROACH FOOTING

TOP AND BOTTOM ELEVATIONS
FOR APPROACH FOOTING

North Approach		
Point/ Location	Top	Bottom
A	598.83	597.99
B	599.25	598.41
C	598.59	597.75
D	598.71	597.87
E	598.99	598.15
F	598.41	597.57

* Fabric bearing pads at the expansion end shall be recessed 1/4" into the approach footing and bonded. Adjusting shims, when required, shall be bonded to the top of the fabric bearing pads.

TRAFFIC SIGNAL
FOUNDATION LOCATIONS AND TYPES

Foundation Tag	Station	Offset	Foundation Type
NW-1	605+37.43	34.56', Lt.	TS-2
NW-2	605+26.53	24.46', Lt.	TS-1
NE-1	605+36.08	34.99', Rt.	TS-1
NE-2	605+26.11	24.39', Rt.	TS-1

NOTES

- Bars noted thus 3x2 - #5 indicates 3 lines of bars with 2 bars per line.
- ADA sidewalk ramp concrete and reinforcement shall be paid for as part of Concrete Superstructure (Approach Slab) and Welded Wire Reinforcement, respectively.
- For ADA sidewalk ramps slopes and dimesnions, see Roadway ADA sheets.
- For parapet details, bar bends, Bill of Materials, and details, see Sheet S-19.
- For ADA Ramp reinforcement plan, sidewalk joint detail, and traffic signal foundation details, see Sheet S-22.
- For embedded conduit layout plan, see Electrical sheets.

MINIMUM LAP LENGTHS

Bar	Lap
#5	2'-1"
#6	3'-1"
#8	5'-2"

REVISED SHEET 1/2/2026

FILE NAME: \\cs1m-dbsstepw2\mcs_pdf_work_dh1008\5302_6010162091+D162K62-S016-North Appr 1.dgn



DB STERLIN CONSULTANTS, INC.
123 N. Wacker Drive, Suite 2000
Chicago, Illinois 60606
312.857.1006

USER NAME =	icsM-dbsstepw215	DESIGNED -	JMM	REVISED -	12/19/2025	JMM
PLOT SCALE =		DRAWN -	JMM	REVISED -		
PLOT DATE =	12/12/2025	CHECKED -	BJN	REVISED -		
PLOT TIME =	8:45:38 PM	DATE -		REVISED -		









STATE OF ILLINOIS
DEPARTMENT OF TRANSPORTATION

NORTH APPROACH SLAB DETAILS (1 OF 2)
STRUCTURE NO. 016-2091

SCALE: SHEET NO. S-18 OF S-50 SHEETS

F.A.I. RTE	SECTION	COUNTY	TOTAL SHEETS	SHEET NO.
290	2019-189-BR	COOK	250	205
CONTRACT NO. 62K62				
ILLINOIS FED. AID PROJECT				

FILE NAME: \\cs1m-dstepw2\ICS_pdf_work_dh1008\5302_8810162091-D162K62-S035-North Wingwall Details.dgn

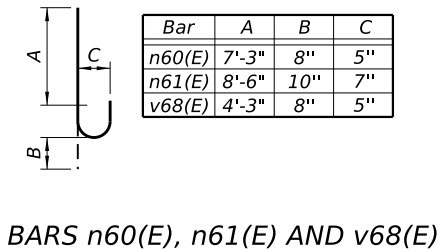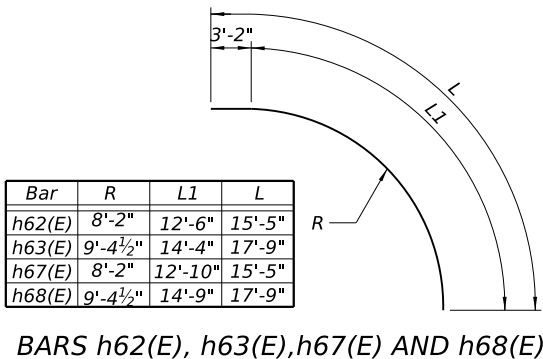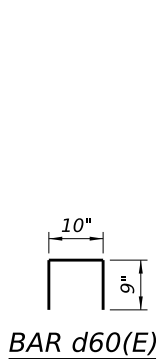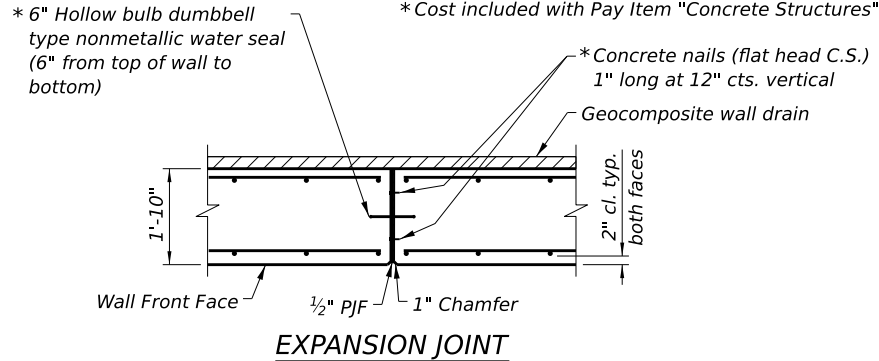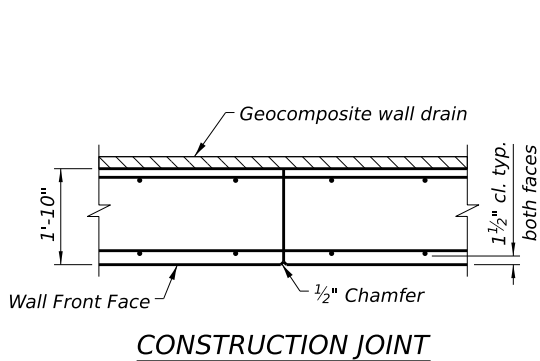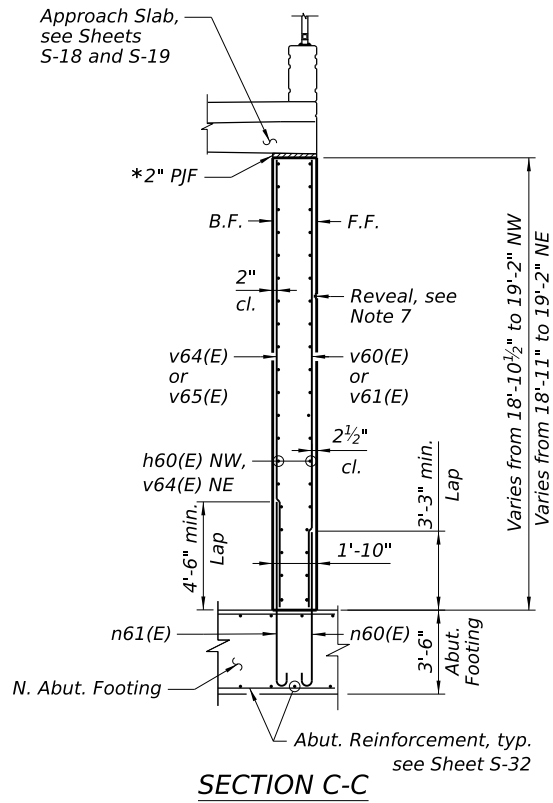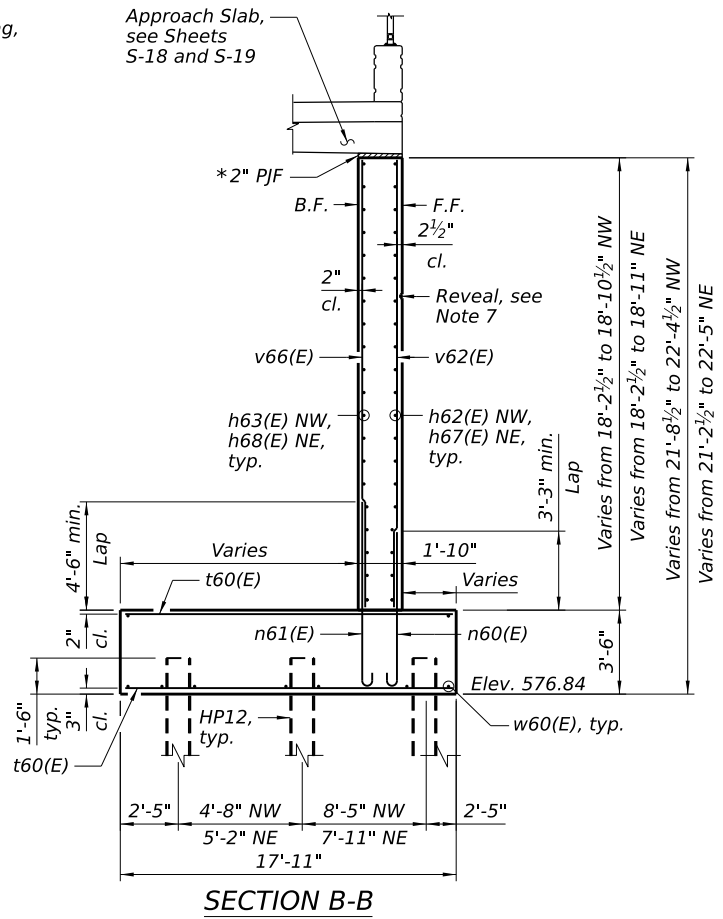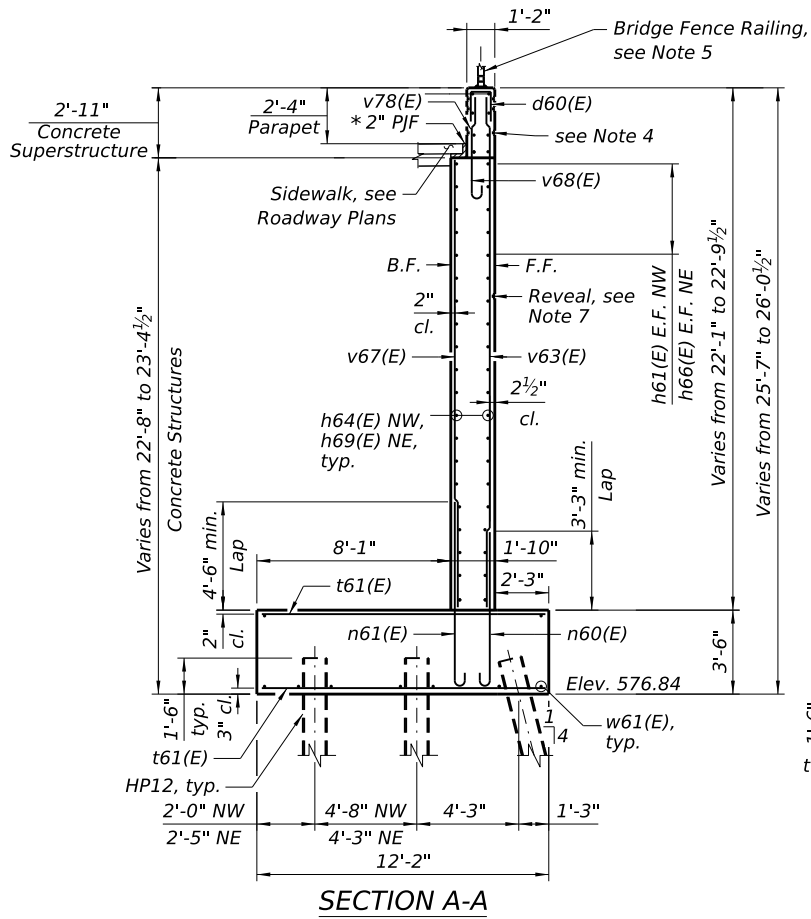

TOTAL BILL OF MATERIAL

NW and NE Wingwalls

Bar	No.	Size	Length	Shape
d60(E)	59	#5	2'-5"	□
h60(E)	32	#5	9'-0"	—
h61(E)	8	#5	8'-4"	—
h62(E)	20	#5	15'-6"	—
h63(E)	20	#5	17'-10"	—
h64(E)	40	#5	26'-0"	—
h65(E)	32	#5	7'-5"	—
h66(E)	8	#5	6'-9"	—
h67(E)	20	#5	15'-11"	—
h68(E)	20	#5	18'-3"	—
h69(E)	40	#5	25'-6"	—
h70(E)	8	#5	26'-0"	—
h71(E)	8	#5	25'-6"	—
h72(E)	8	#5	0'-9"	—
h73(E)	8	#5	6'-2"	—
h74(E)	8	#4	5'-4"	—
n60(E)	101	#5	7'-11"	⌋
n61(E)	204	#7	9'-4"	⌋
t60(E)	81	#7	17'-7"	—
t61(E)	121	#7	11'-10"	—
v60(E)	2	#5	14'-3"	—
v61(E)	17	#5	18'-8"	—
v62(E)	27	#5	18'-9"	—
v63(E)	55	#5	21'-11"	—
v64(E)	2	#7	14'-3"	—
v65(E)	32	#7	18'-8"	—
v66(E)	63	#7	18'-9"	—
v67(E)	107	#7	17'-9"	—
v68(E)	59	#5	5'-4"	⌋
v69(E)	4	#5	6'-2"	—
v70(E)	4	#7	9'-4"	—
w60(E)	78	#5	22'-5"	—
w61(E)	54	#5	47'-1"	—
Structure Excavation				Cu Yd 1,349.0
Concrete Structures				Cu Yd 304.4
Concrete Superstructure				Cu Yd 6.6
Protective Coat				Sq Yd 14
Reinforcement Bars, Epoxy Coated				Pound 30,250
Furnishing Steel Piles HP12x53				Foot 2,950
Driving Piles				Foot 2,950
Pile Shoes				Each 59
Concrete Sealer				Sq Ft 1,680
Granular Backfill for Structures				Cu Yd 932.3
Geocomposite Wall Drain				Sq Yd 200
Pipe Underdrains for Structures 4"				Foot 98

NOTES

- For location of Sections A-A thru C-C, see Sheets S-33 and S-34.
- For Section thru Wingwall see Sheet S-40.
- Protective Coat shall be applied to front face of parapet.
- For parapet reveal detail, see Detail 1 Sheet S-40 and Sheet S-16 for additional details.
- For Bridge Fence Railing details, see Sheets S-25 and S-26.
- Concrete Sealer shall be applied to exposed front face of wingwalls per Section 587 of the Standard Specifications.
- For drainage details behind wingwalls, see Section Thru Wingwall on Sheet S-40.
- For reveal pattern and layout, see Sheet S-41.

1 REVISED SHEET 1/2/2026



DB STERLIN CONSULTANTS, INC.
123 N. Wacker Drive, Suite 2000
Chicago, Illinois 60606
312.857.1006

USER NAME =	icsm-dstepw215	DESIGNED -	EV	REVISED -	12/19/2025 LS
PLOT SCALE =		DRAWN -	SFM	REVISED -	
PLOT DATE =	12/12/2025	CHECKED -	BJN	REVISED -	
PLOT TIME =	8:44:46 PM	DATE -		REVISED -	


STATE OF ILLINOIS
DEPARTMENT OF TRANSPORTATION

NORTH WINGWALLS DETAILS
STRUCTURE NO. 016-2091

SCALE: SHEET NO. S-35 OF S-50 SHEETS

F.A.I. RTE	SECTION	COUNTY	TOTAL SHEETS	SHEET NO.
290	2019-189-BR	COOK	250	222
CONTRACT NO. 62K62				
ILLINOIS FED. AID PROJECT				


FILE NAME: \\cs\m-dstepw2\mcs_pd_work_dh\10315302_6510162091-D162K62-S038-South Wing Plan and Elev.dgn

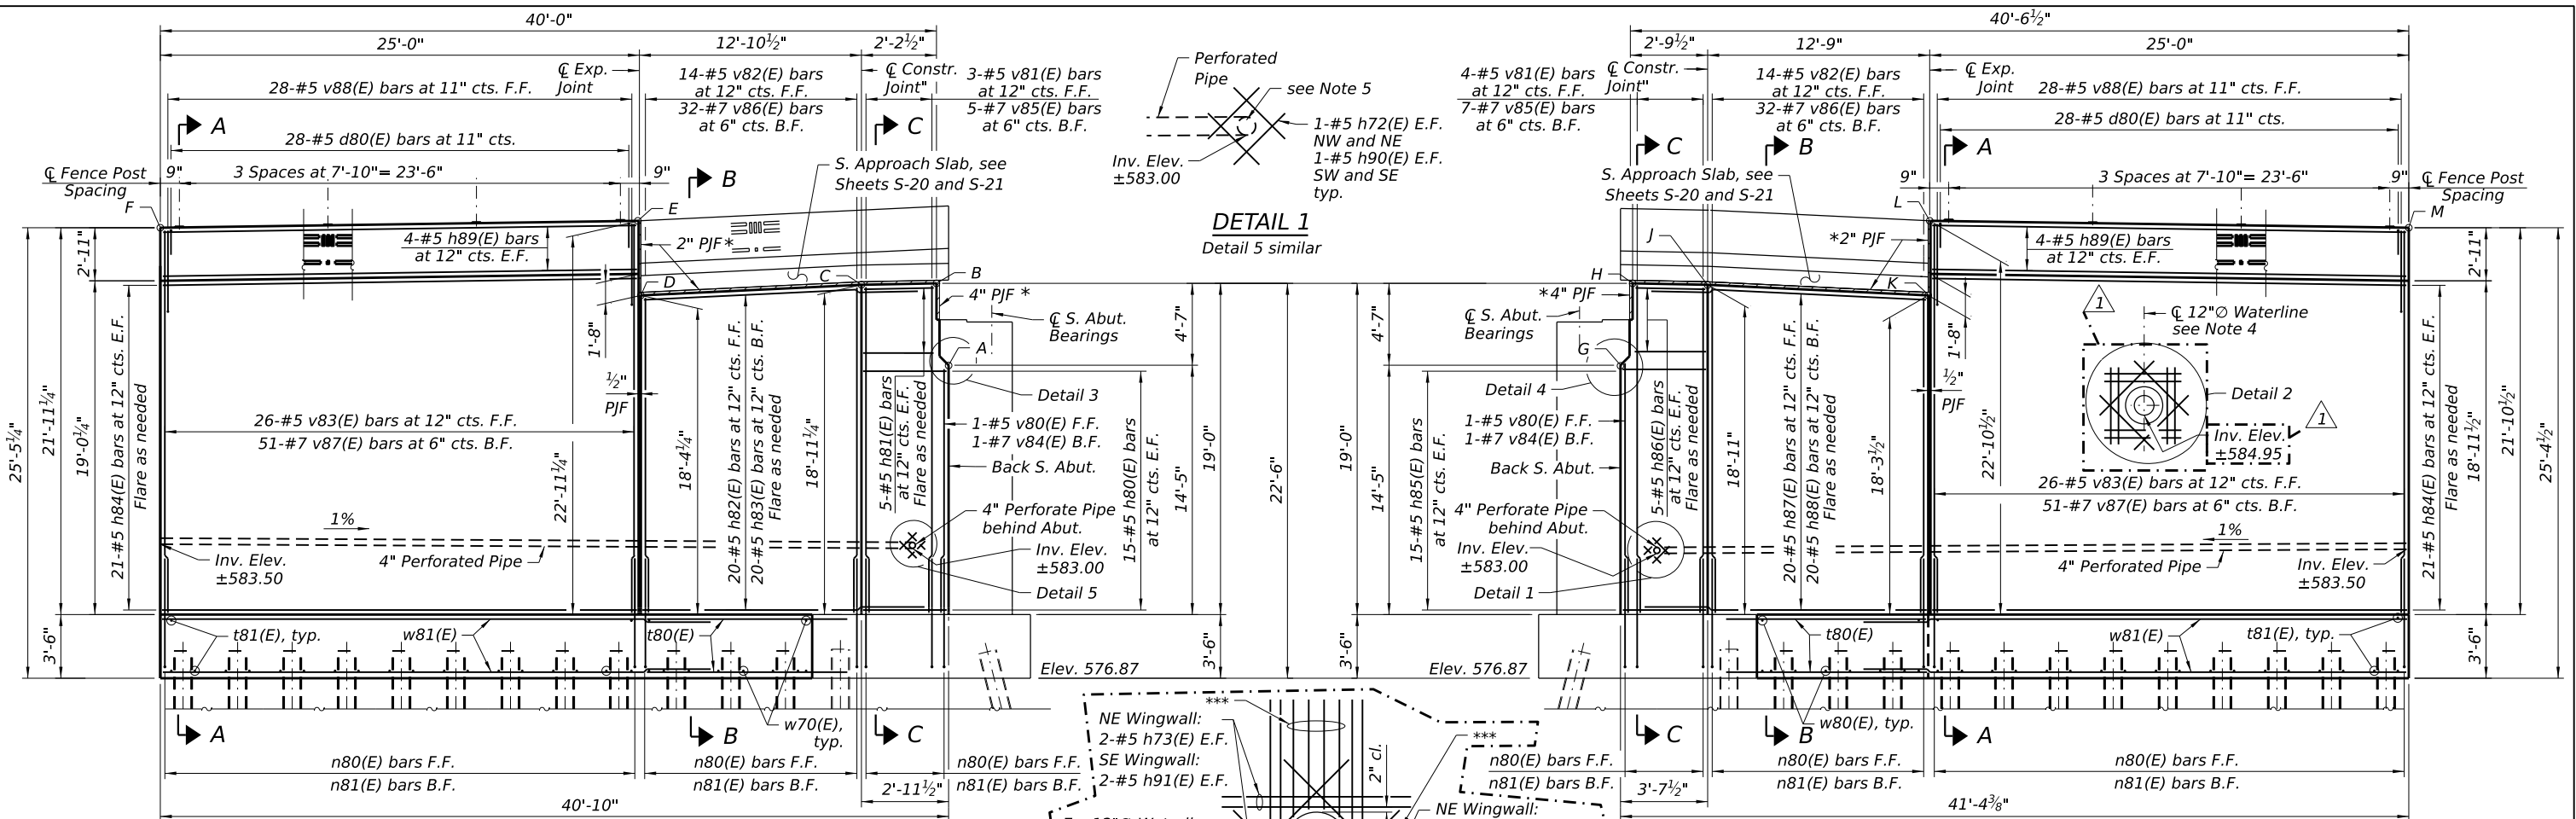

* PJF (per Article 1051.09 of the Standard Specifications) Bonded to Wingwall and diaphragm with Suitable Adhesive as Recommended by Supplier

NOTES

- For Sections A-A thru C-C, Section thru Wingwall and Bill of Materials, see Sheet S-40.
- For construction and expansion joints details see Sheet S-35.
- For Details 3 and 4 see Sheet S-33.
- Contractor to verify location and Inv. Elev. of existing 12" $\varnothing$ Waterline.
- Hole through the wall for underdrain outlet. Cost included in "Pipe underdrain for Structures, 4"
- For Perforated Pile and additional drainage details see Sheet S-3.

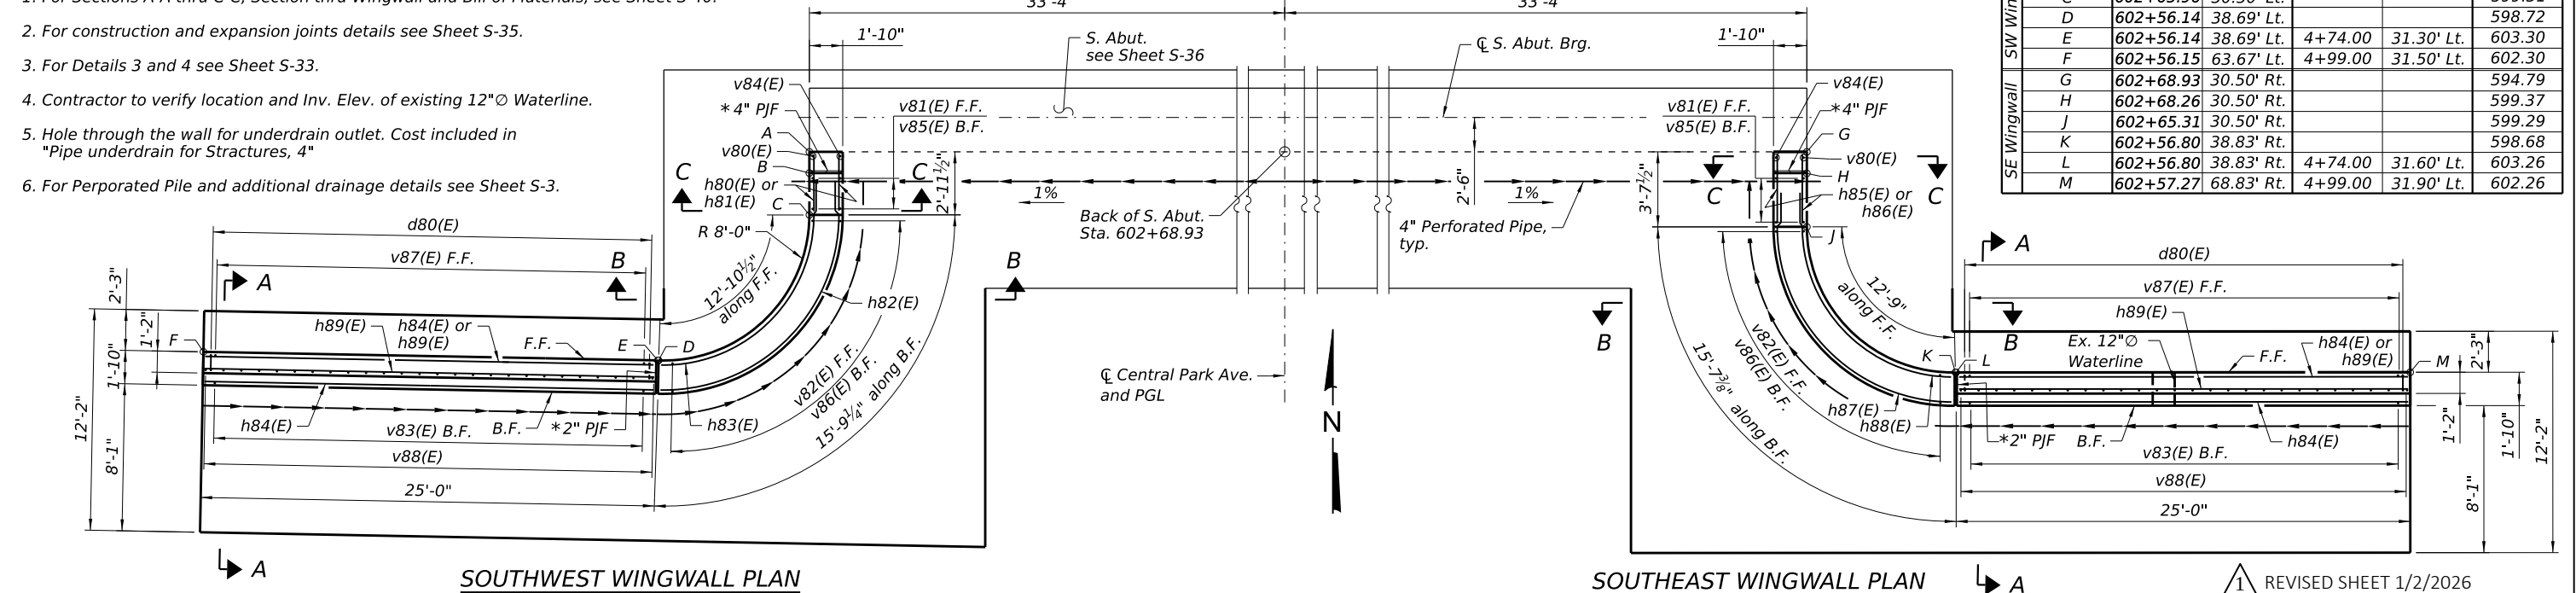

	along $\varnothing$ Prop. Central Park Ave.			along $\varnothing$ Exist. W. Harrison Street		
	Point	Station	Offset	Station	Offset	Elevation
SW Wingwall	A	602+68.93	30.50' Lt.			594.79
	B	602+68.26	30.50' Lt.			599.37
	C	602+65.96	30.50' Lt.			599.31
	D	602+56.14	38.69' Lt.			598.72
	E	602+56.14	38.69' Lt.	4+74.00	31.30' Lt.	603.30
SE Wingwall	F	602+56.15	63.67' Lt.	4+99.00	31.50' Lt.	602.30
	G	602+68.93	30.50' Rt.			594.79
	H	602+68.26	30.50' Rt.			599.37
	J	602+65.31	30.50' Rt.			599.29
	K	602+56.80	38.83' Rt.			598.68
	L	602+56.80	38.83' Rt.	4+74.00	31.60' Lt.	603.26
	M	602+57.27	68.83' Rt.	4+99.00	31.90' Lt.	602.26

REVISD SHEET 1/2/2026



DB STERLIN CONSULTANTS, INC.
123 N. Wacker Drive, Suite 2000
Chicago, Illinois 60606
312.857.1006

USER NAME	=	icsm-dstepw215	DESIGNED	-	EV	12/19/2025	EV
PLOT SCALE	=		DRAWN	-	SFM		
PLOT DATE	=	12/15/2025	CHECKED	-	BJN		
PLOT TIME	=	3:40:36 PM	DATE	-			

STATE OF ILLINOIS
DEPARTMENT OF TRANSPORTATION

SOUTH WINGWALLS PLAN AND ELEVATION
STRUCTURE NO. 016-2091


SCALE: SHEET NO. S-38 OF S-50 SHEETS

F.A.I. RTE	SECTION	COUNTY	TOTAL SHEETS	SHEET NO.
290	2019-189-BR	COOK	250	225
CONTRACT NO. 62K62				
ILLINOIS FED. AID PROJECT				


PILE DATA

Type: HP12 x 53
Nominal Required Bearing: 251 kip
Factored Resistance Available: 138 kip
Est. Length: 50'-0"
No. Production Piles: 52
No. Test Piles: 0
Battered Pile
Regular driven pile
Pre-core driven pile (See Note 3)

Exist. timber piles to be removed to 1'-0" below proposed grade or proposed bottom of footing elevation, whichever is lower, typ.

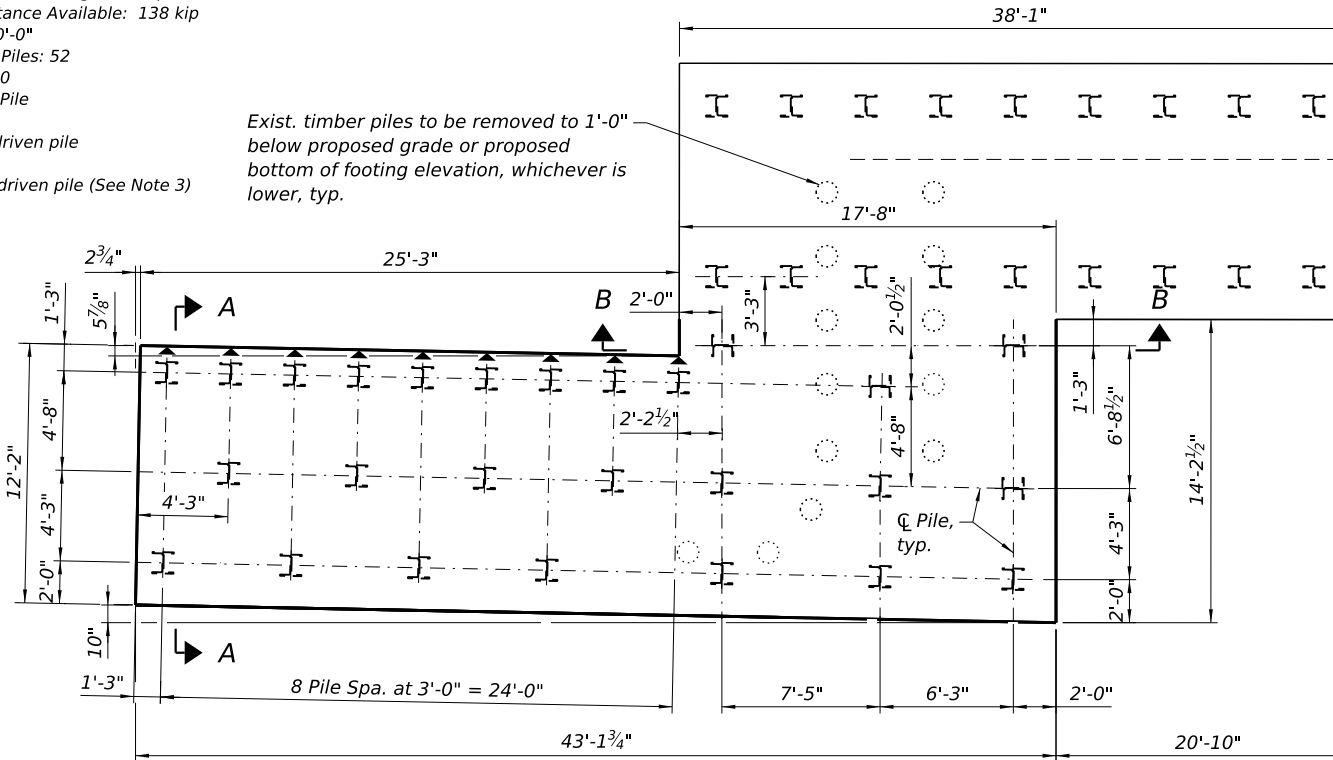

SOUTHWEST WINGWALL PILE PLAN

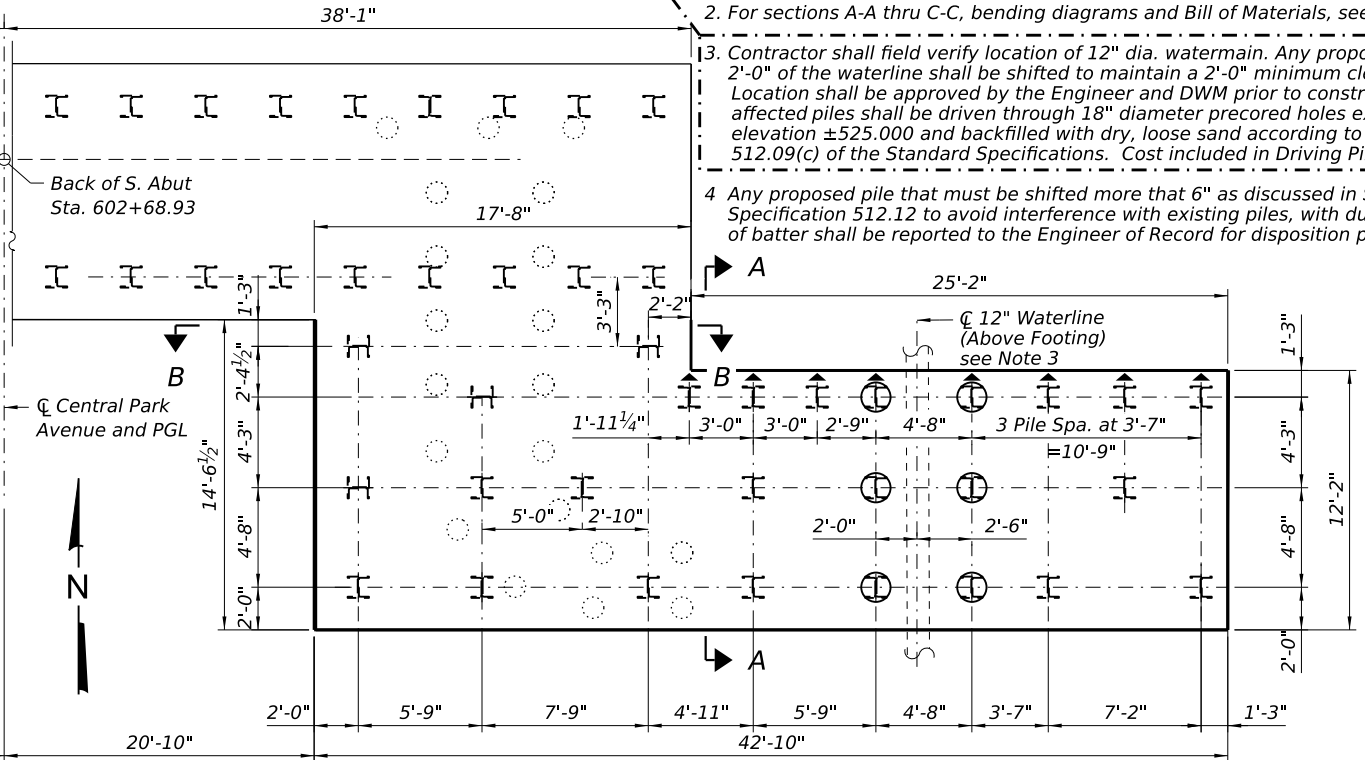


SOUTHEAST WINGWALL PILE PLAN


NOTES

- The Southeast and Southwest wingwall foundations will be poured monolithically with the South Abutment foundation. For South abutment foundation and reinforcement details, see Sheet S-37.
- For sections A-A thru C-C, bending diagrams and Bill of Materials, see Sheet S-40.
- Contractor shall field verify location of 12" dia. watermain. Any proposed pile within 2'-0" of the waterline shall be shifted to maintain a 2'-0" minimum clearance. Location shall be approved by the Engineer and DWM prior to construction. The affected piles shall be driven through 18" diameter precored holes extending to elevation ± 525.000 and backfilled with dry, loose sand according to Article 512.09(c) of the Standard Specifications. Cost included in Driving Piles.
- Any proposed pile that must be shifted more than 6" as discussed in Standard Specification 512.12 to avoid interference with existing piles, with due consideration of batter shall be reported to the Engineer of Record for disposition prior to driving.

- | | | | |
|---|--|----|------------------------------------|
| 1 | 8" min., typ. Bottom | 8 | 2-#5 w80(E) at 9" cts., Bottom |
| 2 | 1-#5 w81(E), Bottom | 9 | 9-#5 w80(E) at 9" cts., Bottom |
| 3 | 5-#5 w81(E) at 10" cts., Bottom | 10 | 7-#5 w80(E) at 9 1/2" cts., Bottom |
| 4 | 5-#5 w81(E) at 8 3/4" cts., Bottom | 11 | 3-#7 w80(E) at 7" cts., Bottom |
| 5 | 3-#5 w81(E) at 7" cts., Bottom | 12 | 1-#7 t80(E), Bottom |
| 6 | 1-#7 t81(E), Bottom | 13 | 8-#7 t80(E) at 9" cts., Bottom |
| 7 | 4-#7 t81(E) at 6 1/2" cts., Bottom
typ. 8 locations | 14 | 5-#7 t80(E) at 8 3/4" cts., Bottom |
| | | 15 | 3-#7 t80(E) at 7" cts., Bottom |

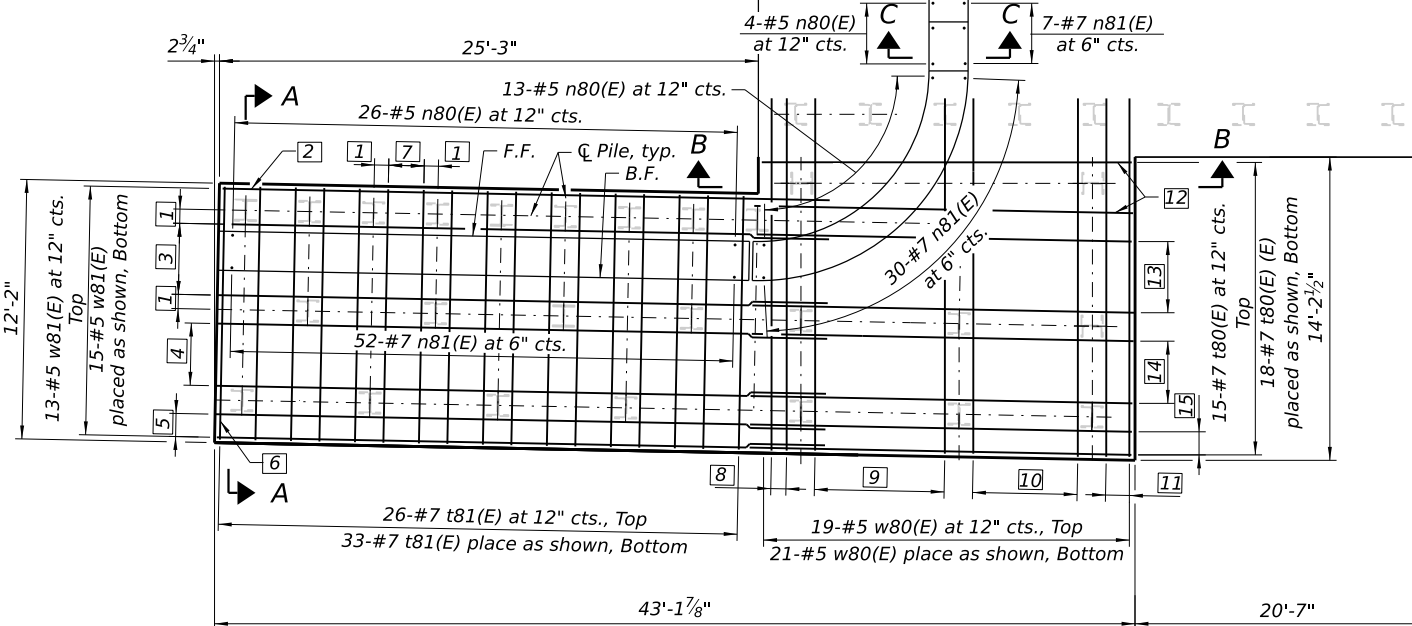

SOUTHWEST WINGWALL FOUNDATION PLAN

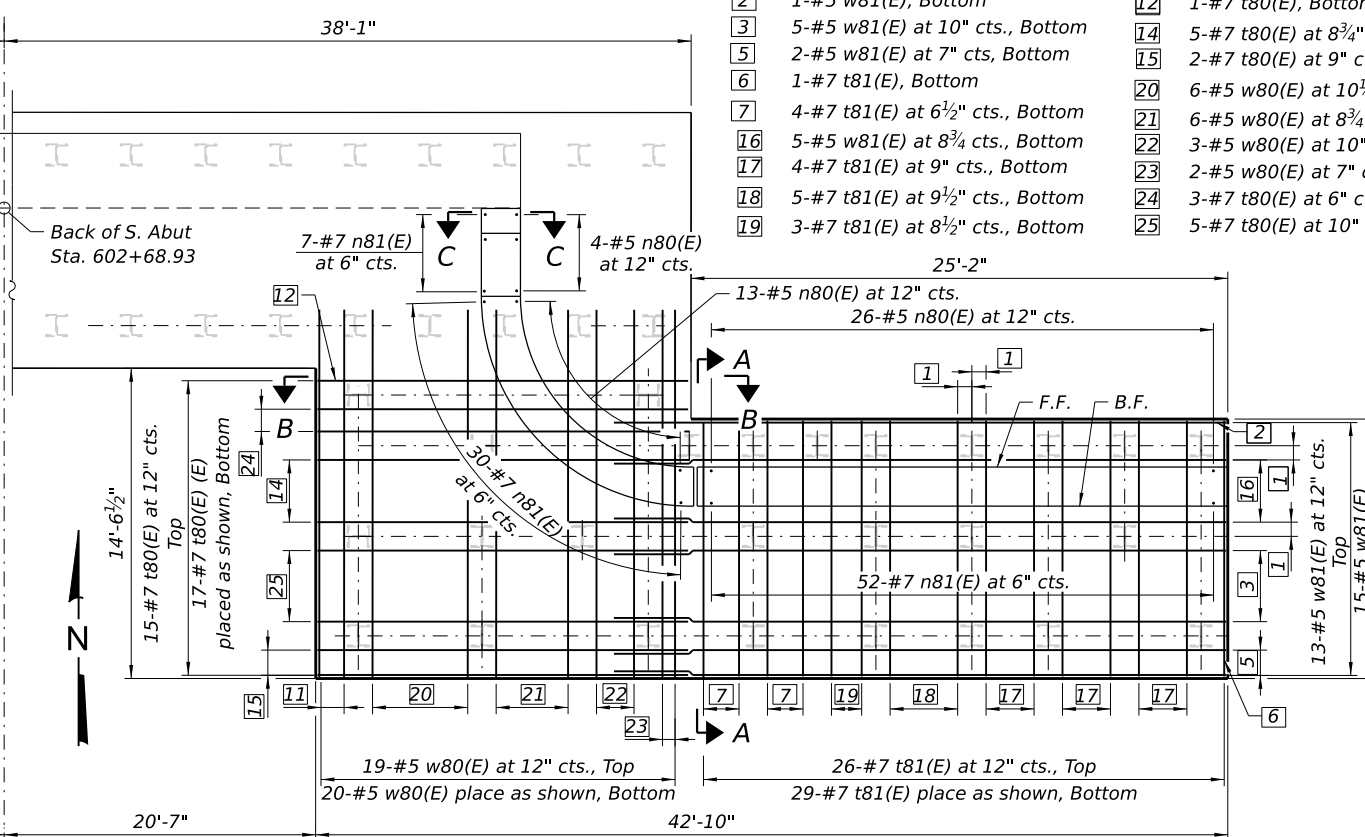

SOUTHEAST WINGWALL FOUNDATION PLAN

- | | | | |
|----|------------------------------------|----|-------------------------------------|
| 1 | 8" min., typ. Bottom | 11 | 2-#5 w80(E) at 7" cts., Bottom |
| 2 | 1-#5 w81(E), Bottom | 12 | 1-#7 t80(E), Bottom |
| 3 | 5-#5 w81(E) at 10" cts., Bottom | 14 | 5-#7 t80(E) at 8 3/4" cts., Bottom |
| 5 | 2-#5 w81(E) at 7" cts., Bottom | 15 | 2-#7 t80(E) at 9" cts., Bottom |
| 6 | 1-#7 t81(E), Bottom | 20 | 6-#5 w80(E) at 10 1/2" cts., Bottom |
| 7 | 4-#7 t81(E) at 6 1/2" cts., Bottom | 21 | 6-#5 w80(E) at 8 3/4" cts., Bottom |
| 16 | 5-#5 w81(E) at 8 3/4" cts., Bottom | 22 | 3-#5 w80(E) at 10" cts., Bottom |
| 17 | 4-#7 t81(E) at 9" cts., Bottom | 23 | 2-#5 w80(E) at 7" cts., Bottom |
| 18 | 5-#7 t81(E) at 9 1/2" cts., Bottom | 24 | 3-#7 t80(E) at 6" cts., Bottom |
| 19 | 3-#7 t81(E) at 8 1/2" cts., Bottom | 25 | 5-#7 t80(E) at 10" cts., Bottom |

REVISED SHEET 1/2/2026

FILE NAME: \\cs\m-dstepw2\mcs_pdf_work_dh\1008\5302_90\0162091-D162K62-S03S-South Wingwalls Fdn Plan.dgn

FILE NAME: \\cs\m-dstepw2\mcs_pdf_work_dh\1008\5302_88\0162091-D162K62-S040-South Wing Walls.dgn



DB STERLIN CONSULTANTS, INC.
123 N. Wacker Drive, Suite 2000
Chicago, Illinois 60606
312.857.1000

USER NAME =	icsm-dstepw215	DESIGNED -	EV	REVISED -	12/19/2025	LS
PLOT SCALE =		DRAWN -	SFM	REVISED -		
PLOT DATE =	12/12/2025	CHECKED -	BJN	REVISED -		
PLOT TIME =	8:46:24 PM	DATE -		REVISED -		


STATE OF ILLINOIS
DEPARTMENT OF TRANSPORTATION

SOUTH WINGWALLS DETAILS
STRUCTURE NO. 016-2091


SCALE: SHEET NO. S-40 OF S-50 SHEETS

TOTAL BILL OF MATERIAL
SW and SE Wingwalls


Bar	No.	Size	Length	Shape
d80(E)	56	#5	2'-5"	□
h80(E)	30	#5	2'-9"	—
h81(E)	10	#5	1'-11"	—
h82(E)	20	#5	16'-2"	⌒
h83(E)	20	#5	18'-6"	⌒
h84(E)	84	#5	24'-7"	—
h85(E)	30	#5	3'-5"	—
h86(E)	10	#5	2'-7"	—
h87(E)	20	#5	16'-0"	⌒
h88(E)	20	#5	18'-5"	⌒
h89(E)	16	#5	24'-7"	—
h90(E)	8	#5	9'-0"	—
h91(E)	8	#5	6'-2"	—
h92(E)	8	#4	5'-4"	—
n80(E)	89	#5	7'-9"	⌒
n81(E)	180	#7	8'-6"	⌒
t80(E)	65	#7	17'-6"	—
t81(E)	114	#7	11'-10"	—
v80(E)	2	#5	14'-1"	—
v81(E)	7	#5	18'-9"	—
v82(E)	28	#5	18'-4"	—
v83(E)	52	#5	18'-9"	—
v84(E)	2	#7	14'-1"	—
v85(E)	12	#7	18'-9"	—
v86(E)	64	#7	18'-4"	—
v87(E)	102	#7	21'-9"	—
v88(E)	59	#5	5'-4"	⌒
v89(E)	4	#5	6'-2"	—
v90(E)	4	#7	9'-4"	—
w80(E)	80	#5	18'-4"	—
w81(E)	56	#5	43'-2"	—
Structure Excavation			Cu Yd	1,144.3
Concrete Structures			Cu Yd	265.8
Concrete Superstructure			Cu Yd	6.3
Protective Coat			Sq Yd	1.3
Reinforcement Bars, Epoxy Coated			Pound	27,100
Furnishing Steel Piles HP12x53			Foot	2,600
Driving Piles			Foot	2,600
Pile Shoes			Each	52
Concrete Sealer			Sq Ft	1,456
Granular Backfill for Structures			Cu Yd	854.7
Geocomposite Wall Drain			Sq Yd	183
Pipe Underdrains for Structures 4"			Foot	85

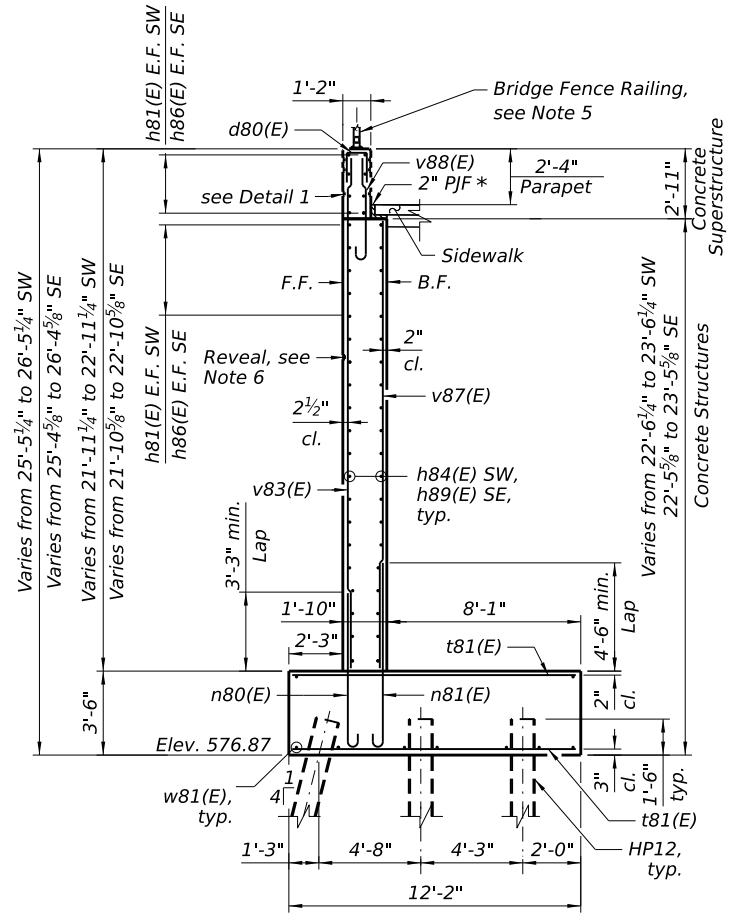


SECTION A-A

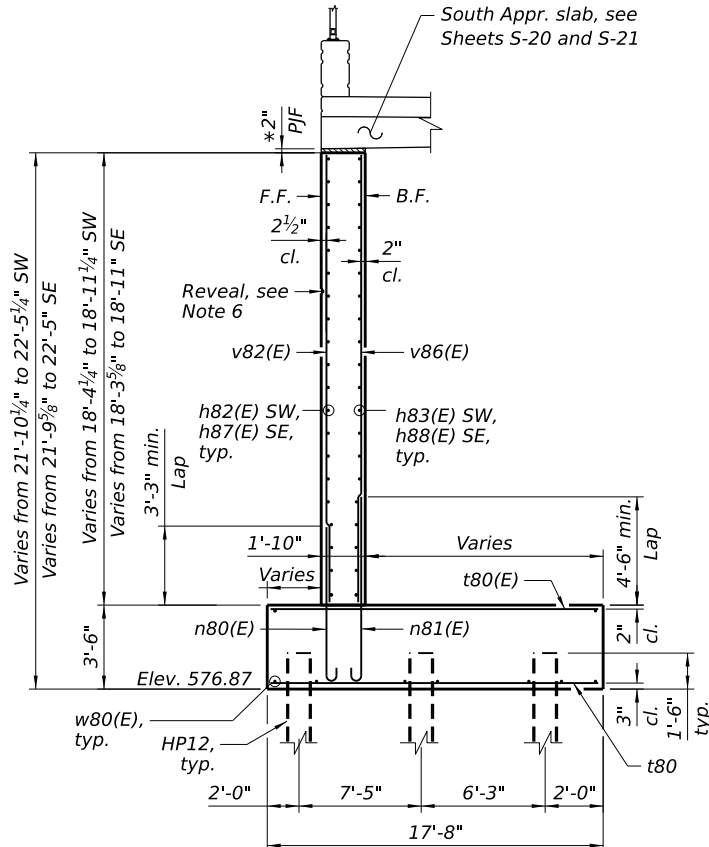


SECTION B-B

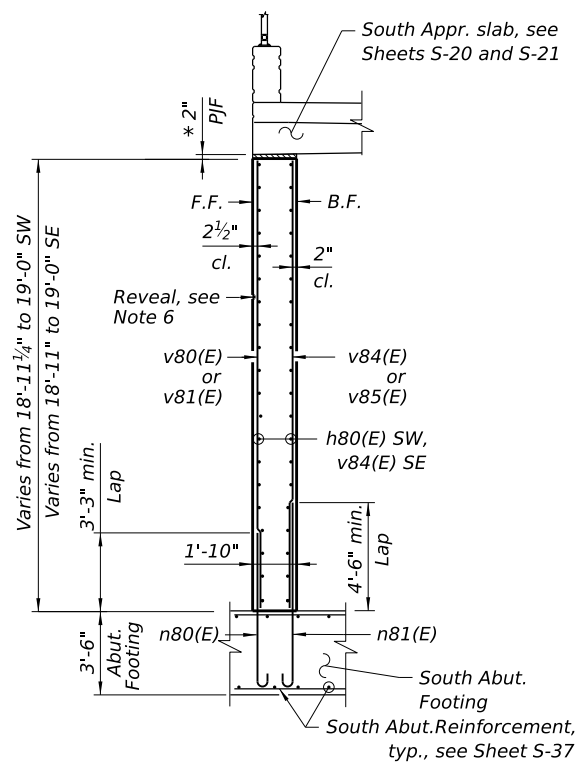

SECTION C-C

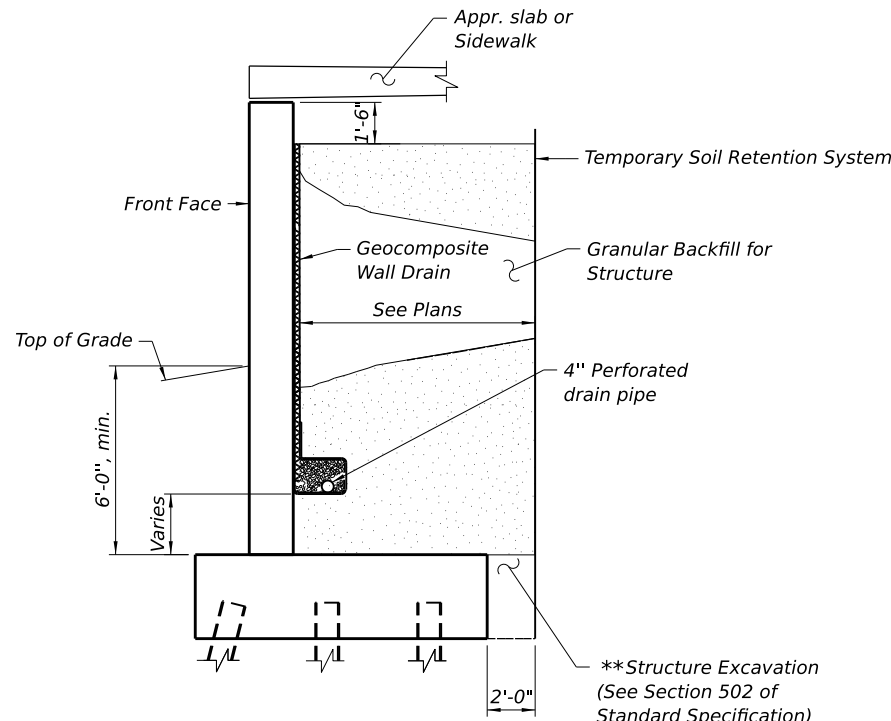

SECTION THRU WINGWALL

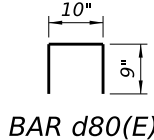

BAR d80(E)

Bar	R	L1	L
h82(E)	8'-2"	12'-6"	15'-5"
h83(E)	9'-4 1/2"	14'-4"	17'-9"
h87(E)	8'-2"	12'-10"	15'-5"
h88(E)	9'-4 1/2"	14'-9"	17'-9"


BARS h82(E), h83(E), h87(E) AND h88(E)

Bar	A	B	C
n80(E)	7'-3"	8"	5"
n81(E)	8'-6"	10"	7"
v88(E)	4'-3"	8"	5"

BARS n80(E), n81(E) AND v88(E)

NOTES

- For location of Sections A-A thru C-C, see Sheets S-38 and S-39
- Concrete Sealer shall be applied to exposed front face of wingwalls per Section 587 of the Standard Specifications.
- Protective Coat shall be applied to front face of parapet.
- For additional parapet reveal details, see Sheet S-16.
- For Bridge Fence Railing details, see Sheets S-25 and S-26.
- For reveal pattern and layout, see Sheet S-41.

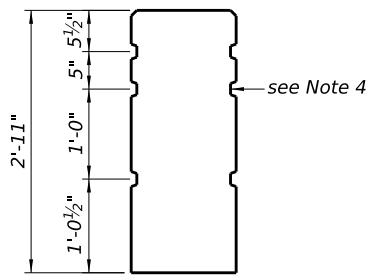


DETAIL 1

REVISED SHEET 1/2/2026

F.A.I. RTE	SECTION	COUNTY	TOTAL SHEETS	SHEET NO.
290	2019-189-BR	COOK	250	227
CONTRACT NO. 62K62				
ILLINOIS FED. AID PROJECT				

FILE NAME: \\casM-dbsstepw21\CS_pdf_work_d\102815424_137D162K62-sh-xssht-12.dgn

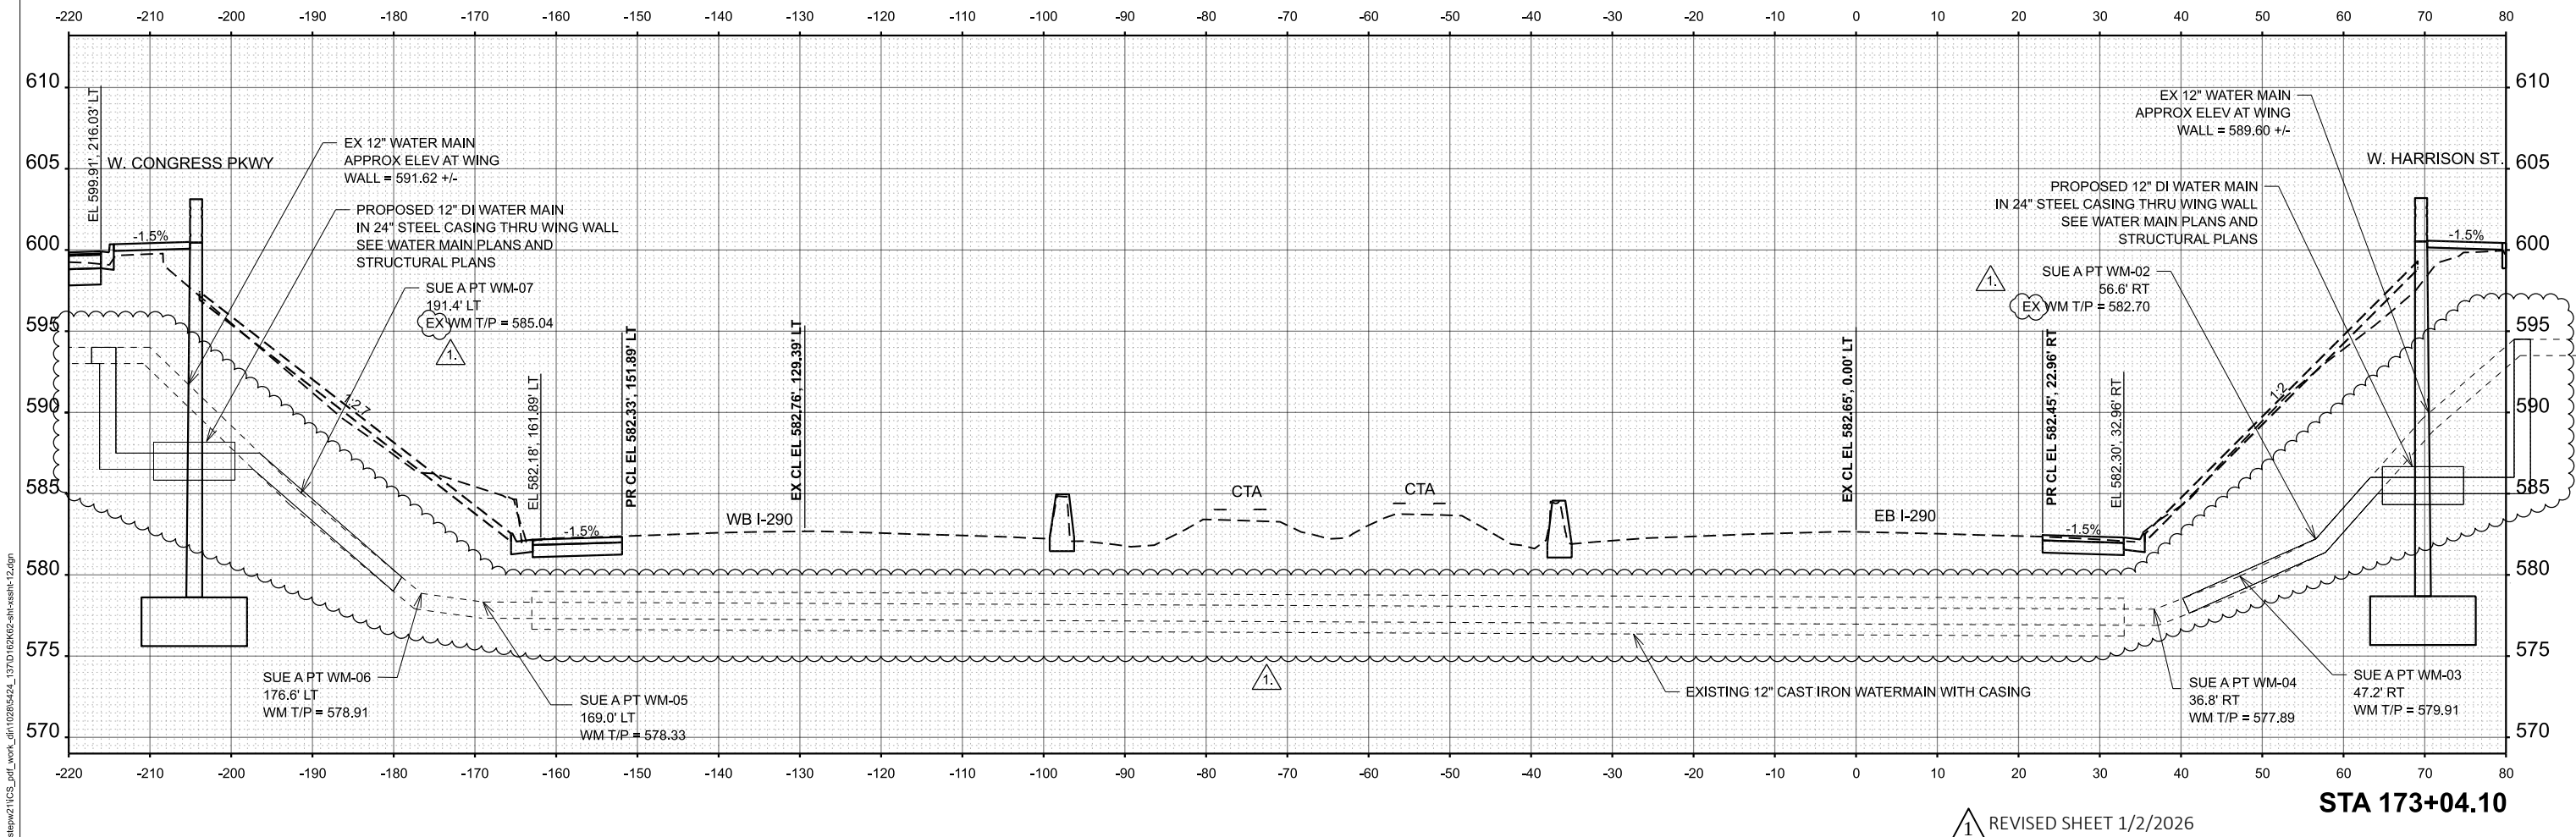

1 REVISED SHEET 1/2/2026

STA 173+04.10



USER NAME =	icsM-dbsstepw21\$	DESIGNED -	RCH	REVISED -	12/19/2025	KRW
PLOT SCALE =	0.16666667' / in.	DRAWN -	RCH	REVISED -		
PLOT DATE =	12/15/2025	CHECKED -	KRW	REVISED -		
PLOT TIME =	2:20:56 PM	DATE -		REVISED -		

STATE OF ILLINOIS
DEPARTMENT OF TRANSPORTATION

I-290
CROSS SECTIONS

SCALE: 1" = 10' SHEET NO. XS-12 OF XS-13 SHEETS STA. 173+04.10

F.A.I. RTE	SECTION	COUNTY	TOTAL SHEETS	SHEET NO.
290	2019-189-BR	COOK	250	249
CONTRACT NO. 62K62				
ILLINOIS FED. AID PROJECT				