

SN 002-0032
ORIGINAL CONST.

STATE OF ILLINOIS
DEPARTMENT OF TRANSPORTATION
DIVISION OF HIGHWAYS


PLANS FOR PROPOSED
FEDERAL AID HIGHWAY
F.A. ROUTE 14 (ILL. RTE. 3)
SECTION 133B-1, (133-2) A
PROJECT NO. F-BRF-14 (119)
ALEXANDER COUNTY

AS BUILT PLANS

AS BUILT PLANS

14 * ALEXANDER 14S 1
* 133B-1, (133-2) A

P-99-048-83

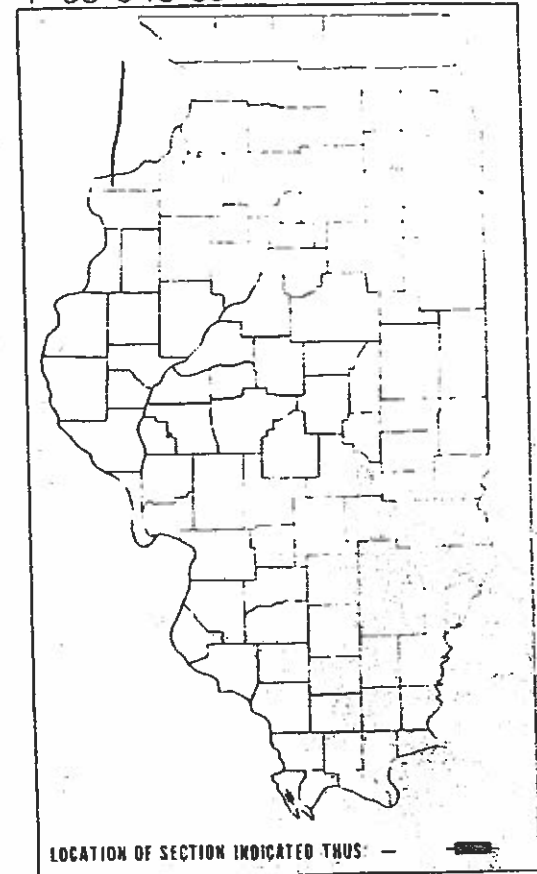

Index Of Sheets	Shl. No. <u>8</u>
Summary Of Quantities	Shl. No. <u>9</u>

C-99-021-87

FOR INFORMATION ONLY

Office Plans (As Built)

Project & Proposed Grading End
Sta. 1232 + 00

EQUATION STATION
STA. 1193 + 19.26 BACK +
STA. 1193 + 40.48 AHEAD

SEC. 133B-1 STA. 1209 + 90.00
PROPOSED STRUCTURE - 3 SPAN, R.C. SLAB
ON 54" STEEL PLATE GIRDERS;
400' - 0" BK-BK. ABUTMENTS (ALONG
LOCAL TANGENT)
STRUCTURE NO. 002 - 0032

Project & Proposed Grading Begin
Sta. 1106 + 70

NET LENGTH SEC. (133-2) A : 12,107.74 LIN. FT. = 2.293 MILE
NET LENGTH SEC. 133B-1 : 401.04 LIN. FT. = 0.076 MILE
PROJECT TOTAL LENGTH : 12,508.78 LIN. FT. = 2.369 MILE

AS BUILT PLANS

AS BUILT PLANS

AS BUILT PLANS

STATE OF ILLINOIS
DEPARTMENT OF TRANSPORTATION
DIVISION OF HIGHWAYS

DESIGNED Jan 13 '88 J.L. Jennings
 CHECKED 2-25 '88 Angie Ladd
 DRAWN 2-25 '88 N.W. Wilson
 APPROVED 2-25 '88 John Thompson

CONTRACT NO. 98006

ALEXANDER COUNTY SECTION 133B-1, (133-2) A

F.A. ROUTE 14 (ILL. RTE. 3)


ROUTE NO.	SEC.	COUNTY	TOTAL SHEETS	SHEET NO.
F. A. 14	15	ALEXANDER	145	21
FED. ROAD DIST. 7 ILLINOIS PROJECT				
* SEC. 133B-1, (133-2)A				

CURVE DATA

R = 1,909.86' D = 3°-00'-00"
 L = 2,044.35' Δ = 61°-19'-50"
 T = 1,132.43' E = 310.49'
 P.E. STA. 1204+72.91
 PROP. S.E. = 0.06 FT/FT
 ATTAIN S.E. STA. 1191+00 TO STA. 1194+11
 REMOVE S.E. STA. 1213+18 TO STA. 1215+18



PLAN
 SHOWS
 ALL
 NOTES
 IN
 THIS
 SHEET
 APPLY
 TO
 THIS
 SHEET
 ONLY

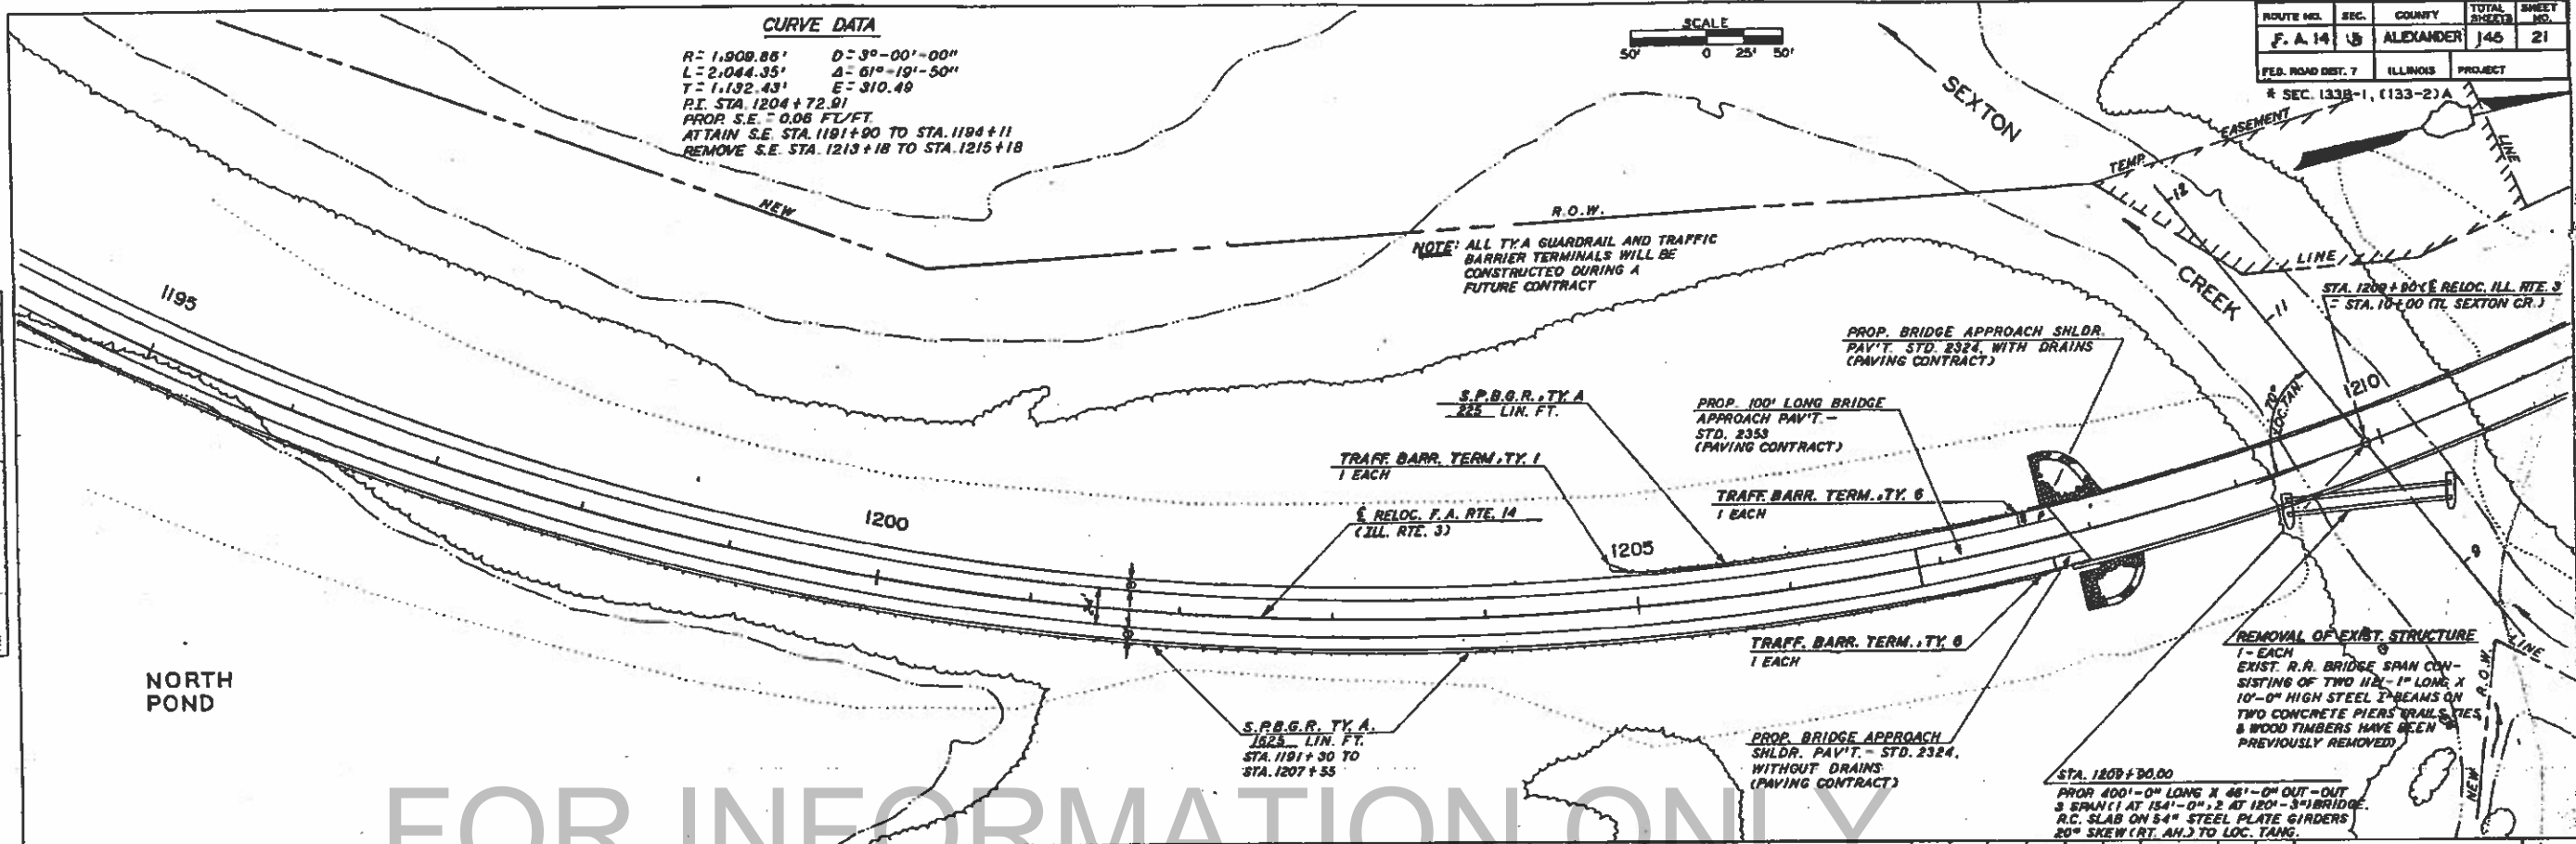

FOR INFORMATION ONLY

PROFILE
 SHOWS
 ALL
 NOTES
 IN
 THIS
 SHEET
 APPLY
 TO
 THIS
 SHEET
 ONLY



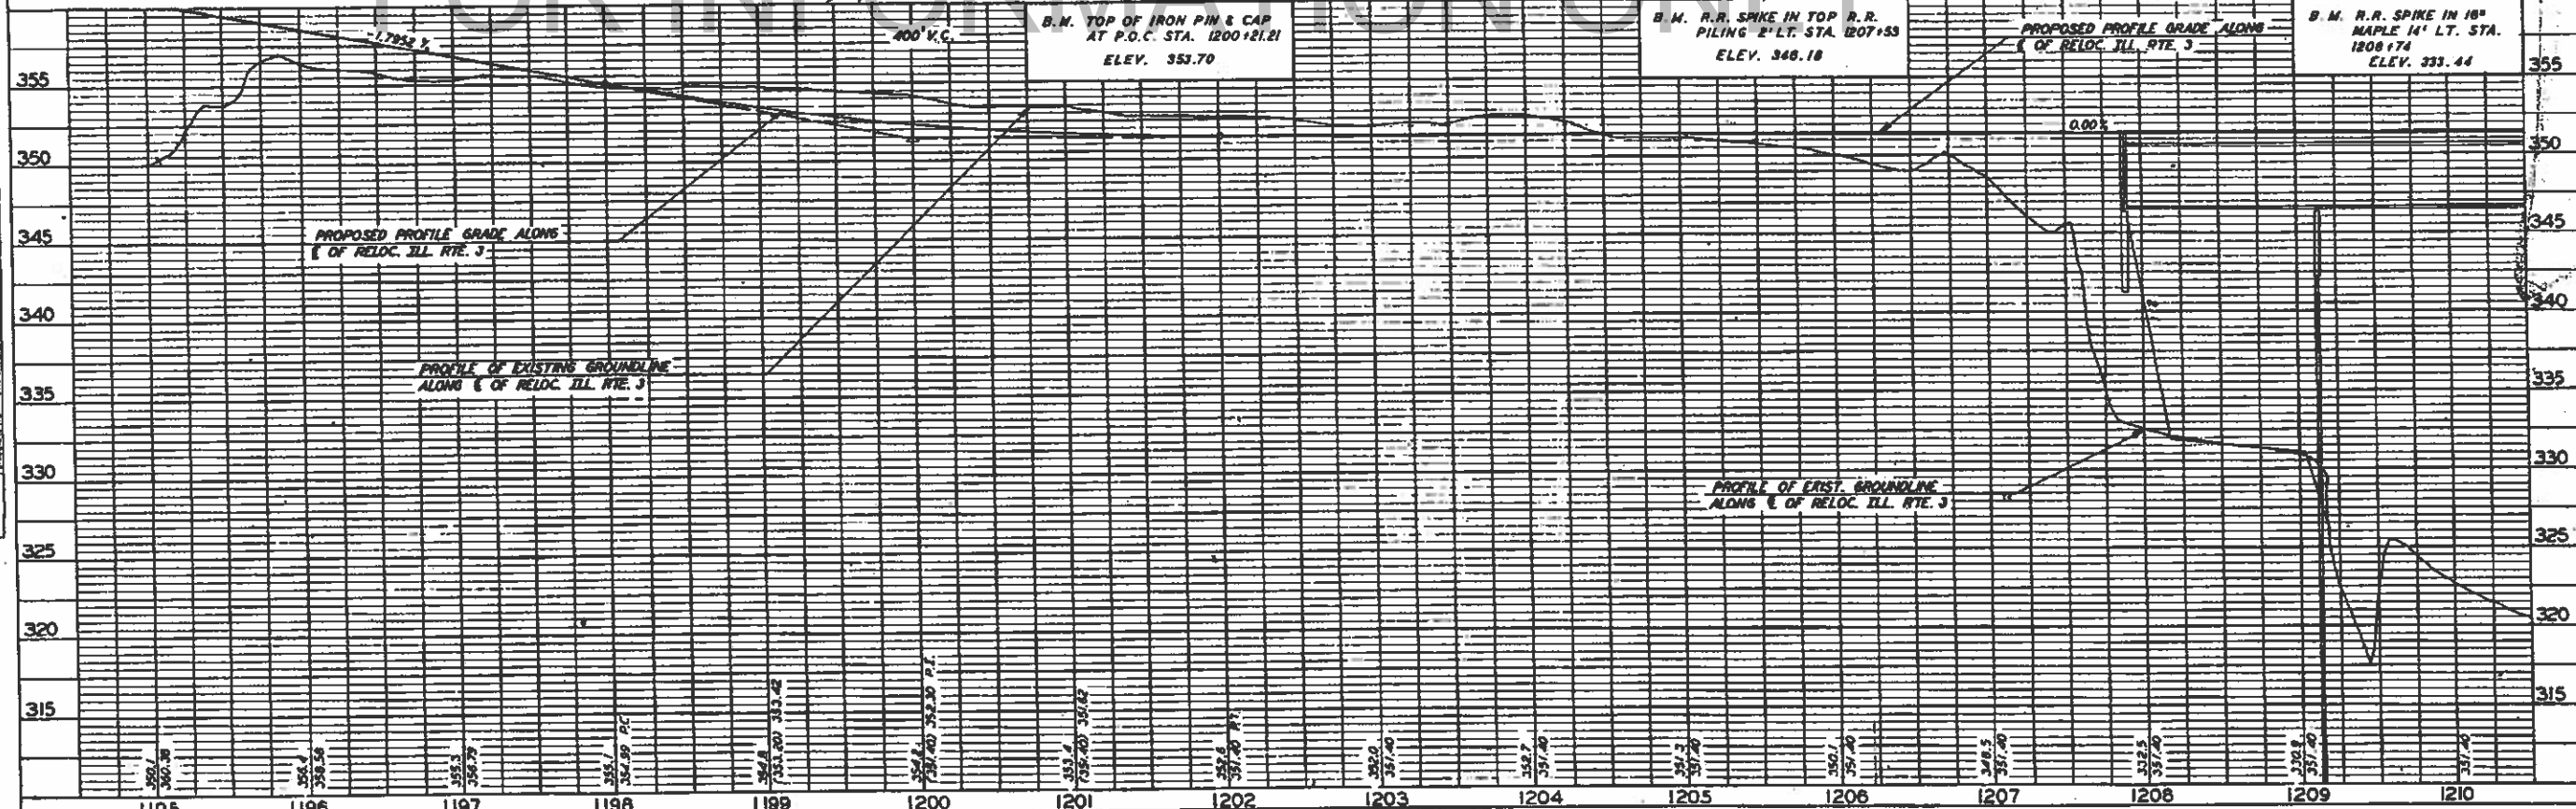


PLATE 1-SINGLE PLAN AND PROFILE-PALL LINE

STA. 1195+00 TO STA. 1210+00

ROUTE NO.	SEC.	COUNTY	TOTAL SHEETS	SHEET NO.
RTA-14	2	ALEXANDER	145	22
FEA ROAD DIST. 7	ILLINOIS	PROJECT		
K SEC. 1338-1 (433-2) A				

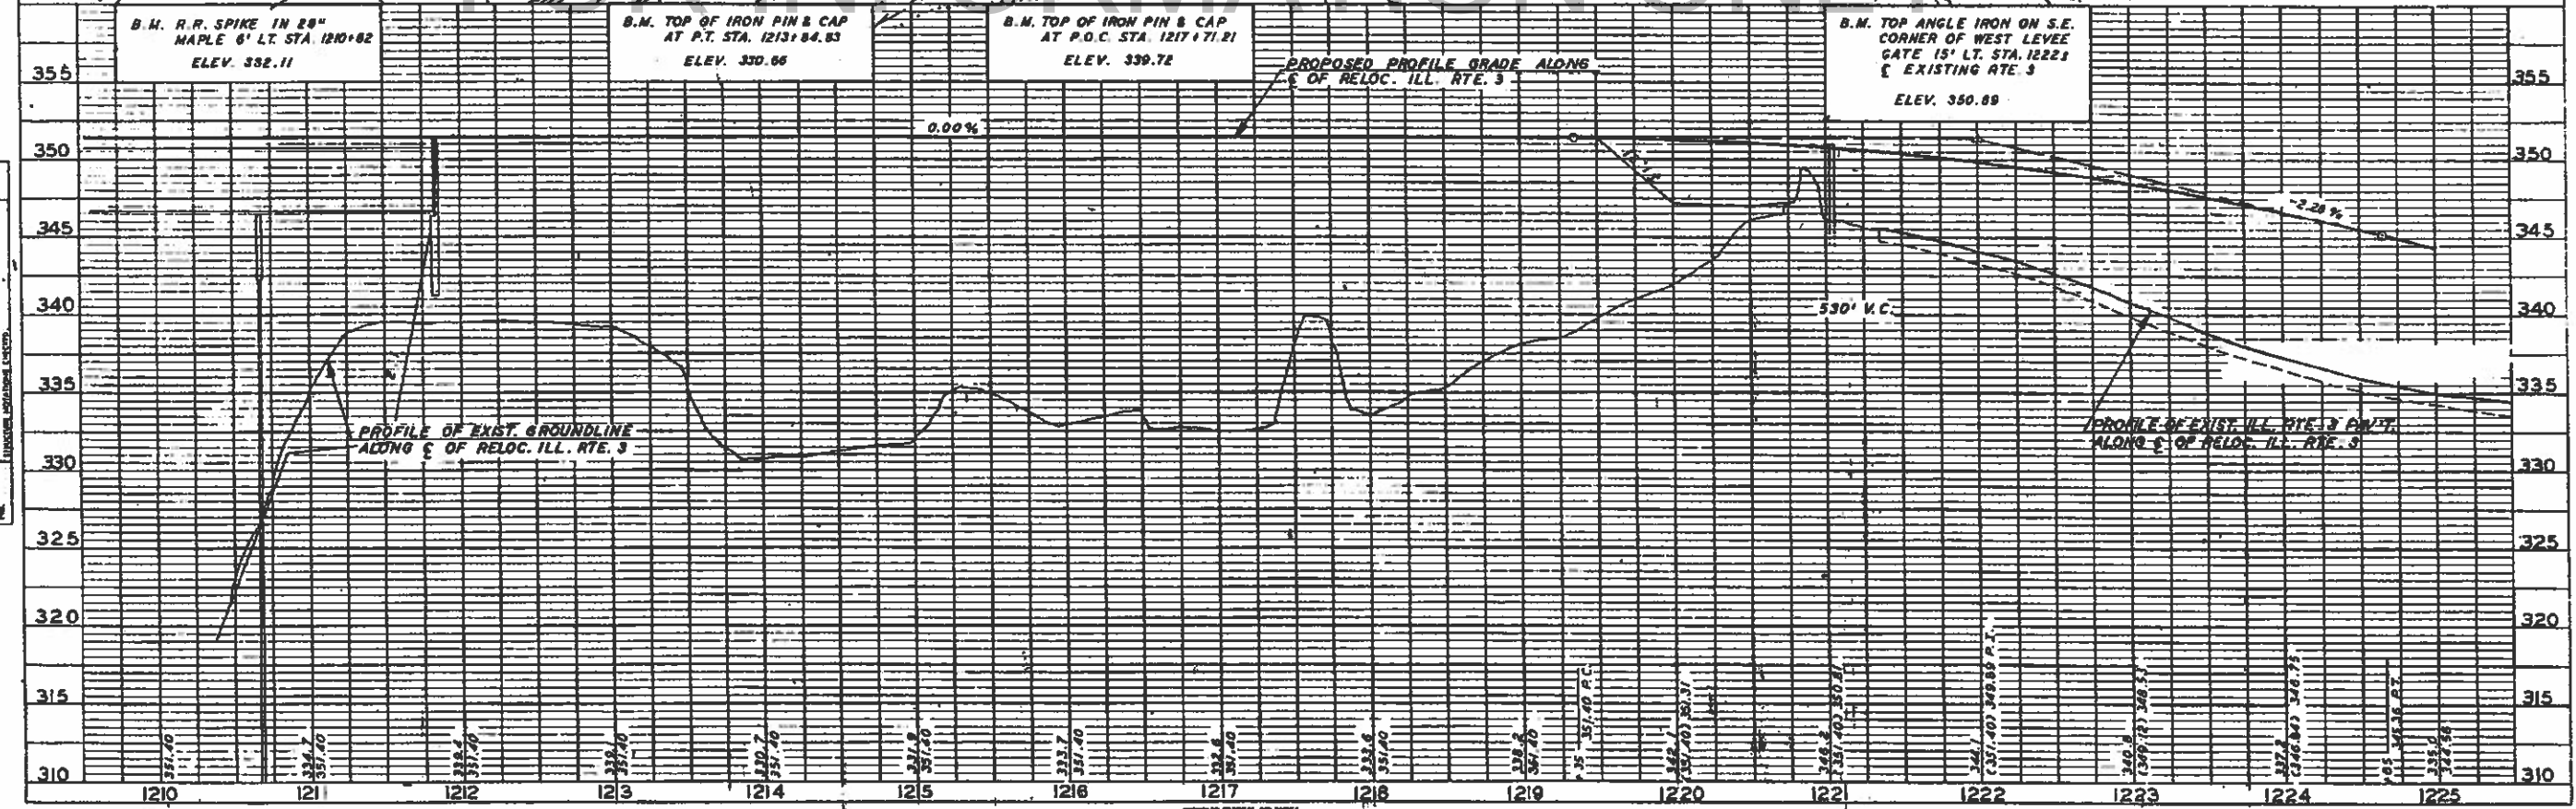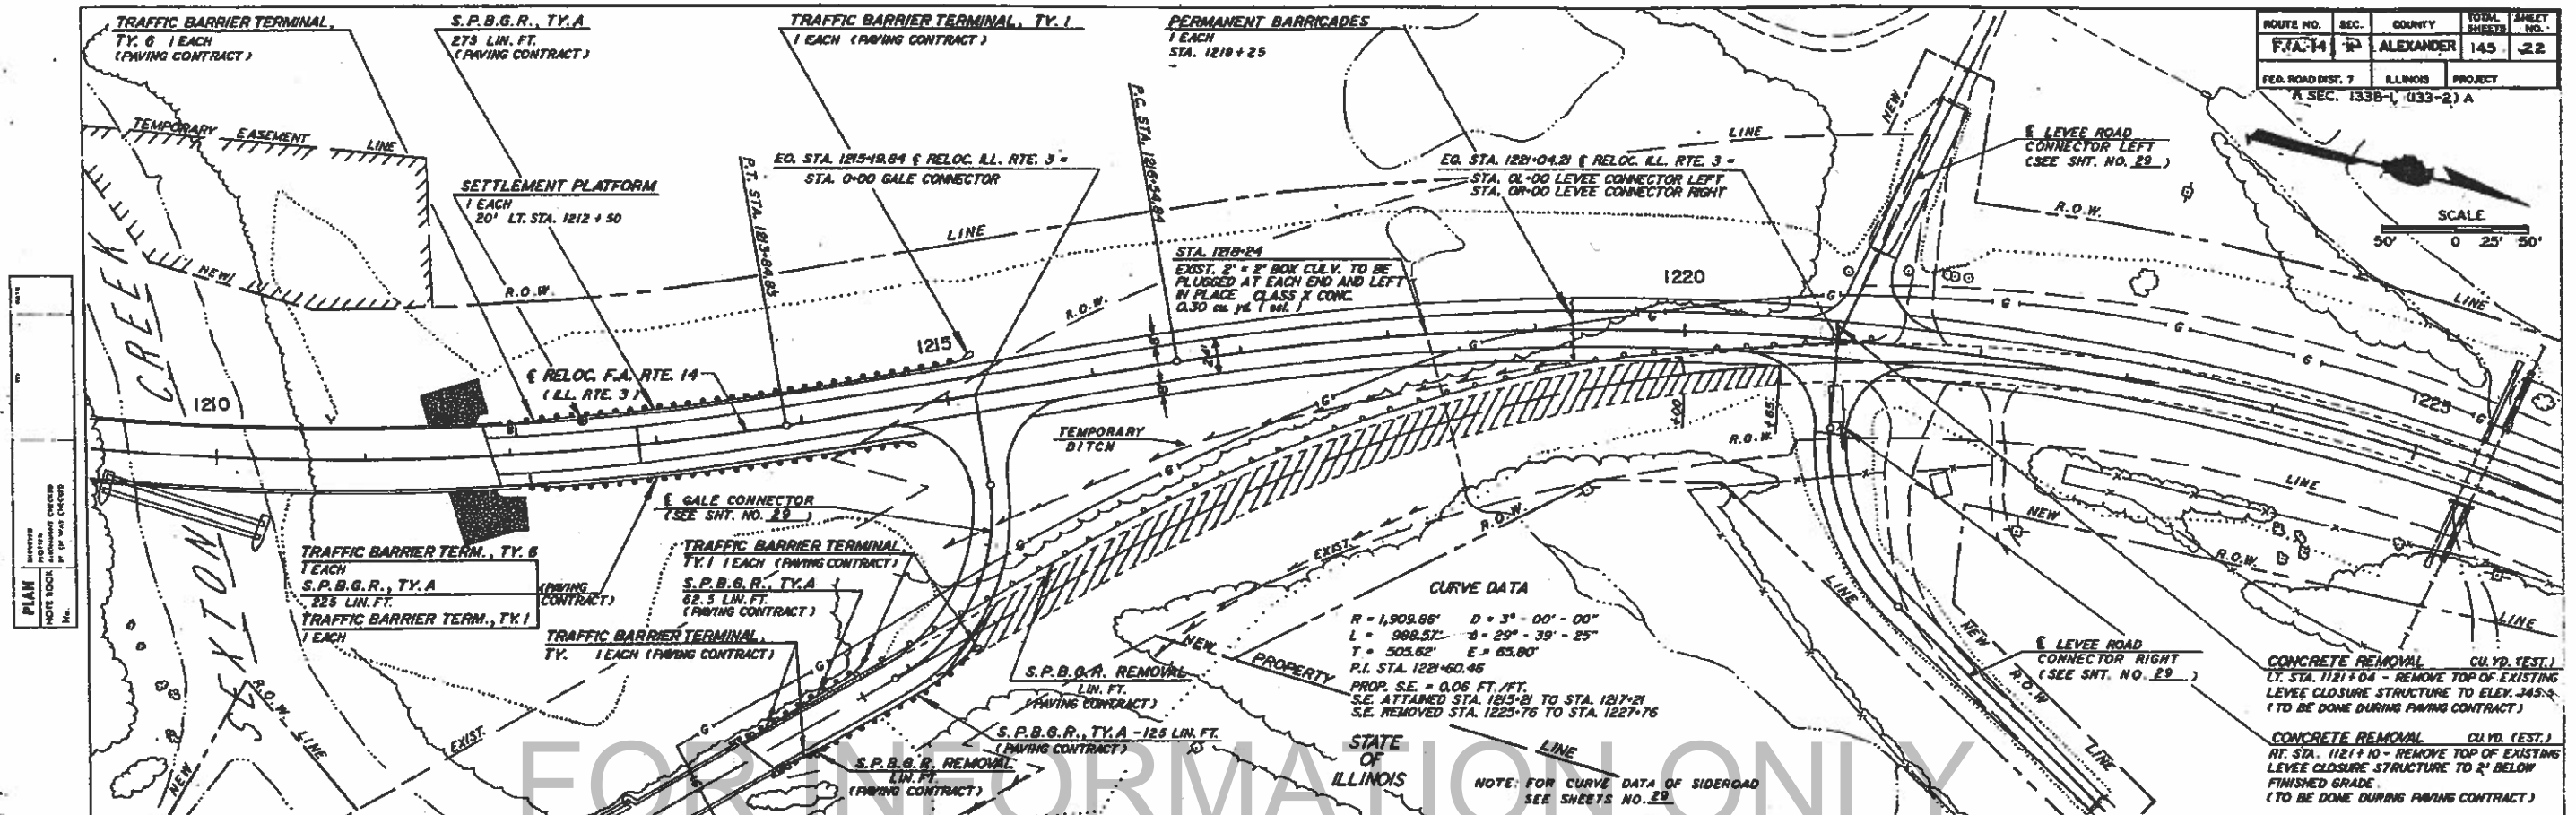


PLAN
 1/4" = 100'
 NORTH SOUTH
 No. 1

PROFILE
 1/4" = 10'
 NORTH SOUTH
 No. 1


PLATE 14 SINGLE PLAN AND PROFILE SHEET
 DRAWN BY: [Name]
 CHECKED BY: [Name]

STA. 1210+00 TO STA. 1225+00

ROUTE NO.	SEC.	COUNTY	TOTAL SHEETS	SHEET NO.
F.A. 14	9	ALEXANDER	145	128
LEVEE ROAD DIST. 7	ILLINOIS	PROJECT	A SEC. 133B-1, (U33-2) A	

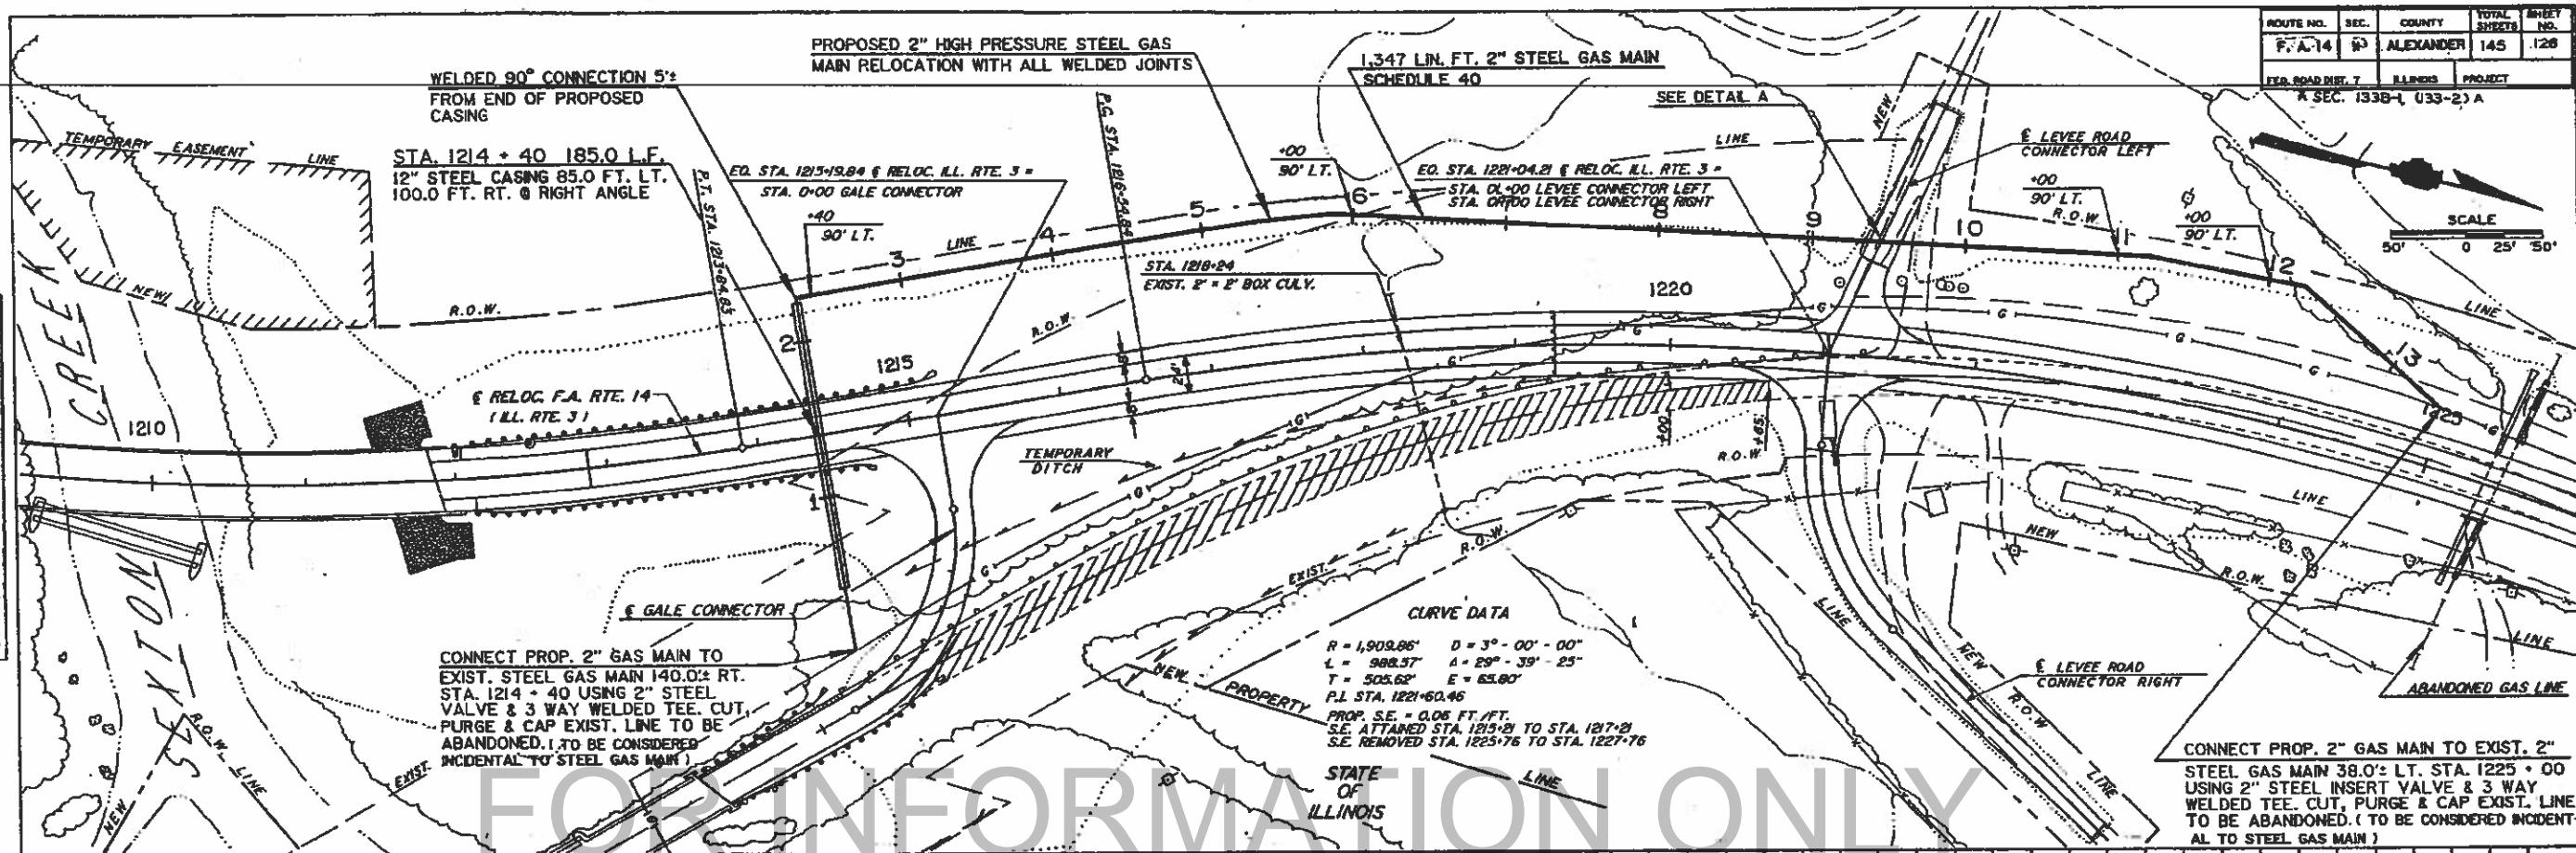

PLAN
 DATE: _____
 DRAWN BY: _____
 CHECKED BY: _____
 PROJECT NO. _____

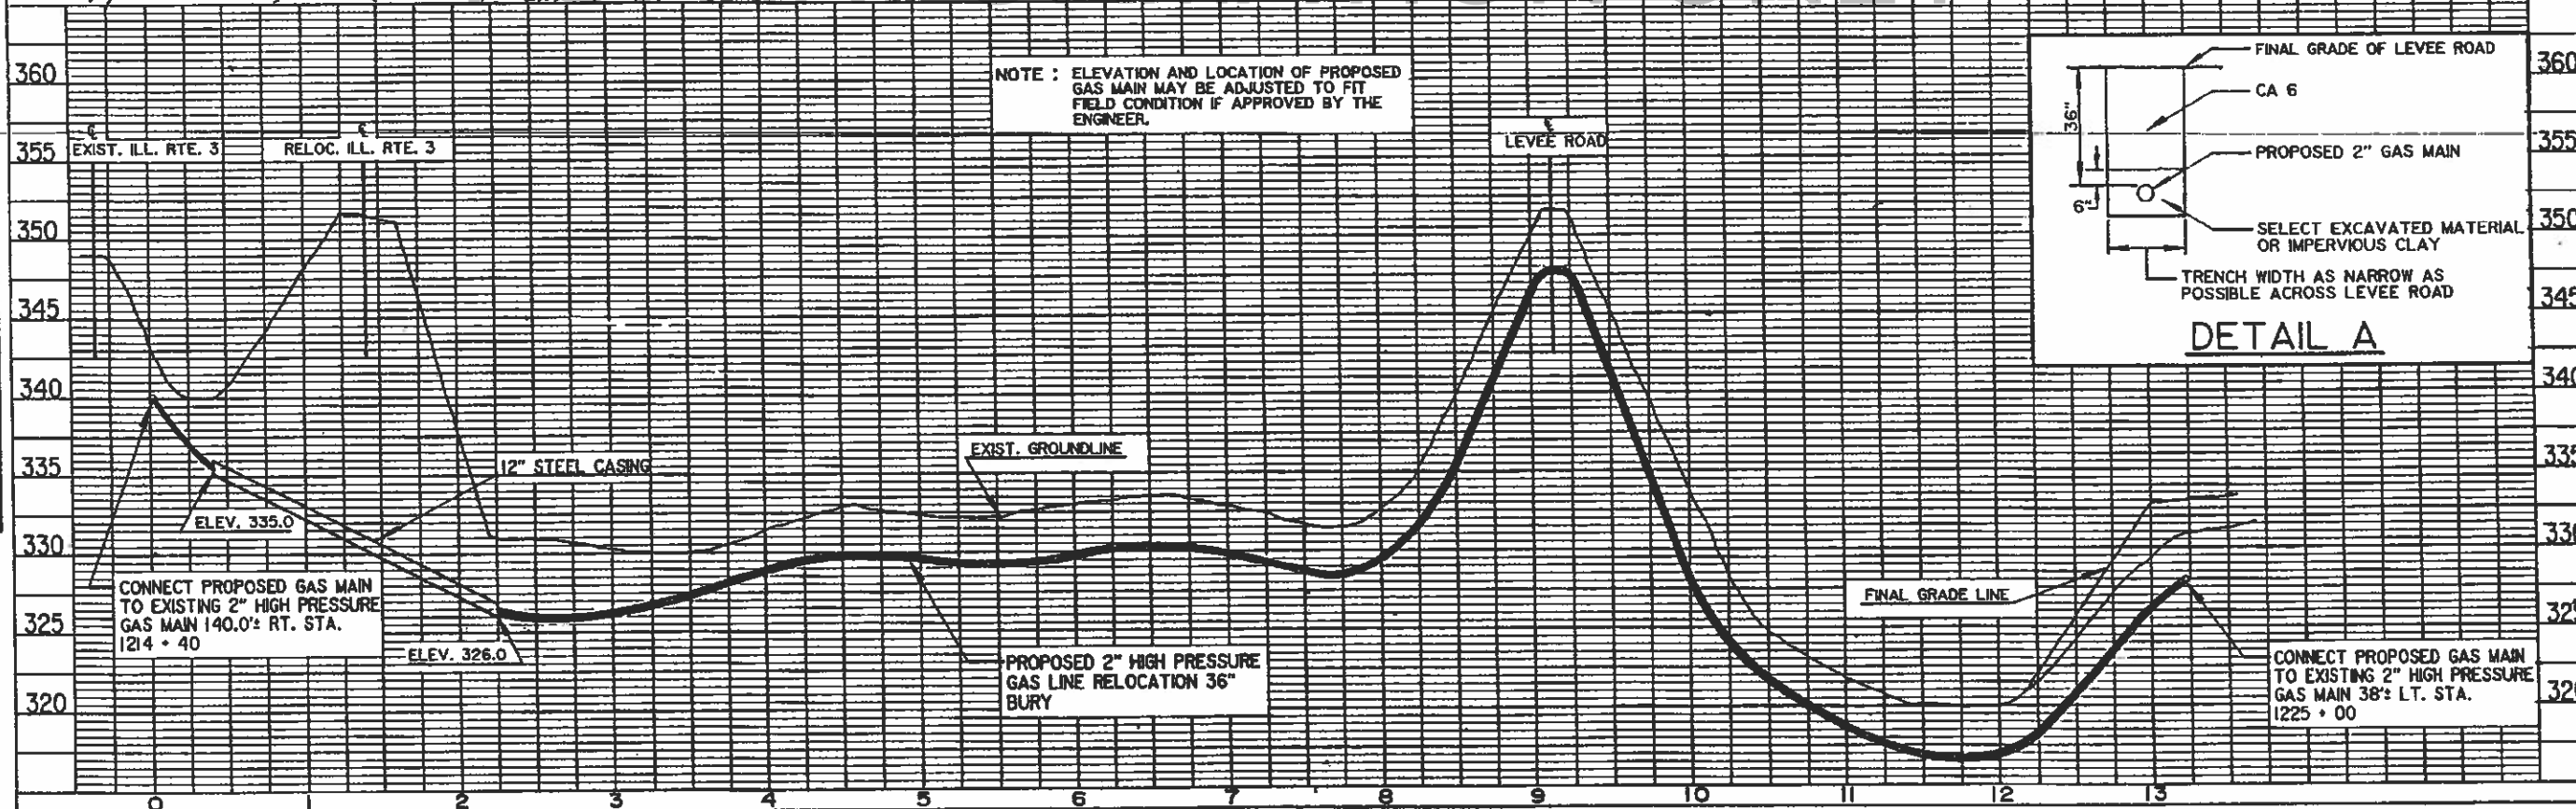

PROFILE
 DATE: _____
 DRAWN BY: _____
 CHECKED BY: _____
 PROJECT NO. _____


PLATE 1-SINGLE PLAN AND PROFILE FULL LINE

DETAILS OF PROPOSED GAS LINE ADJUSTMENT

B.M. Benchmark R.R. Spike in 16" Maple tree, 14' Lt. Sta. 1208+74.00 Elev. 333.44

STATE OF ILLINOIS
DEPARTMENT OF TRANSPORTATION

PROJECT NO.	133B-1	DESIGNER	Alexander	DATE	M5	12'	SHEET NO. 1
19 SHEETS							

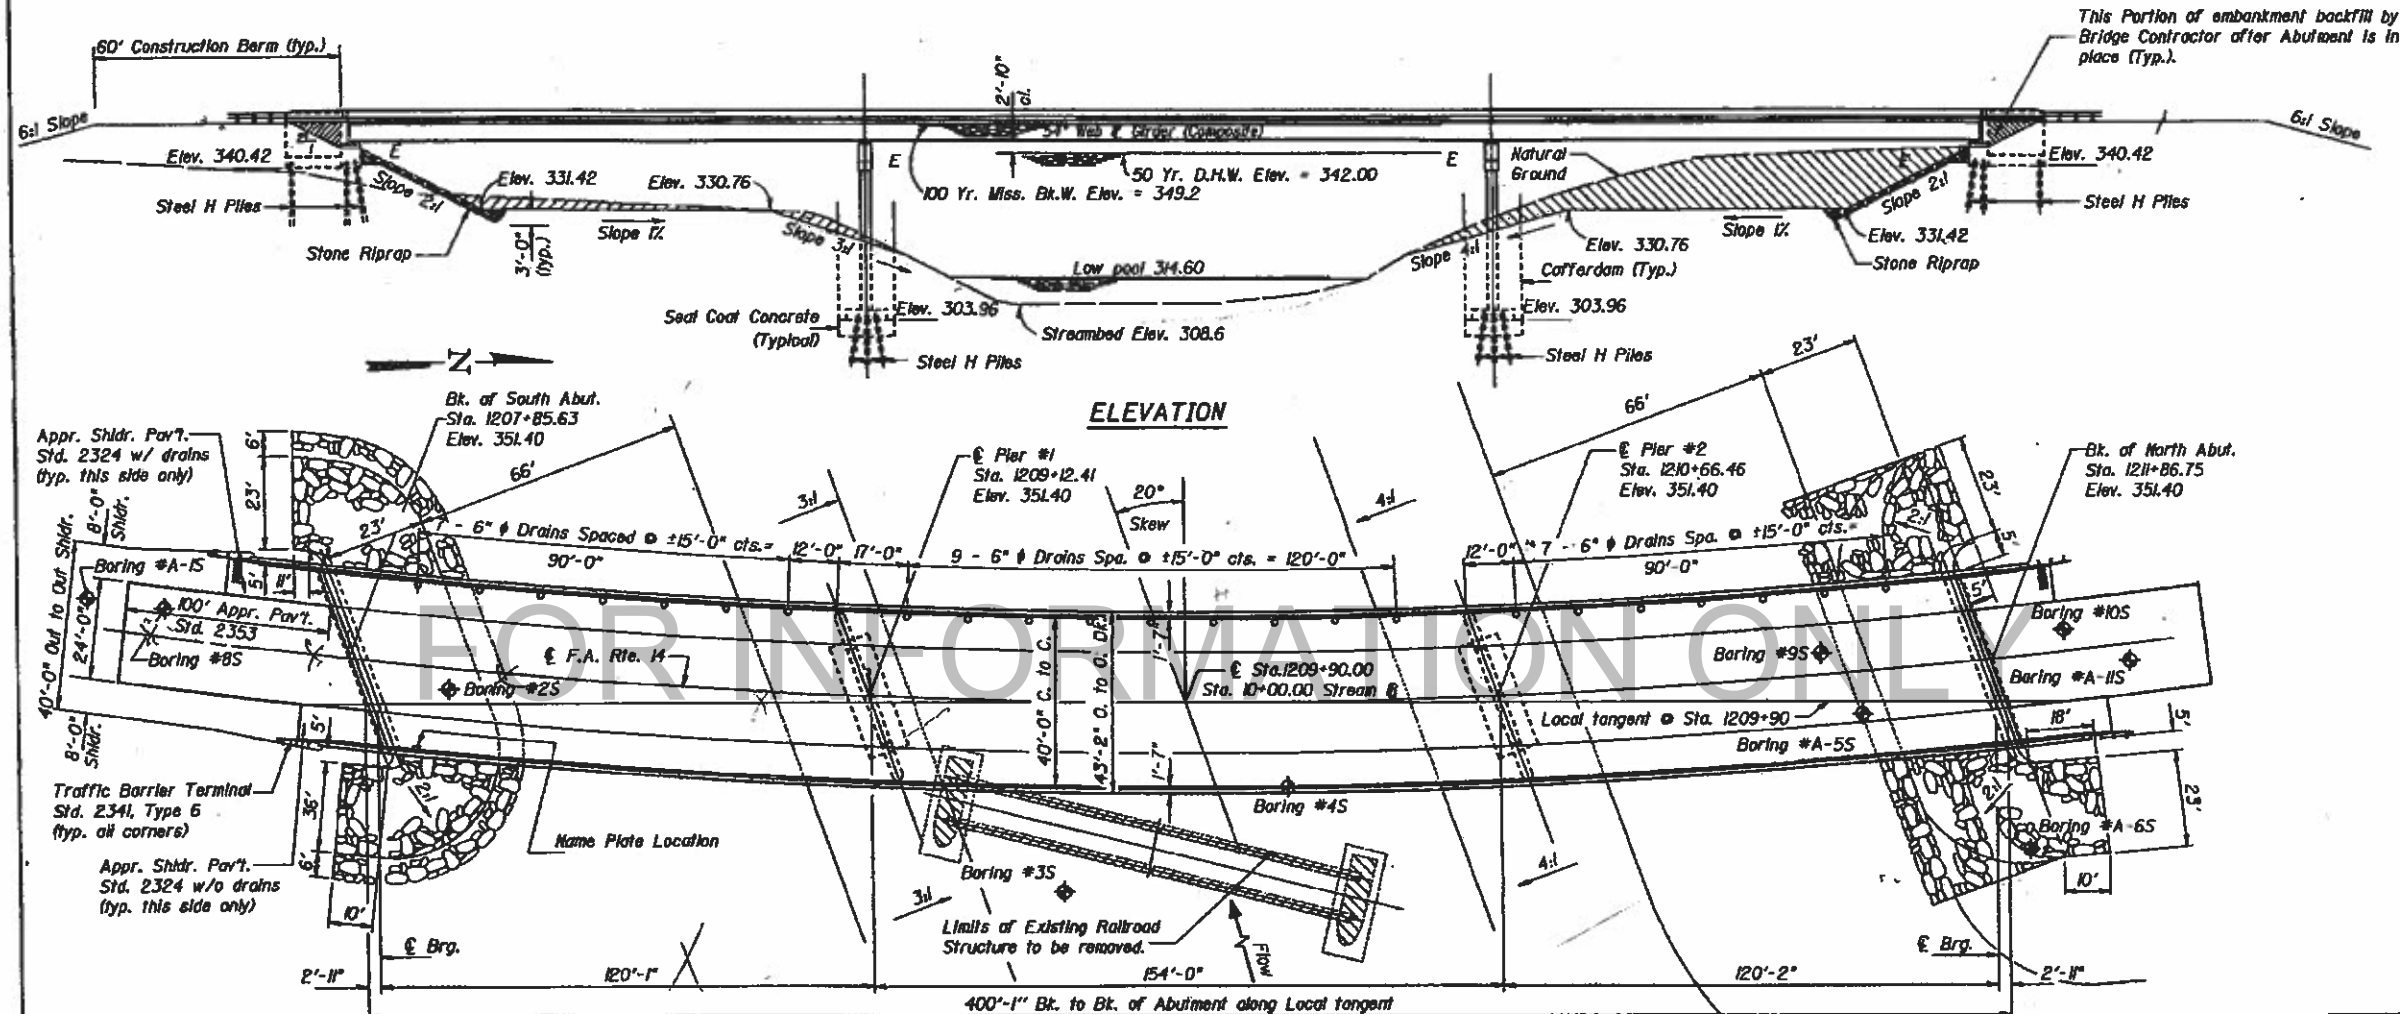

CURVE DATA
 $\Delta = 67^{\circ}19'50''$
 $D = 3^{\circ}$
 $L = 2044.354$
 $R = 1909.86$
 $T = 1132.428$
 $E = 310.491$
 $P.C. = 1203+40.48$
 $P.I. = 1204+72.91$
 $P.T. = 1205+84.83$
 $S.E. = .06 \text{ ft./ft.}$

PROFILE GRADE
(Along E Roadway)
 0.00%
 Sta. 1207+00.00 Elev. 351.40


WATERWAY INFORMATION

Drainage Area = 217 Sq. Mi. Low Grade Elev. 351.40 @ Sta. 1215+20.00

Flood	Freq. Yr.	0	Opening	Sq. Ft.	Nat.	Head - Ft.	Headwater	Elev.
			Exist.	Prop.	H.W.E.	Exist.	Prop.	Exist.
Design	50	15759	-	5764	342.00	-	0.0	342.00
Base	100	17904	-	5764	342.00	-	0.0	342.00
Overtopping	-	-	-	-	-	-	-	-
Max. Colc.	500	22787	-	5764	342.00	-	0.0	342.00

10 Yr. Flood on Mississippi River.

DESIGN SPECIFICATIONS
 1983 AASHTO, 1984 thru 1986 Interims (Seismic Zone 3)
LOADING HS 20-44
 Allow 25* / sq. ft. for future wearing surface.
DESIGN STRESSES
FIELD UNITS
 $f'c = 3,500 \text{ psi}$
 $f_y = 60,000 \text{ psi (reinf.)}$
 $f_y = 36,000 \text{ psi (MB3)}$
 $f_y = 50,000 \text{ psi (M223 Grade 50)}$

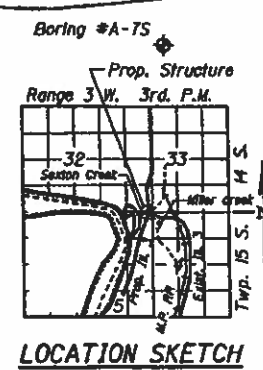

STATION 1209+90.00
 BUILT 198 BY
 STATE OF ILLINOIS
 F.A. RT. 14 SEC. 133B-1
 PROJECT BR-14(119)
 LOADING HS20
 STR. NO. 002-0032

NAME PLATE
 See Sid. 213


GENERAL PLAN
 ILLINOIS RTE. 3 OVER SEXTON CREEK
 F.A. RTE. 14 SECTION 133B-1
 ALEXANDER COUNTY
 STATION 1209+90.00
 STRUCTURE NUMBER 002-0032

DESIGNED: M. G. Ahrens
 CHECKED: Eric E. Howdy
 DRAWN: John F. Schneller Jr.
 CHECKED: GBA

Feb 11 1988
 APPROVED: [Signature]
 APPROVED: [Signature]

STATE OF ILLINOIS
DEPARTMENT OF TRANSPORTATION


DATE	BY	CHKD	APP'D	SHEET NO. 2
12/1	J.E.S.			21 SHEETS
PROJECT NO. 002-0032				

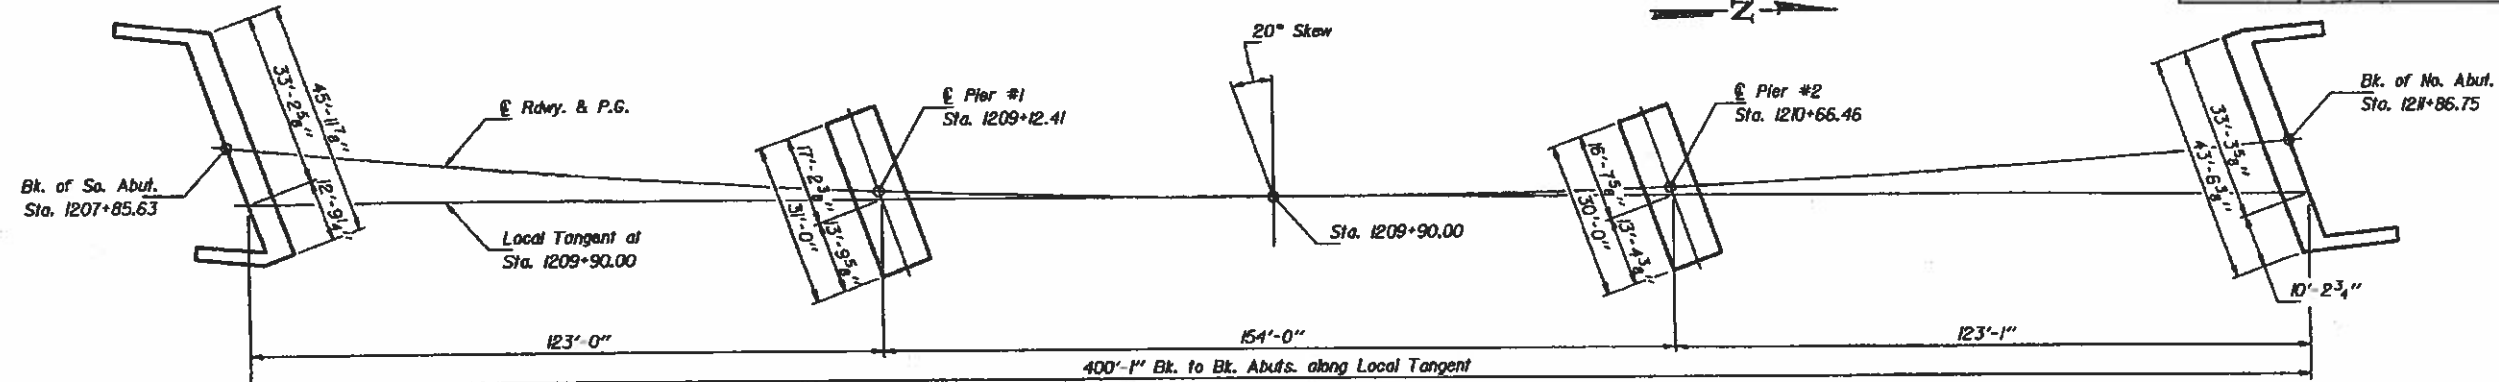

FOOTING LAYOUT

TOTAL BILL OF MATERIAL

ITEM	UNIT	SUPER	SUB	TOTAL
Structure Excavation	Cu. Yd.		288	288
Floor Drains	Each	23		23
Protective Coat	Sq. Yd.	351		351
Class X Concrete Superstructure	Cu. Yd.	505.5		505.5
Class X Concrete	Cu. Yd.		464.8	464.8
Seismic Isolation B-g. Assy. 13" x 13"	Each		10	10
Seismic Isolation Brg. Assy. 18" x 18"	Each		10	10
Stud Shear Connectors	Each	4,230		4,230
Seal Coat Concrete	Cu. Yd.		178.9	178.9
Structural Steel	L.S.	1		1
Reinforcement Bars	Lbs.		67,940	67,940
Reinforcement Bars (Epoxy Coated)	Lbs.		146,620	146,620
Test Piles Steel HPI2x74	Each		1	1
Test Piles Steel HPI2x63	Each		1	1
Steel Piles HPI2x74	Lin. Ft.		3,234	3,234
Steel Piles HPI2x63	Lin. Ft.		2,518	2,518
Name Plates	Each	1		1
Stone Riprap, Class A2	Sq. Yd.		1050	1050
Heaprane Expansion Joint (4")	Lin. Ft.	90		90
Removal of Existing Structure	L.S.	1		1
Cofferdam	Each		2	2
Cofferdam Excavation	Cu. Yd.		90	90

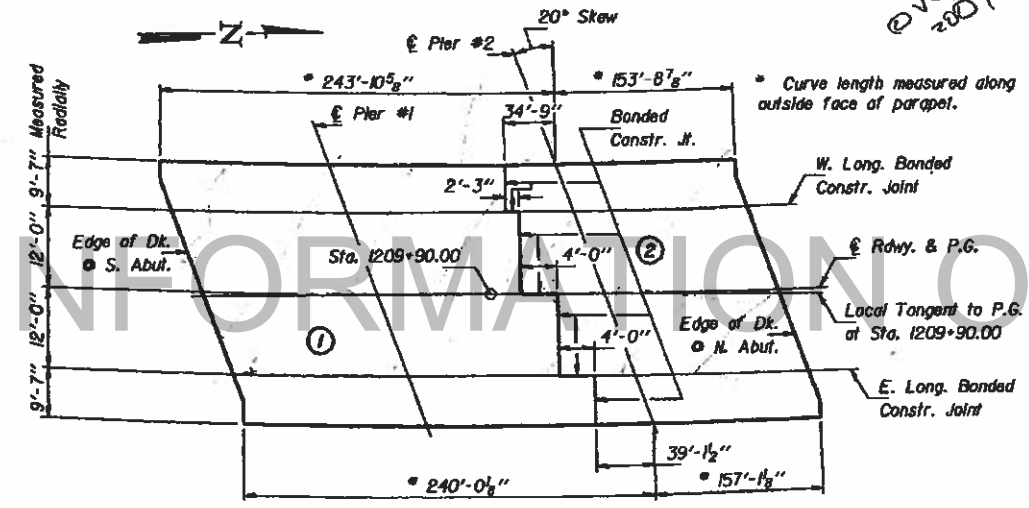


DECK POURING SKETCH

The concrete deck slab segments shall be poured in numerical order as shown above.


Notes: Transverse bonded construction joints are to be constructed radial. Longitudinal bonded construction joints are to be constructed along the curve.

GENERAL NOTES

See Proposal for Boring Data.
Fasteners shall be high strength bolts. Bolts 7/8" φ, open holes 5/8" φ, unless otherwise noted.
Tightening and inspection of all high strength bolt connections shall conform to the requirements of the latest issue of the Specification for Structural Joints using A325 (M64) or A490 (M253) bolts for slip-critical connections. Except tightening methods using either the load indicating washers or the calibrated wrench are not allowed.
Calculated weight of Structural Steel = 42,660 Lbs. (AASHTO M223 Gr. 50).
Calculated weight of Structural Steel = 512,990 Lbs. (AASHTO M223 Gr. 50).
The Zinc-silicate and vinyl paint system shall be used for shop and field painting of Structural Steel except where otherwise noted.
Field welding of construction accessories will not be permitted to the bottom flange of girders nor to the top flange for a distance equal to one-fourth the span length each way from the pier supports. Field welding in other areas will be permitted only when approved by the Engineer.
The main load carrying member components subject to tensile stress shall conform to the Supplemental Requirements for Notch Toughness Zone 2. These components are the tension flanges, webs and all splice plate material of the steel girders or wide flange beams.
Reinforcement bars shall conform to the requirements of AASHTO M-31, M-42 or M-53 Grade 60.
Layout of stone riprap may be varied in the field to suit ground conditions as directed by the Engineer.
The embankment configuration shown shall be the minimum embankment that must be constructed prior to construction of the abutments.
Bearing seat surfaces shall be constructed or adjusted to the designated elevations within a tolerance of 1/4 inch. Adjustment shall be made either by grinding the surface or by shimming the bearing. Two 1/2" adjusting shims, of the dimensions of the bottom bearing plate, shall be provided for each bearing in addition to all other plates or shims.
The contractor shall drive one (1) steel HPI2x74 test piles in a permanent location at the South Abutment and one (1) steel HPI2x63 test pile in a permanent location at Pier #2 as directed by the Engineer before ordering the remainder of piles.
Anchor bolts shall be set before bolting cross frames over supports.
All structural steel fabricators performing work on the main load carrying components of steel structures shall be certified under category III (AISC) Quality Certification Program.

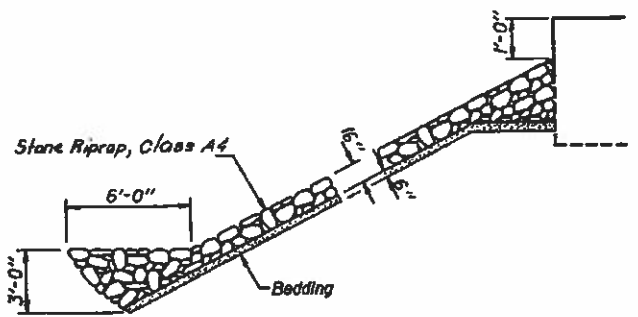

STONE RIPRAP ANCHOR DETAIL

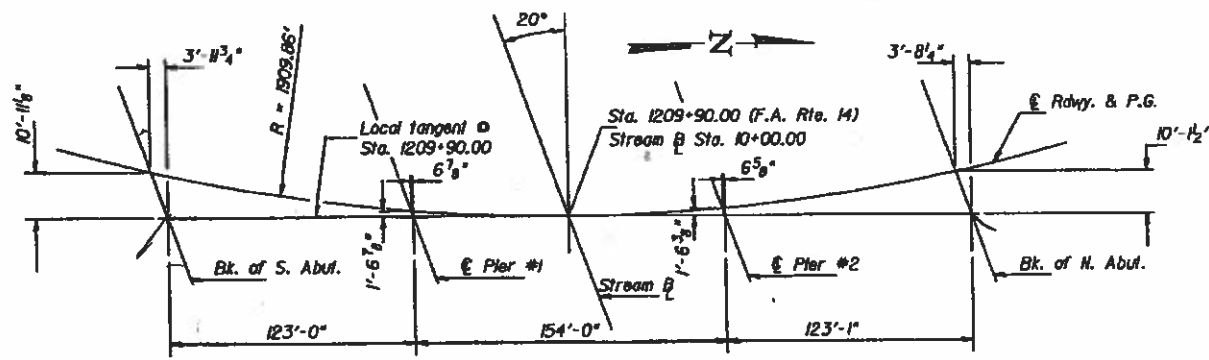


OFFSET SKETCH

DESIGNED *[Signature]*
CHECKED *[Signature]*
DRAWN *[Signature]*
EXAMINED *[Signature]*
PASSED *[Signature]*
APPROVED *[Signature]*


DETAILS
ILLINOIS RTE. 3 OVER SEXTON CREEK
F.A. RTE. 14 SECTION 133B-1
ALEXANDER COUNTY
STATION 1209+90.00
STRUCTURE NUMBER 002-0032

STATE OF ILLINOIS
DEPARTMENT OF TRANSPORTATION

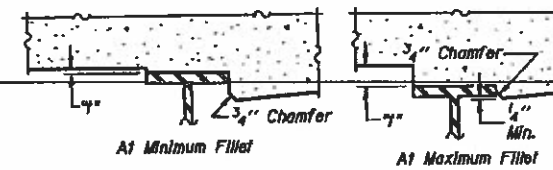

DATE	BY	CHECKED	DATE	BY

SHEET NO. 3
OF 12 SHEETS

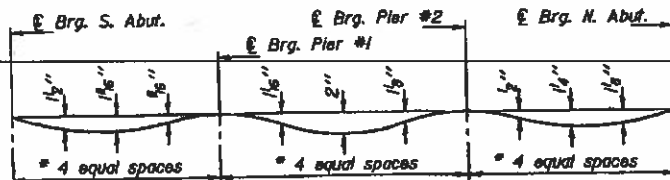

* See Structural Steel sheet #10 of 19 for span dimensions.

DEAD LOAD DEFLECTION DIAGRAM
(Includes weight of concrete only)

Note: The above deflections are not to be used in the field if the engineer is working from the grade elevations adjusted for dead load deflections as shown below.

To determine γ : After all structural steel has been erected, elevations of the top flanges of the beams shall be taken at intervals shown below. These elevations subtracted from the "Theoretical Grade Elevations Adjusted for Dead Load Deflection" shown below, minus slab thickness, equals the fillet heights γ above top flange of beams.

FILLET HEIGHTS

G GIRDER #1					WEST LONGITUDINAL BONDED CONST. JT.					G GIRDER #2					P.G., G RDWY. & G GIRDER #3				
Location	Station	Offset	Theoretical Grade Elevations	Theoretical Grade Elevations Adjusted For Dead Load Deflection	Location	Station	Offset	Theoretical Grade Elevations	Theoretical Grade Elevations Adjusted For Dead Load Deflection	Location	Station	Offset	Theoretical Grade Elevations	Theoretical Grade Elevations Adjusted For Dead Load Deflection	Location	Station	Offset	Theoretical Grade Elevations	Theoretical Grade Elevations Adjusted For Dead Load Deflection
Bt. S. Abut.	120776.343	-18.333	350.300	350.300	Bt. S. Abut.	120778.708	-12.000	350.680	350.680	Bt. S. Abut.	120781.113	-9.167	350.850	350.850	Bt. S. Abut.	120785.634	0.000	351.400	351.400
Brg. S. Abut.	120779.631	-18.333	350.300	350.300	Brg. S. Abut.	120782.781	-12.000	350.680	350.680	Brg. S. Abut.	120784.183	-9.167	350.850	350.850	Brg. S. Abut.	120788.688	0.000	351.400	351.400
A	120788.728	-18.333	350.300	350.340	A	120792.848	-12.000	350.680	350.720	A	120794.251	-9.167	350.850	350.890	A	120798.686	0.000	351.400	351.440
B	120799.825	-18.333	350.300	350.379	B	120802.908	-12.000	350.680	350.759	B	120804.280	-9.167	350.850	350.929	B	120808.686	0.000	351.400	351.480
C	120809.922	-18.333	350.300	350.419	C	120812.971	-12.000	350.680	350.799	C	120814.328	-9.167	350.850	350.959	C	120818.686	0.000	351.400	351.519
D	120820.018	-18.333	350.300	350.489	D	120823.034	-12.000	350.680	350.809	D	120824.376	-9.167	350.850	350.979	D	120828.686	0.000	351.400	351.529
E	120830.116	-18.333	350.300	350.435	E	120833.098	-12.000	350.680	350.815	E	120834.464	-9.167	350.850	350.985	E	120838.686	0.000	351.400	351.535
F	120840.213	-18.333	350.300	350.441	F	120843.161	-12.000	350.680	350.821	F	120844.478	-9.167	350.850	350.991	F	120848.686	0.000	351.400	351.541
G	120850.310	-18.333	350.300	350.421	G	120853.224	-12.000	350.680	350.801	G	120854.521	-9.167	350.850	350.971	G	120858.686	0.000	351.400	351.521
H	120860.407	-18.333	350.300	350.394	H	120863.287	-12.000	350.680	350.774	H	120864.569	-9.167	350.850	350.944	H	120868.686	0.000	351.400	351.493
I	120870.504	-18.333	350.300	350.367	I	120873.359	-12.000	350.680	350.747	I	120874.611	-9.167	350.850	350.917	I	120878.686	0.000	351.400	351.467
J	120880.600	-18.333	350.300	350.346	J	120883.414	-12.000	350.680	350.726	J	120884.665	-9.167	350.850	350.926	J	120888.686	0.000	351.400	351.445
K	120890.697	-18.333	350.300	350.327	K	120893.477	-12.000	350.680	350.707	K	120894.714	-9.167	350.850	350.976	K	120898.686	0.000	351.400	351.466
Pier 1	120904.796	-18.333	350.300	350.300	Pier 1	120907.443	-12.000	350.680	350.680	Pier 1	120908.621	-9.167	350.850	350.850	Pier 1	120912.405	0.000	351.400	351.400
L	120914.893	-18.333	350.300	350.322	L	120917.304	-12.000	350.680	350.702	L	120918.669	-9.167	350.850	350.872	L	120922.405	0.000	351.400	351.422
M	120924.990	-18.333	350.300	350.345	M	120922.568	-12.000	350.680	350.725	M	120928.717	-9.167	350.850	350.895	M	120932.405	0.000	351.400	351.445
N	120935.087	-18.333	350.300	350.367	N	120937.633	-12.000	350.680	350.747	N	120938.765	-9.167	350.850	350.917	N	120942.405	0.000	351.400	351.467
O	120945.184	-18.333	350.300	350.389	O	120947.636	-12.000	350.680	350.789	O	120948.813	-9.167	350.850	350.939	O	120952.405	0.000	351.400	351.489
P	120955.281	-18.333	350.300	350.410	P	120957.759	-12.000	350.680	350.789	P	120958.862	-9.167	350.850	350.960	P	120962.405	0.000	351.400	351.510
Q	120965.378	-18.333	350.300	350.430	Q	120967.822	-12.000	350.680	350.810	Q	120968.910	-9.167	350.850	350.980	Q	120972.405	0.000	351.400	351.530
R	120975.475	-18.333	350.300	350.451	R	120977.885	-12.000	350.680	350.831	R	120978.858	-9.167	350.850	351.001	R	120982.405	0.000	351.400	351.551
S	120985.572	-18.333	350.300	350.460	S	120987.948	-12.000	350.680	350.840	S	120989.006	-9.167	350.850	351.010	S	120992.405	0.000	351.400	351.560
T	120995.669	-18.333	350.300	350.441	T	120998.012	-12.000	350.680	350.821	T	120999.059	-9.167	350.850	350.991	T	121002.405	0.000	351.400	351.541
U	121005.766	-18.333	350.300	350.422	U	121008.075	-12.000	350.680	350.802	U	121009.103	-9.167	350.850	350.972	U	121012.405	0.000	351.400	351.522
V	121015.862	-18.333	350.300	350.403	V	121018.158	-12.000	350.680	350.783	V	121019.151	-9.167	350.850	350.953	V	121022.405	0.000	351.400	351.502
W	121025.959	-18.333	350.300	350.382	W	121028.282	-12.000	350.680	350.761	W	121029.199	-9.167	350.850	350.931	W	121032.405	0.000	351.400	351.481
X	121036.056	-18.333	350.300	350.358	X	121038.265	-12.000	350.680	350.738	X	121039.248	-9.167	350.850	350.908	X	121042.405	0.000	351.400	351.457
Y	121046.153	-18.333	350.300	350.334	Y	121048.328	-12.000	350.680	350.714	Y	121049.296	-9.167	350.850	350.984	Y	121052.405	0.000	351.400	351.435
Pier 2	121080.551	-18.333	350.300	350.300	Pier 2	121082.607	-12.000	350.680	350.680	Pier 2	121083.522	-9.167	350.850	350.850	Pier 2	121086.483	0.000	351.400	351.400
Z	121070.648	-18.333	350.300	350.314	Z	121072.670	-12.000	350.680	350.694	Z	121073.570	-9.167	350.850	350.864	Z	121076.463	0.000	351.400	351.414
A1	121080.745	-18.333	350.300	350.327	A1	121082.733	-12.000	350.680	350.707	A1	121083.618	-9.167	350.850	350.877	A1	121086.463	0.000	351.400	351.467
B1	121090.841	-18.333	350.300	350.341	B1	121088.791	-12.000	350.680	350.721	B1	121089.667	-9.167	350.850	350.891	B1	121092.463	0.000	351.400	351.461
C1	121100.938	-18.333	350.300	350.363	C1	121102.860	-12.000	350.680	350.743	C1	121103.715	-9.167	350.850	350.913	C1	121106.463	0.000	351.400	351.465
D1	121111.035	-18.333	350.300	350.385	D1	121112.923	-12.000	350.680	350.765	D1	121113.743	-9.167	350.850	350.935	D1	121116.463	0.000	351.400	351.485
E1	121121.132	-18.333	350.300	350.404	E1	121122.985	-12.000	350.680	350.784	E1	121123.811	-9.167	350.850	350.954	E1	121126.463	0.000	351.400	351.504
F1	121131.229	-18.333	350.300	350.401	F1	121133.049	-12.000	350.680	350.780	F1	121133.860	-9.167	350.850	350.950	F1	121136.463	0.000	351.400	351.497
G1	121141.326	-18.333	350.300	350.387	G1	121143.113	-12.000	350.680	350.777	G1	121143.988	-9.167	350.850	350.947	G1	121146.463	0.000	351.400	351.497
H1	121151.423	-18.333	350.300	350.380	H1	121153.176	-12.000	350.680	350.768	H1	121153.956	-9.167	350.850	350.938	H1	121156.463	0.000	351.400	351.497
I1	121161.520	-18.333	350.300	350.366	I1	121163.239	-12.000	350.680	350.736	I1	121164.004	-9.167	350.850	350.906	I1	121166.463	0.000	351.400	351.456
J1	121171.617	-18.333	350.300	350.324	J1	121173.302	-12.000	350.680	350.704	J1	121174.053	-9.167	350.850	350.874	J1	121176.463	0.000	351.400	351.424
Brg. N. Abut.	121179.240	-18.333	350.300	350.300	Brg. N. Abut.	121180.867	-12.000	350.680	350.680	Brg. N. Abut.	121181.591	-9.167	350.850	350.850	Brg. N. Abut.	121183.920	0.000	351.400	351.400
Bt. N. Abut.	121182.096	-18.333	350.300	350.300	Bt. N. Abut.	121183.713	-12.000	350.680	350.680	Bt. N. Abut.	121184.432	-9.167	350.850	350.850	Bt. N. Abut.	121186.746	0.000	351.400	351.400

DESIGNED *A.R. Chene*
CHECKED *Eric E. Dworky*
DRAWN *John F. Schneller Jr.*
CHECKED *G.R.H.*

EXAMINED *Eric E. Dworky*
PASSED *James J. Schneller*
APPROVED _____

Feb 11 1982

TOP OF SLAB ELEVATIONS
F.A. RT. 14 SECTION 133B-1
ALEXANDER COUNTY
STATION 1209+90.00

STATE OF ILLINOIS
DEPARTMENT OF TRANSPORTATION

SCALE	DATE	BY	CHECKED	FIG.	SHEET NO.
				130	13 SHEETS

€ GIRDER #4


Location	Station	Offset	Theoretical Grade Elevations	Theoretical Grade Elevations Adjusted For Dead Load Deflection
Bk. S. Abut.	120790.107	9.167	351.950	351.950
€ Brg. S. Abut.	120793.141	9.167	351.950	351.950
A	120803.093	9.167	351.850	351.990
B	120813.045	9.167	351.850	352.030
C	120822.997	9.167	351.950	352.069
D	120832.950	9.167	351.950	352.079
E	120842.902	9.167	351.950	352.085
F	120852.854	9.167	351.950	352.091
G	120862.806	9.167	351.950	352.070
H	120872.759	9.167	351.950	352.043
I	120882.711	9.167	351.950	352.016
J	120892.663	9.167	351.950	351.985
K	120902.615	9.167	351.950	351.976
€ Pier 1	120916.150	9.167	351.950	351.950
L	120926.102	9.167	351.950	351.872
M	120936.055	9.167	351.950	351.995
N	120946.007	9.167	351.950	352.017
O	120955.959	9.167	351.950	352.039
P	120965.911	9.167	351.950	352.060
Q	120975.864	9.167	351.950	352.081
R	120985.816	9.167	351.950	352.101
S	120995.768	9.167	351.950	352.110
T	121005.720	9.167	351.950	352.091
U	121015.673	9.167	351.950	352.071
V	121025.625	9.167	351.950	352.052
W	121035.577	9.167	351.950	352.031
X	121045.529	9.167	351.950	352.007
Y	121055.482	9.167	351.950	351.993
€ Pier 2	121069.375	9.167	351.950	351.950
Z	121079.327	9.167	351.950	351.964
AA	121089.280	9.167	351.950	351.977
AB	121099.232	9.167	351.950	351.991
AC	121109.184	9.167	351.950	352.013
AD	121119.136	9.167	351.950	352.036
AE	121129.089	9.167	351.950	352.054
AF	121139.041	9.167	351.950	352.050
AG	121148.993	9.167	351.950	352.047
AH	121158.945	9.167	351.950	352.037
AI	121168.898	9.167	351.950	352.025
AJ	121178.850	9.167	351.950	351.974
€ Brg. N. Abut.	121186.225	9.167	351.950	351.950
Bk. N. Abut.	121189.037	9.167	351.950	351.950

EAST LONGITUDINAL BONDED CONST. JT.

Location	Station	Offset	Theoretical Grade Elevations	Theoretical Grade Elevations Adjusted For Dead Load Deflection
Bk. S. Abut.	120791.480	12.000	352.120	352.120
€ Brg. S. Abut.	120794.508	12.000	352.120	352.120
A	120804.446	12.000	352.120	352.160
B	120814.383	12.000	352.120	352.200
C	120824.321	12.000	352.120	352.239
D	120834.258	12.000	352.120	352.249
E	120844.196	12.000	352.120	352.255
F	120854.133	12.000	352.120	352.261
G	120864.071	12.000	352.120	352.240
H	120874.009	12.000	352.120	352.213
I	120883.946	12.000	352.120	352.186
J	120893.884	12.000	352.120	352.165
K	120903.821	12.000	352.120	352.146
€ Pier 1	120917.300	12.000	352.120	352.120
L	120927.238	12.000	352.120	352.142
M	120937.175	12.000	352.120	352.165
N	120947.113	12.000	352.120	352.187
O	120957.050	12.000	352.120	352.209
P	120966.988	12.000	352.120	352.230
Q	120976.925	12.000	352.120	352.251
R	120986.863	12.000	352.120	352.271
S	120996.801	12.000	352.120	352.280
T	121006.738	12.000	352.120	352.281
U	121016.676	12.000	352.120	352.241
V	121026.613	12.000	352.120	352.222
W	121036.551	12.000	352.120	352.201
X	121046.488	12.000	352.120	352.177
Y	121056.426	12.000	352.120	352.153
€ Pier 2	121070.289	12.000	352.120	352.120
Z	121080.207	12.000	352.120	352.134
AA	121090.144	12.000	352.120	352.147
AB	121100.082	12.000	352.120	352.161
AC	121110.020	12.000	352.120	352.183
AD	121119.957	12.000	352.120	352.206
AE	121129.895	12.000	352.120	352.224
AF	121139.832	12.000	352.120	352.220
AG	121149.770	12.000	352.120	352.217
AH	121159.707	12.000	352.120	352.207
AI	121169.645	12.000	352.120	352.175
AJ	121179.583	12.000	352.120	352.144
€ Brg. N. Abut.	121186.933	12.000	352.120	352.120
Bk. N. Abut.	121189.740	12.000	352.120	352.120

€ GIRDER #5

Location	Station	Offset	Theoretical Grade Elevations	Theoretical Grade Elevations Adjusted For Dead Load Deflection
Bk. S. Abut.	120794.532	18.333	352.500	352.500
€ Brg. S. Abut.	120797.548	18.333	352.500	352.500
A	120807.483	18.333	352.500	352.540
B	120817.418	18.333	352.500	352.580
C	120827.353	18.333	352.500	352.620
D	120837.288	18.333	352.500	352.629
E	120847.223	18.333	352.500	352.635
F	120857.158	18.333	352.500	352.641
G	120867.093	18.333	352.500	352.620
H	120877.028	18.333	352.500	352.593
I	120886.963	18.333	352.500	352.566
J	120896.898	18.333	352.500	352.545
K	120906.833	18.333	352.500	352.528
€ Pier 1	120919.857	18.333	352.500	352.500
L	120929.782	18.333	352.500	352.522
M	120939.707	18.333	352.500	352.545
N	120949.632	18.333	352.500	352.567
O	120959.557	18.333	352.500	352.589
P	120969.482	18.333	352.500	352.610
Q	120979.407	18.333	352.500	352.631
R	120989.332	18.333	352.500	352.651
S	120999.257	18.333	352.500	352.660
T	121009.182	18.333	352.500	352.641
U	121019.107	18.333	352.500	352.621
V	121029.032	18.333	352.500	352.602
W	121038.957	18.333	352.500	352.581
X	121048.882	18.333	352.500	352.557
Y	121058.807	18.333	352.500	352.533
€ Pier 2	121072.258	18.333	352.500	352.500
Z	121082.183	18.333	352.500	352.514
AA	121092.108	18.333	352.500	352.527
AB	121102.033	18.333	352.500	352.541
AC	121111.958	18.333	352.500	352.563
AD	121121.883	18.333	352.500	352.586
AE	121131.808	18.333	352.500	352.604
AF	121141.733	18.333	352.500	352.600
AG	121151.658	18.333	352.500	352.587
AH	121161.583	18.333	352.500	352.567
AI	121171.508	18.333	352.500	352.555
AJ	121181.433	18.333	352.500	352.523
€ Brg. N. Abut.	121189.507	18.333	352.500	352.500
Bk. N. Abut.	121191.305	18.333	352.500	352.500

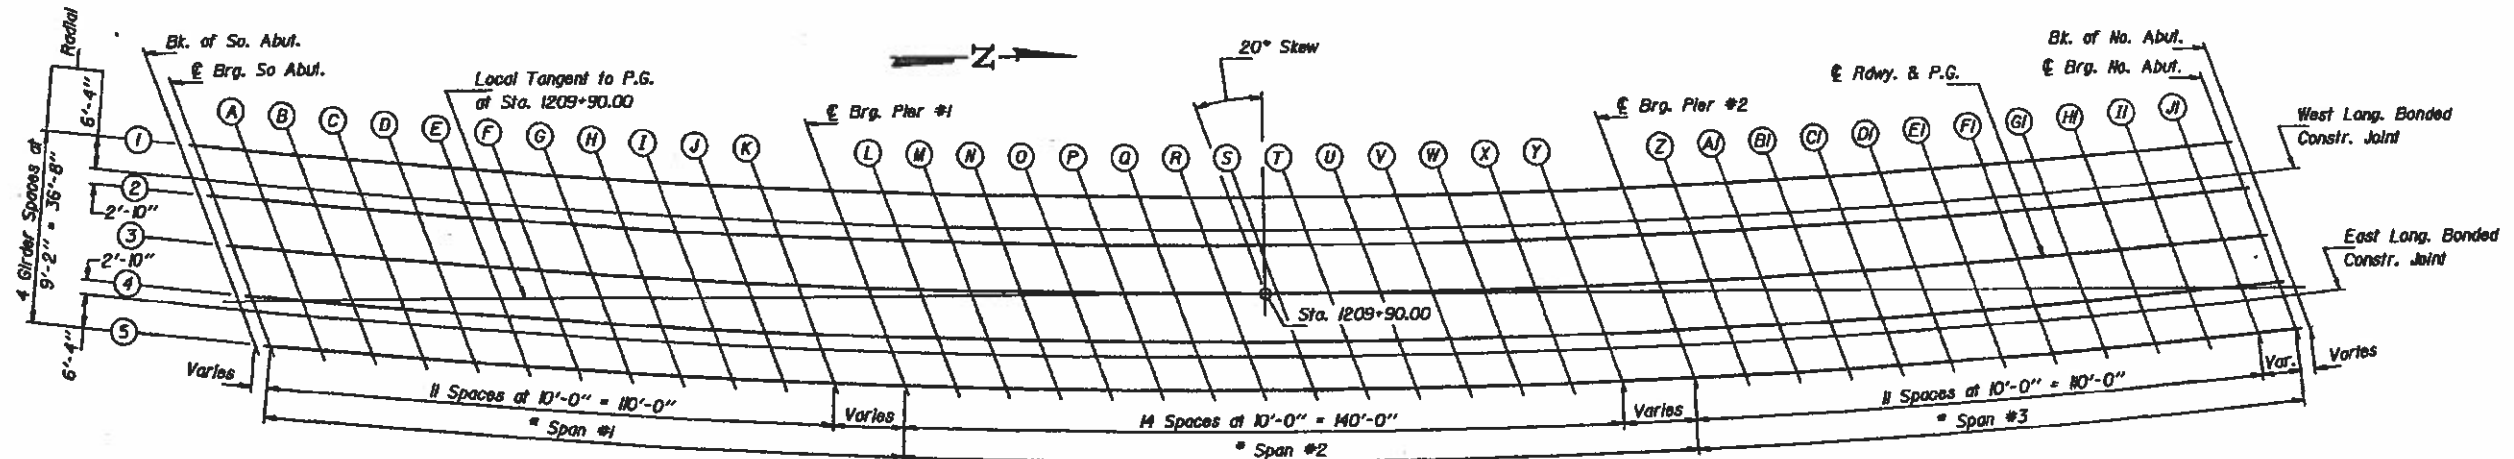

* See Structural Steel sheet #10 of 19 for span dimensions.

PLAN

Horizontal dimensions are taken along € of individual girders.

DESIGNED *W. H. H. H.*
 CHECKED *Eric E. Dowdy*
 DRAWN *John E. Schaeffer Jr.*
 CHECKED *GRH*

Feb 11 1988
 EXAMINED *Orsi O. Hagan*
 PREPARED *James J. Hagan*
 APPROVED _____


DIRECTOR OF HIGHWAYS

E-S 1-6-82


TOP OF SLAB ELEVATIONS
 F.A. RT. 14 SECTION 133B-1
 ALEXANDER COUNTY
 STATION 1209+90.00

STATE OF ILLINOIS
DEPARTMENT OF TRANSPORTATION

PROJECT NO.	SECTION	DATE	JOB	BY	SHEET NO. 6
					19 SHEETS

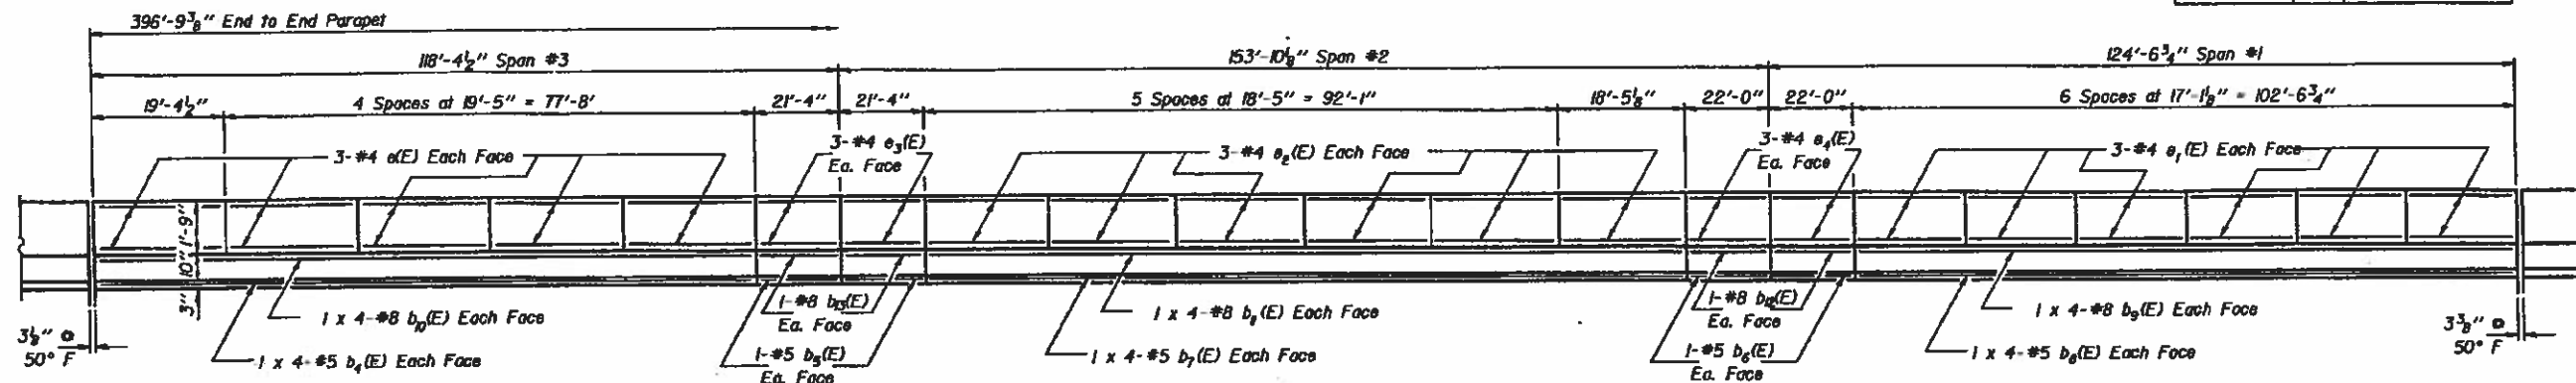


INSIDE ELEVATION OF EAST PARAPET
(Looking East)

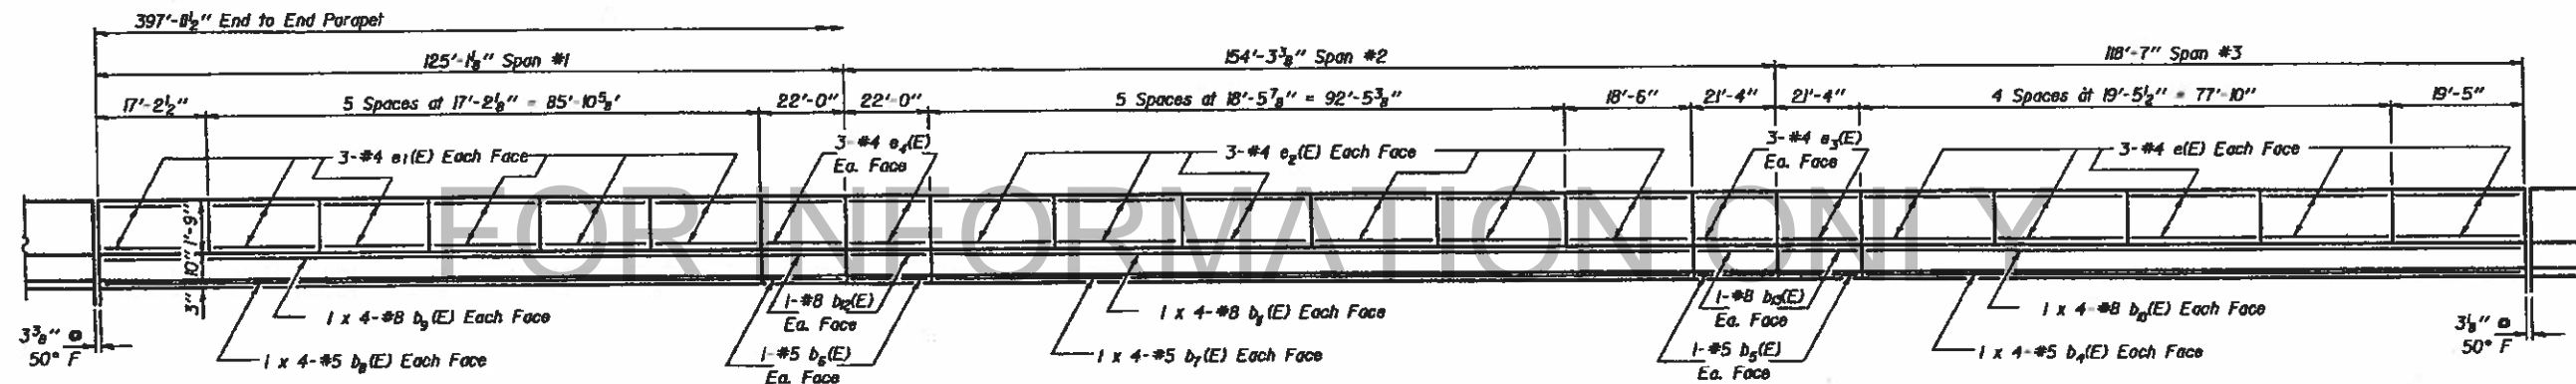

INSIDE ELEVATION OF WEST PARAPET
(Looking West)

MIN. BAR LAPS
#5 Bars = 1'-9"
#8 Bars = 3'-9"

Notes: Reinforcement bars designated (E) shall be epoxy coated.
Bars indicated thus 20 x 3-#5 etc. indicates 20 lines of bars with 3 lengths per line.

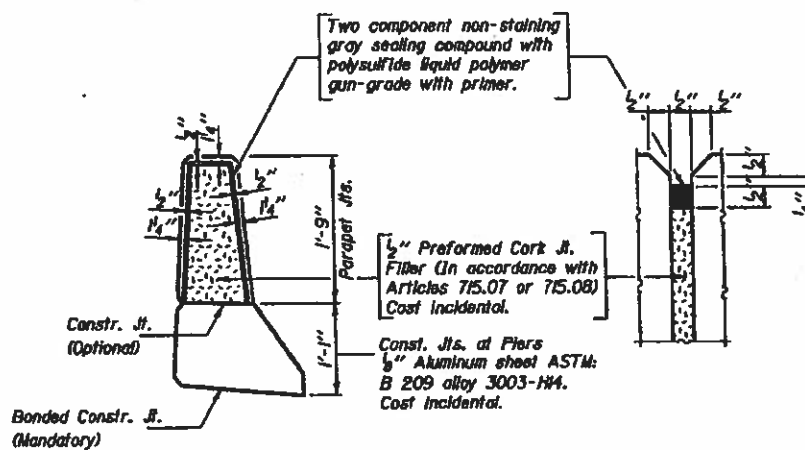

PARAPET JOINT DETAILS




DESIGNED <i>M. R. Schmidt</i>	EXAMINED <i>Gregory D. ...</i>
CHECKED <i>Eric E. Hardy</i>	PASSED <i>James J. ...</i>
DRAWN <i>John E. Schneller Jr.</i>	APPROVED <i>...</i>
CHECKED <i>...</i>	

PARAPET
F.A. RT. 14 SECTION 133B-1
ALEXANDER COUNTY
STATION 1209+90.00




STATE OF ILLINOIS
DEPARTMENT OF TRANSPORTATION

DATE	BY	NO.	REV.	SHEET NO. 7
				13 SHEETS

Notes:
The exterior surfaces of the Floor Drain shall be painted with the vinyl enamel coating specified for Structural Steel. The exterior surface of the Aluminum tube shall be cleaned and given a washcoat pretreatment in accordance with Steel Structural Painting Council's Spec. SSPC-SP1 & SSPC-Paint 27 prior to painting.
Fiberglass pipe shall conform to ASTM: D2996, with short-time rupture strength hoop tensile stress of 30,000 p.s.i. minimum. The surface of the Fiberglass pipe shall be free of bond inhibiting agents.

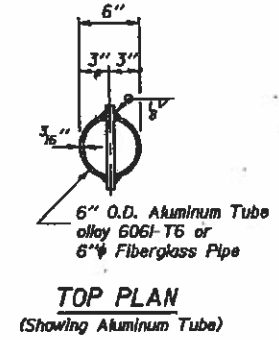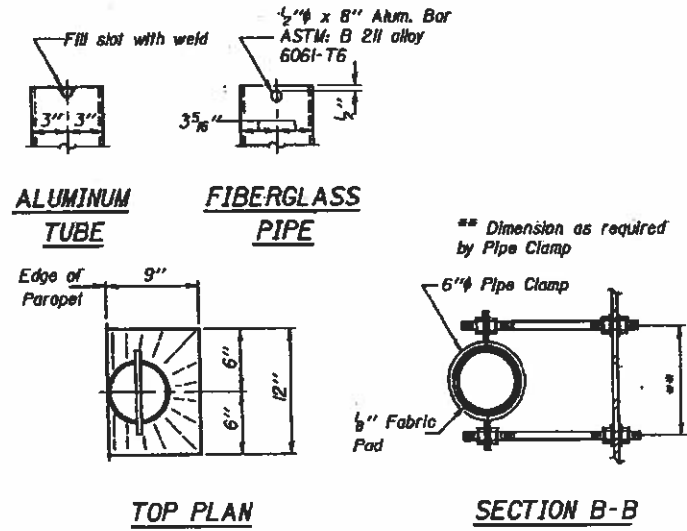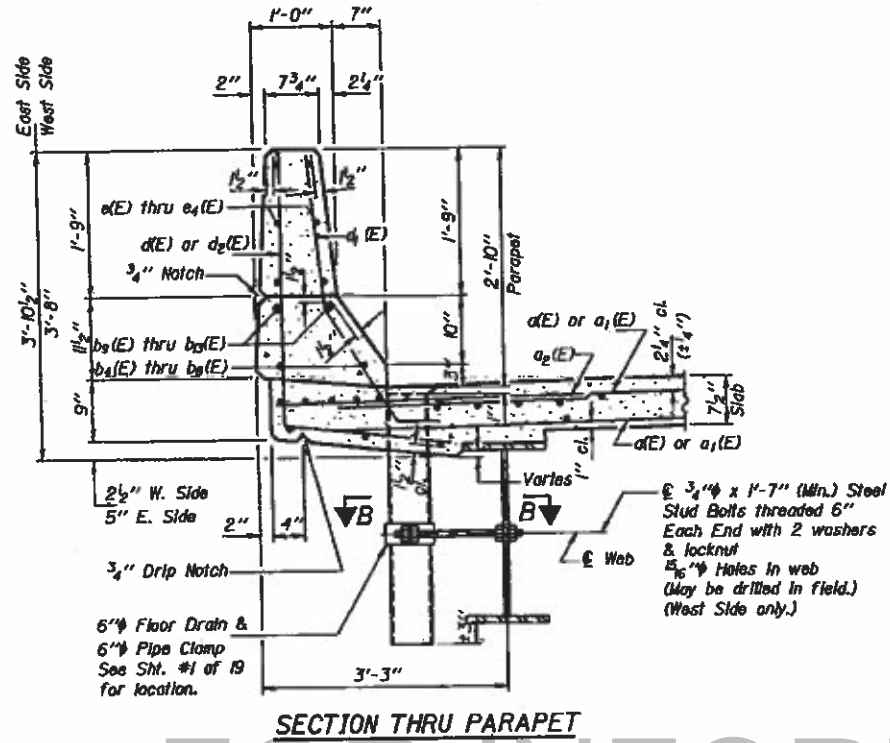

FOR INFORMATION ONLY

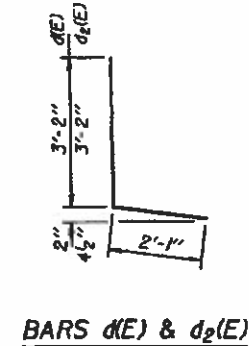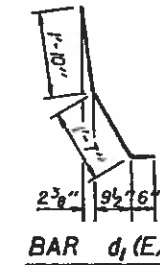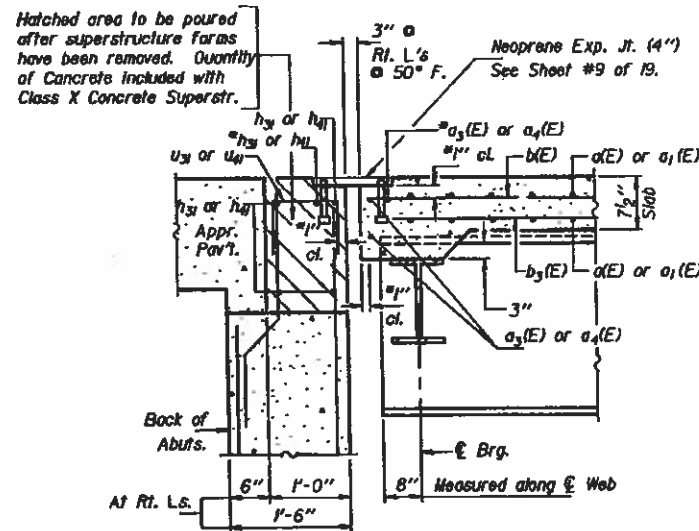

SUPERSTRUCTURE
BILL OF MATERIAL

Bar	No.	Size	Length	Shape
a(E)	1591	#5	41'-2"	
a1(E)	57	#5	43'-8"	
a2(E)	953	#6	4'-0"	
a3(E)	2	#6	45'-6"	
a4(E)	2	#6	42'-3"	
b(E)	690	#5	28'-7"	
b1(E)	129	#6	28'-11"	
b2(E)	129	#6	28'-3"	
b3(E)	700	#5	30'-8"	
b4(E)	16	#5	25'-8"	
b5(E)	8	#5	21'-1"	
b6(E)	8	#5	21'-9"	
b7(E)	16	#5	29'-0"	
b8(E)	16	#5	27'-2"	
b9(E)	16	#8	28'-8"	
b10(E)	16	#8	27'-2"	
b11(E)	16	#8	30'-7"	
b12(E)	8	#8	21'-9"	
b13(E)	8	#8	21'-1"	
d(E)	399	#4	5'-3"	L
d1(E)	869	#5	3'-11"	L
d2(E)	398	#4	5'-3"	L
e(E)	60	#4	19'-1"	
e1(E)	72	#4	16'-10"	
e2(E)	72	#4	18'-2"	
e3(E)	24	#4	21'-1"	
e4(E)	24	#4	21'-9"	
Reinforcement Bars (Epoxy Coated)	Lbs.		46,620	
Class X Concrete Superstructure	Cu. Yds.		505.5	

Reinforcement bars designated (E) shall be epoxy coated.

SUPERSTRUCTURE DETAILS
F.A. RT. 14 SECTION 133B-1
ALEXANDER COUNTY
STATION 1209+90.00

DESIGNED: *St. Albrecht*
CHECKED: *Eric E. Dourdy*
DRAWN: *John F. Schellert Jr.*
CHECKED: *GAA*
S-1-D 12-1-83

Feb 11 mBB
EXAMINED: *Greg D. Kasper*
IN CHARGE OF PUBLIC WORKS
APPROVED: *James J. Schellert*
DIRECTOR OF PUBLIC WORKS

SECTION A-A
Place a3(E), a4(E), h3 & h4 bars in back of anchor bolts as shown if required to maintain 1" cl. (±0-1/8"). Anchor bolts should be tied to a3(E), a4(E), h3 & h4 bars.

STATE OF ILLINOIS
DEPARTMENT OF TRANSPORTATION

PROJECT NO.	SECTION	DATE	SCALE	SHEET NO. 5
				134
SHEET NO. 5				19 SHEETS

Joint Size	"C" at 50°F	"D" at 50°F
2"	2"	1 1/2" Min.
2 1/2"	2 1/2"	1 3/4" Min.
4"	3"	2 1/2" Min.


INSTALLATION NOTES

1. Install sponge mounds into positions shown to form flap convolution.
2. Install parapet or sidewalk piece (trim roadway flap to fit before applying epoxy).
3. Install continuous seal in roadway.
4. Install anchor blocks as indicated.


NOTE A: Maximum spacing of anchor bolts shall be 12" centers.

SKREW LIMITATIONS

The details of the anchor blocks and the elastomeric membrane in the parapet, as shown, are for up to 50° skews. For skews greater than 50°, the anchor blocks and the elastomeric membrane, installed in accordance with dimension "D", might require modifications to insure a minimum clearance of 1/2" from centerline of anchor studs to edge of parapet opening. The anchor blocks and the elastomeric membrane shall also be installed to the top of the parapet with the anchor studs spaced at 12" cts.

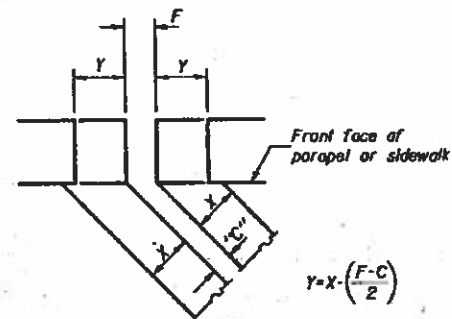

FORMING BLOCKOUT SKETCH


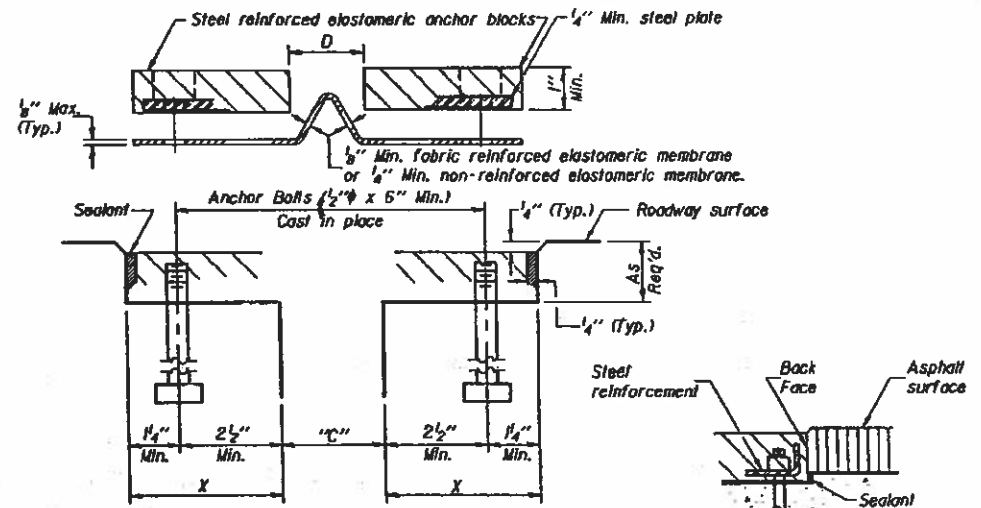


CROSS SECTION


ANCHOR BLOCK REINFORCEMENT WITH ASPHALT SURFACE

GENERAL NOTES


Continuous Seal Neoprene Expansion Joint shall consist of molded anchor blocks of elastomer and steel, field assembled over continuous lengths of elastomeric membrane. See Special Provisions. The elastomeric membrane shall be premolded with a single or a double upward convolution that will have a "memory" to return to its molded position upon joint closure. The steel reinforcement must extend up the back face of anchor blocks when asphalt surfaces are used but is optional in concrete blockout. The convolution length shall be such that the extended length will not be greater than the manufactured length when the joint is fully expanded in its design range and will not protrude above the anchor blocks when the joint is fully compressed. Joint openings shall be adjusted in accordance with Article 503.07(c) of the Standard Specifications when the deck is poured at an ambient temperature other than 50° F. The parapet and sidewalk flaps may be furnished factory vulcanized to the roadway membrane provided the centerline of the convolution is maintained and the process and method meet the approval of the Engineer.

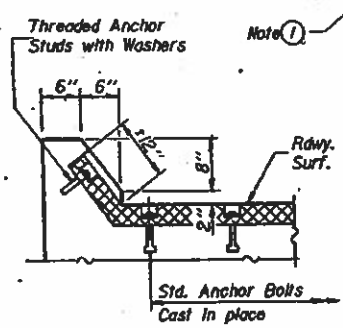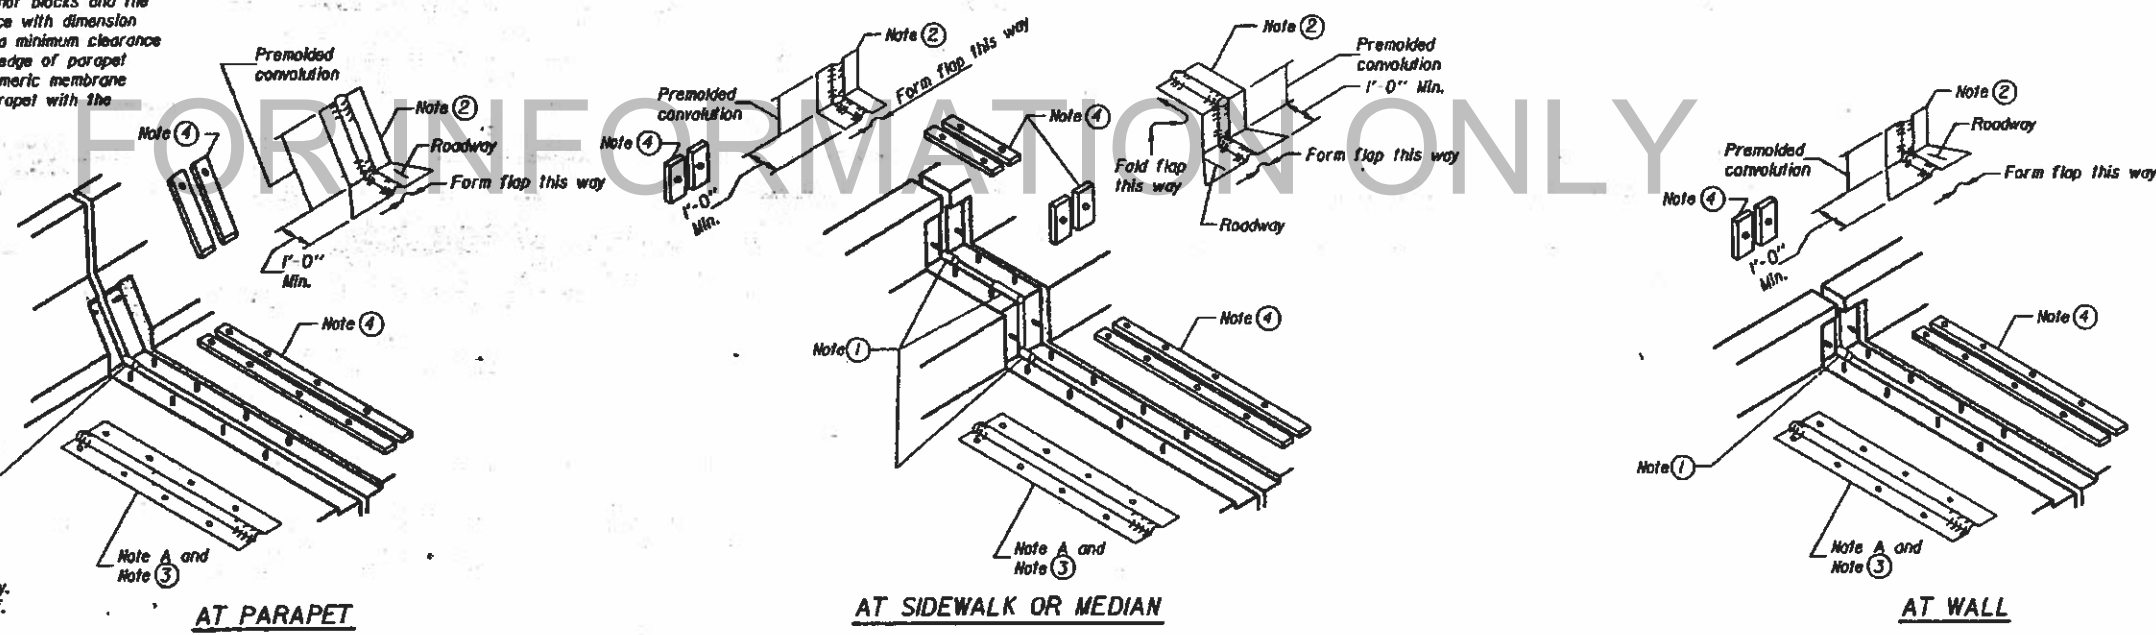


AT CURB

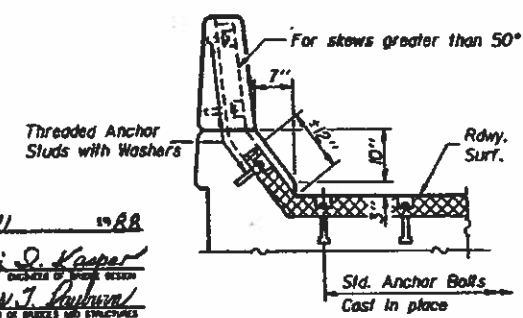

AT PARAPET

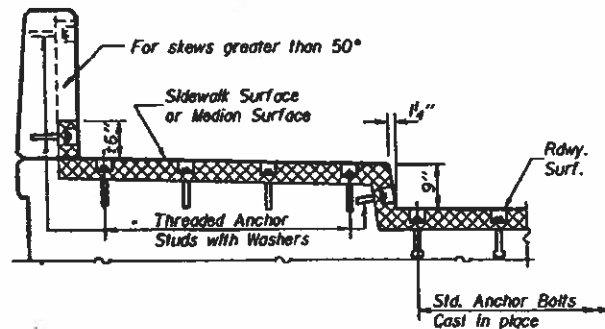

AT SIDEWALK OR MEDIAN

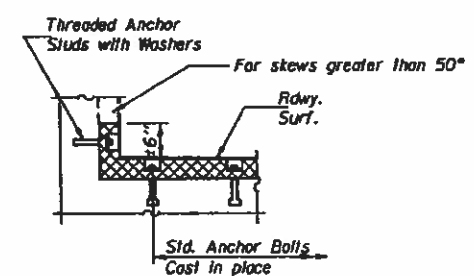

AT WALL

DESIGNED: *J.P. Howard*
 CHECKED: *Eric E. Rowley*
 DRAWN: *J. SCHNEIDER*
 CHECKED: *G.R.A.*

EXAMINED: *Gregory S. Kasper*
 PASSED: *James J. Robinson*
 APPROVED: _____

Feb 11 '88

DIRECTOR OF HIGHWAYS


EJ-CS 12-1-83

CONTINUOUS SEAL TYPE NEOPRENE EXPANSION JOINTS
 For 2", 2 1/2" and 4" Movement

PART 74 SEC. 133B-1
ALEXANDER COUNTY
STA. 1209+70.00

STATE OF ILLINOIS
DEPARTMENT OF TRANSPORTATION

DATE	BY	CHKD	APP'D	SHEET NO. 9
				135
PROJECT NO. 133B-1				19 SHEETS

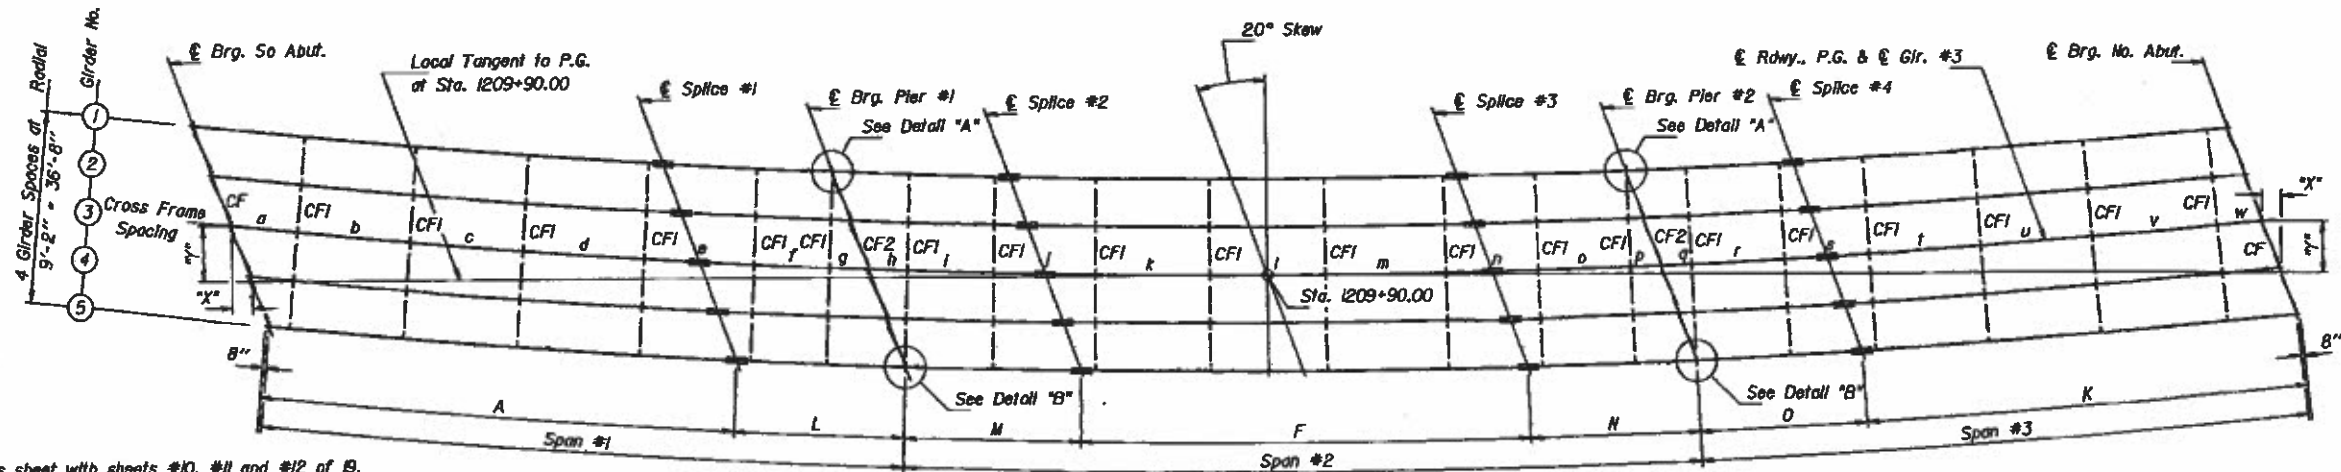

Notes: Work this sheet with sheets #10, #11 and #12 of 13. Girders shall be fabricated to their respective radii. All horizontal dimensions are given along E Girder except "x". All vertical dimensions are given radially except "y". Dimensions "x" & "y" are given from the respective Local Tangent of each Girder at Station 1209+90.00. For Girder dimensions, "x" & "y" dimensions and Cross Frame spacing see sheet #10 of 13. Cross Frame CFI shall be placed radially. All Brg. Stiffeners and Connecting Plates are placed radially. All flanges, webs, brg. stiffeners and splice plate materials shall be AASHTO M-223 Grade 50. All other Structural Steel shall be AASHTO M-183.

FRAMING PLAN

TOP OF WEB ELEVATIONS

Gir.	Loc.	E Brg. S. Abut.	E Splice #1	E Brg. Pier #1	E Splice #2	E Splice #3	E Brg. Pier #2	E Splice #4	E Brg. N. Abut.
#1		349.53	349.48	349.40	349.50	349.50	349.40	349.46	349.53
#2		350.08	350.03	349.95	350.05	350.05	349.95	350.01	350.08
#3		350.63	350.58	350.50	350.60	350.60	350.50	350.56	350.63
#4		351.18	351.13	351.05	351.15	351.15	351.05	351.11	351.18
#5		351.73	351.68	351.60	351.70	351.70	351.60	351.66	351.73

Top of Web Elevations of Splices have been adjusted for Camber. For Fabrication only.

INTERIOR GIRDER REACTION TABLE

	Abuts.	Piers
RR (K)	69.7	244.5
Rt (K)	66.9	107.8
Imp. (K)	11.0	20.5
R (Total) (K)	147.6	372.8


INTERIOR GIRDER MOMENT TABLE

	0.4 Sp. #1 or 0.6 Sp. #3	Piers	0.5 Sp. #2
Is (in ⁴)	33,639.4	67,794.9	33,639.4
Ic (in ⁴)	86,391.7		86,391.7
Se (in ³)	1,482.4	2,307.9	1,482.4
Sc (in ³)	1,987.1		1,987.1
Sbl (in ³)	61.3	101.3	61.3
φ	(K/ft)	1.159	1.558
M _R (K)	1,108.7	3,274.2	995.2
s _R (K/ft)	0.393		0.393
M _{sR} (K)	441.5		480.1
M ₁ (K)	1,677.9	1,384.6	1,768.9
M ₂ (Imp)	275.1	263.1	258.3
S ₂ (M ₂ +I)	3,255.0	2,746.2	3,378.7
M ₀ (K)	6,246.8	7,826.5	6,300.2
M _{bl} (K)	27.8	23.2	29.3
f _s non-comp (k.s.l.)	9.0	17.0	8.1
f _s comp (k.s.l.)	2.7		2.9
f _s (k+1) (k.s.l.)	19.7	14.3	20.4
f _w (k.s.l.)	5.5	2.8	5.8
f _s + f _w (Overload) (k.s.l.)	35.6	33.5	35.9
f _s (Total) (k.s.l.)	40.8	40.7	40.8
f _s (Total) + f _w (k.s.l.)	46.3	43.5	46.6
F _b (k.s.l.)	50.0	50.0	50.0
VR (K)	74.5		66.4



CAMBER DIAGRAM DIMENSIONS A_i THRU N_i

Gir.	Loc.	A _i	B _i	C _i	D _i	E _i	F _i	G _i
#1		±22'-8 1/2"	90'-11 1/2"	±16'-6"	33'-0"	±17'-3"	34'-6"	±21'-9"
#2		±22'-8 1/2"	90'-10 1/2"	±16'-5 1/2"	32'-8 1/2"	±17'-2 1/2"	34'-5 1/2"	±21'-8 1/2"
#3		±22'-8 1/2"	90'-9 1/2"	±16'-5 1/4"	32'-8 1/4"	±17'-2 3/4"	34'-5 1/4"	±21'-8 1/4"
#4		±22'-8 1/2"	90'-8 1/2"	±16'-5 1/8"	32'-8 1/8"	±17'-2 5/8"	34'-5 1/8"	±21'-8 1/8"
#5		±22'-7 3/4"	90'-7 1/4"	±16'-5 1/4"	32'-10 3/4"	±17'-2 3/4"	34'-4 3/4"	±21'-8 3/4"

Gir.	Loc.	H _i	J _i	K _i	L _i	N _i	N _i
#1		87'-0 1/2"	±16'-4 1/2"	32'-9"	±16'-3"	32'-6"	±21'-3 1/2"
#2		86'-10 1/2"	±16'-4 1/2"	32'-8 3/4"	±16'-3"	32'-5 3/4"	±21'-3"
#3		86'-10 1/2"	±16'-4 1/2"	32'-8 3/8"	±16'-2 3/4"	32'-5 3/8"	±21'-3"
#4		86'-10 1/2"	±16'-4 1/2"	32'-8 3/8"	±16'-2 3/4"	32'-5 3/8"	±21'-2 3/4"
#5		86'-9 1/2"	±16'-4 1/2"	32'-8 1/4"	±16'-2 3/4"	32'-5 1/4"	±21'-2 3/4"

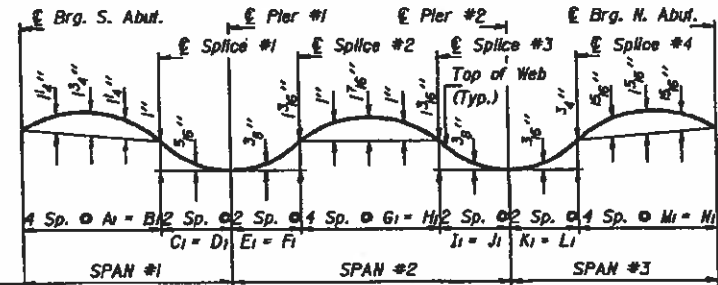

CAMBER DIAGRAM

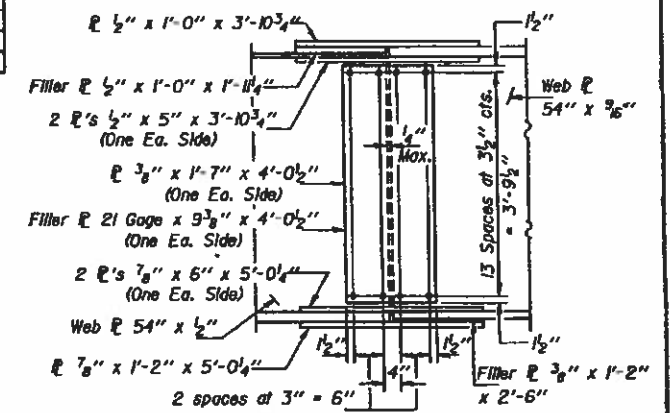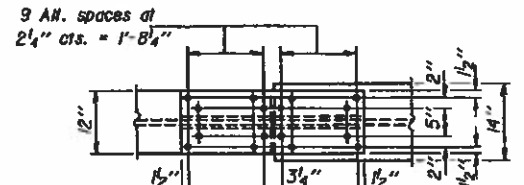

FIELD SPICE DETAIL

Notch Toughness Requirements are required for all splice plates except filler plates. Top flange filler plates shall be placed on the South side of splice #1 & #3 and on the North side of splice #2 & #4. Bottom flange filler plates shall be placed on the North side of splice #1 & #3 and on the South side of splice #2 & #4.

STRUCTURAL STEEL
F.A. RT. 14 SECTION 133B-1
ALEXANDER COUNTY
STATION 1209+90.00


Is and Ss are the moment of inertia and section modulus of the steel section used in computing Is (Total & Overload).
Ic and Sc are the moment of inertia and section modulus of the composite section used in computing Is (Total & Overload).
VR is the maximum Live Load + Impact shear range in span.
Mo (Applied Moment) = 1.3IMR + MsR + 1/2(Mt + D).
fs + fw (Overload) is the sum of the stresses due to MR + MsR + 1/2(Mt + D) + (Mt + D).
fs (Total) (Non-compacted section) is the sum of the stresses due to 1.3IMR + MsR + 1/2(Mt + D).
Sbl is the section modulus for one flange plate for lateral flange bending.
Mbl is the lateral bending moment for flange plate (factored).
fw is the calculated normal stress at the edge of flange due to lateral flange bending (factored).
Mt and Rt have been increased due to effect of centrifugal force and superelevation.
Fb - Maximum allowable shear, Fbu or Fbv, computed according to AASHTO (Guide Specifications for Horizontally Curved Highway Bridges Section 2.12(B) & 2.16).
MR - Moment due to dead loads on non-composite section.
MsR - Moment due to dead loads on composite section.
Mt - Moment due to live loads on non-composite or composite section.
I - Live Load Impact.

DESIGNED: J.R. Hensch
CHECKED: Eric E. Dowdy
DRAWN: John F. Schneider Jr.
EXAMINED: [Signature]
APPROVED: [Signature]

Notes: All dimensions are along the curve except as noted.
 Work this sheet with sheets #9, #11 & #12 of 19.
 All flanges, webs, bearing stiffeners and splice plates materials shall be AASHTO M223 Grade 50.
 All other Structural Steel shall be AASHTO M-183.

STATE OF ILLINOIS
 DEPARTMENT OF TRANSPORTATION


DESIGNED	CHECKED	DRAWN	DATE	SHEET NO.
			1/36	19 SHEETS

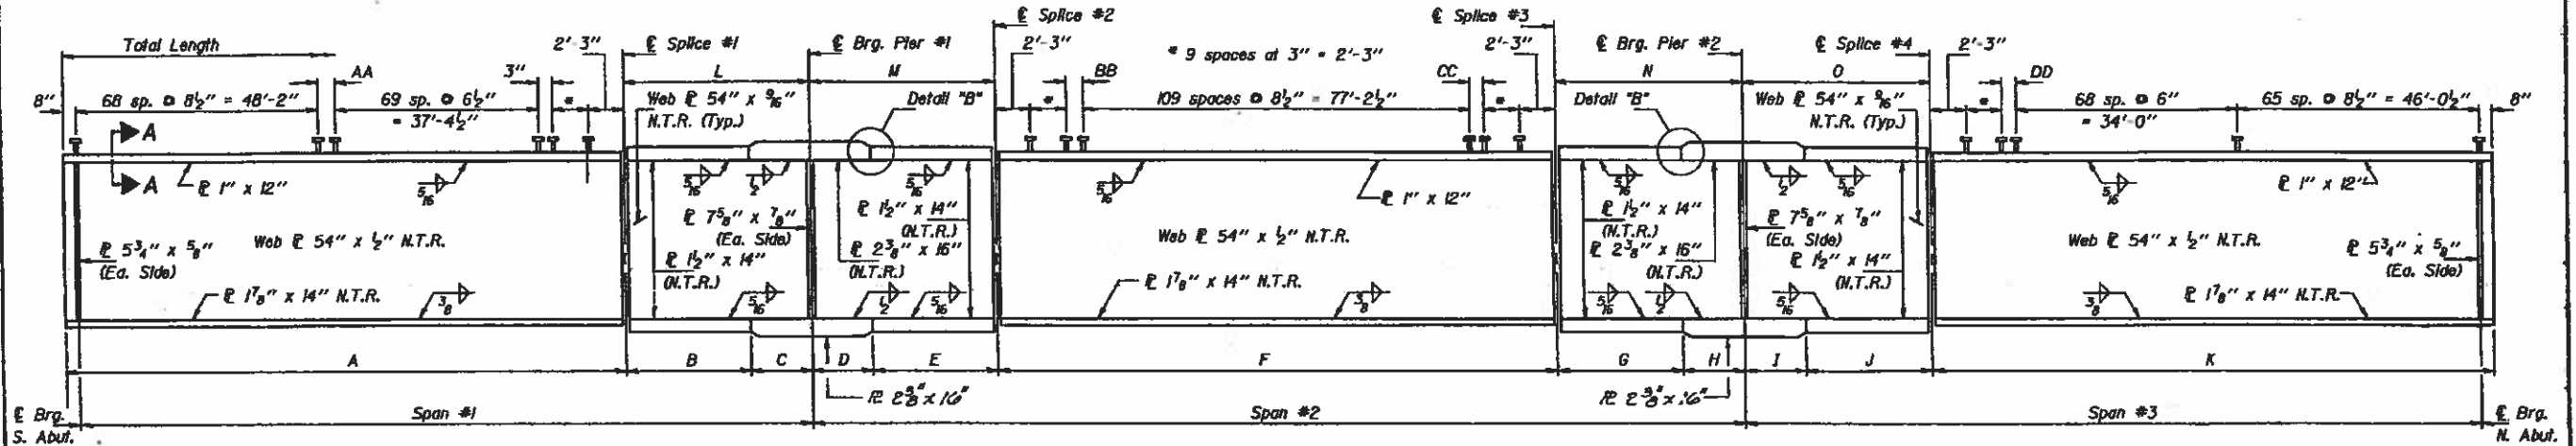

GIRDER ELEVATION
 NTR denotes plates to which toughness requirements are applicable.

CROSS FRAME SPACING

Gir. Loc.	a	b	c	d	e	f	g	h	i	j	k	l	m	n	o	p	q	r	s	t	u	v	w
#1	21'-8"	21'-7"	21'-7"	22'-4 1/2"	22'-1 1/2"	14'-7 1/2"		14'-11"	15'-10"	20'-7"	21'-1 1/2"	22'-0 1/2"	22'-3 1/2"	18'-8 1/2"	17'-9"		11'-7 1/2"	18'-1 1/2"	17'-4 1/2"	20'-7 1/2"	21'-7"	24'-3 1/2"	4'-0"
#2	17'-2 1/2"	21'-8 1/2"	21'-8 1/2"	22'-6"	22'-2 1/2"	14'-8 1/2"	3'-9 1/2"	11'-2 1/2"	15'-11"	20'-8 1/2"	21'-2 1/2"	22'-2 1/2"	22'-4 1/2"	18'-9 1/2"	17'-10 1/2"	2'-8 1/2"	8'-8 1/2"	18'-2 1/2"	17'-5 1/2"	20'-8 1/2"	21'-8 1/2"	24'-4 1/2"	6'-4 1/2"
#3	12'-9 1/2"	21'-9 1/2"	21'-9 1/2"	22'-7 1/2"	22'-3 1/2"	14'-9 1/2"	7'-7 1/2"	7'-5 1/2"	17'-0"	20'-9 1/2"	21'-3 1/2"	22'-3 1/2"	22'-5 1/2"	18'-11"	17'-11 1/2"	5'-11"	5'-9 1/2"	18'-4"	17'-6 1/2"	20'-9 1/2"	21'-9 1/2"	24'-6 1/2"	8'-8 1/2"
#4	8'-4 1/2"	21'-10 1/2"	21'-10 1/2"	22'-8 1/2"	22'-5 1/2"	14'-10 1/2"	11'-4 1/2"	3'-8 1/2"	17'-1 1/2"	20'-10 1/2"	21'-4 1/2"	22'-4 1/2"	22'-7 1/2"	18'-0"	18'-0 1/2"	8'-10 1/2"	2'-10 1/2"	18'-5"	17'-7 1/2"	20'-10 1/2"	21'-10 1/2"	24'-7 1/2"	11'-0 1/2"
#5	4'-0"	22'-0"	22'-0"	22'-9 1/2"	22'-6 1/2"	14'-11 1/2"	15'-2 1/2"		17'-1 1/2"	20'-11 1/2"	21'-6"	22'-6"	22'-8 1/2"	18'-1 1/2"	18'-1 1/2"	11'-9 1/2"		18'-6 1/2"	17'-8 1/2"	21'-0"	22'-0"	24'-8 1/2"	13'-5 1/2"

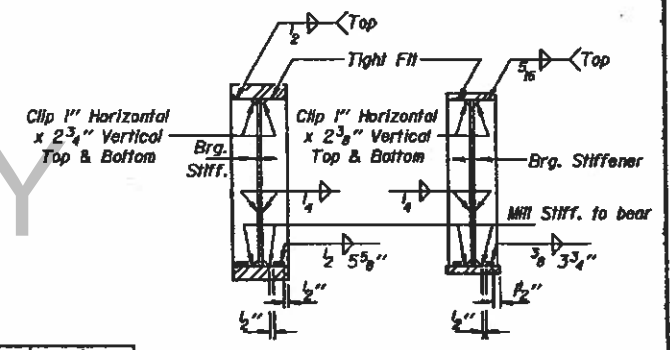

GIRDER DIMENSIONS


Gir. Loc.	Radius	Span #1	Span #2	Span #3	Total Length	A	B	C	D	E	F	G	H	I	J	K	L	M	N	O
#1	1891.53'	123'-11 1/2"	154'-3 1/2"	117'-6 1/2"	397'-1 1/2"	91'-7 1/2"	21'-0"	12'-0"	12'-0"	22'-6"	87'-0 1/2"	20'-9"	12'-0"	12'-0"	20'-6"	85'-8 1/2"	33'-0"	34'-6"	32'-9"	32'-6"
#2	1900.69'	123'-10 1/2"	154'-1 1/2"	117'-6"	396'-10"	91'-6 1/2"	20'-11 1/2"	11'-11 1/2"	11'-11 1/2"	22'-5 1/2"	86'-11 1/2"	20'-8 1/2"	11'-11 1/2"	12'-0"	20'-5 1/2"	85'-8 1/2"	32'-11 1/2"	34'-5 1/2"	32'-8 1/2"	32'-5 1/2"
#3	1909.86'	123'-8 1/2"	154'-0 1/2"	117'-5 1/2"	396'-6 1/2"	91'-5 1/2"	20'-8 1/2"	11'-11 1/2"	11'-11 1/2"	22'-5 1/2"	86'-10 1/2"	20'-8 1/2"	11'-11 1/2"	11'-11 1/2"	20'-5 1/2"	85'-7 1/2"	32'-11 1/2"	34'-5 1/2"	32'-8 1/2"	32'-5 1/2"
#4	1919.03'	123'-7 1/2"	153'-11 1/2"	117'-4 1/2"	396'-3 1/2"	91'-4 1/2"	20'-8 1/2"	11'-11 1/2"	11'-11 1/2"	22'-5 1/2"	86'-10 1/2"	20'-8 1/2"	11'-11 1/2"	11'-11 1/2"	20'-5 1/2"	85'-7 1/2"	32'-11 1/2"	34'-5 1/2"	32'-8 1/2"	32'-5 1/2"
#5	1928.19'	123'-5 1/2"	153'-10 1/2"	117'-4 1/2"	396'-0 1/2"	91'-3 1/2"	20'-11 1/2"	11'-8 1/2"	11'-11 1/2"	22'-5 1/2"	86'-9 1/2"	20'-8 1/2"	11'-11 1/2"	11'-11 1/2"	20'-5 1/2"	85'-7 1/2"	32'-10 1/2"	34'-4 1/2"	32'-8 1/2"	32'-5 1/2"

"X" & "Y" OFFSET DIMENSIONS


Gir. Loc.	E Brg. S. Abut.		E Splice #1		E Brg. Pier #1		E Splice #2		E Splice #3		E Brg. Pier #2		E Splice #4		E Brg. N. Abut.	
	X	Y	X	Y	X	Y	X	Y	X	Y	X	Y	X	Y	X	Y
#1	4'-2"	11'-5 1/2"	1'-3 1/2"	3'-7 1/2"	8 1/2"	1'-10 1/2"	2 1/2"	7 1/2"	1 1/2"	4 1/2"	5 1/2"	1'-3 1/2"	1'-0 1/2"	2'-9 1/2"	3'-4 1/2"	9'-3 1/2"
#2	4'-0 1/2"	11'-0 1/2"	1'-2 1/2"	3'-5 1/2"	7 1/2"	1'-8 1/2"	2 1/2"	6 1/2"	1 1/2"	5 1/2"	6 1/2"	1'-4 1/2"	1'-0 1/2"	2'-11 1/2"	3'-5 1/2"	9'-6 1/2"
#3	3'-10 1/2"	10'-7 1/2"	1'-2 1/2"	3'-2 1/2"	6 1/2"	1'-6 1/2"	2 1/2"	5 1/2"	2 1/2"	6 1/2"	1'-6 1/2"	1'-1 1/2"	3'-1 1/2"	3'-7 1/2"	9'-10"	
#4	3'-8 1/2"	10'-2 1/2"	1'-1 1/2"	2'-11 1/2"	6 1/2"	1'-5 1/2"	1 1/2"	5 1/2"	2 1/2"	6 1/2"	1'-7 1/2"	1'-2 1/2"	3'-3 1/2"	3'-8 1/2"	10'-1 1/2"	
#5	3'-6 1/2"	9'-9 1/2"	1'-0 1/2"	2'-9 1/2"	5 1/2"	1'-3 1/2"	1 1/2"	4 1/2"	2 1/2"	7 1/2"	1'-9 1/2"	1'-3 1/2"	3'-5 1/2"	3'-9 1/2"	10'-4 1/2"	

VALUES OF AA THRU DD


Gir. Loc.	AA	BB	CC	DD
#1	8"	4 1/2"	4 1/2"	6 1/2"
#2	6 1/2"	4 1/2"	4 1/2"	5 1/2"
#3	5 1/2"	4 1/2"	4 1/2"	5 1/2"
#4	4 1/2"	3 1/2"	3 1/2"	5"
#5	3 1/2"	3 1/2"	3 1/2"	4 1/2"

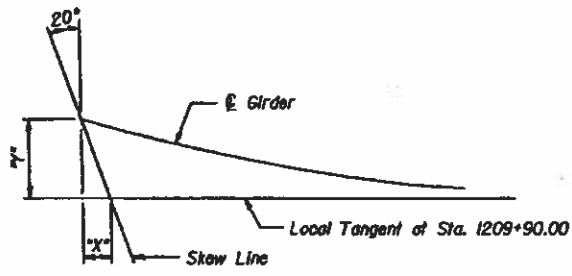


"X" & "Y" OFFSET LOCATIONS

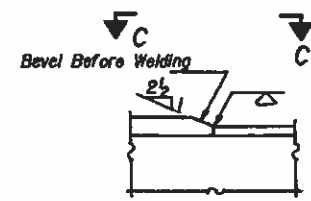

DETAIL "B"

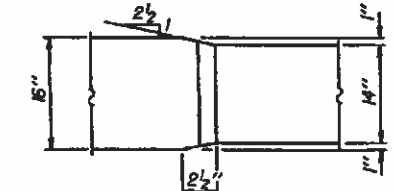

VIEW C-C

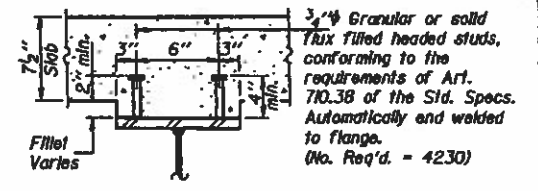


SECTION A-A

DESIGNED: *M.R. Wood*
 CHECKED: *Eric E. Downey*
 DRAWN: *John P. Schneller Jr.*
 DATE: Feb 11, 1988


STRUCTURAL STEEL
F.A. RT. 14 SECTION 133B-1
ALEXANDER COUNTY
STATION 1209+90.00

STATE OF ILLINOIS
DEPARTMENT OF TRANSPORTATION


PROJECT NO.	SECTION	SHEET NO.	TOTAL SHEETS
		81	89 SHEETS

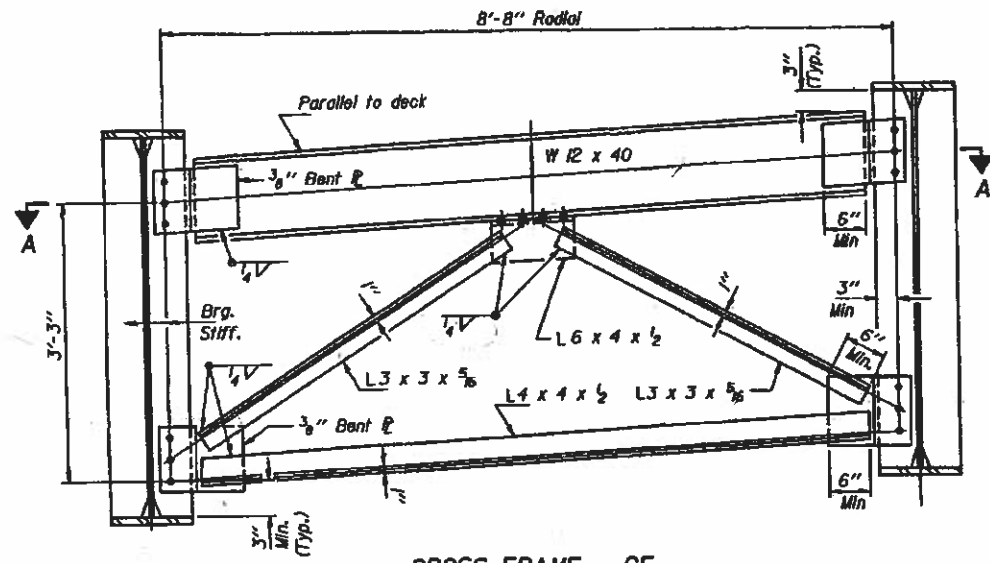


CROSS FRAME - CF
(B Required)

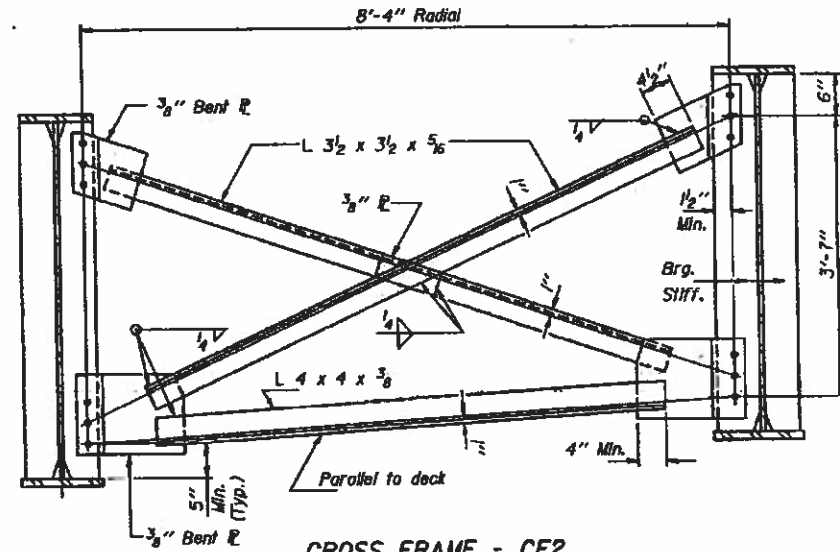


CROSS FRAME - CF2
(B Required)

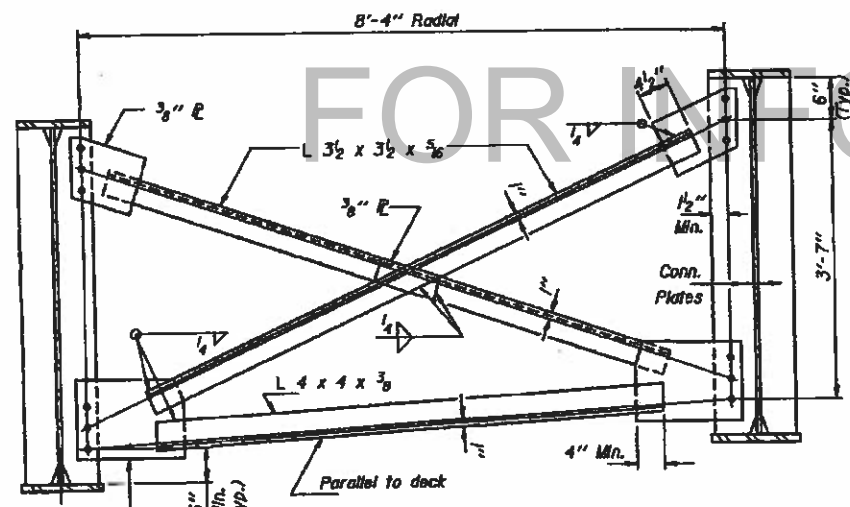


CROSS FRAME - CF1
(B0 Required)

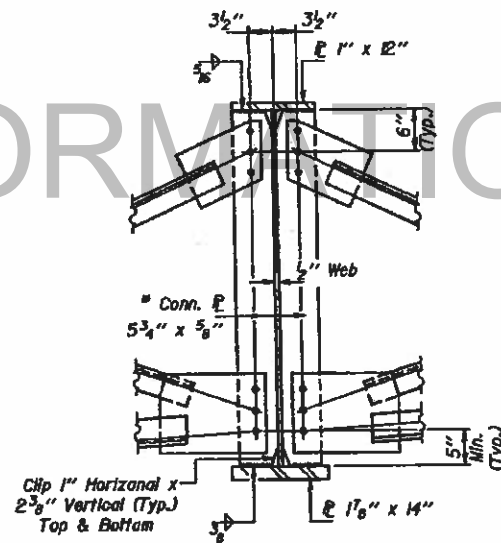

CROSS FRAME - CF1
(Showing Connecting Plates at
12" Top Flange and 14" Bottom Flange)

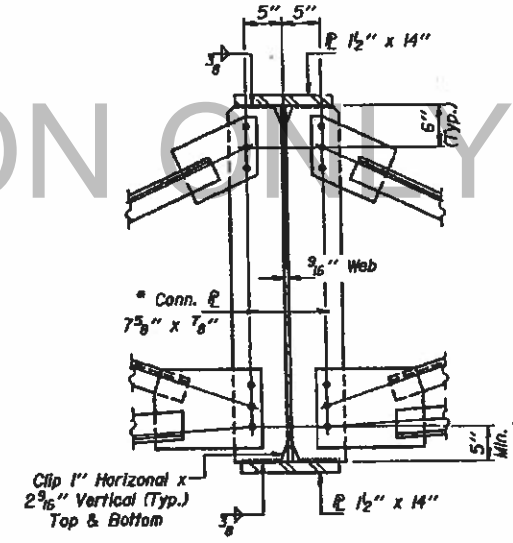

CROSS FRAME - CF1
(Showing Connecting Plates at
14" Top Flange and 14" Bottom Flange)

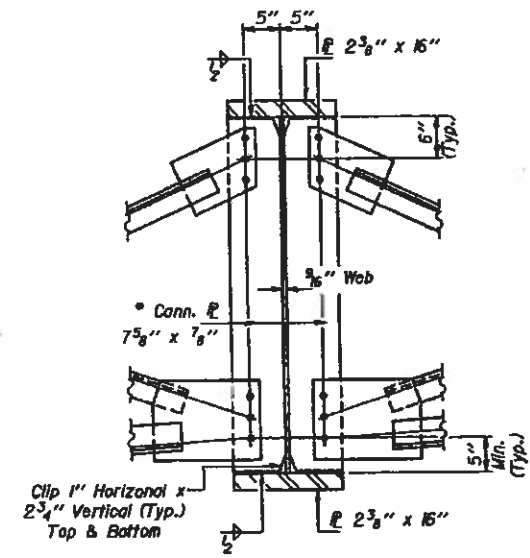

CROSS FRAME - CF1
(Showing Connecting Plates at
16" Top Flange and 16" Bottom Flange)

Notes:
Use 3/4" H.S. Bolts with 5/16" holes.
Two hardened washers shall be required
over all holes for Cross Frame.
All connecting plates and bearing stiffeners
are placed radial.
All Structural Steel for cross frames shall
be AASHTO M-183.
For Section A-A see sheet #12 of B.
* Omit connecting plates on exterior side of
exterior girders.


DESIGNED *M. Williams*
CHECKED *Eric E. Handy*
DRAWN *John R. Schneller Jr.*
CHECKED *GRI*

Feb 11 1988
EXAMINED *Orville D. Hanson*
PASSED *James T. Johnson*
APPROVED *James T. Johnson*
ENGINEER OF STRUCTURES

STRUCTURAL STEEL
F.A. RT. 14 SECTION 133B-1
ALEXANDER COUNTY
STATION 1209+90.00

STATE OF ILLINOIS
DEPARTMENT OF TRANSPORTATION

DESIGN NO.	PROJECT	DATE	SHEET NO. 12
			138
SHEET NO. 12			13 SHEETS

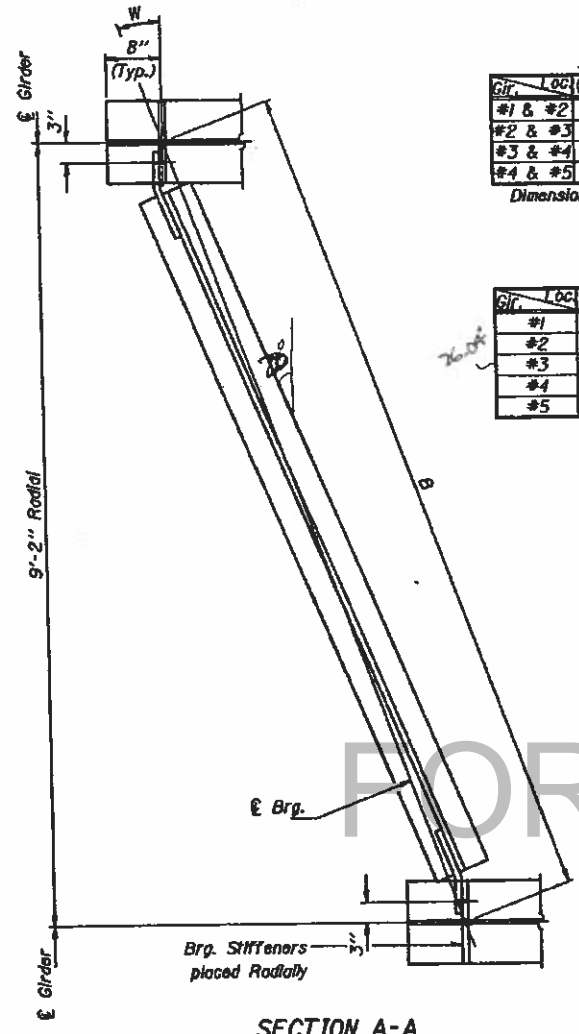

DIMENSION "B"

Gir.	Loc.	Brq. S. Abut.	Brq. N. Abut.
#1 & #2		10'-2 1/2"	9'-5 1/2"
#2 & #3		10'-2 1/2"	9'-5 1/2"
#3 & #4		10'-2 1/2"	9'-5 1/2"
#4 & #5		10'-2 1/2"	9'-5 1/2"

Dimensions are between Girders.

VALUE OF W

Gir.	Loc.	Brq. S. Abut.	Brq. N. Abut.
#1		26'-10'-40"	14'-19'-22"
#2		26'-10'-28"	14'-15'-08"
#3		26'-02'-22"	14'-10'-57"
#4		25'-54'-21"	14'-06'-48"
#5		25'-46'-25"	14'-02'-41"


DIMENSION "C"

Gir.	Loc.	Brq. Pier #1	Brq. Pier #2
#1 & #2		9'-11 1/2"	9'-7 1/2"
#2 & #3		9'-11"	9'-7 1/2"
#3 & #4		9'-10 1/2"	9'-7 1/2"
#4 & #5		9'-10 1/4"	9'-7 1/4"


Dimensions are between Girders.

VALUE OF Z

Gir.	Loc.	Brq. Pier #1	Brq. Pier #2
#1		22'-33'-22"	17'-53'-01"
#2		22'-26'-29"	17'-47'-40"
#3		22'-9'-40"	17'-42'-22"
#4		22'-12'-56"	17'-37'-08"
#5		22'-06'-15"	17'-31'-56"

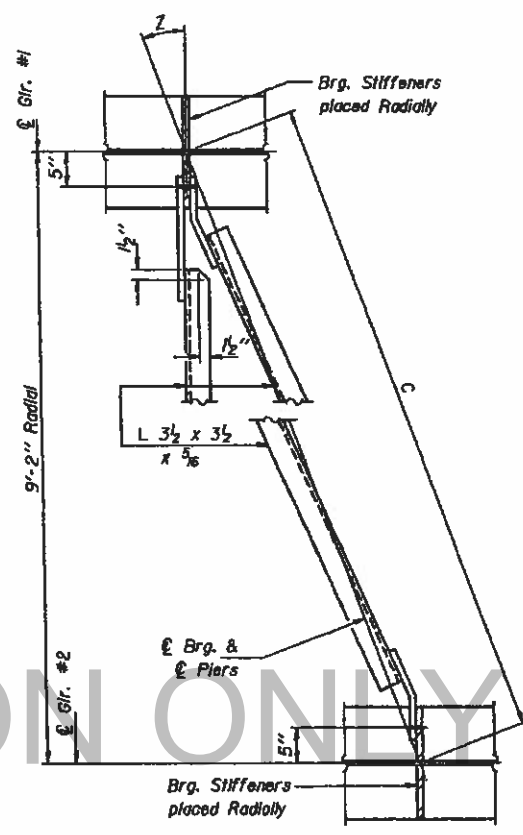


DETAIL "A"
(Top)

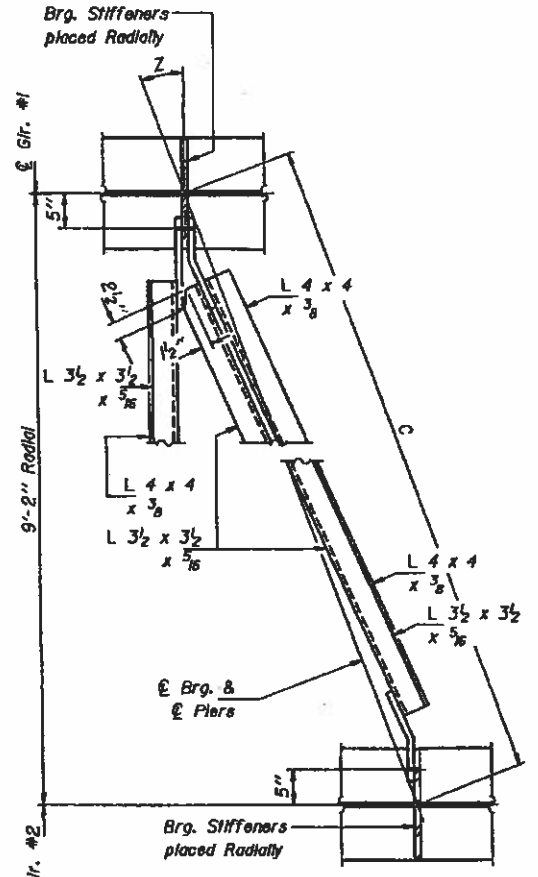


DETAIL "A"
(Bottom)

Notes: Work this sheet with sheets #9 and #11 of 13.

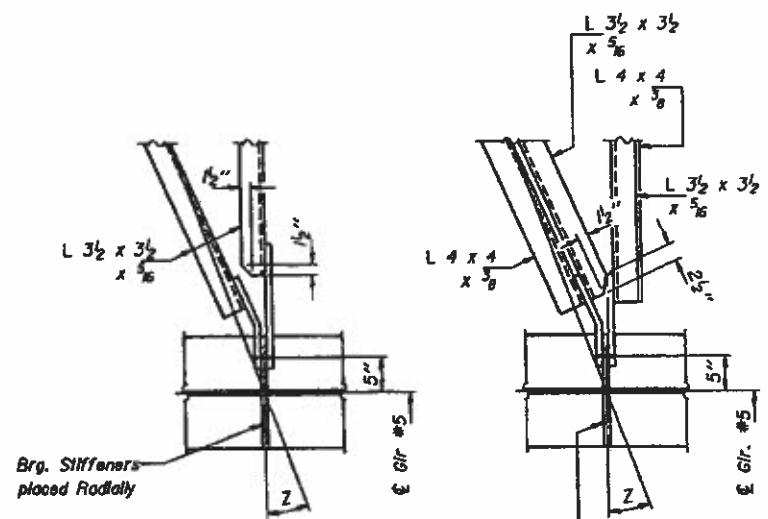

DETAIL "B"
(Top)

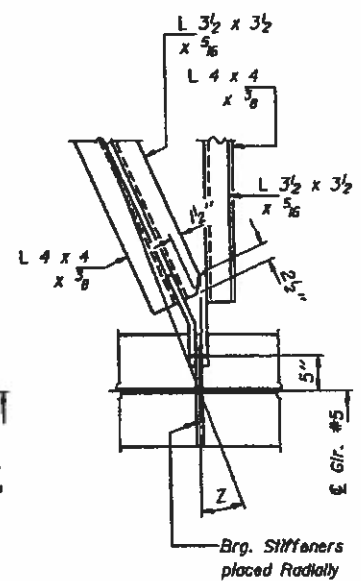

DETAIL "B"
(Bottom)


DESIGNED: *[Signature]*
 CHECKED: Eric E. Hauck
 DRAWN: John F. Schnoller Jr.
 CHECKED: GPA

Feb 11 1988
 EXAMINED: *[Signature]*
 PASSED: *[Signature]*
 APPROVED: *[Signature]*


STRUCTURAL STEEL
F.A. RT. 14 SECTION 133B-1
ALEXANDER COUNTY
STATION 1209+90.00

STATE OF ILLINOIS
DEPARTMENT OF TRANSPORTATION

PROJECT NO.	SECTION	DATE	SHEET NO.	TOTAL SHEETS
			139	19

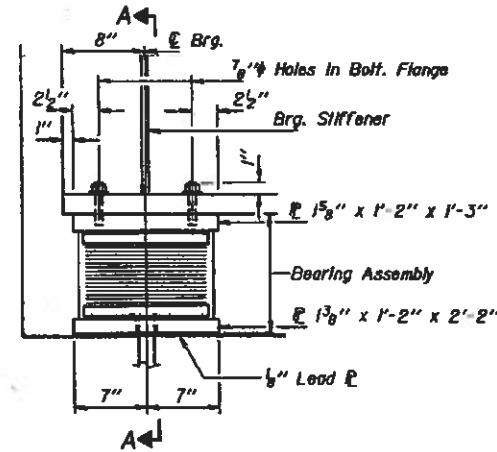


ELEVATION AT ABUTS.

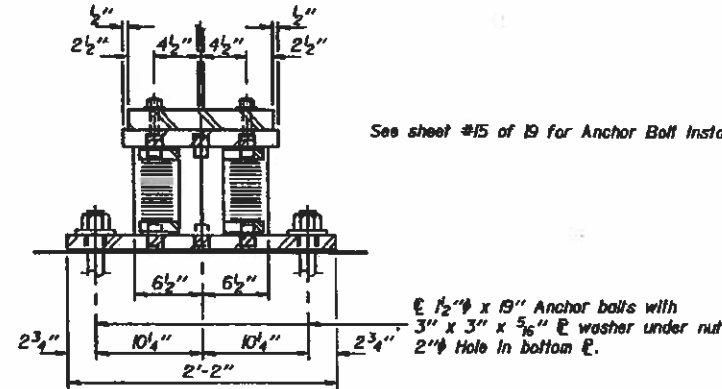


SECTION A-A

See sheet #15 of 19 for Anchor Bolt Installation.

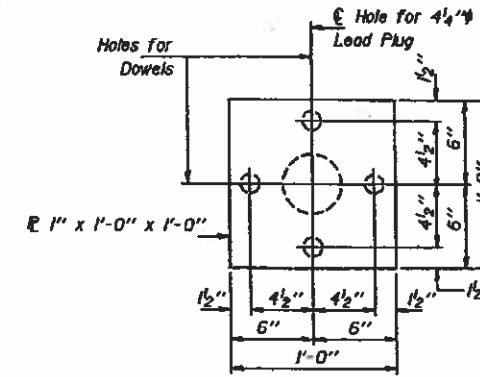


PLAN - TOP 1" PLATE

SEISMIC ISOLATION BEARING 1'-1" x 1'-1"

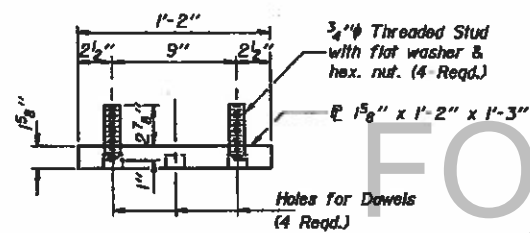


*TOP BEARING ASSEMBLY

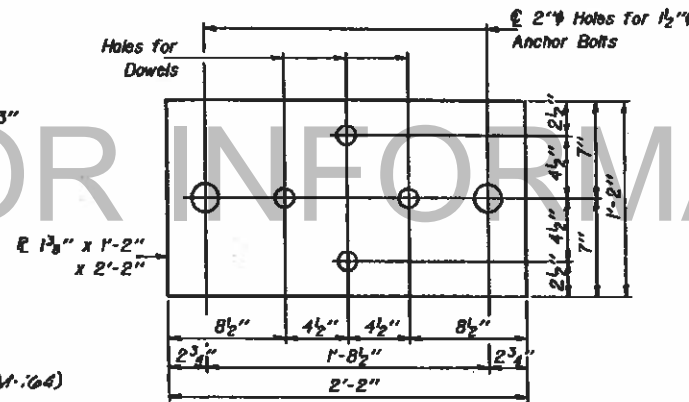


*PLAN - BOTTOM BEARING ASSEMBLY


*The Top & Bottom Plates of the Bearing Assembly shall be AASHTO M-223 Grade 50.

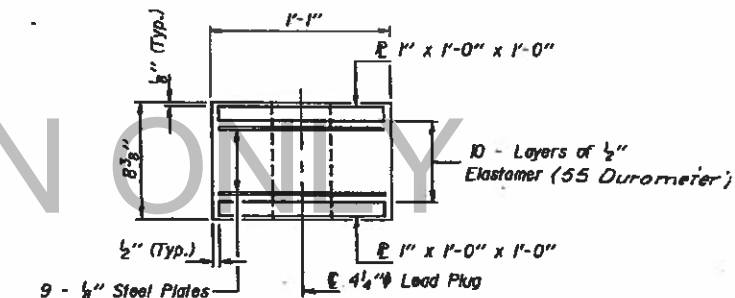

INTERIOR BEARING ASSEMBLY

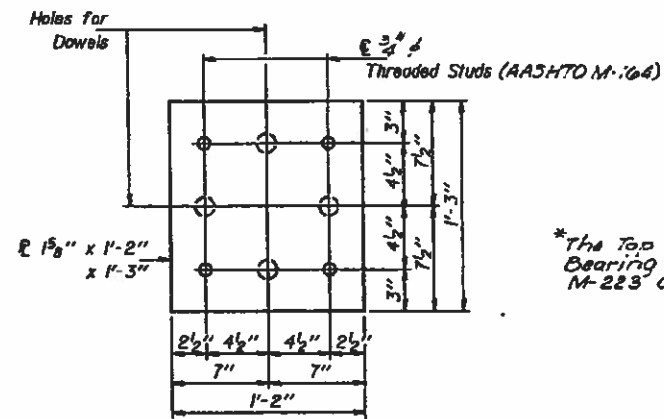

*PLAN - TOP BEARING ASSEMBLY

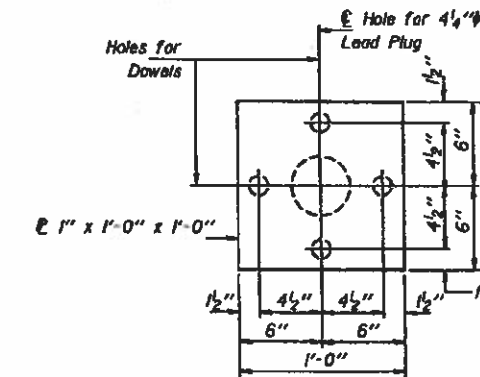

PLAN - BOTTOM 1" PLATE

BILL OF MATERIAL

Item	Unit	Total
Seismic Isolation Bearing Assy. 13" x 13"	Each	10


DESIGNED: <i>M. R. K...</i>	EXAMINED: <i>...</i>
CHECKED: <i>Eric E. Lowry</i>	PASSED: <i>James T. ...</i>
DRAWN: <i>John F. Schneller Jr.</i>	APPROVED: <i>...</i>
CHECKED: <i>GRA</i>	DIRECTOR OF HIGHWAYS

Feb 11 1988


ABUTMENT BEARING DETAILS
F.A. RT. 14 SECTION 133B-1
ALEXANDER COUNTY
STATION 1209+90.00

STATE OF ILLINOIS
DEPARTMENT OF TRANSPORTATION

PROJECT NO.	SECTION	DRAWN	DATE	"E"	SHEET NO. 14
				140	19 SHEETS
PROJ. DIST. NO.	SCALE	FILE NO.			

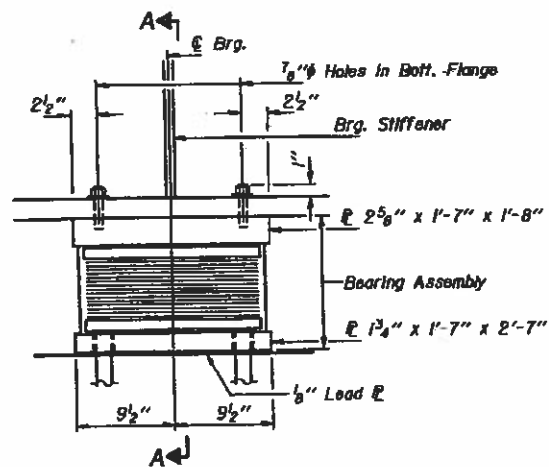


ELEVATION AT PIERS

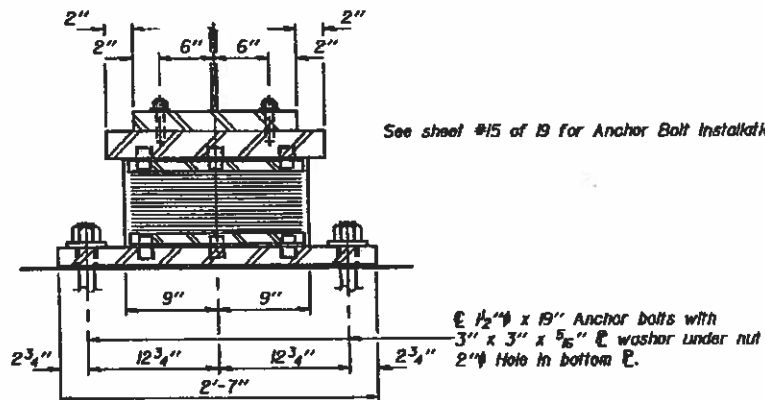


SECTION A-A

See sheet #15 of B for Anchor Bolt Installation.


SEISMIC ISOLATION BEARING 1'-6" x 1'-6"

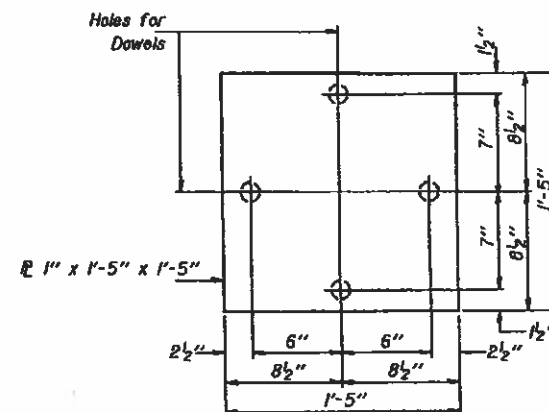


PLAN - TOP 1" PLATE

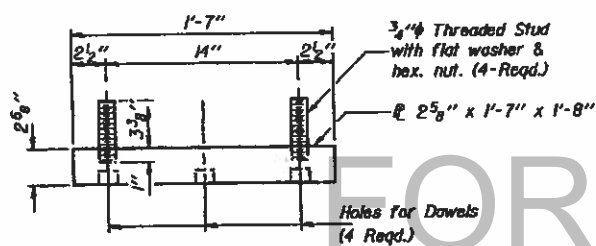


*TOP BEARING ASSEMBLY

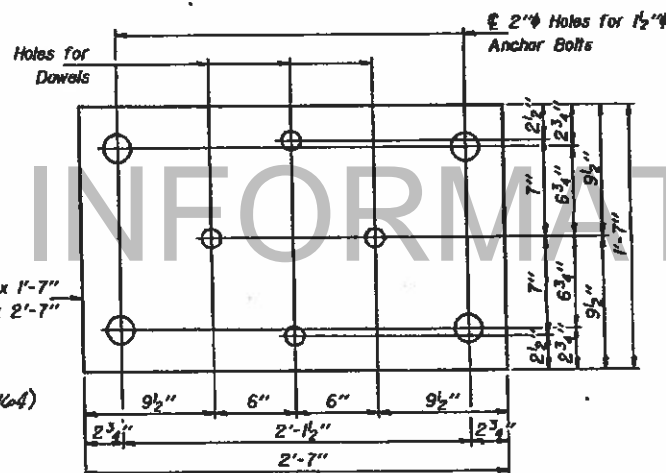

*PLAN - BOTTOM BEARING ASSEMBLY

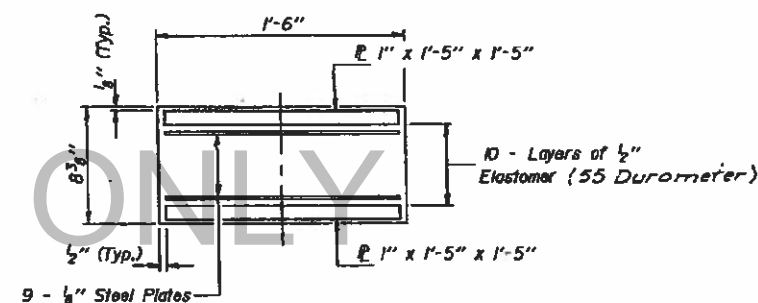


INTERIOR BEARING ASSEMBLY

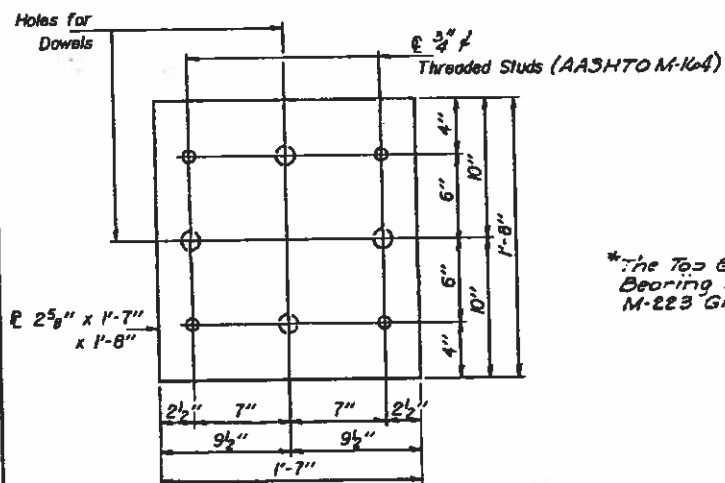

*PLAN - TOP BEARING ASSEMBLY

*The Top & Bottom Plates of the Bearing Assembly shall be AASHTO M-223 Grade 50.

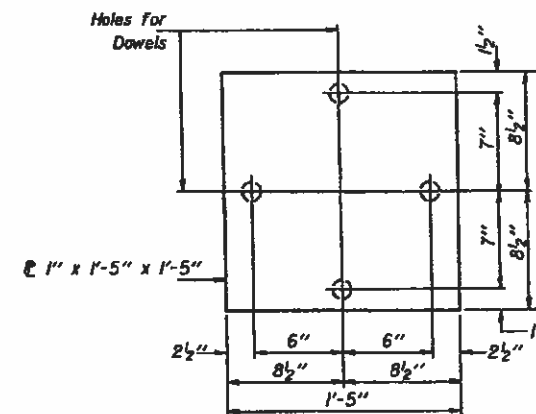

PLAN - BOTTOM 1" PLATE

BILL OF MATERIAL

Item	Unit	Total
Seismic Isolation Bearing Assy: 18" x 18"	Each	10

DESIGNED: <i>Sh. H. G. ...</i>	DATE: Feb 11 1988
CHECKED: <i>Eric E. Dowdy</i>	EXAMINED: <i>Orsi D. ...</i>
DRAWN: <i>John F. Schelller Jr.</i>	PROJ. NO. <i>James J. ...</i>
CHECKED: <i>G.R.A.</i>	APPROVED: <i>...</i>


PIER BEARING DETAILS
F.A. RT. 14 SECTION 133B-1
ALEXANDER COUNTY
STATION 1209+90.00

STATE OF ILLINOIS
DEPARTMENT OF TRANSPORTATION


PROJECT NO.	SECTION	DATE	SHEET NO.
			15
SHEET NO.			19 SHEETS

The Illinois Coil-Lock Anchor Bolt is a proprietary item which is the property of the Illinois Department of Transportation. Use, reproduction or disclosure without express written permission is prohibited and protected under Federal copyright laws. The production and the fabrication of this bolt for use on highway projects in the State of Illinois shall be permitted and there shall be no incurred charges or fees to the manufacturer or the fabricator for producing or fabricating this bolt.

D	E	H	K	"d"
1"	1 1/8"	1 1/2"	1 3/4"	1/2"
1 1/2"	1 5/8"	1 7/8"	2 1/4"	5/8"
2"	2 1/4"	2 5/8"	3 1/8"	3/4"
2 1/2"	2 7/8"	3 1/4"	3 7/8"	1"

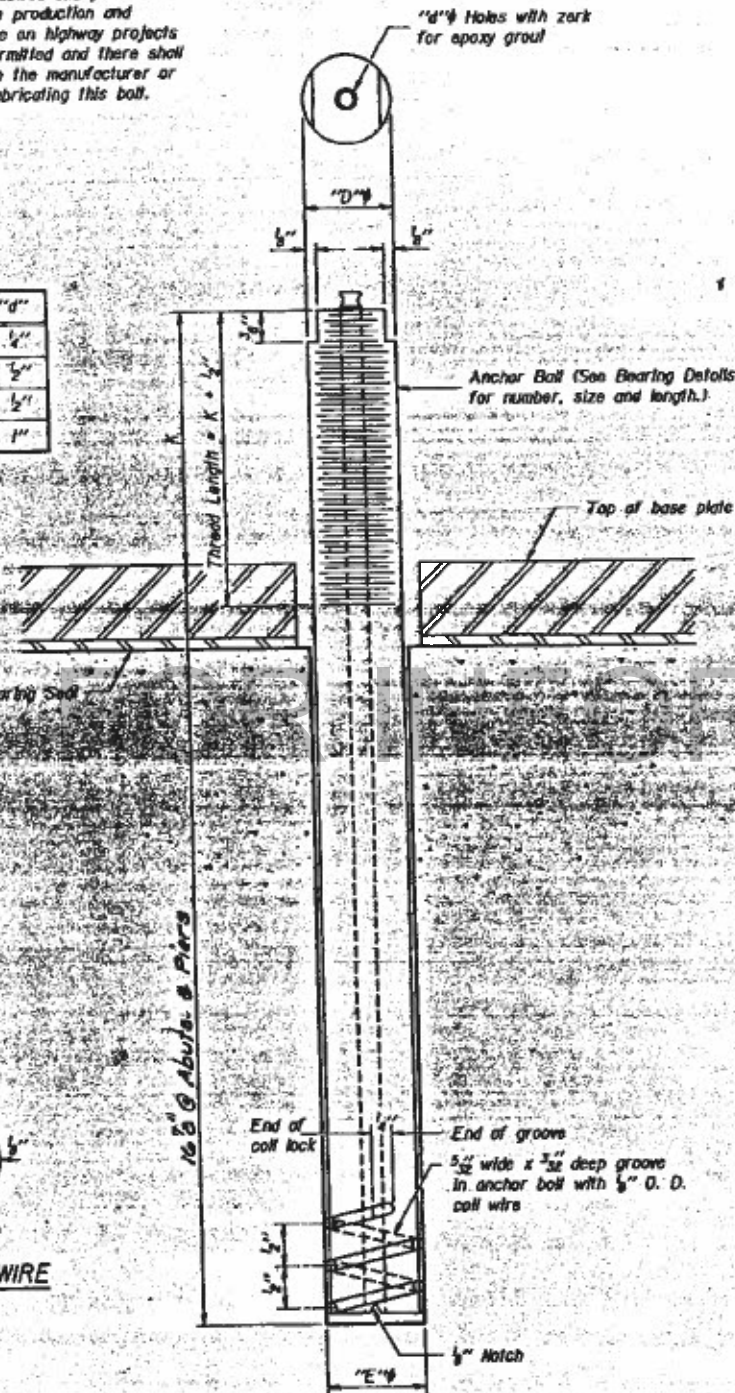

ILLINOIS COIL-LOCK ANCHOR BOLT

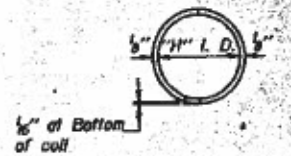

PLAN-COIL WIRE

MATERIALS FOR ILLINOIS COIL-LOCK ANCHOR BOLT

The anchor bolt shall be fabricated from cold drawn or hot finished seamless carbon steel mechanical tubing conforming to ASTM A519, Grade 1026 and supplied with hexagonal nuts and cut washers.
The coil wire shall be made of any suitable soft steel wire.
The finished anchor bolt shall be cleaned of rust and other foreign materials and wrapped or packaged to prevent contamination until they are installed.
The epoxy grout shall be a two-component, epoxy resin bonding system conforming to ASTM C881, Type I, Grade I and of a Class suitable for the temperature at installation.

INSTALLATION PROCEDURE for the ILLINOIS COIL-LOCK ANCHOR BOLT

1. With the coil wire in place, the bolt shall be inserted into the hole and turned clockwise to a snug fit in the hole. Nut and washer shall be placed on the bolt. The nut shall be tensioned until the steel base plates are held securely to the concrete bearing seat.
2. Epoxy grout shall be pumped through the zerk fitting with a pressure gun. Pumping shall continue until the epoxy overflows the hole around the bolt shank. After pumping is discontinued, excess epoxy shall be immediately wiped off.

ALTERNATE ANCHOR BOLTS

The Contractor may use, at his option, the capsule or the adhesive cartridge type anchor rods that have been previously tested and given a prior approval by the Department. The Contractor shall install these anchor rods in pre-drilled holes in accordance with the manufacturer's recommendations and procedures.
The capsule or the adhesive cartridge type anchor rods shall be a two-part system composed of:
1. A threaded rod stud with nut and washer conforming to ASTM A307.
2. A sealed glass capsule or a sealed glass adhesive cartridge containing premeasured amounts of the adhesive chemical.

GENERAL NOTES

Holes in the masonry for anchor bolts shall be drilled through the base plates to the diameter and depth shown or in accordance with the manufacturer's recommendation after beams or girders have been erected and adjusted.
Prior to setting the bolts, the holes shall be dry and all dust and loose particles shall be removed by the use of compressed air or vacuuming.
The anchor bolts, furnished and installed and including the epoxy grout or capsules shall not be paid for separately but shall be included in the unit bid price for "Furnishing and Erecting Structural Steel".
Anchor bolts, nuts and washers shall be completely coated by either the hot-dipped process conforming with AASHTO M 232 or the mechanical plating method conforming to ASTM B 695, Class 50. Zinc-coated nuts shall be topped oversize in accordance with the requirements of AASHTO M 291 and shall meet the supplementary requirements SL1 thru SL2.1 of the same specifications for lubricant and testing.

ANCHOR BOLT DETAILS FOR BEARINGS







EX. RT. 14 SEC. 133B-1
ALEXANDER COUNTY
STA. 120+74.00

DESIGNED A. R. Aland EXAMINED James J. Kuykendall
CHECKED Eric E. Bowdy PASSED James J. Kuykendall
DRAWN J. SCHWELER
CHECKED GPA

Feb 11 1983
ABB-1 12-1-83

STATE OF ILLINOIS
DEPARTMENT OF TRANSPORTATION

PROJECT NO.	142	SHEET NO.	16
DATE		TITLE	REINFORCEMENT

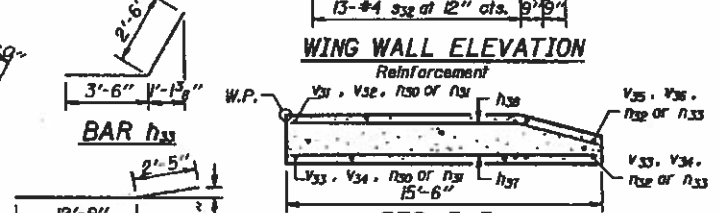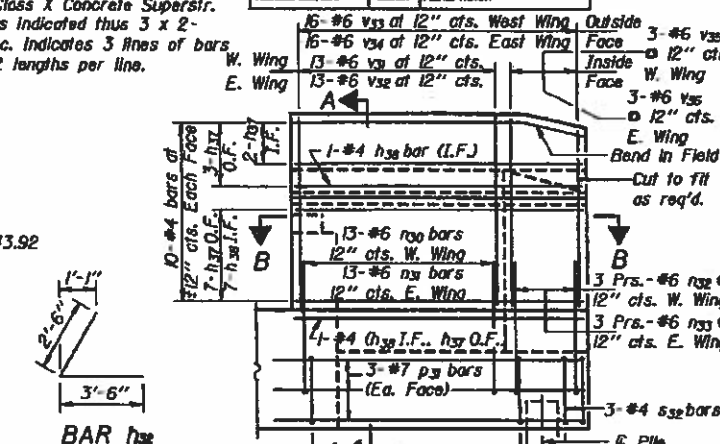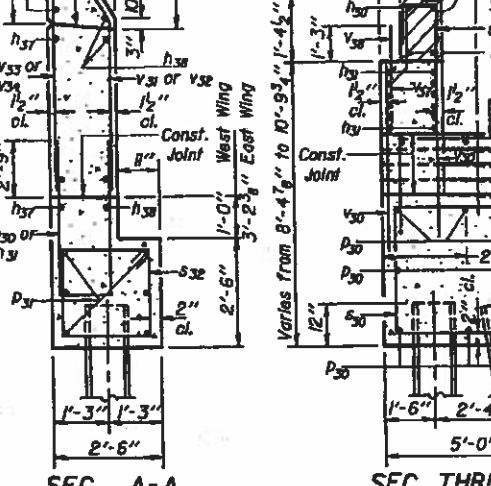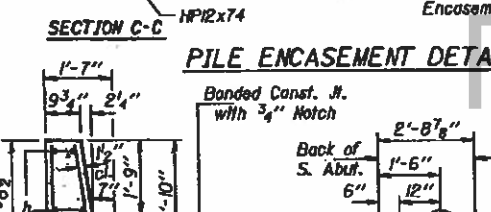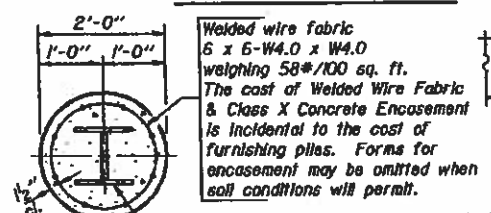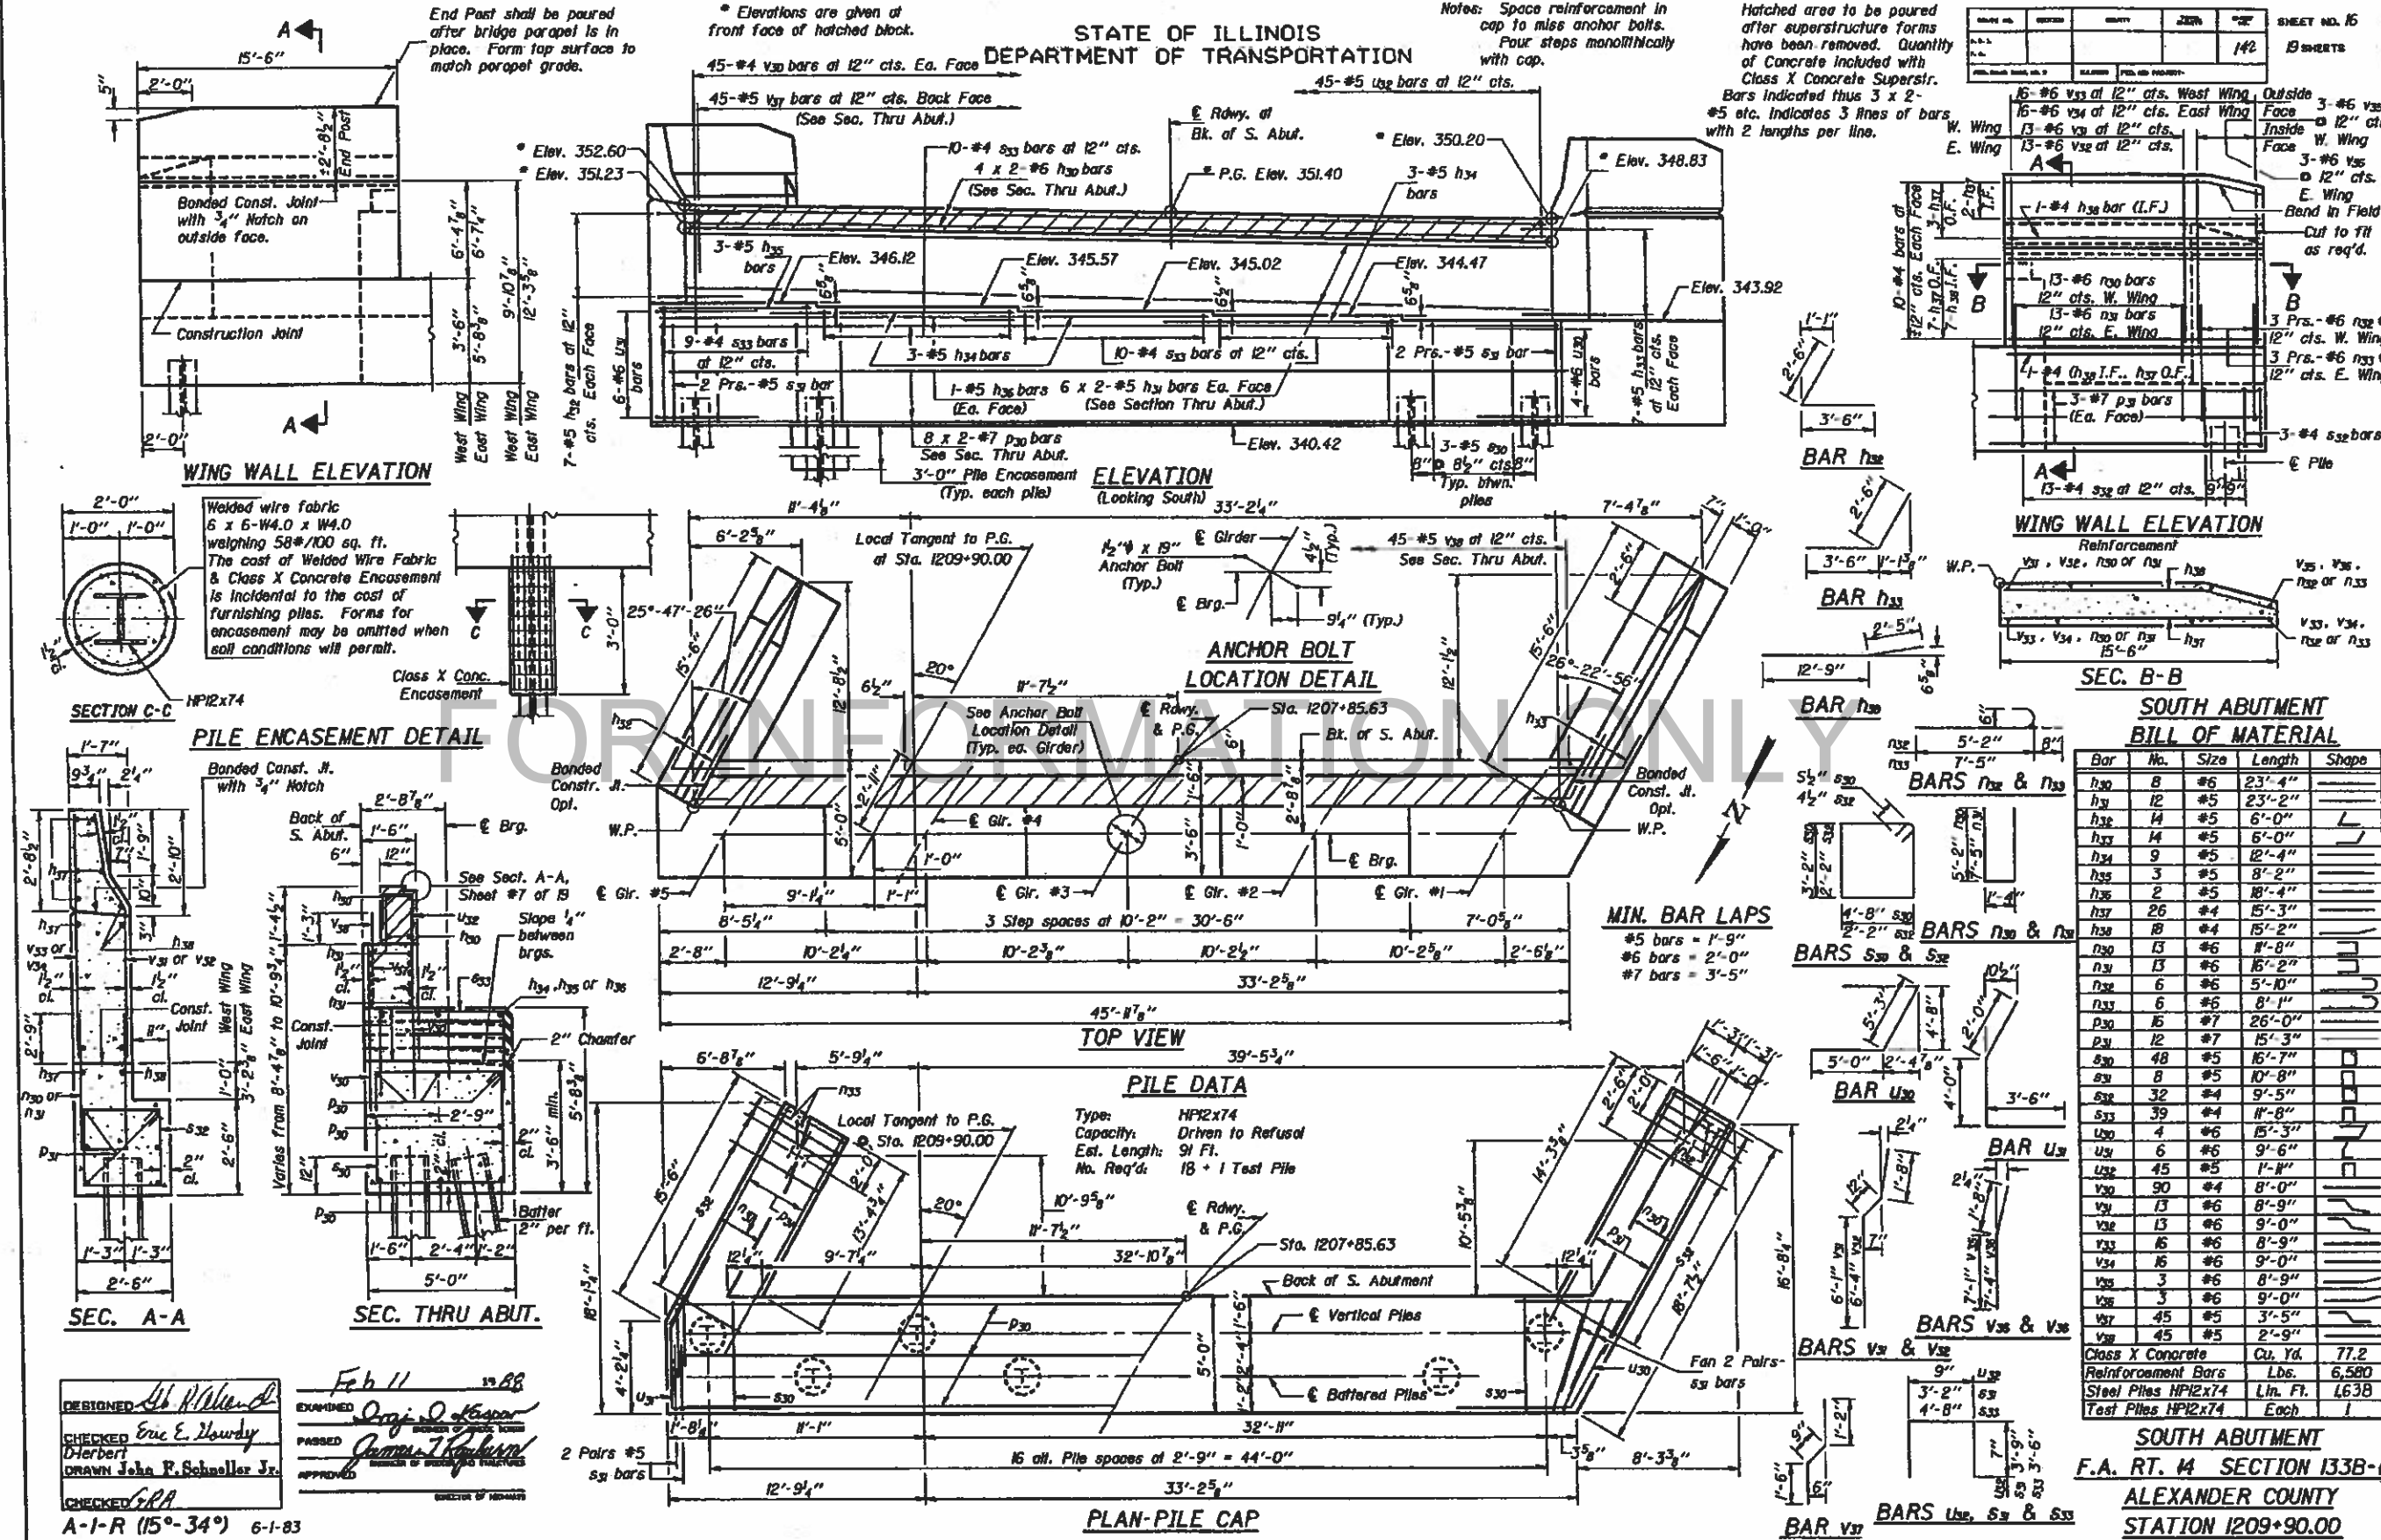

**SOUTH ABUTMENT
BILL OF MATERIAL**

Bar	No.	Size	Length	Shape
U30	8	#6	23'-4"	
U31	12	#5	23'-2"	
U32	14	#5	6'-0"	L
U33	14	#5	6'-0"	L
U34	9	#5	12'-4"	
U35	3	#5	8'-2"	
U36	2	#5	10'-4"	
U37	26	#4	15'-3"	
U38	18	#4	15'-2"	
U39	13	#6	8'-8"	
U40	13	#6	16'-2"	
U41	6	#6	5'-10"	
U42	6	#6	8'-1"	
U43	15	#7	26'-0"	
U44	12	#7	15'-3"	
U45	48	#5	16'-7"	
U46	8	#5	10'-8"	
U47	32	#4	9'-5"	
U48	39	#4	11'-8"	
U49	4	#6	15'-3"	
U50	6	#6	9'-6"	
U51	45	#5	1'-8"	
U52	90	#4	8'-0"	
U53	13	#6	8'-9"	
U54	13	#6	9'-0"	
U55	16	#6	8'-9"	
U56	16	#6	9'-0"	
U57	3	#6	8'-9"	
U58	3	#6	9'-0"	
U59	45	#5	3'-5"	
U60	45	#5	2'-9"	

Class X Concrete Cu. Yd. 77.2
Reinforcement Bars Lbs. 6,580
Steel Piles HP12x74 Lin. Ft. 1,638
Test Piles HP12x74 Each 1

**SOUTH ABUTMENT
F.A. RT. 4 SECTION 1338-1
ALEXANDER COUNTY
STATION 1209+90.00**

DESIGNED: *[Signature]*
CHECKED: Eric E. Hourdy
DRAWN: John P. Schneller Jr.
CHECKED: *[Signature]*

Feb 11 1988
APPROVED: *[Signature]*
DIRECTOR OF HIGHWAYS

A-1-R (15°-34°) 6-1-83



STATE OF ILLINOIS
DEPARTMENT OF TRANSPORTATION

DATE	PROJECT	NO.	SHEET NO.
		149	19 SHEETS

PILE DATA

Type Steel (HP2x63)
Capacity Drive to refusal
Est Length 34 Ft.
No. Req'd. 23

Notes:
Space reinforcement in cap to miss anchor bolts.
Four steps monolithically with cap.
All edges shall have standard 3" chamfers except as noted.
Each set of 3/2, 3/3 & 3/4 bars has 4 bars each. (2 Top & 2 Bottom) See Sec. A-A.

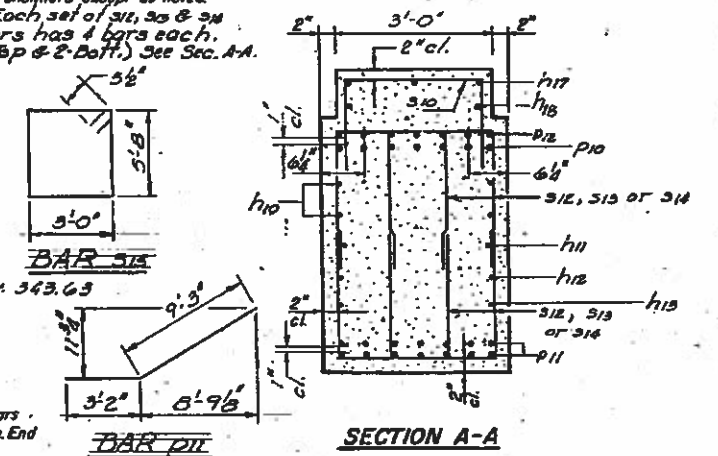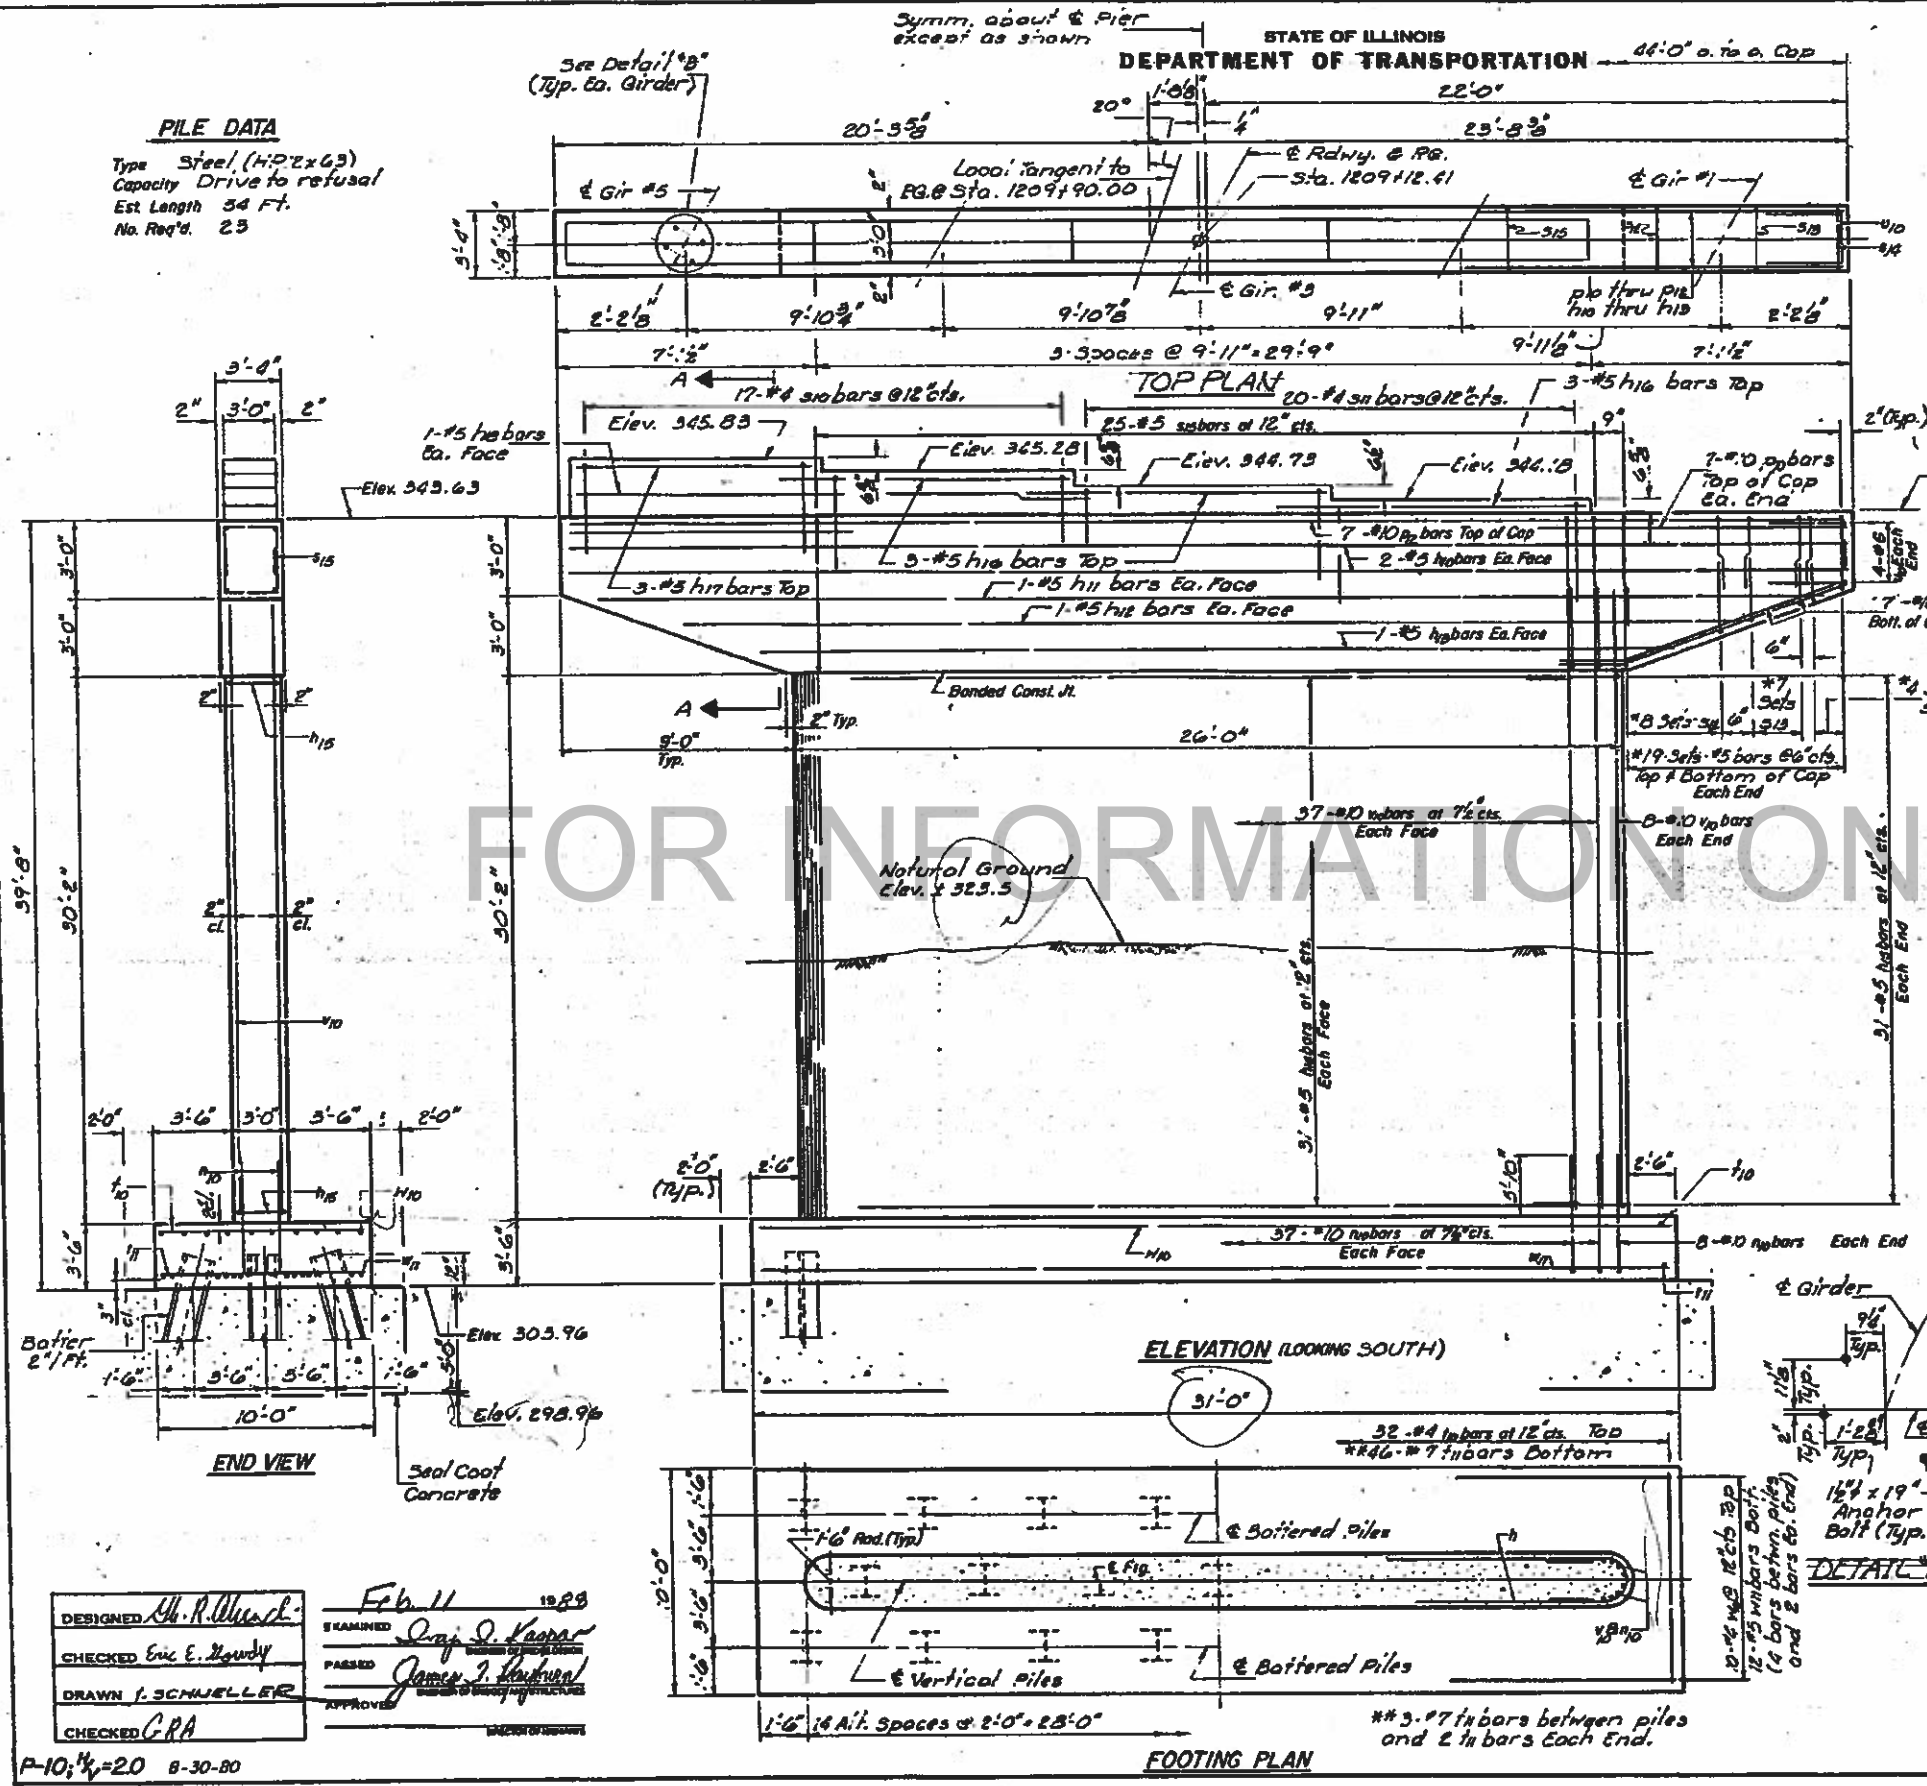

A & B DIMENSIONS

Bar	A	B
h10	2'-8"	3'-6"
h11	2'-8"	2'-6"
h12	2'-2"	4'-0"
h13	2'-2"	3'-4"
h14	2'-2"	2'-8"

**PIER #1
BILL OF MATERIAL**

Bar	No.	Size	Length	Shape
h10	4	#5	23'-9"	—
h11	2	#5	40'-10"	—
h12	2	#5	35'-0"	—
h13	2	#5	29'-2"	—
h14	62	#5	23'-0"	—
h15	62	#5	9'-0"	—
h16	9	#5	11'-2"	—
h17	3	#5	6'-8"	—
h18	2	#5	16'-9"	—
h19	90	#10	10'-6"	—
h20	14	#10	17'-0"	—
h21	28	#10	12'-5"	—
h22	7	#10	43'-9"	—
h23	17	#4	9'-8"	—
h24	20	#4	7'-8"	—
h25	64	#5	10'-2"	—
h26	56	#5	8'-10"	—
h27	32	#5	7'-6"	—
h28	23	#5	13'-3"	—
h29	32	#4	9'-9"	—
h30	46	#7	9'-9"	—
h31	8	#6	7'-10"	—
h32	90	#10	34'-5"	—
h33	10	#4	30'-9"	—
h34	12	#5	30'-9"	—
Class X Concrete				Cu. Yds. 159.8
Reinforcement Bars				Lbs. 23,740
Steel Piles HP2x63				Lin. Ft. 1,242
Seal Coat Concrete				Cu. Yds. 90.8

DESIGNED: M. R. Ulrich
CHECKED: Eric E. Lowndy
DRAWN: J. SCHWELLER
CHECKED: G.R.A.

EXAMINED: Craig J. Kasper
PASSED: James J. Kasper
APPROVED: James J. Kasper

Feb 11 1929

P-10; 1/4" = 20' B-30-80

PIER #1
I.A. RT. 74 SEC. 135B-1
ALEXANDER COUNTY
STA. 1209+90.00

