


FOR REFERENCE ONLY

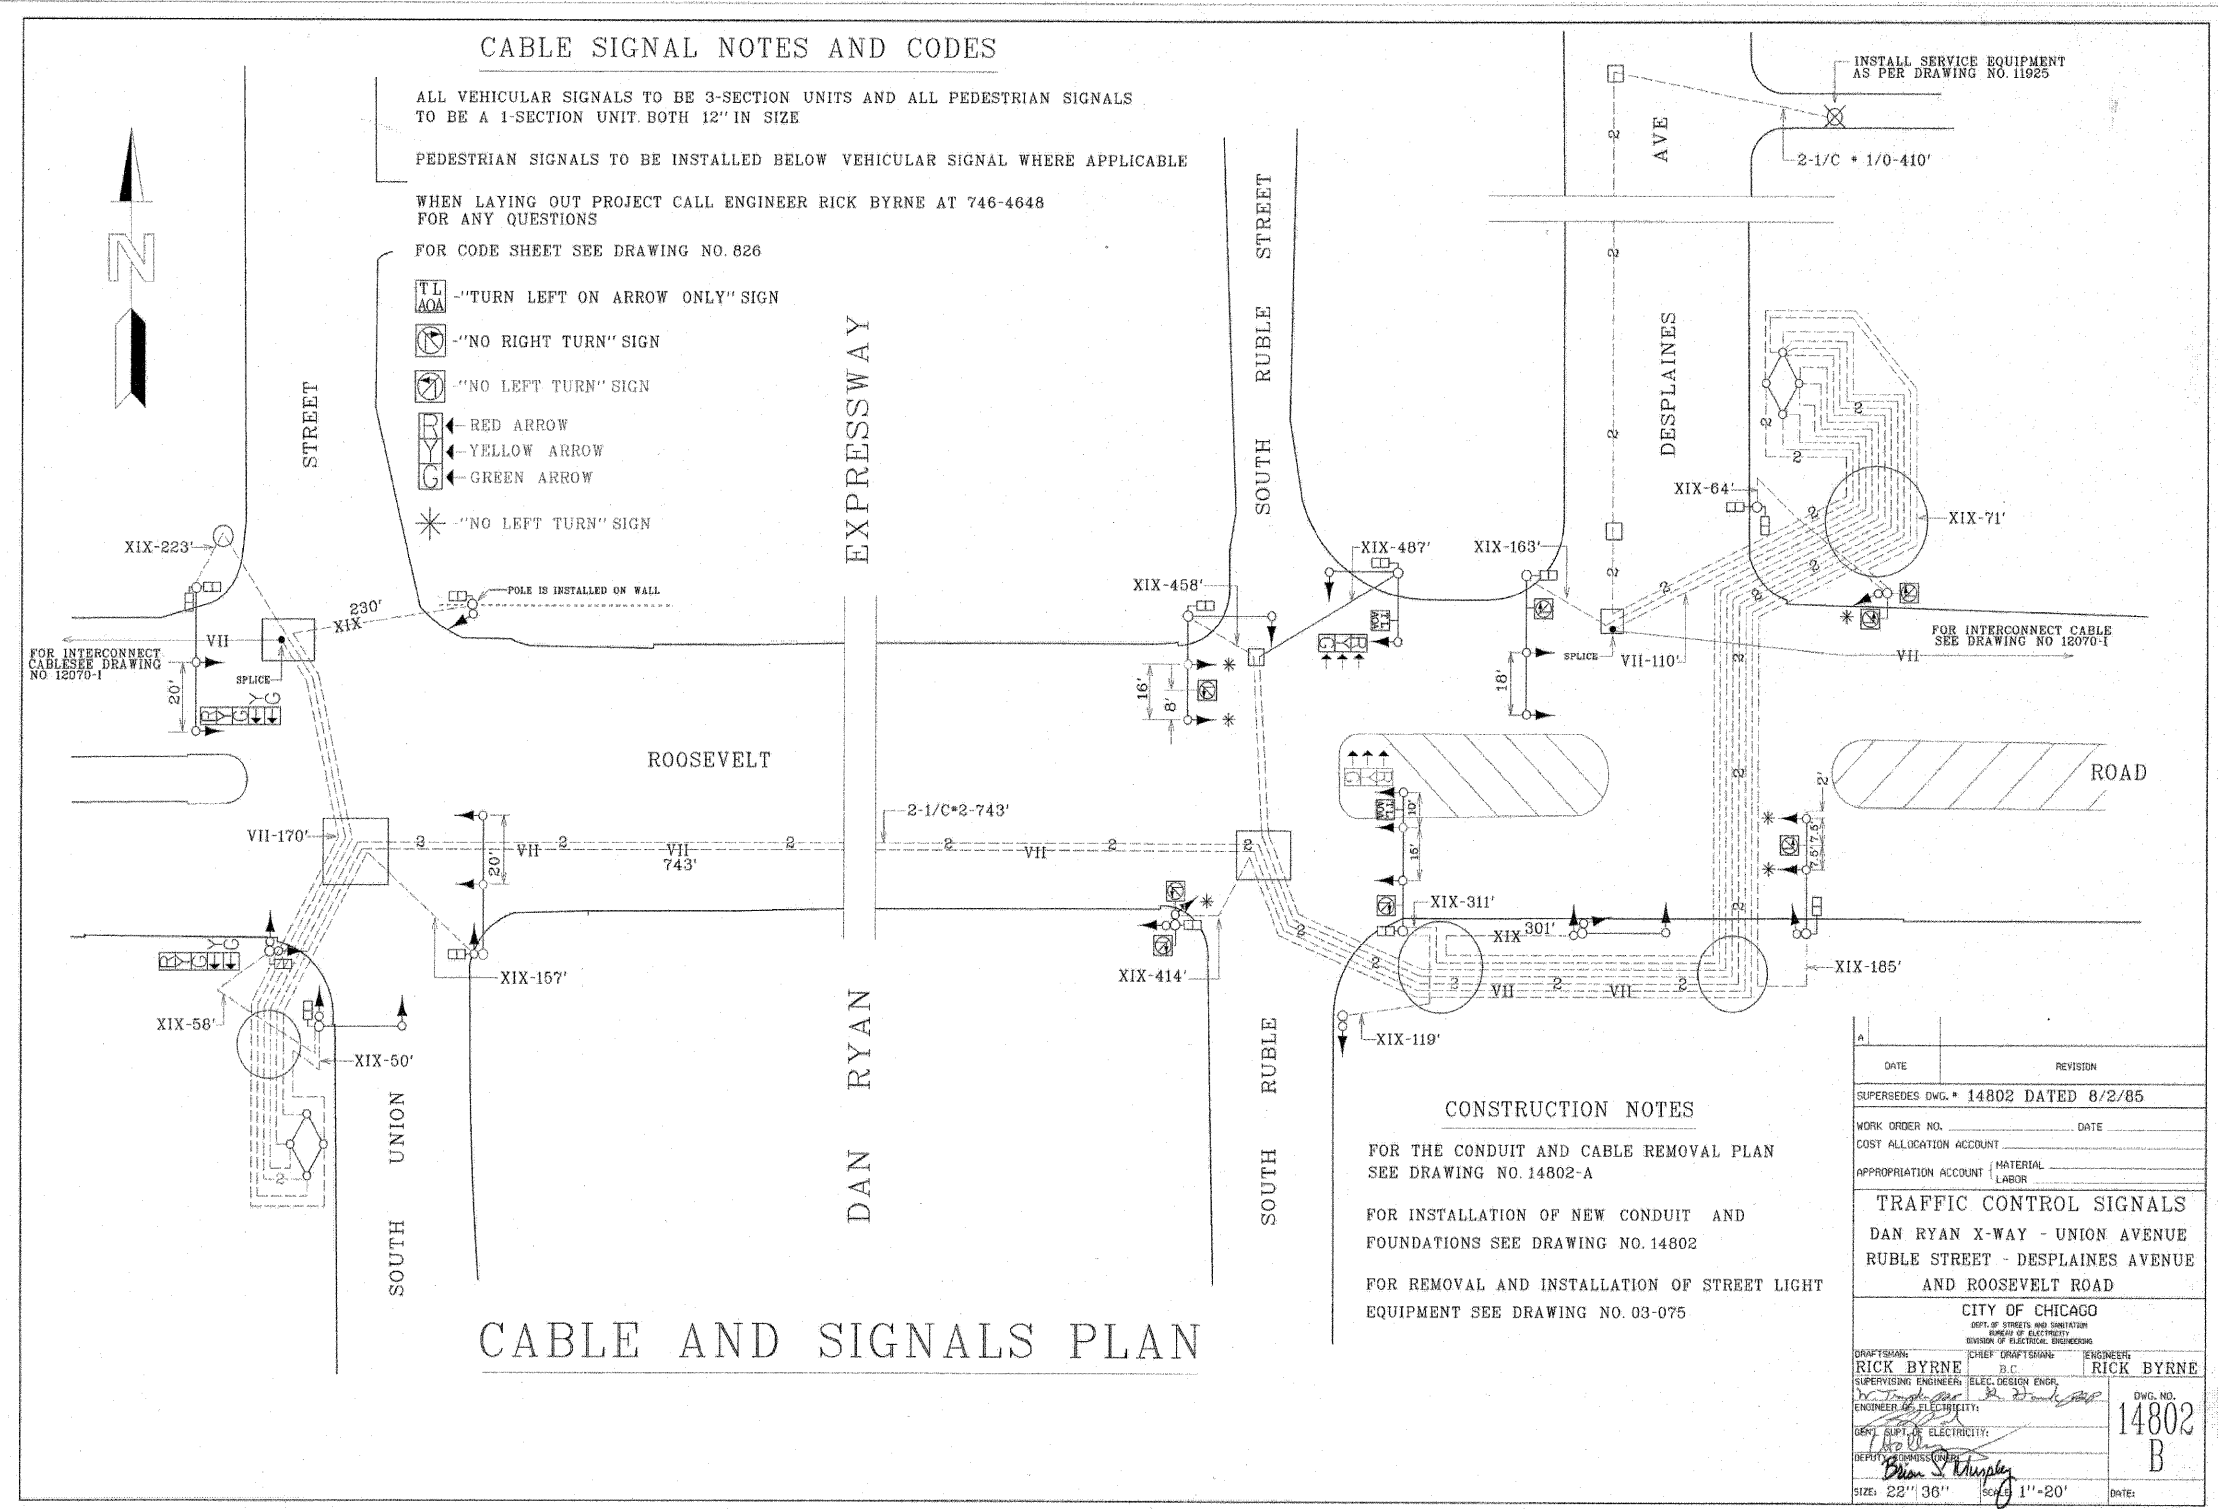

FILE NAME = J:\299\CD\ACAD\ Sheets\14802\Final_TSG.dgn

SINGH 300 W. ADAMS ST.
 CHICAGO, IL 60606
 TEL: (312) 629-0240
 SINGH & ASSOCIATES, INC.
 CONSULTING ENGINEERS FAX: (312) 629-8449

USER NAME = kprajapati	DESIGNED - KP	REVISED -
PLOT SCALE = 5,0000' / 1"	DRAWN - VP	REVISED -
PLOT DATE = 11/30/2011	CHECKED - IY	REVISED -
	DATE - 11/29/2011	REVISED -

STATE OF ILLINOIS
 DEPARTMENT OF TRANSPORTATION

W. ROOSEVELT RD. OVER I-90/94 (DAN RYAN EXPY)
 AS BUILT TRAFFIC SIGNAL CABLE PLAN
 (FOR REFERENCE ONLY)

SCALE: N.T.S. SHEET NO. OF SHEETS STA. TO STA.

F.A.I. RTE. 90/94	SECTION 2011-070-1	COUNTY COOK	TOTAL SHEETS 27	SHEET NO. 6F
ILLINOIS FED. AID PROJECT			CONTRACT NO. 60P89	