SUMMARY OF QUANTITIES

	SP. PROV.	ITEM #	PAY ITEMS	UNIT	ITEP FUNDS - CONSTRUCTION CODE 0028 (80% FEDERAL / 20% LOCAL)	ITEP FUNDS LIGHTING - CONSTRUCTION CODE 0028 (50% FEDERAL / 50% LOCAL)
ŀ		20100110	TREE REMOVAL (6 TO 15 UNITS DIAMETER)	UNIT	9	0
ľ		20200100	EARTH EXCAVATION	CU YD	4010	0
ľ		20400800	FURNISHED EXCAVATION	CU YD	2725	0
		21101615	TOPSOIL FURNISH AND PLACE, 4"	SQ YD	21257	0
ľ		25000110	SEEDING, CLASS 1A	ACRE	3.23	0
		25000312	SEEDING, CLASS 4A	ACRE	1.38	mmmmm
	}	25000322	SEEDING, CLASS 5A	ACRE	1.38	0
	9	25000400	NITROGEN FERTILIZER NUTRIENT	POUND	393	
Ī		25000500	PHOSPHORUS FERTILZER NUTRIENT	POUND	393	0
		25000600	POTASSIUM FERTILIZER NUTRIENT	POUND	393	0
		25100115	MULCH, METHOD 2	ACRE	4.37	0
ľ		25100630	EROSION CONTROL BLANKET	SQ YD	19060	0
ľ		25100635	HEAVY DUTY EROSION CONTROL BLANKET	SQ YD	2196	0
ľ		28000400	PERIMETER EROSION BARRIER	FOOT	6394	0
ľ		28000500	INLET AND PIPE PROTECTION	EACH	2	0
ľ		28100101	STONE RIPRAP, CLASS A1	SQ YD	1204	0
ľ		28200200	FILTER FABRIC	SQ YD	2810	0
		35101400	AGGREGATE BASE COURSE, TYPE B	TON	2469	0
ľ		40600275	BITUMINOUS MATERIALS (PRIME COAT)	POUND	9046	0
l		40600290	BITUMINOUS MATERIALS (TACK COAT)	POUND	67	0
ľ		40604050	HOT-MIX ASPHALT SURFACE COURSE, MIX "C", IL 9.5 N50	TON	666	0
ŀ		42000101	PORTLAND CEMENT CONCRETE PAVEMENT 6" (JOINTED)	SQ YD	490	0
		42300300	PORTLAND CEMENT CONCRETE DRIVEWAY PAVEMENT, 7 INCH	SQ YD	244	0
ŀ		42400100	PORTLAND CEMENT CONCRETE SIDEWALK 4 INCH	SQ FOOT	3615	0
ŀ		42400800	DETECTABLE WARNINGS	SQ FOOT	92	0
ŀ		44000200	DRIVEWAY PAVEMENT REMOVAL	SQ YD	230	0
l		44000500	COMBINATION CURB AND GUTTER REMOVAL	FOOT	398	0
ľ		44000600	SIDEWALK REMOVAL	SQ FOOT	2494	0
r		44200050	WELDED WIRE REINFORCEMENT	SQ YD	663	0
ľ		44201684	CLASS D PATCHES, TYPE IV, 3 INCH	SQ YD	148	0
ľ		50200100	STRUCTURE EXCAVATION	CU YD	36.2	0
ľ		50300225	CONCRETE STRUCTURES	CU YD	47	0
ľ		50500505	STUD SHEAR CONNECTORS	EACH	227	0
ľ		50800105	REINFORCEMENT BARS	POUND	5710	0
ľ		51500100	NAME PLATES	EACH	3	0
ľ	*	52200015	PERMANENT SHEET PILING	SQ FOOT	12032	0

					,	, , , , , , , , , , , , , , , , , , ,
ŀ		52200105	FURNISHING SOLDER PILES (W SECTION)	FOOT	792	0
		52200200	DRILLING AND SETTING SOLDER PILES (IN SOIL)	CU FOOT	3895	0
		52200250	UNTREATED TIMBER LAGGING	SQ FOOT	917	0
	*	52200800	SEGMENTAL CONCRETE BLOCK WALL	SQ FT	355	0
		59100100	GEOCOMPOSITE WALL DRAIN	SQ YD	50	0
		60146304	PIPE UNDERDRAINS FOR STRUCTURES 4"	FOOT	129	0
		60108106	PIPE UNDERDRAINS, TYPE 1, 6"	FOOT	624	0
		60108206	PIPE UNDERDRAINS, TYPE 2, 6"	FOOT	406	0
		60604400	COMBINATION CONCRETE CURB AND GUTTER, TYPE B-6.18	FOOT	470	0
Δ	*	66900200	NON-SPECIAL WASTE DISPOSAL	CU YD	951	0
Δ	*	66900530	SOIL DISPOSAL ANALYSIS	EACH	6	0
Δ	*	66901001	REGULATED SUBSTANCES PRE-CONSTRUCTION PLAN	L SUM	1	0
Δ	*	66901003	REGULATED SUBSTANCES FINAL CONSTRUCTION REPORT	L SUM	1	0
	*	66901005	ENGINEERED BARRIER	SQ YD	247	0
Δ	*	66901006	REGULATED SUBSTANCES MONITORING	CAL DAY	10	0
		67100100	MOBILIZATION	L SUM	1	0
Δ		72000100	SIGN PANEL - TYPE 1	SQ FOOT	11.5	0
Δ		72900100	METAL POST - TYPE A	FOOT	30	0
Δ		78000100	THERMOPLASTIC PAVEMENT MARKING - LETTERS AND SYMBOLS	SQ FOOT	19	0
Δ		78000400	THERMOPLASTIC PAVEMENT MARKING - LINE 6"	FOOT	254	0
Δ		78000600	THERMOPLASTIC PAVEMENT MARKING - LINE 12"	FOOT	311	0
Δ		78000650	THERMOPLASTIC PAVEMENT MARKING - LINE 24"	FOOT	10	0
Δ		80400100	ELECTRICAL SERVICE INSTALLATION	EACH	0	2
Δ		81028730	UNDERGROUND CONDUIT, COILABLE NONMETALLIC CONDUIT, 1 1/4" DIA.	FOOT	0	2786
Δ		81028750	UNDERGROUND CONDUIT, COILABLE NONMETALLIC CONDUIT, 2" DIA.	FOOT	0	250
Δ		81028760	UNDERGROUND CONDUIT, COILABLE NONMETALLIC CONDUIT, 2 1/2" DIA.	FOOT	0	200
Δ		81100100	CONDUIT ATTACHED TO STRUCTURE, 1/2" DIA., GALVANIZED STEEL	FOOT	0	356
Δ		81400100	HANDHOLE	EACH	0	35
Δ		81702145	ELECTRIC CABLE IN CONDUIT, 600V (XLP-TYPE USE) 1/C NO.3	FOOT	0	250
Δ		81702420	ELECTRIC CABLE IN CONDUIT, 600V (XLP-TYPE USE) 3-1/C NO.8	FOOT	0	12698
	Δ SPEC	IALTY ITEN	MS			

UNIT

PAY ITEMS

ITEM#

SP. PROV.

FEHR GRALIAM

ENGINEERING & ENVIRONMENTAL

ILLINOIS DESIGN FIRM NO. 184-003525

ILLINOIS IOWA WISCONSIN OWNER/DEVELOPER:
CITY OF DIXON
121 WEST 2ND STREET
DIXON, IL 61016

PROJECT AND LOCATION:

SHARED USE PATH EXTENSION
SEC 17-00178-00-BT
PROJECT NO. MXY3(094)
JOB C-92-024-19

DRAWN BY: MS
APPROVED BY: JS
DATE: 10/19/22
SCALE: AS NOTED

	REVISIONS				
REV. NO.	DESCRIPTION	DATE			
1	ADDENDUM 1	01/09/23			

DRAWING:
SUMMARY OF QUANTITIES

SET TYPE: FOR BID SET
G\(C30\)17\17-0678\Pidra\\17-067A - PLANS 2.dng, SUMMARY(1)

ITEP FUNDS LIGHTING - CONSTRUCTION CODE 0028 (50% FEDERAL / 50% LOCAL)

ITEP FUNDS - CONSTRUCTION CODE 0028

(80% FEDERAL / 20% LOCAL)

JOB NUMBER:

17-067B

SHEET NUMBER:

C5.0

SUMMARY OF QUANTITIES

SP. PROV.	ITEM #	PAY ITEMS	UNIT	ITEP FUNDS - CONSTRUCTION CODE 0028 (80% FEDERAL / 20% LOCAL)	ITEP FUNDS LIGHTING - CONSTRUCTION CODE 0028 (50% FEDERAL / 50% LOCAL)
	81702450	ELECTRIC CABLE IN CONDUIT, 600V (XLP-TYPE USE) 3-1/C NO.10	FOOT	0	1068
	87100105	FIBER OPTIC CABLE IN CONDUIT, NO. 62.5/125, 4F	FOOT	0	3856
	A2000090	TREE, ACER X FREEMANII ARMSTRONG (ARMSTRONG FREEMAN MAPLE), 3" CALIPER, BALLED & BURLAPPED	EACH	6	0
	A2007122	TREE, QUERCUS RUBRA (RED OAK), 3" CALIPER, BALLED & BURLAPPED	EACH	1	0
	B2006266	TREE, SYRINGA RETICULATA (JAPANESE TREE LILAC), 6' HEIGHT, CLUMP FORM, BALLED AND BURLAPPED	EACH	6	0
	C2000436	SHRUB, ARONIA ARBUTIFOLIA BRILLIANTISSIMA (BRILLANT RED CHOKEBERRY), 3' HEIGHT, BALLED AND BURLAPPED	EACH	24	0
	C2001636	SHRUB, CORNUS SERICEA (REDOSIER DOGWOOD), 3' HEIGHT, BALLED AND BURLAPPED	EACH	62	0
	C2005818	SHRUB, RHUS AROMATICA GRO-LOW (GRO-LOW FRAGRANT SUMAC), 18" WIDTH, BALLED AND BURLAPPED	EACH	46	0
	C2011736	SHRUB, VIBURNUM DENTATUM (ARROWWOOD VIBURNUM), 3' HEIGHT, BALLED AND BURLAPPED	EACH	18	0
	C2012748	SHRUB, VIBURNUM PRUNIFOLIUM (BLACKHAW VIBURNUM), 4' HEIGHT, BALLED AND BURLAPPED	EACH	8	0
	D2001460	EVERGREEN, JUNIPERUS SCOPULORUM WICHITA BLUE (WICHITA BLUE JUNIPER), 5' HEIGHT, BALLED AND BURLAPPED	EACH	8	0
	D2001772	EVERGREEN, PICEA ABIES (NORWAY SPRUCE), 6' HEIGHT, BALLED AND BURLAPPED	EACH	9	0
	D2002984	EVERGREEN, PINUS STROBUS (EASTERN WHITE PINE), 7' HEIGHT, BALLED AND BURLAPPED	EACH	6	0
	D2C00724	EVERGREEN, JUNIPERUS CHINENSIS VAR. SARGENTII VIVIDIS (GREEN SARGENT JUNIPER), 2' WIDTH, CONTAINER	EACH	50	0
	D2C00918	EVERGREEN, JUNIPERUS HORIZONTALIS HUGHES (HUGHES CREEPING JUNIPER), 18" WIDTH, CONTAINER	EACH	28	0
	C2000524	SHRUB, ARONIA MELANOCARPA IROQUOIS BEAUTY (IROQUOIS BEAUTY BLACK CHOKEBERRY), 2' HEIGHT, CONTAINER	EACH	32	0
	C2002324	SHRUB, DIERVILLA LONICERA (BUSH HONEYSUCKLE), 2' HEIGHT, BALLED AND BURLAPPED	EACH	92	0
	C2C041G5	SHRUB, ITEA VIRGINICA LITTLE HENRY (LITLE HENRY VIRGINIA SWEETSPIRE), CONTAINER GROWN, 5-GALLON	EACH	20	0
	C2C09784	SHRUB, SPIREA BETULIFOLIA TOR (TOR BIRCHLEAF SPIREA), 2' HEIGHT, CONTAINER	EACH	27	0
	C2C15761	SHRUB, SPIREA JAPONICA NEON FLASH (NEON FLASH JAPANESE SPIREA), 18" HEIGHT, 5-GALLON CONTAINER	EACH	53	0
	K0012990	PERENNIAL PLANTS, ORNAMENTAL TYPE, GALLON POT	UNIT	0.32	0
*	K1005481	SHREDDED BARK MULCH 3"	SQ YD	2835	0
*	X0100003	CLEARING AND GRUBBING	SQ YD	8294	0
*	X0322920	COMMUNICATIONS CABINET AND EQUIPMENT	EACH	0	1
*	X0323455	ADJUST MONITORING WELLS	EACH	1	0
*	X0326806	WASHOUT BASIN	L SUM	1	0
*	X0327997	TRASH RECEPTACLES	EACH	2	0
*	X1400088	POWER PEDESTALS	EACH	0	2
*	X1400210	LIGHT POLE, SPECIAL, 12'	EACH	0	35
*	X1400238	LUMINAIRE, LED, SPECIAL	EACH	0	35
*	X2503110	MOWING (SPECIAL)	ACRE	42.8	
*	X5012502	CONCRETE REMOVAL (SPECIAL)	CUYD	125	0
*	X5091725	BICYCLE RAILING, SPECIAL	FOOT	470	0
*	X5800110	MEMBRANE WATERPROOFING (SPECIAL)	SQ FOOT	7523	0
*	X7010216	TRAFFIC CONTROL AND PROTECTION (SPECIAL)	L SUM	1	0
*	X8130110	JUNCTION BOX (SPECIAL)	EACH	0	10
*	X8250500	LIGHTING UNIT COMPLETE, SPECIAL	EACH	0	42
*	X8360120	LIGHT POLE FOUNDATION, SPECIAL	EACH	0	35
*	Z0003850	BENCHES	EACH	4	0
*	Z0077900	WOOD POST AND RAIL FENCE	FOOT	2950	0
*	XX008287	BOARDWALK STRUCTURE	SQ FOOT	4576	0
*	XX008921	EMERGENCY CALL BOXES	EACH	7	0
					TION CODE 0042
*	Z0076600	TRAINEES	HOUR	1000	0
	Z0076604	TRAINEES TRAINING PROGRAM GRADUATE	HOUR	1000	0

FEHR GRALAM

ENGINEERING & ENVIRONMENTAL

ILLINOIS DESIGN FIRM NO. 184-003525

ILLINOIS IOWA WISCONSIN OWNER/DEVELOPER:
CITY OF DIXON
121 WEST 2ND STREET
DIXON, IL 61016

PROJECT AND LOCATION:

SHARED USE PATH EXTENSION
SEC 17-00178-00-BT
PROJECT NO. MXY3(094)
JOB C-92-024-19

DRAWN BY: MS
APPROVED BY: JS
DATE: 10/19/22
SCALE: AS NOTED

$\overline{}$	REVISIONS	
REV. NO.		DATE
1	ADDENDUM 1	01/09/2

DRAWING:
SUMMARY OF QUANTITIES

SET TYPE: FOR BID SET
S(23017/17-0678/Plans\17-067A - PLAIS 2.dng, SUMMARY(2)

JOB NUMBER:

17-067B

SHEET NUMBER:

COLIEDIUE OF OLIMITATIES

	SCHED	ULE OF QUANTITIES					
	20100110 - TREE REM	OVAL (6 TO 15 UNITS DIAMTER) (UNIT)					
	SEGMENT A	9					
	TOTAL:	9					
	20200400 545	THEY CAVATION (CH. VD)					
	SEGMENT A	4010					
	TOTAL:	4010					
		ISHED EXCAVATION (CU YD)					
	SEGMENT A	2725					
	TOTAL:	2725					
	21101615 - TOPSOIL FURNISH AND PLACE, 4" (SQ YD)						
	SEGMENT A	21257					
	TOTAL:	21257					
	~~~~~~~~~~~~~~~~~~~~~~~~~~~~~~~~~~~~~~	~~~~~					
{		EDING, CLASS 1A (ACRE)					
{	SEGMENT A	3.23					
	TOTAL:	3.23					
}	25000312 - SE	EDING, CLASS 4A (ACRE)					
, ζ	SEGMENT A	1.38					
{	TOTAL:	1.38					
	2500000						
}	25000322 - SE SEGMENT A	EDING, CLASS 5A (ACRE)  1.38					
	TOTAL:	1.38					
	25000400 - NITROGEN SEGMENT A	FERTILIZER NUTRIENT (POUND) 393					
	TOTAL:	393					
	25000500 - PHOSPHORUS FERTILZER NUTRIENT (POUND)						
	SEGMENT A	393					
	TOTAL:	393					
	25000600 DOTASSILIA	A CERTILIZED ALLITRICALT (DOLLAID)					
	SEGMENT A	7 FERTILIZER NUTRIENT (POUND) 393					
	TOTAL:	393					
	TOTAL.	393					
		JLCH, METHOD 2 (ACRE)					
	SEGMENT A	4.37					
	TOTAL:	4.37					
	25100630 - EROSIO	N CONTROL BLANKET (SQ YD)					
	SEGMENT A	19060					
	TOTAL:	19060					
		' EROSION CONTROL BLANKET (SQ YD)					
	SEGMENT A STA 79+18 - 82+00						
	RT/LT	2196					
	TOTAL	2100					

28000400 - PERIMET	ER EROSION BARRIER (FOOT)
SEGMENT A	6394
TOTAL:	6394
20000500 151157 14	UD DIDE DOCTECTION (EAGU)
	ND PIPE PROTECTION (EACH)
SEGMENT A	
STA 53+30 LT	1
STA 58+20 LT	1
TOTAL:	2
	RIPRAP, CLASS A1 (SQ YD)
SEGMENT A	1204
TOTAL	1204
TOTAL:	1204
28200200 - F	 
SEGMENT A	2810
JESMENT A	2010
TOTAL:	2810
35101400 AGGREGAT	E BASE COURSE, TYPE B (TON)
SEGMENT A	2469
TOTAL:	2469
40600275 BITUMINO	US MATERIALS (PRIME COAT)
SEGMENT A	9046
TOTAL:	9046
101712.	3010
40600290 BITUMINO	US MATERIALS (TACK COAT)
SEGMENT A	67
SEGIMENT A	<u> </u>
TOTAL:	67
40604050 HOT-MIX ASPHALT	SURFACE COURSE, MIX "C", IL-9.5 N50
SEGMENT A	666
TOTAL:	666
	IT CONCRETE PAVEMENT 6" (JOINTED)
SEGMENT A	(SQ YD) 490
0202	
TOTAL:	490
	 T CONCRETE DRIVEWAY PAVEMENT, 7 CH (SQ YD)
SEGMENT A	
STA 50+40.2 LT	61
STA 51+28 LT	61
STA 52+16.1 LT	61
STA 52+81.8 LT	61
TOT::	
TOTAL:	244

SEGMENT A	
STA 50+05.0 - 53+72.0 LT	1835
STA 53+82.1 LT	16
STA 59+02.8 LT	34
STA 63+82.7 LT	34
STA 68+62.3 LT	34
STA 73+43.8 LT	34
STA 82+73	
STA 87+21.6 LT	100
STA 88+64.6 LT	34
STA 89+20.6 LT STA 91+20.6 LT	100
STA 93+04.5 LT	100
STA 93+33.96	784
STA 94+05.44	376
TOTAL:	3615
42400800 - DETECTABLE V	VARNINGS (SQ FOOT)
SEGMENT A	
STA 53+75	20
STA 93+44	33.5
STA 94+08	38.5
TOTAL:	92
TOTAL	
44000200 - DRIVEWAY PAVEI	MENT REMOVAL (SQ YD)
SEGMENT A	
50+40.2 LT	50
51+28 LT	50
52+16.1 LT	50
52+81.8 LT	80
TOTAL:	230
	ND CLITTED DEMOVAL (FOOT)
SEGMENT A	ND GOTTER REIVIOVAL (FOOT)
STA 50+09.70 - 50+74.70	 65
STA 50+95.46 - 51+60.46	65
STA 51+83.62 - 53+68.1	200
STA 93+27.0 - 93+49.2	46
STA 94+02 RT	22
TOTAL:	398
44000600 - SIDEWALK R	EMOVAL (SQ FOOT)
SEGMENT A	2-
STA 50+03 - 50+22 LT	95
STA 50+62 - 51+11 LT	243
STA 51+50 - 51+95 LT STA 52+37 - 5	254 22±62 LT
STA 52+37 - 5	322
STA 92+56.3 - 93+48.7 LT	1091
STA 94+05.44	405
TOTAL:	2494
44200050 - WELDED WIRE RI	EINFORCEMENT (SQ YD)
SEGMENT A	
50+40.2 LT	61
51+28 LT	61
52+16.1 LT	61
52+81.8 LT	61
STA 67+86 - 68+56	125
STA 71+52 - 72+16 STA 75+22 - 76+23	114 180
31A /3TZZ - /0+Z3	100

44201684 - CLASS D PATCH	HES, TYPE IV, 3" (SQ YD)
SEGMENT A	
STA 50+09.70 - 50+74.70	30
STA 50+95.46 - 51+60.46	30
STA 51+83.62 - 53+68.1	88
TOTAL:	148
52200015 - PERMANENT S	HEET PILING (SQ FOOT)
SEGMENT A	
STA 68+55.8 - 71+52.3 RT/LT	5930
STA 72+16.5 - 75+21.6 RT/LT	6102
TOTA	ıL:
52200800 - SEGMENTAL CONCR	ETE BLOCK WALL (SO FOOT)
SEGMENT A	ETT BEOCK WALL (SQ 1001)
STA 53+14 - 53+85	355
317(33*11 33*03	
TOTAL:	355
1017121	
60108106 - PIPE UNDERDR	AINS. TYPE 1. 6" (FOOT)
SEGMENT A	
STA 68+50 - 71+52.3 RT	312
STA 72+18.5 - 75+20.5 RT	312
TOTAL:	624
60108206 - PIPE UNDERDR	AINS, TYPE 2, 6" (FOOT)
SEGMENT A	
STA 50+09.70 - 50+74.70 LT	65
STA 50+95.46 - 51+60.46 LT	65
STA 51+83.62 -	53+18.5 LT
STA 53+33.4 - 53+72.0 LT	50
STA 93+27.0 - 93+49.2	69
STA 94+02 RT	22
	<u></u>
	·
60604400 - COMBINATION CONC B-6.18 (F	
SEGMENT A	
STA 57+86 - 68+56	140
STA 71+52	+ 72+16
STA 75+22 - 76+23	202
55.22 75.25	
TOTAL:	470
* 66900200 - NON-SPECIAL \	WASTE DISPOSAL (CU YD)
SEGMENT A	951
TOTAL:	951
* 66900530 - SOIL DISPO	SAL ANALYSIS (EACH)
SEGMENT A	6
TOTAL:	6
66901001 - REGULATED SUBSTAN	
(L SUI	<b>VI)</b>
SEGMENT A	<u> -</u>
SEGMENT A	<del>_</del>

SEGMENT A	1
TOTAL:	1
* 66901005 - ENGINEERED	BARRIER (SQ YD)
SEGMENT A	
STA 80+35 - 80+55	47
STA 81+06 - 82+15 RT	75
STA 85+76 - 86+00	125
TOTAL:	247
 * 66901006 - REGULATED SUBSTANG	CES MONITORING (CAL DAY
SEGMENT A	10
TOTAL:	10
67100100 11001170	71001 (t. 01100)
67100100 - MOBILIZA SEGMENT A	
SEGIVILINI A	1
TOTAL:	1
72000100 - SIGN PANE	EL - TYPE 1 (SF)
SEGMENT A STA 53+81.5 LT	4.5
STA 54+46.4 LT	
STA 93+26.0 RT	2.5 4.5
31A 93+20.0 KT	4.5
TOTAL:	11.5
72900100 - METAL POST	- TYPE A (FOOT)
SEGMENT A	
STA 53+81.5 LT	10
STA 54+46.4 LT	10
STA 93+26.0 RT	10
TOTAL:	30
78000100 - THERMOPLASTIC PAVMI	ENT MARKING - LETTER AND
SYMBOLS (SQ	
SEGMENT A	
STA 50+57 RT	9.5
STA 52+55 RT	9.5
TOTAL:	19
78000400 - THERMOPLASTIC PAVEMEN	NT MARKING - LINE 6" (FOOT)
SEGMENT A	
STA 93+39.78 - 94+16.71	254
TOTAL:	254
78000600 - THERMOPLASTIC PAVEMEN	IT MARKING - LINE 12" (FOOT)
SEGMENT A	
STA 93+39.78 - 94+16.71	311
TOTAL:	311
78000650 - THERMOPLASTIC PAVEMEN	IT MARKING - LINE 24" (FOOT)
SEGMENT A	
STA 53+81 LT	5
	F
STA 93+25	5

SEGMENT A	
STA 53+81 LT	5
STA 93+25	5
	TOTAL:
80400100 - ELECTRIC SI	ERVICE INSTALLATION (EACH)
SEGMENT A	
STA 53+81 LT	1
STA 92+44 LT	1
TOTAL:	2
	UIT, COILABLE NONMETALLIC CONDUI DIA. (FOOT)
SEGMENT A	2786
TOTAL:	2786
81028750 - LINDERGROUND CONF	UIT, COILABLE NONMETALLIC CONDUI
	IA. (FOOT)
SEGMENT A	
STA 53+81 LT	125
STA 92+44 LT	125
	 TOTAL:
	TOTAL.
	DUIT, COILABLE NONMETALLIC CONDUI DIA. (FOOT)
SEGMENT A	
STA 92+44 LT	200
TOTAL:	200
	TO STRUCTURE, 1/2" DIA., GALVANIZE
SEGMENT A	EL (FOOT)
STA 76+23 - 79+79	356
TOTAL:	356
81400100 - F	 HANDHOLE (EACH)
SEGMENT A	
STA 50+84.9 LT	1
STA 51+71.8 LT	1
STA 52+48.8 LT	1
STA 53+89.0 LT	1
STA 54+35.7 LT	1
STA 55+55.9 LT	1
STA 56+84.1 LT	1
STA 58+02.5 LT	1
STA 59+21.3 LT STA 60+41.2 LT	1
STA 60+41.2 LT	1 1
STA 61+61.0 LT	1
STA 64+01.0 LT	1
STA 65+20.8 LT	1
STA 66+40.8 LT	1
STA 67+60.8 LT	1
STA 68+80.6 LT	1
STA 70+01.2 LT	1
STA 71+21.1 LT	1
STA 72+41.6 LT	1
	1
STA 73+62.1 LT	1
STA 74+82.1 LT	_
STA 74+82.1 LT STA 76+00.5 LT	1
STA 74+82.1 LT STA 76+00.5 LT STA 80+68.6 LT	1
STA 74+82.1 LT  STA 76+00.5 LT  STA 80+68.6 LT  STA 81+65.00 LT	1 1
STA 74+82.1 LT  STA 76+00.5 LT  STA 80+68.6 LT  STA 81+65.00 LT  STA 82+63.7 LT	1 1 1
STA 74+82.1 LT  STA 76+00.5 LT  STA 80+68.6 LT  STA 81+65.00 LT	1 1
STA 74+82.1 LT  STA 76+00.5 LT  STA 80+68.6 LT  STA 81+65.00 LT  STA 82+63.7 LT  STA 83+64.9 LT	1 1 1 1
STA 74+82.1 LT  STA 76+00.5 LT  STA 80+68.6 LT  STA 81+65.00 LT  STA 82+63.7 LT  STA 83+64.9 LT  STA 84+61.6 LT	1 1 1 1 1
STA 74+82.1 LT  STA 76+00.5 LT  STA 80+68.6 LT  STA 81+65.00 LT  STA 82+63.7 LT  STA 83+64.9 LT  STA 84+61.6 LT  STA 85+68.5 LT	1 1 1 1 1 1
STA 74+82.1 LT  STA 76+00.5 LT  STA 80+68.6 LT  STA 81+65.00 LT  STA 82+63.7 LT  STA 83+64.9 LT  STA 84+61.6 LT  STA 85+68.5 LT  STA 86+70.6 LT	1 1 1 1 1 1 1
STA 74+82.1 LT  STA 76+00.5 LT  STA 80+68.6 LT  STA 81+65.00 LT  STA 82+63.7 LT  STA 83+64.9 LT  STA 84+61.6 LT  STA 85+68.5 LT  STA 86+70.6 LT	1 1 1 1 1 1 1 1 1 1 1 1 1 1 1 1
STA 74+82.1 LT  STA 76+00.5 LT  STA 80+68.6 LT  STA 81+65.00 LT  STA 82+63.7 LT  STA 83+64.9 LT  STA 84+61.6 LT  STA 85+68.5 LT  STA 86+70.6 LT  STA 87+70.6 LT	1 1 1 1 1 1 1 1 1 1 1 1 1 1 1 1 1 1 1

FEHR GRAHAM

2196

ENGINEERING & ENVIRONMENTAL ILLINOIS DESIGN FIRM NO. 184-003525

ILLINOIS IOWA

WISCONSIN

CITY OF DIXON 121 WEST 2ND STREET DIXON, IL 61016

OWNER/DEVELOPER:

PROJECT AND LOCATION: SHARED USE PATH EXTENSION SEC 17-00178-00-BT PROJECT NO. MXY3(094) JOB C-92-024-19

DRAWN BY: MS APPROVED BY: JS DATE: 10/19/22 SCALE: AS NOTED

		REVISIONS	
REV.	NO.	DESCRIPTION	DATE
	1	ADDENDUM 1	01/09/2

SCHEDULE OF QUANTITIES SET TYPE: FOR BID SET C:\C3D\17\17-067B\Plans\17-067A - PLANS 2.dwg, SCH-1

TOTAL:

JOB NUMBER: 17-067B SHEET NUMBER:

35

C7.0

TOTAL:

## SCHEDULE OF QUANTITIES

31702145 - ELECTRIC CABLE IN CONDU	IT, 600V (XLP-TYPE USE) 1/C NO.3 (FOOT
SEGMENT A	
STA 53+81 LT	125
STA 92+44 LT	125
TOTAL	250
TOTAL:	250
	DUIT, 600V (XLP-TYPE USE) 3-1/C NO.8 OOT)
SEGMENT A	12698
TOTAL:	12698
	_  T, COILABLE NONMETALLIC CONDUIT, 2 A. (FOOT)
SEGMENT A	
STA 76+23 - 79+79	1068
TOTAL:	1068
*0740040F FIRED ODTIC CARLE II	CONDUIT NO C2 F /42F 4F /FOOT)
*87100105 - FIBER OPTIC CABLE II SEGMENT A	N CONDUIT, NO. 62.5/125, 4F (FOOT)  3856
TOTAL:	3856
<u>`</u>	FREEMANII, 3" CALIPER, B&B
SEGMENT A	6
TOTAL:	6
A2007422 OUEDOUS BUSS	A (PED CAN) 3" CALIDED DOD
A2007122 - QUERCUS RUBR SEGMENT A	A (RED OAK), 3" CALIPER, B&B
···	
TOTAL:	1
B2006266 - TREE, SYRINGA RETICU	  LATA, 6' HEIGHT, CLUMP FORM, B&B
SEGMENT A	6
TOTAL:	6
. 5	, in the second
C2000436 - SHRUB, ARONIA ARBUTIF	OLIA BRILLIANTISSIMA, 3' HEIGHT, B&B
SEGMENT A	24
TOTAL:	24
0004606 00000 0000	HICCEPICES SUFFICIE DOS
C2001636 - SHRUB, CORN SEGMENT A	IUS SERICEA, 3'HEIGHT, B&B
SEGIVILINT A	UZ
TOTAL:	62
	IATICA GRO-LOW, 18" WIDTH, B&B
SEGMENT A	46
TOTAL:	46
C2011736 - SHRIIR VIRIIRNI	 IM DENTATUM, 3' HEIGHT, B&B
SEGMENT A	18
TOT::	
TOTAL:	18
C2012748 - SHRUB, VIBURNUI	M PRUNIFOLIUM, 4' HEIGHT B&B
SEGMENT A	8
	8
ΤΟΤΔΙ·	i
D2001460 - EVERGREEN, JUNIPERUS S	COPULORUM WICHITA BLUE, 5' HEIGHT 8&B 8
D2001460 - EVERGREEN, JUNIPERUS S E	8&B
D2001460 - EVERGREEN, JUNIPERUS S E SEGMENT A TOTAL:	8 8 8
D2001460 - EVERGREEN, JUNIPERUS S E SEGMENT A TOTAL:	8 <b>8B</b> 8
D2001460 - EVERGREEN, JUNIPERUS S E SEGMENT A TOTAL: D2001772 - EVERGREEN, I	8 8 PICEA ABIES, 6' HEIGHT, B&B

D2002984 - EVERGREEN, PINI SEGMENT A	US STROBUS, 7' HEIGHT, B&B
TOTAL:	6
D2C00724 - EVERGREEN, JUNIPERUS (	I CHINENSIS VAR. SRAGENTII VIRDIS, 2' , CONT.
SEGMENT A	50
TOTAL:	50
D2C00918 - EVERGREEN, JUNIPERUS CO	HORIZONTALIS HUGHES, 18"' WIDTH, NT.
SEGMENT A	28
TOTAL:	28
C2000524 - SHRUB, ARONIA MELANO	CARPA IROQUOIS BEAUTY, 2' HEIGHT
	(EACH) 32
SEGIVIENT A	32
TOTAL:	32
C2002324 - SHRUB, DIERVILLA LO	 DNICERA, 2' HEIGHT, B&B (EACH)
SEGMENT A	92
TOTAL:	92
C2C044.0F CURLID 1774 1/17 5/1/10	LITTLE LIENDY CONTAINS COOK
	LITTLE HENRY, CONTAINER GROWN, N (EACH)
SEGMENT A	20
TOTAL:	20
C2C09784 - SHRUB. SPIREA BETULIF	OLIA TOR, 2' HEIGHT, CONT. (EACH)
SEGMENT A	27
TOTAL:	27
TOTAL.	21
C2C15761 - SHRUB, SPIREA JAPONICA CONTAIN	NEON FLASH, 18" HEIGHT, 5-GALLON ER (EACH)
SEGMENT A	53
TOTAL:	53
	, ,
SEGMENT A	O.32
SEGINEIN 71	0.02
TOTAL:	0.32
*K1005481 - SHREDDED	 BARK MULCH 3" (SQ YD)
SEGMENT A	2004
FOR PLANTINGS UNDER BOARDWALK	2001 834
	TAL.
TO	ΓAL:
	AND GRUBBING (SQ YD)
SEGMENT A TA 57+30 - 71+62 RT/LT - 15' RT/LT OF	2431
CL	
TA 80+10 - 85+45 LT - 15' LT OF CL, RT-	2724
60' OF CL STA 100+25 - 104+10 LT - 15 LT OF CL,	2524
RT - 60' OF CL	2324
TOTAL:	8294
* X0322920 - COMMUNICATIONS	CABINET AND EQUIPMENT (EACH)
SEGMENT A	1
TOTAL:	1
IOIAL.	1
	MONITORING WELLS
SEGMENT A	_
STA 82+90 LT	1

* X0326806 -WASH	1
SEGMENT A	1
TOTAL:	1
* X0327997 -TRASH F	RECEPTACLES (EACH)
SEGMENT A STA 87+20 LT	1
STA 93+05 LT	1
211120 22 21	<del>_</del>
TOTAL:	2
**********	
* <b>X1400088 - POWE</b> F	R PEDESTALS (EACH)
STA 53+51 LT	1
STA 92+44.7 LT	1
TOTAL:	2
* V4.400024.0 LIGHT DO	UE CDECIAL 421/EACH)
* X14000210 - LIGHT PO SEGMENT A	LE, SPECIAL, 12" (EACH)
STA 50+84.9 LT	1
STA 50+84.9 LT	1
STA 52+	
STA 53+89.0 LT	1
STA 54+35.7 LT	1
STA 55+55.9 LT	1
STA 56+84.1 LT	1
STA 58+02.5 LT	1
STA 59+21.3 LT	1
STA 60+41.2 LT	1
STA 61+61.0 LT	1
STA 62+81.0 LT	1
STA 64+01.0 LT	1
STA 65+20.8 LT	1
STA 66+40.8 LT	1
STA 67+60.8 LT	1
STA 68+80.6 LT	1
STA 70+01.2 LT	1
STA 71+21.1 LT	1
STA 72+41.6 LT STA 73+62.1 LT	1 1
STA 74+82.1 LT	1
STA 76+00 LT	1
STA 80+68.6 LT	1
STA 81+65 LT	1
STA 82+63.7 LT	1
STA 83+64.9 LT	1
STA 84+61.6 LT	1
STA 85+68.5 LT	1
STA 86+70.6 LT	1
STA 87+70.6 LT	1
STA 88+70.6 LT	1
STA 89+70.6 LT	1
STA 90+70.7 LT	1
STA 91+70.6 LT	1
TOTAL	25
TOTAL:	35
* X1400238 - LUMINAIR	RE, LED, SPECIAL (EACH)
SEGMENT A	35
TOTAL:	35
* X2503110 -MOWIN	NG (SPECIAL) (ACRE)
STA 75+65 - 82+00 RT / LT	42.8

* X5012502 - CONCRETE REMO	
SEGMENT A	125
TOTAL:	125
TOTAL.	123
*X5091725 - BICYCLE RAILII	NG, SPECIAL (FOOT)
SEGMENT A	
STA 67+56 - 68+56 LT/RT	140
STA 71+52 - 72+16 LT/RT	128
STA 75+22 - 76+23 LT/RT	202
TOTAL:	470
*X5800110 - MEMBRANE WATERPI	
SEGMENT A	7523
TOTAL:	7523
(7010216 - TRAFFIC CONTROL AND P	PROTECTION (SPECIAL) (L SLIM
SEGMENT A	1
TOTAL:	1
* X8130110 - JUNCTION BO	OX SPECIAL (EACH)
SEGMENT A	
STA 53+82.1 LT	1
STA 59+02.8 LT	1
STA 63+82.7 LT	1
STA 68+62.3 LT	1
STA 73+43.8 LT	1
STA 75+21.6 LT	1
STA 79+79.5 LT	1
STA 80+50 LT	1
STA 82+73.9 LT	1
STA 88+64.6 LT	1
TOTAL	10
TOTAL:	10
* X8250500 - LIGHTING UNIT	COMPLETE, SPECIAL
SEGMENT A	42
TOTAL:	42
* X8360120 LIGHT POLE FOUND	•
SEGMENT A	35
TOTAL:	35
*Z0003850 - BENCI	HES (FACH)
SEGMENT A	ilo (lacil)
STA 87+20 LT	1
STA 89+20 LT	1
STA 91+20 LT	1
STA 93+05 LT	1
TOTAL	4
TOTAL:	4
*Z0077900 - WOOD POST AN	D RAIL FENCE (FOOT)
SEGMENT A	
STA 62+75 - 67+83.6 RT/LT	1030
STA 68+55.8 - 71+52.3 RT/LT	594
STA 72+16.5 - 75+21.6 RT/LT	612
STA 76+23.3 - 79+79.5 RT/LT	714
TOTAL:	2950
IVIAL.	7710

* XX008287 - BOARDWALK STRUCTURE (SQ FOOT)	
SEGMENT A	4576
TOTAL:	4576
* XX008921 - EMERGE	ENCY CALL BOXES (EACH)
SEGMENT A	
STA 53+82.1 LT	1
STA 59+02.8 LT	1
STA 63	3+82.7 LT
STA 68+62.3 LT	1
STA 73+43.8 LT	1
STA 82+73.9 LT	1
STA 88	3+64.6 LT
TOTAL:	7

FEHR GRAHAM

ENGINEERING & ENVIRONMENTAL ILLINOIS DESIGN FIRM NO. 184-003525

ILLINOIS IOWA

WISCONSIN

OWNER/DEVELOPER:

CITY OF DIXON
121 WEST 2ND STREET
DIXON, IL 61016

SHARED USE PATH EXTENSION
SEC 17-00178-00-BT
PROJECT NO. MXY3(094)
JOB C-92-024-19

DRAWN BY: MS
APPROVED BY: JS
DATE: 10/19/22
SCALE: AS NOTED

TOTAL:

	REVISIONS	-
REV. NO.	DESCRIPTION	DATE
1	ADDENDUM 1	01/09/2

2950

DRAWING:
SCHEDULE OF QUANTITIES


SET TYPE: FOR BID SET
G:\C3D\17\17-067B\Plans\17-067A - PLANS 2.dwg, SCH-2

JOB NUMBER:

17-067B

SHEET NUMBER:

C8.0

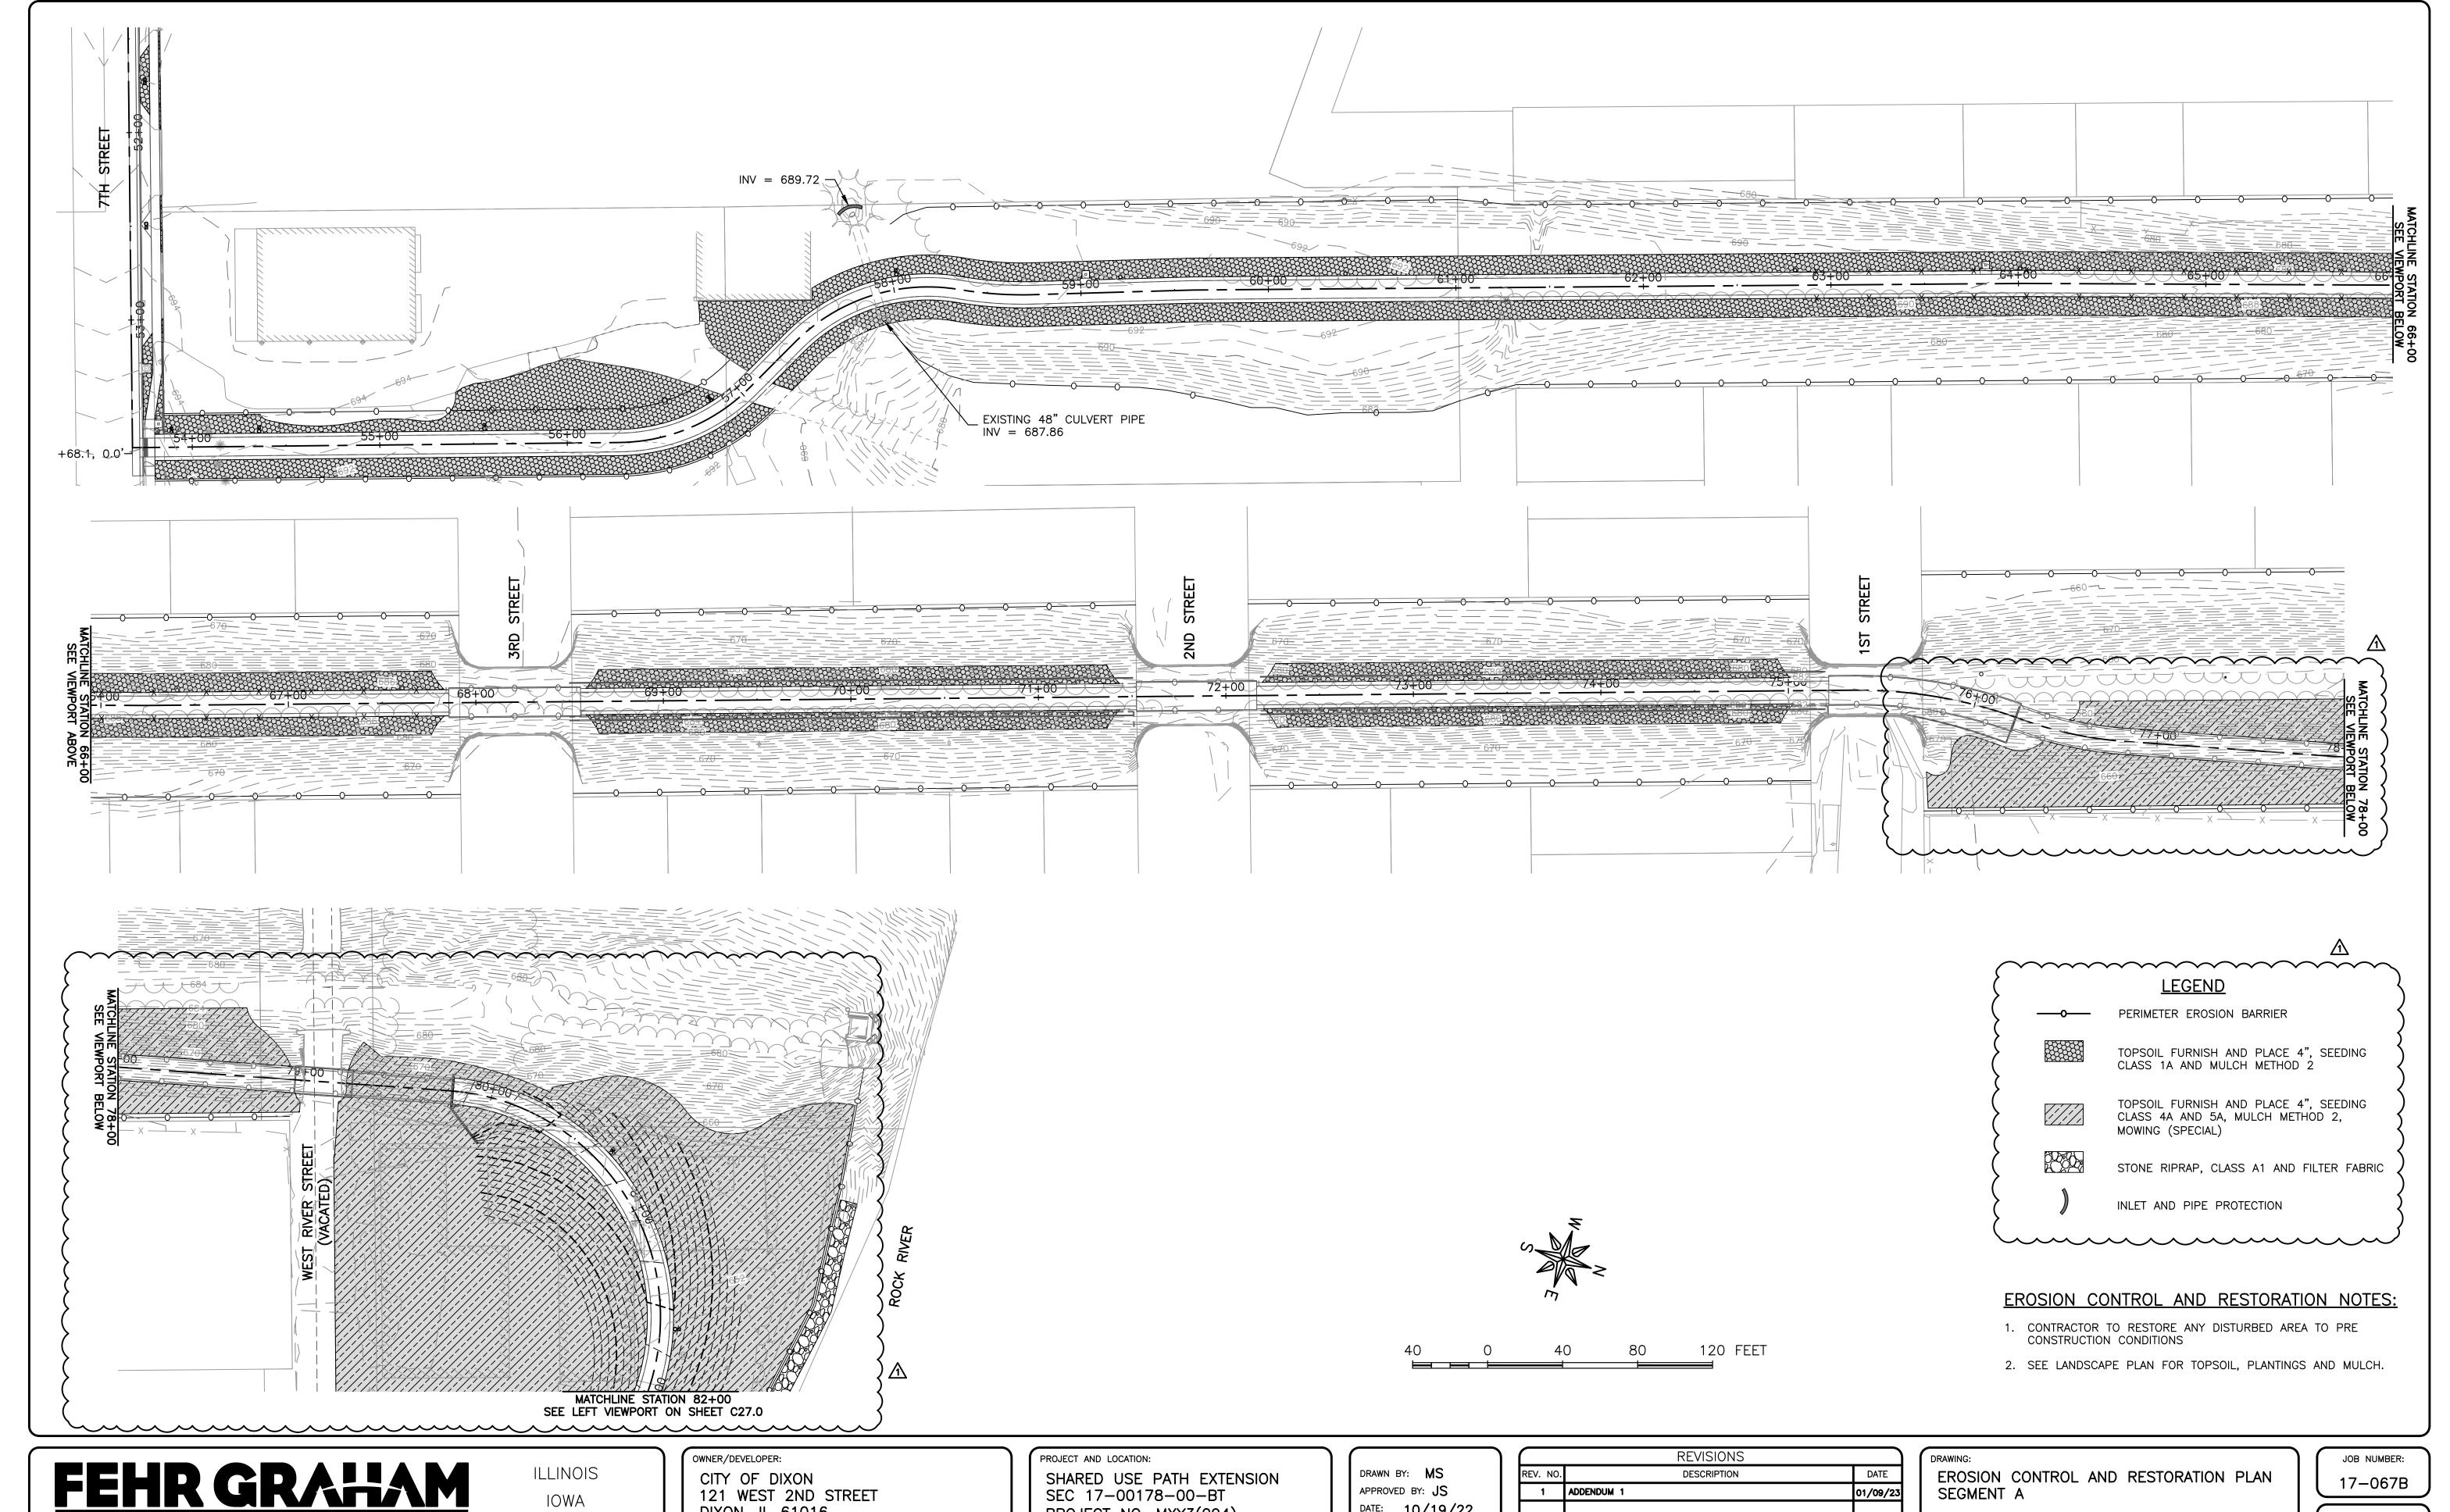

ENGINEERING & ENVIRONMENTAL ILLINOIS DESIGN FIRM NO. 184-003525

IOWA

WISCONSIN

121 WEST 2ND STREET DIXON, IL 61016


SEC 17-00178-00-BT PROJECT NO. MXY3(094) JOB C-92-024-19

DATE: 10/19/22 SCALE: AS NOTED

	REVISIONS	
REV. NO.	DESCRIPTION	DATE
1	ADDENDUM 1	01/09/23

SET TYPE: FOR BID SET (S:\C3D\17\17-067B\Plans\17-067A - PLANS.dwg, EROS 1

SHEET NUMBER: C26.0

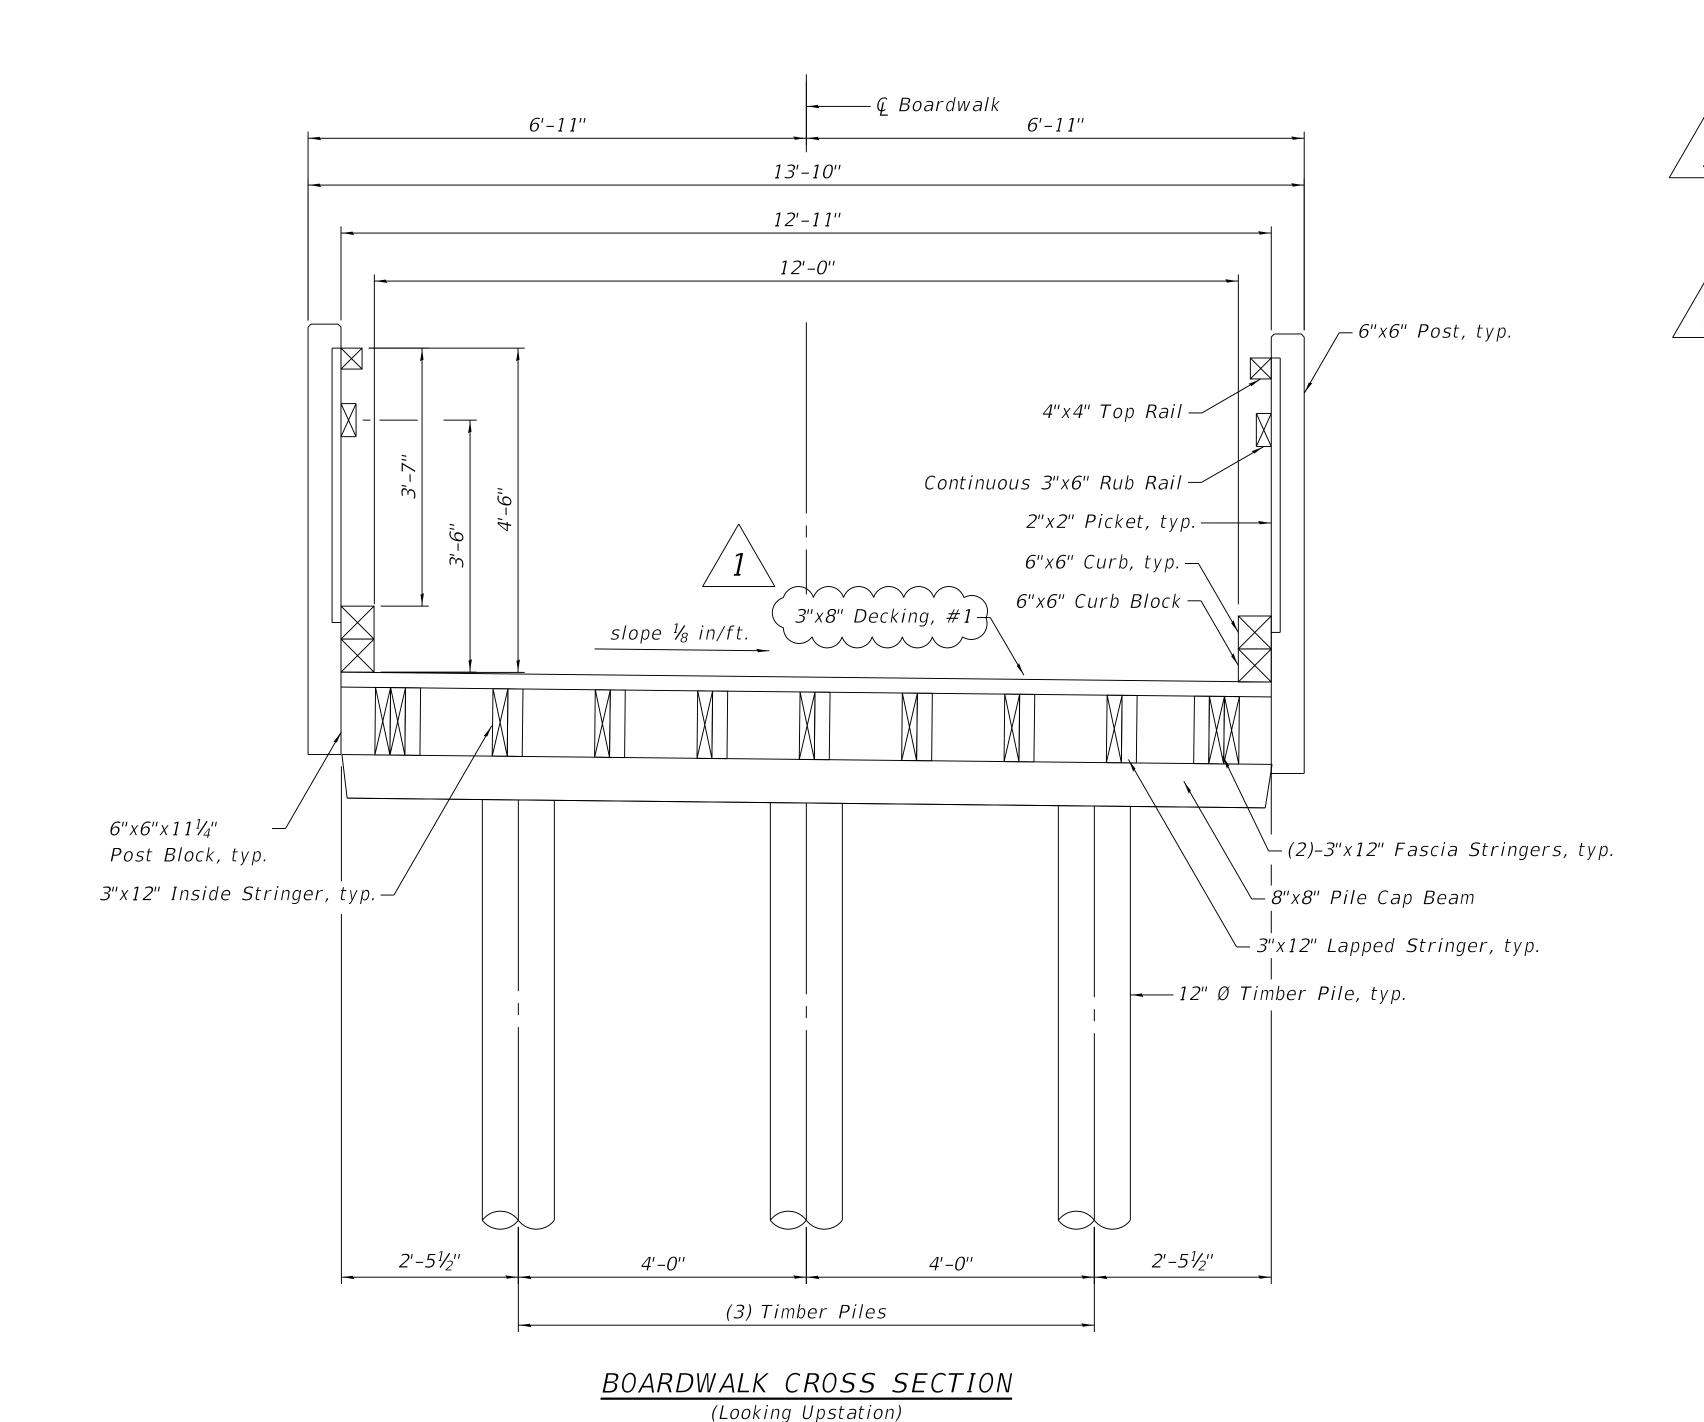

*Notes:* 

- 1. The top and bottom of pier post shall be covered with an epoxy glue to prevent water absorption.
- 2. Provide 2"x10" blocking for joists at the center of each span.
- 3. Decking shall be butted tightly board to board to allow for board shrinkage after deck construction.
- 4. Decking to be attached with 305 stainless steel or better screw recessed 1/8" below deck surface.
- 5. No splices shall be allowed for bridge decking.
- 6. All nails shall be the common wire nail type unless noted otherwise.
- 7. Wood members designated KDAT shall be kiln dried after treatment.

8. Wood members designated CA shall be pressure treated with copper azole.

9. Wood members designated CCA shall be pressure treated with chromated copper

arsenate.

10. All lumber cross section dimensions are nominal unless stated otherwise.

11. All timber piles with exposed heights above ground exceeding 5'-0" shall be braced according to the cross bracing detail shown on sheet S4.0.

PILE DATA

Nominal Required Bearing: 21 kips Factored Resistance Available: 11.5 kips

E	stimated Pile	e Length Tab	le
Boardwalk Segment	Boardwalk Station	Estimated Bottom of Pile Elev.	Depth of Timber Pile below Existing Grade
	76+00	670.0	8 ft
A	76+95	663.5	5 ft
A	78+00	658.0	5 ft
	78+56	657.5	5 f t

Timber piles: Unless otherwise specified,

- 1. Piles are required to be driven to the nominal required bearing as shown on the plans as defined by boardwalk designer.
- 2. If proper bearing capacity is not met at the minimum pile depth, pilings shall be spliced and driven until proper bearing is achieved. All standard splices must provide engineers calculations and stamp. Contractor may visit site prior to bidding, to assist in determining the proper depth of pilings. No additional compensation will be allowed for driving and installing piles deeper than may be shown on the drawings.
- 3. Timber piles shall be southern yellow pine, conforming to ASTM standard D-25 (Latest Edition) for quality. Specification for size shal be 1" taper in 10 linear feet.
- 4. All piling shall be pressure impregnated to a minimum of .80 pounds per cubic foot bet retention of CCA in accordance with AWPA standard U1, commodity specification (E), use category 4C.

5. Hand augering is not an approved pile installation method.

FEHR GRAHAM

**ENGINEERING & ENVIRONMENTAL** 

ILLINOIS DESIGN FIRM NO. 184-003525

ILLINOIS IOWA WISCONSIN OWNER/DEVELOPER: CITY OF DIXON 121 WEST 2ND STREET DIXON, IL 61016

PROJECT AND LOCATION: SHARED USE PATH EXTENSION SEC 17-00178-00-BT PROJECT NO. MXY3(094) JOB C-92-024-19

DRAWN BY: CFC APPROVED BY: MCB DATE: 11/15/22 SCALE: AS NOTED

REV. NO.	DESCRIPTION	DATE
1 ADDENDUM 1		12/21/22


DRAWING: DETAILS 1 SN 052-P003.1 SET TYPE: FOR BID SET

G:\C3D\Bridge Structural(Copy Only)\sht-003-details-l.dgr

JOB NUMBER: 17-067B SHEET NUMBER:


S3.0

PLOT DATE: 11/15/2022 © 2022 FEHR GRAHAM

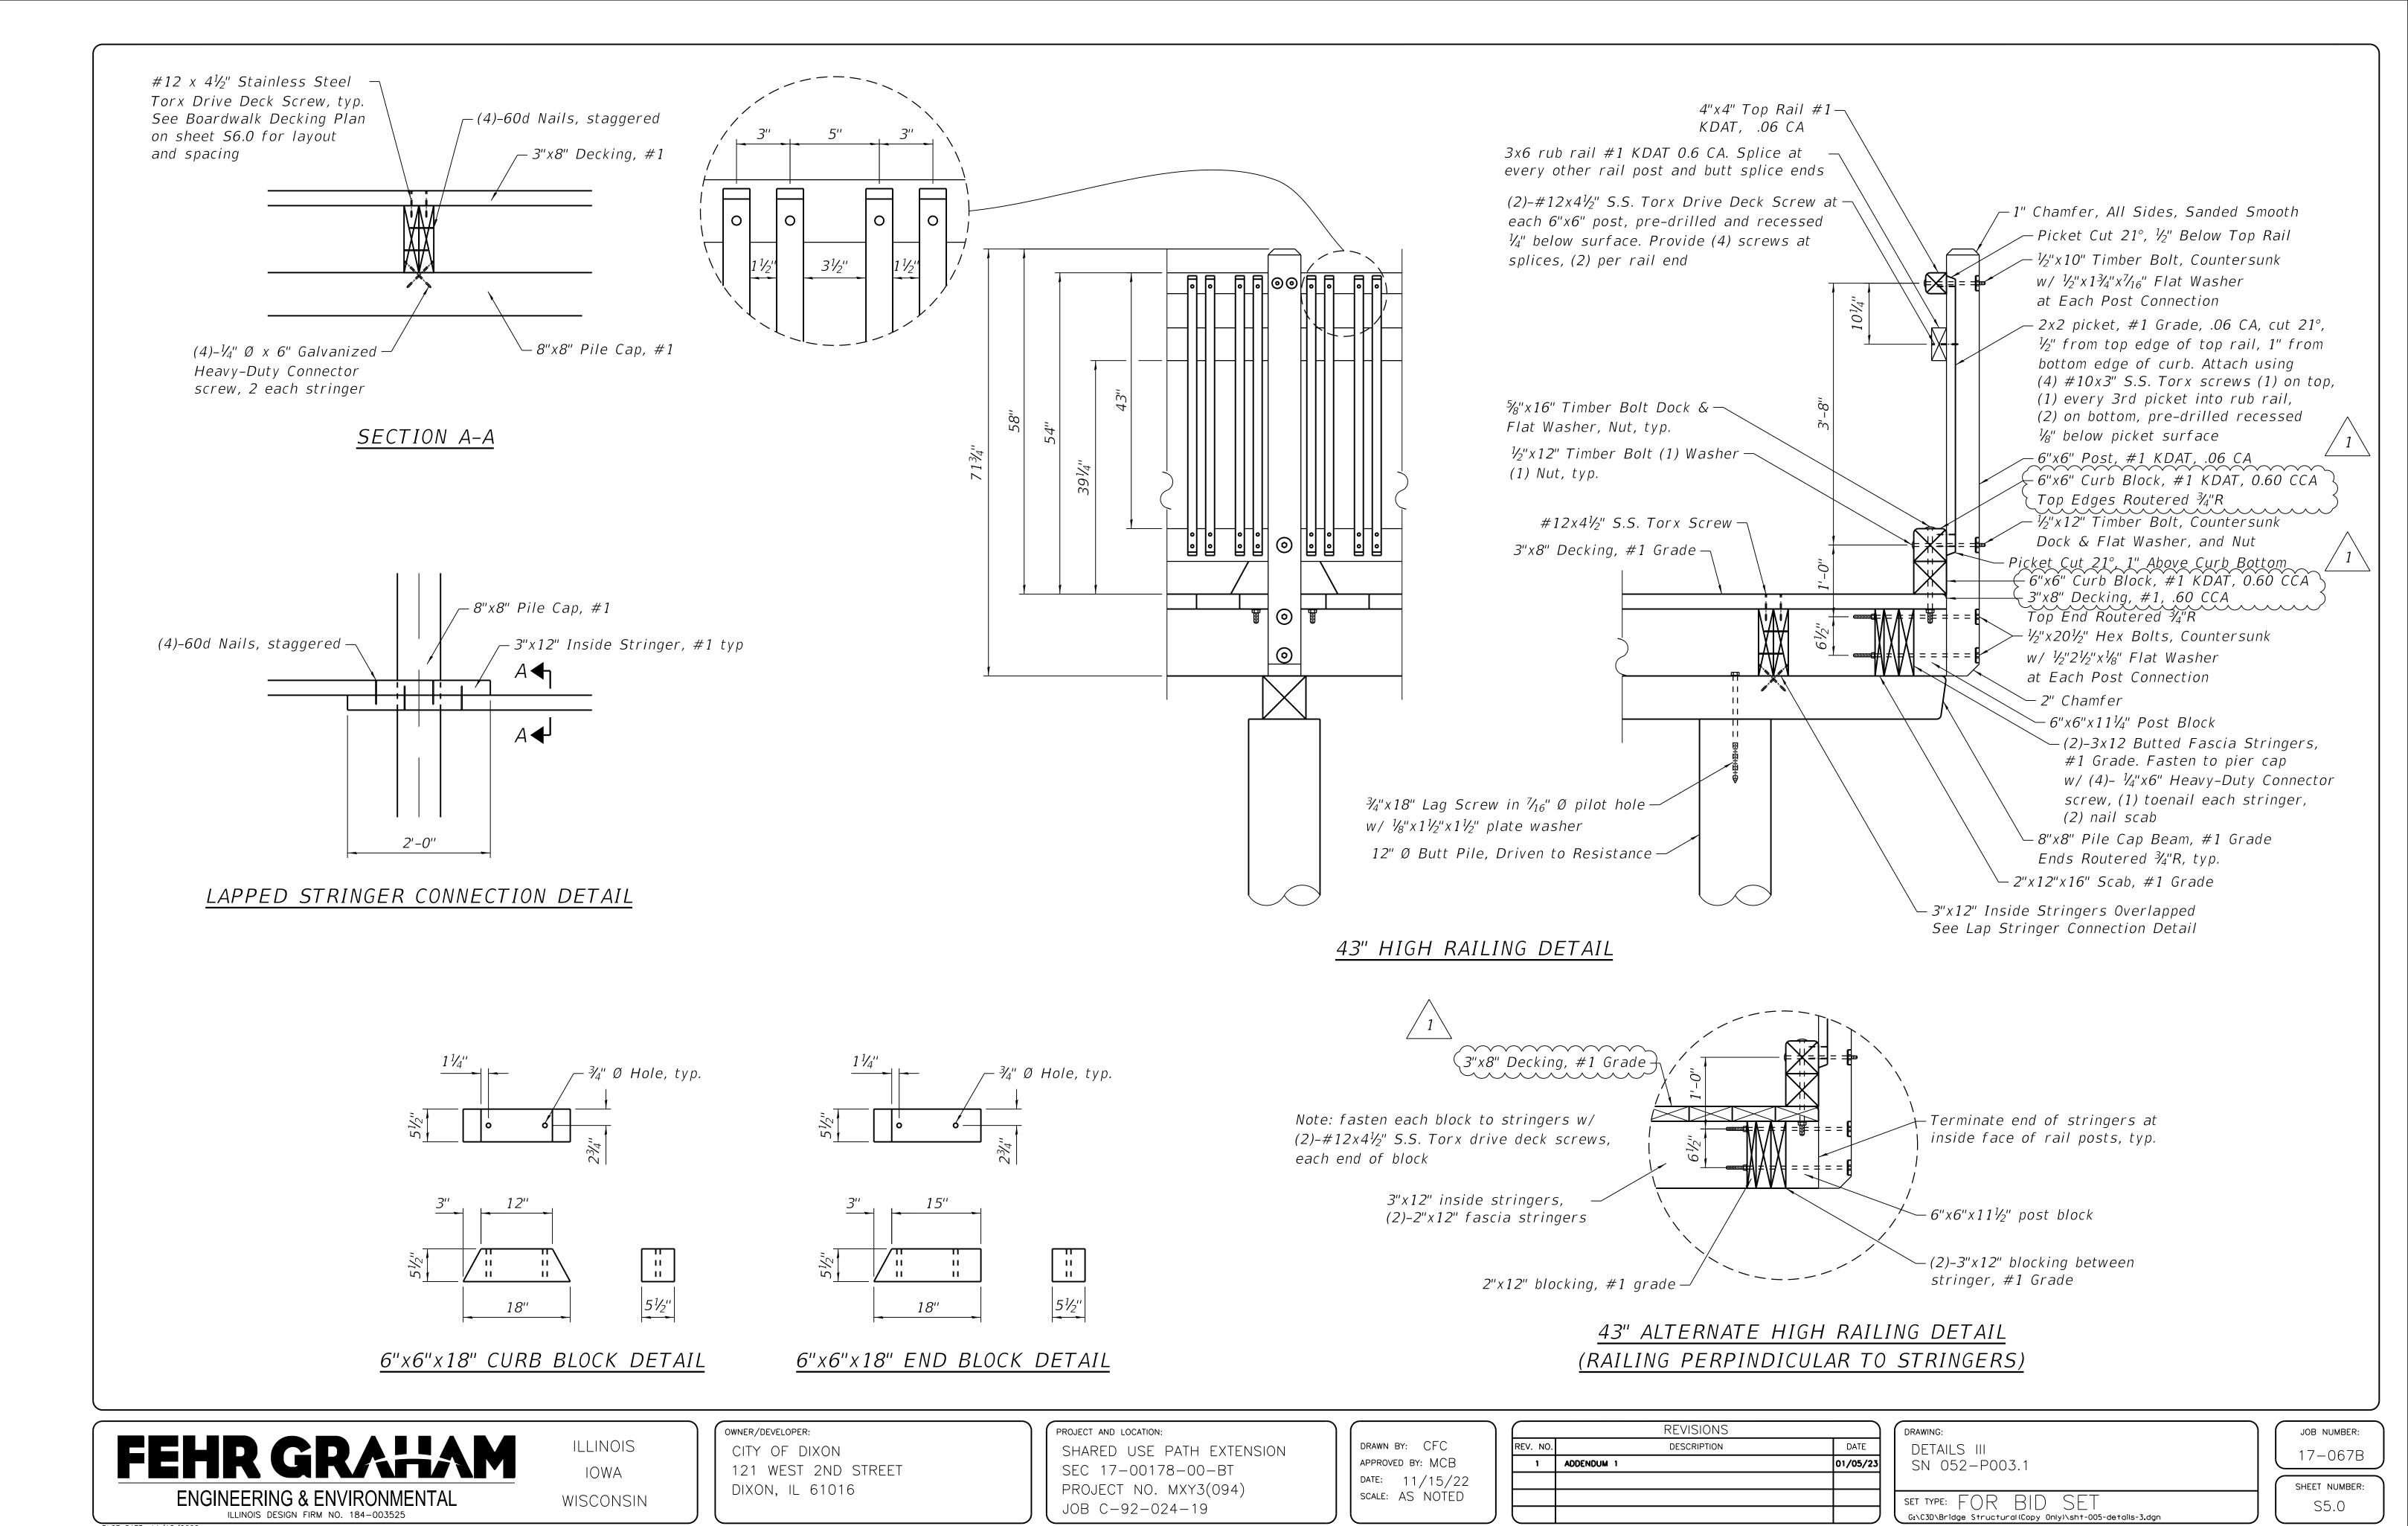

PLOT DATE: 11/15/2022 © 2022 FEHR GRAHAM

SHEET 86 of 96

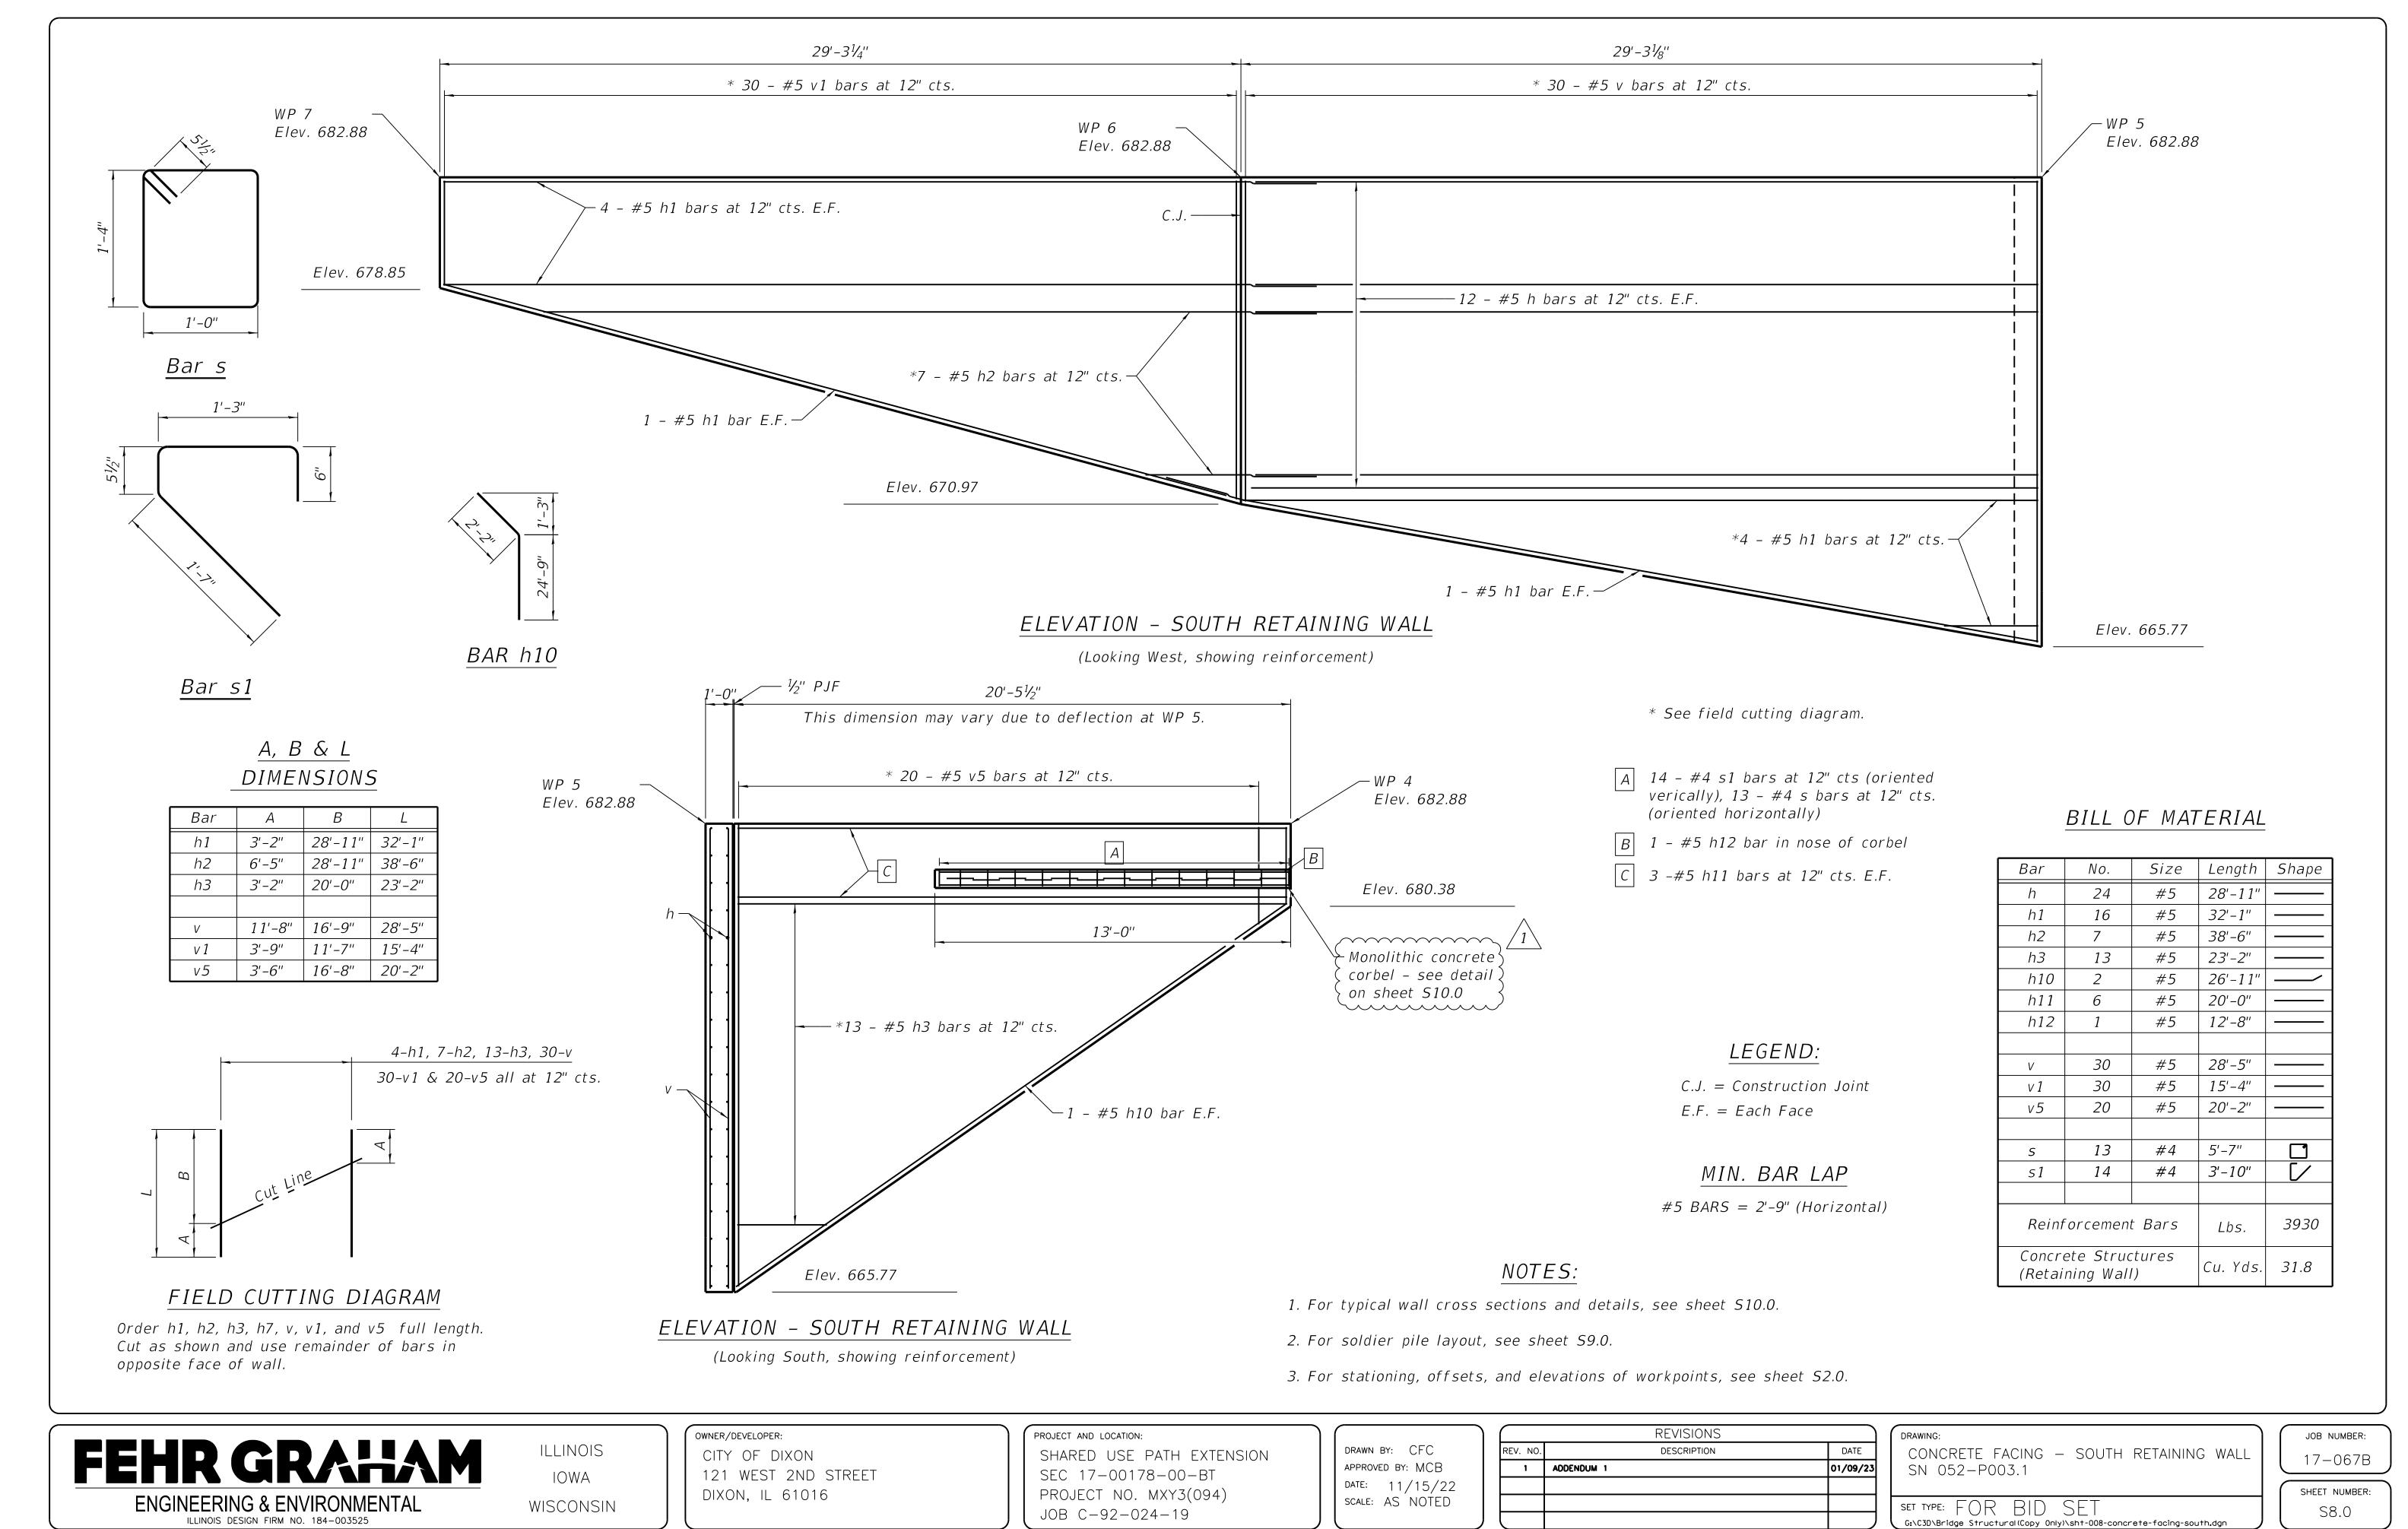

PLOT DATE: 11/15/2022 © 2022 FEHR GRAHAM

SHEET 89 of 96