


SUMMARY OF QUANTITIES (THIS SHEET)		
DESCRIPTION	UNIT	QUANTITY
ELECTRIC CABLE IN CONDUIT, LEAD-IN, NO. 18 4/C, TWISTED, SHIELDED	LF	224
INDUCTION LOOP	LF	318

NOTE:
 IDOT RECORD PLANS PROVIDED FOR INFORMATIONAL PURPOSES ONLY. THE CONTRACTOR IS RESPONSIBLE FOR VERIFYING THE LOCATION AND EXTENT OF WORK ASSOCIATED WITH REPLACEMENT OF INDUCTION LOOPS, LEAD-IN CABLE AND RELATED WORK.

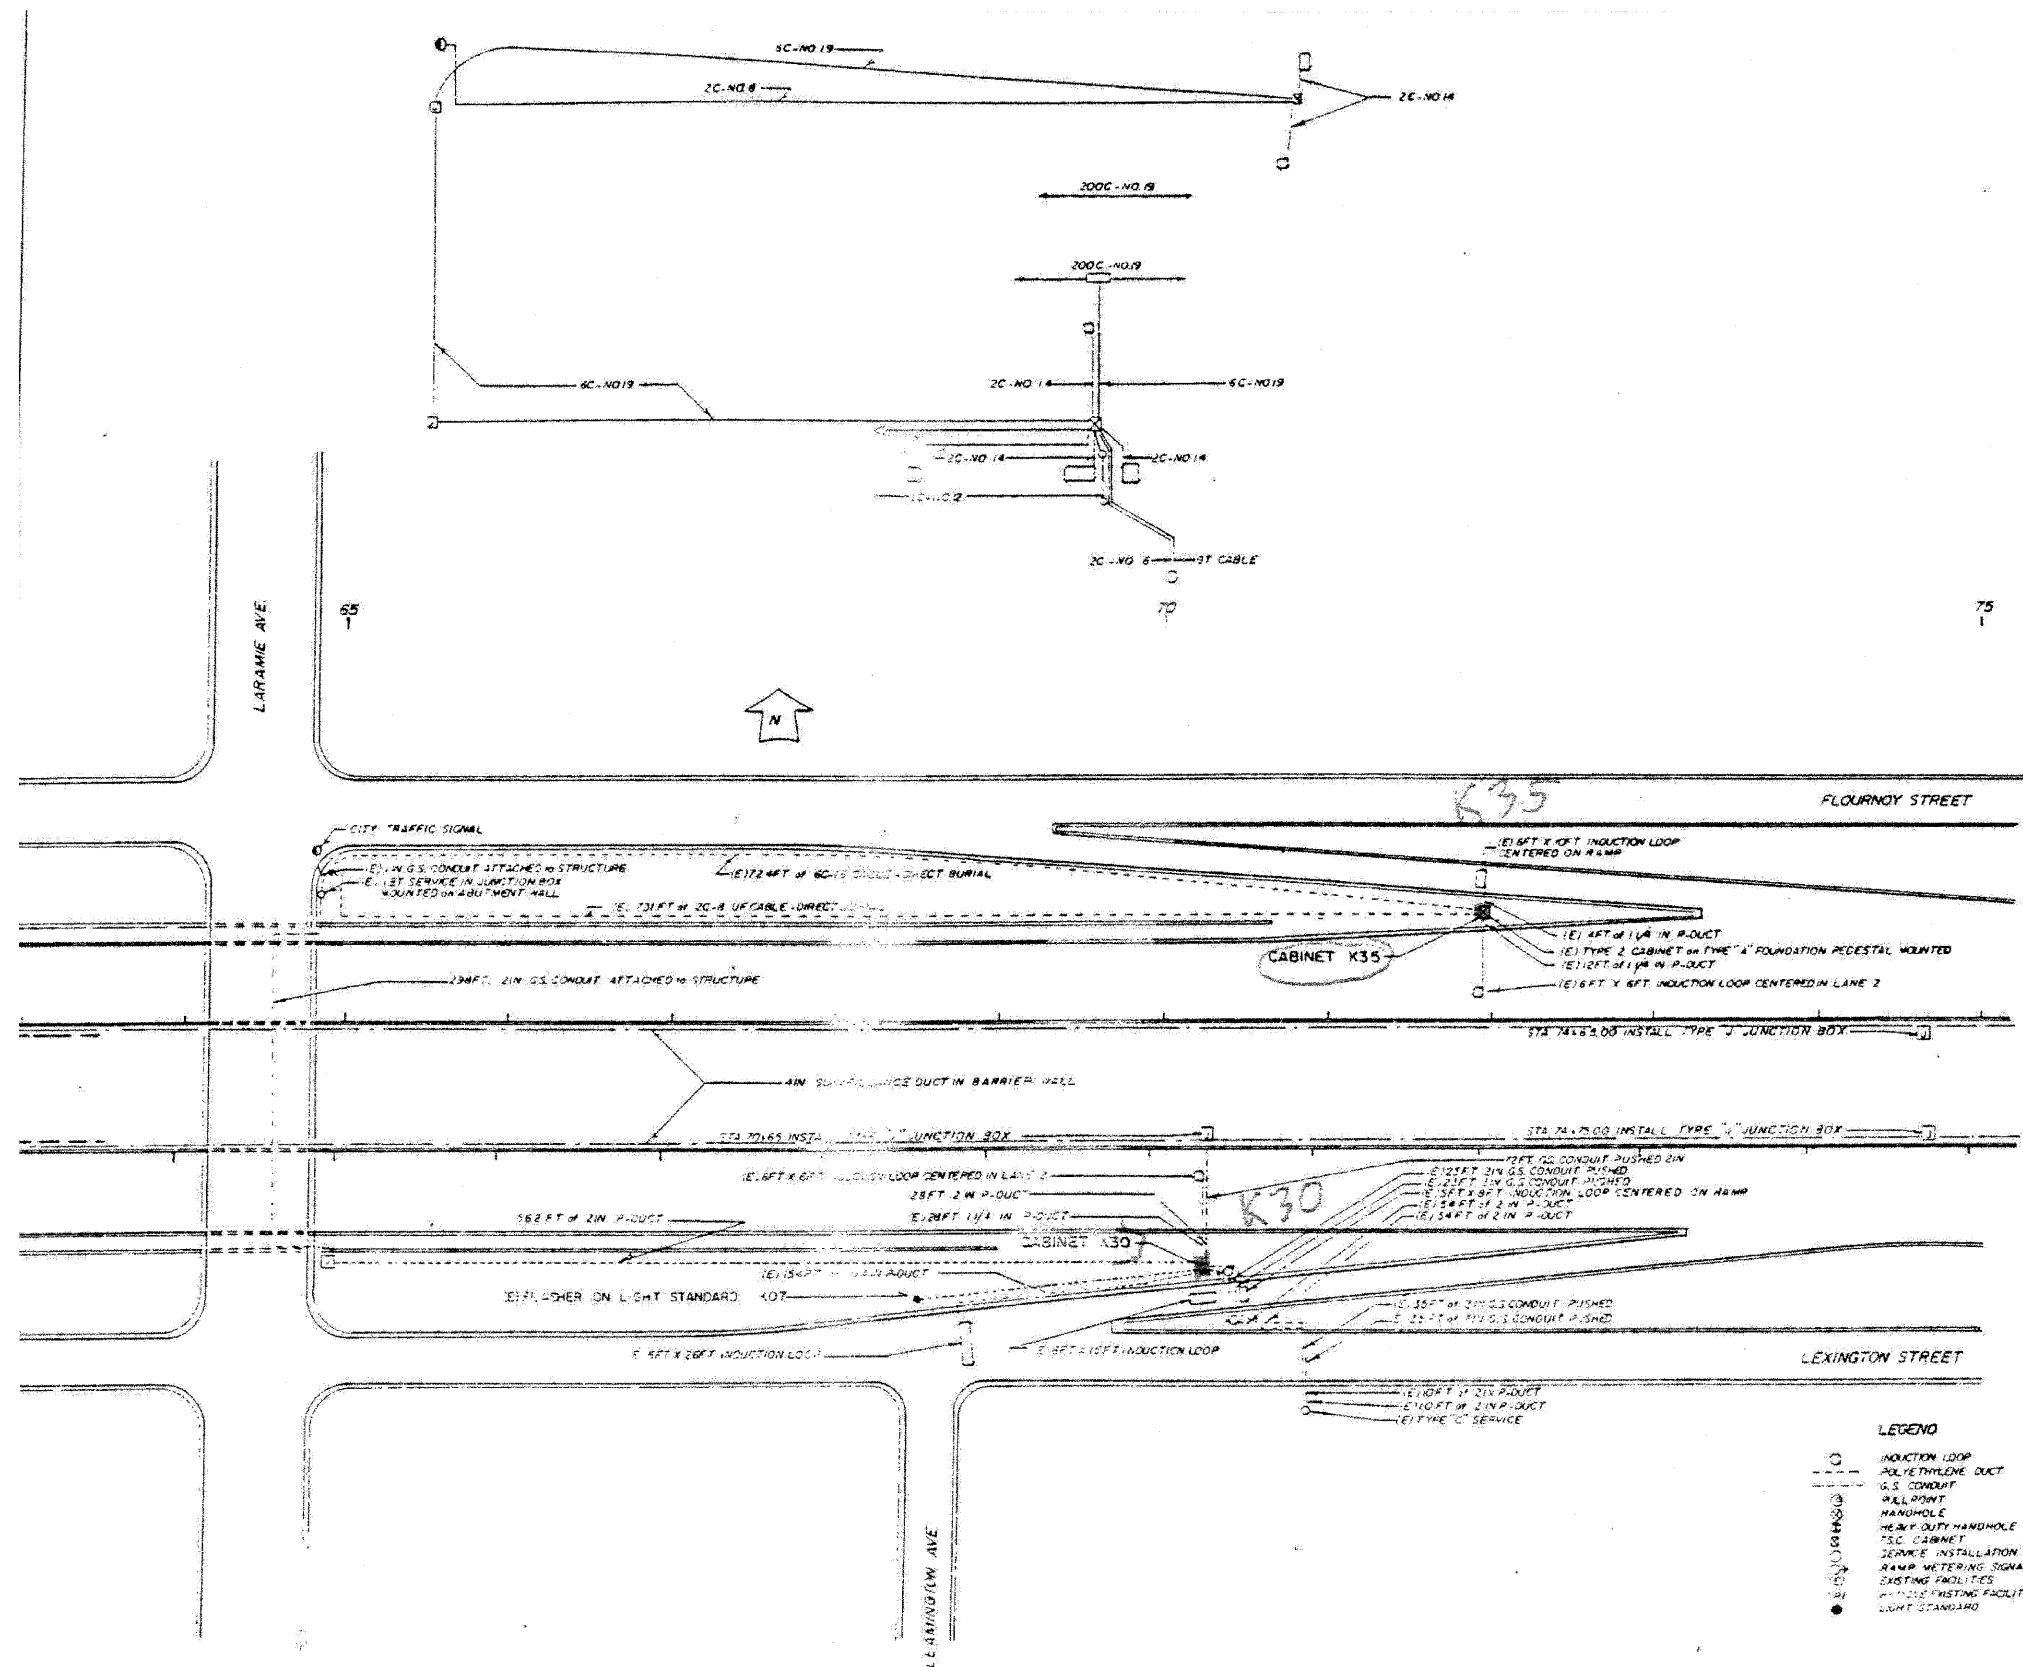

FILE NAME =	DESIGNED - GHT	REVISED -
...:\signals\grp\in_abc_c3_ts_17.dgn	DRAWN - DMS	REVISED -
USER NAME = jrojanowski	CHECKED - MPM	REVISED -
PLOT DATE = 1/25/2010	DATE - 1/25/10	REVISED -

benesch

**STATE OF ILLINOIS
 DEPARTMENT OF TRANSPORTATION**

**TRAFFIC SURVEILLANCE
 LARAMIE AVE INSTALLATION**

F.A.I. RTE.	SECTION	COUNTY	TOTAL SHEETS	SHEET NO.
290	(2727, ETC., 3131)RS-7	COOK	216	180
FED. ROAD DIST. NO.			ILLINOIS FED. AID PROJECT	

SCALE: N.T.S. SHEET NO. 6 OF 7 SHEETS STA. TO STA.

CONTRACT NO. 60G53