


P. A. FILE	SECTION	COUNTY	TOTAL SHEETS	SHEET NO.
8094	2826.2-R-1	COOK	452	57
STA.	TO STA.			
FED. ROAD DIST. NO.	ILLINOIS	FED. AID PROJECT		
CONTRACT NO. 62113		INDOT DES. NO. 0100987		

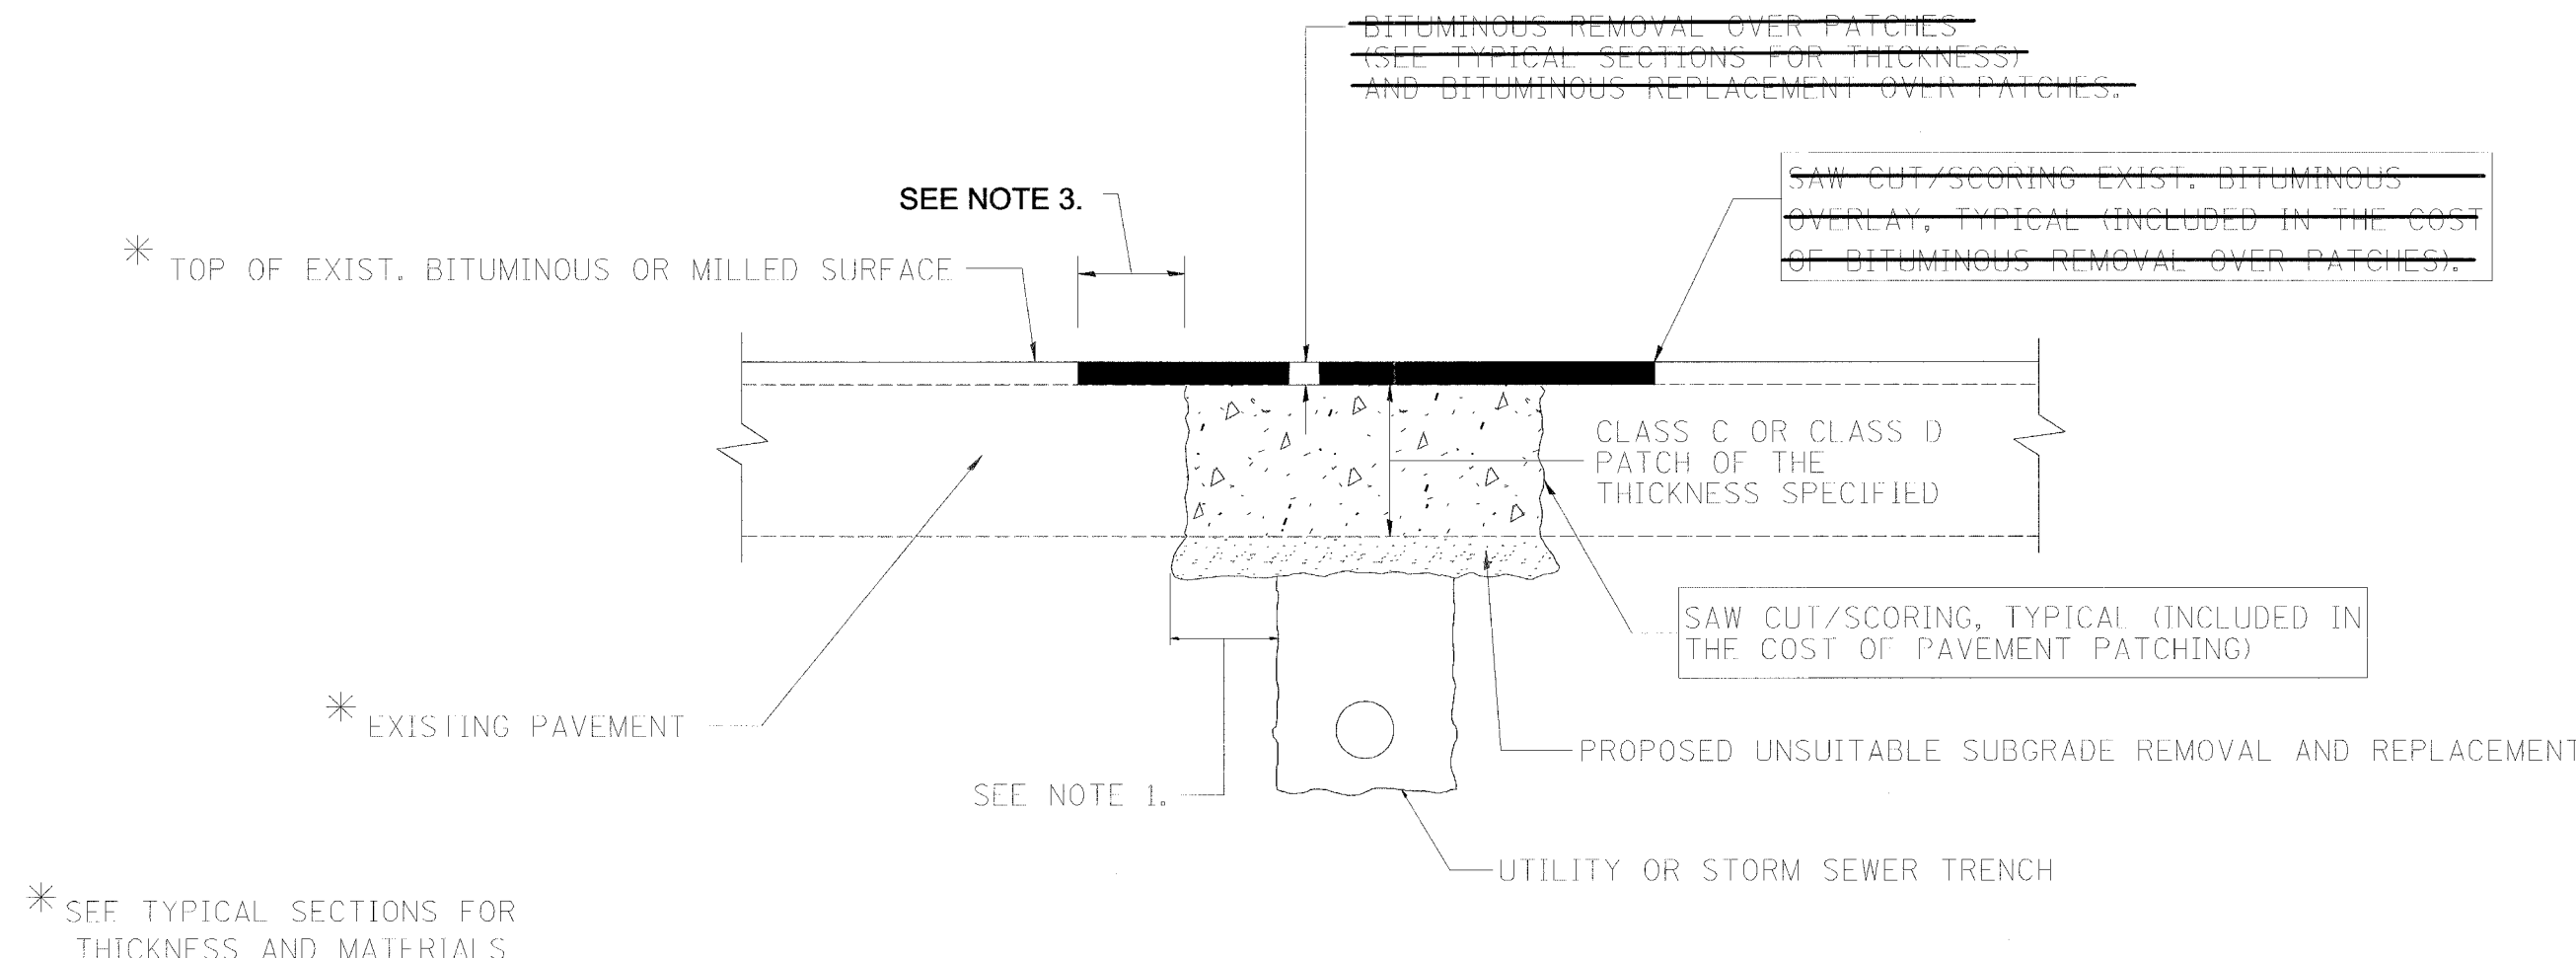

* SEE TYPICAL SECTIONS FOR THICKNESS AND MATERIALS

NOTES:

1. THE WIDTH OF THE FULL DEPTH PATCH OVER A TRENCH SHALL BE 300 (12) WIDER ON EACH SIDE OF THE TRENCH.
- ~~2. FOR METHOD OF MEASUREMENT AND BASIS OF PAYMENT, SEE SPECIAL PROVISION "PATCHING WITH BITUMINOUS OVERLAY REMOVAL".~~
3. **SAW CUT FULL DEPTH OF PATCH. DO NOT REMOVE OVERLAY BEYOND SAW CUT.**

SEQUENCE OF CONSTRUCTION

- ~~1. REMOVE THE EXISTING BITUMINOUS MATERIAL OVER THE AREA TO BE PATCHED.~~
2. REMOVE AND REPLACE FULL DEPTH PATCHES
- ~~3. REPLACE BITUMINOUS MATERIAL OVER THE AREA TO BE PATCHED.~~

ALL DIMENSIONS ARE IN MILLIMETERS (INCHES) UNLESS OTHERWISE SHOWN.

ILLINOIS DEPARTMENT OF TRANSPORTATION

PAVEMENT PATCHING FOR BITUMINOUS SURFACED PAVEMENT

REVISIONS		REVISIONS	
NAME	DATE	NAME	DATE
R. SHAH	10/25/94	ART ABBAS	04/27/98
R. SHAH	01/14/95		
R. SHAH	03/23/95		
R. SHAH	04/24/95		
A. HOUSEH	03/15/96		
A. ABBAS	03/21/97		
A. ABBAS	01/20/98		

SCALE: NONE
DATE \$\$\$DATE\$\$
DRAWN BY
CHECKED BY

BD400-04 (BD-22)