


AS-BUILT PLANS FOR INFORMATION ONLY

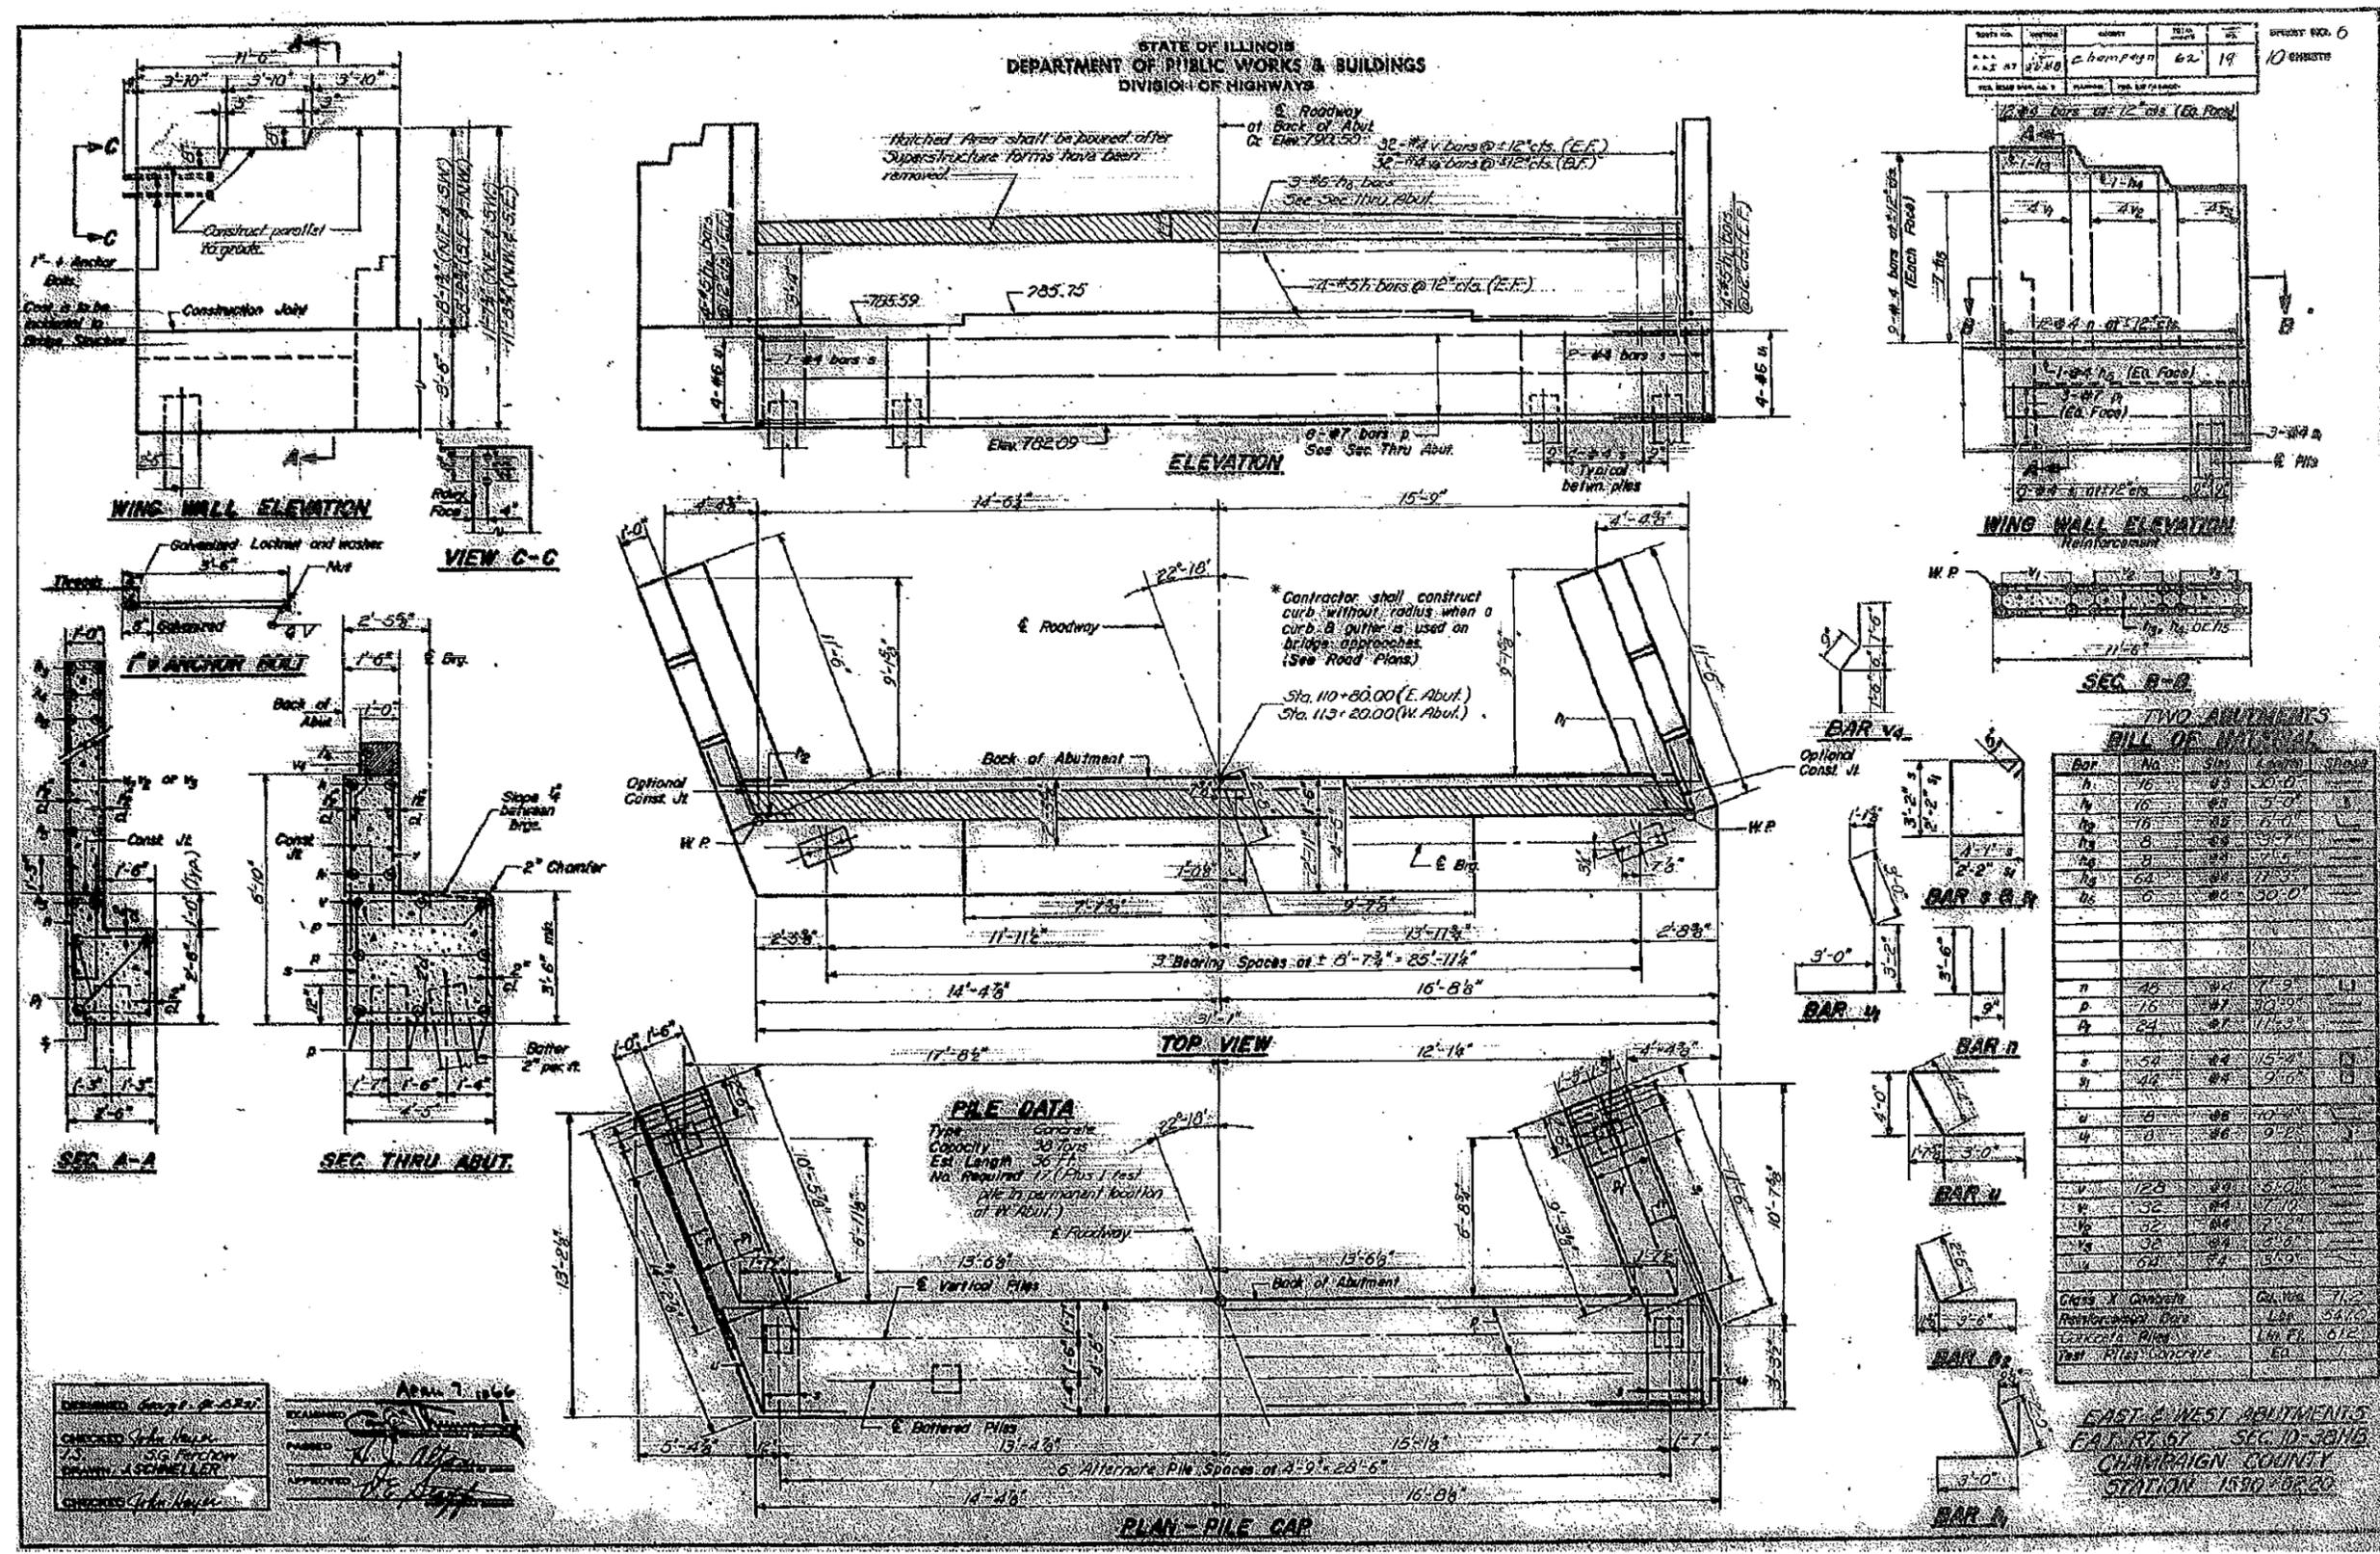

DATE	BY	CHECKED	SCALE	SHEET NO.	TOTAL SHEETS
12/2/09	AW	AW	AS SHOWN	8	8

Bar	No.	Size	Length	Spaced
h	16	#4	30'-0"	
h	16	#4	3'-0"	
h	16	#4	2'-0"	
h	8	#4	33'-7"	
h	8	#4	2'-5"	
h	64	#4	17'-5"	
h	6	#4	30'-0"	
n	48	#4	7'-5"	
p	16	#4	30'-0"	
q	24	#4	11'-5"	
s	52	#4	15'-4"	
g	44	#4	9'-0"	
u	8	#6	30'-0"	
u	8	#6	9'-0"	
v	128	#4	6'-0"	
w	32	#4	7'-0"	
v	32	#4	2'-0"	
v	32	#4	3'-0"	
u	64	#4	3'-0"	

DESIGNED: GMS
CHECKED: AW
DRAWN: GMS
PLOT SCALE: 40.0000' / IN.
PLOT DATE: 12/2/2009

APR 7 2006
AW
GMS