

INDEX OF SHEETS

- 1 COVER SHEET
- 2 INDEX OF SHEETS, HIGHWAY STANDARDS,
GENERAL NOTES & COMMITMENTS
- 3-5 SUMMARY OF QUANTITIES
- 6-10 TYPICAL SECTIONS
- 11-14 **A** SCHEDULE OF QUANTITIES
- 15 TIE POINTS AND BENCHMARKS
- 16-22 PLAN AND PROFILE SHEETS
- 23-26 PLAN SHEETS
- 27 WIDE LOAD SIGNING PLAN
- 28-33 STAGE CONSTRUCTION
- 34-35 TRAFFIC CONTROL PLAN
- 36-37 STORM WATER POLLUTION PREVENTION PLAN
- 38 EROSION CONTROL SCHEDULE OF QUANTITIES
- 39-42 EROSION CONTROL PLAN
- 43-47 REMOVAL PLAN
- 48-51 DRAINAGE PLAN
- 52-58 PAVEMENT MARKING PLAN
- 59 MISCELLANEOUS DETAILS
- 60 ENTRANCE DETAILS
- 61-64 LIGHTING PLANS
- 65-98 BRIDGE PLANS
- 99-106 EXISTING STRUCTURE PLANS
- 107-115 PRE-STAGE I CROSS SECTIONS
- 116-124 STAGE I CROSS SECTIONS
- 125-140 STAGE II CROSS SECTIONS
- 141-142 INLET CROSS SECTIONS
- 143-144 ENTRANCE CROSS SECTIONS

GENERAL NOTES:

1. THE STANDARDS AND REVISION NUMBERS SHALL APPLY TO THIS PROJECT.
2. THE CONTRACTOR SHALL VERIFY ALL DIMENSIONS AND CONDITIONS IN THE FIELD PRIOR TO CONSTRUCTION AND ORDERING MATERIALS.
3. ILLINOIS STATE LAW REQUIRES A 48-HOUR NOTICE BE GIVEN TO ALL UTILITIES BEFORE DIGGING. FIELD MARKING OF FACILITIES MAY BE OBTAINED BY CONTACTING J.U.L.I.E. OR FOR NON-MEMBERS, THE UTILITY COMPANY DIRECTLY. AGENCIES KNOWN TO HAVE FACILITIES WITHIN THE PROJECT AREA ARE AS FOLLOWS:
 - CHARTER COMMUNICATIONS
 - CITY OF COLUMBIA (WATER & SANITARY SEWER)
 - HARRISONVILLE TELEPHONE CO.
 - ILLINOIS AMERICAN WATER CO.
 - AMERENIP (GAS & ELECTRIC)
 MEMBERS OF J.U.L.I.E. (800) 892-0123 OR 811 ARE INDICATED BY AN •. NON-J.U.L.I.E. MEMBERS MUST BE NOTIFIED INDIVIDUALLY.
4. "ROAD CONSTRUCTION AHEAD" SIGNS SHALL BE PLACED AT EACH END OF THE PROJECT AND ALL INTERSECTING SIDE ROADS AND WILL BE INCLUDED IN THE TRAFFIC CONTROL PAY ITEMS. ALL CONSTRUCTION SIGNS SHALL BE FLOURESCENT ORANGE, 48".
5. IF THE CONTRACTOR, FOR HIS CONSTRUCTION ACTIVITY, REMOVES TREES WITHIN THE RIGHT-OF-WAY LIMITS WHICH ARE NOT DESIGNATED ON THE PLANS FOR REMOVAL, I.E. IN ORDER TO GAIN ACCESS TO THE PROJECT SITE; IT WILL BE HIS RESPONSIBILITY TO REPLACE THE TREES AT A 1:1 RATIO. THE TREES WILL BE REPLACED WITH A 1 GALLON NATIVE ILLINOIS TREE SPECIES AND SHALL BE APPROVED BY THE ENGINEER. THE TREE REMOVAL AND TREE REPLACEMENT WILL BE AT THE CONTRACTOR'S EXPENSE, AND NO ADDITIONAL COMPENSATION WILL BE ALLOWED.
6. A QUANTITY OF 2325 FEET OF "TEMPORARY PAVEMENT MARKING - LINE 6 INCH" WHITE HAS BEEN INCLUDED IN THE PLANS FOR PAINTING THE BOTTOM 6" OF THE TEMPORARY CONCRETE BARRIER.
7. THE THICKNESS OF HOT-MIX ASPHALT MIXTURES SHOWN ON THE PLANS IS THE NOMINAL THICKNESS. DEVIATIONS MAY OCCUR DUE TO IRREGULARITIES IN THE EXISTING SURFACE OR BASE ON WHICH THE HOT-MIX ASPHALT MIXTURE IS PLACED.
8. FLAGGERS SHALL BE REQUIRED AT ALL TIMES DURING PATCHING OPERATIONS.
9. COORDINATION WITH THE DEPARTMENT'S BUREAU OF OPERATIONS IS REQUIRED BEFORE ANY TRENCHING SHALL BE DONE TO LOCATE HIGHWAY LIGHTING/ PUMP STATION/ INTELLIGENT TRANSPORTATION SYSTEM FACILITIES AND TO COORDINATE OTHER FIELD ACTIVITIES.
10. ALL DROP-OFFS AT THE EDGE OF PAVEMENT SHALL BE PROTECTED BY EXTENDED LEG BARRICADES WITH APPROPRIATE LIGHTS. **A**

COMMITMENTS

NONE

HIGHWAY STANDARDS

000001-05	602301-02	630301-05	701301-03	701411-06
280001-05	604051-03	631031-08	701306-02	701431-05
420401-08	606001-04	635006-03	701311-03	701456
442101-07	606301-04	635011-02	701321-10	701901-01
515001-03	630001-08	701201-03	701326-03	704001-06
542301-02	631011-06	701206-02	701336-05	780001-02
				781001-03

**STATE OF ILLINOIS
DEPARTMENT OF TRANSPORTATION**

**INDEX OF SHEETS, HIGHWAY STANDARDS,
GENERAL NOTES AND COMMITMENTS**


A Rev. 2-11-10

FILE NAME =	USER NAME = cwenbj	DESIGNED -	REVISED -	STATE OF ILLINOIS DEPARTMENT OF TRANSPORTATION	INDEX OF SHEETS, HIGHWAY STANDARDS, GENERAL NOTES AND COMMITMENTS	F.A.P. RTE.	SECTION	COUNTY	TOTAL SHEETS	SHEET NO.	
ct\pwork\PWIDOT\OWENBJ\dms52558\pin0606.dgn		DRAWN -	REVISED -			809	67-1HBR	MONROE	144	2	
PLOT SCALE = 50.0000' / 1" IN.		CHECKED -	REVISED -			CONTRACT NO. 76977					
PLOT DATE = 2/8/2010		DATE -	REVISED -			SCALE:	SHEET NO. 1 OF 1 SHEETS	STA.	TO STA.	FED. ROAD DIST. NO. ILLINOIS FED. AID PROJECT	

SUMMARY OF QUANTITIES

SUMMARY OF QUANTITIES			URBAN 80% FEDERAL 20% STATE TOTAL QUANTITIES	CONSTRUCTION TYPE CODE		SUMMARY OF QUANTITIES			URBAN 80% FEDERAL 20% STATE TOTAL QUANTITIES	CONSTRUCTION TYPE CODE		
CODE NO	ITEM	UNIT		X271-2A	I000-2A	CODE NO	ITEM	UNIT		X271-2A	I000-2A	Y030-1E
58700300	CONCRETE SEALER	SQ FT	1531	1531		70106700	TEMPORARY RUMBLE STRIP	EACH	6	6		
59100100	GEOCOMPOSITE WALL DRAIN	SQ YD	274	274		70106800	CHANGEABLE MESSAGE SIGN	CAL MO	30	30		
60109580	PIPE UNDERDRAINS FOR STRUCTURES 4"	FOOT	247	247		70300100	SHORT-TERM PAVEMENT MARKING	FOOT	950	417	533	
60236800	INLETS, TYPE A, TYPE 11 FRAME AND GRATE	EACH	1	1		70300220	TEMPORARY PAVEMENT MARKING - LINE 4"	FOOT	14846	5941	8905	
60260100	INLETS TO BE ADJUSTED	EACH	8	4	4	70300240	TEMPORARY PAVEMENT MARKING - LINE 6"	FOOT	2325	2325		
60404800	FRAMES AND GRATES, TYPE 11	EACH	8	4	4	70301000	WORK ZONE PAVEMENT MARKING REMOVAL	SQ FT	5265	2119	3146	
60500060	REMOVING INLETS	EACH	1	1		70400100	TEMPORARY CONCRETE BARRIER	FOOT	1325	1325		
60605600	COMBINATION CONCRETE CURB AND GUTTER, TYPE B-9.06	FOOT	4300	2660	1640	70400200	RELOCATE TEMPORARY CONCRETE BARRIER	FOOT	1000	1000		
60618300	CONCRETE MEDIAN SURFACE, 4 INCH	SQ FT	10,745	6,645	4100	78000200	THERMOPLASTIC PAVEMENT MARKING - LINE 4"	FOOT	13840	4935	8905	
* 63000001	STEEL PLATE BEAM GUARD RAIL, TYPE A, 6 FOOT POSTS	FOOT	525	525		78000500	THERMOPLASTIC PAVEMENT MARKING - LINE 8"	FOOT	1805	380	1425	
* 63000003	STEEL PLATE BEAM GUARD RAIL, TYPE A, 9 FOOT POSTS	FOOT	3850		3850	78008210	POLYUREA PAVEMENT MARKING TYPE I - LINE 4"	FOOT	1006	1006		
* 63100045	TRAFFIC BARRIER TERMINAL, TYPE 2	EACH	3	2	1	78100100	RAISED REFLECTIVE PAVEMENT MARKER	EACH	61	61		
* 63100085	TRAFFIC BARRIER TERMINAL, TYPE 6	EACH	4	4		* 78200300	PRISMATIC CURB REFLECTOR	EACH	120	80	40	
* 63100167	TRAFFIC BARRIER TERMINAL, TYPE 1 (SPECIAL) TANGENT	EACH	8	5	3	78200410	GUARDRAIL MARKERS, TYPE A	EACH	49	12	37	
63200310	GUARDRAIL REMOVAL	FOOT	5109	1091	4018	78200520	BARRIER WALL MARKERS, TYPE B	EACH	6	6		
67000400	ENGINEER'S FIELD OFFICE, TYPE A	CAL MO	20	20		78200530	BARRIER WALL MARKERS, TYPE C	EACH	6	6		
67100100	MOBILIZATION	L SUM	1	1		78201000	TERMINAL MARKER - DIRECT APPLIED	EACH	8	5	3	
70100420	TRAFFIC CONTROL AND PROTECTION, STANDARD 701411	EACH	1	1		78300100	PAVEMENT MARKING REMOVAL	SQ FT	6152	2234	3918	
70100450	TRAFFIC CONTROL AND PROTECTION, STANDARD 701201	L SUM	1		1	78300200	RAISED REFLECTIVE PAVEMENT MARKER REMOVAL	EACH	61	61		
70100455	TRAFFIC CONTROL AND PROTECTION, STANDARD 701206	L SUM	1		1	* 80300100	LOCATING UNDERGROUND CABLE	FOOT	2760			2760
70100460	TRAFFIC CONTROL AND PROTECTION, STANDARD 701306	L SUM	1		1	* 81603035	UNIT DUCT, 600V, 2-1C NO. 6, 1/C NO. 6 GROUND, (XLP-TYPE USE), 1" DIA. POLYETHYLENE	FOOT	2960			2960
70100500	TRAFFIC CONTROL AND PROTECTION, STANDARD 701326	L SUM	1		1	* 81900200	TRENCH AND BACKFILL FOR ELECTRICAL WORK	FOOT	2760			2760
70100600	TRAFFIC CONTROL AND PROTECTION, STANDARD 701336	L SUM	1		1	* 83600300	LIGHT POLE FOUNDATION, 30" DIAMETER	FOOT	16			16
70100825	TRAFFIC CONTROL AND PROTECTION, STANDARD 701456	L SUM	1		1	84200806	REMOVAL OF FOUNDATION, CONCRETE	EACH	2			2
70101200	TRAFFIC CONTROL AND PROTECTION, STANDARD 701431 (SPECIAL)	EACH	1	1		* 84400105	RELOCATE EXISTING LIGHTING UNIT	EACH	2			2
70101205	TRAFFIC CONTROL AND PROTECTION, STANDARD 701321 (SPECIAL)	EACH	1	1		X0323988	TEMPORARY SOIL RETENTION SYSTEM	SQ FT	207	207		
70101800	TRAFFIC CONTROL AND PROTECTION, (SPECIAL)	L SUM	1	1		X0322400	PILE EXTRACTION	EACH	8	8		
70103815	TRAFFIC CONTROL SURVEILLANCE	CAL DA	30		30	X0502600	TEMPORARY LIGHTING	L SUM	1			1
70106600	TEMPORARY BRIDGE TRAFFIC SIGNALS (STATE FURNISHED CONTROLLER)	EACH	1	1		X4421000	PARTIAL DEPTH PATCHING	TON	100		100	
						X4422030	PARTIAL DEPTH REMOVAL 3"	SQ YD	570		570	
						X5080600	MECHANICAL SPLICERS	EACH	120	120		
						X6060500	CORRUGATED MEDIAN REMOVAL	SQ FT	535		535	


* Specialty Items Rev. 2-11-10 Rev.

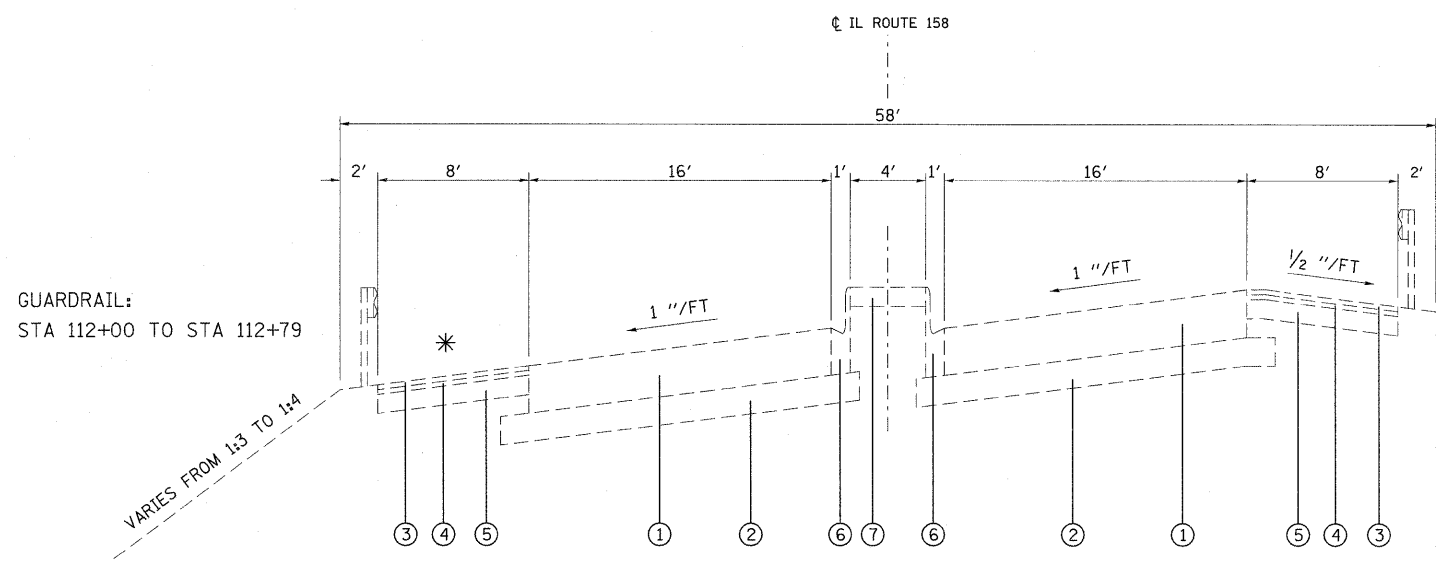


EXISTING SUPERELEVATED TYPICAL SECTION
 STA 103+20 TO STA 109+80
 STA 112+00 TO STA 114+80.10

GUARDRAIL:
 STA 109+12 TO STA 109+80
 STA 112+00 TO STA 113+87

- LEGEND
- ① EXISTING PORTLAND CEMENT CONCRETE PAVEMENT - 10"
 - ② EXISTING SUB-BASE GRANULAR MATERIAL, TYPE A - 6"
 - ③ EXISTING BITUMINOUS CONCRETE SURFACE COURSE, SUB-CLASS I-11 (SHOULDERS) - 1 1/2 "
 - ④ EXISTING BITUMINOUS CONCRETE BINDER COURSE (SHOULDERS) - 1 1/2 "
 - ⑤ EXISTING STABILIZED SHOULDERS
 - ⑥ EXISTING COMBINATION CONCRETE CURB AND GUTTER, TYPE B-9.06
 - ⑦ EXISTING PORTLAND CEMENT CONCRETE MEDIAN SURFACE - 4"
 - ⑧ PROPOSED HMA SURFACE COURSE - 1 1/2 "
 - ⑨ PROPOSED LEVELING BINDER - 1"
 - ⑩ PROPOSED HMA BINDER COURSE - VARIES FROM 1.25" TO 36.2" Δ
 - ⑪ PROPOSED HMA BASE COURSE - 11"
 - ⑫ PROPOSED HMA BASE COURSE - 10"
 - ⑬ PROPOSED HMA SHOULDER
 - ⑭ PROPOSED COMBINATION CURB AND GUTTER, TYPE B-9.06
 - ⑮ PROPOSED CONCRETE MEDIAN SURFACE - 4"
 - ⑯ PROPOSED GUARDRAIL
 - ⑰ PROPOSED AGGREGATE WEDGE SHOULDER, TYPE B
 - ⑱ PROPOSED RAVED SHOULDER REMOVAL
 - ⑲ PROPOSED PAVEMENT REMOVAL (AFTER STAGE CONSTRUCTION) Δ

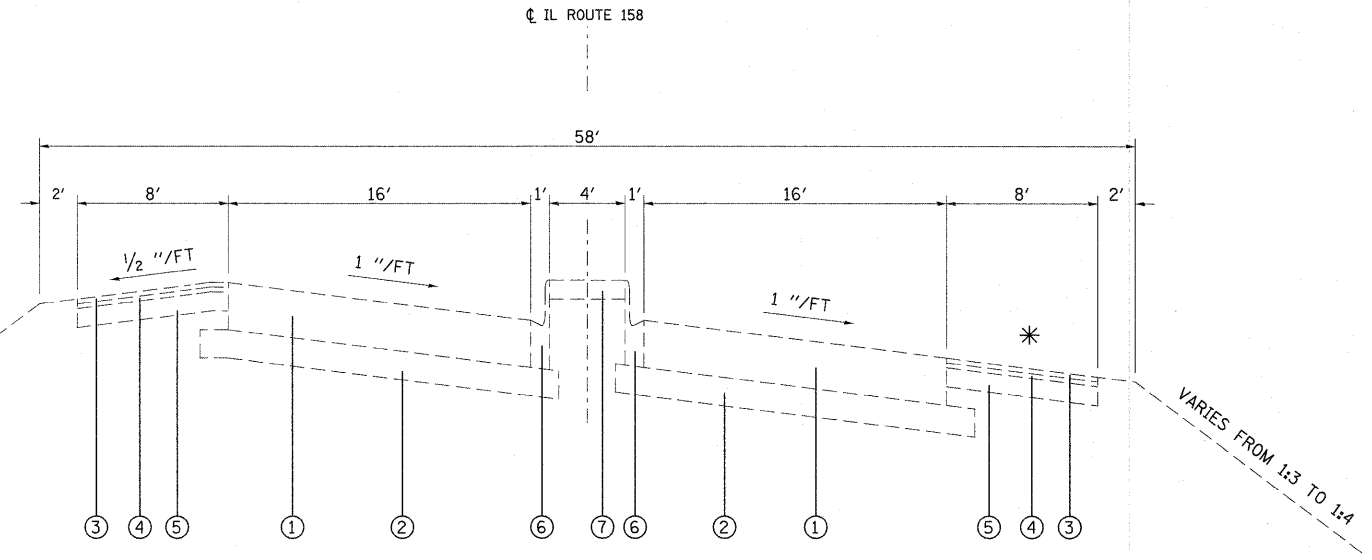

EXISTING SUPERELEVATED TYPICAL SECTION
 STA 117+55.54 TO STA 127+20

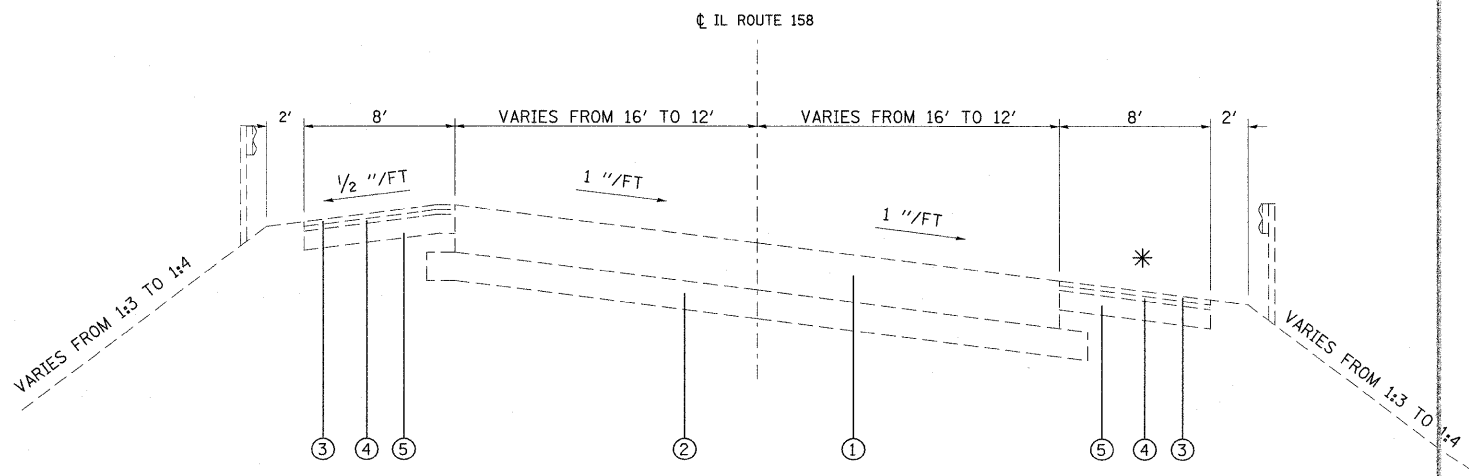

EXISTING SUPERELEVATED TYPICAL SECTION
 STA 127+20 TO STA 129+21.79
 STA 129+27.56 TO STA 138+50.58 Δ


GUARDRAIL:
 STA 127+20 TO STA 128+77

* ON THE INSIDE OF THE CURVE THE SHOULDER SLOPE SHALL BE THE SAME AS THE PAVEMENT SUPERELEVATION WITH A MINIMUM SLOPE OF 1/2" PER FOOT.


NOTE:
 EXISTING STRUCTURE FROM STA 109+80 TO STA 112+00

Rev. 2-11-10

FILE NAME =	USER NAME = owenbj	DESIGNED -	REVISED -	STATE OF ILLINOIS DEPARTMENT OF TRANSPORTATION	EXISTING TYPICAL SECTIONS	F.A.P. RTE.	SECTION	COUNTY	TOTAL SHEETS	SHEET NO.	
ct:\pw\work\midot\owenbj\dms52558\p1n200865.dgn		DRAWN -	REVISED -			809	67-1HBR	MONROE	144	6	
PLOT SCALE = 50.0000' / IN.		CHECKED -	REVISED -			CONTRACT NO. 76977					
PLOT DATE = 2/5/2010		DATE -	REVISED -			FED. ROAD DIST. NO. ILLINOIS FED. AID PROJECT					
						SCALE:	SHEET NO. OF SHEETS	STA.	TO STA.		

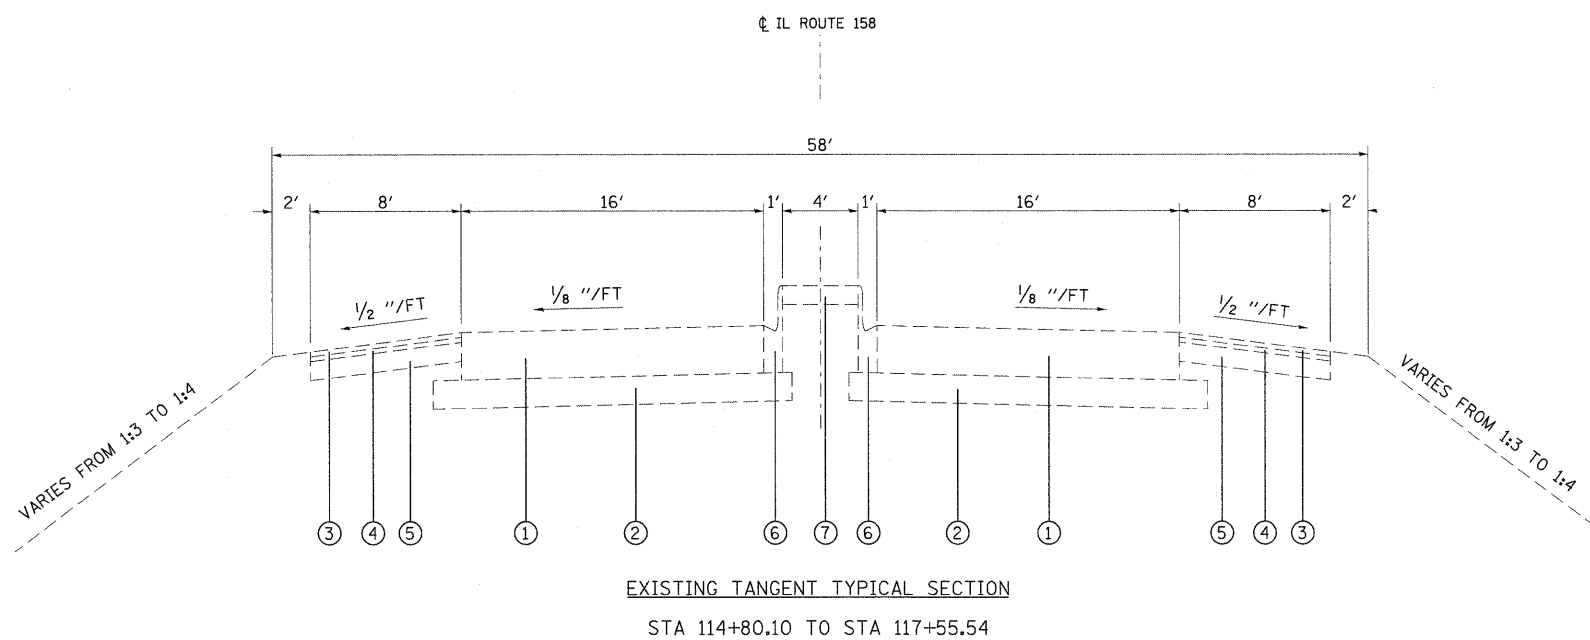


- LEGEND
- ① EXISTING PORTLAND CEMENT CONCRETE PAVEMENT - 10"
 - ② EXISTING SUB-BASE GRANULAR MATERIAL, TYPE A - 6"
 - ③ EXISTING BITUMINOUS CONCRETE SURFACE COURSE, SUB-CLASS I-11 (SHOULDERS) - 1 1/2 "
 - ④ EXISTING BITUMINOUS CONCRETE BINDER COURSE (SHOULDERS) - 1 1/2 "
 - ⑤ EXISTING STABILIZED SHOULDERS
 - ⑥ EXISTING COMBINATION CONCRETE CURB AND GUTTER, TYPE B-9.06
 - ⑦ EXISTING PORTLAND CEMENT CONCRETE MEDIAN SURFACE - 4"
 - ⑧ PROPOSED HMA SURFACE COURSE - 1 1/2 "
 - ⑨ PROPOSED LEVELING BINDER - 1"
 - ⑩ PROPOSED HMA BINDER COURSE - VARIES FROM 1.25" TO 36.2" [△]
 - ⑪ PROPOSED HMA BASE COURSE - 11"
 - ⑫ PROPOSED HMA BASE COURSE - 10"
 - ⑬ PROPOSED HMA SHOULDER
 - ⑭ PROPOSED COMBINATION CURB AND GUTTER, TYPE B-9.06
 - ⑮ PROPOSED CONCRETE MEDIAN SURFACE - 4"
 - ⑯ PROPOSED GUARDRAIL
 - ⑰ PROPOSED AGGREGATE WEDGE SHOULDER, TYPE B
 - ⑱ PROPOSED RAVED SHOULDER REMOVAL
 - ⑲ PROPOSED PAVEMENT REMOVAL (AFTER STAGE CONSTRUCTION) [△]

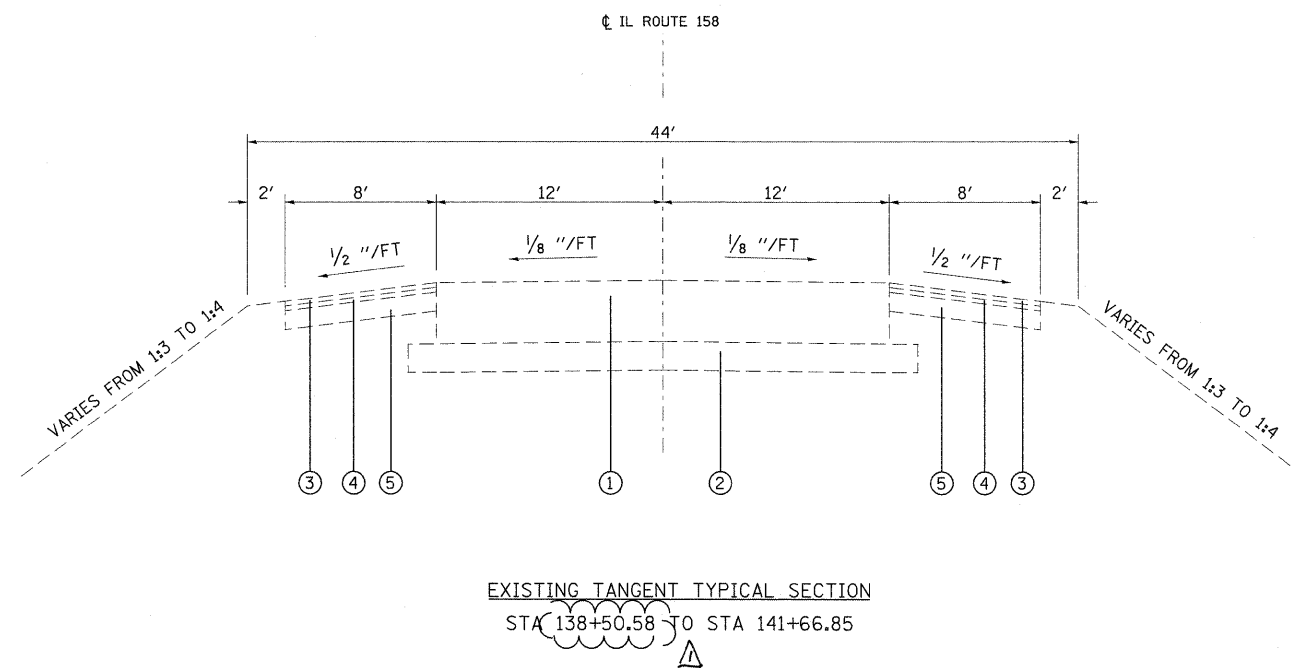

FILE NAME =	USER NAME = owenbj	DESIGNED -	REVISED -	STATE OF ILLINOIS DEPARTMENT OF TRANSPORTATION	EXISTING TYPICAL SECTIONS			F.A.P. RTE.	SECTION	COUNTY	TOTAL SHEETS	SHEET NO.
ca:\pw\work\p1dot\owenbj\dms52558\p1n2006a.dgn	PLOT SCALE = 50.0000' / IN.	DRAWN -	REVISED -					809	67-1HBR	MONROE	144	7
PLOT DATE = 2/5/2010	DATE -	CHECKED -	REVISED -		SCALE: SHEET NO. OF SHEETS STA. TO STA.			CONTRACT NO. 76977				
								ILLINOIS FED. AID PROJECT				

Rev. 7-11-10

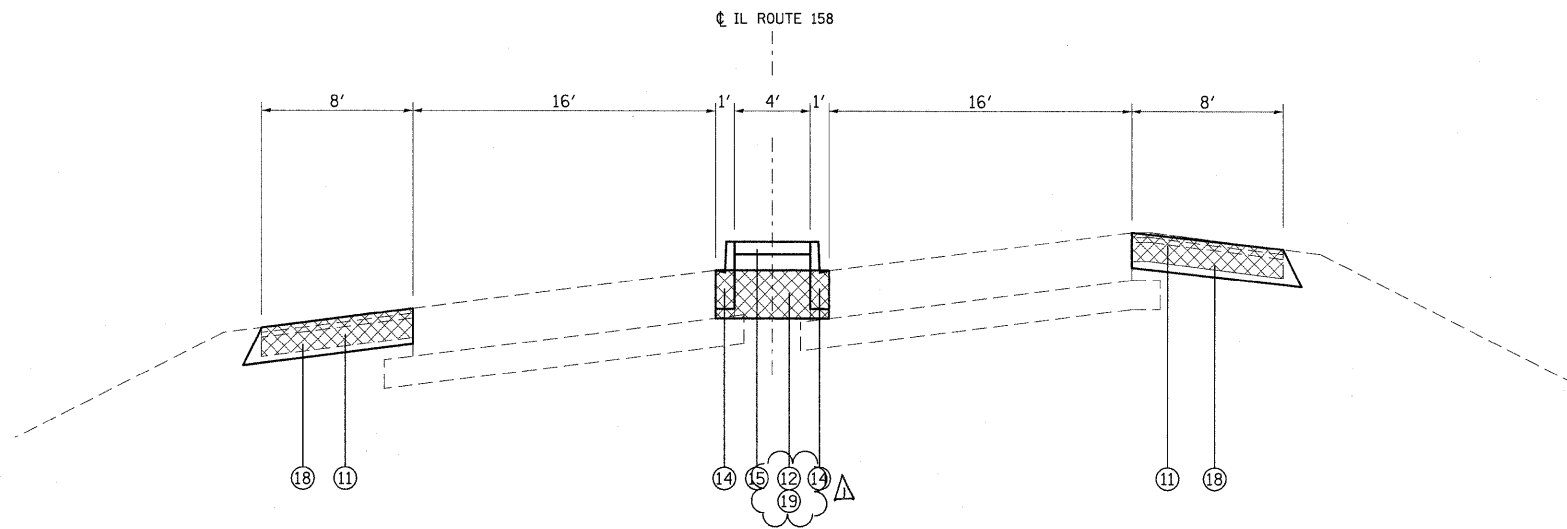

PROPOSED SUPERELEVATED TYPICAL SECTION
STA 103+20 TO STA 106+28.65

MIXTURE CHART


MIXTURE USE	SURFACE	LEVEL BINDER	BINDER / BASE CRS
AC/PG	PG 64-22	PG 64-22	PG 64-22
RAP % (MAX)	10%	15%	15%
DESIGN AIR VOIDS	4.0% @ Ndes=70	4.0% @ Ndes=70	4.0% @ Ndes=70
MIX COMPOSITION (GRADATION MIXTURE)		IL 12.5	IL 19.0
FRICITION AGG	MIXTURE "D"	MIXTURE "C"	MIXTURE "B"

TOP LIFT SHOULDERS - DESIGN THIS MIX AT 2.0% VOIDS AND ADD ASPHALT TO REDUCE VOIDS TO 1.5%.


PLAN QUANTITIES FOR HOT-MIX ASPHALT SURFACE COURSE ITEMS ARE CALCULATED USING A UNIT WEIGHT OF 112 LB/SQ YD/IN.

LEGEND

- ① EXISTING PORTLAND CEMENT CONCRETE PAVEMENT - 10"
- ② EXISTING SUB-BASE GRANULAR MATERIAL, TYPE A - 6"
- ③ EXISTING BITUMINOUS CONCRETE SURFACE COURSE, SUB-CLASS I-11 (SHOULDERS) - 1 1/2 "
- ④ EXISTING BITUMINOUS CONCRETE BINDER COURSE (SHOULDERS) - 1 1/2 "
- ⑤ EXISTING STABILIZED SHOULDERS
- ⑥ EXISTING COMBINATION CONCRETE CURB AND GUTTER, TYPE B-9.06
- ⑦ EXISTING PORTLAND CEMENT CONCRETE MEDIAN SURFACE - 4"
- ⑧ PROPOSED HMA SURFACE COURSE - 1 1/2 "
- ⑨ PROPOSED LEVELING BINDER - 1"
- ⑩ PROPOSED HMA BINDER COURSE - VARIES FROM 1.25" TO 36.2" Δ
- ⑪ PROPOSED HMA BASE COURSE - 11"
- ⑫ PROPOSED HMA BASE COURSE - 10"
- ⑬ PROPOSED HMA SHOULDER
- ⑭ PROPOSED COMBINATION CURB AND GUTTER, TYPE B-9.06
- ⑮ PROPOSED CONCRETE MEDIAN SURFACE - 4"
- ⑯ PROPOSED GUARDRAIL
- ⑰ PROPOSED AGGREGATE WEDGE SHOULDER, TYPE B
- ⑱ PROPOSED PAVED SHOULDER REMOVAL
- ⑲ PROPOSED PAVEMENT REMOVAL (AFTER STAGE CONSTRUCTION) Δ

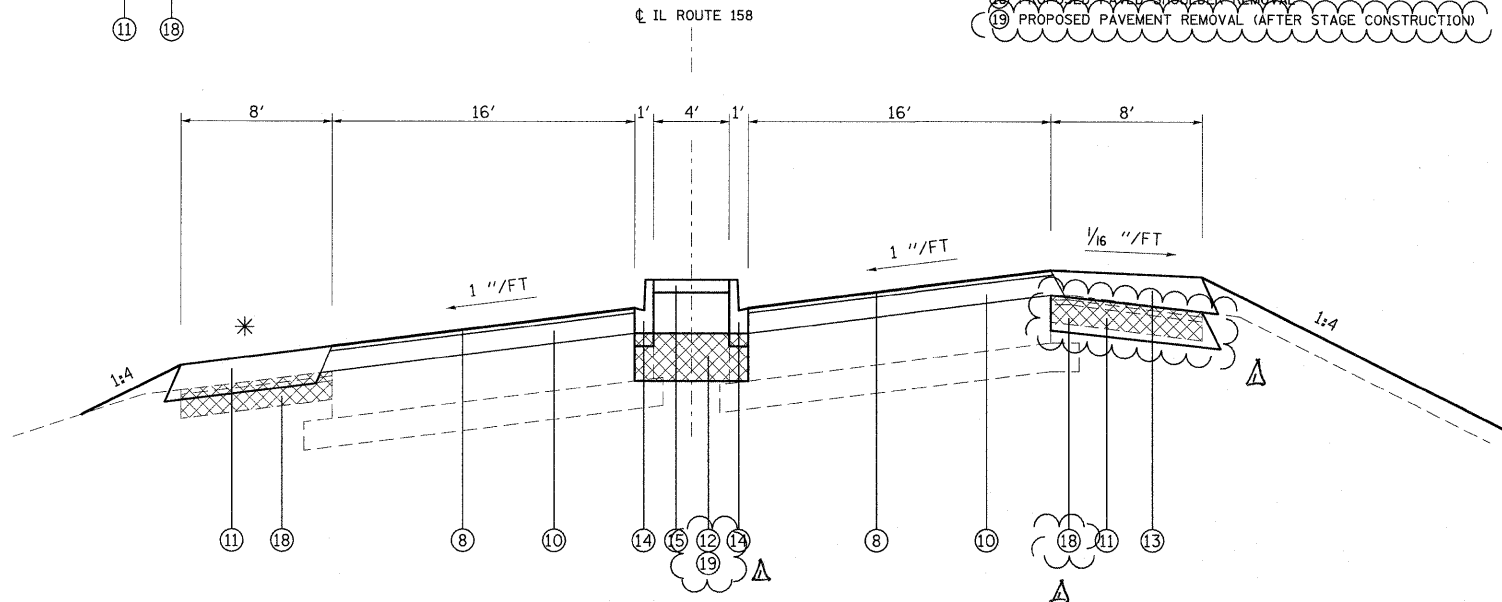

PROPOSED SUPERELEVATED TYPICAL SECTION
STA 106+28.65 TO STA 107+00

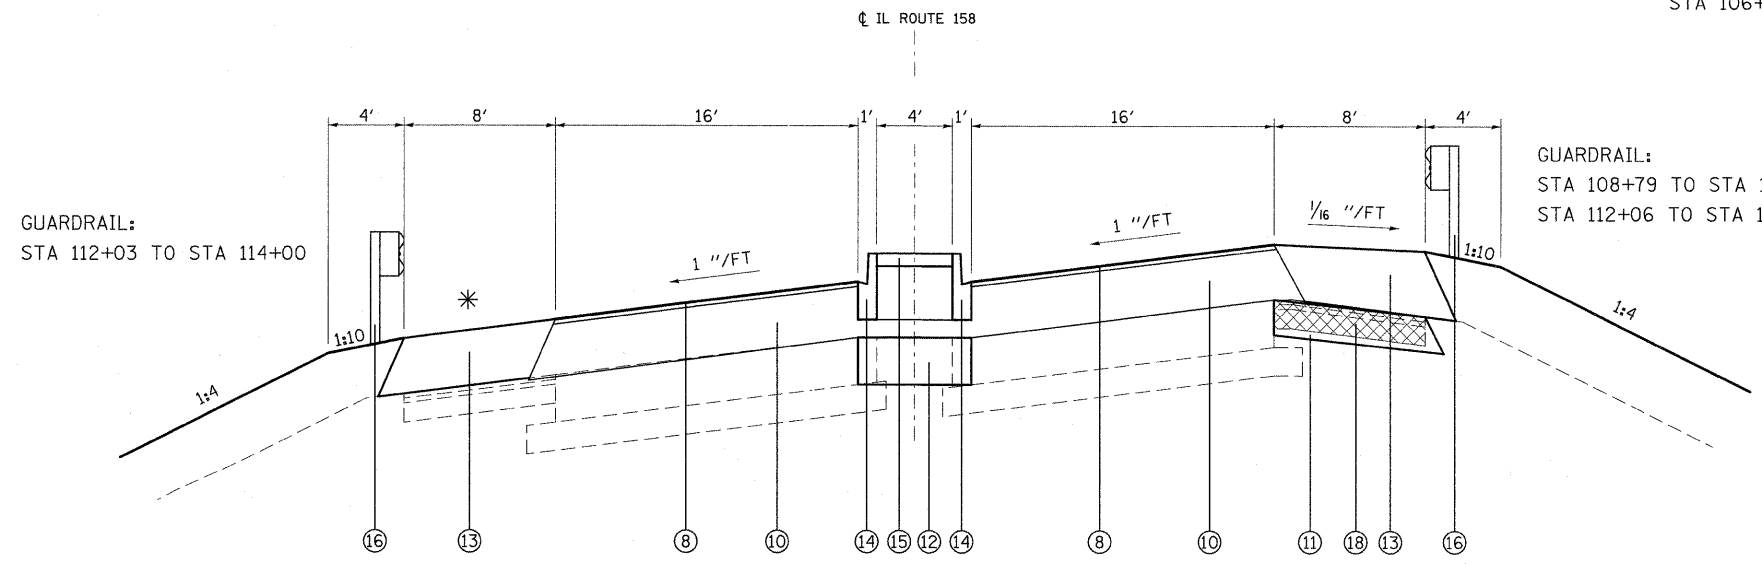


PROPOSED SUPERELEVATED TYPICAL SECTION
STA 107+00 TO STA 109+67.01
STA 112+30.45 TO STA 114+00

GUARDRAIL:
STA 108+79 TO STA 109+94
STA 112+06 TO STA 113+00


- * ON THE INSIDE OF THE CURVE THE SHOULDER SLOPE SHALL BE THE SAME AS THE PAVEMENT SUPERELEVATION WITH A MINIMUM SLOPE OF 1/2" PER FOOT.
- ** HMA BASE COURSE - 11" ENDS AT STA 119+00
HMA SHOULDER - 6" FROM STA 119+00 TO STA 127+20

NOTE:
PROPOSED WEST BRIDGE APPROACH PAVEMENT FROM STA 109+76.01 TO STA 110+02.98
PROPOSED STRUCTURE FROM STA 110+02.98 TO STA 111+94.45
PROPOSED EAST BRIDGE APPROACH PAVEMENT FROM STA 111+94.45 TO STA 112+24.45

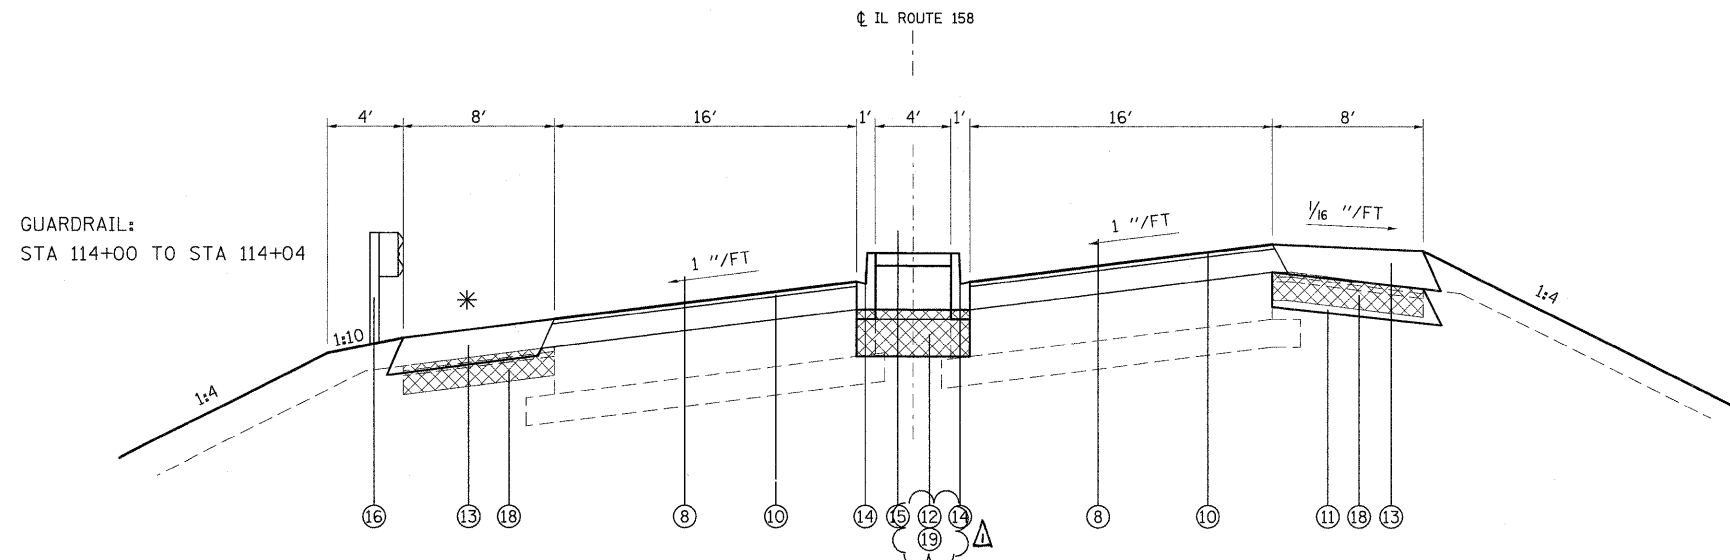


PROPOSED SUPERELEVATED TYPICAL SECTION
STA 114+00 TO STA 114+80.10
SUPERELEVATION TRANSITION BEGINS AT STA. 114+29.6

- LEGEND
- ① EXISTING PORTLAND CEMENT CONCRETE PAVEMENT - 10"
 - ② EXISTING SUB-BASE GRANULAR MATERIAL, TYPE A - 6"
 - ③ EXISTING BITUMINOUS CONCRETE SURFACE COURSE, SUB-CLASS I-11 (SHOULDERS) - 1 1/2"
 - ④ EXISTING BITUMINOUS CONCRETE BINDER COURSE (SHOULDERS) - 1 1/2"
 - ⑤ EXISTING STABILIZED SHOULDERS
 - ⑥ EXISTING COMBINATION CONCRETE CURB AND GUTTER, TYPE B-9.06
 - ⑦ EXISTING PORTLAND CEMENT CONCRETE MEDIAN SURFACE - 4"
 - ⑧ PROPOSED HMA SURFACE COURSE - 1 1/2"
 - ⑨ PROPOSED LEVELING BINDER - 1"
 - ⑩ PROPOSED HMA BINDER COURSE - VARIES FROM 1.25" TO 36.2"
 - ⑪ PROPOSED HMA BASE COURSE - 11"
 - ⑫ PROPOSED HMA BASE COURSE - 10"
 - ⑬ PROPOSED HMA SHOULDER
 - ⑭ PROPOSED COMBINATION CURB AND GUTTER, TYPE B-9.06
 - ⑮ PROPOSED CONCRETE MEDIAN SURFACE - 4"
 - ⑯ PROPOSED GUARDRAIL
 - ⑰ PROPOSED AGGREGATE WEDGE SHOULDER, TYPE B
 - ⑱ PROPOSED RAVED SHOULDER REMOVAL
 - ⚠ PROPOSED PAVEMENT REMOVAL (AFTER STAGE CONSTRUCTION)

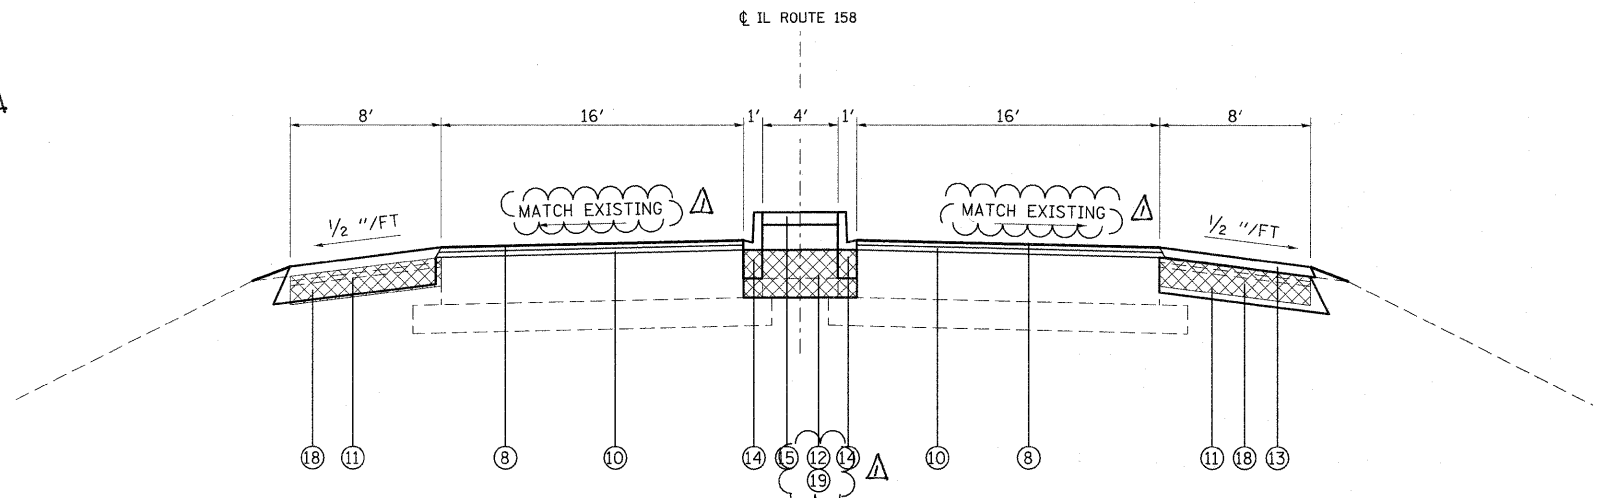

PROPOSED TANGENT TYPICAL SECTION
STA 114+80.10 TO STA 115+00

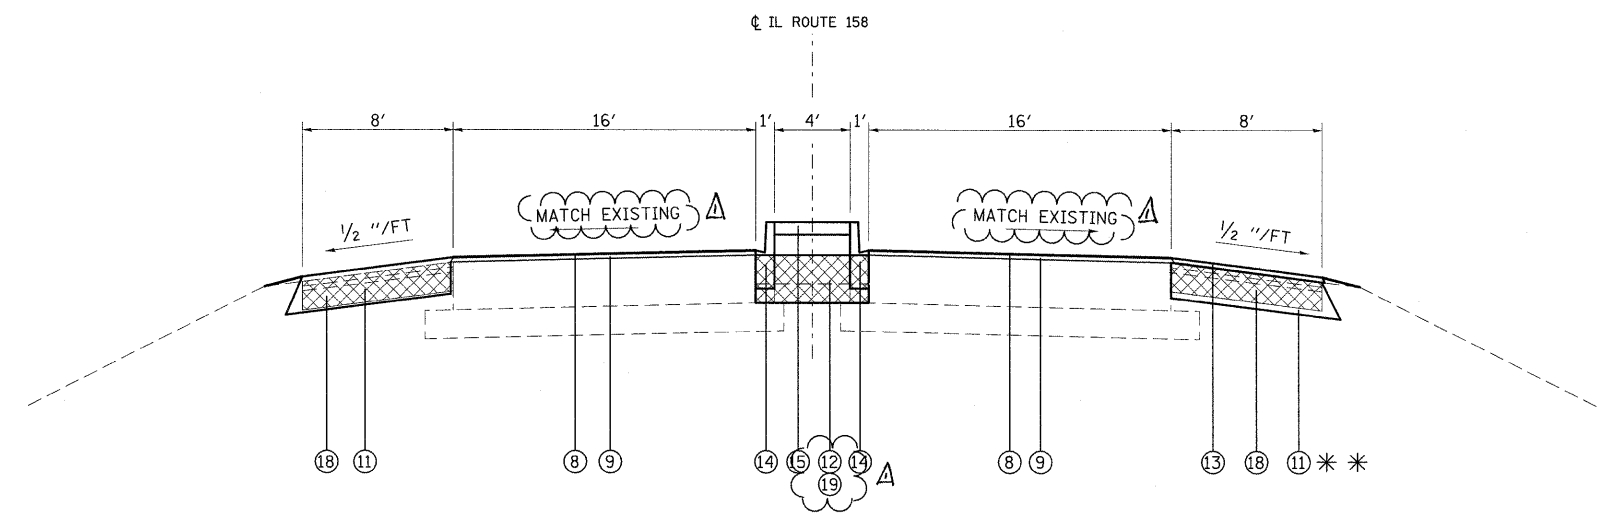


PROPOSED TANGENT TYPICAL SECTION
STA 115+00 TO STA 117+55.54
* * HMA BASE COURSE - 11" ENDS AT STA 116+50

* ON THE INSIDE OF THE CURVE THE SHOULDER SLOPE SHALL BE THE SAME AS THE PAVEMENT SUPERELEVATION WITH A MINIMUM SLOPE OF 1/2" PER FOOT.

FILE NAME =	USER NAME = owenbj	DESIGNED -	REVISED -	STATE OF ILLINOIS DEPARTMENT OF TRANSPORTATION	PROPOSED TYPICAL SECTIONS			F.A.P. RTE.	SECTION	COUNTY	TOTAL SHEETS	SHEET NO.
ct:\pw\work\p\idot\owenbj\dms52558\p\in\00005a.dgn	PLOT SCALE = 50.0000' / IN.	DRAWN -	REVISED -					809	67-1HBR	MONROE	144	9
PLOT DATE = 2/5/2010	DATE -	CHECKED -	REVISED -		CONTRACT NO. 76977			ILLINOIS FED. AID PROJECT				
		DATE -	REVISED -		SCALE:	SHEET NO. OF SHEETS	STA. TO STA.					

Rev. 2-11-10

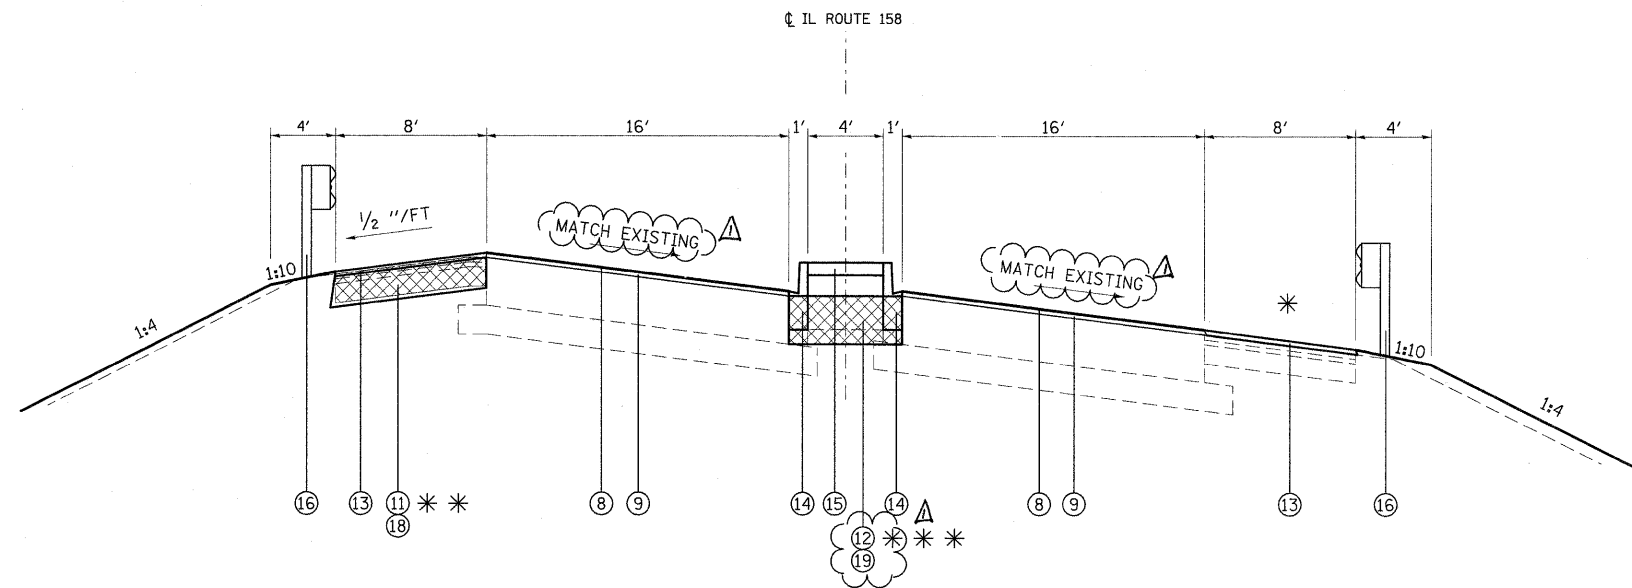


- LEGEND
- ① EXISTING PORTLAND CEMENT CONCRETE PAVEMENT - 10"
 - ② EXISTING SUB-BASE GRANULAR MATERIAL, TYPE A - 6"
 - ③ EXISTING BITUMINOUS CONCRETE SURFACE COURSE, SUB-CLASS I-11 (SHOULDERS) - 1 1/2 "
 - ④ EXISTING BITUMINOUS CONCRETE BINDER COURSE (SHOULDERS) - 1 1/2 "
 - ⑤ EXISTING STABILIZED SHOULDERS
 - ⑥ EXISTING COMBINATION CONCRETE CURB AND GUTTER, TYPE B-9.06
 - ⑦ EXISTING PORTLAND CEMENT CONCRETE MEDIAN SURFACE - 4"
 - ⑧ PROPOSED HMA SURFACE COURSE - 1 1/2 "
 - ⑨ PROPOSED LEVELING BINDER - 1"
 - ⑩ PROPOSED HMA BINDER COURSE - VARIES FROM 1.25" TO 36.2"
 - ⑪ PROPOSED HMA BASE COURSE - 11"
 - ⑫ PROPOSED HMA BASE COURSE - 10"
 - ⑬ PROPOSED HMA SHOULDER
 - ⑭ PROPOSED COMBINATION CURB AND GUTTER, TYPE B-9.06
 - ⑮ PROPOSED CONCRETE MEDIAN SURFACE - 4"
 - ⑯ PROPOSED GUARDRAIL
 - ⑰ PROPOSED AGGREGATE WEDGE SHOULDER, TYPE B
 - ⑱ PROPOSED PAVED SHOULDER REMOVAL
 - ⑲ PROPOSED PAVEMENT REMOVAL (AFTER STAGE CONSTRUCTION)

GUARDRAIL:
 STA 126+00 TO STA 127+20
 ALSO ON RAMP

PROPOSED SUPERELEVATED TYPICAL SECTION
 STA 117+55.54 TO STA 127+20


* * HMA BASE COURSE - 11" AND PAVED SHOULDER REMOVAL END AT STA 119+00.
 HMA SHOULDER FROM STA 119+00 TO STA 127+20

* * * HMA BASE COURSE - 10" ENDS AT STA 119+00

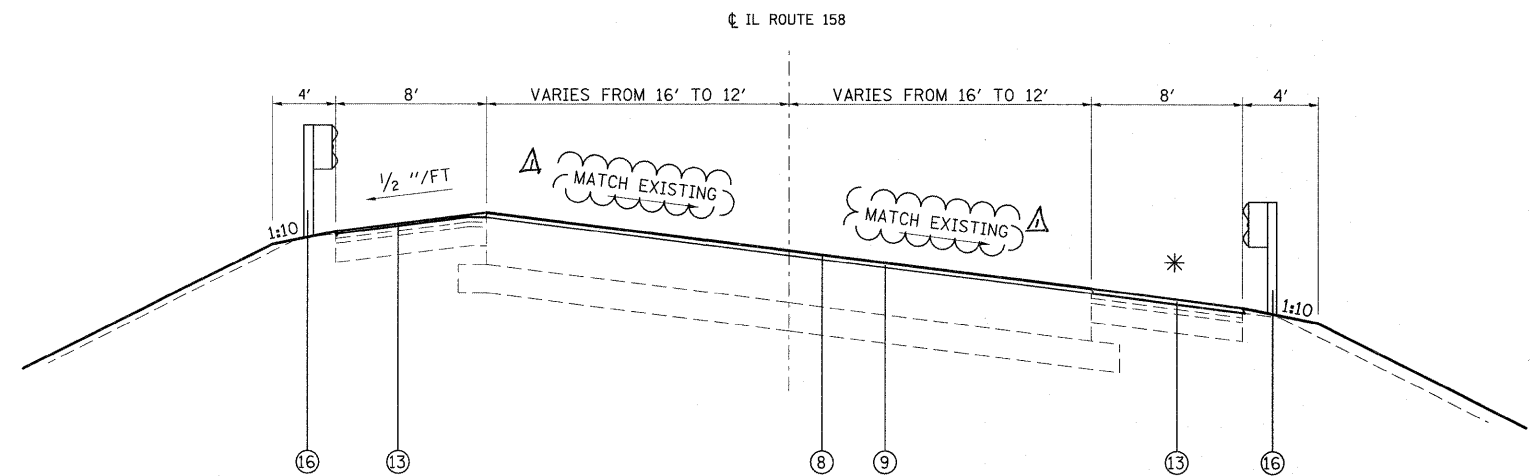

PROPOSED SUPERELEVATED TYPICAL SECTION
 STA 127+20 TO STA 129+21.79
 STA 129+27.56 TO STA 140+00

GUARDRAIL:
 STA 127+20 TO STA 128+72

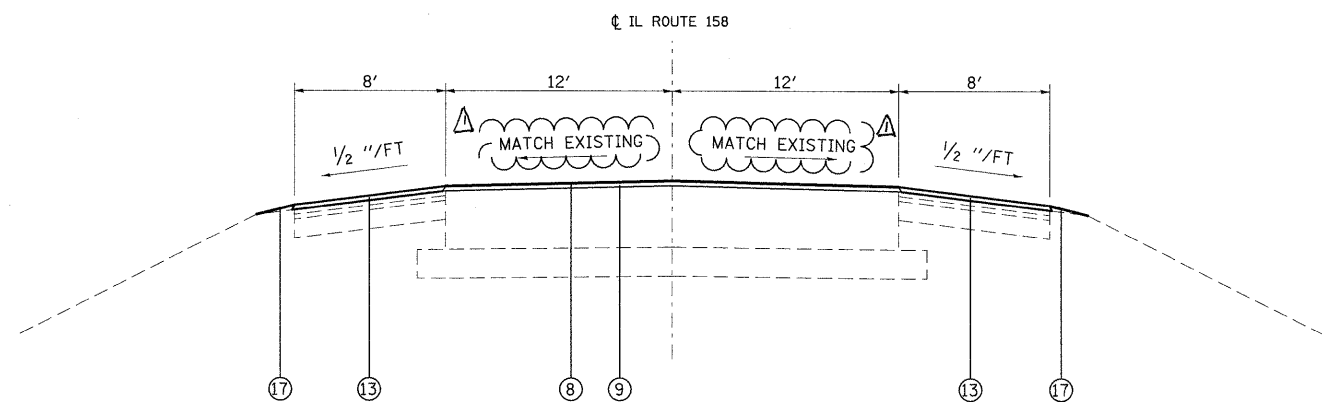

PROPOSED TANGENT TYPICAL SECTION
 STA 129+21.79 TO STA 129+27.59
 STA 140+00 TO STA 141+66.85

FILE NAME =	USER NAME = owerb.j	DESIGNED -	REVISED -	STATE OF ILLINOIS DEPARTMENT OF TRANSPORTATION	PROPOSED TYPICAL SECTIONS			F.A.P. RTE.	SECTION	COUNTY	TOTAL SHEETS	SHEET NO.
cs:\pw\work\p1\dot\owenb.j\dms52558\p1\000026a.dgn	PLOT SCALE = 50.0000' / IN.	DRAWN -	REVISED -					809	67-1HBR	MONROE	144	10
PLOT DATE = 2/5/2010	DATE -	CHECKED -	REVISED -		CONTRACT NO. 76977			FED. ROAD DIST. NO. ILLINOIS FED. AID PROJECT				
					SCALE:	SHEET NO. OF SHEETS	STA. TO STA.					

Rev. 2-11-10

STAGING SCHEDULE

LOCATION	HOT-MIX ASPHALT BASE COURSE, 10"	HOT-MIX ASPHALT BASE COURSE, 11"	PAVEMENT REMOVAL	TEMPORARY CONCRETE BARRIER	RELOCATE TEMPORARY CONCRETE BARRIER	IMPACT ATTENUATOR, TEMPORARY (NON-REDIRECTIVE)	IMPACT ATTENUATOR, RELOCATE (NON-REDIRECTIVE)	TEMPORARY PAVEMENT MARKING - LINE 6"
	SQ YD	SQ YD	SQ YD	FOOT	FOOT	EACH	EACH	FOOT
PRE-STAGE I		990						
STAGE I	880	4780	139	1025		4		1325
STAGE II			115		1000		2	1000
IL 3 - NB				150				
IL 3 - SB				150				
TOTAL	880	5770	254 *	1325	1000	4	2	2325

* NOT A TOTAL QUANTITY. SEE REMOVAL SCHEDULE.

GUARDRAIL SCHEDULE

LOCATION	GUARDRAIL REMOVAL	STEEL PLATE BEAM GUARDRAIL, TYPE A, 6 FT POSTS	STEEL PLATE BEAM GUARDRAIL, TYPE A, 9 FT POSTS	TRAFFIC BARRIER TERMINAL, TYPE 1, (SPECIAL) TANGENT	TRAFFIC BARRIER TERMINAL, TYPE 6	TRAFFIC BARRIER TERMINAL, TYPE 2	GUARDRAIL MARKERS, TYPE A	BARRIER WALL MARKERS, TYPE B	BARRIER WALL MARKERS, TYPE C	TERMINAL MARKER - DIRECT APPLIED
	FOOT	FOOT	FOOT	EACH	EACH	EACH	EACH	EACH	EACH	EACH
IL 158										
NORTH SIDE							1	3	3	
SOUTH SIDE							2	3	3	
NW QUADRANT					1					
NE QUADRANT	79			1	1					1
SW QUADRANT	81	25		1	1					1
SE QUADRANT	194			1	1					1
IL 3										
WEST SIDE	424	212.5		1		1	5			1
EAST SIDE	313	287.5		1		1	4			1
RAMPS										
NB IL 3 TO EB IL 158	2431		2325	2			20			2
WB IL 158 TO NB IL 3	1587		1525	1		1	17			1
TOTAL	5109	525	3850	8	4	3	49	6	6	8

TEMPORARY RAMP SCHEDULE

LOCATION	WIDTH	LENGTH	TEMPORARY RAMP
	FOOT	FOOT	SQ YD
STA 106+28	32	5	18
STA 109+67	32	5	18
STA 112+24	32	5	18
STA 115+00	32	5	18
TOTAL			72

Rev. 2-11-10

PAVEMENT MARKING SCHEDULE

LOCATION	THERMOPLASTIC PAVEMENT MARKING						POLYUREA PAVEMENT MARKING			PAINT PAVEMENT MARKING -	PAINT PAVEMENT MARKING - CURB		PAVEMENT MARKING REMOVAL	RAISED REFLECTIVE PAVEMENT MARKER REMOVAL		RAISED REFLECTIVE PAVEMENT MARKER		PRISMATIC CURB REFLECTOR	SHORT TERM PAVEMENT MARKING	TEMPORARY PAVEMENT MARKING				WORK ZONE PAVEMENT MARKING REMOVAL	
	SKIP-DASH CENTERLINE 4" YELLOW		SOLID CENTERLINE 4" YELLOW		EDGE LINE 4" WHITE		SOLID CHANNELIZING 8" WHITE	SOLID CENTERLINE 4" WHITE		RAISED MEDIAN	LT	RT	SQ FT	EACH		1-WAY CRYSTAL	2-WAY AMBER	EACH	FOOT	4" YELLOW	4" YELLOW	4" WHITE		SQ FT	
	STATION	TO STATION	FOOT	FOOT	FOOT	FOOT	FOOT	FOOT	FOOT	FOOT	FOOT	FOOT	FOOT	FOOT	FOOT	FOOT	FOOT	FOOT	FOOT	FOOT	FOOT	FOOT	FOOT	FOOT	
STA 103+20.00	TO STA 108+00.00		960	480	480							320		640				24	105		960	480	480	675	
STA 108+00.00	TO STA 109+73.00		347	173	173							128		231				9	38		347	173	173	244	
STA 109+73.00	TO STA 112+24.50							503	251.5	251.5		160		335				13	56		503	251.5	251.5	354	
STA 112+24.50	TO STA 114+00.00		351	175	175							112		234				9	39		351	175	175	247	
STA 114+00.00	TO STA 115+00.00		200	100	100									133				5	22		200	100	100	141	
STA 115+00.00	TO STA 119+00.00		800	400	20	380							32	660				20	89		800	400	20	436	
STA 119+00.00	TO STA 120+00.00		200	45		142							64	176	5	5		5	22		200	45		89	
STA 120+00.00	TO STA 126+00.00		1200		6	381							400	656	41	41		30	132		1200		6	446	
STA 126+00.00	TO STA 132+00.00		1200	575	600					47			64	792	3		3	6	89		1200	575	600	821	
STA 132+00.00	TO STA 138+00.00	130	700	600	600									677	7		7	79	130	700	600	600	703		
STA 138+00.00	TO STA 142+00.00	100	400	400	400									433	5		5	52	100	400	400	400	451		
STA 63+25.00	TO STA 73+85.00				1061	460								660					138				1061	399	
STA 19+74.00	TO STA 26+62.00			689		442								524					89			689		259	
SUB-TOTAL		230	6358	3637	3615		503	251.5	252			720	560			46	15				230	6861	3889	3867	
TOTAL			13840			1805		1006		47		1280	6152		61		61		120	950		14846			5265

PAVEMENT PATCHING SCHEDULE - CLASS B

LOCATION	SIZE		CLASS B PATCHING 10" TYPE II	CLASS B PATCHING 10" TYPE III	CLASS B PATCHING 10" TYPE IV	SAW CUT	DOWEL BARS 1-1/2"	PVMT FABRIC
	LENGTH	WIDTH						
	FOOT	FOOT						
IL 158 EASTBOUND								
112+50 *	4	16	7.1			56	27	
115+25	8	16	14.2			64	28	
116+30	8	16	14.2			64	28	
117+10	8	16	14.2			64	28	
119+00	8	12	10.7			52	20	
120+40	6	12	8.0			48	20	
120+50	6	16	10.7			60	28	
122+00	8	16	14.2			64	28	
123+75	25	16			45	98	28	44
125+25	8	18		16		70	32	16
127+30	8	15	13.2			61	26	
128+10	8	14	12.4			58	24	
130+20	8	13	11.6			55	22	
IL 158 WESTBOUND								
115+25	8	16	14.2			64	28	
116+30	8	16	14.2			64	28	
117+10	8	16	14.2			64	28	
123+85	8	16	14.2			64	28	
123+85	8	16	14.2			64	28	
126+15	12	16		21		72	28	
130+20	8	13	11.6			55	22	
TOTAL			213	37	45	1261	529	60

* PAVEMENT PATCH NECESSARY FOR STORM SEWER PLACEMENT.

PARTIAL DEPTH PATCHING SCHEDULE

LOCATION	SIDE	SIZE		PARTIAL DEPTH REMOVAL 3"	PARTIAL DEPTH PATCHING
		LENGTH	WIDTH		
		FOOT	FOOT		
IL 158 EASTBOUND					
117+50	RT	475	2	105.6	17.7
117+95	CNTR	6	6	4.0	0.7
118+05	CNTR	6	6	4.0	0.7
119+40	RT	20	6	13.3	2.2
120+60	RT	1075	2	238.9	40.1
121+00	CNTR	110	4	48.9	8.2
122+30	CNTR	4	4	1.8	0.3
122+50	RT	120	2	26.7	4.5
123+40	RT	2	10	2.2	0.4
125+00	CNTR	4	4	1.8	0.3
127+10	CNTR	4	4	1.8	0.3
127+60	LT	16	8	14.2	2.4
128+60	CNTR	20	2	4.4	0.7
128+70	LT	4	4	1.8	0.3
129+60	CNTR	4	4	1.8	0.3
129+80	CNTR	4	4	1.8	0.3
131+95	CNTR	2	12	2.7	0.4
135+00	CNTR	2	12	2.7	0.4
136+50	CNTR	2	12	2.7	0.4
IL 15 WESTBOUND					
114+75	CNTR	4	4	1.8	0.3
115+45	CNTR	4	4	1.8	0.3
124+50	RT	300	2	66.7	11.2
125+00	CNTR	2	16	3.6	0.6
125+10	CNTR	2	16	3.6	0.6
127+90	LT	2	8	1.8	0.3
129+00	CNTR	2	14	3.1	0.5
135+00	CNTR	2	12	2.7	0.4
135+65	CNTR	2	12	2.7	0.4
TOTAL				568	96
ROUNDING				570	100

REMOVAL SCHEDULE

LOCATION	STATION	TO STATION	PAVEMENT REMOVAL SQ YD	COMBINATION CURB AND GUTTER REMOVAL FOOT	MEDIAN REMOVAL SQ FT	PAVED SHOULDER REMOVAL	
						LEFT SQ YD	RIGHT SQ YD
						IL 158	
STA 103+20	TO STA 104+00		53.2	160	400	71	71
STA 104+00	TO STA 105+00		66.6	200	500	89	89
STA 105+00	TO STA 106+00		66.6	200	500	89	89
STA 106+00	TO STA 107+00		66.6	200	500	89	89
STA 107+00	TO STA 108+00			200	500		89
STA 108+00	TO STA 109+00			200	500		89
STA 109+00	TO STA 109+67			160	400		71
STRUCTURE							
STA 112+30	TO STA 113+00			200	500		89
STA 113+00	TO STA 114+00			200	500		89
STA 114+00	TO STA 115+00		66.6	200	500	89	89
STA 115+00	TO STA 116+00		66.6	200	500	89	89
STA 116+00	TO STA 117+00		66.6	200	500	89	44
STA 117+00	TO STA 118+00		66.6	200	500	89	
STA 118+00	TO STA 119+00		66.6	200	500	89	
STA 119+00	TO STA 120+00			200	500		
STA 120+00	TO STA 121+00			200	500		
STA 121+00	TO STA 122+00			200	500		
STA 122+00	TO STA 123+00			200	500		
STA 123+00	TO STA 124+00			200	500		
STA 124+00	TO STA 125+00			200	500		
STA 125+00	TO STA 126+00			200	500		
STA 126+00	TO STA 127+00			200	500		
STA 127+00	TO STA 128+00			40	100		
SUB-TOTAL						783	987
TOTAL			586 *	4360	10900		1770

* NOT A TOTAL QUANTITY. SEE STAGING SCHEDULE.

FILE NAME =
 c:\pwwork\pwwork\owenbj\dms52558\p1n00806a.dgn
 PLOT SCALE = 50.0000' / IN.
 PLOT DATE = 2/5/2010

USER NAME = owenbj
 DESIGNED -
 DRAWN -
 CHECKED -
 DATE -

REVISED -
 REVISED -
 REVISED -
 REVISED -

STATE OF ILLINOIS
 DEPARTMENT OF TRANSPORTATION

SCHEDULE OF QUANTITIES

SCALE: SHEET NO. OF SHEETS STA. TO STA. FED. ROAD DIST. NO. ILLINOIS FED. AID PROJECT

Rev. 2-11-10
 SECTION 67-1HBR COUNTY MONROE TOTAL SHEETS 144 SHEET NO. 13 CONTRACT NO. 76977

RESURFACING SCHEDULE

LOCATION	STATION TO	STATION	BITUMINOUS MATERIALS (PRIME COAT) TON	AGGREGATE (PRIME COAT) TON	LEVELING BINDER TON	HOT-MIX ASPHALT BINDER COURSE TON	HOT-MIX ASPHALT SURFACE COURSE TON	HOT-MIX ASPHALT SURFACE REMOVAL-BUTT JOINT SQ YDS	HOT-MIX ASPHALT SHOULDERS		HOT-MIX ASPHALT SHOULDERS (2 1/2")		HOT-MIX ASPHALT SHOULDERS (1 1/2") TONS	AGGREGATE WEDGE SHOULDERS, TYPE B		
									LEFT TONS	RIGHT TONS	LEFT TONS	RIGHT TONS		LEFT TONS	RIGHT TONS	
IL 158																
STA	106+29	TO STA	107+00	0.08	0.38		29.3	23.0	88.9		43.0		5.3			
STA	107+00	TO STA	108+00	0.11	0.53		264.1	29.9		59	95.7		7.5			
STA	108+00	TO STA	109+00	0.11	0.53		522.3	29.9		123	142.9		7.5			
STA	109+00	TO STA	109+67	0.07	0.36		463.5	20.0		113	117.1		5.0			
STRUCTURE																
STA	112+30	TO STA	113+00	0.08	0.37		301.7	20.9		70	79.1		5.2			
STA	113+00	TO STA	114+00	0.11	0.53		197.3	29.9		46	66.4		7.5			
STA	114+00	TO STA	115+00	0.11	0.53		41.3	29.9			33.6		7.5			
STA	115+00	TO STA	116+00	0.11	0.53	19.9		29.9								
STA	116+00	TO STA	117+00	0.11	0.53	19.9		29.9				5.4				
STA	117+00	TO STA	118+00	0.11	0.53	19.9		29.9				7.0				
STA	118+00	TO STA	119+00	0.11	0.53	19.9		29.9				3.7				
STA	119+00	TO STA	120+00	0.11	0.53	19.9		29.9			22.6	0.3				
STA	120+00	TO STA	121+00	0.11	0.53	19.9		29.9			24.9					
STA	121+00	TO STA	122+00	0.11	0.53	19.9		29.9			16.6					
STA	122+00	TO STA	123+00	0.11	0.53	19.9		29.9			8.3					
STA	123+00	TO STA	124+00	0.11	0.53	19.9		29.9			1.8					
STA	124+00	TO STA	125+00	0.11	0.53	19.9		29.9								
STA	125+00	TO STA	126+00	0.11	0.53	19.9		29.9				1.0				
STA	126+00	TO STA	127+00	0.11	0.53	19.9		29.9			7.1	12.5				
STA	127+00	TO STA	128+00	0.11	0.53	17.4		29.9			12.4	12.4				
STA	128+00	TO STA	129+00	0.11	0.51	17.4		29.9			9.6	9.3				
STA	129+00	TO STA	130+00	0.10	0.47	17.4		29.9			12.3	10.4				
STA	130+00	TO STA	131+00	0.10	0.47	16.4		26.9			8.8	8.7		0.9	0.9	
STA	131+00	TO STA	132+00	0.09	0.43	14.9		22.4			12.4	12.4		1.2	1.2	
STA	132+00	TO STA	133+00	0.08	0.40	14.9		22.4			12.4	12.4		1.2	1.2	
STA	133+00	TO STA	134+00	0.08	0.40	14.9		22.4			12.4	12.4		1.2	1.2	
STA	134+00	TO STA	135+00	0.08	0.40	14.9		22.4			12.4	12.4		1.2	1.2	
STA	135+00	TO STA	136+00	0.08	0.40	14.9		22.4			12.4	12.4		1.2	1.2	
STA	136+00	TO STA	137+00	0.08	0.40	14.9		22.4			12.4	12.4		1.2	1.2	
STA	137+00	TO STA	138+00	0.08	0.40	14.9		22.4			12.4	12.4		1.2	1.2	
STA	138+00	TO STA	139+00	0.08	0.40	14.9		22.4			12.4	12.4		1.2	1.2	
STA	139+00	TO STA	140+00	0.08	0.40	14.9		22.4			12.4	12.4		1.2	1.2	
STA	140+00	TO STA	141+00	0.08	0.40	14.9		22.4			12.4	12.4		1.2	1.2	
STA	141+00	TO STA	141+92	0.08	0.37	13.7		20.6	66.7		8.3	8.3		0.8	0.8	
RAMPS																
STA	19+55	TO STA	19+94									4.9				
STA	19+94	TO STA	23+30	0.10	0.49	18.3		27.4			41.8					
STA	23+30	TO STA	27+38	0.23	1.09	40.6		60.9			41.3					
STA	63+25	TO STA	64+15	0.05	0.24	9.0		13.4			7.8	11.2				
STA	64+15	TO STA	64+75	0.03	0.15	5.5		8.3			1.3	7.5				
STA	64+75	TO STA	67+90	0.15	0.71	26.5		39.7				39.2				
STA	67+90	TO STA	73+83	0.16	0.75	28.2		42.2				73.8				
TOTAL				4.06	19.45	598.7	1819.6	1095	155.6	411	578	354.3	335.2	45.4	14	14
ROUNDING				4.0	20	600	1820	1100	156			1725			30	

FILE NAME = c:\pwwork\pwwork\owenb\j\dms52558\p1r0026.dgn
 USER NAME = owenb
 PLOT SCALE = 50.0000' / 1"
 PLOT DATE = 2/5/2010

DESIGNED -
 DRAWN -
 CHECKED -
 DATE -

REVISED -
 REVISED -
 REVISED -
 REVISED -

STATE OF ILLINOIS
 DEPARTMENT OF TRANSPORTATION

SCHEDULE OF QUANTITIES

SCALE: SHEET NO. OF SHEETS STA. TO STA.

F.A.P. RTE. 809	SECTION 67-1HBR	COUNTY MONROE	TOTAL SHEETS 144	SHEET NO. 14
FED. ROAD DIST. NO. ILLINOIS FED. AID PROJECT			CONTRACT NO. 76977	

Rev. 2-11-10

CURB AND GUTTER AND MEDIAN SCHEDULE

LOCATION	COMB. CONCRETE CURB AND GUTTER TYPE B-9.06	CONCRETE MEDIAN SURFACE, 4 INCH
STATION	FOOT	SQ FT
STA 103+20 TO 108+00	960	2400
STA 108+00 TO 109+73	347	865
STA 112+24 TO 120+00	1553	3880
STA 120+00 TO 126+00	1200	3000
STA 126+00 TO 127+20	240	600
TOTAL	4300	10745

DRAINAGE SCHEDULE

LOCATION	INLETS TO BE ADJUSTED	FRAMES AND GRATES, TYPE 11	INLETS, TYPE A, TYPE 11 FRAME AND GRATE	REMOVING INLETS	PRECAST REINF. CONC. FLARED END SECTIONS 12"	STORM SEWERS, CLASS A, TYPE 1 12"
STATION	EACH	EACH	EACH	EACH	EACH	FOOT
STA 106+00	1	1				
STA 109+00	1	1				
STA 112+15				1		
STA 112+50			1		1	35
STA 114+00	1	1				
STA 115+00	1	1				
STA 117+18	1	1				
STA 120+18	1	1				
STA 123+17	1	1				
STA 125+17	1	1				
TOTAL	8	8	1	1	1	35

SUPERELEVATION SCHEDULE

STATION	PROFILE ELEVATION	RIGHT EDGE OF PAVEMENT ELEVATION	LEFT EDGE OF PAVEMENT ELEVATION
106+30.00	598.48	599.75	597.20
106+40.00	598.88	600.16	597.60
106+50.00	599.28	600.56	598.00
106+60.00	599.68	600.97	598.41
106+70.00	600.09	601.37	598.81
106+80.00	600.49	601.77	599.21
106+90.00	600.89	602.17	599.61
107+00.00	601.29	602.57	600.01
107+10.00	601.68	602.96	600.40
107+20.00	602.07	603.35	600.79
107+30.00	602.44	603.72	601.16
107+40.00	602.80	604.08	601.52
107+50.00	603.14	604.42	601.86
107+60.00	603.48	604.76	602.20
107+70.00	603.80	605.08	602.52
107+80.00	604.11	605.39	602.83
107+90.00	604.41	605.69	603.13
108+00.00	604.69	605.97	603.41
108+10.00	604.97	606.25	603.69
108+20.00	605.23	606.51	603.95
108+30.00	605.48	606.76	604.20
108+40.00	605.71	607.00	604.44
108+50.00	605.94	607.22	604.66
108+60.00	606.15	607.43	604.87
108+70.00	606.35	607.63	605.07
108+80.00	606.54	607.82	605.26
108+90.00	606.72	608.00	605.44
109+00.00	606.89	608.17	605.61
109+10.00	607.04	608.32	605.76
109+20.00	607.18	608.46	605.90
109+30.00	607.31	608.59	606.03
109+40.00	607.42	608.70	606.14
109+50.00	607.53	608.81	606.25
109+60.00	607.62	608.90	606.34
109+70.00	607.71	608.99	606.43
109+80.00	607.78	609.06	606.50
109+90.00	607.85	609.13	606.57
110+00.00	607.91	609.19	606.63
110+10.00	607.96	609.24	606.68
110+20.00	608.00	609.28	606.72
110+30.00	608.03	609.31	606.75
110+40.00	608.06	609.34	606.78
110+50.00	608.07	609.35	606.79
110+60.00	608.08	609.36	606.80



STATION	PROFILE ELEVATION	RIGHT EDGE OF PAVEMENT ELEVATION	LEFT EDGE OF PAVEMENT ELEVATION
110+70.00	608.08	609.36	606.80
110+80.00	608.07	609.35	606.79
110+90.00	608.05	609.33	606.77
111+00.00	608.02	609.30	606.74
111+10.00	607.98	609.26	606.70
111+20.00	607.94	609.22	606.66
111+30.00	607.88	609.16	606.60
111+40.00	607.82	609.10	606.54
111+50.00	607.75	609.03	606.47
111+60.00	607.67	608.95	606.39
111+70.00	607.58	608.86	606.30
111+80.00	607.48	608.76	606.20
111+90.00	607.37	608.65	606.09
112+00.00	607.26	608.54	605.98
112+10.00	607.13	608.41	605.85
112+20.00	607.00	608.28	605.72
112+30.00	606.86	608.14	605.58
112+40.00	606.71	607.99	605.43
112+50.00	606.55	607.83	605.27
112+60.00	606.39	607.67	605.11
112+70.00	606.22	607.50	604.94
112+80.00	606.06	607.34	604.78
112+90.00	605.90	607.18	604.62
113+00.00	605.73	607.01	604.45
113+10.00	605.57	606.85	604.29
113+20.00	605.42	606.70	604.14
113+30.00	605.28	606.56	604.00
113+40.00	605.15	606.43	603.87
113+50.00	605.03	606.31	603.75
113+60.00	604.92	606.20	603.64
113+70.00	604.81	606.09	603.53
113+80.00	604.72	606.00	603.44
113+90.00	604.63	605.91	603.35
114+00.00	604.55	605.83	603.27
114+10.00	604.48	605.76	603.20
114+20.00	604.43	605.71	603.15
114+30.00	604.38	605.65	603.10
114+40.00	604.33	605.52	603.14
114+50.00	604.30	605.39	603.19
114+60.00	604.28	605.27	603.24
114+70.00	604.27	605.17	603.31
114+80.00	604.26	605.07	603.39
114+90.00	604.27	604.98	603.47
115+00.00	604.28	604.90	603.56



Rev. 2-11-10

PLAN	SURVEYED	DATE
	PLOTTED	
	CHECKED	
	BY	
	NO.	
	FILE NAME	

PROFILE	SURVEYED	DATE
	PLOTTED	
	CHECKED	
	BY	
	NO.	
	FILE NAME	

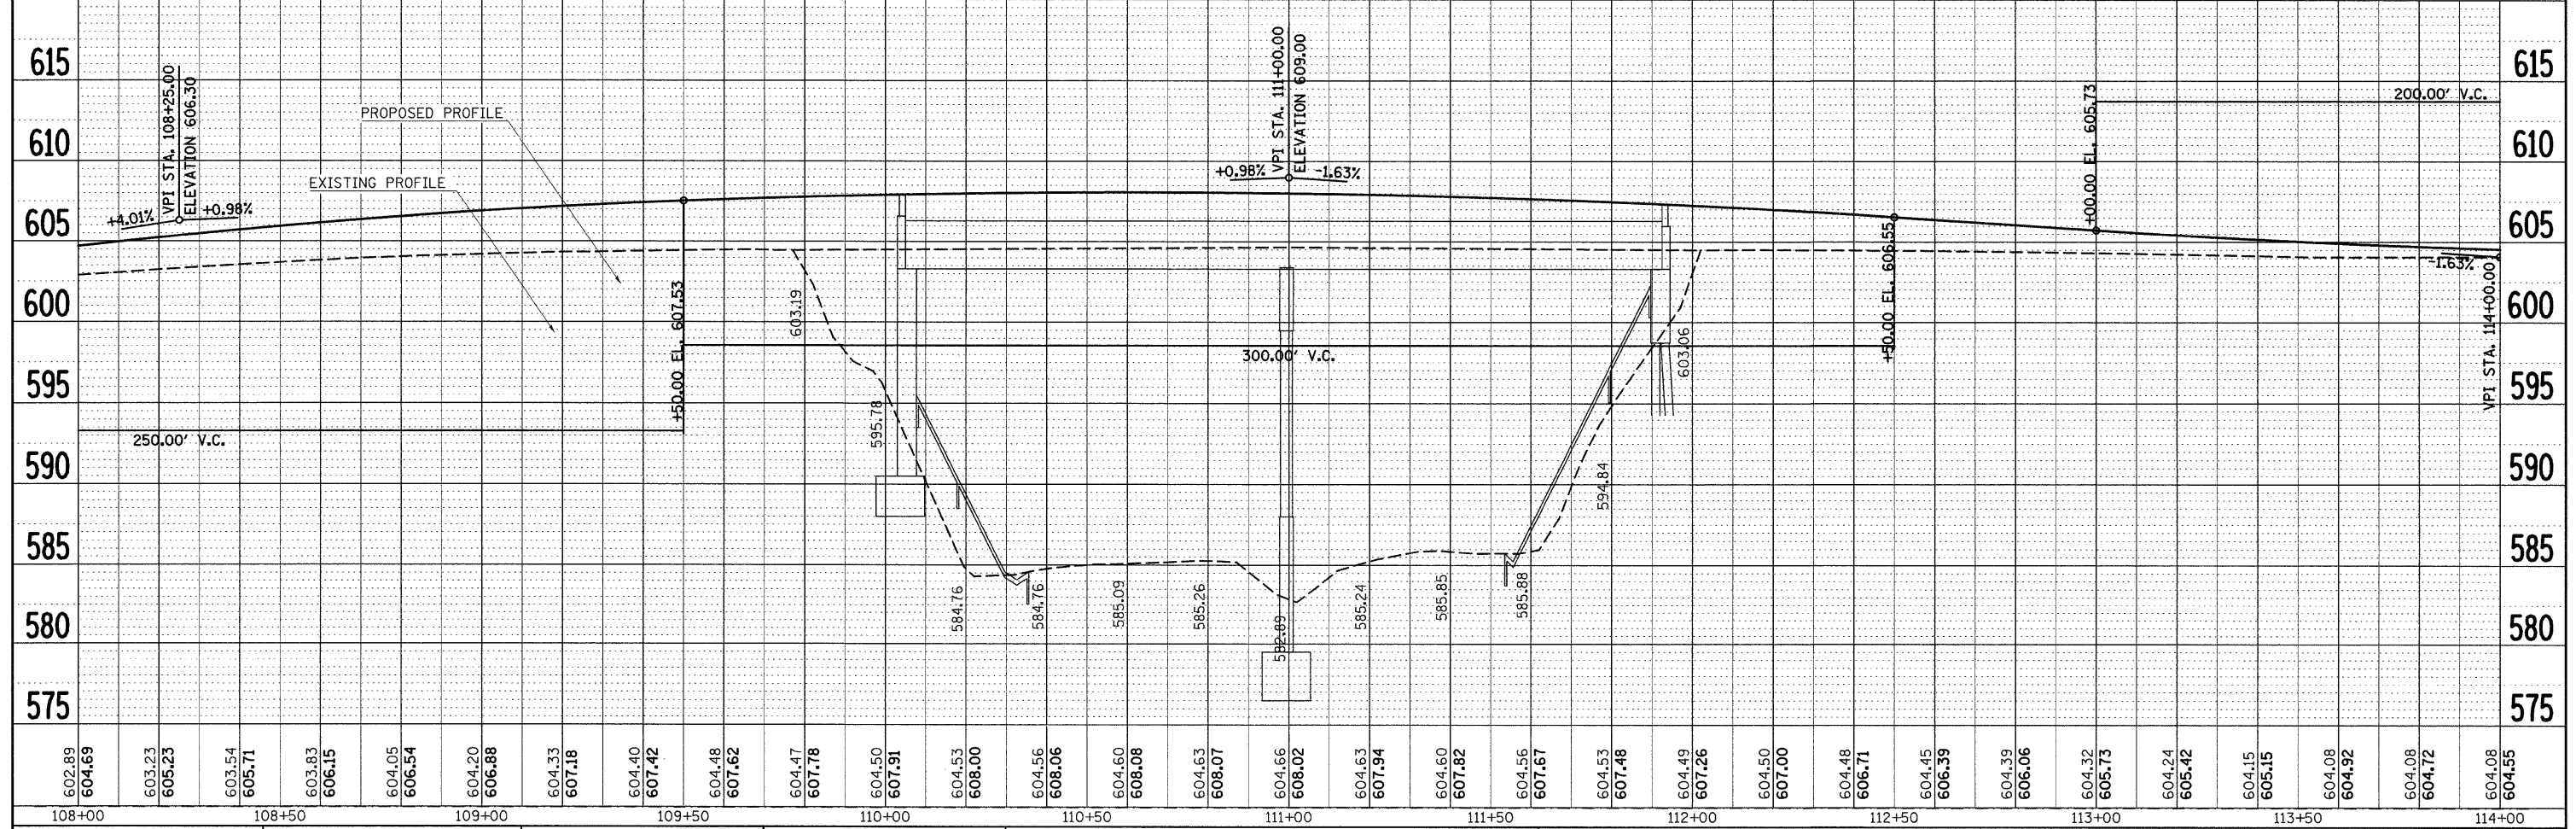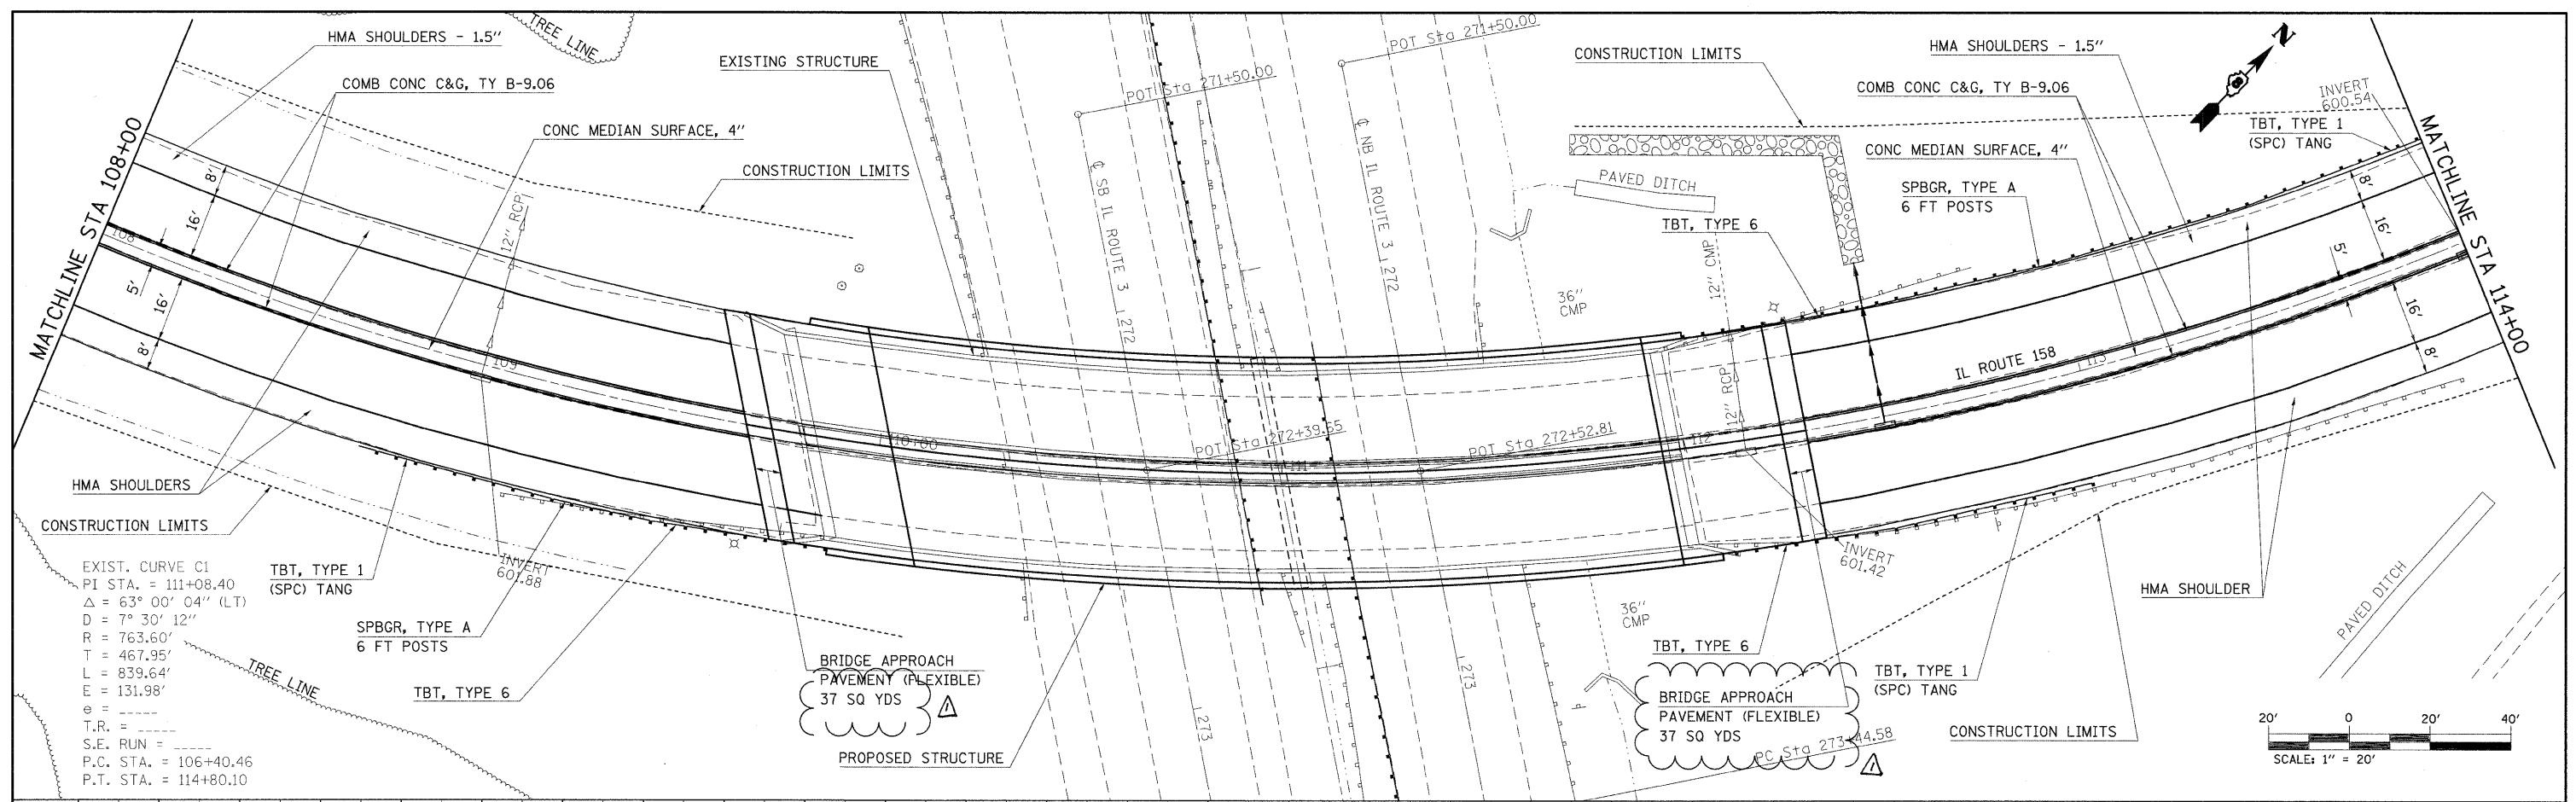

602.89	604.69	603.23	605.23	603.54	605.71	603.83	606.15	604.05	606.54	604.20	606.88	604.33	607.18	604.40	607.42	604.48	607.62	604.47	607.78	604.50	607.91	604.53	608.00	604.56	608.06	604.60	608.08	604.63	608.07	604.66	608.02	604.63	607.94	604.60	607.82	604.56	607.67	604.53	607.48	604.49	607.26	604.50	607.00	604.48	606.71	604.45	606.39	604.39	606.06	604.32	605.73	604.24	605.42	604.15	605.15	604.08	604.92	604.08	604.72	604.08	604.55
108+00		108+50		109+00		109+50		110+00		110+50		111+00		111+50		112+00		112+50		113+00		113+50		114+00																																					

FILE NAME = es:\pwwork\p1\DOT\0\ENBJ\dms52558\p1r025961.dgn

USER NAME = awenbj
 DESIGNED -
 DRAWN -
 CHECKED -
 DATE -

REVISIED -
 REVISIED -
 REVISIED -
 REVISIED -

DESIGNED -
 DRAWN -
 CHECKED -
 DATE -

STATE OF ILLINOIS
 DEPARTMENT OF TRANSPORTATION

PLAN AND PROFILE
 SCALE: SHEET NO. OF SHEETS STA. TO STA.

F.A.P. RTE. 809
 SECTION 67-1HBR
 COUNTY MONROE
 TOTAL SHEETS 144
 SHEET NO. 17
 CONTRACT NO. 76977

THIS PLAN HAS BEEN PREPARED TO COMPLY WITH THE PROVISIONS OF THE NPDES PERMIT NUMBER ILR10, ISSUED BY THE ILLINOIS ENVIRONMENTAL PROTECTION AGENCY ON MAY 30, 2003 FOR STORM WATER DISCHARGES FROM CONSTRUCTION SITE ACTIVITIES. THIS PLAN HAS ALSO BEEN PREPARED TO COMPLY WITH THE PROVISIONS OF NPDES PERMIT NUMBER ILR40 FOR DISCHARGES FROM SMALL MUNICIPAL SEPARATE STORM SEWER SYSTEMS IF CHECKED BELOW.

NPDES PERMITS ASSOCIATED WITH THIS PROJECT:

- ILR10
 ILR40 PERMIT NO. 0493

I CERTIFY UNDER PENALTY OF LAW THAT THIS DOCUMENT AND ALL ATTACHMENTS WERE PREPARED UNDER MY DIRECTION OR SUPERVISION IN ACCORDANCE WITH A SYSTEM DESIGNED TO ASSURE THAT QUALIFIED PERSONNEL PROPERLY GATHERED AND EVALUATED THE INFORMATION SUBMITTED. BASED ON MY INQUIRY OF THE PERSON OR PERSONS WHO MANAGE THE SYSTEM, OR THOSE PERSONS DIRECTLY RESPONSIBLE FOR GATHERING THE INFORMATION, THE INFORMATION SUBMITTED IS, TO THE BEST OF MY KNOWLEDGE AND BELIEF, TRUE, ACCURATE AND COMPLETE. I AM AWARE THAT THERE ARE SIGNIFICANT PENALTIES FOR SUBMITTING FALSE INFORMATION, INCLUDING THE POSSIBILITY OF FINE AND IMPRISONMENT FOR KNOWING VIOLATIONS.

MARY C. LAMIE
 PRINT NAME
 DEPUTY DIRECTOR OF HIGHWAYS
 REGION FIVE ENGINEER
 TITLE
 IL DEPT. OF TRANSPORTATION
 AGENCY

M. C. Lamie
 SIGNATURE
 Nov 9, 2009
 DATE

I. SITE DESCRIPTION:

A. THE FOLLOWING IS A DESCRIPTION OF THE PROJECT LOCATION:

THE PROJECT CONSISTS OF STRUCTURE REPLACEMENT OF THE STRUCTURE CARRYING IL ROUTE 158 OVER IL ROUTE 3, SOUTH OF COLUMBIA.

B. THE FOLLOWING IS A DESCRIPTION OF THE CONSTRUCTION ACTIVITY WHICH IS THE SUBJECT OF THIS PLAN:

CONSTRUCTION INCLUDES STRUCTURE REPLACEMENT, A PROFILE GRADE CHANGE, AGGREGATE AND HMA SHOULDERS, GUARDRAIL, EARTH EXCAVATION AND EMBANKMENT, AND ALL INCIDENTAL AND COLLATERAL WORK NECESSARY TO COMPLETE THE PROJECT AS SHOWN ON THE PLANS.

C. THE FOLLOWING IS A DESCRIPTION OF THE INTENDED SEQUENCE OF MAJOR ACTIVITIES WHICH WILL DISTURB SOILS FOR MAJOR PORTIONS OF THE CONSTRUCTION SITE, SUCH AS GRUBBING, EXCAVATION AND GRADING:

DESCRIPTION OF INTENDED SEQUENCE FOR MAJOR CONSTRUCTION ACTIVITIES WHICH WILL DISTURB SOILS FOR MAJOR PORTIONS OF THE CONSTRUCTION SITE:

PRE-STAGE 1: CONSTRUCT HMA BASE COURSE ON EAST SIDE OF ROADWAY FOR STAGE I TRAFFIC.

STAGE 1: WITH TRAFFIC ON THE EAST HALF OF THE STRUCTURE, REMOVE AND REPLACE THE WEST HALF. AFTER THE WEST HALF OF THE STRUCTURE IS BUILT, BUILD PAVEMENT ON BOTH SIDES OF STRUCTURE. CONSTRUCT HMA BASE COURSE ON WEST SIDE OF ROADWAY FOR STAGE II TRAFFIC.

STAGE 2: REMOVE AND REPLACE THE EAST HALF OF THE STRUCTURE. AFTER THE EAST HALF OF THE STRUCTURE IS BUILT, BUILD THE PAVEMENT ON EAST SIDE.

D. THE TOTAL AREA OF THE CONSTRUCTION SITE IS ESTIMATED TO BE 7.2 ACRES.

THE TOTAL AREA OF THE SITE THAT IS ESTIMATED WILL BE DISTURBED BY EXCAVATION, GRADING OR OTHER ACTIVITIES IS 1.25 ACRES.

E. THE FOLLOWING IS A WEIGHTED AVERAGE OF THE RUNOFF COEFFICIENT FOR THIS PROJECT AFTER CONSTRUCTION ACTIVITIES ARE COMPLETED: 0.79

F. THE FOLLOWING IS A DESCRIPTION OF THE SOIL TYPES FOUND AT THE PROJECT SITE FOLLOWED BY INFORMATION REGARDING THEIR EROSIVITY:

ONE SOIL TYPE IS LOCATED WITHIN THE PROJECT AREA OF THE IL ROUTE 158 BRIDGE REPLACEMENT OVER IL 3

ORTHENTS, SILTY, STEEP (801D) - A SOMEWHAT POORLY DRAINED SOIL WITH MODERATE TO LOW PERMEABILITY. THIS SOIL HAS A MODERATELY HIGH SUSCEPTIBILITY TO WATER EROSION AND A LOW SUSCEPTIBILITY TO WIND EROSION.

G. THE FOLLOWING IS A DESCRIPTION OF POTENTIALLY EROSION AREAS ASSOCIATED WITH THIS PROJECT:

NONE

H. THE FOLLOWING IS A DESCRIPTION OF SOIL DISTURBING ACTIVITIES, THEIR LOCATIONS, AND THEIR EROSION FACTORS (E.G. STEEPNESS OF SLOPES, LENGTH OF SLOPES, ETC):

THE PURPOSE OF LAND DISTURBING ACTIVITIES ON THIS PROJECT IS TO REMOVE AND REPLACE THE IL ROUTE 158 BRIDGE OVER IL ROUTE 3 (PROPOSED STRUCTURE NO. 067-0042, EXISTING STRUCTURE NO. 067-0006), THE RECONSTRUCTION OF GUARDRAIL AND SIDE SLOPES.

THE ONLY SOIL TYPE IN THE PROJECT AREA IS ORTHENTS, SILTY, STEEP (801D). IT HAS A MODERATELY HIGH SUSCEPTIBILITY TO WATER EROSION AND A LOW SUSCEPTIBILITY TO WIND EROSION.

I. SEE THE EROSION CONTROL PLANS AND/OR DRAINAGE PLANS FOR THIS CONTRACT FOR INFORMATION REGARDING DRAINAGE PATTERNS, APPROXIMATE SLOPES ANTICIPATED BEFORE AND AFTER MAJOR GRADING ACTIVITIES, LOCATIONS WHERE VEHICLES ENTER OR EXIT THE SITE AND CONTROLS TO PREVENT OFF SITE SEDIMENT TRACKING (TO BE ADDED AFTER CONTRACTOR IDENTIFIES LOCATIONS), AREAS OF SOIL DISTURBANCE, THE LOCATION OF MAJOR STRUCTURAL AND NON-STRUCTURAL CONTROLS IDENTIFIED IN THE PLAN, THE LOCATION OF AREAS WHERE STABILIZATION PRACTICES ARE EXPECTED TO OCCUR, SURFACE WATERS (INCLUDING WETLANDS) AND LOCATIONS WHERE STORM WATER IS DISCHARGED TO SURFACE WATER INCLUDING WETLANDS.

J. THE FOLLOWING IS A LIST OF RECEIVING WATER(S) AND THE ULTIMATE RECEIVING WATER(S), AND AERIAL EXTENT OF WETLAND ACREAGE AT THE SITE. THE LOCATION OF THE RECEIVING WATERS CAN BE FOUND ON THE EROSION AND SEDIMENT CONTROL PLANS:

NONE

K. THE FOLLOWING POLLUTANTS OF CONCERN WILL BE ASSOCIATED WITH THIS CONSTRUCTION PROJECT: (CHECK ALL THAT APPLY)

- | | |
|---|--|
| <input checked="" type="checkbox"/> SOIL SEDIMENT | <input checked="" type="checkbox"/> PETROLEUM (GAS, DIESEL, OIL, KEROSENE, HYDRAULIC OIL/FLUIDS) |
| <input checked="" type="checkbox"/> CONCRETE | <input checked="" type="checkbox"/> ANTIFREEZE / COOLANTS |
| <input checked="" type="checkbox"/> CONCRETE TRUCK WASTE | <input checked="" type="checkbox"/> WASTE WATER FROM CLEANING CONSTRUCTION EQUIPMENT |
| <input checked="" type="checkbox"/> CONCRETE CURING COMPOUNDS | <input type="checkbox"/> OTHER (SPECIFY)..... |
| <input type="checkbox"/> SOLID WASTE DEBRIS | <input type="checkbox"/> OTHER (SPECIFY)..... |
| <input type="checkbox"/> PAINTS | <input type="checkbox"/> OTHER (SPECIFY)..... |
| <input type="checkbox"/> SOLVENTS | <input type="checkbox"/> OTHER (SPECIFY)..... |
| <input checked="" type="checkbox"/> FERTILIZERS / PESTICIDES | <input type="checkbox"/> OTHER (SPECIFY)..... |

II. CONTROLS

THIS SECTION OF THE PLAN ADDRESSES THE CONTROLS THAT WILL BE IMPLEMENTED FOR EACH OF THE MAJOR CONSTRUCTION ACTIVITIES DESCRIBED IN I.C. ABOVE AND FOR ALL USE AREAS, BORROW SITES, AND WASTE SITES. FOR EACH MEASURE DISCUSSED, THE CONTRACTOR WILL BE RESPONSIBLE FOR ITS IMPLEMENTATION AS INDICATED. THE CONTRACTOR SHALL PROVIDE TO THE RESIDENT ENGINEER A PLAN FOR THE IMPLEMENTATION OF THE MEASURES INDICATED. THE CONTRACTOR, AND SUBCONTRACTORS, WILL NOTIFY THE RESIDENT ENGINEER OF ANY PROPOSED CHANGES, MAINTENANCE, OR MODIFICATIONS TO KEEP CONSTRUCTION ACTIVITIES COMPLIANT WITH THE PERMIT. EACH SUCH CONTRACTOR HAS SIGNED THE REQUIRED CERTIFICATION ON FORMS WHICH WILL BE PROVIDED AT THE PRE-CONSTRUCTION CONFERENCE, AND ARE A PART OF, THIS PLAN:

A. EROSION AND SEDIMENT CONTROL

1. STABILIZED PRACTICES: PROVIDED BELOW IS A DESCRIPTION OF INTERIM AND PERMANENT STABILIZATION PRACTICES, INCLUDING SITE SPECIFIC SCHEDULING OF THE IMPLEMENTATION OF THE PRACTICES. SITE PLANS WILL ENSURE THAT EXISTING VEGETATION IS PRESERVED WHERE ATTAINABLE AND DISTURBED PORTIONS OF THE SITE WILL BE STABILIZED. STABILIZATION PRACTICES MAY INCLUDE BUT ARE NOT LIMITED TO: TEMPORARY SEEDING, PERMANENT SEEDING, MULCHING, GEOTEXTILES, SODDING, VEGETATIVE BUFFER STRIPS, PROTECTION OF TREES, PRESERVATION OF MATURE VEGETATION, AND OTHER APPROPRIATE MEASURES. EXCEPT AS PROVIDED BELOW IN II(A)(1)(d) AND II(A)(3), STABILIZATION MEASURES SHALL BE INITIATED AS SOON AS PRACTICABLE IN PORTIONS OF THE SITE WHERE CONSTRUCTION ACTIVITIES HAVE TEMPORARILY OR PERMANENTLY CEASED, BUT IN NO CASE MORE THAN 14 DAYS AFTER THE CONSTRUCTION ACTIVITY IN THAT PORTION OF THE SITE HAS TEMPORARILY OR PERMANENTLY CEASED ON ALL DISTURBED PORTIONS OF THE SITE WHERE CONSTRUCTION WILL NOT OCCUR FOR A PERIOD OF 21 OR MORE CALENDAR DAYS.

q. WHERE THE INITIATION OF STABILIZATION MEASURES BY THE 14TH DAY AFTER CONSTRUCTION ACTIVITY TEMPORARILY OR PERMANENTLY CEASES IS PRECLUDED BY SNOW COVER, STABILIZATION MEASURES SHALL BE INITIATED AS SOON AS PRACTICABLE THEREAFTER.

THE FOLLOWING STABILIZATION PRACTICES WILL BE USED FOR THIS PROJECT: (CHECK ALL THAT APPLY)

- | | |
|---|--|
| <input type="checkbox"/> PRESERVATION OF MATURE VEGETATION | <input checked="" type="checkbox"/> EROSION CONTROL BLANKET / MULCHING |
| <input type="checkbox"/> VEGETATED BUFFER STRIPS | <input type="checkbox"/> SODDING |
| <input type="checkbox"/> PROTECTION OF TREES | <input type="checkbox"/> GEOTEXTILES |
| <input checked="" type="checkbox"/> TEMPORARY EROSION CONTROL SEEDING | <input type="checkbox"/> OTHER (SPECIFY)..... |
| <input type="checkbox"/> TEMPORARY TURF (SEEDING, CLASS 7) | <input type="checkbox"/> OTHER (SPECIFY)..... |
| <input type="checkbox"/> TEMPORARY MULCHING | <input type="checkbox"/> OTHER (SPECIFY)..... |
| <input checked="" type="checkbox"/> PERMANENT SEEDING | <input type="checkbox"/> OTHER (SPECIFY)..... |

DESCRIBE HOW THE STABILIZATION PRACTICES LISTED ABOVE WILL BE UTILIZED:

1. TEMPORARY EROSION CONTROL SEEDING - THIS ITEM WILL BE APPLIED TO ALL BARE AREAS EVERY SEVEN DAYS TO MINIMIZE THE AMOUNT OF EXPOSED SURFACE AREAS.

TEMPORARY EROSION CONTROL SEEDING SHALL BE APPLIED AT A RATE OF 100 LBS/ACRE.

EARTH STOCKPILES SHALL BE TEMPORARILY SEEDED IF THEY ARE TO REMAIN UNUSED FOR MORE THAN 14 DAYS.

WITHIN THE CONSTRUCTION LIMITS, AREAS WHICH MAY BE SUSCEPTIBLE TO EROSION AS DETERMINED BY THE ENGINEER SHALL REMAIN UNDISTURBED UNTIL FULL SCALE CONSTRUCTION IS UNDERWAY TO PREVENT UNNECESSARY SOIL EROSION.

BARE AND SPARSELY VEGETATED GROUND IN HIGHLY ERODIBLE AREAS AS DETERMINED BY THE ENGINEER SHALL BE TEMPORARILY SEEDED AT THE BEGINNING OF CONSTRUCTION WHERE NO CONSTRUCTION ACTIVITIES ARE EXPECTED WITHIN 7 DAYS.

2. PERMANENT SEEDING - SEEDING, CLASS 2 WILL BE INSTALLED PER IDOT SPECIFICATIONS.

3. EROSION CONTROL BLANKETS/MULCHING - EROSION CONTROL BLANKETS WILL BE INSTALLED OVER FILL SLOPES AND IN HIGH VELOCITY AREAS (I.E. DITCHES) THAT HAVE BEEN BROUGHT TO FINAL GRADE AND SEEDED TO PROTECT SLOPES FROM EROSION AND ALLOW SEEDS TO GERMINATE. MULCH, METHOD 2 WILL BE APPLIED IN RELATIVELY FLAT AREAS TO PROTECT THE DISTURBED AREAS AND PREVENT FURTHER EROSION.

MULCH AS APPLIED TO TEMPORARY EROSION CONTROL SEEDING SHALL BE BY THE METHOD SPECIFIED IN THE CONTRACT AND AT THE DIRECTION OF THE ENGINEER. MULCH WILL BE PAID SEPARATELY AND SHALL CONFORM TO SECTION 251 OF THE STANDARD SPECIFICATIONS.

PERMANENT STABILIZATION - ALL AREAS DISTURBED BY CONSTRUCTION WILL BE STABILIZED WITH PERMANENT SEEDING IMMEDIATELY FOLLOWING THE FINISHED GRADING. EROSION CONTROL BLANKETS WILL BE INSTALLED OVER FILL SLOPES WHICH HAVE BEEN BROUGHT TO FINAL GRADE AND HAVE BEEN SEEDED TO PROTECT THE SLOPES FROM RILL AND GULLY EROSION AND ALLOW SEED TO GERMINATE PROPERLY. MULCH, METHOD 2 WILL BE USED ON RELATIVELY FLAT AREAS.

2. STRUCTURAL PRACTICES: PROVIDED BELOW IS A DESCRIPTION OF STRUCTURAL PRACTICES THAT WILL BE IMPLEMENTED, TO THE DEGREE ATTAINABLE, TO DIVERT FLOWS FROM EXPOSED SOILS, STORE FLOWS OR OTHERWISE LIMIT RUNOFF AND THE DISCHARGE OF POLLUTANTS FROM EXPOSED AREAS OF THE SITE. SUCH PRACTICES MAY INCLUDE BUT ARE NOT LIMITED TO: PERIMETER EROSION BARRIER, EARTH DIKES, DRAINAGE SWALES, SEDIMENT TRAPS, DITCH CHECKS, SUBSURFACE DRAINS, PIPE SLOPE DRAINS, LEVEL SPREADERS, STORM DRAIN INLET PROTECTION, ROCK OUTLET PROTECTION, REINFORCED SOIL RETAINING SYSTEMS, GABIONS, AND TEMPORARY OR PERMANENT SEDIMENT BASINS. THE INSTALLATION OF THESE DEVICES MAY BE SUBJECT TO SECTION 404 OF THE CLEAN WATER ACT.

THE FOLLOWING STRUCTURAL PRACTICES WILL BE USED FOR THIS PROJECT:(CHECK ALL THAT APPLY)

- | | |
|---|--|
| <input checked="" type="checkbox"/> PERIMETER EROSION BARRIER | <input type="checkbox"/> ROCK OUTLET PROTECTION |
| <input checked="" type="checkbox"/> TEMPORARY DITCH CHECK | <input type="checkbox"/> RIPRAP |
| <input type="checkbox"/> STORM DRAIN INLET PROTECTION | <input type="checkbox"/> GABIONS |
| <input type="checkbox"/> SEDIMENT TRAP | <input type="checkbox"/> SLOPE MATTRESS |
| <input type="checkbox"/> TEMPORARY PIPE SLOPE DRAIN | <input type="checkbox"/> RETAINING WALLS |
| <input type="checkbox"/> TEMPORARY SEDIMENT BASIN | <input checked="" type="checkbox"/> SLOPE WALLS |
| <input type="checkbox"/> TEMPORARY STREAM CROSSING | <input type="checkbox"/> CONCRETE REVETMENT MATS |
| <input type="checkbox"/> STABILIZED CONSTRUCTION EXITS | <input type="checkbox"/> LEVEL SPREADERS |
| <input type="checkbox"/> TURF REINFORCEMENT MATS | <input type="checkbox"/> OTHER (SPECIFY)..... |
| <input type="checkbox"/> PERMANENT CHECK DAMS | <input type="checkbox"/> OTHER (SPECIFY)..... |
| <input type="checkbox"/> PERMANENT SEDIMENT BASIN | <input type="checkbox"/> OTHER (SPECIFY)..... |
| <input type="checkbox"/> AGGREGATE DITCH | <input type="checkbox"/> OTHER (SPECIFY)..... |
| <input type="checkbox"/> PAVED DITCH | <input type="checkbox"/> OTHER (SPECIFY)..... |

DESCRIBE HOW THE STRUCTURAL PRACTICES LISTED ABOVE WILL BE UTILIZED:

1. PERIMETER EROSION BARRIER - SILT FENCES WILL BE PLACED ALONG THE CONSTRUCTION LIMITS IN AN EFFORT TO CONTAIN SILT AND RUNOFF FROM LEAVING THE SITE.

CONSTRUCT AT BEGINNING OF CONSTRUCTION. REMOVE AT END OF CONSTRUCTION.

2. TEMPORARY DITCH CHECKS - THE LOCATION OF TEMPORARY DITCH CHECKS ARE SHOWN ON THE EROSION CONTROL PLAN SHEETS AND SCHEDULES.

TEMPORARY DITCH CHECKS SHALL BE LOCATED AT EVERY 1.5 FT. FALL/RISE IN DITCH GRADE.

TEMPORARY DITCH CHECKS, AGGREGATE USES GRADING NO. 3 - REMOVE AT END OF CONSTRUCTION.

STRAW BALES, HAY BALES, PERIMETER EROSION BARRIER AND SILT FENCE WILL NOT BE PERMITTED FOR TEMPORARY OR PERMANENT DITCH CHECKS. DITCH CHECKS SHALL BE COMPOSED OF AGGREGATE (IF SPECIFIED), ENVIROBERM, TRIANGULAR SILT DIKES, GEORIDGE AND ROLLED EXCELSIOR.

3. SLOPE WALLS - WILL BE CONSTRUCTED AT BOTH ABUTMENTS OF THE STRUCTURE TO MAINTAIN THE STEEP SLOPES.

AS SOON AS REASONABLE ACCESS IS AVAILABLE TO ALL LOCATIONS WHERE WATER DRAINS AWAY FROM THE PROJECT, TEMPORARY DITCH CHECKS AND PERIMETER EROSION BARRIER SHALL BE INSTALLED AS CALLED OUT IN THIS PLAN AND DIRECTED BY THE ENGINEER.

ALL EROSION CONTROL PRODUCTS FURNISHED SHALL BE SPECIFICALLY RECOMMENDED BY THE MANUFACTURER FOR THE USE SPECIFIED IN THE EROSION CONTROL PLAN. PRIOR TO THE APPROVAL AND USE OF THE PRODUCT, THE CONTRACTOR SHALL SUBMIT TO THE ENGINEER A NOTARIZED CERTIFICATION BY THE PRODUCER STATING THE INTENDED USE OF THE PRODUCT AND THAT THE PHYSICAL PROPERTIES REQUIRED FOR THIS APPLICATION ARE MET OR EXCEEDED. THE CONTRACTOR SHALL PROVIDE MANUFACTURER INSTALLATION PROCEDURES TO FACILITATE THE ENGINEER IN CONSTRUCTION INSPECTION.

FILE NAME =	USER NAME = owerbj	DESIGNED -	REVISED -	STATE OF ILLINOIS DEPARTMENT OF TRANSPORTATION	SWPPP PLAN	F.A.P. RTE.	SECTION	COUNTY	TOTAL SHEETS	SHEET NO.
cr:\pw\work\p\wdot\owenbj\dms52556\p\ln00206adgn	DRAWN -	REVISED -	809			67-1HBR	MONROE	144	36	
PLOT SCALE = 50.0000' / IN.	CHECKED -	REVISED -	CONTRACT NO. 76977							
PLOT DATE = 12/8/2009	DATE -	REVISED -	FED. ROAD DIST. NO. ILLINOIS/FED. AID PROJECT							
			SCALE:			SHEET NO.	OF	SHEETS	STA.	TO STA.

Rev. 2-11-10



EXIST. CURVE C32
 PI STA. = 103+66.07
 $\Delta = 53^\circ 08' 58''$ (LT)
 $D = 12^\circ 47' 27''$
 $R = 447.94'$
 $T = 224.07'$
 $L = 415.53'$
 $E = 52.91'$
 $e = \text{---}$
 $T.R. = \text{---}$
 $S.E. \text{ RUN} = \text{---}$
 $P.C. \text{ STA.} = 101+42.00$
 $P.T. \text{ STA.} = 105+57.53$

COMBINATION CURB & GUTTER REMOVAL

EXISTING MEDIAN REMOVAL

CONSTRUCTION LIMITS

PAVED SHOULDER REMOVAL

MATCHLINE STA 108+00


PAVED DITCH

IL ROUTE 158

PAVEMENT REMOVAL - 1140 SQ YDS
 (10" HMA BASE COURSE PLACED IN MEDIAN
 FOR CROSS-OVER TRAFFIC TO BE REMOVED.)



EXIST. CURVE C31
 PI STA. = 105+92.77
 $\Delta = 7^\circ 41' 25''$ (LT)
 $D = 10^\circ 55' 35''$
 $R = 524.38'$
 $T = 35.24'$
 $L = 70.38'$
 $E = 1.18'$
 $e = \text{---}$
 $T.R. = \text{---}$
 $S.E. \text{ RUN} = \text{---}$
 $P.C. \text{ STA.} = 105+57.53$
 $P.T. \text{ STA.} = 106+27.91$

NOTE: "PAVED SHOULDER REMOVAL" REMOVES EXISTING SHOULDER FOR PLACEMENT OF 11" HMA BASE COURSE FOR STAGE CONSTRUCTION TRAFFIC.
 STAGE I REMOVE TO EXISTING STRUCTURE: STA 103+20 TO STA 109+80 RIGHT
 STAGE II ONLY REMOVE AREA IN CONFLICT: STA 103+20 TO STA 107+00 LEFT

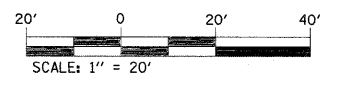


FILE NAME =	USER NAME = owarbj	DESIGNED -	REVISED -	STATE OF ILLINOIS DEPARTMENT OF TRANSPORTATION	REMOVAL PLAN	F.A.P. RTE.	SECTION	COUNTY	TOTAL SHEETS	SHEET NO.
cr:\pw\work\PWIDOT\OWENBJ\dms52558\oin8606a.dgn	PLOT SCALE = 20.0000' / IN.	DRAWN -	REVISED -			809	67-1HBR	MONROE	144	43
PLOT DATE = 2/9/2010	DATE -	CHECKED -	REVISED -			CONTRACT NO. 76977				
		DATE -	REVISED -			FED. ROAD DIST. NO. ILLINOIS FED. AID PROJECT				

Rev. 2-11-10

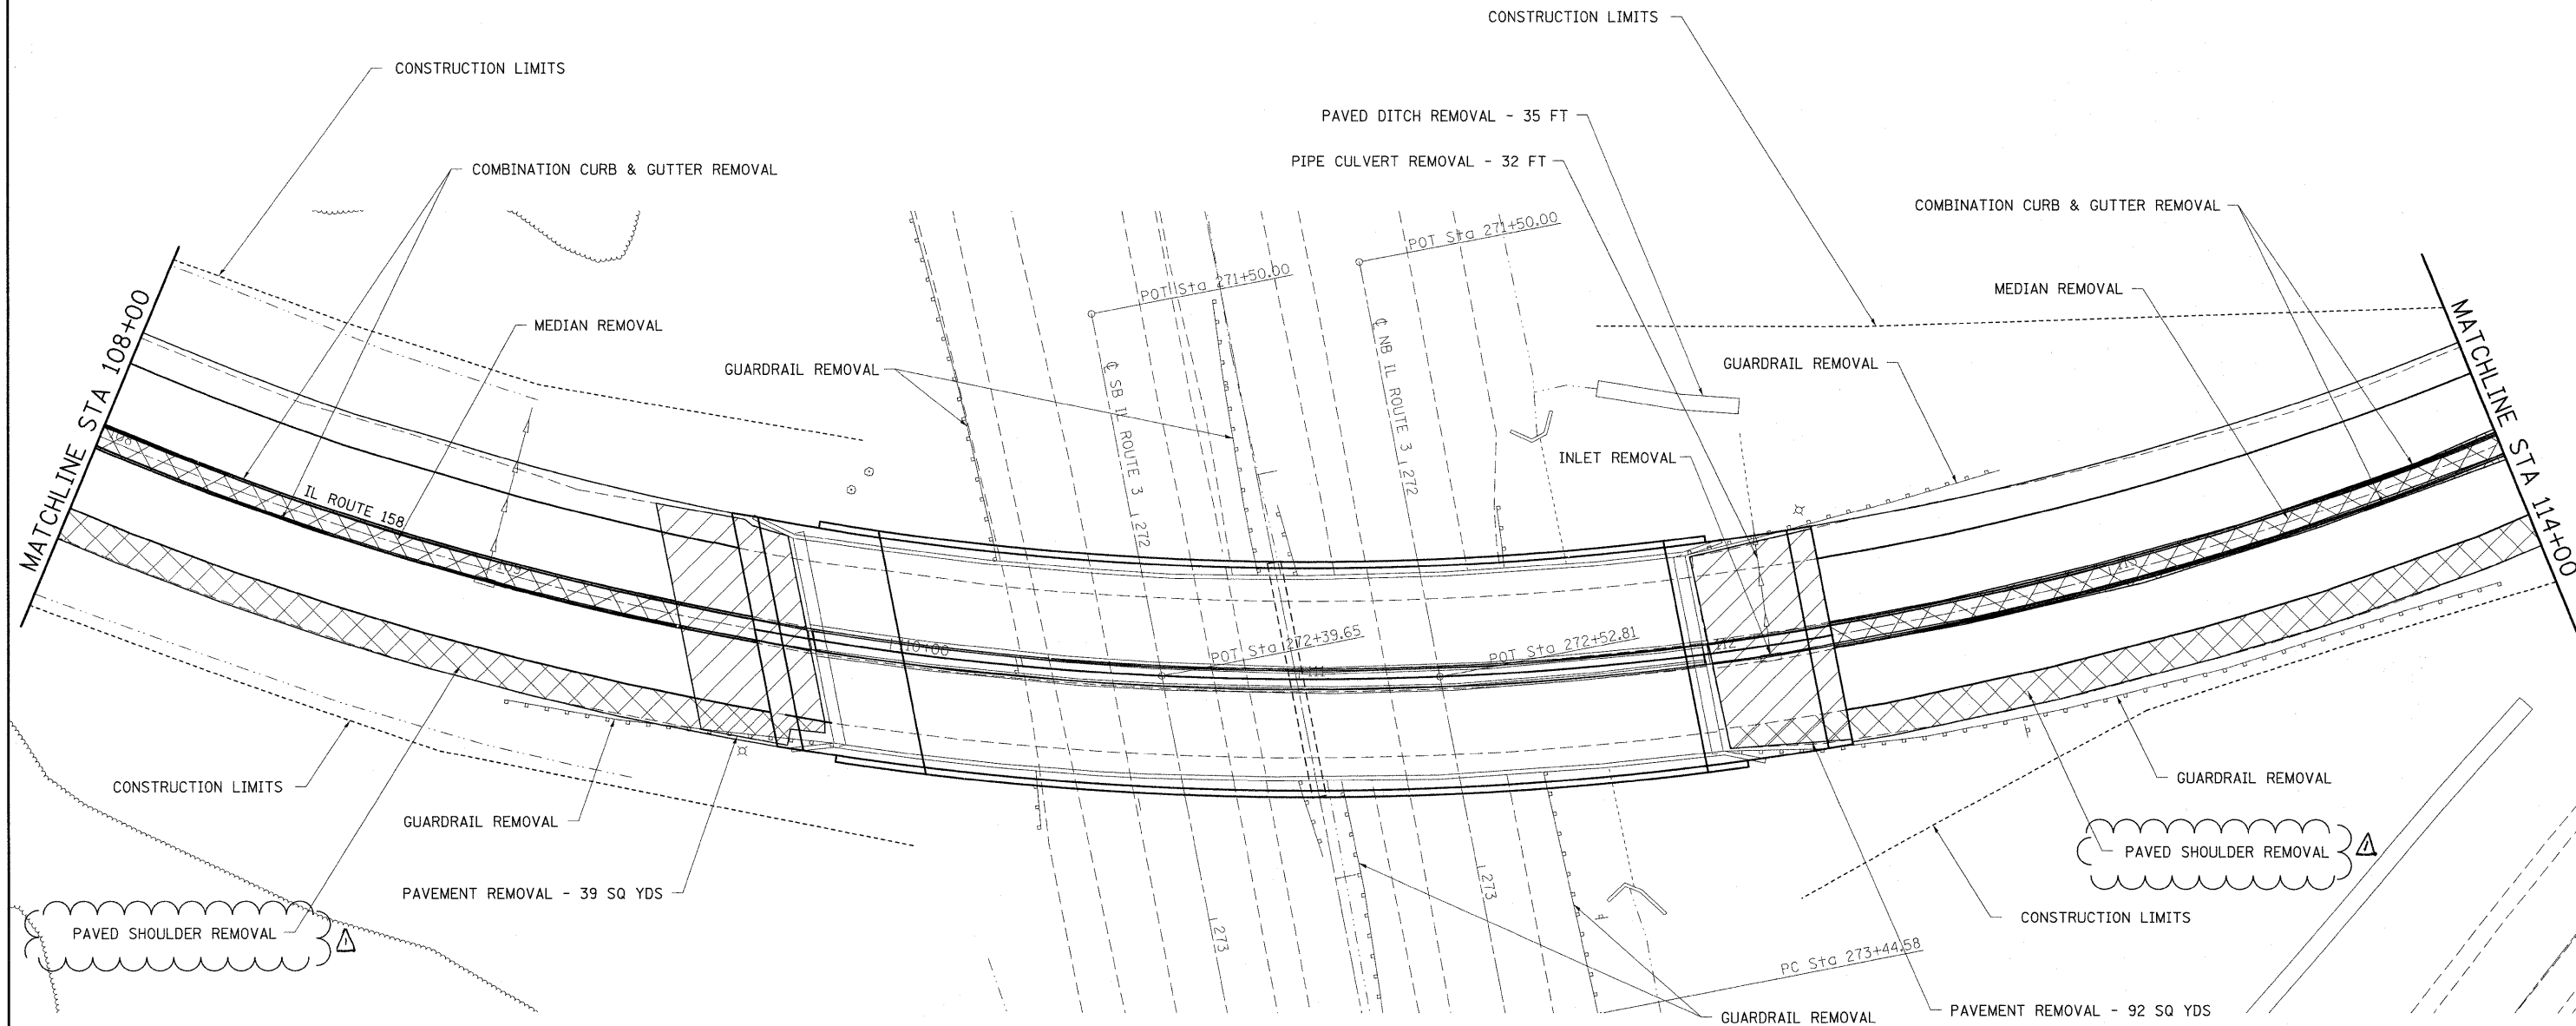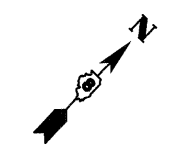

EXIST. CURVE C1
 PI STA. = 111+08.40
 $\Delta = 63^\circ 00' 04''$ (LT)
 $D = 7^\circ 30' 12''$
 $R = 763.60'$
 $T = 467.95'$
 $L = 839.64'$
 $E = 131.98'$
 $e = \text{-----}$
 $T.R. = \text{-----}$
 $S.E. RUN = \text{-----}$
 P.C. STA. = 106+40.46
 P.T. STA. = 114+80.10


NOTE: "PAVED SHOULDER REMOVAL" REMOVES EXISTING SHOULDER FOR PLACEMENT OF 11" HMA BASE COURSE FOR STAGE CONSTRUCTION TRAFFIC.
 STAGE I REMOVE TO EXISTING STRUCTURE: STA 103+20 TO STA 109+80 RIGHT
 STA 112+00 TO STA 116+50 RIGHT

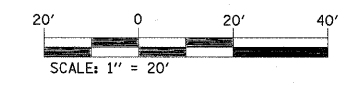

Rev. 2-11-10

FILE NAME =	USER NAME = cwerbj	DESIGNED -	REVISED -	STATE OF ILLINOIS DEPARTMENT OF TRANSPORTATION	REMOVAL PLAN	F.A.P. RTE.	SECTION	COUNTY	TOTAL SHEETS	SHEET NO.	
ct:\pw\work\VPWIDOT\OWENB\J\dm52558\p1n0606audgn	606audgn	DRAWN -	REVISED -			809	67-1HBR	MONROE	144	44	
PLOT SCALE = 20.0000' / IN.		CHECKED -	REVISED -			CONTRACT NO. 76977					
PLOT DATE = 2/8/2010		DATE -	REVISED -			FED. ROAD DIST. NO. ILLINOIS FED. AID PROJECT					
SCALE: SHEET NO. OF SHEETS STA. TO STA.											


EXIST. CURVE C108
 PI STA. = 27+47.92
 $\Delta = 13^\circ 18' 44''$ (RT)
 $D = 7^\circ 40' 32''$
 $R = 746.46'$
 $T = 87.11'$
 $L = 173.43'$
 $E = 5.07'$
 $e = \text{-----}$
 $T.R. = \text{-----}$
 $S.E. \text{ RUN} = \text{-----}$
 $P.C. \text{ STA.} = 26+60.81$
 $P.T. \text{ STA.} = 28+34.25$

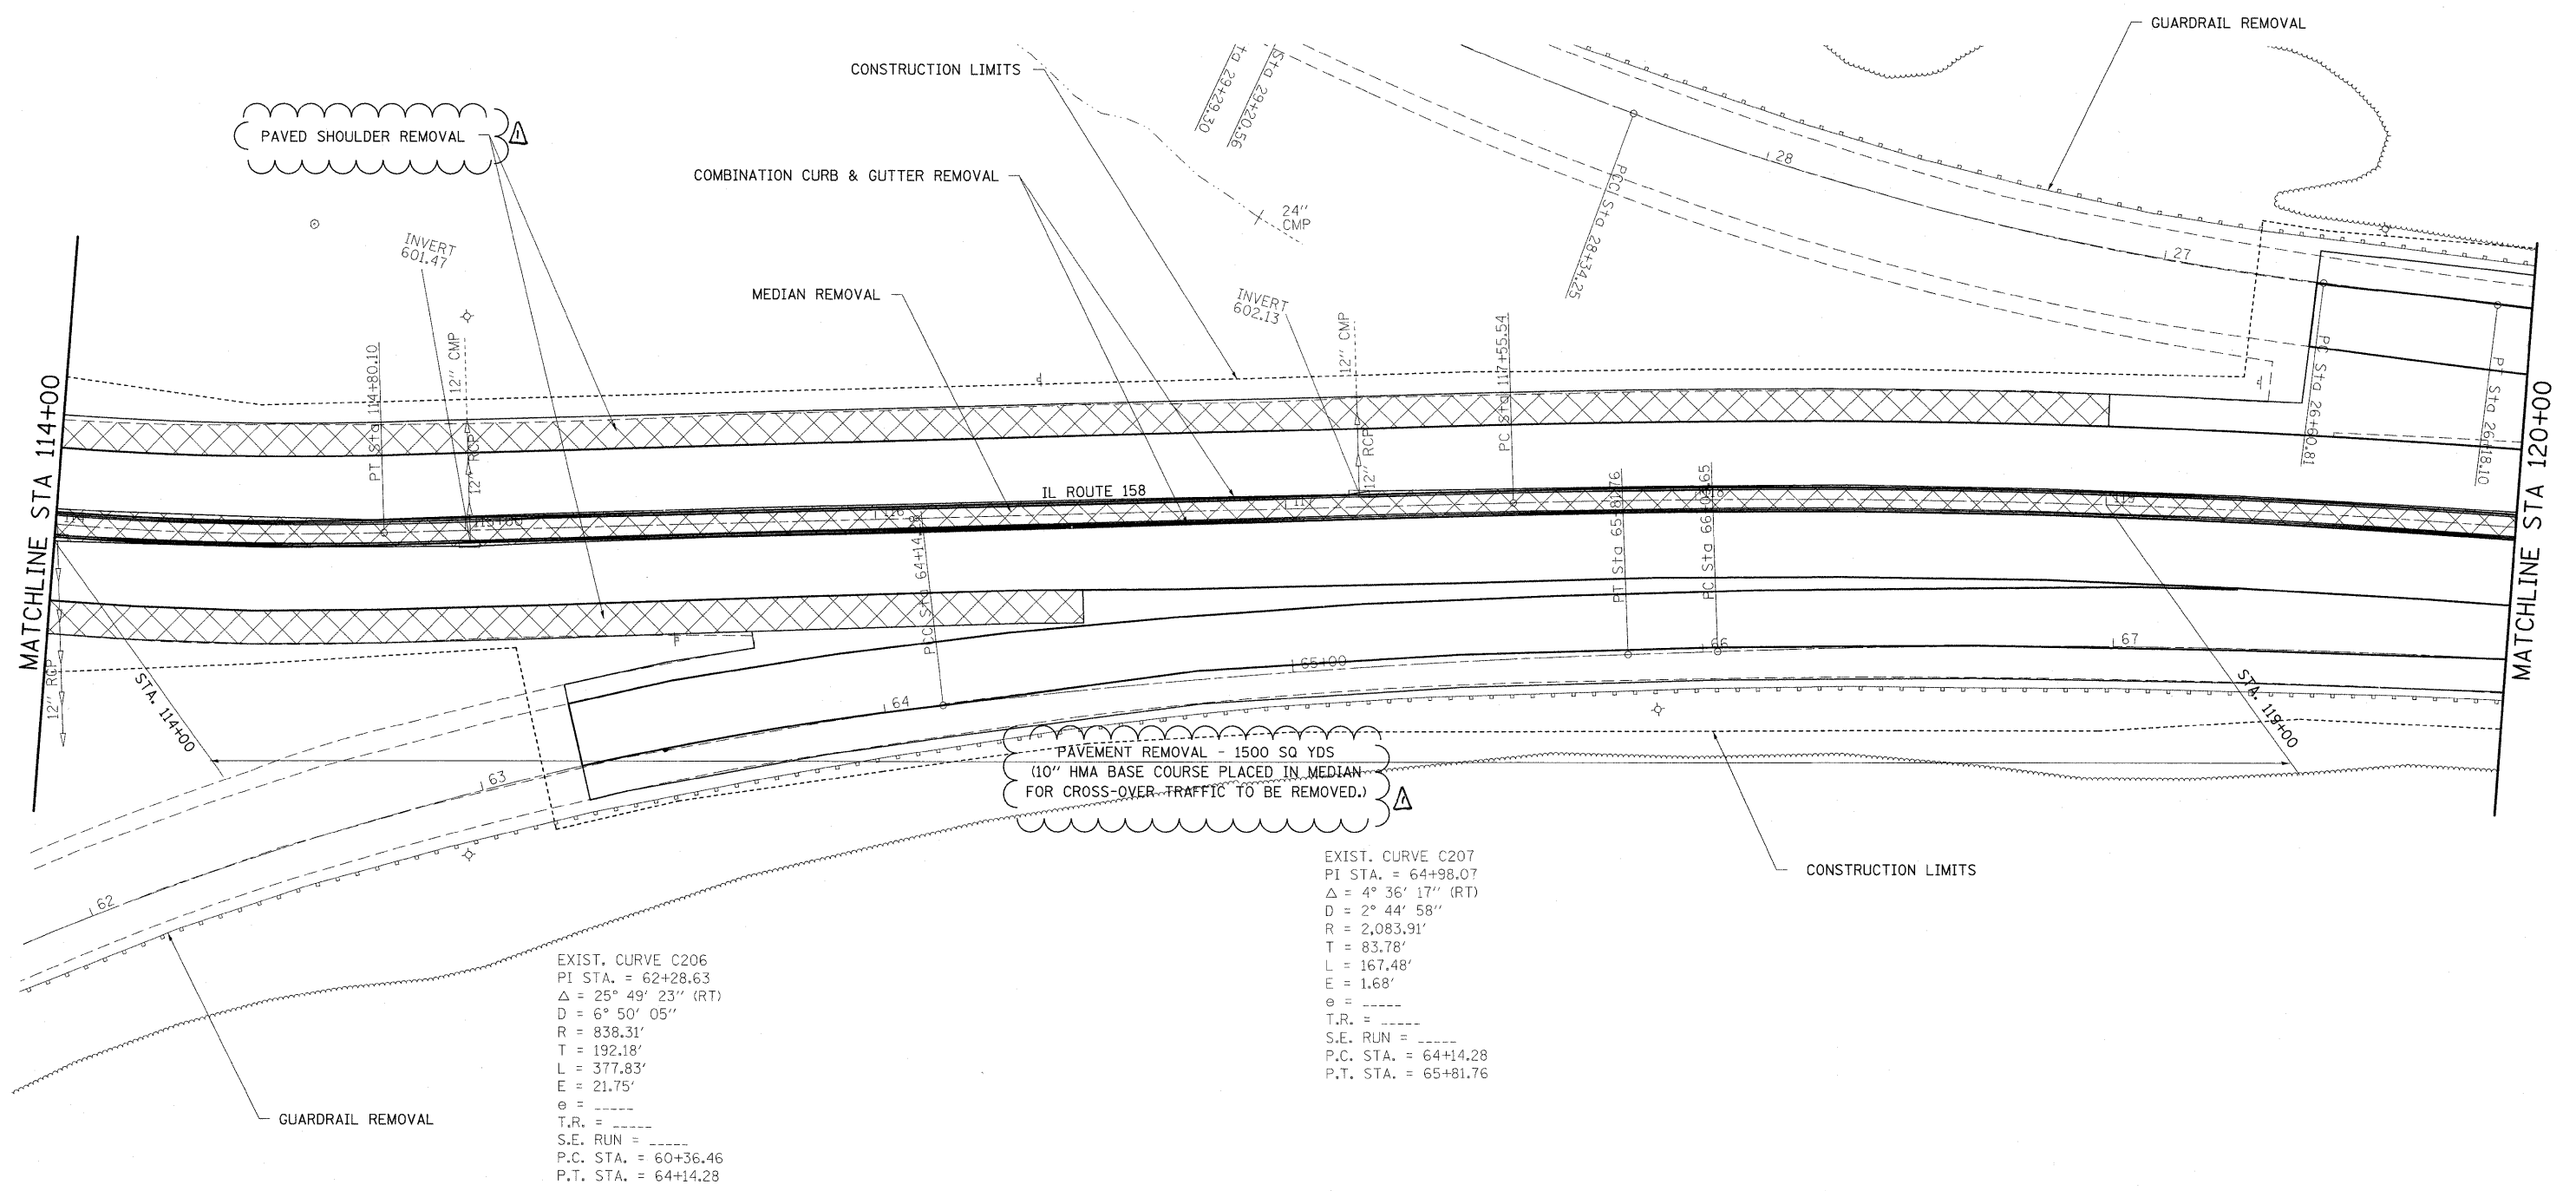

EXIST. CURVE C206
 PI STA. = 62+28.63
 $\Delta = 25^\circ 49' 23''$ (RT)
 $D = 6^\circ 50' 05''$
 $R = 838.31'$
 $T = 192.18'$
 $L = 377.83'$
 $E = 21.75'$
 $e = \text{-----}$
 $T.R. = \text{-----}$
 $S.E. \text{ RUN} = \text{-----}$
 $P.C. \text{ STA.} = 60+36.46$
 $P.T. \text{ STA.} = 64+14.28$

EXIST. CURVE C207
 PI STA. = 64+98.07
 $\Delta = 4^\circ 36' 17''$ (RT)
 $D = 2^\circ 44' 58''$
 $R = 2,083.91'$
 $T = 83.78'$
 $L = 167.48'$
 $E = 1.68'$
 $e = \text{-----}$
 $T.R. = \text{-----}$
 $S.E. \text{ RUN} = \text{-----}$
 $P.C. \text{ STA.} = 64+14.28$
 $P.T. \text{ STA.} = 65+81.76$

NOTE: "PAVED SHOULDER REMOVAL" REMOVES EXISTING SHOULDER FOR PLACEMENT OF 11" HMA BASE COURSE FOR STAGE CONSTRUCTION TRAFFIC.
 STAGE I REMOVE TO EXISTING STRUCTURE; STA 112+00 TO STA 116+50 RIGHT
 STAGE II ONLY REMOVE AREA IN CONFLICT; STA 114+00 TO STA 119+00 LEFT

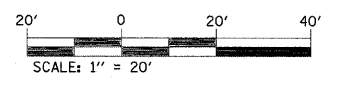

Rev. 2-11-10


FILE NAME =	USER NAME = owerbj	DESIGNED -	REVISED -	STATE OF ILLINOIS DEPARTMENT OF TRANSPORTATION	REMOVAL PLAN	F.A.P. RTE.	SECTION	COUNTY	TOTAL SHEETS	SHEET NO.
c:\pwwork\pwwork\owner\j\dms52558\p1n000000.dgn	PLOT SCALE = 20.0000' / IN.	DRAWN -	REVISED -			809	67-1HBR	MONROE	144	45
PLOT DATE = 2/8/2010	DATE -	CHECKED -	REVISED -			CONTRACT NO. 76977				
		DATE -	REVISED -			FED. ROAD DIST. NO. ILLINOIS FED. AID PROJECT				
						SCALE:	SHEET NO. OF	SHEETS	STA. TO STA.	



EXIST. CURVE C32
 PI STA. = 103+66.07
 $\Delta = 53^\circ 08' 58''$ (LT)
 $D = 12^\circ 47' 27''$
 $R = 447.94'$
 $T = 224.07'$
 $L = 415.53'$
 $E = 52.91'$
 $e = \text{-----}$
 T.R. = -----
 S.E. RUN = -----
 P.C. STA. = 101+42.00
 P.T. STA. = 105+57.53

INLETS TO BE ADJUSTED
 TYPE 11 FRAME AND GRATE
 STA. 106+00, 3.0 RT
 FL ELEV. 600.66



EXIST. CURVE C31
 PI STA. = 105+92.77
 $\Delta = 7^\circ 41' 25''$ (LT)
 $D = 10^\circ 55' 35''$
 $R = 524.38'$
 $T = 35.24'$
 $L = 70.38'$
 $E = 1.18'$
 $e = \text{-----}$
 T.R. = -----
 S.E. RUN = -----
 P.C. STA. = 105+57.53
 P.T. STA. = 106+27.91

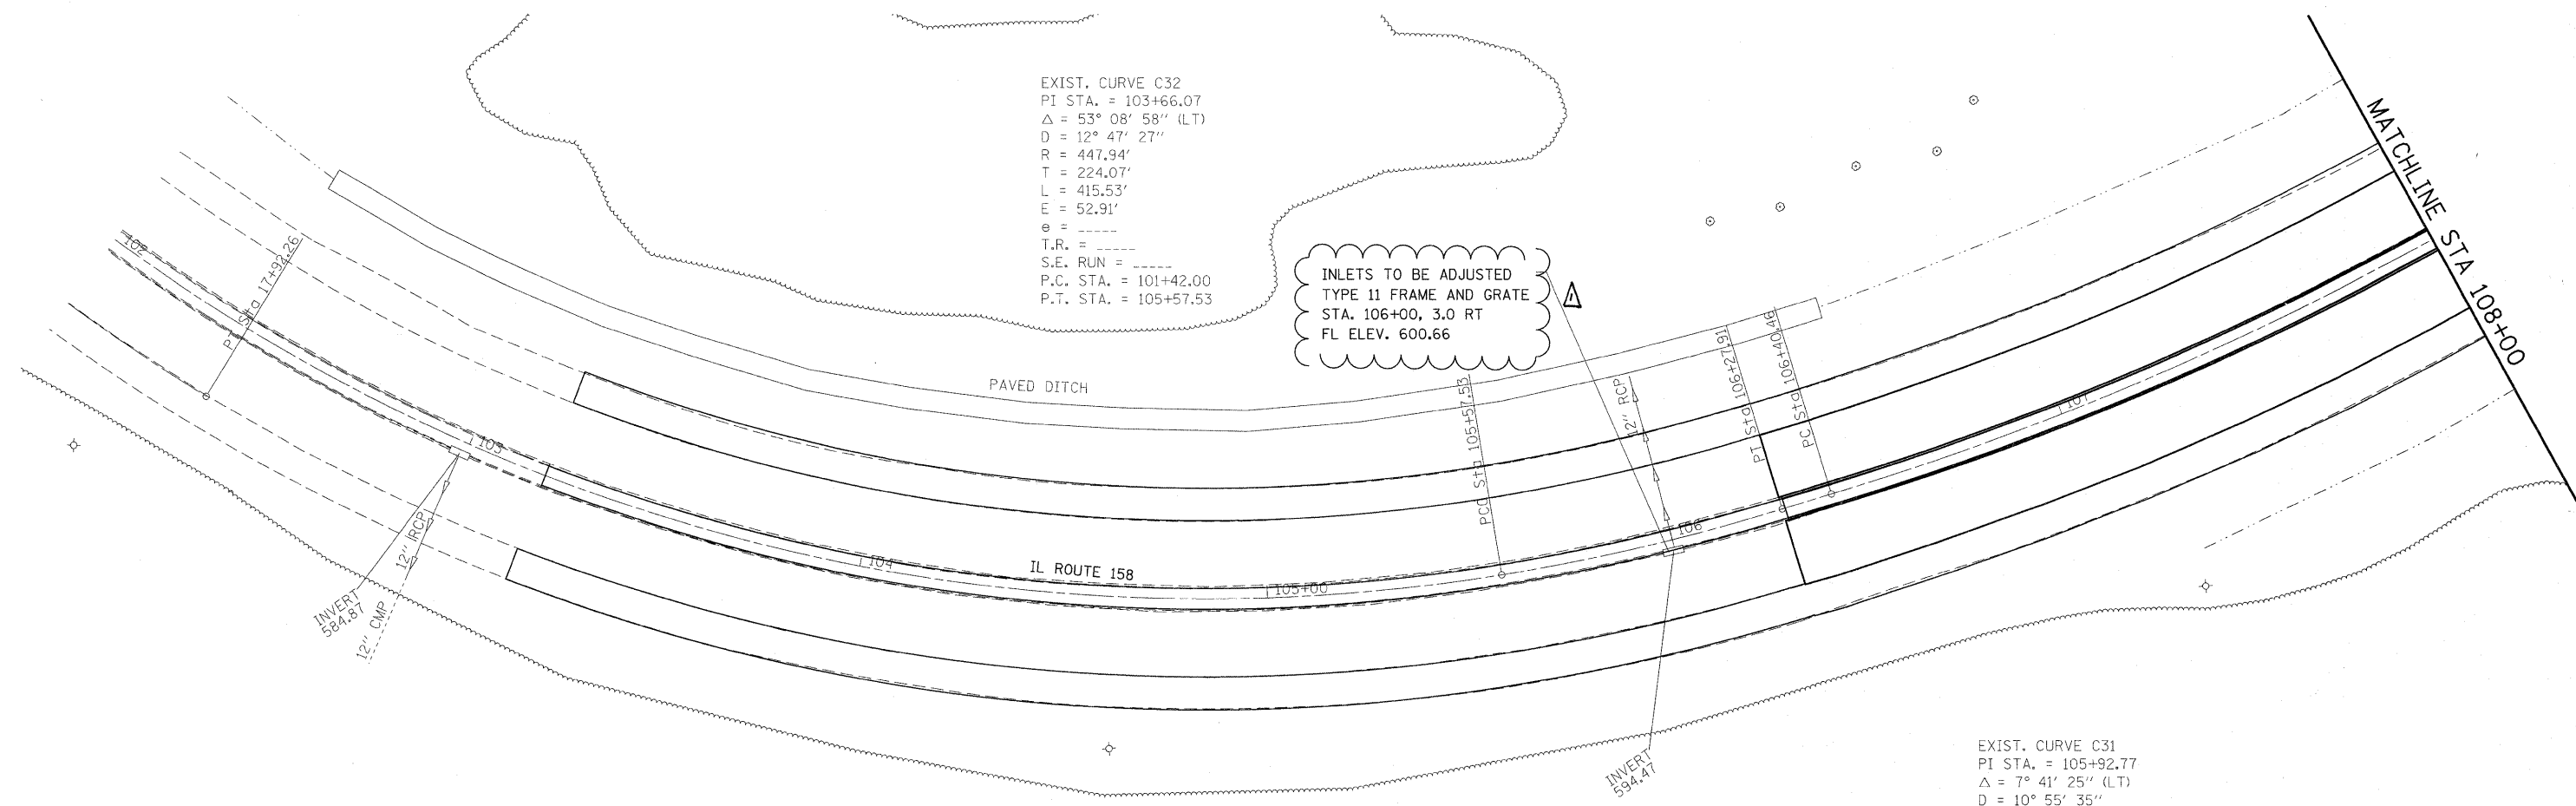

MATCHLINE STA 108+00

FILE NAME =	USER NAME = owenbj	DESIGNED -	REVISED -	STATE OF ILLINOIS DEPARTMENT OF TRANSPORTATION	DRAINAGE PLAN			F.A.P. RTE.	SECTION	COUNTY	TOTAL SHEETS	SHEET NO.
ct:\pwork\p1dot\owenbj\dms52558\p1n2006.dgn	PLOT SCALE = 20.0000' / 1"	DRAWN -	REVISED -					809	67-1HBR	MONROE	144	48
PLOT DATE = 2/5/2010	DATE -	CHECKED -	REVISED -		CONTRACT NO. 76977							
		DATE -	REVISED -		SCALE:	SHEET NO. OF SHEETS	STA. TO STA.	FED. ROAD DIST. NO. ILLINOIS FED. AID PROJECT				

Rev. 9-11-10

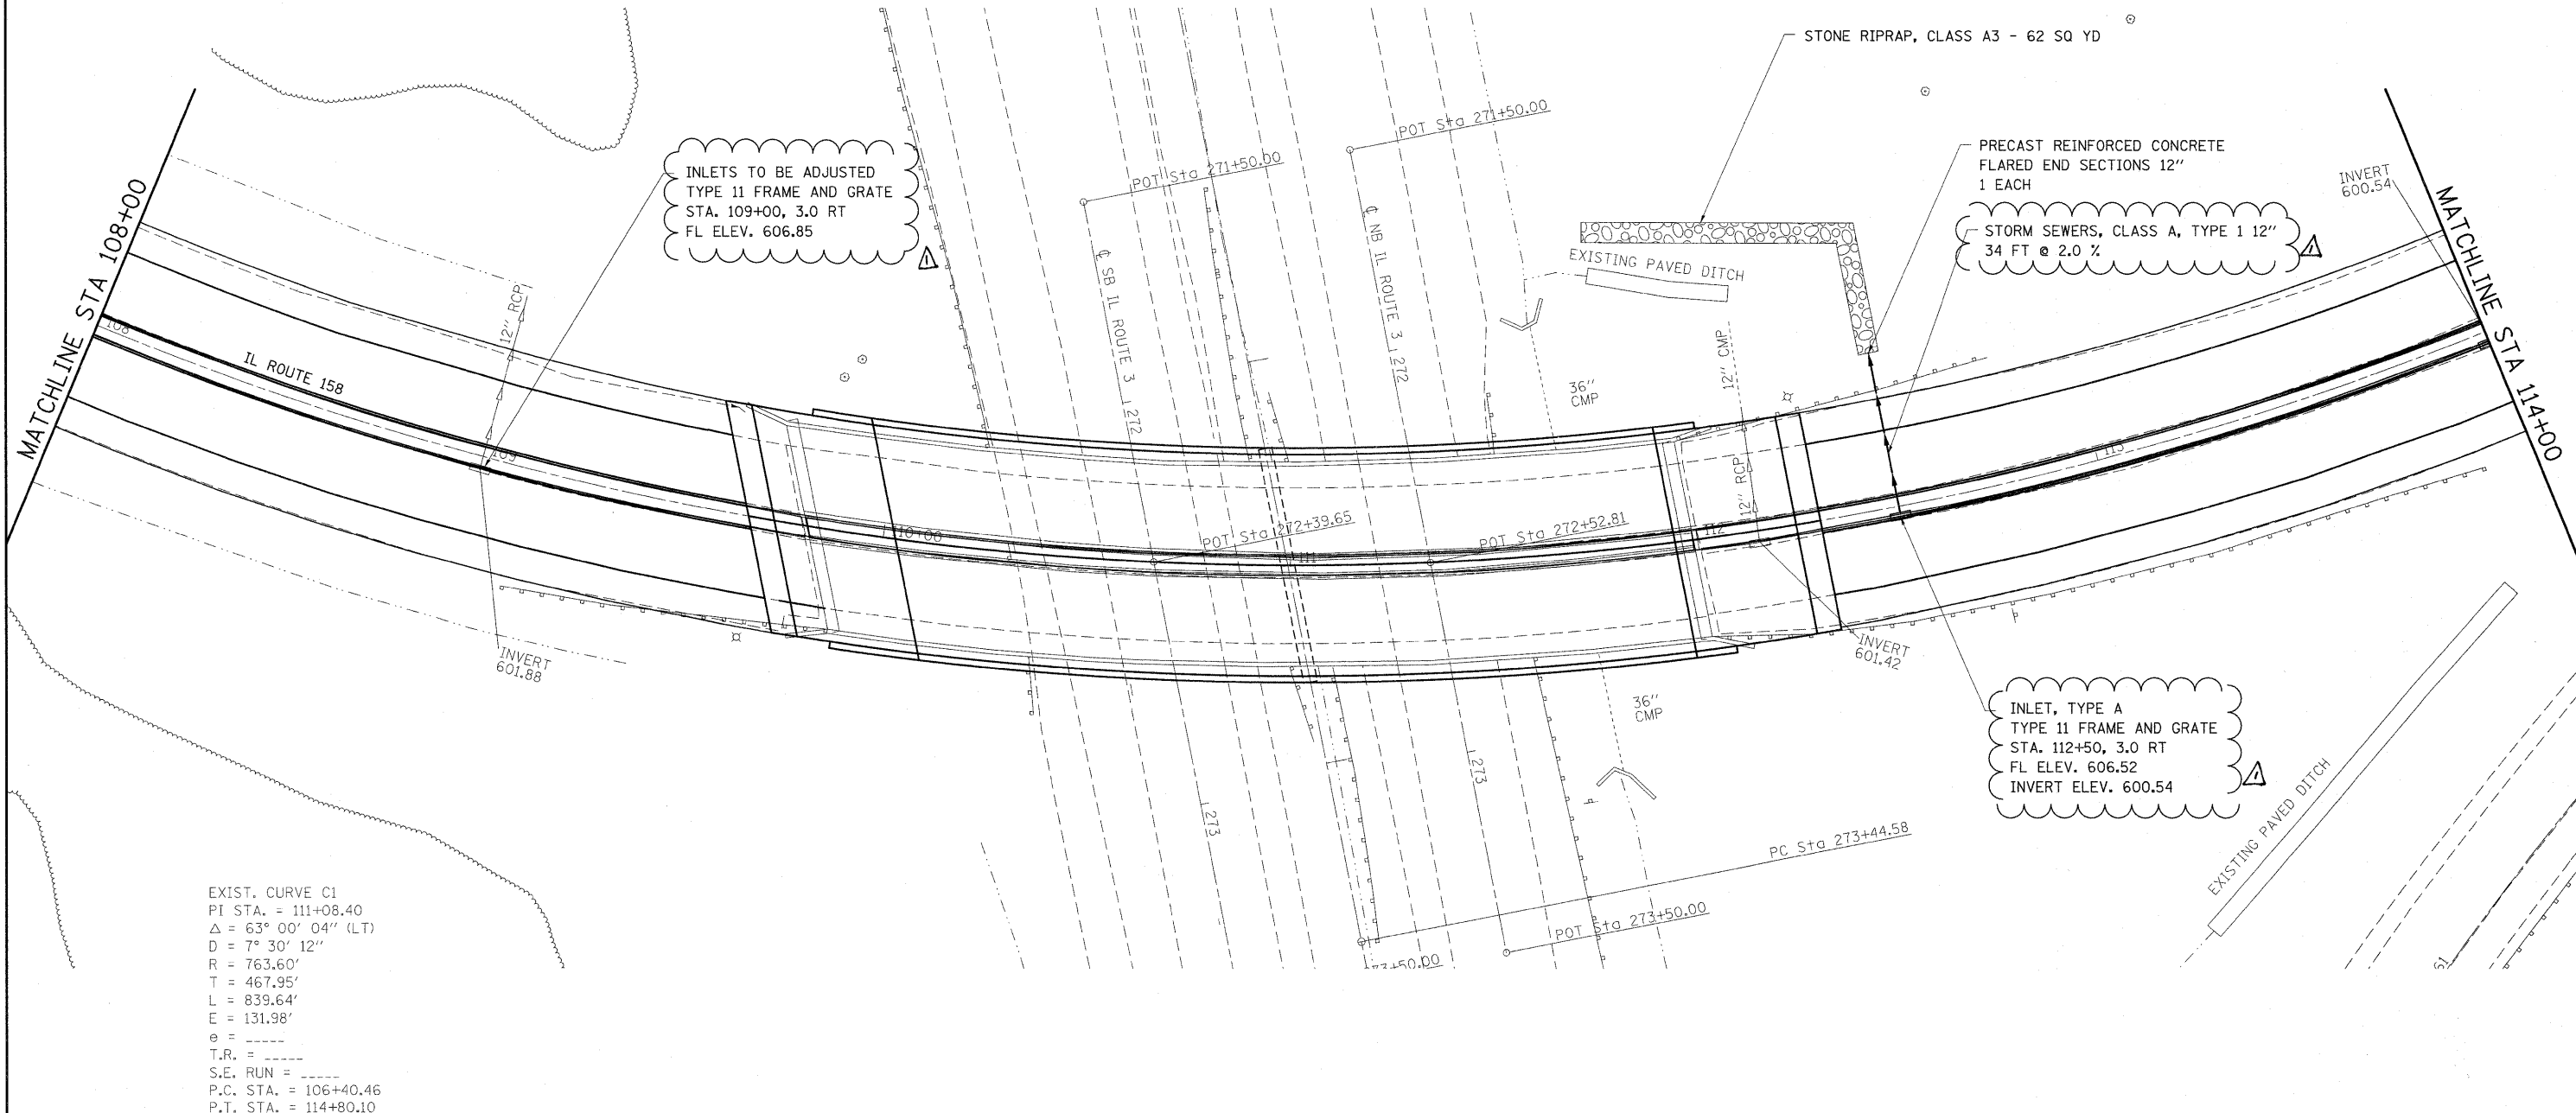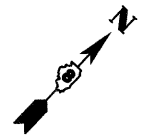

FILE NAME =	USER NAME = owenbj	DESIGNED -	REVISED -
ca:\pw\work\p1\dot\owenbj\dms52558\p1\2010\26a.dgn		DRAWN -	REVISED -
PLOT SCALE = 20.0000' / IN.		CHECKED -	REVISED -
PLOT DATE = 2/5/2010		DATE -	REVISED -

**STATE OF ILLINOIS
DEPARTMENT OF TRANSPORTATION**


DRAINAGE PLAN

SCALE: SHEET NO. OF SHEETS STA. TO STA.

Rev. 2-11-10

F.A.P. RTE.	SECTION	COUNTY	TOTAL SHEETS	SHEET NO.
809	67-1HBR	MONROE	144	49
FED. ROAD DIST. NO. ILLINOIS FED. AID PROJECT			CONTRACT NO. 76977	

EXIST. CURVE C108
 PI STA. = 27+47.92
 $\Delta = 13^\circ 18' 44''$ (RT)
 D = $7^\circ 40' 32''$
 R = 746.46'
 T = 87.11'
 L = 173.43'
 E = 5.07'
 e = -----
 T.R. = -----
 S.E. RUN = -----
 P.C. STA. = 26+60.81
 P.T. STA. = 28+34.25

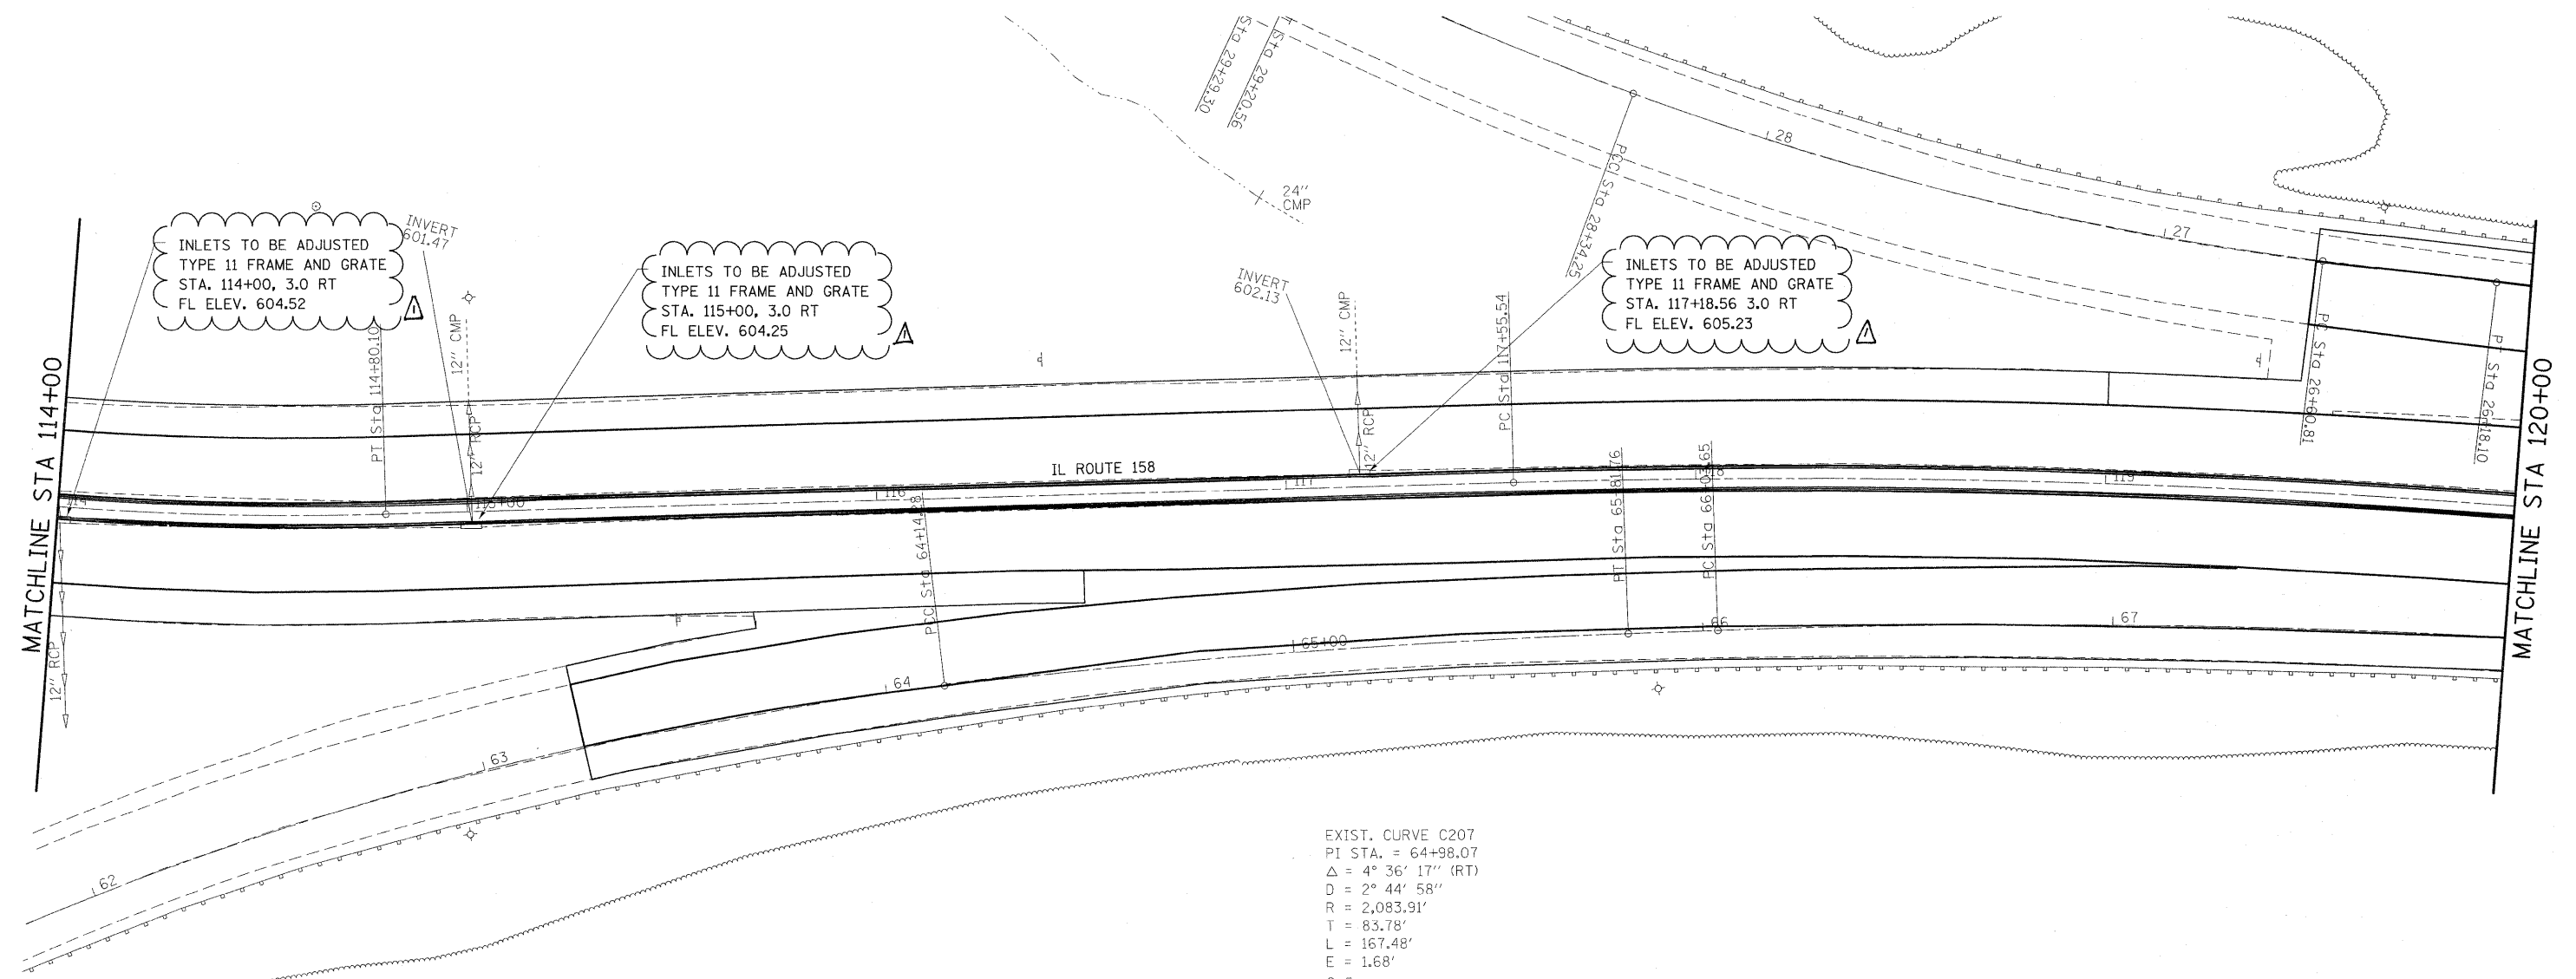

INLETS TO BE ADJUSTED
 TYPE 11 FRAME AND GRATE
 STA. 114+00, 3.0 RT
 FL ELEV. 604.52

INLETS TO BE ADJUSTED
 TYPE 11 FRAME AND GRATE
 STA. 115+00, 3.0 RT
 FL ELEV. 604.25

INLETS TO BE ADJUSTED
 TYPE 11 FRAME AND GRATE
 STA. 117+18.56 3.0 RT
 FL ELEV. 605.23

EXIST. CURVE C206
 PI STA. = 62+28.63
 $\Delta = 25^\circ 49' 23''$ (RT)
 D = $6^\circ 50' 05''$
 R = 838.31'
 T = 192.18'
 L = 377.83'
 E = 21.75'
 e = -----
 T.R. = -----
 S.E. RUN = -----
 P.C. STA. = 60+36.46
 P.T. STA. = 64+14.28

EXIST. CURVE C207
 PI STA. = 64+98.07
 $\Delta = 4^\circ 36' 17''$ (RT)
 D = $2^\circ 44' 58''$
 R = 2,083.91'
 T = 83.78'
 L = 167.48'
 E = 1.68'
 e = -----
 T.R. = -----
 S.E. RUN = -----
 P.C. STA. = 64+14.28
 P.T. STA. = 65+81.76

FILE NAME =	USER NAME = owenbj	DESIGNED -	REVISED -
ca:\pw_work\p\dot\owenb\ndms52558\p\in0006a.dgn		DRAWN -	REVISED -
PLOT SCALE = 20,0000' / IN.		CHECKED -	REVISED -
PLOT DATE = 2/5/2010		DATE -	REVISED -

**STATE OF ILLINOIS
 DEPARTMENT OF TRANSPORTATION**

DRAINAGE PLAN

SCALE: SHEET NO. OF SHEETS STA. TO STA.

Rev. 2-11-10

F.A.P. RTE.	SECTION	COUNTY	TOTAL SHEETS	SHEET NO.
809	67-1HBR	MONROE	144	50
CONTRACT NO. 76977				
FED. ROAD DIST. NO. ILLINOIS FED. AID PROJECT				


EXIST. CURVE C109
 PI STA. = 23+10.16
 $\Delta = 14^\circ 37' 28''$ (LT)
 $D = 2^\circ 21' 42''$
 $R = 2,426.18'$
 $T = 311.33'$
 $L = 619.27'$
 $E = 19.89'$
 $e = \text{-----}$
 T.R. = -----
 S.E. RUN = -----
 P.C. STA. = 19+98.83
 P.T. STA. = 26+18.10



INLETS TO BE ADJUSTED
 TYPE 11 FRAME AND GRATE
 STA. 120+17.76, 3.0 LT
 FL ELEV. 610.48

INLETS TO BE ADJUSTED
 TYPE 11 FRAME AND GRATE
 STA. 123+17.09, 3.0 LT
 FL ELEV. 619.49

INLETS TO BE ADJUSTED
 TYPE 11 FRAME AND GRATE
 STA. 125+16.52, 3.0 LT
 FL ELEV. 625.38

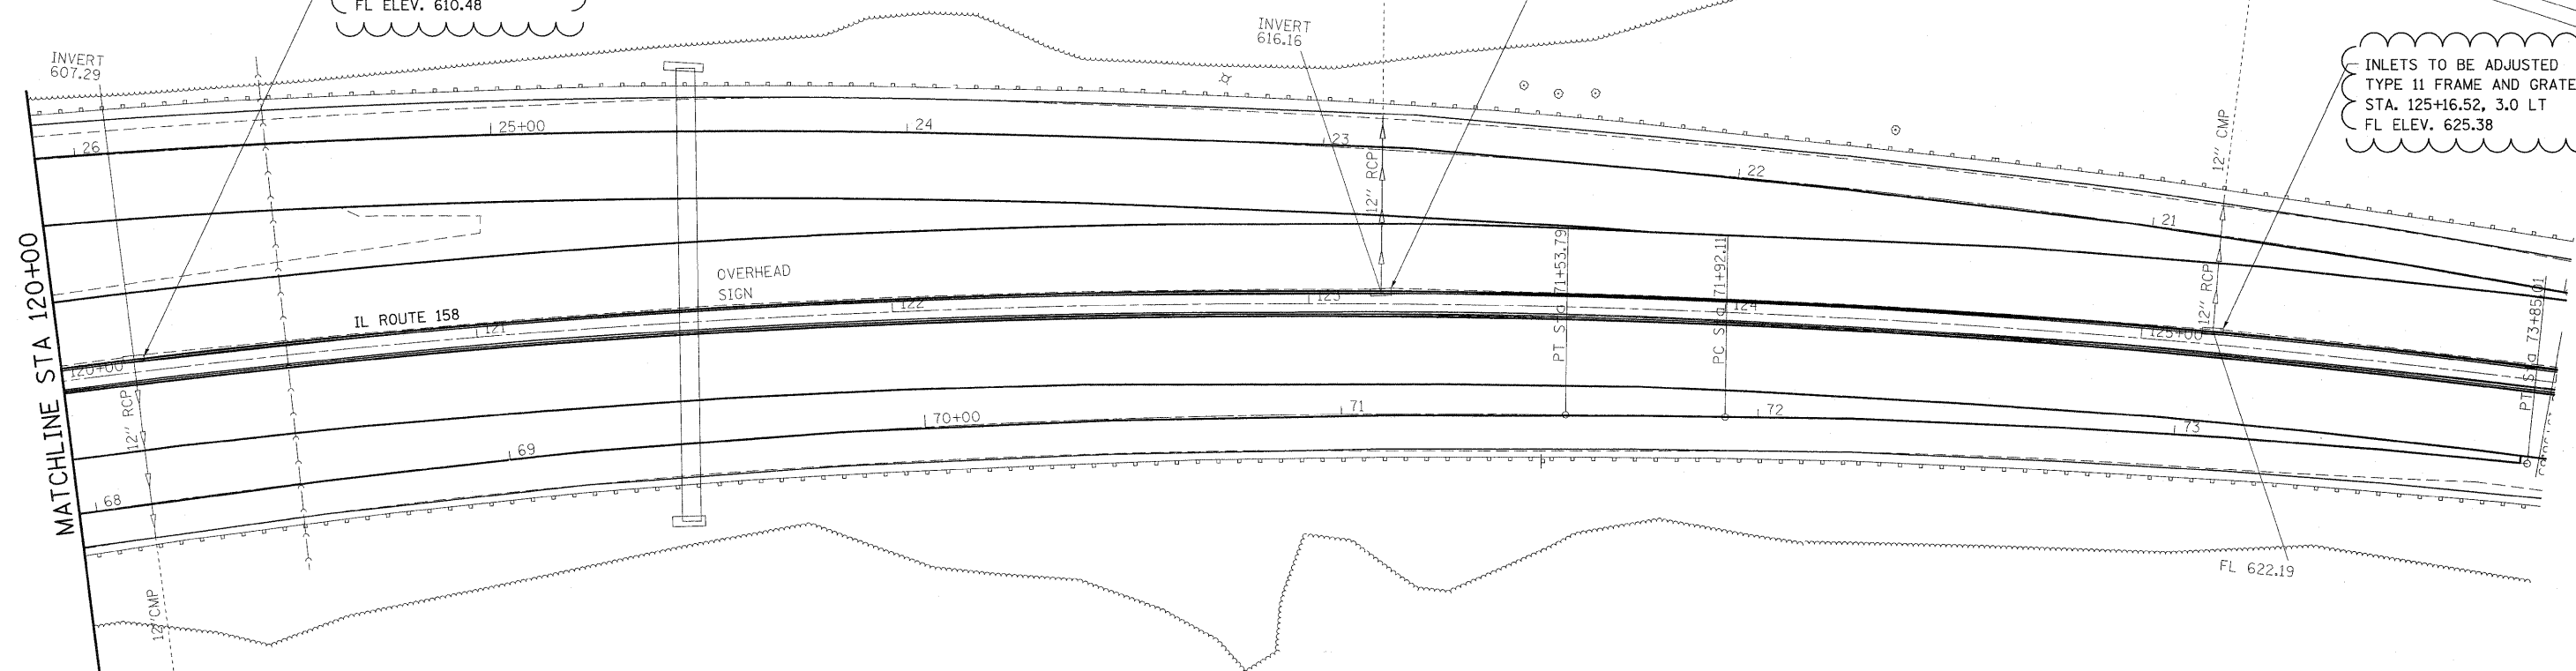

EXIST. CURVE C208
 PI STA. = 68+80.14
 $\Delta = 14^\circ 13' 45''$ (RT)
 $D = 2^\circ 35' 11''$
 $R = 2,215.22'$
 $T = 276.49'$
 $L = 550.14'$
 $E = 17.19'$
 $e = \text{-----}$
 T.R. = -----
 S.E. RUN = -----
 P.C. STA. = 66+03.65
 P.T. STA. = 71+53.79

EXIST. CURVE C2
 PI STA. = 123+50.42
 $\Delta = 27^\circ 50' 31''$ (RT)
 $D = 2^\circ 23' 14''$
 $R = 2,400.00'$
 $T = 594.87'$
 $L = 1,166.24'$
 $E = 72.62'$
 $e = \text{-----}$
 T.R. = -----
 S.E. RUN = -----
 P.C. STA. = 117+55.54
 P.T. STA. = 129+21.79

EXIST. CURVE C209
 PI STA. = 72+88.62
 $\Delta = 4^\circ 54' 50''$ (RT)
 $D = 2^\circ 32' 51''$
 $R = 2,249.13'$
 $T = 96.51'$
 $L = 192.90'$
 $E = 2.07'$
 $e = \text{-----}$
 T.R. = -----
 S.E. RUN = -----
 P.C. STA. = 71+92.11
 P.T. STA. = 73+85.01

FILE NAME =	USER NAME = owenbj	DESIGNED -	REVISED -	STATE OF ILLINOIS DEPARTMENT OF TRANSPORTATION	DRAINAGE PLAN			F.A.P. RTE.	SECTION	COUNTY	TOTAL SHEETS	SHEET NO.
es:\pw\work\p\idot\owenbj\dms52558\p\in2006a.dgn	DRAWN -	REVISED -	809					67-1HBR	MONROE	144	51	
PLOT SCALE = 28,0000 ' / IN.	CHECKED -	REVISED -	CONTRACT NO. 76977									
PLOT DATE = 2/5/2010	DATE -	REVISED -	ILLINOIS FED. AID PROJECT									

Rev. 2-11-10

STATE OF ILLINOIS
DEPARTMENT OF TRANSPORTATION

INDEX OF SHEETS

- 1 - GENERAL PLAN AND ELEVATION
- 2 - INDEX OF DRAWINGS, TOTAL BILL OF MATERIAL & GENERAL NOTES
- 3 - CONSTRUCTION STAGING DETAILS
- 4 - FOOTING LAYOUT AND TEMPORARY SHEET PILING DETAILS
- 5 - SLOPEWALL & SECTION THRU ABUTMENT DETAILS
- 6 - REMOVAL PLAN AND DETAILS
- 7 - TOP OF DECK ELEVATION I
- 8 - TOP OF DECK ELEVATION II
- 9 - TOP OF DECK ELEVATION III
- 10 - SUPERSTRUCTURE PLAN & CROSS SECTION
- 11 - SUPERSTRUCTURE DETAILS
- 12 - PREFORMED JOINT STRIP SEAL DETAILS
- 13 - FRAMING PLAN
- 14 - GIRDER DETAILS I
- 15 - GIRDER DETAILS II
- 16 - DIAPHRAGM DETAILS
- 17 - BEARING DETAILS
- 18 - WEST ABUTMENT DETAILS
- 19 - SOUTHWEST WINGWALL DETAILS I
- 20 - SOUTHWEST WINGWALL DETAILS II
- 21 - NORTHWEST WINGWALL DETAILS I
- 22 - NORTHWEST WINGWALL DETAILS II
- 23 - EAST ABUTMENT DETAILS
- 24 - EAST ABUTMENT WINGWALL DETAILS
- 25 - PIER DETAILS
- 26 - STEEL H PILES
- 27 - BAR SPLICER ASSEMBLY DETAILS
- 28 - TEMPORARY CONCRETE BARRIER FOR STAGE CONSTRUCTION
- 29 - BRIDGE APPROACH PAVEMENT PLAN & CROSS SECTION
- 30 - BRIDGE APPROACH PAVEMENT DETAILS
- 31 - TOP OF WEST APPROACH SLAB ELEVATIONS
- 32 - TOP OF EAST APPROACH SLAB ELEVATIONS
- 33 - SOIL BORING LOGS I
- 34 - SOIL BORING LOGS II

GENERAL NOTES

1. Fasteners shall be AASHTO M164 Type I, mechanically galvanized bolts. Bolts $\frac{7}{8}$ " ϕ , open holes $\frac{5}{16}$ " ϕ , unless otherwise noted.
2. Calculated weight of Structural Steel = 403,400 lbs
3. No field welding is permitted except as specified in the contract documents.
4. Reinforcement bars shall conform to the requirements of ASTM A 706 Gr 60. See Special Provisions.
5. Reinforcement bars designated (E) shall be epoxy coated.
6. Bearing seat surfaces shall be constructed or adjusted to the designated elevations within a tolerance of $\frac{1}{8}$ in. (0.01 ft.). Adjustment shall be made either by grinding the surface or by shimming the bearings.
7. Concrete Sealer shall be applied to the designated areas of the abutments.
8. The Organic Zinc Rich Primer / Epoxy / Urethane Paint System shall be used for painting of new structural steel except where otherwise noted. The entire system shall be shop applied, with the exception that masked off connection surfaces, field installed fasteners and damaged areas shall be touched up in the field. The color of the final finish coat for all interior steel surfaces shall be Gray, Munsell No. 5B 7/1. The color of the final finish coat for the exterior and bottom flange of the fascia beams shall be Gray Munsell No. 5B YR 7/1. See Special Provision for "Cleaning and Painting New Metal Structures".
9. The embankment configuration shown shall be the minimum that must be placed and compacted prior to construction of the abutments.
10. The Contractor shall drive test piles to 110% of the nominal required bearing specified in production locations at substructures specified or approved by the Engineer before ordering the remainder of the piles.
11. Slipforming of the parapets is not allowed.
12. The existing structural steel coating contains lead. The contractor shall take appropriate precautions to deal with the presence of lead on this project.

TOTAL BILL OF MATERIAL

ITEM	UNIT	SUPER	SUB	TOTAL
Removal of Existing Structures	Each	-	-	1
Protective Coat	Sq Yd	1,322	55	1,377
Concrete Superstructure	Cu Yd	539	-	539
Concrete Structures	Cu Yd	-	543	543
Name Plates	Each	1	-	1
Prefomed Joint Strip Seal	Foot	115	-	115
Elastomeric Bearing Assembly, Type I	Each	16	-	16
Protective Shield	Sq Yd	1,018	-	1,018
Furnishing and Erecting Structural Steel	L Sum	1	-	1
Bridge Deck Grooving	Sq Yd	1,022	-	1,022
Stud Shear Connectors	Each	6,960	-	6,960
Reinforcement Bars, Epoxy Coated	Pound	117,522	84,498	202,020
Structure Excavation	Cu Yd	-	157	157
Concrete Sealer	Sq Ft	-	1531	1531
Slope Wall 4 Inch	Sq Yd	-	494	494
Geocomposite Wall Drain	Sq Yd	-	274	274
Test Pile Steel HP 12 x 53	Each	-	1	1
Furnishing Steel Piles HP 12 x 53	Foot	-	513	513
Driving Piles	Foot	-	513	513
Pile Shoes	Each	-	20	20
Pipe Underdrains for Structures 4 Inch	Foot	-	247	247
Bar Splicers	Each	-	303	303
Mechanical Splicers	Each	-	120	120
Porous Granular Embankment, Special	Cu Yd	-	139	139
Temporary Sheet Piling	Sq Ft	-	163	163
Rock Excavation For Structures	Cu Yd	-	349	349
Concrete Encasement	Cu Yd	-	7	7
Anchor Bolts 1 1/2"	Each	-	32	32
Anchor Bolts 2"	Each	-	16	16
Pile Extraction	Each	-	8	8
Temporary Support System	L Sum	-	1	1
Temporary Soil Retention System	Sq Ft	-	207	207

STATION 110+99.40
BUILT BY
STATE OF ILLINOIS
F.A. RT. 158 SEC. 67-1HBR
LOADING HL-93
STR. NO. 067-0042

NAME PLATE
See Std. 515001

INDEX OF DRAWINGS, BILL OF MATERIAL & GENERAL NOTES
STRUCTURE NO. 067-0042

DESIGNED - JPM
CHECKED - WPM
DRAWN - GAP
CHECKED - JPM, WPM



9-28-09

SHEET NO. 2	F.A.P RTE.	SECTION	COUNTY	TOTAL SHEETS	SHEET NO.
34 SHEETS	809	67-1HBR	Monroe	144	66
CONTRACT NO. 76977					
FED. ROAD DIST. NO. 7 ILLINOIS FED. AID PROJECT					

Rev. 2-11-10