


ROUTE NO.	DISTRICT	COUNTY	SECTION	SHEET NO.
FAI 55		McLEAN	70	5
FED. ROAD DIST. NO. 7		FED. ROAD PROJECT		

• (07-1)HBR-5&VBR-11&57-2HB-1

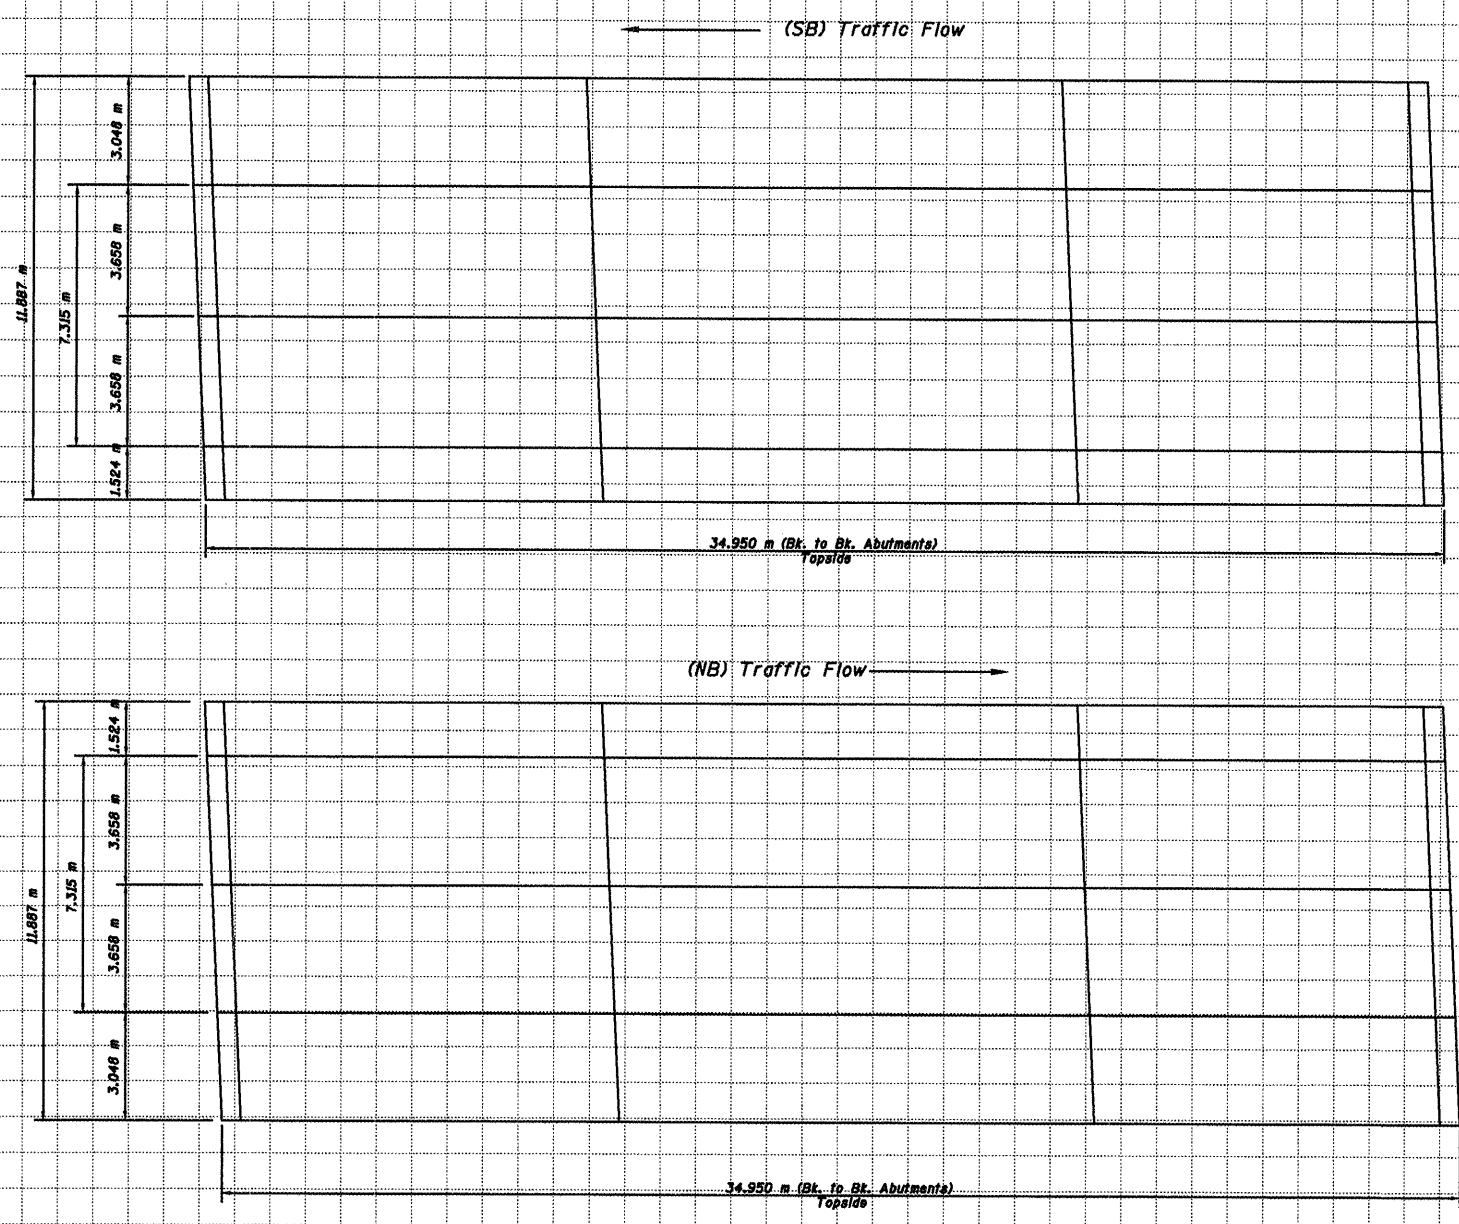

DESIGNED	JDA
CHECKED	JKC
DRAWN	NO
CHECKED	JDA

AS BUILT  
 DECK REPAIRS  
 F.A.I. 55 OVER LINDEN STREET  
 McLEAN COUNTY  
 SN 057-0028 (NB)  
 SN 057-0029 (SB)  
 STA. 38+543.992