SUMMARY OF QUANTITIES F						FUNDING CATEGORY \ CONSTRUCTION TYPE CODE					
SPECIALTY ITEM	PAY CODE	PAY ITEM	UNIT	TOTAL QUANTITY	ITEP 50/50 0031	ITEP 80/20 0028	NON-PARTICIPATING 0043	STATE ONLY 100% STATE 0005			
	60601805	CONCRETE CURB TRANSITION	FOOT	63		63					
	60603800	COMBINATION CONCRETE CURB AND GUTTER, TYPE B-6.12	FOOT	16		***		16			
	60605000	COMBINATION CONCRETE CURB AND GUTTER, TYPE B-6.24	FOOT	5224				5224			
	60626500	TRANSITIONAL COMBINATION CONCRETE CURB AND GUTTER	FOOT	357		236		121			
*	66900200	NON-SPECIAL WASTE DISPOSAL	CU YD	310	100000	310					
*	66900530	SOIL DISPOSAL ANALYSIS	EACH	2		2					
***************************************	66901001	REGULATED SUBSTANCES PRE-CONSTRUCTION PLAN	LSUM		~~~~~~~~~~~~~~~~~~~~~~~~~~~~~~~~~~~~~~~	······································					
***************************************	66901002	ON-SITE MONITORING OF REGULATED SUBSTANCES	ČĂĽĎĂ	5		5					
*	66901003	REGULATED SUBSTANCES FINAL CONSTRUCTION REPORT	LSUM	1		1					
	67000500	ENGINEER'S FIELD OFFICE, TYPE B	CAL MO	12		7.2		4.8			
	67100100	MOBILIZATION	LSUM	1		0.6		0.4			
	70103815	TRAFFIC CONTROL SURVEILLANCE	CAL DA	200		120		80			
	70107025	CHANGEABLE MESSAGE SIGN	CAL DA	180	· · · · · · · · · · · · · · · · · · ·	108		72			
	70300100	SHORT TERM PAVEMENT MARKING	FOOT	5100				5100			
	70300150	SHORT TERM PAVEMENT MARKING REMOVAL	SQ FT	1700				1700			
*	78009000	MODIFIED URETHANE PAVEMENT MARKING - LETTERS AND SYMBOLS	SQ FT	413	***************************************			413			
*	78009004	MODIFIED URETHANE PAVEMENT MARKING - LINE 4"	FOOT	5538				5538			

O FINAL QUANTITIES SHALL BE SPLIT 40% STATE ONLY / 60% ITEP 80/20

MW
Midwest Engineering
A

USER NAME = IDOTCAD	DESIGNED - KMC	REVISED - CADD. #1 (2-04-19)
	DRAWN - KRS DLC	REVISED -
PLOT SCALE = 2.000 FT / in.	CHECKED - RDC	REVISED -
PLOT DATE = 2/4/2019	DATE - SDATE	REVISED -

STATI	E OF	ILLINOIS
DEPARTMENT	OF	TRANSPORTATION

				IL. RTE. 29)		F.A.P. RTE.	SECTION	COUNTY	TOTAL	SHEE NO.
١	SUMMARY OF QUANTITIES						669	16-00045-01-SW	TAZEWELL	155	11
			JUNINA	iti di ud	ARTITIES				CONTRAC	T NO. 8	89713
	SCALE: NONE	SHEET 6	OF 11	SHEETS	STA.	TO STA.		ILLINOIS FED	. AID PROJECT OS	E2(122)	


		SUMMARY OF QUANTITIES	FUNDING CATEGORY \ CONSTRUCTION TYPE CODE					
SPECIALTY ITEM	PAY CODE	PAY ITEM	UNIT	TOTAL QUANTITY	ITEP 50/50 0031	ITEP 80/20 0028	NON-PARTICIPATING 0043	STATE ONLY 100% STATE 0005
*	Z0015300	CURB STOPS 2"	EACH	3			3	
								ANTONIA
	Z0023600	FILLING EXISTING CULVERTS	EACH	2		***************************************		2
	70000700	LONGITI DINIAL LOINT OF ALANT.	FOOT	40500				40500
	20033700	LONGITUDINAL JOINT SEALANT	FOOT	13500				13500
	Z0034105	MATERIAL TRANSFER DEVICE	TON	1513				1513
	Z0041500	PLUG EXISTING CULVERTS	EACH	1				1
*	Z0049901	REMOVAL AND DISPOSAL OF NON-FRIABLE ASBESTOS, BUILDING NO. 1	LSUM	1		1		
	Z0056648	STORM SEWERS, TYPE 1, WATER MAIN QUALITY PIPE, 12"	FOOT	197				197
	Z0056652	STORM SEWERS, TYPE 1, WATER MAIN QUALITY PIPE, 18"	FOOT	30				30
	Z0056668	STORM SEWERS, TYPE 2, WATER MAIN QUALITY PIPE, 12"	FOOT	327				327
~~~	Z0056678	STORM SEWERS, TYPE 2, WATER MAIN QUALITY PIPE, 36"	FOOT	35				35
		UNDERGROUND CONDUIT, PVC, 1 1/4" DIA.	FOOT	5429	* * * * * *	* * * * * *	* * * * * * * * * * * * * * * * * * *	5429
		DRILL EXISTING HANDHOLE	EACH	8				8
- www.		CAT 5 ETHERNET CABLE	FOOT	288.5		***************************************		288.5
		CLOSED CIRCUIT TELEVISION DOME CAMERA, IP BASED	EACH	2				2
*	X0327607	FIBER OPTIC SPLICE-MAINLINE	EACH	2				2
*	X8710030	FIBER OPTIC CABLE 48 FIBERS, SINGLE MODE	FOOT	2519				2519
		FIBER OPTIC ETHERNET DROP AND REPEAT SWITCH	EACH	2				2
*	Z0033052	COMMUNICATIONS VAULT	EACH	3	W 1111.			3
<u> </u>	<u> </u>		سسا	سسا	سىسى	سسس	<del>Junual</del>	<del>uuu</del>
					·			


MW
Midwest Engineering
Associates Inc

USER NAME = IDOTCAD	DESIGNED - KMC	REVISED - 2/22/19
	DRAWN - KRS OLC	REVISED -
PLOT SCALE = 2.000 FT / In.	CHECKED - RDC	REVISED -
PLOT DATE = 1/22/2019	DATE - \$DATE	REVISED -

STATE OF ILLINOIS DEPARTMENT OF TRANSPORTATION

	IL. RTE. 2	F.A.P. RTE.	SECTION		COUNTY	TOTAL SHEETS	SHEET NO.		
SUMMARY OF QUANTITIES					16-00045-01-SW		TAZEWELL	155	16
					CONTRAC	T NO.	89713		
SCALE: NONE	SHEET 11 OF 11 SHEET:	STA.	TO STA.		ILLINOIS	FED. A	AID PROJECT 058	E2(122)	

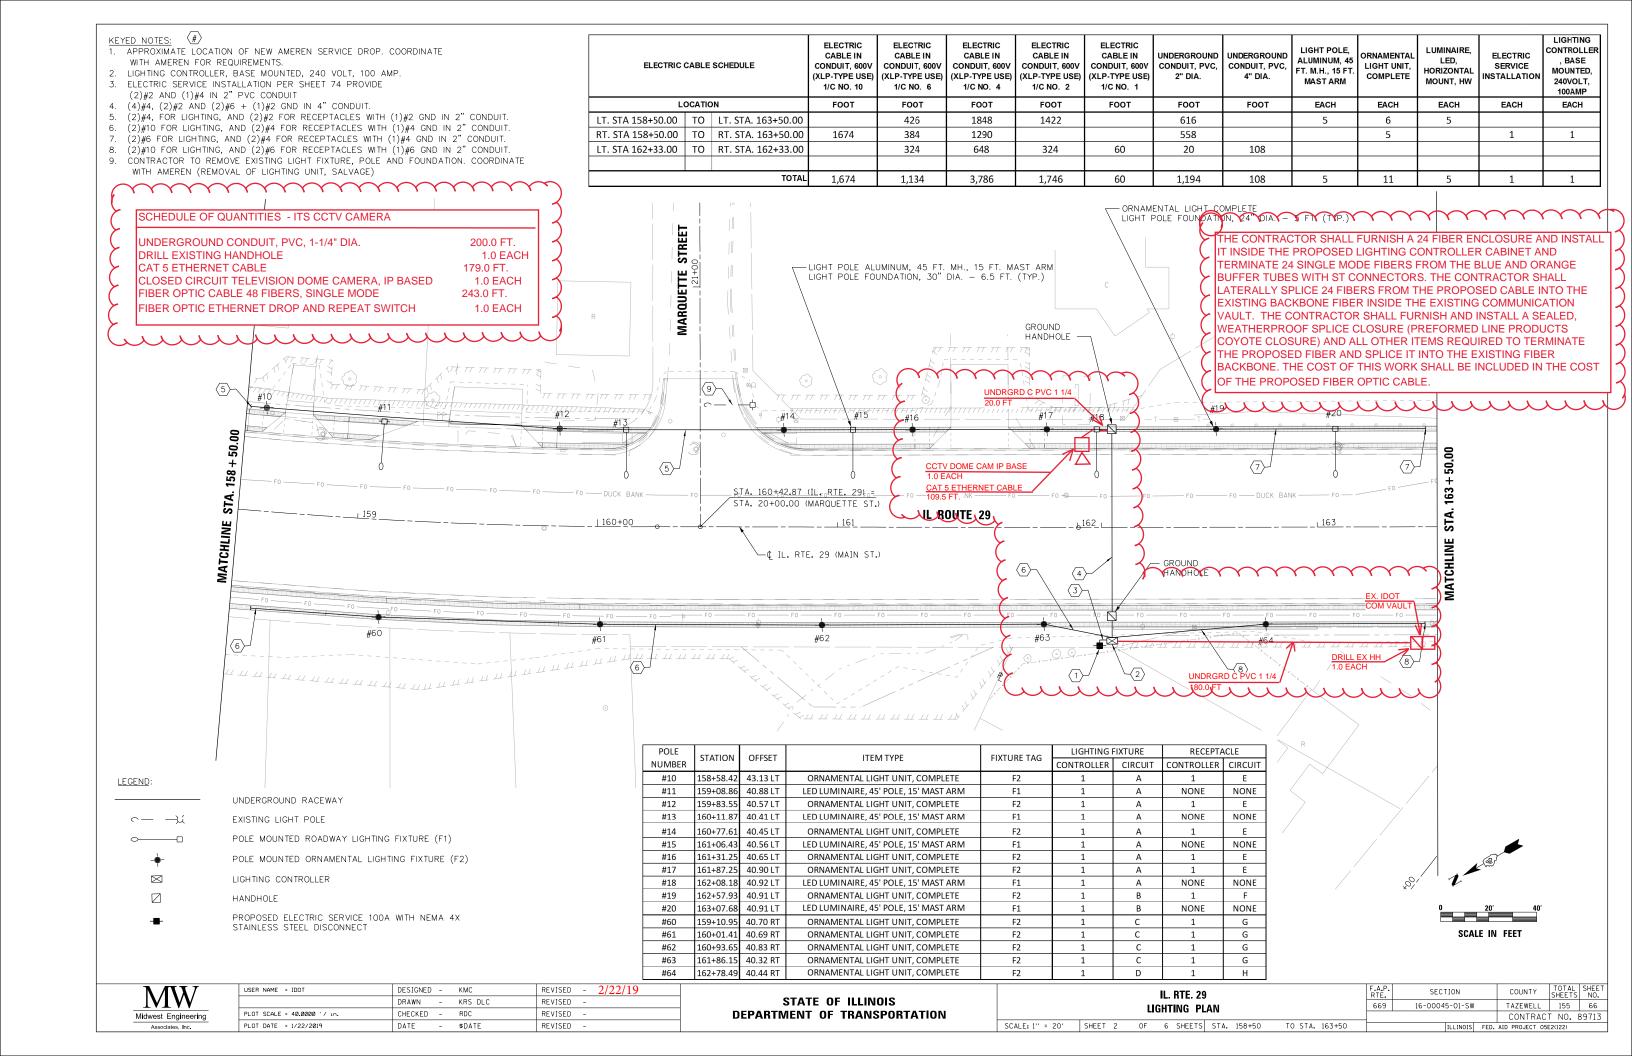

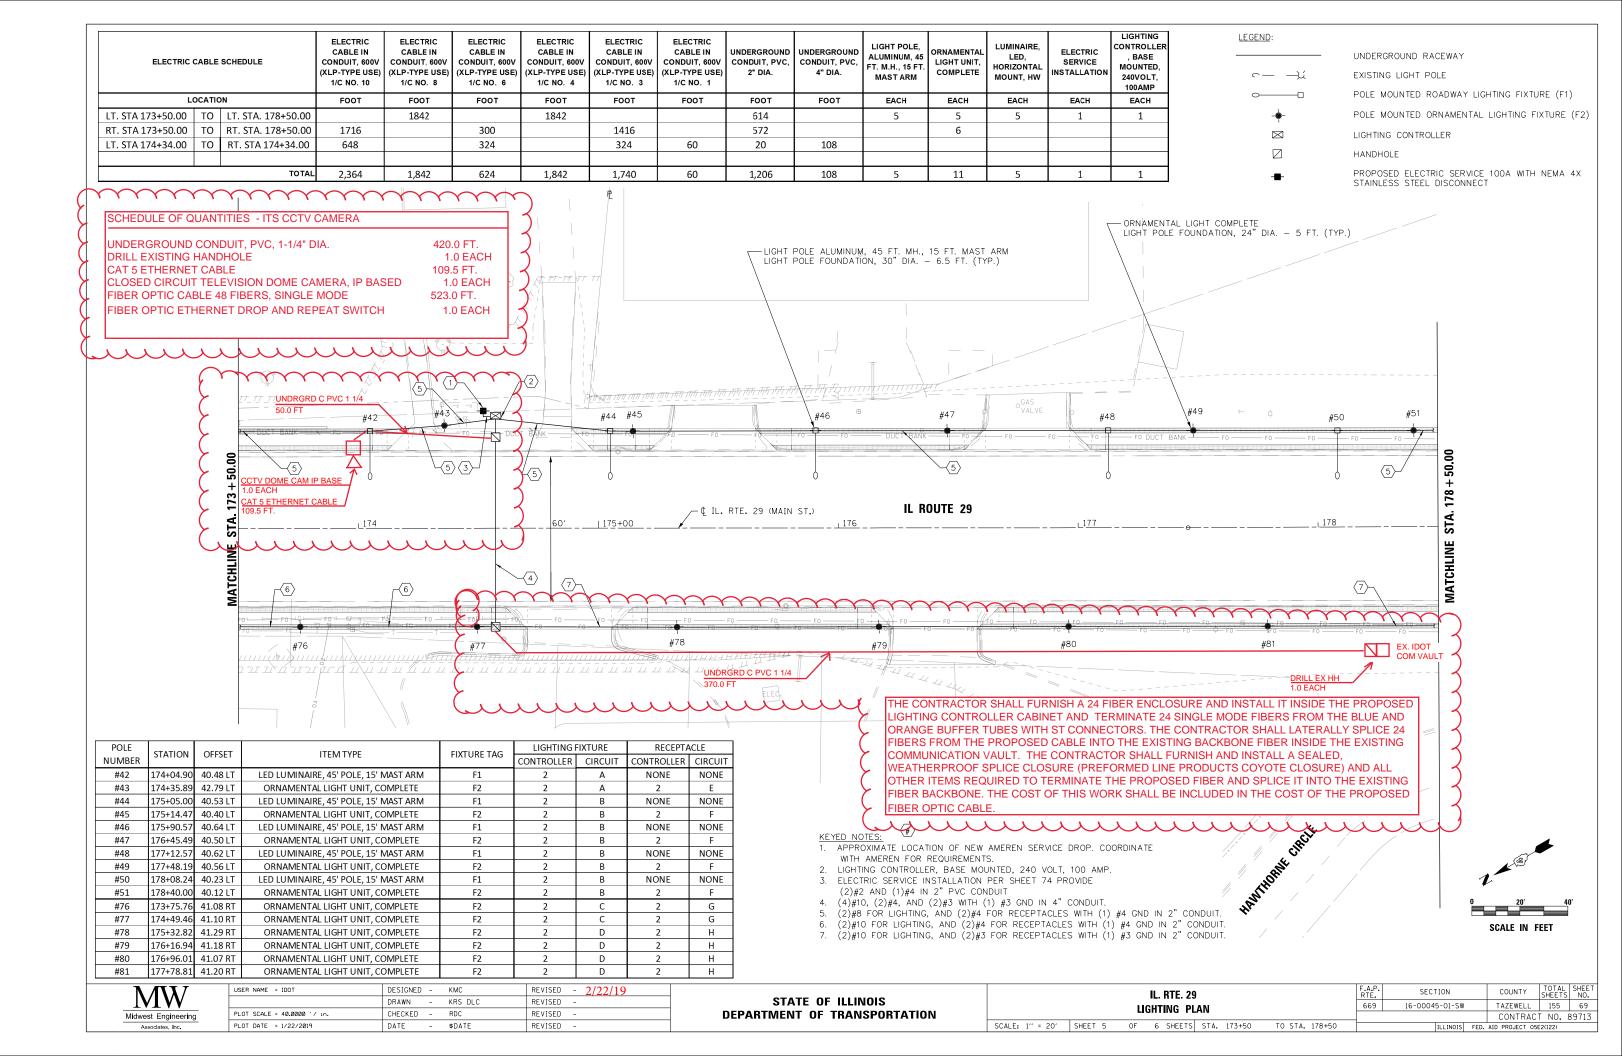

THE CONTRACTOR SHALL LOCATE AND MARK THE ENTIRE RUN OF EXISTING IDOT FIBER OPTIC CABLE BETWEEN THE PROJECT LIMITS PRIOR TO COMMENCING CONSTRUCTION. THE GENERAL CONTRACTOR SHALL WORK WITH THE ELECTRICAL CONTRACTOR AND IDOT TO IDENTIFY AREAS WHERE THE PROPOSED CONSTRUCTION IS IN CONFLICT WITH THE EXISTING IDOT FIBER OPTIC CABLE. THE CONTRACTOR SHALL MEET WITH THE RESIDENT ENGINEER TO IDENTIFY THESE AREAS AND TO DETERMINE THE EXTENT OF RELOCATION THAT IS REQUIRED TO ACCOMODATE THE PROPOSED CONSTRUCTION. IN SOME CASES, THE EXISTING DUCT CAN BE EXPOSED AND RE-ROUTED OUT OF THE WAY OF THE PROPOSED. CONSTRUCTION.

THE EXISTING CONDUIT CONSISTS OF THREE 1-1/4" DIAMETER DUCTS (LOCATED IN COMMON TRENCH), 48SM FIBER OPTIC CABLE, AND COMMUNICATIONS VAULTS.

THE FOLLOWING LOCATIONS HAVE BEEN IDENTIFIED BY THE DESIGNER AS AREAS WHERE THE EXISTING CONDUITS MAY BE IN CONFLICT WITH THE PROPOSED IMPROVEMENTS:

STATION 159+80 (CAUTION, POSSIBLE CONFLICT WITH PROPOSED INLET)

STATION 161+59 (CAUTION, POSSIBLE CONFLICT WITH PROPOSED INLET)

STATION 163+78 (CAUTION, POSSIBLE CONFLICT WITH PROPOSED INLET AND STORM SEWER CROSSING)

STATION 164+50 TO STATION 180+53 (MULTIPLE CONFLICTS, CROSSING AND LONGITUDINAL, THAT MAY REQUIRE RELOCATION)

THE QUANTITIES ASSOCIATED WITH FIBER RELOCATION ARE ESTIMATED QUANTITIES AND MAY VARY DEPENDING UPON FIELD CONDITIONS.

ALL UTILITY COORDINATION AND EXISTING FIBER MARKING SHALL BE INCLUDED IN THE COST OF THE THE PROPOSED 1-1/4" DIA. UNDERGROUND CONDUIT.

RELOCATED FIBERS SHALL BE FUSION SPLICED INTO EXISTING FIBERS INSIDE COMMUNICATIONS VAULTS. THE CONTRACTOR SHALL FURNISH AND INSTALL A SEALED WATERPROOF SPLICE CLOSURE (PREFORMED LINE PRODUCTS COYOYTE CLOSURE), AND ALL ITEMS REQUIRED FOR FIBER OPTIC CABLE SPLICE. ALL SPLICE LOCATIONS WILL BE DETERMINED BY IDOT AND THE MAXIMUM NUMBER OF ALLOWABLE SPLICES IN THE RUN WILL BELIMITED TO TWO MAINLINE SPLICES. THIS WORK SHALL BE INCLUDED IN THE BID PRICE FOR FIBER OPTIC SPLICE-MAINLINE.

## SCHEDULE OF QUANTITIES - FIBER RELOCATION

UNDERGROUND CONDUIT, PVC, 1-1/4" DIA. 4809.0 FOOT DRILL EXISTING HANDHOLE 6.0 EACH FIBER OPTIC CABLE 48 FIBERS, SINGLE MODE 1753.0 FOOT COMMUNICATIONS VAULT 3.0 EACH

	LIGHTING FIXTURES							
TAG	DESCRIPTION	LIGHTING		LAMP				REMARKS
IAG		DISTRIBUTION	APPROXIMATE LUMENS	APPROX. WATTAGE	TYPE	COLOR TEMP	VOLTAGE	REWARKS
F1	ROADWAY LIGHTING FIXTURE ASSEMBLY CONSISTING OF A TAPERED ALUMINUM POLE, & 15' LONG CURVED TRUSS ARM WITH AN OVERALL MOUNTING HEIGHT OF 45' WITH A ROADWAY TYPE LIGHTING LUMINAIRE WITH A CAST ALUMINUM POWER-PAD HOUSING, FULL CUT-OFF OPTICS, AND IES TYPE III DISTRIBUTION. ENTIRE FIXTURE ASSEMBLY SHALL COMPLY WITH IDOT PERFORMANCE SPECIFICATIONS. ASSEMBLY SHALL BE AS DETAILED ON DRAWINGS.	ROADWAY TYPE III	41,857	388	LED	4,000K	240	
F2	SITE LIGHTING FIXTURE ASSEMBLY CONSISTING OF A 14' CAST ALUMINUM ORNAMENTAL POLE WITH CAST RAISED FLUTED BASE WITH A 16" TO 24" OVERALL HEIGHT, TAPERED 6 1/2" TO 4" FLUTED POLE WITH (1) POST TOP MOUNTED ACORN STYLE LUMINAIRE WITH CAST ALUMINUM HOUSING, AND PRESSED PRISMATIC GLASS REFLECTOR. LUMINAIRE SHALL HAVE IES TYPE III LUNAR OPTIC LIGHTING DISTRIBUTION AS REQUIRED. ASSEMBLY SHALL BE AS DETAILED ON THE DRAWINGS.	TYPE III LUNAR OPTIC	1,340	26	LED	4,000K	240	GFCI RECEPTACLE MOUNTED IN POLE, (2) BANNER ARMS ON POLES, FUSED ON EACH PHASE, AND ON RECEPTACLE, & FIXED FLAG HOLDER.
NOTES:	NOTES: 1. CONTRACTOR IS RESPONSIBLE FOR PROVIDING ALL NECESSARY HARDWARE AND MOUNTING COMPONENTS FOR A COMPLETE AND FULLY FUNCTIONAL SYSTEM.							

- - 2. ALL IDOT SPECIFICATIONS SHALL BE FOLLOWED WHEN SELECTING FIXTURES AND HARDWARE.
  - 3. REFER TO DETAILS FOR MOUNTING, POLES, AND ADDITIONAL REQUIREMENTS.
  - 4. COORDINATE WITH EXISTING FIXTURES FOR LOOK AND COLOR TO MATCH THE APPEARANCE.
  - 5. CONTRACTOR SHALL PROVIDE PHOTOMETRIC CALCULATIONS FROM THE MANUFACTURER USING A LIGHT LOSS FACTOR OF 0.684 TO THE ENGINEER DURING THE SUBMITTAL PROCESS. ALL PHOTOMETRIC REQUIREMENTS LISTED IN PERFORMANCE REQUIREMENTS ON THE LUMINAIRE PERFORMANCE TABLE SHALL BE MET.

USER NAME = IDOTCAD	DESIGNED - BJR	REVISED - 2/22/19
	DRAWN - KRS	DLC REVISED -
PLOT SCALE = 40.0032 '/ in.	CHECKED - RDC	REVISED -
PLOT DATE = 1/22/2019	DATE - \$DA	E REVISED -

STATE O	F ILLINOIS
DEPARTMENT OF	TRANSPORTATION

SCALE: 1" = 20"

IL. RTE. 29		F.A.P. RTE.	SECTION	COUNTY	TOTAL SHEETS	SHEET NO.			
LIGHTING SCHEDULES					669	16-00045-01-SW	TAZEWELL	155	71
				CONTRACT NO.			T NO. 8	39713	
	SHEET 1 OF	1 SHEETS	STA.	TO STA.		TILINOIS FED	AID PROJECT OS	F2(122)	

