


DECK REPAIR PLAN

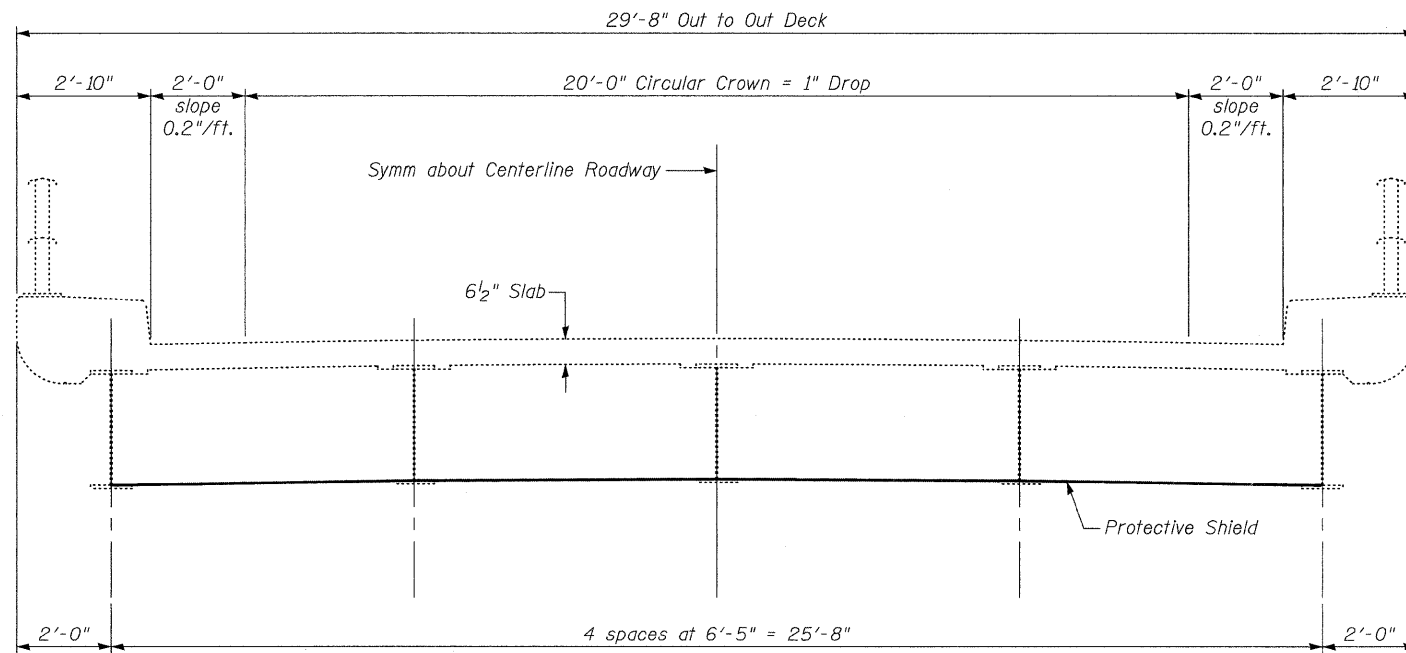

TYPICAL SECTION

BILL OF MATERIALS

ITEM	UNIT	QUANTITY
Deck Slab Repair (Full Depth, Type I)	Sq. Yd.	---
Deck Slab Repair (Partial)	Sq. Yd.	---

- Full Depth Repair Area
- Partial Depth Repair Area

CHAMLIN & ASSOCIATES, INC. PERU, ILLINOIS

FILE NAME = 05000129-66A48-ABDECK-003.DGN

USER NAME =

DESIGNED - JKC

REVISED -

CHECKED - AJO

REVISED -

PLOT SCALE =

DRAWN - LAG

REVISED -

PLOT DATE =

CHECKED - JKC

REVISED -

**STATE OF ILLINOIS
DEPARTMENT OF TRANSPORTATION**

**AS-BUILT DECK REPAIR PLAN
STRUCTURE NO. 050-0129**

SHEET NO. 3 OF 5 SHEETS

F.A.I. RTE. 80

SECTION (50-2,4)RS-5 & (50-3)RS-6

COUNTY LASALLE

TOTAL SHEETS 109

SHEET NO. 68

CONTRACT NO. 66A48

ILLINOIS FED. AID PROJECT