SPECIALTY	SPECIAL PROVISION	CODED PAY ITEM NO.	ITEM	UNIT	TOTAL QUANTITY
		78300202	PAVEMENT MARKING REMOVAL - WATER BLASTING	SQ FT	100
Δ	*	81028200	UNDERGROUND CONDUIT, GALVANIZED STEEL, 2" DIA.	FOOT	46
Δ	*	81028220	UNDERGROUND CONDUIT, GALVANIZED STEEL, 3" DIA.	FOOT	68
Δ	*	81028350	UNDERGROUND CONDUIT, PVC, 2" DIA.	FOOT	150
Δ	*	84200804	REMOVAL OF POLE FOUNDATION	EACH	7
Δ	*	85000200	MAINTENANCE OF EXISTING TRAFFIC SIGNAL INSTALLATION	EACH	1
Δ	*	85000205	MAINTENANCE OF EXISTING TRAFFIC SIGNAL INSTALLATION (SPECIAL)	EACH	1
Δ		87301215	ELECTRIC CABLE IN CONDUIT, SIGNAL NO. 14 2C	FOOT	1094
Δ		87301225	ELECTRIC CABLE IN CONDUIT, SIGNAL NO. 14 3C	FOOT	1141
Δ		87301255	ELECTRIC CABLE IN CONDUIT, SIGNAL NO. 14 7C	FOOT	397
Δ	*	87301291	ELECTRIC CABLE IN CONDUIT, SIGNAL NO. 18 4C	FOOT	41
Δ	*	87301800	ELECTRIC CABLE IN CONDUIT, SERVICE, NO. 4 2 C	FOOT	372
Δ	*	87301900	ELECTRIC CABLE IN CONDUIT, EQUIPMENT GROUNDING CONDUCTOR, NO. 6 1C	FOOT	273
Δ	*	87502710	TRAFFIC SIGNAL POST, ALUMINUM 17 FT.	EACH	1
Δ	*	87800100	CONCRETE FOUNDATION, TYPE A	FOOT	8
Δ	*	87900200	DRILL EXISTING HANDHOLE	EACH	7

FILE NAME =	USER NAME = mthomas	DESIGNED -	REVISED - A 2/17/2023			DES D		RIVER T	RAIL SEGMENT	· •	F.A.	SECTION	COUNTY I	TOTAL SHEET
N:\ROSEMONT\868381.2127A\C1v11\SO0_2127A	Ø1.SHT	DRAWN	REVISED -	STATE OF ILLINOIS		DES PLAINES RIVER TRAIL SEGMENT 2 SUMMARY OF QUANTITIES			-		17-00034-00-BT	COOK	137 B	
	PLOT SCALE = 2'	CHECKED -	REVISED -	DEPARTMENT OF TRANSPORTATION		SUMMARY OF QUANTITIES				I		CONTRACT NO	0. 61H78	
Default	PLOT DATE = 2/19/2023	DATE -	REVISED -		SCALE:	SHEET	OF	SHEET	S STA.	TO STA.		ILLINOIS FED. A	D PROJECT	

				CONSTRUCTI ITEP FUI 80% FEDS / 20	NDS
D PAY NO.	ITEM	UNIT	TOTAL QUANTITY	FACILITIES FOR BICYCLE/PEDESTRIAN TRAILS 0028 URBAN	TRAINEES 0042 URBAN
0202	PAVEMENT MARKING REMOVAL - WATER BLASTING	SQ FT	100	100	
8200	UNDERGROUND CONDUIT, GALVANIZED STEEL, 2" DIA.	FOOT	46	46	
8220	UNDERGROUND CONDUIT, GALVANIZED STEEL, 3" DIA.	FOOT	68	68	
3220			80	50	
8350	UNDERGROUND CONDUIT, PVC, 2" DIA.	FOOT	150	150	
0804	REMOVAL OF POLE FOUNDATION	EACH	7	7	
)200	MAINTENANCE OF EXISTING TRAFFIC SIGNAL INSTALLATION	EACH	1	1	
)205	MAINTENANCE OF EXISTING TRAFFIC SIGNAL INSTALLATION (SPECIAL)	EACH	1	1	
.203		EACH	L		
1215	ELECTRIC CABLE IN CONDUIT, SIGNAL NO. 14 2C	FOOT	1094	1094	
1225	ELECTRIC CABLE IN CONDUIT, SIGNAL NO. 14 3C	FOOT	1141	1141	
1255	ELECTRIC CABLE IN CONDUIT, SIGNAL NO. 14 7C	FOOT	397	397	
L291	ELECTRIC CARLE IN CONDUIT SIGNAL NO. 19, 40	ГООТ	A1	11	
-727	ELECTRIC CABLE IN CONDUIT, SIGNAL NO. 18 4C	FOOT	41	41	
1800	ELECTRIC CABLE IN CONDUIT, SERVICE, NO. 4 2 C	FOOT	372	372	
· · ·					<u> </u>
1900	ELECTRIC CABLE IN CONDUIT, EQUIPMENT GROUNDING CONDUCTOR, NO. 6_1C	FOOT	273	273 /1	
$\vee$					
2710	TRAFFIC SIGNAL POST, ALUMINUM 17 FT.	EACH	1		
$\wedge$					
0100	CONCRETE FOUNDATION, TYPE A	FOOT	8	8	
)200	DRILL EXISTING HANDHOLE	EACH	7	7	
1200			/	1	

SPECIALTY	SPECIAL PROVISION	CODED PAY ITEM NO.	ITEM	UNIT	TOTAL QUANTITY
Δ	*	88040070	SIGNAL HEAD, POLYCARBONATE, LED, 1-FACE, 3-SECTION, BRACKET MOUNTED	EACH	7
Δ	*	88040090	SIGNAL HEAD, POLYCARBONATE, LED, 1-FACE, 3-SECTION, MAST ARM MOUNTED	EACH	5
Δ	*	88040150	SIGNAL HEAD, POLYCARBONATE, LED, 1-FACE, 5-SECTION, BRACKET MOUNTED	EACH	1
Δ	*	88040160	SIGNAL HEAD, POLYCARBONATE, LED, 1-FACE, 5-SECTION, MAST ARM MOUNTED	EACH	1
Δ	*	88102717	PEDESTRIAN SIGNAL HEAD, LED, 1-FACE, BRACKET MOUNTED WITH COUNTDOWN TIMER	EACH	6
Δ	*	88102825	PEDESTRIAN SIGNAL HEAD, POLYCARBONATE, LED, 1-FACE, BRACKET MOUNTED WITH COUNT DOWN TIMER	EACH	2
Δ		89500100	RELOCATE EXISTING SIGNAL HEAD	EACH	2
Δ		89500200	RELOCATE EXISTING PEDESTRIAN SIGNAL HEAD	EACH	1
Δ		89501150	RELOCATE EXISTING TRAFFIC SIGNAL POST	EACH	2
Δ	*	89502200	MODIFY EXISTING CONTROLLER	EACH	1
Δ	*	89502210	MODIFY EXISTING CONTROLLER CABINET	EACH	1
Δ		89502300	REMOVE ELECTRIC CABLE FROM CONDUIT	FOOT	1876 ↓ <del>1766 _</del>
Δ	*	89502375	REMOVE EXISTING TRAFFIC SIGNAL EQUIPMENT	EACH	
Δ		89502385	REMOVE EXISTING CONCRETE FOUNDATION	EACH	2
	*	X0321156	HIGH VISIBILITY TEMPORARY FENCING	FOOT	552
Δ	*	X0322281	WIDE AREA VIDEO DETECTION SYSTEM COMPLETE	EACH	1
Δ	*	X0322708	REMOVE EXISTING STREET LIGHTING EQUIPMENT	EACH	3

FILE NAME =	USER NAME = mthomas	DESIGNED -	REVISED - A 2/17/2023			DEC DI	AINCO D		CCORENT	' <b>1</b>	F.A.	SECTION	COUNTY	TOT	AL SHEET
NINROSEMONT\668081.2127A\CLV1\SD0_2127A	81.SHT	DRAWN -	REVISED -	STATE OF ILLINOIS	DES PLAINES RIVER TRAIL SEGMENT 2 SUMMARY OF QUANTITIES	2	RIE.	17-00034-00-BT	COOK	SHEE					
	PLOT SCALE = Z'	CHECKED -	REVISED -	DEPARTMENT OF TRANSPORTATION		5	SUMMARY OF QUANTITIES		11-00034-00-81	CONTRACT	1 137	61H78			
Default	PLOT DATE = 2/19/2023	DATE -	REVISED -		SCALE:	SHEET	OF	SHEETS	STA.	TO STA.	(	ILLINOIS FED.	ALD PROJECT	1 100	UIIIO

				CONSTRUC ITEP F 80% FEDS /	UNDS
AY 9.	ITEM	UNIT	TOTAL QUANTITY	FACILITIES FOR BICYCLE/PEDESTRIAN TRAILS 0028 URBAN	TRAINEES 0042 URBAN
	SIGNAL HEAD, POLYCARBONATE, LED, 1-FACE, 3-SECTION, BRACKET MOUNTED	EACH	7	7	
	SIGNAL HEAD, POLYCARBONATE, LED, 1-FACE, 3-SECTION, MAST ARM MOUNTED	EACH	5	5	
	SIGNAL HEAD, POLYCARBONATE, LED, 1-FACE, 5-SECTION, BRACKET MOUNTED	EACH	1	1	
	SIGNAL HEAD, POLYCARBONATE, LED, 1-FACE, 5-SECTION, MAST ARM MOUNTED	EACH	1	1	
	PEDESTRIAN SIGNAL HEAD, LED, 1-FACE, BRACKET MOUNTED WITH COUNTDOWN TIMER	EACH	6	6	
	PEDESTRIAN SIGNAL HEAD, POLYCARBONATE, LED, 1-FACE, BRACKET MOUNTED WITH COUNT DOWN TIMER	EACH	2	2	
	RELOCATE EXISTING SIGNAL HEAD	EACH	2	2	
	RELOCATE EXISTING PEDESTRIAN SIGNAL HEAD	EACH	1	1	
	RELOCATE EXISTING TRAFFIC SIGNAL POST	EACH	2	2	
	MODIFY EXISTING CONTROLLER	EACH	1	1	
	MODIFY EXISTING CONTROLLER CABINET	EACH	1		$\Lambda$
	REMOVE ELECTRIC CABLE FROM CONDUIT	FOOT	1876 ∨ <del>1766</del>	<u>1876</u>	
	REMOVE EXISTING TRAFFIC SIGNAL EQUIPMENT	EACH			
	REMOVE EXISTING CONCRETE FOUNDATION	EACH	2	2	
	HIGH VISIBILITY TEMPORARY FENCING	FOOT	552	552	
,	VIDE AREA VIDEO DETECTION SYSTEM COMPLETE	EACH	1	1	
	REMOVE EXISTING STREET LIGHTING EQUIPMENT	EACH	3	3	

SPECIALTY	SPECIAL PROVISION	CODED PAY ITEM NO.	ITEM	UNIT	TOTAL QUANTITY
Δ	*	X0324900	SERVICE CONNECTION TO CECO LINE	EACH	1
Δ	*	Voaacaac			840
Δ		X0326326	CABLE IN CONDUIT, TRIPLEX, 2-1/C NO. 6 AND 1-1/C NO. 8 GROUND	FOOT	
	*	X0326806	WASHOUT BASIN	L SUM	1
Δ	*	X0326968	JUNCTION BOX, POLE OR POST MOUNTED	EACH	5
	*				6
Δ	*	X0327485	MAST ARM, STREET LIGHTING, 15'	EACH	
Δ	*	X0327690	TELEVISION INSPECTION OF SEWER, SPECIAL	FOOT	200
Δ	*	X0327860	REMOVE CONCRETE FOUNDATION (ELECTRICAL)	EACH	1
Δ	*	X0935100	MAST ARM, STEEL, MONOTUBE 35 FT.	EACH	2
Δ	*	X0935200	MAST ARM, STEEL, MONOTUBE 40 FT.	EACH	1
Δ	*	X1200139	REMOVAL OF LIGHTING LUMINAIRE, SALVAGE	EACH	3
Δ	*	X1400081	FULL-ACTUATED CONTROLLER AND TYPE SUPER P CABINET (SPECIAL)	EACH	1
Δ	*	X1400238	LUMINAIRE, LED, SPECIAL	EACH	$6^{\circ}$
Δ	*	X1400367	PEDESTRIAN SIGNAL POST, 10 FT.	EACH	4
Δ	*	X1400381	CABLE, SPECIAL	FOOT	382
Δ	*	X1400382	ELECTRIC CABLE IN CONDUIT, SIGNAL NO. 14 19/C	FOOT	656
Δ	*	X2010400	STUMP REMOVAL ONLY	UNIT	399
	*	X2080250	TRENCH BACKFILL, SPECIAL	CUYD	10

FILE NAME =	USER NAME = mthomas	DESIGNED -	REVISED - A 2/17/2023					
N:\R05EMONT\860001.2127A\Civi1\500_2127A	81.SHT	DRAWN -	REVISED -	STATE OF ILLINOIS		DES PLAIN	ES RIVER	TRAIL S
	PLOT SCALE = 2'	CHECKED -	REVISED -	DEPARTMENT OF TRANSPORTATION		SUM	MARY OF	QUANTI
Default	PLOT DATE = 2/19/2023	DATE	REVISED -		SCALE:	SHEET	OF SHE	ETS STA
				2				

	CONSTRUC ITEP F 80% FEDS /	UNDS	
	FACILITIES FOR BICYCLE/PEDESTRIAN TRAILS 0028 URBAN	TRAINEES 0042 URBAN	
╞	1 840	$\Lambda$	
ł		-	
	1		
	5 6	$\Lambda$	
	_5		
	200		
	1		
	2		
	1	· · · · · · · · · · · · · · · · · · ·	
	3		
╞		$-\Lambda$	
╞			
	4		
	382		
╀	656		
╞	399		
╞	10		

SEGMENT 2		SECTION	COUNTY	TOTAL	SHEET NO.
TITIES		17-00034-00-8T	соок	137	10
111125			CONTRACT	NO. 61	H78
TA. TO STA.		ILLINOIS FED. A	ID PROJECT		

SPECIALTY	SPECIAL PROVISION	CODED PAY ITEM NO.	ITEM	UNIT	TOTAL QUANTITY
	*	X2110100	TOPSOIL FURNISH AND PLACE, SPECIAL	CUYD	884
Δ	*	X2511630	EROSION CONTROL BLANKET (SPECIAL)	SQ YD	4911
Δ	*	X6020105	MANHOLE, ELECTRIC, 3' X 4' X 4', WITH 24" FRAME AND LID	EACH	1
	*	X6050040	REMOVING MANHOLES, SPECIAL	EACH	2
	*	X6640300	CHAIN LINK FENCE REMOVAL	FOOT	2538
	*	X7010216	TRAFFIC CONTROL AND PROTECTION, (SPECIAL)	L SUM	1
Δ	*	X8100105	CONDUIT SPLICE	EACH	1
Δ	*	X8140210	HEAVY-DUTY HANDHOLE (SPECIAL)	EACH	4
Δ	*	X8760200	ACCESSIBLE PEDESTRIAN SIGNALS	EACH	8
Δ	*	X8760202	ACCESSIBLE PEDESTRIAN SIGNALS (SPECIAL)	EACH	2
Δ	*	X8780012	CONCRETE FOUNDATION, TYPE A 12-INCH DIAMETER	FOOT	16
Δ	*	X8780107	CONCRETE FOUNDATION (SPECIAL)	FOOT	5
Δ	*	XX005703	REMOVE EXISTING TRAFFIC SIGNAL EQUIPMENT, SPECIAL	L SUM	1
	*	XX007037	SAFETY FENCE	FOOT	1424
Δ	*	XX007709	CONDUIT IN GROUND, 2" DIA., GALVANIZED STEEL	FOOT	
Δ	*	XX007711	CONDUIT IN GROUND, 3" DIA., GALVANIZED STEEL	FOOT	919 915
Δ	*	XX008269	WAYFINDING SIGN	EACH	

FILE NAME =	USER NAME = mthomes	DESIGNED -	REVISED - 🛕 2/17/2023					WED TRAIL OF ORACL	17 0	F.A	SECTION	COUNTY	TOTAL	SHEET
N:\ROSEMONT\860001.2127A\Civi1\500.2127A	BLSHT	DRAWN -	REVISED -	STATE OF ILLINOIS		DES PLAINES RIVER TRAIL SEGMENT 2 SUMMARY OF QUANTITIES				RTE.	17-00034-00-81	0000011	SHEETS	<u>NO.</u>
	PLOT SCALE = 2'	CHECKED -	REVISED -	DEPARTMENT OF TRANSPORTATION	SUMMARY OF QUANTITIES					17+00034-00-BT		CONTRACT	131 L	11
Default	PLOT DATE = 2/19/2823	DATE –	REVISED -		SCALE:	SHEET	0F	SHEETS STA.	TO STA.		ILLINOIS FED. A	ID PROJECT	NO. BIL	110
					1						licentrol cor i			

			CONSTRUCTION CODE ITEP FUNDS 80% FEDS / 20% STATE			
ITEM	UNIT	TOTAL QUANTITY	FACILITIES FOR BICYCLE/PEDESTRIAN TRAILS 0028 URBAN	TRAINEES 0042 URBAN		
TOPSOIL FURNISH AND PLACE, SPECIAL	CU YD	884	884			
EROSION CONTROL BLANKET (SPECIAL)	SQ YD	4911	4911			
MANHOLE, ELECTRIC, 3' X 4' X 4', WITH 24" FRAME AND LID	EACH	1	1			
REMOVING MANHOLES, SPECIAL	EACH	2	2			
CHAIN LINK FENCE REMOVAL	FOOT	2538	2538			
TRAFFIC CONTROL AND PROTECTION, (SPECIAL)	LSUM	1	1			
CONDUIT SPLICE	EACH	1	1			
HEAVY-DUTY HANDHOLE (SPECIAL)	EACH	4	4			
ACCESSIBLE PEDESTRIAN SIGNALS	EACH	8	8			
ACCESSIBLE PEDESTRIAN SIGNALS (SPECIAL)	EACH	2	2			
CONCRETE FOUNDATION, TYPE A 12-INCH DIAMETER	FOOT	16	16			
CONCRETE FOUNDATION (SPECIAL)	FOOT	5	5			
REMOVE EXISTING TRAFFIC SIGNAL EQUIPMENT, SPECIAL	LSUM	1	1			
SAFETY FENCE	FOOT	1424	<u>1424</u> 158	A		
CONDUIT IN GROUND, 2" DIA., GALVANIZED STEEL	FOOT					
CONDUIT IN GROUND, 3" DIA., GALVANIZED STEEL	FOOT	<u>919</u>	919 <u>-915</u>			
WAYFINDING SIGN	EACH		1			

SPECIALTY	SPECIAL PROVISION	CODED PAY ITEM NO.	ITEM	UNIT	TOTAL QUANTITY
	*	XX008310	AGGREGATE SURFACE COURSE, TYPE B 3" (SPECIAL)	SQ YD	4275
Δ	*	XX008710	CONCRETE FOUNDATION, 24" DIAMETER, 1 1/4" ANCHOR RODS, 15" BOLT CIRCLE, 9 FEET	EACH	
Δ	*	XX009225		EACH	3
$A = \Delta$	*	XX009356			
		^^009530	CONCRETE FOUNDATION, 20" DIAMETER	FOOT	10
Δ		XX009360	CONCRETE FOUNDATION, 30" DIAMETER	FOOT	33
Δ	*	XX009362	STEEL POLE, TYPE 1	EACH	(
Δ	*	XX009363	STEEL POLE, TYPE 2	EACH	3
	*				
Δ	*	XX009529	TREE ROOT PRESERVATION	SQ YD	1155
	*	XX009531	TREE ROOT PRUNING (SPECIAL)	FOOT	7500
		////0000001		FOOT	7500
	*	Z0013797	STABILIZED CONSTRUCTION ENTRANCE	SQ YD	550
	*	Z0013798	CONSTRUCTION LAYOUT	LSUM	1
Δ	*	Z0023700	FILLING EXISTING HANDHOLES	EACH	3
· · · · · ·	*	Z0030850			
			TEMPORARY INFORMATION SIGNING	SQ FT	52
Δ	*	Z0033026	MAINTENANCE OF EXISTING LIGHTING SYSTEM COMPLETE	LSUM	1
				2001	<u> </u>
Δ	*	Z0033044	RE-OPTIMIZE TRAFFIC SIGNAL SYSTEM LEVEL 1	EACH	1
	<u>                                     </u>				
	*	Z0076600	TRAINEES	HOUR	500
	*				
		Z0076604	TRAINEES TRAINING PROGRAM GRADUATE	HOUR	500


NARDSEMENT LEGGEDUL2127ACCIVITYSOD, 2127A CLIVITYSOD, 2127A CLIVIT	FILE NAME =	USER NAME = mthomas	OESIGNEO -	REVISED - A 2/17/2023								SECTION	COUNTY	TOTAL	SHEET
PLOT SLOLE 2 CHECKED - REVISED - DEPARTMENT OF TRANSPORTATION CONTRACT OF UDANTITIES CONTRACT	N:\RDSEMONT\860001.2127A\C1v11\SD0_2127A	Ø1.SHT	DRAWN -	REVISED -	STATE OF ILLINOIS		DES PLAINES RIVER TRAIL SEGMENT 2		2	RTE.			SHEET	<u>5 NO.</u>	
		PLOT SCALE = 2'	CHECKED -	REVISED -	DEPARTMENT OF TRANSPORTATION	RTATION SUMMARY OF QUANTITIES SCALE: SHEET OF SHEETS STA. TO STA.				11-00034-00*B1	CONTRACT	121	12		
Default PLOTURIE 2/19/2023 DATE - REVISED - SHEETS STA. TO STA. (ILLINOIS) FED. AID PROJECT	Default	PLOT DATE = 2/19/2023	DATE -	REVISED -				TO STA.	-	ILLINOIS FED. AID PROJECT		NO. 0	1010		


						CONSTRUCT ITEP FL 80% FEDS / 2	NDS
SPECIAL	PROVISION	CODED PAY ITEM NO.	ITEM	UNIT	TOTAL QUANTITY	FACILITIES FOR BICYCLE/PEDESTRIAN TRAILS 0028 URBAN	TRAINEES 0042 URBAN
	*	XX008310	AGGREGATE SURFACE COURSE, TYPE B 3" (SPECIAL)	SQ YD	4275	4275	Δ
					$\sim_2$ $\vee$		
	*	XX008710	CONCRETE FOUNDATION, 24" DIAMETER, 1 1/4" ANCHOR RODS, 15" BOLT CIRCLE, 9 FEET	EACH	$\left(\begin{array}{c} -1 \\ \end{array}\right)$		
	*	XX009225	STREET SIGN COMPLETE				·····
+	$\overline{}$			EACH	3		
	*	XX009356	CONCRETE FOUNDATION, 20" DIAMETER	FOOT	10	10	
	$\overline{\mathcal{A}}$						~~~~~
`	*	XX009360	CONCRETE FOUNDATION, 30" DIAMETER	FOOT	33	33	
,	*	Wypegaca			$\sim_2$ $\vee$	2	
	·	XX009362	STEEL POLE, TYPE 1	EACH			
	*	XX009363	STEEL POLE, TYPE 2	EACH	3	3	
1	·			LACH	5	<b>J</b>	
*	*	XX009529	TREE ROOT PRESERVATION	SQ YD	1155	1155	
×	*	XX009531	TREE ROOT PRUNING (SPECIAL)	FOOT	7500	7500	
	*	Z0013797	STABILIZED CONSTRUCTION ENTRANCE				
		20013797	STABILIZED CONSTRUCTION ENTRANCE	SQ YD	550	550	
-	*	Z0013798	CONSTRUCTION LAYOUT	LSUM	1	1	
				200141	<u>ــــــــــــــــــــــــــــــــــــ</u>	±	
*	*	Z0023700	FILLING EXISTING HANDHOLES	EACH	3	3	
*	*	Z0030850	TEMPORARY INFORMATION SIGNING	SQ FT	52	52	
*		Z0033026	MAINTENANCE OF EXISTING LIGHTING SYSTEM COMPLETE		*		
		20033020		LSUM	1	1	
*		Z0033044	RE-OPTIMIZE TRAFFIC SIGNAL SYSTEM LEVEL 1	EACH	1	1	
				<u> </u>	<u>+</u>	±	
*	•	Z0076600	TRAINEES	HOUR	500		500
	-+						
*	<u> </u>	Z0076604	TRAINEES TRAINING PROGRAM GRADUATE	HOUR	500		500

	TRAFFIC SIGNALS AND STREET LIGHTING SCHEDULE OF	QUAN	NTITIES			
				East River Rd	East River/Dee Rd	
PAY CODE	ITEM	UNIT	TOTAL	@ Bryn Mawr	@ IL 72/Higgins	
	UNDERGROUND CONDUIT, GALVANIZED STEEL, 2" DIA. UNDERGROUND CONDUIT, GALVANIZED STEEL, 3" DIA.	FOOT FOOT	46 68		46 68	
	UNDERGROUND CONDUIT, PVC, 2" DIA.	FOOT	150	150		
	REMOVAL OF POLE FOUNDATION	EACH	7	7		
	MAINTENANCE OF EXISTING TRAFFIC SIGNAL INSTALLATION	EACH	1		1	
	MAINTENANCE OF EXISTING TRAFFIC SIGNAL INSTALLATION (SPECIAL)	EACH FOOT	1 1094	1	1004	
	ELECTRIC CABLE IN CONDUIT, SIGNAL NO. 14 2C ELECTRIC CABLE IN CONDUIT, SIGNAL NO. 14 3C	FOOT	1141		1094	
	ELECTRIC CABLE IN CONDUIT, SIGNAL NO. 14 7C	FOOT	397		397	
	ELECTRIC CABLE IN CONDUIT, SIGNAL NO. 18 4C	FOOT	41	41		
	ELECTRIC CABLE IN CONDUIT, SERVICE, NO. 4 2 C	FOOT	372	372	070	
	ELECTRIC CABLE IN CONDUIT, EQUIRMENT GROUNDING CONDUCTOR, NO. 6, 10	FOOT FOOT	273		273	
	CONCRETE FOUNDATION, TYPE A	EACH	7		6	
	SIGNAL HEAD, POLYCARBONATE, LED, 1-FACE, 3-SECTION, BRACKET MOUNTED	EACH	7	7		
88040090	SIGNAL HEAD, POLYCARBONATE, LED, 1-FACE, 3-SECTION, MAST ARM MOUNTED	EACH	5	5		
	SIGNAL HEAD, POLYCARBONATE, LED, 1-FACE, 5-SECTION, BRACKET MOUNTED	EACH	1			
	SIGNAL HEAD, POLYCARBONATE, LED, 1-FACE, 5-SECTION, MAST ARM MOUNTED PEDESTRIAN SIGNAL HEAD, LED, 1-FACE, BRACKET MOUNTED WITH COUNTDOWN TIMER	EACH EACH	1 6		6	
	PEDESTRIAN SIGNAL HEAD, LED, 1-FACE, BRACKET MOUNTED WITH COUNTDOWN TIMER PEDESTRIAN SIGNAL HEAD, POLYCARBONATE, LED, 1-FACE, BRACKET MOUNTED WITH COUNT DOWN TIMER	EACH	2	2		
	RELOCATE EXISTING SIGNAL HEAD	EACH	2		2	
	RELOCATE EXISTING PEDESTRIAN SIGNAL HEAD	EACH	1	4	1	
	RELOCATE EXISTING TRAFFIC SIGNAL POST	EACH	2	<u>↓</u>	2	
	MODIFY EXISTING CONTROLLER MODIFY EXISTING CONTROLLER CABINET	EACH EACH	1	<u> </u>	1	
	REMOVE ELECTRIC CABLE FROM CONDUIT	FOOT	1876	640 <	1236	
	REMOVE EXISTING TRAFFIC SIGNAL EQUIPMENT	EACH	1		1	
89502385	REMOVE EXISTING CONCRETE FOUNDATION	EACH	2		2	
	REMOVE EXISTING STREET LIGHTING EQUIPMENT	EACH	3	3		
	WIDE AREA VIDEO DETECTION SYSTEM COMPLETE SERVICE CONNECTION TO CECO LINE	EACH EACH	1			
	CABLE IN CONDUIT, TRIPLEX, 2-1/C NO. 6 AND 1-1/C NO. 8 GROUND	FOOT	840	840		
	JUNCTION BOX, POLE OR POST MOUNTED	EACH	5	5		
X0327485	MAST ARM, STREET LIGHTING, 15'	EACH	6	6		
	REMOVE CONCRETE FOUNDATION (ELECTRICAL)	EACH	1			
	MAST ARM, STEEL, MONOTUBE 35 FT.	EACH EACH	2			
	MAST ARM, STEEL, MONOTUBE 40 FT. REMOVAL OF LIGHTING LUMINAIRE, SALVAGE	EACH	3			
	FULL-ACTUATED CONTROLLER AND TYPE SUPER P CABINET (SPECIAL)	EACH	1			
	LUMINAIRE, LED, SPECIAL	EACH	6	6		
	PEDESTRIAN SIGNAL POST, 10 FT.	EACH	4		4	CHRISTOPHER B. BURKE ENGINEERING, LT
	CABLE, SPECIAL ELECTRIC CABLE IN CONDUIT, SIGNAL NO. 14 19/C	FOOT FOOT	382 656	382 656		9575 W. Higgins Road, Suite 600
	TRENCH BACKFILL, SPECIAL	CUYD	10	10		Rosemont, Illinois 60018 (847) 823-0500
	MANHOLE, ELECTRIC, 3' X 4' X 4', WITH 24" FRAME AND LID	EACH	1	1		
	REMOVING MANHOLES, SPECIAL	EACH	2	2		
		EACH	1			
	HEAVY-DUTY HANDHOLE (SPECIAL) ACCESSIBLE PEDESTRIAN SIGNALS	EACH EACH	4	4	8	
	ACCESSIBLE PEDESTRIAN SIGNALS ACCESSIBLE PEDESTRIAN SIGNALS (SPECIAL)	EACH	2	2		NO. BY DATE DESCRIPTION
	CONCRETE FOUNDATION, TYPE A 12-INCH DIAMETER	FOOT	16	$\langle \rangle$	16	REVISIONS
	CONCRETE FOUNDATION (SPECIAL)	FOOT	5	5		
	REMOVE EXISTING TRAFFIC SIGNAL EQUIPMENT, SPECIAL		1			DES PLAINES RIVER TRAIL
	CONDUIT IN GROUND, 2" DIA., GALVANIZED STEEL CONDUIT IN GROUND, 3" DIA., GALVANIZED STEEL	FOOT FOOT	158 919	158 919		
	CONCRETE FOUNDATION, 24" DIAMETER, 1 1/4" ANCHOR RODS, 15" BOLT CIRCLE, 9 FEET	EACH	2	2		SEGMENT 2
	CONCRETE FOUNDATION, 30" DIAMETER	FOOT	33	33		
XX009362	STEEL POLE TYPE 1 A A A A A A A A A A A A A A A A A A	EACH	2	2		TRAFFIC SIGNALS
XX009363	STEEL POLE, TYPE 2	EACH		3		SCHEDULE OF QUANTITIES
	FILLING EXISTING HANDHOLES MAINTENANCE OF EXISTING LIGHTING SYSTEM COMPLETE	EACH L SUM	<u>3</u>	<u>3</u>		
	RE-OPTIMIZE TRAFFIC SIGNAL SYSTEM LEVEL 1	EACH	1		1	
			<u> </u>	I	· ·	CITY OF CHICAGO
						DEPARTMENT OF TRANSPORTATION DIVISION OF PROJECT DEVELOPMENT
						PROJECT NO.: 860001.2127A DEO SHEET NO. SHEET NUMBER DATE: tourd date
						\$SUB_DATE DSGN DRAWN CHECK   EAJ FPB GMZ SHEET 55 0E
						SHEET 55 OF 13
SIGNED -	REVISED - 1 2/17/2023			TDAFFIA AIA		F.A. SECTION COUNTY TOTAL SH RTE. SECTION COUNTY SHEETS N
SIGNED – AWN – ICKED –	REVISED   -   2/17/2023     REVISED   -   STATE OF ILLINOIS     REVISED   -   DEPARTMENT OF TRANSPORTATION			TRAFFIC SIGNA	LS SCHEDULE OF QUANTITI	ES F.A. SECTION COUNTY TOTAL SH SHEETS N COOK 137 5 CONTRACT NO. 61H7

FILE NAME =	USER NAME = bchavez	DESIGNED -	REVISED – <u>/1</u>
N:\ROSEMONT\860001.2127A\Traffic\TS5_212	7A_QTY_TS.dgn	DRAWN -	REVISED -
	PLOT SCALE = 20'	CHECKED -	REVISED -
default	PLOT DATE = 2/17/2023	DATE –	REVISED –

2/17/2023	STATE OF ILLINOIS		TRAFFIC	SIGNALS	SCHED
	DEPARTMENT OF TRANSPORTATION				
		SCALE.	СПЕЕТ	ΛF	СПЕЕТ

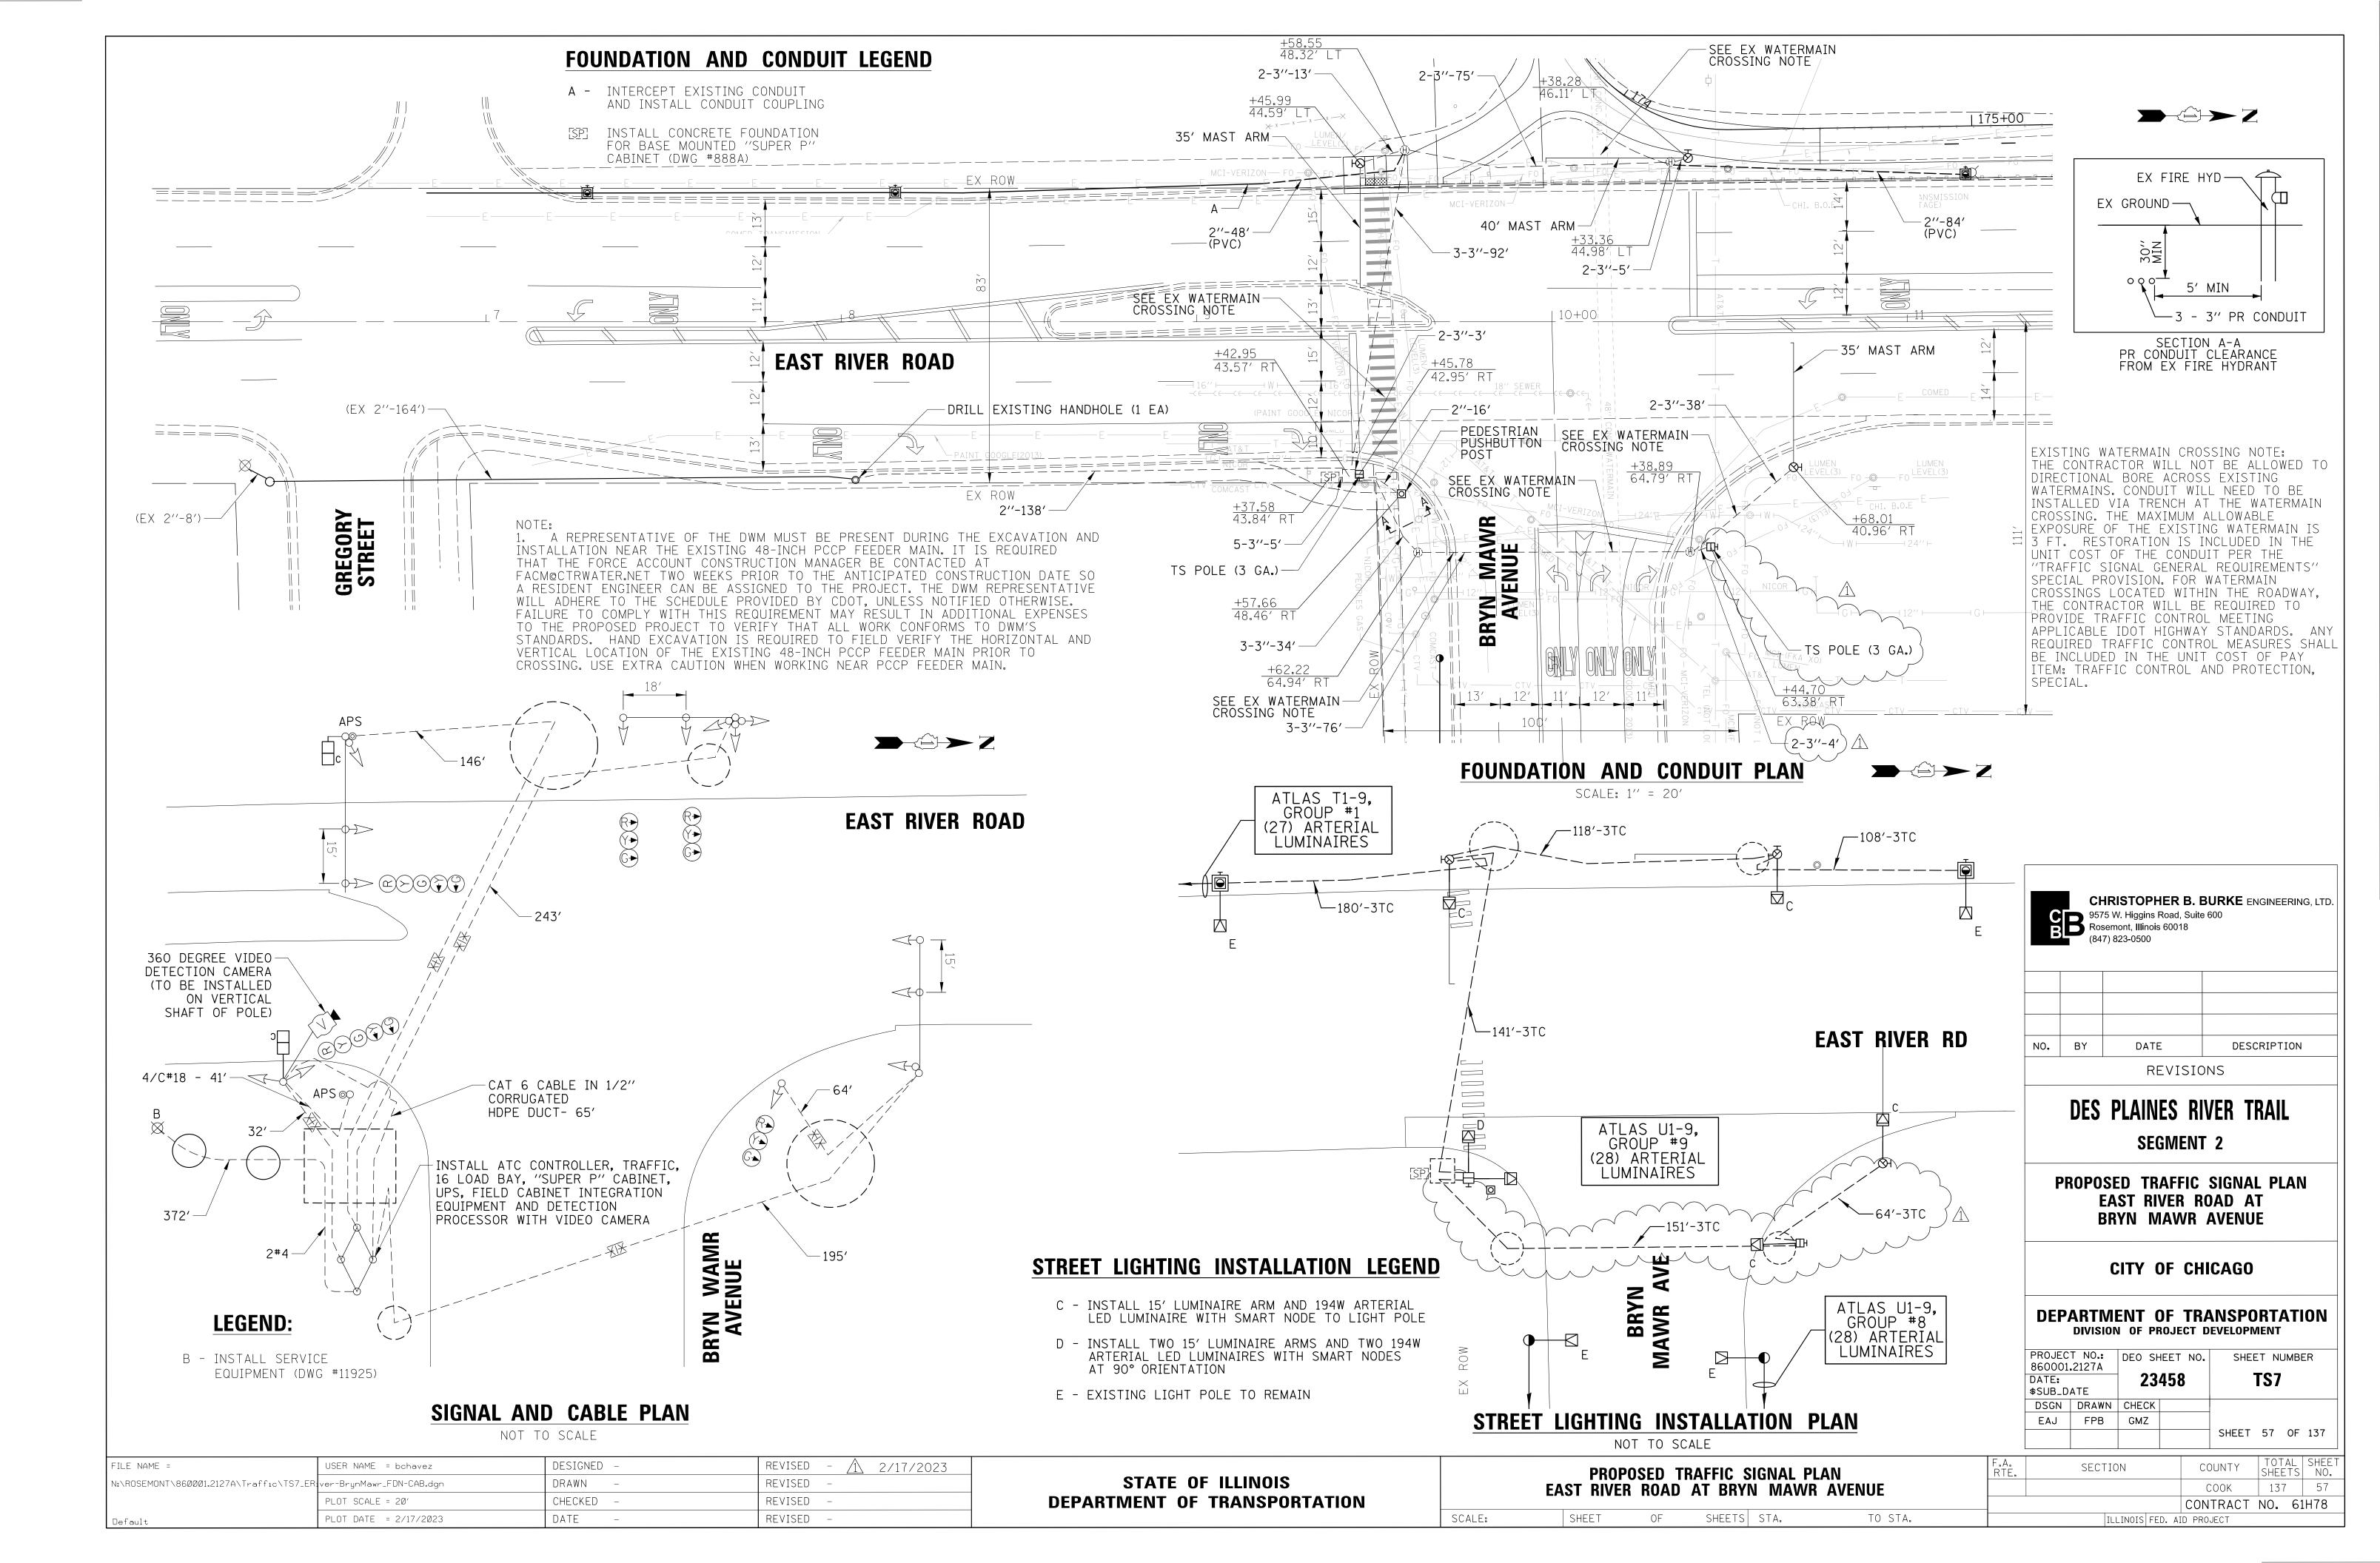

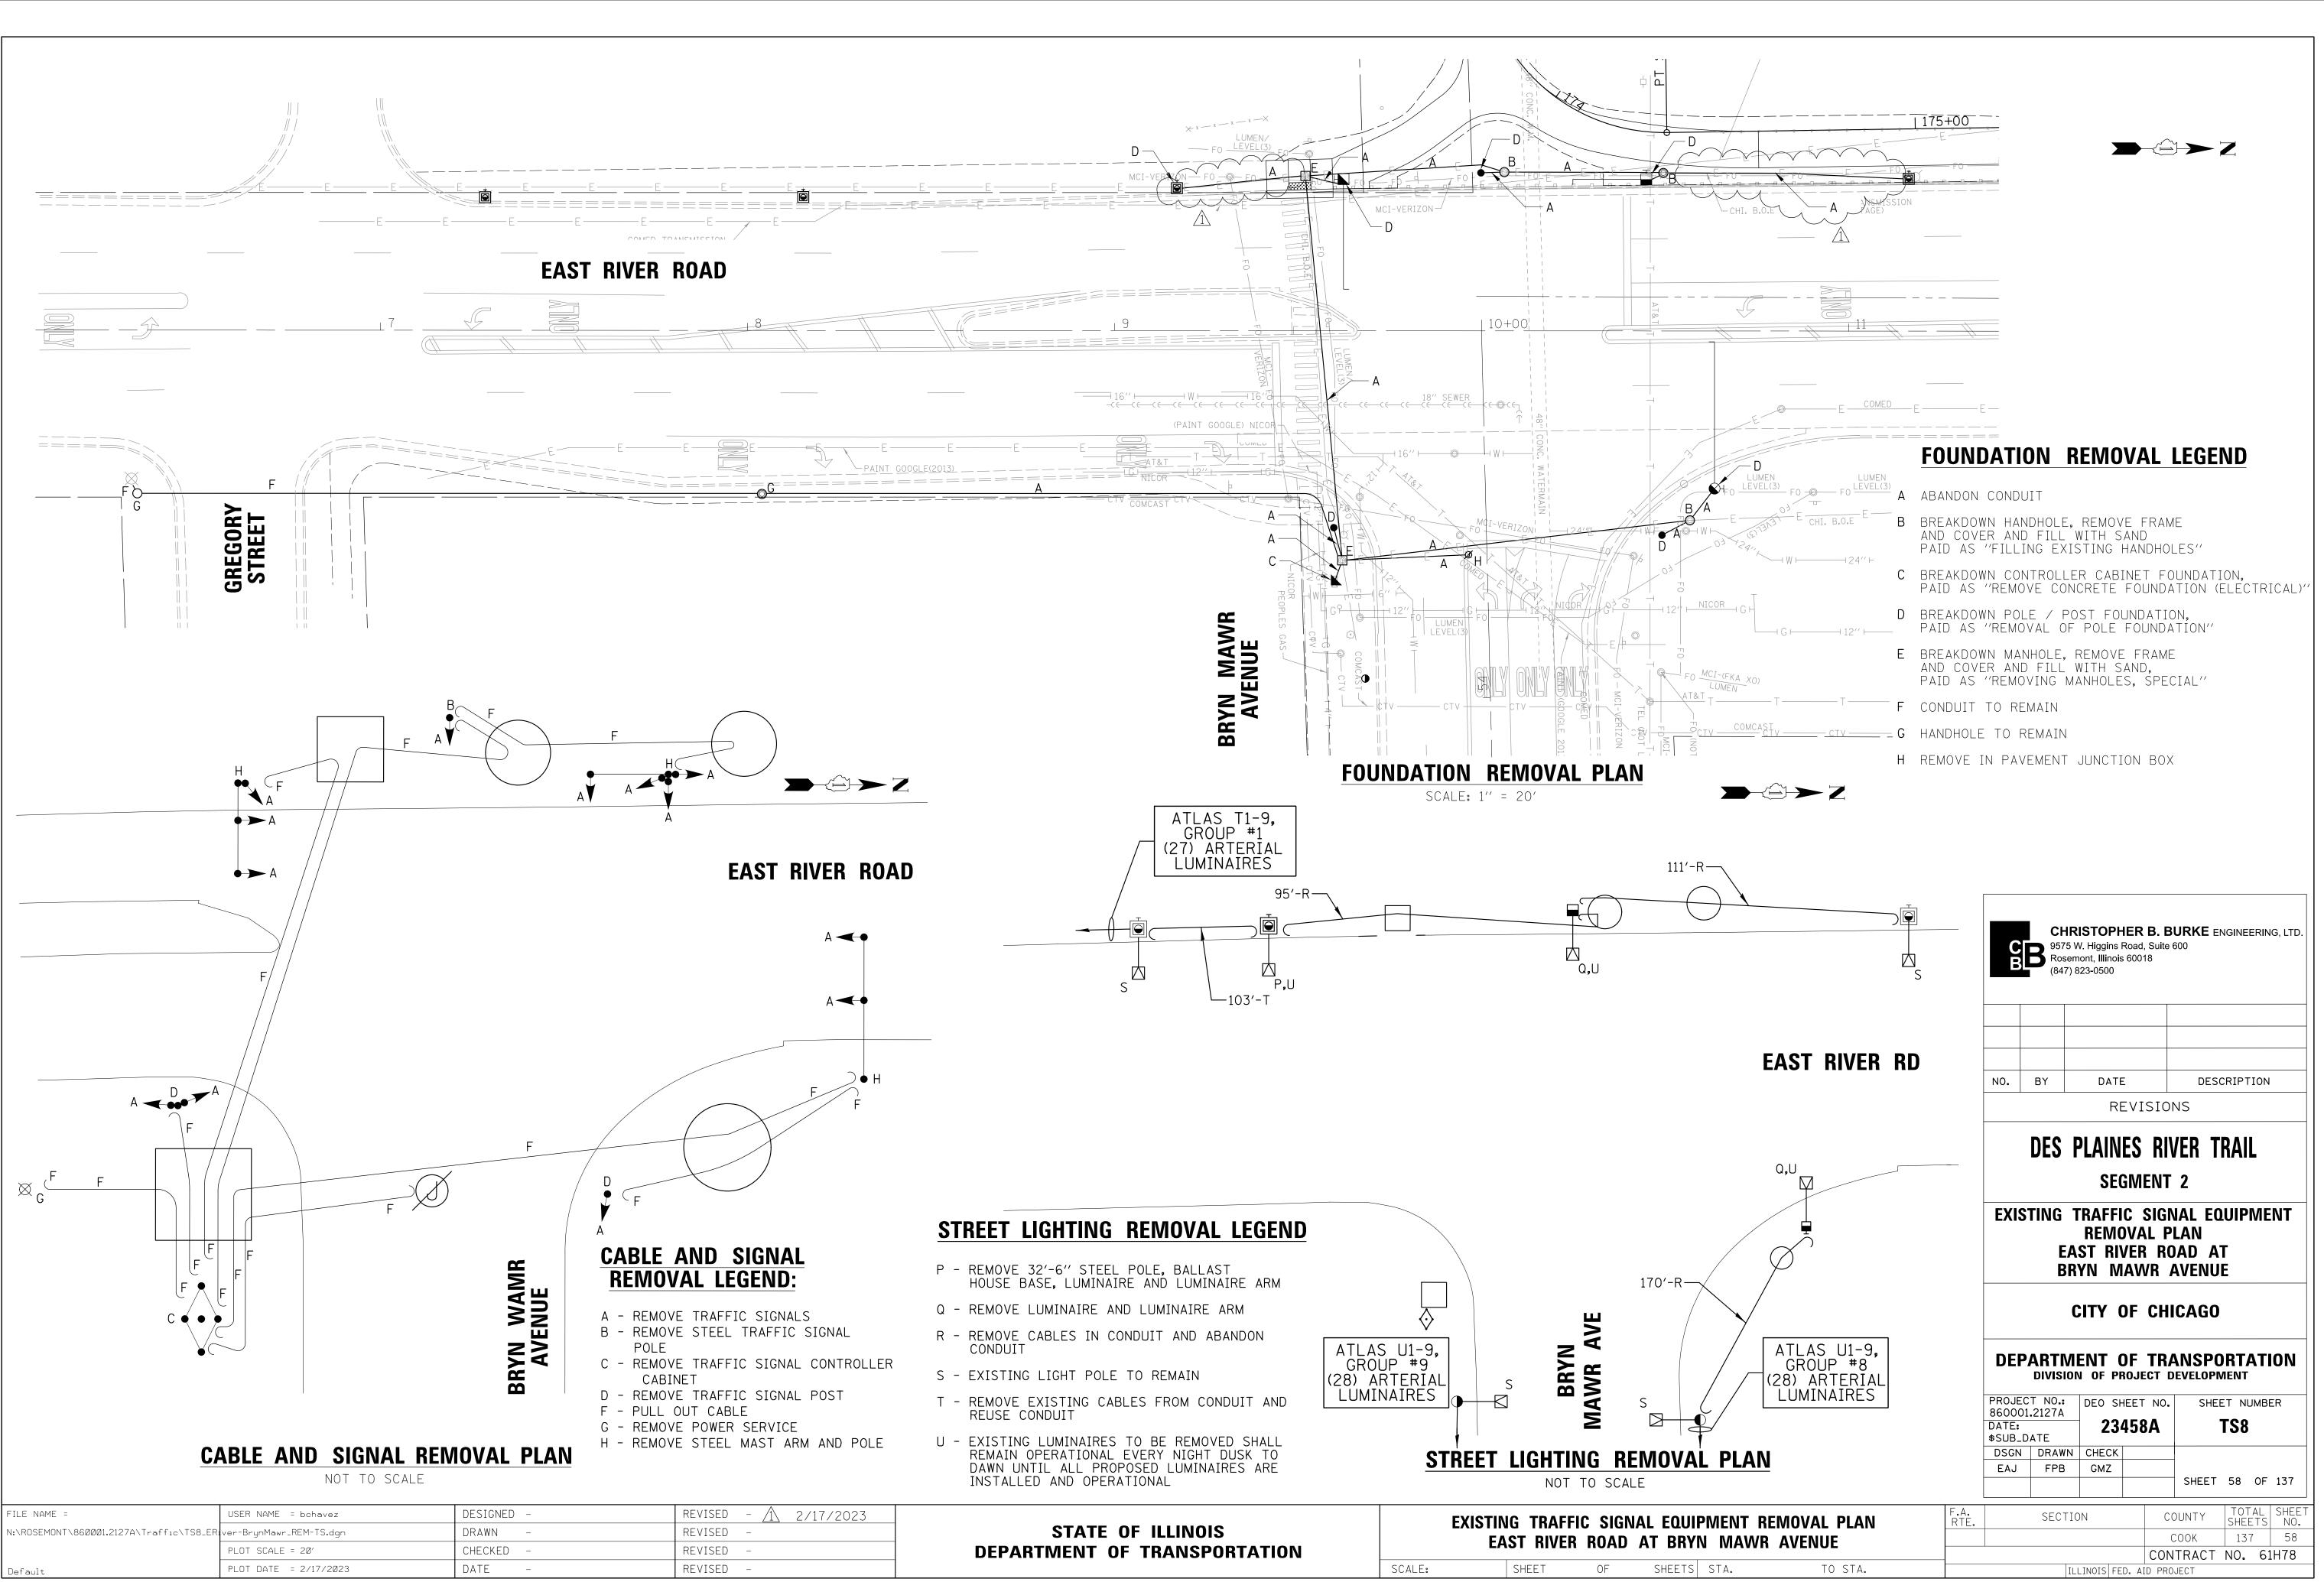

<b>BRYN MAWR</b>		AVENUE		СООК			
		/// 21102	_			CONTRACT	Ν
ETS	STA.	TO STA.		ILLINOIS	FED. Al	D PROJECT	