


# PROPOSED TYPICAL CROSS SECTION 10

OFF RAMPS CB AND DA

STATION TO STATION  
 CB 10+00.00 TO 28+63.98  
 DA 10+00.00 TO 27+60.49

NOTES:  
~~DELETED~~

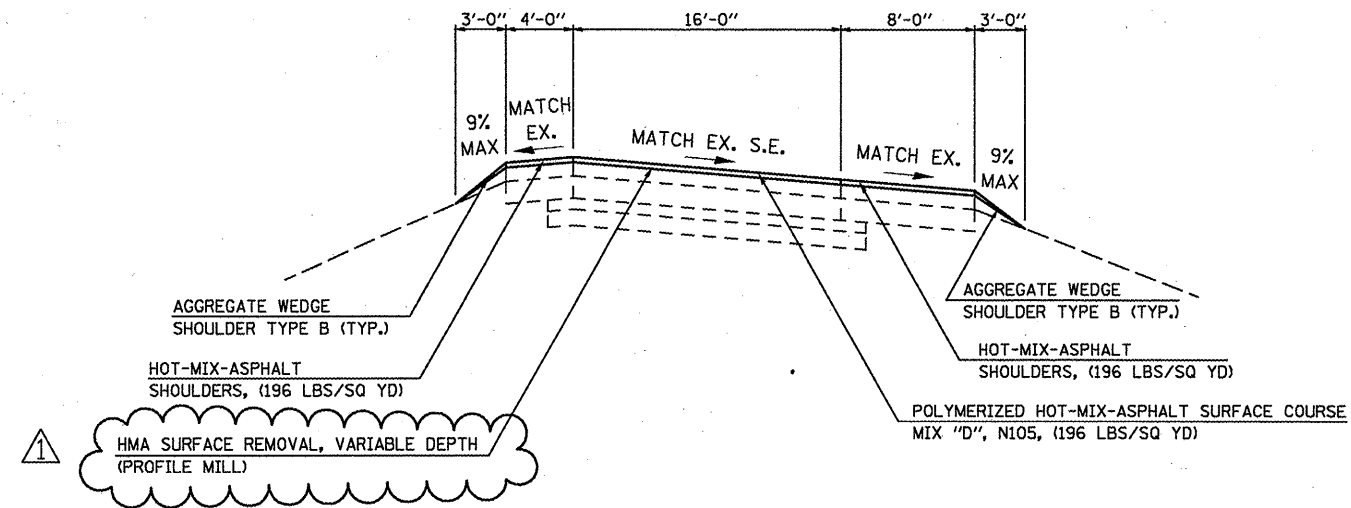


# PROPOSED TYPICAL CROSS SECTION 11

ON RAMPS AC AND BD

STATION TO STATION  
 AC 10+24.00 TO 31+64.13  
 BD 10+24.00 TO 32+79.31

NOTES:  
~~DELETED~~

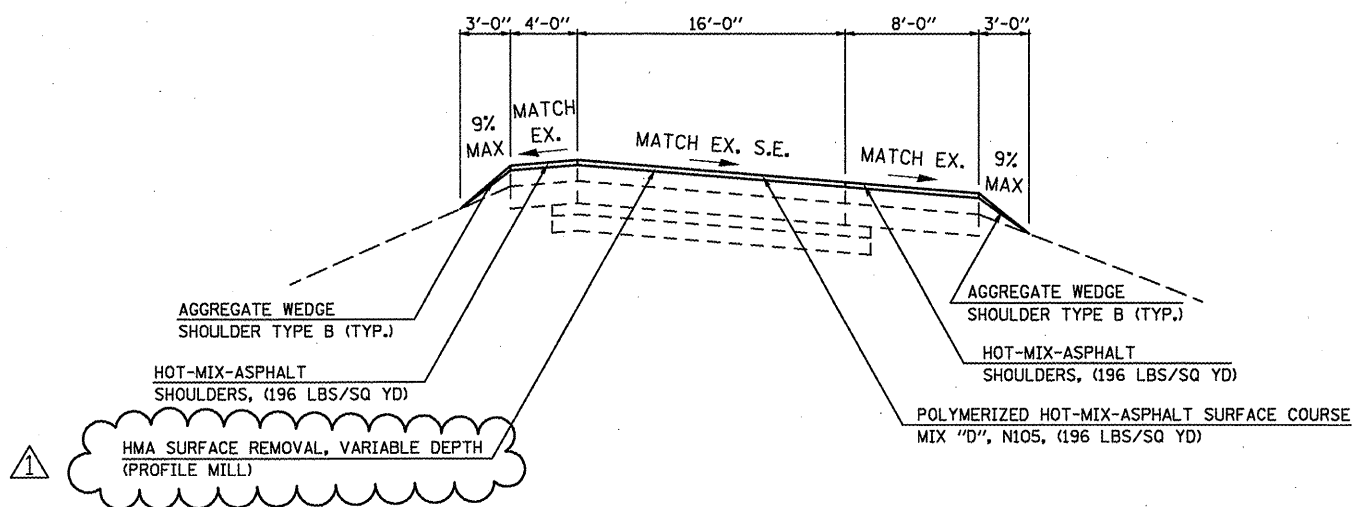

SHEET REVISED 2-23-11

FILE NAME =	USER NAME = p1ersonbr	DESIGNED -	REVISED - BJH 8/10/2010
ar\pwwork\p1dot\p1ersonbr\d0158340\05	0550-sh1-typical.dgn	DRAWN -	REVISED - BJH 8/12/2010
	PLOT SCALE = 1/8" = 100.0000' / IN.	CHECKED -	REVISED - Addendum #1 2/11
	PLOT DATE = 2/18/2011	DATE -	REVISED -

STATE OF ILLINOIS  
 DEPARTMENT OF TRANSPORTATION

PROPOSED TYPICAL SECTIONS

F.A.I. RTE.	SECTION	COUNTY	TOTAL SHEETS	SHEET NO.
74	(57-2011), 21, 22 IRS-3	MCCLEAN	150	27
CONTRACT NO. 70550			ILLINOIS FED. AID PROJECT	