


FOR INFORMATION ONLY

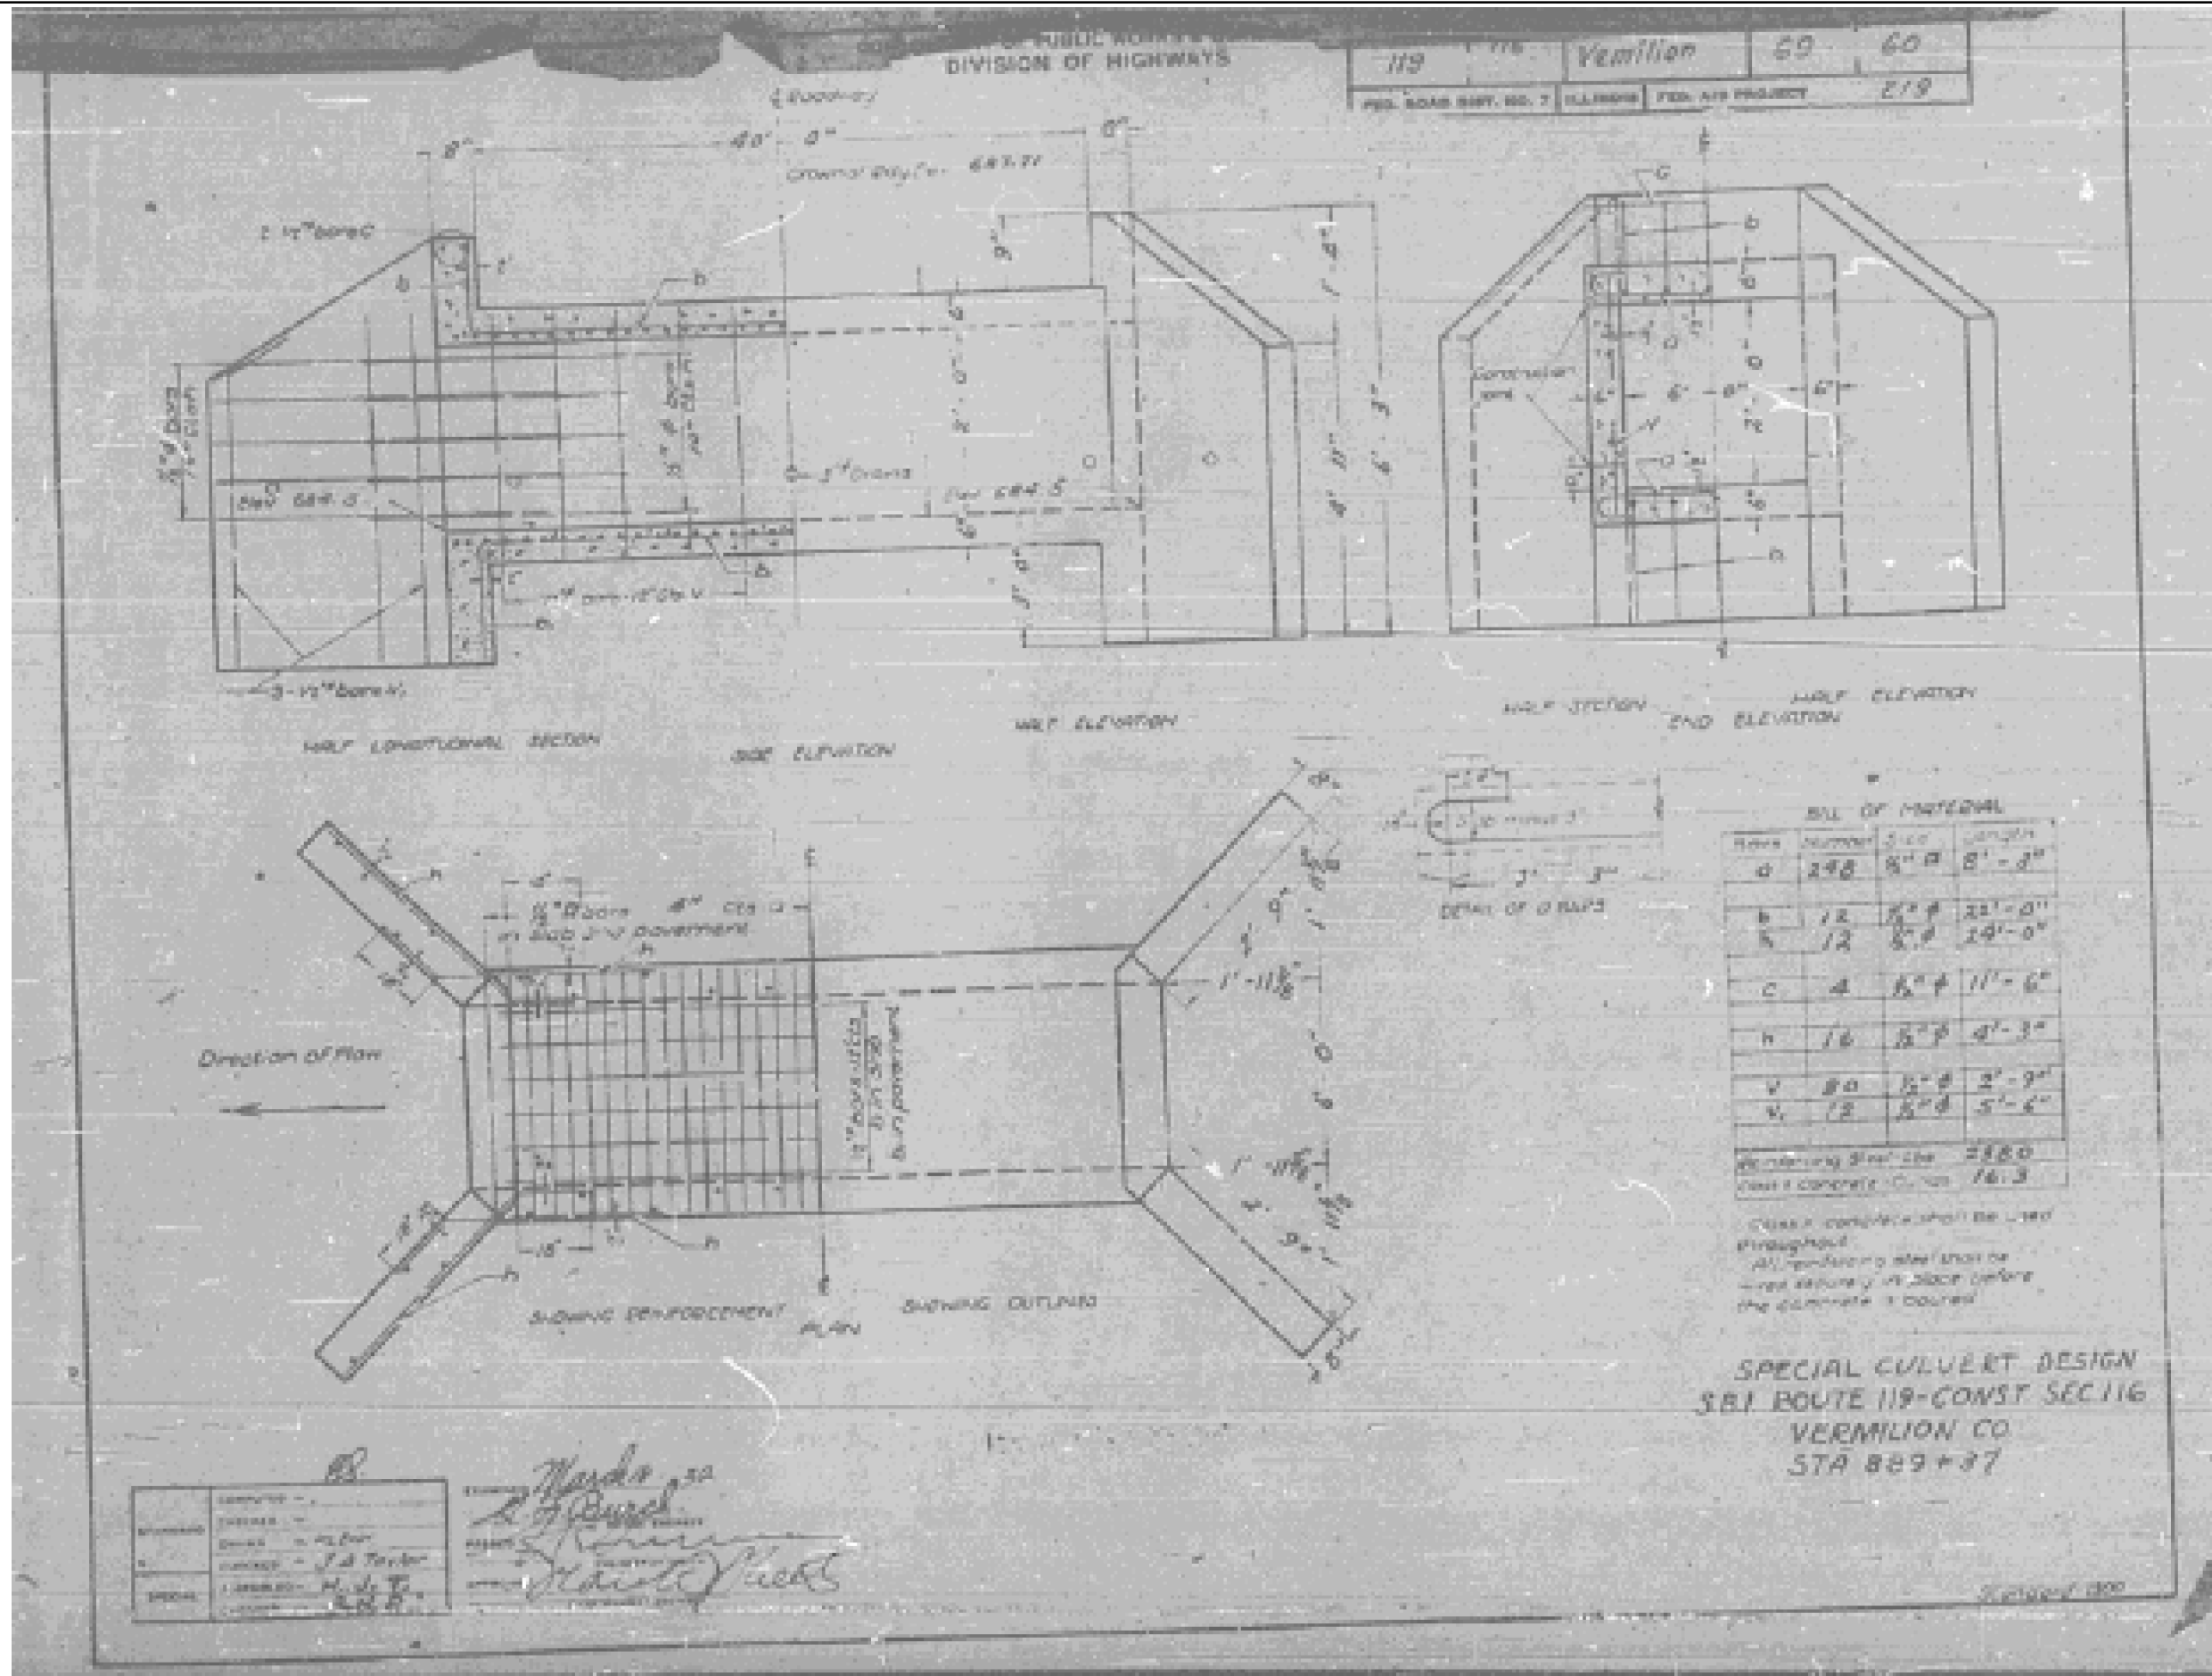

FOR INFORMATION ONLY

| | | | | | | | | | | | |
|---|-------------------------------|------------|-----------|---|----------------------------------|---------------------------|---------|-----------|--------------|-----------|--|
| FILE NAME = | USER NAME = bowerm1 | DESIGNED - | REVISED - | STATE OF ILLINOIS DEPARTMENT OF TRANSPORTATION | AS-BUILTS FOR SN 092-8033 | F.A.P. RTE. | SECTION | COUNTY | TOTAL SHEETS | SHEET NO. | |
| ct:\pw\work\pwsdot\bowerm1\d0186764\70801 | sht-BoxCulverts.dgn | DRAWN - | REVISED - | | | 711 | 116CR | VERMILION | 50 | 23 | |
| | PLOT SCALE = 40.0000 1" = IN. | CHECKED - | REVISED - | | | CONTRACT NO. 70801 | | | | | |
| | PLOT DATE = 11/30/2010 | DATE - | REVISED - | | | ILLINOIS FED. AID PROJECT | | | | | |