


AS-BUILT PLANS FOR INFORMATION ONLY

STATE OF ILLINOIS
DEPARTMENT OF TRANSPORTATION


ROUTE NO.	SECTION	COUNTY	TOTAL SHEETS	SHEET NO. /
P.A. 132	BR	Edgar	53	34 // SHEETS

B.M. Cut "D" in N.E. Corner of R.C.C. inspection well on N. side of pump building. 60' Lt. Sta. 908+80. Elev. 667.06

Existing Structure #023-0006 Built in 1915 as Reservoir Bridge over Twin Lakes at the city of Paris at Sta. 911+27.95. ± 60 ft. long thru plate girder structure on R.C. closed abutments. Existing Structure to be removed as necessary by Bridge Contractor after stage I lanes are constructed and two-way traffic is established.
No Salvage.

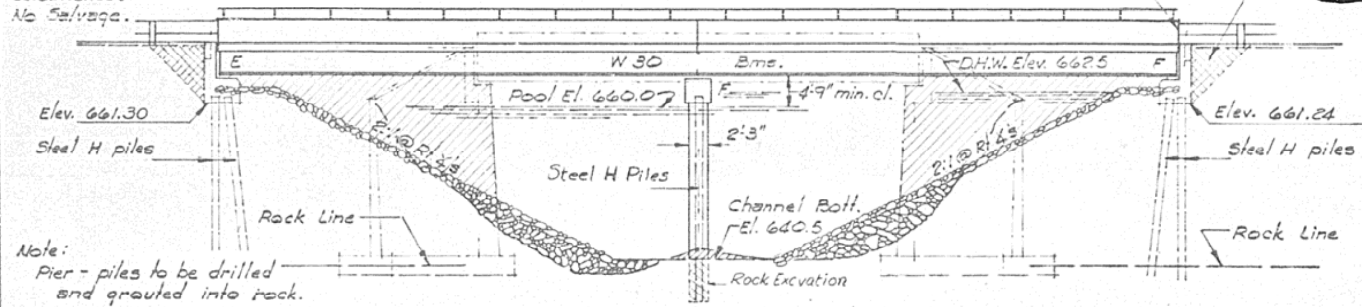

Note: Pier - piles to be drilled and grouted into rock.

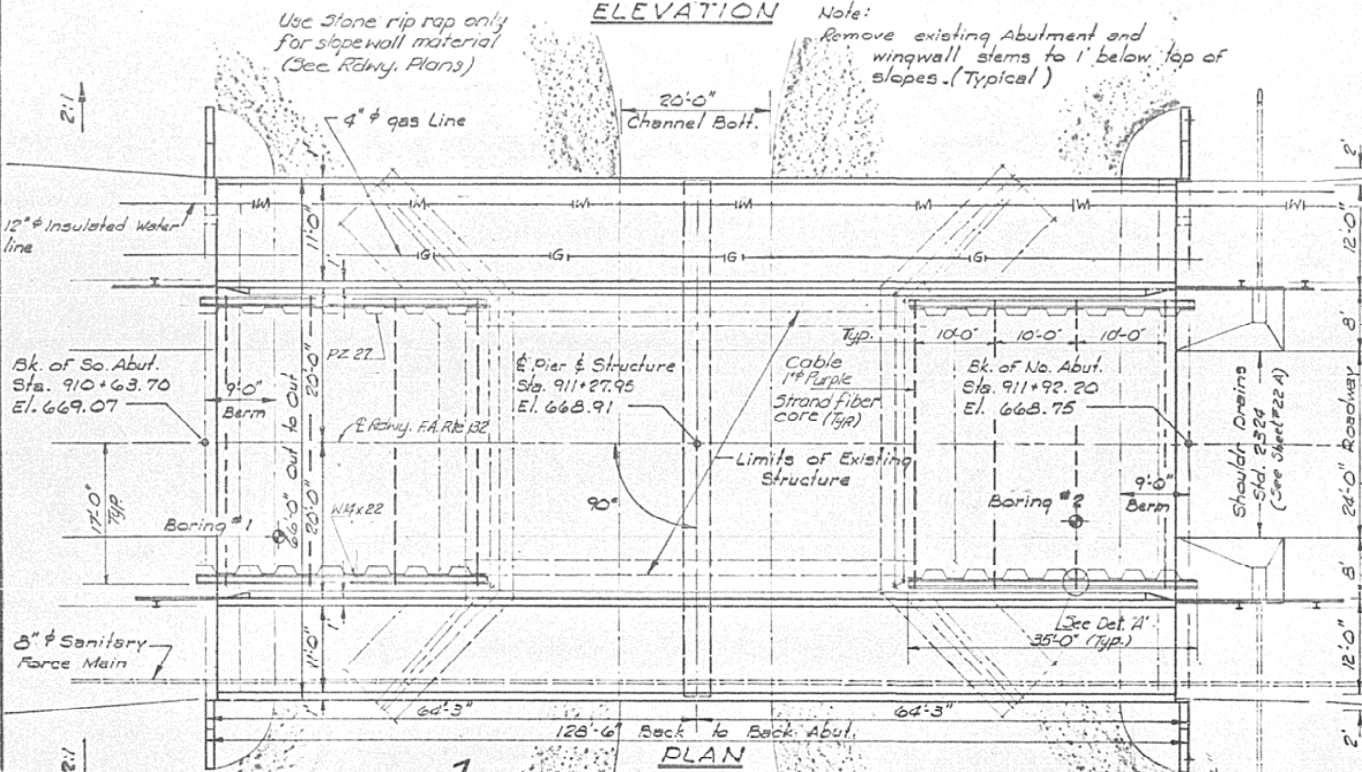

#See Std. 2113
Note: Str. No. to be supplied by the District.

STATION 911+27.95
BUILT 1917 BY
STATE OF ILLINOIS
FA. RTE. 132 SEC. (C-X) BR
FA. PROJ. BR-F-132(18)
LOADING HS 20
STR. No. 023-0024

NAME PLATE
April 1 1977
Carl E. Thompson, Jr.
CHIEF OF BRIDGE AND TRAFFIC STRUCTURES



DESIGNED	R. Carroll
CHECKED	D.R. Gathard
DRAWN	A. Borazza
CHECKED	D.R. Gathard

EXAMINED	Carl E. Thompson, Jr.
PASSED	
APPROVED	

WATERWAY INFORMATION

Drainage Area	= 17.4 sq. mi.
Discharge (50yr)	= 2300 cfs.
Required Opening	= 1366 sq. ft.
Existing Opening	= 1223 sq. ft.
Proposed Opening	= 1366 sq. ft.
Created Hd. (50yr)	= NA
Q (100 yr.)	= 2800 cfs
H.W.E. (100yr)	= 663.0
Created Hd. (100yr)	= NA

DETAIL "A"

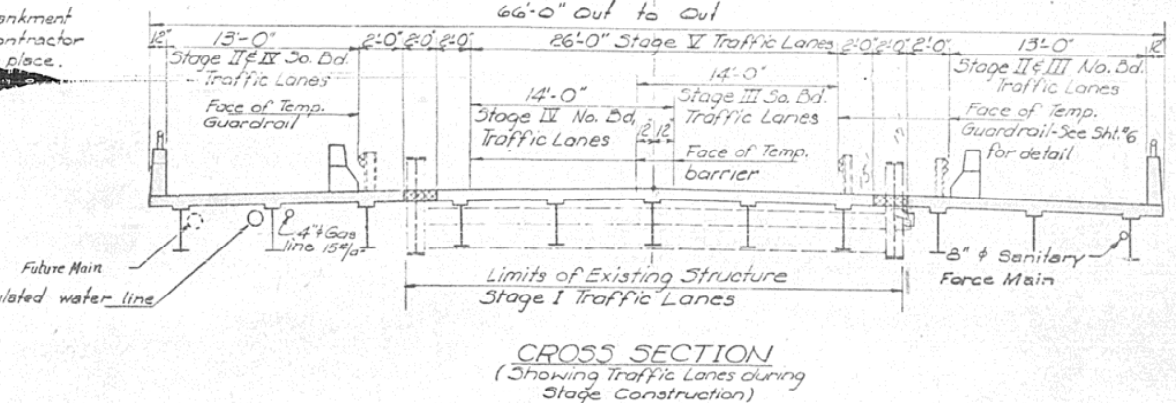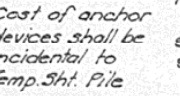

TOTAL BILL OF MATERIAL

Item	Super.	Sub	Total
Removal of Existing Structures Ea.			1
Protective Coat Sq Yds	1141		1141
Class X Concrete Cu Yds	262.4	121.5	383.9
Structural Steel L.S.			967.6
Aluminum Railing Lin Ft	252		252
Temporary Guardrail Lin Ft	252		252
Reinforcement Bars Lbs.	27290	8920	36210
Reinforcement Bars (Epoxy coated) Lbs	36800		36800
Steel Piles HP 8x36 Lin Ft		564	564
Steel Piles HP 12x53 (Special) Lin Ft		319	319
Test Piles Steel HP 8x36 Ea.	2		2
Class X Concrete Encasement Culs Ea.	44.3		44.3
Name Plates Ea.			1
Rock Excavation Cu Yds			10
Temp. Sheet Piling Sq Ft.			4200
Preformed Jt. Sealer # Lin Ft.	66		66
Shear Connectors Ea.	4356		4356
Coil Rods 3/4" x 3'-0" (Epoxy coated) Ea.	260		260
Coil Rods 3/4" x 2'-0" (Epoxy coated) Ea.	264		264
Straight Loop Inserts 3/4" x 4" Ea.	264		264
Open Coil Inserts 3/4" x 4" Ea.	260		260

GENERAL NOTES


See Proposal for Boring Data.
Fasteners shall be high strength bolts. Bolts 3/4"; open holes 13/16" unless otherwise noted.
Calculated weight of Structural Steel = 131720 lbs
All structural steel shall be AASHTO M282 unpainted except expansion joint angles and attached bars which shall be AASHTO M183 and shop painted with two coats of basic lead silico chromate paint.
Field welding of construction accessories will not be permitted to the bottom flange of beams nor to the top flange for a distance equal to one-fourth the span length each way from the pier supports. Field welding in other areas will be permitted only when approved by the Engineer.
Anchor bolts shall be set before bolting diaphragms over supports.
Layout of rip rap may be varied in the field to suit ground conditions as directed by the Engineer.
The Contractor shall drive 2 steel test piles in a permanent location, 1 @ ea. Abut., as directed by the Engineer before ordering the remainder of piles.
It shall be the responsibility of the Contractor to verify all dimensions and conditions existing in the field prior to construction and ordering of materials.
The concrete rail section above the mandatory construction joint at the top of the slab shall be constructed of Class X Conc. except the aggregates shall conform to the requirements of Handrail Concrete.
Bearing seat surfaces shall be constructed or adjusted to the designated elevations within a tolerance of 6". Adjustment shall be made either by grinding the surface or by shimming the brg. Two 6" adjusting shims, of the dimensions of the bolt brg. fl., shall be provided for ea. bearing in addition to all other plates or shims.
Protective coat shall be applied in accordance with Art. 503.12 of Standard Specifications.
All reinforcement bars shall be AASHTO M31 Grade 60

DESIGN STRESSES PROFILE GRADE FA. RTE. 132

f_c = 3500 psi
f_y = 60,000 psi (Reinf.)
f_s = 27,000 psi (Struct.)

LOADING HS 20-44

Allow 25#/sq. ft. for future wearing surface. Design Specification: 1973 AASHTO 1974, 1975 and 1976 Interim specifications.
*Epoxy coated reinforcement shall be used in top layer of the slab.

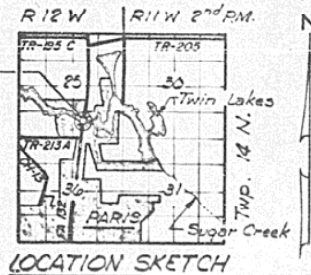

GENERAL PLAN & ELEVATION
FA. RTE. 132 Over TWIN LAKES - CITY OF PARIS
FA. RTE. 132 SECTION (C-X) BR
EDGAR COUNTY
STATION 911+27.95

Rev 6-1-77