
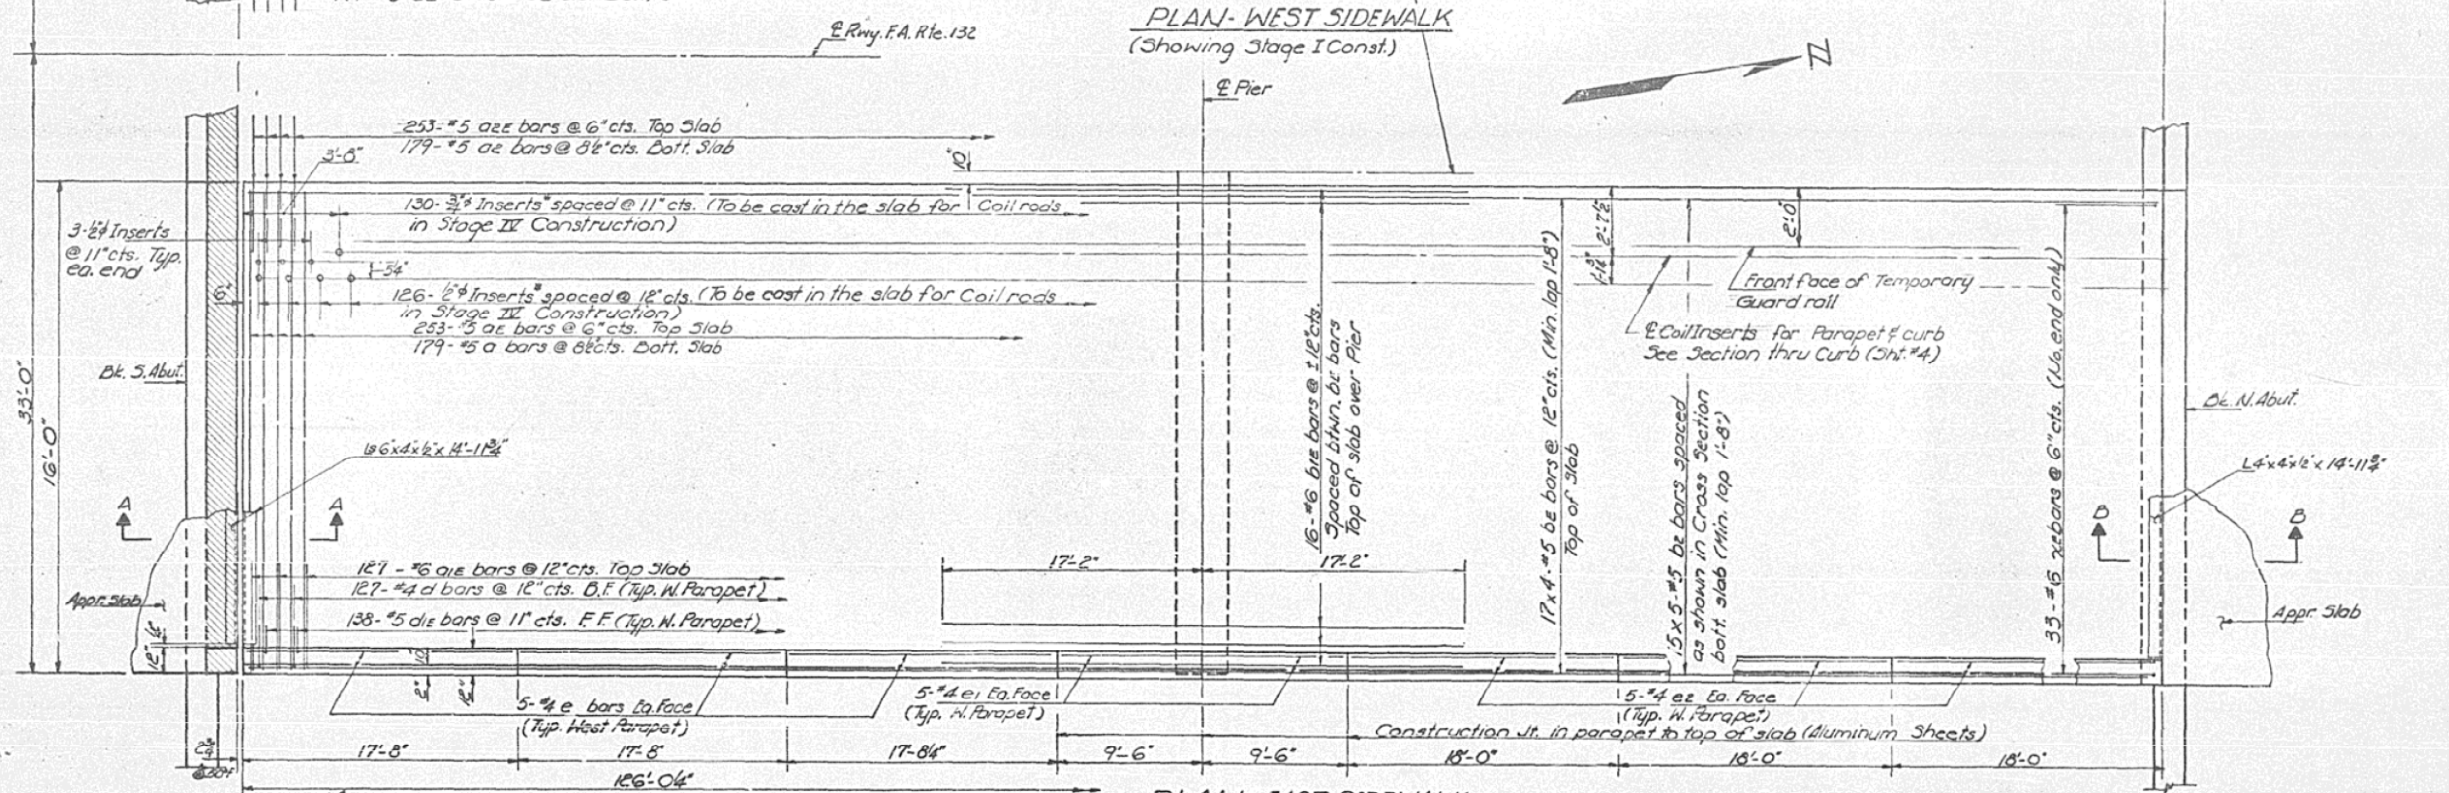


AS-BUILT PLANS FOR INFORMATION ONLY

STATE OF ILLINOIS
DEPARTMENT OF TRANSPORTATION

| | | | | | |
|-------------|---------|--------|--------------|-----------|-----------|
| ROUTE NO. | SECTION | COUNTY | TOTAL SHEETS | SHEET NO. | SHEET NO. |
| 132 | BR | Edgar | 53 | 36 | 11 SHEETS |
| SHEET NO. 3 | | | | | |

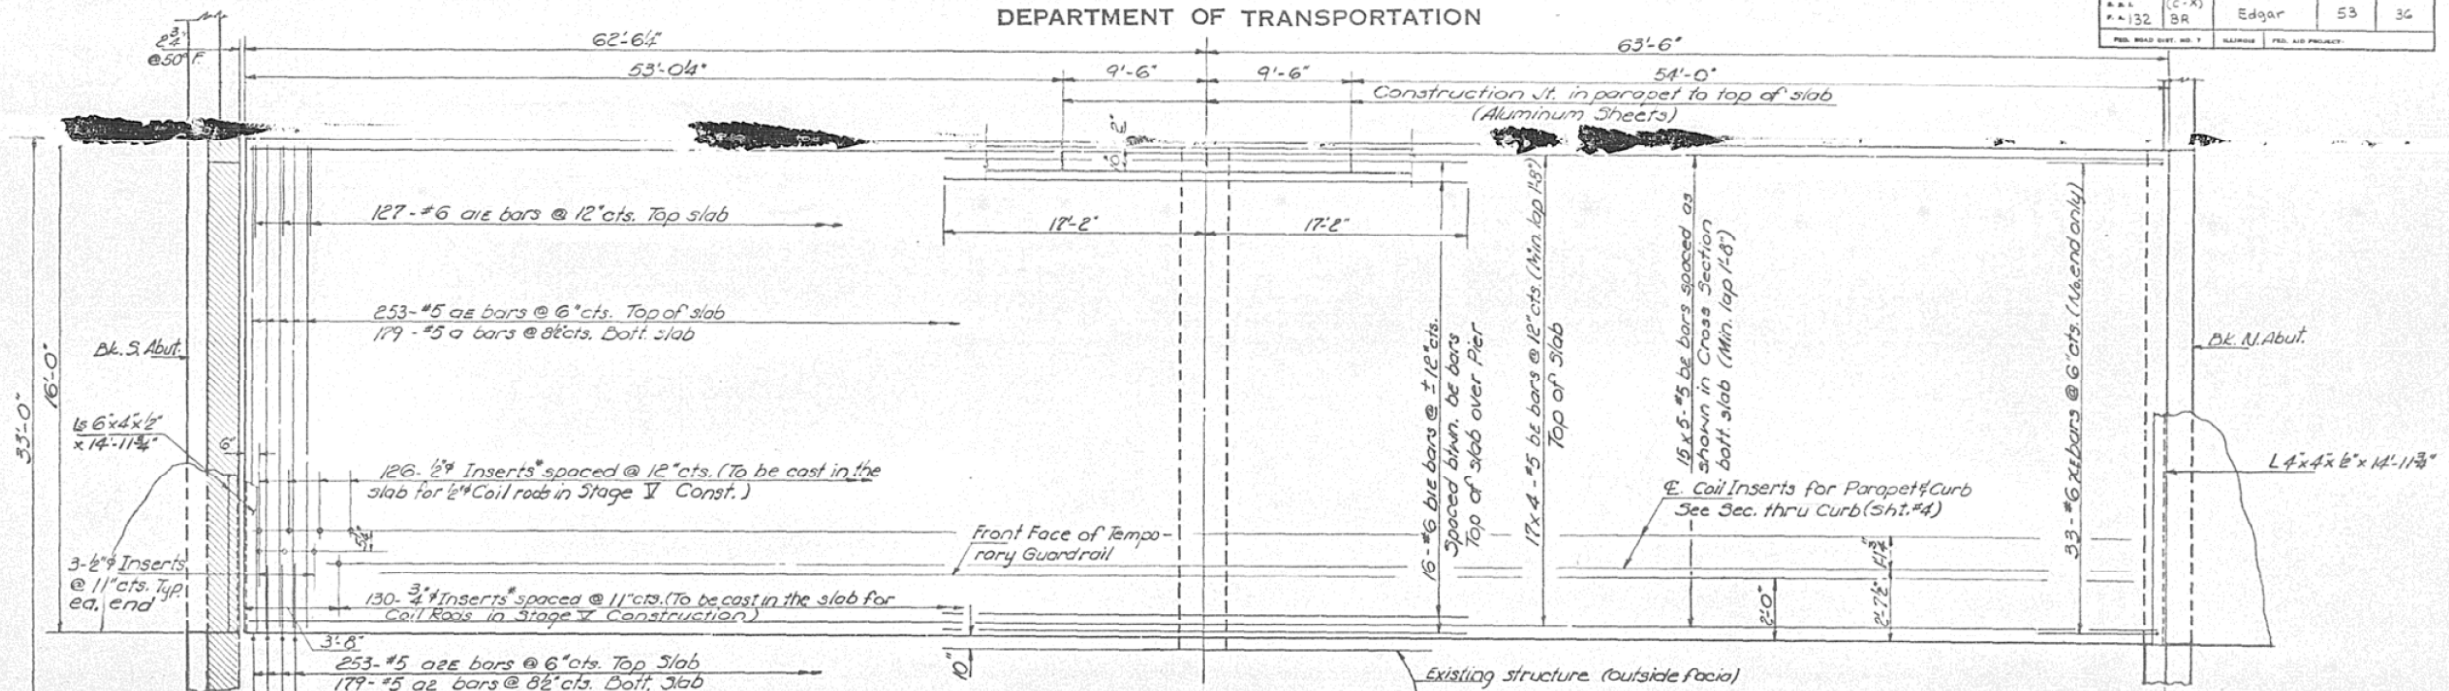

| | |
|-----------------------------|----------------------------------|
| DESIGNED <i>R. Carroll</i> | EXAMINED <i>Earl E. Thompson</i> |
| CHECKED <i>D.R. Gathard</i> | PASSED |
| DRAWN <i>A. Borraza</i> | APPROVED |
| CHECKED <i>D.R. Gathard</i> | |

* 1/2" Inserts shall be straight coil loop insert
 #4 Inserts shall be open coil insert two-strut.
 See Special Provisions

Note:
 Bars indicated thus 17x4-#5 etc. indicate 17 lines of bars with 4 lengths per line.
 See Sheet #5 for Deck Cross Sec., Sec. A-A, Sec. B-B, Bar details & Drill of Material.

**SUPERSTRUCTURE
 STAGE I CONSTRUCTION
 F.A. RTE. 132 SEC. (C-X) BR
 EDGAR COUNTY
 STA. 911+27.95**