


AS-BUILT PLANS FOR INFORMATION ONLY

STATE OF ILLINOIS
DEPARTMENT OF TRANSPORTATION


ROUTE NO.	SECTION	COUNTY	TOTAL SHEETS	SHEET NO.
32	SR	Edgar	37	11
SHEETS				

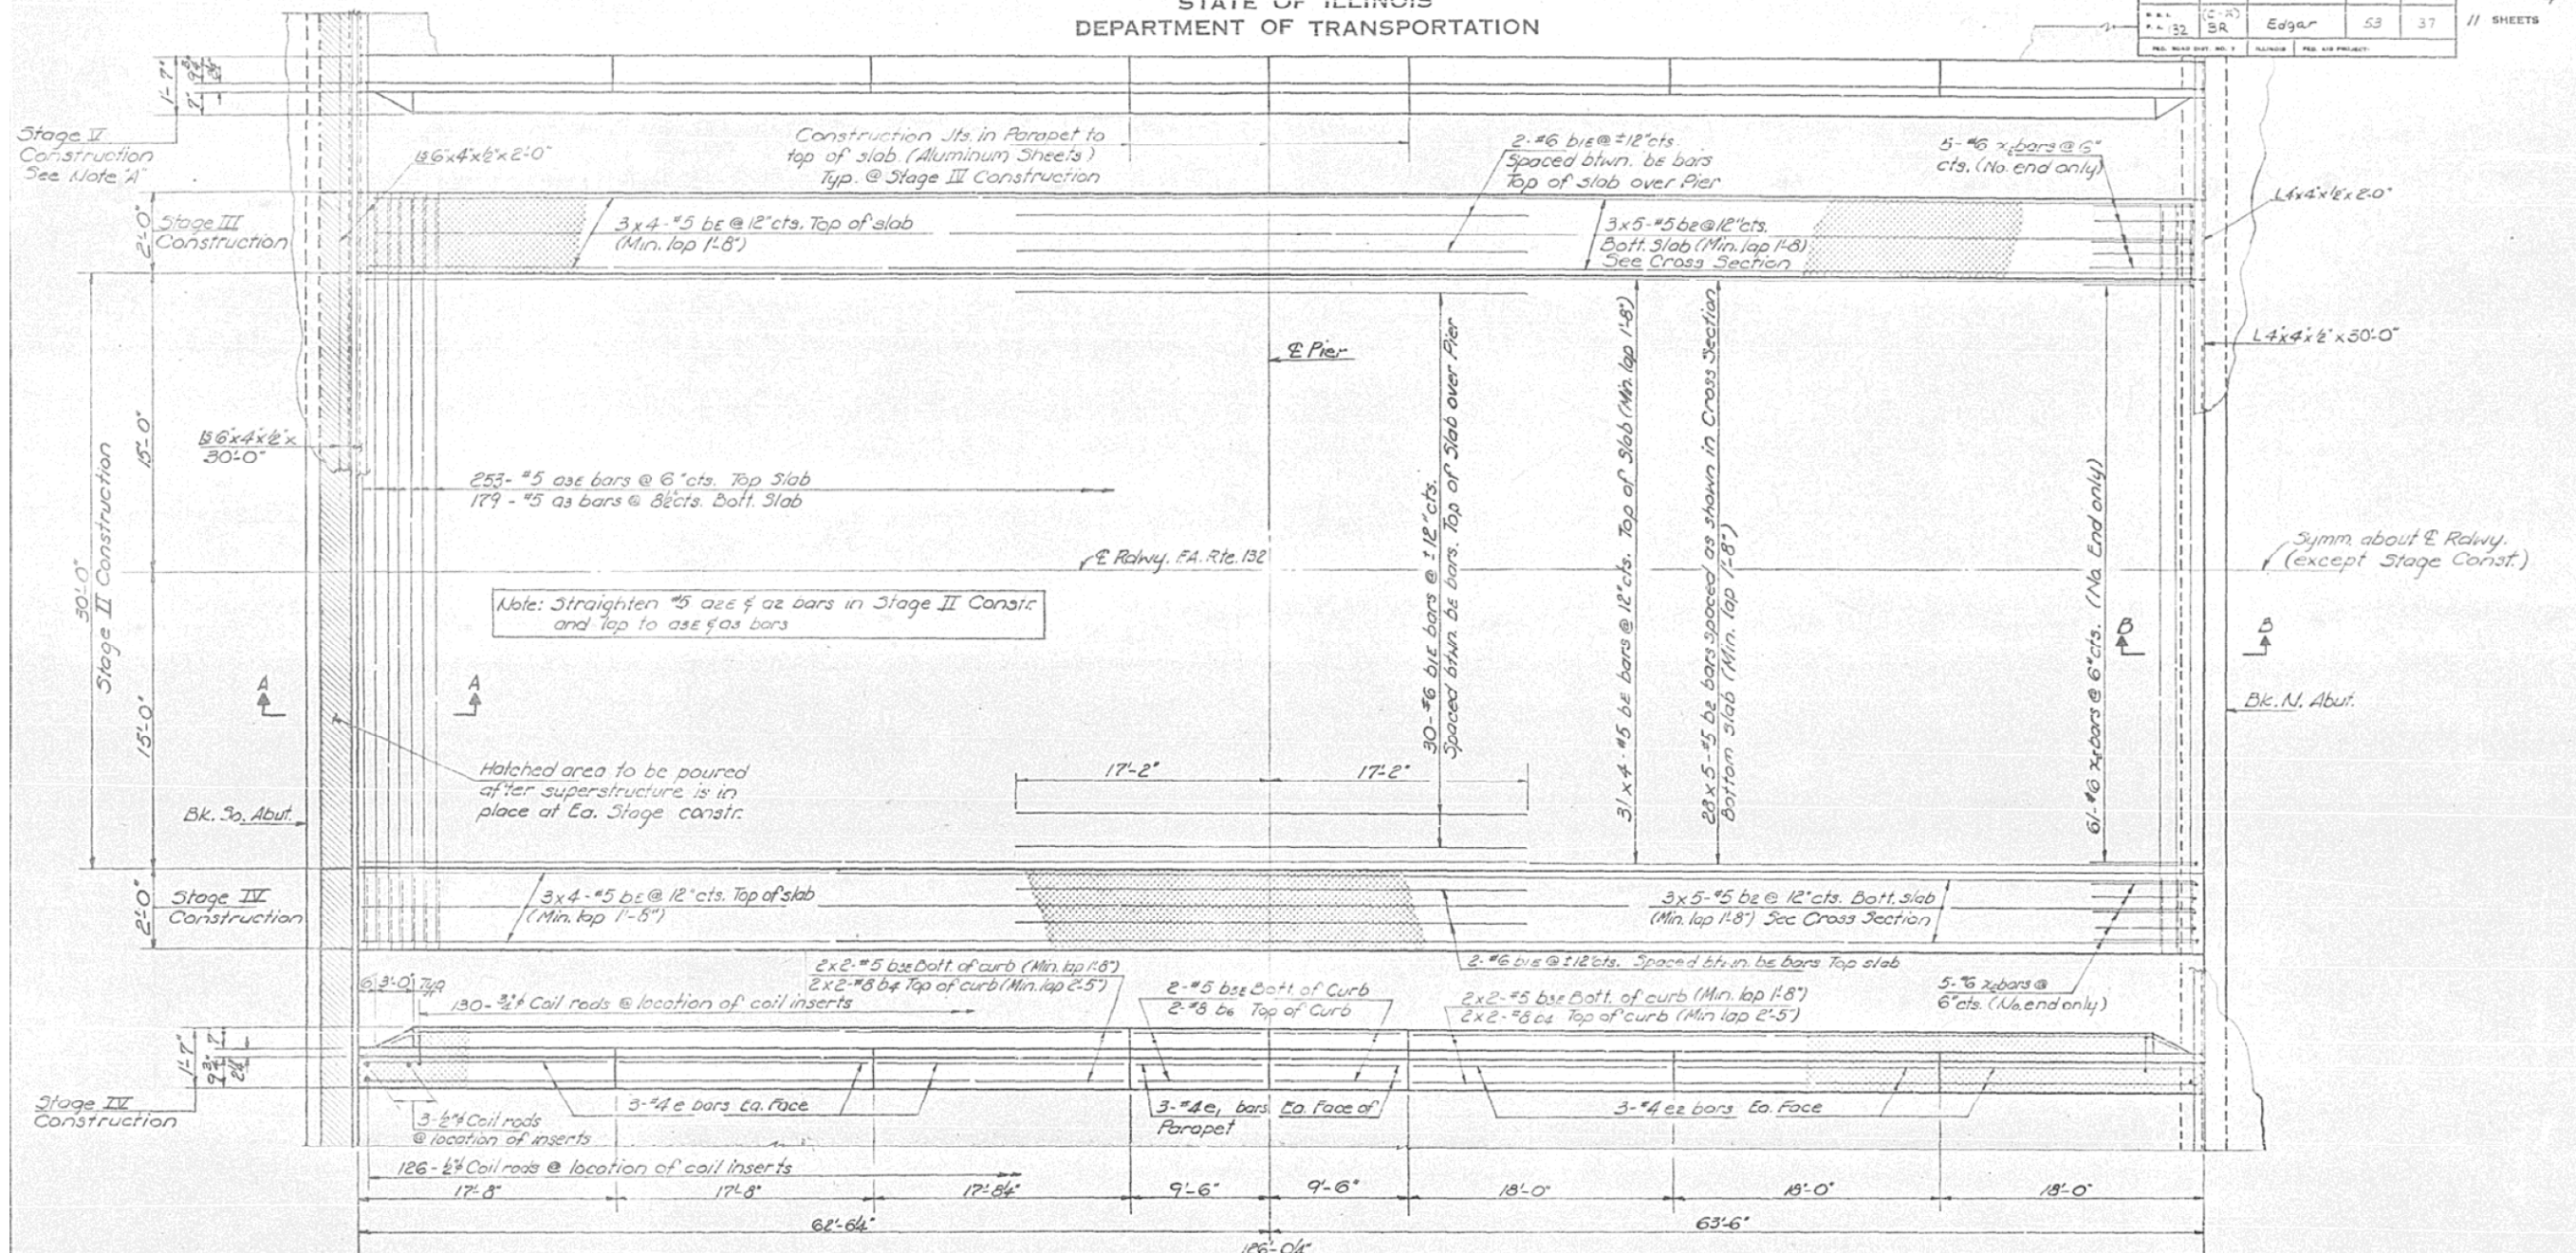

Note: Straighten #5 az bars in Stage II Const. and lap to az bars

Note 'A': Dimensions of reinforcement in Parapet & Curb at Stage I Const. are typical to Stage II Construction.

PLAN

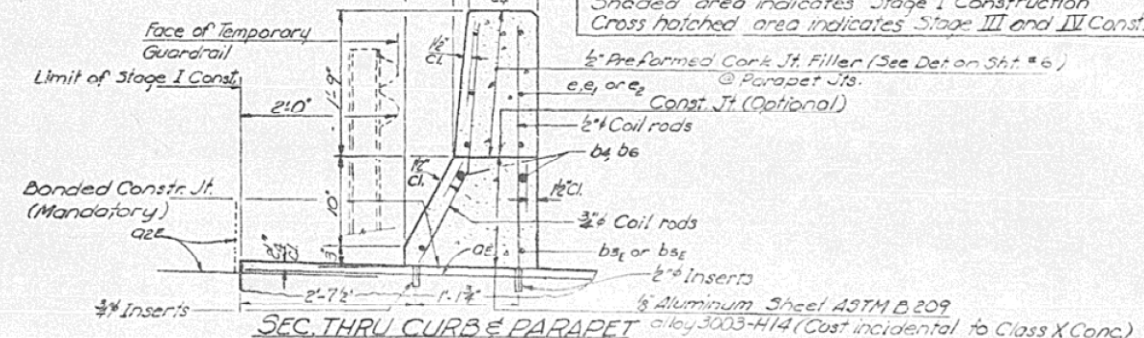

Note: Bars indicated thus 3x4 #5 etc. indicate 3 lines of bars with 4 lengths per line. See Sheet #5 for Cross Sec., Sec. A-A, Sec. B-B, Bar Details & Bill of Materials.

DESIGNED	R. Carroll	EXAMINED	April 1, 2011 Carl E. Hummer
CHECKED	D.R. Giffard	PASSED	
DRAWN	A. Borraza	APPROVED	
CHECKED	D.R. Giffard		

**SUPERSTRUCTURE
STAGE II, III, IV & V CONST.
FA RTE. 132 SEC. (C-X) BR
EDGAR COUNTY
STA. 911+27.95**

FILE NAME =	USER NAME = carrollr	DESIGNED R. Carroll	REVISED -
ct:\pw\work\pudot\carrollr\td0212096\Bridg	Bridge Repairs - 023-0024.dgn	DRAWN R. Carroll	REVISED -
	PLOT SCALE = 40.0000 ' / IN.	CHECKED T. Brandenburg	REVISED -
	PLOT DATE = 12/10/2010	DATE 10/1/2010	REVISED -

**STATE OF ILLINOIS
DEPARTMENT OF TRANSPORTATION**

**AS-BUILT PLANS (FOR INFORMATION ONLY)
S.N. 023-0024**

SCALE: SHEET NO. 14 OF 19 SHEETS STA. TO STA.

F.A.P. RTE.	SECTION	COUNTY	TOTAL SHEETS	SHEET NO.
332 & 91	101 BDR & CX-BJR	EDGAR	36	26
CONTRACT NO. 70873				
ILLINOIS FED. AID PROJECT				