


SHEET NO 47

NORTH

SHEET NO 45

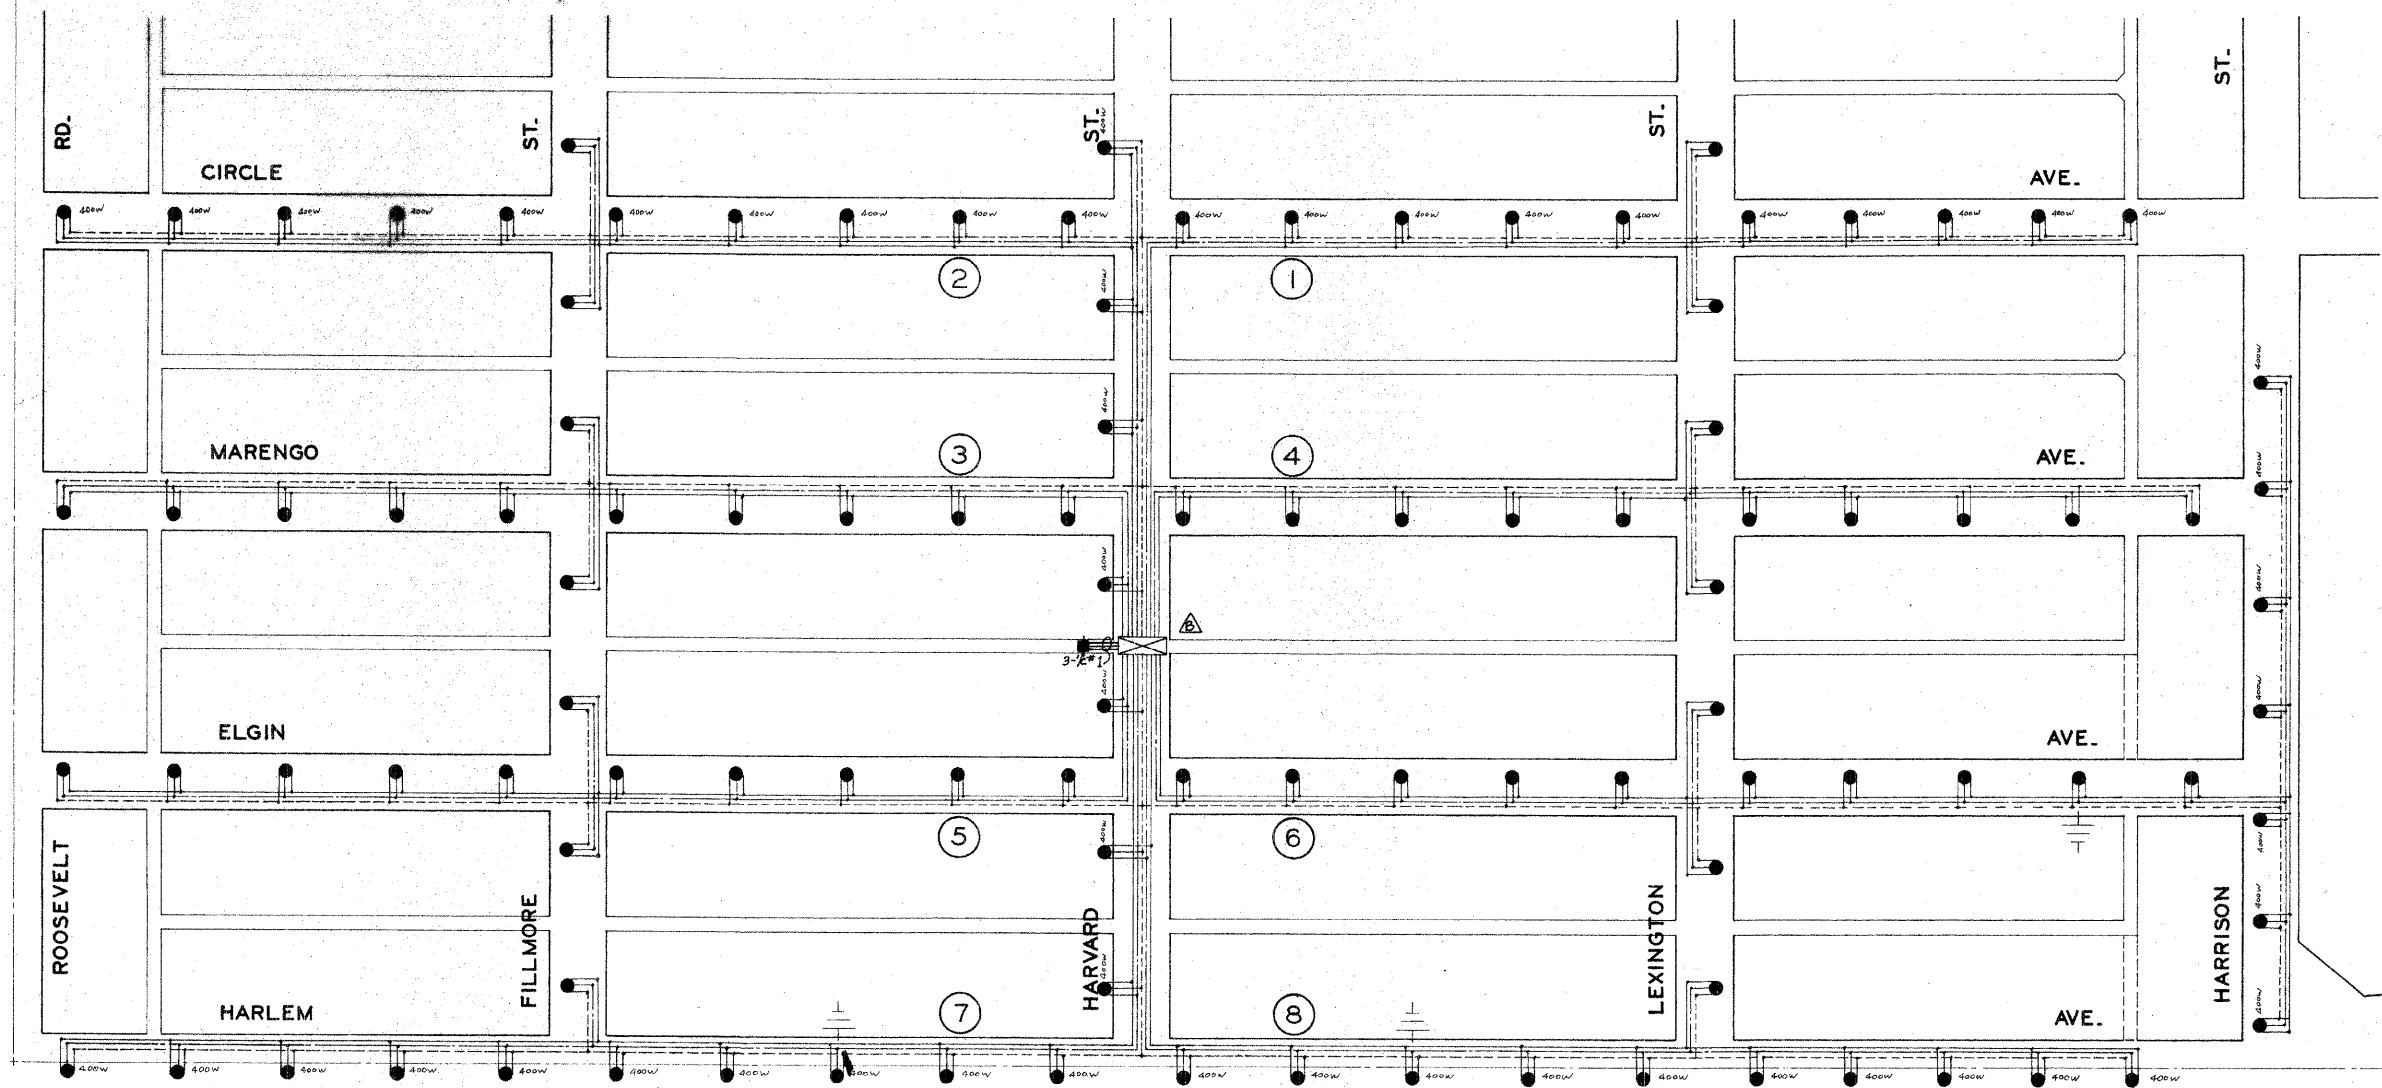

NOTE: HARLEM AVE. TO HAVE 400 WATT MERCURY VAPOR LUMINAIRES.

WIRING DIAGRAM

STREET LIGHTING IMPROVEMENT PROJECT

REVISIONS		FOREST PARK, ILL.	DRAWN BY	COMB
DATE	BY		CHECKED BY	
4/15/74	C.N.	APPROVED BY		
11/1/75	MK	FIELD NOTES	MK	BOOK NO. 804-809
	AS SHOWN	DATE	2-14-74	
		SCALE	1" = 100'	
		SHEET NO.	46	OF 56 SHEETS

EDWIN HANCOCK ENGINEERING CO.  
CONSULTING ENGINEERS  
7521 MADISON ST. FOREST PARK, ILL. 60130

FILE NAME =	USER NAME = JBARNETT	DESIGNED -	REVISED -
N:\FORESTPARK\070082\Mech\REC_070082_02.SHT		DRAWN -	REVISED -
PLOT SCALE = 2"		CHECKED -	REVISED -
PLOT DATE = 2/16/2009		DATE -	REVISED -

STATE OF ILLINOIS  
DEPARTMENT OF TRANSPORTATION

ROADWAY LIGHTING IMPROVEMENTS - HARVARD ST.  
EXISTING CIRCUIT DIAGRAM (1 OF 2) RECORD DRAWING

F.A.U. RTE.	SECTION	COUNTY	TOTAL SHEETS	SHEET NO.
1702	07-00106-00-PV	COOK	75	48
CONTRACT NO. 63148				
FED. ROAD DIST. NO. 1   ILLINOIS FED. AID PROJECT				

SCALE: SHEET NO. OF SHEETS STA. TO STA.