
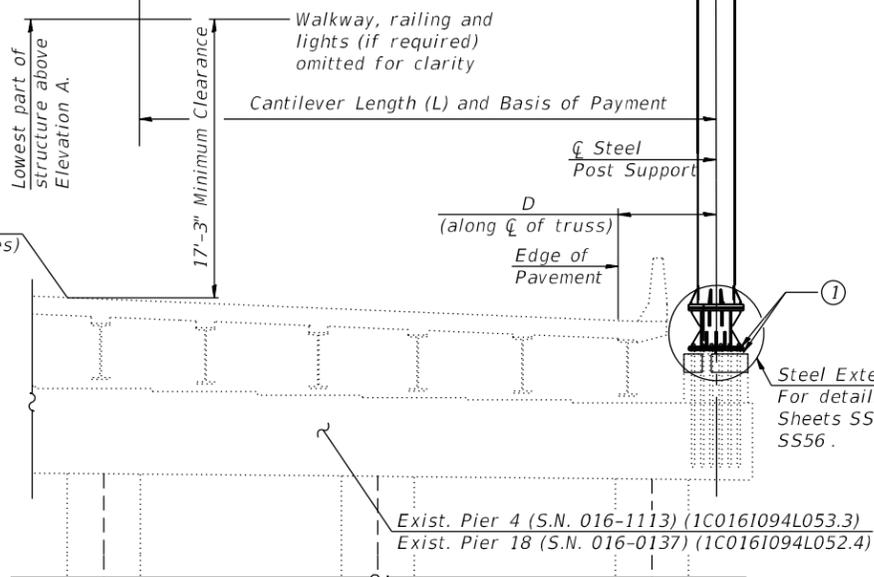


TYPICAL PLAN
(Walkway not shown)

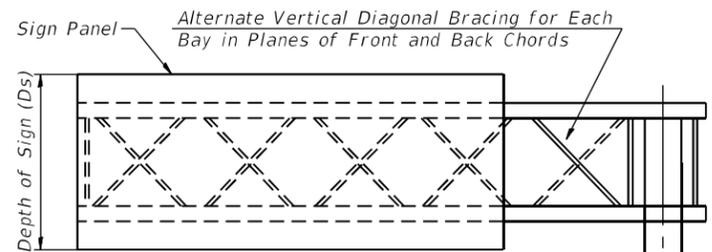

TYPICAL ELEVATION

Looking in Direction of Traffic

Elev. A = Elevation at point of minimum clearance to sign, walkway support or truss.

Sign support structures may be subject to damaging vibrations and oscillations when sign panels are not in place during erection or maintenance of the structure. To avoid these vibrations and oscillations, consideration should be given to attaching temporary blank sign panels to the structure.




SIGNED Moussa A. Issa
DR. MOUSSA A. ISSA, S.E., IL. LIC. NO. 081-005738
EXPIRES 11-30-2020
DATE 01/29/2020 FOR SHEETS SS51 THRU SS58
AND SS59 TO SS74
(TOTAL OF 24 SHEETS)

** Measured along Exist. NB I-90/94. It should be noted that the station included in the Table is measured along the Exist. NB I-90/94 as presented in this Contract and may differ from stations shown in Existing Record Drawings.

Structure Number	**Station	Design Truss Type	Cantilever Length (L)	Elev. A	Dim. D	Ds	Total Sign Area
1C0161094L053.3	130+60.47	II-C-A	25'-0"	639.58	7'-6"	8'-6"	187 Sq. Ft.
1C0161094L052.4	178+42.70	II-C-A	21'-6"	614.00	6'-4 1/4"	12'-0"	198 Sq. Ft.

Truss Type	Maximum Sign Area	Maximum Length
I-C-A	170 Sq. Ft.	25 Ft.
II-C-A	340 Sq. Ft.	30 Ft.
III-C-A	400 Sq. Ft.	40 Ft.

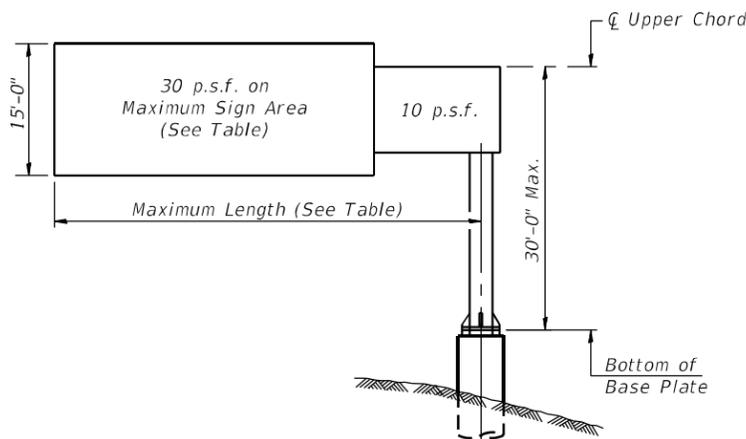

DESIGN WIND LOADING DIAGRAM

Parameters shown are basis for I.D.O.T. Standards. Installations not within dimensional limits shown require special analysis for all components.

Note:
Trusses shall be shipped individually with adequate provision to prevent detrimental motion during transport. This may require ropes between horizontals and diagonals or energy dissipating (elastic) ties to the vehicle. The contractor is responsible for maintaining the configuration and protection of the trusses.

① After adjustments to level truss and ensure adequate vertical clearance, all top and leveling nuts shall be tightened against the base plate with a minimum torque of 200 lb.-ft. Stainless steel mesh shall then be placed around the perimeter of the base plate. Secure to base plate with stainless steel banding.

* If M270 Gr. 50W (M222) steel is proposed, chemistry for plate to be used shall first be approved by the Engineer as suitable for galvanizing and welding.

GENERAL NOTES

DESIGN: AASHTO Standard Specifications for Structural Supports for Highway Signs, Luminaires and Traffic Signals. ("AASHTO Specifications")

CONSTRUCTION: Current (at time of letting) Illinois Department of Transportation Standard Specifications for Road and Bridge Construction, Supplemental Specifications and Special Provisions. ("Standard Specifications")

LOADING: 90 M.P.H. WIND VELOCITY

WALKWAY LOADING: Dead load plus 500 lbs. concentrated live load.

DESIGN STRESSES:

Field Units	Existing Construction
f'c = 3,500 p.s.i.	f'c = 3,500 p.s.i.
fy = 60,000 p.s.i. (reinforcement)	fy = 60,000 p.s.i. (reinforcement)
fy = 50,000 p.s.i. (AASHTO M270 Grade 50 Struct. Steel)	fy = 55,000 p.s.i. (Anchor Bolts - ASTM A576)

WELDING: All welds to be continuous unless otherwise shown. All welding to be done in accordance with current AWS D1.1 and D1.2 Structural Welding Codes (Steel and Aluminum) and the Standard Specifications.

MATERIALS: Aluminum Alloys as shown throughout plans. All Structural Steel Pipe shall be ASTM A53 Grade B or A500 Grade B or C. If A500 pipe is substituted for A53, then the outside diameter shall be as detailed and wall thickness greater than or equal to A53.

All Structural Steel Plates and Shapes shall conform to AASHTO M270 Gr. 36, Gr. 50 or Gr. 50W*. Stainless steel for shims, sleeves and handhole covers shall be ASTM A240, Type 302 or 304, or another alloy suitable for exterior exposure and acceptable to the Engineer.

The steel pipe and stiffening ribs at the base plate for the column shall have a minimum longitudinal Charpy V-Notch (CVN) energy of 15 lb.-ft. at 40° F. (Zone 2) before galvanizing.

FASTENERS FOR ALUMINUM TRUSSES: All bolts noted as "high strength" must satisfy the requirements of AASHTO M164 (ASTM A325), or approved alternate, and must have matching lock nuts. Threaded studs for splices (if Members interfere) must satisfy the requirements of ASTM A449, ASTM A193, Grade B7, or approved alternate, and must have matching lock nuts. Bolts and lock nuts not required to be high strength must satisfy the requirements of ASTM A307. All bolts and lock nuts must be hot dip galvanized per AASHTO M232. The lock nuts must have nylon or steel inserts. A stainless steel flat washer conforming to ASTM A240 Type 302 or 304, is required under both head and nut or under both nuts where threaded studs are used. High strength bolt installation shall conform to Article 505.04 (f) (2)d of the IDOT Standard Specifications for Road and Bridge Construction. Rotational capacity ("ROCAP") testing of bolts will not be required.

U-BOLTS AND EYEBOLTS: U-Bolts and Eyebolts must be produced from ASTM A276 Type 304, 304L, 316 or 316L, Condition A, cold finished stainless steel, or an equivalent material acceptable to the Engineer. All nuts for U-Bolts and Eyebolts must be lock nuts equivalent to ASTM A307 with nylon or steel inserts and hot dip galvanized per AASHTO M232. A stainless steel flat washer conforming to ASTM A240, Type 302 or 304, is required under each U-Bolt and Eyebolt lock nut.

GALVANIZING: All Steel Grating, Plates, Shapes and Pipe shall be Hot Dip Galvanized after fabrication in accordance with AASHTO M111. Painting is not permitted.

ANCHOR RODS: The existing anchor rods shall be cleaned, primed, painted (after Grout Pad Removal) and revised. Cost shall be included with Grout Pad Removal. The top of concrete pedestal shall be cleaned and coated with Concrete Sealer in accordance with the Standard Specifications. Cost included with Grout Pad Removal.

CONCRETE SURFACES: All concrete surfaces above an elevation 6" below the lowest final ground line at each foundation shall be cleaned and coated with Concrete Sealer in accordance with the Standard Specifications.

REINFORCEMENT BARS: Reinforcement Bars designated (E) shall be epoxy coated in accordance with the Standard Specifications.

WALKWAY: Walking grating, walking brackets, handrails, lighting and associated components shown in these plans on the traffic side of the sign structure/sign panel will not be installed with Contract 62A76. The truss grating and maintenance walkway behind the sign panel will be included with Overhead Sign Structure Cantilever Type II-C-A.

TOTAL BILL OF MATERIAL

ITEM	UNIT	TOTAL
FURNISHING AND ERECTING STRUCTURAL STEEL	POUND	3,090
OVERHEAD SIGN STRUCTURE CANTILEVER TYPE II-C-A	FOOT	47
STRUCTURAL REPAIR OF CONCRETE (DEPTH < 5")	SQ FT	6
GROUT PAD REMOVAL	EACH	2



USER NAME = marina.stoica	DESIGNED - JJS, WM	REVISED -
PLOT SCALE = N.T.S	CHECKED - MAI, JMG	REVISED -
PLOT DATE = 1/29/2020	DRAWN - JJS, WM	REVISED -
	CHECKED - MAI, JMG	REVISED -





STATE OF ILLINOIS
DEPARTMENT OF TRANSPORTATION

CANTILEVER SIGN STRUCTURES - GENERAL PLAN & ELEVATION
ALUMINUM TRUSS & STEEL POST

F.A.I. RTE. 90/94/290	SECTION 2015-019R	COUNTY COOK	TOTAL SHEETS 2155	SHEET NO. 1001
CONTRACT NO. 62A76				
ILLINOIS FED. AID PROJECT				

SHEET NO. SS51 OF SS129 SHEETS

FILE NAME: P:\V\AE\COM-NA-AWS1\aecononline\local\AE\COM-NA-AWS1\aecononline\01_Americas\Transportation\620269938_Circle\Phase_II\000_CAD\008_Structural\Sign_Structure\62A76_Sign_Structure\62A76-Cant-SS202- SignStruct.dgn

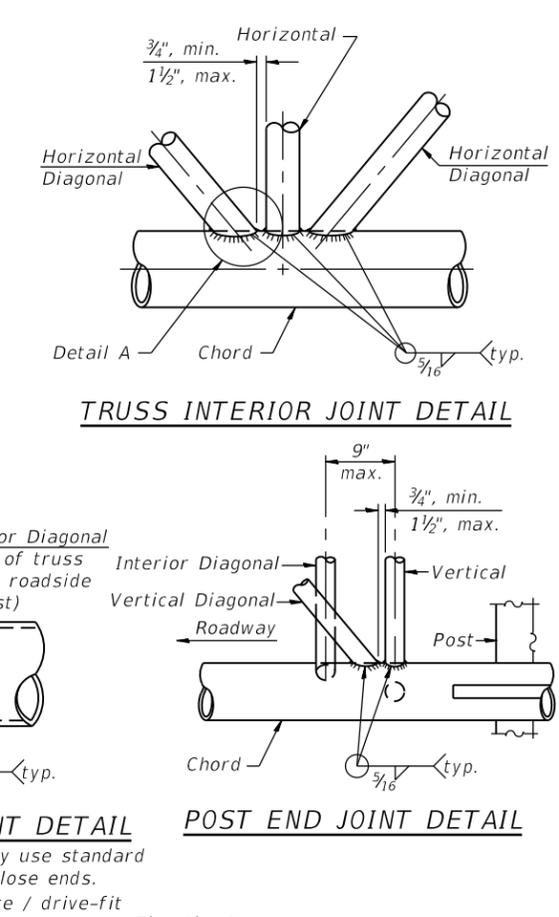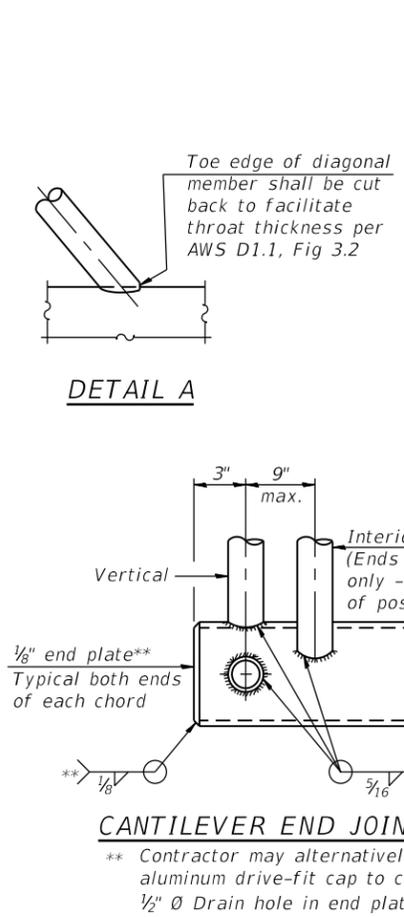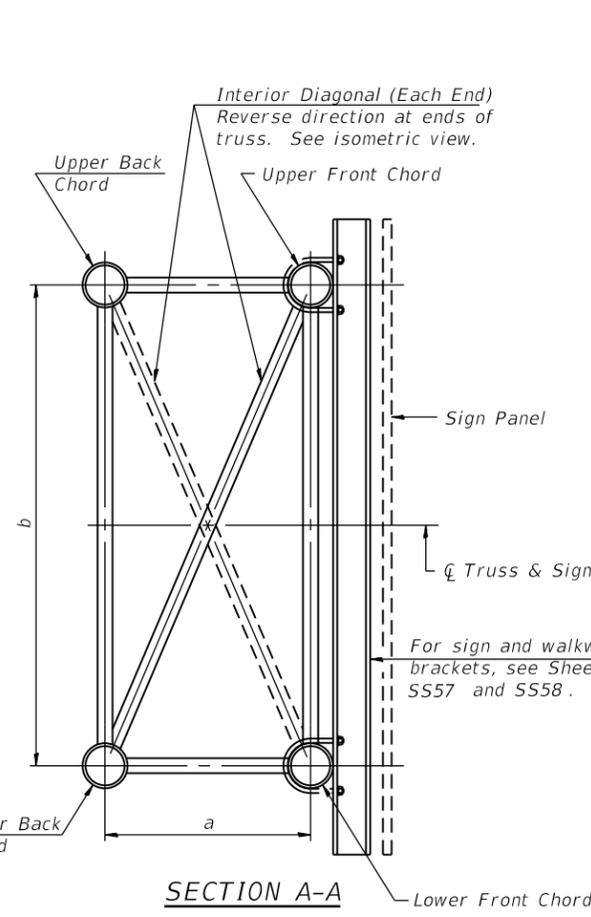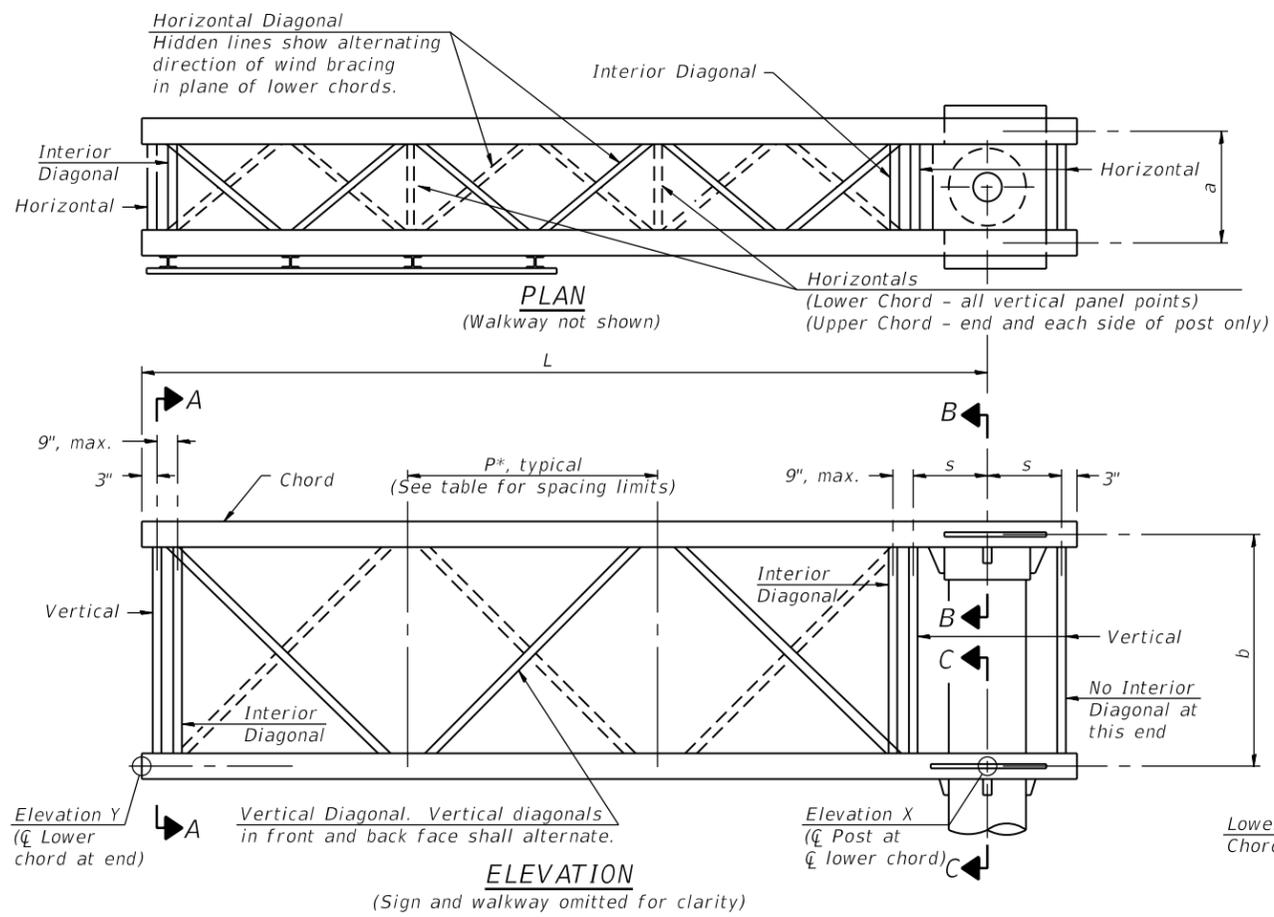

Note: There are twice as many horizontal diagonals as there are vertical diagonals.


TRUSS UNIT TABLE

Truss Type	Dimension "a"	Dimension "b"	Dimension "s"	Limits for Panel Spacing (P)*	Up. & Low. Chord		Verticals; Horizontals; Vertical, Horizontal, and Interior Diagonals	
					O.D.	Wall	O.D.	Wall
I-C-A	24"	54"	16"	36" min. to 48" max.	5"	5/16"	2 1/2"	5/16"
II-C-A	36"	66"	21"	42" min. to 54" max.	6 1/2"	5/16"	3 1/4"	5/16"
III-C-A (35' Max.)	36"	84"	21"	48" min. to 66" max.	7"	3/8"	3 1/2"	3/8"
III-C-A (>35' to 40')	36"	84"	21"	48" min. to 66" max.	8"	3/8"	3 1/2"	3/8"

$$*p = \frac{L-s-3"}{\# \text{ Panels}}$$


Structure Number	***Station	Truss Type	Design Length (L)	Number of Panels Per Unit	Panel Length (P)*
1C0161094L053.3	130+60.47	II-C-A	25'-0"	6	3'-10"
1C0161094L052.4	178+42.70	II-C-A	21'-6"	5	3'-10 3/4"

***Measured along Exist. NB I-90/94. It should be noted that the station included in the Table is measured along the Exist. NB I-90/94 as presented in this Contract and may differ from stations shown in Existing Record Drawings.

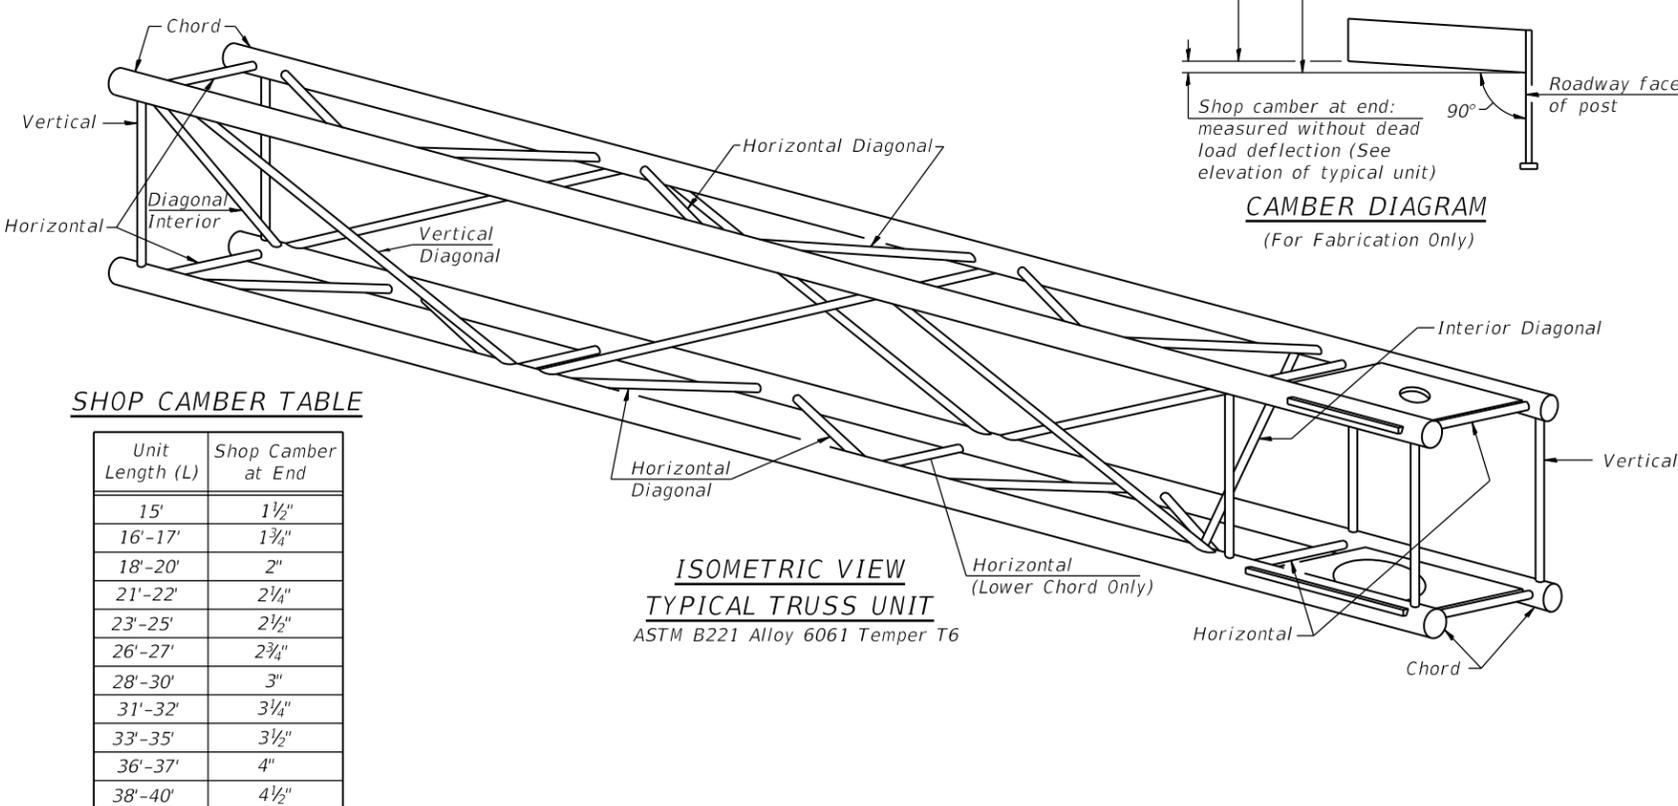

SHOP CAMBER TABLE

Unit Length (L)	Shop Camber at End
15'	1 1/2"
16'-17'	1 3/4"
18'-20'	2"
21'-22'	2 1/4"
23'-25'	2 1/2"
26'-27'	2 3/4"
28'-30'	3"
31'-32'	3 1/4"
33'-35'	3 1/2"
36'-37'	4"
38'-40'	4 1/2"

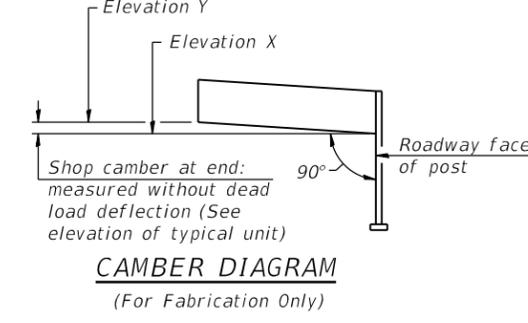

OSC-A-2

2-17-2017



USER NAME = charles.pigozzi	DESIGNED - JJS, WM	REVISED -
PLOT SCALE = N.T.S	CHECKED - MAI, JMG	REVISED -
PLOT DATE = 1/24/2020	DRAWN - JJS, WM	REVISED -
	CHECKED - MAI, JMG	REVISED -


STATE OF ILLINOIS
DEPARTMENT OF TRANSPORTATION

CANTILEVER SIGN STRUCTURES - TRUSS DETAILS
ALUMINUM TRUSS & STEEL POST


SHEET NO. SS52 OF SS129 SHEETS

F.A.I. RTE. 90/94/290	SECTION 2015-019R	COUNTY COOK	TOTAL SHEETS 2155	SHEET NO. 1002
CONTRACT NO. 62A76			ILLINOIS FED. AID PROJECT	


FILE NAME: D:\V\AECOM-NA-AW51_aecomonline-local\AECOM_DS02_NAVDocuments\01_Americas\Transportation\60269938_Circle\Phase\Structural\Sign_Structures\62A76_Sign_Structure\62A76-Cant-SS203-SignStruct.dgn

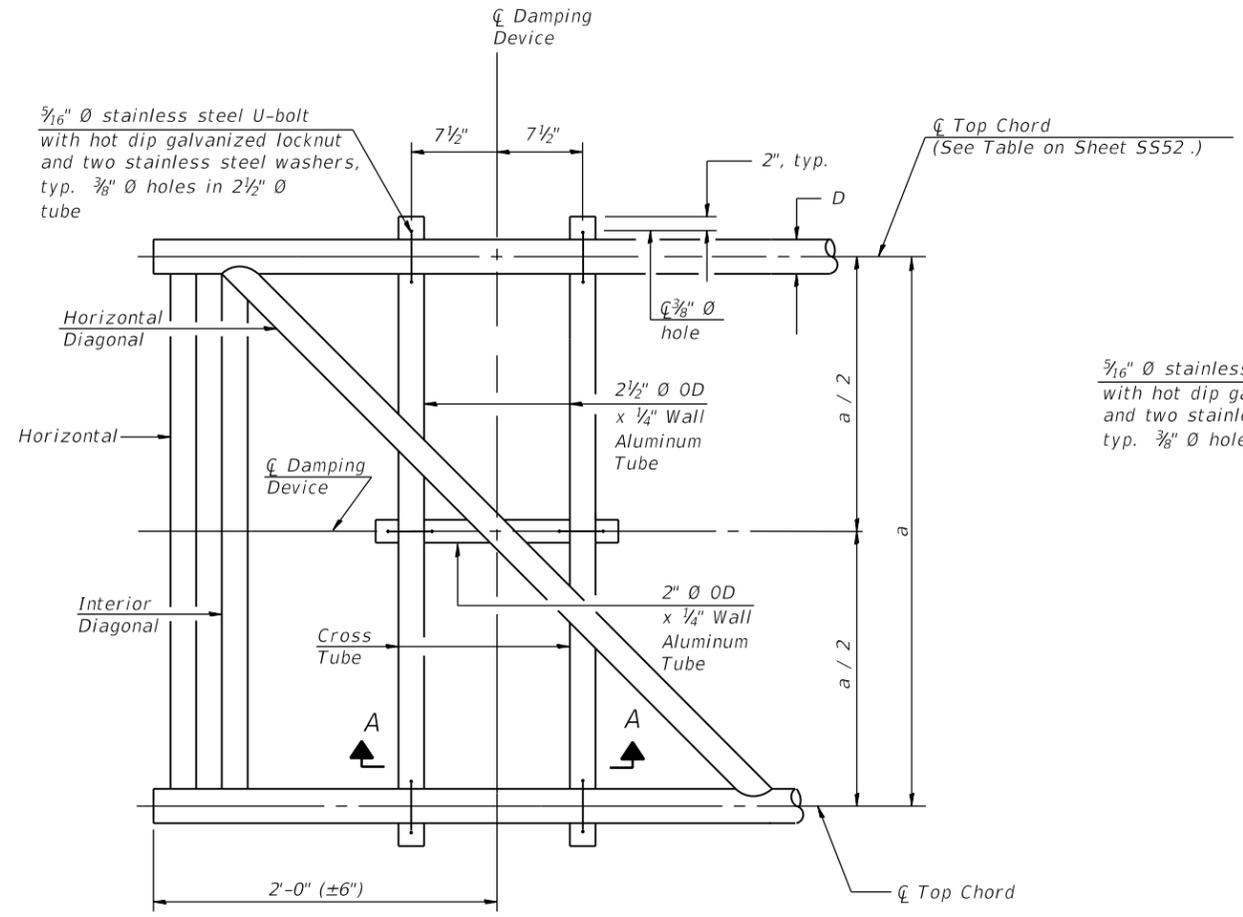


PLAN DETAIL

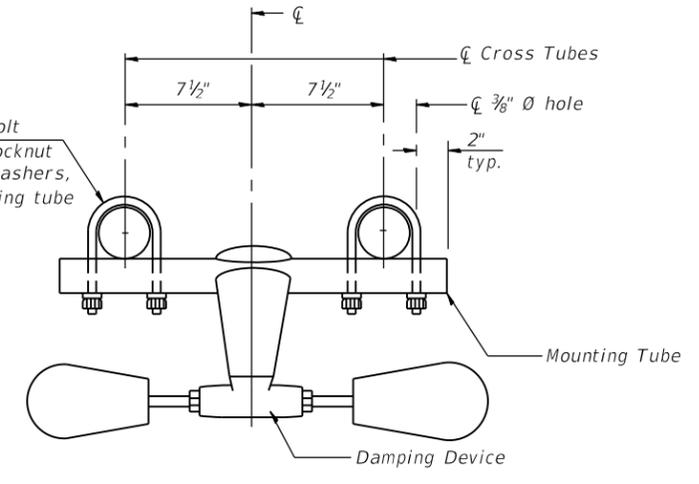


TRUSS DAMPING DEVICE CONNECTION DETAIL

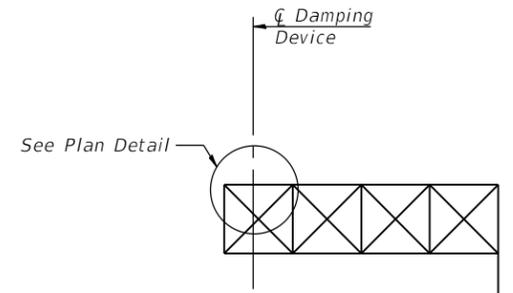


ELEVATION
Aluminum Cantilever Sign Structure

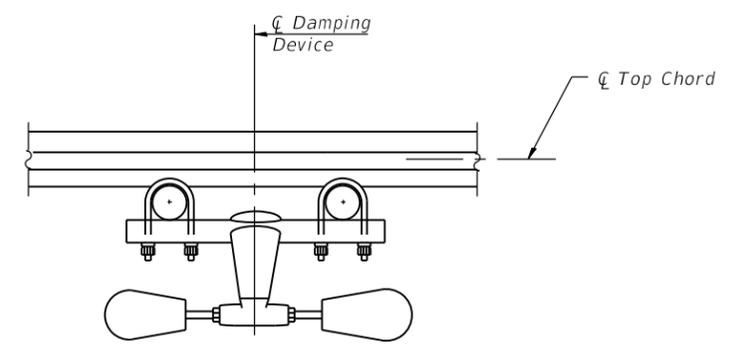

SECTION A-A

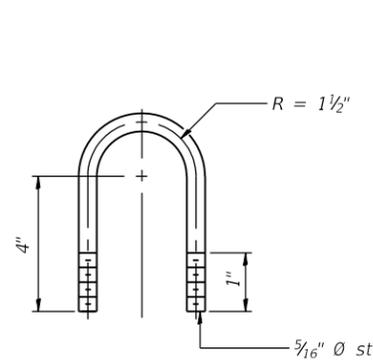

DAMPING DEVICE MOUNTING TUBE U-BOLT DETAIL
(Typical)

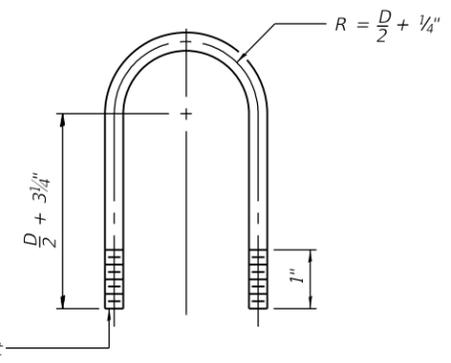

TOP CHORD TO CROSS TUBE U-BOLT DETAIL
(Typical)

GENERAL NOTES

- Damper: One damper per truss. (31 lbs. Stockbridge-Type Aluminum-29" minimum between ends of weights)
- Materials: Aluminum tubes shall be ASTM B221 alloy 6061 temper T6

OSC-A-D

2-17-2017



USER NAME = charles.pigozzi	DESIGNED - JJS, WM	REVISED -
PLOT SCALE = N.T.S	CHECKED - MAI, JMG	REVISED -
PLOT DATE = 1/24/2020	DRAWN - JJS, WM	REVISED -
	CHECKED - MAI, JMG	REVISED -

STATE OF ILLINOIS
DEPARTMENT OF TRANSPORTATION


CANTILEVER SIGN STRUCTURE
DAMPING DEVICE

SHEET NO. SS53 OF SS129 SHEETS

F.A.I. RTE. 90/94/290	SECTION 2015-019R	COUNTY COOK	TOTAL SHEETS 2155	SHEET NO. 1003
CONTRACT NO. 62A76				


ILLINOIS FED. AID PROJECT

FILE NAME: D:\V\AECOM-NA-AWS1\...; OSC-A-3; 11:19:21 AM

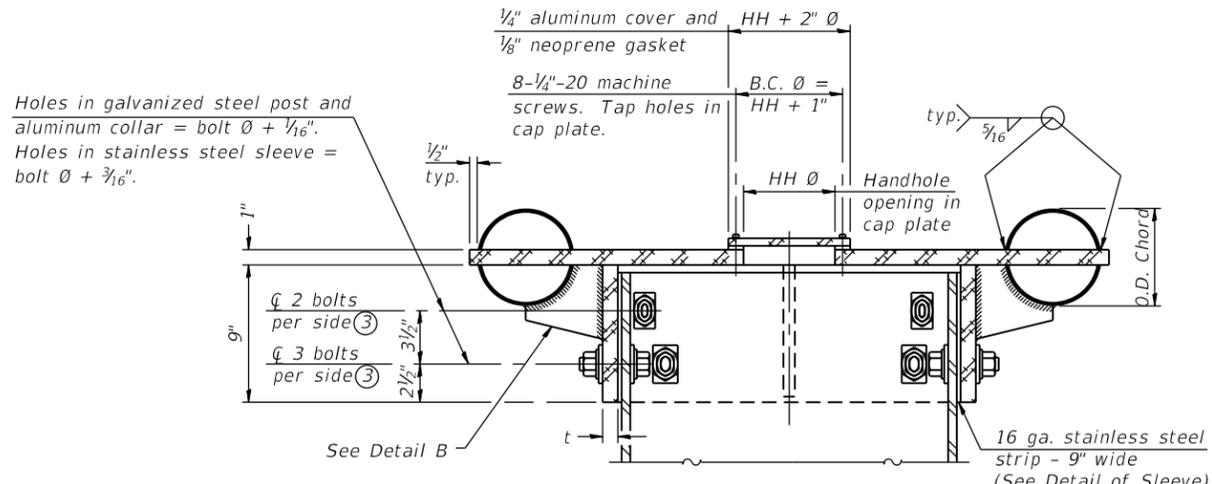


④ Collar I.D. shall be manufactured to correspond to O.D. of actual galvanized post and stainless steel sleeve plus 1/8" (±1/16"). Maximum gap between post and collar at any location equals 1/8" before tightening bolts.


SECTION B-B
Bolts, washers (including contoured washers), and locknuts shall be stainless steel.

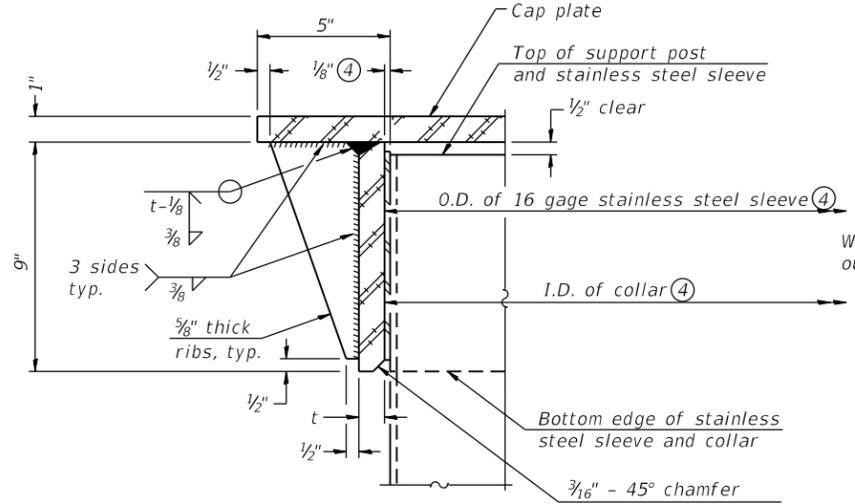


DETAIL A
(Two locations)
3/16" - 45° chamfer on inside of collar to facilitate field assembly

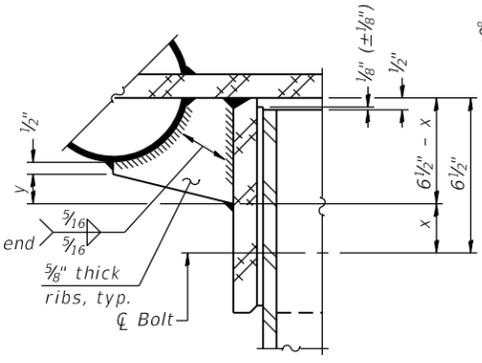


DETAIL B
Two locations
(For details not shown, see Detail C)

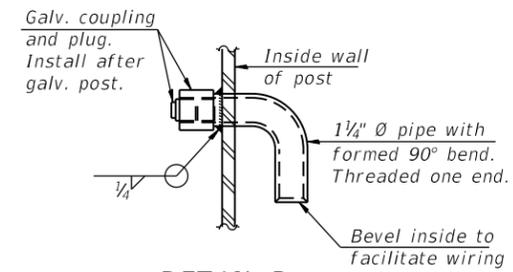


DETAIL D

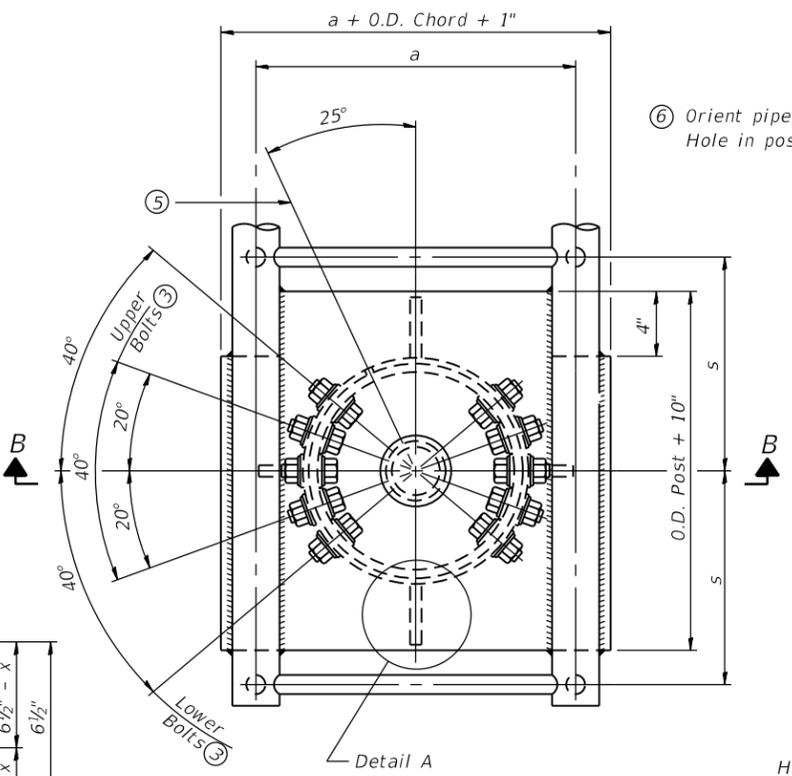


PLAN VIEW - TOP OF COLUMN
⑤ Optional full penetration weld in collar. (Two locations maximum....(180° apart)....X-ray or UT 100%)

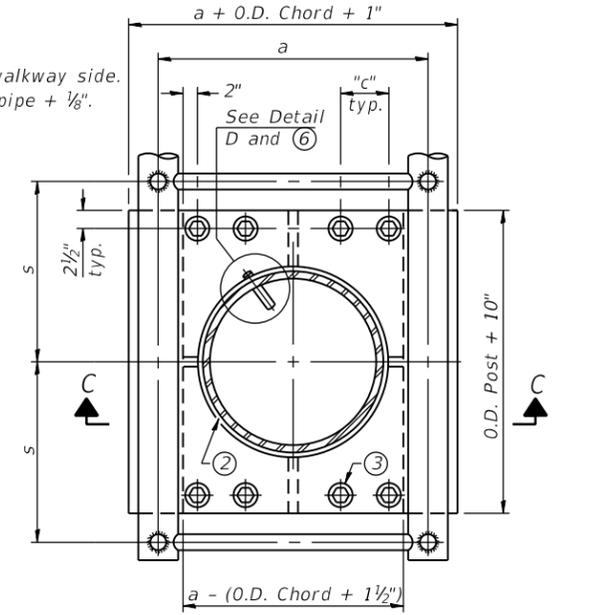

SECTION THRU POST ABOVE LOWER CHORDS

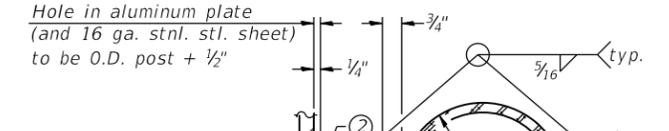

DETAIL C

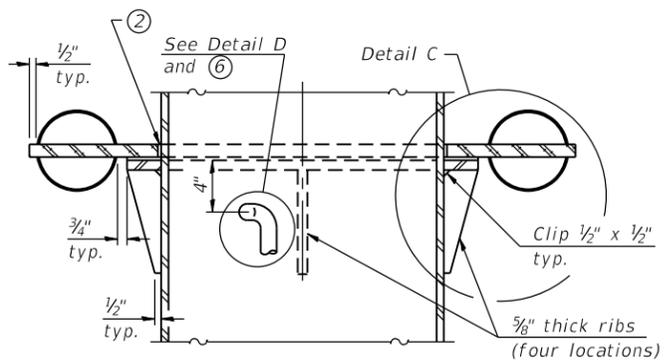

SECTION C-C

CONTOURED WASHERS

Bolt Size	Contoured Washers	
	Hole Dia.	B
7/8"	1"	2 1/2"
1"	1 1/8"	3"
1 1/4"	1 3/8"	3 1/4"

DETAIL OF STAINLESS STEEL SLEEVE

Weld to post after galvanizing. (Prepare post surface to ensure tight, uniform fit and allow welding.) Welds to be 1 1/2" long at 6" cts. along top edge and at 1/4" opening.

Truss Type	Post Size	Upper & Lower Connection Bolt Diameter ③	Lower Juncture Bolt Spacing Dimension "c" ③	Opening in Cap Plate "HH"	Collar Thickness (t)	Side Ribs	
						x	y
I-C-A	16" Ø (83#/')	7/8"	3 1/4"	8"	5/8"	1 3/4"	2 1/4"
II-C-A	24" Ø (125#/')	1"	3 1/2"	12"	7/8"	2"	1 1/4"
III-C-A (35' max.)	24" Ø (125#/')	1 1/4"	3 1/2"	12"	7/8"	2"	1"
III-C-A (>35' to 40')	24" Ø (171#/')	1 1/4"	3 1/2"	12"	7/8"	2"	1"

- ① Grind top if required to fully seat aluminum plate and stainless steel sheet.
- ② After tightening lower connection bolts, fill gap with non-hardening, silicone caulk suitable for exterior exposure and acceptable to the Engineer. Cost is included in Overhead Sign Structure Cantilever.
- ③ Upper and lower connection bolts in collar and bolts at lower chord connection shall be high strength with matching locknuts. Connection bolts shall have 2 stainless steel flat washers each.

OSC-A-3

2-17-2017



USER NAME = charles.pigozzi	DESIGNED - JJS, WM	REVISED -
PLOT SCALE = N.T.S	CHECKED - MAI, JMG	REVISED -
PLOT DATE = 1/24/2020	DRAWN - JJS, WM	REVISED -
	CHECKED - MAI, JMG	REVISED -




STATE OF ILLINOIS
DEPARTMENT OF TRANSPORTATION

CANTILEVER SIGN STRUCTURES - JUNCTURE DETAILS
ALUMINUM TRUSS & STEEL POST

SHEET NO. SS54 OF SS129 SHEETS


F.A.I. RTE.	SECTION	COUNTY	TOTAL SHEETS	SHEET NO.
90/94/290	2015-019R	COOK	2155	1004
CONTRACT NO. 62A76				
ILLINOIS FED. AID PROJECT				

FILE NAME: D:\V\AECOM-NA-AWS1\... Structures\2015-019R\Structures\62A76-Sign_Structure\62A76-Cant-SS205A-51gnStruct.dgn

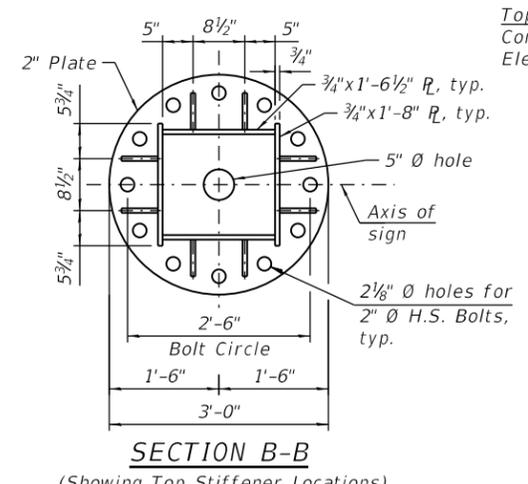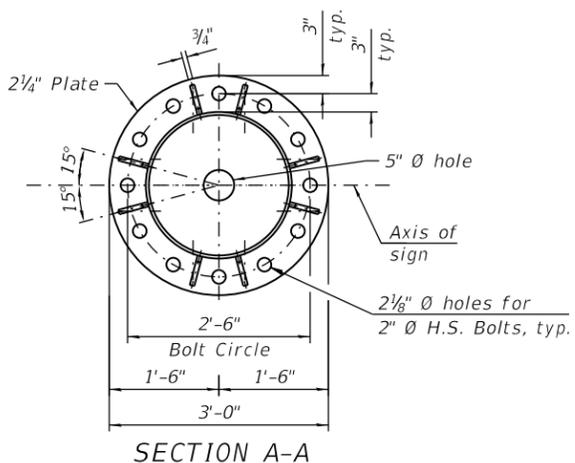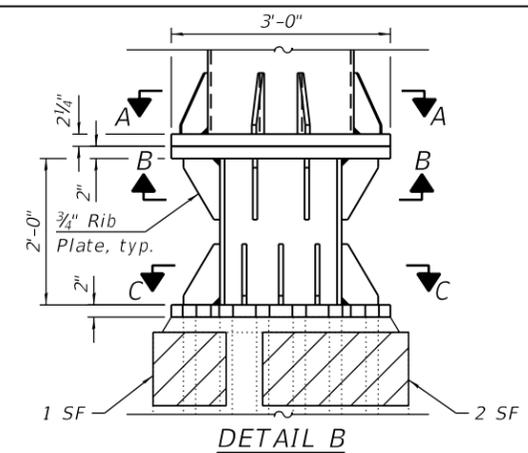

BILL OF MATERIAL


ITEM	UNIT	QUANTITY
Furnishing And Erecting Structural Steel	POUND	1570
Structural Repair of Concrete (Depth < 5")	SQ FT	3

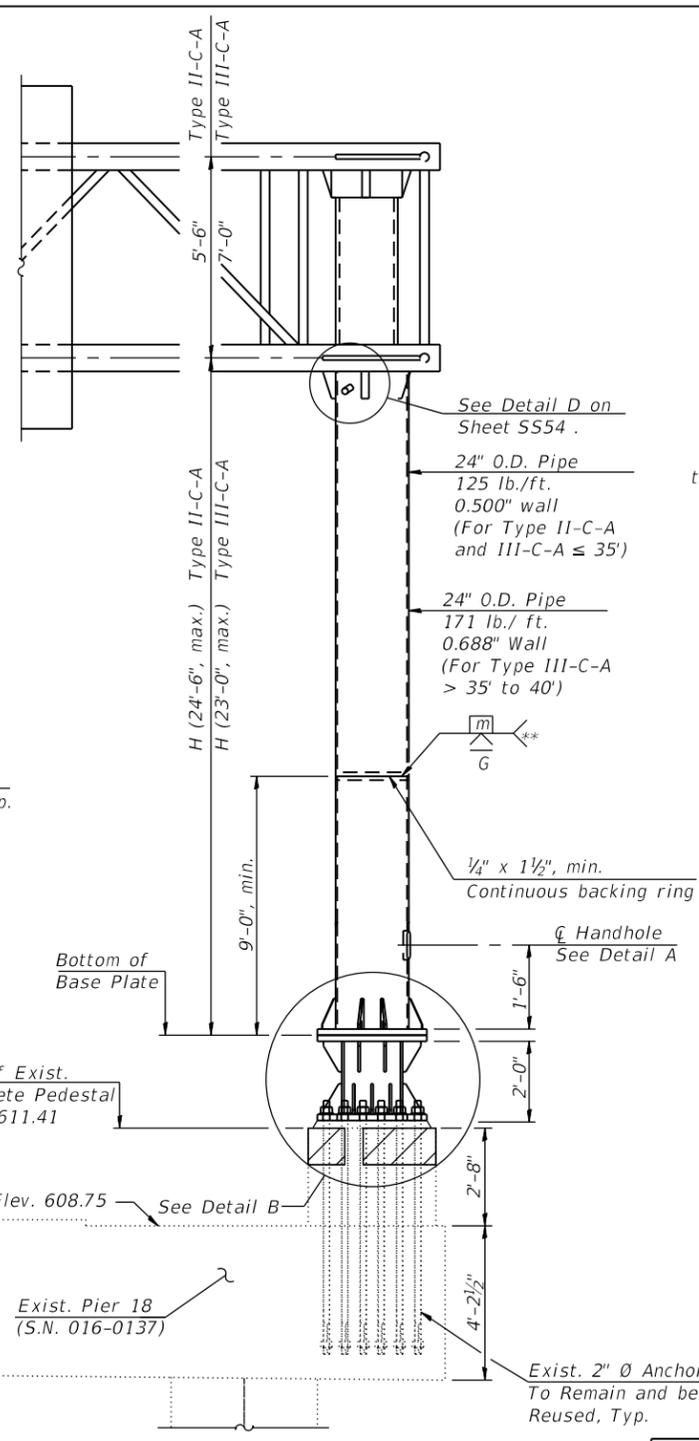

FRONT ELEVATION
(Exist. Bridge Superstructure and Exist. Pier reinforcement not shown for clarity - See Exist. Record Drawings for details)

*** Measured along Exist. @ NB 1-90/94. It should be noted that the stations included in the Table are measured along the Exist. @ NB 1-90/94 as presented in this Contract and may differ from stations shown in Existing Record Drawings

LEGEND
 Structural Repair of Concrete (Depth < 5")

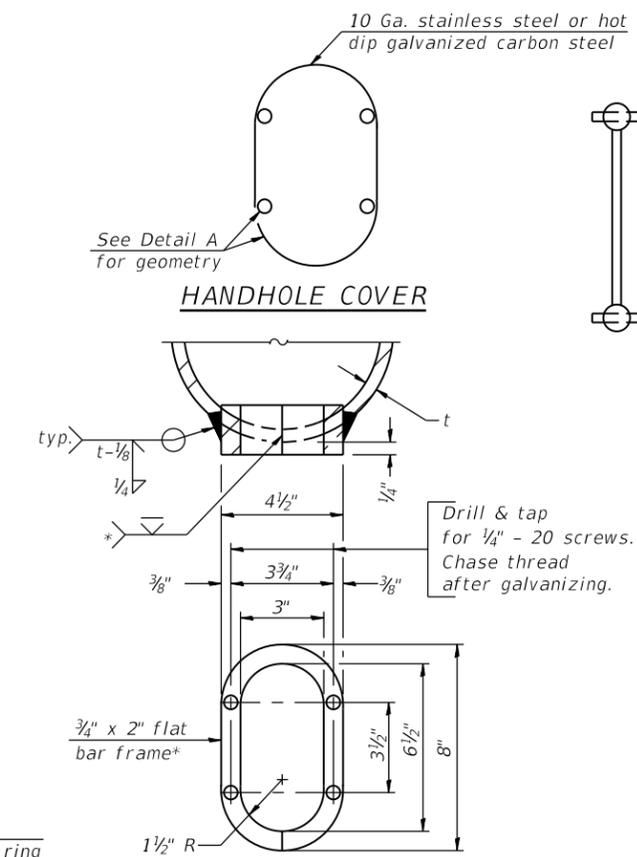


Provide 8" x 4 1/2" cover. Outside corners = 2 1/4" radius. Provide 4-5/16" holes in cover for 1/4" - 20 round head hot dip galvanized or stainless steel machine screws. (See cover details.)

DETAIL A

- * Bent bars may be butt welded top and bottom or bottom only. In lieu of fabricated handhole frame as shown, may cut from 2" plate (rolling direction vertical). All cut faces to be ground to ANSI Roughness of 500µ in or less.
- ** Butt welded joint in post is only allowed for post heights (H) over 20 ft. in length. If used, weld procedure must be preapproved by Engineer and joint shall receive 100% RT or UT (tension criteria) at Contractor's expense.

Structure Number	***Station	H
1C0161094L052.4	178+42.70	23'-3 3/4"

Note: "H" based on 15'-0" or actual sign height, whichever is greater.

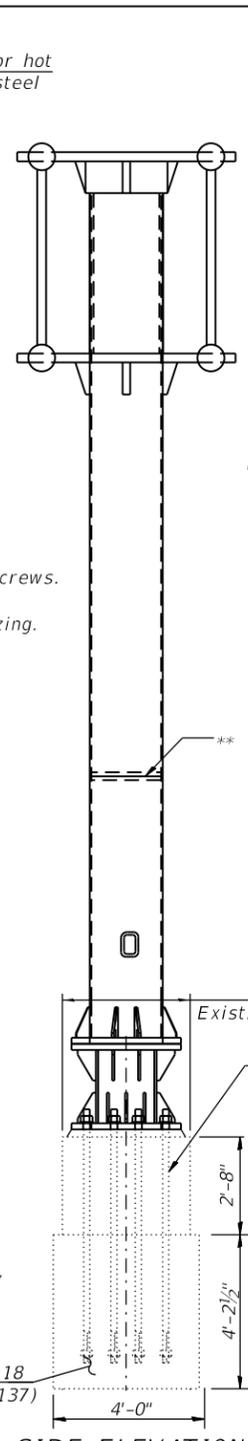


SIDE ELEVATION


(Exist. Bridge Superstructure and Exist. Pier reinforcement not shown for clarity - See Exist. Record Drawings for details)

NOTE:


- Cost of steel extension, high-strength bolts, grout pad, and all required nuts and washers shall be included with Furnishing and Erecting Structural Steel.

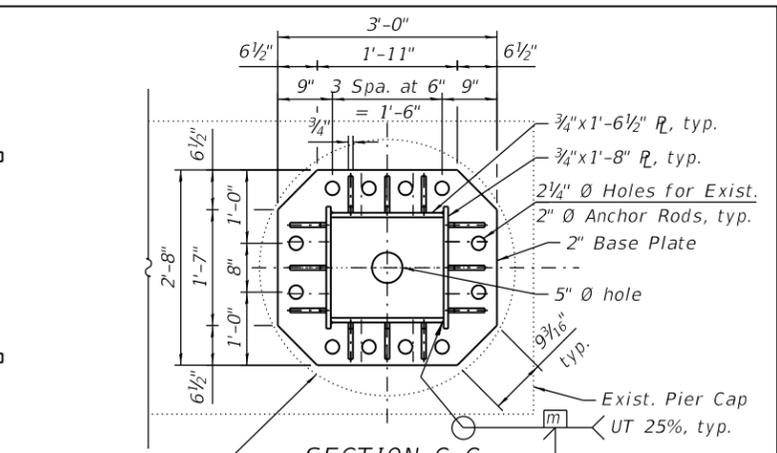


SECTION C-C
(Showing Overall R.L. dimensions and Anchor Rod Locations)
(Exist. Pier/Pedestal reinforcement not shown for clarity - see Exist. Record Drawings for details)

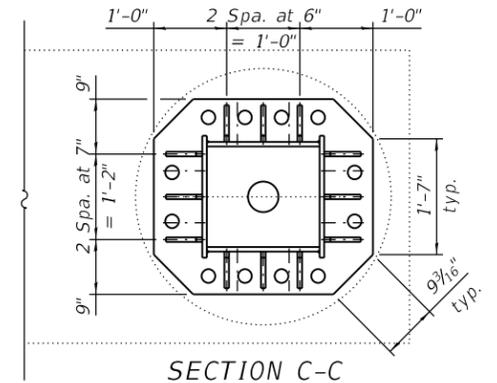

SECTION C-C
(Showing Bottom Stiffener Locations)

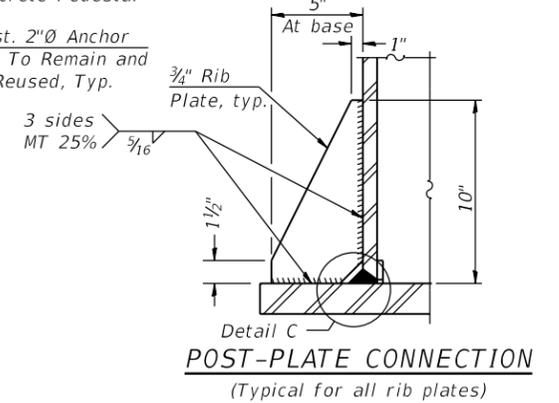

POST-PLATE CONNECTION
(Typical for all rib plates)

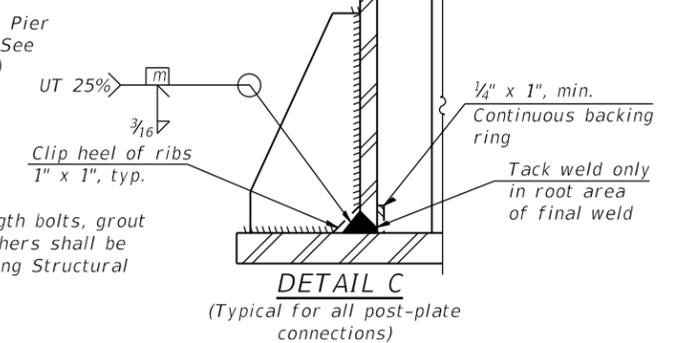

DETAIL C
(Typical for all post-plate connections)



USER NAME = hassan.issa	DESIGNED - JJS, WM	REVISED -
PLOT SCALE = N.T.S	CHECKED - MAI, JMG	REVISED -
PLOT DATE = 1/29/2020	DRAWN - JJS, WM	REVISED -
	CHECKED - MAI, JMG	REVISED -


**STATE OF ILLINOIS
DEPARTMENT OF TRANSPORTATION**

**CANTILEVER SIGN STRUCTURES - TYPE II-C-A
TRUSS SUPPORT POST - ALUMINUM TRUSS & STEEL POST**


SHEET NO. SS55 OF SS129 SHEETS

F.A.I. RTE. 90/94/290	SECTION 2015-019R	COUNTY COOK	TOTAL SHEETS 2155	SHEET NO. 1005
CONTRACT NO. 62A76			ILLINOIS FED. AID PROJECT	


FILE NAME: D:\V\AE\COM-NA-AWS1\ae\com\line\local\AE\COM_DS02_NAVDocuments\01_Americas\Transportation\620269938_Circle\Phase_I\0000_CAD\008_Structural\Sign_Structures\62A76_Sign_Structure\62A76-Cant-SS205B-5\SignStruct.dgn
 4:02:10 PM

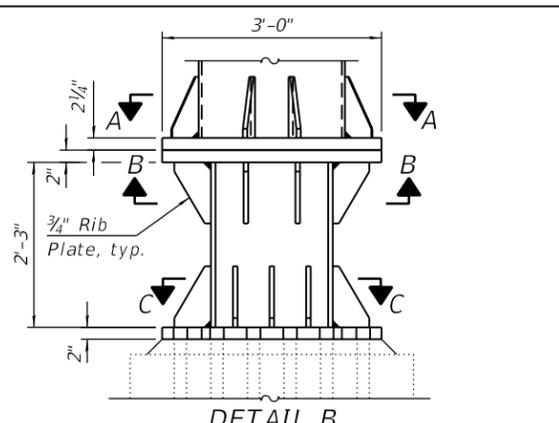

DETAIL B

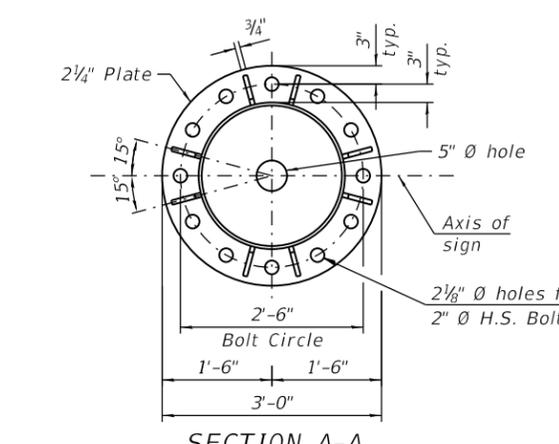


SECTION A-A

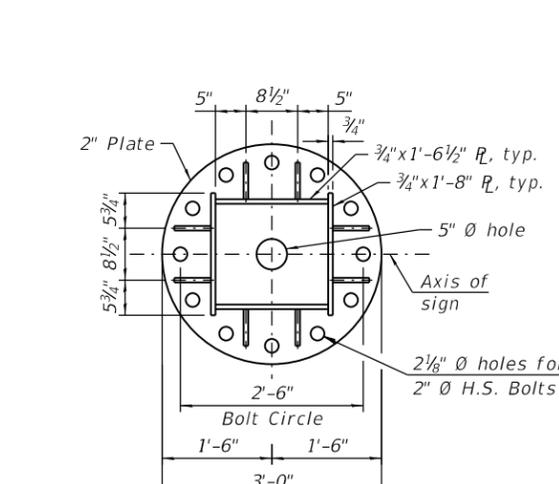


SECTION B-B

(Showing Top Stiffener Locations)

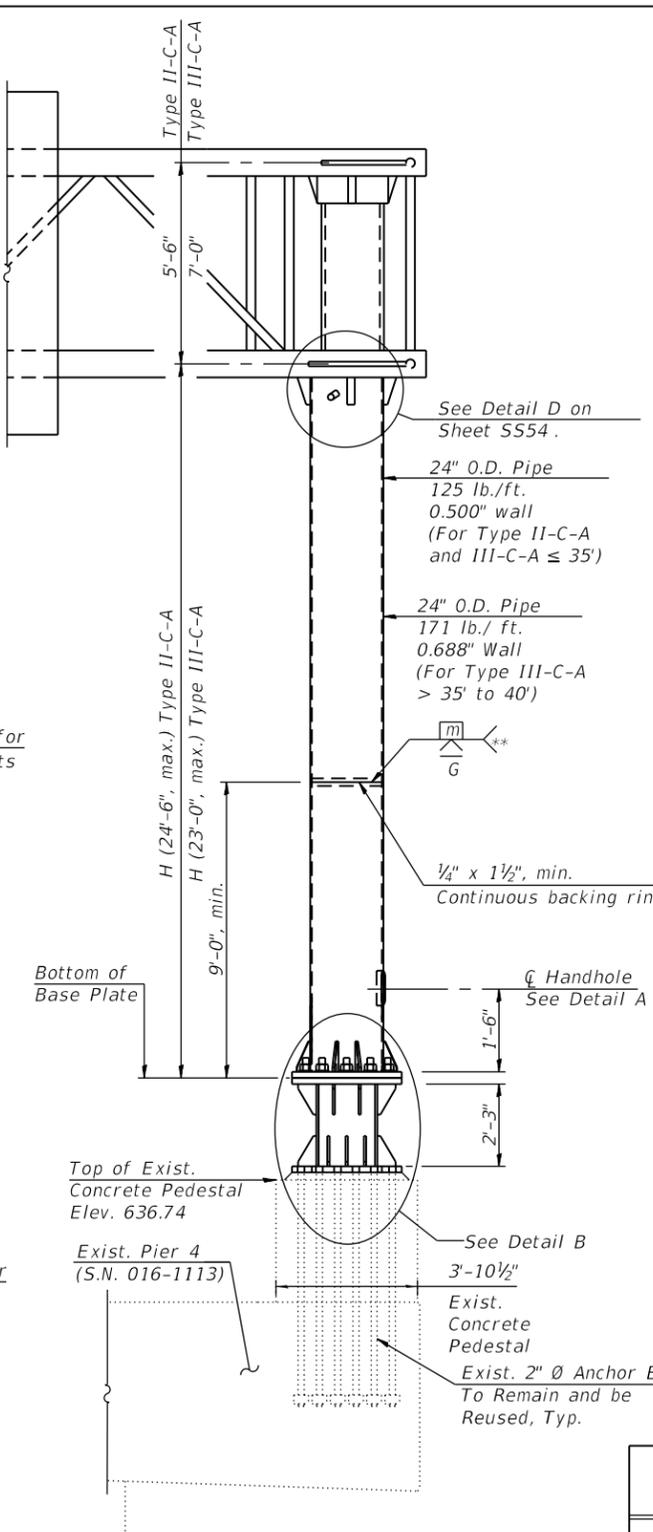

FRONT ELEVATION

(Exist. Bridge Superstructure and Exist. Pier reinforcement not shown for clarity - see Existing Record Drawings for Details)

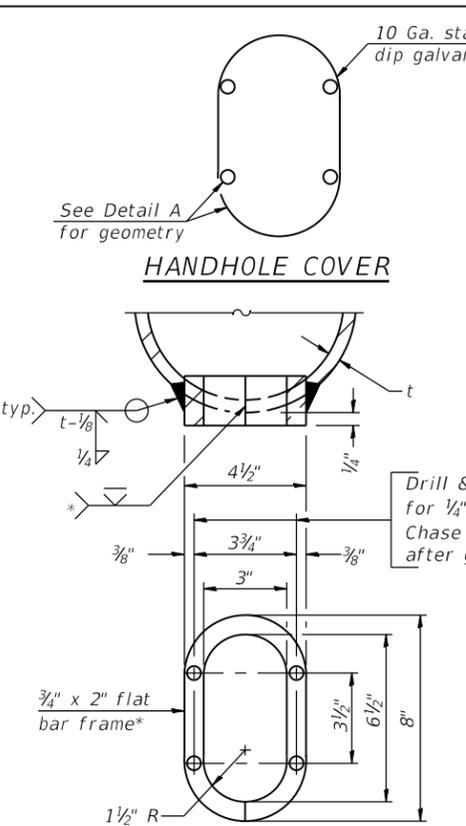

HANDHOLE COVER


Provide 8" x 4 1/2" cover. Outside corners = 2 1/4" radius. Provide 4-5/16" Ø holes in cover for 1/4" - 20 round head hot dip galvanized or stainless steel machine screws. (See cover details.)

DETAIL A

- * Bent bars may be butt welded top and bottom or bottom only. In lieu of fabricated handhole frame as shown, may cut from 2" plate (rolling direction vertical). All cut faces to be ground to ANSI Roughness of 500µ in or less.
- ** Butt welded joint in post is only allowed for post heights (H) over 20 ft. in length. If used, weld procedure must be preapproved by Engineer and joint shall receive 100% RT or UT (tension criteria) at Contractor's expense.
- *** Measured along Exist. NB 1-90/94. It should be noted that the station included in the Table is measured along the Exist. NB 1-90/94 as presented in this Contract and may differ from stations shown in Existing Record Drawings.


Structure Number	***Station	H
1C0161094L053.3	130+60.47	23'-3 3/4"

Note: "H" based on 15'-0" or actual sign height, whichever is greater.

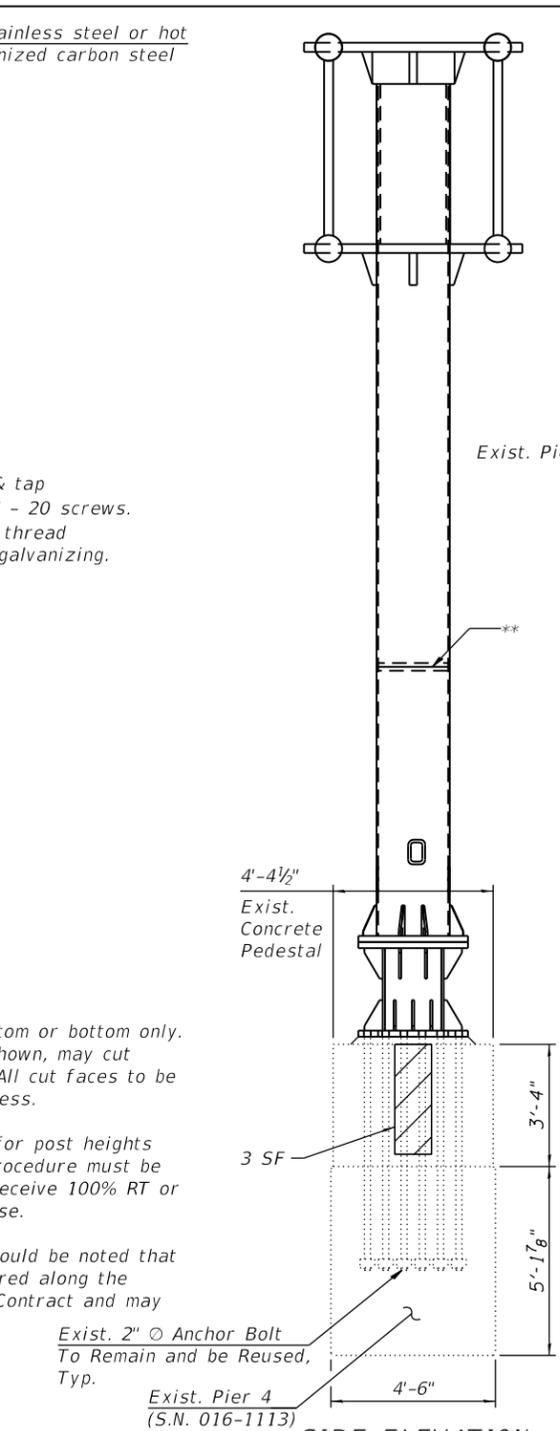


SIDE ELEVATION

(Exist. Bridge Superstructure and Exist. Pier reinforcement not shown for clarity - See Exist. Record Drawings for details)

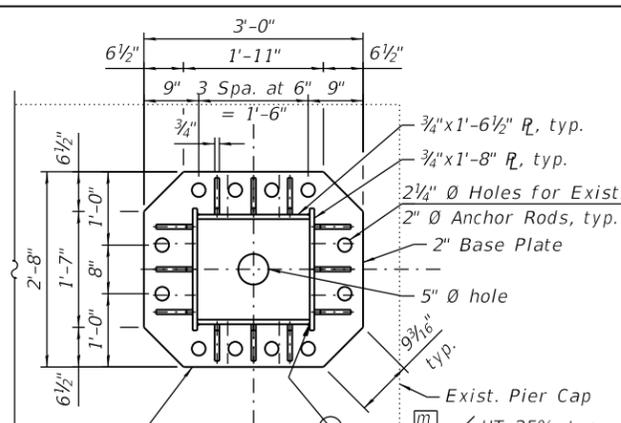


SECTION C-C

(Showing Overall R dimensions and Anchor Rod Locations)
(Exist. Pier/Pedestal reinforcement not shown for clarity - see Exist. Record Drawings for details)

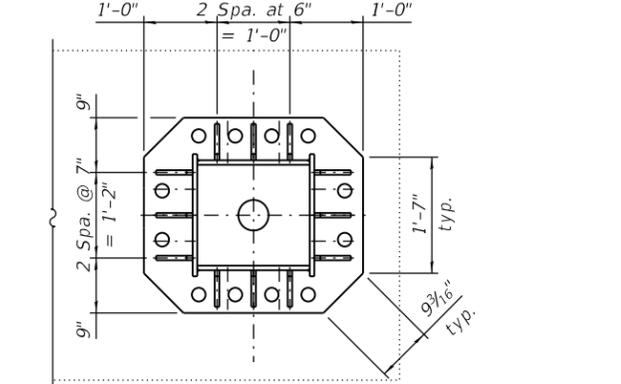


SECTION C-C

(Showing Bottom Stiffener Locations)

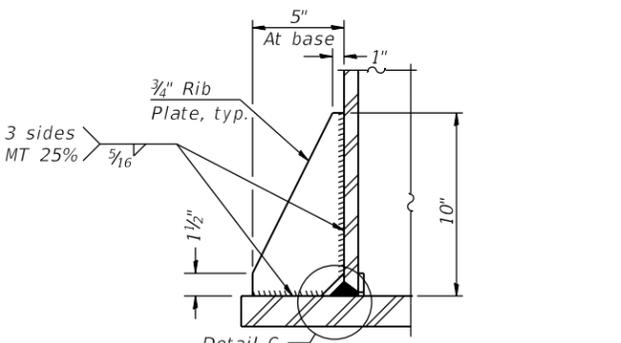

POST-PLATE CONNECTION

(Typical for all rib plates)

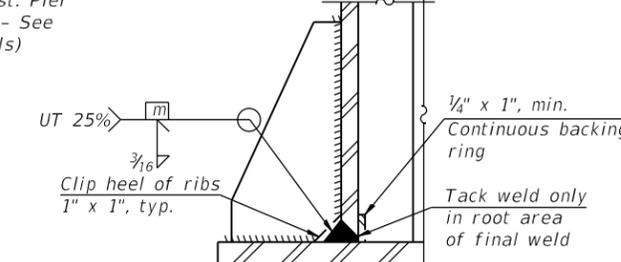

DETAIL C

(Typical for all post-plate connections)

BILL OF MATERIAL

ITEM	UNIT	QUANTITY
Furnishing And Erecting Structural Steel	POUND	1520
Structural Repair of Concrete (Depth < 5")	SQ FT	3

LEGEND



NOTE:

1. Cost of steel extension high strength bolts, grout pad and all required nuts and washers shall be included with Furnishing and Erecting Structural Steel.




USER NAME = hassan.issa	DESIGNED - JJS, WM	REVISED -
PLOT SCALE = N.T.S	CHECKED - MAI, JMG	REVISED -
PLOT DATE = 1/29/2020	DRAWN - JJS, WM	REVISED -
	CHECKED - MAI, JMG	REVISED -

**STATE OF ILLINOIS
DEPARTMENT OF TRANSPORTATION**


**CANTILEVER SIGN STRUCTURES - TYPE II-C-A
TRUSS SUPPORT POST - ALUMINUM TRUSS & STEEL POST**

F.A.I. RTE. 90/94/290	SECTION 2015-019R	COUNTY COOK	TOTAL SHEETS 2155	SHEET NO. 1006
			CONTRACT NO. 62A76	
ILLINOIS			FED. AID PROJECT	

SHEET NO. SS56 OF SS129 SHEETS

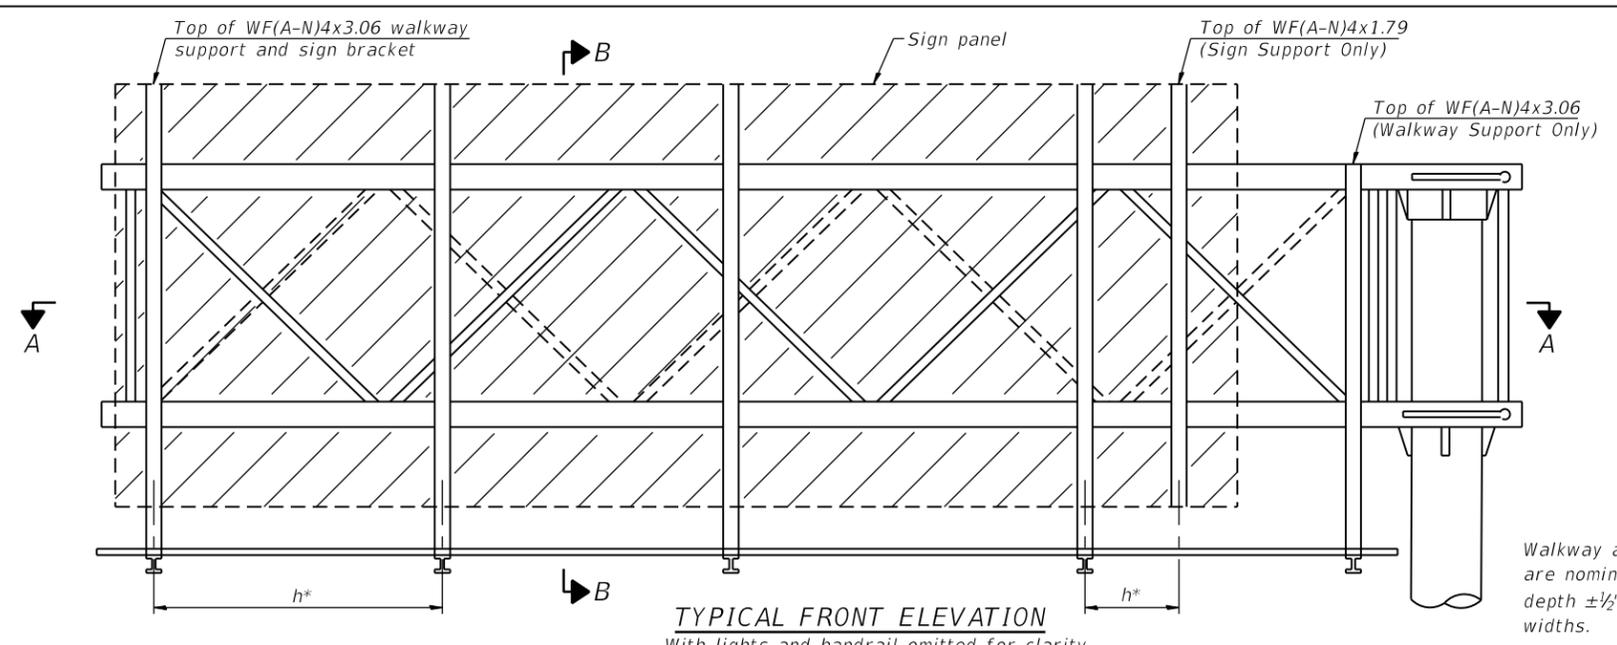


TYPICAL FRONT ELEVATION
With lights and handrail omitted for clarity.

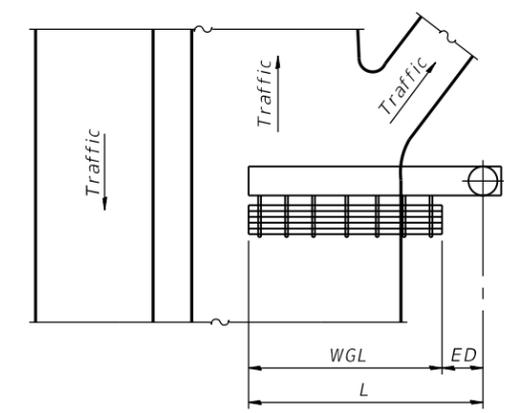

PLAN WALKWAY AND HANDRAIL SKETCH
(Road plan beneath truss varies)

Walkway and truss grating dimensions are nominal and may vary (width ±1/2", depth ±1/2") based on available standard widths.

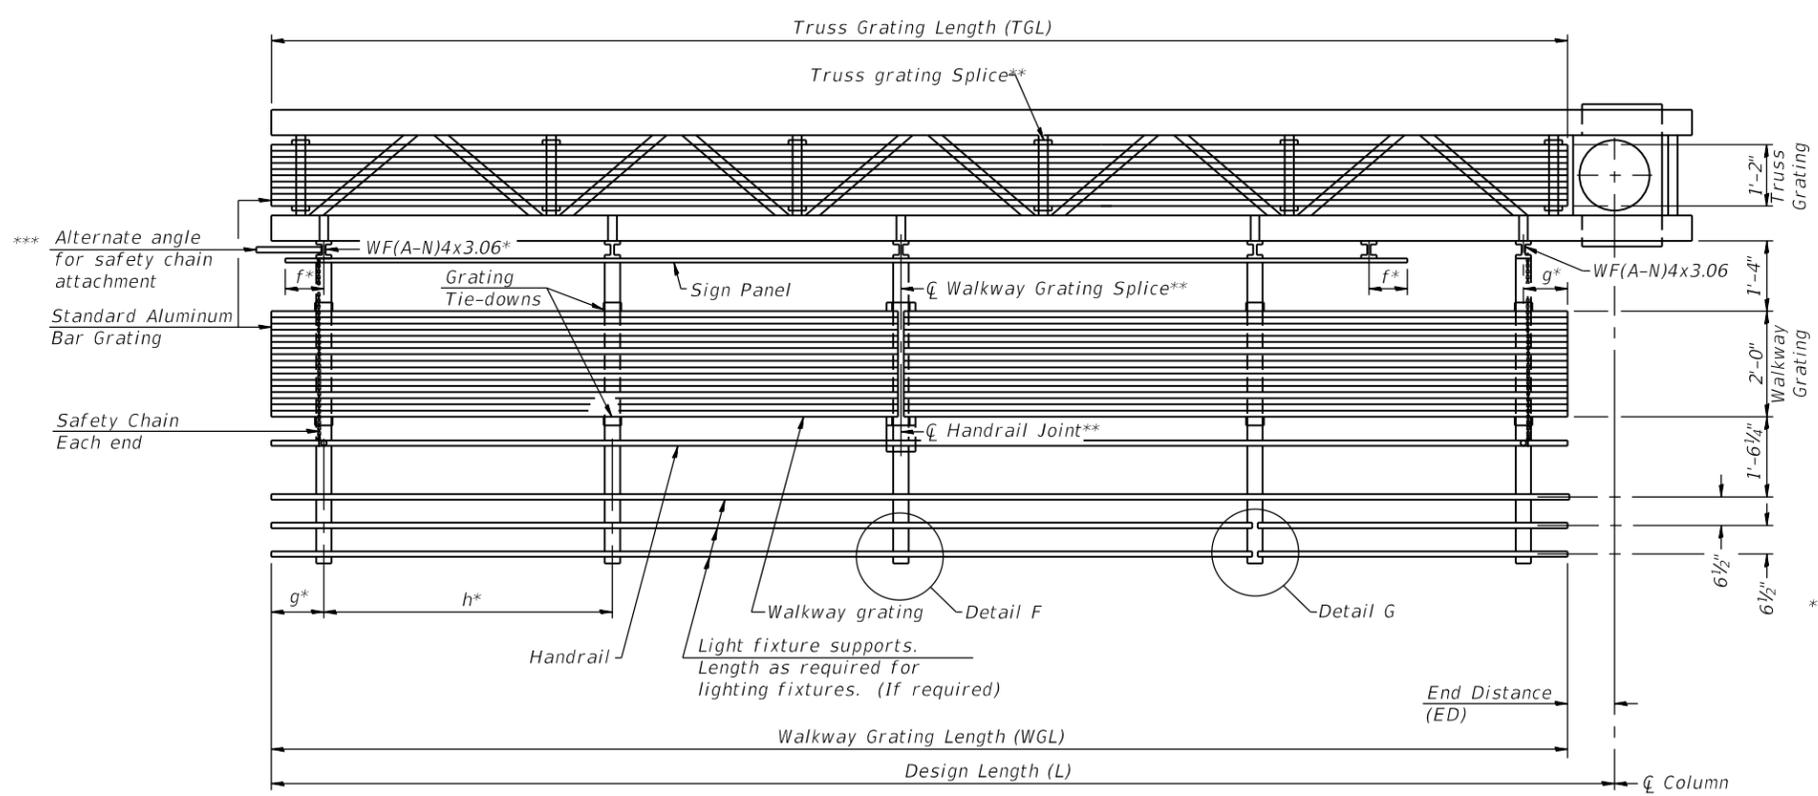

SECTION A-A

Truss grating to facilitate inspection shall run full length of cantilevers. Cost of truss grating is included in Overhead Sign Structure Cantilever.

Handrail and walkway grating shall span a minimum of three brackets between splices.
** Use and location of handrail joints or grating splices are optional, based on lengths needed and material availability.

$$TGL = L - \left(\frac{\text{Post O.D.}}{2} + 6'' \right)$$

Structure Number	^t Station	WGL	ED	TGL
1C0161094L053.3	130+60.47	-	-	23'-6"
1C0161094L052.4	178+42.70	-	-	20'-0"

Notes:
 * Space walkway brackets WF(A-N)4x3.06 and sign brackets WF(A-N)4x1.79 for efficiency and within limits shown:
 f = 12" maximum, 4" minimum (End of sign to center of nearest bracket)
 g = 12" maximum, 4" minimum (End of walkway to center of nearest bracket)
 h = 6'-0" maximum (center to center sign and/or walkway support brackets, WF(A-N)4x1.79 or WF(A-N)4x3.06)
 *** If walkway bracket at safety chain location is behind sign, add angle to bracket. See alternate safety chain attachment on Base Sheet OSC-A-8.
 For details of sign placement, sign/walkway brackets, truss and walkway gratings, grating splices and Section B-B, see Sheet SS58.
 For details of handrail, handrail joint, safety chain and Details F and G, see Base Sheet OSC-A-8.
^t Measured along Exist. NB I-90/94. It should be noted that the stations included in the Table are measured along the Exist. NB I-90/94 as presented in this Contract and may differ from stations shown in Existing Record Drawings.

BRACKET TABLE

WF(A-N)4x1.79 or WF(A-N)4x3.06 ASTM B308, Alloy 6061-T6		
Sign Width		Number Brackets Required
Greater Than	Less Than or Equal To	
	8'-0"	2
8'-0"	14'-0"	3
14'-0"	20'-0"	4
20'-0"	26'-0"	5
26'-0"	32'-0"	6

OSC-A-6

2-17-2017



USER NAME = charles.pigozzi	DESIGNED - JJS, WM	REVISED -
PLOT SCALE = N.T.S	CHECKED - MAI, JMG	REVISED -
PLOT DATE = 1/24/2020	DRAWN - JJS, WM	REVISED -
	CHECKED - MAI, JMG	REVISED -

**STATE OF ILLINOIS
DEPARTMENT OF TRANSPORTATION**






**CANTILEVER SIGN STRUCTURES - ALUMINUM WALKWAY
DETAILS - ALUMINUM TRUSS & STEEL POST**

SHEET NO. SS57 OF SS129 SHEETS






F.A.I. RTE. 90/94/290	SECTION 2015-019R	COUNTY COOK	TOTAL SHEETS 2155	SHEET NO. 1007
CONTRACT NO. 62A76				
ILLINOIS FED. AID PROJECT				

FILE NAME: D:\V\AECOM\NA-AW51\recomonline\local\AECOM_ID502_NAVDocuments\01_Americas\Transportation\60269938_Circle\Phase_I\000_CAD\008_Structural\Sign_Structures\62A76_Sign_Structure\62A76-Cant-55206-SignStruct.dgn

FILE NAME: P:\V\AECOM-NA-AWS1\...recomonline.local\AECOM_DS02_NAVDocuments\01_Americas\Transportation\60269938_Circle\Phase_I\000_CAD\008_Structural\Sign_Structures\62A76-Cant-55207-SignStruct.dgn

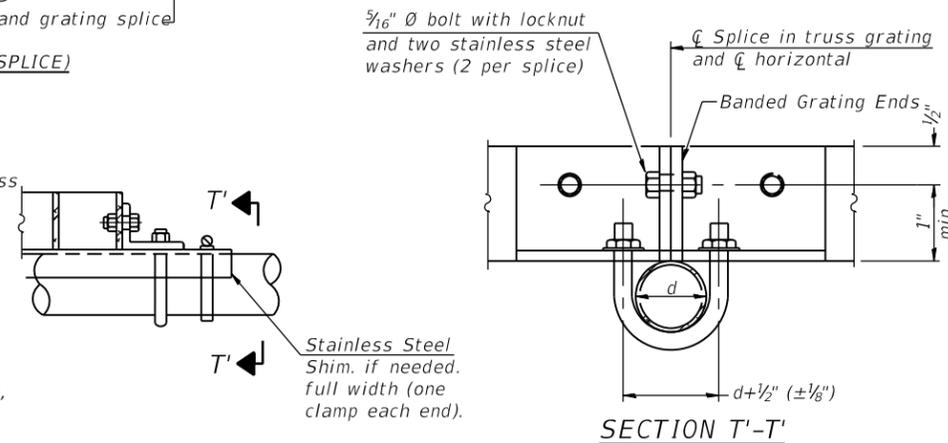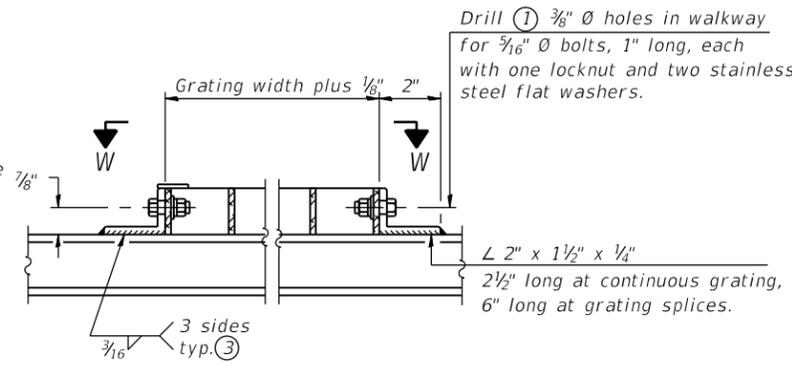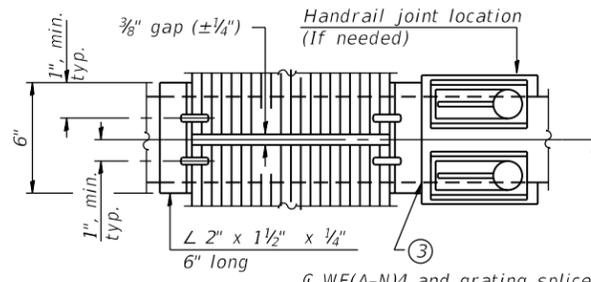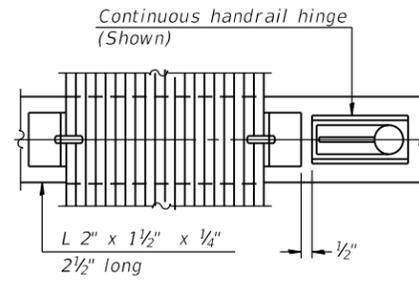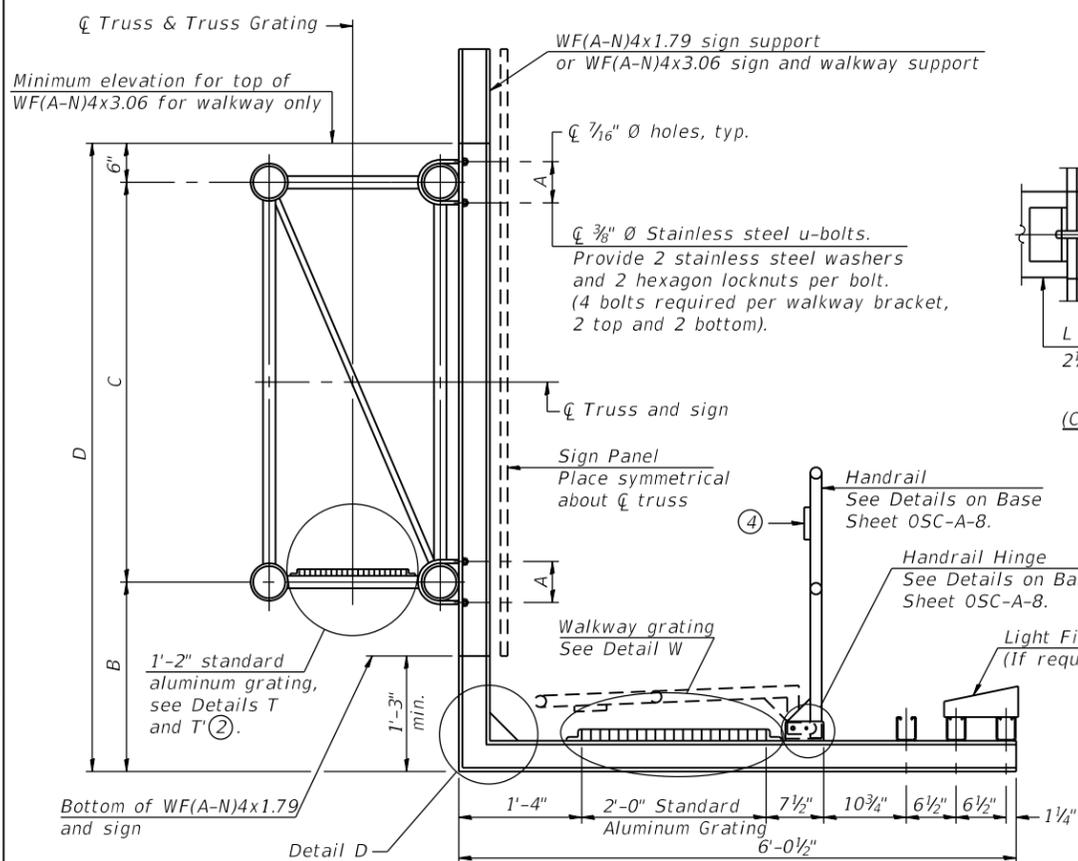

DETAIL T'
(Truss grating splice)
Details not shown same as Detail T. Alternate materials may be used subject to the Engineer's review and approval.

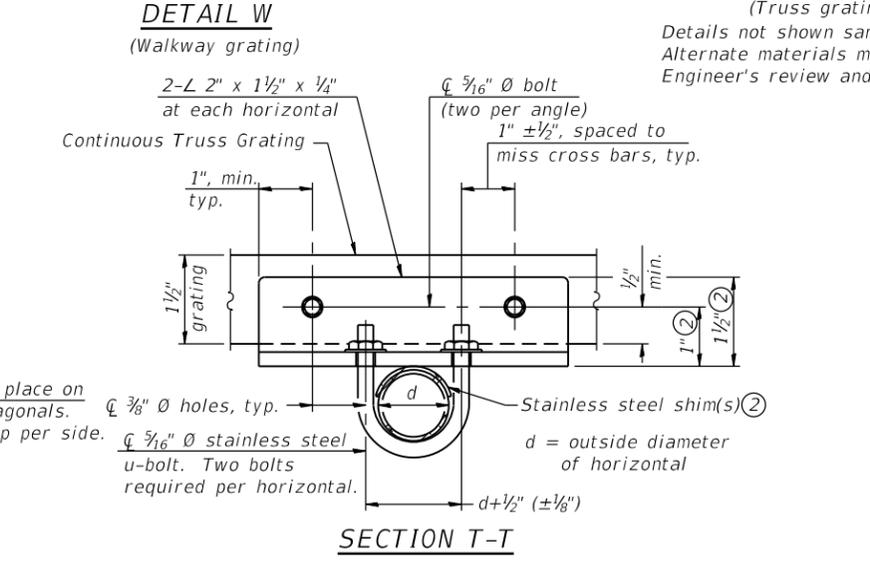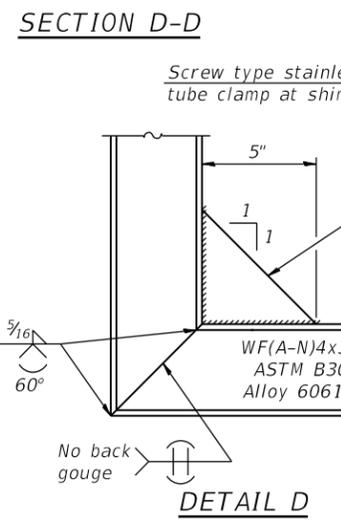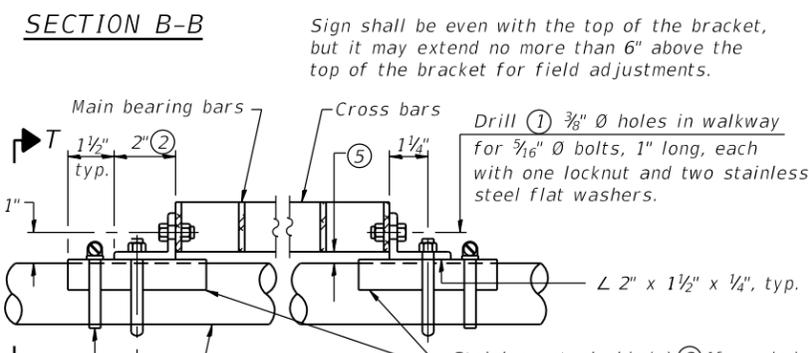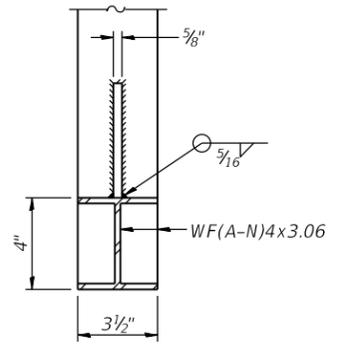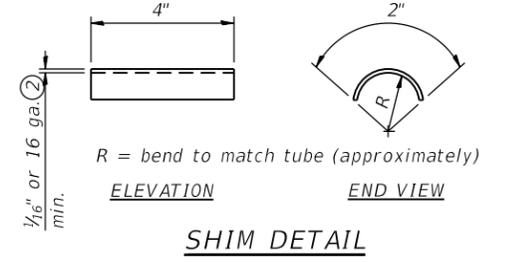

Structure Number	Station	A	ⓐ B	C	ⓐ D
1C0161094L053.3	131+47.33	7 1/2"	2'-9"	5'-6"	8'-9"
1C0161094L052.4	179+17.00	7 1/2"	4'-6"	5'-6"	10'-6"

SPECIFICATIONS FOR STANDARD ALUMINUM GRATING
Main Bearing Bars (MBB) shall be 3/16" x 1 1/2" on 1 3/16" centers and conform to ASTM B211 Alloy 6061-T6.
Cross bars (CB) shall be 3/16" x 1 1/2" on 4" centers and conform to ASTM B221 Alloy 6063-T5 or 6061-T6.

OR
Aluminum Grating with modified "t" sections for main bearing bars shall meet the following requirements:
Main bars shall conform to ASTM B221 Alloy 6061-T6 and have a minimum section modulus equal to 0.0705 in.³ per bar, a depth of 1 1/2", spaced on 1 3/16" centers.
Cross bars shall conform to ASTM B221 Alloy 6063-T5 or T-42 and spaced on 4" centers.

- Drilling holes in grating may be done in shop or field, based on Contractor's preference and subject to accurate alignment.
- Stainless steel shims shall be placed as shown in Detail T if needed to compensate for alignment variations between horizontal and diagonal pipes beyond adjustment provided by angles. Thicker shims may be used subject to shims performing properly.
- If Handrail Joint present, weld angle to WF(A-N)4 and 1/4" extension bars. (See Base Sheet OSC-A-8.)
- ϕ 1/8" x 1/2" x 2" welded to handrail posts to protect locations that contact grating.
- Tube to grating gap may vary from 0 to 1/2", max. to align walkway, allow for camber, etc.
- Based on actual sign height, Ds, given on Base Sheet OSC-A-1.

^t Measured along Exist. NB I-90/94. It should be noted that the stations included in the Table are measured along the Exist. NB I-90/94 as presented in this Contract and may differ from stations shown in Existing Record Drawings.

OSC-A-7

2-17-2017



USER NAME = charles.pigozzi	DESIGNED - JJS, WM	REVISED -
PLOT SCALE = N.T.S	CHECKED - MAI, JMG	REVISED -
PLOT DATE = 1/24/2020	DRAWN - JJS, WM	REVISED -
	CHECKED - MAI, JMG	REVISED -

STATE OF ILLINOIS
DEPARTMENT OF TRANSPORTATION

CANTILEVER SIGN STRUCTURES - WALKWAY DETAILS
ALUMINUM TRUSS & STEEL POST

SHEET NO. SS58 OF SS129 SHEETS

F.A.I. RTE. 90/94/290	SECTION 2015-019R	COUNTY COOK	TOTAL SHEETS 2155	SHEET NO. 1008
ILLINOIS FED. AID PROJECT			CONTRACT NO. 62A76	

FOR INFORMATION ONLY

STATE OF ILLINOIS
 DEPARTMENT OF TRANSPORTATION
 DIVISION OF HIGHWAYS
**PLANS FOR PROPOSED
 FEDERAL AID INTERSTATE HIGHWAY**

INDEX OF VOLUMES		NO. OF SHEETS
VOL. NO.	DESCRIPTION	
<u>CIVIL</u>		
1	ROADWAY PLANS & GENERAL SHEETS	127
2	MAINTENANCE OF TRAFFIC & ROADWAY CROSS SECTIONS	45
<u>STRUCTURAL</u>		
3	STRUCTURE NO.016-0137 (MAXWELL ST. TO 15TH ST.)	65
4	STRUCTURE NO.016-1110 (15TH ST. TO 16TH ST.)	33
5	STRUCTURE NO.016-1111 (16TH ST. TO 18TH ST.)	51
6	STRUCTURE NO.016-1112 (18TH ST. TO CERMAK RD.)	91
7	STRUCTURE NO.016-1113 (CERMAK RD. TO CHICAGO RIVER)	88
8	STRUCTURE NO.016-1114 & 1070 (CHICAGO RIVER BRIDGE)	16
9	STRUCTURE NO.016-1115 (I-55 INTERCHANGE - MAINLINE)	101
10	STRUCTURE NO.016-1047 & 1140 (I-55 INTERCHANGE - RAMPS)	53
11	STRUCTURE NO.016-1116 (CANAL ST. TO STEWART AVE.)	21
12	STRUCTURE NO.016-1117 & 1118 (STEWART AVE. TO 28TH PL.)	98
13	MISCELLANEOUS VIADUCT DETAILS AND SOUTH TERMINUS RETAINING WALLS	88
<u>ELECTRICAL</u>		
14	ROADWAY LIGHTING & SURVEILLANCE	49
TOTAL		926

SCALES
 PLAN 1 INCH = 40 FEET
 PROFILE HORIZ. 1 INCH = 40 FEET
 PROFILE VERT. 1 INCH = 4 FEET
 CROSS SECTIONS 1 INCH = 4 FEET HORIZONTAL
 1 INCH = 4 FEET VERTICAL
 * SEE PLANS

VOLUME NO. 3

F.A.I. ROUTE 90/94 (DAN RYAN EXPRESSWAY)
 SECTION 1985-077 R
 PROJECT


COOK COUNTY

~~C-91-430-85~~
 NORTHBOUND MAINLINE RECONSTRUCTION
 28TH PL. TO MAXWELL ST.

F.A. RTE.	SECTION	COUNTY	SHEET NO.
90/94	4	COOK	651
1985-077 R			
P-91-175-84			



DESIGN DESIGNATION

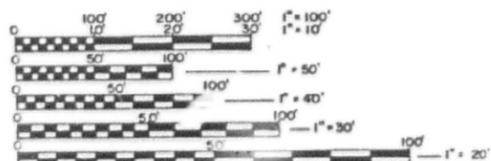

FULL SIZE PLANS HAVE BEEN PREPARED USING STANDARD ENGINEERING SCALES, REDUCED SIZED PLANS WILL NOT CONFORM TO STANDARD SCALES, IN MAKING MEASUREMENTS ON REDUCED PLANS, THE ABOVE SCALES MAY BE USED.

CONTRACT NO. **80065**



END STA. 183+87.00
 STA. EQ. 183+87.10 (BK.) = STA. 183+13.36 (AH.)
 STA. EQ. 165+08.650 (BK.) = STA. 164+94.890 (AH.)
 STA. EQ. 122+01.688 (BK.) = STA. 123+47.028 (AH.)
 STA. EQ. 103+85.412 (BK.) = STA. 103+85.570 (AH.)
 BEGIN STA. 63+20.000

NET LENGTH = 11,934 FT. = 2.260 MILES
 GROSS LENGTH = 11,934 FT. = 2.260 MILES

SCALE: 1 INCH = 160 FEET

STATE OF ILLINOIS
 DEPARTMENT OF TRANSPORTATION
 DIVISION OF HIGHWAYS

DESIGNED BY: _____
 EXAMINED BY: _____ DISTRICT ENGINEER
 PREPARED BY: _____ PROJECT ENGINEER
 APPROVED BY: _____ DIVISION ENGINEER

DEPARTMENT OF TRANSPORTATION
 FEDERAL HIGHWAY ADMINISTRATION

DATE: _____

COUNTY COOK SECTION 1985-077 R.R. ROUTE 90/94 (DAN RYAN EXPRESSWAY)

FILE NAME: D:\V\AECOM\NA-AW51...recomonline\local\AECOM_DS02_NAVDocuments\01_Americas\Transportation\60269938_Circle\Phase_II\000_CAD\008_Structural\Sign_Structure\62A76-Sign_Structure\62A76-Cant-55208-SignStruct.dgn



USER NAME = charles.pigozzi	DESIGNED - JJS, WM	REVISED -
PLOT SCALE = N.T.S	CHECKED - MAI, JMG	REVISED -
PLOT DATE = 1/24/2020	DRAWN - JJS, WM	REVISED -
	CHECKED - MAI, JMG	REVISED -

STATE OF ILLINOIS
 DEPARTMENT OF TRANSPORTATION

EXISTING RECORD DRAWINGS
 STRUCTURE NO. 016-0137

SHEET NO. SS59 OF SS129 SHEETS

F.A.I. RTE.	SECTION	COUNTY	TOTAL SHEETS	SHEET NO.
90/94/290	2015-019R	COOK	2155	1009
CONTRACT NO. 62A76				

ILLINOIS FED. AID PROJECT

FOR INFORMATION ONLY

FEDERAL AID DISTRICT NO.	SECTION	COUNTY	TOTAL SHEETS	SHEET NO.
90/94	*	COOK	65	2
STA. TO STA.				
FED. AID PROJECT				

PLAN DIMENSIONS AND DETAILS RELATIVE TO EXISTING STRUCTURE WERE OBTAINED FROM EXISTING PLANS AND ARE SUBJECT TO SEVERAL CONSTRUCTION VARIATIONS. IT SHALL BE THE CONTRACTOR'S RESPONSIBILITY TO VERIFY SUCH DIMENSIONS AND DETAILS IN THE FIELD AND MAKE NECESSARY APPROVED ADJUSTMENTS PRIOR TO CONSTRUCTION OR ORDERING OF MATERIALS. SUCH VARIATIONS SHALL NOT BE CAUSE FOR ADDITIONAL COMPENSATION FOR A CHANGE IN THE SCOPE OF WORK, HOWEVER, THE CONTRACTOR WILL BE PAID FOR THE QUANTITY ACTUALLY FURNISHED AT THE UNIT PRICE BID FOR THE WORK.

CALCULATED WEIGHT OF STRUCTURAL STEEL = 9-183 = 827,960 LBS. (TO BE ERECTED)

THE MAIN LOAD CARRYING MEMBER COMPONENTS SUBJECT TO TENSILE STRESSES SHALL CONFORM TO THE SUPPLEMENTAL REQUIREMENTS FOR HOT-ROLLED STEEL SECTION 2. THESE COMPONENTS INCLUDE TENSION PLATES AND WEBS OF PLATE GIRDERS, WIDE FLANGE BEAMS AND ALL SPlice PLATES MATERIAL OF THE WELDED PLATE GIRDERS AND ARE DESIGNATED ON THE PLANS BY "H.T.R.".

REINFORCEMENT BARS SHALL CONFORM TO THE REQUIREMENTS OF ASTM A-36, A-42 OR A-53 GRADE 60.

REINFORCEMENT BARS NOTED (R) SHALL BE EPOXY COATED.

FIELD WELDING OF CONSTRUCTION ACCESSORIES WILL NOT BE PERMITTED TO THE BOTTOM FLANGE OF BEAMS OR GIRDERS NOR TO THE TOP FLANGE FOR A DISTANCE EQUAL TO ONE-FIFTH THE SPAN LENGTH EACH WAY FROM THE PIER SUPPORTS. FIELD WELDING IN OTHER AREAS WILL BE PERMITTED ONLY WHEN APPROVED BY THE ENGINEER.

ANCHOR BOLTS SHALL BE SET BEFORE INSTALLING DIAPHRAGMS OR CROSS FRAMES OVER SUPPORTS.

FASTENERS SHALL CONFORM TO THE REQUIREMENTS OF ASTM A164 TYPE I (ASTM A325). ALL FASTENERS SHALL BE 7/8" DIAMETER UNLESS OTHERWISE NOTED WITH 15/16" DIAMETER BOLT HOLES. BOLT HOLES SHALL BE DRILLED 1-1/16" DIAMETER FOR 7/8" DIAMETER BOLTS AT CROSS FRAME CONNECTIONS. DIAPHRAGMS SHALL BE CONNECTED WITH 3/4" DIAMETER BOLTS AND BOLT HOLES SHALL BE PREDRILLED TO 15/16" DIAMETER. WASHERS SHALL BE USED FOR ALL CROSS FRAME AND DIAPHRAGM CONNECTIONS.

EXPANSION BOLTS SHALL CONSIST OF APPROVED EXPANSION ANCHORS, PROVIDING MINIMUM CERTIFIED PROOF LOAD = 4,000 LBS., FOR 3/4" DIAMETER X 18" HOOKED BOLTS, AND 2000 LBS FOR 1/2" DIA. X 10" HOOKED BOLTS.

ROADWAY EXPANSION GUARDS SHALL BE ASSEMBLED IN THE PROPER POSITION WITH THE ENDS IN PLACE AND SHALL BE LEFT ASSEMBLED FOR SHOP INSPECTION.

THE ROADWAY EXPANSION PLATES SHALL BE PLANE CUT AS PROVIDED IN ARTICLE 507.04(1) OF THE STANDARD SPECIFICATIONS.

BEARING SURFACES SHALL BE CONSTRUCTED OR ADJUSTED TO THE DESIGNATED ELEVATIONS WITHIN A TOLERANCE OF 1/8 INCH. ADJUSTMENT SHALL BE MADE EITHER BY GRINDING THE SURFACE OR BY SHIMMING THE BEARINGS. TWO 1/8" ADJUSTING SHIMS, OF THE DIMENSIONS OF THE BOTTOM BEARING PLATE, SHALL BE PROVIDED FOR EACH BEARING IN ADDITION TO ALL OTHER PLATES OR SHIMS. (FOR TYPE I ELASTOMERIC BEARINGS, SHIMS OF THE DIMENSIONS OF TOP PLATE BE PROVIDED AND PLACED AS DETAILED).

STUD SHEAR CONNECTORS

STUD SHEAR CONNECTORS SHALL CONFORM TO THE REQUIREMENTS OF ASTM A169 COLD DRAWN BARS, GRADES 1015, 1018 OR 1020 EITHER EMI-OR FULLY-RILLED, GRANULAR OR SOLID FLEX FILLED HEADED STUDS AUTOMATICALLY END WELDED. STUD SHEAR CONNECTORS SHALL BE INSTALLED IN ACCORDANCE WITH ARTICLE 507.08(a).

MATERIAL SHALL CONFORM TO ARTICLE 710.35 OF THE STANDARD SPECS.

NOTES FOR NEW CONCRETE PIERS

A) THE CONTRACTOR SHALL SPACE REINFORCEMENT BARS IN PIER CAP TO MISS ANCHOR BOLTS.

B) ALL EXPOSED EDGES TO HAVE STANDARD 3/4 INCH CHAMFERS, EXCEPT NOTED OTHERWISE.

- FIELD CLEANING AND PAINTING**
- EXISTING STRUCTURAL STEEL SURFACES IN CONTACT WITH NEW STRUCTURAL STEEL SHALL BE FIELD CLEANED IN ACCORDANCE WITH ARTICLE 509.06(b) METHOD III. SURFACES MUST BE CLEANED TO RECEIVE NEW STRUCTURAL STEEL SHALL BE PAINTED WITH ONE COAT LEAD AND CHROMATE FREE PAINT. CONTACT SURFACES SHALL NOT BE PAINTED.
 - EXISTING TOP FLANGE SURFACES IN CONTACT WITH NEW CONCRETE SHALL BE CLEANED IN ACCORDANCE WITH ARTICLE 509.06(b), METHOD III.
 - SURFACES TO RECEIVE STUD SHEAR CONNECTORS SHALL BE CLEANED IN ACCORDANCE WITH ARTICLE 509.06(b), METHOD II AND ARTICLE 507.08(a)(2).
 - NEW STRUCTURAL STEEL SHALL BE SPOT PAINTED WITH ZINC SILICATE PRIMER APPLIED ON HEADS OF FIELD BOLTS, FIELD WELDS, AND ALL AREAS WHERE PAINT HAS BEEN REMOVED OR DAMAGED.

SHEET NO.	INDEX	
1	A1	TITLE SHEET
2	A2	GENERAL NOTE, INDEX & BILL OF MATERIAL
3	A3	GENERAL PLAN
4	A4	PIER REMOVAL
5-15	A5-A15	PIER REPLACEMENT DETAILS
16	A16	ABUTMENT DETAILS
17-18	A17-A18	SUBSTRUCTURE BAR SCHEDULE
19-20	A19-A20	FRAMING PLANS
21-22	A21-A22	STRESS TABLE
23-28	A23-A28	STRUCTURAL STEEL DETAILS
29-32	A29-A32	34" PPC I-BEAM AND DECK DETAILS
33	A33	TRANSVERSE DECK JOINT ELEVATIONS
34-43	A34-A43	TOP OF SLAB ELEVATIONS
44-54	A44-A54	DECK PLAN, CROSS SECTION & PARAPET DETAILS
55-56	A55-A56	DECK BAR SCHEDULE
57-65	A57-A65	SUBSTRUCTURE WIDENING, REHABILITATION & REPLACEMENT

STATION 171+73.00
REBUILT 1989 BY
STATE OF ILLINOIS
F.A. PROJ. ID# A-18-74-3(270)
LOADING HS20
STR. NO. 016-0137

NAME PLATE
(See Std. 2113)

LOAD FOR TEMPORARY SUPPORT		
BEARING LINE	D.L. REACTION	L.L. REACTION
75	106 ^K	—
7N	52 ^K	—
115	52 ^K	—
11W	46 ^K	—
13	172 ^K	—
14	164 ^K	—
153	46 ^K	—
15N	93.5 ^K	—
16	253 ^K	—
18	208 ^K	—
193	70 ^K	—
19N	51 ^K	—

Note: D.L. Reaction includes the weight of existing steel beams only.

TOTAL BILL OF MATERIAL		
ITEM	UNIT	TOTAL
*STRUCTURE EXCAVATION	CU. YD.	89.4
*CONCRETE REMOVAL	CU. YD.	478.8
*CONCRETE REMOVAL (SPECIAL)	CU. YD.	53.9
*REMOVAL OF EXISTING CONCRETE DECK	L. SUM	0.92
*EXPANSION BOLTS 3/4 INCH DIA.	EACH	46
*PROTECTIVE SHIELD	SQ. YD.	18,575
*CLASS "X" CONCRETE	CU. YD.	886.8
*CLASS "X" CONCRETE (SUBSTRUCTURE)	CU. YD.	2988.6
PREFORMED JOINT SEAL 2 1/2 INCH	LIN. FT.	183.8
*NEOPRENE EXPANSION JOINT 2 1/2 INCH	LIN. FT.	182.1
*NEOPRENE EXPANSION JOINT 4 INCH	LIN. FT.	338.1
*PROTECTIVE COAT	SQ. YD.	1389.5
EPOXY CRACK SEALING	LIN. FT.	186
*FORMED CONCRETE REPAIR (<5' depth)	SQ. FT.	128
*FORMED CONCRETE REPAIR (>5' depth)	SQ. FT.	182
*PROTECTIVE SURFACE TREATMENT	SQ. FT.	42,953
*MECHANICAL SPLICERS	EACH	476
*REINFORCEMENT BARS (EPOXY COATED)	POUND	104,824.0
*INSTALLING PPC I-BEAMS	LIN. FT.	1772
*ERECTING STRUCTURAL STEEL	L. SUM	0.76
STUD SHEAR CONNECTORS	EACH	44,478
*STRUCTURAL STEEL REPAIR	POUND	1,688
*INSTALLING BRIDGE SCUPPERS	EACH	21
*DOWNSPOT DRAINAGE SYSTEM	LIN. FT.	568
*NAME PLATES	EACH	1
*TEMPORARY SUPPORT SYSTEM (HEIGHT < 38 FT.)	EACH	4
*TEMPORARY SUPPORT SYSTEM (HEIGHT > 38 FT.)	EACH	2
*CLASS "X" CONCRETE (RETAINING WALL)	CU. YD.	5.0
*REMOVAL OF EXISTING FOUNDATIONS	CU. YD.	15.0
* SPECIAL PROVISIONS		
** QUANTITY DOES NOT INCLUDE BRIDGE DECK SURFACE		

SHEET A2 OF A65

STATE OF ILLINOIS
DEPARTMENT OF TRANSPORTATION
F.A. ROUTE 90/94 (DAN RYAN EXPRESSWAY)
SECTION 1985-0778 COOK COUNTY
N.B. MAINLINE RECONSTRUCTION
STRUCTURE 037
GENERAL NOTES, INDEX & BILL OF MATERIAL

Scale: NONE
Date: AUGUST 1988

Drawn By: AV
Checked By: M.E.M.

ENVIRODYNE ENGINEERS INC.
Chicago, Illinois

REVISIONS	
Name	Date

12-1-1988

FILE NAME: D:\VAE\COM-NA-AW51\recomonline\local\AE\COM_D502_NAVDocuments\01_Americas\Transportation\60269938_Circle\Phase_II\000_CAD\008_Structural\Sign_Structure\62A76-Cant-552008-SignStruct.dgn



USER NAME =	charles.pigozzi	DESIGNED -	JJS, WM	REVISED -	
PLOT SCALE =	N.T.S	CHECKED -	MAI, JMG	REVISED -	
PLOT DATE =	1/24/2020	DRAWN -	JJS, WM	REVISED -	
		CHECKED -	MAI, JMG	REVISED -	

STATE OF ILLINOIS
DEPARTMENT OF TRANSPORTATION

EXISTING RECORD DRAWINGS
STRUCTURE NO. 016-0137


F.A. RTE.	SECTION	COUNTY	TOTAL SHEETS	SHEET NO.
90/94/290	2015-019R	COOK	2155	1010
CONTRACT NO. 62A76				
ILLINOIS FED. AID PROJECT				

SHEET NO. SS60 OF SS129 SHEETS

FOR INFORMATION ONLY


FEDERAL AID DISTRICT NO.	SECTION	COUNTY	TOTAL SHEETS	SHEET NO.
90/94	4	COOK	65	3
STA.	TO STA.			
FED. RD. DIST. NO.	ILLINOIS	FED. AID PROJECT		
# 1985-077 BR				

Bench Mark
TBM #49 North NE Flange bolt on hydrant
on NW corner of 21st St. and Emerald St. Elev. 13.59

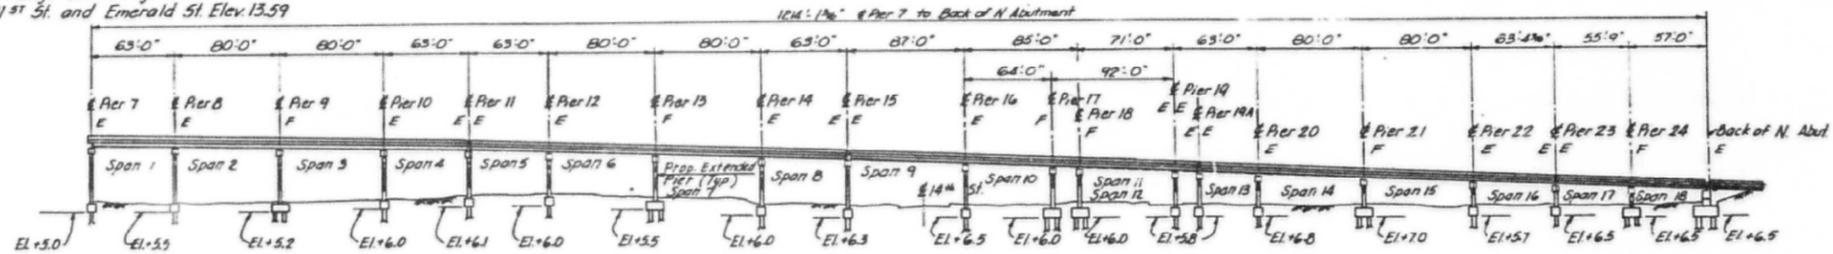


ELEVATION

Existing Structure
Structure No 016-0137 is part of the Dan Ryan Expressway Viaduct. The superstructure consists of four span, three span and two span continuous steel and concrete structures. Spans 1 thru 16 are rolled beam spans and spans 17 & 18 are concrete beam spans. The substructure consists of multiple column concrete piers and an abutment supported on concrete caissons. The structure was built in 1961 and opened to traffic in 1962. The contractor shall maintain traffic at all times reconstructing structure while widening the substructures.

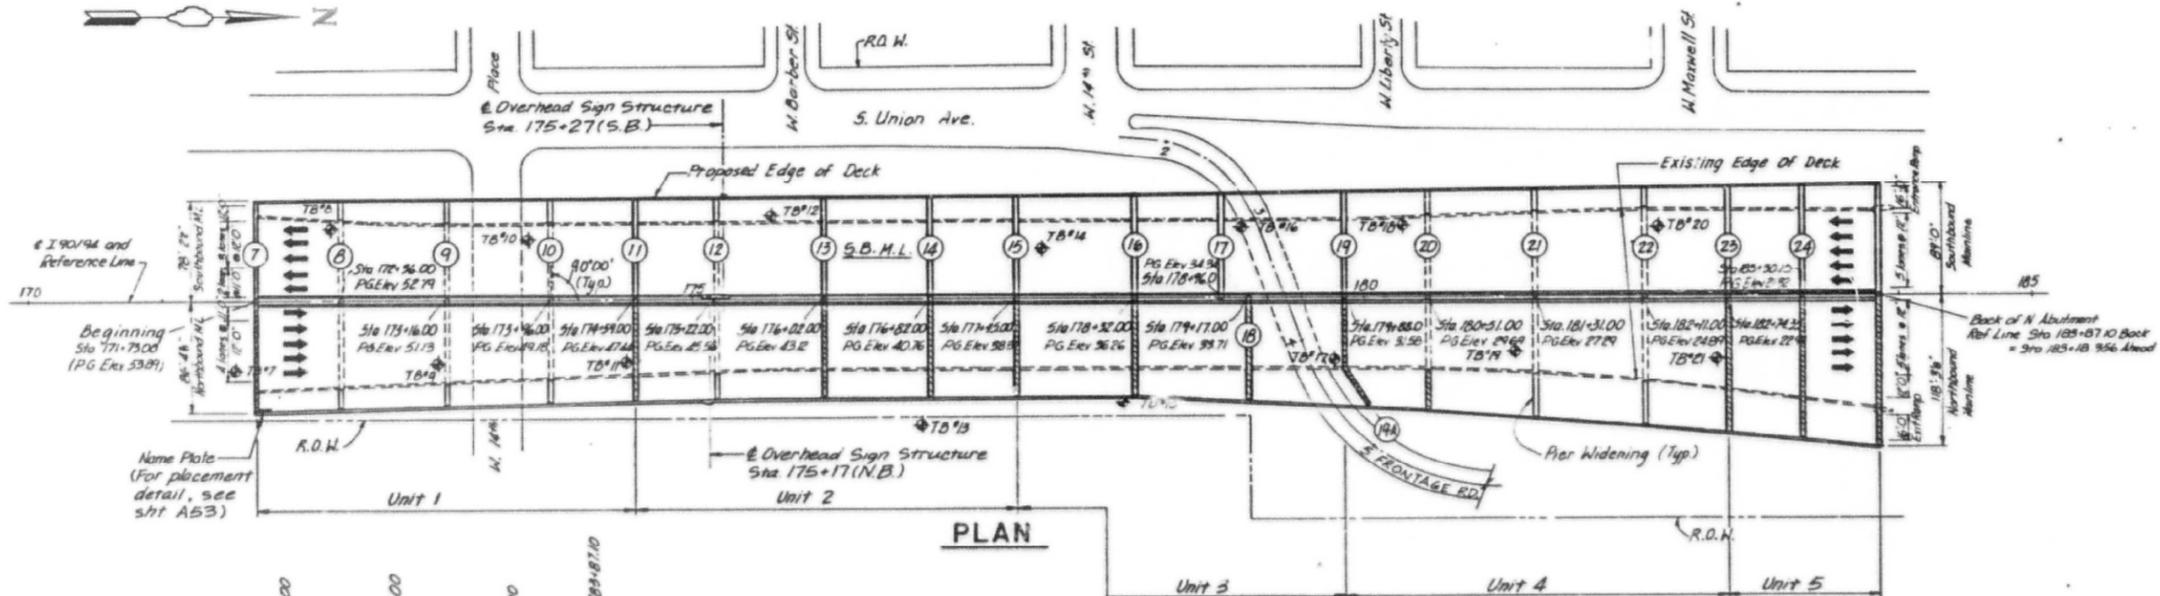

PLAN

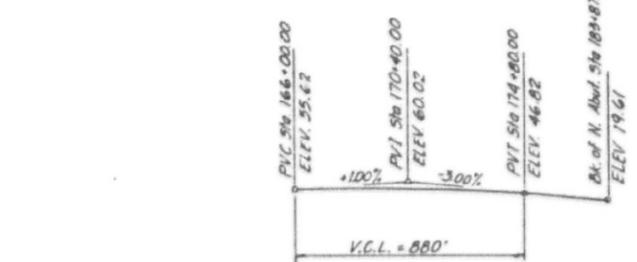


PROPOSED PROFILE GRADE
DAN RYAN EXPRESSWAY (I 90 / 94)

Design Stresses

New Construction	Existing Construction
$f_c = 3500$ PSI	$f_c = 3500$ PSI
$f_c = 1400$ PSI	$f_c = 1400$ PSI W/O Earth Pressure
$f_y = 60,000$ PSI (Reinforcement)	$f_y = 1,000$ PSI W/ Earth Pressure
$f_s = 20,000$ PSI	$V = 75$ PSI Max Shear in Footings
Working Stress Design Method	$f_s = 20,000$ PSI
Allowable Bearing Pressure on Rock = 60 Tons / 50 FT	Bedrock Bearing for Drilled Sub-Piers = 60 Tons / 50 FT

Loading HS 20-44 and AH.
Design Specifications: AASHTO (1983)
and applicable Interims (1984, 1985 thru 1987)

- Legend**
- ◆ Indicates existing soil borings
 - New Pier Replacement or Widening completed in previous contracts
 - Indicates Pier Number
 - Pier Replacement or Widening

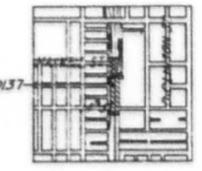

LOCATION PLAN



APPROVED
FOR STRUCTURAL ADEQUACY ONLY

James J. Ferguson
Engineer of Structures

SHEET A3 OF A65

REVISIONS	
Name	Date

STATE OF ILLINOIS
DEPARTMENT OF TRANSPORTATION
F.A.I. ROUTE 90/94 (DAN RYAN EXPRESSWAY)
SECTION 1985-077BR - COOK COUNTY
N.B. MAINLINE RECONSTRUCTION
STRUCTURE 016-0137
GENERAL PLAN

Scale: NONE
Date: AUG. 1988
Drawn By: D. C.
Checked By: M.E.H.

ENVIRODYNE ENGINEERS INC.
Chicago, Illinois

FILE NAME: D:\V\AE\COM-NA-AW51...recomonline.local\AE\COM_DS02_NAVDocuments\01_Americas\Transportation\60269938_Circle\Phase_I\0000_CAD\008_Structural\Sign_Structures\62A76-Cant-55208-SignStruct.dgn



USER NAME = charles.pigozzi	DESIGNED - JJS, WM	REVISED -
PLOT SCALE = N.T.S	CHECKED - MAI, JMG	REVISED -
PLOT DATE = 1/24/2020	DRAWN - JJS, WM	REVISED -
	CHECKED - MAI, JMG	REVISED -

STATE OF ILLINOIS
DEPARTMENT OF TRANSPORTATION







EXISTING RECORD DRAWINGS
STRUCTURE NO. 016-0137

SHEET NO. SS61 OF SS129 SHEETS

F.A.I. RTE.	SECTION	COUNTY	TOTAL SHEETS	SHEET NO.
90/94/290	2015-019R	COOK	2155	1011
CONTRACT NO. 62A76				
ILLINOIS FED. AID PROJECT				

FOR INFORMATION ONLY

FEDERAL AID DISTRICT NO.	SECTION	COUNTY	TOTAL SHEETS	SHEET NO.
90/94	0	COOK	65	4
STA.	TO STA.			
FED. RD. DIST. NO.	ILLINOIS	FED. AID PROJECT		
		# 1985-077BR		

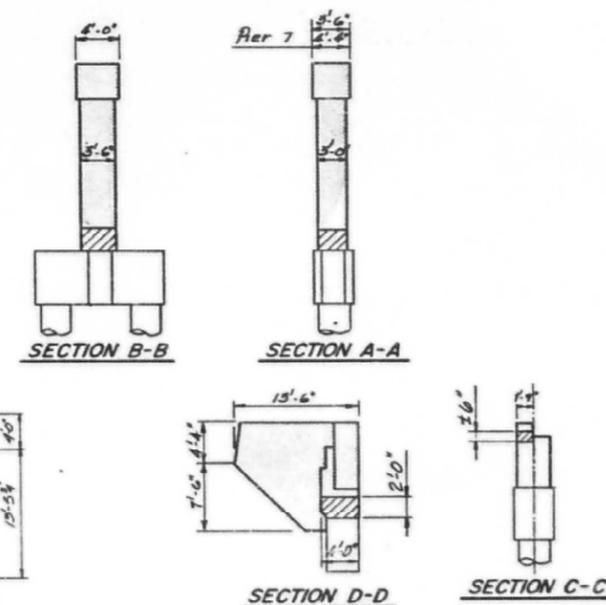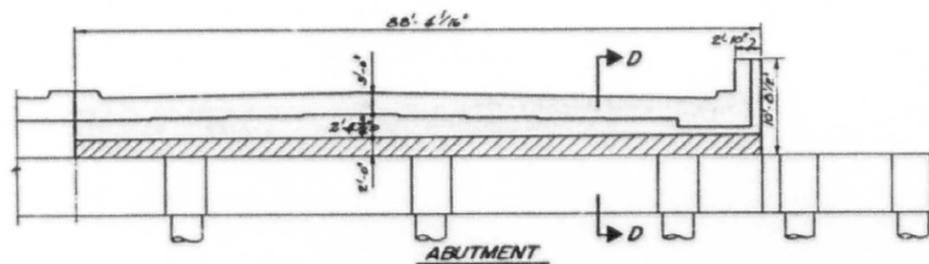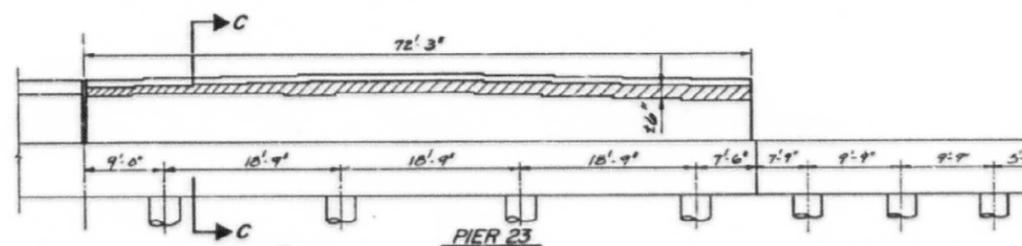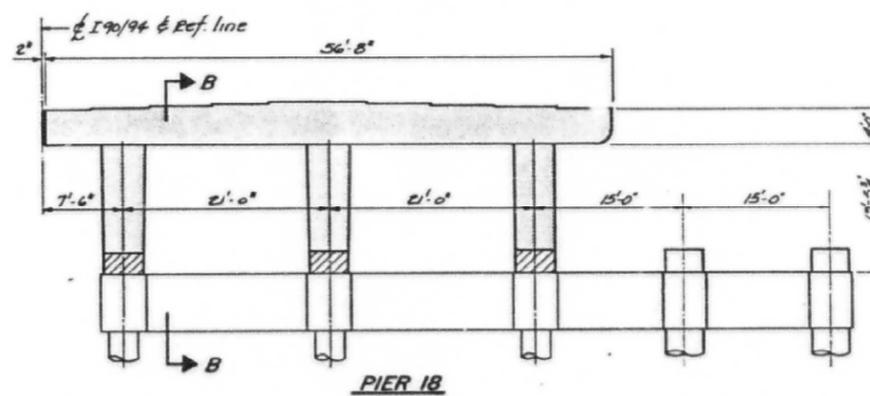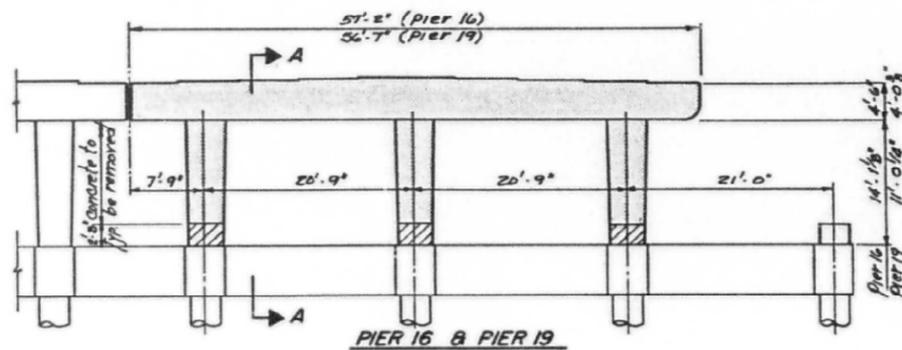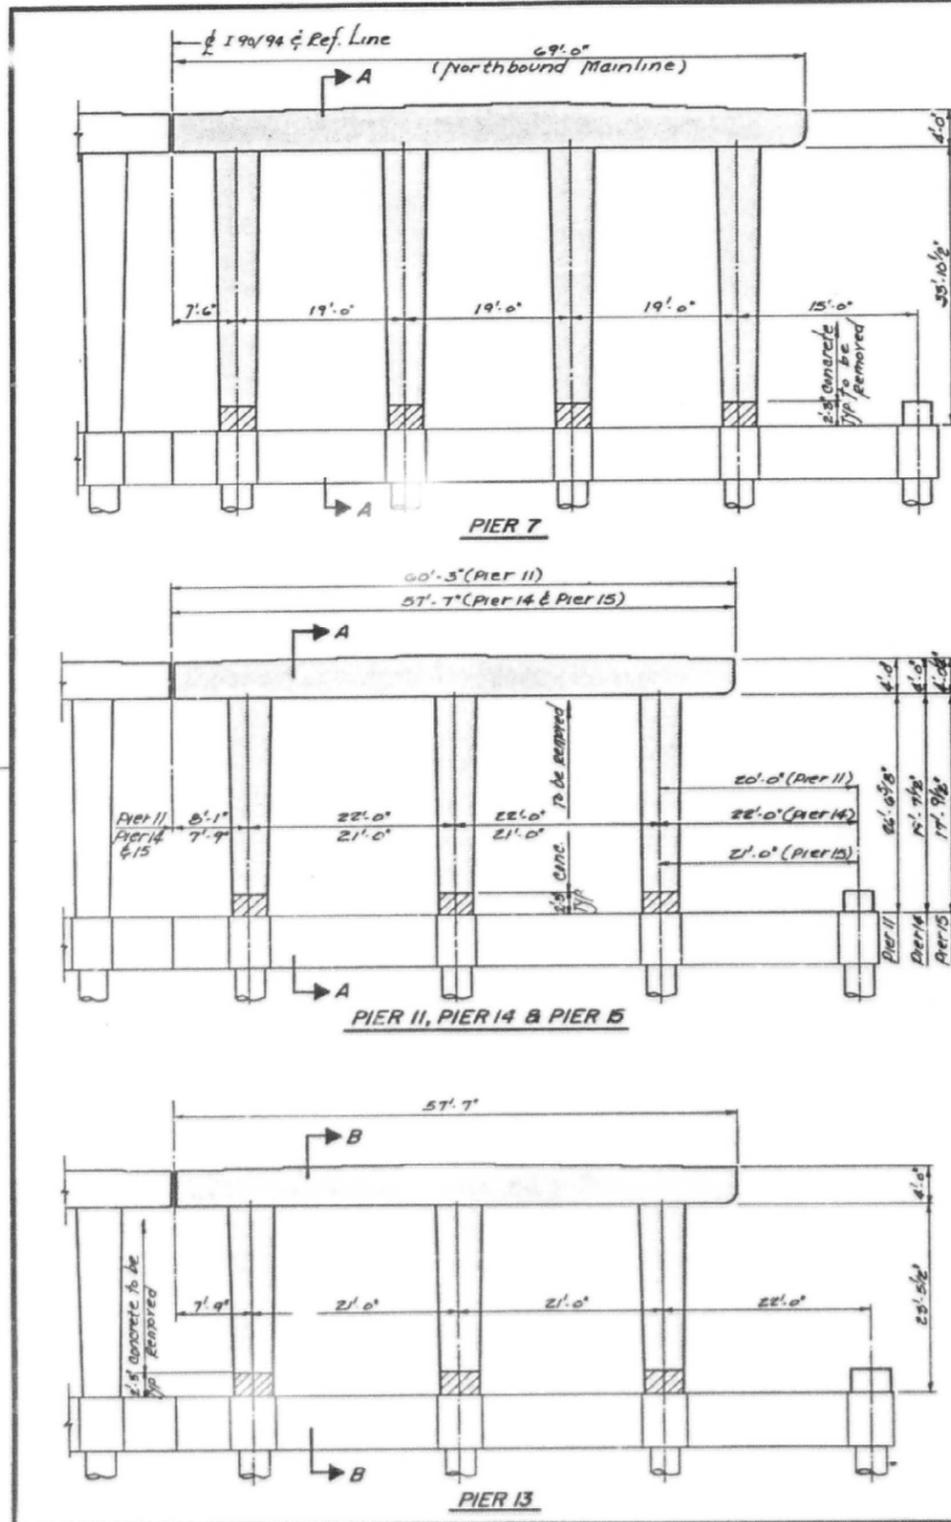

SYMBOL	ITEM	UNIT	QUANTITY
Concrete Removal		Cu Yd.	472.0
Concrete Reinforcement (Special)		Cu Yd.	48.8

SHEET A4 OF A65

REVISIONS	
Name	Date

STATE OF ILLINOIS
DEPARTMENT OF TRANSPORTATION
F.A.I. ROUTE 90 / 94 (DAN RYAN EXPRESSWAY)
SECTION 1985 - 077 BR - COOK COUNTY
N.B. MAINLINE RECONSTRUCTION
STRUCTURE 016 - 0137
PIER REMOVAL

Scale: NONE
Date: AUG., 1988
Checked By: M.E.H.
Drawn By: M.M.S.
ENVIRODYNE ENGINEERS INC.
Chicago, Illinois

FILE NAME: D:\VAECOM-NA-AWS1\recomonline\local\VAECOM_ID502_NAVDocuments\01_Americas\Transportation\60269938_Circle\Phase_I\000_CAD\008_Structural\Sign_Structure\62A76-Cant-55208-SignStruct.dgn



USER NAME =	charles.pigozzi	DESIGNED -	JJS, WM	REVISED -	
		CHECKED -	MAI, JMG	REVISED -	
PLOT SCALE =	N.T.S	DRAWN -	JJS, WM	REVISED -	
PLOT DATE =	1/24/2020	CHECKED -	MAI, JMG	REVISED -	

STATE OF ILLINOIS
DEPARTMENT OF TRANSPORTATION



EXISTING RECORD DRAWINGS
STRUCTURE NO. 016-0137

SHEET NO. SS62 OF SS129 SHEETS

F.A.I. RTE.	SECTION	COUNTY	TOTAL SHEETS	SHEET NO.
90/94/290	2015-019R	COOK	2155	1012
				CONTRACT NO. 62A76
		ILLINOIS	FED. AID PROJECT	

FOR INFORMATION ONLY

FEDERAL AID ROUTE NO.	SECTION	COUNTY	TOTAL SHEETS	SHEET NO.
90/194	*	COOK	65	5
STA.	TO STA.			
FED. DIST. NO.	ILLINOIS	FED. AID PROJECT		
* 1985-077 BR				

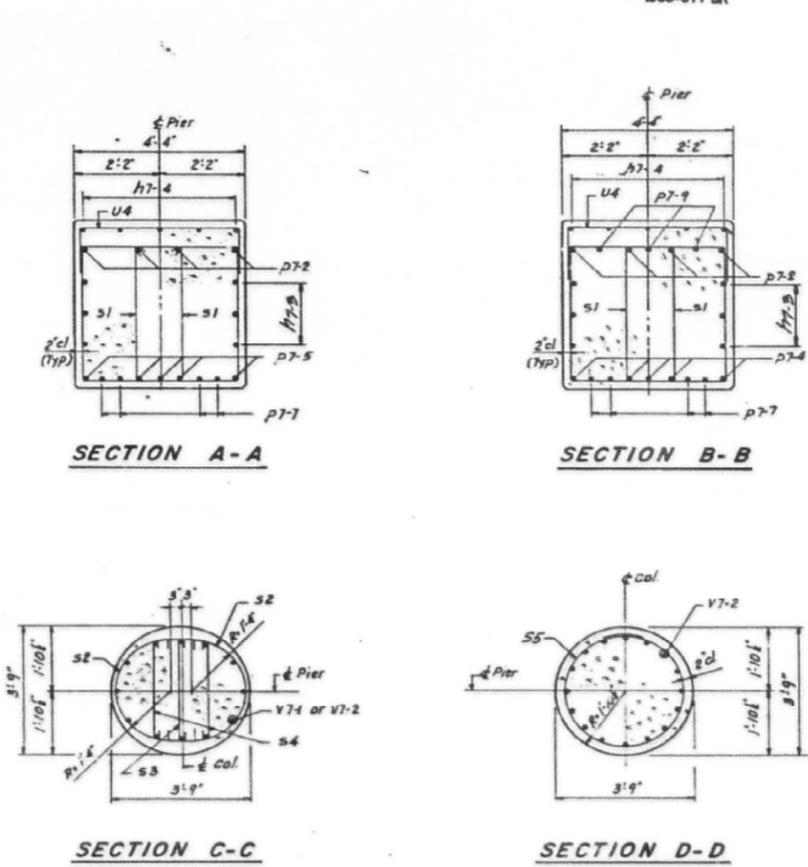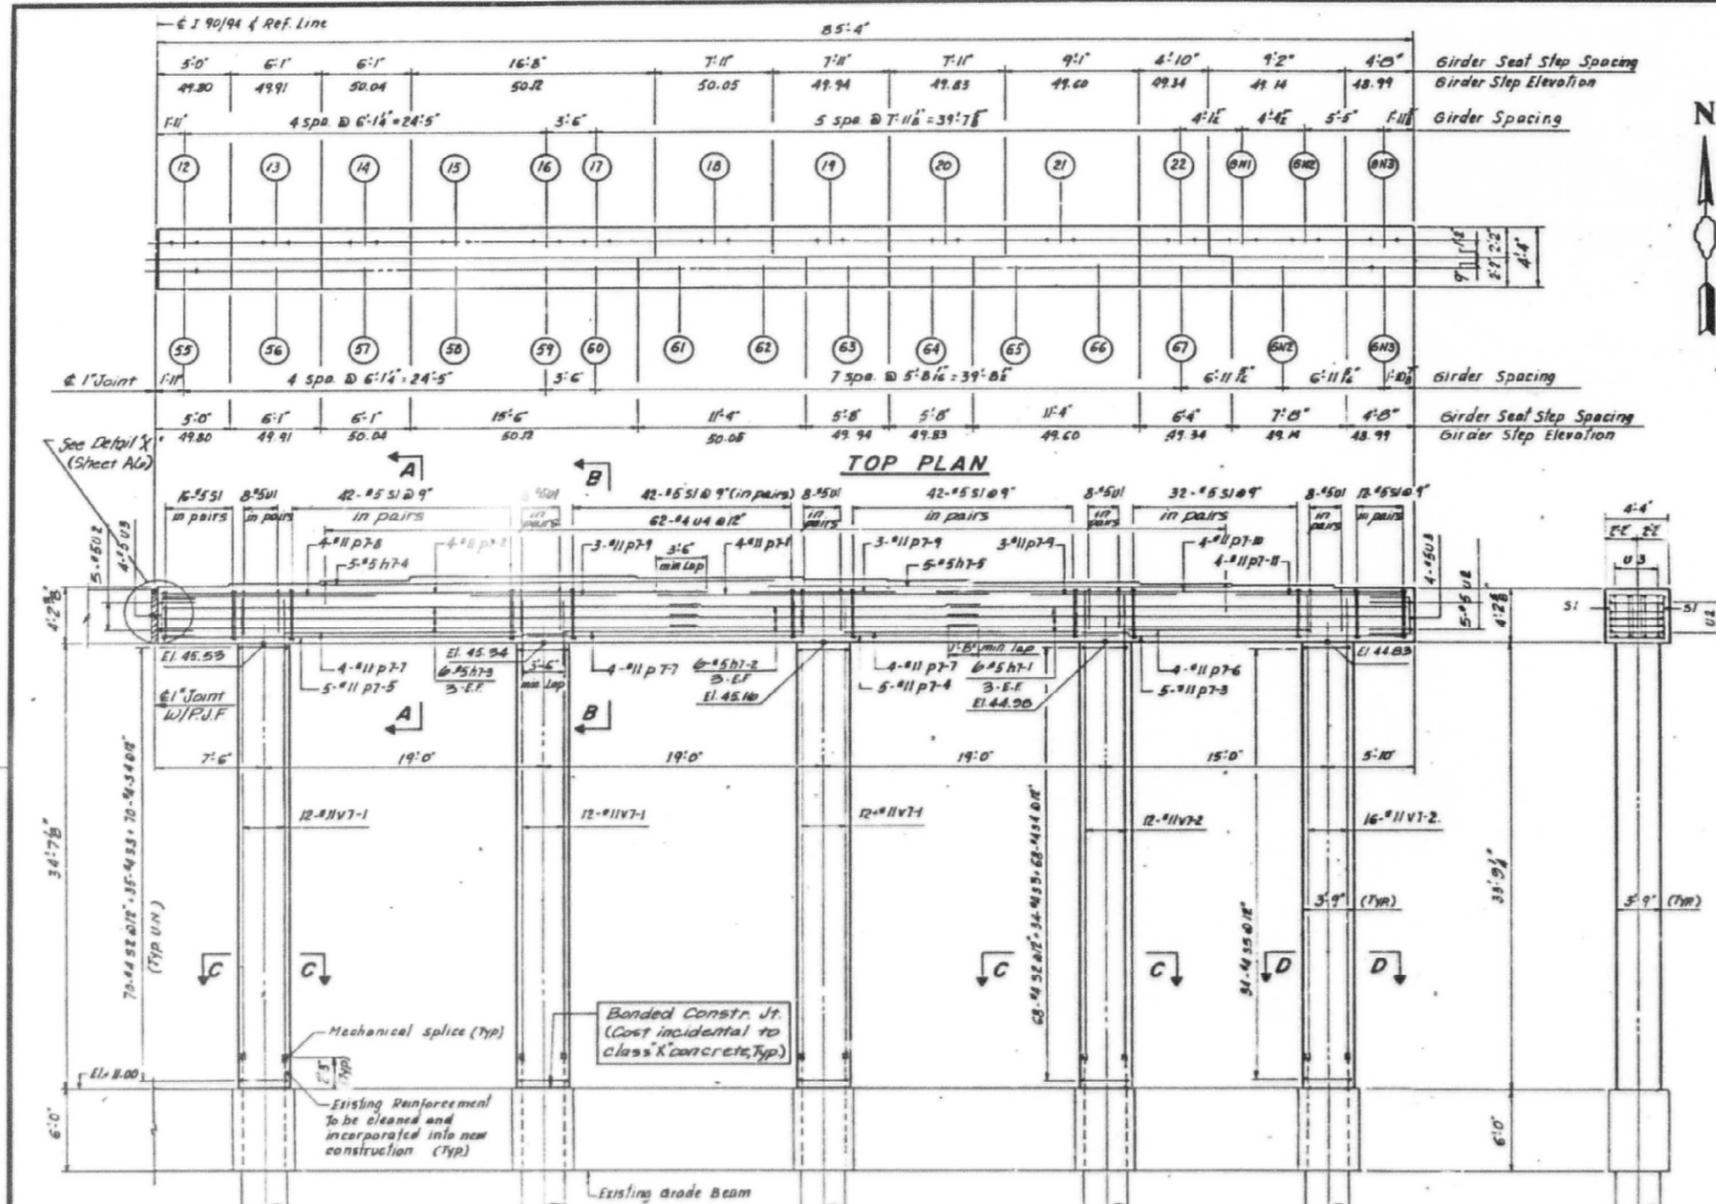

- NOTES:**
- All edges shall have std. 5 chamfer except as noted.
 - Pour steps monolithically with cap.
 - For reinforcement bar schedules see sheet no. A17 & A18.
 - For concrete removal see sheet no. A4.
 - Contractor to verify all existing top of pier elevations.
 - All Expansion bolts and Anchor bolts shall be placed in sound concrete.

BILL OF MATERIAL

ITEM	UNIT	PIER NO. 7
Reinforcement Bars (Epoxy Coated)	Lbs	25,920
Class 'x' Concrete	cu. Yd	132.5
Mechanical Splicers	Each	64


SHEET A5 OF A+5

STATE OF ILLINOIS
DEPARTMENT OF TRANSPORTATION
F.A.I. ROUTE 90/194 (DAN RYAN EXPRESSWAY)
SECTION 0985-077BR - COOK COUNTY
N.B. MAINLINE RECONSTRUCTION
STRUCTURE 016-0137
PIER 7

Scale: NONE
Date: AUG. 1988

Drawn By: ASR
Checked By: MEM

ENVIRODYNE ENGINEERS INC.
Chicago, Illinois

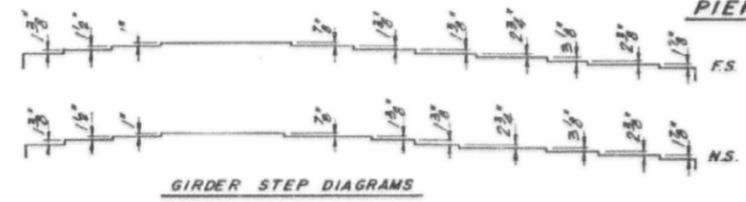

FILE NAME: D:\V\AECOM\NA\AW51\ecomonline\local\AECOM_DS02_NAVDocuments\01_Americas\Transportation\60269938_Circle\Phase_I\0000_CAD\008_Structural\Sign_Structure\62A76_Sign_Structure\62A76-Cant-55208-SignStruct.dgn



USER NAME =	charles.pigozzi	DESIGNED -	JJS, WM	REVISED -	
PLOT SCALE =	N.T.S	CHECKED -	MAI, JMG	REVISED -	
PLOT DATE =	1/24/2020	DRAWN -	JJS, WM	REVISED -	
		CHECKED -	MAI, JMG	REVISED -	

STATE OF ILLINOIS
DEPARTMENT OF TRANSPORTATION

EXISTING RECORD DRAWINGS
STRUCTURE NO. 016-0137

F.A.I. RTE.	SECTION	COUNTY	TOTAL SHEETS	SHEET NO.
90/94/290	2015-019R	COOK	2155	1013
CONTRACT NO. 62A76				
ILLINOIS FED. AID PROJECT				

SHEET NO. SS63 OF SS129 SHEETS


FOR INFORMATION ONLY

FEDERAL AID DISTRICT NO.	SECTION	COUNTY	TOTAL SHEETS	SHEET NO.
90/94	6	COOK	65	17
TO STA.				
FED. RD. DIST. NO.	ALIGNMENT	FED. AID PROJECT		
		1965-0778R		

STRUCTURE	REINFORCEMENT BAR SCHEDULE	MARK	NUMBER	SIZE	LENGTH	TYPE
PIER No. 7	h7-1(E)	6	#5	31'-0"		
PIER No. 7	h7-2(E)	6	#5	21'-0"		
PIER No. 7	h7-3(E)	6	#5	35'-6"		
PIER No. 7	h7-4(E)	5	#5	30'-4"		
PIER No. 7	h7-5(E)	5	#5	31'-0"		
PIER No. 7	p7-1(E)	4	#11	22'-0"		
PIER No. 7	p7-2(E)	4	#11	37'-6"		
PIER No. 7	p7-3(E)	5	#11	22'-6"		
PIER No. 7	p7-4(E)	5	#11	41'-6"		
PIER No. 7	p7-5(E)	5	#11	28'-0"		
PIER No. 7	p7-6(E)	4	#11	13'-0"		
PIER No. 7	p7-7(E)	12	#11	17'-0"		
PIER No. 7	p7-8(E)	4	#11	15'-0"		
PIER No. 7	p7-9(E)	9	#11	11'-0"		
PIER No. 7	p7-10(E)	4	#11	32'-6"		
PIER No. 7	p7-11(E)	4	#11	12'-0"		
PIER No. 7	s1(E)	166	#5	13'-7"		
PIER No. 7	s2(E)	278	#4	6'-6"		
PIER No. 7	s3(E)	139	#4	3'-8"		
PIER No. 7	s4(E)	278	#4	3'-7"		
PIER No. 7	s5(E)	34	#4	12'-1"		
PIER No. 7	u1(E)	40	#5	10'-1"		
PIER No. 7	u2(E)	10	#5	7'-11"		
PIER No. 7	u3(E)	8	#5	7'-8"		
PIER No. 7	u4(E)	62	#4	6'-6"		
PIER No. 7	v7-1(E)	36	#11	36'-4"		
PIER No. 7	v7-2(E)	28	#11	35'-5"		
PIER No. 11	h11-1(E)	-5	#5	27'-4"		
PIER No. 11	h11-2(E)	5	#5	17'-0"		
PIER No. 11	h11-3(E)	5	#5	13'-0"		
PIER No. 11	h11-4(E)	18	#5	29'-6"		
PIER No. 11	p11-1(E)	6	#10	17'-0"		
PIER No. 11	p11-2(E)	6	#10	24'-0"		
PIER No. 11	p11-3(E)	6	#10	40'-0"		
PIER No. 11	p11-4(E)	12	#10	14'-0"		
PIER No. 11	p11-5(E)	6	#10	22'-6"		
PIER No. 11	p11-6(E)	6	#10	15'-6"		
PIER No. 11	p11-7(E)	6	#11	31'-9"		
PIER No. 11	p11-8(E)	6	#11	25'-9"		
PIER No. 11	p11-9(E)	6	#11	29'-3"		
PIER No. 11	s2(E)	210	#4	6'-6"		
PIER No. 11	s3(E)	105	#4	3'-8"		
PIER No. 11	s4(E)	210	#4	3'-7"		
PIER No. 11	s6(E)	234	#5	12'-9"		
PIER No. 11	u3(E)	8	#5	7'-8"		
PIER No. 11	u5(E)	32	#5	9'-8"		
PIER No. 11	u6(E)	10	#5	7'-1"		
PIER No. 11	u7(E)	50	#4	5'-8"		
PIER No. 11	v11-1(E)	36	#11	28'-3"		
PIER No. 11	v11-2(E)	16	#9	27'-6"		
PIER No. 13	h13-1(E)	5	#5	28'-3"		
PIER No. 13	h13-2(E)	5	#5	20'-6"		
PIER No. 13	h13-3(E)	5	#5	15'-0"		
PIER No. 13	h13-4(E)	12	#5	40'-3"		
PIER No. 13	p13-1(E)	12	#10	41'-0"		
PIER No. 13	p13-2(E)	8	#11	15'-0"		
PIER No. 13	p13-3(E)	9	#11	14'-0"		
PIER No. 13	p13-4(E)	12	#10	30'-6"		
PIER No. 13	p13-5(E)	6	#10	24'-6"		
PIER No. 13	s7(E)	184	#4	7'-4"		
PIER No. 13	s8(E)	92	#4	4'-2"		
PIER No. 13	s9(E)	184	#4	4'-1"		
PIER No. 13	s15(E)	222	#5	13'-3"		

STRUCTURE	REINFORCEMENT BAR SCHEDULE	MARK	NUMBER	SIZE	LENGTH	TYPE
PIER No. 13	u3(E)	8	#5	7'-8"		
PIER No. 13	u8(E)	32	#5	9'-11"		
PIER No. 13	u9(E)	63	#4	6'-2"		
PIER No. 13	u10(E)	10	#5	7'-7"		
PIER No. 13	v13-1(E)	42	#11	25'-0"		
PIER No. 13	v13-2(E)	16	#9	24'-2"		
PIER No. 14	h14-1(E)	5	#5	12'-0"		
PIER No. 14	h14-2(E)	5	#5	22'-2"		
PIER No. 14	h14-3(E)	5	#5	20'-0"		
PIER No. 14	h14-4(E)	5	#5	14'-6"		
PIER No. 14	h14-5(E)	12	#5	40'-0"		
PIER No. 14	p14-1(E)	12	#10	40'-9"		
PIER No. 14	u14-2(E)	6	#10	16'-0"		
PIER No. 14	p14-3(E)	19	#10	14'-0"		
PIER No. 14	p14-4(E)	12	#11	30'-4"		
PIER No. 14	p14-5(E)	6	#11	24'-6"		
PIER No. 14	s2(E)	154	#4	6'-6"		
PIER No. 14	s3(E)	77	#4	3'-8"		
PIER No. 14	s4(E)	154	#4	3'-7"		
PIER No. 14	s6(E)	226	#5	12'-9"		
PIER No. 14	u3(E)	8	#5	7'-0"		
PIER No. 14	u5(E)	22	#5	9'-8"		
PIER No. 14	u6(E)	10	#5	7'-1"		
PIER No. 14	u7(E)	69	#4	5'-8"		
PIER No. 14	v14-1(E)	26	#11	21'-3"		
PIER No. 14	v14-2(E)	16	#9	20'-6"		
PIER No. 15	h15-1(E)	12	#5	40'-0"		
PIER No. 15	h15-2(E)	3	#5	12'-8"		
PIER No. 15	h15-3(E)	6	#5	20'-0"		
PIER No. 15	h15-4(E)	6	#5	13'-4"		
PIER No. 15	h15-5(E)	3	#5	20'-4"		
PIER No. 15	h15-6(E)	5	#5	6'-6"		
PIER No. 15	h15-7(E)	3	#5	15'-4"		
PIER No. 15	h15-8(E)	3	#5	17'-8"		
PIER No. 15	p15-1(E)	12	#10	40'-6"		
PIER No. 15	p15-2(E)	17	#10	16'-0"		
PIER No. 15	p15-3(E)	12	#10	14'-0"		
PIER No. 15	p15-4(E)	12	#11	30'-4"		
PIER No. 15	p15-5(E)	6	#11	24'-6"		
PIER No. 15	s2(E)	138	#4	6'-6"		
PIER No. 15	s3(E)	69	#4	3'-8"		
PIER No. 15	s4(E)	138	#4	3'-7"		
PIER No. 15	s6(E)	204	#5	12'-9"		
PIER No. 15	u3(E)	8	#5	7'-8"		
PIER No. 15	u5(E)	26	#5	9'-8"		
PIER No. 15	u6(E)	10	#5	7'-1"		
PIER No. 15	u7(E)	7	#5	5'-8"		
PIER No. 15	u11(E)	66	#4	3'-4"		
PIER No. 15	u13(E)	76	#4	4'-11"		
PIER No. 15	v15-1(E)	36	#11	19'-0"		
PIER No. 15	v15-2(E)	16	#9	12'-0"		
PIER No. 16	h16-1(E)	12	#5	40'-0"		
PIER No. 16	h16-2(E)	5	#5	12'-8"		
PIER No. 16	h16-3(E)	5	#5	21'-10"		
PIER No. 16	h16-4(E)	5	#5	20'-4"		
PIER No. 16	p16-1(E)	12	#10	40'-3"		
PIER No. 16	p16-2(E)	12	#10	16'-0"		
PIER No. 16	p16-3(E)	12	#10	14'-0"		
PIER No. 16	s2(E)	106	#4	6'-6"		
PIER No. 16	s3(E)	53	#4	3'-8"		
PIER No. 16	s4(E)	106	#4	3'-7"		
PIER No. 16	s6(E)	158	#5	12'-9"		
PIER No. 16	u3(E)	8	#5	7'-0"		
PIER No. 16	u5(E)	40	#5	9'-8"		
PIER No. 16	u6(E)	20	#5	7'-1"		
PIER No. 16	u7(E)	17	#5	5'-8"		
PIER No. 16	v16-1(E)	40	#11	17'-0"		
PIER No. 16	v16-2(E)	16	#9	15'-6"		

STRUCTURE	REINFORCEMENT BAR SCHEDULE	MARK	NUMBER	SIZE	LENGTH	TYPE
PIER No. 16	p16-4(E)	6	#11	31'-0"		
PIER No. 16	p16-5(E)	6	#11	30'-0"		
PIER No. 16	p16-6(E)	6	#11	24'-3"		
PIER No. 16	s2(E)	108	#4	6'-6"		
PIER No. 16	s3(E)	54	#4	3'-8"		
PIER No. 16	s4(E)	108	#4	3'-7"		
PIER No. 16	s11(E)	226	#5	13'-7"		
PIER No. 16	u6(E)	10	#5	7'-1"		
PIER No. 16	u7(E)	64	#4	5'-8"		
PIER No. 16	u14(E)	32	#5	10'-6"		
PIER No. 16	u15(E)	8	#5	8'-1"		
PIER No. 16	v16-3(E)	36	#11	16'-0"		
PIER No. 16	v16-4(E)	16	#9	15'-6"		
PIER No. 18	h18-1(E)	12	#5	24'-0"		
PIER No. 18	h18-2(E)	6	#5	40'-0"		
PIER No. 18	h18-3(E)	10	#5	13'-6"		
PIER No. 18	h18-4(E)	5	#5	21'-10"		
PIER No. 18	h18-5(E)	5	#5	23'-6"		
PIER No. 18	p18-1(E)	6	#10	40'-0"		
PIER No. 18	p18-2(E)	6	#10	43'-0"		
PIER No. 18	p18-3(E)	4	#11	43'-0"		
PIER No. 18	p18-4(E)	8	#11	14'-0"		
PIER No. 18	p18-5(E)	6	#10	30'-0"		
PIER No. 18	p18-6(E)	6	#10	39'-2"		
PIER No. 18	p18-7(E)	6	#10	22'-0"		
PIER No. 18	p18-8(E)	12	#10	16'-6"		
PIER No. 18	s7(E)	120	#4	7'-4"		
PIER No. 18	s8(E)	64	#4	4'-2"		
PIER No. 18	s9(E)	120	#4	4'-1"		
PIER No. 18	s12(E)	5	#4	11'-3"		
PIER No. 18	s13(E)	7	#6	15'-11"		
PIER No. 18	s15(E)	218	#5	13'-3"		
PIER No. 18	u3(E)	8	#5	7'-0"		
PIER No. 18	u8(E)	48	#5	9'-11"		
PIER No. 18	u9(E)	71	#4	6'-8"		
PIER No. 18	u10(E)	10	#5	7'-7"		
PIER No. 18	v18-1(E)	15	#9	6'-5"		
PIER No. 18	v18-2(E)	42	#11	18'-0"		
PIER No. 18	v18-3(E)	22	#9	14'-3"		
PIER No. 19	h19-1(E)	5	#5	13'-0"		
PIER No. 19	h19-2(E)	5	#5	24'-0"		
PIER No. 19	h19-3(E)	5	#5	6'-6"		
PIER No. 19	h19-4(E)	5	#5	39'-0"		
PIER No. 19	h19-5(E)	5	#5	45'-6"		
PIER No. 19	h19-6(E)	5	#5	51'-0"		
PIER No. 19	h19-7(E)	5	#5	14'-6"		
PIER No. 19	h19-8(E)	5	#5	13'-0"		
PIER No. 19	h19-9(E)	5	#5	39'-0"		
PIER No. 19	h19-10(E)	5	#5	20'-0"		
PIER No. 19	s2(E)	106	#4	6'-6"		
PIER No. 19	s3(E)	53	#4	3'-8"		
PIER No. 19	s4(E)	106	#4	3'-7"		
PIER No. 19	s6(E)	158	#5	12'-9"		
PIER No. 19	u3(E)	8	#5	7'-0"		
PIER No. 19	u5(E)	40	#5	9'-8"		
PIER No. 19	u6(E)	20	#5	7'-1"		
PIER No. 19	u7(E)	17	#5	5'-8"		
PIER No. 19	v19-1(E)	40	#11	17'-0"		
PIER No. 19	v19-2(E)	16	#9	15'-6"		

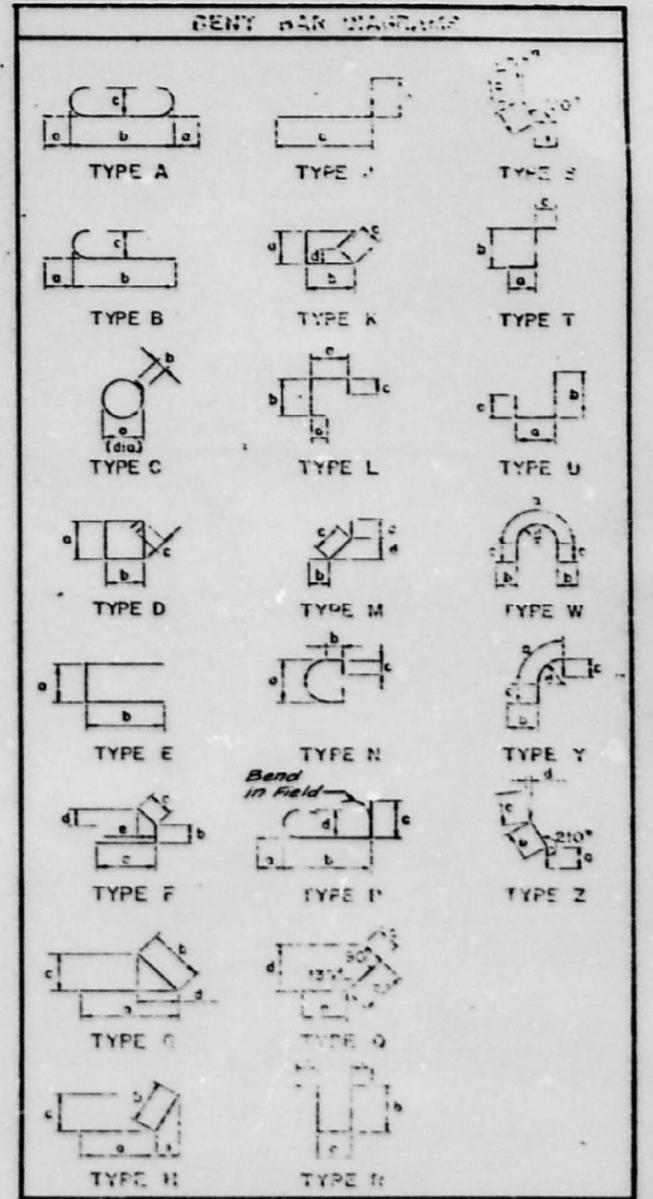

Note: All bar dimensions are out to out.

SHEET A17 OF A65

STATE OF ILLINOIS
DEPARTMENT OF TRANSPORTATION
F.A.I. ROUTE 90/94 (DAN RYAN EXPRESSWAY)
SECTION 1985-0778R COOK COUNTY
N.B. MAINLINE RE


FOR INFORMATION ONLY

FEDERAL AID ROUTE NO.	SECTION	COUNTY	TOTAL SHEETS	SHEET NO.
90/94	4	COOK	65	18
STA.	TO STA.			
FED. RD. DIST. NO.	PLAN NO.	FED. AID PROJECT		
		* 1985-077BR		

STRUCTURE	REINFORCEMENT BAR SCHEDULE				TYPE
	MARK	NUMBER	SIZE	LENGTH	
PIER No. 20	h20-3(E)	26	#5	31'-11"	
PIER No. 20	u21(E)	12	#5	5'-3"	
PIER No. 20	u22(E)	33	#5	5'-4"	
PIER No. 20	v20-2(E)	66	#5	10'-9"	
PIER No. 23	h23-1(E)	21	#5	7'-4"	
PIER No. 23	h23-2(E)	3	#5	13'-4"	
PIER No. 23	h23-3(E)	3	#5	6'-5"	
PIER No. 23	h23-4(E)	3	#5	11'-6"	
PIER No. 23	h23-5(E)	6	#5	6'-8"	
PIER No. 23	h23-6(E)	3	#5	8'-6"	
PIER No. 23	u23(E)	101	#4	2'-2"	
PIER No. 24	h24-1(E)	6	#5	14'-0"	
PIER No. 24	h24-2(E)	6	#5	40'-8"	
PIER No. 24	h24-3(E)	6	#5	25'-6"	
PIER No. 24	h24-5(E)	6	#5	31'-2"	
PIER No. 24	n(E)	32	#8	1'-6"	
PIER No. 24	p24-1(E)	4	#9	12'-10"	
PIER No. 24	p24-2(E)	4	#9	20'-0"	
PIER No. 24	u19(E)	32	#4	8'-4"	
PIER No. 24	u20(E)	79	#4	4'-6"	
PIER No. 24	u24(E)	2	#4	6'-3"	
PIER No. 24	u25(E)	6	#4	4'-1 1/2"	
PIER No. 24	u26(E)	2	#4	4'-0"	

STRUCTURE	REINFORCEMENT BAR SCHEDULE				TYPE
	MARK	NUMBER	SIZE	LENGTH	
ABUTMENT	b(E)	2	#8	15'-2"	
ABUTMENT	b1(E)	2	#5	15'-2"	
ABUTMENT	b2(E)	6	#8	0'-8"	
ABUTMENT	b3(E)	6	#5	0'-8"	
ABUTMENT	d(E)	25	#4	5'-0"	
ABUTMENT	d2(E)	25	#5	5'-0"	
ABUTMENT	d3(E)	103	#5	2'-3"	
ABUTMENT	e(E)	8	#4	15'-2"	
ABUTMENT	e1(E)	24	#4	0'-8"	
ABUTMENT	hA-1(E)	12	#5	28'-9"	
ABUTMENT	hA-2(E)	24	#5	25'-4"	
ABUTMENT	hA-3(E)	12	#5	17'-8"	
ABUTMENT	hA-4(E)	12	#5	23'-10"	
ABUTMENT	hA-5(E)	18	#5	31'-10"	
ABUTMENT	hA-6(E)	2	#5	26'-6"	
ABUTMENT	hA-7(E)	4	#6	13'-0"	
ABUTMENT	hA-8(E)	2	#6	10'-8"	
ABUTMENT	hA-9(E)	2	#6	8'-4"	
ABUTMENT	hA-10(E)	2	#6	6'-1"	
ABUTMENT	hA-11(E)	2	#6	3'-9"	
ABUTMENT	hA-12(E)	2	#6	2'-10"	
ABUTMENT	pA-1(E)	18	#9	27'-6"	
ABUTMENT	pA-2(E)	6	#9	26'-6"	
ABUTMENT	hA-13(E)	2	#6	14'-0"	
ABUTMENT	u29(E)	82	#5	5'-2"	
ABUTMENT	u30(E)	6	#5	4'-5"	
ABUTMENT	u31(E)	28	#5	3'-8"	
ABUTMENT	u32(E)	50	#5	3'-2"	
ABUTMENT	u34(E)	25	#5	2'-8"	
ABUTMENT	u35(E)	14	#5	2'-2"	
ABUTMENT	u36(E)	24	#5	4'-2"	
ABUTMENT	u37(E)	50	#5	8'-0"	
ABUTMENT	u39(E)	25	#5	7'-8"	
ABUTMENT	u40(E)	14	#5	6'-10"	
ABUTMENT	u42(E)	6	#4	3'-1"	
ABUTMENT	u43(E)	27	#4	5'-1"	
ABUTMENT	u44(E)	12	#6	5'-1"	
ABUTMENT	VA-1(E)	116	#5	3'-0"	
ABUTMENT	VA-2(E)	82	#5	5'-6"	
ABUTMENT	VA-3(E)	6	#5	4'-9"	
ABUTMENT	VA-4(E)	28	#5	4'-0"	
ABUTMENT	VA-5(E)	14	#4	4'-2"	
ABUTMENT	VA-6(E)	6	#4	3'-0"	
ABUTMENT	VA-7(E)	6	#4	1'-10"	

TYPE	MARK	BENT BAR DETAILS			
		a	b	c	d
○	s5(C)	3'-5"	1'-4"		
○	s12(C)	3'-2"	1'-4"		
□	s1(E)	3'-9"	2'-7"	0'-5 1/2"	
□	s5(E)	3'-9"	2'-2"	0'-5 1/2"	
□	s11(E)	4'-2"	2'-2"	0'-5 1/2"	
□	s13(E)	3'-9"	3'-8"	0'-6 1/2"	
□	s15(E)	3'-9"	2'-5"	0'-5 1/2"	
	u1(E)	2'-7"	3'-9"		
	u2(E)	3'-11"	2'-0"		
	u3(E)	3'-8"	2'-0"		
	u4(E)	4'-0"	1'-3"		
	u5(E)	2'-2"	3'-9"		
	u6(E)	3'-1"	2'-0"		
	u7(E)	3'-2"	1'-3"		
	u8(E)	2'-5"	3'-9"		
	u9(E)	3'-8"	1'-3"		
	u10(E)	3'-7"	2'-0"		
	u13(E)	1'-5"	1'-9"		
	u14(E)	2'-2"	-2"		
	u15(E)	4'-1"	2'-0"		
	u19(E)	2'-2"	3'-1"		
	u20(E)	2'-2"	1'-2"		
	u21(E)	2'-1"	1'-7"		
	u22(E)	2'-2"	1'-7"		
	u23(E)	1'-5"	0'-5"		
	u42(E)	1'-1"	1'-0"		
	u43(E)	1'-1"	2'-0"		
	u26(E)	2'-0"	2'-0"	1'-5"	
	u32(E)	2'-6"	0'-8"	0'-5 3/4"	
	u34(E)	2'-0"	0'-8"	0'-5 3/4"	
	u35(E)	1'-6"	0'-8"	0'-5 3/4"	
	u11(E)	2'-6"	1'-3"		
	u29(E)	4'-0"	1'-2"		
	u30(E)	2'-3"	1'-2"		
	u31(E)	2'-6"	1'-2"		
	u36(E)	3'-8"	0'-6"		
	u44(E)	4'-0"	1'-1"		
○○○	s2(C)	2'-0"	0'-8"	0'-6"	
○○○	s7(C)	3'-2"	0'-8"	0'-6"	
○○○	u24(E)	2'-1"	1'-0"	0'-6"	
	s3(C)	6'-6"	2'-8"	0'-6"	0'-3 1/2"
	s4(E)	0'-6"	2'-7"	0'-6"	0'-3 1/2"
	s8(E)	0'-5"	2'-0"	0'-6"	0'-3 1/2"
	s9(E)	0'-5"	3'-1"	0'-6"	0'-3 1/2"
∨	u25(E)	2'-3"	0'-3 1/2"	1'-10"	1'-3 1/2"
∨	u37(E)	3'-3"	2'-10"	1'-6"	
∨	u39(E)	3'-8"	2'-6"	1'-5"	
∨	u40(E)	3'-8"	1'-10"	1'-4"	
∨	d2(E)	2'-3"	1'-1"	1'-0"	0'-2 1/2"

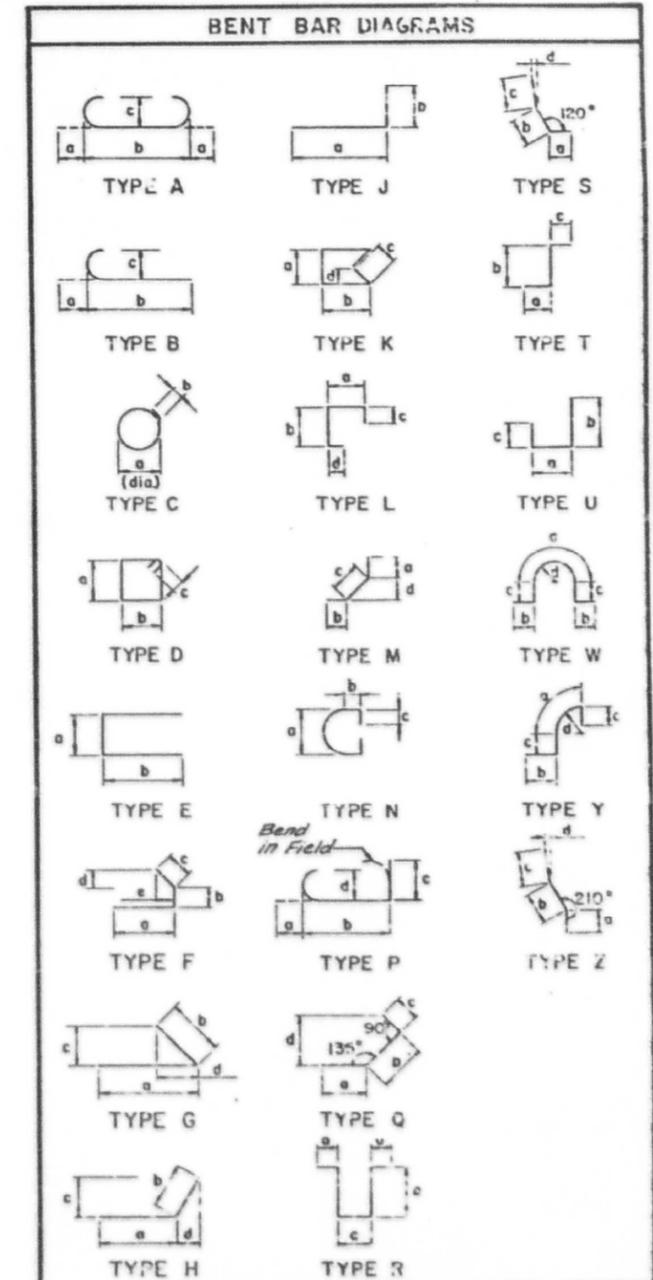

Note:
All bar dimensions are out to out.

SHEET 118 OF 165

STATE OF ILLINOIS
DEPARTMENT OF TRANSPORTATION
F.A.I. ROUTE 90/94 (DAN RYAN EXPRESSWAY)
SECTION 1985-077BR/COOK COUNTY
NB MARSH RECONSTRUCTION
STRUCTURE 016-0137
PER BAR SCHEDULE

Scale: NONE
Date: AUGUST 1988
Checked By: MEM

Drawn By: CADJAV
Checked By: MEM

ENVIRODYNE ENGINEERS INC.
Chicago, Illinois

REVISIONS	
Name	Date

FILE NAME: D:\VAE\COM-NA-AW51\ecomonline\local\AECOM_ID502_NAVDocuments\01_Americas\Transportation\60269938_Circle\Phase_I\0000_CAD\008_Structural\Sign_Structure\62A76_Sign_Structure\62A76-Cant-55208-SignStruct.dgn



USER NAME =	charles.pigozzi	DESIGNED -	JJS, WM	REVISED -	
CHECKED -	MAI, JMG	REVISIONS -			
PLOT SCALE =	N.T.S	DRAWN -	JJS, WM	REVISED -	
PLOT DATE =	1/24/2020	CHECKED -	MAI, JMG	REVISED -	

STATE OF ILLINOIS
DEPARTMENT OF TRANSPORTATION

EXISTING RECORD DRAWINGS
STRUCTURE NO. 016-0137

F.A.I. RTE.	SECTION	COUNTY	TOTAL SHEETS	SHEET NO.
90/94/290	2015-019R	COOK	2155	1016
CONTRACT NO. 62A76				

SHEET NO. SS66 OF SS129 SHEETS

ILLINOIS FED. AID PROJECT

FOR INFORMATION ONLY

STATE OF ILLINOIS
 DEPARTMENT OF TRANSPORTATION
 DIVISION OF HIGHWAYS
**PLANS FOR PROPOSED
 FEDERAL AID INTERSTATE HIGHWAY**

F.A. RTE.	SECTION	COUNTY	TOTAL SHEETS	SHEET NO.
90/94	8	COOK	88	1
1985-077 B-R				
P-91-179-84				


INDEX OF VOLUMES		NO. OF SHEETS
VOL. NO.	DESCRIPTION	
CIVIL		
1	ROADWAY PLAN & GENERAL SHEETS	127
2	MAINTENANCE OF TRAFFIC & ROADWAY CROSS SECTIONS	45
STRUCTURAL		
3	STRUCTURE NO.016-0137 (MAXWELL ST. TO 15TH ST.)	65
4	STRUCTURE NO.016-1110 (15TH ST. TO 16TH ST.)	33
5	STRUCTURE NO.016-1111 (16TH ST. TO 18TH ST.)	51
6	STRUCTURE NO.016-1112 (18TH ST. TO CERMAK RD.)	91
7	STRUCTURE NO.016-1113 (CERMAK RD. TO CHICAGO RIVER)	88
8	STRUCTURE NO.016-1114 & 1070 (CHICAGO RIVER BRIDGE)	16
9	STRUCTURE NO.016-1115 (I-55 INTERCHANGE - MAINLINE)	101
10	STRUCTURE NO.016-1047 & 1140 (I-55 INTERCHANGE - RAMPS)	53
11	STRUCTURE NO.016-1116 (CANAL ST. TO STEWART AVE.)	21
12	STRUCTURE NO.016-1117 & 1118 (STEWART AVE. TO 28TH PL.)	98
13	MISCELLANEOUS VIADUCT DETAILS	88
ELECTRICAL		
14	ROADWAY LIGHTING & SURVEILLANCE	49
TOTAL		926

VOLUME NO. 7
 F.A.I. ROUTE 90/94 (DAN RYAN EXPRESSWAY)
 SECTION 1985-077 B-R
 PROJECT
 COOK COUNTY
~~C-91-430-85~~
 NORTHBOUND MAINLINE RECONSTRUCTION
 28TH PL TO MAXWELL ST.

SCALES
 PLAN 1 INCH = 40 FEET
 PROFILE HORIZ. 1 INCH = 40 FEET
 PROFILE VERT. 1 INCH = 4 FEET
 CROSS SECTIONS 1 INCH = 4 FEET HORIZONTAL
 1 INCH = 4 FEET VERTICAL



DESIGN DESIGNATION

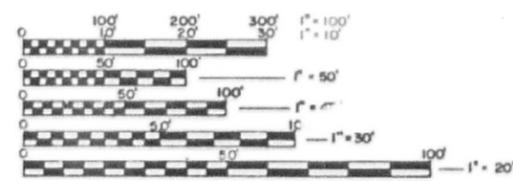

FULL SIZE PLANS HAVE BEEN PREPARED USING STANDARD ENGINEERING SCALES, REDUCED SIZED PLANS WILL NOT CONFORM TO STANDARD SCALES, IN MAKING MEASUREMENTS ON REDUCED PLANS, THE ABOVE SCALES MAY BE USED.

CONTRACT NO. **80065**



END STA 183+67.00
 STA EQ 183+87.10 (BK) + STA 183+13.36 (AH.)
 STA EQ 165+08.650 (BK) + STA 164+94.890 (AH.)
 STA EQ 122+01.688 (BK) + STA 123+47.028 (AH.)
 STA EQ 103+85.412 (BK) + STA 103+85.570 (AH.)
 BEGIN STA 63+20.000

NET LENGTH = 11,934 FT. = 2.260 MILES
 GROSS LENGTH = 11,934 FT. = 2.260 MILES

SHEET E1 OF 88

STATE OF ILLINOIS
 DEPARTMENT OF TRANSPORTATION
 DIVISION OF HIGHWAYS

SUBMITTED _____
 EXAMINED _____
 PASSED _____
 APPROVED _____

DEPARTMENT OF TRANSPORTATION
 FEDERAL HIGHWAY ADMINISTRATION

DIVISION ENGINEER _____ DATE _____

COUNTY COOK SECTION 1985-077 R ROUTE 90/94 (DAN RYAN EXPRESSWAY)

FILE NAME: D:\V\AECOM-NA-AWS1\...
 CONSULTANT SECTION ENGINEER: K. HENNSTREET / J. KOS 318 705-4188



USER NAME = charles.pigozzi	DESIGNED - JJS, WM	REVISED -
PLOT SCALE = N.T.S	CHECKED - MAI, JMG	REVISED -
PLOT DATE = 1/24/2020	DRAWN - JJS, WM	REVISED -
	CHECKED - MAI, JMG	REVISED -

STATE OF ILLINOIS
 DEPARTMENT OF TRANSPORTATION

EXISTING RECORD DRAWINGS
 STRUCTURE NO. 016-1113

SHEET NO. SS67 OF SS129 SHEETS

F.A.I. RTE.	SECTION	COUNTY	TOTAL SHEETS	SHEET NO.
90/94/290	2015-019R	COOK	2155	1017
CONTRACT NO. 62A76				
ILLINOIS FED. AID PROJECT				

FOR INFORMATION ONLY

FEDERAL AID ROUTE NO.	SECTION	COUNTY	TOTAL SHEETS	SHEET NO.
90/94		COOK	88	2
STA.	TO STA.			
FED. RD. DIST. NO.	ILLINOIS	FED. AID PROJECT		
	1985-077 B-R			

GENERAL NOTES

PLAN DIMENSIONS AND DETAILS RELATIVE TO EXISTING STRUCTURE WERE OBTAINED FROM EXISTING PLANS AND ARE SUBJECT TO NOMINAL CONSTRUCTION VARIATIONS. IT SHALL BE THE CONTRACTOR'S RESPONSIBILITY TO VERIFY SUCH DIMENSIONS AND DETAILS IN THE FIELD AND MAKE NECESSARY APPROVED ADJUSTMENTS PRIOR TO CONSTRUCTION OR ORDERING OF MATERIALS. SUCH VARIATION SHALL NOT BE CAUSE FOR ADDITIONAL COMPENSATION FOR A CHANGE IN THE SCOPE OF WORK. HOWEVER, THE CONTRACTOR WILL BE PAID FOR THE QUANTITY ACTUALLY FURNISHED AT THE UNIT PRICE BID FOR THE WORK.

CALCULATED WEIGHT OF STRUCTURAL STEEL = 830840 LBS. (TO BE ERECTED)
THE MAIN LOAD CARRYING MEMBER COMPONENTS SUBJECT TO TENSILE STRESSES SHALL CONFORM TO THE SUPPLEMENTAL REQUIREMENTS FOR NOTCH TOUGHNESS ESR-2. THESE COMPONENTS INCLUDE TENSION FLANGES AND WEBS OF PLATE GIRDERS, WIDE FLANGE BEAMS AND ALL SPL. PLATES MATERIAL OF THE WELDED PLATE GIRDERS AND ARE DESIGNATED ON THE PLANS BY "N.T.R.".

REINFORCEMENT BARS SHALL CONFORM TO THE REQUIREMENTS OF AASHTO M-31, M-42 OR M-53 GRADE 60.

REINFORCEMENT BARS NOTED (E) SHALL BE EPOXY COATED.

REINFORCEMENT BARS NOTED THUSLY 44 X 3 - #5 ETC. INDICATES 44 LINES OF BARS WITH 3 LENGTHS PER LINE.

FIELD WELDING OF CONSTRUCTION ACCESSORIES WILL NOT BE PERMITTED TO THE BOTTOM FLANGE OF BEAMS OR GIRDERS NOR TO THE TOP FLANGE FOR A DISTANCE EQUAL TO ONE-FOURTH THE SPAN LENGTH EACH WAY FROM THE PIER SUPPORTS. FIELD WELDING IN OTHER AREAS WILL BE PERMITTED ONLY WHEN APPROVED BY THE ENGINEER.

ANCHOR BOLTS SHALL BE SET BEFORE INSTALLING DIAPHRAGMS OR CROSS FRAMES OVER SUPPORTS.

FASTENERS SHALL CONFORM TO THE REQUIREMENT OF AASHTO M164. ALL FASTENERS SHALL BE 7/8" DIAMETER UNLESS OTHERWISE NOTED WITH 15/16" DIAMETER BOLT HOLES. BOLT HOLES SHALL BE DRILLED 1-1/16" DIAMETER FOR 7/8" DIAMETER BOLTS AT CROSS FRAME CONNECTIONS. DIAPHRAGMS SHALL BE CONNECTED WITH 3/4" DIAMETER BOLTS AND BOLT HOLES SHALL BE PREDRILLED TO 15/16" DIAMETER. HARDENED WASHERS SHALL BE USED FOR ALL CROSS FRAME AND DIAPHRAGM CONNECTIONS.

EXPANSION BOLTS SHALL CONSIST OF APPROVED EXPANSION ANCHORS, PROVIDING MINIMUM CERTIFIED PROOF LOAD = 4,000 LBS., AND 3/4" DIAMETER X 12" HOOKED BOLTS.

ROADWAY EXPANSION GUARDS SHALL BE ASSEMBLED IN THE PROPER POSITION WITH THE ENDS IN PLACE AND SHALL BE LEFT ASSEMBLED FOR SHOP INSPECTION.

THE ROADWAY EXPANSION PLATES SHALL BE FLAME CUT AS PROVIDED IN ARTICLE 507.04(1) OF THE STANDARD SPECIFICATIONS.

BEARING SEAT SURFACES SHALL BE CONSTRUCTED OR ADJUSTED TO THE DESIGNATED ELEVATIONS WITHIN A TOLERANCE OF 1/8 INCH. ADJUSTMENT SHALL BE MADE EITHER BY GRINDING THE SURFACE OR BY SHIMMING THE BEARINGS. TWO 1/8" ADJUSTING SHIMS, OF THE DIMENSIONS OF THE BOTTOM BEARING PLATE, SHALL BE PROVIDED FOR EACH BEARING IN ADDITION TO ALL OTHER PLATES OR SHIMS. (FOR TYPE I ELASTOMERIC BEARINGS, SHIMS OF THE DIMENSIONS OF TOP PLATE BE PROVIDED AND PLACED AS DETAILED).

STUD SHEAR CONNECTORS

STUD SHEAR CONNECTORS SHALL CONFORM TO THE REQUIREMENTS OF AASHTO M169 COLD DRAWN BARS, GRADES 1015, 1018 OR 1020 EITHER SEMI-OR FULLY-KILLED, GRANULAR OR SOLID FLUX FILLED BEADED STUDS AUTOMATICALLY END WELDED. STUD SHEAR CONNECTORS SHALL BE INSTALLED IN ACCORDANCE WITH ARTICLE 507.08(m). MATERIAL SHALL CONFORM TO ARTICLE 710.38 OF STD. SPECS. NOTES FOR NEW CONCRETE PIERS

A) THE CONTRACTOR SHALL SPACE REINFORCEMENT BARS IN PIER CAP TO MISS ANCHOR BOLTS.

B) ALL EXPOSED EDGES TO HAVE STANDARD 3/4 INCH CHAMFERS, EXCEPT NOTED OTHERWISE.

FIELD CLEANING AND PAINTING

- EXISTING STRUCTURAL STEEL SURFACES IN CONTACT WITH NEW STRUCTURAL STEEL SHALL BE FIELD CLEANED IN ACCORDANCE WITH ARTICLE 509.06(b) METHOD III. SURFACES BLAST CLEANED TO RECEIVE NEW STRUCTURAL STEEL SHALL BE PAINTED WITH ONE COAT LEAD AND CHROMATE FREE ALKYLID PAINT PRIMER. CONTACT SURFACES SHALL NOT BE PAINTED.
- EXISTING TOP FLANGE SURFACES IN CONTACT WITH NEW CONCRETE SHALL BE CLEANED IN ACCORDANCE WITH ARTICLE 509.06(b), METHOD III.
- SURFACES TO RECEIVE STUD SHEAR CONNECTORS SHALL BE CLEANED IN ACCORDANCE WITH ARTICLE 509.06(b), METHOD II AND ARTICLE 507.08(m)(2).
- NEW STRUCTURAL STEEL SHALL BE FIELD SPOT PAINTED WITH ZINC SILICATE PRIMER APPLIED ON HEADS OF FIELD BOLTS, FIELD WELDS, AND ALL AREAS WHERE PAINT HAS BEEN REMOVED OR DAMAGED.

TOTAL BILL OF MATERIALS

ITEM	UNIT	TOTAL
* MECHANICAL SPLICERS	EACH	556
* CONCRETE REMOVAL	CU. YD.	1079.3
* CONCRETE REMOVAL (SPECIAL)	CU. YD.	134
* EXPANSION BOLTS - 3/4 INCH DIAMETER	EACH	6
* REMOVAL OF EXISTING CONCRETE DECK	L. SUM	.151
* STRUCTURE EXCAVATION	CU. YD.	215
PREFORMED JOINT SEAL - 2 1/2 INCHES	LIN. FT.	209
PREFORMED JOINT SEAL - 4 INCHES	LIN. FT.	117
* NEOPRENE EXPANSION JOINT - 2 INCHES	LIN. FT.	79
* NEOPRENE EXPANSION JOINT - 2 1/2 INCHES	LIN. FT.	281
* NEOPRENE EXPANSION JOINT - 4 INCHES	LIN. FT.	102
** PROTECTIVE COAT	SQ. YD.	2560
* CLASS "X" CONCRETE	CU. YD.	1427.1
* CLASS "X" CONCRETE (SUPERSTRUCTURE)	CU. YD.	4608.7
* ERECTING STRUCTURAL STEEL	L. SUM	.161
STUD SHEAR CONNECTORS	EACH	55300
* STRUCTURAL STEEL REMOVAL	L. SUM	.09
* REINFORCEMENT BARS (EPOXY COATED)	POUND	1567410
* PROTECTIVE SHIELD	SQ. YD.	16040
* REINFORCED NEOPRENE EXPANSION JOINT TREATMENT	LIN. FT.	136
* DOWNSPOUT DRAINAGE SYSTEM	LIN. FT.	670
EPOXY CRACK SEALING	LIN. FT.	31
* FIELD DRILLING 1/2 HOLES IN EXISTING GIRDER WEBS	EACH	20
* PROTECTIVE SURFACE TREATMENT	SQ. FT.	74140
* FORMED CONCRETE REPAIR (DEPTH < 5 INCHES)	SQ. FT.	1844
* NAME PLATE	EACH	1
* RELOCATING EXISTING STEEL STRINGERS	POUND	33780
* FATIGUE RETROFIT TYPE I REPAIR	POUND	504
* FATIGUE RETROFIT TYPE II REPAIR	POUND	135
* INSTALLING BRIDGE SCUPPERS	EACH	17
* TEMPORARY SUPPORT SYSTEM (HEIGHT < 30 FT.)	EACH	0
* * * * * (HEIGHT > 30 FT.)	EACH	11
* STRUCT FIELD INSPECTION - TYPE I CONN	EACH	14
TEMPORARY STRUCTURAL STEEL SUPPORT TOWERS	POUND	223,650
* DRILL AND GROUT #9 COL. BARS	EACH	25
* DRILL AND GROUT #11 COL. BARS	EACH	15
* REMOVAL OF EXISTING FOUNDATION	CU. YD.	18
* FORMED CONCRETE REPAIR (DEPTH > 5 INCHES)	SQ. FT.	2766

** QUANTITY DOES NOT INCLUDE BRIDGE DECK SURFACE
* SPECIAL PROVISIONS
NOTE: FINGER JOINTS INCLUDED IN * ERECTING STRUCTURAL STEEL *

** See sheet 74 & 75 in Volume 13 for details

LOAD FOR TEMPORARY SUPPORT		
PIER NO.	D.L. REACTION S.BRG. LINE	D.L. REACTION N.BRG. LINE
1		116 K
3	87 K	87 K
4	11 K	11 K
7	105 K	115 K
8	115 K	126 K
C3	72 K	76 K
C4	77 K	99 K
C6	151 K	53 K
C7	53 K	19 K
C8	65 K	-
C10	19 K	24 K
C13	24 K	-

NOTE:

D.L. REACTION INCLUDES WEIGHT OF STEEL BEAM ONLY.

STATION
BUILT 198 BY
STATE OF ILLINOIS
F.A. PROJ. ID# AC3R943(270)
LOADING HS 20
STR. NO. 016-1113

NAME PLATE
(See Std. 2113)

SHEET NO.

- 1
- 2
- 3
- 4
- 5 - 16
- 17 - 18
- 19 - 20
- 21 - 27
- 28 - 35
- 36
- 37 - 38
- 39 - 55
- 56 - 74
- 75
- 76 - 78
- 79 - 88

INDEX

SHEET NO.	TITLE SHEET
E1	GENERAL NOTE, INDEX AND BILL OF MATERIAL
E2	GENERAL PLAN
E3	PIER REMOVAL PLAN
E4	PIER REPLACEMENT DETAILS
E5 - E16	PIER BAR SCHEDULE
E17 - E18	STRESS TABLE
E19 - E20	FRAMING PLANS
E21 - E27	STRUCTURAL STEEL DETAILS
E28 - E35	FATIGUE RETROFIT REPAIR DETAIL
E36	TRANSVERSE DECK JOINT ELEVATION
E37 - E38	TOP OF SLAB ELEVATIONS
E39 - E55	DECK PLAN, TYPICAL SECTION & PARAPET DETAILS
E56 - E74	CONCRETE INTEGRAL DIAPHRAGM DETAILS
E75	DECK BAR SCHEDULE
E76 - E78	SUBSTRUCTURE WIDENING REHABILITATION & REPLACEMENT
E79 - E88	

SHEET E2 OF 88

REVISIONS	
Name	Date

STATE OF ILLINOIS
DEPARTMENT OF TRANSPORTATION
F.A.I. ROUTE 90/94 (DAN RYAN EXPRESSWAY)
SECTION 1985-077-B-R-COOK COUNTY
N.B. MAINLINE RECONSTRUCTION
STRUCTURE 016-1113
GENERAL NOTE, INDEX AND BILL OF MATERIAL
Scale: NONE
Date: AUGUST, 1988
Drawn By: J.R.
Checked By: M.M.
ENVIRODYNE ENGINEERS INC.
Chicago, Illinois

12-1-88



USER NAME =	charles.pigozzi	DESIGNED -	JJS, WM	REVISED -	
PLOT SCALE =	N.T.S	CHECKED -	MAI, JMG	REVISED -	
PLOT DATE =	1/24/2020	DRAWN -	JJS, WM	REVISED -	
		CHECKED -	MAI, JMG	REVISED -	

STATE OF ILLINOIS
DEPARTMENT OF TRANSPORTATION

EXISTING RECORD DRAWINGS
STRCUTURE NO. 016-1113

F.A.I. RTE.	SECTION	COUNTY	TOTAL SHEETS	SHEET NO.
90/94/290	2015-019R	COOK	2155	1018
CONTRACT NO. 62A76				

SHEET NO. SS68 OF SS129 SHEETS

ILLINOIS FED. AID PROJECT

FILE NAME: D:\VAE\COM-NA-AW51\ecomonline\local\AECOM_D502_NAVDocuments\01_Americas\Transportation\620269938_Circle\Phase_I\0000_CAD\008_Structural\Sign_Structure\62A76_Sign_Structure\62A76-Cont-55208-SignStruct.dgn


FOR INFORMATION ONLY

FEDERAL AID ROUTE NO.	SECTION	COUNTY	TOTAL SHEETS	SHEET NO.
90/94	*	COOK	88	3
TO BE				
FED. AID DIST. NO.	ALIGNED	FED. AID PROJECT		

* 1985-077-B-R

Bench Mark:
7 BM #49 North NE Flange bolt on hydrant on NW corner of 21st St. and Emerald St. Elev. 13.59.

EXISTING STRUCTURE
Structure No. 016-1113 is part of the Dan Ryan Expressway Viaduct. The superstructure is series of simple and continuous spans welded plate girders. The substructure consists of multiple column concrete piers supported on concrete caissons. The structure was built in 1961 and opened to traffic in 1962. The entire Deck (Ramps & Mainline) will be removed as Part of this Contract.

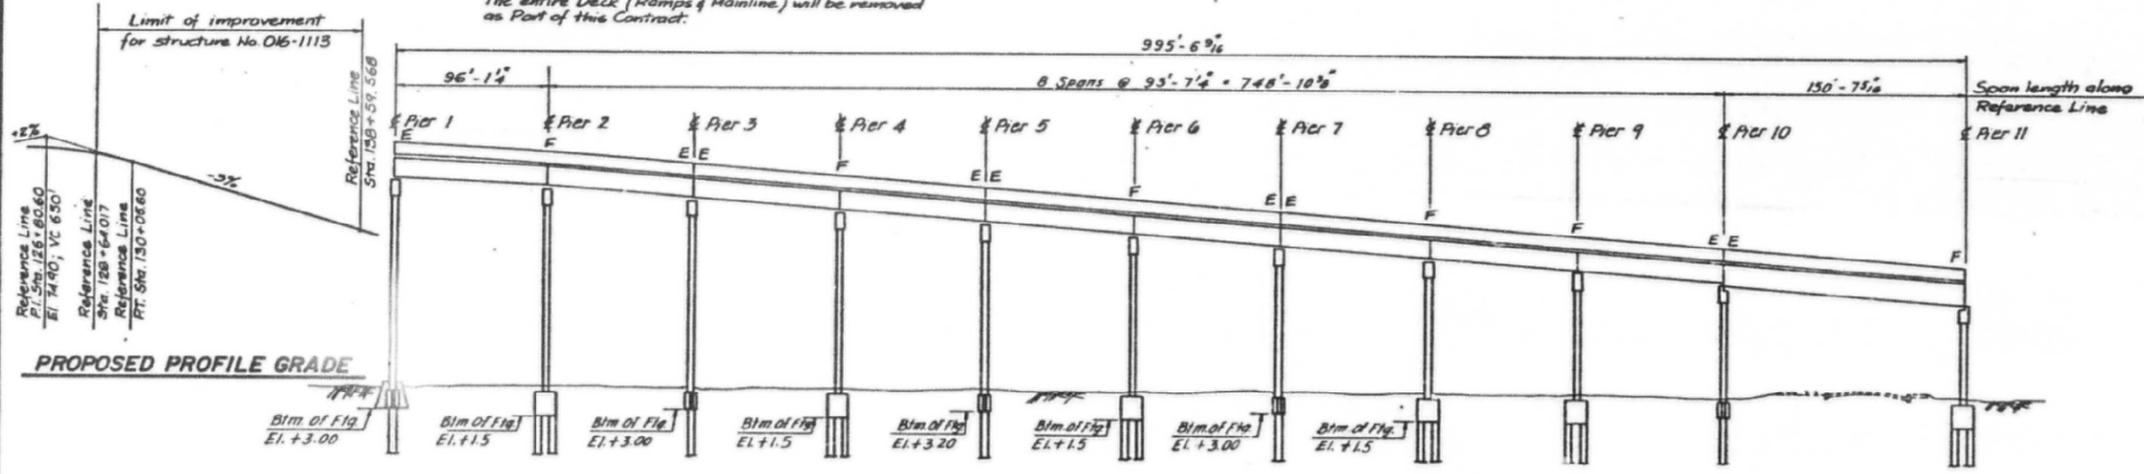

DESIGN STRESSES



New Construction
 Fc = 3500 PSI
 Ft = 1400 PSI
 Fy = 60,000 PSI
 Fv = 20,000 PSI
 Str. Steel (A-183)
 Working Stress Design Method
 Allowable Bearing Pressure on Rock = 60 Tons/Sq. Ft.

Existing Construction
 Fc = 3500 PSI
 Ft = 1,400 PSI W/O Earth Pressure
 Ft = 1,000 PSI W/Earth Pressure
 Fv = 75 PSI Max. Shear in Footings
 Fc = 18,000 PSI (Str. Steel)
 Bedrock Bearing for Drilled Caisson = 60 Tons/Sq. Ft.
 Fy = 40,000 PSI (Reinforcement)

Loading HS 20-44 and All
 Design Specification: AASHTO (1983) and Interims 1984 thru 1987

LEGEND

- Indicates existing Soil Borings, SRS
- Proposed pier Widening, not part of this Contract.

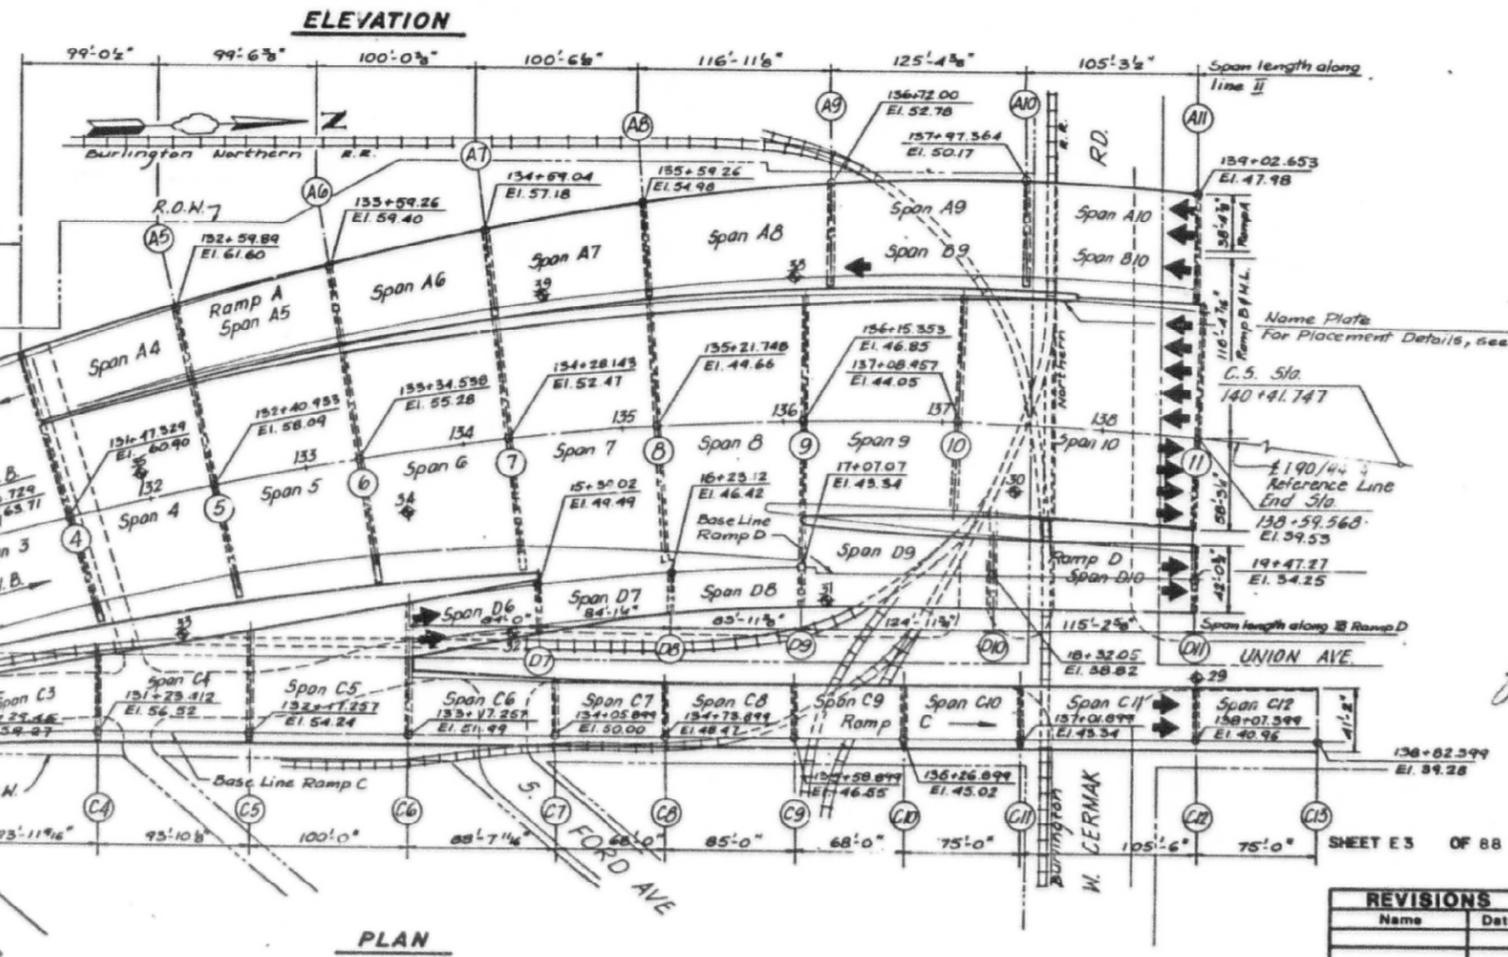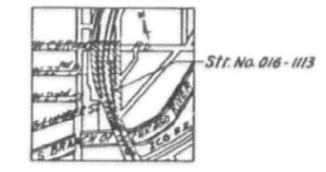

APPROVED
 EDR STRUCTURE - ADEQUACY ONLY
 James J. [Signature]
 Engineer

Elevations are Profile Grade Line elevations.

REVISIONS	
Name	Date

STATE OF ILLINOIS
 DEPARTMENT OF TRANSPORTATION
 E.A.I. ROUTE 90/94 (DAN RYAN EXPRESSWAY)
 SECTION 1985-077 B-R-COOK COUNTY
 N.B. MAINLINE RECONSTRUCTION
 STRUCTURE 016-1113
 GENERAL PLAN

Scale: NONE
 Date: AUGUST, 1988
 Drawn By: J.R.
 Checked By: J.M./T.
 ENHYRODYNE ENGINEERS INC.
 Chicago, Illinois

FILE NAME: D:\V\AE\COM-NA-AW51... Documents\01_NAV\Documents\01_Americas\Transportation\60269938_Circle\Phase_I\0000_CAD\008_Structures\016-1113_Sign_Structure\62A76-Cant-55208-SignStructure.dgn



USER NAME =	charles.pigozzi	DESIGNED -	JJS, WM	REVISED -	
		CHECKED -	MAI, JMG	REVISED -	
PLOT SCALE =	N.T.S	DRAWN -	JJS, WM	REVISED -	
PLOT DATE =	1/24/2020	CHECKED -	MAI, JMG	REVISED -	

STATE OF ILLINOIS
 DEPARTMENT OF TRANSPORTATION


EXISTING RECORD DRAWINGS
 STRUCTURE NO. 016-1113

SHEET NO. SS69 OF SS129 SHEETS

F.A.I. RTE.	SECTION	COUNTY	TOTAL SHEETS	SHEET NO.
90/94/290	2015-019R	COOK	2155	1019
CONTRACT NO. 62A76				
ILLINOIS FED. AID PROJECT				

FOR INFORMATION ONLY

FEDERAL AID ROUTE NO.	SECTION	COUNTY	TOTAL SHEETS	SHEET NO.
90/94	8	COOK	88	4
STA.	TO STA.			
FED. RD. DIST. NO.	ILLINOIS	FED. AID PROJECT		
# 985-077 B-R				

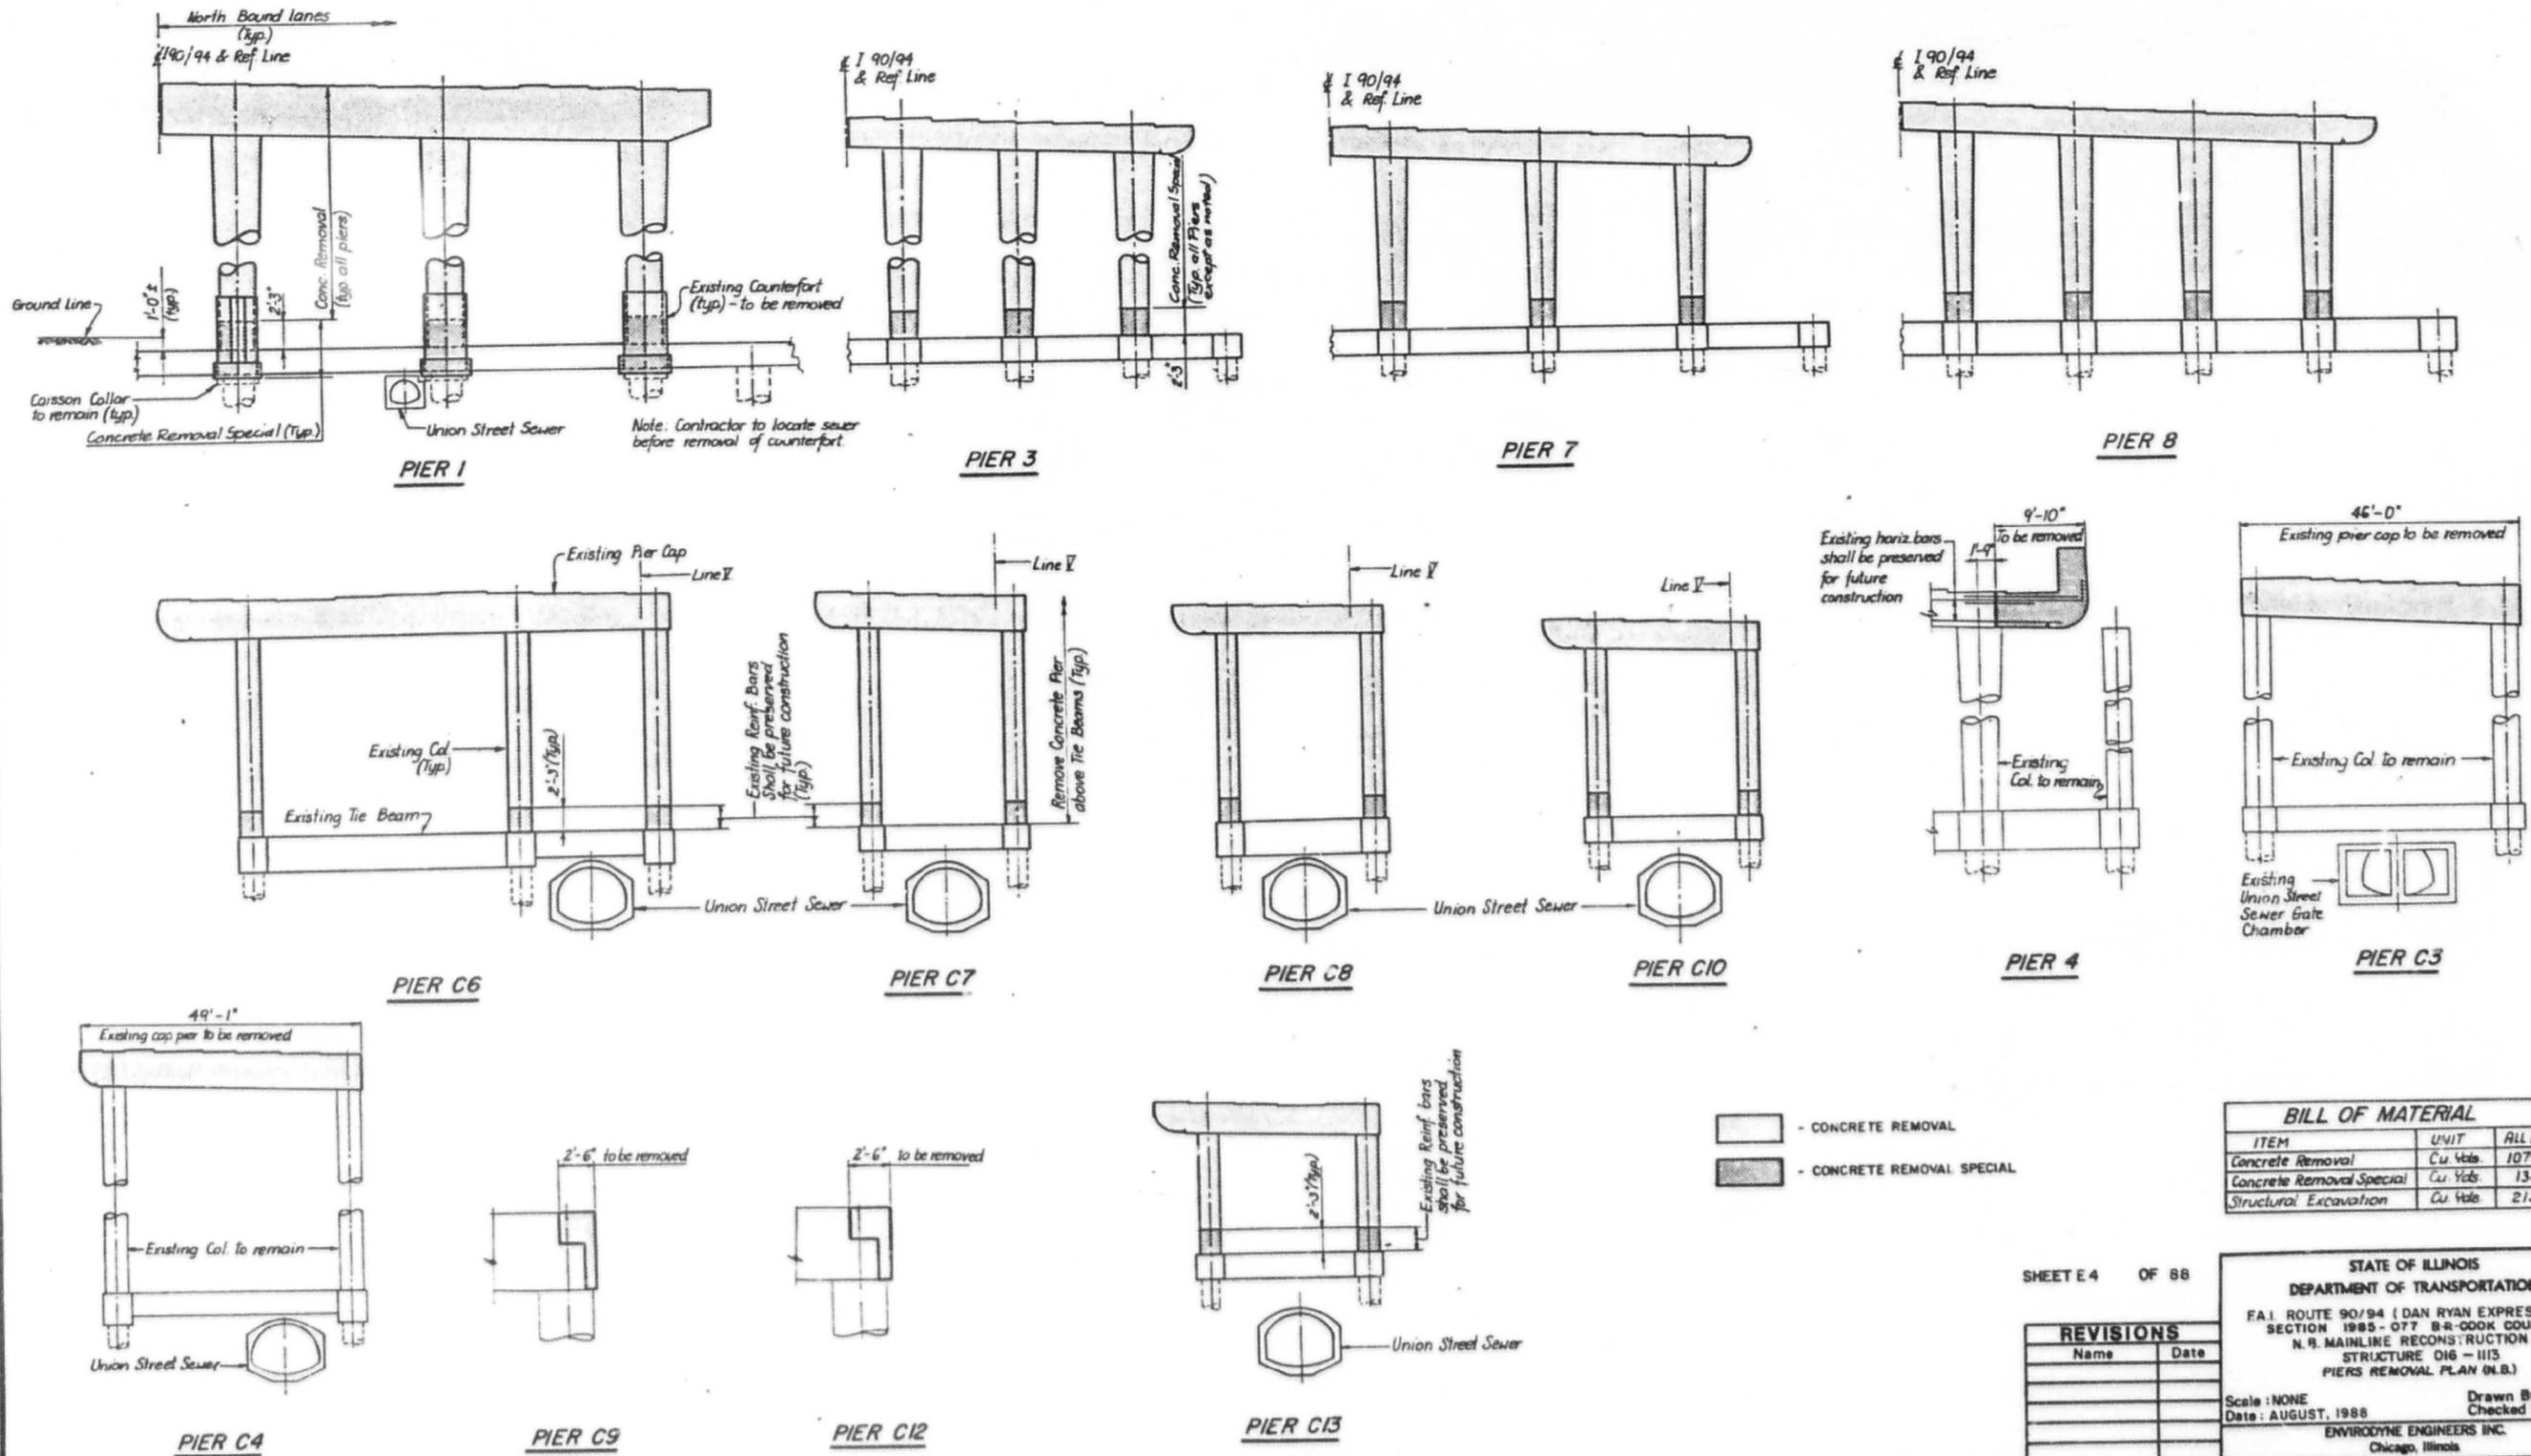

BILL OF MATERIAL		
ITEM	UNIT	ALL PIERS
Concrete Removal	Cu Yds	1079.3
Concrete Removal Special	Cu Yds	134.0
Structural Excavation	Cu Yds	213.0

SHEET E 4 OF 88

REVISIONS	
Name	Date

STATE OF ILLINOIS
DEPARTMENT OF TRANSPORTATION
F.A.I. ROUTE 90/94 (DAN RYAN EXPRESSWAY)
SECTION 1985-077 B-R-COOK COUNTY
N.R. MAINLINE RECONSTRUCTION
STRUCTURE D16 - 1115
PIERS REMOVAL PLAN (N.B.)

Scale: NONE
Date: AUGUST, 1988
Drawn By: D.M.T.S.
Checked By: M.M.
ENVIRODYNE ENGINEERS INC.
Chicago, Illinois

FILE NAME: D:\V\AECOM\NA-AWS1\recomonline\local\AECOM_ID502_NAVDocuments\01_Americas\Transportation\60269938_Circle\Phase_I\000_CAD\008_Structural\Sign_Structures\62A76-Struc-Structures\62A76-Cant-55208-SignStruct.dgn



USER NAME =	charles.pigozzi	DESIGNED -	JJS, WM	REVISED -	
		CHECKED -	MAI, JMG	REVISED -	
PLOT SCALE =	N.T.S	DRAWN -	JJS, WM	REVISED -	
PLOT DATE =	1/24/2020	CHECKED -	MAI, JMG	REVISED -	


STATE OF ILLINOIS
DEPARTMENT OF TRANSPORTATION

EXISTING RECORD DRAWINGS
STRUCUTRE NO. 016-1113

SHEET NO. SS70 OF SS129 SHEETS

F.A.I. RTE.	SECTION	COUNTY	TOTAL SHEETS	SHEET NO.
90/94/290	2015-019R	COOK	2155	1020
CONTRACT NO. 62A76				
ILLINOIS		FED. AID PROJECT		

FOR INFORMATION ONLY

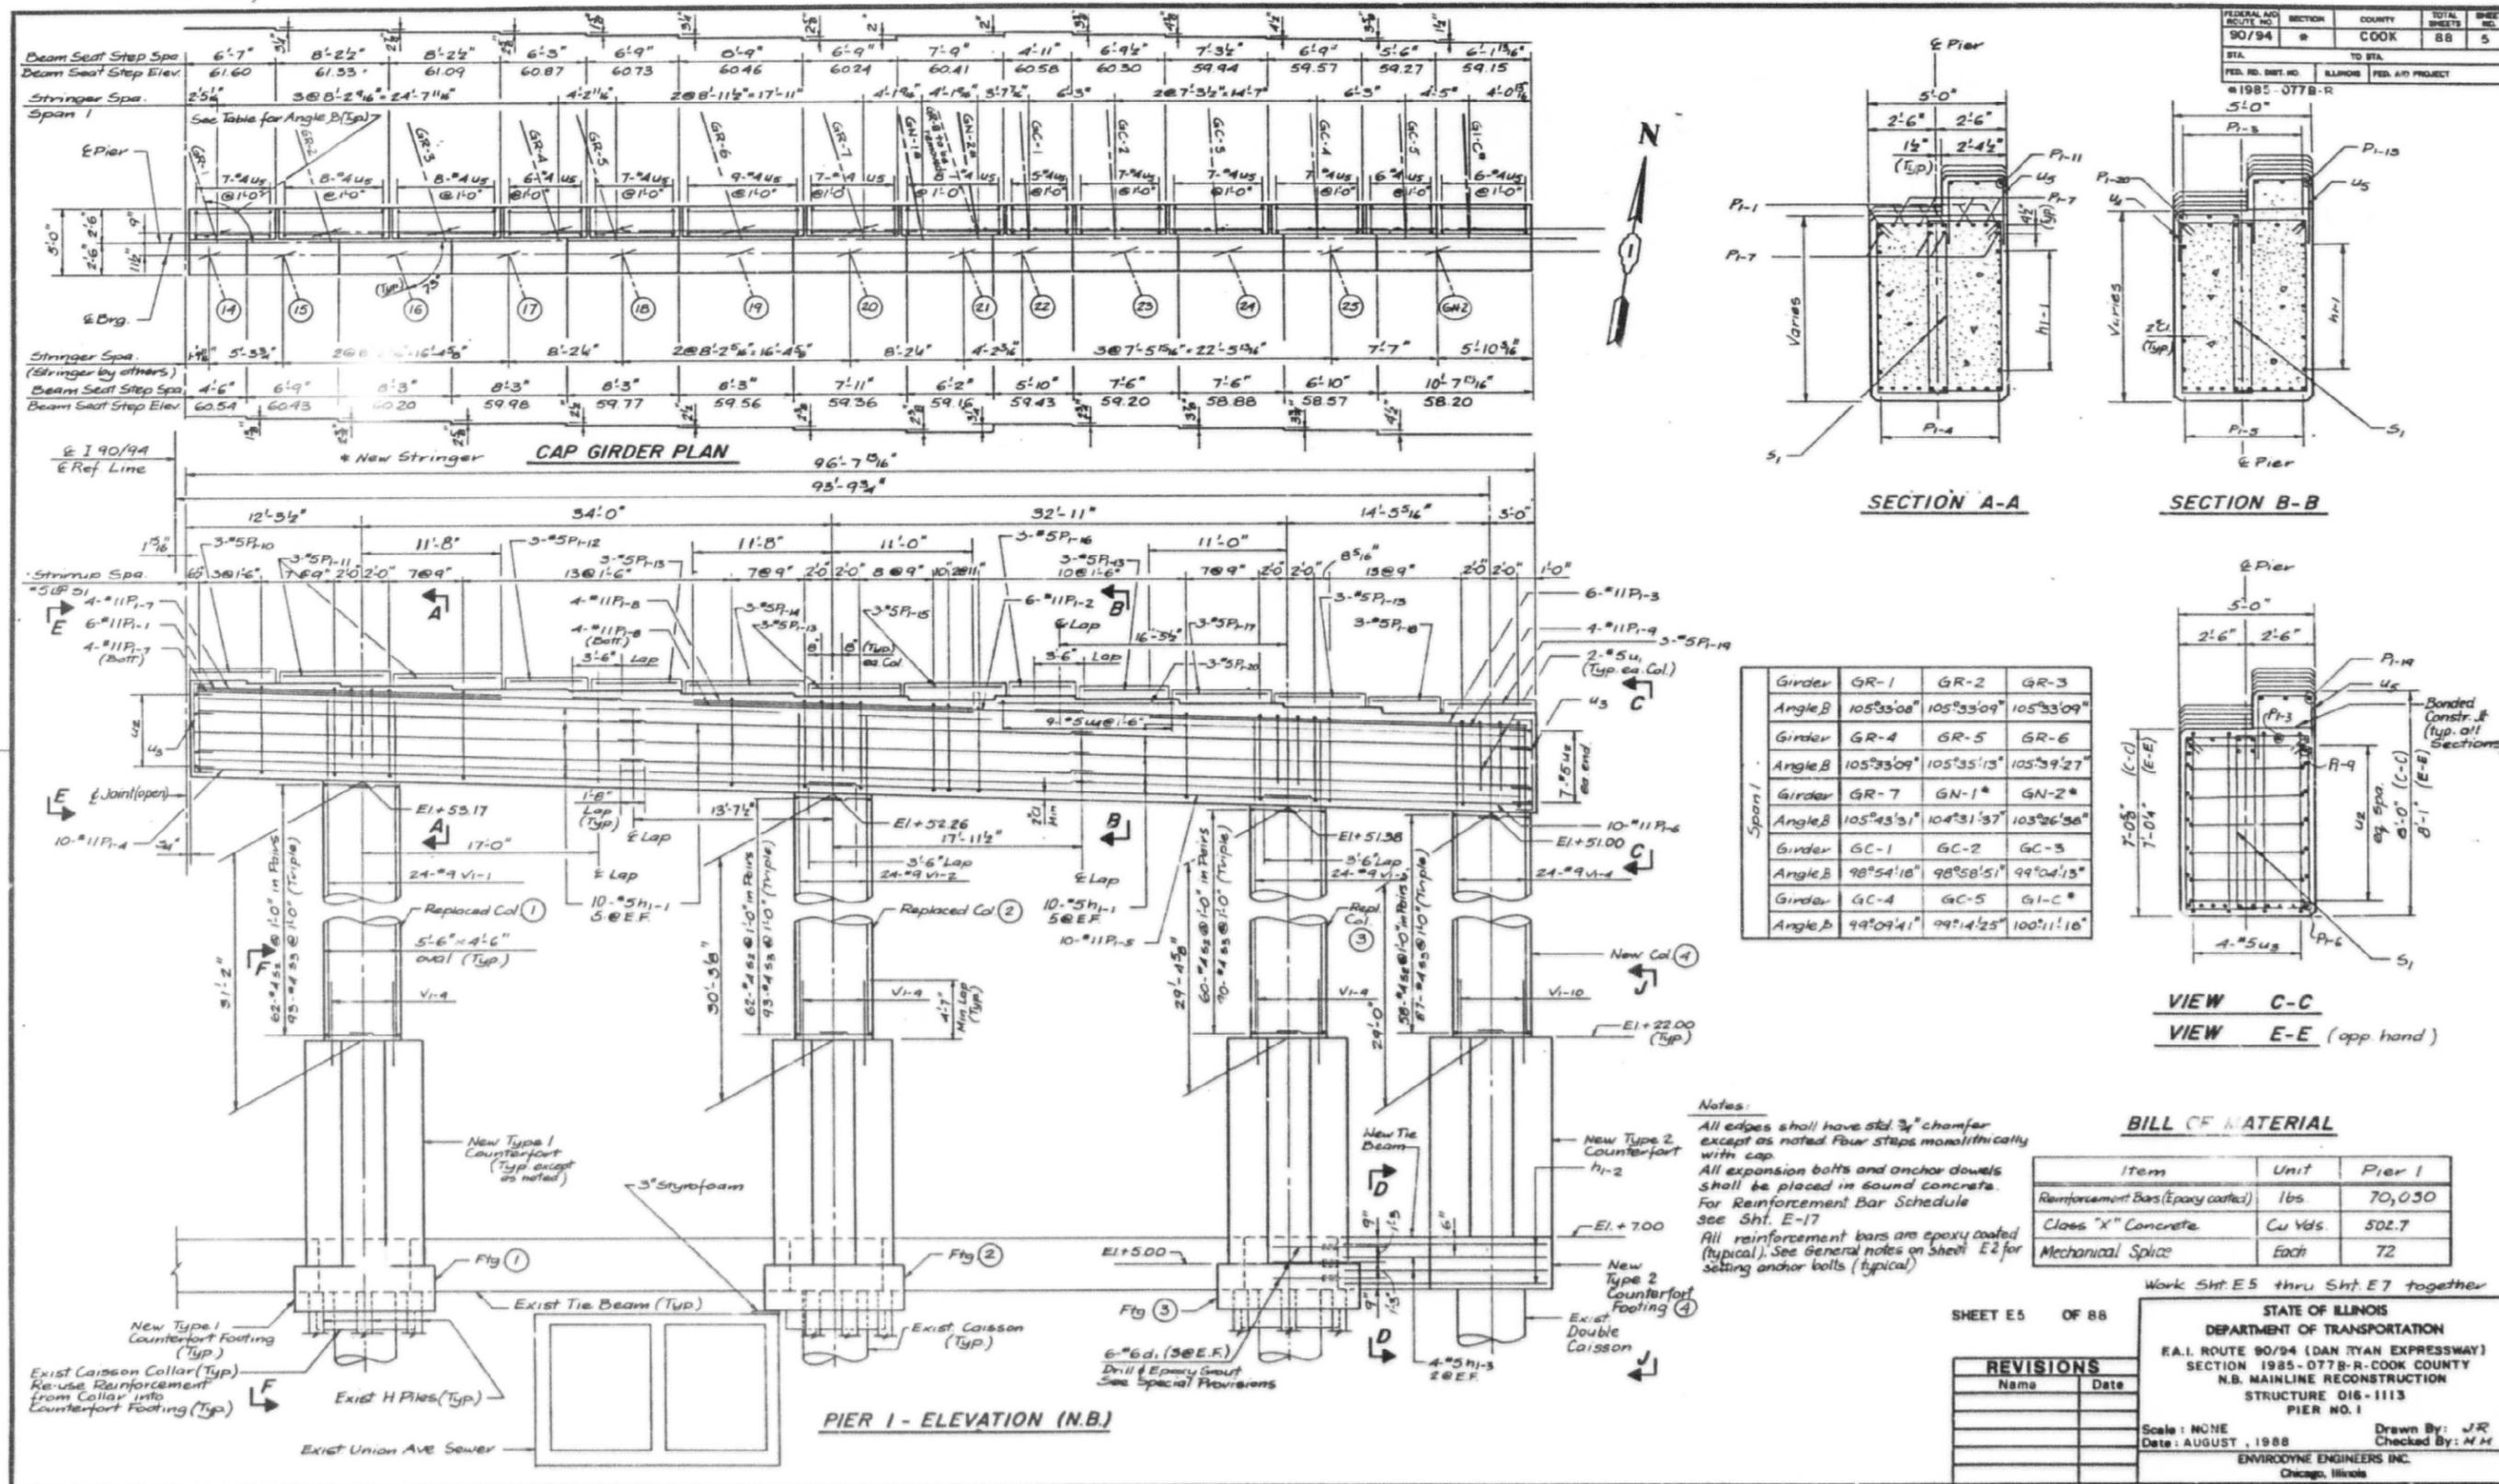

FILE NAME: D:\V\AECOM\NA-AWS1\..._Americas\Transportation\60269938_Circle\Phase_I\0000_CAD\008_Structural\Sign_Structure\62A76-76-Cant-55208-5\SignStruct.dgn



USER NAME =	charles.pigozzi	DESIGNED -	JJS, WM	REVISED -	
CHECKED -	MAI, JMG	REVISIONS -			
PLOT SCALE =	N.T.S	DRAWN -	JJS, WM	REVISED -	
PLOT DATE =	1/24/2020	CHECKED -	MAI, JMG	REVISED -	

STATE OF ILLINOIS
DEPARTMENT OF TRANSPORTATION

EXISTING RECORD DRAWINGS
STRUCURE NO. 016-1113

SHEET NO. SS71 OF SS129 SHEETS

F.A.I. RTE.	SECTION	COUNTY	TOTAL SHEETS	SHEET NO.
90/94/290	2015-019R	COOK	2155	1021
ILLINOIS			FED. AID PROJECT	

Work Sht. E5 thru Sht. E7 together








STATE OF ILLINOIS
DEPARTMENT OF TRANSPORTATION
E.A.I. ROUTE 90/94 (DAN RYAN EXPRESSWAY)
SECTION 1985-0778-R-COOK COUNTY
N.B. MAINLINE RECONSTRUCTION
STRUCTURE 016-1113
PIER NO. 1

Scale: NONE
Date: AUGUST, 1988
Drawn By: JJR
Checked By: MM

ENVIRODYNE ENGINEERS INC.
Chicago, Illinois

FOR INFORMATION ONLY

FEDERAL AID ROUTE NO.	SECTION	COUNTY	TOTAL SHEETS	SHEET NO.
90/94	*	COOK	88	9
STA.	TO STA.			
FED. HD. DIST. NO.	ILLINOIS	FED. AID PROJECT		
* 1985-077 B-R				

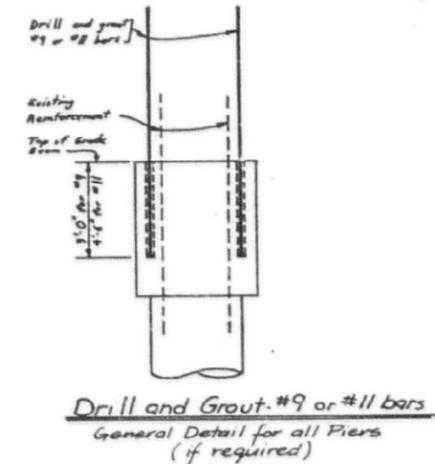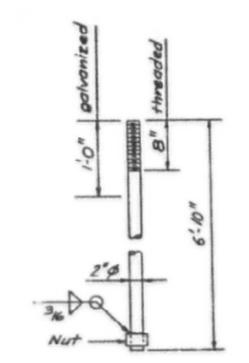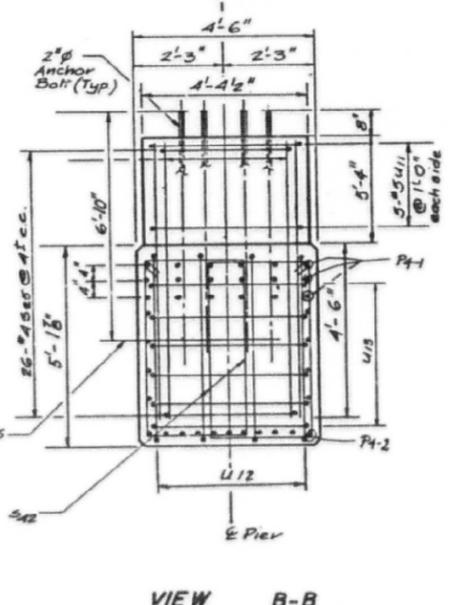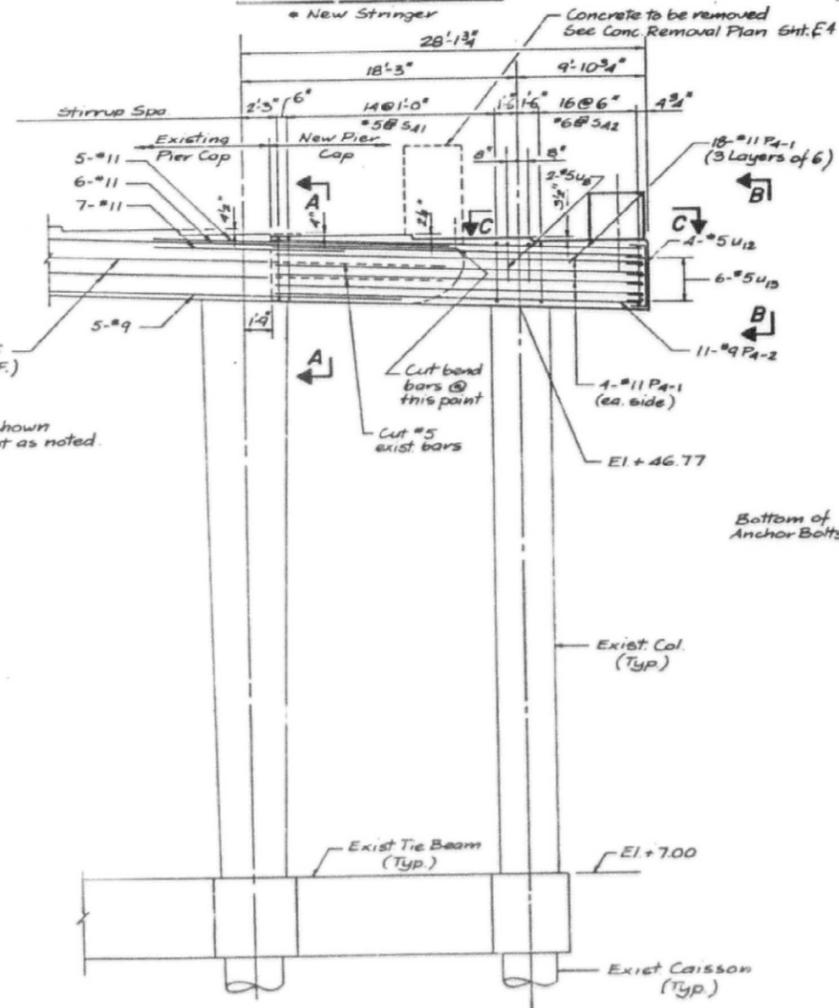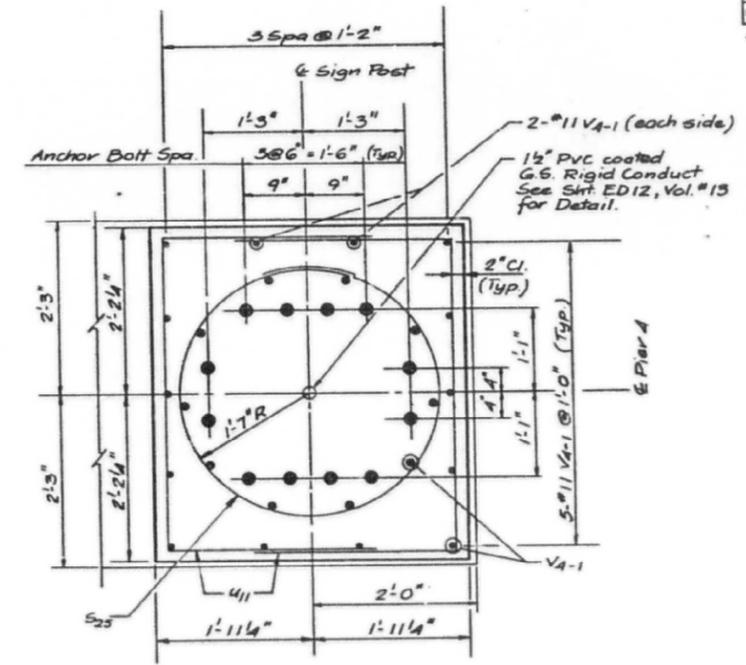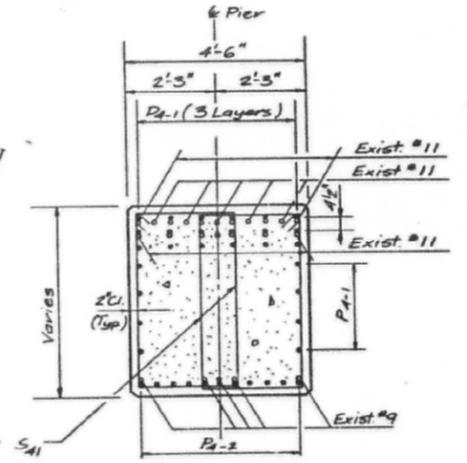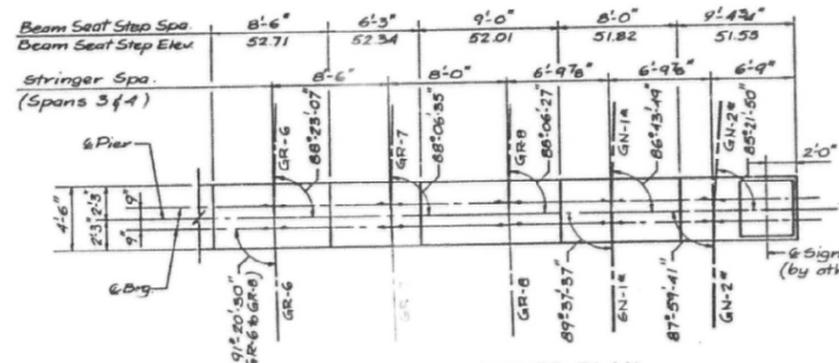

BILL OF MATERIAL

Item	Unit	Pier 4
Reinforcement Bars (Epoxy coated)	lbs	6480
Class "X" Concrete	Cu Yds.	22.6

SHEET E9 OF 88

REVISIONS	
Name	Date

See SHT. E5 for Notes

STATE OF ILLINOIS
 DEPARTMENT OF TRANSPORTATION
 F.A.I. ROUTE 90/94 (DAN RYAN EXPRESSWAY)
 SECTION 1985-077 B-R-COOK COUNTY
 N.B. MAINLINE RECONSTRUCTION
 STRUCTURE 016-1115
 PIER NO. 4

Scale: NONE
 Date: AUGUST, 1988
 ENVIRODYNE ENGINEERS INC.
 Chicago, Illinois

Drawn By: J.R.
 Checked By: M.M.

FILE NAME: D:\V\AE\COM-NA-AWS1\ecomonline\local\AE\COM_DS02_NAVDocuments\01_Americas\Transportation\60269938_Circle\Phase_II\000_CAD\008_Structural\Sign_Structure\62A76_Sign_Structure\62A76-Cant-S5208-SignStruct.dgn



USER NAME =	charles.pigozzi	DESIGNED -	JJS, WM	REVISED -	
PLOT SCALE =	N.T.S	CHECKED -	MAI, JMG	REVISED -	
PLOT DATE =	1/24/2020	DRAWN -	JJS, WM	REVISED -	
		CHECKED -	MAI, JMG	REVISED -	

STATE OF ILLINOIS
 DEPARTMENT OF TRANSPORTATION

EXISTING RECORD DRAWINGS
 STRCUTURE NO. 016-1113

SHEET NO. SS72 OF SS129 SHEETS

F.A.I. RTE.	SECTION	COUNTY	TOTAL SHEETS	SHEET NO.
90/94/290	2015-019R	COOK	2155	1022
CONTRACT NO. 62A76				
ILLINOIS FED. AID PROJECT				


FOR INFORMATION ONLY

REINFORCEMENT BAR SCHEDULE				
STRUCTURE	MARK	NUMBER	SIZE	LENGTH
PIER 1	d1(E)	6	#6	3'-0"
PIER 1	d1-1(E)	36	#11	14'-1"
PIER 1	d1-2(E)	114	#9	9'-0"
PIER 1	d1-3(E)	40	#9	9'-6"
PIER 1	d1-4(E)	12	#11	14'-7"
PIER 1	h1-1(E)	30	#5	33'-4"
PIER 1	h1-2(E)	6	#6	15'-0"
PIER 1	h1-3(E)	4	#5	15'-0"
PIER 1	h1-4(E)	256	#4	4'-10"
PIER 1	h1-5(E)	96	#5	12'-8"
PIER 1	h1-6(E)	32	#5	11'-8"
PIER 1	n1-1(E)	24	#9	8'-5"
PIER 1	p1-1(E)	6	#11	30'-10"
PIER 1	p1-2(E)	6	#11	36'-11"
PIER 1	p1-3(E)	6	#11	35'-6"
PIER 1	p1-4(E)	10	#11	47'-10"
PIER 1	p1-5(E)	10	#11	36'-5"
PIER 1	p1-6(E)	10	#11	19'-0"
PIER 1	p1-7(E)	8	#11	23'-9"
PIER 1	p1-8(E)	8	#11	22'-6"
PIER 1	p1-9(E)	4	#11	28'-3"
PIER 1	p1-10(E)	3	#5	6'-1"
PIER 1	p1-11(E)	6	#5	7'-10"
PIER 1	p1-12(E)	3	#5	5'-11"
PIER 1	p1-13(E)	12	#5	6'-5"
PIER 1	p1-14(E)	3	#5	8'-5"
PIER 1	p1-15(E)	3	#5	7'-5"
PIER 1	p1-16(E)	3	#5	4'-7"
PIER 1	p1-17(E)	3	#5	6'-11"
PIER 1	p1-18(E)	3	#5	5'-2"
PIER 1	p1-19(E)	3	#5	5'-9"
PIER 1	p1-20(E)	3	#5	13'-0"
PIER 1	p1-21(E)	18	#11	19'-8"
PIER 1	p1-22(E)	64	#9	12'-0"
PIER 1	p1-23(E)	54	#7	9'-8"
PIER 1	p1-24(E)	24	#9	21'-0"
PIER 1	p1-25(E)	18	#7	18'-8"
PIER 1	s1(E)	168	#5	19'-9"
PIER 1	s2(E)	306	#4	9'-10"
PIER 1	s3(E)	363	#4	5'-4"
PIER 1	s31(E)	48	#5	18'-11"
PIER 1	s32(E)	128	#5	22'-7"
PIER 1	s33(E)	7	#4	11'-5"
PIER 1	u1(E)	8	#5	17'-8"
PIER 1	u2(E)	14	#5	7'-2"
PIER 1	u3(E)	8	#5	9'-2"
PIER 1	u4(E)	9	#5	4'-8"
PIER 1	u5(E)	98	#4	6'-8"
PIER 1	u23(E)	9	#9	23'-11"
PIER 1	u24(E)	4	#6	26'-2"
PIER 1	v1-1(E)	24	#9	37'-10"
PIER 1	v1-2(E)	24	#9	37'-0"
PIER 1	v1-3(E)	24	#9	36'-3"
PIER 1	v1-4(E)	24	#9	35'-11"
PIER 1	v1-5(E)	12	#9	14'-7"
PIER 1	v1-6(E)	78	#9	16'-10"
PIER 1	v1-7(E)	36	#11	18'-4"
PIER 1	v1-8(E)	34	#9	14'-10"
PIER 1	v1-9(E)	72	#9	17'-4"
PIER 1	v1-10(E)	24	#9	19'-7"
PIER 1	v1-11(E)	12	#11	16'-3"
PIER 1	v1-12(E)	4	#9	4'-7"
PIER 1	v1-13(E)	4	#9	8'-7"
PIER 1	v1-14(E)	4	#9	12'-7"
PIER 1	v1-15(E)	12	#9	6'-7"
PIER 1	v1-16(E)	12	#9	10'-7"
PIER 1	u35(E)	12	#5	12'-4"
PIER 3	h3-1(E)	10	#5	36
PIER 3	h3-2(E)	10	#5	28'-1"
PIER 3	p3-1(E)	6	#11	39'-5"
PIER 3	p3-2(E)	6	#11	29'-0"
PIER 3	p3-3(E)	9	#9	29'-6"
PIER 3	p3-4(E)	9	#9	38'-7"
PIER 3	p3-5(E)	3	#11	15'-4"
PIER 3	p3-6(E)	3	#11	24'-2"
PIER 3	s4(E)	344	#4	8'-1"

REINFORCEMENT BAR SCHEDULE				
STRUCTURE	MARK	NUMBER	SIZE	LENGTH
PIER 3	s5(E)	346	#4	4'-11"
PIER 3	s20(E)	173	#4	6" 0"
PIER 3	s40(E)	102	#5	15'-5"
PIER 3	u2(E)	8	#5	7'-2"
PIER 3	u8(E)	8	#5	11'-2"
PIER 3	u19(E)	10	#5	6'-8"
PIER 3	v3-1(E)	20	#9	47'-4"
PIER 3	v3-2(E)	20	#9	46'-7"
PIER 3	v3-3(E)	20	#9	45'-10"
PIER 3	v3-4(E)	20	#9	45'-3"
PIER 4	p4-1(E)	26	#11	26'-2"
PIER 4	p4-2(E)	11	#9	26'-2"
PIER 4	s25(E)	26	#4	11'-3"
PIER 4	s41(E)	32	#5	15'-5"
PIER 4	s42(E)	34	#6	15'-5"
PIER 4	u12(E)	4	#5	6'-11"
PIER 4	u2(E)	2	#5	11'-2"
PIER 4	u13(E)	6	#5	6'-8"
PIER 4	v4-1(E)	24	#11	8'-9"
PIER 4	u11(E)	10	#5	9'-10"
PIER 7	h7-1(E)	6	#5	49'-6"
PIER 7	h7-2(E)	6	#5	37'-2"
PIER 7	p7-1(E)	6	#11	50'-0"
PIER 7	p7-2(E)	6	#11	38'-6"
PIER 7	p7-3(E)	6	#11	35'-10"
PIER 7	p7-4(E)	10	#11	27'-11"
PIER 7	p7-5(E)	6	#11	28'-3"
PIER 7	p7-6(E)	6	#11	19'-2"
PIER 7	p7-7(E)	6	#11	19'-0"
PIER 7	p7-8(E)	6	#11	36'-0"
PIER 7	p7-9(E)	4	#11	26'-7"
PIER 7	p7-10(E)	4	#11	20'-10"
PIER 7	s6(E)	248	#4	7'-3"
PIER 7	s7(E)	248	#4	4'-5"
PIER 7	s21(E)	124	#4	4'-6"
PIER 7	s24(E)	112	#5	16'-1"
PIER 7	u7(E)	8	#5	10'-8"
PIER 7	u10(E)	8	#5	7'-5"
PIER 7	u16(E)	27	#5	6'-2"
PIER 7	v7-1(E)	20	#11	36'-0"
PIER 7	v7-2(E)	20	#11	35'-0"
PIER 7	v7-3(E)	20	#11	34'-0"
PIER 7	v7-4(E)	20	#9	33'-9"
PIER 7	p7-11(E)	6	#5	11'-9"
PIER 7	p7-12(E)	6	#5	4'-6"
PIER 8	h8-1(E)	6	#5	49'-4"
PIER 8	h8-2(E)	6	#5	46'-0"
PIER 8	p8-1(E)	6	#10	40'-3"
PIER 8	p8-2(E)	6	#10	22'-10"
PIER 8	p8-3(E)	6	#10	37'-0"
PIER 8	p8-4(E)	6	#10	46'-10"
PIER 8	p8-5(E)	6	#10	50'-0"
PIER 8	p8-6(E)	4	#10	19'-2"
PIER 8	p8-7(E)	4	#10	16'-6"
PIER 8	p8-8(E)	6	#5	11'-7"
PIER 8	p8-9(E)	6	#5	3'-5"
PIER 8	s4(E)	278	#4	8'-1"
PIER 8	s5(E)	278	#4	4'-11"
PIER 8	s12(E)	140	#5	15'-0"
PIER 8	s20(E)	24	#4	5'-0"
PIER 8	u8(E)	10	#5	11'-2"
PIER 8	u2(E)	8	#5	6'-11"
PIER 8	u13(E)	26	#5	6'-8"
PIER 8	v8-1(E)	24	#11	32'-8"
PIER 8	v8-2(E)	24	#11	31'-10"
PIER 8	v8-3(E)	24	#11	31'-2"
PIER 8	v8-4(E)	24	#11	30'-3"
PIER 8	v8-5(E)	20	#10	29'-4"
PIER C3	hC3-1(E)	16	#6	16'-0"
PIER C3	pC3-1(E)	8	#9	12'-4"
PIER C3	pC3-2(E)	6	#9	45'-8"
PIER C3	pC3-3(E)	30	#11	45'-8"

BENT BAR DETAILS			
TYPE	MARK	a	b
U	p1-21(E)	1'-7"	16'-6"
U	p1-22(E)	1'-3"	9'-6"
U	p1-24(E)	1'-3"	18'-6"
U	d1-1(E)	1'-7"	12'-6"
U	d1-2(E)	1'-3"	7'-9"
U	d1-3(E)	1'-3"	8'-3"
U	d1-4(E)	1'-7"	13'-0"
O	s25(E)	3'-2"	1'-4"
O	s26(E)	3'-8"	1'-4"
□	s1(E)	6'-8"	2'-9"
□	s12(E)	4'-8"	2'-7 1/2"
□	s17(E)	4'-2"	2'-2"
□	s24(E)	5'-2"	2'-5"
□	s28(E)	6'-9"	2'-8"
□	s31(E)	5'-4"	3'-8"
□	s32(E)	4'-2"	6'-8"
□	s33(E)	3'-8"	1'-8"
□	s34(E)	5'-5"	2'-4"
□	s35(E)	4'-2"	2'-5"
□	s36(E)	4'-5"	2'-3"
□	s37(E)	4'-10"	3'-8"
□	s38(E)	4'-4"	3'-8"
□	s39(E)	5'-9 1/2"	2'-5 1/2"
□	s40(E)	4'-8"	2'-7"
□	s41(E)	4'-5"	2'-7"
□	s42(E)	4'-5"	2'-7"
	h1-4(E)	2'-10"	1'-8"
	h1-5(E)	2'-6"	5'-8"
	h1-6(E)	2'-8"	4'-6"
	u1(E)	4'-8"	6'-6"
	u2(E)	4'-8"	1'-3"
	u3(E)	6'-8"	1'-3"
	u4(E)	2'-2"	1'-3"
	u5(E)	2'-0 1/2"	2'-4"
	u7(E)	3'-8"	3'-6"
	u8(E)	4'-2"	3'-6"
	u10(E)	4'-11"	1'-3"
	u11(E)	4'-2"	2'-10"
	u12(E)	4'-5"	1'-3"
	u13(E)	4'-2"	1'-3"
	u16(E)	3'-8"	1'-3"
	u17(E)	3'-11"	1'-3"
	u23(E)	16'-7"	3'-8"
	u24(E)	16'-8"	4'-9"
	u19(E)	5'-8"	1'-3"
	u27(E)	3'-11"	3'-6"
	u27(E)	1'-8 1/2"	2'-0"
	u28(E)	4'-8"	3'-6"
	u29(E)	5'-9"	1'-3"
	u31(E)	3'-8"	2'-0"
	u33(E)	3'-8"	3'-0"
	u34(E)	6'-9"	1'-3"
	u35(E)	8'-0"	2'-2"
	u30(E)	3'-0"	4'-10"
	u32(E)	4'-0"	4'-4"
	v1-7(E)	17'-4"	1'-0"
	v1-11(E)	15'-3"	1'-0"
	s2(E)	4'-2"	1'-2"
	s4(E)	3'-8"	0'-8"
	s6(E)	3'-2"	0'-6"
	s3(E)	0'-6"	4'-2"
	s5(E)	0'-6"	3'-7"
	s7(E)	0'-6"	3'-1"
	s20(E)	0'-6"	3'-8"
	s21(E)	0'-6"	3'-2"
			0'-11 1/2"
			0'-11 1/2"
			0'-5"
			0'-6"
			0'-6"
			0'-8"
			0'-4"
			0'-10"
			0'-10"
			0'-10"
			0'-3 1/2"
			0'-3 1/2"
			0'-3 1/2"

Note: All bars designated (E) shall be epoxy coated.
Work shls E17 and E18 together.

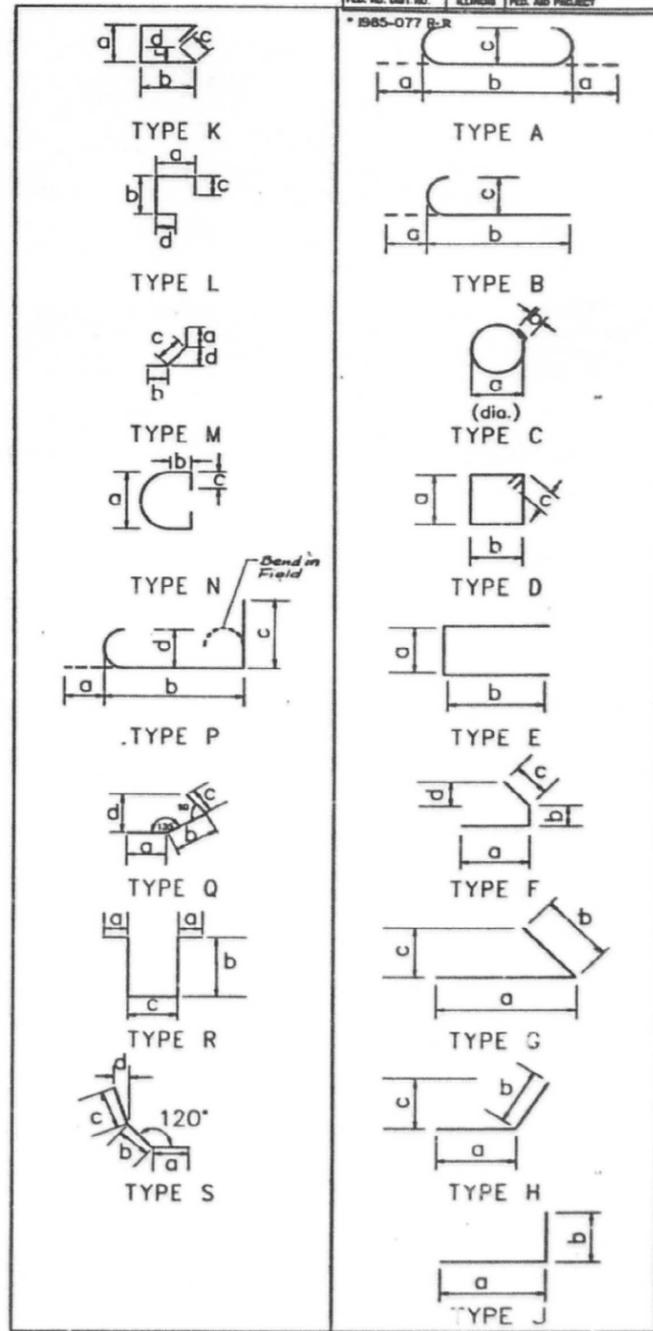

SHEET E17 OF 88

REVISIONS	
Name	Date

STATE OF ILLINOIS
DEPARTMENT OF TRANSPORTATION
F.A.I. ROUTE 90/94 (DAN RYAN EXPRESSWAY)
SECTION 1985-077 BRADCOCK COUNTY
N.B. MAINLINE RECONSTRUCTION
STRUCTURE 016-83
BAR SCHEDULE

Scale: NONE
Date: AUGUST, 1988
Drawn By: T.V./D.L.
Checked By: T.V.

ENVIRODYNE ENGINEERS INC.
Chicago, Illinois

FILE NAME: D:\V\AECOM\NA-AWS1\recomonline\local\AECOM_D502_NAVDocuments\01_Americas\Transportation\60269938_Circle\Phase_I\0000_CAD\008_Structural\Sign_Structure\62A76_Sign_Structure\62A76-Sign_Structure.dgn



USER NAME = charles.pigozzi	DESIGNED - JJS, WM	REVISED -
PLOT SCALE = N.T.S	CHECKED - MAI, JMG	REVISED -
PLOT DATE = 1/24/2020	DRAWN - JJS, WM	REVISED -
	CHECKED - MAI, JMG	REVISED -

STATE OF ILLINOIS
DEPARTMENT OF TRANSPORTATION

EXISTING RECORD DRAWINGS
STRUCURE NO. 016-1113

SHEET NO. SS73 OF SS129 SHEETS

F.A.I. RTE. 90/94/290	SECTION 2015-019R	COUNTY COOK	TOTAL SHEETS 2155	SHEET NO. 1023
ILLINOIS		FED. AID PROJECT		

CONTRACT NO. 62A76

FOR INFORMATION ONLY

FILE NAME: D:\VAECOM\NA-AWS1\recomonline\local\AE\COM_D502_NAVDocuments\01_Americas\Transportation\60269938_Circle\Phase_I\0000_CAD\008_Structural\Sign_Structures\62A76_Sign_Structure\62A76-6-Cant-55208-SignStruct.dgn

REINFORCEMENT BAR SCHEDULE					
STRUCTURE	MARK	NUMBER	SIZE	LENGTH	TYPE
PIER C3	s28(E)	102	#5	19'-9"	□□□□
PIER C3	w2(E)	8	#5	7'-2"	□□□□
PIER C3	w28(E)	4	#5	11'-8"	□□□□
PIER C3	w34(E)	8	#5	9'-3"	□□□□
PIER C4	hc4-1(E)	12	#6	26'-10"	
PIER C4	pc4-1(E)	4	#10	18'-9"	
PIER C4	pc4-2(E)	16	#10	27'-8"	
PIER C4	c4-3(E)	4	#10	20'-2"	
PIER C4	pc4-4(E)	24	#11	44'-6"	
PIER C4	pc4-5(E)	8	#11	6'-6"	
PIER C4	pc4-6(E)	8	#11	7'-11"	
PIER C4	w8(E)	4	#5	11'-2"	□□□□
PIER C4	w13(E)	8	#5	6'-8"	□□□□
PIER C4	w29(E)	8	#5	8'-3"	□□□□
PIER C4	s39(E)	128	#5	17'-5"	□□□□
PIER C6	hc6-1(E)	12	#6	41'-9"	
PIER C6	hc6-2(E)	12	#6	50'-0"	
PIER C6	hc6-3(E)	4	#5	7'-0"	
PIER C6	hc6-4(E)	4	#5	16'-4"	
PIER C6	pc6-1(E)	10	#11	43'-8"	
PIER C6	pc6-2(E)	20	#11	31'-8"	
PIER C6	pc6-3(E)	10	#11	50'-0"	
PIER C6	pc6-4(E)	10	#11	26'-0"	
PIER C6	pc6-5(E)	10	#11	18'-5"	
PIER C6	pc6-6(E)	20	#11	48'-0"	
PIER C6	pc6-7(E)	10	#11	30'-7"	
PIER C6	s26(E)	99	#4	12'-10"	□□□□
PIER C6	s34(E)	196	#5	16'-11"	□□□□
PIER C6	w8(E)	28	#5	11'-2"	□□□□
PIER C6	w13(E)	10	#5	6'-8"	□□□□
PIER C6	w19(E)	8	#5	8'-2"	□□□□
PIER C6	vc6-1(E)	72	#11	35'-10"	
PIER C7	hc7-1(E)	8	#6	41'-11"	
PIER C7	hc7-2(E)	5	#5	3'-2"	
PIER C7	hc7-3(E)	5	#5	5'-2"	
PIER C7	hc7-4(E)	20	#5	6'-11"	
PIER C7	hc7-5(E)	5	#5	3'-11"	
PIER C7	pc7-1(E)	8	#11	41'-11"	
PIER C7	pc7-2(E)	8	#11	25'-1"	
PIER C7	pc7-3(E)	8	#9	41'-11"	
PIER C7	s25(E)	63	#4	11'-3"	□□□□
PIER C7	s36(E)	80	#5	14'-3"	□□□□
PIER C7	w12(E)	8	#5	6'-11"	□□□□
PIER C7	w17(E)	8	#5	6'-5"	□□□□
PIER C7	w26(E)	4	#5	10'-11"	□□□□
PIER C7	w27(E)	47	#5	5'-8"	□□□□
PIER C7	vc7-1(E)	14	#9	33'-6"	
PIER C7	vc7-2(E)	14	#9	33'-0"	
PIER C8	hc8-1(E)	8	#6	38'-8"	
PIER C8	pc8-1(E)	12	#10	38'-8"	
PIER C8	pc8-2(E)	12	#9	38'-8"	
PIER C8	s25(E)	61	#4	11'-3"	□□□□
PIER C8	s35(E)	80	#5	14'-1"	□□□□
PIER C8	w7(E)	4	#5	10'-8"	□□□□
PIER C8	w13(E)	8	#5	6'-8"	□□□□
PIER C8	w16(E)	8	#5	6'-2"	□□□□
PIER C8	vc8-1(E)	20	#11	32'-9"	
PIER C8	vc8-2(E)	20	#11	32'-4"	
PIER C9	s37(E)	2	#5	17'-11"	□□□□
PIER C9	w30(E)	6	#10	7'-10"	□□□□
PIER C9	w31(E)	5	#5	7'-8"	□□□□
PIER C10	hc10-1(E)	8	#6	37'-8"	
PIER C10	pc10-1(E)	8	#11	37'-8"	
PIER C10	pc10-2(E)	4	#11	15'-10"	
PIER C10	pc10-3(E)	4	#11	12'-11"	

REINFORCEMENT BAR SCHEDULE					
STRUCTURE	MARK	NUMBER	SIZE	LENGTH	TYPE
PIER C10	pc10-4(E)	8	#10	37'-8"	
PIER C10	pc10-5(E)	8	#10	24'-11"	
PIER C10	s14(E)	48	#5	14'-1"	□□□□
PIER C10	s25(E)	54	#4	11'-3"	□□□□
PIER C10	w7(E)	4	#5	10'-8"	□□□□
PIER C10	w12(E)	8	#5	6'-11"	□□□□
PIER C10	w16(E)	8	#5	6'-2"	□□□□
PIER C10	vc10-1(E)	14	#9	28'-11"	
PIER C10	vc10-2(E)	14	#9	28'-4"	
PIER C12	s38(E)	4	#5	16'-11"	□□□□
PIER C12	w32(E)	6	#10	8'-4"	□□□□
PIER C12	w33(E)	4	#5	9'-8"	□□□□
PIER C13	hc13-1(E)	8	#6	37'-8"	
PIER C13	pc13-1(E)	16	#11	37'-8"	
PIER C13	pc13-2(E)	4	#11	26'-3"	
PIER C13	pc13-3(E)	4	#11	15'-10"	
PIER C13	pc13-4(E)	4	#11	11'-10"	
PIER C13	s17(E)	50	#5	13'-7"	□□□□
PIER C13	s25(E)	41	#4	11'-3"	□□□□
PIER C13	w7(E)	4	#5	10'-8"	□□□□
PIER C13	w13(E)	8	#5	6'-8"	□□□□
PIER C13	w16(E)	8	#5	6'-2"	□□□□
PIER C13	vc13-1(E)	14	#9	22'-7"	
PIER C13	vc13-2(E)	14	#9	22'-2"	

TYPE	MARK	BENT BAR DETAILS			
		a	b	c	d
U	p1-21(E)	1'-7"	16'-6"	1'-2 1/4"	
U	p1-22(E)	1'-3"	9'-6"	0'-11 1/4"	
U	p1-24(E)	1'-3"	18'-6"	0'-11 1/4"	
U	d1-1(E)	1'-7"	12'-6"	1'-2 1/4"	
U	d1-2(E)	1'-3"	7'-9"	0'-11 1/4"	
U	d1-3(E)	1'-3"	8'-3"	0'-11 1/4"	
U	d1-4(E)	1'-7"	13'-0"	1'-2 1/4"	
o	s25(E)	3'-2"	1'-4"		
o	s26(E)	3'-8"	1'-4"		
o	s12(E)	4'-8"	2'-9"	0'-5 1/2"	
o	s14(E)	4'-5"	2'-2"	0'-5 1/2"	
o	s17(E)	4'-2"	2'-2"	0'-5 1/2"	
o	s24(E)	5'-2"	2'-5"	0'-5 1/2"	
o	s28(E)	6'-9"	2'-8"	0'-5 1/2"	
o	s31(E)	5'-4"	3'-8"	0'-5 1/2"	
o	s32(E)	4'-2"	6'-8"	0'-5 1/2"	
o	s33(E)	3'-8"	1'-9"	0'-4 1/2"	
o	s34(E)	5'-8"	2'-4"	0'-5 1/2"	
o	s35(E)	4'-2"	2'-5"	0'-5 1/2"	
o	s36(E)	4'-5"	2'-3"	0'-5 1/2"	
o	s37(E)	4'-10"	3'-8"	0'-5 1/2"	
o	s38(E)	4'-4"	3'-8"	0'-5 1/2"	
o	s39(E)	5'-9 1/2"	2'-5 1/2"	0'-5 1/2"	
o	s40(E)	4'-8"	2'-7"	0'-5 1/2"	
o	s41(E)	4'-5"	2'-7"	0'-5 1/2"	
o	s42(E)	4'-5"	2'-7"	0'-5 1/2"	
U	h1-4(E)	2'-10"	1'-0"		
U	h1-5(E)	2'-8"	5'-0"		
U	h1-6(E)	2'-8"	4'-6"		
U	w1(E)	4'-8"	6'-6"		
U	w2(E)	4'-8"	1'-3"		
U	w3(E)	6'-8"	1'-3"		
U	w4(E)	2'-2"	1'-3"		
U	w5(E)	2'-0 1/2"	2'-4"		
U	w7(E)	3'-8"	3'-6"		
U	w8(E)	4'-2"	3'-6"		
U	w10(E)	4'-11"	1'-3"		
U	w11(E)	4'-2"	2'-10"		
U	w12(E)	4'-5"	1'-3"		
U	w13(E)	4'-2"	1'-3"		
U	w16(E)	3'-8"	1'-3"		
U	w17(E)	3'-11"	1'-3"		
U	w23(E)	16'-7"	3'-8"		
U	w24(E)	16'-8"	4'-9"		
U	w19(E)	5'-8"	1'-3"		
U	w26(E)	3'-11"	3'-6"		
U	w27(E)	1'-8 1/2"	2'-0"		
U	w28(E)	4'-8"	3'-6"		
U	w29(E)	5'-9"	1'-3"		
U	w31(E)	3'-8"	2'-0"		
U	w33(E)	3'-8"	3'-0"		
U	w34(E)	6'-9"	1'-3"		
U	w30(E)	3'-0"	4'-10"		
U	w32(E)	4'-0"	4'-4"		
o	s2(E)	4'-2"	1'-2"	0'-6"	
o	s4(E)	3'-8"	0'-8"	0'-6"	
o	s6(E)	3'-2"	0'-8"	0'-6"	
U	s3(E)	0'-6"	4'-2"	0'-8"	0'-4"
U	s5(E)	0'-6"	3'-7"	0'-10"	0'-3 1/2"
U	s7(E)	0'-6"	3'-1"	0'-10"	0'-3 1/2"
U	s20(E)	0'-6"	3'-8"	0'-10"	0'-3 1/2"
U	s21(E)	0'-6"	3'-2"	0'-10"	0'-3 1/2"

Note: All bars designated (E) shall be epoxy coated.
Work shls E17 and E18 together.

SECTION	COUNTY	TOTAL SHEETS	SHEET NO.
90/794	COOK	88	18
FED. AID PROJECT			

SECTION	COUNTY	TOTAL SHEETS	SHEET NO.
90/94/290	2015-019R	COOK	2155 1024
CONTRACT NO. 62A76			

REVISIONS

Name	Date

STATE OF ILLINOIS
DEPARTMENT OF TRANSPORTATION
F.A.I. ROUTE 90/794 (DAN RYAN EXPRESSWAY)
SECTION 1985-077 BR/COOK COUNTY
N.B. MAINLINE RECONSTRUCTION
STRUCTURE 016-83
BAR SCHEDULE

Scale: NONE
Date: AUGUST, 1988
Drawn By: T.V./D.L.
Checked By: T.V.
ENVIRODYNE ENGINEERS INC.
Chicago, Illinois

SHEET E18 OF 88

TYPE K
TYPE L
TYPE M
TYPE N
TYPE P
TYPE Q
TYPE R
TYPE S
TYPE A
TYPE B
TYPE C
TYPE D
TYPE E
TYPE F
TYPE G
TYPE H
TYPE J



USER NAME =	charles.pigozzi	DESIGNED -	JJS, WM	REVISED -	
		CHECKED -	MAI, JMG	REVISED -	
PLOT SCALE =	N.T.S	DRAWN -	JJS, WM	REVISED -	
PLOT DATE =	1/24/2020	CHECKED -	MAI, JMG	REVISED -	


STATE OF ILLINOIS
DEPARTMENT OF TRANSPORTATION

EXISTING RECORD DRAWINGS
STRCUTURE NO. 016-1113

SHEET NO. SS74 OF SS129 SHEETS

F.A.I. RTE.	SECTION	COUNTY	TOTAL SHEETS	SHEET NO.
90/94/290	2015-019R	COOK	2155	1024
CONTRACT NO. 62A76				

FILE NAME: D:\VAECOM-NA-AV51\recomonline-local\AECOM_DS02_NAVDocuments\01_Americas\Transportation\60269938_CirclePhase_I\000_CAD\008_Structural\Sign_Structures\62A76-BM-SS301-SignStruct.dgn

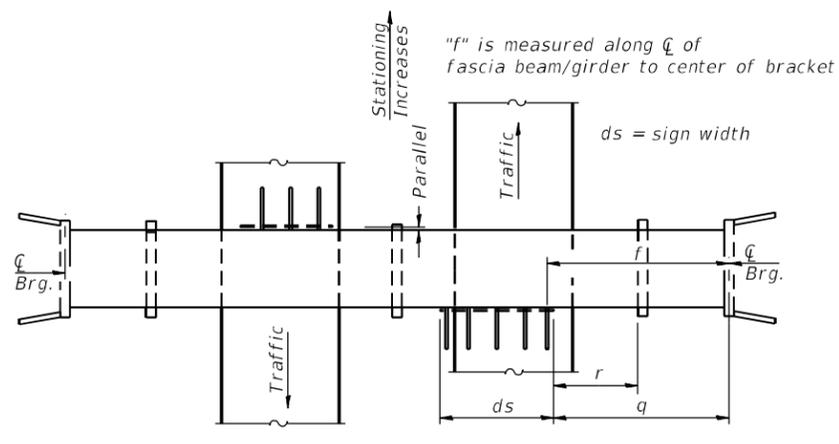

PLAN
(For Sign Skew $\leq 15^\circ$, all brackets constant)
WALKWAY AND HANDRAIL SKETCH
(Road plan beneath structure varies.)

NOTES:


- "q" is measured from \bar{C} Brg. of abutment along \bar{C} of fascia beam/girder to edge of sign.
- "r" is measured from face of pier along \bar{C} of fascia beam/girder to edge of sign.
- Walkway grating, walkway brackets, handrail, lighting and associated components will not be installed in Contract 62A76.

Dimensions f & g may vary as approved by the Engineer, see ①.
When $cw < cs$ and/or $dw < ds$, use alternate brackets without walkway supports where applicable, see ③.


Structure Number	Bridge Name	g1	g2	g3	g4
1B0161094L051.8	Congress Pkwy (I290 EB)	6'-0"	6'-0"	5'-3"	5'-3"
1B0161094L051.4C	Adams Street	5'-4"	4'-4"	4'-4"	-
1B0161094L051.3B	Monroe Street	4'-6"	5'-0"	5'-0"	5'-0"
1B0161094L051.2A	Washington Street	4'-11 1/2"	4'-10"	-	-

Structure Number	Sign Skew Angle (L) or	Bridge Station	Bridge Structure Number	Bridge Name	Contract Route Designation	ds	r	f	g	No. of Brackets	q
1B0161094L051.8	0°	5160+01.31	016-1704	Congress Pkwy (I290 EB)	NB 1-90/94	24'-0"	-	51'-2 1/2"	*	5	50'-8 1/2"
1B0161094L051.5A	0°	8214+28.34	016-1702	Jackson Blvd	NB 1-90/94	17'-0"	-	22'-11 7/8"	5'-4"	4	22'-5 7/8"
1B0161094L051.5B	0°	8214+45.30	016-1702	Jackson Blvd	NB 1-90/94	14'-6"	-	7'-3 3/8"	4'-6"	4	6'-9 3/8"
1B0161094L051.4A	0°	8313+79.09	016-1701	Adams Street	NB 1-90/94	17'-6"	18'-9 1/4"	91'-0 1/4"	5'-2"	4	-
1B0161094L051.4B	0°	8314+31.76	016-1701	Adams Street	NB 1-90/94	17'-6"	-	38'-1 5/8"	5'-4"	4	37'-4 1/8"
1B0161094L051.4C	0°	8314+61.75	016-1701	Adams Street	NB 1-90/94	15'-0"	-	9'-1 1/4"	*	4	8'-7 1/4"
1B0161094L051.3A	0°	8414+55.55	016-1700	Monroe Street	NB 1-90/94	17'-6"	-	50'-1"	5'-2"	4	49'-1"
1B0161094L051.3B	0°	8414+82.08	016-1700	Monroe Street	NB 1-90/94	21'-0"	-	21'-7"	*	5	20'-9 5/8"
1B0161094L051.3C	0°	8415+00.58	016-1700	Monroe Street	NB 1-90/94	15'-0"	-	6'-3 5/8"	4'-4"	4	5'-3 5/8"
1B0161094L051.2A	0°	8614+63.71	016-0601	Washington Street	NB 1-90/94	11'-6"	-	50'-6 5/8"	*	0 **	49'-3 3/8"
1B0161094L051.2B	0°	8614+82.42	016-0601	Washington Street	NB 1-90/94	20'-0"	-	27'-8 7/8"	6'-0"	3 **	26'-8 7/8"

* Varies, see separate table. Note Signs A, B, C and g1-g4 are listed from west to east
Note the following brackets shall be placed at the locations of existing holes in the beams:
1B0161094L051.3A (Monroe St): one east bracket; 1B0161094L051.3B (Monroe St): two west brackets
Note the following brackets shall be reused:
1B0161094L051.2A (Washington St): all three brackets; 1B0161094L051.2B (Washington St): one west bracket
** On signs with existing brackets to be reused, only proposed brackets are listed

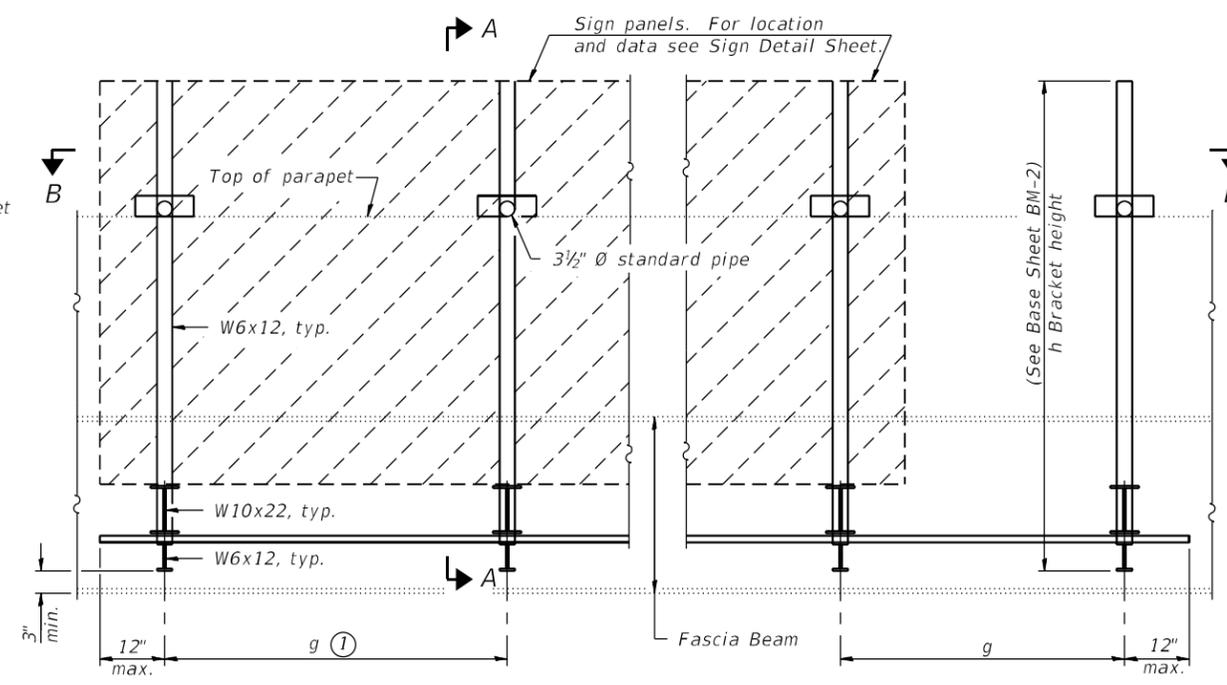

TYPICAL FRONT ELEVATION
(With lights, safety chain and handrail omitted for clarity.)

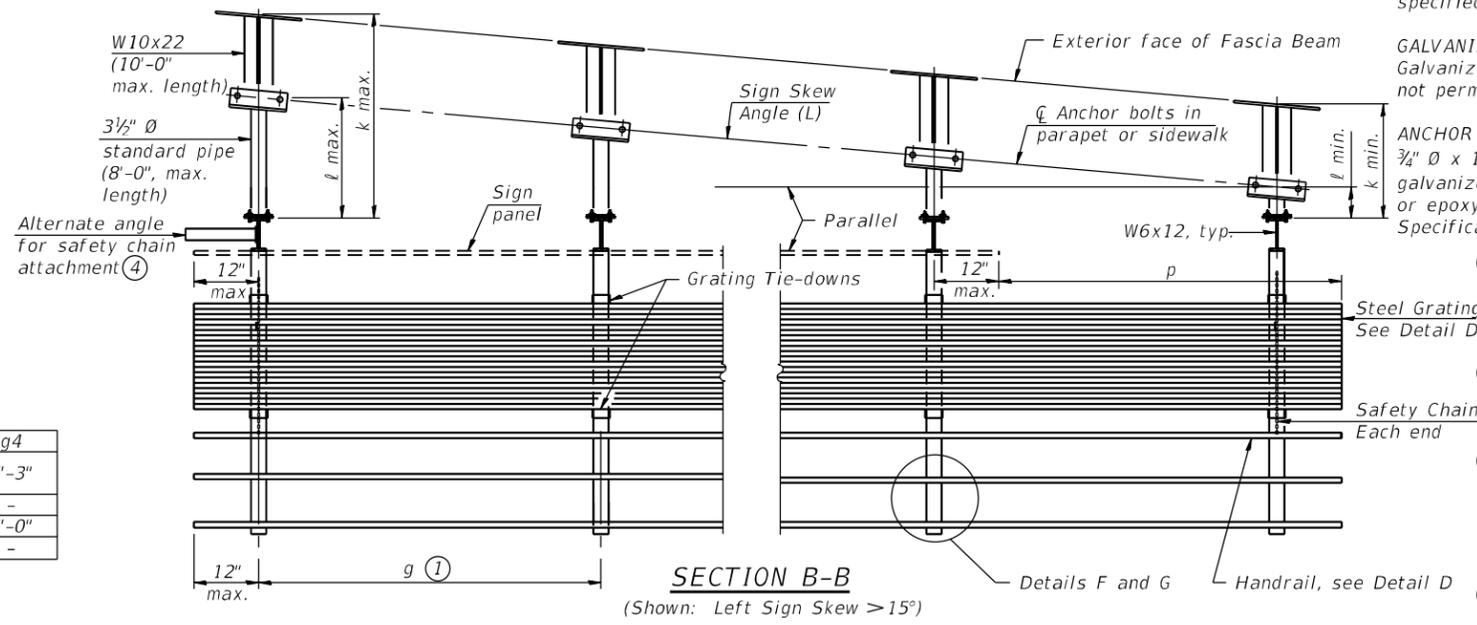

SECTION B-B
(Shown: Left Sign Skew > 15°)

GENERAL NOTES

- SPECIFICATIONS:**
- DESIGN:** AASHTO Standard Specifications for Structural Supports for Highway Signs, Luminaires and Traffic Signals. ("AASHTO Specifications") ②
- CONSTRUCTION:** Current (at time of letting) Illinois Department of Transportation Standard Specifications for Road and Bridge Construction, Supplemental Specifications and Special Provisions. ("Standard Specifications")
- LOADING:** 90 M.P.H. WIND VELOCITY
- WALKWAY LOADING:** Dead load plus 500 lbs. concentrated live load.
- MINIMUM CLEARANCE:** 3" greater than bridge members at all locations. (All Obstructions)
- WELDING:** All welds to be continuous unless otherwise shown. All welding to be done in accordance with current AWS D1.1 Structural Welding Code (Steel) and the Standard Specifications.
- MATERIALS:** All Structural Steel Pipe shall be ASTM A53 Grade B with a minimum yield of 35,000 p.s.i., or A500 Grade B or C with a minimum yield of 46,000 p.s.i. If A500 pipe is substituted for A53, then the outside diameter shall be as detailed and wall thickness greater than or equal to A53. All Structural Steel Plates and Shapes shall conform to AASHTO M270 Gr. 36, Gr. 50 (M183, M223 Gr. 50.).
- HIGH STRENGTH BOLTS:** All bolts, washers, nuts and locknuts shall satisfy the requirements of ASTM designation A307 unless noted as "H.S." which shall require AASHTO M164 (A325), ASTM A449, or approved alternate. All fasteners shall be hot dip galvanized per AASHTO M232 unless otherwise specified.
- GALVANIZING:** All Steel Grating, Plates, Shapes and Pipe shall be Hot Dip Galvanized after fabrication in accordance with AASHTO M111. Painting is not permitted.
- ANCHOR RODS:** All-threaded rod shall conform to ASTM F1554 Grade 105, 3/4" \bar{O} x 12" long, each with one plate washer and locknut and be hot dip galvanized per AASHTO M232. They shall be either cast into the concrete or epoxy grouted in accordance with Section 584 of the Standard Specifications. Minimum embedment in concrete shall be 9".

- Bracket spacing $g \leq 6'-0"$, max. Spacing shall be uniform if possible but may vary $\pm 6"$ to miss existing obstruction (rail post, light poles, web stiffeners, splice plates, etc.). Adjust bracket lengths accordingly on skewed structures.
- Any design modifications shall be based on the current version of applicable specifications and submitted for the Engineer's approval.
- Unit price includes grating, handrail, brackets, supports, anchor bolts, fasteners, fabrication, delivery, erection, field drilling and other necessary items. Limits of payment are based on sign width (ds). For Safety Chain Details and Details D, F and G, see Sheet SS80.
- If walkway bracket at safety chain location is behind sign, add angle to bracket. See detail on Sheet SS80.



SIGNED: Moussa A. Issa
DR. MOUSSA A. ISSA, S.E., IL. LIC. NO. 081-005738
EXPIRES 11-30-2020
DATE: 01/29/2020 FOR SHEETS SS75 THRU SS80
(TOTAL OF 6 SHEETS)

TOTAL BILL OF MATERIAL

DESCRIPTION	UNIT	QUANTITY
OVERHEAD SIGN STRUCTURE - BRIDGE MOUNTED	FOOT	159
STRUCTURAL STEEL SUPPORT FOR OVERHEAD SIGN STRUCTURE - BRIDGE MOUNTED	EACH	3
MODIFICATION OF ORNAMENTAL CLADDING	FOOT	32



USER NAME = marina.stoica	DESIGNED - CP, LAB	REVISED -
PLOT SCALE = N.T.S	CHECKED - JJS, MAI	REVISED -
PLOT DATE = 1/29/2020	DRAWN - CP	REVISED -
	CHECKED - JJS, MAI	REVISED -

STATE OF ILLINOIS
DEPARTMENT OF TRANSPORTATION

BRIDGE MOUNT SIGN STRUCTURES
GENERAL PLAN AND ELEVATION


SHEET NO. SS75 OF SS129 SHEETS

F.A.I. RTE.	SECTION	COUNTY	TOTAL SHEETS	SHEET NO.
90/94/290	2015-019R	COOK	2155	1025
CONTRACT NO. 62A76				
ILLINOIS FED. AID PROJECT				

FILE NAME: D:\V\AECOM-NA-AW51...aecocom\line\local\AECOM_D502_NAVDocuments\01_Americas\Transportation\60269938_Circle\Phase_I\000_CAD\008_Structural\Sign_Structures\62A76-BM-SS301A-SignStruct.dgn


* After bridge mounted sign brackets are removed, any open holes in existing fascia beams shall be filled with HS Bolts with washers. Bolts shall be 3/4" diameter ASTM A325, Type 1 hot-dipped galvanized. Cost shall be included with Remove Overhead Sign Structure.

The existing fascia beam is hot-dip galvanized. Areas on the existing fascia beam where the bridge mounted sign brackets are removed shall be cleaned, and the coating system shall be repaired, as required by the Special Provision "Metallizing of Structural Steel" to the satisfaction of the Engineer. Cost shall be included with Remove Overhead Sign Structure.

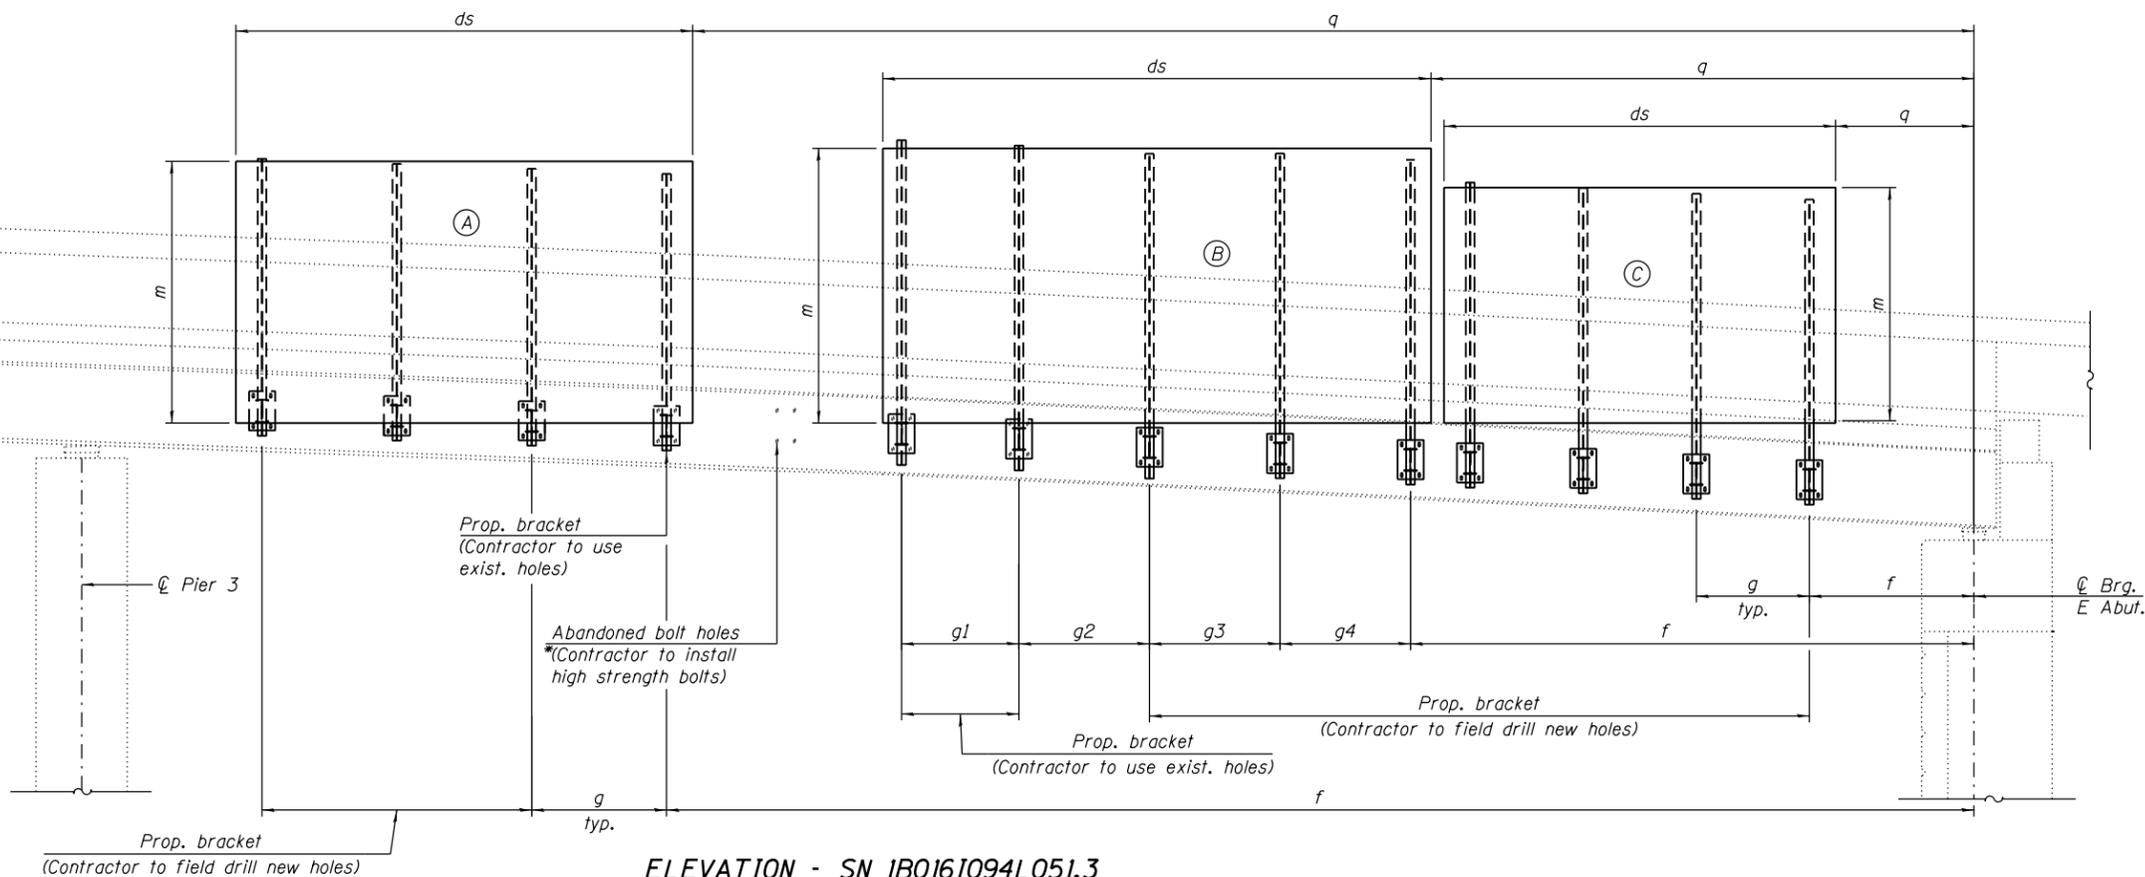


ELEVATION - SN 1B016I094L051.3

South Fascia Girder of Monroe Street Bridge SN 016-1700
(Looking North)

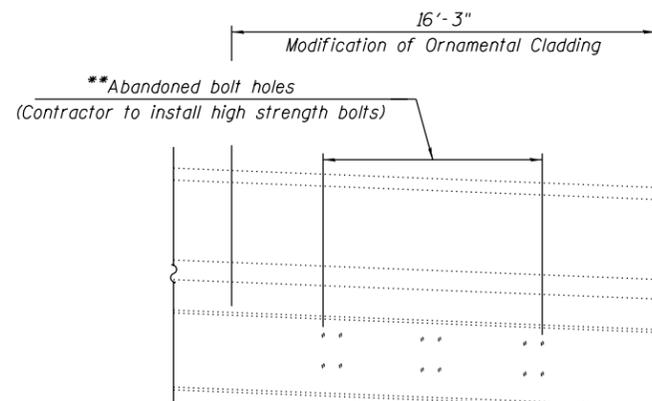

** After bridge mounted sign brackets are removed, any open holes in existing fascia beams shall be filled with HS Bolts with washers. Bolts shall be 3/4" diameter ASTM A325, Type 1 hot-dipped galvanized. Cost shall be included with Remove Overhead Sign Structure.

The existing structural steel coating contains lead. The Contractor shall take appropriate precautions to deal with the presence of lead on this project. Areas on the existing fascia beam where the bridge mounted sign brackets are removed shall be cleaned per Power Tool Cleaning to Bare Metal SSPC-SP-11 and painted as required by the Special Provision "Cleaning and Painting Contact Surface Areas of Existing Steel Structures". All structural steel shall be shop painted with the inorganic zinc rich primer per AASHTO M300, Type 1. The color of the primer shall be Gray, Munsell No. 5B 7/1. Cost shall be included with Remove Overhead Sign Structure.

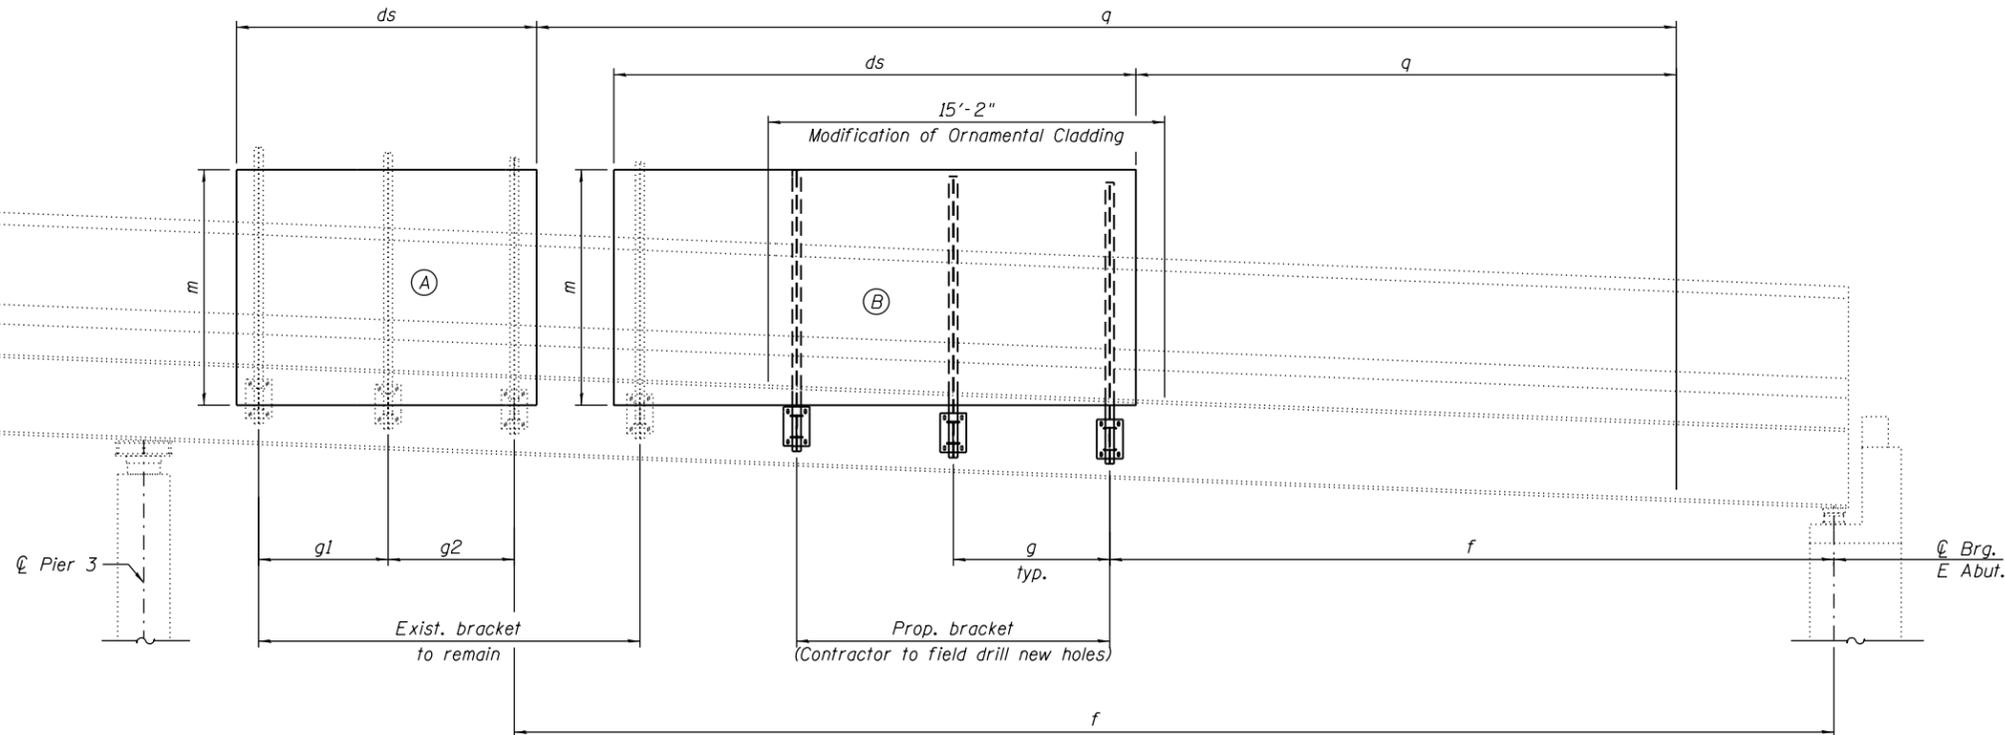

ELEVATION - SN 1B016I094L051.2

South Fascia Girder of Washington Street Bridge SN 016-0601
(Looking North)
(Ornamental cladding not shown for clarity)



USER NAME = marina.stoica	DESIGNED - AMS, LAB	REVISED -
PLOT SCALE = N.T.S	CHECKED - JJS, MAI	REVISED -
PLOT DATE = 1/29/2020	DRAWN - AMS	REVISED -
	CHECKED - JJS, MAI	REVISED -

STATE OF ILLINOIS
DEPARTMENT OF TRANSPORTATION



BRIDGE MOUNT SIGN STRUCTURES
ELEVATION

SHEET NO. SS76 OF SS129 SHEETS

F.A.I. RTE. 90/94/290	SECTION 2015-019R	COUNTY COOK	TOTAL SHEETS 2155	SHEET NO. 1026
CONTRACT NO. 62A76				

ILLINOIS FED. AID PROJECT

FILE NAME: P:\V\AECOM-NA-AWS1\arecomonline\local\AECOM_DS02_NAVDocuments\01_Americas\Transportation\60269938_Circle\Phase_I\000_CAD\008_Structural\Sign_Structure\62A76-BM-SS302-SignStruct.dgn

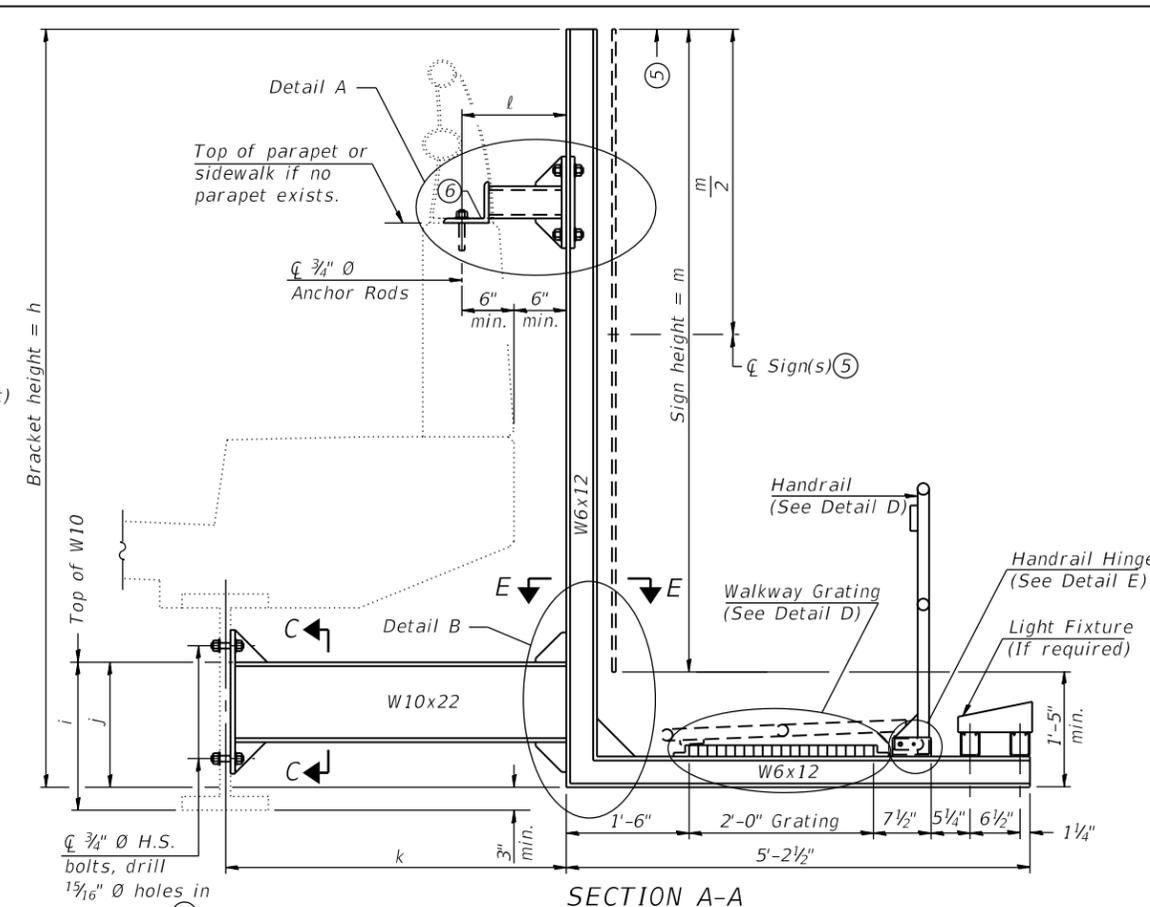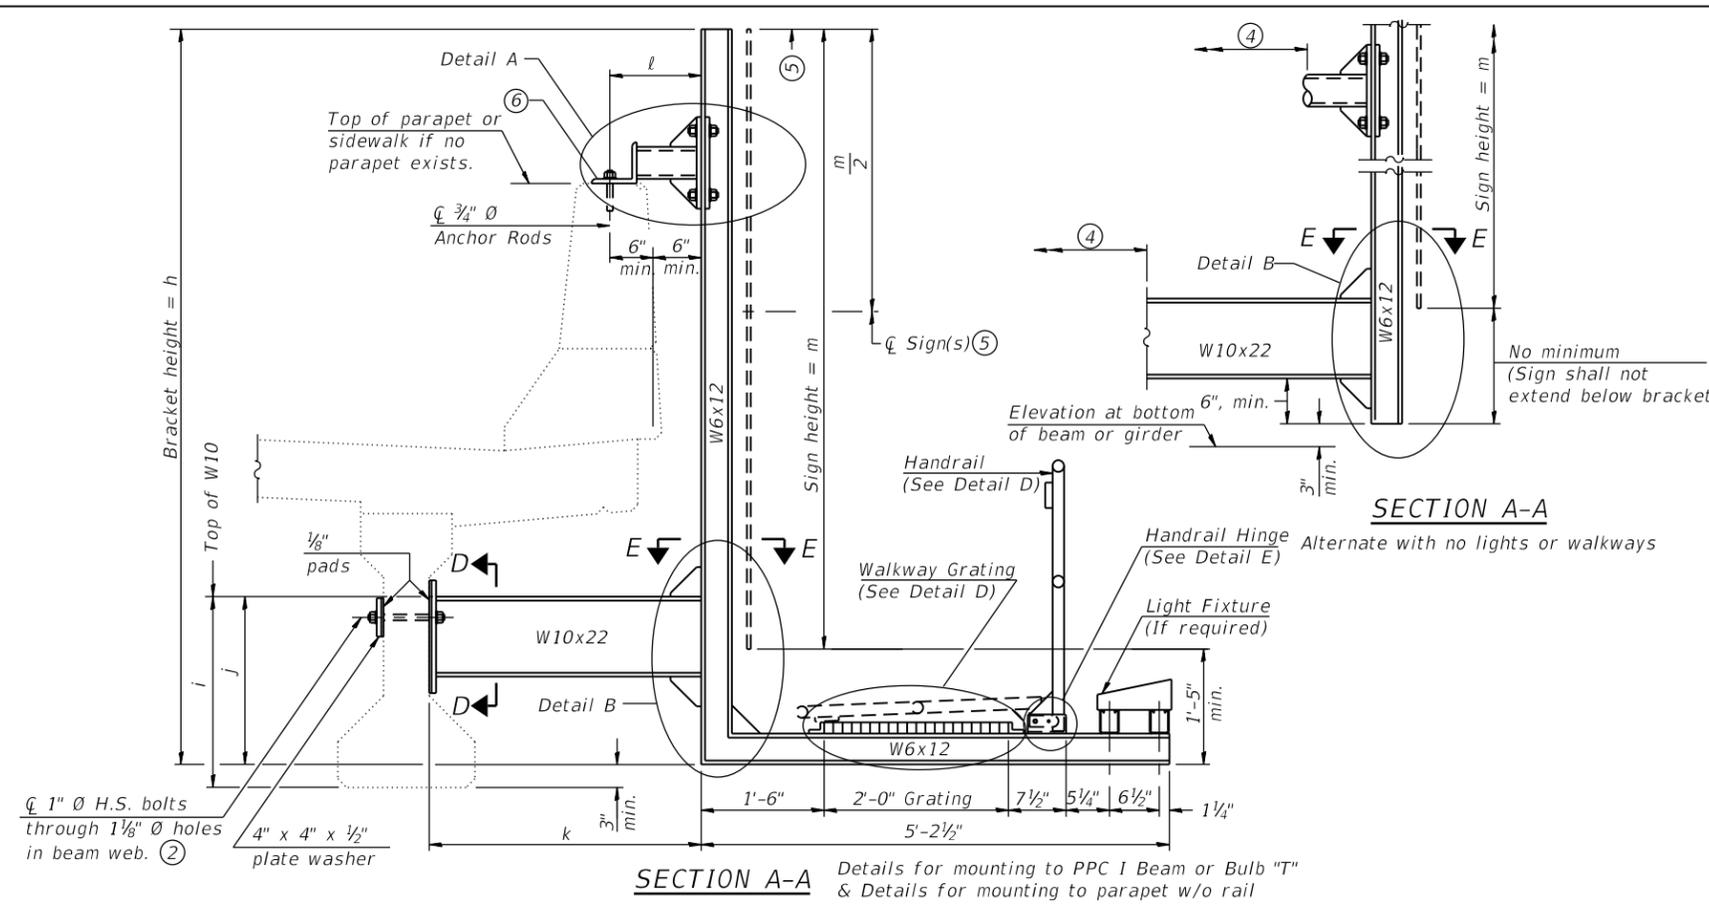

Notes:
 Installations not within dimensional limits shown require special analysis for all components and must be submitted to the Bureau of Bridges and Structures for approval. Contractor shall field check all pertinent existing bridge dimensions shown on plans before submitting shop drawings.
 All holes in bridge beams or girders should be located in the middle half of the member. There shall be no holes drilled in the lower quarter of the member's depth. (For R.C. girder, depth = bottom of deck to bottom of the girder.) Proposed exceptions must be approved by the Bureau of Bridges and Structures.
 The Engineer may adjust dimension "i" to meet the above condition and to keep the sign level.

NOTES:

1. Walkway grating, walkway brackets, handrail, lighting and associated components will not be installed in Contract 62A76.

For Details A & B, Sections C-C, D-D and E-E, see Sheet SS79.
 For Details D & E, see Sheet SS80.

- ① Holes in new steel members may be drilled in the fabrication shop or in the field. Field drill existing members.
- ② For new PPC I beams, holes shall be formed during casting. For existing PPC I beams, prestressing strand locations shall be determined and spaced to miss strands by 6", min. Minimize spalling during field drilling of existing beams.
- ③ For new construction, form holes. For existing RC beams, locate primary reinforcement and space holes to miss by 6", min. Minimize spalling and concrete fracturing/damage during field drilling of existing concrete. Spalls over 1/4" deep or beyond the coverage of the 4x4 plate washer shall be repaired with epoxy mortar before installing washer.
- ④ For attachment details of 3/2" pipe and W10x22, see other sections as applicable.
- ⑤ Sign shall not extend more than 6" above top of bracket, and this dimension may vary to keep sign level if bridge is on grade or vertical curve. Multiple signs of various heights shall share a common horizontal centerline and use equal bracket heights. If no sign is attached to a W6x12 vertical (bracket only supporting walkway), dimension h shall be the same as an adjacent bracket with a sign attached, unless Engineer specifically directs shorter brackets due to locational restraints on future uses. (See Detail A for minimum bracket height.)
- ⑥ For bridge mounted sign structures installed on new bridges with railing, during design, bracket spacing must be coordinated with railing post spacing and the Contractor must install upper brackets prior to railing installation. For bridge mounted sign structures installed on existing bridges with railing, during design, brackets spacing must be coordinated with railing post spacing and the Contractor must temporarily remove sections of railing to facilitate upper bracket installation. If it is determined during design that existing railings can't be removed, alternate upper connection details must be developed for the contract plans and approved by the Bureau of Bridges and Structures.

Structure Number	Bridge Name	Bridge Station	h	i	j	k max. (10'-0" max.)	l max. (8'-0" max.)	m (15'-0" max.)
1B0161094L051.8	Congress Pkwy (I290 EB)	5160+01.31	8'-6"	2'-3"	1'-4 1/2"	3'-8"	1'-0"	6'-6"
1B0161094L051.5A	Jackson Blvd	8214+28.34	11'-6"	*	1'-4 1/2"	3'-4 1/2"	1'-0"	10'-6"
1B0161094L051.5B	Jackson Blvd	8214+45.30	10'-6"	1'-9"	1'-4 1/2"	3'-4 1/2"	1'-0"	9'-0"
1B0161094L051.4A	Adams Street	8313+79.09	8'-6"	1'-8 1/4"	1'-4 1/2"	3'-4 1/2"	1'-0"	8'-0"
1B0161094L051.4B	Adams Street	8314+31.76	11'-0"	*	1'-4 1/2"	3'-4 1/2"	1'-0"	10'-0"
1B0161094L051.4C	Adams Street	8314+61.75	10'-0"	1'-8 1/4"	1'-4 1/2"	3'-4 1/2"	1'-0"	8'-6"
1B0161094L051.3A	Monroe Street	8414+55.55	10'-7"	*	1'-4 1/2"	3'-0"	1'-0"	10'-0"
1B0161094L051.3B	Monroe Street	8414+82.08	12'-5"	*	*	3'-0"	1'-0"	10'-6"
1B0161094L051.3C	Monroe Street	8415+00.58	11'-8"	1'-11"	1'-4 1/2"	3'-0"	1'-0"	9'-0"
1B0161094L051.2A	Washington Street	8614+63.71	-	-	-	-	-	9'-0"
1B0161094L051.2B	Washington Street	8614+82.42	10'-9"	1'-11 1/4"	1'-4 1/2"	6'-0"	2'-11 1/2"	9'-0"

* Varies, see separate table

Structure Number	Bridge Name	i1	i2	i3	i4	i5
1B0161094L051.5A	Jackson Blvd	1'-10 1/4"	1'-9"	1'-9"	1'-9"	-
1B0161094L051.4B	Adams Street	1'-9 1/2"	1'-8 1/4"	1'-8 1/4"	1'-8 1/4"	-
1B0161094L051.3A	Monroe Street	1'-11 3/4"	1'-11 3/4"	1'-11 3/4"	2'-0"	-
1B0161094L051.3B	Monroe Street	2'-0"	2'-0"	1'-11"	1'-11"	1'-11"

Structure Number	Bridge Name	j1	j2	j3	j4	j5
1B0161094L051.3B	Monroe Street	1'-7 1/2"	1'-7 1/2"	1'-7 1/2"	1'-4 1/2"	1'-4 1/2"



USER NAME = lisa.buntin	DESIGNED - CP, LAB	REVISED -
PLOT SCALE = N.T.S	CHECKED - JJS, MAI	REVISED -
PLOT DATE = 1/28/2020	DRAWN - CP	REVISED -
	CHECKED - JJS, MAI	REVISED -


**STATE OF ILLINOIS
DEPARTMENT OF TRANSPORTATION**

**BRIDGE MOUNT SIGN STRUCTURES
WALKWAY AND CONNECTION DETAILS I**

SHEET NO. SS77 OF SS129 SHEETS


F.A.I. RTE. 90/94/290	SECTION 2015-019R	COUNTY COOK	TOTAL SHEETS 2155	SHEET NO. 1027
CONTRACT NO. 62A76				
ILLINOIS FED. AID PROJECT				

FILE NAME: D:\V\AECOM-NA-AWS1\arecomonline\local\AECOM_DS02_NAVDocuments\01_Americas\Transportation\60269938_Circle\Phase\Structural\Sign_Structures\62A76-BM-SS302A-SignStruct.dgn

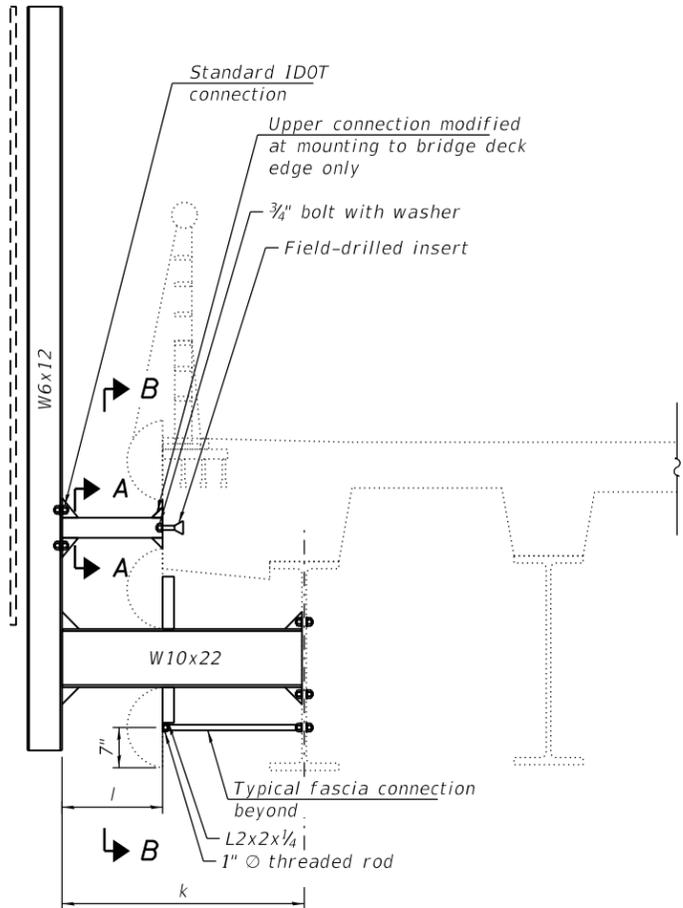

ORNAMENTAL CLADDING CONNECTION DETAIL


Note: All threaded rod conforming to ASTM A307, 3/4"x12" long each with one plate washer and locknut and be hot dip galvanized per AASHTO M232. They shall be epoxy grouted in accordance with section 584 of the standard specifications. Minimum embedment in concrete shall be 9".

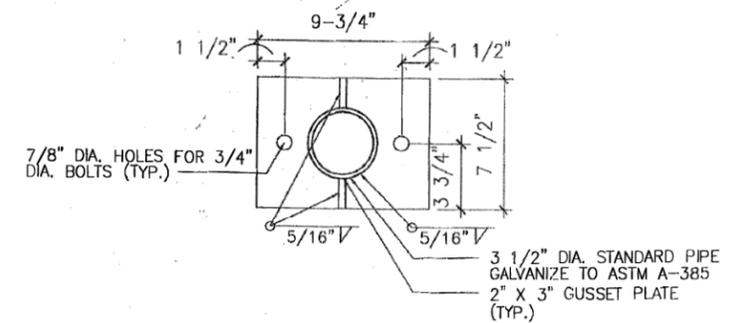


VIEW A-A SUPPORT BRACKET DETAIL

NOTES:


- Existing slots which are abandoned, due to removal or relocation of the sign structure supports, shall be filled.
- The existing ornamental cladding shall be modified per the details shown in the plans, or as directed by the Engineer, to permit connection of new sign structure supports to the existing structure.
- Plan dimensions and details relative to existing plans are subject to nominal construction variations. The Contractor shall field-verify existing dimensions and details affecting new construction and make necessary approved adjustments prior to construction or ordering of materials. Such variations shall not be cause for additional compensation for a change in scope of the work; however, the Contractor will be paid for the quantity actually furnished at the unit price bid for the work.
- The Contractor shall take all necessary precautions during removal/construction activities to avoid damage to existing elements to remain. Any damage to existing elements to remain, caused by the Contractor in the performance of his/her work, shall be repaired by the Contractor, to the satisfaction of the Engineer, at no cost to the Department.
- See Special Provision for Modification of Ornamental Cladding for details.

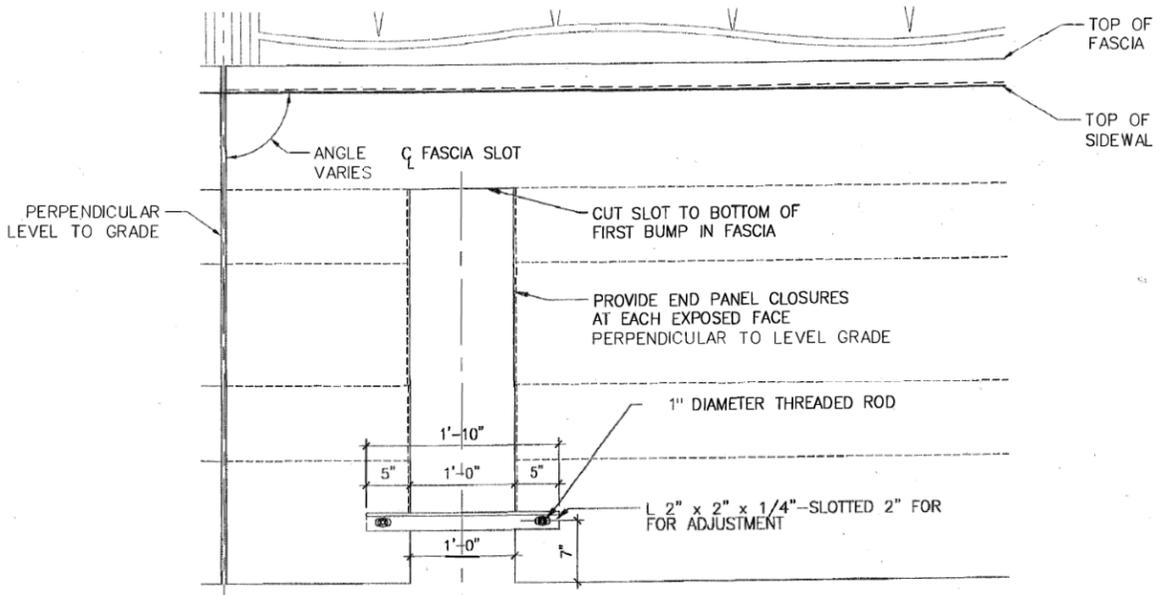

VIEW B-B FASCIA SLOT DETAIL

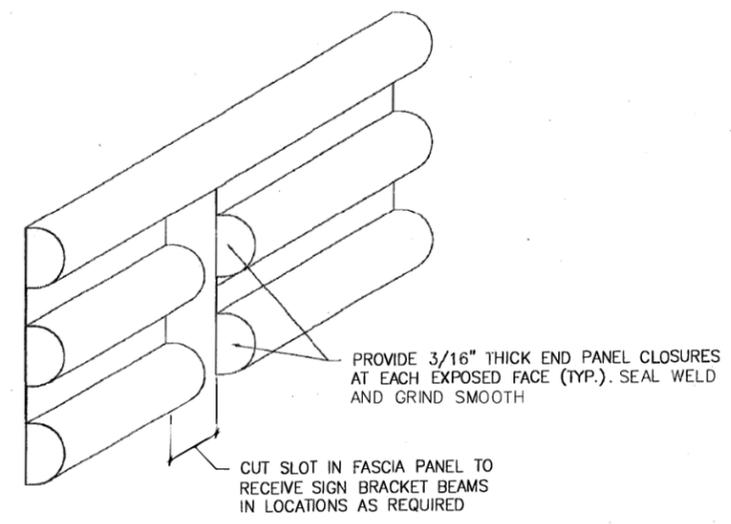

FASCIA PANEL AT SIGN BRACKET-SCHEMATIC VIEW (TYP.)

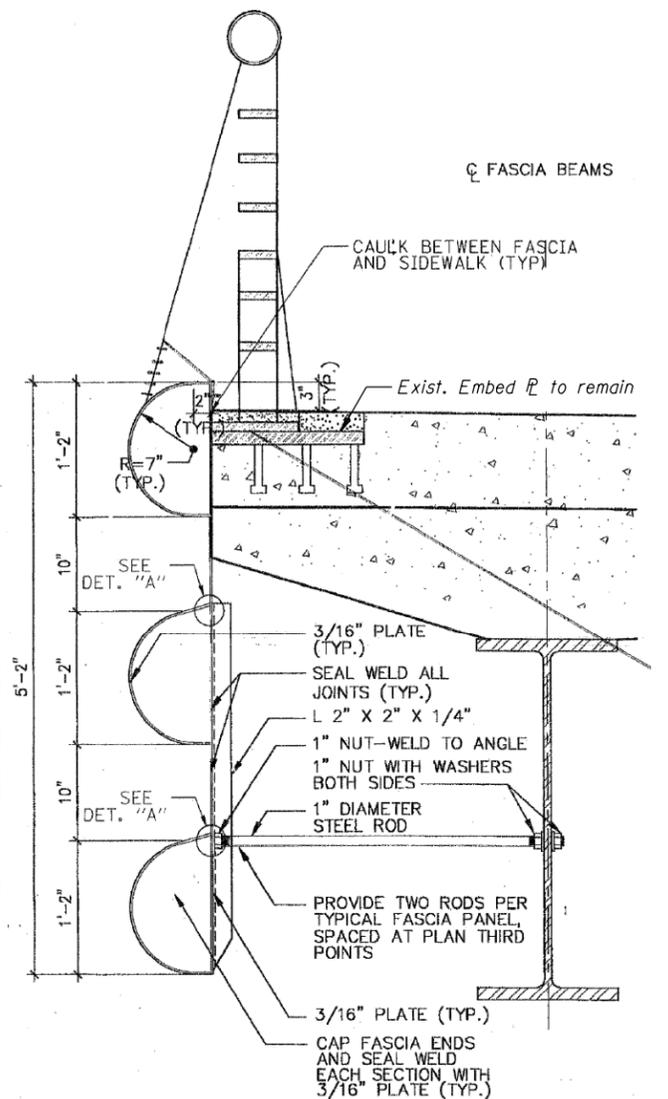

ORNAMENTAL CLADDING DETAIL

(SN 016-0601, For Information Only)



USER NAME = elizabeth.kurian	DESIGNED - CP, LAB	REVISED -
PLOT SCALE = N.T.S	CHECKED - JJS, MAI	REVISED -
PLOT DATE = 1/29/2020	DRAWN - CP	REVISED -
	CHECKED - JJS, MAI	REVISED -

**STATE OF ILLINOIS
DEPARTMENT OF TRANSPORTATION**


**BRIDGE MOUNT SIGN STRUCTURES
WALKWAY AND CONNECTION DETAILS II**

SHEET NO. SS78 OF SS129 SHEETS


F.A.I. RTE. 90/94/290	SECTION 2015-019R	COUNTY COOK	TOTAL SHEETS 2155	SHEET NO. 1028
CONTRACT NO. 62A76				

ILLINOIS FED. AID PROJECT


FILE NAME: D:\V\AE\COM-NA-AWS1\ae\online\local\AE\COM_ID502_NAV\Documents\01_Americas\Transportation\60269938_Circle\Phase_I\000_CAD\008_Structural\Sign_Structures\62A76-BM-SS304-SignStruct.dgn

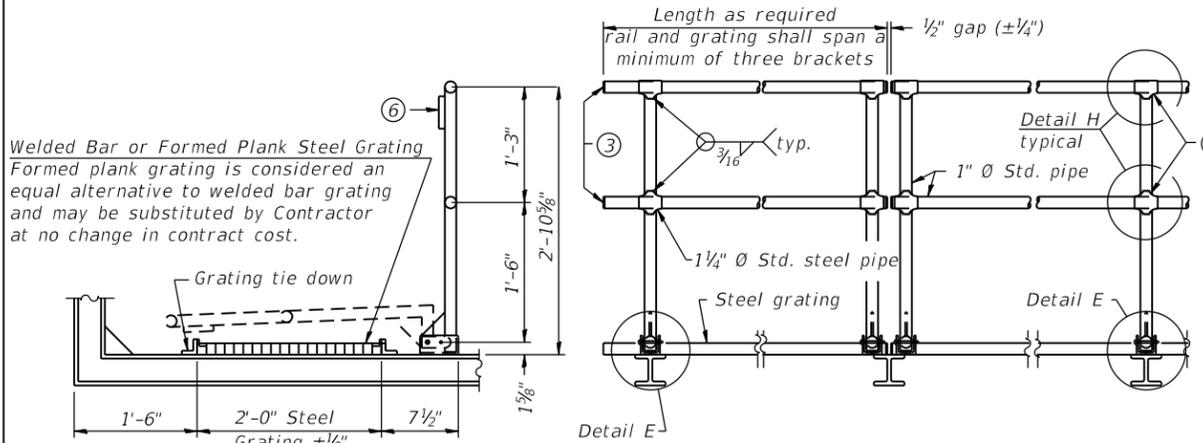


SIDE ELEVATION DETAIL D HANDRAIL FRONT ELEVATION

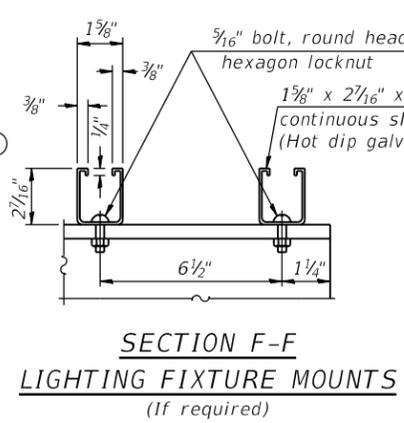


SECTION F-F LIGHTING FIXTURE MOUNTS (If required)

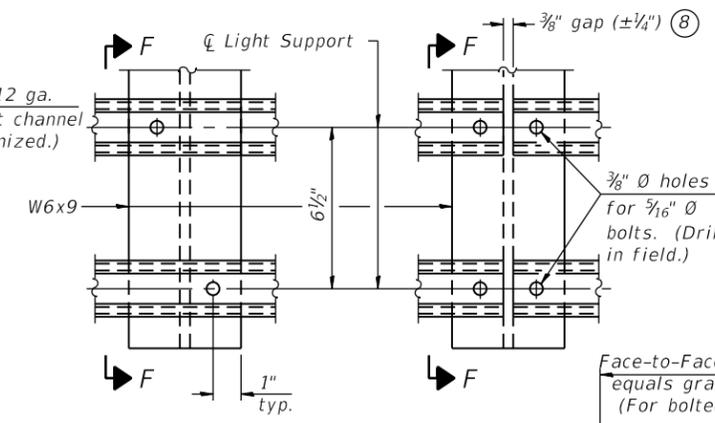


DETAIL F DETAIL G

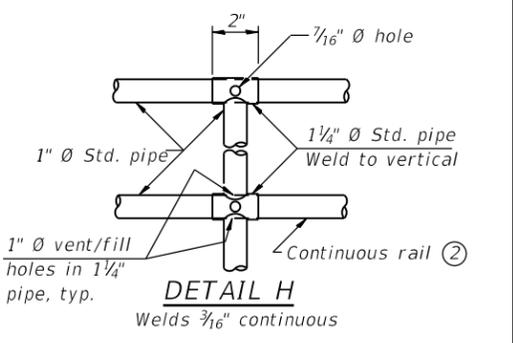


DETAIL H

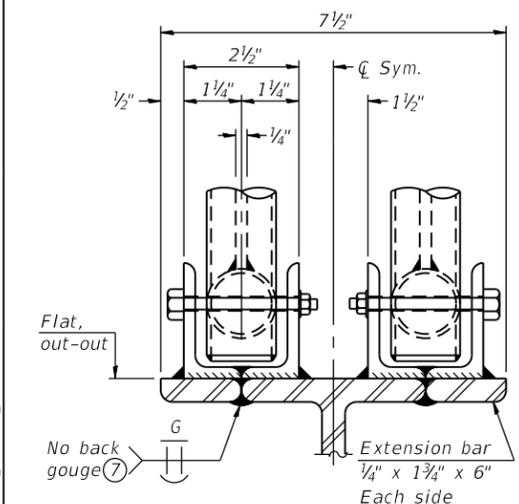


ELEVATION AT HANDRAIL JOINT
(Details not shown same as "FRONT ELEVATION")

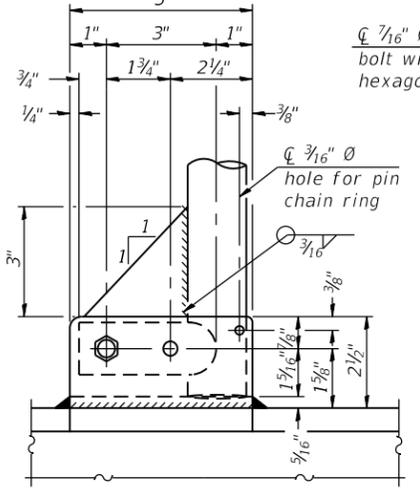


SIDE ELEVATION

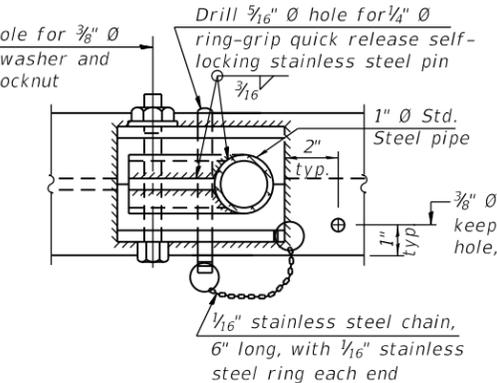


PLAN AT SINGLE HANDRAIL HINGE DETAIL E

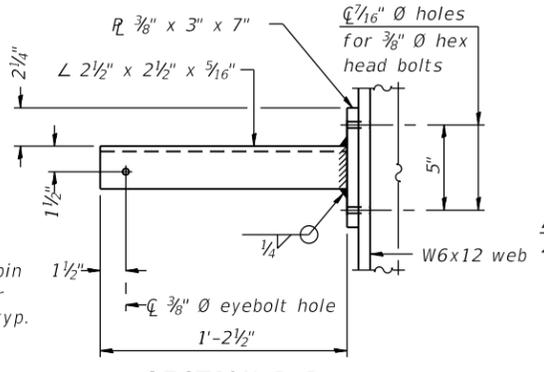


SECTION P-P

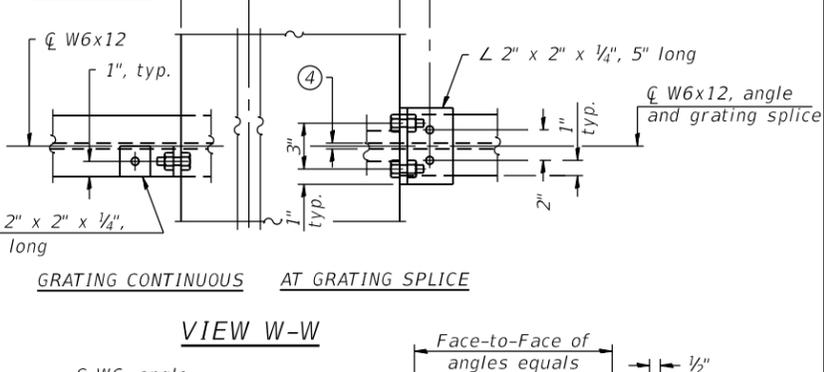


VIEW W-W

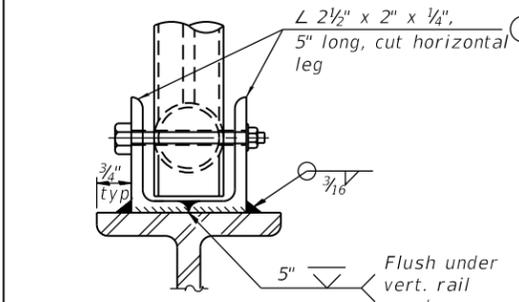


FRONT ELEVATION
(See above Elevations for dimensions.)

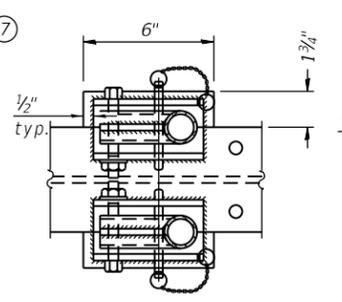


PLAN AT HANDRAIL JOINT
(For Details, see Elevations.)

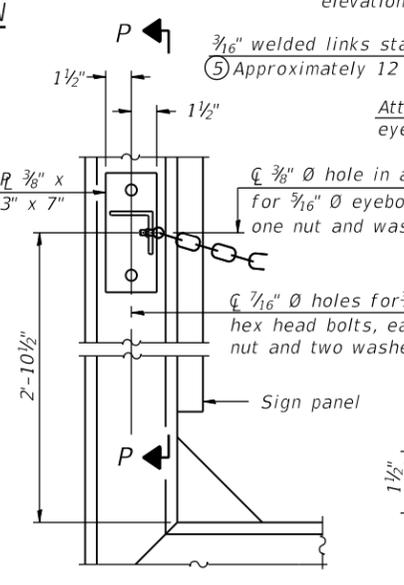

SAFETY CHAIN ATTACHMENT
(With Sign Present)
Items not shown same as "SIDE ELEVATION" and "SAFETY CHAIN"

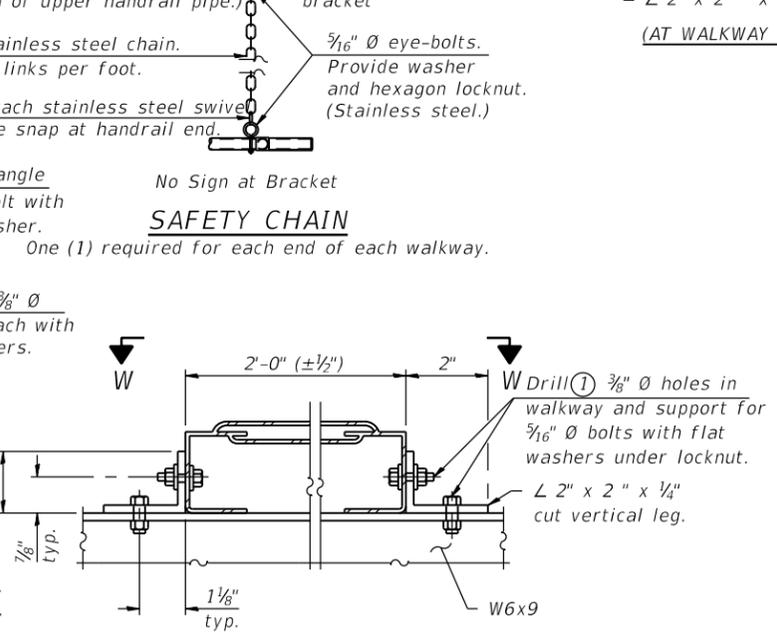

ALTERNATE FORMED PLANK GRATING DETAILS
Plank Grating: nominal depth = 2 1/2" (±1/2"); perforated or expanded steel sheet with a non-skid surface (non-serrated) concentrated load capacity = 500 lbs. with 6'-0" clear span.

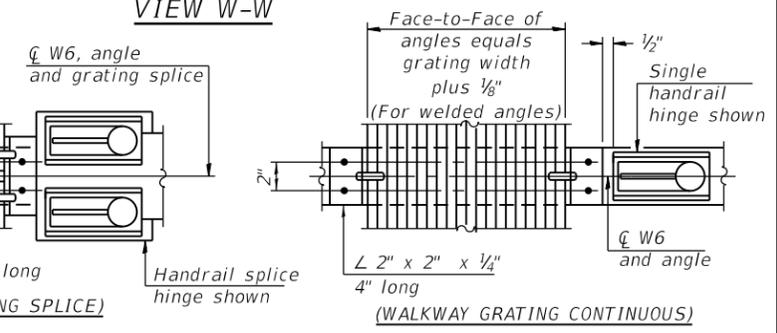

PLAN NOTES

- ① Drilling holes in grating may be done in shop or field, based on Contractor's preference and subject to accurate alignment. Field drilled holes must be touched up with galvanized paint.
- ② Horizontal rail member shall be continuous thru 1 1/4" Ø pipe. Provide 7/16" Ø hole in 1 1/4" Ø pipe for 3/8" Ø bolt. Field drill 7/16" Ø hole in horizontal rail member. Provide washer and locknut for bolt. (Use 5/16" eyebolts in 7/16" Ø holes on top rail at ends only.)
- ③ Install standard force-fit end caps or weld 1/8" end plates with 1/8" c.f.w. and grind smooth. (All rail ends.)
- ④ 3/8" (±1/4") gap between grating panels at splice.
- ⑤ Chain to be type 304L stainless steel suitable for prolonged exterior exposure. Approximately 3'-6" long chain per location. Maximum sag with handrail erected = 4".
- ⑥ R 1/8" x 1/2" x 2" welded to handrail posts to protect locations that contact grating.
- ⑦ Extrusions may be used in lieu of details shown, with approval by Engineer.
- ⑧ Field cut ends of light support channels shall be free of burrs or hazardous projections and coated with zinc-rich primer or equivalent.

BM-4 2-17-2017

WELDED BAR GRATING DETAILS

USER NAME =	charles.pigozzi	DESIGNED -	CP, LAB	REVISED -	
PLOT SCALE =	N.T.S	CHECKED -	JJS, MAI	REVISED -	
PLOT DATE =	1/24/2020	DRAWN -	CP	REVISED -	
		CHECKED -	JJS, MAI	REVISED -	

STATE OF ILLINOIS DEPARTMENT OF TRANSPORTATION




BRIDGE MOUNT SIGN STRUCTURES WALKWAY DETAILS

F.A.I. RTE.	SECTION	COUNTY	TOTAL SHEETS	SHEET NO.
90/94/290	2015-019R	COOK	2155	1030
CONTRACT NO. 62A76				

SHEET NO. SS80 OF SS129 SHEETS

ILLINOIS FED. AID PROJECT

FILE NAME: D:\V\AECOM-NA-AW51...recomonline-local\AECOM_D502_NAD\Documents\01_Americas\Transportation\620269938_Circle\Phase_I\1000_CAD\008_Structural\Sign_Structures\62A76-BM-SS305-Special-SignStruct.dgn

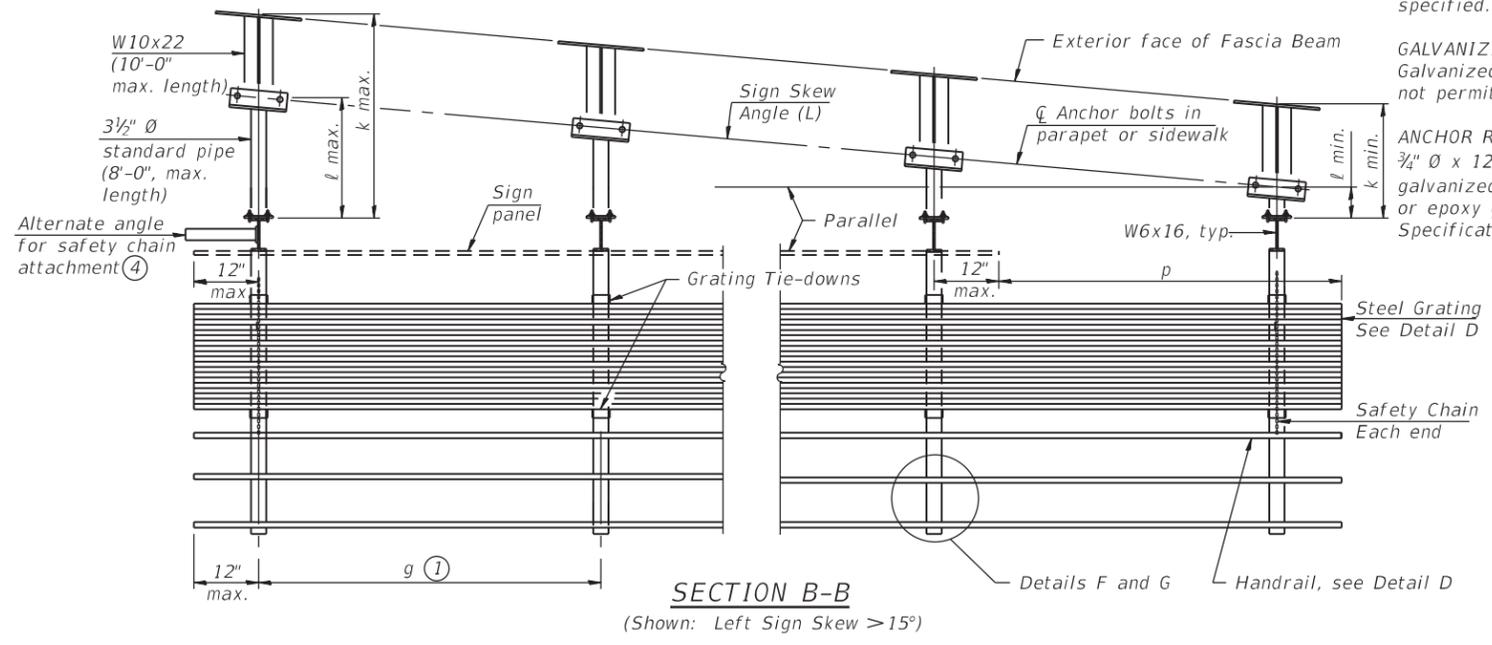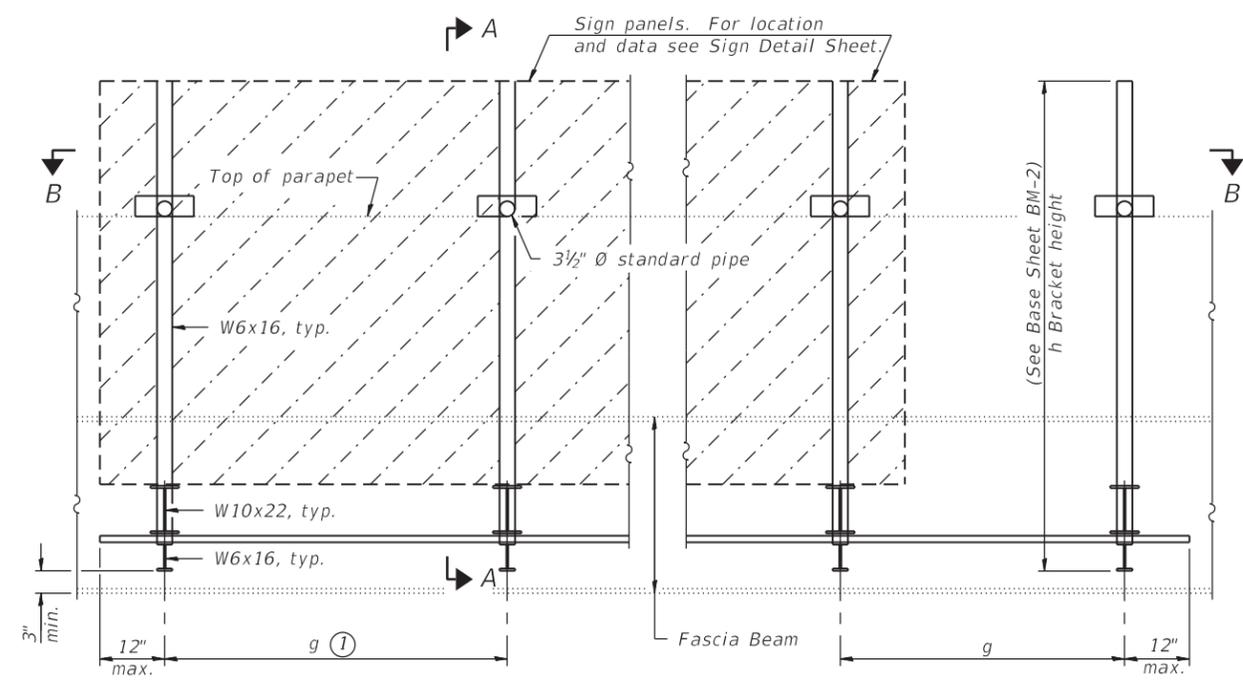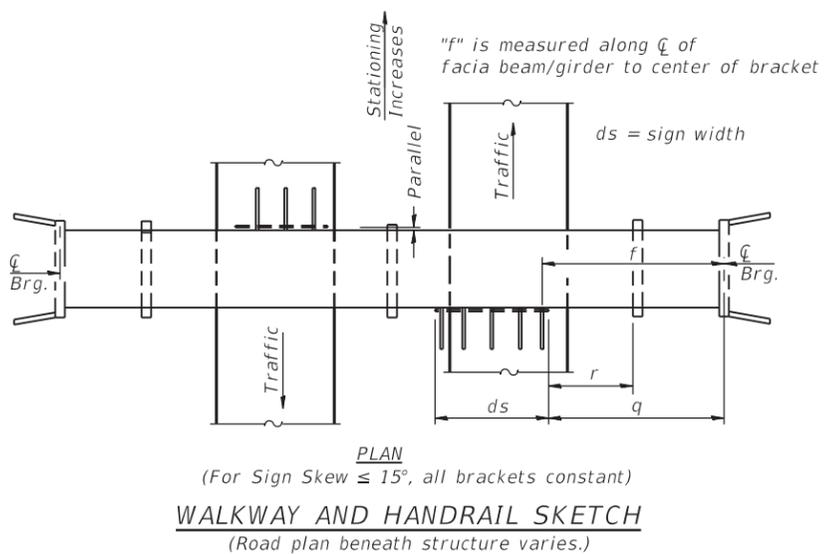

NOTES:

1. "q" is measured from \bar{C} Brg. of abutment along \bar{C} of fascia beam/girder to edge of sign.
2. "r" is measured from face of pier along \bar{C} of fascia beam/girder to edge of sign.
3. Walkway grating, walkway brackets, handrail, lighting and associated components will not be installed in Contract 62A76.

Dimensions f & g may vary as approved by the Engineer, see ①.
When $cw < cs$ and/or $dw < ds$, use alternate brackets without walkway supports where applicable, see ③.

GENERAL NOTES

SPECIFICATIONS:
DESIGN: AASHTO Standard Specifications for Structural Supports for Highway Signs, Luminaires and Traffic Signals. ("AASHTO Specifications")^②
CONSTRUCTION: Current (at time of letting) Illinois Department of Transportation Standard Specifications for Road and Bridge Construction, Supplemental Specifications and Special Provisions. ("Standard Specifications")
LOADING: 90 M.P.H. WIND VELOCITY
WALKWAY LOADING: Dead load plus 500 lbs. concentrated live load.
MINIMUM CLEARANCE: 3" greater than bridge members at all locations. (All Obstructions)
WELDING: All welds to be continuous unless otherwise shown. All welding to be done in accordance with current AWS D1.1 Structural Welding Code (Steel) and the Standard Specifications.
MATERIALS: All Structural Steel Pipe shall be ASTM A53 Grade B with a minimum yield of 35,000 p.s.i., or A500 Grade B or C with a minimum yield of 46,000 p.s.i. If A500 pipe is substituted for A53, then the outside diameter shall be as detailed and wall thickness greater than or equal to A53. All Structural Steel Plates and Shapes shall conform to AASHTO M270 Gr. 36, Gr. 50 (M183, M223 Gr. 50.).
HIGH STRENGTH BOLTS: All bolts, washers, nuts and locknuts shall satisfy the requirements of ASTM designation A307 unless noted as "H.S." which shall require AASHTO M164 (A325), ASTM A449, or approved alternate. All fasteners shall be hot dip galvanized per AASHTO M232 unless otherwise specified.

GALVANIZING: All Steel Grating, Plates, Shapes and Pipe shall be Hot Dip Galvanized after fabrication in accordance with AASHTO M111. Painting is not permitted.
ANCHOR RODS: All-threaded rod shall conform to ASTM F1554 Grade 105, 3/4" \bar{O} x 12" long, each with one plate washer and locknut and be hot dip galvanized per AASHTO M232. They shall be either cast into the concrete or epoxy grouted in accordance with Section 584 of the Standard Specifications. Minimum embedment in concrete shall be 9".

- ① Bracket spacing $g \leq 6'-0"$, max. Spacing shall be uniform if possible but may vary $\pm 6"$ to miss existing obstruction (rail post, light poles, web stiffeners, splice plates, etc.). Adjust bracket lengths accordingly on skewed structures.
- ② Any design modifications shall be based on the current version of applicable specifications and submitted for the Engineer's approval.
- ③ Unit price includes grating, handrail, brackets, supports, anchor bolts, fasteners, fabrication, delivery, erection, field drilling and other necessary items. Limits of payment are based on sign width (ds). For Safety Chain Details and Details D, F and G, see Sheet SS84.
- ④ If walkway bracket at safety chain location is behind sign, add angle to bracket. See detail on Sheet SS84.



SIGNED: Moussa A. Issa
DR. MOUSSA A. ISSA, S.E., IL. LIC. NO. 081-005738
EXPIRES 11-30-2020
DATE: 01/29/2020 FOR SHEETS SS81 THRU SS84
(TOTAL OF 4 SHEETS)

Structure Number	Sign Skew Angle (L) or (R)	Bridge Station	Bridge Structure Number	Bridge Name	Contract Route Designation	ds	r	f	g	No. of Brackets (Total)	q
1B0161094L052.1	0°	7612+74.62	016-1165	Taylor Street	NB I-90/94	25'-6"	3'-5 1/2"	58'-6 1/4"	*	7	-

* Varies, see separate table

Structure Number	Bridge Name	g1	g2	g3	g4	g5-g6
1B0161094L052.1	Taylor Street	3'-10"	4'-1"	4'-4"	3'-10"	4'-1"

Note g1-g6 are numbered west to east

TOTAL BILL OF MATERIAL

③ OVERHEAD SIGN STRUCTURE-BRIDGE MOUNTED (SPECIAL)	Foot	26
--	------	----



USER NAME = charles.pigozzi	DESIGNED - CP, LAB	REVISED -
PLOT SCALE = N.T.S	CHECKED - JJS, MAI	REVISED -
PLOT DATE = 1/24/2020	DRAWN - CP	REVISED -
	CHECKED - JJS, MAI	REVISED -




STATE OF ILLINOIS
DEPARTMENT OF TRANSPORTATION

BRIDGE MOUNT SIGN STRUCTURES
GENERAL PLAN AND ELEVATION

SHEET NO. SS81 OF SS129 SHEETS

F.A.I. RTE.	SECTION	COUNTY	TOTAL SHEETS	SHEET NO.
90/94/290	2015-019R	COOK	2155	1031
CONTRACT NO. 62A76				
ILLINOIS FED. AID PROJECT				

FILE NAME: D:\V\AECOM-NA-AWS1\arecomonline\local\AECOM_ID502_NAVDocuments\01_Americas\Transportation\60269938_Circle\Phase_I\000_CAD\008_Structural\Sign_Structures\62A76-BM-SS306-Special-SignStruct.dgn

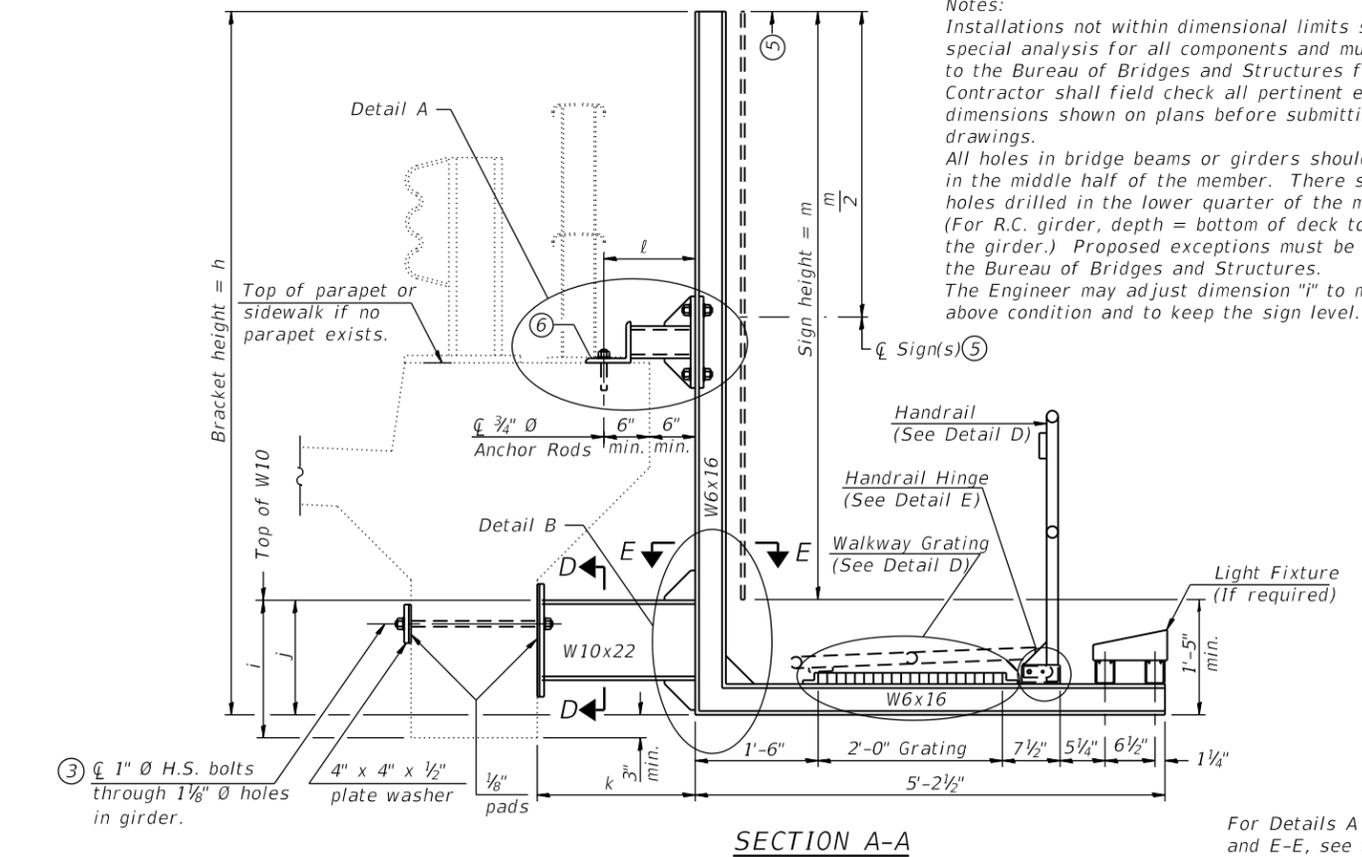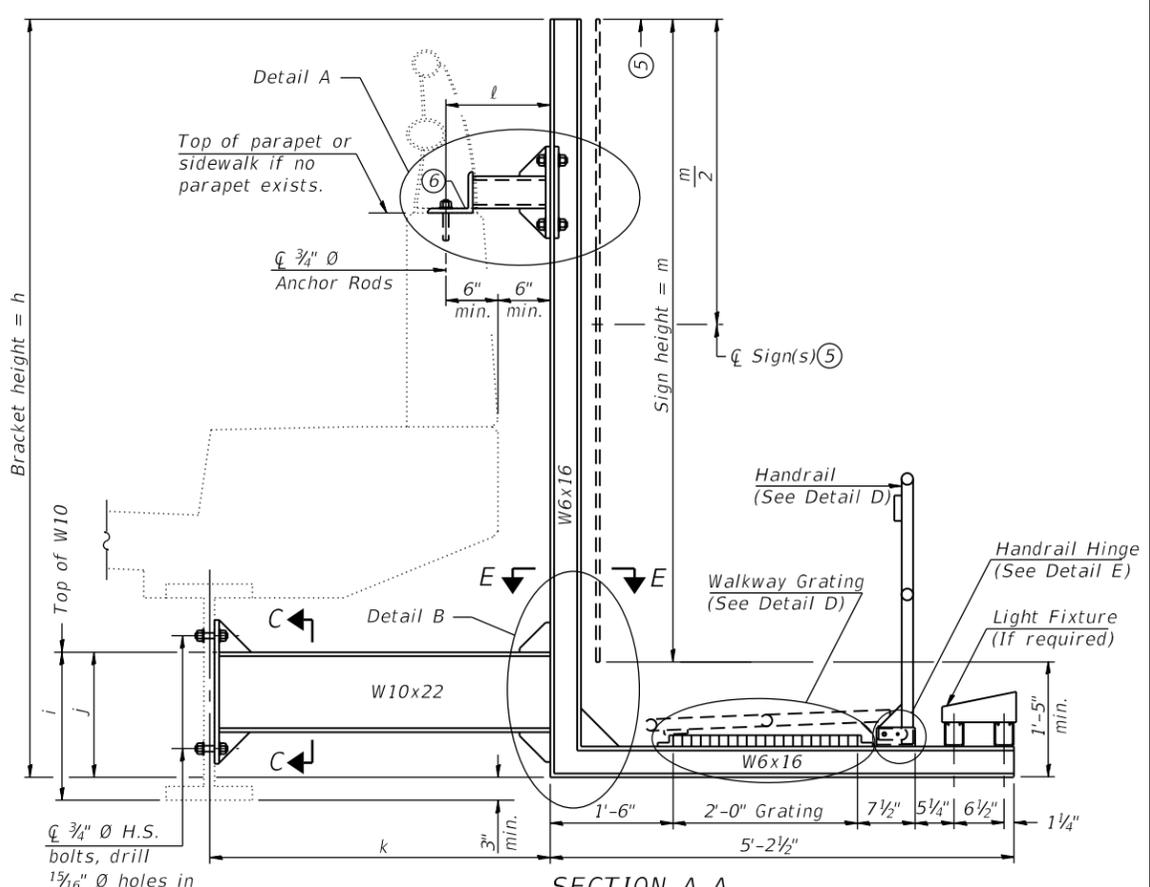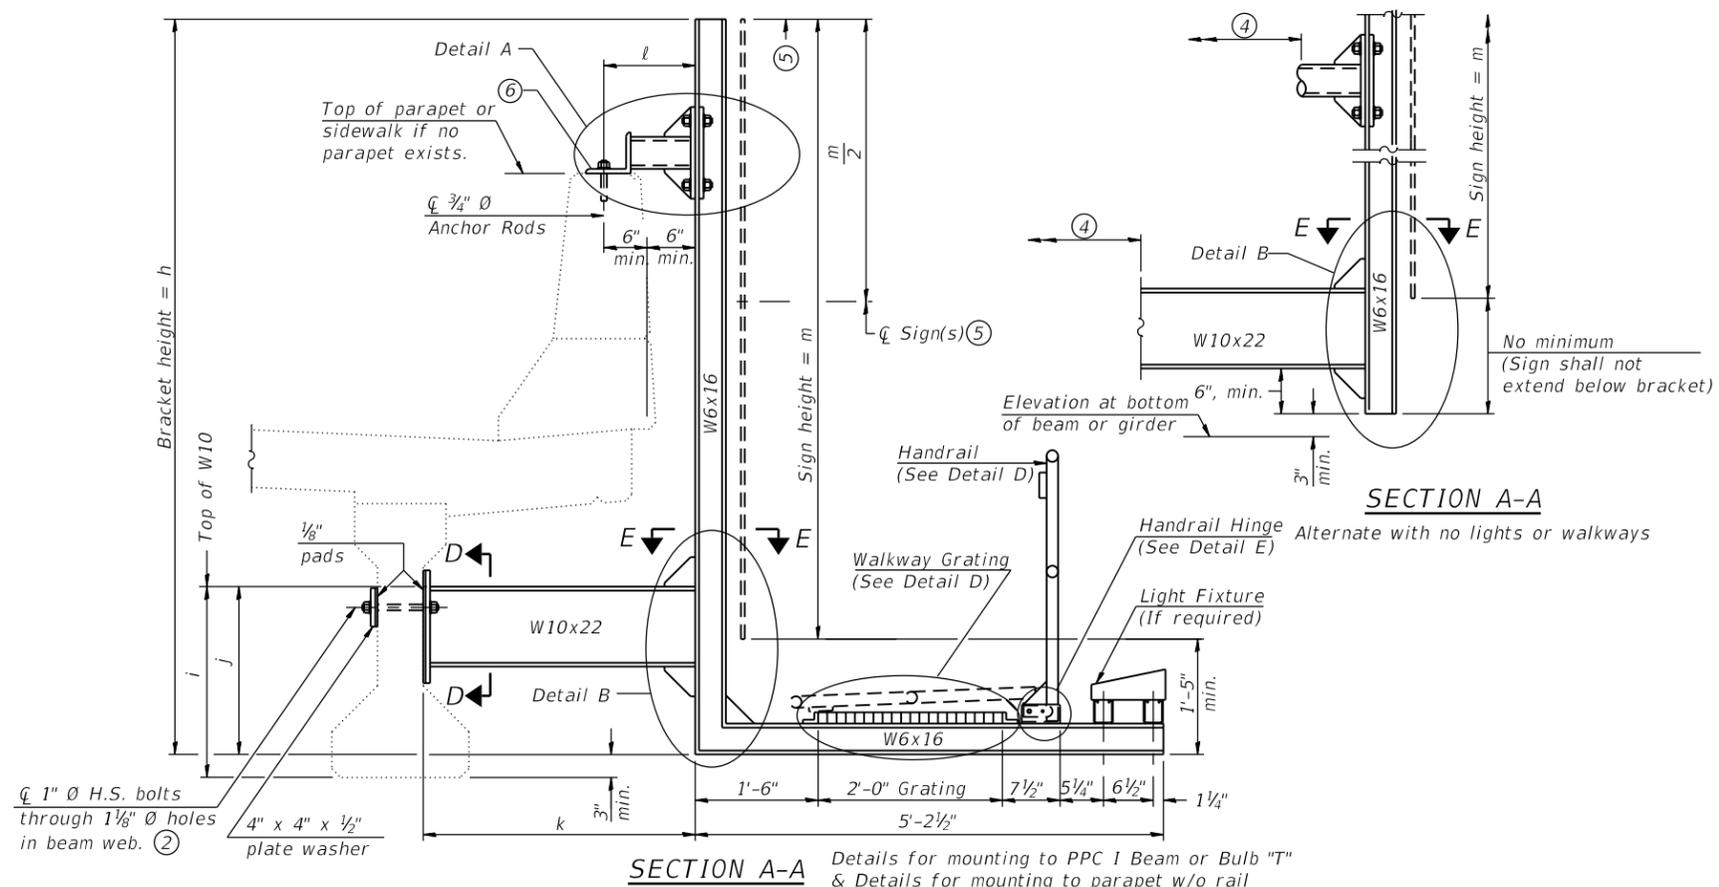

Notes:
Installations not within dimensional limits shown require special analysis for all components and must be submitted to the Bureau of Bridges and Structures for approval. Contractor shall field check all pertinent existing bridge dimensions shown on plans before submitting shop drawings.
All holes in bridge beams or girders should be located in the middle half of the member. There shall be no holes drilled in the lower quarter of the member's depth. (For R.C. girder, depth = bottom of deck to bottom of the girder.) Proposed exceptions must be approved by the Bureau of Bridges and Structures.
The Engineer may adjust dimension "i" to meet the above condition and to keep the sign level.

- ① Holes in new steel members may be drilled in the fabrication shop or in the field. Field drill existing members.
- ② For new PPC I beams, holes shall be formed during casting. For existing PPC I beams, prestressing strand locations shall be determined and spaced to miss strands by 6", min. Minimize spalling during field drilling of existing beams.
- ③ For new construction, form holes. For existing RC beams, locate primary reinforcement and space holes to miss by 6", min. Minimize spalling and concrete fracturing/damage during field drilling of existing concrete. Spalls over 1/4" deep or beyond the coverage of the 4x4 plate washer shall be repaired with epoxy mortar before installing washer.
- ④ For attachment details of 3 1/2" pipe and W10x22, see other sections as applicable.
- ⑤ Sign shall not extend more than 6" above top of bracket, and this dimension may vary to keep sign level if bridge is on grade or vertical curve. Multiple signs of various heights shall share a common horizontal centerline and use equal bracket heights. If no sign is attached to a W6x12 vertical (bracket only supporting walkway), dimension h shall be the same as an adjacent bracket with a sign attached, unless Engineer specifically directs shorter brackets due to locational restraints on future uses. (See Detail A for minimum bracket height.)
- ⑥ For bridge mounted sign structures installed on new bridges with railing, during design, bracket spacing must be coordinated with railing post spacing and the Contractor must install upper brackets prior to railing installation. For bridge mounted sign structures installed on existing bridges with railing, during design, brackets spacing must be coordinated with railing post spacing and the Contractor must temporarily remove sections of railing to facilitate upper bracket installation. If it is determined during design that existing railings can't be removed, alternate upper connection details must be developed for the contract plans and approved by the Bureau of Bridges and Structures.

NOTES:
1. Walkway grating, walkway brackets, handrail, lighting, and associated components of the sign structure/sign panel will not be installed.

Structure Number	Bridge Name	Bridge Station	h	i	j	k max. (10'-0" max.)	l max. (8'-0" max.)	m
1B0161094L052.1	Taylor Street	7612+74.62	16'-10"	2'-1"	1'-4 1/2"	2'-7"	1'-0"	16'-0"

For Details A & B, Sections C-C, D-D and E-E, see Sheet SS83.
For Details D & E, see Sheet SS84.

BM-2-SPECIAL 2-17-2017



USER NAME = charles.pigozzi	DESIGNED - CP, LAB	REVISED -
PLOT SCALE = N.T.S	CHECKED - JJS, MAI	REVISED -
PLOT DATE = 1/24/2020	DRAWN - CP	REVISED -
	CHECKED - JJS, MAI	REVISED -


STATE OF ILLINOIS
DEPARTMENT OF TRANSPORTATION

BRIDGE MOUNT SIGN STRUCTURES
WALKWAY AND CONNECTION DETAILS


SHEET NO. SS82 OF SS129 SHEETS

F.A.I. RTE. 90/94/290	SECTION 2015-019R	COUNTY COOK	TOTAL SHEETS 2155	SHEET NO. 1032
CONTRACT NO. 62A76				
ILLINOIS FED. AID PROJECT				


FILE NAME: D:\VAECOM\NA-AWS1\aecononline\local\AECON_ID502_NAVDocuments\01_Americas\Transportation\60269938_Circle\Phase_I\000_CAD\008_Structural\Sign_Structures\62A76-BM-SS308-Special-SignStruct.dgn

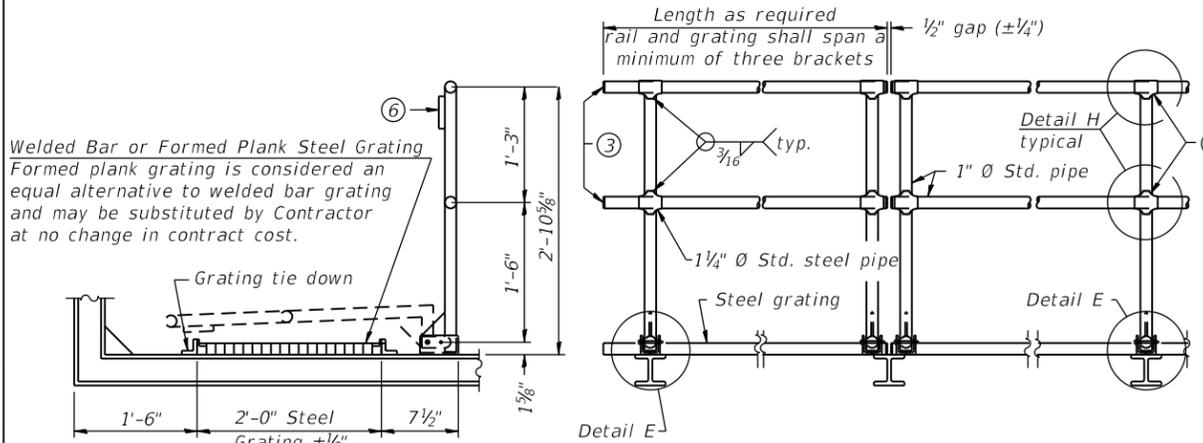


SIDE ELEVATION DETAIL D HANDRAIL FRONT ELEVATION

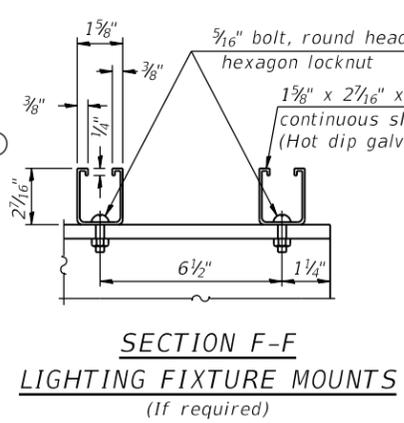


SECTION F-F LIGHTING FIXTURE MOUNTS (If required)

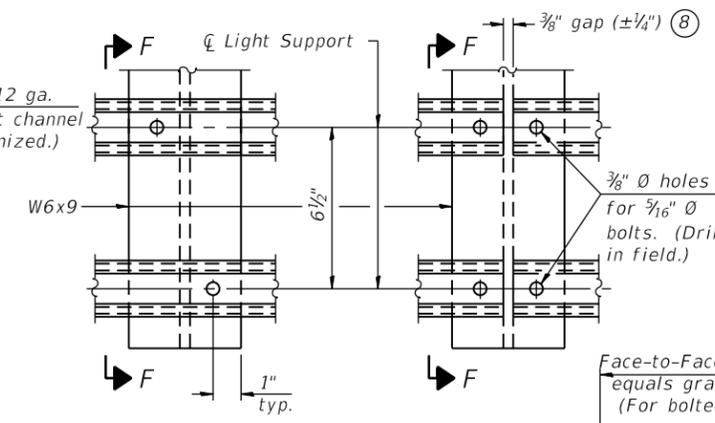


DETAIL F DETAIL G

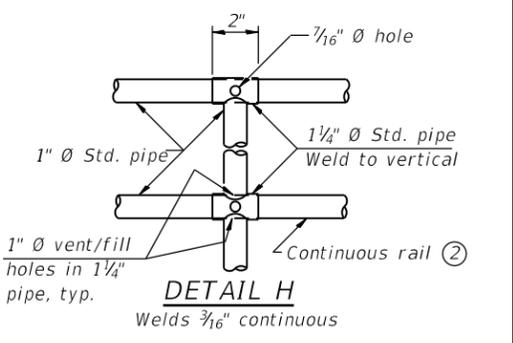


DETAIL H

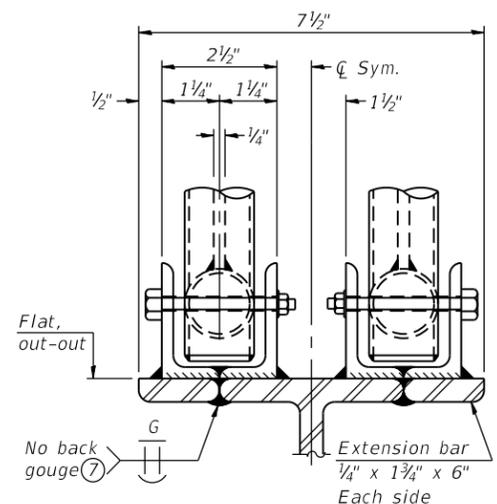


ELEVATION AT HANDRAIL JOINT

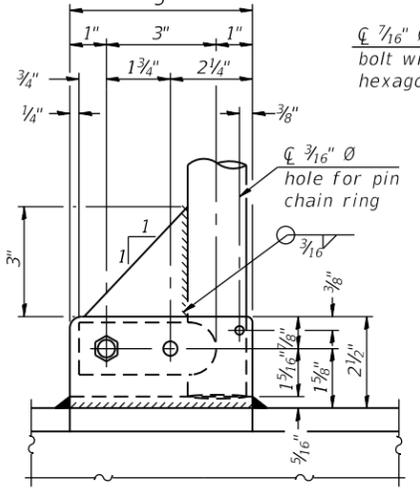


SIDE ELEVATION

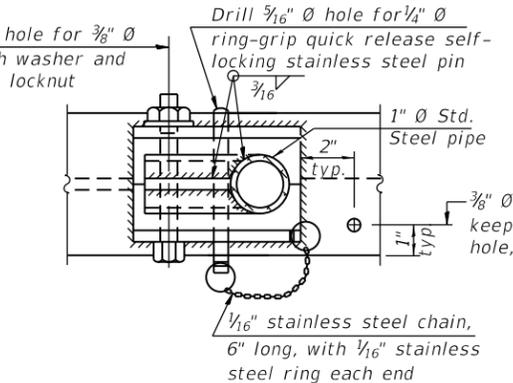


PLAN AT SINGLE HANDRAIL HINGE DETAIL E

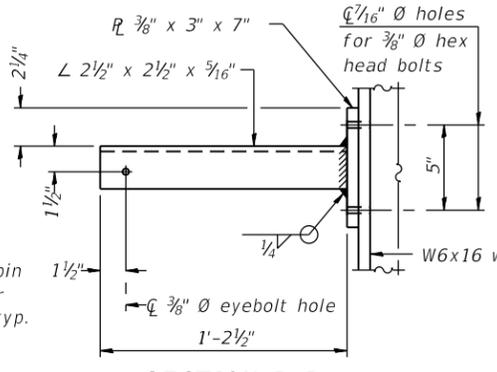


SECTION P-P

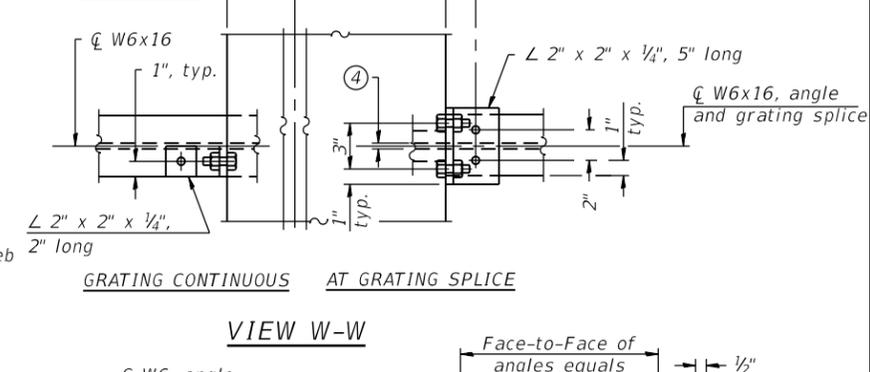


VIEW W-W

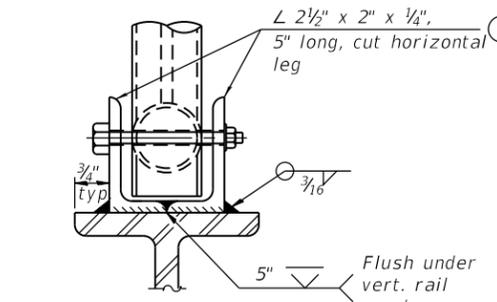


FRONT ELEVATION

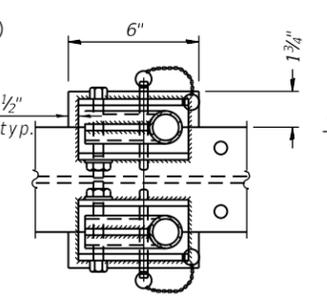


PLAN AT HANDRAIL JOINT

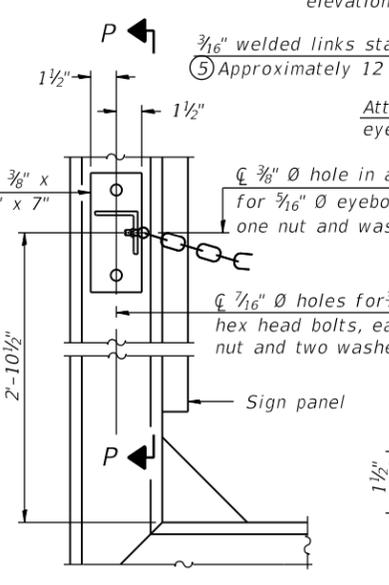


SAFETY CHAIN ATTACHMENT

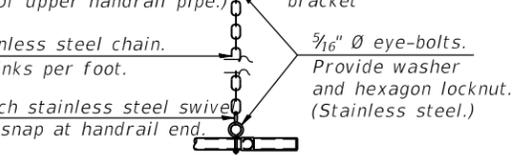

SAFETY CHAIN

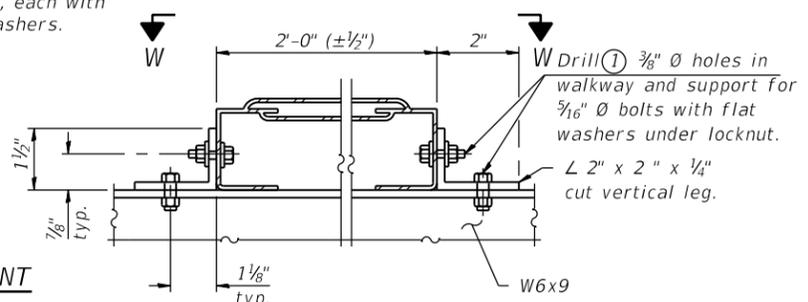

ALTERNATE FORMED PLANK GRATING DETAILS

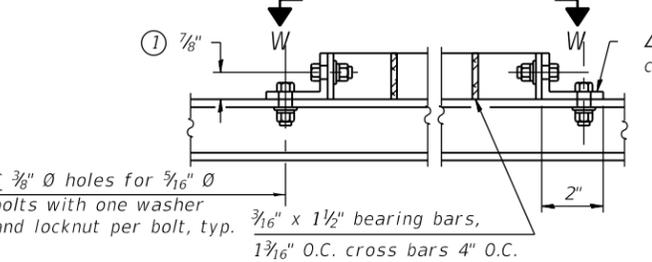

WELDED BAR GRATING DETAILS

- NOTES**
- Drilling holes in grating may be done in shop or field, based on Contractor's preference and subject to accurate alignment. Field drilled holes must be touched up with galvanized paint.
 - Horizontal rail member shall be continuous thru 1 1/4" Std. pipe. Provide 7/16" hole in 1 1/4" Std. pipe for 3/8" bolt. Field drill 7/16" hole in horizontal rail member. Provide washer and locknut for bolt. (Use 7/16" eyebolts in 7/16" holes on top rail at ends only.)
 - Install standard force-fit end caps or weld 1/8" end plates with 1/8" c.f.w. and grind smooth. (All rail ends.)
 - 3/8" (±1/4") gap between grating panels at splice.
 - Chain to be type 304L stainless steel suitable for prolonged exterior exposure. Approximately 3'-6" long chain per location. Maximum sag with handrail erected = 4".
 - R 1/8" x 1/2" x 2" welded to handrail posts to protect locations that contact grating.
 - Extrusions may be used in lieu of details shown, with approval by Engineer.
 - Field cut ends of light support channels shall be free of burrs or hazardous projections and coated with zinc-rich primer or equivalent.

BM-4-SPECIAL 2-17-2017



USER NAME =	charles.pigozzi	DESIGNED -	CP, LAB	REVISED -	
PLOT SCALE =	N.T.S	CHECKED -	JJS, MAI	REVISED -	
PLOT DATE =	1/24/2020	DRAWN -	CP	REVISED -	
		CHECKED -	JJS, MAI	REVISED -	

STATE OF ILLINOIS
DEPARTMENT OF TRANSPORTATION


BRIDGE MOUNT SIGN STRUCTURES
WALKWAY DETAILS

F.A.I. RTE.	SECTION	COUNTY	TOTAL SHEETS	SHEET NO.
90/94/290	2015-019R	COOK	2155	1034
CONTRACT NO. 62A76				


SHEET NO. SS84 OF SS129 SHEETS

ILLINOIS FED. AID PROJECT


FILE NAME: D:\V\AECOM-NA-AW51...recomonline-local\AECOM_DS02_NAVDocuments\01_Americas\Transportation\60269938_Circle\Phase_I\000_CAD\008_Structural\Sign_Structures\62A76-Sign_Structures\62A76-Sign_Structures\62A76-Sign_Structures.dgn

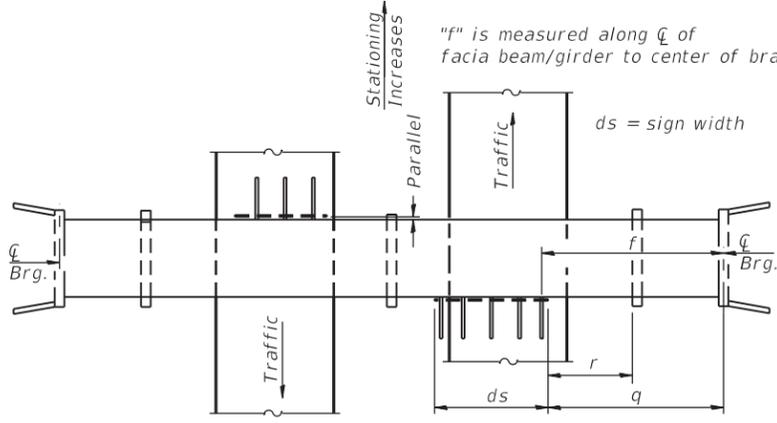

PLAN
(For Sign Skew $\leq 15^\circ$, all brackets constant)
WALKWAY AND HANDRAIL SKETCH
(Road plan beneath structure varies.)

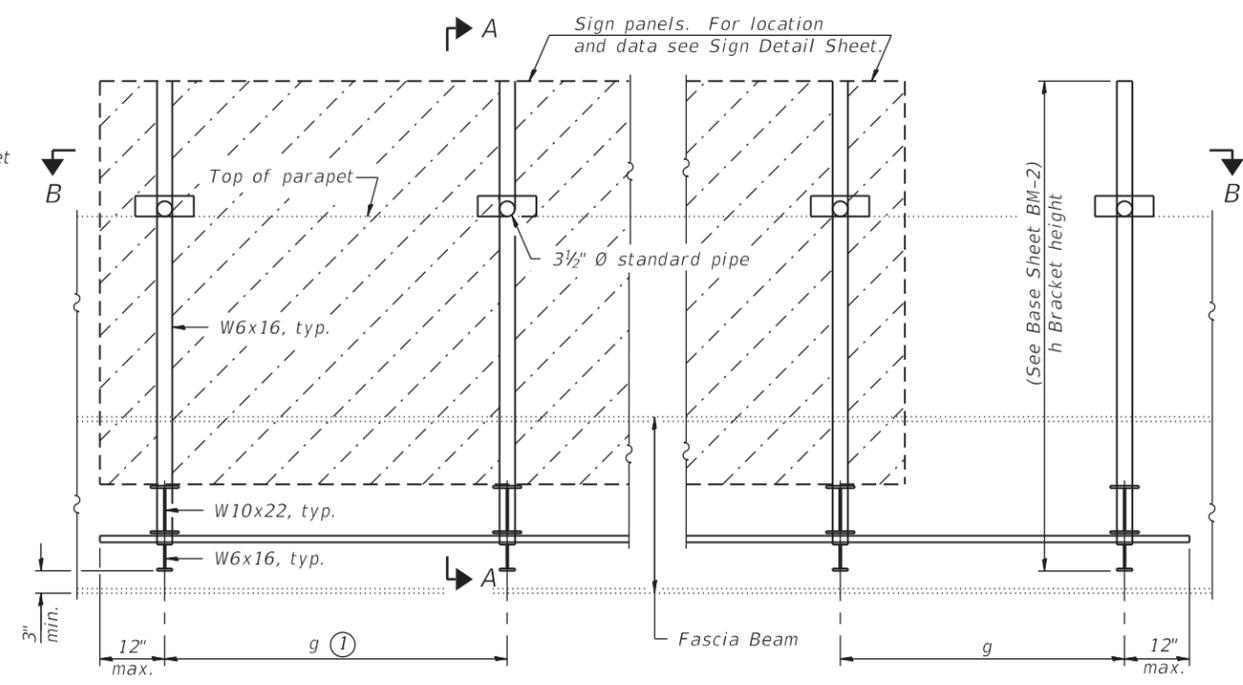

TYPICAL FRONT ELEVATION
(With lights, safety chain and handrail omitted for clarity.)

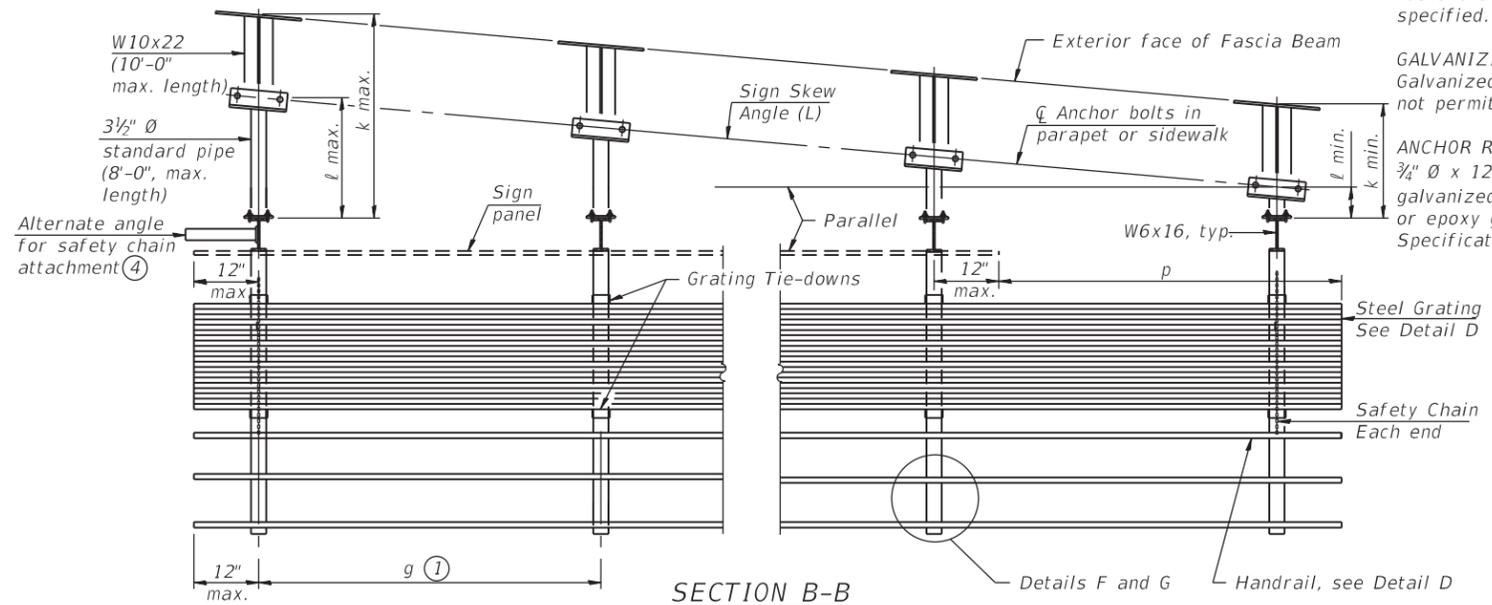

SECTION B-B
(Shown: Left Sign Skew $> 15^\circ$)

Dimensions f & g may vary as approved by the Engineer, see ①.

GENERAL NOTES

- SPECIFICATIONS:**
- DESIGN:** AASHTO Standard Specifications for Structural Supports for Highway Signs, Luminaires and Traffic Signals. ("AASHTO Specifications") ②
- CONSTRUCTION:** Current (at time of letting) Illinois Department of Transportation Standard Specifications for Road and Bridge Construction, Supplemental Specifications and Special Provisions. ("Standard Specifications")
- LOADING:** 90 M.P.H. WIND VELOCITY
- WALKWAY LOADING:** Dead load plus 500 lbs. concentrated live load.
- MINIMUM CLEARANCE:** 3" greater than bridge members at all locations. (All Obstructions)
- WELDING:** All welds to be continuous unless otherwise shown. All welding to be done in accordance with current AWS D1.1 Structural Welding Code (Steel) and the Standard Specifications.
- MATERIALS:** All Structural Steel Pipe shall be ASTM A53 Grade B with a minimum yield of 35,000 p.s.i., or A500 Grade B or C with a minimum yield of 46,000 p.s.i. If A500 pipe is substituted for A53, then the outside diameter shall be as detailed and wall thickness greater than or equal to A53. All Structural Steel Plates and Shapes shall conform to AASHTO M270 Gr. 36, Gr. 50 (M183, M223 Gr. 50).
- HIGH STRENGTH BOLTS:** All bolts, washers, nuts and locknuts shall satisfy the requirements of ASTM designation A307 unless noted as "H.S." which shall require AASHTO M164 (A325), ASTM A449, or approved alternate. All fasteners shall be hot dip galvanized per AASHTO M232 unless otherwise specified.
- GALVANIZING:** All Steel Grating, Plates, Shapes and Pipe shall be Hot Dip Galvanized after fabrication in accordance with AASHTO M111. Painting is not permitted.
- ANCHOR RODS:** All-threaded rod shall conform to ASTM F1554 Grade 105, 3/4" \emptyset x 12" long, each with one plate washer and locknut and be hot dip galvanized per AASHTO M232. They shall be either cast into the concrete or epoxy grouted in accordance with Section 584 of the Standard Specifications. Minimum embedment in concrete shall be 9".

- ① Bracket spacing $g \leq 6'-0"$, max. Spacing shall be uniform if possible but may vary $\pm 6"$ to miss existing obstruction (rail post, light poles, web stiffeners, splice plates, etc.). Adjust bracket lengths accordingly on skewed structures.
- ② Any design modifications shall be based on the current version of applicable specifications and submitted for the Engineer's approval.
- ③ Unit price includes grating, handrail, brackets, supports, anchor bolts, fasteners, fabrication, delivery, erection, field drilling and other necessary items. Limits of payment are based on sign width (ds). For Safety Chain Details and Details D, F and G, see Sheet SS89.
- ④ If walkway bracket at safety chain location is behind sign, add angle to bracket. See detail on Sheet SS89.

NOTES:

- 1. "q" is measured from centerline of abutment along centerline of fascia beam/girder to edge of sign.
- 2. "r" is measured from face of pier along centerline of fascia beam/girder to edge of sign.
- 3. Walkway grating, walkway brackets, handrail, lighting and associated components will not be installed in Contract 62A76.

Structure Number	Sign Skew Angle (L) or (R)	Bridge Station	Bridge Structure Number	Bridge Name	Contract Route Designation	ds	r	f	g	No. of Brackets (Total)	q
1B0161094L52.2	0°	6+37.37	016-0478	Roosevelt Road	NB 1-90/94	56'-6"	-	38'-2"	*	12	37'-7 7/8"

Note the following brackets shall be placed at the locations of existing holes in the beams:
1B0161094L52.2 (Roosevelt Rd): brackets 7-11
* Varies, see separate table
Note brackets 1-12 and spacing g1-g11 are numbered west to east.

Structure Number	Bridge Name	g1	g2-g3	g4	g5	g6	g7-g8	g9	g10	g11
1B0161094L52.2	Roosevelt Road	5'-7 1/4"	5'-0"	4'-0"	5'-10"	4'-0"	4'-11"	5'-0 1/2"	5'-3 1/2"	5'-11 1/2"



SIGNED: Moussa A. Issa
DR. MOUSSA A. ISSA, S.E., IL. LIC. NO. 081-005738
EXPIRES 11-30-2020

DATE 01/29/2020 FOR SHEETS SS85 THRU SS89
(TOTAL OF 5 SHEETS)

TOTAL BILL OF MATERIAL

③ OVERHEAD SIGN STRUCTURE-BRIDGE MOUNTED (SPECIAL)	Foot	57
--	------	----



USER NAME = charles.pigozzi	DESIGNED - CP, LAB	REVISED -
PLOT SCALE = N.T.S	CHECKED - JJS, MAI	REVISED -
PLOT DATE = 1/24/2020	DRAWN - CP	REVISED -
	CHECKED - JJS, MAI	REVISED -


STATE OF ILLINOIS
DEPARTMENT OF TRANSPORTATION

BRIDGE MOUNT SIGN STRUCTURES
GENERAL PLAN AND ELEVATION

SHEET NO. SS85 OF SS129 SHEETS

F.A.I. RTE.	SECTION	COUNTY	TOTAL SHEETS	SHEET NO.
90/94/290	2015-019R	COOK	2155	1035
CONTRACT NO. 62A76				
ILLINOIS FED. AID PROJECT				

FILE NAME: D:\V\AECOM\NA-AWS1\arecomonline-local\AECOM_DS02_NA\Documents\01_Amerikas\Transportation\60269938_Circle\Phase_I\000_CAD\008_Structural\Sign_Structures\62A76-Sign_Structure\62A76-BM-SS309A-Special-SignStruct.dgn

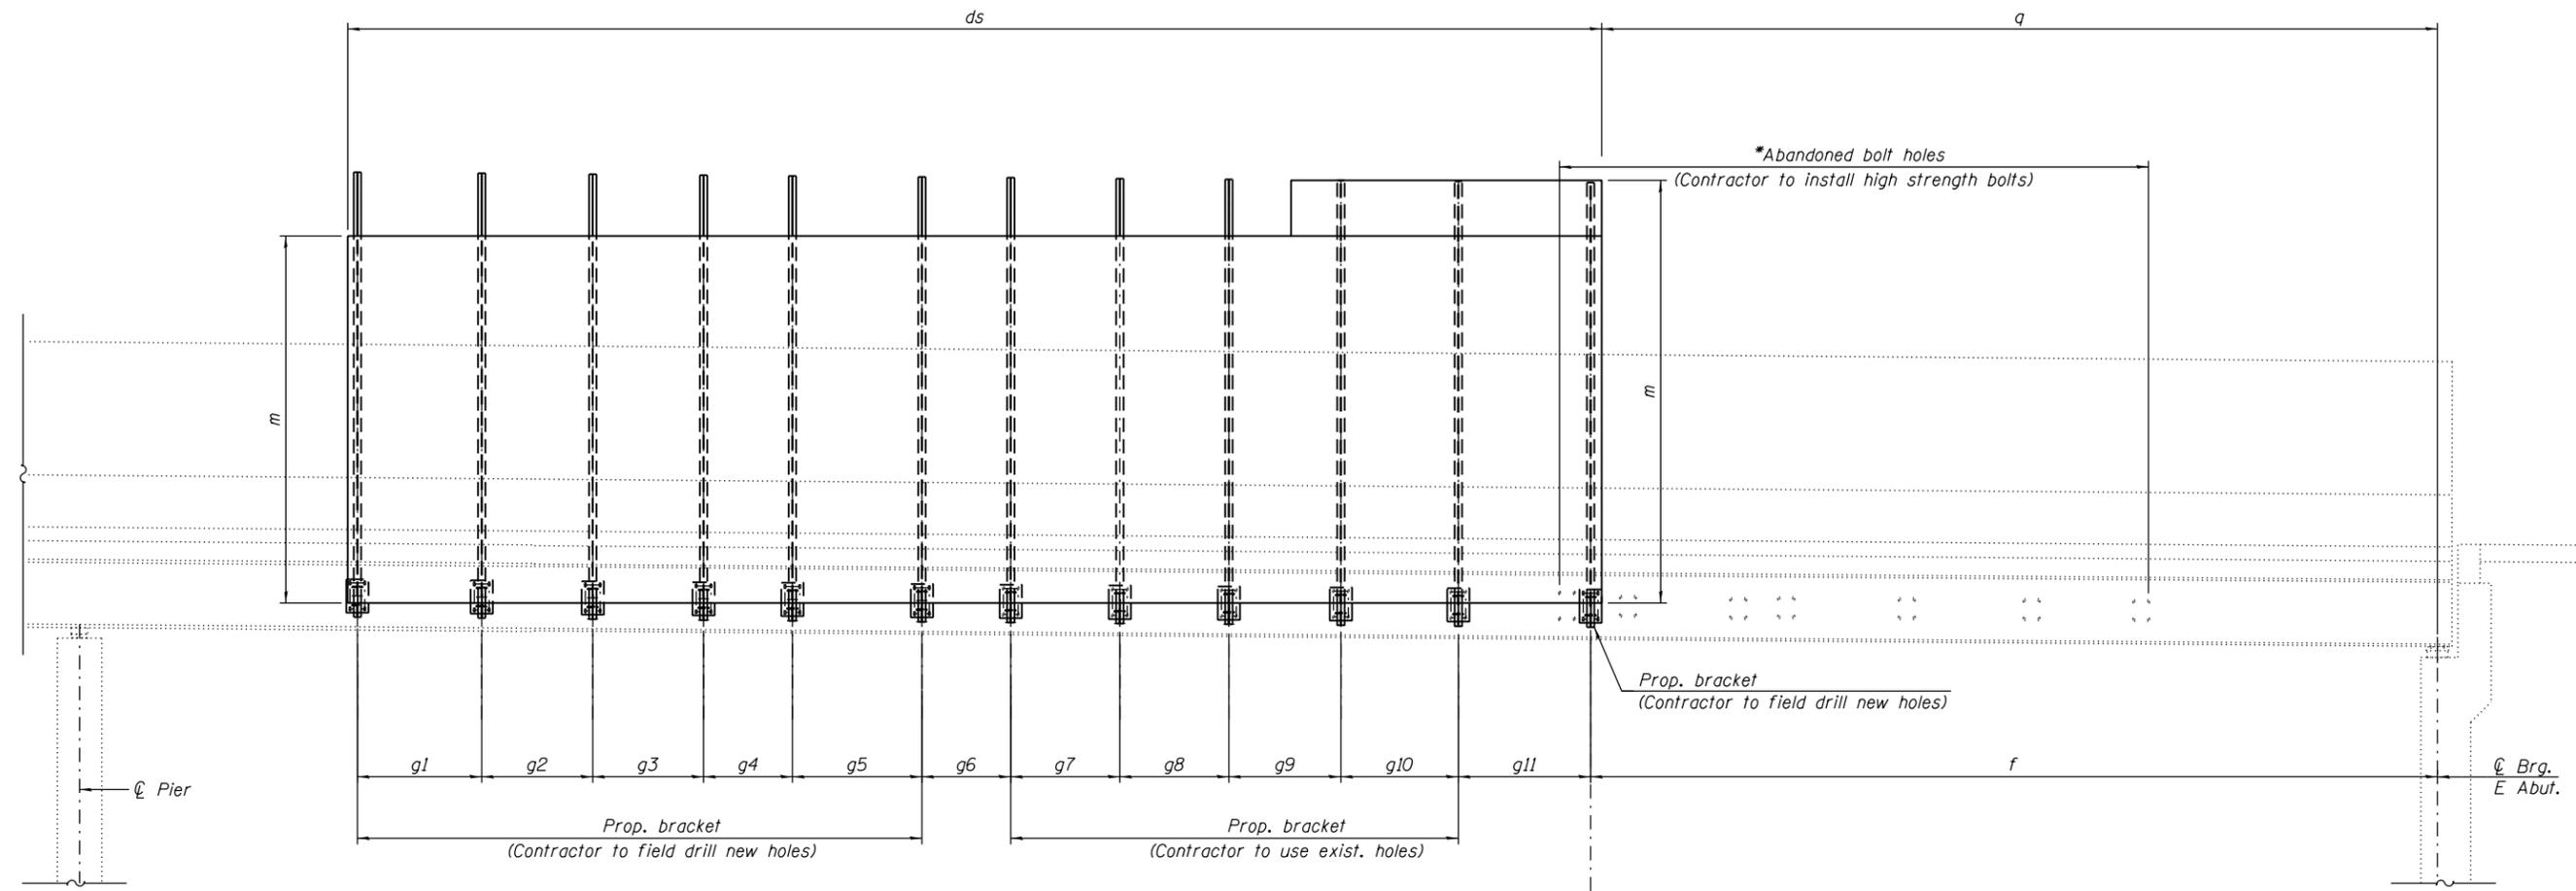

ELEVATION - SN 1B016I094L52.2
 South Fascia Girder of Roosevelt Road Bridge SN 016-0478
 Looking North

* After bridge mounted sign brackets are removed, any open holes in existing fascia beams shall be filled with HS Bolts with washers. Bolts shall be 3/4" diameter ASTM A325, Type 1 hot-dipped galvanized. Cost shall be included with Remove Overhead Sign Structure.

Areas on the existing fascia beam where the bridge mounted sign brackets are removed shall be cleaned per Power Tool Cleaning to Bare Metal SSPC-SP-11 and painted as required by the Special Provision "Cleaning and Painting Contact Surface Areas of Existing Steel Structures". All structural steel shall be shop painted with the inorganic zinc rich primer per AASHTO M300, Type 1. The color of the primer shall be Reddish Brown, Munsell No. 2.5YR 3/4. Cost shall be included with Remove Overhead Sign Structure.



USER NAME =	charles.pigozzi	DESIGNED -	AMS, LAB	REVISED -	
		CHECKED -	JJS, MAI	REVISED -	
PLOT SCALE =	N.T.S	DRAWN -	AMS	REVISED -	
PLOT DATE =	1/24/2020	CHECKED -	JJS, MAI	REVISED -	




STATE OF ILLINOIS
 DEPARTMENT OF TRANSPORTATION

BRIDGE MOUNT SIGN STRUCTURES
 ELEVATION

SHEET NO. SS86 OF SS129 SHEETS

F.A.I. RTE.	SECTION	COUNTY	TOTAL SHEETS	SHEET NO.
90/94/290	2015-019R	COOK	2155	1036
CONTRACT NO. 62A76				
ILLINOIS		FED. AID PROJECT		

FILE NAME: D:\V\AECOM-NA-AWS1_aecomonline-local\AECOM_DS02_NAVDocuments\01_Americas\Transportation\60269938_Circle\Phase_I\000_CAD\008_Structural\Sign_Structures\62A76-BM-SS310-Special-SignStruct.dgn

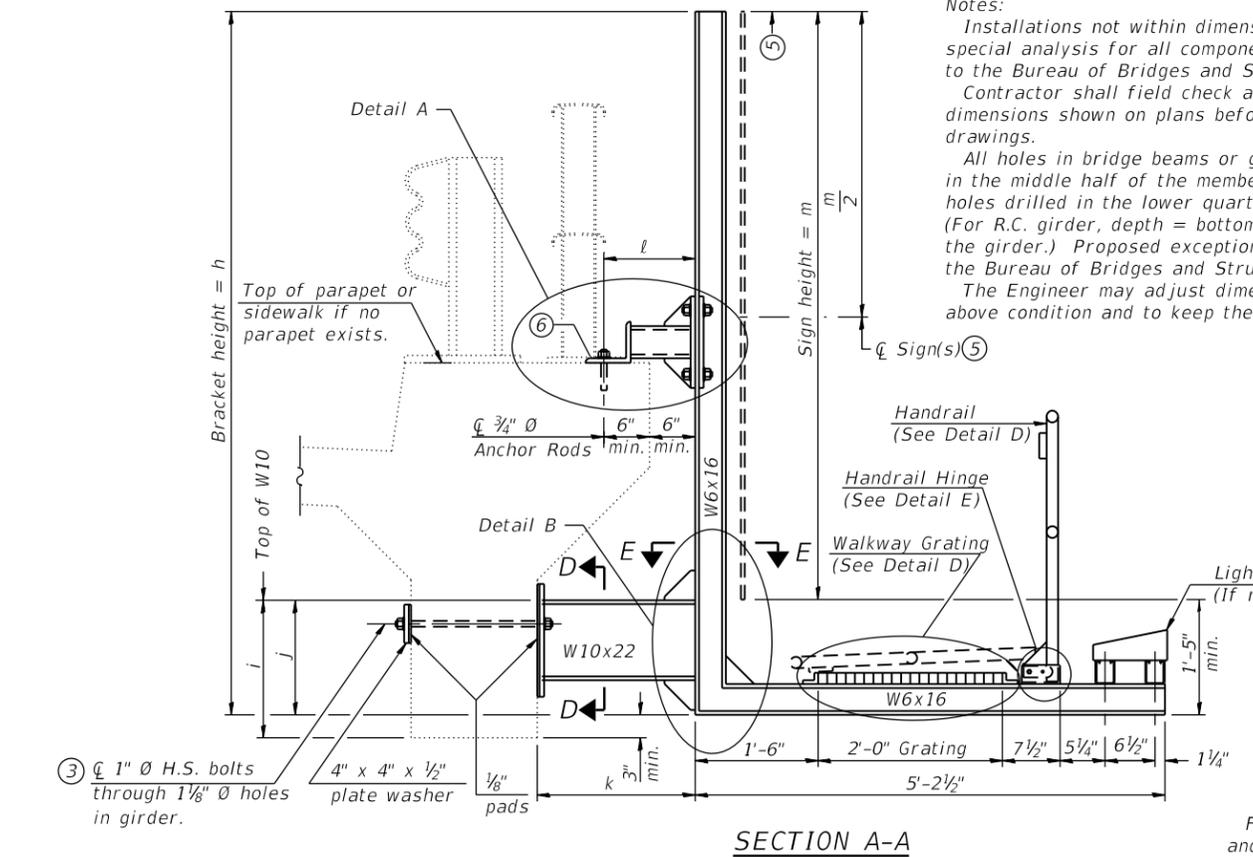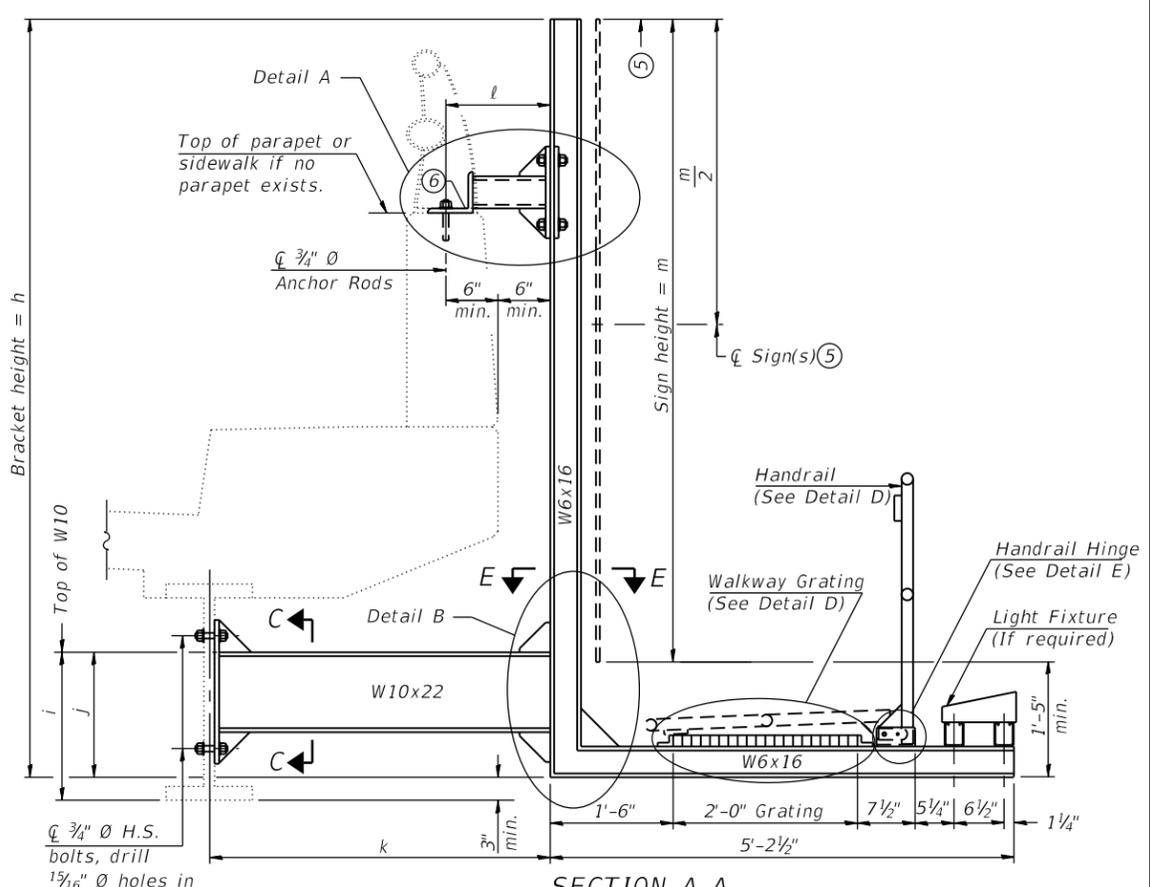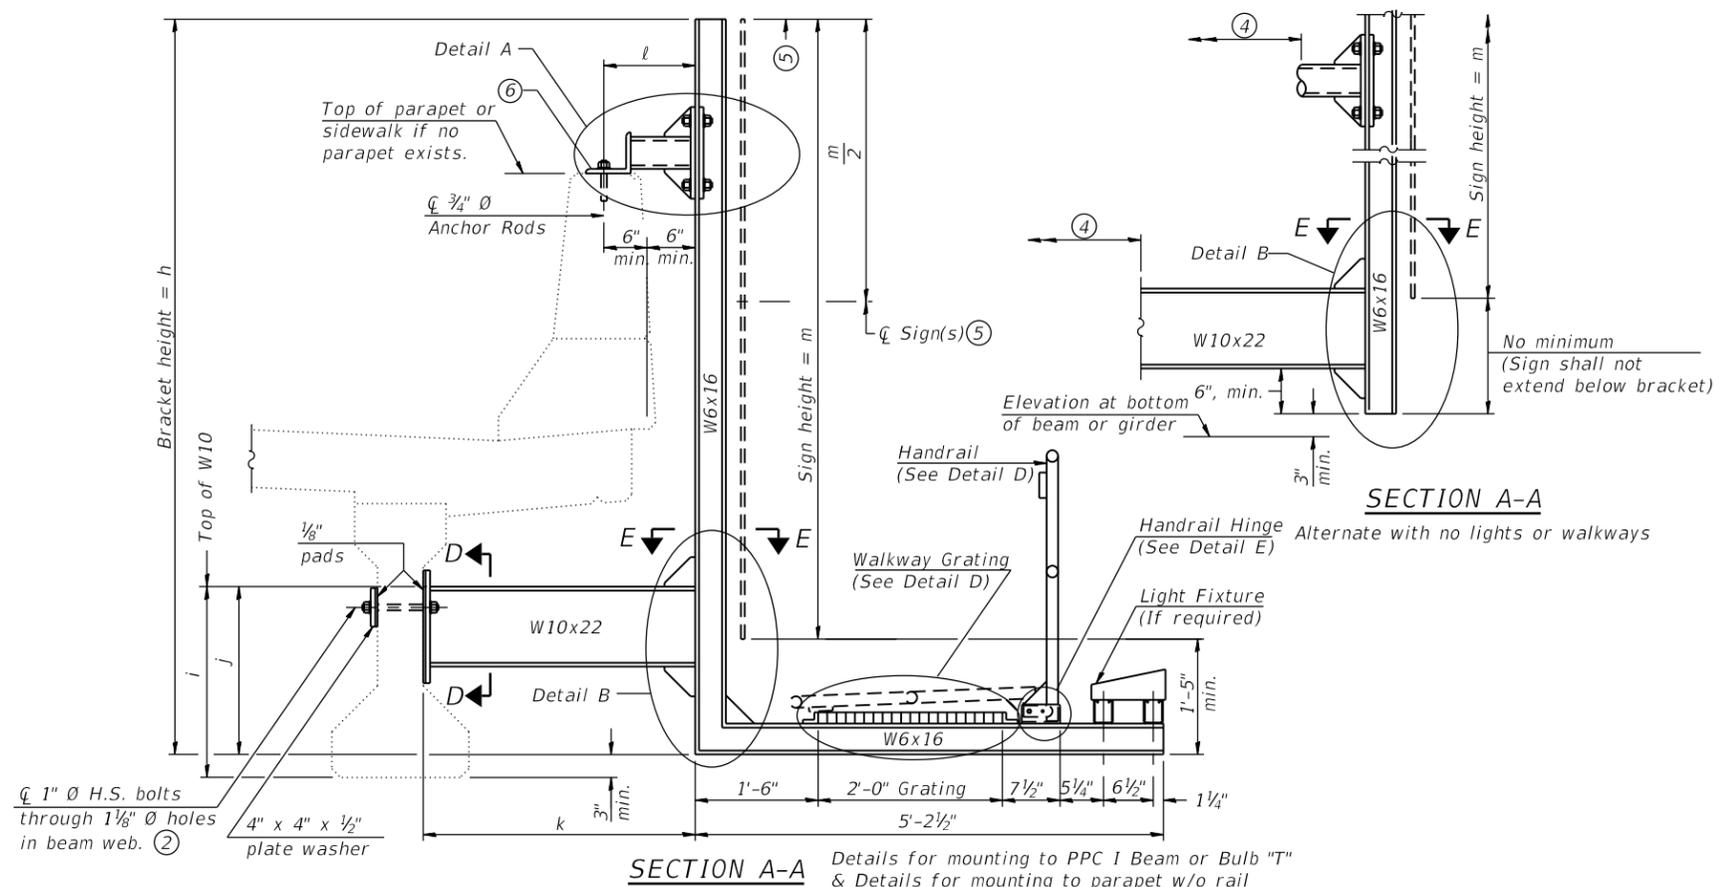

Notes:
 Installations not within dimensional limits shown require special analysis for all components and must be submitted to the Bureau of Bridges and Structures for approval. Contractor shall field check all pertinent existing bridge dimensions shown on plans before submitting shop drawings.
 All holes in bridge beams or girders should be located in the middle half of the member. There shall be no holes drilled in the lower quarter of the member's depth. (For R.C. girder, depth = bottom of deck to bottom of the girder.) Proposed exceptions must be approved by the Bureau of Bridges and Structures.
 The Engineer may adjust dimension "i" to meet the above condition and to keep the sign level.

- ① Holes in new steel members may be drilled in the fabrication shop or in the field. Field drill existing members.
- ② For new PPC I beams, holes shall be formed during casting. For existing PPC I beams, prestressing strand locations shall be determined and spaced to miss strands by 6", min. Minimize spalling during field drilling of existing beams.
- ③ For new construction, form holes. For existing RC beams, locate primary reinforcement and space holes to miss by 6", min. Minimize spalling and concrete fracturing/damage during field drilling of existing concrete. Spalls over 1/4" deep or beyond the coverage of the 4x4 plate washer shall be repaired with epoxy mortar before installing washer.
- ④ For attachment details of 3/2" pipe and W10x22, see other sections as applicable.
- ⑤ Sign shall not extend more than 6" above top of bracket, and this dimension may vary to keep sign level if bridge is on grade or vertical curve. Multiple signs of various heights shall share a common horizontal centerline and use equal bracket heights. If no sign is attached to a W6x12 vertical (bracket only supporting walkway), dimension h shall be the same as an adjacent bracket with a sign attached, unless Engineer specifically directs shorter brackets due to locational restraints on future uses. (See Detail A for minimum bracket height.)
- ⑥ For bridge mounted sign structures installed on new bridges with railing, during design, bracket spacing must be coordinated with railing post spacing and the Contractor must install upper brackets prior to railing installation. For bridge mounted sign structures installed on existing bridges with railing, during design, brackets spacing must be coordinated with railing post spacing and the Contractor must temporarily remove sections of railing to facilitate upper bracket installation. If it is determined during design that existing railings can't be removed, alternate upper connection details must be developed for the contract plans and approved by the Bureau of Bridges and Structures.

NOTES:
 1. Walkway grating, walkway brackets, handrail, lighting and associated components will not be installed in Contract 62A76.

Structure Number	Bridge Name	Bridge Station	h	i	j	k max. (10'-0" max.)	l max. (8'-0" max.)	m
1B0161094L52.2	Roosevelt Road	6+37.37	20'-0"	1'-11"	1'-4 1/2"	4'-6 1/2"	1'-10"	varies from 16'-6" to 19'-0"

For Details A & B, Sections C-C, D-D and E-E, see Sheet SS88.
 For Details D & E, see Sheet SS89.

BM-2-SPECIAL 2-17-2017



USER NAME = charles.pigozzi	DESIGNED - CP, LAB	REVISED -
PLOT SCALE = N.T.S	CHECKED - JJS, MAI	REVISED -
PLOT DATE = 1/24/2020	DRAWN - CP	REVISED -
	CHECKED - JJS, MAI	REVISED -


STATE OF ILLINOIS
 DEPARTMENT OF TRANSPORTATION

BRIDGE MOUNT SIGN STRUCTURES
 WALKWAY AND CONNECTION DETAILS


SHEET NO. SS87 OF SS129 SHEETS

F.A.I. RTE. 90/94/290	SECTION 2015-019R	COUNTY COOK	TOTAL SHEETS 2155	SHEET NO. 1037
CONTRACT NO. 62A76				
ILLINOIS FED. AID PROJECT				

FILE NAME: D:\VACOM-NA-AV51...ecomonline-local\AECOM_D502_NAD\Documents\01_Americas\Transportation\60269938_Circle\Phase_II\000_CAD\008_Structural\Sign_Structures\62A76_Sign_Structure\62A76-Trichord-SS101-SignStruct.dgn

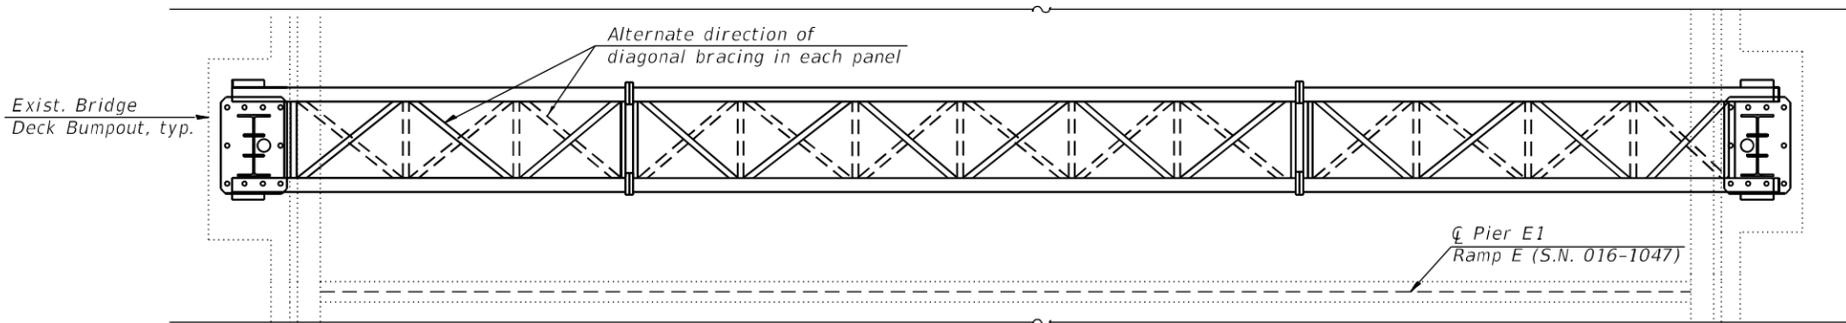

TYPICAL PLAN

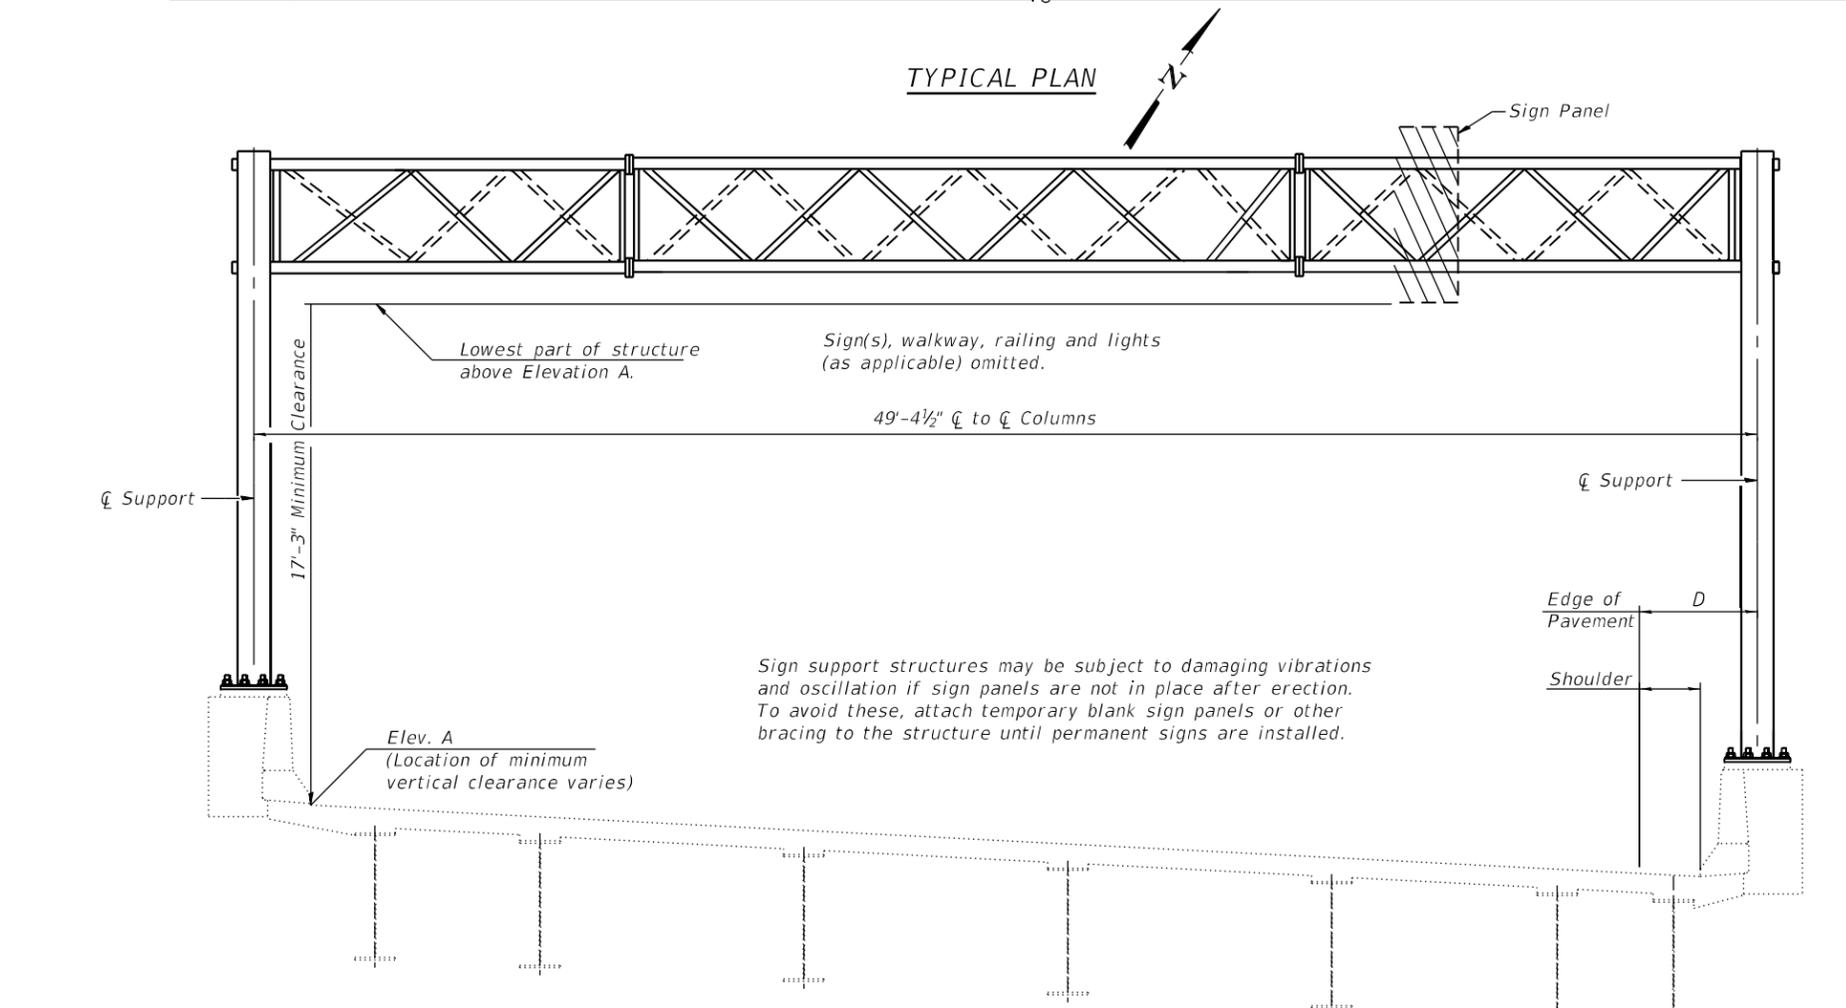

TOTAL BILL OF MATERIAL

ITEM	UNIT	TOTAL
EPOXY CRACK INJECTION	FOOT	9
STRUCTURAL REPAIR OF CONCRETE (DEPTH EQUAL TO OR LESS THAN 5 INCHES)	SQ FT	45
OVERHEAD SIGN STRUCTURE - TRICHORD - TYPE TRI-I-S	FOOT	50
GROUT PAD REMOVAL	EACH	2

TYPICAL ELEVATION

(Looking at Face of Signs)

WALKWAY: Walkway grating, walkway brackets, handrails, lighting, and associated components shown in these plans on the traffic side of the sign structure/sign panel will not be installed in Contract 62A76. The truss grating and maintenance walkway behind the sign panel will be included with Overhead Sign Structure - Trichord Type Tri-I-S.

Structure Number	** Station	Design Truss Type	c. to c. Supports	*** Elev. A	Dim. D	Height of Tallest Sign	Total Sign Area
1S0161094L053.6	120+18.82	TRI-I-S	49'-4 1/2"	636.36	7'-5"	13'-0"	370 Sq. Ft.

*Estimated from Existing Plans. Contractor shall verify and make necessary approved adjustments prior to construction or ordering materials.

Elev. A = Elevation at point of minimum clearance to sign, walkway support or truss.

** Measured along Exist. NB I-90/94. It should be noted that the station included in the Table is measured along the Exist. NB I-90/94 as presented in this Contract and may differ from stations shown in Existing Record Drawings.

*** Verify in Field



SIGNED: Moussa A. Issa
 DR. MOUSSA A. ISSA, S.E., IL. LIC. NO. 081-005738
 EXPIRES 11-30-2020
 DATE: 01/29/2020 FOR SHEETS SS90 THRU SS97 (TOTAL OF 8 SHEETS)

GENERAL NOTES

EXISTING STRUCTURE: Plan dimensions and details relative to existing plans are subject to nominal construction variations. The Contractor shall field-verify existing dimensions and details affecting new construction and make necessary approved adjustments prior to construction or ordering of materials. Such variations shall not be cause for additional compensation for a change in scope of the work; however, the Contractor will be paid for the quantity furnished at the unit price bid for the work.

DESIGN: AASHTO Standard Specifications for Structural Supports for Highway Signs, Luminaires and Traffic Signals. (2001, 4th edition, 2002 interim) ("AASHTO Specifications")

CONSTRUCTION: Current (at time of letting) Illinois Department of Transportation Standard Specifications for Road and Bridge Construction, Supplemental Specifications and Special Provisions. ("Standard Specifications")

LOADING: 90 M.P.H. WIND

WALKWAY LOADING: Dead load plus 500 lbs. concentrated live load.

DESIGN STRESSES
 FIELD UNITS
 f'c = 3,500 psi
 fy = 60,000 psi (reinforcement)

MINIMUM CLEARANCE: Vertical Roadway Clearance = 17'-3" (All Obstructions)

WELDING: All welds to be continuous unless otherwise shown. All welding to be done in accordance with current AWS D1.1 Structural Welding Code (Steel) and the Standard Specifications.

MATERIALS: Structural steel pipe for chords shall be ASTM A500 Grade C. Structural steel pipe for perpendiculars and diagonals shall be ASTM A53 Grade B or A500 Grade B or C. If A500 pipe is substituted for A53, then the outside diameter shall be as detailed and wall thickness greater than or equal to A53.

All Structural Steel Plates and Shapes shall conform to AASHTO M270 Gr. 50 or ASTM A992 Gr. 50. The W24 columns and stiffening ribs at the base plate shall have a minimum longitudinal Charpy V-Notch (CVN) energy of 15 lb.-ft. at 40° F. (Zone 2) before galvanizing.


GALVANIZING: All steel grating, plates, shapes and pipe shall be hot dip galvanized after fabrication in accordance with AASHTO M111. All bolts, u-bolts, eye bolts, lock nuts and washers must be hot dip galvanized per AASHTO M232.

FASTENERS FOR STEEL TRUSSES: All bolts noted as "high strength" (HS) must satisfy the requirements of AASHTO M164 (ASTM A325), ASTM A449, or an Engineer-approved alternate, and must have matching lock nuts and washers. All bolts, u-bolts, eye bolts, lock nuts and washers not specified to be "high strength" must satisfy the requirements of ASTM A307 Gr B. All lock nuts must have nylon or steel inserts. High strength bolt installation shall conform to Article 505.04 (f) (2)d of the Standard Specifications. Rotational capacity ("ROCAP") testing will not be required.

ANCHOR RODS: After removed of the existing grout pads, exposed portions of anchor bolts shall be cleaned and painted with one coat of primer. The primer shall meet the requirements of sections 4 and 5 of SSPC-PS25 for red iron oxide zinc oxide raw linseed oil and alkyd primer. Cleaning and painting of existing anchor bolts shall not be paid separately but shall be included with Concrete Removal.

REINFORCEMENT BARS: All supplemental reinforcement bars shall be epoxy-coated in accordance with the Standard Specifications.

PROTECTION: The Contractor shall take all necessary precautions for the protection of passing and/or parked vehicles from falling objects and/or materials until completion of the work.

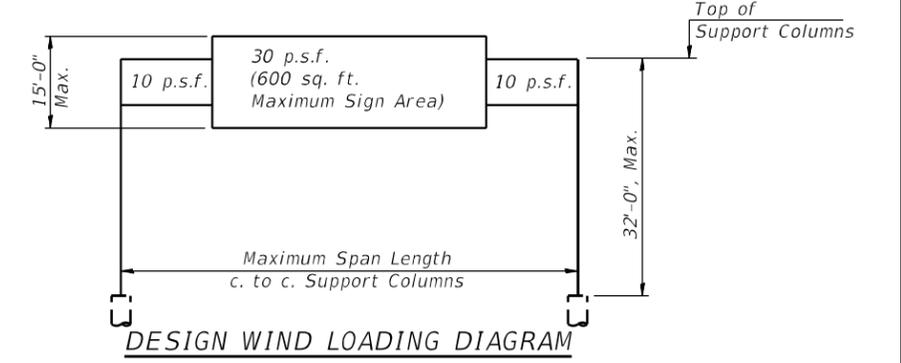

Parameters shown are basis for I.D.O.T. Standards and Sign Manual Tables. Installations not within dimensional limits shown require special analysis for all components.



USER NAME = marina.stoica	DESIGNED - JJS, FL	REVISED -
PLOT SCALE = N.T.S	CHECKED - MAI, JMG	REVISED -
PLOT DATE = 1/29/2020	DRAWN - HI, FL	REVISED -
	CHECKED - MAI, JMG	REVISED -


STATE OF ILLINOIS
 DEPARTMENT OF TRANSPORTATION

TRI-CHORD SIGN STRUCTURES - GENERAL PLAN & ELEVATION - STEEL TRUSS & STEEL SUPPORTS

F.A.I. RTE.	SECTION	COUNTY	TOTAL SHEETS	SHEET NO.
90/94/290	2015-019R	COOK	2155	1040
CONTRACT NO. 62A76				
ILLINOIS		FED. AID PROJECT		


SHEET NO. SS90 OF SS129 SHEETS

FILE NAME: D:\V\AECOM-NA-AW51... \NA\Documents\01_Americas\Transportation\60269938_Circle\Phase_II\000_CAD\008_Structural\Sign_Structures\62A76-Trichord-SS102-SignStruct.dgn

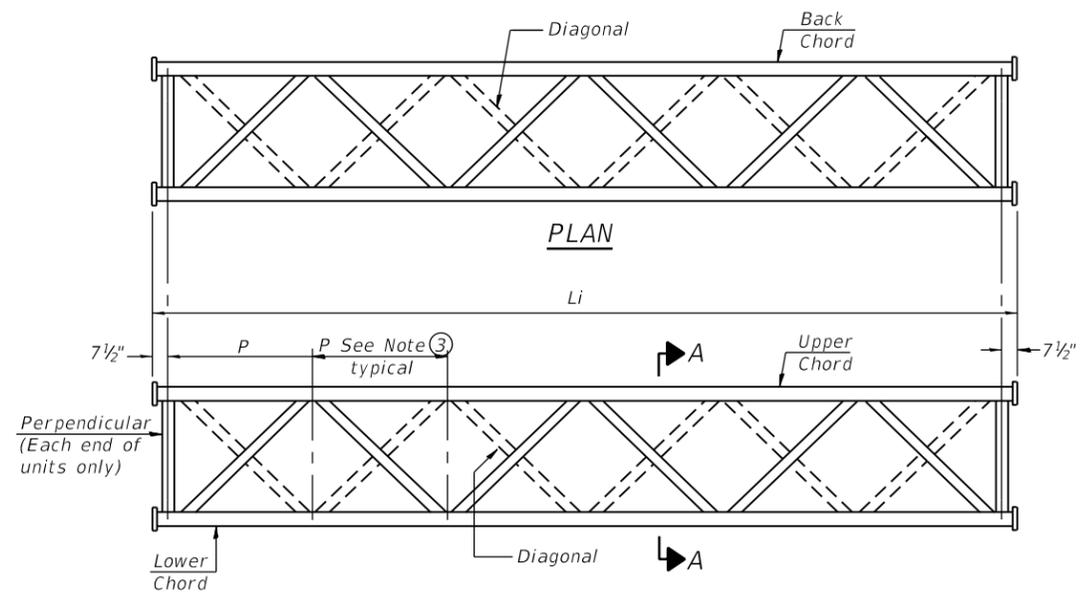


**ELEVATION
TYPICAL INTERIOR UNIT**

Even number of panels/interior unit required.
For two interior units, each unit may have even or odd number of panels.

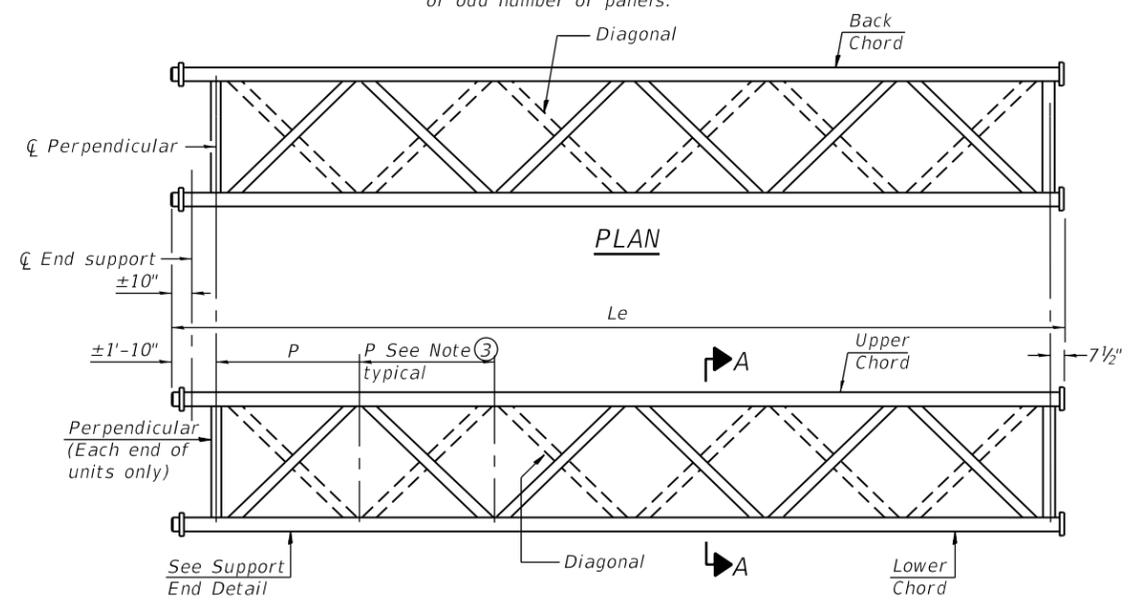


**ELEVATION
TYPICAL EXTERIOR UNIT**

Even or odd number of panels/exterior unit allowed.

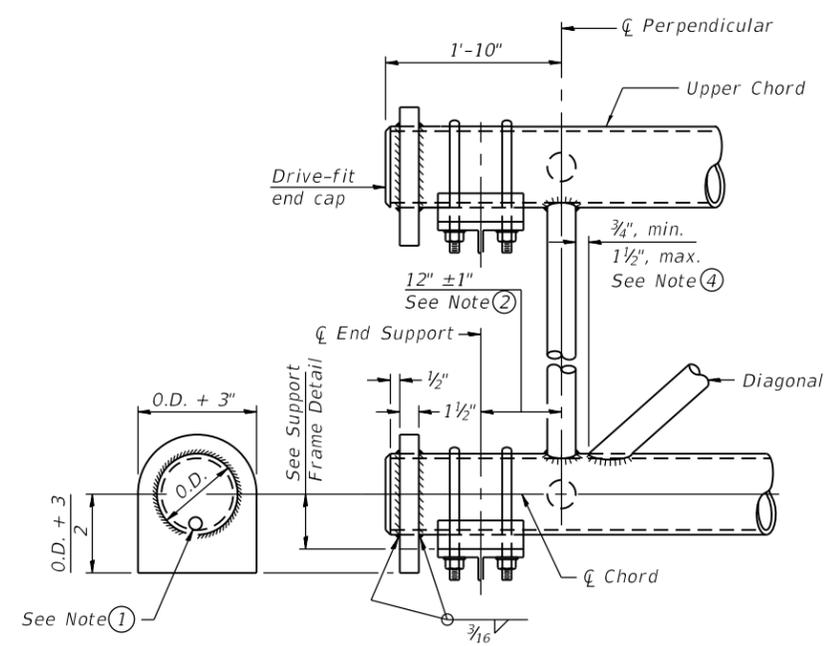


SUPPORT END DETAIL FOR EXTERIOR UNIT

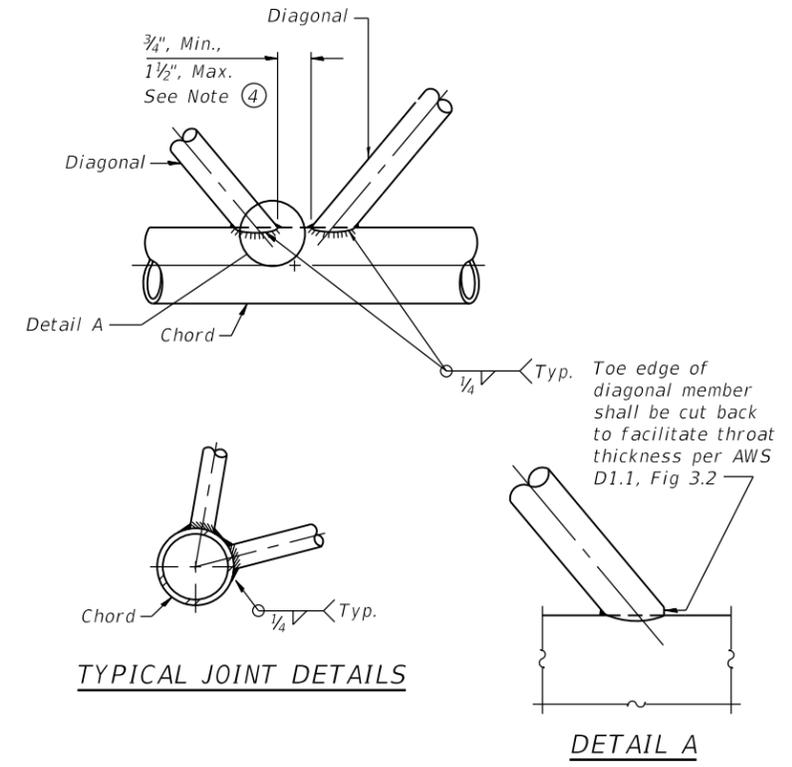

TYPICAL JOINT DETAILS

NOTES

- ① Contractor must use standard drive-fit cap to close end. The drive-fit cap must have a 1/2" Ø drain hole and must be installed after galvanizing. (Typ. at non-splice ends of chords)
- ② 1'-10" end dimension may vary by ±1" to provide uniform panel spacing (P).
- ③ Panel spacing (P) shall be uniform for entire truss and between 4'-0" and 5'-0". (Fabricator may vary for uniform diagonals).
- ④ All diagonals shall be offset from the panel point based on the following: offset shall provide a 3/4" minimum to 1 1/2" maximum clearance between diagonal and any other diagonal, or perpendicular member, and to provide clearance for U-bolt connections of signs or walkway brackets.
- ⑤ Galvanizing vent holes of adequate size must be provided at each end of truss members except chords. Place on underside of sloping members and truss side of vertical members. Alternately, holes may be provided in wall of chords. All vent holes must be drilled and de-burred, typ.

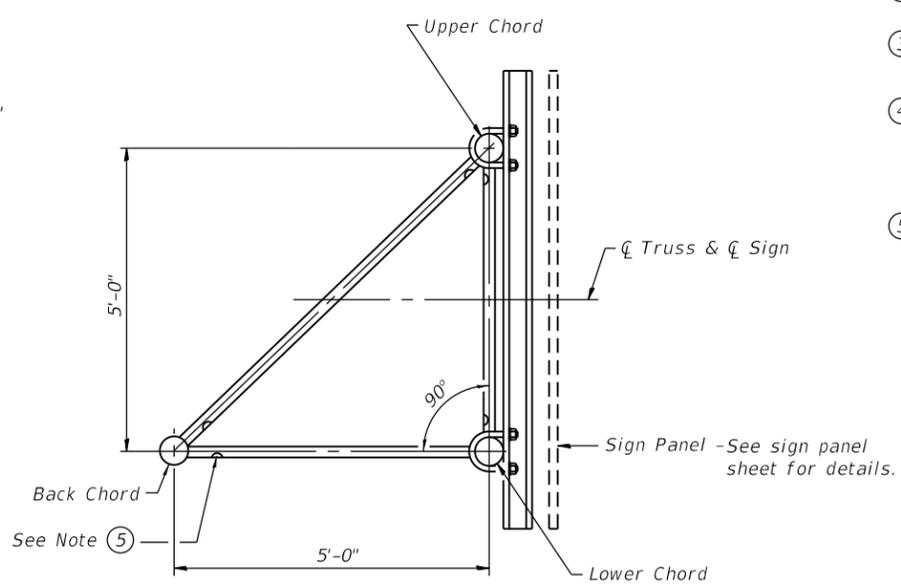

SECTION A-A

TRI-S-2

2-17-2017



USER NAME = charles.pigozzi	DESIGNED - JJS, FL	REVISED -
PLOT SCALE = N.T.S	CHECKED - MAI, JMG	REVISED -
PLOT DATE = 1/24/2020	DRAWN - HI, FL	REVISED -
	CHECKED - MAI, JMG	REVISED -

STATE OF ILLINOIS
DEPARTMENT OF TRANSPORTATION

TRI-CHORD SIGN STRUCTURES - STEEL TRUSS DETAILS
FOR TRUSS TYPES TRI-I-S, TRI-II-S AND TRI-III-S


SHEET NO. SS91 OF SS129 SHEETS

F.A.I. RTE. 90/94/290	SECTION 2015-019R	COUNTY COOK	TOTAL SHEETS 2155	SHEET NO. 1041
			CONTRACT NO. 62A76	
		ILLINOIS FED. AID PROJECT		


TRICHORD UNIT TABLE

Structure Number	** Station	Design Truss Type	Exterior Units (2)			Interior Unit			
			No. Panels per Unit	Unit Lgth.(Le)	Panel Lgth.(P)	No. Req'd.	No. Panels per Unit	Unit Lgth.(Li)	Panel Lgth.(P)
1S0161094L053.6	120+18.82	TRI-I-S	5	25'-6 1/4"	4'- 7 1/4"	-	-	-	-

** Measured along Exist. NB I-90/94. It should be noted that the station included in the Table is measured along the Exist. NB I-90/94 as presented in this Contract and may differ from stations show in Existing Record Drawings.

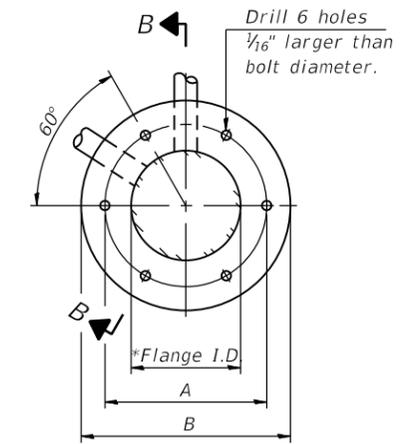


TRUSS TYPES I-S, II-S, & III-S

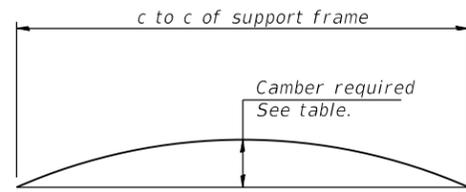


CAMBER DIAGRAM

Camber curve shown is theoretical. Actual camber attained by slope changes at splices between units.

CAMBER ATTAINMENT EXAMPLES:

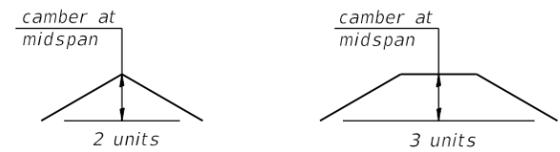


Camber shown is for fabrication only, measured with truss fully supported. (No-load condition)

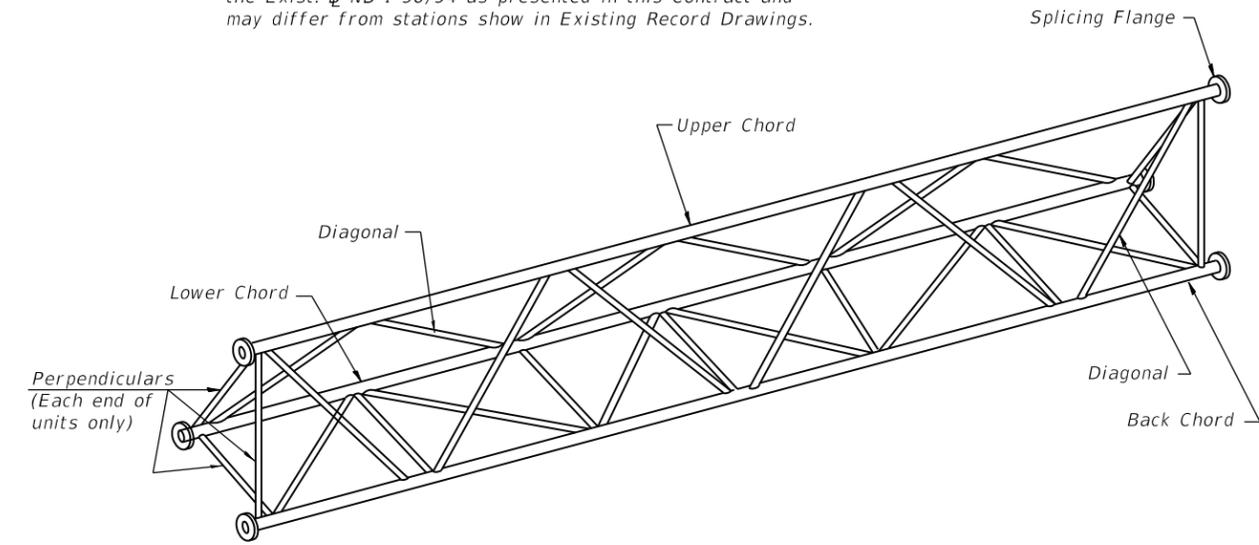

ISOMETRIC VIEW
TYPICAL INTERIOR TRUSS UNIT

Note:
Units shall be shipped individually with adequate provision to prevent detrimental motion during transport. This may require ropes between horizontals and diagonals or energy-dissipating (elastic) ties to the vehicle. The Contractor is responsible for maintaining the configuration and protection of the units.

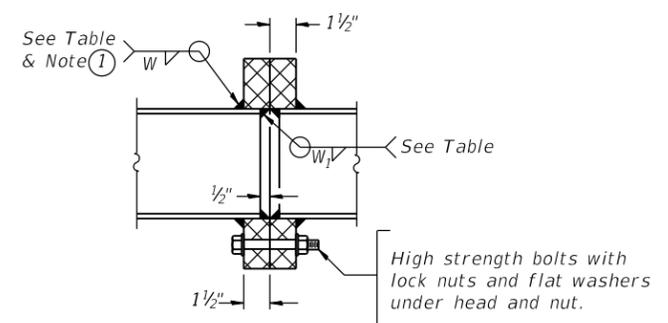

SECTION B-B

① Splicing Flanges shall be attached to each truss unit with the truss shop assembled to camber shown. Truss units shall be in proper alignment and flange surfaces shall be shop-bolted into full contact before welding. Sufficient external welds or tacks shall be made to secure flanges until remaining welds are made after disassembly. Adjacent flanges shall be "match-marked" to ensure proper field assembly.

TRICHORD DESIGN TABLE

Truss Type	Maximum Span Length	Chords		Diagonals and Perpendiculars		*Camber at Midspan	Splicing Flange					
		O.D.	Wall	O.D.	Wall		H.S. Bolts		Weld Sizes			
							No./Splice	Diameter	W	W1	A	B
TRI-I-S	80	4.500	0.237	2.875	0.203	2.25	6	7/8	1/4	3/16	8 1/4	11 1/4
TRI-II-S	100	5.563	0.258	2.875	0.203	3.25	6	7/8	3/8	1/4	9 1/4	12 1/4
TRI-III-S	120	6.625	0.280	2.875	0.203	5.00	6	1	3/8	1/4	11 1/2	15
TRI-IV-S	140	8.625	0.322	3.500	0.216	6.25	6	1 1/4	9/16	1/16	13	16 1/2

* Note to fabricator: For spans between maximum span lengths given in table, use linear interpolation to determine camber.
Minimum AASHTO Camber = L / 1000

TRI-S-3

2-17-2017



USER NAME = charles.pigozzi	DESIGNED - JJS, FL	REVISED -
PLOT SCALE = N.T.S	CHECKED - MAI, JMG	REVISED -
PLOT DATE = 1/24/2020	DRAWN - HI, FL	REVISED -
	CHECKED - MAI, JMG	REVISED -

STATE OF ILLINOIS
DEPARTMENT OF TRANSPORTATION


TRI-CHORD SIGN STRUCTURES - STEEL TRUSS DETAILS
FOR TRUSS TYPES TRI-I-S, TRI-II-S AND TRI-III-S

SHEET NO. SS92 OF SS129 SHEETS

F.A.I. RTE. 90/94/290	SECTION 2015-019R	COUNTY COOK	TOTAL SHEETS 2155	SHEET NO. 1042
CONTRACT NO. 62A76			ILLINOIS FED. AID PROJECT	

FILE NAME: D:\VAECOM-NA-AWS1\arecomonline\local\AECOM_ID502_NAIDDocuments\01_Americas\Transportation\60269938_Circle\Phase_II\000_CAD\008_Structural\Sign_Structures\62A76_Sign_Structure\62A76-Trichord-SS103-SignStruct.dgn

FILE NAME: D:\V\AECOM-NA-AWS1... \NA\Documents\01_Americas\Transportation\60269938_Circle\Phase_II\000_CAD\008_Structural\Sign_Structures\62A76-TriChord-SS104-SignStruct.dgn

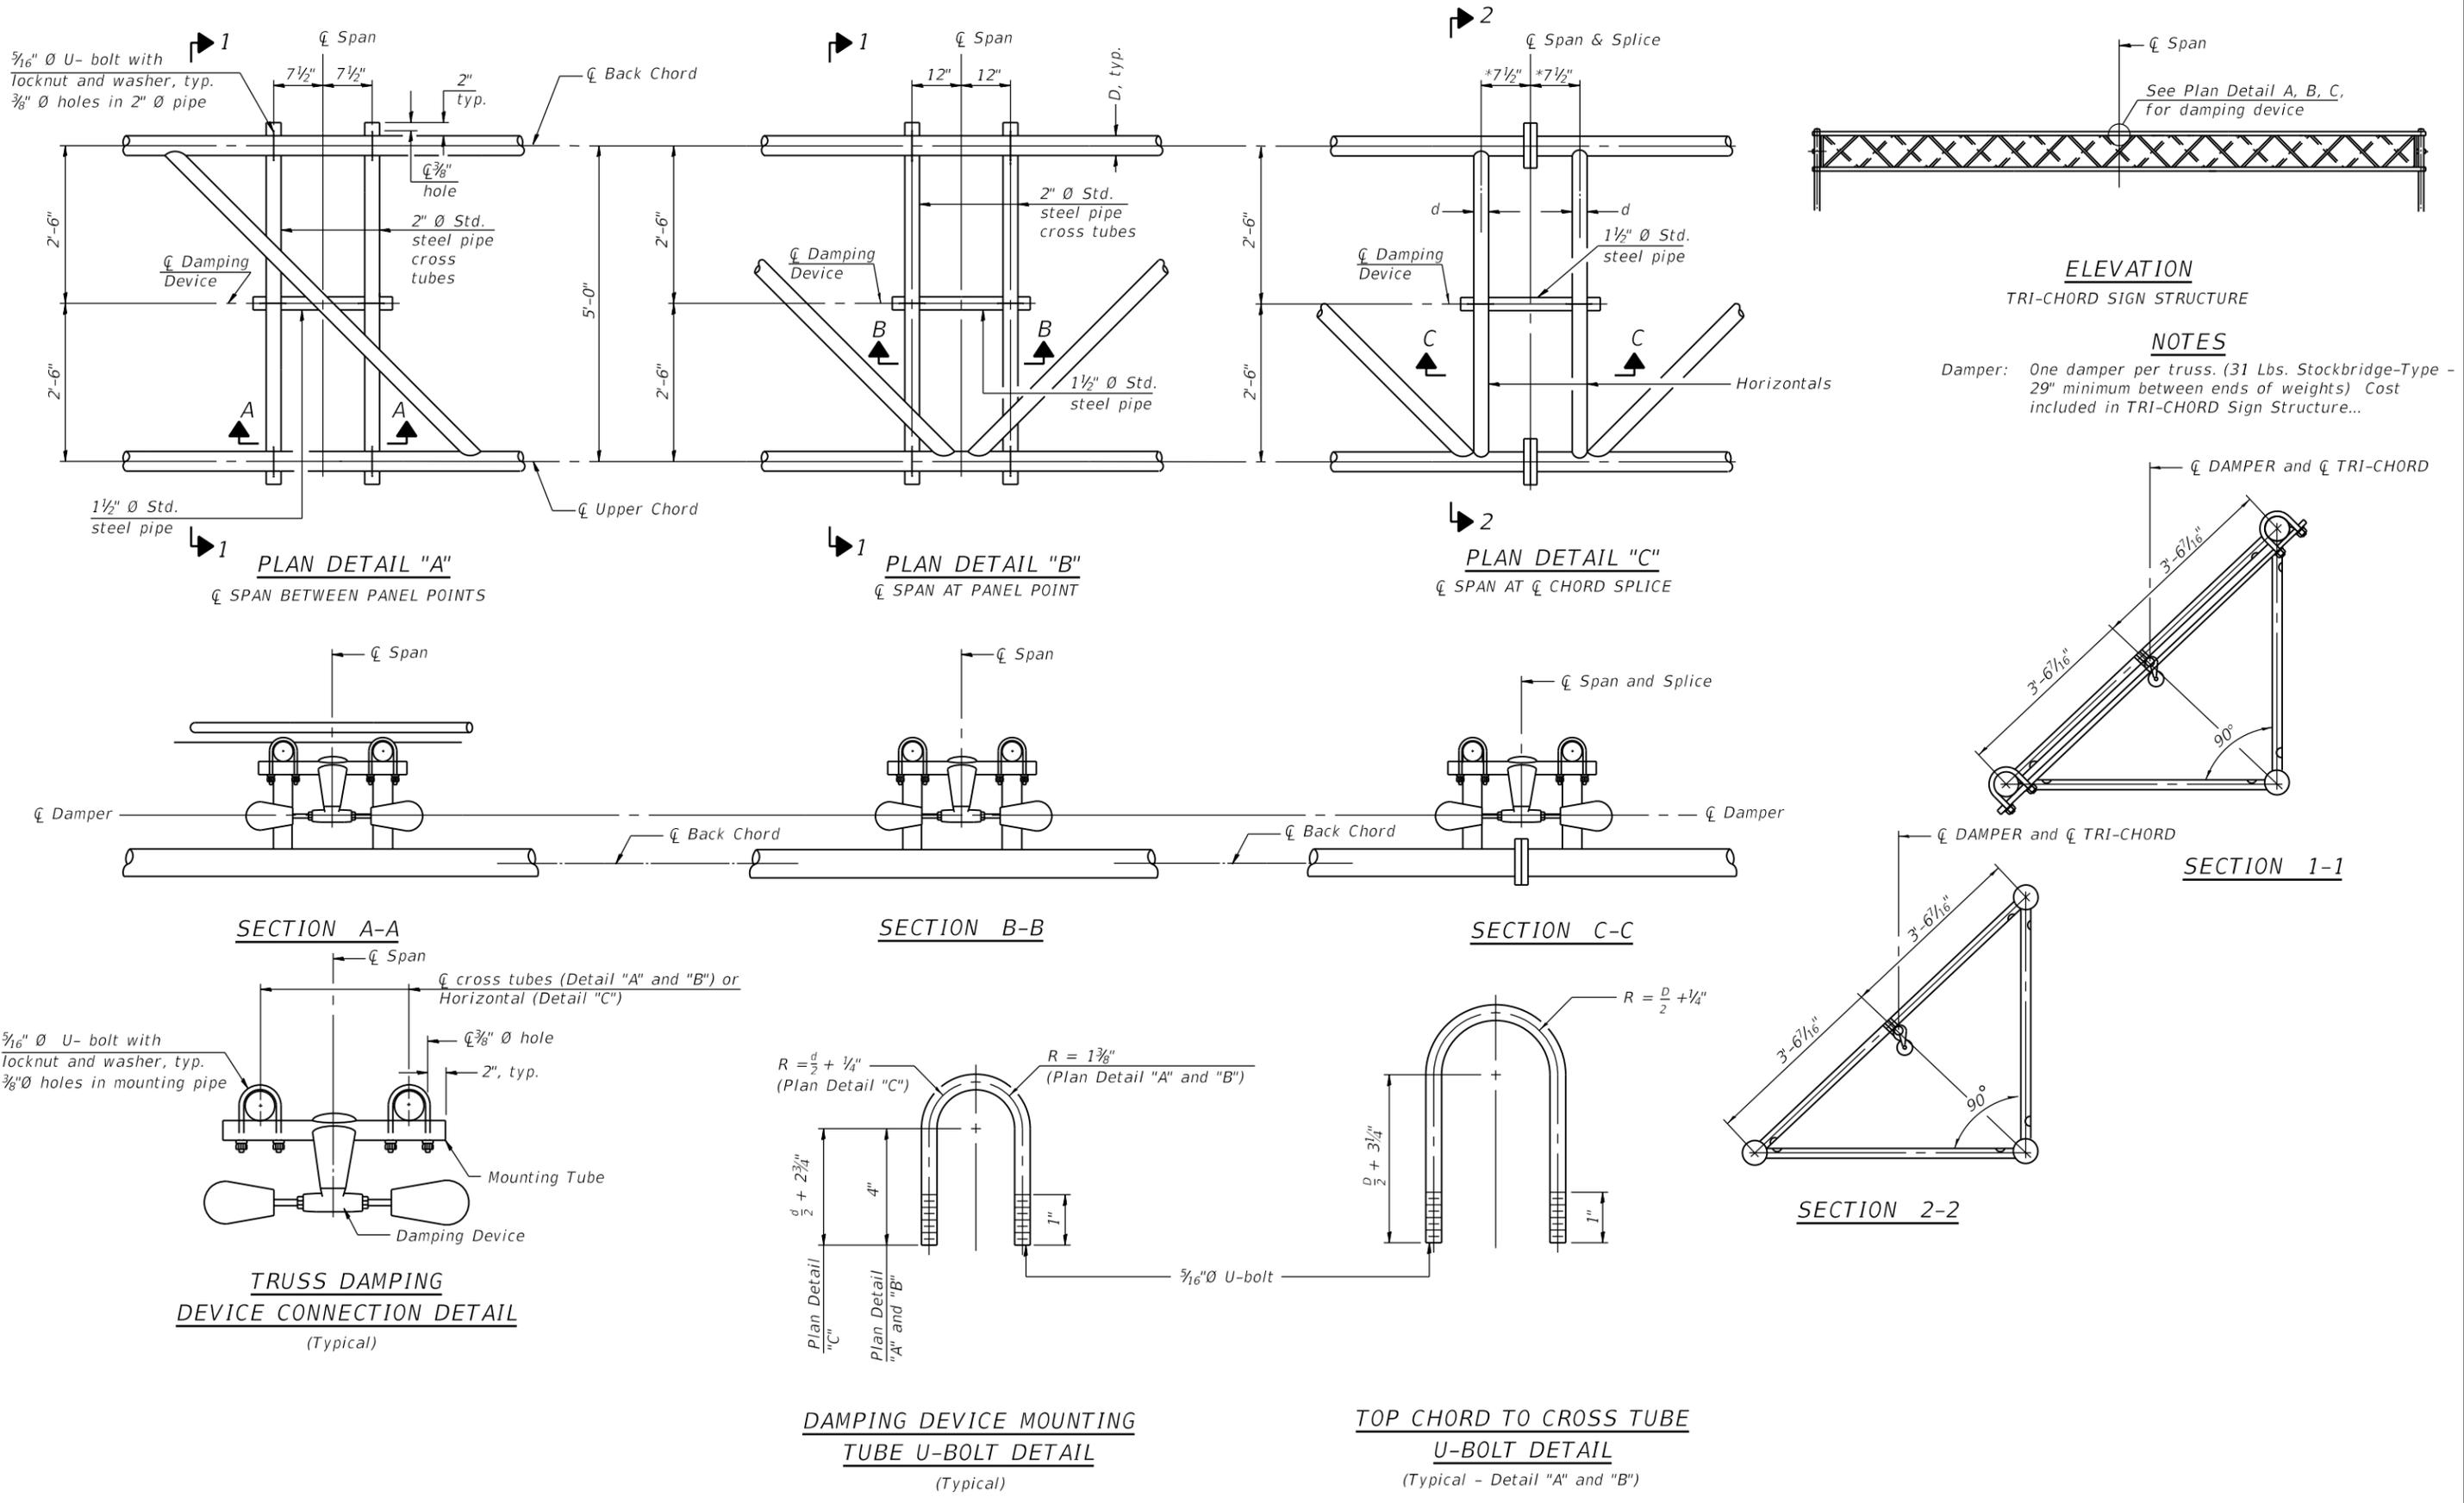

NOTES
 Damper: One damper per truss. (31 Lbs. Stockbridge-Type - 29" minimum between ends of weights) Cost included in TRI-CHORD Sign Structure...

TRI-S-4

2-17-2017



USER NAME =	charles.pigozzi	DESIGNED -	JJS, FL	REVISED -	
		CHECKED -	MAI, JMG	REVISED -	
PLOT SCALE =	N.T.S	DRAWN -	HI, FL	REVISED -	
PLOT DATE =	1/24/2020	CHECKED -	MAI, JMG	REVISED -	

STATE OF ILLINOIS
 DEPARTMENT OF TRANSPORTATION



TRI-CHORD SIGN STRUCTURE
 DAMPING DEVICE

F.A.I. RTE.	SECTION	COUNTY	TOTAL SHEETS	SHEET NO.
90/94/290	2015-019R	COOK	2155	1043
CONTRACT NO. 62A76				
ILLINOIS FED. AID PROJECT				


SHEET NO. SS93 OF SS129 SHEETS

11:30:07 AM

FILE NAME: D:\VAECOM\NA-AW51\aecononline\local\AECON_ID502_NAD\Documents\01_Americas\Transportation\60269938_Circle\Phase_I\000_CAD\008_Structural\Sign_Structures\62A76-Tchord-SS106-SignStruct.dgn
 11:30:31 AM

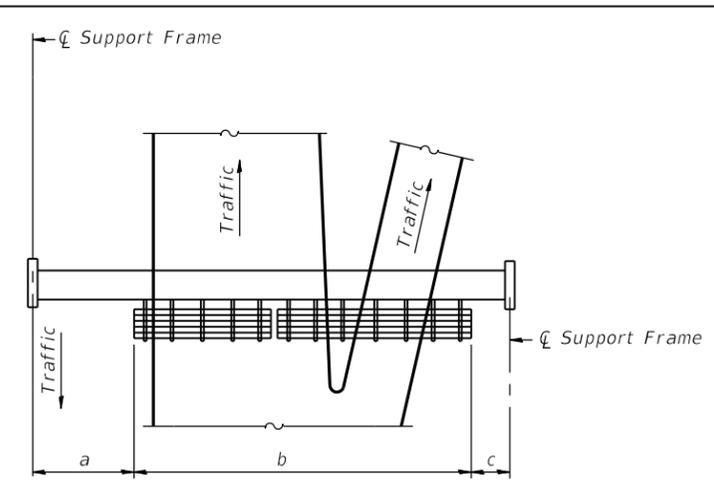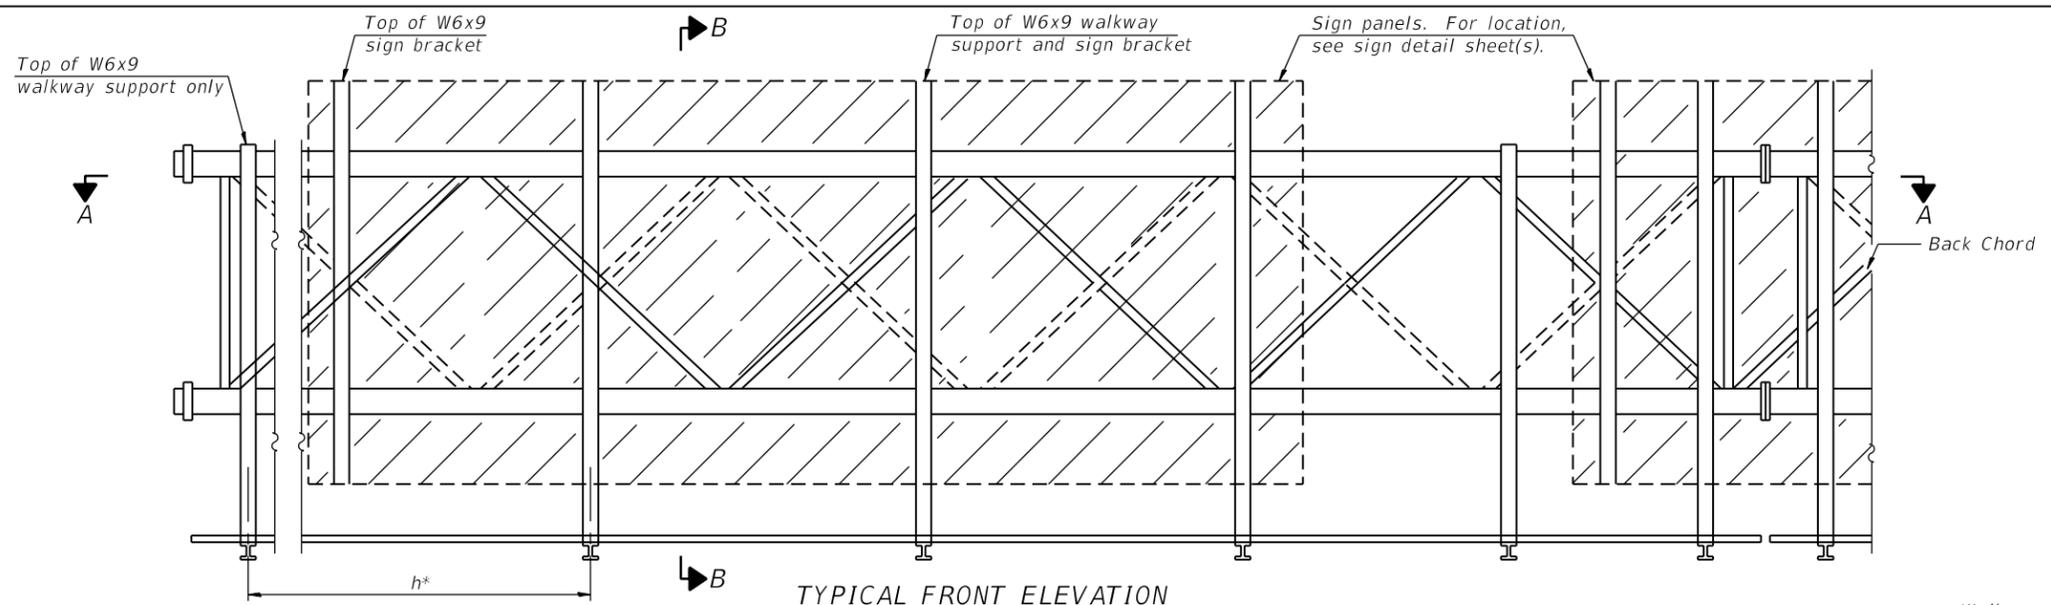

Walkway Grating width dimensions is nominal and may vary $\pm 1/2$ " based on available standard widths.

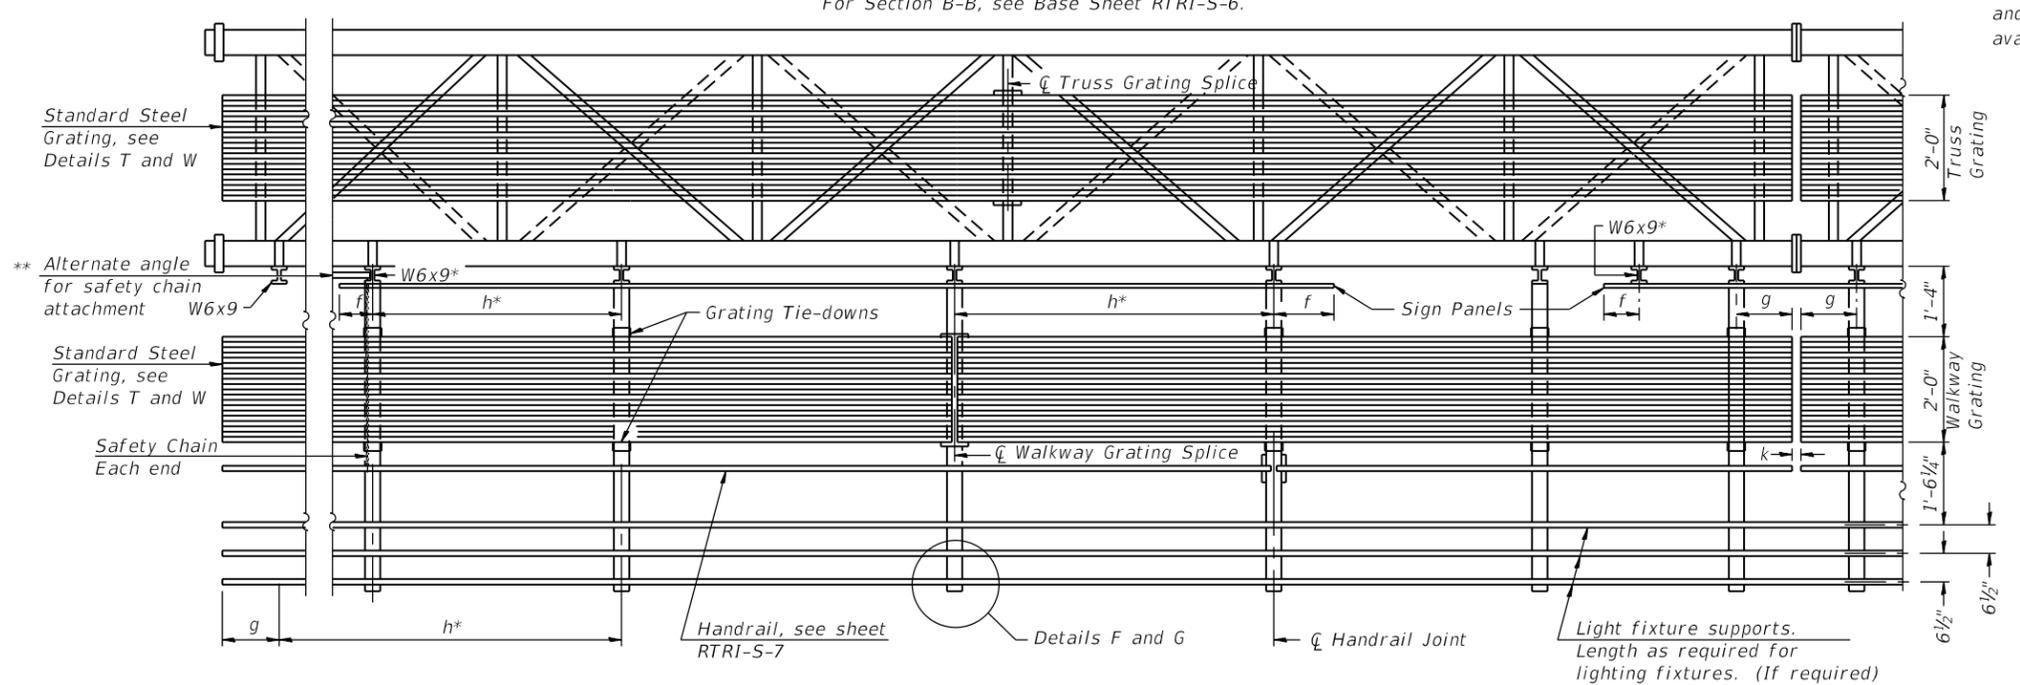

Handrail and walkway shall span a minimum of three brackets between splices and/or gap joints. Place all sign and walkway brackets as close to panel points as practical. Handrail joint, grating and light support splices placed as needed.

Structure Number	*** Station	a	b	c	Walkway Grating and Handrail Lengths
1S0161094L053.6	120+18.82	-	-	-	-









Truss grating to facilitate inspection shall run full length (center to center of support frames) ± 12 " on overhead trusses. Cost of truss grating is included in "Overhead Sign Structure".

BRACKET TABLE

W6x9		Number Brackets Required
Sign Width Greater Than	Sign Width Less Than or Equal To	
8'-0"	14'-0"	2
14'-0"	20'-0"	3
20'-0"	26'-0"	4
26'-0"	32'-0"	5
		6

- Notes:
- * Space W6x9 walkway brackets and sign brackets W6x9 for efficiency and within limits shown:
 - f = 12" maximum, 4" minimum (End of sign to ϕ of nearest bracket)
 - g = 12" maximum, 4" minimum (End of walkway grating to ϕ of nearest support bracket)
 - h = 6'-0" maximum (ϕ to ϕ sign and/or walkway support brackets, W6x9)
 - k = 2" maximum gap between adjacent walkway grating sections and handrail ends
 - ** If walkway bracket at safety chain location is behind sign, add angle to bracket, see Alternate Safety Chain Attachment on Base Sheet RTRI-S-7
 - For Details T and W, Section B-B and Grating Splice Details, see Base Sheet RTRI-S-6. For Handrail Details, see Base Sheet RTRI-S-7.
 - *** Measured along Exist. \parallel NB I-90/94. It should be noted that the station included in the Table is measured along the Exist. \parallel NB I-90/94 as presented in this Contract and may differ from stations show in Existing Record Drawings.

FILE NAME: D:\V\AE\COM-NA-AW51...ae\comonline-local\AE\COM_DS02_NAD\Documents\01_Americas\Transportation\60269938_Circle\Phase_I\0000_CAD\008_Structural\Sign_Structures\62A76_Sign_Structure\62A76-TriChord-SS107-SignStruct.dgn

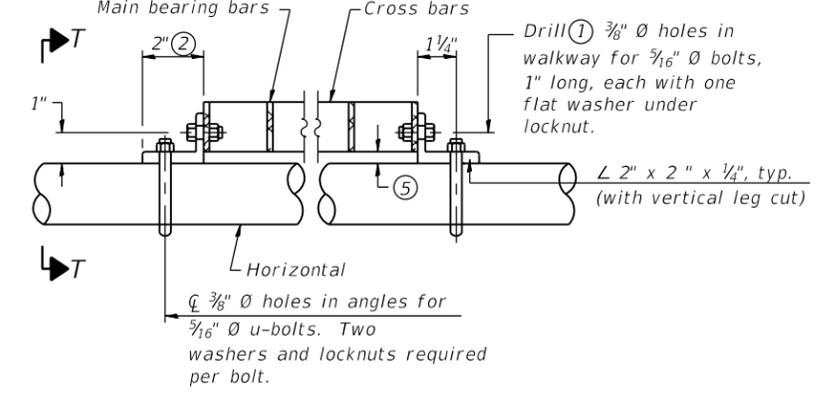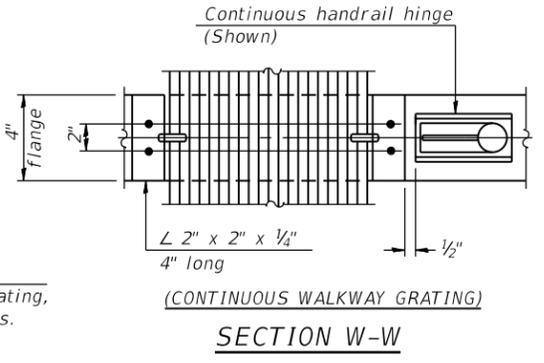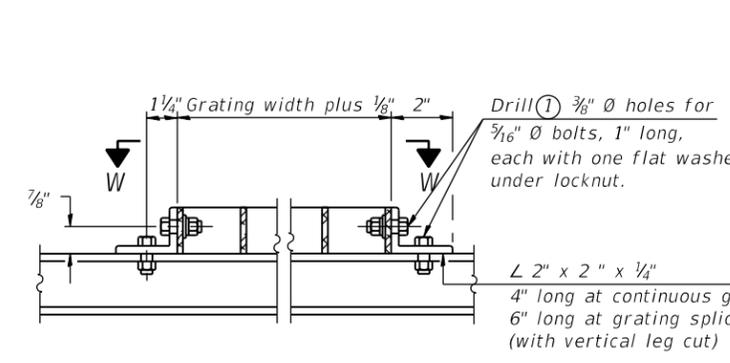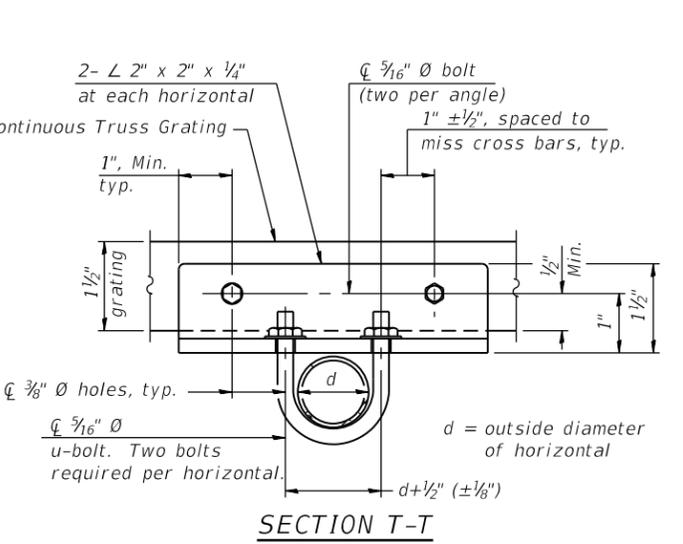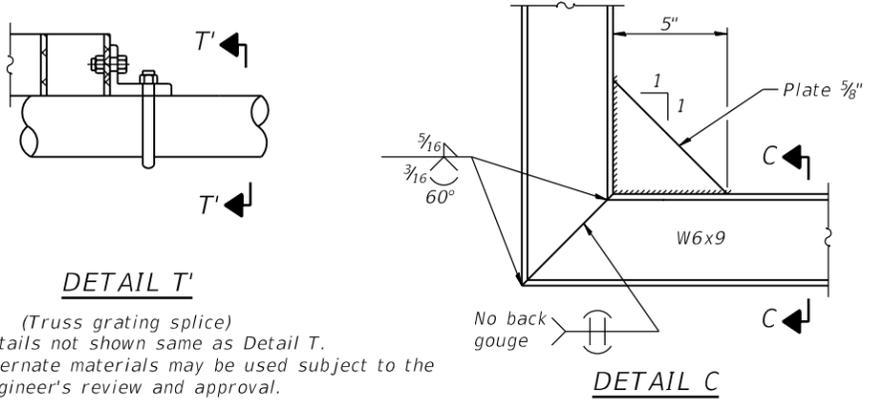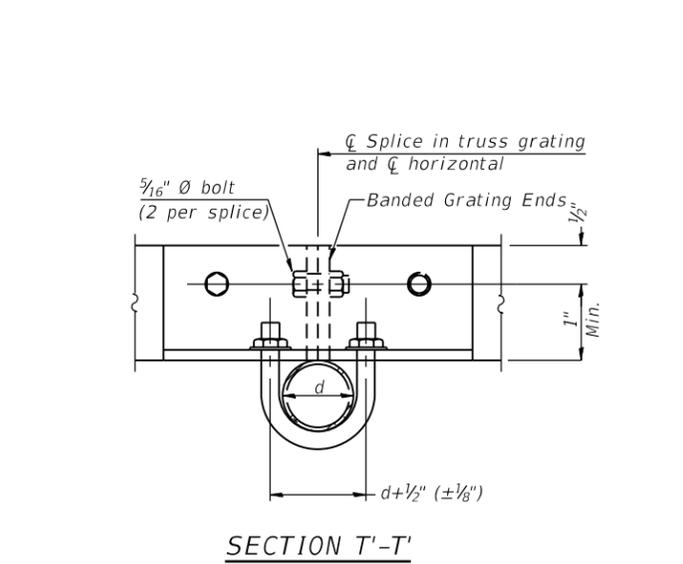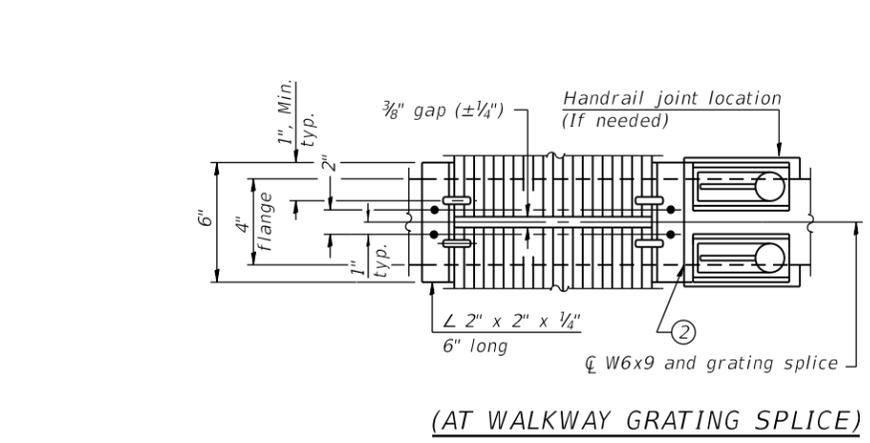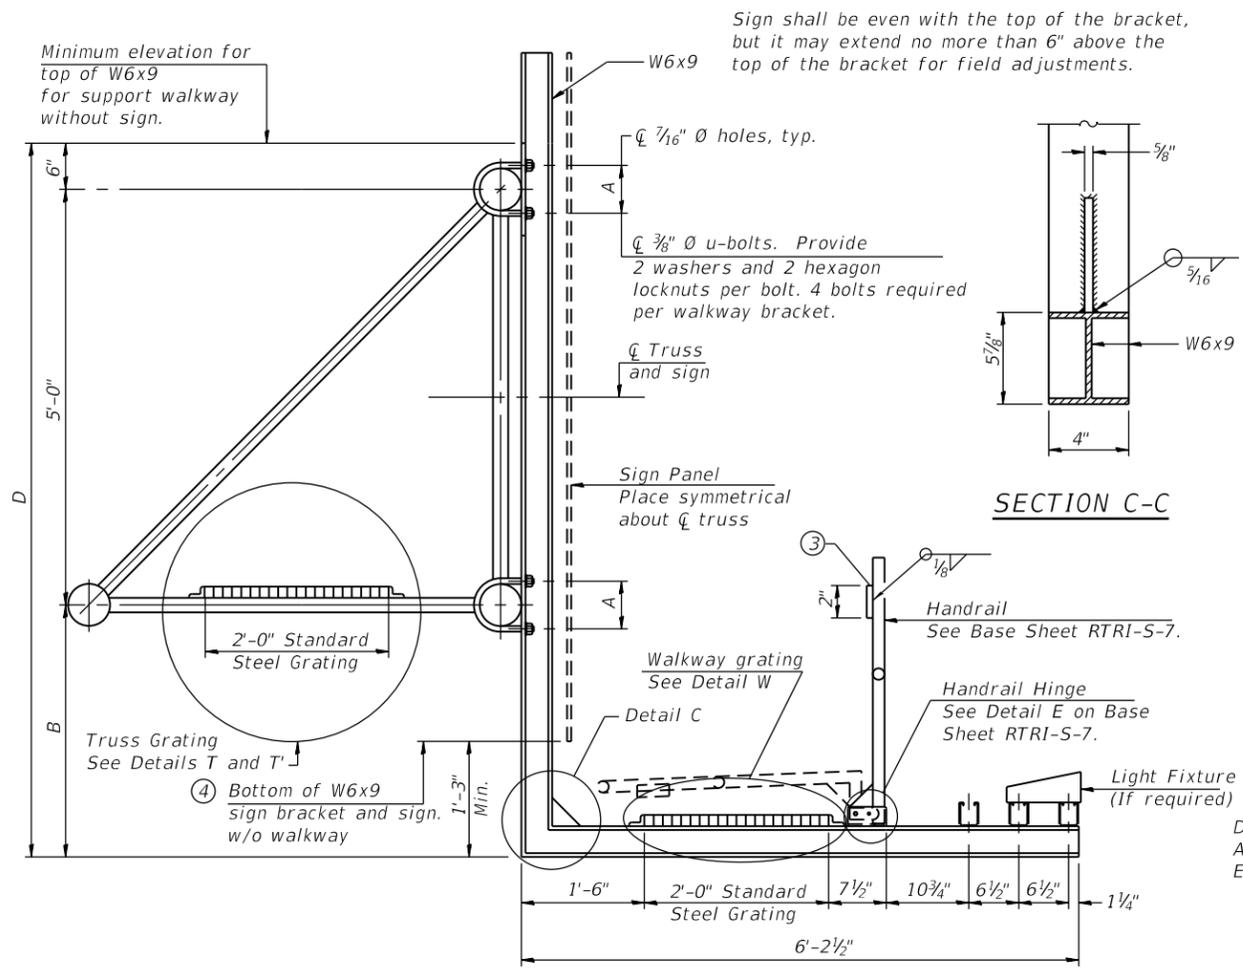

- ① Drilling holes in grating may be done in shop or field, based on Contractor's preference and subject to accurate alignment.
- ② If Handrail Joint present, weld angle to W6x9 and 1/4" extension bars. (See Base Sheet TRI-S-7.)
- ③ ϕ $\frac{1}{8}$ " x $\frac{1}{2}$ " x 2" welded to handrail posts to protect locations that contact grating.
- ④ For projects that don't require walkway and lighting.
- ⑤ Tube to grating gap may vary from 0 to 1/2", max. to align walkway, allow for camber, etc.
- ⑥ Based on actual height of tallest sign given on TRI-S-1.

BARS SIZES FOR STANDARD STEEL GRATING

WALKWAY GRATING Main bearing bars $\frac{3}{16}$ " x $1\frac{1}{2}$ " on $1\frac{3}{16}$ " centers. Cross bars $\frac{3}{16}$ " x $1\frac{1}{2}$ " on 4" centers. All intersects welded.

Structure Number	* Station	A	⑥ B	⑥ D
1S0161094L053.6	120+18.82	5 1/2"	5'-3"	10'-9"

* Measured along Exist. ϕ NB I-90/94. It should be noted that the station included in this Table is measured along the Exist. ϕ NB I-90/94 as presented in this Contract and may differ from stations shown in Existing Record Drawings.

TRI-S-7

2-17-2017



USER NAME = charles.pigozzi	DESIGNED - JJS, FL	REVISED -
PLOT SCALE = N.T.S	CHECKED - MAI, JMG	REVISED -
PLOT DATE = 1/24/2020	DRAWN - HI, FL	REVISED -
	CHECKED - MAI, JMG	REVISED -


STATE OF ILLINOIS
DEPARTMENT OF TRANSPORTATION

TRI-CHORD SIGN STRUCTURES - STEEL
SIGN BRACKET AND WALKWAY DETAILS

SHEET NO. SS96 OF SS129 SHEETS

F.A.I. RTE. 90/94/290	SECTION 2015-019R	COUNTY COOK	TOTAL SHEETS 2155	SHEET NO. 1046
ILLINOIS FED. AID PROJECT			CONTRACT NO. 62A76	

FILE NAME: D:\VAECOM-NA-AW51\arecomonline\local\AECOM_D502_NAD\Documents\01_Americas\Transportation\60269938_Circle\Phase_II\000_CAD\008_Structural\Sign_Structures\62A76-Sign_Structure\62A76-Ticbord-55110_SignStruct.dgn

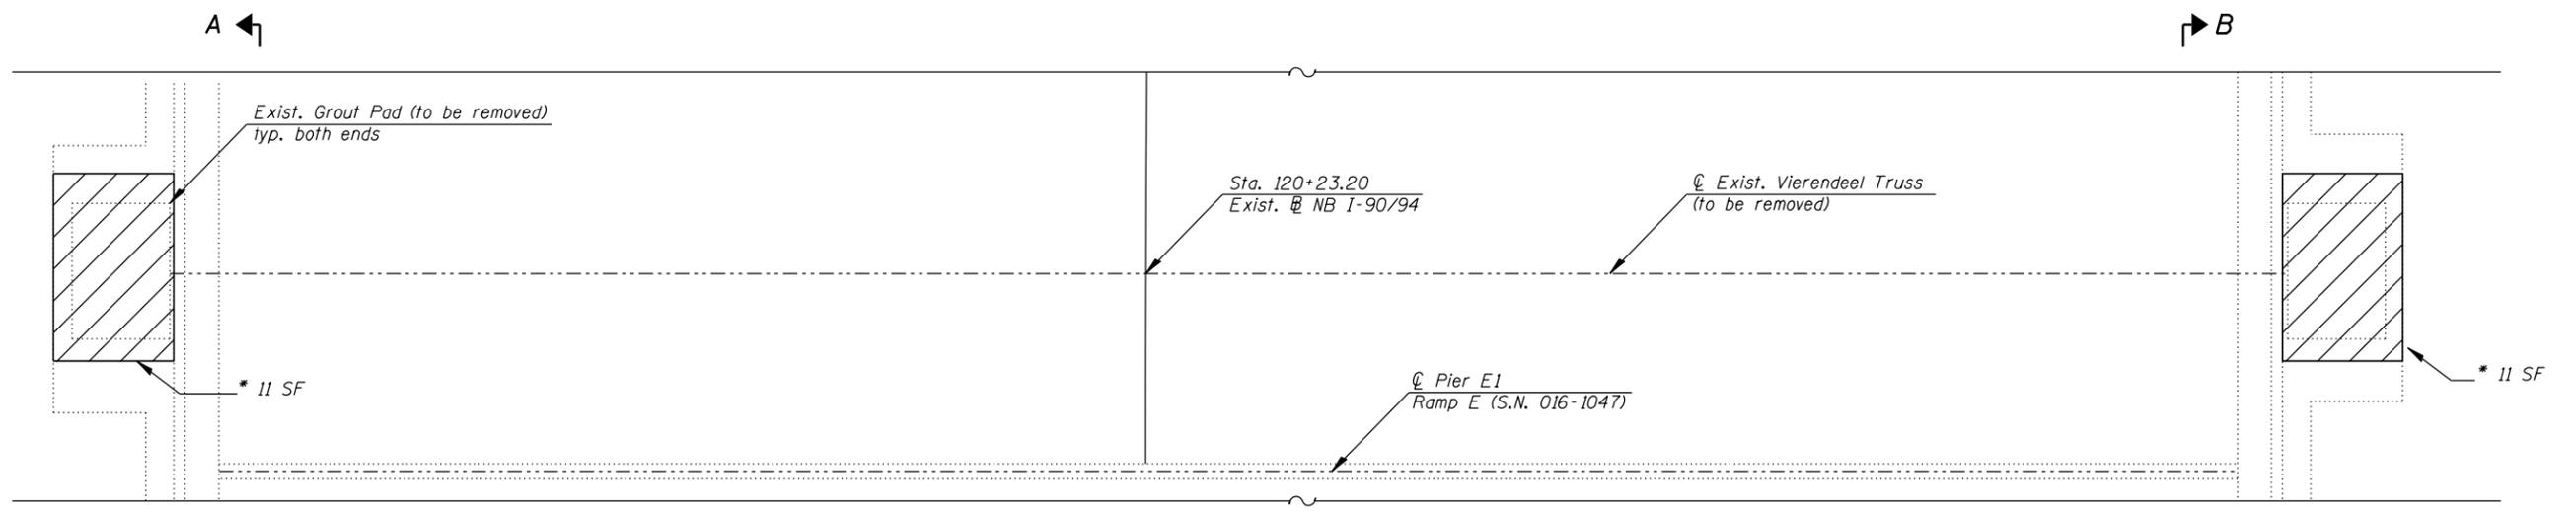


* After removal of the existing grout pad, the Contractor shall perform structural repair of concrete to the top of parapet including area previously covered by grout pad.

PLAN
(Existing Viereendeel Truss not shown for clarity)




NOTES:


- Parapet repair locations are approximate and were determined from field inspection performed at the time of plan preparation. The necessary adjustments based on current field conditions will be made at time of construction. Such variations shall not be cause for additional compensation for a change in the scope of work; however, the Contractor will be paid for the quantity actually furnished at the unit price bid for the work.
- Existing reinforcing steel which is exposed by the concrete repair or removal process but is to remain in the existing structure and be reused, shall be cleaned (to be free of existing concrete and rust) and straightened (if necessary). Existing reinforcing steel which is cut, stretched, or damaged by the Contractor during the concrete repair/removal process shall be replaced by embedded reinforcing steel or anchorage, equal to or greater than the size of original reinforcing steel, subject to approval of the Engineer and at no cost to the Department. See Special Provisions for Structural Repair of Concrete and Concrete Removal.

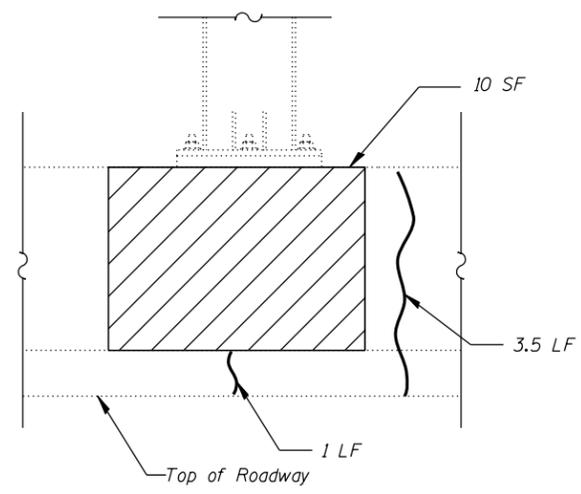

SECTION A-A

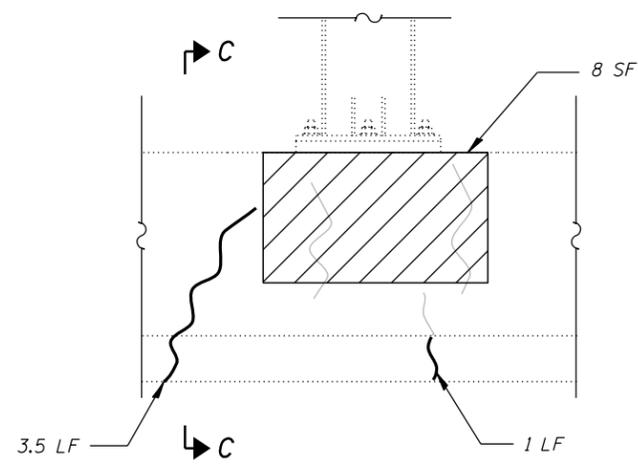

SECTION B-B

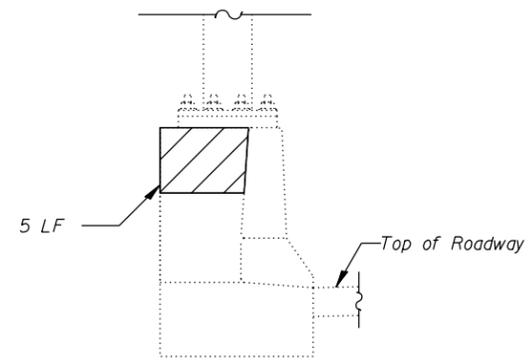

SECTION C-C

BILL OF MATERIAL

ITEM	UNIT	QUANTITY
EPOXY CRACK INJECTION	FOOT	9
STRUCTURAL REPAIR OF CONCRETE (DEPTH EQUAL TO OR LESS THAN 5 INCHES)	SQ. FT.	45
GROUT PAD REMOVAL	EACH	2

LEGEND

- Structural Repair of Concrete (Depth Less than or Equal to 5 inches)
- Hairline Crack (Width < 0.06")
- Epoxy Crack Injection (Width > 0.06")



USER NAME =	charles.pigozzi	DESIGNED -	JJS, FL	REVISED -	
		CHECKED -	MAI, JMG	REVISED -	
PLOT SCALE =	N.T.S	DRAWN -	HI, FL	REVISED -	
PLOT DATE =	1/24/2020	CHECKED -	MAI, JMG	REVISED -	

**STATE OF ILLINOIS
DEPARTMENT OF TRANSPORTATION**


**EXIST. PARAPET PARTIAL REMOVAL AND REPAIRS
STRUCTURE NO. 016-1047**

F.A.I. RTE.	SECTION	COUNTY	TOTAL SHEETS	SHEET NO.
90/94/290	2015-019R	COOK	2155	1047
CONTRACT NO. 62A76				

SHEET NO. SS97 OF SS129 SHEETS

ILLINOIS FED. AID PROJECT

FILE NAME: D:\VIAECOM-NA-AW51\arecomonline\local\AECOM_DS02_NAD\Documents\01_Americas\Transportation\60269938_Circle\Phase_I\000_CAD\008_Structural\Sign_Structures\62A76_Vierendeel-SS101-SignStruct.dgn

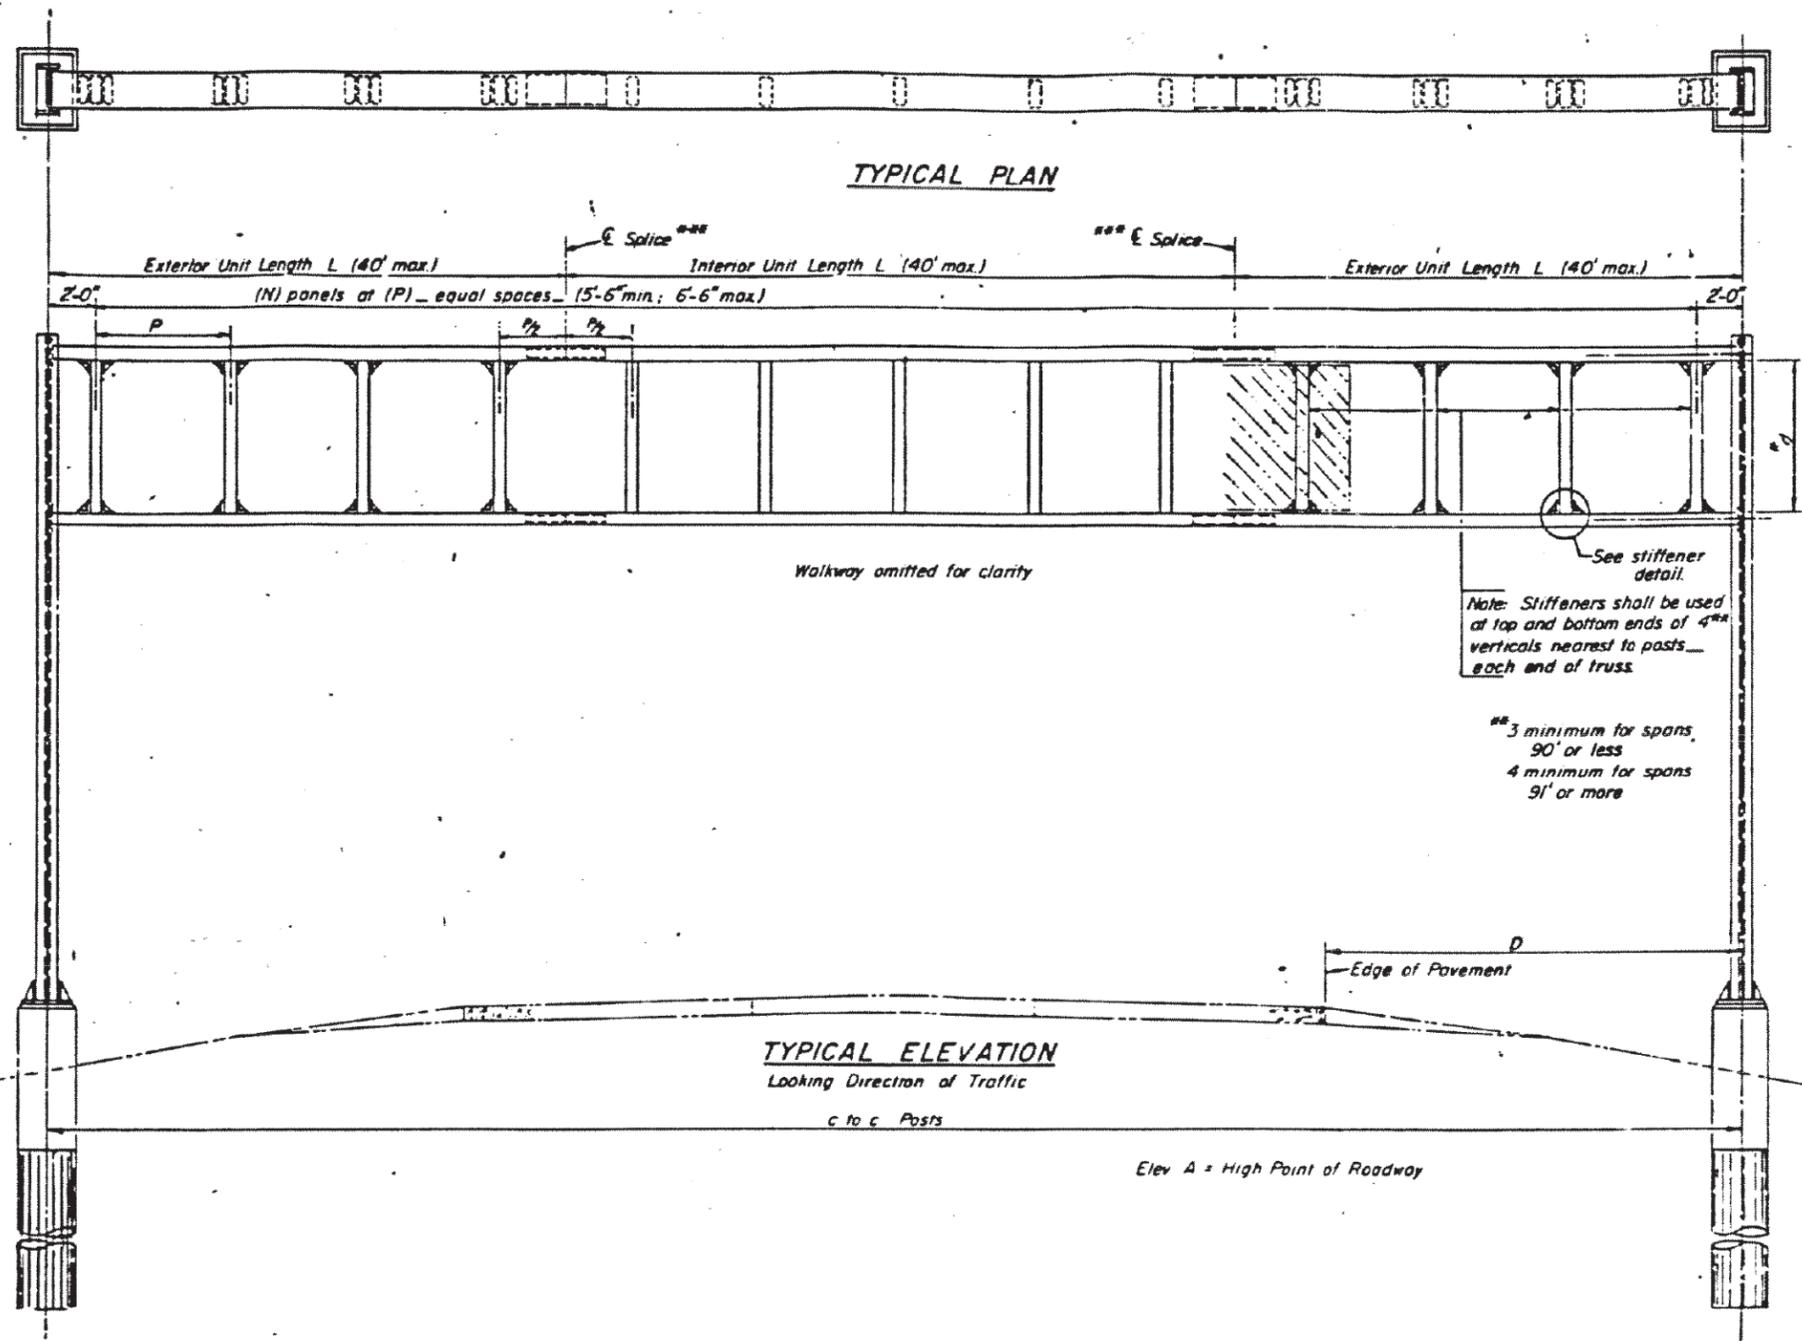

SPECIFICATIONS:

DESIGN: AASHTO Standard Specifications for Structural Supports for Highway Signs, Luminaires and Traffic Signals, dated January, 1985.

CONSTRUCTION: Standard Specifications for Road and Bridge Construction, State of Illinois, (dated October 1, 1983), Supplemental Specifications for Road and Bridge Construction; Standard Specifications for Traffic Control Items (dated Feb. 1, 1984) and Special Provisions.

MINIMUM CLEARANCE: Vertical Roadway Clearance = 17'-3" (All Obstructions)


LOADING: 80 MPH WIND VELOCITY PLUS 30% GUST FACTOR
WIND LOADING: 35 psf normal to Sign Panel Area as shown below in Wind Loading Diagram plus 48 psf normal to exposed frame members.

WALKWAY LOADING: Dead Load plus 500# concentrated Live Load

MATERIALS:
REINFORCEMENT BARS shall conform to the requirements of AASHTO M31 or M53, Grade 60.
CLASS X CONCRETE shall be used throughout.
STRUCTURAL STEEL All material for structural chords, verticals, or chord splices shall conform to either ASTM A500-Grade C, AASHTO M222 or AASHTO M223-Grade 50 and shall meet the longitudinal CVN requirements of 15 ft lbs. at 40° F.
Posts shall conform to AASHTO M222 or M223-Grade 50, and shall meet the longitudinal CVN requirements of 15 ft lbs. at 40° F.
HIGH STRENGTH BOLTS shall conform to the requirements of AASHTO M164.
STRUCTURAL SHAPES and PLATES shall conform to the requirements of AASHTO M223, Grade 50, or M222, unless otherwise specified.

PAINTING: The zinc-silicate and vinyl paint system shall be used for shop and field painting of all structural steel. Exterior surfaces of all structural steel that are painted with the high-build vinyl paint shall receive one coat of vinyl enamel. Paint system, including field coat, for the walkway gratings may be done in the shop or just prior to erection. Chords and verticals will require painting on exterior surfaces only.

WELDING: All welding shall be in accordance with Article 507.04(s) of the Standard Specifications for Road and Bridge Construction.

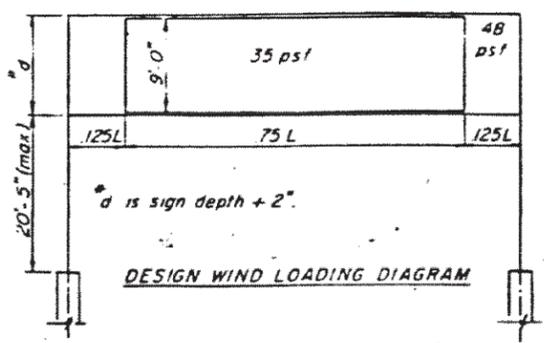

NOTES:

1. For General Notes, General Paint Notes, Index of Sheets, Total Bill of Material and Miscellaneous Details, see Sheet SS99.

For Existing Vierendeel Truss Sign Structure Location Map, see Sheet SS100.

DESIGNATION	STRUCTURE NO.	^a STATION	LOCATION DESCRIPTION
NB-01	ISO161094L054.0	101+36.60	South of 18th St.
NB-03	ISO161094L053.3	130+31.78	North of 26th St. over UPRR
NB-05A	ISO161094L053.0	149+69.96	Ramp C near Lumber St.
NB-08	ISO161094L052.5	174+42.54	North of 14th Place
NB-11	ISO161094L052.2	7247+64.90	S. End of Roosevelt Rd. Ramp to I-290

^aNB-01, NB-03, NB-05A, NB-08 Measured along Exist. @ NB I-90/94.
 NB-11 Measured along Prop. @ Roosevelt Road Entrance Ramp. It should be noted that the stations included in the Table for sign structures NB-01, NB-03, NB-05A and NB-08 are measured along the Exist. @ NB I-90/94 as presented in this Contract and may differ from stations shown in Existing Record Drawings

SIGNED Moussa A. Issa
 DR. MOUSSA A. ISSA, S.E., IL. LIC. NO. 081-005738
 EXPIRES 11-30-2020

DATE 01/29/2020 FOR SHEETS SS98 THRU SS129
 (TOTAL OF 32 SHEETS)



USER NAME = marian.agamy	DESIGNED - HI, FL	REVISED -
PLOT SCALE = N.T.S	CHECKED - MAI, JJS	REVISED -
PLOT DATE = 1/29/2020	DRAWN - HI, FL	REVISED -
	CHECKED - MAI, JJS	REVISED -

STATE OF ILLINOIS
 DEPARTMENT OF TRANSPORTATION

EXISTING VIERENDEEL TRUSS SIGN STRUCTURE
 TYPICAL PLAN, ELEVATION AND SPECIFICATIONS

F.A.I. RTE.	SECTION	COUNTY	TOTAL SHEETS	SHEET NO.
90/94/290	2015-019R	COOK	2155	1048
CONTRACT NO. 62A76				
ILLINOIS FED. AID PROJECT				

SHEET NO. SS98 OF SS129 SHEETS

GENERAL NOTES:

- Fasteners shall be ASTM A325 Type 1, mechanically galvanized bolts. All new fasteners, and associated hardware such as nuts and washers, shall match existing sizes. See Existing Record Drawings included within these plans for details.
- No field welding is permitted except as specified in the contract documents.
- Existing Vierendeel truss sign structure repairs, and associated concrete repairs, were determined from field inspection performed at the time of plan preparation. The necessary adjustments based on current field conditions will be made at time of construction. Such variations shall not be cause for additional compensation for a change in the scope of work; however, the Contractor will be paid for the quantity actually furnished at the unit price bid for the work.
- Plan dimensions and details relative to existing plans are subject to nominal construction variations. The Contractor shall field-verify existing dimensions and details affecting new construction and make necessary approved adjustments prior to construction or ordering of materials. Such variations shall not be cause for additional compensation for a change in the scope of work; however, the Contractor will be paid for the quantity actually furnished at the unit price bid for the work.
- The Contractor shall take all necessary precautions for the protection of passing vehicles for falling objects and/or materials until completion of the work.

INDEX OF SHEETS


SS98	Existing Vierendeel Truss Sign Structure, Typical Plan, Elevation and Specifications
SS99	General Notes, Index of Sheets, Total Bill of Material and Miscellaneous Details
SS100	Existing Vierendeel Truss Sign Structure Location Map
SS101	NB-01 (ISO161094L054.0) Vierendeel Truss Sign Structure Repairs
SS102	NB-03 (ISO161094L053.3) Vierendeel Truss Sign Structure Repairs
SS103	NB-05A (ISO161094L053.0) Vierendeel Truss Sign Structure Repairs
SS104	NB-08 (ISO161094L052.5) Vierendeel Truss Sign Structure Repairs
SS105	NB-11 (ISO161094L052.2) Vierendeel Truss Sign Structure Repairs
SS106 thru SS129	Existing Record Drawings

TOTAL BILL OF MATERIAL


ITEM	UNIT	QUANTITY
EPOXY CRACK INJECTION	FOOT	27
POLYURETHANE SEALANT	FOOT	54
REPLACE JOINT FILLER	FOOT	56
REPLACE HANDRAIL LOCKING PIN CONNECTION	EACH	58
CONTAINMENT AND DISPOSAL OF NON-LEAD PAINT CLEANING RESIDUES NO. 1	L SUM	1
CONTAINMENT AND DISPOSAL OF NON-LEAD PAINT CLEANING RESIDUES NO. 2	L SUM	1
CONTAINMENT AND DISPOSAL OF NON-LEAD PAINT CLEANING RESIDUES NO. 3	L SUM	1
CONTAINMENT AND DISPOSAL OF NON-LEAD PAINT CLEANING RESIDUES NO. 4	L SUM	1
CONTAINMENT AND DISPOSAL OF NON-LEAD PAINT CLEANING RESIDUES NO. 5	L SUM	1
TIGHTEN SUPPORT ANCHOR BOLT	EACH	3
METAL SCREEN	EACH	10
SAFETY CHAIN	EACH	10
REPLACE SPLICE FLANGE BOLT	EACH	280
CLEANING AND PAINTING SIGN STRUCTURE NO. 1	L SUM	1
CLEANING AND PAINTING SIGN STRUCTURE NO. 2	L SUM	1
CLEANING AND PAINTING SIGN STRUCTURE NO. 3	L SUM	1
CLEANING AND PAINTING SIGN STRUCTURE NO. 4	L SUM	1
CLEANING AND PAINTING SIGN STRUCTURE NO. 5	L SUM	1
STRUCTURAL REPAIR OF CONCRETE (DEPTH EQUAL TO OR LESS THAN 5 INCHES)	SQ FT	4
GROUT PAD REMOVAL	EACH	9

GENERAL PAINT NOTES:


- Cleaning and painting of the existing structural steel shall be as specified in the Special Provision for "Cleaning and Painting Existing Overhead Sign Structures".
- All cleaning shall be performed per SSPC-SPII, Power Tool Cleaning to Bare Metal, and all painting shall be performed according to Paint System 1-OZ/E/U. The color of the final finish coat shall be Reddish Brown, Munsell No. 2.5 YR 3/4.
- All items attached to the structure such as, but not limited to, existing conduits and brackets shall be cleaned and painted.
- All work associated with the cleaning and painting of existing overhead sign structures shall be performed using temporary expressway lane closures in accordance with the Special Provision for Keeping Expressways Open to Traffic, or as otherwise permitted by the Department, and shall not proceed until the appropriate permits have been secured from the Department.
- At no time shall work associated with containment, cleaning, or painting be performed on more than one (1) Vierendeel truss sign structure simultaneously; rather, all such work shall be completed at one sign structure prior to commencing work on a different sign structure.
- Temporary relocation, and/or removal, storage and re-erection, of existing sign panels may be required to accomplish the work. At no time shall sign panels with exit arrows be removed from the sign structures with the exception of immediate relocation to allow for completion of the remaining work at the same sign structure. Temporary Support Brackets shall be as per the "District One Overhead Sign Structure Hanger Detail for Vierendeel Truss" show in the Signing Plans or as otherwise permitted by the Engineer. All materials, fabrication erection, and other work associated with temporary relocation, and/or removal, storage and re-erection, of sign panels (including temporary support brackets) shall be included in this item and shall not be paid separately.
- No additional holes shall be made in members of the existing Vierendeel truss for any reason.

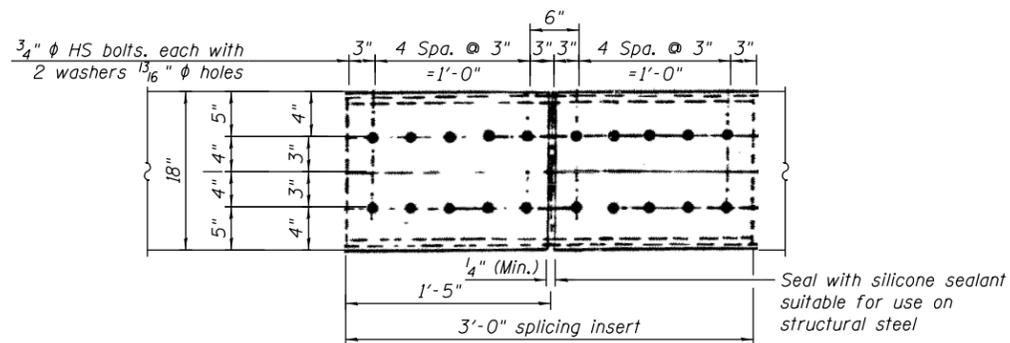

PLAN VIEW OF CHORD SPLICES

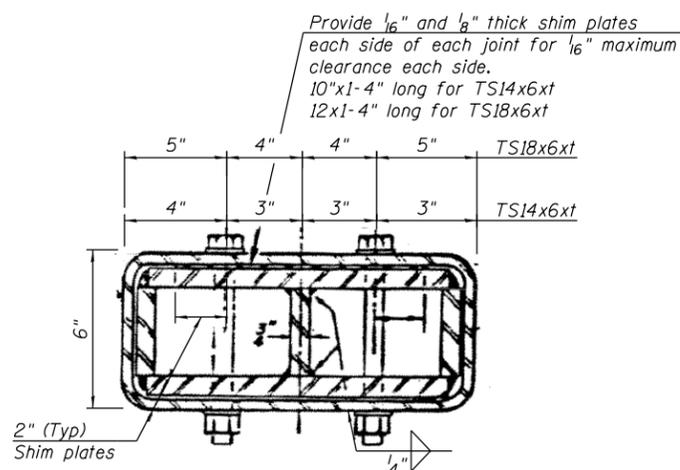


SECTION THRU SPLICE

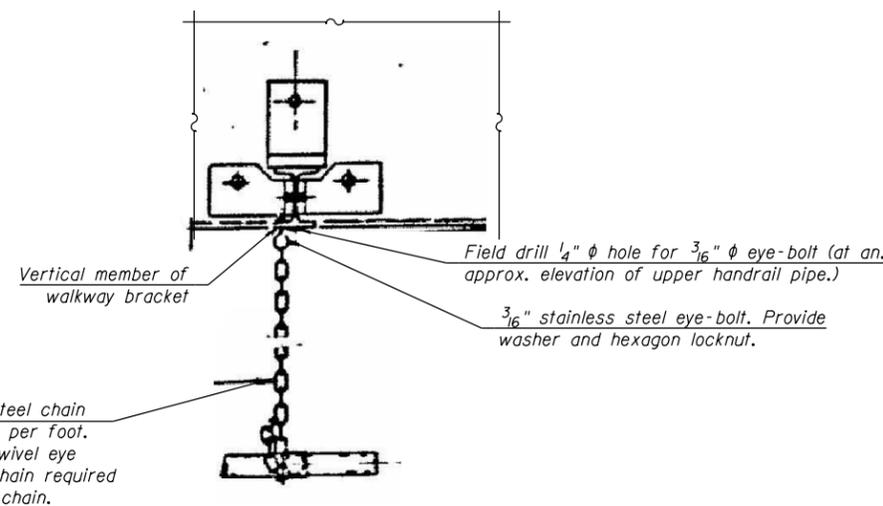

SAFETY CHAIN

One (1) required for each end of each walkway

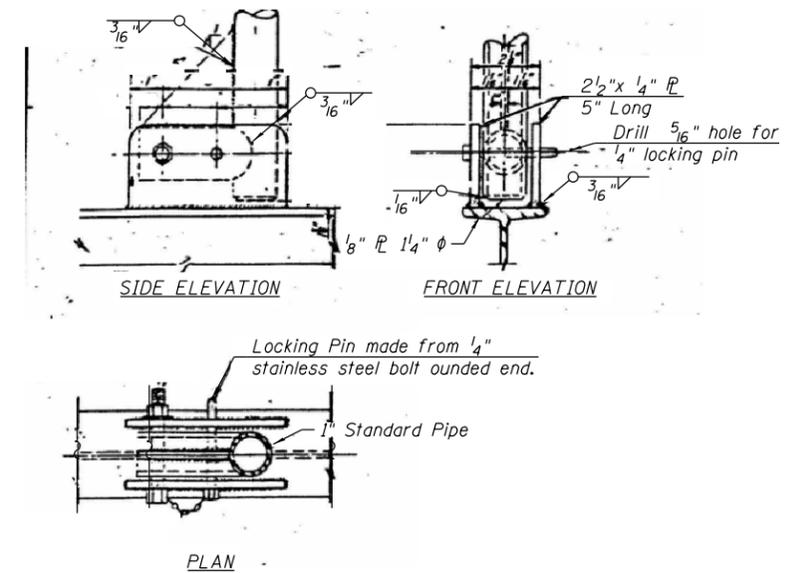

DETAILS OF HANDRAIL HINGE

For additional information, see Existing Record Drawings



USER NAME = marina.stoica	DESIGNED - HI, FL	REVISED -
PLOT SCALE = N.T.S	CHECKED - MAI, JJS	REVISED -
PLOT DATE = 1/29/2020	DRAWN - HI, FL	REVISED -
	CHECKED - MAI, JJS	REVISED -

**STATE OF ILLINOIS
DEPARTMENT OF TRANSPORTATION**



**GENERAL NOTES, INDEX OF SHEETS, TOTAL BILL OF MATERIAL
AND MISCELLANEOUS DETAILS**

SHEET NO. SS99 OF SS129 SHEETS

F.A.I. RTE. 90/94/290	SECTION 2015-019R	COUNTY COOK	TOTAL SHEETS 2155	SHEET NO. 1049
CONTRACT NO. 62A76				
ILLINOIS FED. AID PROJECT				

FILE NAME: D:\V\AECOM-NA-AW51\arecomonline-local\AECOM_D502_NAVDocuments\01_Americas\Transportation\60269938_Circle\Phase_I\000_CAD\008_Structural\Sign_Structures\62A76_Vierendeel-SS102-SignStruct.dgn

FILE NAME: P:\V\AECOM-NA-AWS1\arecomonline\local\AECOM_DS02_NAVDocuments\01_Americas\Transportation\60269938_Circle\Phase_II\000_CAD\008_Structural\Sign_Structures\62A76-Vierendeel-SS102A-SignStruct.dgn

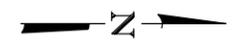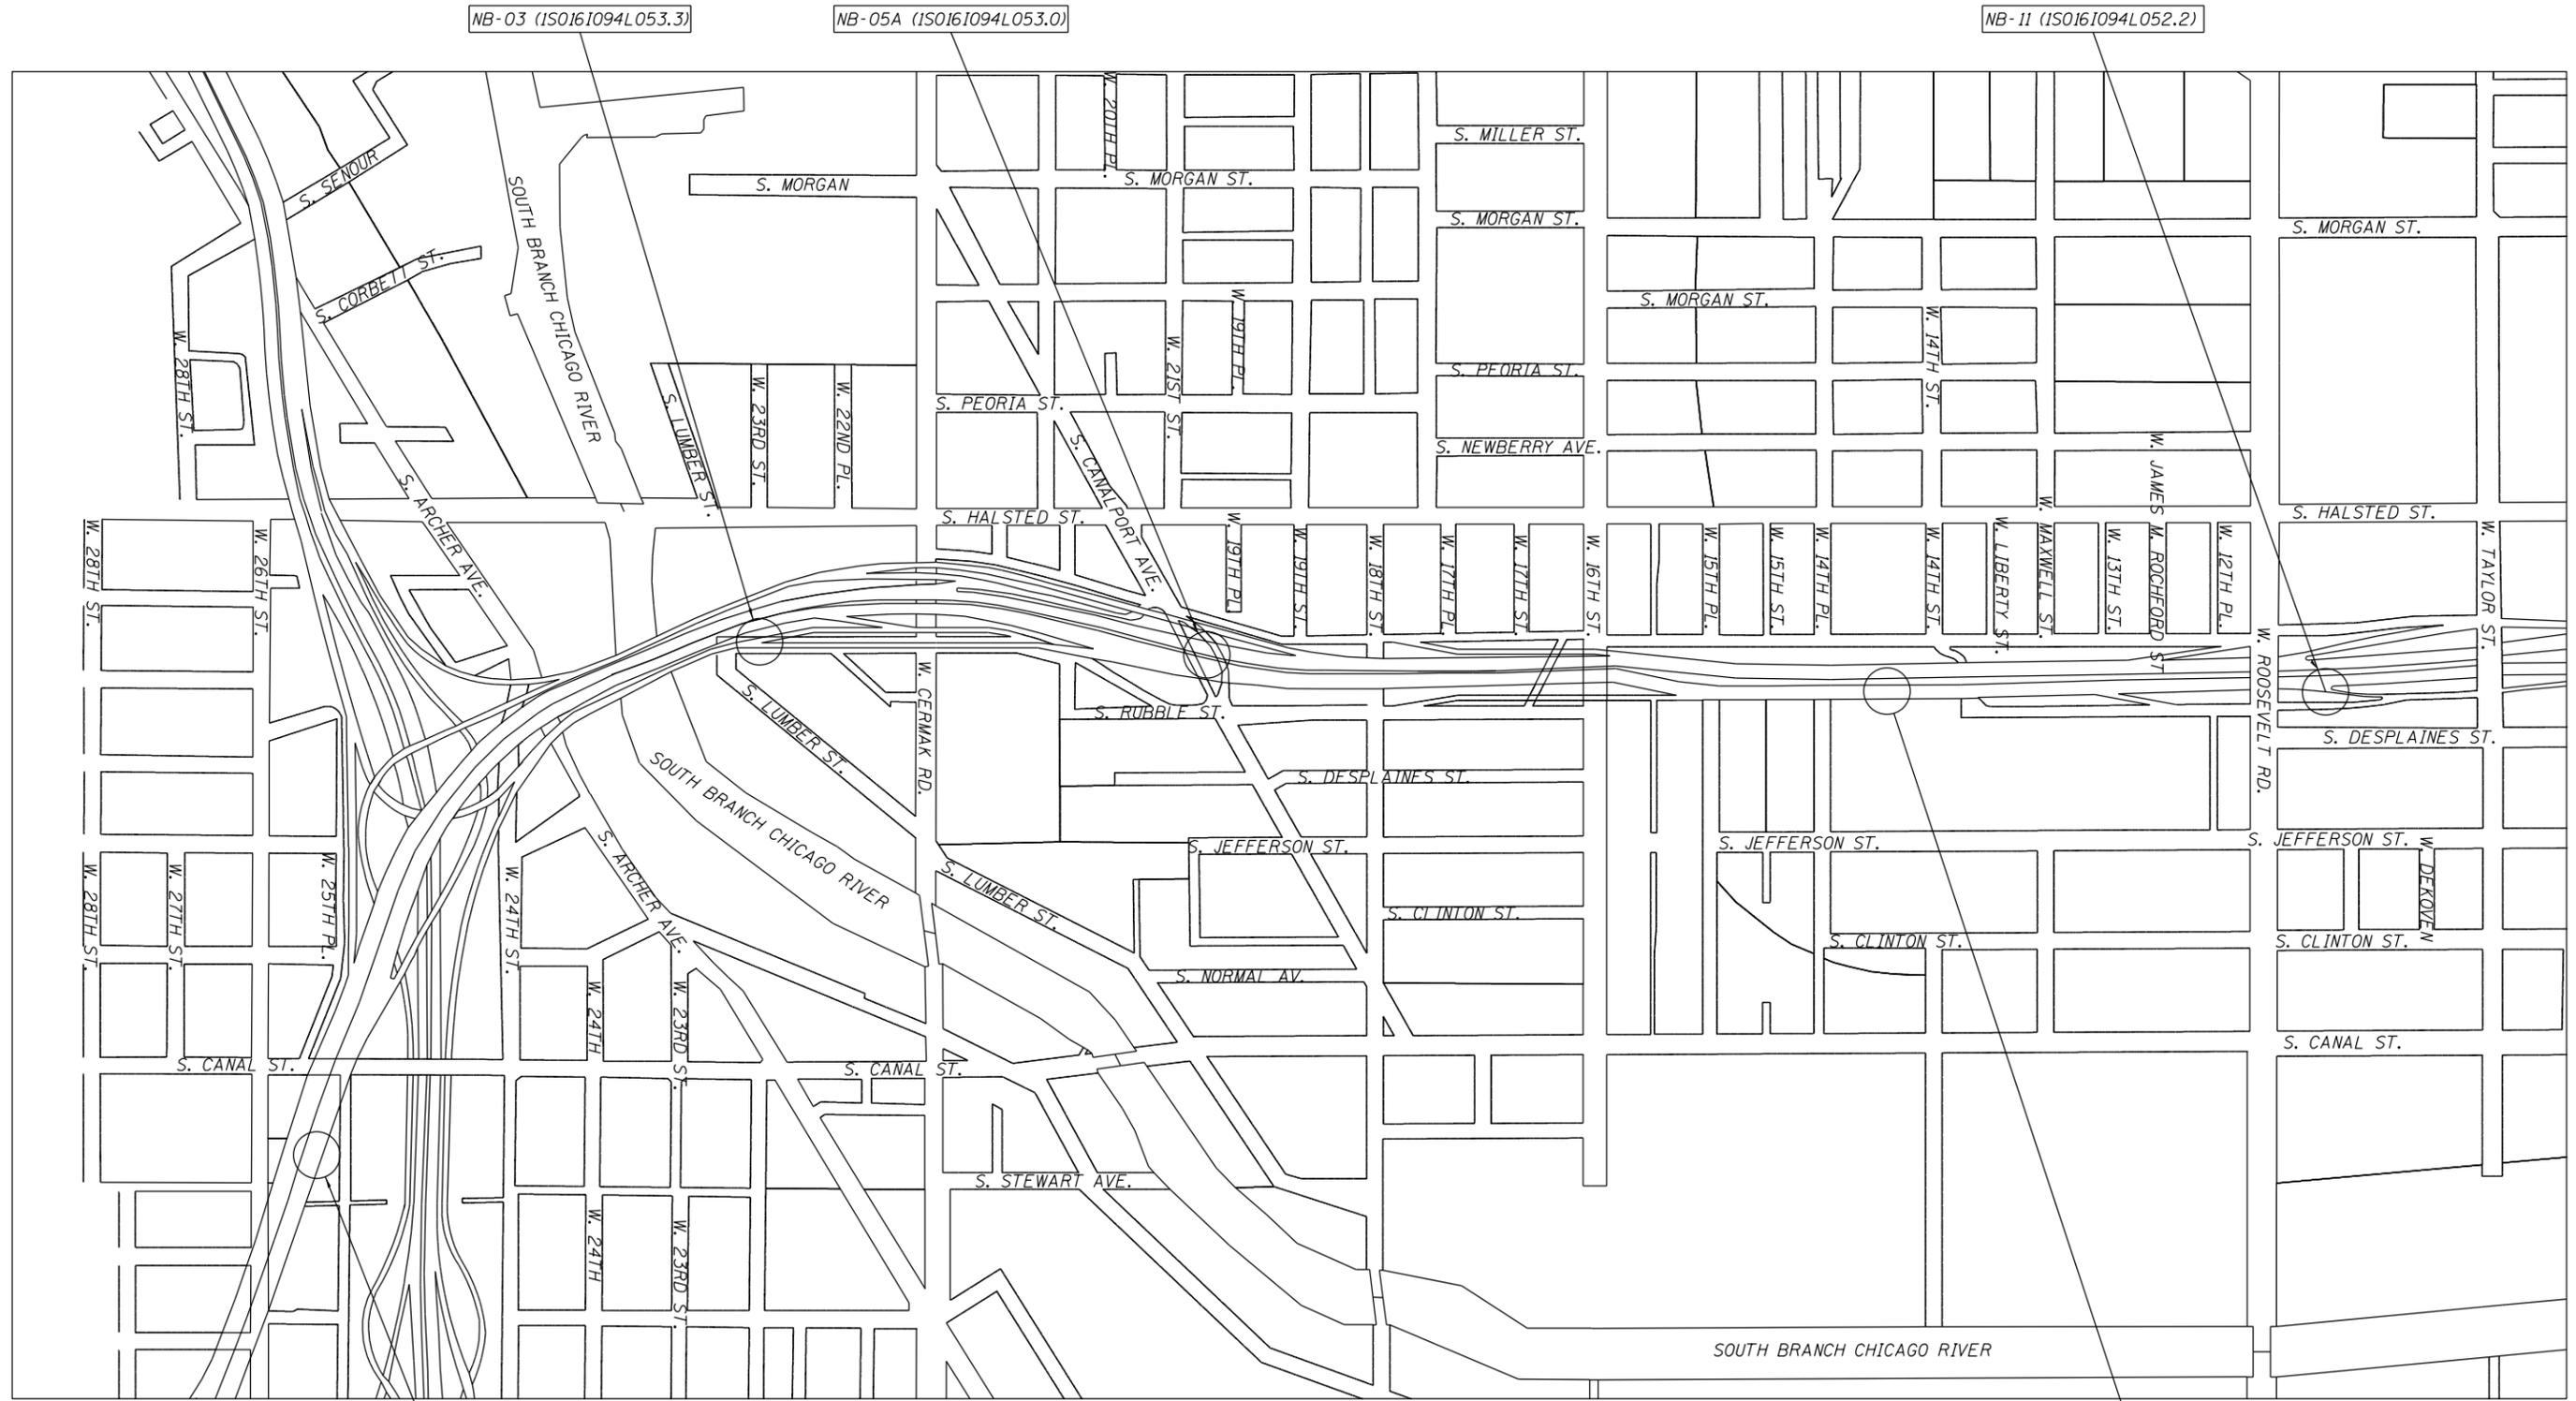

LOCATION MAP



USER NAME = charles.pigozzi	DESIGNED - HI, FL	REVISED -
	CHECKED - MAI, JJS	REVISED -
PLOT SCALE = N.T.S	DRAWN - HI, FL	REVISED -
PLOT DATE = 1/24/2020	CHECKED - MAI, JJS	REVISED -

STATE OF ILLINOIS
DEPARTMENT OF TRANSPORTATION



EXISTING VIERENDEEL TRUSS SIGN STRUCTURE LOCATION MAP
VIERENDEEL TRUSS SIGN STRUCTURE REPAIRS

SHEET NO. SS100 OF SS129 SHEETS


F.A.I. RTE. 90/94/290	SECTION 2015-019R	COUNTY COOK	TOTAL SHEETS 2155	SHEET NO. 1050
CONTRACT NO. 62A76				
ILLINOIS FED. AID PROJECT				

BILL OF MATERIAL


ITEM	UNIT	QUANTITY
EPOXY CRACK INJECTION	FOOT	12
POLYURETHANE SEALANT	FOOT	8
REPLACE JOINT FILLER	FOOT	14
REPLACE HANDRAIL LOCKING PIN CONNECTION	EACH	14
CONTAINMENT AND DISPOSAL OF NON-LEAD PAINT CLEANING RESIDUES NO. 1	L SUM	1.0
METAL SCREEN	EACH	2
SAFETY CHAIN	EACH	2
REPLACE SPLICE FLANGE BOLT	EACH	40
CLEANING AND PAINTING SIGN STRUCTURE NO. 1	L SUM	1.0
STRUCTURAL REPAIR OF CONCRETE (DEPTH EQUAL TO OR LESS THAN 5 INCHES)	SQ FT	1
GROUT PAD REMOVAL	EACH	1

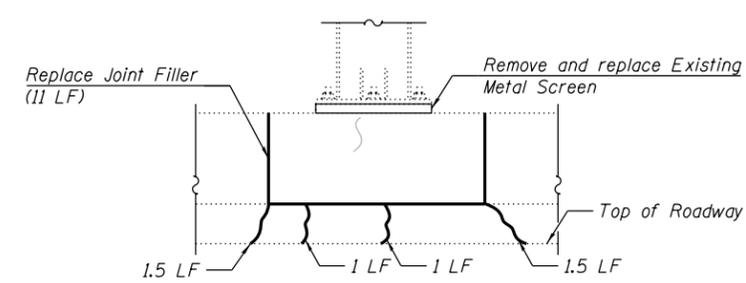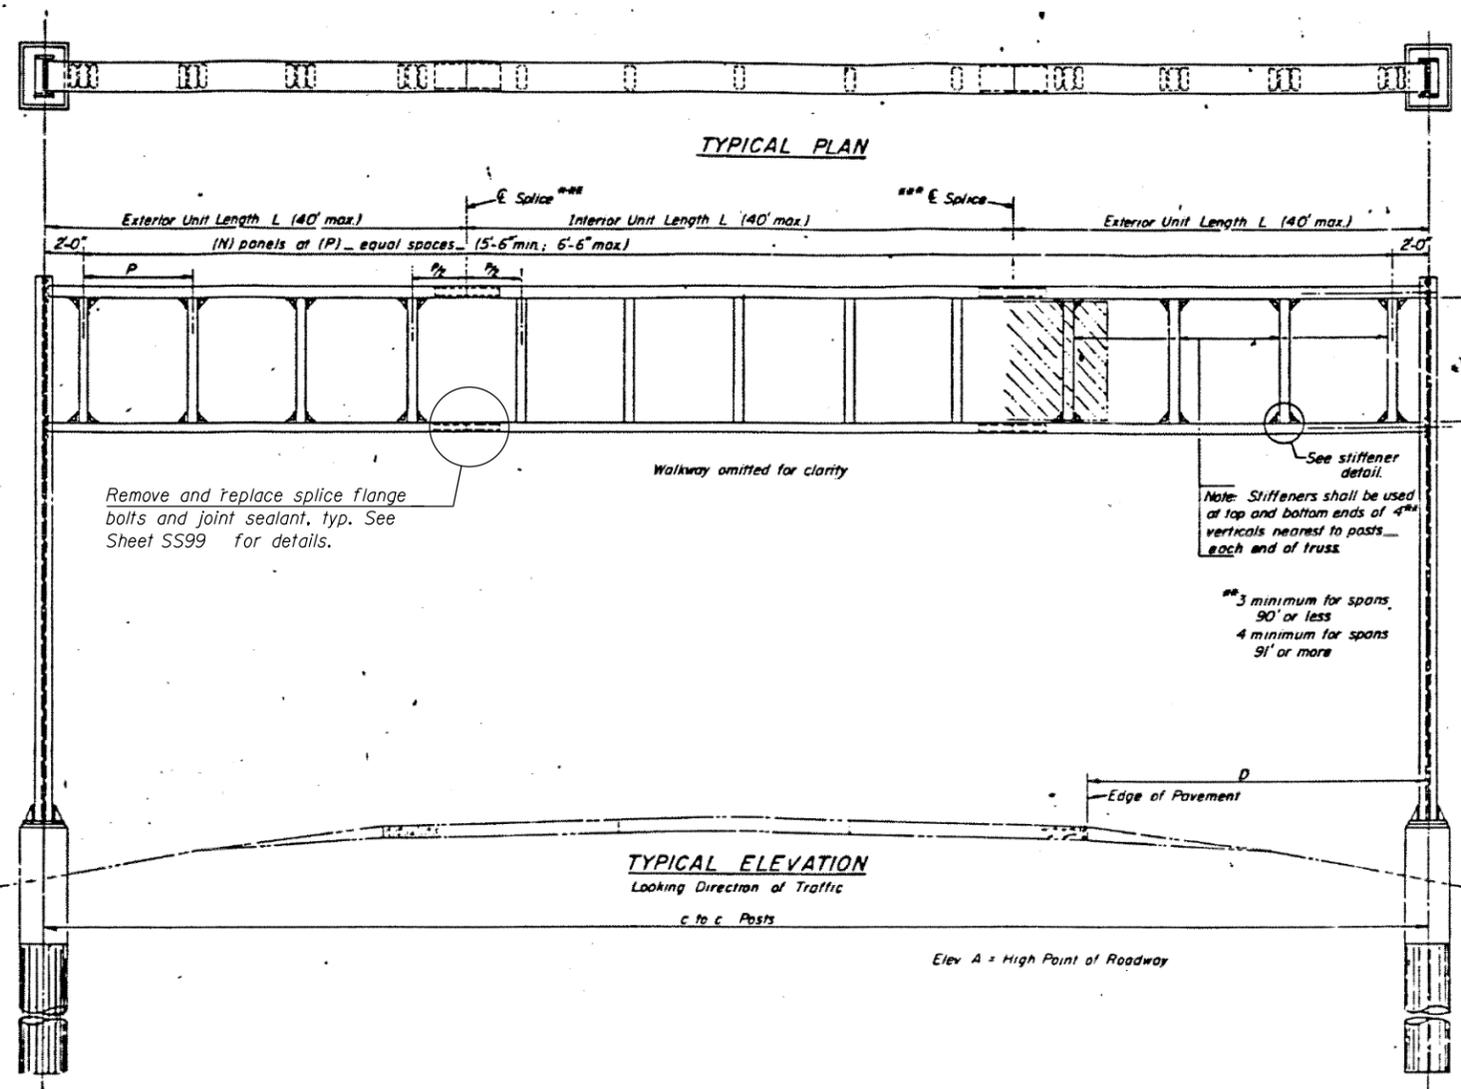


ELEVATION - LEFT PARAPET FOUNDATION

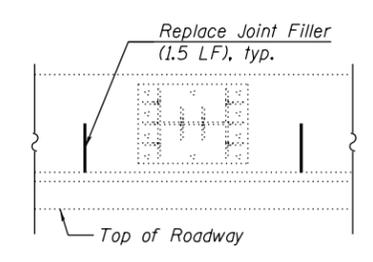


PLAN - LEFT PARAPET FOUNDATION

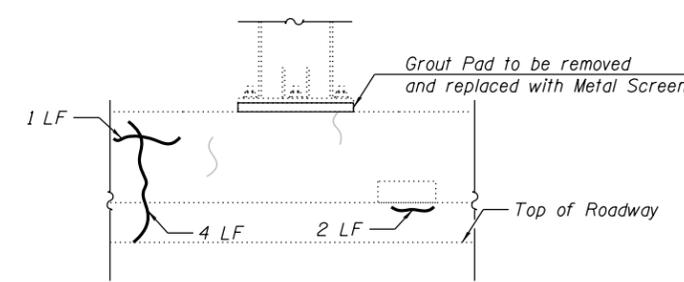

ELEVATION - RIGHT PARAPET FOUNDATION

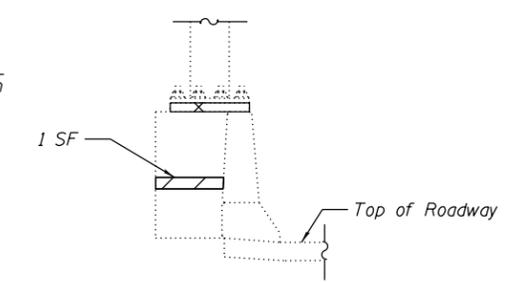

SIDE ELEVATION - RIGHT PARAPET FOUNDATION (NORTH FACE)

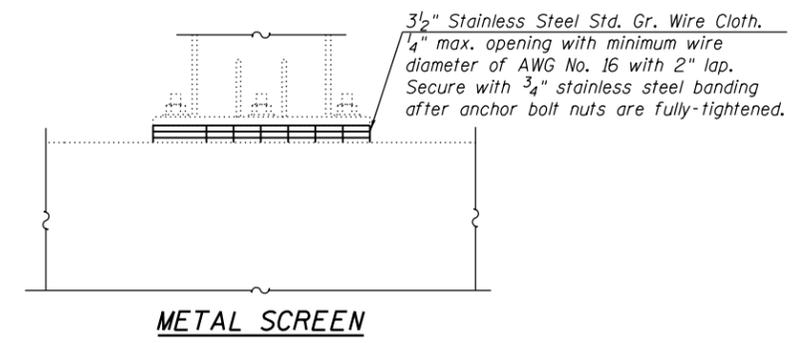

METAL SCREEN

PROPOSED SCOPE OF WORK

1. Remove and replace existing splice flange bolts and existing splice joint sealant material.
2. Install new hangers to support taller sign panels. See Signing Plans for Details and quantities.
3. Replace three (3) missing handrail locking pins and realign eleven (11) misaligned handrail locking pins.
4. Install two (2) new Safety Chains.
5. Perform epoxy crack injection and structural repair of concrete to the left and right parapets/foundations as required.
6. Remove existing wire mesh rodent shield, and remove and replace existing joint filler at left foundation.
7. Remove existing grout pad at right foundation.
8. Clean and paint exposed portions of existing anchor bolts and install new metal screens at both foundations.
9. Sandblast and repaint sign structure and walkway.

LEGEND

- Epoxy Crack Injection (Width > 0.06")
- Replace Joint Filler
- Structural Repair of Concrete (Depth Less than or Equal to 5")

NOTES:

1. For splice, handrail locking pin connection and safety chain details, see Sheet SS99

FILE NAME: D:\V\AE\COM-NA-AW51\aeecomonline\local\AE\COM_D502_NA\Documents\01_Americas\Transportation\60269938_Circle\Phase_I\000_CAD\008_Structural\Sign_Structures\62A76_Vierendeel-SS103-SignStruct.dgn



USER NAME = charles.pigozzi	DESIGNED - HI, FL	REVISED -
PLOT SCALE = N.T.S	CHECKED - MAI, JJS	REVISED -
PLOT DATE = 1/24/2020	DRAWN - HI, FL	REVISED -
	CHECKED - MAI, JJS	REVISED -

**STATE OF ILLINOIS
DEPARTMENT OF TRANSPORTATION**



**NB-01 (1S016I094L054.0)
VIERENDEEL TRUSS SIGN STRUCTURE REPAIRS**

F.A.I. RTE. 90/94/290	SECTION 2015-019R	COUNTY COOK	TOTAL SHEETS 2155	SHEET NO. 1051
CONTRACT NO. 62A76				
ILLINOIS FED. AID PROJECT				

SHEET NO. SS101 OF SS129 SHEETS

BILL OF MATERIAL

ITEM	UNIT	QUANTITY
EPOXY CRACK INJECTION	FOOT	7
POLYURETHANE SEALANT	FOOT	7
REPLACE HANDRAIL LOCKING PIN CONNECTION	EACH	8
CONTAINMENT AND DISPOSAL OF NON-LEAD PAINT CLEANING RESIDUES NO. 2	L SUM	1.0
METAL SCREEN	EACH	2
SAFETY CHAIN	EACH	2
REPLACE SPLICE FLANGE BOLT	EACH	40
CLEANING AND PAINTING SIGN STRUCTURE NO. 2	L SUM	1.0
STRUCTURAL REPAIR OF CONCRETE (DEPTH EQUAL TO OR LESS THAN 5 INCHES)	SQ FT	1
GROUT PAD REMOVAL	EACH	2

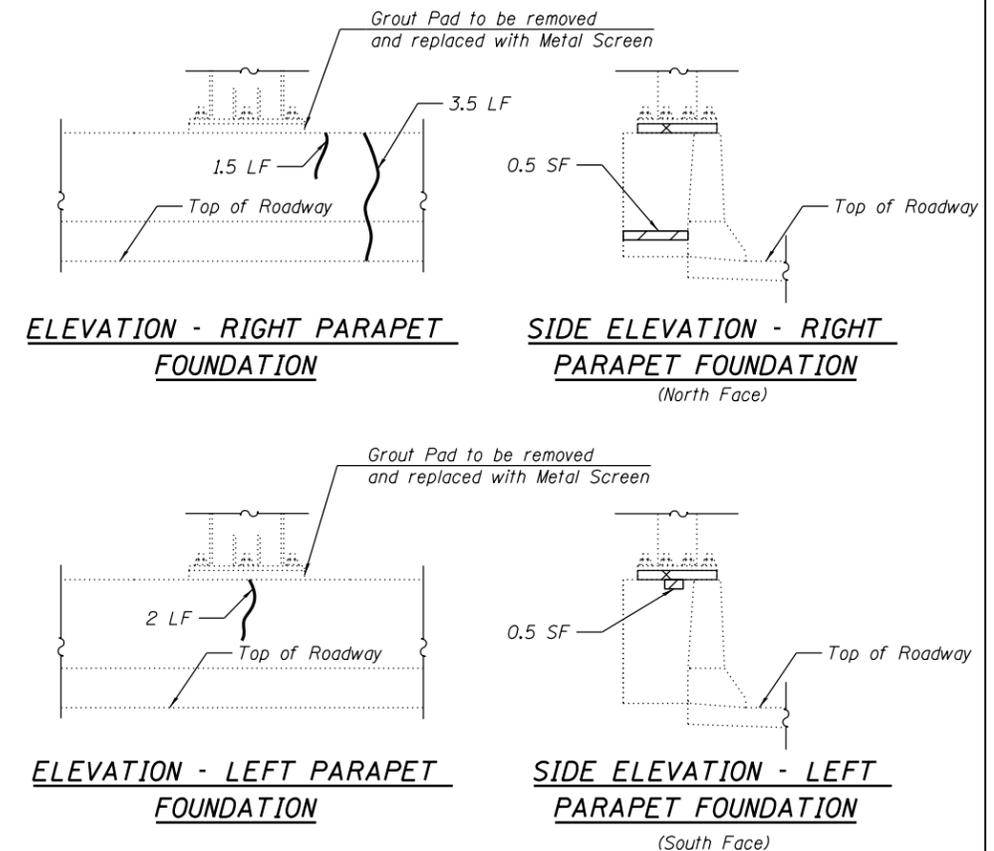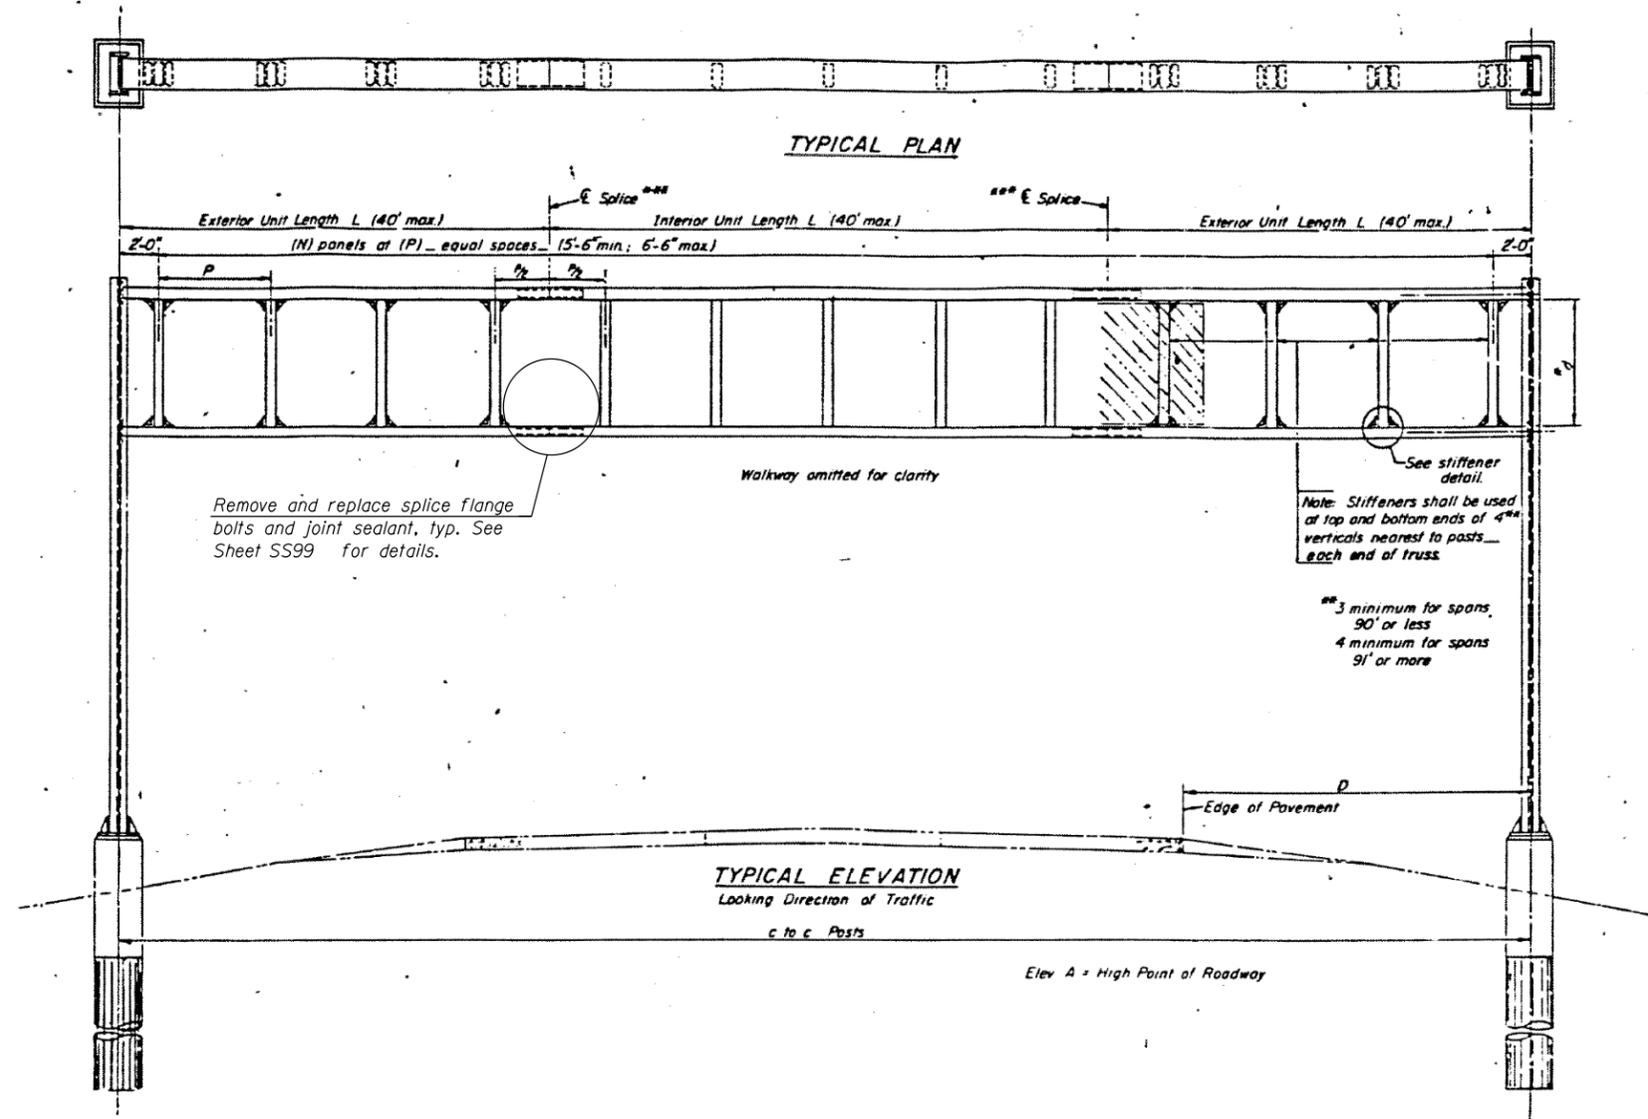


PROPOSED SCOPE OF WORK

1. Remove and replace existing splice flange bolts and existing splice joint sealant material.
2. Realign eight (8) misaligned handrail locking pins.
3. Install two (2) new Safety Chains.
4. Perform epoxy crack injection and structural repair of concrete to the left and right parapets/foundations as required.
5. Remove existing grout pad, clean and paint exposed portions of existing anchor bolts and install new metal screens at both foundations.
6. Sandblast and repaint sign structure and walkway.

LEGEND

- Epoxy Crack Injection (Width > 0.06")
- Structural Repair of Concrete (Depth Less than or Equal to 5")

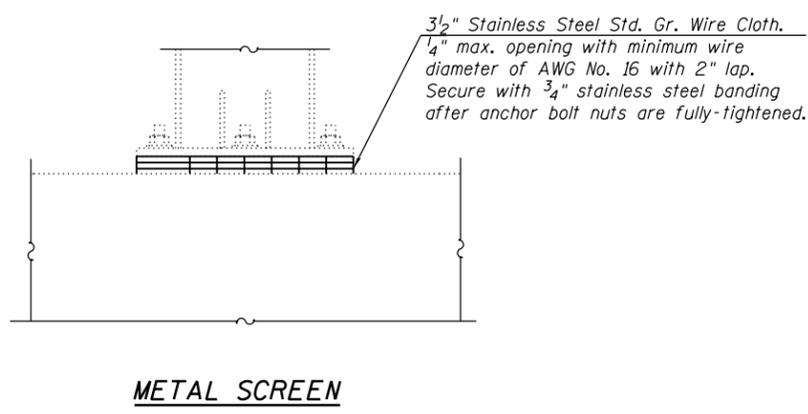

NOTE:
1. For splice, handrail locking pin connection and safety chain details, see Sheet SS99.

FILE NAME: D:\V\AECOM\NA-AW51\arecomonline\local\AECOM_DS02_NAD\Documents\01_Americas\Transportation\60269938_Circle\Phase_II\000_CAD\008_Structural\Sign_Structures\62A76-Vierendeel-SS104-SignStruct.dgn



USER NAME =	charles.pigozzi	DESIGNED -	HI, FL	REVISED -	
		CHECKED -	MAI, JJS	REVISED -	
PLOT SCALE =	N.T.S	DRAWN -	HI, FL	REVISED -	
PLOT DATE =	1/24/2020	CHECKED -	MAI, JJS	REVISED -	

**STATE OF ILLINOIS
DEPARTMENT OF TRANSPORTATION**

**NB-03 (1S0161094L053.3)
VIERENDEEL TRUSS SIGN STRUCTURE REPAIRS**


F.A.I. RTE.	SECTION	COUNTY	TOTAL SHEETS	SHEET NO.
90/94/290	2015-019R	COOK	2155	1052
CONTRACT NO. 62A76				

SHEET NO. SS102 OF SS129 SHEETS


ILLINOIS FED. AID PROJECT

BILL OF MATERIAL


ITEM	UNIT	QUANTITY
POLYURETHANE SEALANT	FOOT	16
REPLACE JOINT FILLER	FOOT	14
REPLACE HANDRAIL LOCKING PIN CONNECTION	EACH	14
CONTAINMENT AND DISPOSAL OF NON-LEAD PAINT CLEANING RESIDUES NO. 3	L SUM	1.0
TIGHTEN SUPPORT ANCHOR BOLT	EACH	2
METAL SCREEN	EACH	2
SAFETY CHAIN	EACH	2
REPLACE SPLICE FLANGE BOLT	EACH	80
CLEANING AND PAINTING SIGN STRUCTURE NO. 3	L SUM	1.0
STRUCTURAL REPAIR OF CONCRETE (DEPTH EQUAL TO OR LESS THAN 5 INCHES)	SQ FT	1
GROUT PAD REMOVAL	EACH	2

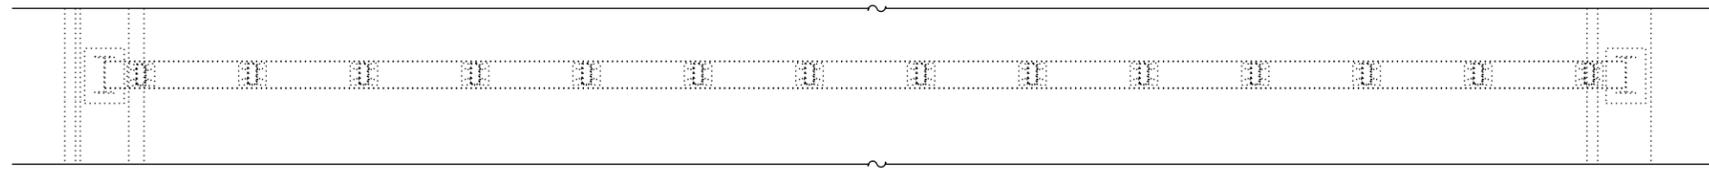

TYPICAL PLAN

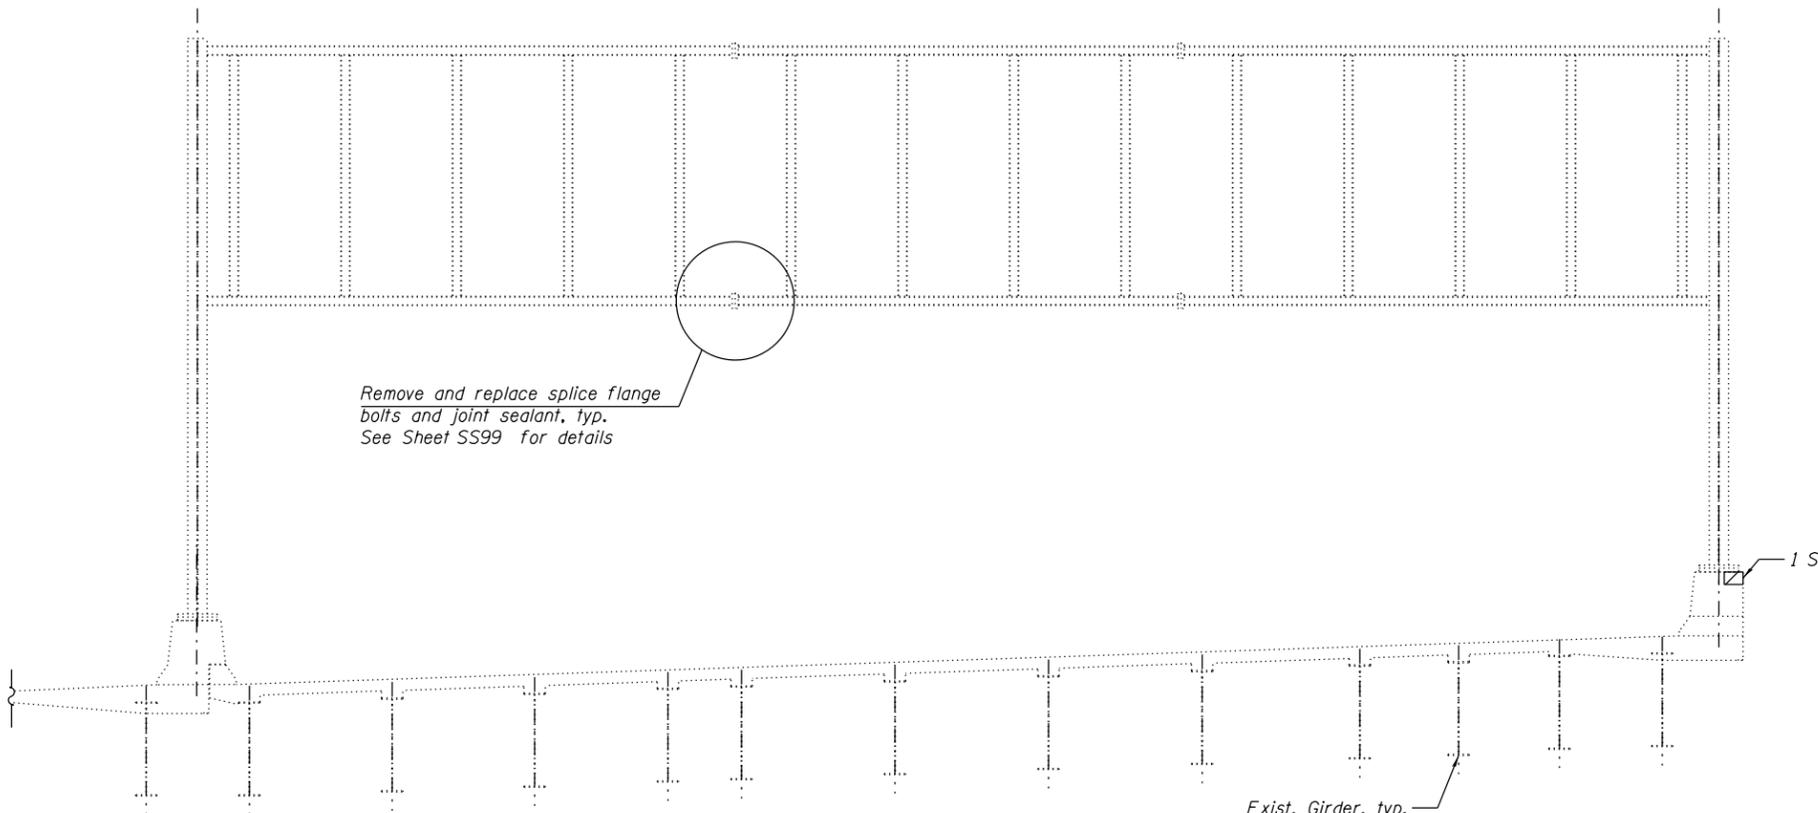


TYPICAL ELEVATION

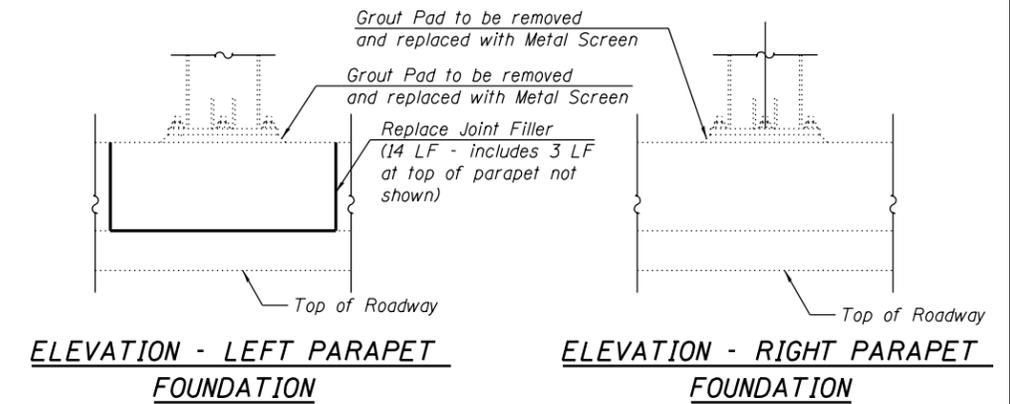


ELEVATION - LEFT PARAPET FOUNDATION

ELEVATION - RIGHT PARAPET FOUNDATION

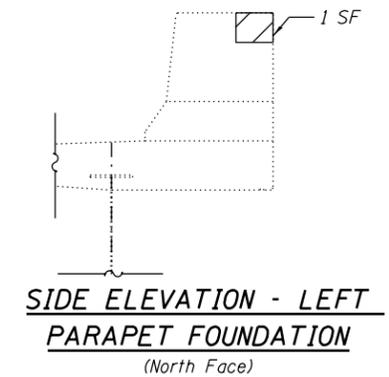

SIDE ELEVATION - LEFT PARAPET FOUNDATION (North Face)

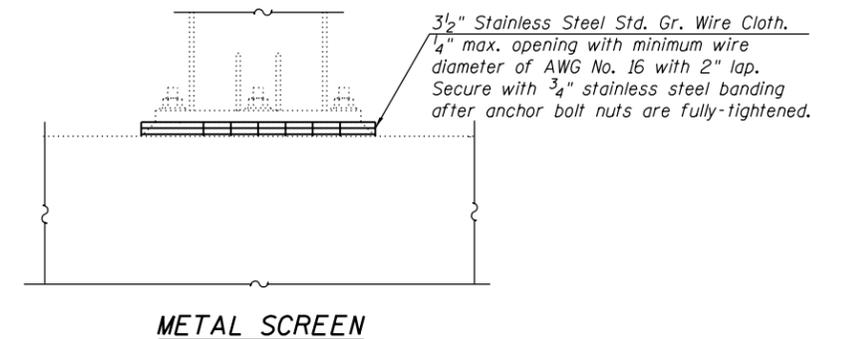

METAL SCREEN

PROPOSED SCOPE OF WORK

1. Remove and replace existing splice flange bolts and existing splice joint sealant material.
2. Realign 14 misaligned handrail locking pins.
3. Install two (2) new Safety Chains.
4. Perform epoxy crack injection and structural repair of concrete to the right parapet/foundation as required.
5. Tighten loose anchor bolt nut at west foundation.
6. Remove existing grout pad, clean and paint exposed portions of existing anchor bolts and install new metal screens at both foundations.
7. Sandblast and repaint sign structure and walkway.

NOTES:

1. For Splice, Handrail Locking Pin Connection and Safety Chain details, see Sheet SS99.

LEGEND

- Replace Joint Filler
- ▨ Structural Repair of Concrete (Depth Less than or Equal to 5")



USER NAME = marina.stoica	DESIGNED - HI, FL	REVISED -
PLOT SCALE = N.T.S	CHECKED - MAI, JJS	REVISED -
PLOT DATE = 1/29/2020	DRAWN - HI, FL	REVISED -
	CHECKED - MAI, JJS	REVISED -

**STATE OF ILLINOIS
DEPARTMENT OF TRANSPORTATION**

**NB-05A (1S016I094L053.0)
VIERENDEEL TRUSS SIGN STRUCTURE REPAIRS**

SHEET NO. SS103 OF SS129 SHEETS





F.A.I. RTE. 90/94/290	SECTION 2015-019R	COUNTY COOK	TOTAL SHEETS 2155	SHEET NO. 1053
CONTRACT NO. 62A76				

ILLINOIS FED. AID PROJECT

FILE NAME: D:\V\AECOM\NA-AW51\arecomonline\local\AECOM_DS02_NAVDocuments\01_Americas\Transportation\60269938_Circle\Phase_I\0000_CAD\008_Structural\Sign_Structures\62A76_Vierendeel-SS104A-SignStruct.dgn

BILL OF MATERIAL

ITEM	UNIT	QUANTITY
EPOXY CRACK INJECTION	FOOT	8
POLYURETHANE SEALANT	FOOT	16
REPLACE JOINT FILLER	FOOT	28
REPLACE HANDRAIL LOCKING PIN CONNECTION	EACH	14
CONTAINMENT AND DISPOSAL OF NON-LEAD PAINT CLEANING RESIDUES NO. 4	L SUM	1.0
TIGHTEN SUPPORT ANCHOR BOLT	EACH	1
METAL SCREEN	EACH	2
SAFETY CHAIN	EACH	2
REPLACE SPLICE FLANGE BOLT	EACH	80
CLEANING AND PAINTING SIGN STRUCTURE NO. 4	L SUM	1.0
STRUCTURAL REPAIR OF CONCRETE (DEPTH EQUAL TO OR LESS THAN 5 INCHES)	SQ FT	1
GROUT PAD REMOVAL	EACH	2

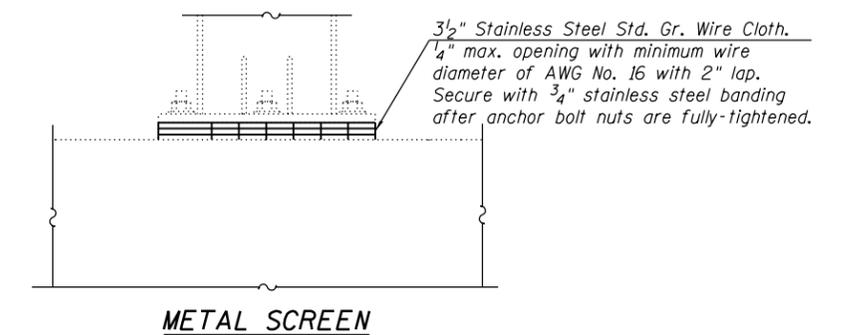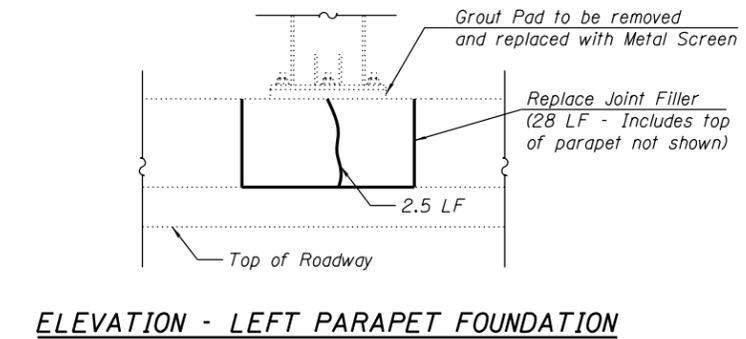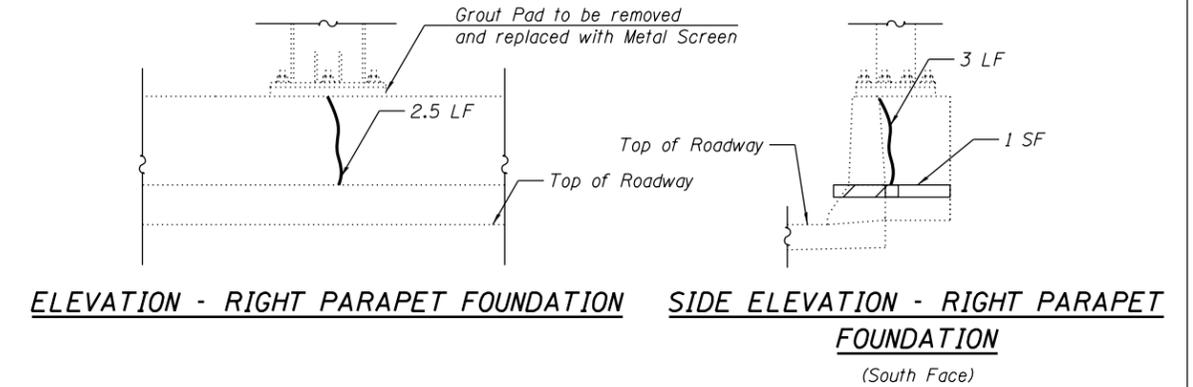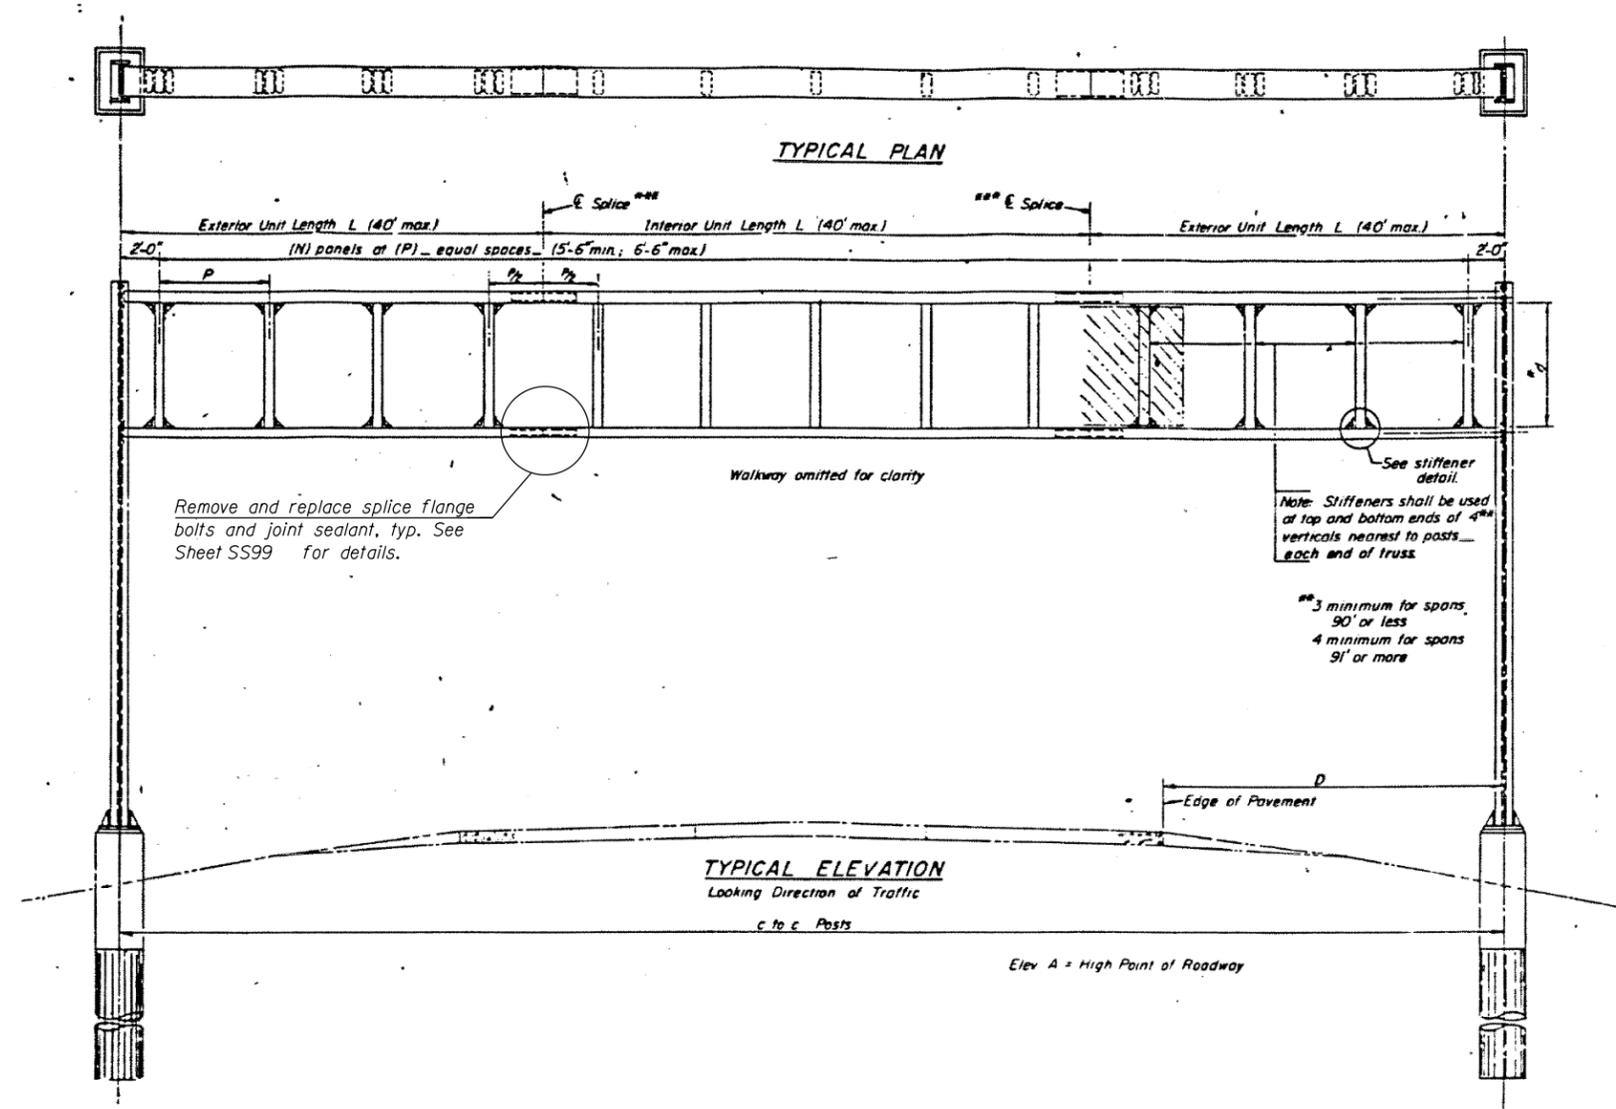

PROPOSED SCOPE OF WORK

1. Remove and replace existing splice flange bolts and existing splice joint sealant material.
2. Replace three (3) damaged handrail locking pins and realign eleven (11) misaligned handrail locking pins.
3. Install two (2) new Safety Chains.
4. Perform epoxy crack injection and structural repair of concrete to the left and right parapets/foundations as required.
5. Remove and replace existing joint filler at the left parapet/foundation as required.
6. Remove existing grout pad, clean and paint, exposed portions of existing anchor bolts and install new metal screens at both foundations.
7. Tighten loose anchor bolt nut at west foundation.
8. Sandblast and repaint sign structure and walkway.

NOTES:

1. For Splice, Handrail Locking Pin Connection and Safety Chain details, see Sheet SS99.

LEGEND

- Epoxy Crack Injection (Width > 0.06")
- Replace Joint Filler
- Structural Repair of Concrete (Depth Less than or Equal to 5")



USER NAME = marina.stoica	DESIGNED - HI, FL	REVISED -
PLOT SCALE = N.T.S	CHECKED - MAI, JJS	REVISED -
PLOT DATE = 1/29/2020	DRAWN - HI, FL	REVISED -
	CHECKED - MAI, JJS	REVISED -

**STATE OF ILLINOIS
DEPARTMENT OF TRANSPORTATION**

**NB-08 (1S0161094L052.5)
VIERENDEEL TRUSS SIGN STRUCTURE REPAIRS**

F.A.I. RTE. 90/94/290	SECTION 2015-019R	COUNTY COOK	TOTAL SHEETS 2155	SHEET NO. 1054
CONTRACT NO. 62A76				



SHEET NO. SS104 OF SS129 SHEETS

ILLINOIS FED. AID PROJECT


FILE NAME: P:\V\AE\COM-NA-AW51\ae\comonline\local\AE\COM_DS02_NAD\Documents\01_Americas\Transportation\60269938_Circle\Phase_I\000_CAD\008_Structural\Sign_Structures\62A76_Vierendeel-SS105-SignStruct.dgn

BILL OF MATERIAL

ITEM	UNIT	QUANTITY
POLYURETHANE SEALANT	FOOT	7
REPLACE HANDRAIL LOCKING PIN CONNECTION	EACH	8
CONTAINMENT AND DISPOSAL OF NON-LEAD PAINT CLEANING RESIDUES NO. 5	L SUM	1.0
METAL SCREEN	EACH	2
SAFETY CHAIN	EACH	2
REPLACE SPLICE FLANGE BOLT	EACH	40
CLEANING AND PAINTING SIGN STRUCTURE NO. 5	L SUM	1.0
GROUT PAD REMOVAL	EACH	2

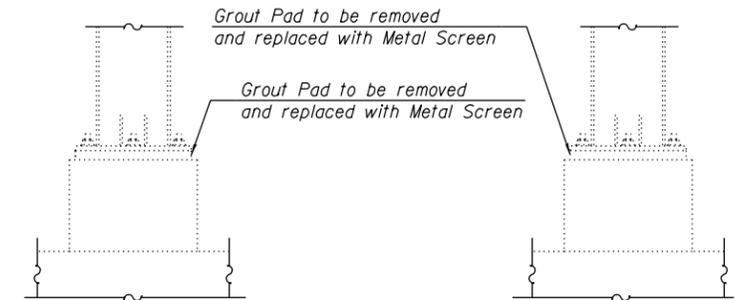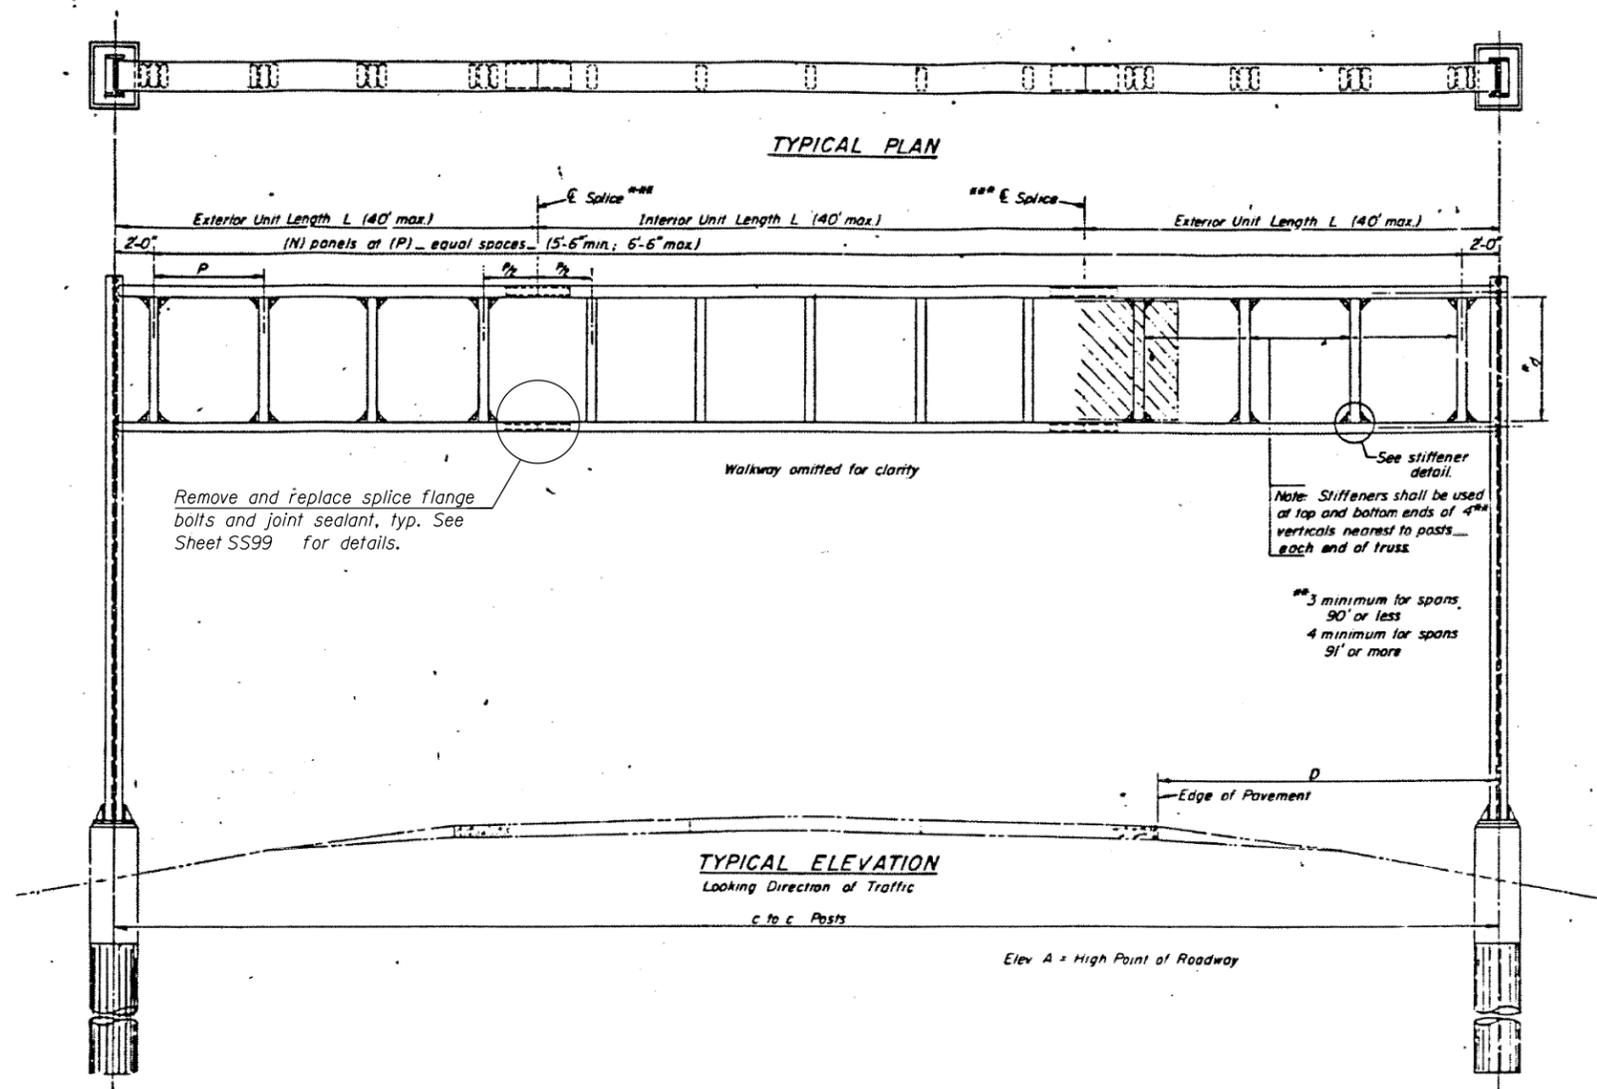

ELEVATION - LEFT FOUNDATION ELEVATION - RIGHT FOUNDATION

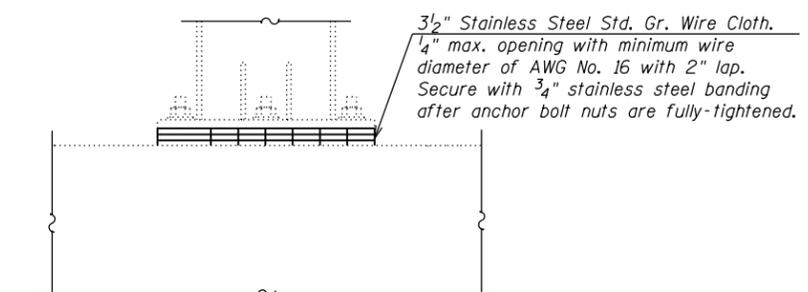

METAL SCREEN

PROPOSED SCOPE OF WORK

1. Remove and replace existing splice flange bolts and install splice joint sealant material.
2. Realign eight (8) misaligned handrail locking pins.
3. Install two (2) new Safety Chains.
4. Remove grout pad, and paint exposed portions of anchor bolts and install metal screen at both foundations.
5. Install washers at all anchor bolts on both foundations.
6. Sandblast and repaint sign structure and walkway.

NOTES:

1. For Splice, Handrail Locking Pin Connection and Safety Chain details, see Sheet SS99.



USER NAME = marina.stoica	DESIGNED - HI, FL	REVISED -
	CHECKED - MAI, JJS	REVISED -
PLOT SCALE = N.T.S	DRAWN - HI, FL	REVISED -
PLOT DATE = 1/29/2020	CHECKED - MAI, JJS	REVISED -

**STATE OF ILLINOIS
DEPARTMENT OF TRANSPORTATION**

**NB-11 (1S016I094L052.2)
VIERENDEEL TRUSS SIGN STRUCTURE REPAIRS**

F.A.I. RTE. 90/94/290	SECTION 2015-019R	COUNTY COOK	TOTAL SHEETS 2155	SHEET NO. 1055
CONTRACT NO. 62A76				
ILLINOIS		FED. AID PROJECT		



SHEET NO. SS105 OF SS129 SHEETS

FILE NAME: D:\V\AECOM-NA-AW51...aecocom\line-local\AECOM_DS02_NAD\Documents\01_Americas\Transportation\60269938_Circle\Phase_II\000_CAD\008_Structural\Sign_Structures\62A76_Sign_Structure\62A76_Vierendeel-SS106-SignStruct.dgn

4:21:27 PM

FOR INFORMATION ONLY

PROJECT NO.	4-1005	FED. AID PROJECT
# 1085-082 B		

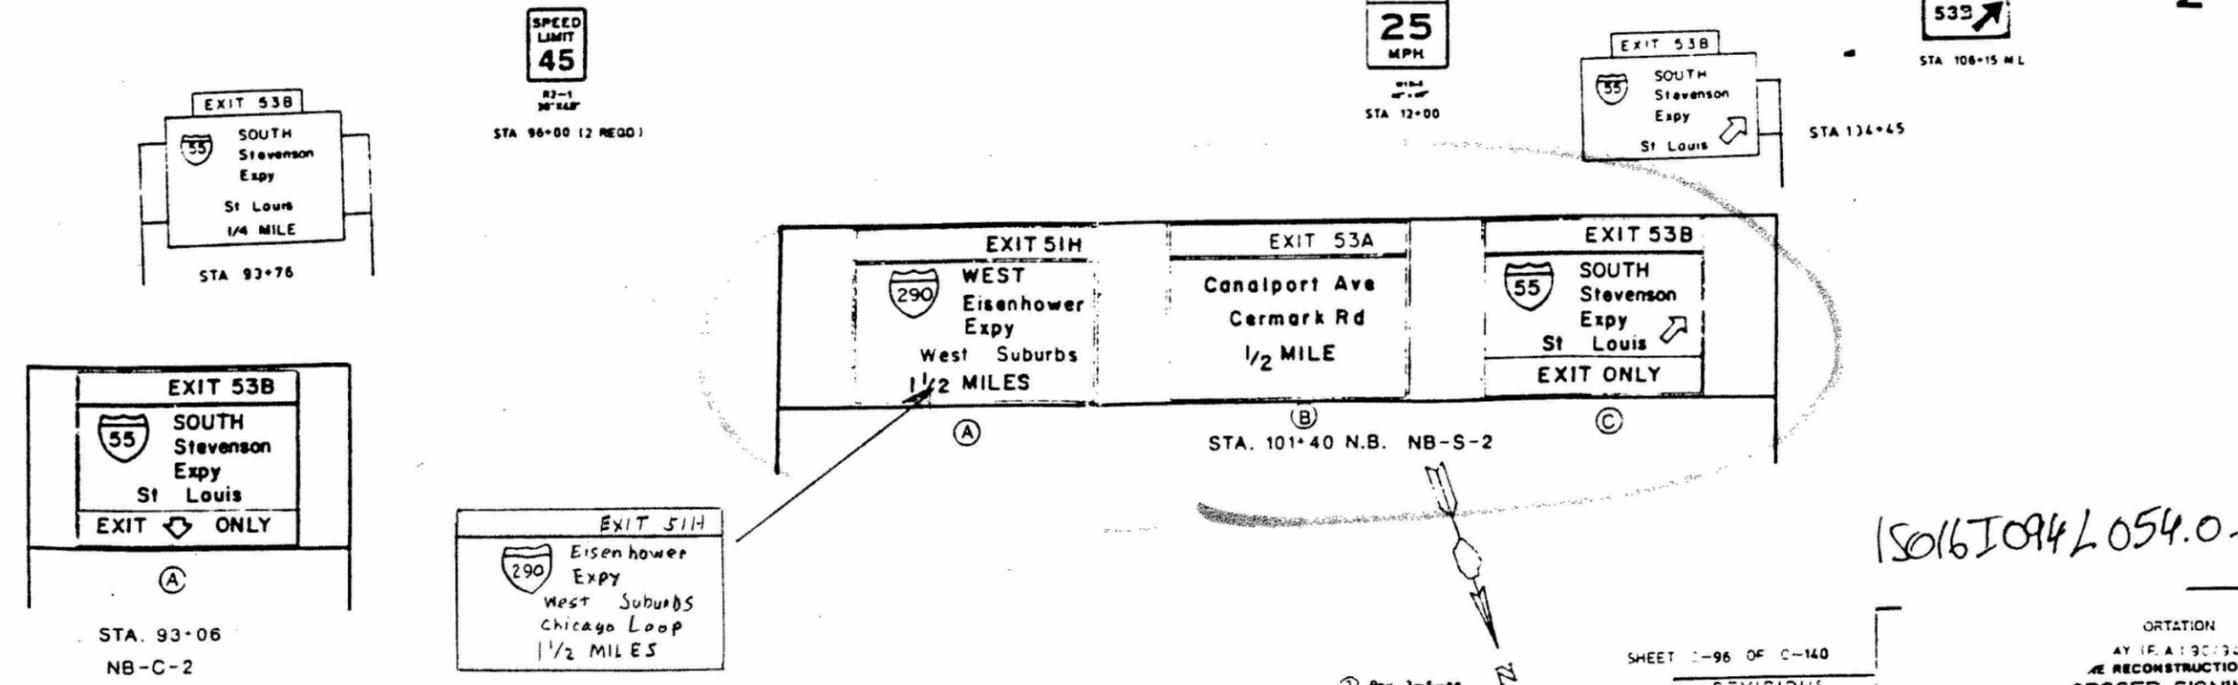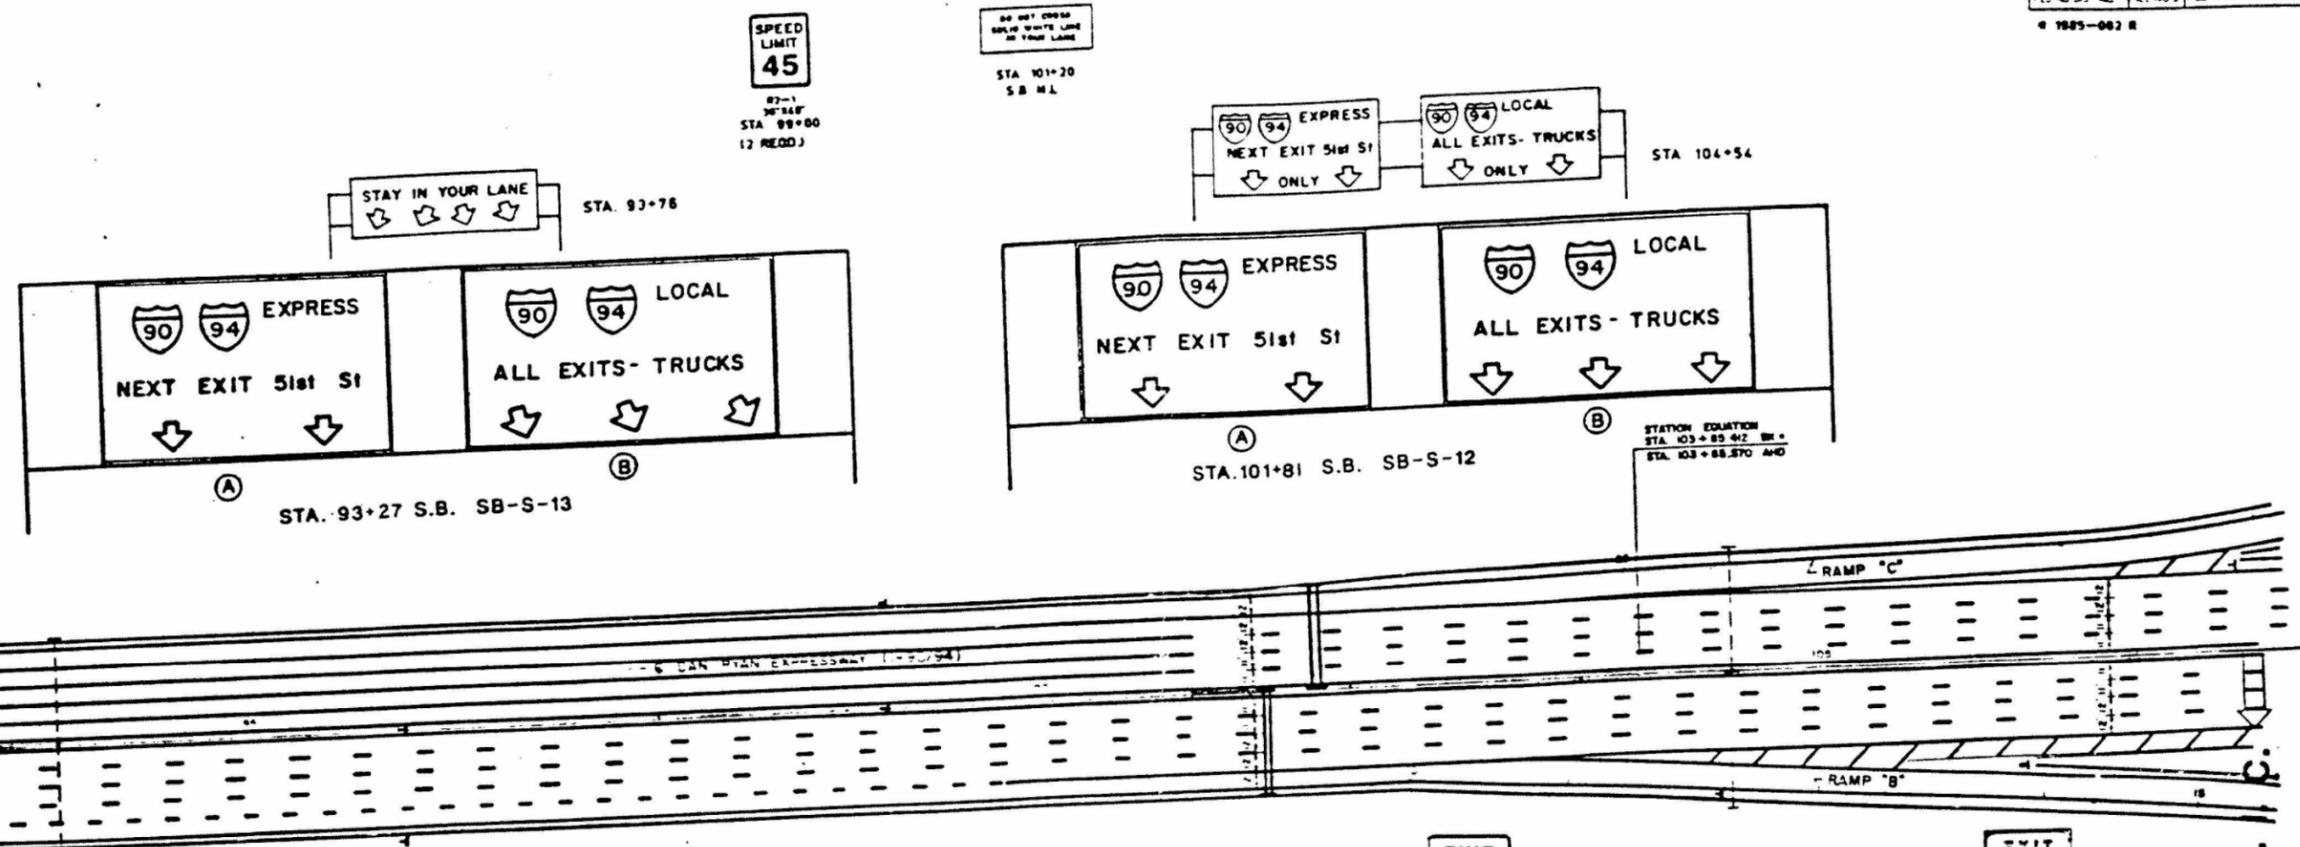

(LEGEND CHANGED TO ABOVE)

150161094 L 054.0-000

REVISED

Name	Date

KEIKAM ENGINEERING, INC.
Consulting Engineers
727A Lake Road • Egan, Illinois • 60120-1372

NOTATION
DATE: 10/19/2019
RECONSTRUCTION
PROPOSED SIGNING
ON OF S.B. LANES
Drawn By:
Checked By:
ENGINEERS INC.
Chicago, Illinois

FILE NAME: D:\V\AE\COM-NA-AW51\recomonline\local\AE\COM_ID502_NAV\Documents\01_Americas\Transportation\60269938_Circle\Phase_I\0000_CAD\008_Structural\Sign_Structures\62A76-Vierendeel-SS107-SignStruct.dgn



USER NAME =	charles.pigozzi	DESIGNED -	HI, FL	REVISED -	
		CHECKED -	MAI, JJS	REVISED -	
PLOT SCALE =	N.T.S	DRAWN -	HI, FL	REVISED -	
PLOT DATE =	1/24/2020	CHECKED -	MAI, JJS	REVISED -	

STATE OF ILLINOIS
DEPARTMENT OF TRANSPORTATION

EXISTING RECORD DRAWINGS
VIERENDEEL TRUSS SIGN STRUCTURES


F.A.I. RTE.	SECTION	COUNTY	TOTAL SHEETS	SHEET NO.
90/94/290	2015-019R	COOK	2155	1056
CONTRACT NO. 62A76				

SHEET NO. SS106 OF SS129 SHEETS

ILLINOIS FED. AID PROJECT

FOR INFORMATION ONLY

SECTION	COUNTY	TOTAL SHEETS	SHEET NO.
90/94	COOK	117	93
STA. TO STA.		PER. AND PROJECT	
* 1005 - 0778 - R			

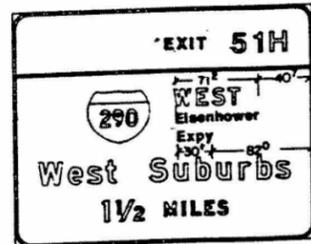

STA. 100+50
NB-S-2-PANEL A

SHIELD STANDARD(S)
N1 - 1 - 4536


BORDER WIDTH IS 2.00 INCHES CORNER RADIUS IS 9.0 INCHES

TOTAL WIDTH IS 18.0 FEET
TOTAL HEIGHT IS 12.5 FEET
TOTAL AREA IS 225.00 SQ. FT.

ARROW SIZE(S)

BACKGROUND/LEGEND COLOR IS GREEN/WHITE

LINE	VERTICAL SPACING	LEGEND HEIGHT	LETTER HEIGHT	LEFT BORDER	WORD 1 WIDTH	HORIZ. SPACING	WORD 2 WIDTH	HORIZ. SPACING	WORD 3 WIDTH	HORIZ. SPACING	WORD 4 WIDTH	HORIZ. SPACING	WORD 5 WIDTH	RIGHT BORDER	LEGEND WIDTH
TOP EDGE															
1	8/4	15/0	15/0-10/0	NR/4	32/3	15/0	39/3							16/6	86/6
2	8/4	2/0	0/0-0/0	2/0	212/0									2/0	212/0
3	12/0	36/0	12/0-0/0	40/7	45/0	18/0	47/6							64/3	110/6
4	13/0	16/0	16/0-12/0	17/6	55/5	24/0	102/0							16/6	181/5
5	12/0	15/0	15/0-10/0	63/6	30/3	15/0	46/2							60/5	91/5
6	14/0														
7															
8															
BOTTOM EDGE															

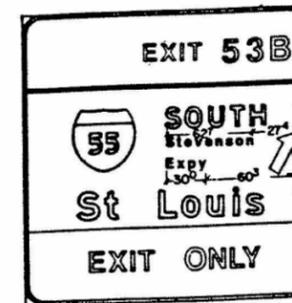

STA. 100+50
NB-S-2-PANEL C

SHIELD STANDARD(S)
N1 - 1 - 3638


BORDER WIDTH IS 2.00 INCHES CORNER RADIUS IS 9.0 INCHES

TOTAL WIDTH IS 14.6 FEET
TOTAL HEIGHT IS 12.5 FEET
TOTAL AREA IS 181.25 SQ. FT.

ARROW SIZE(S)
35 5/8 X 22 1/4

BACKGROUND/LEGEND COLOR IS GREEN/WHITE TOP 9.50 FEET
YELLOW/BLACK BOTTOM 3.0 FEET

LINE	VERTICAL SPACING	LEGEND HEIGHT	LETTER HEIGHT	LEFT BORDER	WORD 1 WIDTH	HORIZ. SPACING	WORD 2 WIDTH	HORIZ. SPACING	WORD 3 WIDTH	HORIZ. SPACING	WORD 4 WIDTH	HORIZ. SPACING	WORD 5 WIDTH	RIGHT BORDER	LEGEND WIDTH
TOP EDGE															
1	8/4	16/0	16/0-10/0	70/1	32/3	16/0	43/6								
2	6/4	2/0	0/0-0/0	2/0	170/0									2/0	170/0
3	12/0	38/0	12/0-0/0	28/6	38/0	18/0	68/6							28/6	114/6
4	12/0	16/0	16/0-12/0	12/5	23/7	18/0	62/7	16/0	27/7					12/6	148/5
5	16/0	12/0	12/0-0/0	33/6	38/3	18/0	49/2							33/5	106/5
6	14/0														
7															
8															
BOTTOM EDGE															

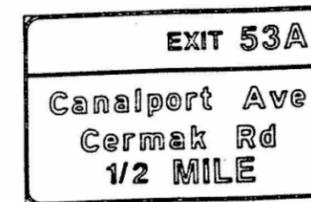

STA. 100+50
NB-S-2-PANEL B

SHIELD STANDARD(S)

BORDER WIDTH IS 2.00 INCHES CORNER RADIUS IS 9.0 INCHES

TOTAL WIDTH IS 19.0 FEET
TOTAL HEIGHT IS 12.5 FEET
TOTAL AREA IS 237.50 SQ. FT.

ARROW SIZE(S)

BACKGROUND/LEGEND COLOR IS GREEN/WHITE

LINE	VERTICAL SPACING	LEGEND HEIGHT	LETTER HEIGHT	LEFT BORDER	WORD 1 WIDTH	HORIZ. SPACING	WORD 2 WIDTH	HORIZ. SPACING	WORD 3 WIDTH	HORIZ. SPACING	WORD 4 WIDTH	HORIZ. SPACING	WORD 5 WIDTH	RIGHT BORDER	LEGEND WIDTH
TOP EDGE															
1	8/4	15/0	15/0-10/0	118/0	32/3	15/0	44/5							18/0	82/0
2	8/4	2/0	0/0-0/0	2/0	224/0									2/0	224/0
3	19/0	16/0	16/0-12/0	18/6	121/3	24/0	45/7							18/0	191/2
4	19/0	16/0	16/0-12/0	41/3	93/5	24/0	27/2							41/6	144/7
5	19/0	15/0	10/0-0/0	78/3	20/1	15/0	36/2							78/2	71/3
6	14/0														
7															
8															
BOTTOM EDGE															

SHEET C-74 OF C-104

ILLINOIS DEPARTMENT OF TRANSPORTATION
DAN RYAN EXPRESSWAY (I.A.1.90/94)
NORTHBOUND MAINLINE RECONSTRUCTION

SIGN PANEL DETAILS
28TH PL. TO MAXWELL ST

SCALE: VERT. 1"=8'0"
HORIZ. 1"=8'0"
DATE: 8/88

FILE NAME: D:\V\AECOM-NA-AW51...recomonline\local\AECOM_DS02_NAVDocuments\01_Americas\Transportation\60269938_Circle\Phase_I\0000_CAD\008_Structural\Sign_Structures\62A76_Verendeeel-SS108-SignStruct.dgn



USER NAME =	charles.pigozzi	DESIGNED -	HI, FL	REVISED -	
CHECKED -	MAI, JJS	CHECKED -	MAI, JJS	REVISED -	
PLOT SCALE =	N.T.S	DRAWN -	HI, FL	REVISED -	
PLOT DATE =	1/24/2020	CHECKED -	MAI, JJS	REVISED -	


STATE OF ILLINOIS
DEPARTMENT OF TRANSPORTATION

EXISTING RECORD DRAWINGS
VIERENDEEL TRUSS SIGN STRUCTURES

F.A.I. RTE.	SECTION	COUNTY	TOTAL SHEETS	SHEET NO.
90/94/290	2015-019R	COOK	2155	1057
CONTRACT NO. 62A76				
ILLINOIS		FED. AID PROJECT		

SHEET NO. SS107 OF SS129 SHEETS

FOR INFORMATION ONLY

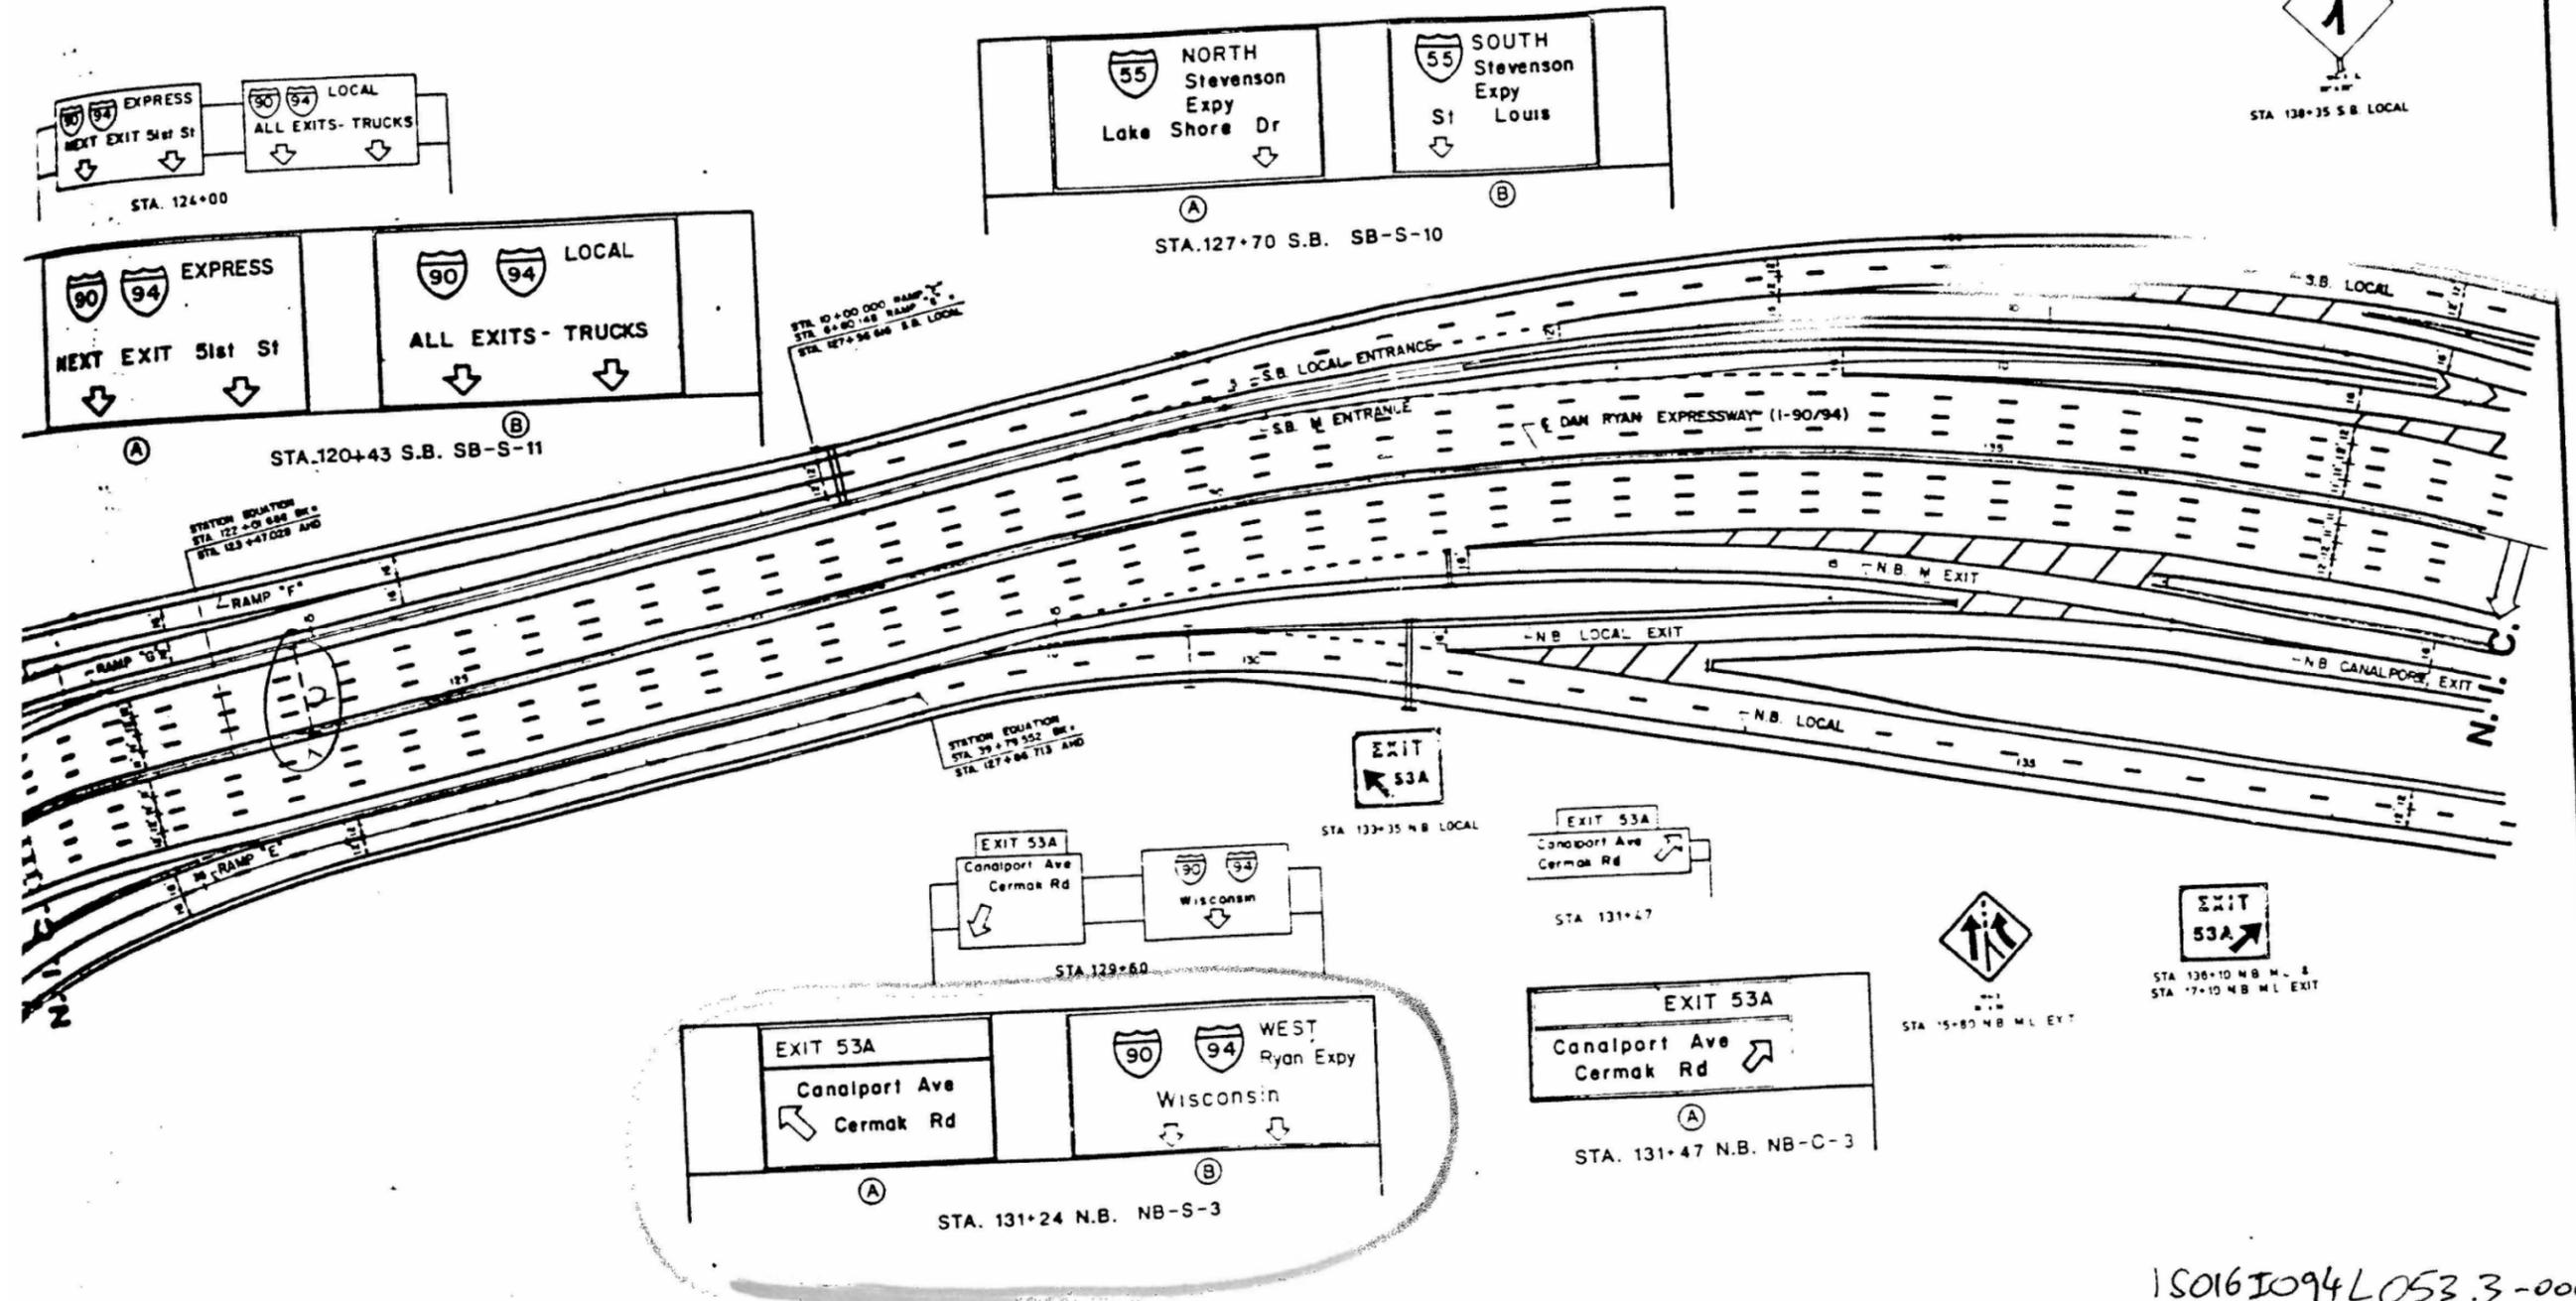

150161094L053.3-000

STATE OF ILLINOIS
DEPARTMENT OF TRANSPORTATION
DAN RYAN EXPRESSWAY I-90/94
SOUTHBOUND MAINLINE RECONSTRUCTION
EXISTING & PROPOSED SIGNING
CONSTRUCTION OF S.B. LANES

Drawn By: _____
Checked By: _____

Scale: _____
Date: _____

11-30-87

FILE NAME: D:\V\AECOM\NA-AWS1\arecomonline\local\AECOM_ID502_NAD\Documents\01_Americas\Transportation\60269938_Circle\Phase_I\0000_CAD\008_Structural\Sign_Structures\62A76-Vierendeel-SS109-SignStruct.dgn




USER NAME =	charles.pigozzi	DESIGNED -	HI, FL	REVISED -	
CHECKED -	MAI, JJS	REVISIONS -		REVISIONS -	
PLOT SCALE =	N.T.S	DRAWN -	HI, FL	REVISIONS -	
PLOT DATE =	1/24/2020	CHECKED -	MAI, JJS	REVISIONS -	

STATE OF ILLINOIS
DEPARTMENT OF TRANSPORTATION

EXISTING RECORD DRAWINGS
VIERENDEEL TRUSS SIGN STRUCTURES

F.A.I. RTE.	SECTION	COUNTY	TOTAL SHEETS	SHEET NO.
90/94/290	2015-019R	COOK	2155	1058
CONTRACT NO. 62A76				
ILLINOIS FED. AID PROJECT				


FOR INFORMATION ONLY

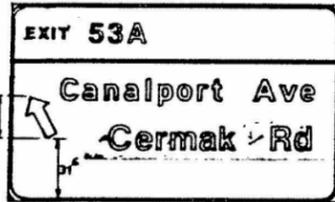

STA. 131+11
NB-5-3-PANEL A

SHIELD STANDARD(S) _____ BORDER WIDTH IS 2.00 INCHES CORNER RADIUS IS 0.0 INCHES
TOTAL WIDTH IS 20.0 FEET
TOTAL HEIGHT IS 10.5 FEET
TOTAL AREA IS 210.00 SQ. FT.
ARROW SIZE(S) _____ BACKGROUND/LEGEND COLOR IS GREEN/WHITE
25 5/8 X 22 1/4 AT 30 FROM VERTICAL (LEFT)

LINE	VERTICAL SPACING	LEGEND HEIGHT	LETTER HEIGHT	LEFT BORDER	WORD 1 WIDTH	HORIZ. SPACING	WORD 2 WIDTH	HORIZ. SPACING	WORD 3 WIDTH	HORIZ. SPACING	WORD 4 WIDTH	HORIZ. SPACING	WORD 5 WIDTH	RIGHT BORDER	LEGEND WIDTH
TOP EDGE															
1	8/4	15/8	15/8-10/8	13/0	32/3	15/0	44/5							325/0	92/0
2	6/4	2/8	0/0-0/0	2/0	266/0									2/0	266/0
3	24/0	16/8	16/8-12/0	13/0	2295	4290	1243	12/0	45/7					13/1	213/7
4	12/0	16/8	16/8-12/0	82/4	83/5	16/0	27/2							34/3	136/7
5	28/0														
6															
7															
8															
BOTTOM EDGE															

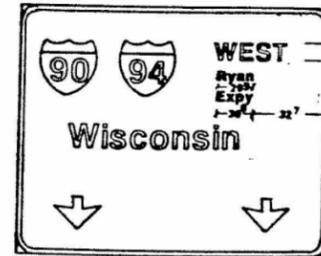

STA. 131+11
NB-5-3-PANEL B

SHIELD STANDARD(S) _____ BORDER WIDTH IS 2.0 INCHES
TOTAL WIDTH IS 14.5 FEET
TOTAL HEIGHT IS 10.5 FEET
TOTAL AREA IS 152.25 SQ. FT.
ARROW SIZE(S) _____ BACKGROUND/LEGEND COLOR IS GREEN/WHITE
32 X 22
32 X 22

LINE	VERTICAL SPACING	LEGEND HEIGHT	LETTER HEIGHT	LEFT BORDER	WORD 1 WIDTH	HORIZ. SPACING	WORD 2 WIDTH	HORIZ. SPACING	WORD 3 WIDTH	HORIZ. SPACING	WORD 4 WIDTH	HORIZ. SPACING	WORD 5 WIDTH	RIGHT BORDER	LEGEND WIDTH
TOP EDGE															
1	14/0	36/8	12/8-0/0	25/1	36/0	12/0	36/0	12/0	47/6					15/1	143/6
2	12/0	16/8	16/8-12/0	25/7	122/2									25/7	122/2
3	12/0	22/0	0/0-0/0	11/0	22/0	88/0	32/0							11/0	152/0
4	14/0														
5															
6															
7															
8															
BOTTOM EDGE															

SECTION	COUNTY	TOTAL SHEETS	SHEET NO.
90/94	COOK	2155	1059

1985-0778-B CORNER RADIUS IS 0.0 INCHES

SHEET C-75 OF C-114

ILLINOIS DEPARTMENT OF TRANSPORTATION
DAN RYAN EXPRESSWAY (F.A.1.90/94)
NORTHBOUND MAINLINE RECONSTRUCTION
SIGN PANEL DETAILS
28TH PL. TO MAXWELL ST
SCALE: VERT: NONE
HORIZ: NONE
DATE: 9/88

KEI KAM ENGINEERING, INC.
707A Davis Road • Egan, Illinois • 60120-1372
CH201931-4211



USER NAME = charles.pigozzi	DESIGNED - HI, FL	REVISED -
PLOT SCALE = N.T.S	CHECKED - MAI, JJS	REVISED -
PLOT DATE = 1/24/2020	DRAWN - HI, FL	REVISED -
	CHECKED - MAI, JJS	REVISED -

STATE OF ILLINOIS
DEPARTMENT OF TRANSPORTATION

EXISTING RECORD DRAWINGS
VIERENDEEL TRUSS SIGN STRUCTURES


F.A.I. RTE.	SECTION	COUNTY	TOTAL SHEETS	SHEET NO.
90/94/290	2015-019R	COOK	2155	1059
CONTRACT NO. 62A76				

SHEET NO. SS109 OF SS129 SHEETS

ILLINOIS FED. AID PROJECT

FILE NAME: D:\V\AECOM\NA-AW51\acconline\local\AECOM_DS02_NAVDocuments\01_Americas\Transportation\60269938_Circle\Phase_I\0000_CAD\008_Structural\Sign_Structure\62A76_Verendeeel-SS110-SignStruct.dgn

FOR INFORMATION ONLY

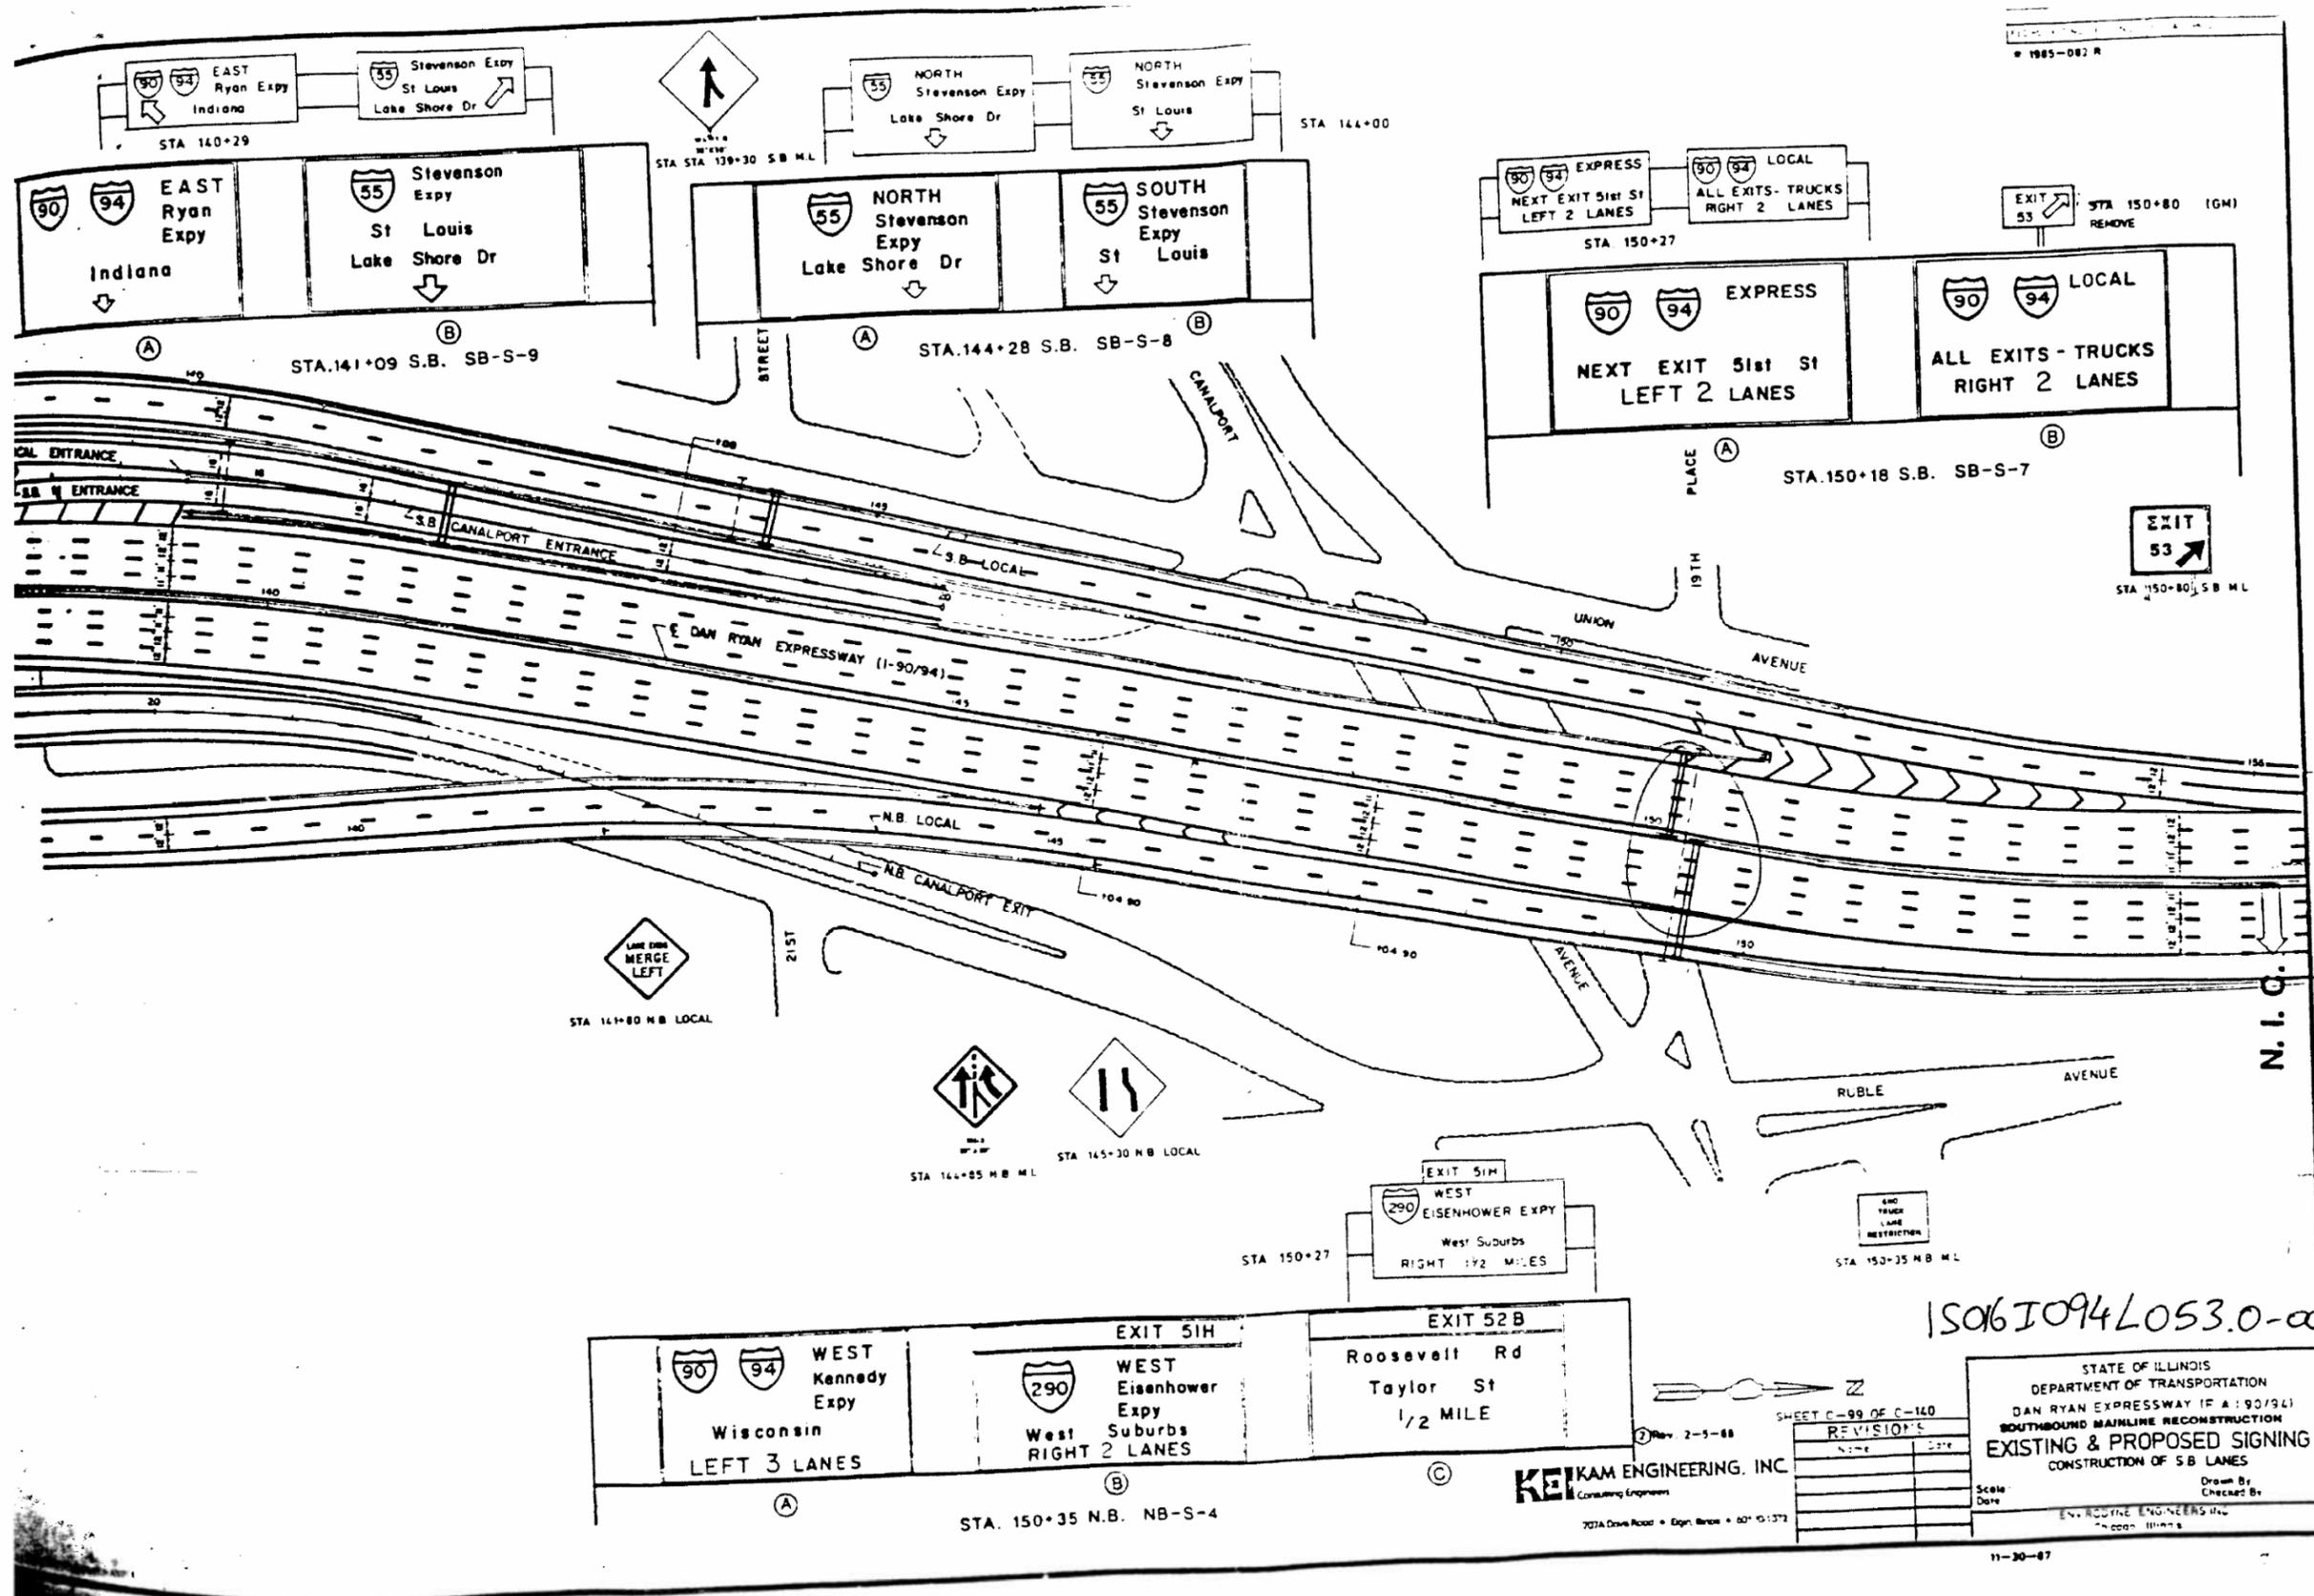

15061094L053.0-000

STATE OF ILLINOIS
DEPARTMENT OF TRANSPORTATION
DAN RYAN EXPRESSWAY (I-90/94)
SOUTHBOUND MAINLINE RECONSTRUCTION
EXISTING & PROPOSED SIGNING
CONSTRUCTION OF S.B. LANES

Scale: _____
Date: _____

Drawn By: _____
Checked By: _____

EN ROUTE ENGINEERS INC.
Chicago, Illinois

KEIKAM ENGINEERING, INC.
Consulting Engineers
707A Davis Road • Eagan, MN • 65121-1373

FILE NAME: D:\VAECOM\NA\AW51\recomonline\local\VAECOM_DS02_NAD\Documents\01_Americas\Transportation\60269938_Circle\Phase_CAD\008_Structural\Sign_Structure\62A76-Vierendeel-SS110A-SignStruct.dgn



USER NAME =	charles.pigozzi	DESIGNED -	HI, FL	REVISED -	
		CHECKED -	MAI, JJS	REVISED -	
PLOT SCALE =	N.T.S	DRAWN -	HI, FL	REVISED -	
PLOT DATE =	1/24/2020	CHECKED -	MAI, JJS	REVISED -	

STATE OF ILLINOIS
DEPARTMENT OF TRANSPORTATION

EXISTING RECORD DRAWINGS
VIERENDEEL TRUSS SIGN STRUCTURES

F.A.I. RTE.	SECTION	COUNTY	TOTAL SHEETS	SHEET NO.
90/94/290	2015-019R	COOK	2155	1060
CONTRACT NO. 62A76				
ILLINOIS FED. AID PROJECT				

FOR INFORMATION ONLY

EXIT 53A
Canalport Ave
Cermak Rd

STA. 131+47
 NB-C-4-PANEL A

SHIELD STANDARD(S) _____ BORDER WIDTH IS 2.00 INCHES CORNER RADIUS IS 9.0 INCHES

ARROW SIZE(S) _____

TOTAL WIDTH IS 22.5 FEET
 TOTAL HEIGHT IS 8.5 FEET
 TOTAL AREA IS 191.25 SQ. FT.

BACKGROUND/LEGEND COLOR IS GREEN/WHITE

35 5/8 X 22 1/4

LINE	VERTICAL SPACING	LEGEND HEIGHT	LETTER HEIGHT	LEFT BORDER	WORD 1 WIDTH	HORIZ. SPACING	WORD 2 WIDTH	HORIZ. SPACING	WORD 3 WIDTH	HORIZ. SPACING	WORD 4 WIDTH	HORIZ. SPACING	WORD 5 WIDTH	RIGHT BORDER	LEGEND WIDTH
TOP EDGE															
1	8 1/4	15/0	15/0-10/0	160/5	32/3	15/0	44/5							17/3	92/0
2	6 1/4	2/0	0/0-0/0	2/0	286/0									2/0	266/0
3	12/0	16/0	16/0-12/0	17/4	121/3	24/0	45/7	15/0	27/7					17/3	234/1
4	12/0	16/0	16/0-12/0	10/4	83/5	24/0	27/2							84/5	144/7
5	14/0														
6															
7															
8															
BOTTOM EDGE															

EXIT 51H
West Suburbs
RIGHT 2 LANES

STA. 150+70
 NB-S-4-PANEL B

SHIELD STANDARD(S) _____ BORDER WIDTH IS 2.00 INCHES CORNER RADIUS IS 9.0 INCHES

ARROW SIZE(S) _____

TOTAL WIDTH IS 18.0 FEET
 TOTAL HEIGHT IS 13.0 FEET
 TOTAL AREA IS 234.00 SQ. FT.

BACKGROUND/LEGEND COLOR IS GREEN/WHITE

LINE	VERTICAL SPACING	LEGEND HEIGHT	LETTER HEIGHT	LEFT BORDER	WORD 1 WIDTH	HORIZ. SPACING	WORD 2 WIDTH	HORIZ. SPACING	WORD 3 WIDTH	HORIZ. SPACING	WORD 4 WIDTH	HORIZ. SPACING	WORD 5 WIDTH	RIGHT BORDER	LEGEND WIDTH
TOP EDGE															
1	8 1/4	15/0	15/0-10/0	102/4	32/3	15/0	39/3							16/6	86/6
2	6 1/4	2/0	0/0-0/0	2/0	212/0									2/0	212/0
3	11 1/8	36/0	12/0-0/0	40/7	45/0	18/0	47/6							64/3	110/6
4	13/0	16/0	16/0-12/0	17/4	55/5	24/0	102/0							16/7	181/5
5	13/6	18/0	18/0-12/0	25/6	55/2	18/0	13/7	18/0	60/5					24/4	165/6
6	15/5														
7															
8															
BOTTOM EDGE															

EXIT 52B
Roosevelt Rd
Taylor St
1/2 MILE

STA. 150+70
 NB-S-4-PANEL C

SHIELD STANDARD(S) _____ BORDER WIDTH IS 2.00 INCHES CORNER RADIUS IS 9.0 INCHES

ARROW SIZE(S) _____

TOTAL WIDTH IS 16.0 FEET
 TOTAL HEIGHT IS 13.0 FEET
 TOTAL AREA IS 208.00 SQ. FT.

BACKGROUND/LEGEND COLOR IS GREEN/WHITE

LINE	VERTICAL SPACING	LEGEND HEIGHT	LETTER HEIGHT	LEFT BORDER	WORD 1 WIDTH	HORIZ. SPACING	WORD 2 WIDTH	HORIZ. SPACING	WORD 3 WIDTH	HORIZ. SPACING	WORD 4 WIDTH	HORIZ. SPACING	WORD 5 WIDTH	RIGHT BORDER	LEGEND WIDTH
TOP EDGE															
1	24/7	36/0	12/0-0/0	15/6	36/0	18/0	36/0	18/0	47/6					15/6	155/6
2	22/6	18/0	16/0-12/0	34/5	122/2									35/1	122/2
3	22/6	18/0	18/0-15/0-12/0	13/0	55/4	18/0	13/7	18/0	60/5					13/0	186/0
4	15/5														
5															
6															
7															
8															
BOTTOM EDGE															

EXIT 52B
Roosevelt Rd
Taylor St
1/2 MILE

STA. 150+70
 NB-S-4-PANEL C

SHIELD STANDARD(S) _____ BORDER WIDTH IS 2.00 INCHES CORNER RADIUS IS 9.0 INCHES

ARROW SIZE(S) _____

TOTAL WIDTH IS 17.0 FEET
 TOTAL HEIGHT IS 13.0 FEET
 TOTAL AREA IS 221.00 SQ. FT.

BACKGROUND/LEGEND COLOR IS GREEN/WHITE

LINE	VERTICAL SPACING	LEGEND HEIGHT	LETTER HEIGHT	LEFT BORDER	WORD 1 WIDTH	HORIZ. SPACING	WORD 2 WIDTH	HORIZ. SPACING	WORD 3 WIDTH	HORIZ. SPACING	WORD 4 WIDTH	HORIZ. SPACING	WORD 5 WIDTH	RIGHT BORDER	LEGEND WIDTH
TOP EDGE															
1	8 1/4	15/0	15/0-10/0	97/3	32/3	15/0	42/5							16/5	90/0
2	6 1/4	2/0	0/0-0/0	2/0	200/0									2/0	200/0
3	20/4	16/0	16/0-12/0	17/6	118/2	24/0	27/2							16/6	169/4
4	20/4	16/0	16/0-12/0	38/5	79/0	24/0	23/7							30/4	126/7
5	20/3	16/0	16/0-12/0	38/5	79/0	24/0	23/7							30/4	126/7
6	15/5	15/0	10/0-0/0	68/3	20/0	15/0	36/2							66/3	91/2
7															
8															
BOTTOM EDGE															

SHEET C-76 OF C-104

ILLINOIS DEPARTMENT OF TRANSPORTATION

DAN RYAN EXPRESSWAY (I.A. 190/94)
 NORTHBOUND MAINLINE RECONSTRUCTION

SIGN PANEL DETAILS
 28TH PL. TO MAXWELL ST

SCALE: VERT: NONE
 HORIZ: NONE
 DATE: 9/08

KEI KAM ENGINEERING, INC.
 707A Davis Road • Egan, Illinois • 60120-1372
 (312) 931-4211

FILE NAME: D:\V\AE\COM-NA-AW51\ae\comonline\local\AE\COM_D502_NAV\Documents\01_Americas\Transportation\60269938_Circle\Phase_II\000_CAD\008_Structural\Sign_Structures\62A76_Verendeeel-SS110B-SignStruct.dgn



USER NAME =	charles.pigozzi	DESIGNED -	HI, FL	REVISED -	
PLOT SCALE =	N.T.S	CHECKED -	MAI, JJS	REVISED -	
PLOT DATE =	1/24/2020	DRAWN -	HI, FL	REVISED -	
		CHECKED -	MAI, JJS	REVISED -	


STATE OF ILLINOIS
 DEPARTMENT OF TRANSPORTATION

EXISTING RECORD DRAWINGS
 VIERENDEEL TRUSS SIGN STRUCTURES

F.A.I. RTE.	SECTION	COUNTY	TOTAL SHEETS	SHEET NO.
90/94/290	2015-019R	COOK	2155	1061
CONTRACT NO. 62A76				
SHEET NO. SS111 OF SS129 SHEETS		ILLINOIS FED. AID PROJECT		

FOR INFORMATION ONLY

SECTION	COUNTY	SHEET NO.
90/94	COOK	154
STA	TO STA	
FED RD DIST NO	ILLINOIS	FED AID PROJECT
1005-02 R		

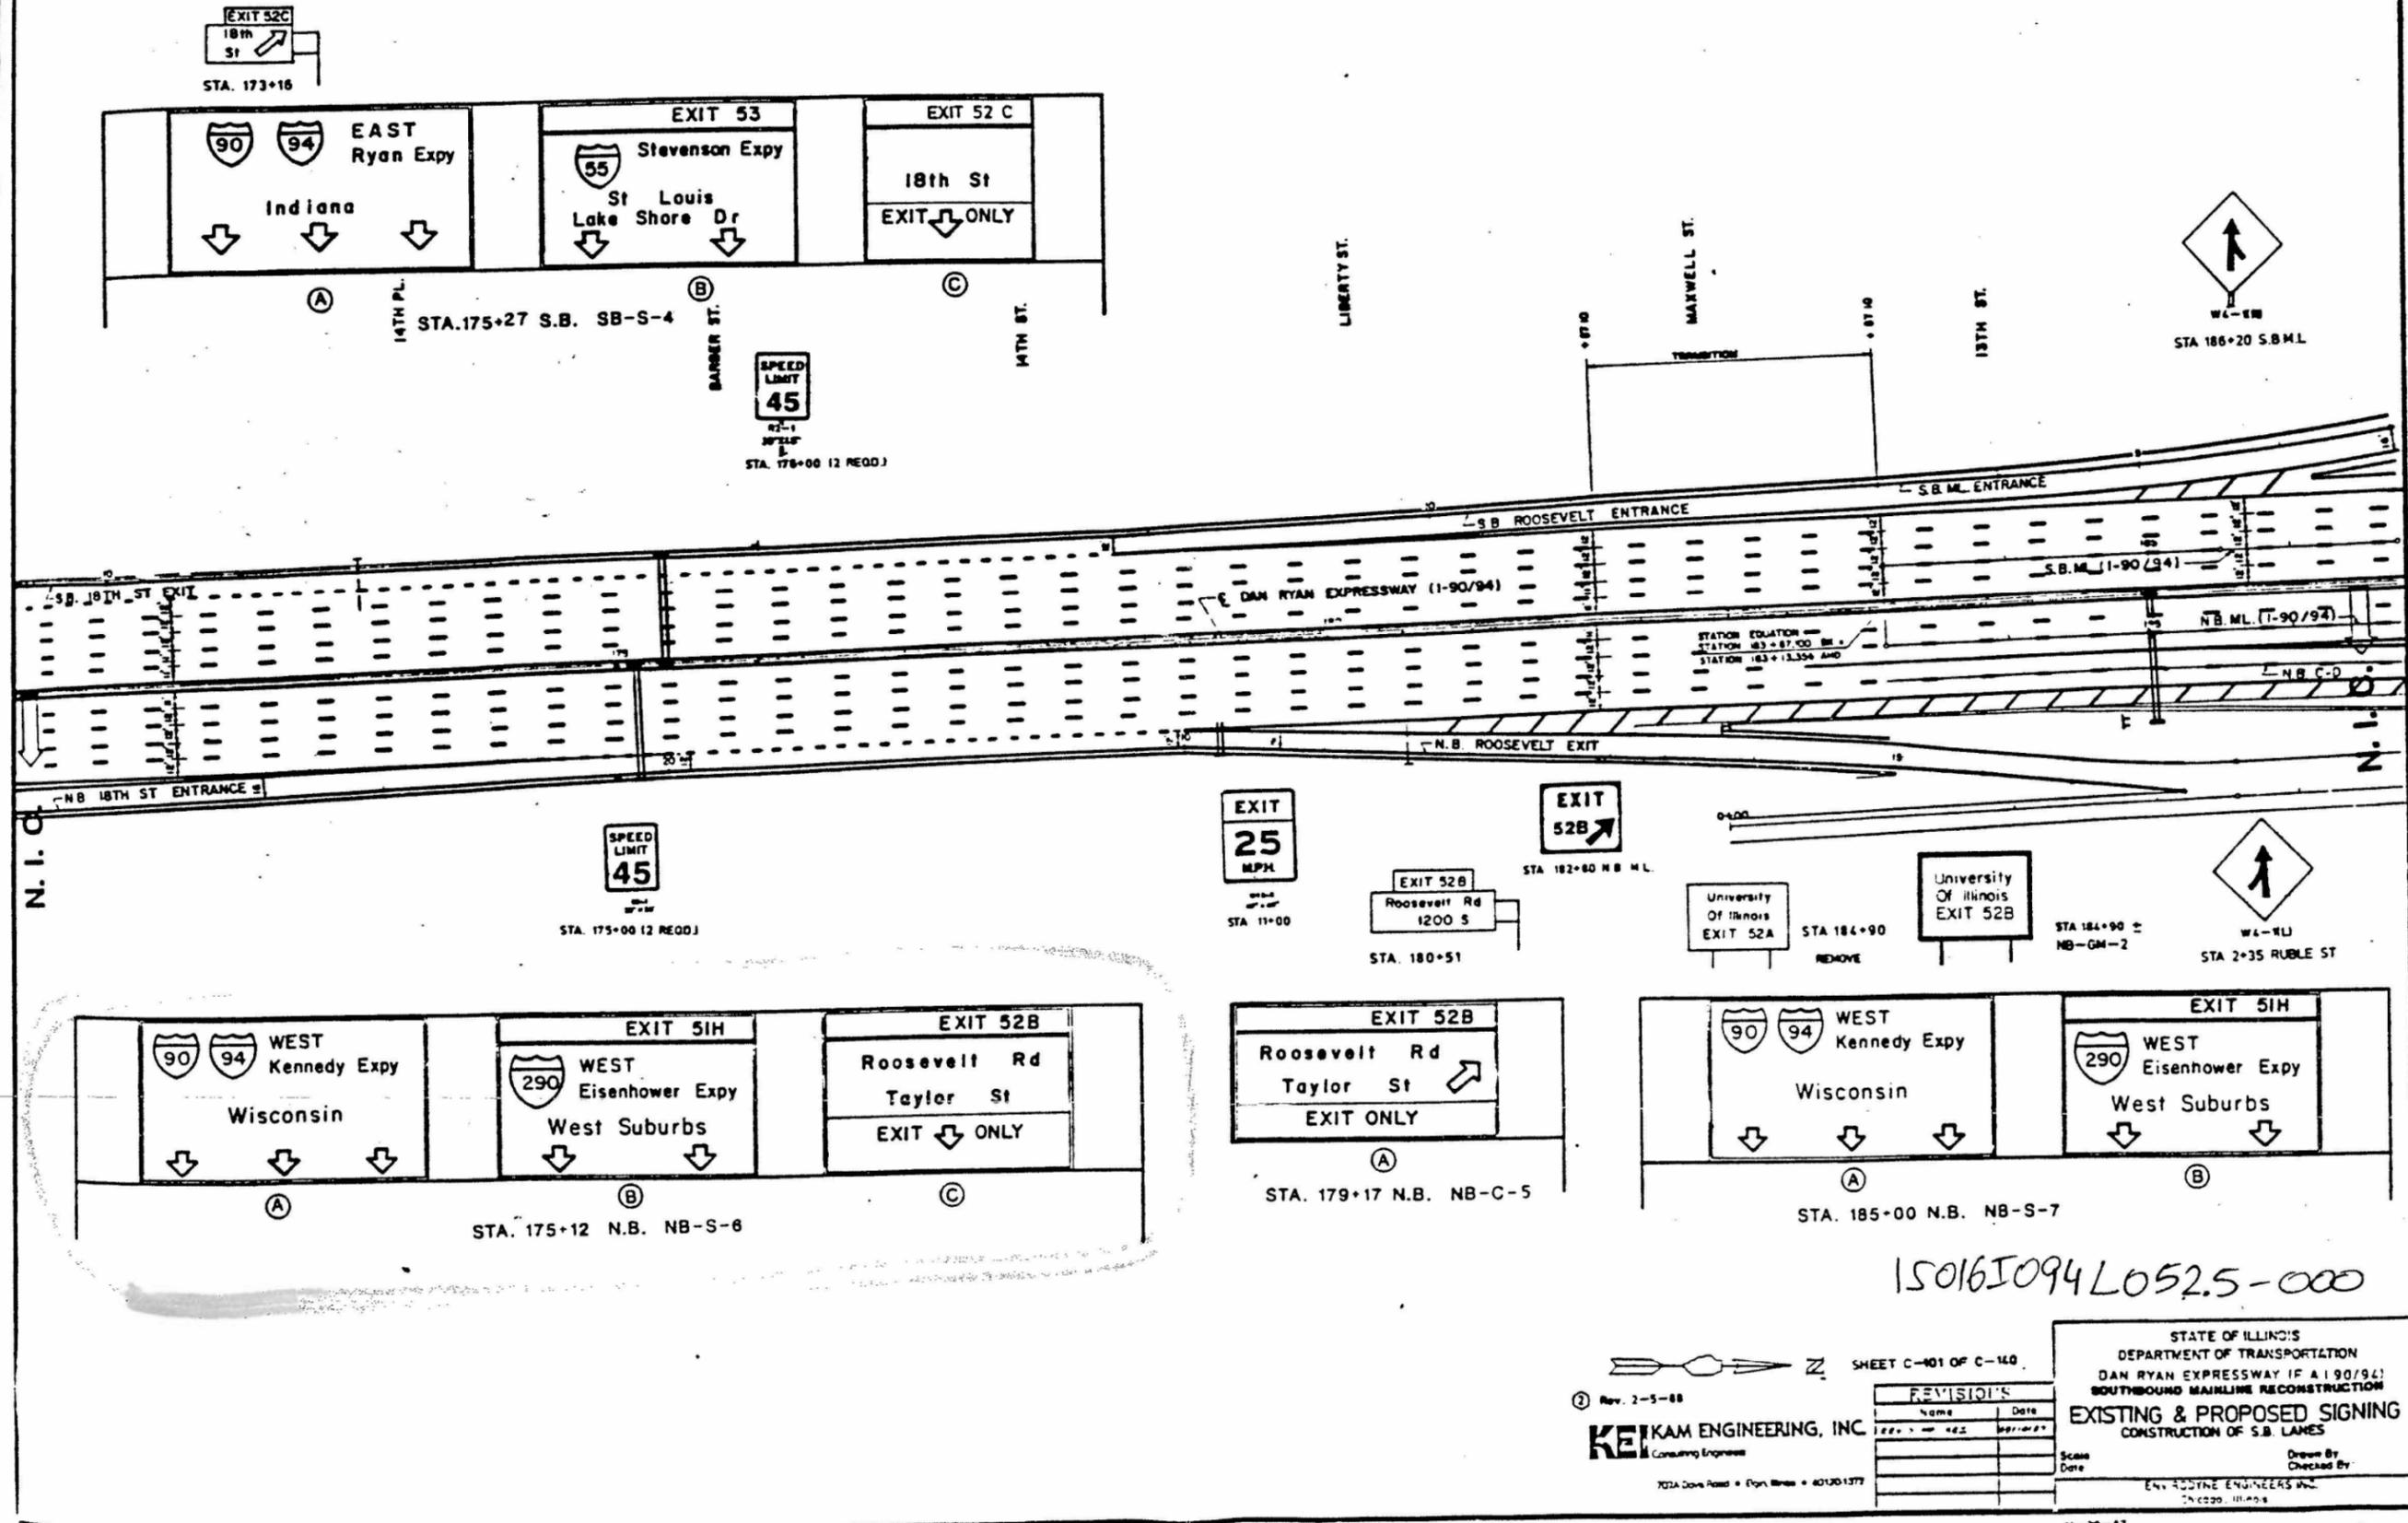

15016I094L052.5-000

STATE OF ILLINOIS
DEPARTMENT OF TRANSPORTATION
DAN RYAN EXPRESSWAY (I-90/94)
SOUTHBOUND MAINLINE RECONSTRUCTION
EXISTING & PROPOSED SIGNING
CONSTRUCTION OF S.B. LANES

REVISIONS

No.	Name	Date
1	MAI	10/1/20

KEIKAM ENGINEERING, INC.
CONSULTING ENGINEERS
702A Dove Road • Elgin, Illinois • 815.320.1377

Drawn By: [Blank]
Checked By: [Blank]
Scale: [Blank]
Date: [Blank]

11-30-87

FILE NAME: D:\V\AECOM\NA-AW51\arecomonline-local\AECOM_ID502_NAVDocuments\01_Americas\Transportation\60269938_Circle\Phase_I\0000_CAD\008_Structural\Sign_Structures\62A76_Sign_Structure\62A76-Vierendeel-SS111-1-SignStruct.dgn



USER NAME =	charles.pigozzi	DESIGNED -	HI, FL	REVISED -	
PLOT SCALE =	N.T.S	CHECKED -	MAI, JJS	REVISED -	
PLOT DATE =	1/24/2020	DRAWN -	HI, FL	REVISED -	
		CHECKED -	MAI, JJS	REVISED -	

STATE OF ILLINOIS
DEPARTMENT OF TRANSPORTATION

EXISTING RECORD DRAWINGS
VIRENDEEL TRUSS SIGN STRUCTURES


F.A.I. RTE.	SECTION	COUNTY	TOTAL SHEETS	SHEET NO.
90/94/290	2015-019R	COOK	2155	1062
CONTRACT NO. 62A76				

SHEET NO. SS112 OF SS129 SHEETS

ILLINOIS FED. AID PROJECT

FOR INFORMATION ONLY

SECTION	COUNTY	TOTAL SHEETS	SHEET NO.
90/94	COOK	127	87
STA TO STA		FED. AID PROJECT	
* I-55 - 077B - R		FED. AID PROJECT	

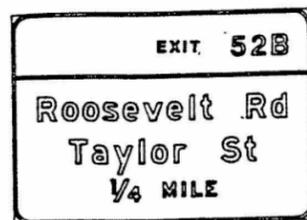


STA. 165+00
NB-S-5-PANEL C

SHIELD STANDARD(S) _____ BORDER WIDTH IS 2.00 INCHES CORNER RADIUS IS 9.0 INCHES

TOTAL WIDTH IS 17.0 FEET
TOTAL HEIGHT IS 13.0 FEET
TOTAL AREA IS 221.00 SQ. FT.

ARROW SIZE(S) _____ BACKGROUND/LEGEND COLOR IS GREEN/WHITE

LINE	VERTICAL SPACING	LEGEND HEIGHT	LETTER HEIGHT	LEFT BORDER	WORD 1 WIDTH	HORIZ. SPACING	WORD 2 WIDTH	HORIZ. SPACING	WORD 3 WIDTH	HORIZ. SPACING	WORD 4 WIDTH	HORIZ. SPACING	WORD 5 WIDTH	RIGHT BORDER	LEGEND WIDTH
TOP EDGE															
1	8/4	15/0	15/0-10/0	97/3	32/3	15/0	42/5							16/5	90/0
2	6/4	2/0	0/0-0/0	2/0	200/0									2/0	200/0
3	18/6	16/0	16/0-12/0	17/6	118/2	24/0	27/2							16/5	168/4
4	18/6	16/0	16/0-12/0	38/6	78/0	24/0	23/7							38/4	126/7
5	18/6	15/0	10/0-0/0	64/5	20/1	15/0	36/2							65/8	71/3
6	20/6														
7															
8															
BOTTOM EDGE															

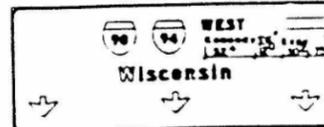


STA. 175+17
NB-S-6-PANEL A

SHIELD STANDARD(S) _____ BORDER WIDTH IS 2.00 INCHES CORNER RADIUS IS 12.0 INCHES

TOTAL WIDTH IS 29.5 FEET
TOTAL HEIGHT IS 13.0 FEET
TOTAL AREA IS 383.50 SQ. FT.

ARROW SIZE(S) _____ BACKGROUND/LEGEND COLOR IS GREEN/WHITE

LINE	VERTICAL SPACING	LEGEND HEIGHT	LETTER HEIGHT	LEFT BORDER	WORD 1 WIDTH	HORIZ. SPACING	WORD 2 WIDTH	HORIZ. SPACING	WORD 3 WIDTH	HORIZ. SPACING	WORD 4 WIDTH	HORIZ. SPACING	WORD 5 WIDTH	RIGHT BORDER	LEGEND WIDTH
TOP EDGE															
1	24/0	36/0	12/0-0/0	75/5	36/0	18/0	36/0	18/0	47/6					122/5	155/6
2	22/0	16/0	16/0-12/0	115/4	122/2									116/1	122/2
3	22/0	22/0	0/0-0/0	17/0	32/0	112/0	32/0	112/0	32/0					17/0	320/0
4	14/0														
5															
6															
7															
8															
BOTTOM EDGE															

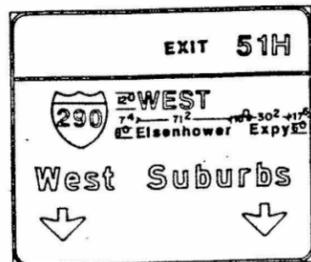


STA. 175+17
NB-S-6-PANEL B

SHIELD STANDARD(S) _____ BORDER WIDTH IS 2.00 INCHES CORNER RADIUS IS 9.0 INCHES

TOTAL WIDTH IS 17.0 FEET
TOTAL HEIGHT IS 13.0 FEET
TOTAL AREA IS 221.00 SQ. FT.

ARROW SIZE(S) _____ BACKGROUND/LEGEND COLOR IS GREEN/WHITE

LINE	VERTICAL SPACING	LEGEND HEIGHT	LETTER HEIGHT	LEFT BORDER	WORD 1 WIDTH	HORIZ. SPACING	WORD 2 WIDTH	HORIZ. SPACING	WORD 3 WIDTH	HORIZ. SPACING	WORD 4 WIDTH	HORIZ. SPACING	WORD 5 WIDTH	RIGHT BORDER	LEGEND WIDTH
TOP EDGE															
1	8/4	15/0	15/0-10/0	102/1	32/3	15/0	39/3							15/1	86/6
2	6/4	2/0	0/0-0/0	2/0	200/0									2/0	200/0
3	12/0	36/0	12/0-0/0	17/6	45/0	12/0	47/6							81/4	104/6
4	12/0	16/0	16/0-12/0	15/2	55/5	16/0	102/0							15/1	173/5
5	12/0	16/0	16/0-12/0	15/2	55/5	16/0	102/0							14/0	176/0
6	14/0	22/0	0/0-0/0	14/0	32/0	112/0	32/0								
7															
8															
BOTTOM EDGE															

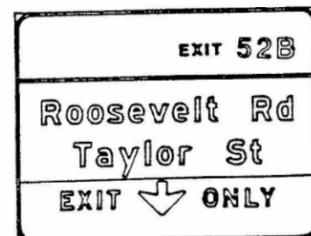

STA. 175+17
NB-S-6-PANEL C

SHIELD STANDARD(S) _____ BORDER WIDTH IS 2.00 INCHES CORNER RADIUS IS 9.0 INCHES

TOTAL WIDTH IS 16.0 FEET
TOTAL HEIGHT IS 13.0 FEET
TOTAL AREA IS 208.00 SQ. FT.

ARROW SIZE(S) _____ BACKGROUND/LEGEND COLOR IS GREEN/WHITE TOP 10.00 FEET YELLOW/BLACK BOTTOM 3.0 FEET

LINE	VERTICAL SPACING	LEGEND HEIGHT	LETTER HEIGHT	LEFT BORDER	WORD 1 WIDTH	HORIZ. SPACING	WORD 2 WIDTH	HORIZ. SPACING	WORD 3 WIDTH	HORIZ. SPACING	WORD 4 WIDTH	HORIZ. SPACING	WORD 5 WIDTH	RIGHT BORDER	LEGEND WIDTH
TOP EDGE															
1	8/4	15/0	15/0-10/0	86/6	32/3	15/0	42/5							15/2	86/6
2	6/4	2/0	0/0-0/0	2/0	188/0									2/0	188/0
3	21/0	16/0	16/0-12/0	15/2	118/2	16/0	27/2							15/2	161/4
4	21/0	16/0	16/0-12/0	36/5	78/0	16/0	23/7							36/4	118/7
5	20/0	16/0	16/0-12/0	36/5	78/0	16/0	23/7							23/5	144/6
6	8/0	22/0	12/0-0/0	23/6	38/3	12/0	32/0	12/0	48/2						
7															
8															
BOTTOM EDGE															

SHEET C-78 OF C-104

ILLINOIS DEPARTMENT OF TRANSPORTATION
DAN RYAN EXPRESSWAY (I-55) 190/941
NORTHBOUND MAINLINE RECONSTRUCTION

SIGN PANEL DETAILS
28TH PI TO MAXWELL ST

SCALE: VERT. = NONE
HORIZ. = NONE
DATE: 9/88

FILE NAME: D:\V\AE\COM-NA-AW51\ae\comonline\local\AE\COM_ID502_NAVDocuments\01_Americas\Transportation\60269938_Circle\Phase_I\1000_CAD\008_Structural\Sign_Structures\62A76_Verendeeel-SS112-SignStruct.dgn



USER NAME = charles.pigozzi	DESIGNED - HI, FL	REVISED -
CHECKED - MAI, JJS	REVISIONS -	
PLOT SCALE = N.T.S	DRAWN - HI, FL	REVISED -
PLOT DATE = 1/24/2020	CHECKED - MAI, JJS	REVISED -

STATE OF ILLINOIS
DEPARTMENT OF TRANSPORTATION

EXISTING RECORD DRAWINGS
VIERENDEEL TRUSS SIGN STRUCTURES

F.A.I. RTE. 90/94/290	SECTION 2015-019R	COUNTY COOK	TOTAL SHEETS 2155	SHEET NO. 1063
CONTRACT NO. 62A76			ILLINOIS FED. AID PROJECT	

SHEET NO. SS113 OF SS129 SHEETS

FOR INFORMATION ONLY

DEPARTMENT OF TRANSPORTATION

DATE	NO.	BY	CHKD.	APPD.	SHEET NO.
9/07/94	1	COOK	117	105	1

GENERAL NOTES

SPECIFICATIONS:

DESIGN: AASHTO Standard Specifications for Structural Supports for Highway Signs, Luminaires and Traffic Signals, dated January, 1985

CONSTRUCTION: Standard Specifications for Road and Bridge Construction, State of Illinois, (dated October 1, 1983), Supplemental Specifications for Road and Bridge Construction, Standard Specifications for Traffic Control Items (dated Feb. 1, 1984) and Special Provisions.

MINIMUM CLEARANCE: Vertical Roadway Clearance = 17'-3" (All Obstructions)

LOADING: 80 MPH WIND VELOCITY PLUS 30% GUST FACTOR
WIND LOADING: 35 psf normal to Sign Panel Area as shown below in Wind Loading Diagram plus 48 psf normal to exposed frame members.

WALKWAY LOADING: Dead Load plus 500# concentrated Live Load

MATERIALS:

REINFORCEMENT BARS shall conform to the requirements of AASHTO M31 or M53, Grade 60.

CLASS X CONCRETE shall be used throughout.

STRUCTURAL STEEL: All material for structural chords, verticals, or chord splices shall conform to either ASTM A500, Grade C, AASHTO M222 or AASHTO M223, Grade 50 and shall meet the longitudinal CVN requirements of 15 ft lbs. at 40° F.

Posts shall conform to AASHTO M222 or M223, Grade 50, and shall meet the longitudinal CVN requirements of 15 ft lbs. at 40° F.

HIGH STRENGTH BOLTS shall conform to the requirements of AASHTO M154.

STRUCTURAL SHAPES and PLATES shall conform to the requirements of AASHTO M223, Grade 50, or M222, unless otherwise specified.


PAINTING: The zinc-silicate and vinyl paint system shall be used for shop and field painting of all structural steel. Exterior surfaces of all structural steel that are painted with the high-build vinyl paint shall receive one coat of vinyl enamel. Paint system, including field coat, for the walkway gratings may be done in the shop or just prior to erection. Chords and verticals will require painting on exterior surfaces only.

WELDING: All welding shall be in accordance with Article 507.04(s) of the Standard Specifications for Road and Bridge Construction.


NOTE: CONTRACTOR SHALL VERIFY DIMENSIONS PRIOR TO ORDERING ANY MATERIAL OR HARDWARE, OR REWORKING EXISTING ITEMS.

TOTAL BILL of MATERIAL

OVERHEAD SIGN STRUCTURE_SPAN (SPECIAL)	Lin Ft	583'-10"
OVERHEAD SIGN STRUCTURE WALKWAY_TYPE S	Lin Ft	453'-1"
DRILLED SHAFT CONCRETE FOUNDATIONS	Cu Yds	0

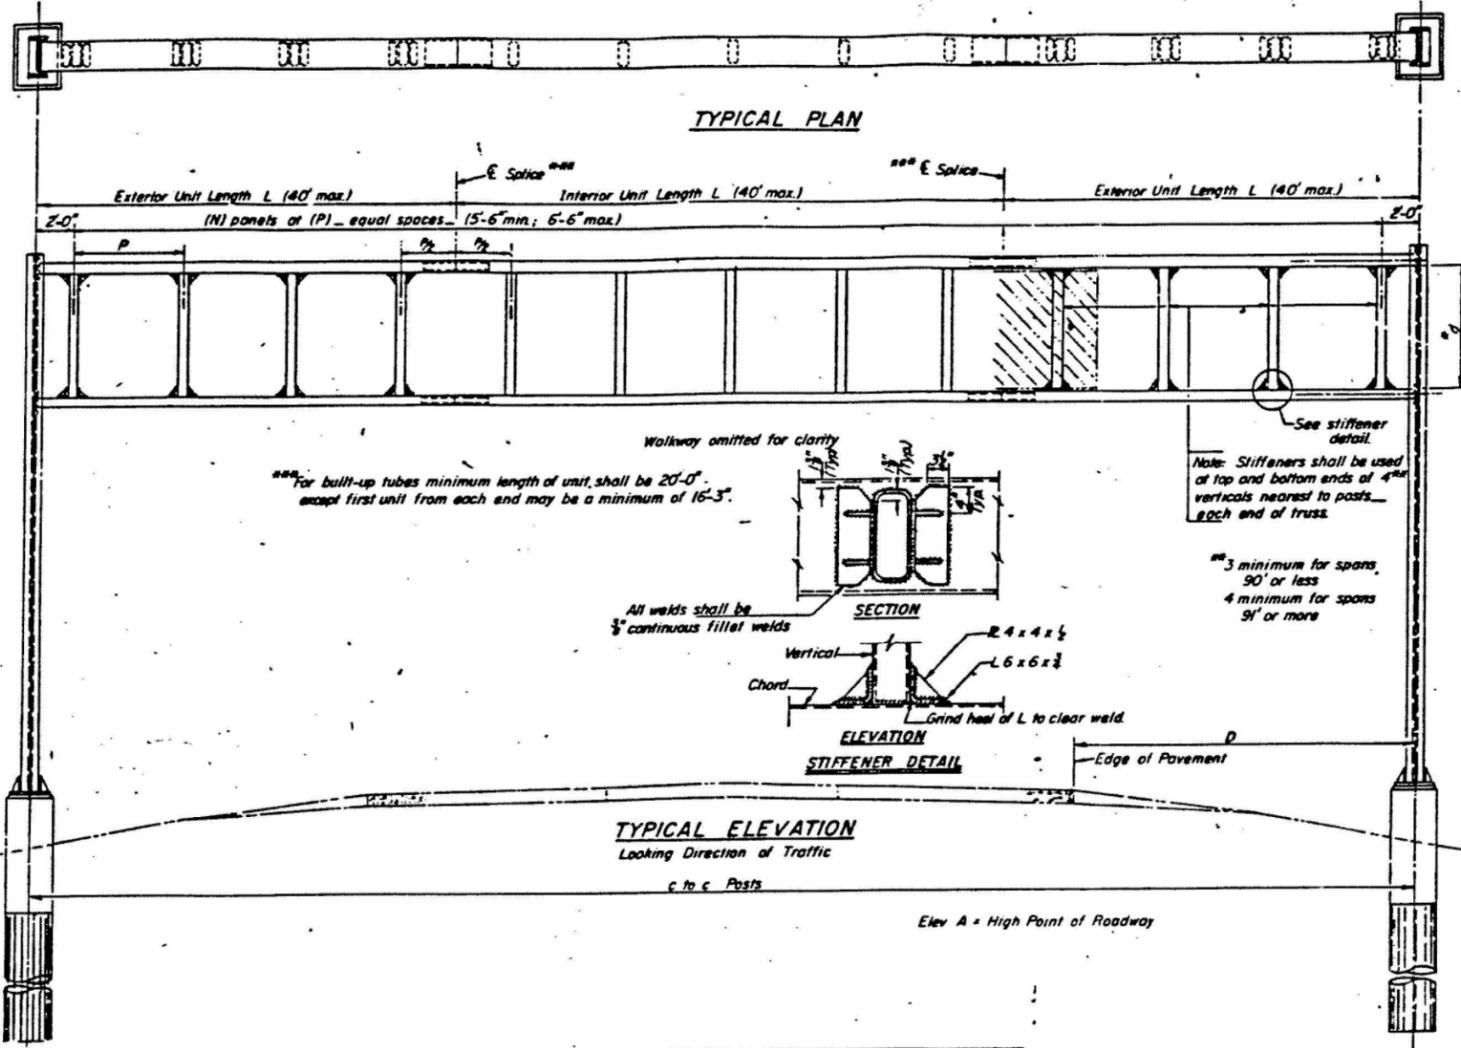

Structure No.	Station	c to c Posts	Elev A	Dim. D
NB-S-1	76+40	N.I.C.	70.1	18'-0"
NB-S-2	100+50	88'-9 1/2"	62.74	5'-2"
NB-S-3	131+11	52'-17 1/2"	58.46	8'-2"
NB-S-4	150+70	83'-3 1/4"	40.24	8'-2"
NB-S-5	165+00	93'-7 1/2"	55.12	5'-2"
NB-S-6	175+17	80'-7 1/2"	46.35	6'-9 1/2"
NB-S-7	185+00	98'-8"	14.54	16'-0"
NB-S-8	12+17	60'-0"	11.85	15'-0"
NB-S-9	212+18	48'-9"	4.33	8'-0"
EB-S-2	12+00 RAMP 'D'	48'-0"		8'-0"
EB-S-3	32+82 RAMP 'E'	49'-4 1/2"	55.33	7'-9"
CMS-10	124+62	90'-11"	70.65	6'-2"
NB-S-10	93+88	88'-9 1/2"	53.81	5'-2"

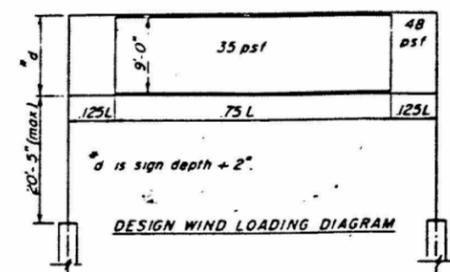

DESIGNED	EXAMINED	19
CHECKED	PASSED	
DRAWN	APPROVED	
CHECKED		

OS-S-1 SPECIAL

SHEET C-86 OF C-164

**OVERHEAD SIGN STRUCTURES
GENERAL PLAN & ELEVATION**

DAN RYAN EXPRESSWAY (I.A. 190/94)
NORTHBOUND MAINLINE RECONSTRUCTION
28TH PL. TO MAXWELL ST

Scale: none
Date: 9/88

FILE NAME: D:\V\AECOM\NA-AW51\recomonline\local\AECOM_DS02_NAD\Documents\01_Americas\Transportation\60269938_Circle\Phase_I\0000_CAD\008_Structural\Sign_Structures\62A76_Sign_Structure\62A76_Verendeeel-SS113-SignStruct.dgn



USER NAME = charles.pigozzi	DESIGNED - HI, FL	REVISED -
PLOT SCALE = N.T.S	CHECKED - MAI, JJS	REVISED -
PLOT DATE = 1/24/2020	DRAWN - HI, FL	REVISED -
	CHECKED - MAI, JJS	REVISED -

STATE OF ILLINOIS
DEPARTMENT OF TRANSPORTATION

EXISTING RECORD DRAWINGS
VIERENDEEL TRUSS SIGN STRUCTURES

F.A.I. RTE.	SECTION	COUNTY	TOTAL SHEETS	SHEET NO.
90/94/290	2015-019R	COOK	2155	1064
			CONTRACT NO. 62A76	



SHEET NO. SS114 OF SS129 SHEETS

ILLINOIS FED. AID PROJECT









FOR INFORMATION ONLY

STATE OF ILLINOIS
DEPARTMENT OF TRANSPORTATION

DATE	BY	CHKD	APP'D	SHEET NO.
9/94	COOK	127	106	

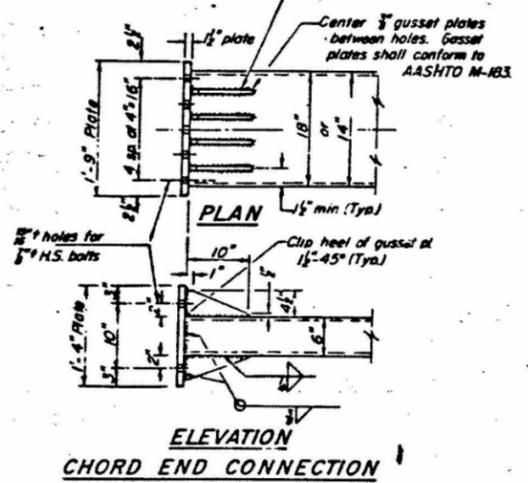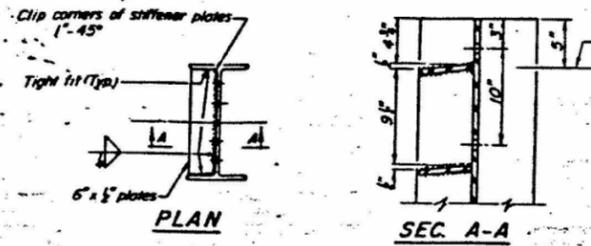

Span	Camber at Centerline	Chord	Vertical	Post	c-c Chords
0 to 70'	4"	TS14x6x3/8	TS10x6x3/8	W24x104	"d+6"
71 to 80'	4"	TS14x6x3/8	TS10x6x3/8	W24x104	"d+6"
81 to 90'	6"	TS18x6x3/8	TS14x6x3/8	W24x104	"d+6"
91 to 100'	6"	TS18x6x3/8	TS14x6x3/8	W24x104	"d+6"
101 to 110'	6"	TS18x6x3/8	TS14x6x3/8	W24x104	"d+6"
111 to 124'	6"	TS18x6x3/8	TS14x6x3/8	W24x104	"d+6"

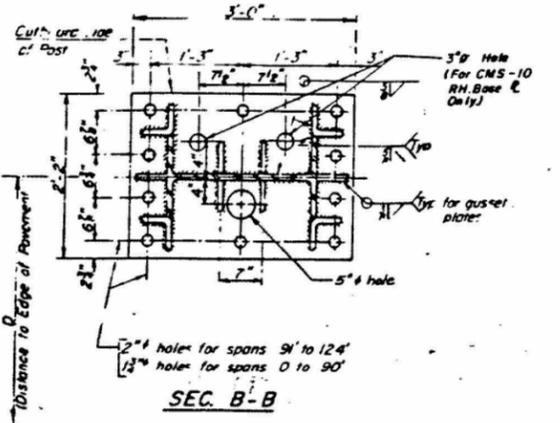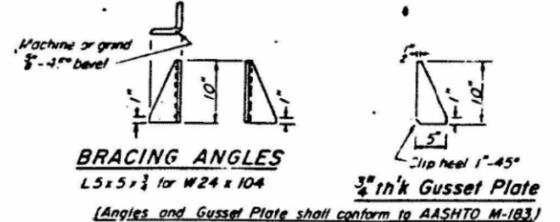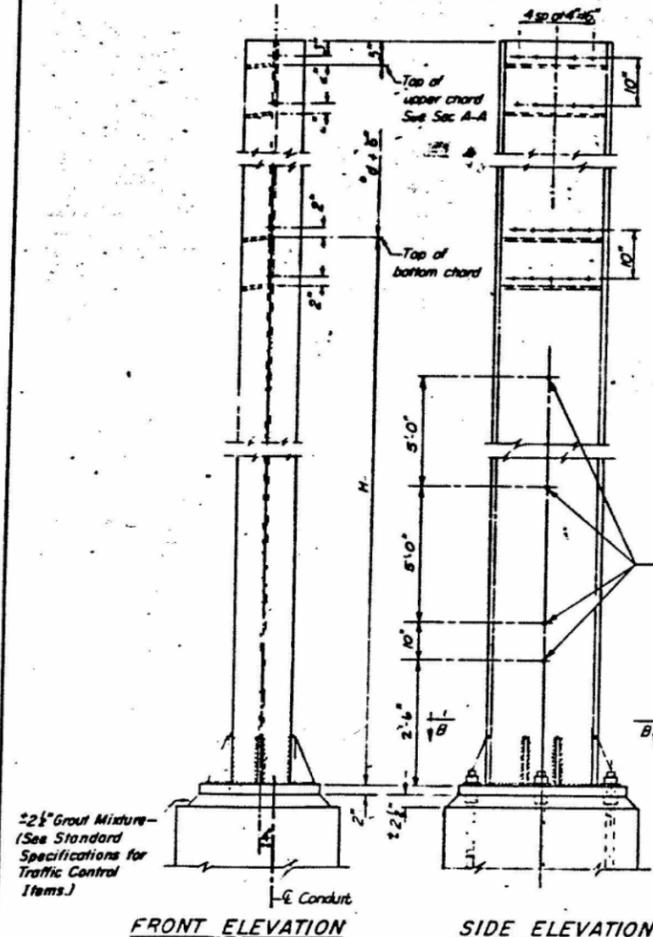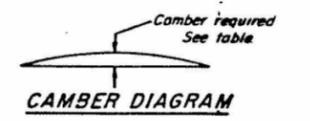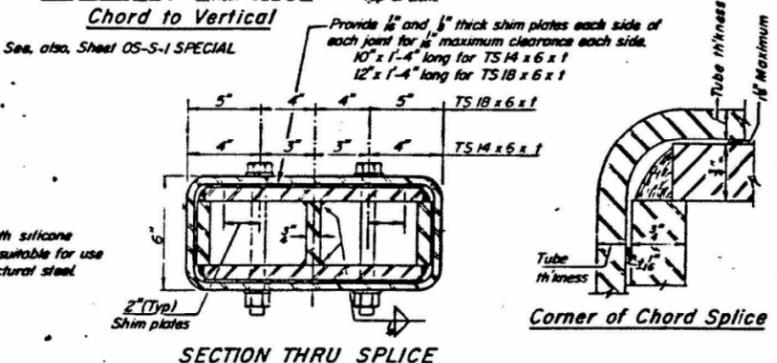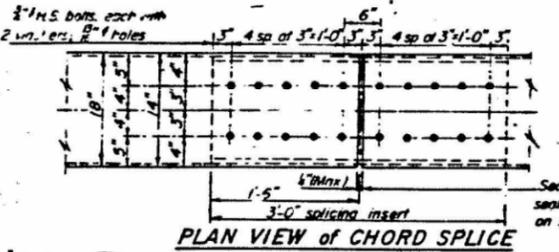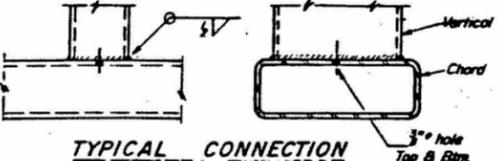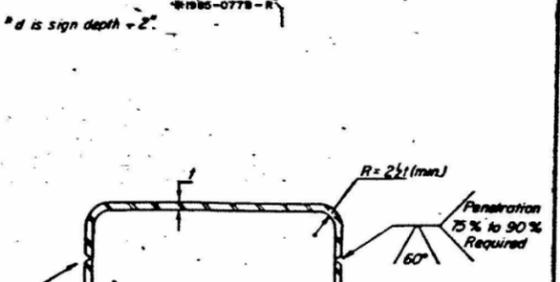

Structure No	Station	Span	"d	Camber at E	Exterior Unit Lgth (L)	Interior Unit Lgth (L)	No. of Panels (N)	Panel Lgth (P)	Chord Size	Vertical Size	Post Size	L.H. Post Dim. H	R.H. Post Dim. H
NB-5-1	79+60	82'-0" 12'-0"	4"	4"	33'-4 3/4"	N.I.C.	11	5'-0 1/2"	TS18X6X3/8	TS14X6X3/8	W24 X 104	17'-3"	16'-1"
NB-5-2	100+50	86'-9 1/2" 12'-8"	4"	4"	33'-4 3/4"	N.I.C.	11	5'-0 1/2"	TS18X6X3/8	TS14X6X3/8	W24 X 104	15'-2"	15'-5"
NB-5-3	131+11	92'-11 1/2" 10'-8"	4"	4"	26'-0 3/4"	N.I.C.	9	5'-5 3/8"	TS14X6X3/8	TS10X6X3/8	W24 X 104	14'-11"	15'-9"
NB-5-4	150+70	87'-3 1/2" 13'-2"	6"	6"	29'-0 1/4"	24'-4 3/4"	13	6'-1 1/8"	TS18X6X3/8	TS14X6X3/8	W24 X 104	17'-4"	14'-8"
NB-5-5	165+00	93'-7 1/2" 13'-2"	6"	6"	34'-10 1/2"	23'-10 1/2"	15	5'-11 3/4"	TS18X6X3/8	TS14X6X1/2	W24 X 104	15'-2"	23'-1"
NB-5-6	175+17	80'-1 1/2" 13'-2"	6"	6"	28'-4 1/2"	23'-6"	13	5'-10 1/2"	TS18X6X5/8	TS14X6X1/2	W24 X 104	15'-2"	15'-9"
NB-5-7	195+00	80'-0" 12'-8"	6"	6"	33'-6 1/8"	22'-11 3/4"	15	5'-8 3/4"	TS18X6X3/8	TS14X6X3/8	W24 X 104	15'-11"	15'-7"
NB-5-8	12+17	80'-0" 10'-8"	2"	2"	30'-0"	N.I.C.	9	6'-2 5/8"	TS18X6X3/8	TS10X6X3/8	W24 X 104	16'-3"	15'-7"
NB-5-9	212+18	46'-9" 10'-8"	4"	4"	23'-1 1/2"	N.I.C.	7	6'-1 1/8"	TS14X6X3/8	TS10X6X3/8	W24 X 104	16'-3"	15'-5"
EB-5-2	12+00 RAMP 'D'	49'-0" 11'-2"	2"	2"	24'-8"	N.I.C.	5	5'-0"	TS14X6X3/8	TS10X6X3/8	W24 X 104	16'-3"	16'-5"
EB-5-3	32+82 RAMP 'E'	49'-4 1/2" 10'-8"	4"	4"	24'-8 1/4"	N.I.C.	7	6'-5 3/4"	TS14X6X3/8	TS10X6X3/8	W24 X 104	14'-6"	17'-0"
EB-5-4	8+40 (I-55)	N.I.C.	N.I.C.	N.I.C.	N.I.C.	N.I.C.	N.I.C.	N.I.C.	N.I.C.	N.I.C.	N.I.C.	N.I.C.	N.I.C.
CMS-10	124+82	90'-8" 17'-0"	6"	6"	33'-10 1/2"	25'-2"	15	5'-9 1/2"	TS18X6X3/8	TS14X6X3/8	W24 X 104	14'-8"	16'-4"
NB-5-10	93+08	66'-9 1/2" 12'-8"	4"	4"	33'-4 3/4"	N.I.C.	11	5'-0 1/2"	TS18X6X3/8	TS10X6X3/8	W24 X 104	16'-3"	15'-5"

DESIGNED: _____
 CHECKED: _____
 DRAWN: _____
 CHECKED: _____

EXAMINED: _____
 PASSED: _____
 APPROVED: _____

OS-S-2 SPECIAL

SHEET C-87 OF C-104

OVERHEAD SIGN STRUCTURES
POST and CHORD DETAILS

DAN RYAN EXPRESSWAY (F.A. 190/94)
NORTHBOUND MAINLINE RECONSTRUCTION
28TH PL. TO MAXWELL ST

Scale: none
Date: 9/98

FILE NAME: D:\VACOM\NA-AWS1\recomonline\local\AECOM_D502_NAVDocuments\01_Americas\Transportation\6269938_Circle\Phase_I\0000_CAD\008_Structural\Sign_Structures\62676_Sign_Structure\62676-Vierendeel-SS114-SignStruct.dgn



USER NAME =	charles.pigozzi	DESIGNED -	HI, FL	REVISED -	
PLOT SCALE =	N.T.S	CHECKED -	MAI, JJS	REVISED -	
PLOT DATE =	1/24/2020	DRAWN -	HI, FL	REVISED -	
		CHECKED -	MAI, JJS	REVISED -	

STATE OF ILLINOIS
DEPARTMENT OF TRANSPORTATION

EXISTING RECORD DRAWINGS
VIERENDEEL TRUSS SIGN STRUCTURES

SHEET NO. SS115 OF SS129 SHEETS




F.A.I. RTE.	SECTION	COUNTY	TOTAL SHEETS	SHEET NO.
90/94/290	2015-019R	COOK	2155	1065
			CONTRACT NO. 62A76	
		ILLINOIS FED. AID PROJECT		

FOR INFORMATION ONLY

STATE OF ILLINOIS
DEPARTMENT OF TRANSPORTATION


PROJECT NO.	SECTION	SHEET NO.	TOTAL SHEETS
90/94	COOK	127	107

1985-0778-R

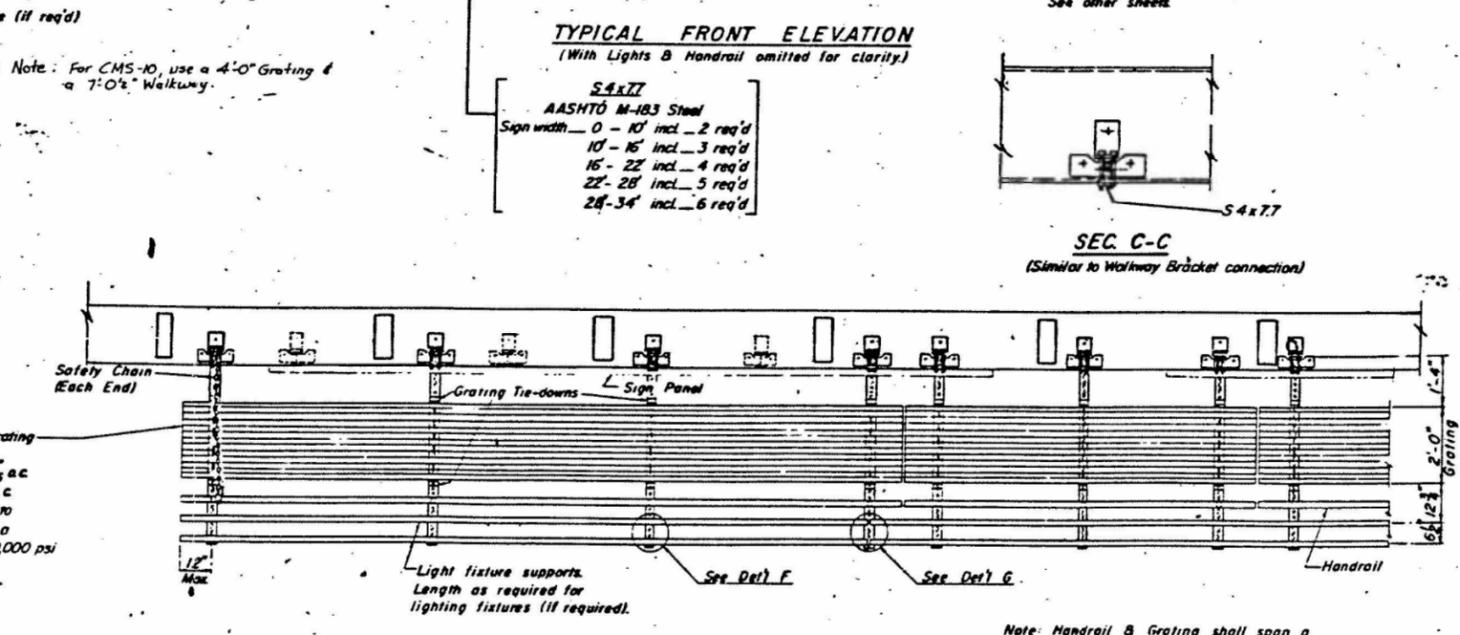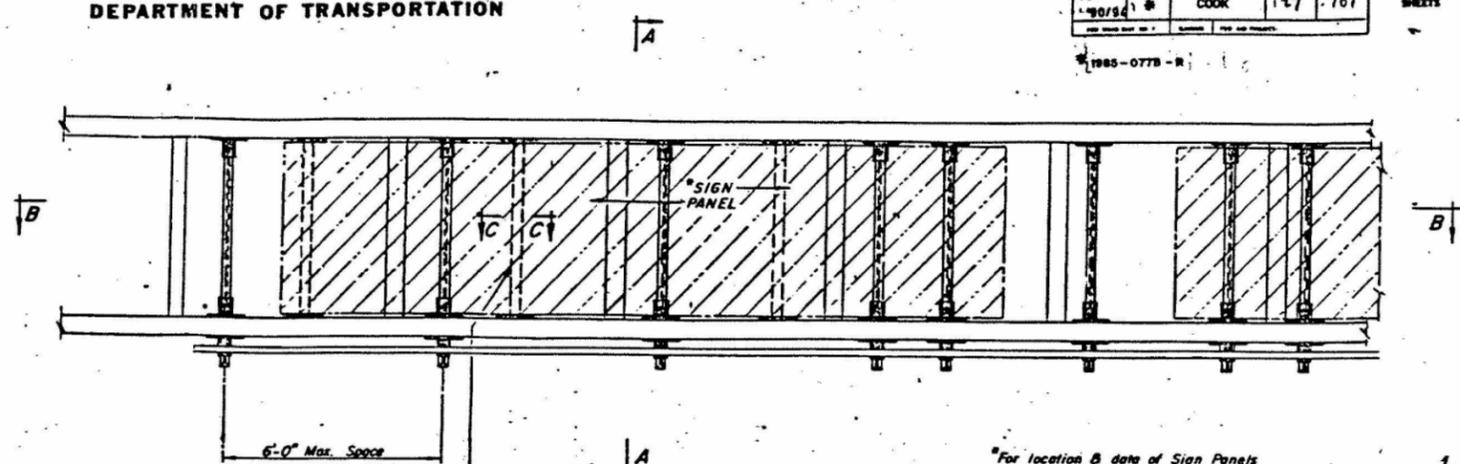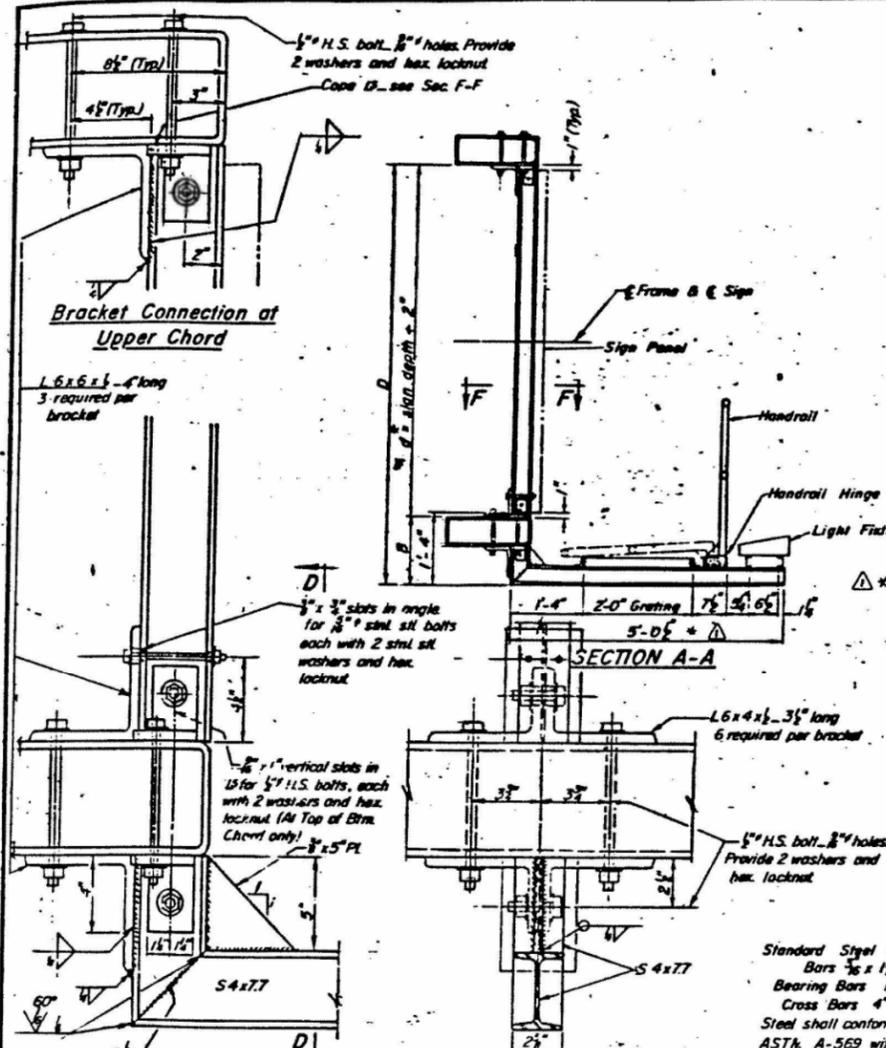

BRACKET DETAILS
NOTE: Walkway brackets shall conform to requirements of AASHTO M-183.

Structure Number	Station	B	D	H
NB-S-1	70+50	N.I.C.	12'-2"	12'-2"
NB-S-2	100+50	8'-3"	12'-8"	12'-8"
NB-S-3	131+11	8'-3"	11'-11"	10'-8"
NB-S-4	150+70	8'-3"	16'-8"	13'-2"
NB-S-5	165+00	8'-3"	14'-5"	13'-2"
NB-S-6	175+17	8'-3"	14'-5"	13'-2"
NB-S-7	185+00	8'-3"	12'-8"	12'-8"
NB-S-8	12+17	8'-3"	16'-8"	10'-8"
NB-S-9	212+18	8'-3"	16'-8"	10'-8"
EB-S-1	14+00	RAMP 'D'	1'-8"	12'-2"
EB-S-2	32+82	RAMP 'E'	1'-3"	11'-11"
ES-S-1		N.I.C.		
NB-S-10	93+08	1'-3"	13'-11"	12'-8"
CMS-10	128+62	1'-3"	8'-3"	7'-0"

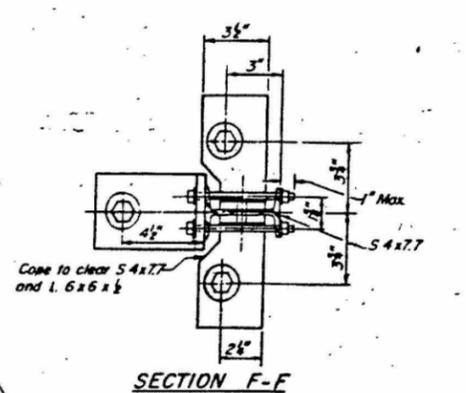

**OVERHEAD SIGN STRUCTURES
STEEL WALKWAY DETAILS**

DAN RYAN EXPRESSWAY (I.A.1.90/94)
NORTHBOUND MAINLINE RECONSTRUCTION
28TH PL. TO MAXWELL ST.

Scale: NONE
Date: 5/88

DESIGNED	HI, FL
CHECKED	MAI, JJS
DESIGNED BY	HI, FL
CHECKED BY	MAI, JJS

OS-S-3-SPECIAL

STATE OF ILLINOIS
DEPARTMENT OF TRANSPORTATION

EXISTING RECORD DRAWINGS
VIERENDEEL TRUSS SIGN STRUCTURES

F.A.I. RTE.	SECTION	COUNTY	TOTAL SHEETS	SHEET NO.
90/94/290	2015-019R	COOK	2155	1066

SHEET NO. SS116 OF SS129 SHEETS

ILLINOIS FED. AID PROJECT

FILE NAME: D:\VIAE\COM-NA-AW51\ecomonline\local\AECOM_D502_NAVDocuments\01_Americas\Transportation\60269938_Circle\Phase_I\000_CAD\008_Structural\Sign_Structures\62A76-Vierendeel-SS115-SignStruct.dgn





11:38:06 AM

FOR INFORMATION ONLY





STATE OF ILLINOIS
DEPARTMENT OF TRANSPORTATION

DATE	BY	REVISION	DATE	BY
10/98	ML	COOK	12.7	108

SHEET NO
SHEETS

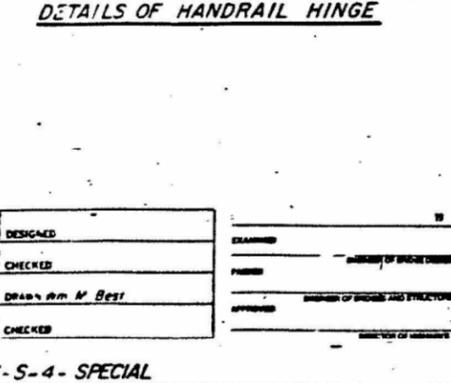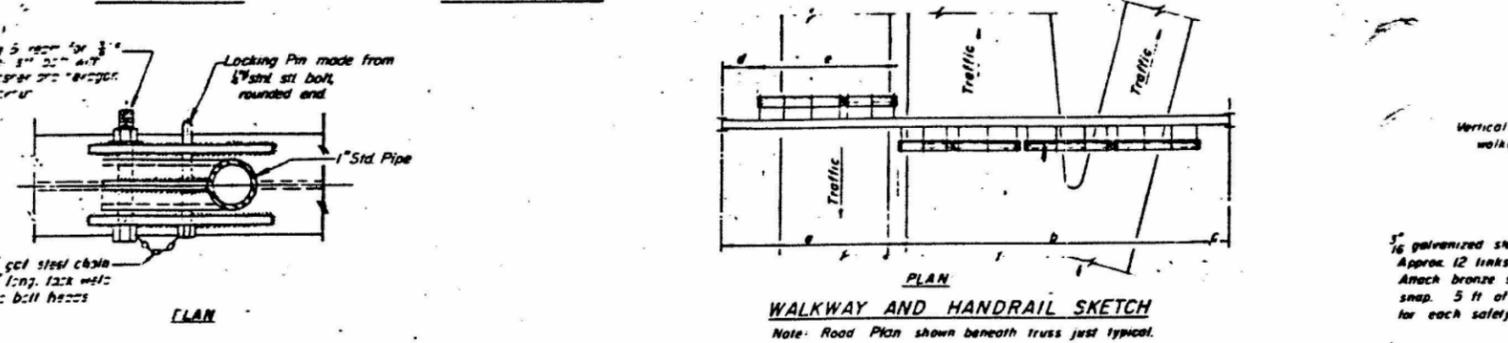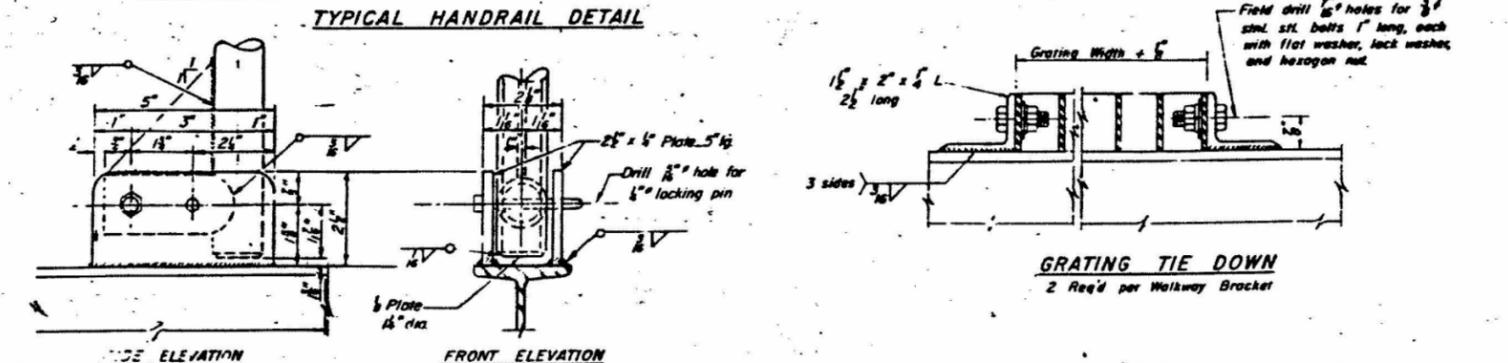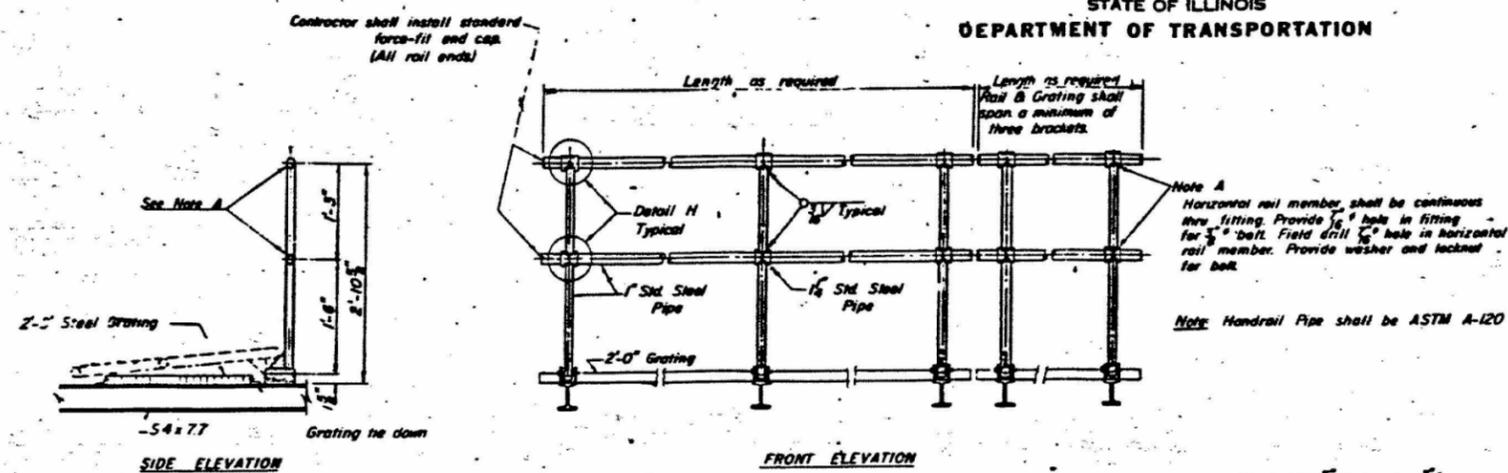

Structure Number	Station	a	b	c	d	e	Grating & Handrail Lengths
NB-5-1	79+50	3'-0"	2'-0"	1'-0"	1'-0"	1'-0"	45'-0"
NB-5-2	100+50	6'-9 1/2"	8'-0"	8'-0"			66'-6"
NB-5-3	131+11	2'-11 3/8"	4'-6"	7'-9"			42'-6"
NB-5-4	150+70	3'-3 1/4"	7'-0"	2'-0"			79'-0"
NB-5-5	165+00	5'-7 1/2"	8'-0"	1'-0"			67'-0"
NB-5-6	175+17	5'-17 1/8"	3'-0"	8'-0"			79'-0"
NB-5-7	185+00	4'-0"	6'-0"	2'-0"			79'-0"
NB-5-8	12+17	3'-0"	4'-0"	1'-0"			79'-0"
NB-5-9	212+18	3'-0"	4'-0"	1'-0"			79'-0"
EB-5-7	12+00	8'-0"	10'-0"	1'-0"			20'-0"
EB-5-3	32+82	5'-0"	4'-0"	2'-5"			42'-0"
CMS-10	124+62	14'-1"	45'-7"	35'-3"			45'-7"
NB-5-10	93+08	4'-0"	1'-0"	1'-0"			15'-6"

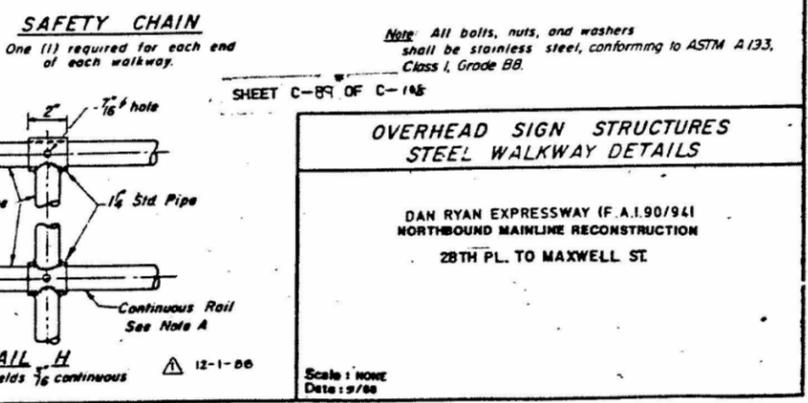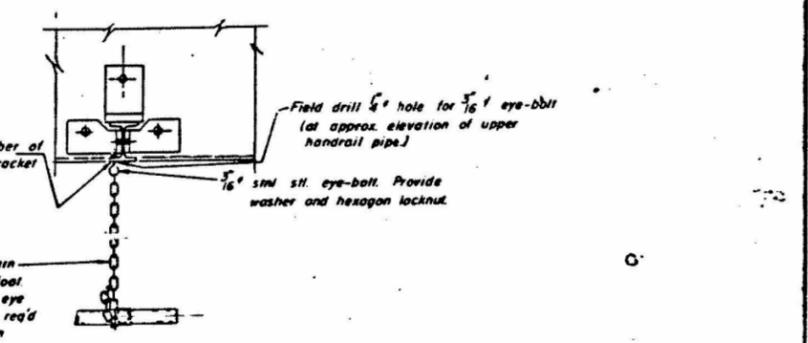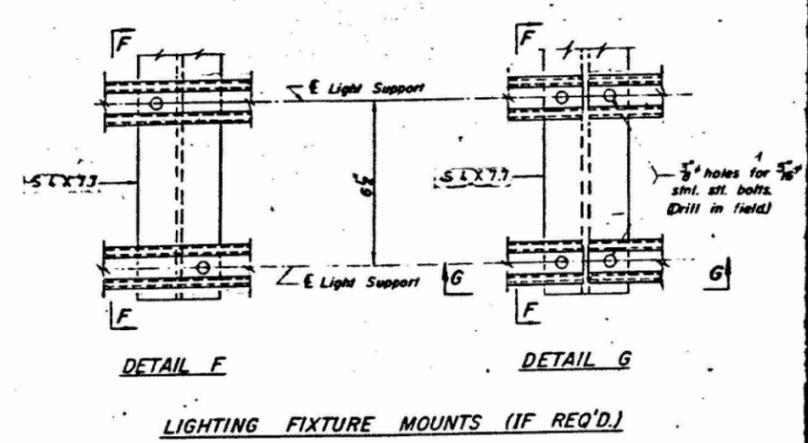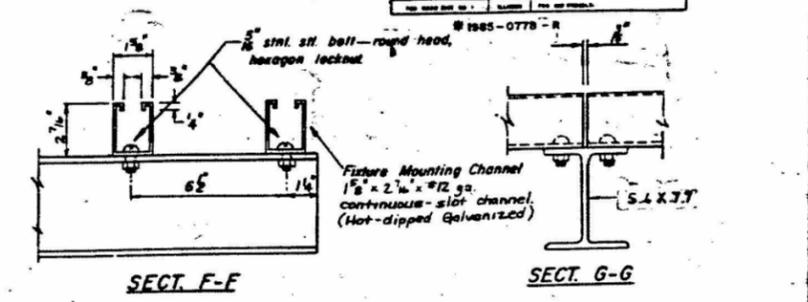

DESIGNED: _____

CHECKED: _____

DRAWN: M. Best

CHECKED: _____

EXAMINED: _____

APPROVED: _____

OS-S-4-SPECIAL

STATE OF ILLINOIS
DEPARTMENT OF TRANSPORTATION

EXISTING RECORD DRAWINGS
VIERENDEEL TRUSS SIGN STRUCTURES

F.A.I. RTE.	SECTION	COUNTY	TOTAL SHEETS	SHEET NO.
90/94/290	2015-019R	COOK	2155	1067

SHEET NO. SS117 OF SS129 SHEETS

ILLINOIS FED. AID PROJECT

HBM
ENGINEERING GROUP, LLC



USER NAME =	charles.pigozzi	DESIGNED -	HI, FL	REVISED -	
PLOT SCALE =	N.T.S	CHECKED -	MAI, JJS	REVISED -	
PLOT DATE =	1/24/2020	DRAWN -	HI, FL	REVISED -	
		CHECKED -	MAI, JJS	REVISED -	

FILE NAME: D:\VIAE\COM-NA-AW51\arecomonline\local\AECOM_DS02_NAD\Documents\01_Americas\Transportation\60269938_Circle\Phase_I\0000_CAD\008_Structural\Sign_Structure\62A76-Vierendeel-SS116-SignStruct.dgn

FOR INFORMATION ONLY


STATE OF ILLINOIS
DEPARTMENT OF TRANSPORTATION

DATE	BY	NO.	REV.	SHEET NO.
11/17/18	COOK	127	109	

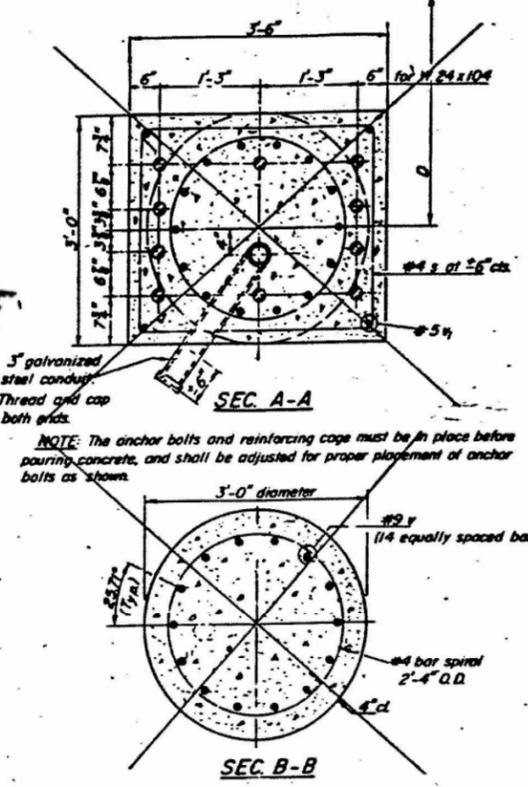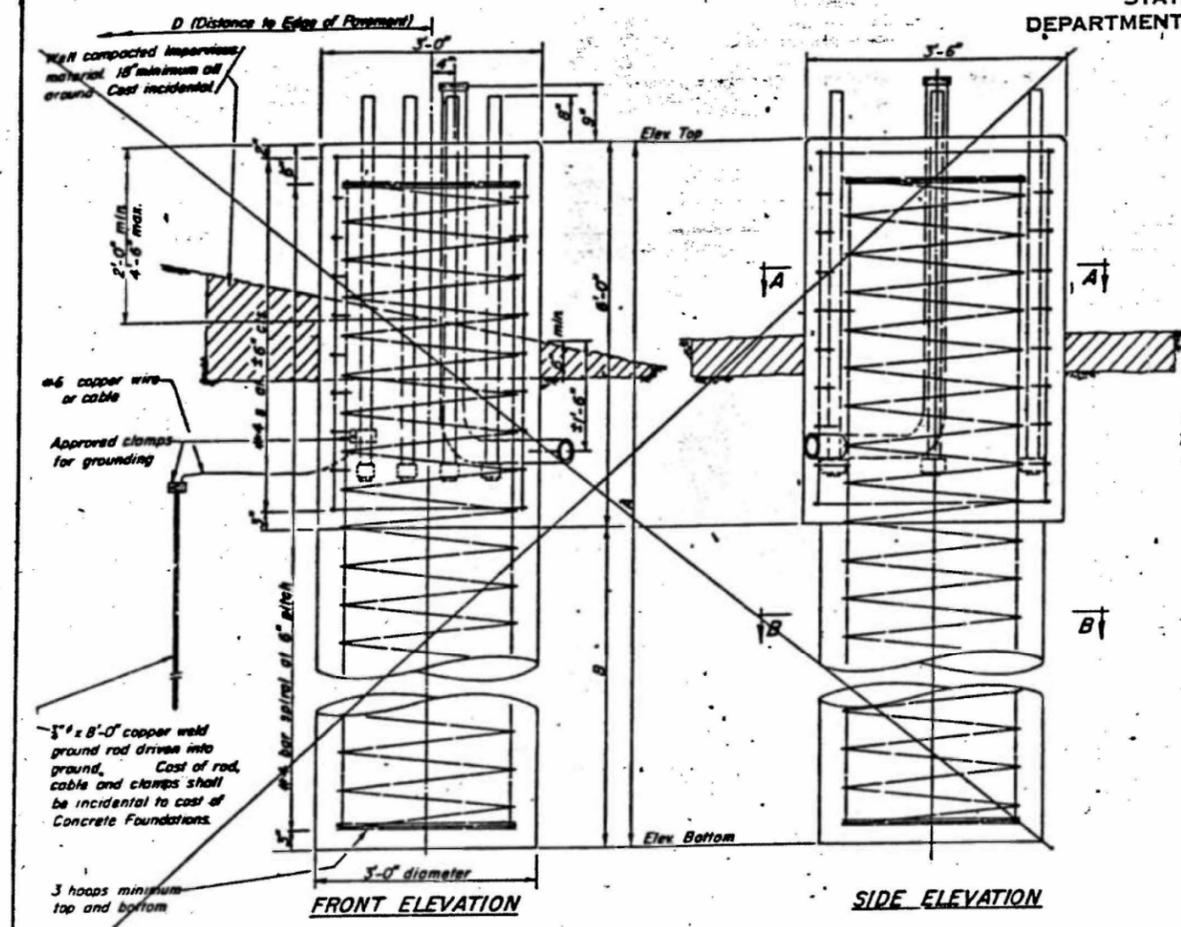

NOTES:
The foundation details shown are for Average Cohesive Soil Conditions (stiff clays, sandy clays) and with minimum $C_u = 1.0$ Tons/Sq. Ft. C_u being the average value of hard penetrometer readings at various depths of the shaft as determined by the Engineer at time of drilling operations or previous soil investigation.


NOTE:
ANCHOR BOLTS THAT ARE IN THE PARAPET OR PIER CAP ARE INCIDENTAL TO CLASS 'X' CONCRETE. LENGTH AND SHAPE OF THESE BOLTS ARE ON THE STRUCTURAL PLANS.

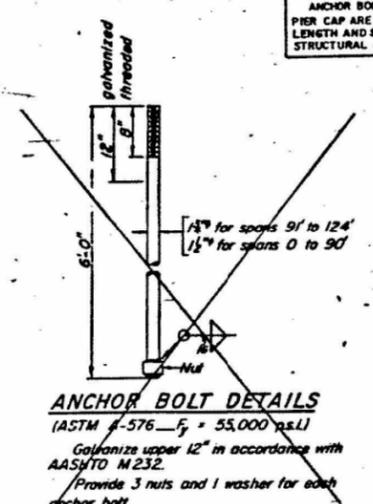

BAR LIST - EACH FOUNDATION

Bar	No	Size	Lath	Shape
s	12	#4	11'-9"	□
v	14	#9	8x5'-7"	—
w	4	#5	5'-3"	—

#4 bar spiral - see Front Elevation

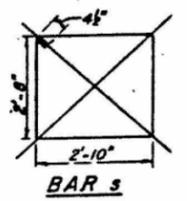

DEPTH TABLE

Span	B (min)
70'	15'
80'	15'
90'	16'
100'	17'
110'	18'
124'	20'

Structure No	Station	B	Anchor Bolt Size	Left Foundation		Right Foundation		Class X Concrete
				Elev. Top	Elev. Btm.	A	Elev. Top	
NB-5-10	93+08							
NB-5-2	100+50			65.76			65.49	
NB-5-3	131+11			58.46			56.85	
NB-5-4	150+70			41.04			43.74	
NB-5-5	165+00			58.11			55.11	
NB-5-6	175+17			49.34			48.77	
NB-5-7	185+00			16.74			17.88	
NB-5-8	12+17			13.52			14.27	
NB-5-9	212+18			6.78			6.78	
EB-5-2	1+00 RAMP 'U'							
EB-5-3	8+50 RAMP 'C'							
EB-5-3	22+82 RAMP 'E'			58.83			56.52	
EB-5-11	93+08			55.62			57.31	

DESIGNED	EXAMINED
CHECKED	PAIRED
DRAWN	APPROVED
CHECKED	

OS-S-5-SPECIAL

SHEET C-90 OF C-104

DRILLED SHAFT FOUNDATION DETAILS

FOR PARAPET MOUNTED OVERHEAD SIGNS SEE VOL. 13, SHEET NO. PD 1

OVERHEAD SIGN STRUCTURES-SPAN FOUNDATION DETAILS*

DAN RYAN EXPRESSWAY (F.A.1.90/94) NORTHBOUND MAINLINE RECONSTRUCTION 28TH PL. TO MAXWELL ST

Scale: 1/8"=1'-0"
Date: 3/88

FILE NAME: D:\V\AECOM-NA-AWS1\... \NAV\Documents\01_Americas\Transportation\60269938_Circle\Phase_I\0000_CAD\008_Structural\Sign_Structures\62A76_Verendeeel-SS117-5ignStruct.dgn



USER NAME = charles.pigozzi	DESIGNED - HI, FL	REVISED -
PLOT SCALE = N.T.S	CHECKED - MAI, JJS	REVISED -
PLOT DATE = 1/24/2020	DRAWN - HI, FL	REVISED -
	CHECKED - MAI, JJS	REVISED -





STATE OF ILLINOIS
DEPARTMENT OF TRANSPORTATION

EXISTING RECORD DRAWINGS
VIERENDEEL TRUSS SIGN STRUCTURES

F.A.I. RTE. 90/94/290	SECTION 2015-019R	COUNTY COOK	TOTAL SHEETS 2155	SHEET NO. 1068
SHEET NO. SS118 OF SS129 SHEETS			CONTRACT NO. 62A76	

FOR INFORMATION ONLY

SHEET NO.

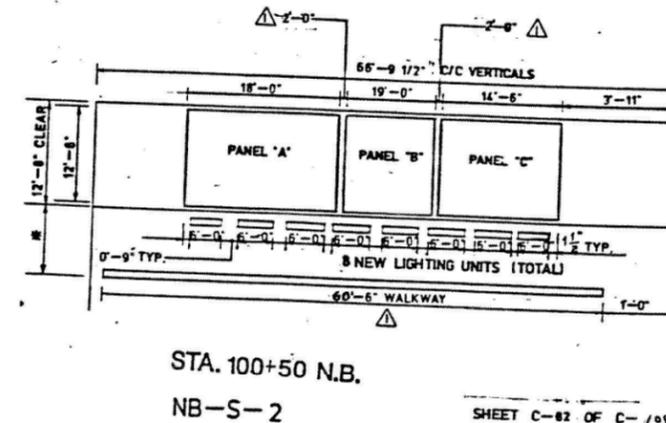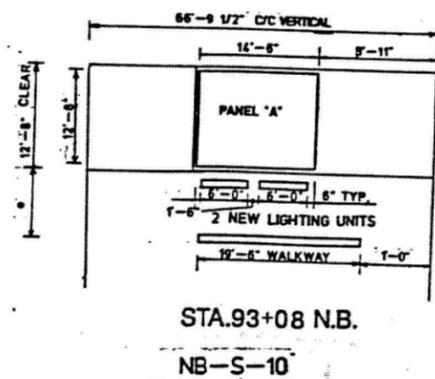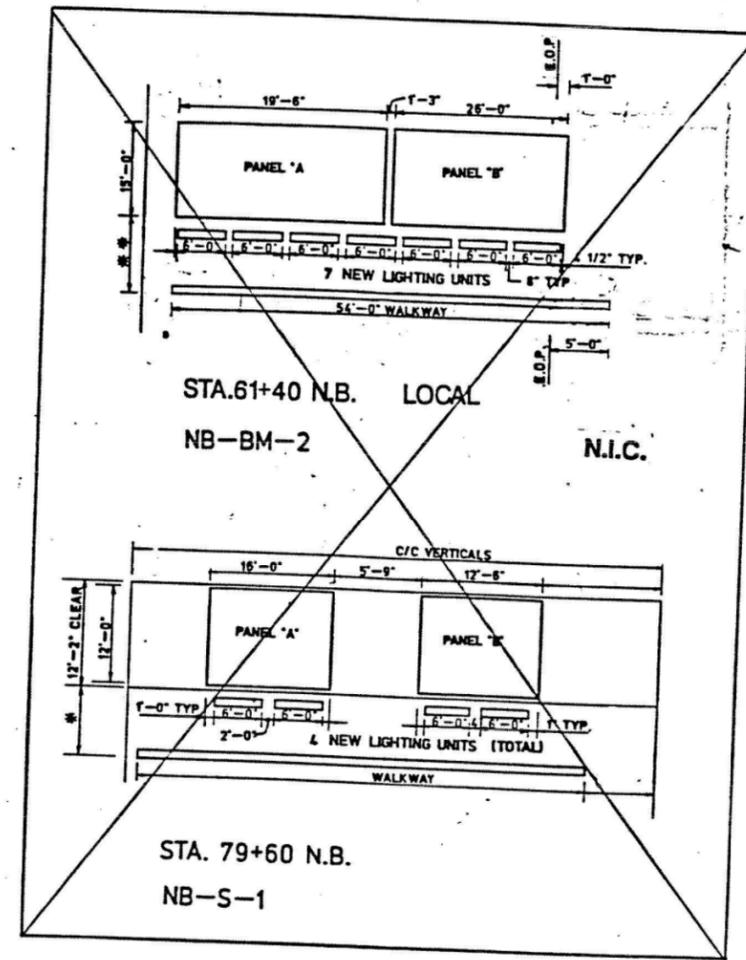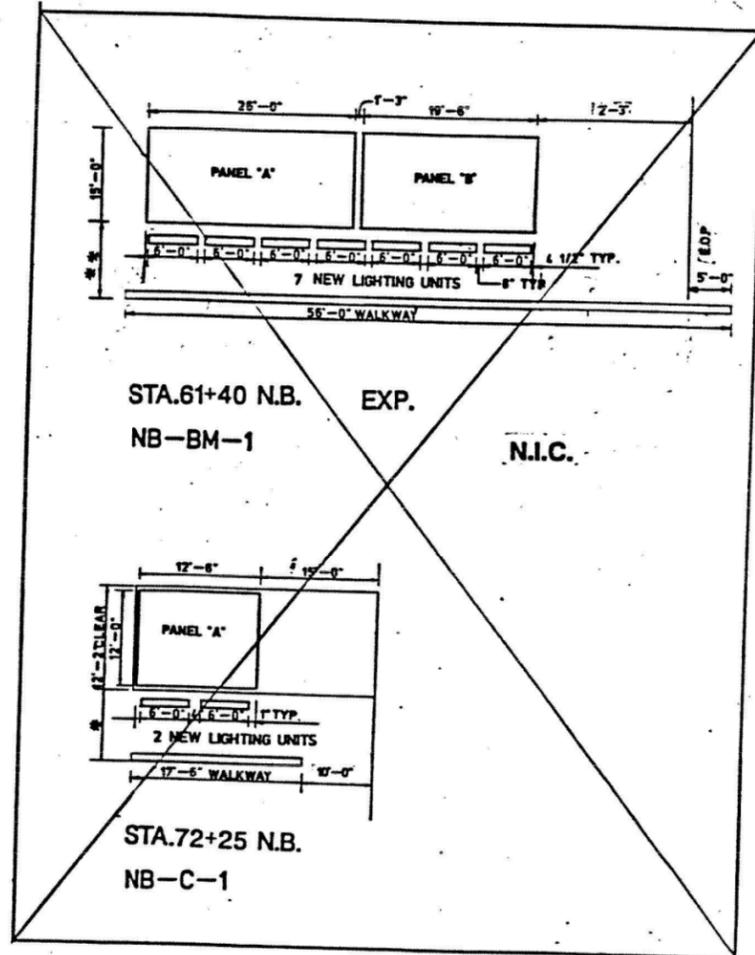

* 1'-3" MIN. TOP OF BOTTOM CHORD TO BOTTOM OF WALKWAY
 ** 1'-5" MIN. BOTTOM OF SIGN TO BOTTOM OF WALKWAY

SECTION	COUNTY	TOTAL SHEETS	SHEET NO.
90/94	COOK	127	101

1985-0778-R

ILLINOIS DEPARTMENT OF TRANSPORTATION
 DAN RYAN EXPRESSWAY (I.A. 90/94)
 NORTHBOUND MAINLINE RECONSTRUCTION
 SIGN PANEL AND
 LIGHT FIXTURE PLACEMENT
 28TH PL. TO MAXWELL ST



USER NAME =	charles.pigozzi	DESIGNED -	HI, FL	REVISED -	
PLOT SCALE =	N.T.S	CHECKED -	MAI, JJS	REVISED -	
PLOT DATE =	1/24/2020	DRAWN -	HI, FL	REVISED -	
		CHECKED -	MAI, JJS	REVISED -	

STATE OF ILLINOIS
 DEPARTMENT OF TRANSPORTATION

EXISTING RECORD DRAWINGS
 VIRENDEEL TRUSS SIGN STRUCTURES

F.A.I. RTE.	SECTION	COUNTY	TOTAL SHEETS	SHEET NO.
90/94/290	2015-019R	COOK	2155	1069

CONTRACT NO. 62A76

SHEET NO. SS119 OF SS129 SHEETS


ILLINOIS FED. AID PROJECT

FILE NAME: D:\V\AE\COM-NA-AWS1\ae\comonline\local\AE\COM_DS02_NAV\Documents\01_Americas\Transportation\60269938_Circle\Phase_CAD\008_Structural\Sign_Structures\62A76_Sign_Structure\62A76-VirenDeel-SS118-SignStruct.dgn


11:38:48 AM

FOR INFORMATION ONLY


SECTION	COUNTY	TOTAL SHEETS	SHEET NO.
2015-019R	COOK	2155	1070
STA. TO STA.		CONTRACT NO. 62A76	
1085+0778-R			

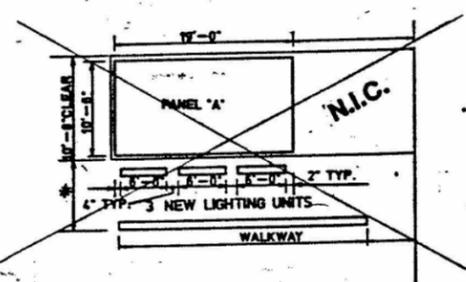


STA. 110+90 N.B.
NB-C-3

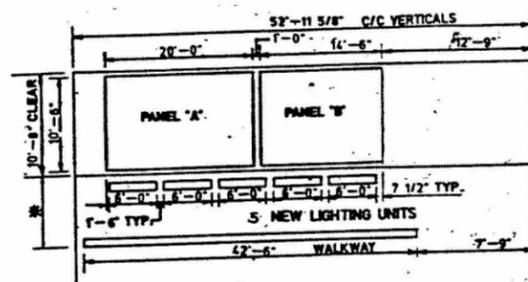


STA. 131+11 N.B.
NB-S-3

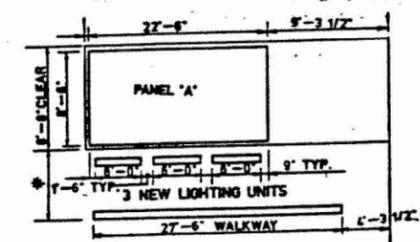


STA. 131+47 N.B.
NB-C-4

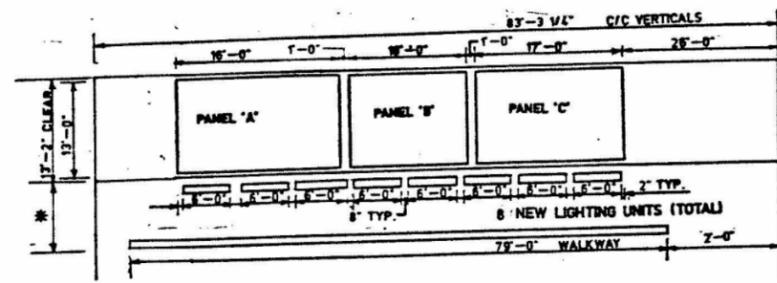

STA. 150+70 N.B.
NB-S-4

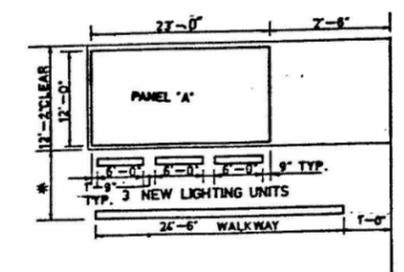

STA. 161+74 N.B.
NB-C-5

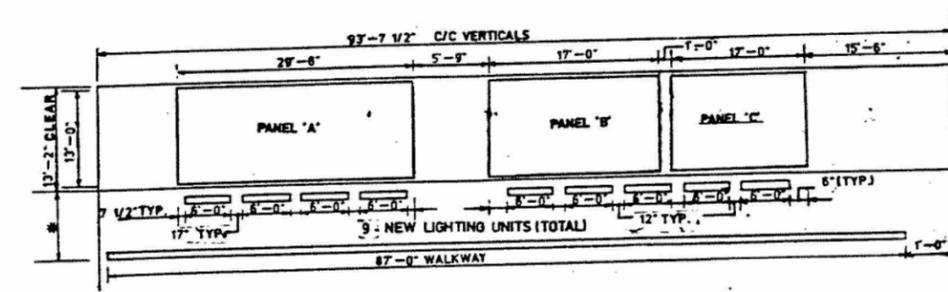

STA. 165+00 N.B.
NB-S-5

* 1'-3" MIN.
TOP OF BOTTOM CHORD
TO BOTTOM OF
WALKWAY

SHEET C-03 OF C-14

12-1-88

ILLINOIS DEPARTMENT OF TRANSPORTATION
DAN RYAN EXPRESSWAY (F.A.I. 90/94)
NORTHBOUND MAINLINE RECONSTRUCTION
SIGN PANEL AND
LIGHT FIXTURE PLACEMENT
28TH PL. TO MAXWELL ST
SCALE: VERT. 1"=8'
HORIZ. 1"=10'
DATE: 9/88

KEI KAM ENGINEERING, INC.
707A Davis Road • Elgin, Illinois • 60120-1372
631.202.4211

FILE NAME: D:\VAE\COM-NA-AW51\recomonline-local\AE\COM_DS02_NAV\Documents\01_Americas\Transportation\60269938_Circle\Phase\Structural\Sign_Structures\62A76_Sign_Structure\62A76_Vierendeel-SS119-SignStruct.dgn

HBM
ENGINEERING GROUP, LLC

USER NAME =	charles.pigozzi	DESIGNED -	HI, FL	REVISED -	
PLOT SCALE =	N.T.S	CHECKED -	MAI, JJS	REVISED -	
PLOT DATE =	1/24/2020	DRAWN -	HI, FL	REVISED -	
		CHECKED -	MAI, JJS	REVISED -	

STATE OF ILLINOIS
DEPARTMENT OF TRANSPORTATION

EXISTING RECORD DRAWINGS
VIENDEEL TRUSS SIGN STRUCTURES


F.A.I. RTE.	SECTION	COUNTY	TOTAL SHEETS	SHEET NO.
90/94/290	2015-019R	COOK	2155	1070
CONTRACT NO. 62A76				

SHEET NO. SS120 OF SS129 SHEETS


ILLINOIS FED. AID PROJECT

FOR INFORMATION ONLY


SECTION	COUNTY	TOTAL SHEETS	SHEET NO.
2015-019R	COOK	2155	1071
STA.	TO STA.		
PER. ROAD DIST. NO. 1	ILLINOIS	PER. AID PROJECT	
1985-0778-R			

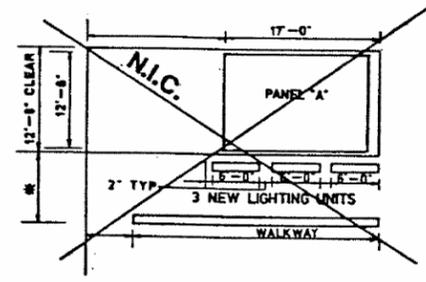


STA. 165+08 N.B.
NB-C-6

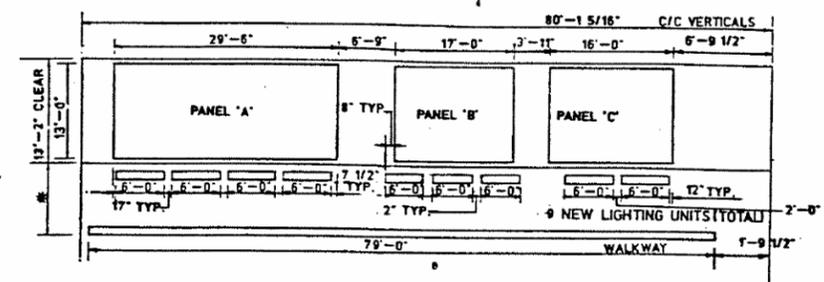


STA. 175+17 N.B.
NB-S-6
Δ

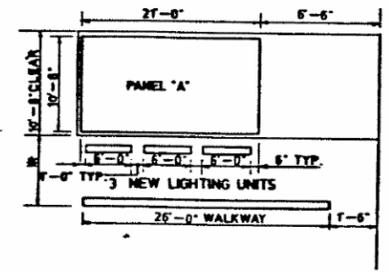


STA. 179+17 N.B.
NB-C-7
Δ

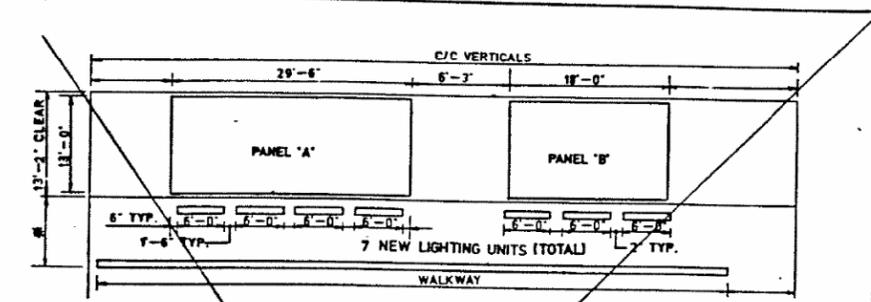

STA. 185+00 N.B.
NB-S-7
N. I. C.

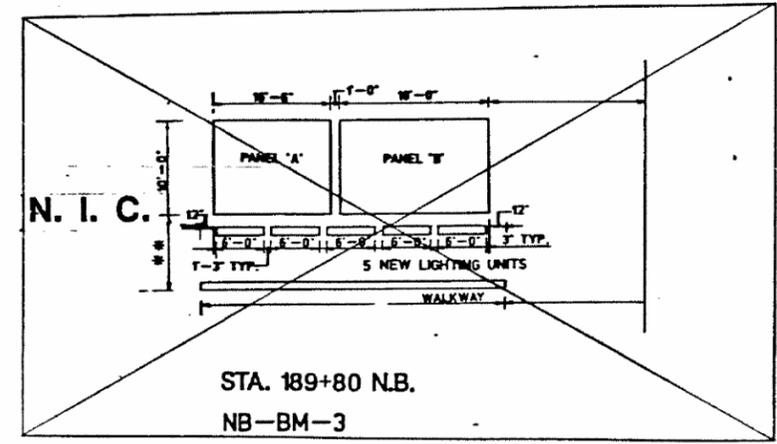

STA. 189+80 N.B.
NB-BM-3

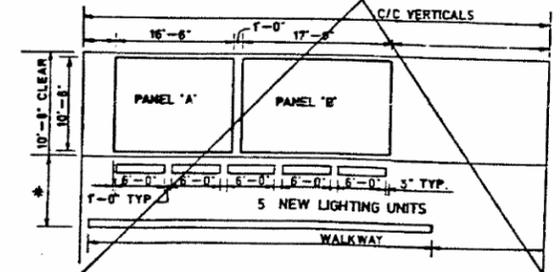

STA. 12+17 N.B. C-D ENTRANCE RAMP
NB-S-8

1'-5" MIN. BOTTOM OF SIGN TO BOTTOM OF WALKWAY
1'-3" MIN. TOP OF BOTTOM CHORD TO BOTTOM OF WALKWAY

SHEET C-84 OF C-104
Δ 12-1-88

ILLINOIS DEPARTMENT OF TRANSPORTATION
DAN RYAN EXPRESSWAY (F.A.J.90/94)
NORTHBOUND MAINLINE RECONSTRUCTION
SIGN PANEL AND
LIGHT FIXTURE PLACEMENT
28TH PL. TO MAXWELL ST
SCALE: VERT: NONE
DATE: 3/88

KEIKAM ENGINEERING, INC.
703A Dowd Road • Elgin, Illinois • 60120-1372
C127931-4211

USER NAME =	charles.pigozzi	DESIGNED -	HI, FL	REVISED -	
PLOT SCALE =	N.T.S	CHECKED -	MAI, JJS	REVISED -	
PLOT DATE =	1/24/2020	DRAWN -	HI, FL	REVISED -	
		CHECKED -	MAI, JJS	REVISED -	

STATE OF ILLINOIS
DEPARTMENT OF TRANSPORTATION

EXISTING RECORD DRAWINGS
VIERENDEEL TRUSS SIGN STRUCTURES

F.A.I. RTE.	SECTION	COUNTY	TOTAL SHEETS	SHEET NO.
90/94/290	2015-019R	COOK	2155	1071
CONTRACT NO. 62A76				
ILLINOIS FED. AID PROJECT				

SHEET NO. SS121 OF SS129 SHEETS

FILE NAME: D:\VIAE\COM-NA-AW51\recomonline.local\AECOM_ID502_NA\Documents\01_Americas\Transportation\60269938_Circle\Phase_I\0000_CAD\008_Structural\Sign_Structures\62A76_Sign_Structure\62A76_Vierendeel-SS120-SignStruct.dgn

HBM
ENGINEERING GROUP, LLC

11:39:16 AM

FOR INFORMATION ONLY

**Congress Pkwy
Chicago Loop
RIGHT LANE**

STA 189+80
NB-BM-3-PANEL B

SHIELD STANDARD(S)
M1 - 1 - 4536

BORDER WIDTH IS 2.00 INCHES
CORNER RADIUS IS 9.0 INCHES

TOTAL WIDTH IS 18.0 FEET
TOTAL HEIGHT IS 10.0 FEET
TOTAL AREA IS 180.00 SQ. FT.

ARROW SIZE(S)
36 X 22

BACKGROUND/LEGEND COLOR IS GREEN/WHITE

LINE	VERTICAL SPACING	LEGEND HEIGHT	LETTER HEIGHT	LEFT BORDER	WORD 1 WIDTH	HORIZ. SPACING	WORD 2 WIDTH	HORIZ. SPACING	WORD 3 WIDTH	HORIZ. SPACING	WORD 4 WIDTH	HORIZ. SPACING	WORD 5 WIDTH	RIGHT BORDER	LEGEND WIDTH
TOP EDGE															
1	20/1	16/0	16/0-12/0	12/4	112/0	16/0	82/7							12/5	190/7
2	19/0	16/0	16/0-12/0	25/2	94/7	16/0	82/5							25/2	185/4
3	19/5	12/0	12/0-0/0	50/2	58/2	12/0	48/3							50/1	115/5
4	16/3														
5															
6															
7															
8															
BOTTOM EDGE															

290 WEST
Eisenhower
Espy
West Suburbs

STA 12+17
NB-S-8-PANEL A

SHIELD STANDARD(S)
M1 - 1 - 4536

BORDER WIDTH IS 2.00 INCHES
CORNER RADIUS IS 12.0 INCHES

TOTAL WIDTH IS 16.5 FEET
TOTAL HEIGHT IS 10.5 FEET
TOTAL AREA IS 173.25 SQ. FT.

ARROW SIZE(S)
36 X 22

BACKGROUND/LEGEND COLOR IS GREEN/WHITE

LINE	VERTICAL SPACING	LEGEND HEIGHT	LETTER HEIGHT	LEFT BORDER	WORD 1 WIDTH	HORIZ. SPACING	WORD 2 WIDTH	HORIZ. SPACING	WORD 3 WIDTH	HORIZ. SPACING	WORD 4 WIDTH	HORIZ. SPACING	WORD 5 WIDTH	RIGHT BORDER	LEGEND WIDTH
TOP EDGE															
1	13/6	36/0	12/0-0/0	31/7	45/0	18/0	47/6							55/3	110/6
2	12/6	16/0	16/0-12/0	12/3	55/5	16/0	102/0							12/0	173/5
3	11/6	22/0	0/0-0/0	104/0	32/0									62/0	32/0
4	13/6														
5															
6															
7															
8															
BOTTOM EDGE															

90 94 WEST
Kennedy
Espy
Wisconsin

STA 12+17
NB-S-8-PANEL B

SHIELD STANDARD(S)
M1 - 1 - 3636

BORDER WIDTH IS 2.00 INCHES
CORNER RADIUS IS 12.0 INCHES

TOTAL WIDTH IS 17.0 FEET
TOTAL HEIGHT IS 10.5 FEET
TOTAL AREA IS 178.50 SQ. FT.

ARROW SIZE(S)
32 X 22

BACKGROUND/LEGEND COLOR IS GREEN/WHITE

LINE	VERTICAL SPACING	LEGEND HEIGHT	LETTER HEIGHT	LEFT BORDER	WORD 1 WIDTH	HORIZ. SPACING	WORD 2 WIDTH	HORIZ. SPACING	WORD 3 WIDTH	HORIZ. SPACING	WORD 4 WIDTH	HORIZ. SPACING	WORD 5 WIDTH	RIGHT BORDER	LEGEND WIDTH
TOP EDGE															
1	13/6	36/0	12/0-0/0	13/4	16/5	12/0	36/0	12/0	36/0	12/0	47/6			18/1	172/3
2	12/0	16/0	16/0-12/0	4/0/6	122/2									4/0/6	122/2
3	11/6	22/0	0/0-0/0	62/0	32/0									110/0	32/0
4	13/6														
5															
6															
7															
8															
BOTTOM EDGE															

290 WEST
Eisenhower
Espy
West Suburbs

STA 199+05
NB-BM-4-PANEL A

SHIELD STANDARD(S)
M1 - 1 - 4536

BORDER WIDTH IS 2.00 INCHES
CORNER RADIUS IS 12.0 INCHES

TOTAL WIDTH IS 16.5 FEET
TOTAL HEIGHT IS 10.5 FEET
TOTAL AREA IS 173.25 SQ. FT.

ARROW SIZE(S)
32 X 22

BACKGROUND/LEGEND COLOR IS GREEN/WHITE

LINE	VERTICAL SPACING	LEGEND HEIGHT	LETTER HEIGHT	LEFT BORDER	WORD 1 WIDTH	HORIZ. SPACING	WORD 2 WIDTH	HORIZ. SPACING	WORD 3 WIDTH	HORIZ. SPACING	WORD 4 WIDTH	HORIZ. SPACING	WORD 5 WIDTH	RIGHT BORDER	LEGEND WIDTH
TOP EDGE															
1	12/6	36/0	12/0-0/0	13/5	45/0	12/0	47/6							79/4	104/5
2	12/6	16/0	16/0-12/0	12/3	55/5	16/0	102/0							12/0	173/5
3	12/5	22/0	0/0-0/0	104/0	32/0									62/0	32/0
4	12/7														
5															
6															
7															
8															
BOTTOM EDGE															

SHEET C-104 OF C-131

ILLINOIS DEPARTMENT OF TRANSPORTATION
DAN RYAN EXPRESSWAY (I.A. 90/94)
ROADWAY GRADING AND PAVING
SIGN PANEL DETAILS
CONSTRUCTION OF N.B. LANES

SCALE VERT
HORIZ
DATE

REVISED 2-9-08

11-12-87 11-16-87

KEI KAM ENGINEERING, INC.
102A Commercial Ave., Naperville, IL 60120-1372
630-201-4211

HBM
ENGINEERING GROUP, LLC

USER NAME = charles.pigozzi	DESIGNED - HI, FL	REVISED -
PLOT SCALE = N.T.S	CHECKED - MAI, JJS	REVISED -
PLOT DATE = 1/24/2020	DRAWN - HI, FL	REVISED -
	CHECKED - MAI, JJS	REVISED -

STATE OF ILLINOIS
DEPARTMENT OF TRANSPORTATION

EXISTING RECORD DRAWINGS
VIERENDEEL TRUSS SIGN STRUCTURES

F.A.I. RTE. 90/94/290	SECTION 2015-019R	COUNTY COOK	TOTAL SHEETS 2155	SHEET NO. 1073
CONTRACT NO. 62A76			ILLINOIS FED. AID PROJECT	

SHEET NO. SS123 OF SS129 SHEETS

FILE NAME: D:\VIA\COM-NA-AW51\recomonline-local\AECOM_ID502_NAV\Documents\01_Americas\Transportation\60269938_Circle\Phase\Sign_Structures\62A76-Vierendeel-SS122-SignStruct.dgn

FOR INFORMATION ONLY

STATE OF ILLINOIS
DEPARTMENT OF TRANSPORTATION

9/19/92	COOK	151	135
---------	------	-----	-----

GENERAL NOTES * 1985-080 R

SPECIFICATIONS:
DESIGN: AASHTO Standard Specifications for Structural Supports for Highway Signs, Luminaires and Traffic Signals, dated January, 1975
CONSTRUCTION: Standard Specifications for Road and Bridge Construction, State of Illinois, (dated October 1, 1983), Supplemental Specifications for Road and Bridge Construction, Standard Specifications for Traffic Control Items (dated Feb 1, 1984) and Special Provisions

MINIMUM CLEARANCE: Vertical Roadway Clearance = 17'-3" (All Obstructions)

LOADING: 80 MPH WIND VELOCITY PLUS 30% GUST FACTOR
WIND LOADING: 35 psf normal to Sign Panel Area as shown below in Wind Loading Diagram plus 48 psf normal to exposed frame members.

WALKWAY LOADING: Dead Load plus 500# concentrated Live Load

MATERIALS:
REINFORCEMENT BARS shall conform to the requirements of AASHTO M31 or M53, Grade 60
CLASS X CONCRETE shall be used throughout
STRUCTURAL STEEL: All material for structural chords, verticals, or chord splices shall conform to either ASTM A500, Grade C, AASHTO M222 or AASHTO M223, Grade 50 and shall meet the longitudinal CVN requirements of 15 ft lbs. at 40° F.
Posts shall conform to AASHTO M222 or M223, Grade 50, and shall meet the longitudinal CVN requirements of 15 ft lbs. at 40° F.

HIGH STRENGTH BOLTS shall conform to the requirements of AASHTO M164.
STRUCTURAL SHAPES and PLATES shall conform to the requirements of AASHTO M223, Grade 50, or M222, unless otherwise specified.


PAINTING: The zinc-silicate and vinyl paint system shall be used for shop and field painting of all structural steel. Exterior surfaces of all structural steel that are painted with the high-build vinyl paint shall receive one coat of vinyl enamel. Paint system, including field coat for the walkway gratings may be done in the shop or just prior to erection. Chords and verticals will require painting on exterior surfaces only.

WELDING: All welding shall be in accordance with Article 507.04(s) of the Standard Specifications for Road and Bridge Construction.


NOTE: CONTRACTOR SHALL VERIFY DIMENSIONS PRIOR TO ORDERING ANY MATERIAL OR HARDWARE, OR REWORKING EXISTING ITEMS.

TOTAL BILL of MATERIAL

OVERHEAD SIGN STRUCTURE SPAN (SPECIAL)	Ln Ft	192'-4"
OVERHEAD SIGN STRUCTURE WALKWAY TYPE S	Ln Ft	147'-L"
DRILLED SHAFT CONCRETE FOUNDATIONS	Cu Yds	

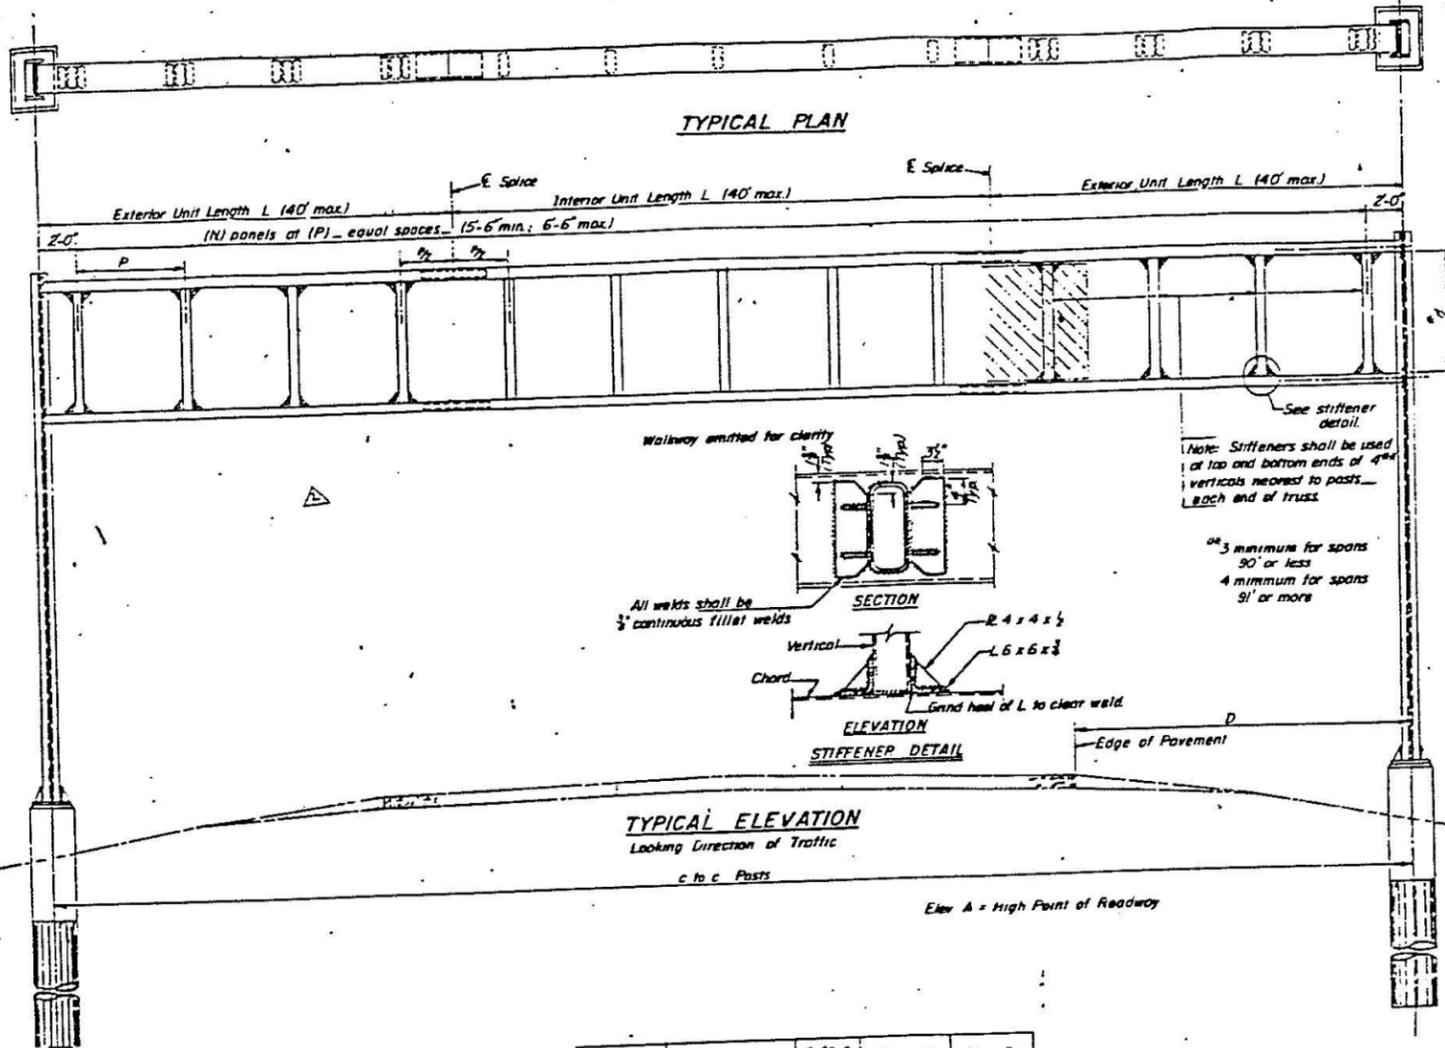

Structure No	Station	c to c Posts	Elev A	Dim. D
MB-S-1	79+60	82'-0"	20.4	16
MB-S-2	104+00	88'-0"	57.52	4
MB-S-3	131+25	56'-0"	57.89	8
MB-S-4	150+25	82'-0"	28.20	7
MB-S-5	181+91	92'-0"	55.72	4
MB-S-6	175+12	78'-0"	46.25	7
MB-S-7	185+00	88'-0"	44.54	16
MB-S-8	12+17	68'-0"	11.85	15
MB-S-9	209+50	42'-4"	3.20	10'-9"
EB-S-1	125+00	100'-0"	10.00	10
EB-S-2	150+00	100'-0"	10.00	10
EB-S-3	175+00	100'-0"	10.00	10
EB-S-36	1000+00	100'-0"	10.00	10

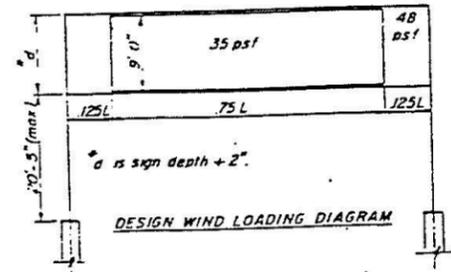

DESIGNED	EXAMINED	19
CHECKED	PASSED	
DRAWN	APPROVED	
CHECKED		

OS-S-1 SPECIAL

SHEET C-115 OF C-131

**OVERHEAD SIGN STRUCTURES
GENERAL PLAN & ELEVATION**

DAN RYAN EXPRESSWAY (I.A.1.90/94)
ROADWAY GRADING AND PAVING
CONSTRUCTION OF N.B. LANES

REVISED 11-23-87 Rev 12-9-87

11-16-87



USER NAME = charles.pigozzi	DESIGNED - HI, FL	REVISED -
PLOT SCALE = N.T.S	CHECKED - MAI, JJS	REVISED -
PLOT DATE = 1/24/2020	DRAWN - HI, FL	REVISED -
	CHECKED - MAI, JJS	REVISED -

STATE OF ILLINOIS
DEPARTMENT OF TRANSPORTATION

EXISTING RECORD DRAWINGS
VIERENDEEL TRUSS SIGN STRUCTURES

F.A.I. RTE.	SECTION	COUNTY	TOTAL SHEETS	SHEET NO.
90/94/290	2015-019R	COOK	2155	1074
CONTRACT NO. 62A76				

SHEET NO. SS124 OF SS129 SHEETS


ILLINOIS FED. AID PROJECT

FILE NAME: D:\V\AECOM-NA-AWS1\arecomonline\local\AECOM_ID502_NAD\Documents\01_Americas\Transportation\60269938_Circle\Phase_II\000_CAD\008_Structural\Sign_Structure\62A76-Vierendeel-SS123-SignStruct.dgn

11:40:04 AM

FOR INFORMATION ONLY




SHEET NO		SHEETS	
151	136	151	136

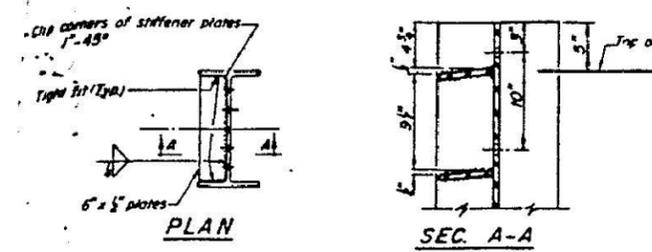

STATE OF ILLINOIS DEPARTMENT OF TRANSPORTATION


Span	Camber at Centerline	Chord	Vertical	Post	C-C CAMBOS
0 to 70'	4"	TS14x6x3/8	TS10x6x3/8	W24x104	"d+6"
71 to 80'	4"	TS14x6x3/8	TS10x6x3/8	W24x104	"d+6"
81 to 90'	6"	TS18x6x3/8	TS14x6x3/8	W24x104	"d+6"
91 to 100'	6"	TS18x6x3/8	TS14x6x3/8	W24x104	"d+6"
101 to 110'	6"	TS18x6x3/8	TS14x6x3/8	W24x104	"d+6"
111 to 124'	6"	TS18x6x3/8	TS14x6x3/8	W24x104	"d+6"

*d is sign depth = 2".
1985-080 R


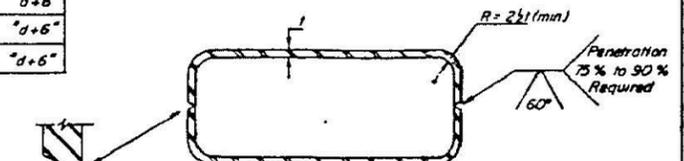
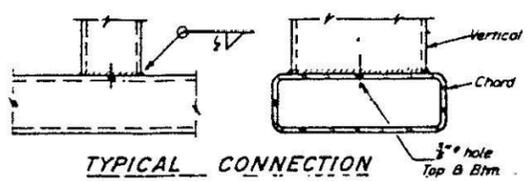
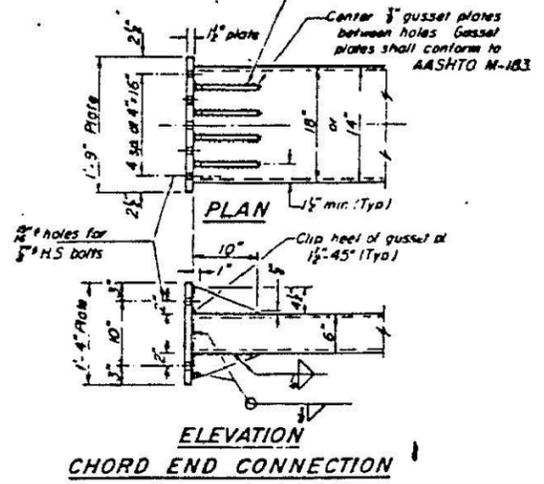


ALTERNATE BUILT-UP TUBE

Width, depth and thickness shall be as indicated for TS members indicated in table.

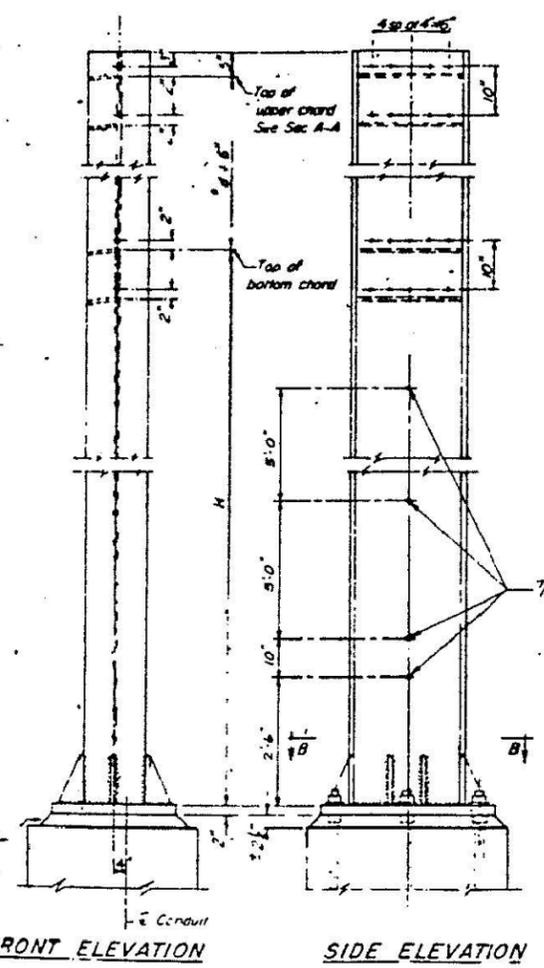

POST
W24x104

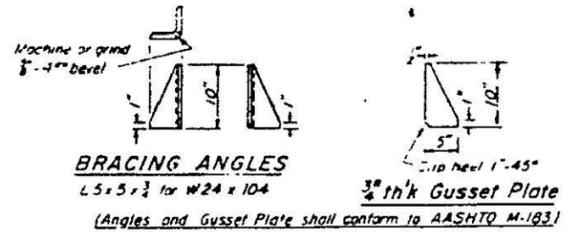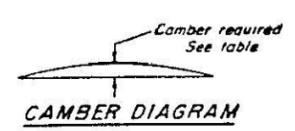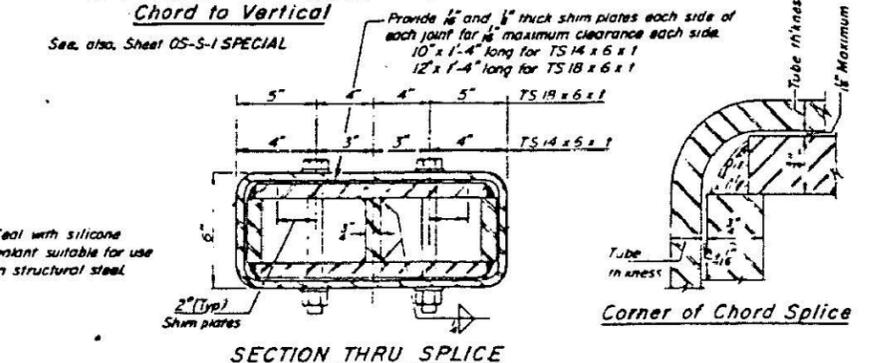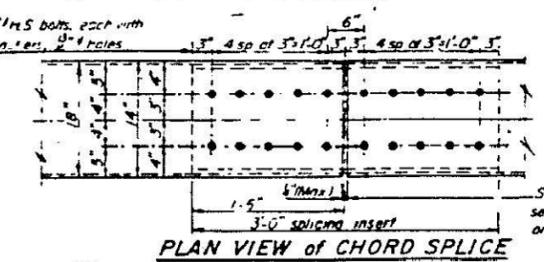

BRACING ANGLES
L5x5x3/8 for W24x104
(Angles and Gusset Plate shall conform to AASHTO M-183)

Structure No	Station	Span	Camber at E	Exterior Unit Lgth (L)	Interior Unit Lgth (L)	No. of Panels (N)	Panel Lgth (P)	Chord Size	Vertical Size	Post Size	LH Post Dim. H	RH Post Dim. H
NB-S-1	79+60	82'-0" 12'-2"	4"	31'-0"	31'-0"	8	6'-5 3/8"	TS14x6x3/8	TS10x6x3/8	W24x104	17'-11"	16'-11"
NB-S-2	101+40	88'-0" 12'-8"	4"	33'-0"	33'-0"	11	5'-7 5/8"	TS14x6x3/8	TS10x6x3/8	W24x104	15'-10"	16'-2"
NB-S-3	121+24	56'-0" 11'-2"	4"	28'-0"	28'-0"	9	5'-9 5/8"	TS14x6x3/8	TS10x6x3/8	W24x104	15'-5"	17'-1"
NB-S-4	153+35	83'-0" 12'-2"	6"	29'-1 1/2"	29'-1 1/2"	12	6'-0 1/2"	TS18x6x3/8	TS14x6x3/8	W24x104	17'-9"	15'-5"
NB-S-5	164+98	92'-0" 12'-8"	6"	34'-3 1/2"	34'-3 1/2"	15	5'-10 3/8"	TS18x6x3/8	TS14x6x3/8	W24x104	15'-10"	16'-2"
NB-S-6	175+12	78'-0" 12'-8"	4"	30'-3"	30'-3"	12	5'-8 13/16"	TS14x6x3/8	TS10x6x3/8	W24x104	15'-10"	16'-5"
NB-S-7	185+00	88'-0" 12'-2"	6"	33'-6 1/2"	33'-6 1/2"	15	5'-8 1/2"	TS18x6x3/8	TS14x6x3/8	W24x104	15'-11"	15'-7"
NB-S-8	12+17	80'-0" 10'-9"	4"	30'-0"	30'-0"	9	6'-2 5/8"	TS14x6x3/8	TS10x6x3/8	W24x104	18'-3"	15'-7"
NB-S-9	209+50	42'-4" 10'-8"	4"	21'-2"	21'-2"	7	5'-5 3/4"	TS14x6x3/8	TS10x6x3/8	W24x104	15'-10"	6'-5 1/4"
EB-S-2	11+52 RAMP			11'-2"	11'-2"							
EB-S-3	32+82 RAMP											
EB-S-1	8+... NB-531											
NB-S-10	83+88	66'-0"	4"	33'-0"	33'-0"	11	5'-7 5/8"	TS14x6x3/8	TS10x6x3/8	W24x104	17'-3"	15'-5"

SHEET C-116 OF C-131

OVERHEAD SIGN STRUCTURES POST and CHORD DETAILS

DAN RYAN EXPRESSWAY (I 90/94)
ROADWAY GRADING AND PAVING
CONSTRUCTION OF NB LANES

REVISION 2.5.88

DESIGNED	19
EXAMINED	
CHECKED	
PASSED	
APPROVED	



USER NAME	= charles.pigozzi
DESIGNED	- HI, FL
CHECKED	- MAI, JJS
REVISOR	-
PLOT SCALE	= N.T.S
DRAWN	- HI, FL
REVISOR	-
PLOT DATE	= 1/24/2020
CHECKED	- MAI, JJS
REVISOR	-

STATE OF ILLINOIS DEPARTMENT OF TRANSPORTATION

EXISTING RECORD DRAWINGS VIERENDEEL TRUSS SIGN STRUCTURES

SHEET NO. SS125 OF SS129 SHEETS



F.A.I. RTE.	SECTION	COUNTY	TOTAL SHEETS	SHEET NO.
90/94/290	2015-019R	COOK	2155	1075
CONTRACT NO. 62A76				

FILE NAME: D:\VIA\COM-NA-AWS1\arecomonline.local\AECOM_DS02_NAVDocuments\01_Americas\Transportation\60269938_Circle\Phase_I\0000_CAD\008_Structural\Sign_Structures\62A76_Vierendeel-SS124-SignStruct.dgn

FOR INFORMATION ONLY

STATE OF ILLINOIS
DEPARTMENT OF TRANSPORTATION


DATE	BY	NO.	REV.	SHEET NO.
9/0/84	COOK	151	137	
1985-080 R				

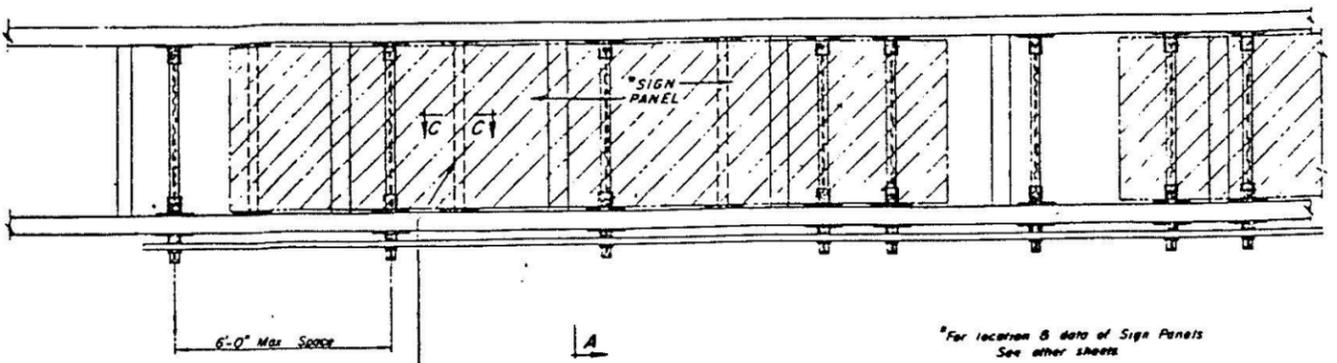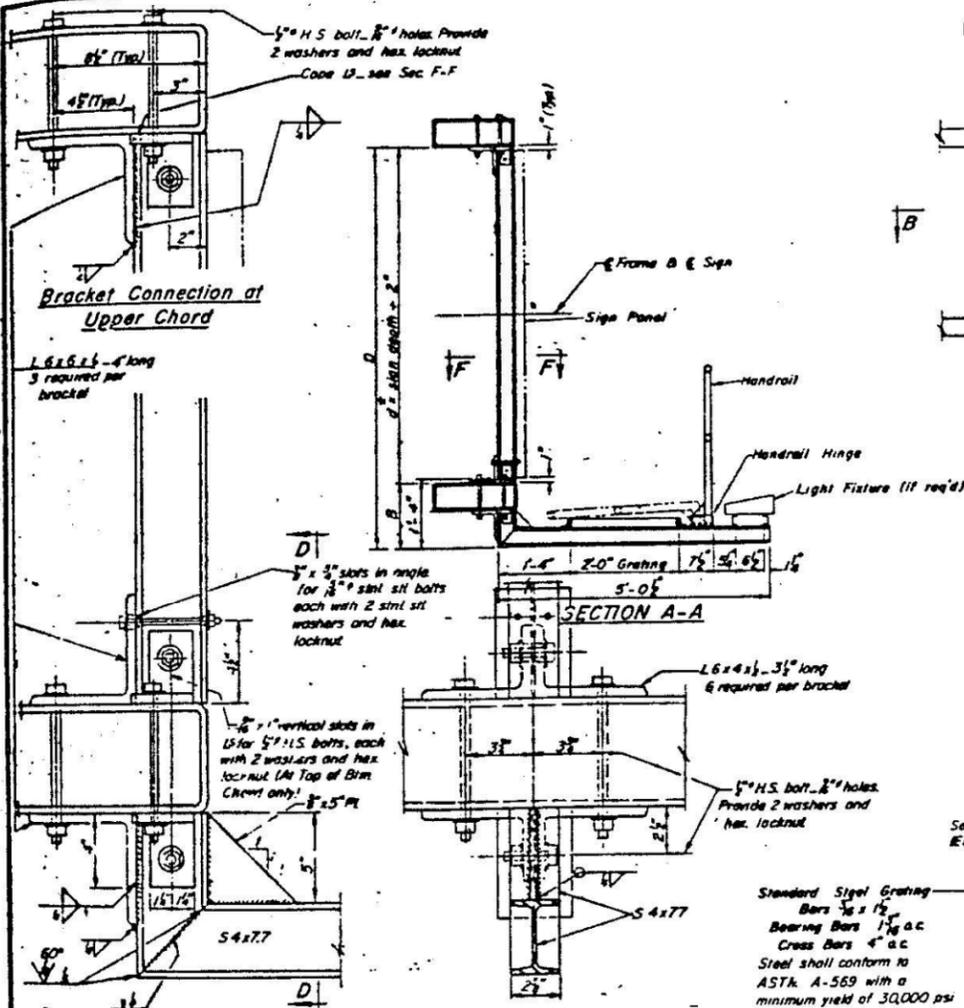


TYPICAL FRONT ELEVATION
(With Lights & Handrail omitted for clarity)

S 4x77
AASHTO M-183 Steel
Sign width — 0 — 10' incl. — 2 req'd
10' — 16' incl. — 3 req'd
16' — 22' incl. — 4 req'd
22' — 28' incl. — 5 req'd
28' — 34' incl. — 6 req'd

*For location & data of Sign Panels
See other sheets

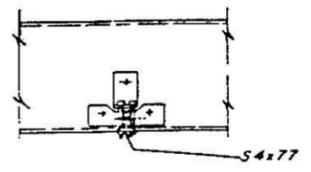

SEC C-C
(Similar to Walkway Bracket connection)

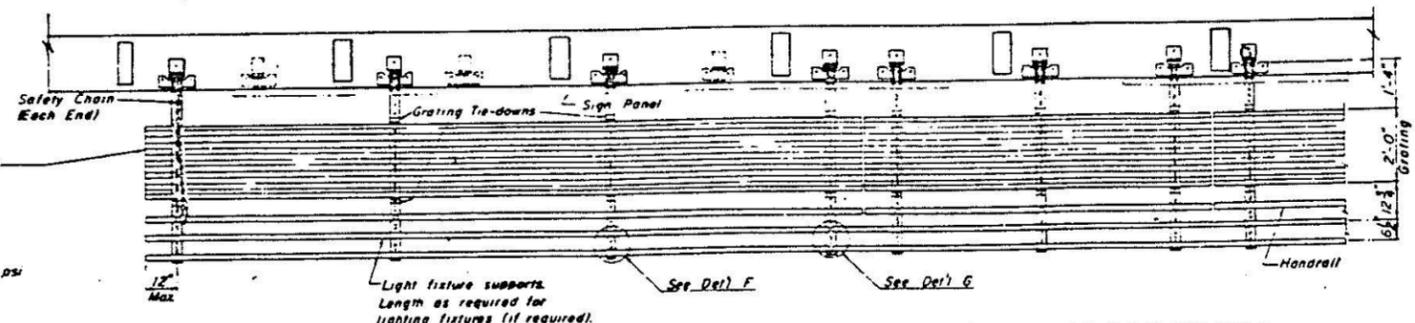


SECTION B-B

Note Handrail & Grating shall span a minimum of three brackets

Bracket Connection at Lower Chord
BRACKET DETAILS
NOTE Walkway brackets shall conform to requirements of AASHTO M-183

d = sign depth + 2'

Structure Number	Station	B	D	g
NB-5-1	79+60	7'-0"	13'-0"	12'-2"
NB-5-2	102+40	9'-0"	11'-0"	12'-8"
NB-5-3	102+24	7'-0"	12'-5"	11'-2"
NB-5-4	150+35	7'-0"	14'-8"	13'-2"
NB-5-5	180+98	7'-0"	16'-0"	12'-8"
NB-5-6	175+12	7'-0"	13'-0"	12'-0"
NB-5-7	185+00	7'-0"	13'-0"	13'-2"
NB-5-8	12+17	7'-0"	11'-0"	10'-8"
NB-5-9	209+50	7'-0"	11'-0"	10'-8"
EB-5-1	111+55	7'-0"	11'-0"	10'-8"
EB-5-2	93+05	1'-0"	11'-0"	10'-8"

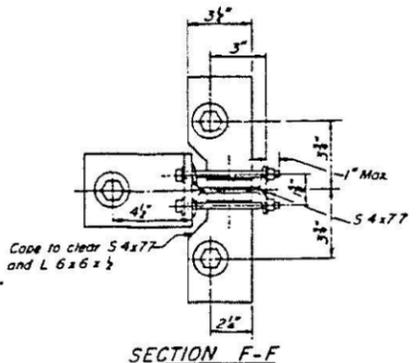

SECTION F-F

OVERHEAD SIGN STRUCTURES
STEEL WALKWAY DETAILS

DAN RYAN EXPRESSWAY (F A 190/94)
ROADWAY GRADING AND PAVING
CONSTRUCTION OF N.B. LANES

SHEET C-117 OF C-131

REVISION 2-5-88

11-12-87

DESIGNED	CHARLES PIGOZZI	DESIGNED	HI, FL
CHECKED		CHECKED	MAI, JJS
APPROVED		APPROVED	MAI, JJS

OS-S-3-SPECIAL



USER NAME =	charles.pigozzi	DESIGNED -	HI, FL	REVISED -	
PLOT SCALE =	N.T.S	CHECKED -	MAI, JJS	REVISED -	
PLOT DATE =	1/24/2020	DRAWN -	HI, FL	REVISED -	
		CHECKED -	MAI, JJS	REVISED -	

STATE OF ILLINOIS
DEPARTMENT OF TRANSPORTATION

EXISTING RECORD DRAWINGS
VIERENDEEL TRUSS SIGN STRUCTURES

SHEET NO. SS126 OF SS129 SHEETS


F.A.I. RTE.	SECTION	COUNTY	TOTAL SHEETS	SHEET NO.
90/94/290	2015-019R	COOK	2155	1076
CONTRACT NO. 62A76				

ILLINOIS FED. AID PROJECT

FOR INFORMATION ONLY

STATE OF ILLINOIS DEPARTMENT OF TRANSPORTATION

DATE	BY	NO.	REVISED	SHEET NO.
9/9/9	COOK	151	138	138
				SHEETS

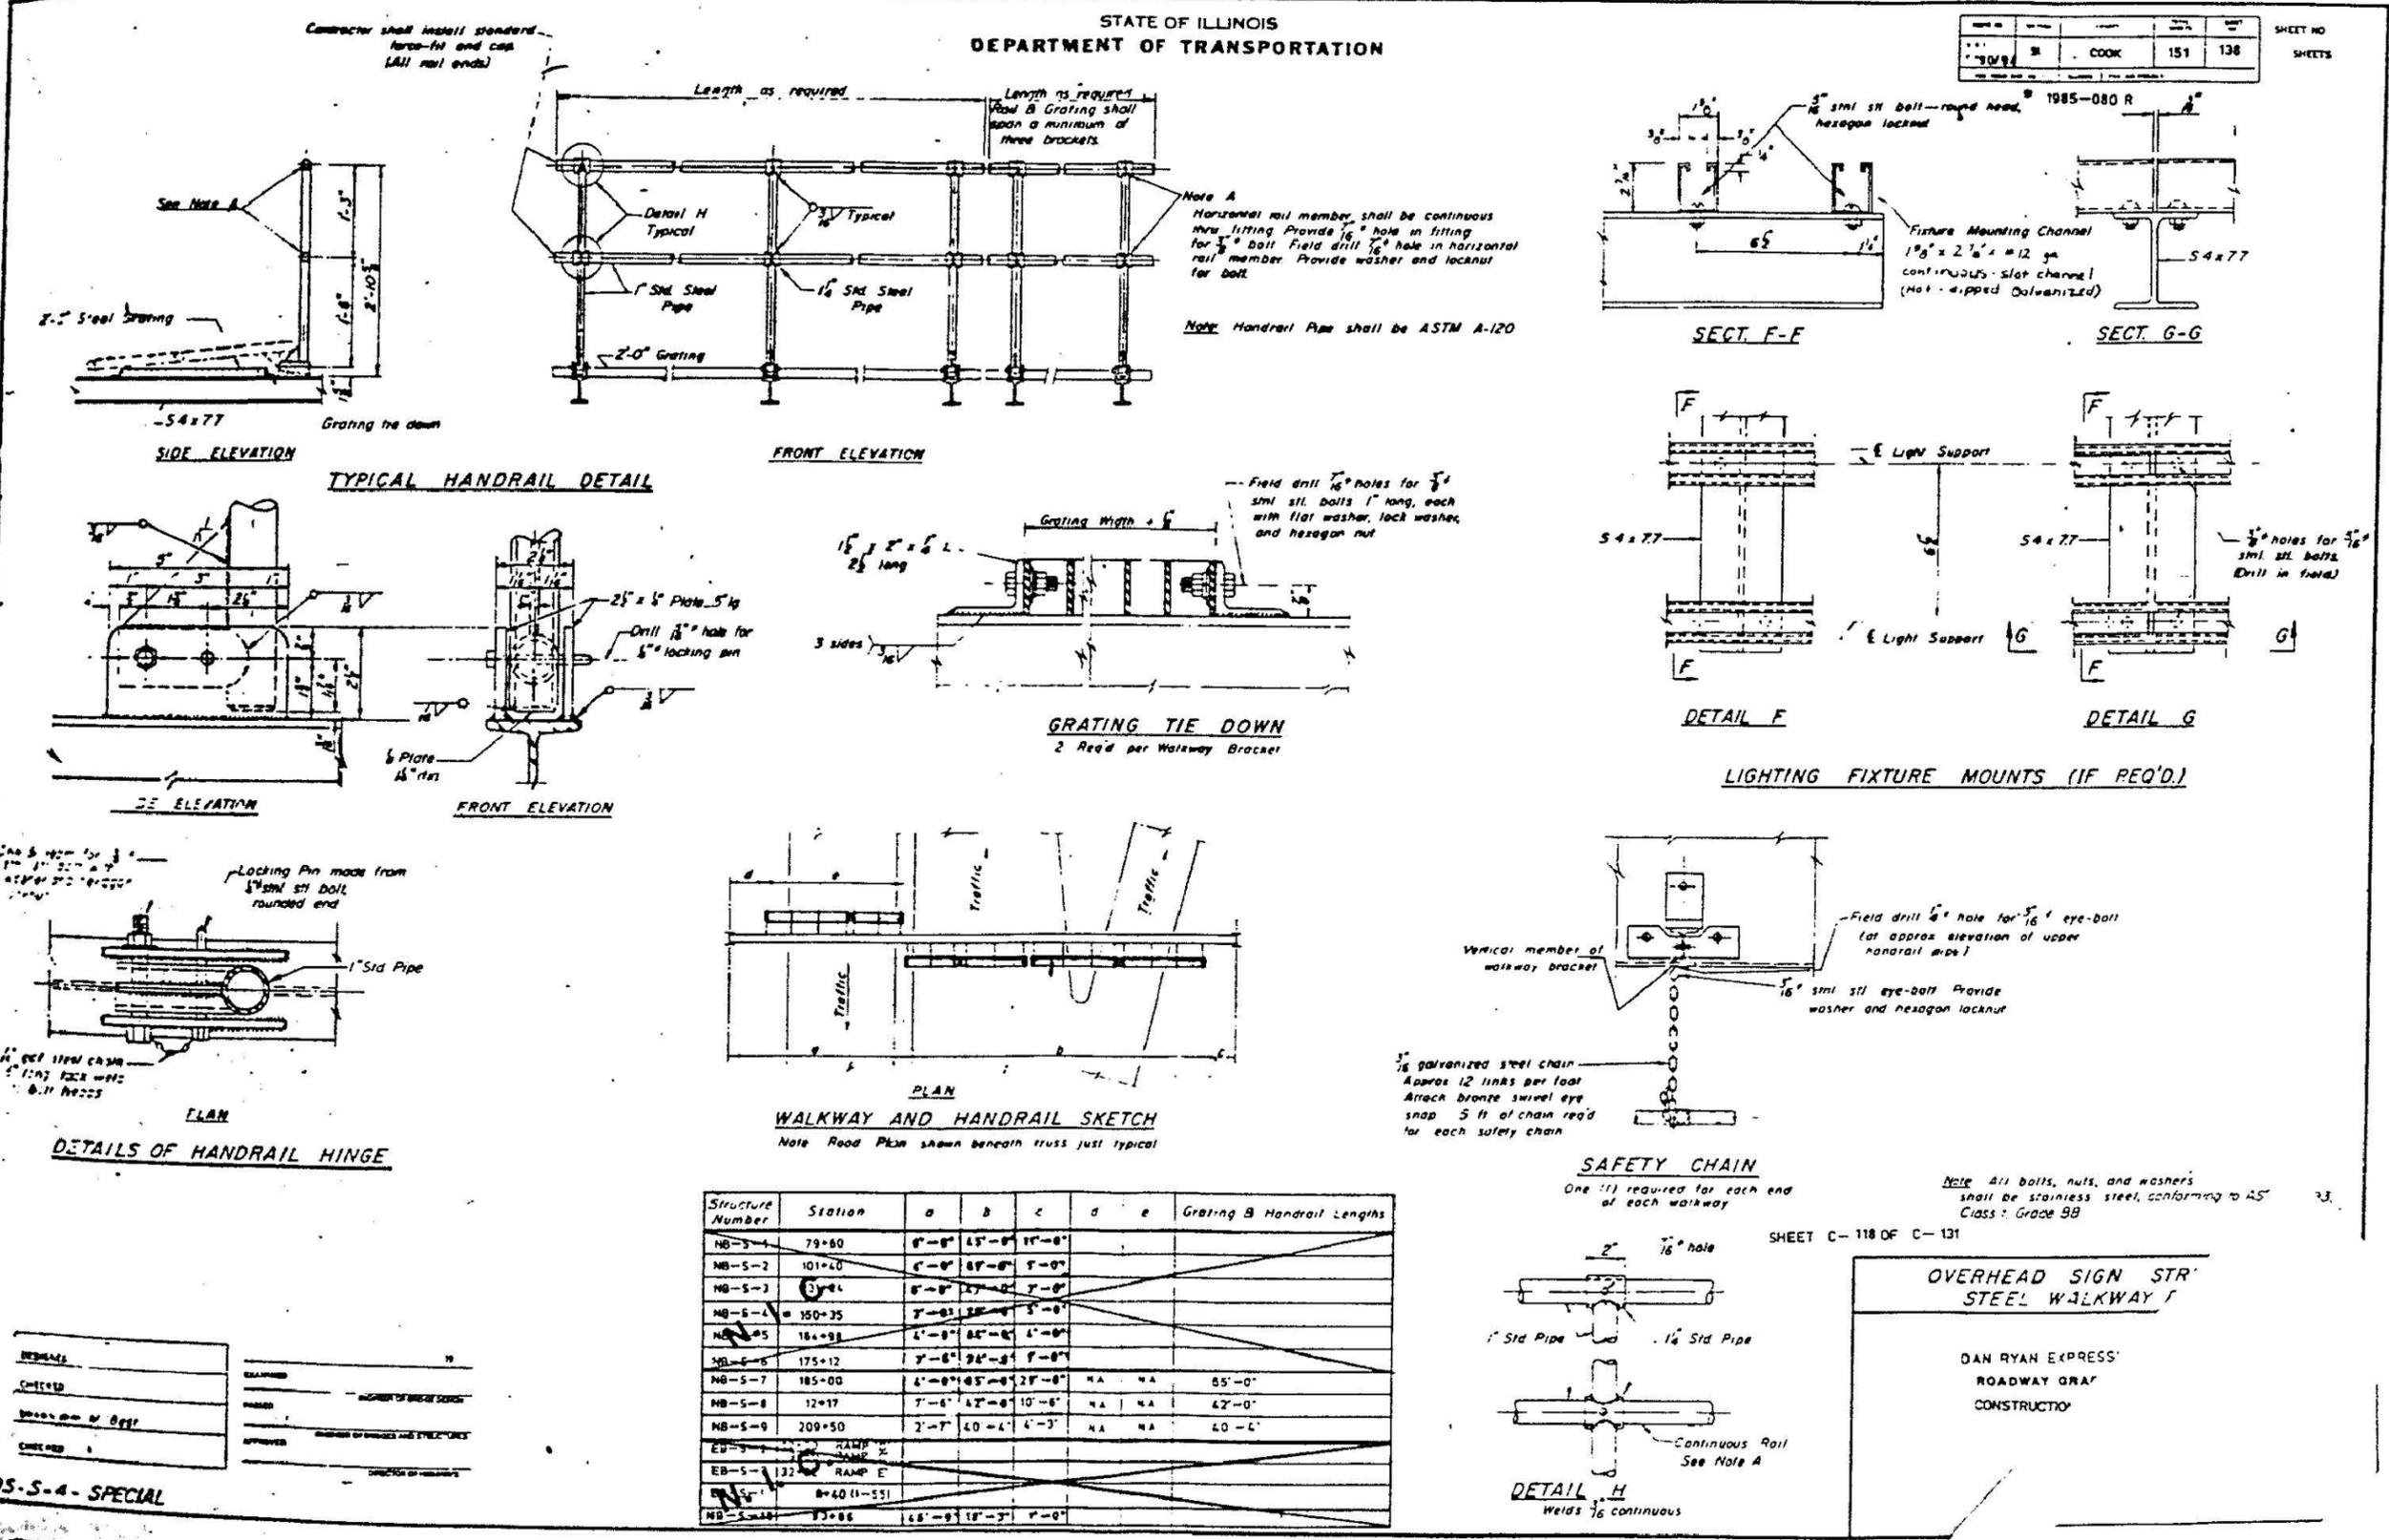

Structure Number	Station	a	b	c	d	e	Grating B Handrail Lengths
NB-5-1	79+60	8'-0"	6'-0"	11'-0"			
NB-5-2	101+40	8'-0"	8'-0"	5'-0"			
NB-5-3	117+64	8'-0"	2'-0"	7'-0"			
NB-5-4	150+35	7'-0"	2'-0"	5'-0"			
NB-5-5	164+98	4'-0"	8'-0"	4'-0"			
NB-5-6	175+12	7'-0"	9'-0"	9'-0"			
NB-5-7	185+00	4'-0"	8'-0"	2'-0"	NA	NA	85'-0"
NB-5-8	12+17	7'-0"	4'-0"	10'-0"	NA	NA	42'-0"
NB-5-9	209+50	2'-0"	4'-0"	4'-3"	NA	NA	40'-0"
EB-5-1	122						
EB-5-2	132						
EB-5-3	140 (1-55)						
NB-5-10	83+86	16'-0"	1'-0"	7'-0"			

DESIGNED	CHARLES PIGOZZI	CHECKED	MAI JJS
DRAWN	HI, FL	APPROVED	MAI JJS
DATE	1/24/2020		

OS-S-4 - SPECIAL



USER NAME	charles.pigozzi	DESIGNED	HI, FL	REVISED	-
PLOT SCALE	N.T.S	CHECKED	MAI, JJS	REVISED	-
PLOT DATE	1/24/2020	DRAWN	HI, FL	REVISED	-
		CHECKED	MAI, JJS	REVISED	-

STATE OF ILLINOIS DEPARTMENT OF TRANSPORTATION

EXISTING RECORD DRAWINGS VIERENDEEL TRUSS SIGN STRUCTURES

SHEET NO. SS127 OF SS129 SHEETS

F.A.I. RTE.	SECTION	COUNTY	TOTAL SHEETS	SHEET NO.
90/94/290	2015-019R	COOK	2155	1077
CONTRACT NO. 62A76				

ILLINOIS FED. AID PROJECT

FILE NAME: D:\V\AE\COM-NA-AW51\ae\comonline\local\AE\COM_DS02_NAVDocuments\01_Americas\Transportation\60269938_Circle\Phase_I\0000_CAD\008_Structural\Sign_Structure\62A76-Vierendeel-SS126-SignStruct.dgn



FOR INFORMATION ONLY

STATE OF ILLINOIS
DEPARTMENT OF TRANSPORTATION


DESIGNED BY	SECTION	COUNTY	TOTAL SHEETS	SHEET NO.
40194	COOK	151	139	

SHEETS

* 1985-080 R

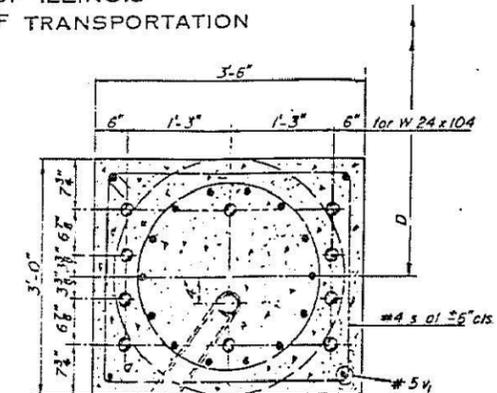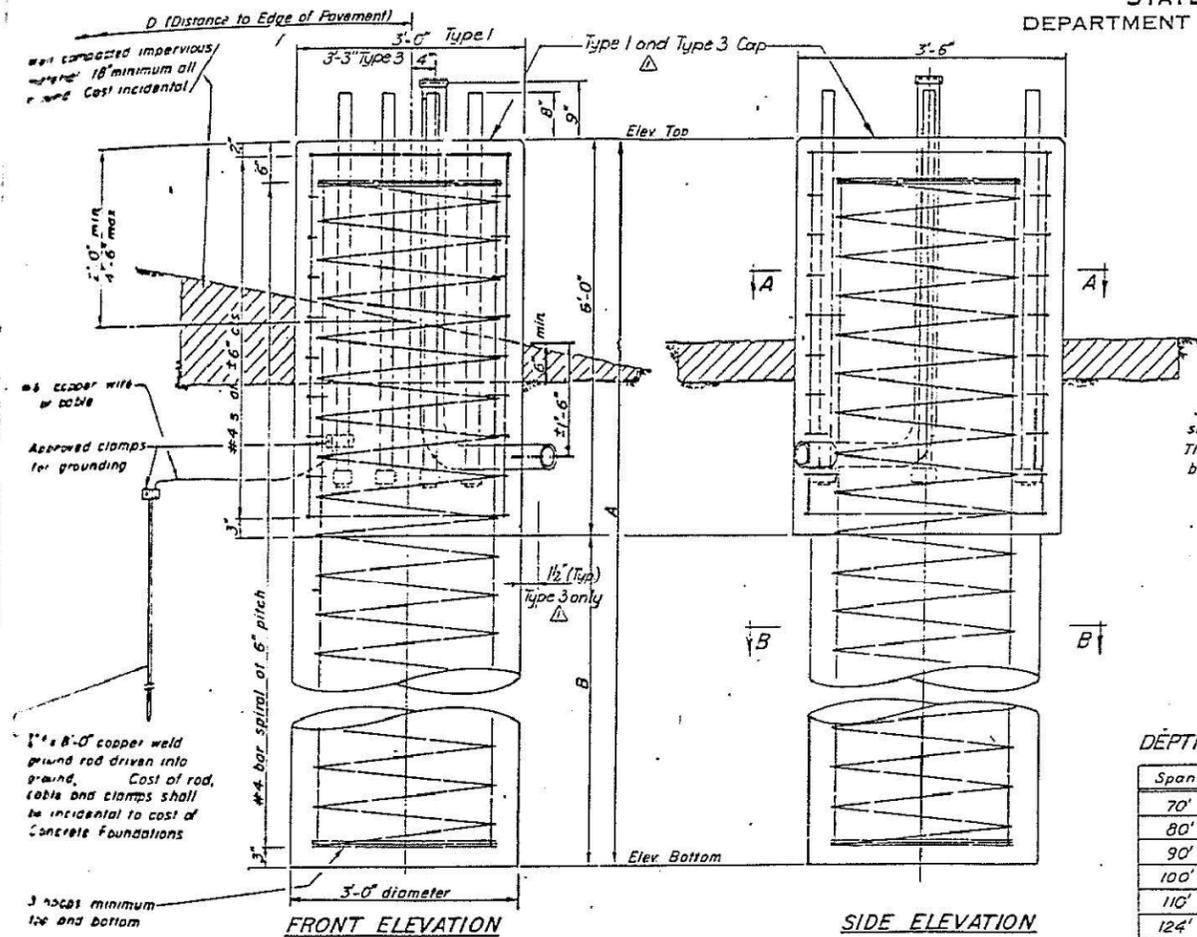

NOTE: The anchor bolts and reinforcing cage must be in place before pouring concrete, and shall be adjusted for proper placement of anchor bolts as shown.

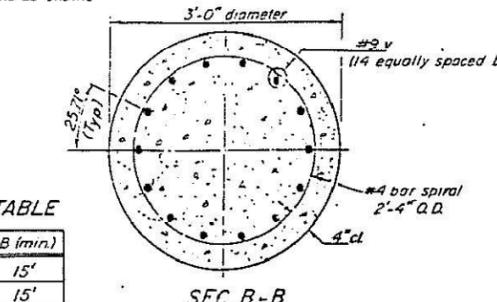


DEPTH TABLE

Span	B (min)
70'	15'
80'	15'
90'	16'
100'	17'
110'	18'
124'	20'

NOTES:
The foundation details shown are for Average Cohesive Soil Conditions (stiff clays, sandy clays) and with minimum $Q_u = 1.0 \text{ Tons/Sq. Ft.}$ "Qu" being the average value of hand penetrometer readings at various depths of the shaft as determined by the Engineer at time of drilling operations or previous soil investigation.


- Top of retaining wall #6, See Volume #4, Sheet RNB
- See detail C this sheet
- Type 2 Cap only
- To be determined in field.
- Type 1 Cap only

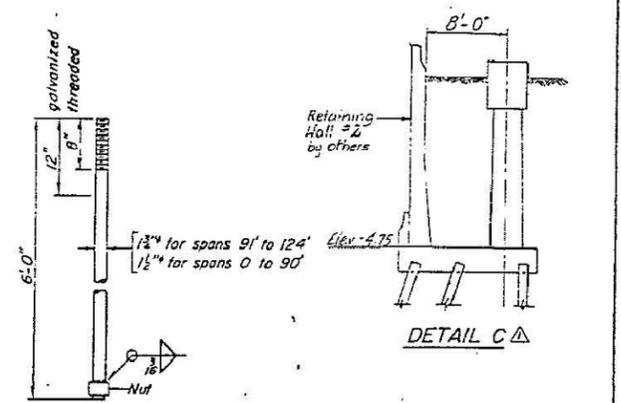

ANCHOR BOLT DETAILS
(ASTM A-576, $f_y = 55,000 \text{ psi.}$)
Galvanize upper 12" in accordance with AASHTO M 232.
Provide 3 nuts and 1 washer for each anchor bolt.

L. BAR LIST - EACH FOUNDATION

Bar	No	Size	Lath	Shape
1	12	#4	11'-9"	□
2	14	#9	B(5'-7")	—
3	4	#5	5'-3"	—
4	8	#5	6'-2"	—
#4 bar spiral - see Front Elevation				
u1	10	#4	8'-2"	—
s1	7	#4	14'-9"	□

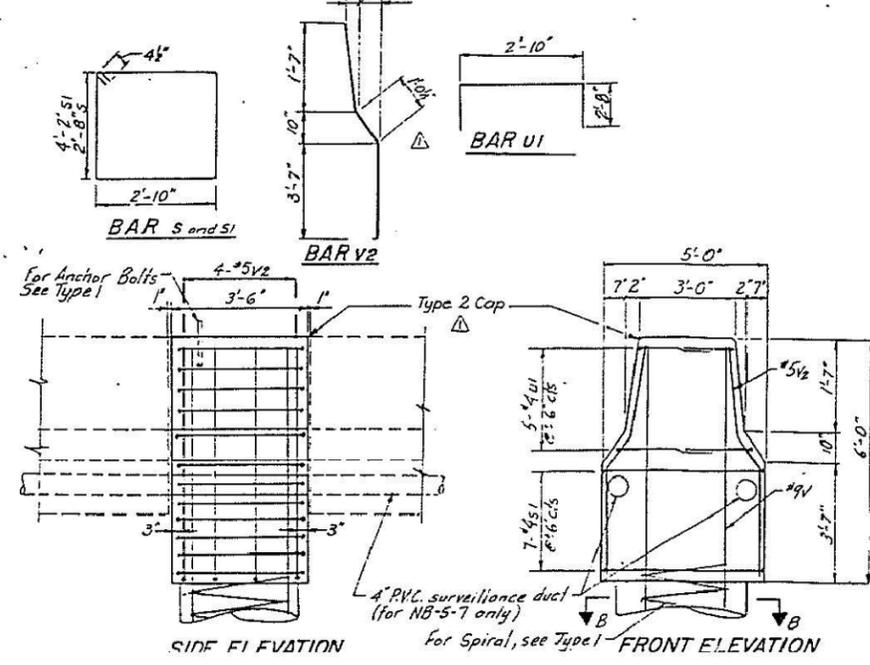

Structure No	Station	B	Anchor Bolt Size	Left Foundation			Right Foundation			Class X Concrete
				Elev. Top	Elev. Btm.	Cap Type	Elev. Top	Elev. Btm.	Cap Type	
NB-S-1	79+60			20.83			22.44			
NB-S-2	101+40			64.88			64.67			
NB-S-3	131+24			50.69			59.03			
NB-S-4	150+36			39.57			41.90			
NB-S-5	181+98			57.41			57.07			
NB-S-6	175+12			48.64			48.85			
NB-S-7	185+00			16.74		3	17.01		23.4	
NB-S-8	12+17			12.52		1	14.27		23.2	
NB-S-9	209+50			6.11		2	15.52		12.9	
EB-S-2	122+00									
EB-S-3	328+82									
EB-S-4	87+0									
NB-S-10	272+00			54.85						

DESIGNED: _____
CHECKED: _____
DRAWN: _____
CHECKED: _____

EXAMINED: _____
PASSED: _____
APPROVED: _____

19

OS-S-5-SPECIAL

SHEET C-119 OF C-131

DRILLED SHAFT FOUNDATION DETAILS

Rev. 11-23-87

OVERHEAD SIGN STRUCTURES FOUNDATION DETAILS

DAN RYAN EXPRESSWAY (I.A.1.90/94)
ROADWAY GRADING AND PAVING
CONSTRUCTION OF N.B. LANES



USER NAME = charles.pigozzi	DESIGNED - HI, FL	REVISED -
PLOT SCALE = N.T.S	CHECKED - MAI, JJS	REVISED -
PLOT DATE = 1/24/2020	DRAWN - HI, FL	REVISED -
	CHECKED - MAI, JJS	REVISED -

STATE OF ILLINOIS
DEPARTMENT OF TRANSPORTATION

EXISTING RECORD DRAWINGS
VIERENDEEL TRUSS SIGN STRUCTURES

F.A.I. RTE.	SECTION	COUNTY	TOTAL SHEETS	SHEET NO.
90/94/290	2015-019R	COOK	2155	1078
CONTRACT NO. 62A76				

SHEET NO. SS128 OF SS129 SHEETS


ILLINOIS FED. AID PROJECT

FILE NAME: D:\V\AE\COM-NA-AWS1\ae\comonline\local\AE\COM_D502_NAV\Documents\01_Americas\Transportation\60269938_Circle\Phase\Structural\Sign_Structures\62A76-Vierendeel-SS127-SignStruct.dgn


11:40:58 AM

FOR INFORMATION ONLY


SECTION	COUNTY	TOTAL SHEETS	SHEET NO.
90/94	COOK	151	128
STA. TO STA.		FED. AID PROJECT	
1985-080 R			

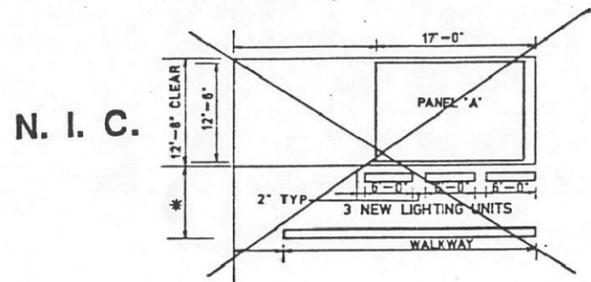


STA. 165+08 N.B.
NB-C-6

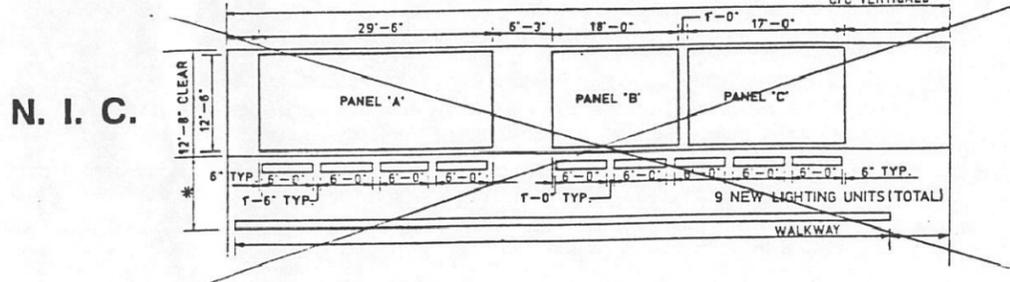


STA. 175+12 N.B.
NB-S-6

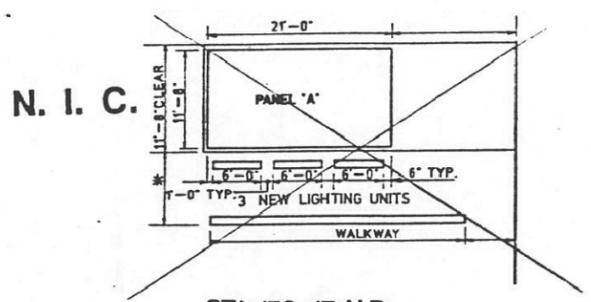

STA. 179+17 N.B.
NB-C-7

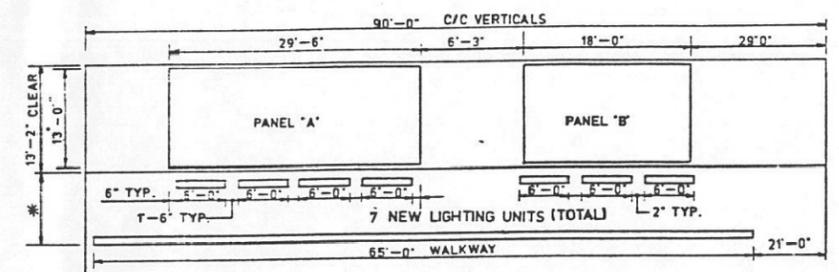


STA. 185+00 N.B.
NB-S-7

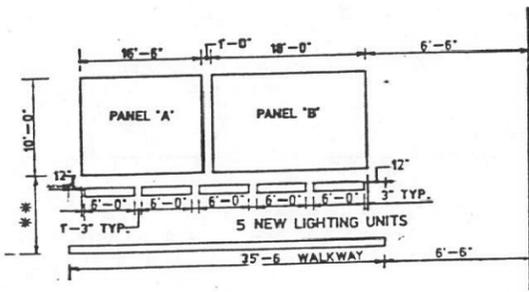

STA. 189+80 N.B.
NB-BM-3

** 1'-5" MIN.
BOTTOM OF SIGN
TO BOTTOM OF
WALKWAY

* 1'-3" MIN.
BOTTOM OF TRUSS
TO BOTTOM OF
WALKWAY

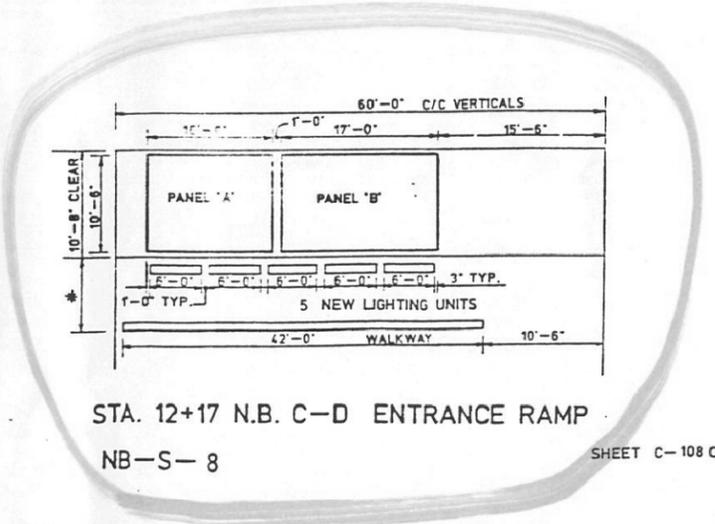

STA. 12+17 N.B. C-D ENTRANCE RAMP
NB-S-8

SHEET C-108 OF C-131

ILLINOIS DEPARTMENT OF TRANSPORTATION
DAN RYAN EXPRESSWAY (F.A.I. 90/94)
ROADWAY GRADING AND PAVING
SIGN PANEL AND
LIGHT FIXTURE PLACEMENT
CONSTRUCTION OF N.B. LANES
SCALE: VERT.
HORIZ.
DATE

KAM ENGINEERING, INC.
707A Davis Road • Elgin, Illinois • 60120-1372

HBM
ENGINEERING GROUP, LLC

USER NAME = charles.pigozzi	DESIGNED - HI, FL	REVISED -
PLOT SCALE = N.T.S	CHECKED - MAI, JJS	REVISED -
PLOT DATE = 1/24/2020	DRAWN - HI, FL	REVISED -
	CHECKED - MAI, JJS	REVISED -

STATE OF ILLINOIS
DEPARTMENT OF TRANSPORTATION

EXISTING RECORD DRAWINGS
VIERENDEEL TRUSS SIGN STRUCTURES

F.A.I. RTE. 90/94/290	SECTION 2015-019R	COUNTY COOK	TOTAL SHEETS 2155	SHEET NO. 1079
CONTRACT NO. 62A76				

SHEET NO. SS129 OF SS129 SHEETS

ILLINOIS FED. AID PROJECT

FILE NAME: D:\VIA\COM-NA-AW51\aecononline.local\AECON_ID502_NAVDocuments\01_Americas\Transportation\60269938_Circle\Phase_I\0000_CAD\008_Structural\Sign_Structures\62A76_Sign_Structure\62A76_Vierendeel-SS128-SignStruct.dgn

11:41:11 AM

FILE PATH = p:\VACOM\NA-ANSI\encom\local\AECOM_DS02_NA\Documents\01_Americas\Transportation\62676\62676-Contract\0162676-sht-Light-01

	LIGHT TOWER: LED LUMINAIRES, TYPE I NUMBER INDICATES TOWER TYPE
	TYPE TOWER HEIGHT 13 - 130 FEET 15 - 150 FEET
	LIGHTING UNIT: TYPE AS INDICATED
	47'-6" M.H., 6 FT. DAVIT ARM LED M-C-III LUMINAIRE. MOUNTED ON PARAPET WALL
	47'-6" M.H., 12 FT. DAVIT ARM LED M-C-III LUMINAIRE. MOUNTED ON PARAPET WALL
	47'-6" M.H., 2-6 FT. DAVIT ARM 2-LED M-C-III LUMINAIRE. MOUNTED ON PARAPET WALL
	TEMPORARY LED LUMINAIRE AND POLE; 80 FOOT WOOD POLE
	TEMPORARY LIGHTING UNIT: 80 FOOT WOOD POLE WITH FOUR TYPE I LED HIGH MAST LUMINAIRE
	UNDERPASS LUMINAIRE: LED, TYPE AS SHOWN ON PLANS (PRIMARY DISTRIBUTION PATTERN DIRECTION AS INDICATED BY ARROW)
	MANHOLE
	ELECTRIC HANDHOLE: TYPE AS INDICATED TYPE E1: PRECAST CONCRETE, 21.5"x21.5"x30", IDOT STANDARD 814001 TYPE E2: PRECAST CONCRETE-HEAVY DUTY, 22"x22"x30", IDOT STANDARD 814001 TYPE C1: COMMUNICATIONS VAULT, 49 5/8"x32 1/8"x57" TYPE S1: PRECAST CONCRETE-HEAVY DUTY, 22"x22"x36" TYPE S2: PRECAST CONCRETE-HEAVY DUTY SPECIAL, 30"x30"x36"
	DOUBLE ELECTRIC HANDHOLE
	JUNCTION BOX: TYPE AND SIZE AS INDICATED ON PLANS
	PULL BOX: TYPE AND SIZE AS INDICATED ON PLANS
	TELEPHONE CONNECTION
	FIBER OPTIC COMMUNICATIONS HUT
	EXISTING LIGHT TOWER
	EXISTING LIGHTING UNIT, TWIN LUMINAIRE
	EXISTING LIGHTING UNIT
	EXISTING TEMPORARY LIGHTING UNIT
	EXISTING CDOT LIGHTING UNIT
	EXISTING UNDERPASS LUMINAIRE
	EXISTING ELECTRIC MANHOLE
	EXISTING ELECTRIC HANDHOLE
	EXISTING JUNCTION BOX
	EXISTING PULL BOX
	EXISTING TELEPHONE CONNECTION
	EXISTING FIBER OPTIC COMMUNICATIONS HUT
	EXISTING ELECTRIC HANDHOLE/MANHOLE
	EXISTING CDOT SURVEILLANCE CABINET

ELECTRICAL SYMBOLS FOR PROPOSED WORK


	4	LIGHTED SIGN STRUCTURE-CANTILEVER TYPE (NUMBER OF FLUORESCENT FIXTURES AS INDICATED - TYP.)
	6	LIGHTED SIGN STRUCTURE-TRUSS TYPE
	6	LIGHTED SIGN STRUCTURE-BRIDGE MOUNT TYPE
		DYNAMIC MESSAGE SIGN
	FBS	FLASHING BEACON SIGN
	C	CLOSED CIRCUIT TELEVISION CAMERA
	M	MICROWAVE DETECTOR
	OR	DETECTOR LOOP
		CONTROLLER CABINET: LIGHTING, RADIO CONTROL DUPLEX TYPE WITH SCADA (DOOR SIDE AS INDICATED)
		CONTROLLER CABINET: SURVEILLANCE
		CONTROLLER CABINET: SURVEILLANCE, TYPE 334
		RAMP METER SIGNAL POLE/HEAD
		RAMP METER FLASHER POST
	T80	TEMPORARY WOOD POLE, LENGTH AS INDICATED ON THE PLANS
	ER	RELOCATED TEMPORARY WOOD POLE
	HAR	HIGHWAY ADVISORY RADIO ANTENNA
		ELECTRIC UTILITY POLE
		CCTV CAMERA POLE
		POLE MOUNTED ELECTRIC UTILITY TRANSFORMER(S)

ELECTRICAL SYMBOLS FOR EXISTING CONDITIONS

	C	EXISTING CDOT ELECTRIC HANDHOLE/MANHOLE
	E	EXISTING LIGHTED SIGN STRUCTURE- CANTILEVER TYPE
	E	EXISTING LIGHTED SIGN STRUCTURE-TRUSS TYPE
	E	EXISTING LIGHTED SIGN STRUCTURE- BRIDGE MOUNT TYPE
	E	EXISTING DYNAMIC MESSAGE SIGN
	FBS	EXISTING FLASHING BEACON SIGN
	C	EXISTING CLOSED CIRCUIT TELEVISION CAMERA
	M	EXISTING MICROWAVE DETECTOR
	E	EXISTING DETECTOR LOOP
	E	EXISTING LIGHTING CONTROLLER, DUPLEX
	E	EXISTING CONTROLLER CABINET

		PAD MOUNTED ELECTRIC UTILITY TRANSFORMER
		GROUND ROD
		MAIN SERVICE FUSED DISCONNECT SWITCH (RATING AS INDICATED)
	PC	PHOTOCELL
		AERIAL CABLE
		FLEXIBLE CONDUIT
		RACEWAY EMBEDDED IN STRUCTURE
		EXPOSED CONDUIT
		RACEWAY OR DIRECT BURIAL CABLE UNDERGROUND WITHOUT ENCASEMENT
		TYPE AS SHOWN ON PLANS CONDUIT SLEEVE, INSTALLED BELOW PAVEMENT
		UNDERGROUND REINFORCED CONCRETE ENCASED CONDUIT DUCTBANK, UNLESS NOTED OTHERWISE. (NUMBER, TYPE, AND SIZE OF DUCTS AS SHOWN)
		CONDUIT TURNED DOWN
		CONDUIT TURNED UP
		EXISTING RAMP METER FLASHER
	HAR	EXISTING HIGHWAY ADVISORY RADIO ANTENNA
	E	EXISTING CCTV CAMERA POLE
	E	EXISTING UTILITY SERVICE CONNECTION, POLE MOUNTED
	E	EXISTING UTILITY SERVICE CONNECTION, PAD MOUNTED
	E	EXISTING CONCEALED CONDUIT IN STRUCTURE
	E	EXISTING EXPOSED CONDUIT
	E	EXISTING RACEWAY OR DIRECT BURIED CABLE WITHOUT ENCASEMENT
	E	EXISTING CONCEALED CONDUIT UNDERGROUND, TRENCHED OR PUSHED
	E	EXISTING ELECTRIC CABLE IN CONDUIT SLEEVE
	A	EXISTING AERIAL CABLE TO REMAIN
	E	EXISTING ELECTRICAL EQUIPMENT TO BE ABANDONED

GENERAL ELECTRICAL CALLOUTS

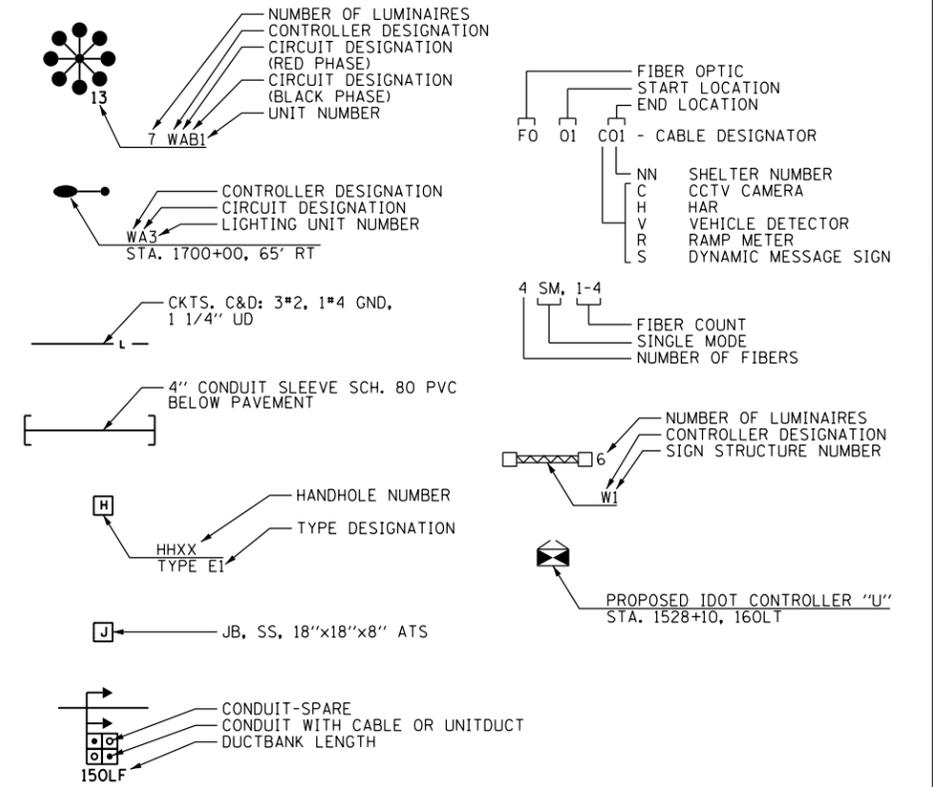

TYPICAL EXISTING TO BE REMOVED SYMBOLS

	R	EXISTING LIGHTING UNIT TO BE REMOVED AND NO SALVAGE
	R	EXISTING UNDERPASS LUMINAIRE TO BE REMOVED AND NO SALVAGE
	R	EXISTING JUNCTION BOX TO BE REMOVED
	R	EXISTING LIGHTED SIGN STRUCTURE- CANTILEVER TYPE TO BE REMOVED
	R	DYNAMIC MESSAGE SIGN TO BE REMOVED
	FBS	FLASHING BEACON SIGN TO BE REMOVED
	R	EXISTING LIGHTING CONTROLLER, DUPLEX TO BE REMOVED
	R	EXISTING CONTROLLER CABINET TO BE REMOVED
	R	EXISTING DETECTOR LOOP TO BE REMOVED
	R	EXISTING RAMP METER SIGNAL POLE/HEAD TO BE REMOVED
	R	EXISTING RAMP METER FLASHER TO BE REMOVED
	R	EXISTING POLE MOUNTED UTILITY SERVICE CONNECTION TO BE REMOVED
	R	EXISTING LIGHT TOWER, PAD, AND FOUNDATION TO BE REMOVED AND NO SALVAGE
	R	EXISTING TEMPORARY LIGHTING UNIT TO BE REMOVED AND LUMINAIRE SALVAGED TO IDOT
	R	EXISTING SIGN LUMINAIRE TO BE REMOVED AND NO SALVAGE



D162A76-sht-Light-01	DESIGNED - TJL	REVISED -
USER NAME = myersc	DRAWN - CAM	REVISED -
PLOT SCALE = 2,0000' / in.	CHECKED - WDS	REVISED -
PLOT DATE = 3/2/2020	DATE - 3/4/20	REVISED -

STATE OF ILLINOIS
DEPARTMENT OF TRANSPORTATION

IDOT ELECTRICAL SYMBOLS

SCALE: N.T.S. SHEET 1 OF 33 SHEETS STA. TO STA.

F.A.I. RTE.	SECTION	COUNTY	TOTAL SHEETS	SHEET NO.
90/94/290	2015-D18R	COOK	2155	1080
CONTRACT NO. 62A76				
ILLINOIS FED. AID PROJECT				

NOTES:

1. SEE DRAWING E-01 FOR IDOT ELECTRICAL SYMBOLS.
2. THE EXISTING ELECTRICAL SYSTEMS, AS DEPICTED ON THE PLANS, ARE INTENDED TO INDICATE THE GENERAL EQUIPMENT INSTALLATIONS INVOLVED AND SHALL NOT BE CONSTRUED AS AN EXACT REPRESENTATION OF THE FIELD CONDITIONS. IT IS THE CONTRACTOR'S RESPONSIBILITY TO CONFIRM AND ASCERTAIN THE EXACT CONDITION, SIZE, TYPE, QUANTITY AND LOCATION OF THE EXISTING ELECTRICAL EQUIPMENT. ANY DISCREPANCIES BETWEEN THE ACTUAL EXISTING ELECTRICAL EQUIPMENT IN THE FIELD AND THE DEPICTION OF THE EXISTING ELECTRICAL EQUIPMENT SHOWN ON THE PLANS SHALL IMMEDIATELY BE BROUGHT TO THE ATTENTION OF THE RESIDENT ENGINEER FOR RESOLUTION. FAILURE TO VERIFY THE CONDITIONS, DIMENSIONS AND DETAILS OF THE EXISTING ELECTRICAL EQUIPMENT TO CONFIRM THAT THE NEW EQUIPMENT IS COMPATIBLE WITH THE EXISTING EQUIPMENT AND CAN BE PROPERLY INSTALLED AND CONNECTED AS SHOWN ON THE PLANS WILL NOT RELIEVE THE CONTRACTOR OF THEIR RESPONSIBILITY FOR PROVIDING A SAFE, COMPLETE AND FULLY FUNCTIONAL ELECTRICAL SYSTEM.
3. ALL WORK SHOWN ON THIS DRAWING MUST BE COORDINATED WITH THIS CONTRACT'S CONSTRUCTION WORK AND STAGING.
4. IDOT CONTRACTS 60X94, 62A77, 62A76 AND 60Y00 WILL BE ONGOING SIMULTANEOUSLY WITH THIS CONTRACT. THE CONTRACTOR IS RESPONSIBLE FOR COORDINATING ALL ELECTRICAL WORK FOR THIS CONTRACT WITH THE WORK IN THOSE CONTRACTS. THIS COORDINATION WORK SHALL BE INCLUDED AT NO ADDITIONAL COST TO THIS CONTRACT.
5. NOT USED
6. DISCONNECT THE EXISTING SIGN LIGHTING ELECTRICAL FEED AND REMOVE CABLES BACK TO THE NEAREST SPLICE POINT UNAFFECTED BY CONSTRUCTION. THIS WORK SHALL BE PAID FOR UNDER THE "DISCONNECT SIGN LIGHTING AND REMOVE WIRING TO THE NEAREST SPLICE" PAY ITEM.
7. REMOVE EXISTING SIGN LUMINAIRES. THIS REMOVAL WORK SHALL BE INCLUDED IN THE COST OF THE "REMOVE OVERHEAD SIGN STRUCTURE-SPAN" PAY ITEM.



FILE PATH = p:\AECOM\NA-AVSI\ecommon\line\local\AECOM_DS02_NA\Documents\01_Americas\Transportation\60269938_Circle_Phase_1\000_CAD\01E_Electrical\Sheets\62A76_Contract\0162A76_sht-Light-02



D162A76-sht-Light-02
 USER NAME = myersc
 PLOT SCALE = 100.0000' / in.
 PLOT DATE = 3/2/2020

DESIGNED - TJL
 DRAWN - CAM
 CHECKED - WDS
 DATE - 3/4/20

REVISED -
 REVISED -
 REVISED -
 REVISED -

**STATE OF ILLINOIS
 DEPARTMENT OF TRANSPORTATION**



**EXISTING LIGHTING PLAN
 NB I-90/94**

SCALE: 1"=50' SHEET 2 OF 33 SHEETS STA. TO STA. 125+00

F.A.I. RTE.	SECTION	COUNTY	TOTAL SHEETS	SHEET NO.
90/94/290	2015-D18R	COOK	2155	1081
CONTRACT NO. 62A76				
ILLINOIS FED. AID PROJECT				

NOTES:

1. SEE DRAWING E-01 FOR IDOT ELECTRICAL SYMBOLS.
2. THE EXISTING ELECTRICAL SYSTEMS, AS DEPICTED ON THE PLANS, ARE INTENDED TO INDICATE THE GENERAL EQUIPMENT INSTALLATIONS INVOLVED AND SHALL NOT BE CONSTRUED AS AN EXACT REPRESENTATION OF THE FIELD CONDITIONS. IT IS THE CONTRACTOR'S RESPONSIBILITY TO CONFIRM AND ASCERTAIN THE EXACT CONDITION, SIZE, TYPE, QUANTITY AND LOCATION OF THE EXISTING ELECTRICAL EQUIPMENT. ANY DISCREPANCIES BETWEEN THE ACTUAL EXISTING ELECTRICAL EQUIPMENT IN THE FIELD AND THE DEPICTION OF THE EXISTING ELECTRICAL EQUIPMENT SHOWN ON THE PLANS SHALL IMMEDIATELY BE BROUGHT TO THE ATTENTION OF THE RESIDENT ENGINEER FOR RESOLUTION. FAILURE TO VERIFY THE CONDITIONS, DIMENSIONS AND DETAILS OF THE EXISTING ELECTRICAL EQUIPMENT TO CONFIRM THAT THE NEW EQUIPMENT IS COMPATIBLE WITH THE EXISTING EQUIPMENT AND CAN BE PROPERLY INSTALLED AND CONNECTED AS SHOWN ON THE PLANS WILL NOT RELIEVE THE CONTRACTOR OF THEIR RESPONSIBILITY FOR PROVIDING A SAFE, COMPLETE AND FULLY FUNCTIONAL ELECTRICAL SYSTEM.
3. ALL WORK SHOWN ON THIS DRAWING MUST BE COORDINATED WITH THIS CONTRACT'S CONSTRUCTION WORK AND STAGING.
4. IDOT CONTRACTS 60X94, 62A77, 62A76 AND 60Y00 WILL BE ONGOING SIMULTANEOUSLY WITH THIS CONTRACT. THE CONTRACTOR IS RESPONSIBLE FOR COORDINATING ALL ELECTRICAL WORK FOR THIS CONTRACT WITH THE WORK IN THOSE CONTRACTS. THIS COORDINATION WORK SHALL BE INCLUDED AT NO ADDITIONAL COST TO THIS CONTRACT.
5. NOT USED
6. DISCONNECT THE EXISTING SIGN LIGHTING ELECTRICAL FEED AND REMOVE CABLES BACK TO THE NEAREST SPLICE POINT UNAFFECTED BY CONSTRUCTION. THIS WORK SHALL BE PAID FOR UNDER THE "DISCONNECT SIGN LIGHTING AND REMOVE WIRING TO THE NEAREST SPLICE" PAY ITEM.
7. REMOVE EXISTING SIGN LUMINAIRES. THIS REMOVAL WORK SHALL BE INCLUDED IN THE COST OF THE "REMOVE OVERHEAD SIGN STRUCTURE -CANTILEVER" PAY ITEM.

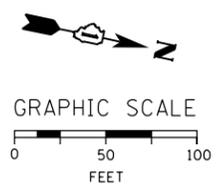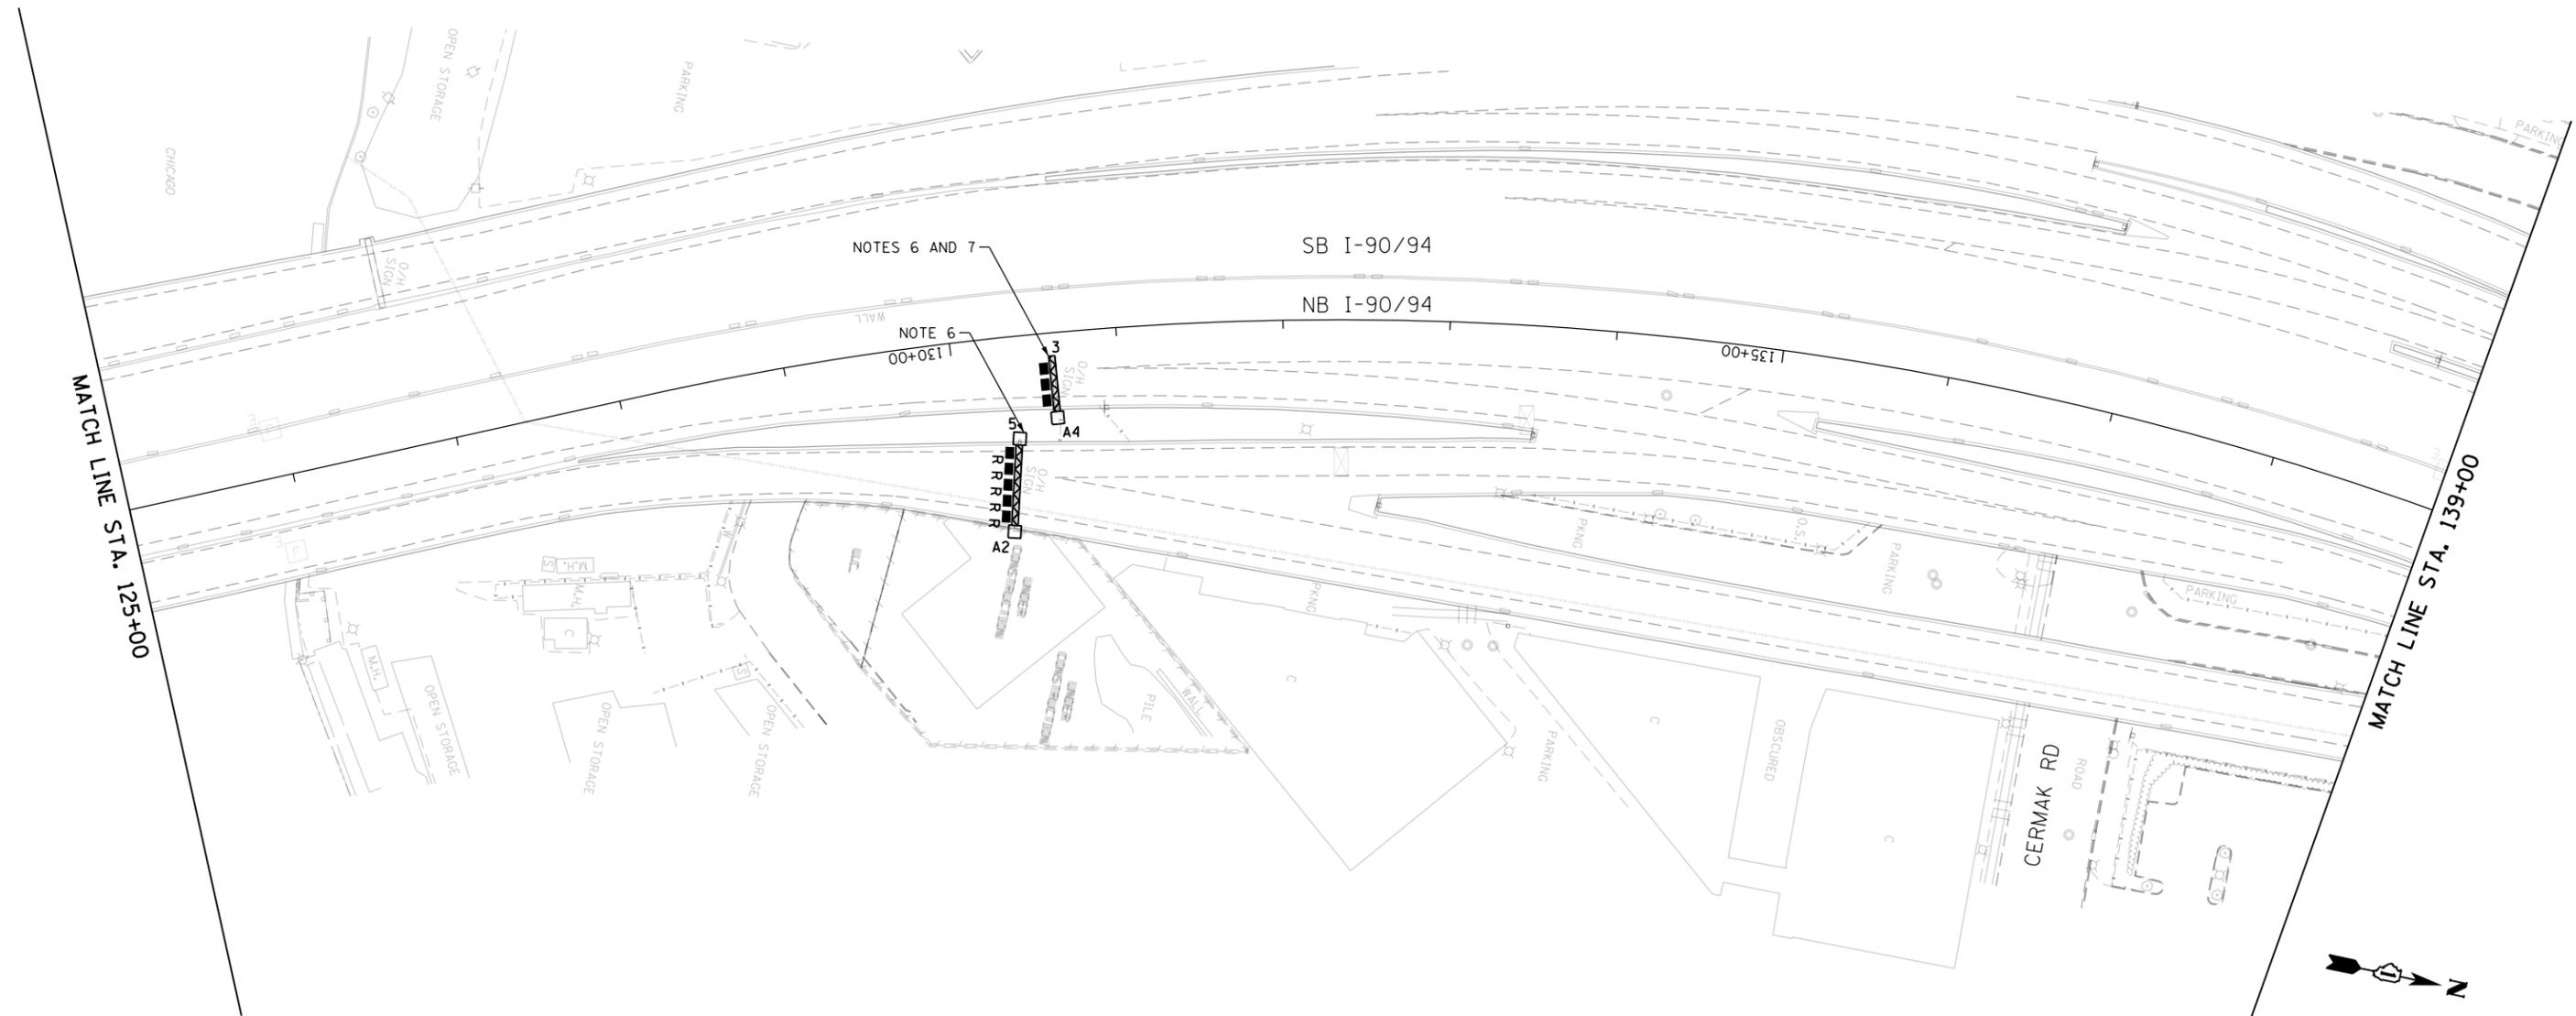

FILE PATH = p:\aecom\ms-ansi\ecommon\line\local\AECOM_DS02_NA\Documents\01_Americas\Transportation\60269938_Circle_Phase_1\1000_CAD\01E_Electrical\Sheets\62A76_Contract\0162A76_sht-Light-03



D162A76-sht-Light-03
 USER NAME = myersc
 PLOT SCALE = 100.0000' / in.
 PLOT DATE = 3/2/2020

DESIGNED - TJL	REVISED -
DRAWN - CAM	REVISED -
CHECKED - WDS	REVISED -
DATE - 3/4/20	REVISED -

**STATE OF ILLINOIS
DEPARTMENT OF TRANSPORTATION**


**EXISTING LIGHTING PLAN
NB I-90/94**

SCALE: 1"=50' SHEET 3 OF 33 SHEETS STA. 125+00 TO STA. 139+00

F.A.I. RTE.	SECTION	COUNTY	TOTAL SHEETS	SHEET NO.
90/94/290	2015-D18R	COOK	2155	1082
CONTRACT NO. 62A76				
ILLINOIS FED. AID PROJECT				

NOTES:

1. SEE DRAWING E-01 FOR IDOT ELECTRICAL SYMBOLS.
2. THE EXISTING ELECTRICAL SYSTEMS, AS DEPICTED ON THE PLANS, ARE INTENDED TO INDICATE THE GENERAL EQUIPMENT INSTALLATIONS INVOLVED AND SHALL NOT BE CONSTRUED AS AN EXACT REPRESENTATION OF THE FIELD CONDITIONS. IT IS THE CONTRACTOR'S RESPONSIBILITY TO CONFIRM AND ASCERTAIN THE EXACT CONDITION, SIZE, TYPE, QUANTITY AND LOCATION OF THE EXISTING ELECTRICAL EQUIPMENT. ANY DISCREPANCIES BETWEEN THE ACTUAL EXISTING ELECTRICAL EQUIPMENT IN THE FIELD AND THE DEPICTION OF THE EXISTING ELECTRICAL EQUIPMENT SHOWN ON THE PLANS SHALL IMMEDIATELY BE BROUGHT TO THE ATTENTION OF THE RESIDENT ENGINEER FOR RESOLUTION. FAILURE TO VERIFY THE CONDITIONS, DIMENSIONS AND DETAILS OF THE EXISTING ELECTRICAL EQUIPMENT TO CONFIRM THAT THE NEW EQUIPMENT IS COMPATIBLE WITH THE EXISTING EQUIPMENT AND CAN BE PROPERLY INSTALLED AND CONNECTED AS SHOWN ON THE PLANS WILL NOT RELIEVE THE CONTRACTOR OF THEIR RESPONSIBILITY FOR PROVIDING A SAFE, COMPLETE AND FULLY FUNCTIONAL ELECTRICAL SYSTEM.
3. ALL WORK SHOWN ON THIS DRAWING MUST BE COORDINATED WITH THIS CONTRACT'S CONSTRUCTION WORK AND STAGING.
4. IDOT CONTRACTS 60X94, 62A77, 62A76 AND 60Y00 WILL BE ONGOING SIMULTANEOUSLY WITH THIS CONTRACT. THE CONTRACTOR IS RESPONSIBLE FOR COORDINATING ALL ELECTRICAL WORK FOR THIS CONTRACT WITH THE WORK IN THOSE CONTRACTS. THIS COORDINATION WORK SHALL BE INCLUDED AT NO ADDITIONAL COST TO THIS CONTRACT.
5. NOT USED
6. DISCONNECT THE EXISTING SIGN LIGHTING ELECTRICAL FEED AND REMOVE CABLES BACK TO THE NEAREST SPLICE POINT UNAFFECTED BY CONSTRUCTION. THIS WORK SHALL BE PAID FOR UNDER THE "DISCONNECT SIGN LIGHTING AND REMOVE WIRING TO THE NEAREST SPLICE" PAY ITEM.

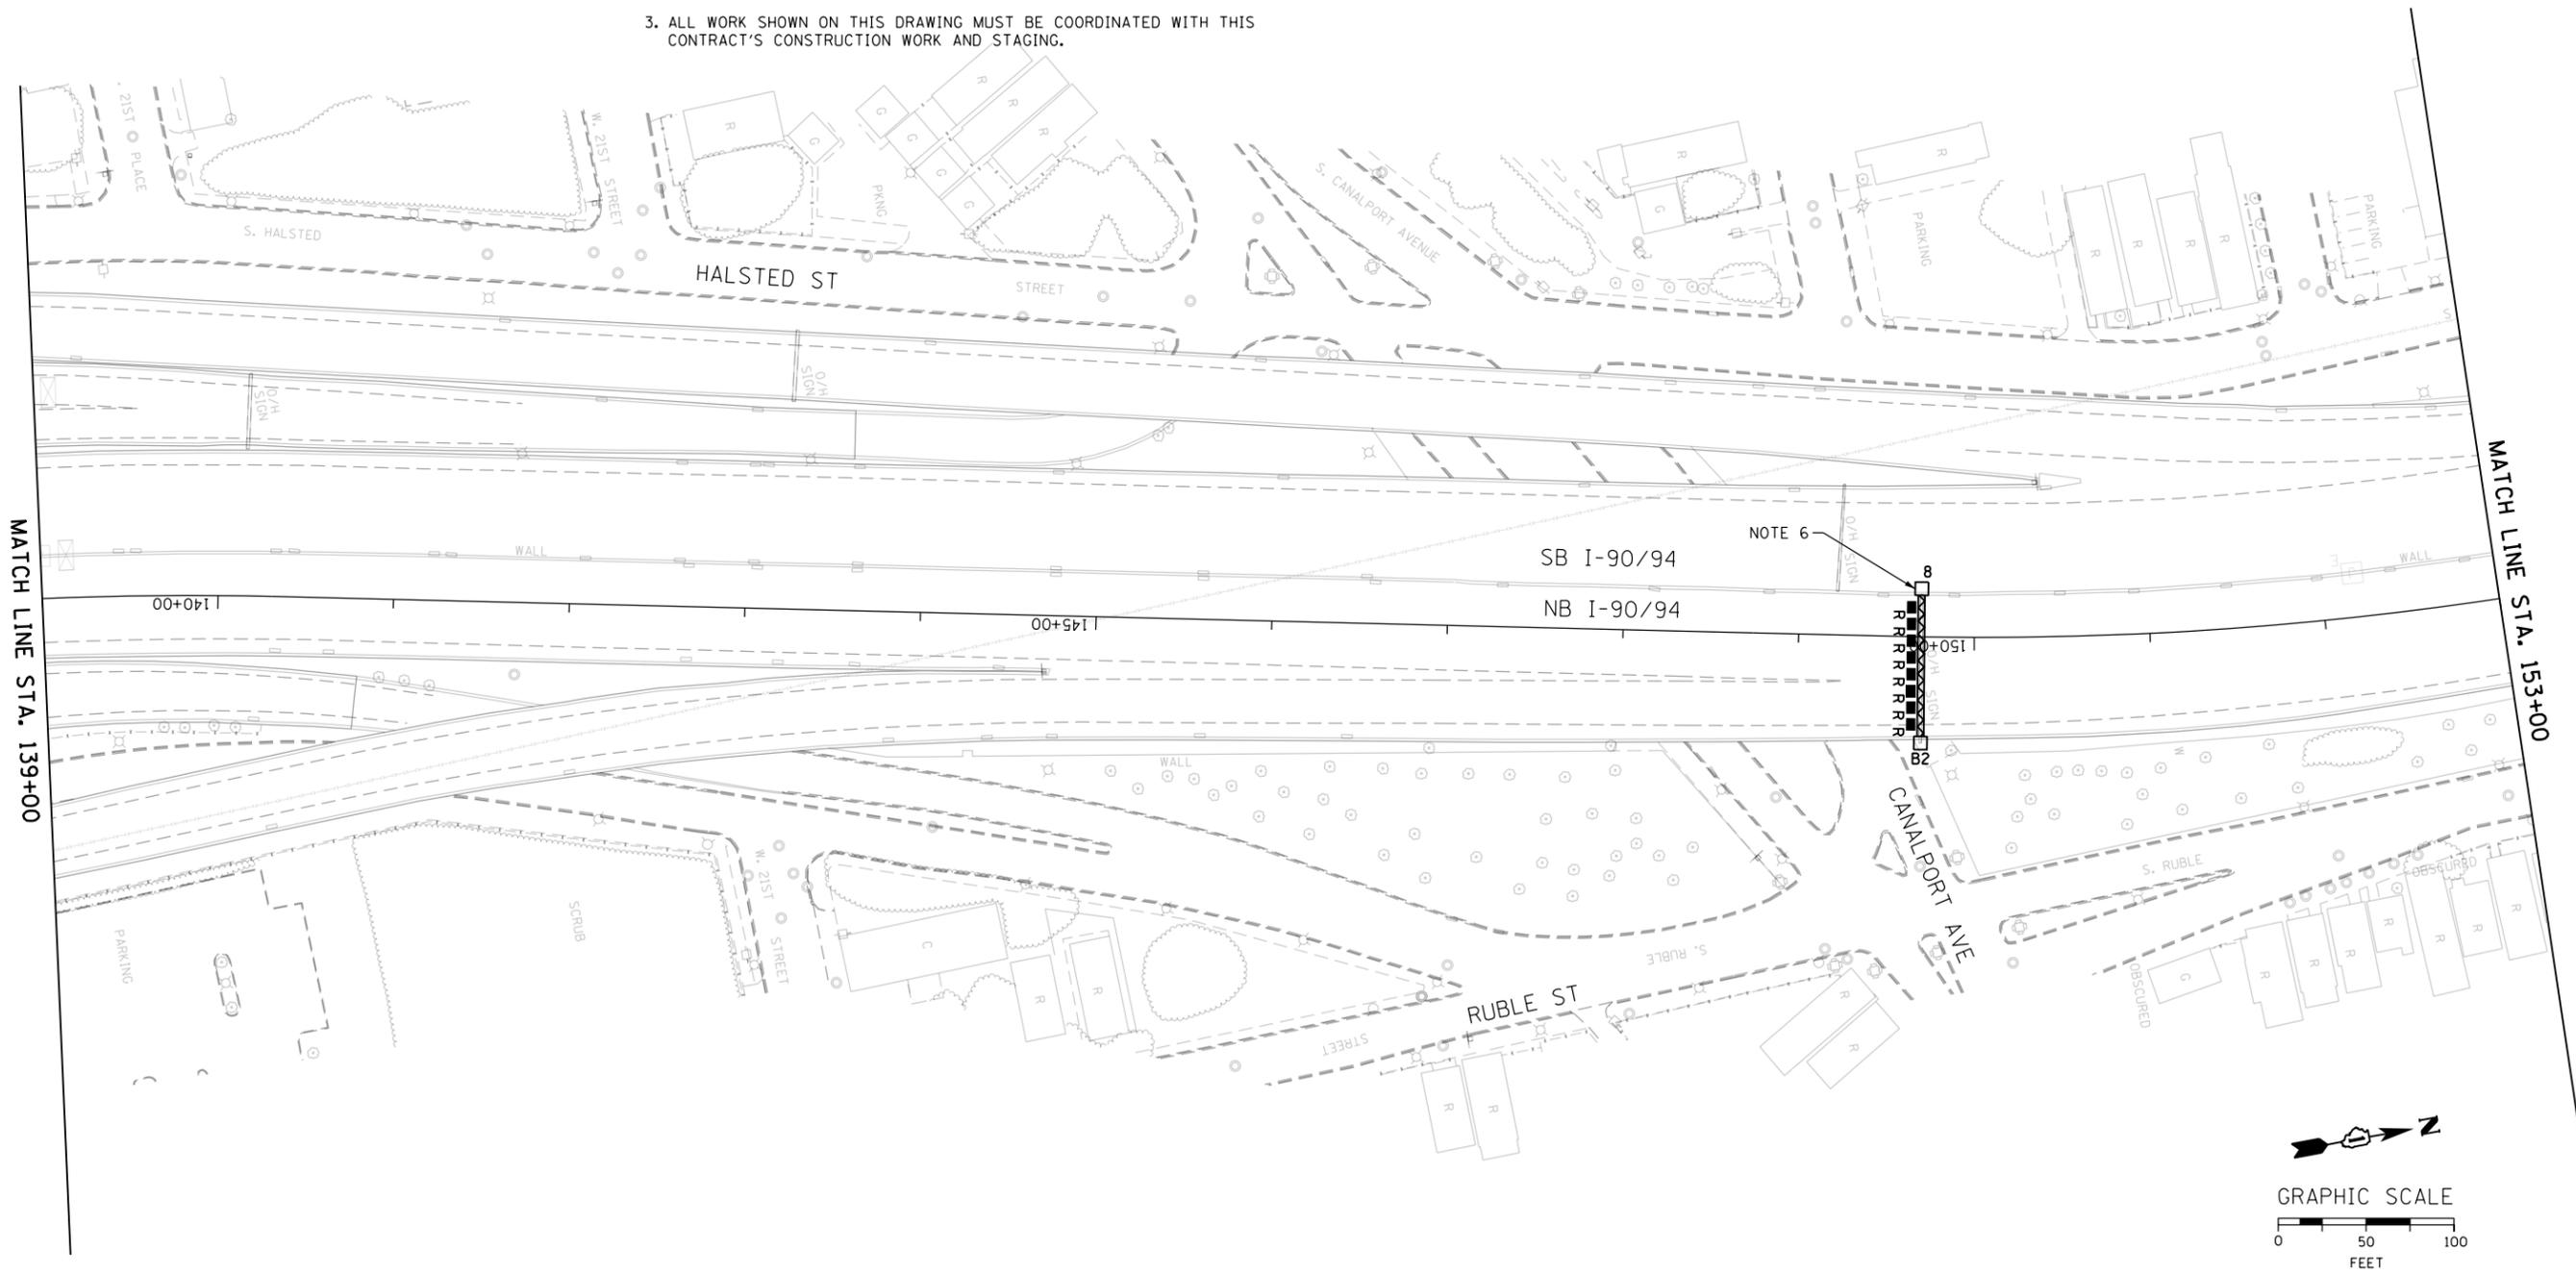

FILE PATH = p:\AECOM\NA-AVSI\ecommon\line\local\AECOM_D502_NA\Documents\01_Americas\Transportation\60269938_Circle_Phase_1\1000_CAD\01E_Electrical\Sheets\62A76_Contract\0162A76_sht-Light-04



D162A76-sht-Light-04
 USER NAME = myersc
 PLOT SCALE = 100.0000' / in.
 PLOT DATE = 3/2/2020

DESIGNED - TJL
 DRAWN - CAM
 CHECKED - WDS
 DATE - 3/4/20

REVISED -
 REVISED -
 REVISED -
 REVISED -

**STATE OF ILLINOIS
 DEPARTMENT OF TRANSPORTATION**

**EXISTING LIGHTING PLAN
 NB I-90/94**



SCALE: 1"=50' SHEET 4 OF 33 SHEETS STA. 139+00 TO STA. 153+00

F.A.I. RTE.	SECTION	COUNTY	TOTAL SHEETS	SHEET NO.
90/94/290	2015-D18R	COOK	2155	1083
CONTRACT NO. 62A76				
ILLINOIS FED. AID PROJECT				

E-04

NOTES:

1. SEE DRAWING E-01 FOR IDOT ELECTRICAL SYMBOLS.
2. THE EXISTING ELECTRICAL SYSTEMS, AS DEPICTED ON THE PLANS, ARE INTENDED TO INDICATE THE GENERAL EQUIPMENT INSTALLATIONS INVOLVED AND SHALL NOT BE CONSTRUED AS AN EXACT REPRESENTATION OF THE FIELD CONDITIONS. IT IS THE CONTRACTOR'S RESPONSIBILITY TO CONFIRM AND ASCERTAIN THE EXACT CONDITION, SIZE, TYPE, QUANTITY AND LOCATION OF THE EXISTING ELECTRICAL EQUIPMENT. ANY DISCREPANCIES BETWEEN THE ACTUAL EXISTING ELECTRICAL EQUIPMENT IN THE FIELD AND THE DEPICTION OF THE EXISTING ELECTRICAL EQUIPMENT SHOWN ON THE PLANS SHALL IMMEDIATELY BE BROUGHT TO THE ATTENTION OF THE RESIDENT ENGINEER FOR RESOLUTION. FAILURE TO VERIFY THE CONDITIONS, DIMENSIONS AND DETAILS OF THE EXISTING ELECTRICAL EQUIPMENT TO CONFIRM THAT THE NEW EQUIPMENT IS COMPATIBLE WITH THE EXISTING EQUIPMENT AND CAN BE PROPERLY INSTALLED AND CONNECTED AS SHOWN ON THE PLANS WILL NOT RELIEVE THE CONTRACTOR OF THEIR RESPONSIBILITY FOR PROVIDING A SAFE, COMPLETE AND FULLY FUNCTIONAL ELECTRICAL SYSTEM.
3. ALL WORK SHOWN ON THIS DRAWING MUST BE COORDINATED WITH THIS CONTRACT'S CONSTRUCTION WORK AND STAGING.
4. IDOT CONTRACTS 60X94, 62A77, 62A76 AND 60Y00 WILL BE ONGOING SIMULTANEOUSLY WITH THIS CONTRACT. THE CONTRACTOR IS RESPONSIBLE FOR COORDINATING ALL ELECTRICAL WORK FOR THIS CONTRACT WITH THE WORK IN THOSE CONTRACTS. THIS COORDINATION WORK SHALL BE INCLUDED AT NO ADDITIONAL COST TO THIS CONTRACT.
5. REMOVE EXISTING SIGN LUMINAIRES. THIS REMOVAL WORK SHALL BE INCLUDED IN THE COST OF THE "REMOVE OVERHEAD SIGN STRUCTURE -CANTILEVER" PAY ITEM.
6. DISCONNECT THE EXISTING SIGN LIGHTING ELECTRICAL FEED AND REMOVE CABLES BACK TO THE NEAREST SPLICE POINT UNAFFECTED BY CONSTRUCTION. THIS WORK SHALL BE PAID FOR UNDER THE "DISCONNECT SIGN LIGHTING AND REMOVE WIRING TO THE NEAREST SPLICE" PAY ITEM.

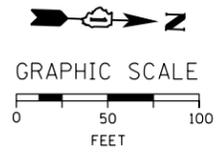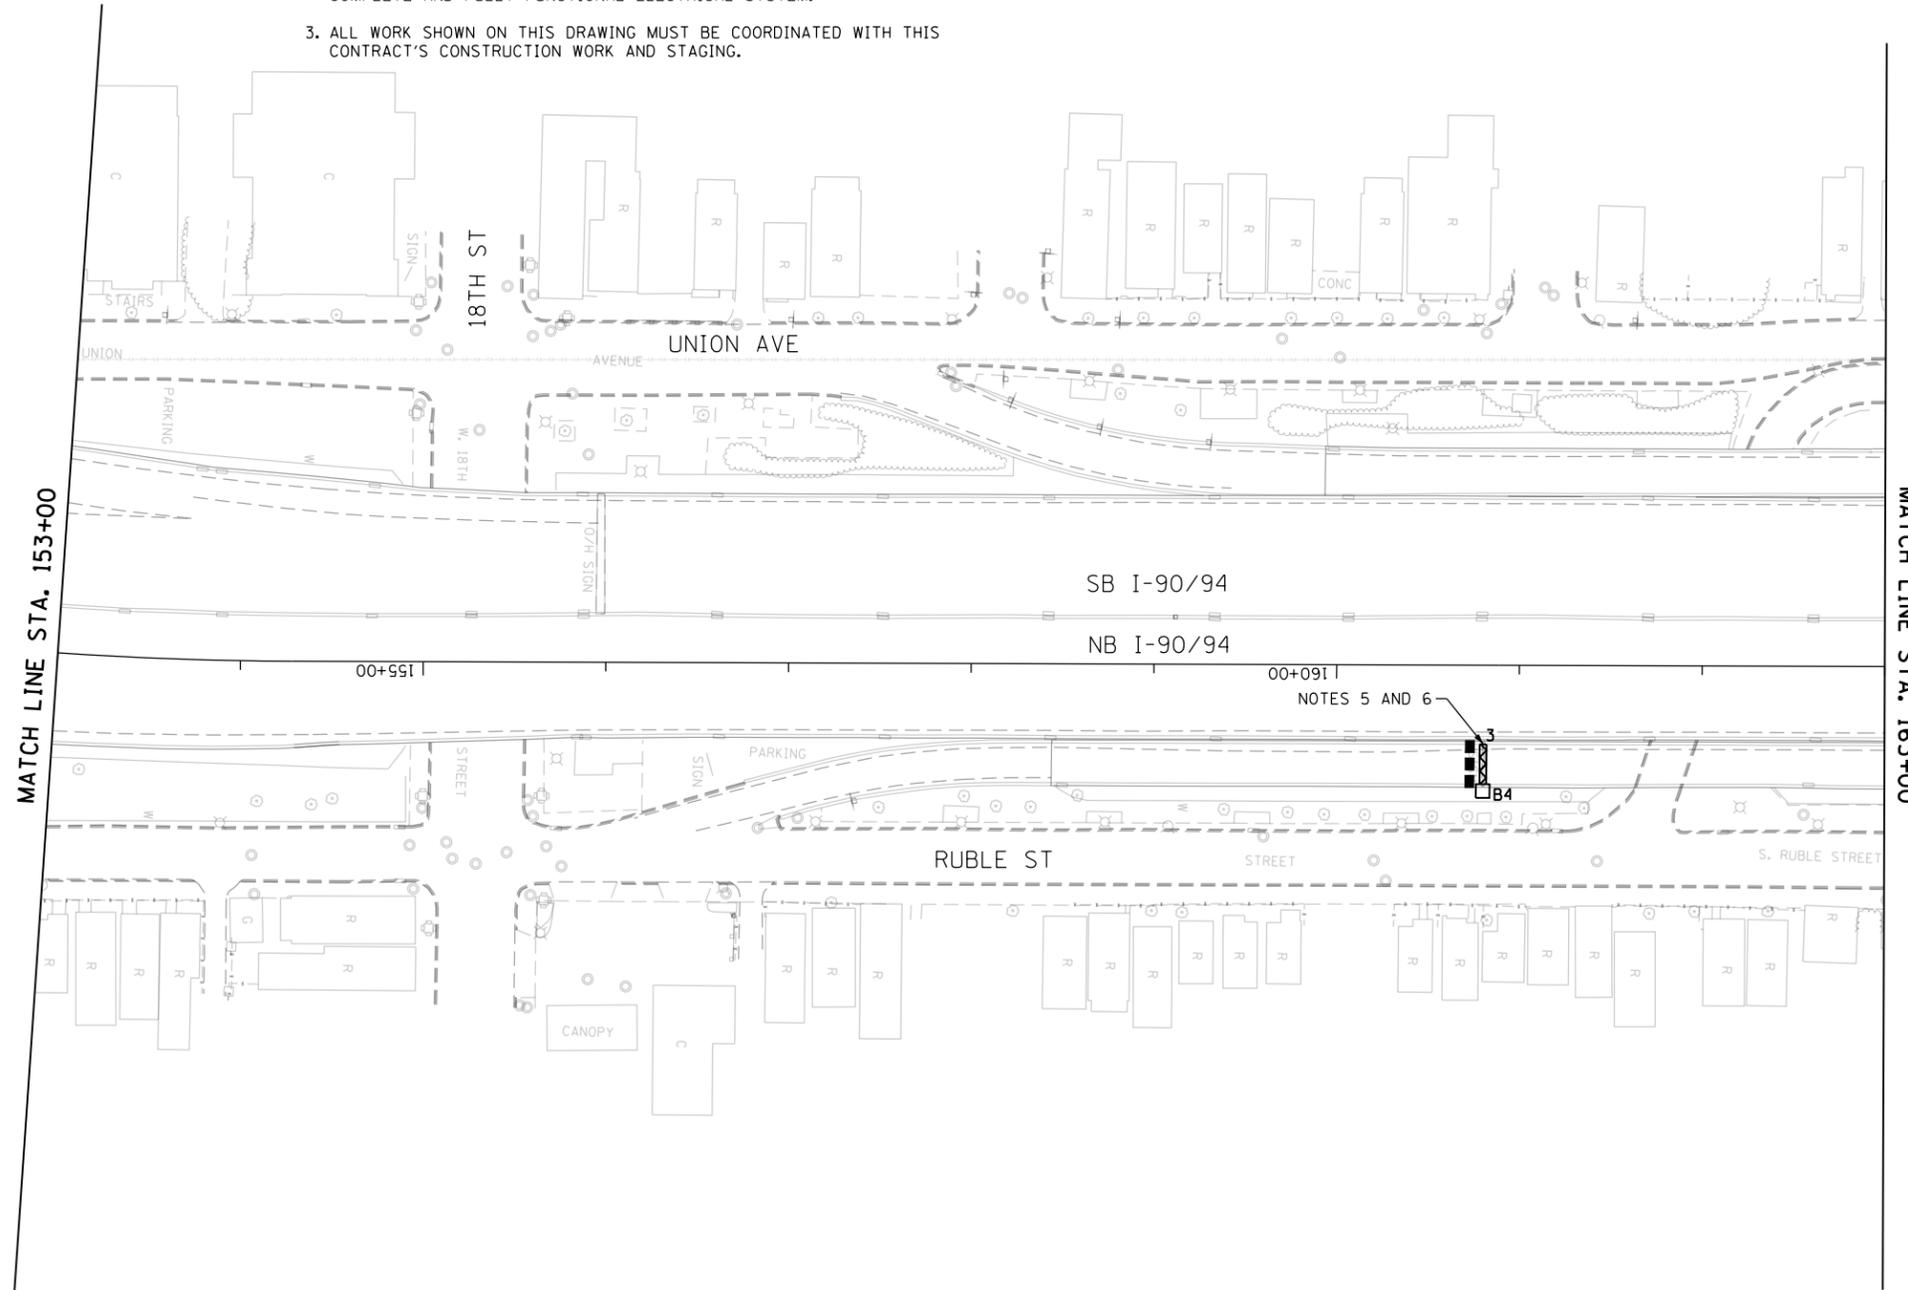

FILE PATH = p:\AECOM\NA-AVSI\ecommon\line\local\AECOM_DS02_NA\Documents\01_Americas\Transportation\60269938_Circle_Phase_1\1000_CAD\01E_Electrical\Sheets\62A76_Contract\0162A76_sht-Light-05



D162A76-sht-Light-05
 USER NAME = myersc
 PLOT SCALE = 100.0000' / in.
 PLOT DATE = 1/23/2020

DESIGNED - TJL
 DRAWN - CAM
 CHECKED - WDS
 DATE - 1/29/20

REVISED -
 REVISED -
 REVISED -
 REVISED -

**STATE OF ILLINOIS
 DEPARTMENT OF TRANSPORTATION**



**EXISTING LIGHTING PLAN
 NB I-90/94**

SCALE: 1"=50' SHEET 5 OF 33 SHEETS STA. 153+00 TO STA. 163+00

F.A.I. RTE.	SECTION	COUNTY	TOTAL SHEETS	SHEET NO.
90/94/290	2015-D18R	COOK	2155	1084
CONTRACT NO. 62A76			ILLINOIS FED. AID PROJECT	

NOTES:

1. SEE DRAWING E-01 FOR IDOT ELECTRICAL SYMBOLS.
2. THE EXISTING ELECTRICAL SYSTEMS, AS DEPICTED ON THE PLANS, ARE INTENDED TO INDICATE THE GENERAL EQUIPMENT INSTALLATIONS INVOLVED AND SHALL NOT BE CONSTRUED AS AN EXACT REPRESENTATION OF THE FIELD CONDITIONS. IT IS THE CONTRACTOR'S RESPONSIBILITY TO CONFIRM AND ASCERTAIN THE EXACT CONDITION, SIZE, TYPE, QUANTITY AND LOCATION OF THE EXISTING ELECTRICAL EQUIPMENT. ANY DISCREPANCIES BETWEEN THE ACTUAL EXISTING ELECTRICAL EQUIPMENT IN THE FIELD AND THE DEPICTION OF THE EXISTING ELECTRICAL EQUIPMENT SHOWN ON THE PLANS SHALL IMMEDIATELY BE BROUGHT TO THE ATTENTION OF THE RESIDENT ENGINEER FOR RESOLUTION. FAILURE TO VERIFY THE CONDITIONS, DIMENSIONS AND DETAILS OF THE EXISTING ELECTRICAL EQUIPMENT TO CONFIRM THAT THE NEW EQUIPMENT IS COMPATIBLE WITH THE EXISTING EQUIPMENT AND CAN BE PROPERLY INSTALLED AND CONNECTED AS SHOWN ON THE PLANS WILL NOT RELIEVE THE CONTRACTOR OF THEIR RESPONSIBILITY FOR PROVIDING A SAFE, COMPLETE AND FULLY FUNCTIONAL ELECTRICAL SYSTEM.
3. ALL WORK SHOWN ON THIS DRAWING MUST BE COORDINATED WITH THIS CONTRACT'S CONSTRUCTION WORK AND STAGING.
4. IDOT CONTRACTS 60X94, 62A77, 62A76 AND 60Y00 WILL BE ONGOING SIMULTANEOUSLY WITH THIS CONTRACT. THE CONTRACTOR IS RESPONSIBLE FOR COORDINATING ALL ELECTRICAL WORK FOR THIS CONTRACT WITH THE WORK IN THOSE CONTRACTS. THIS COORDINATION WORK SHALL BE INCLUDED AT NO ADDITIONAL COST TO THIS CONTRACT.
5. NOT USED
6. DISCONNECT THE EXISTING SIGN LIGHTING ELECTRICAL FEED AND REMOVE CABLES BACK TO THE NEAREST SPLICE POINT UNAFFECTED BY CONSTRUCTION. THIS WORK SHALL BE PAID FOR UNDER THE "DISCONNECT SIGN LIGHTING AND REMOVE WIRING TO THE NEAREST SPLICE" PAY ITEM.
7. REMOVE EXISTING SIGN LUMINAIRES. THIS REMOVAL WORK SHALL BE INCLUDED IN THE COST OF THE "REMOVE OVERHEAD SIGN STRUCTURE-SPAN" PAY ITEM.

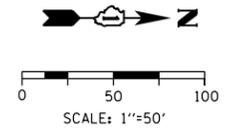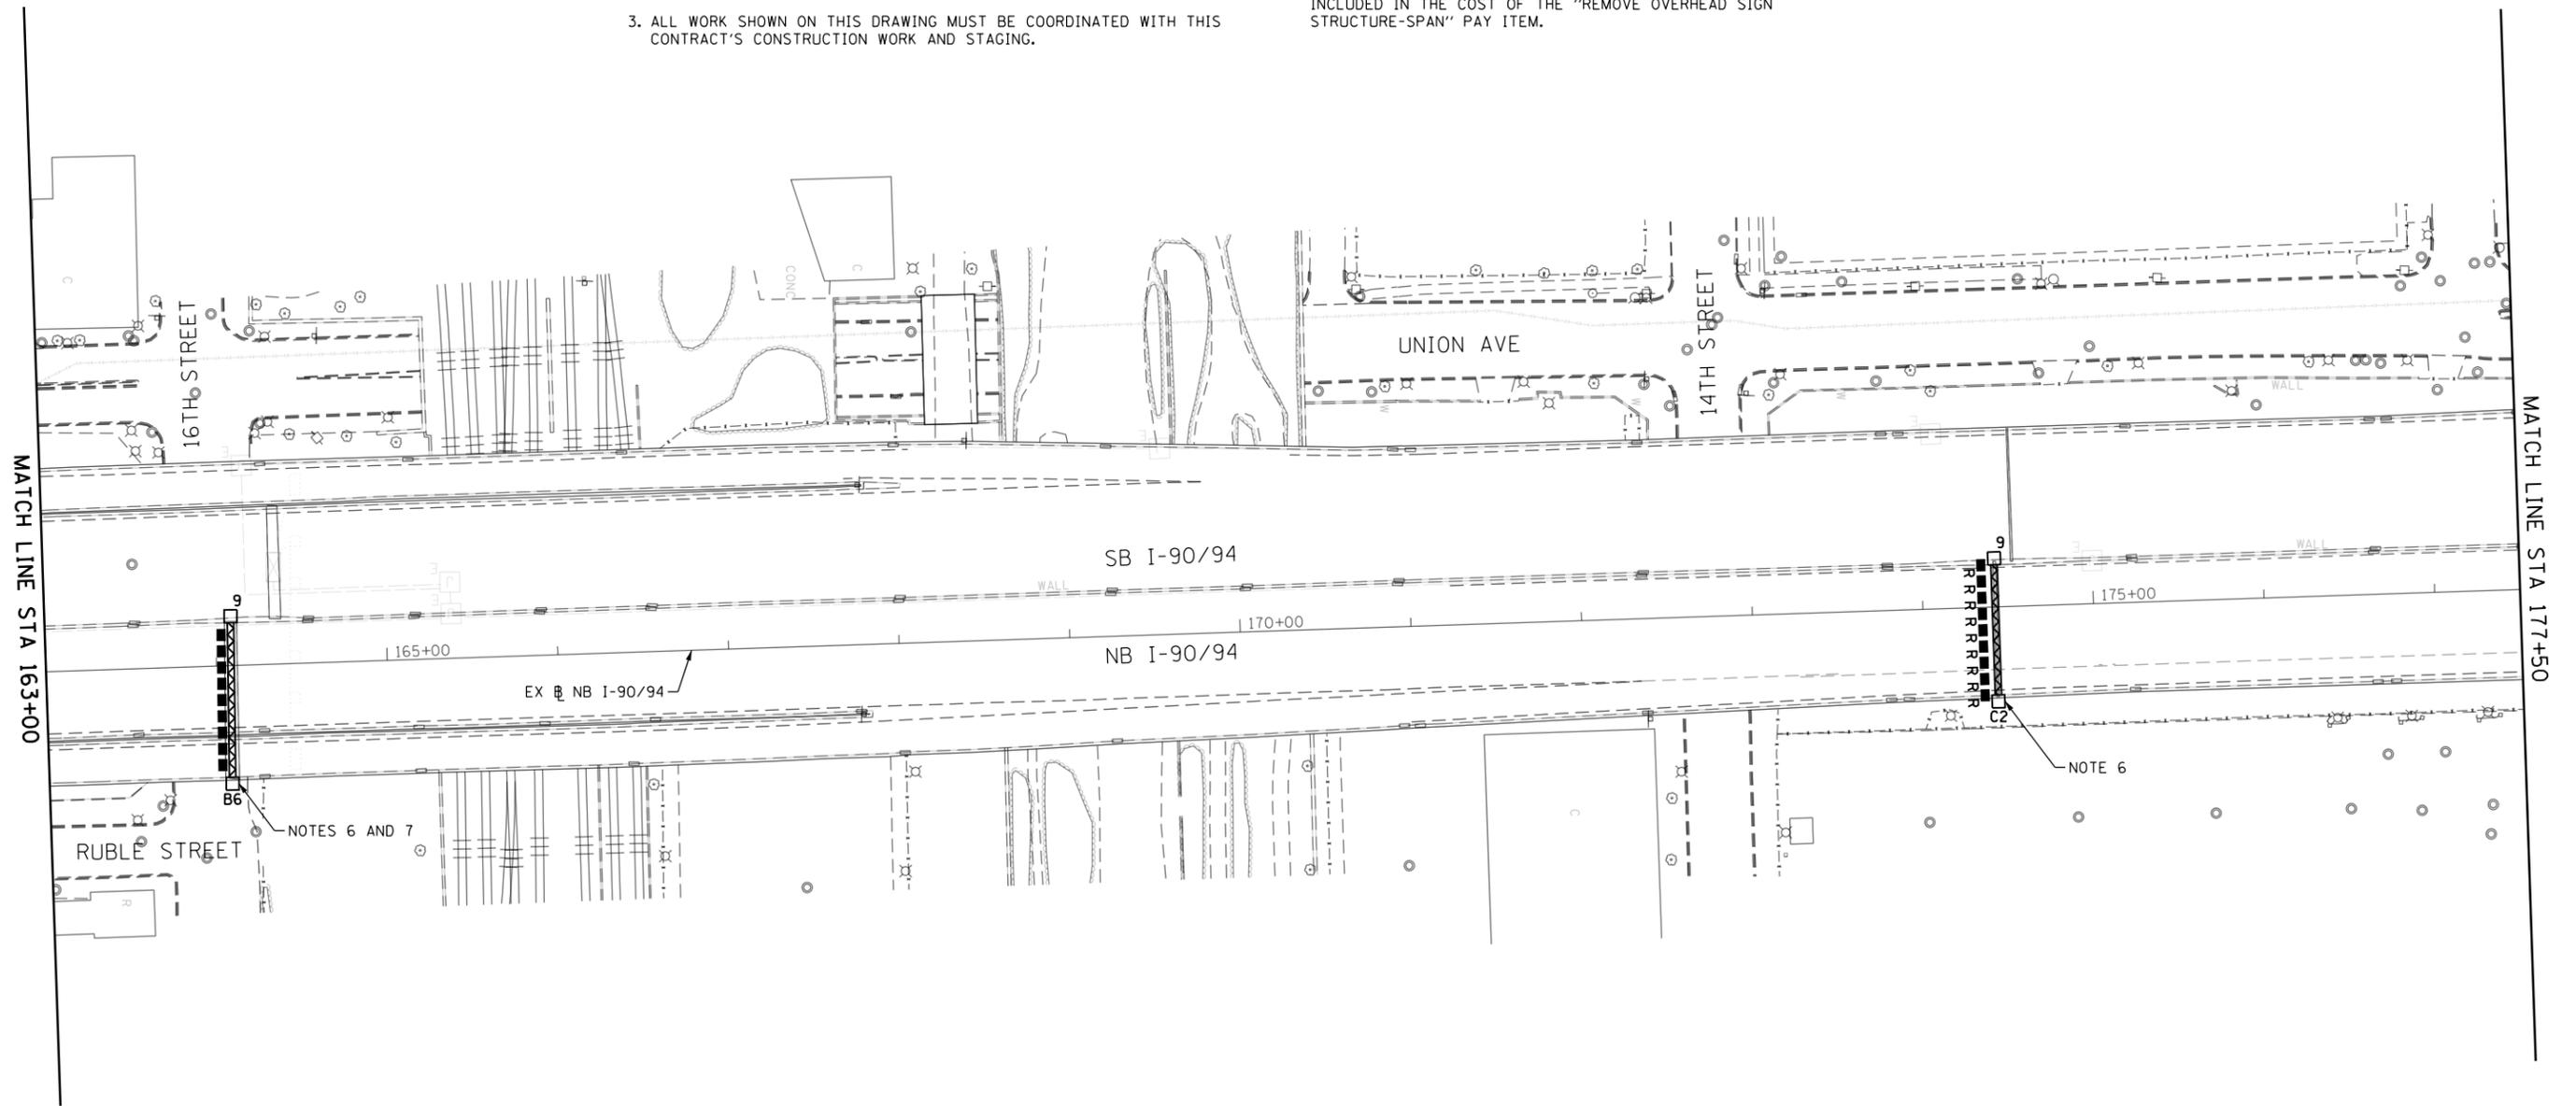

FILE PATH = p:\aecom\ms-ansi\ecommon\line\local\AECOM_D502_MA\Documents\01_Americas\Transportation\60269938_Circle_Phase_1\000_CAD\01E_Electrical\Sheets\62A76_Contract\0162A76_Sht-Light-06



D162A76-Sht-Light-06
 USER NAME = myersc
 PLOT SCALE = 100.0000' / in.
 PLOT DATE = 3/2/2020

DESIGNED - TJL	REVISED -
DRAWN - CAM	REVISED -
CHECKED - WDS	REVISED -
DATE - 3/4/20	REVISED -

**STATE OF ILLINOIS
 DEPARTMENT OF TRANSPORTATION**

**EXISTING LIGHTING PLAN
 NB I-90/94**

SCALE: 1"=50' SHEET 6 OF 33 SHEETS STA. 163+00 TO STA. 177+50

F.A.I. RTE.	SECTION	COUNTY	TOTAL SHEETS	SHEET NO.
90/94/290	2015-D18R	COOK	2155	1085
CONTRACT NO. 62A76				
ILLINOIS FED. AID PROJECT				

E-06

NOTES:

1. SEE DRAWING E-01 FOR IDOT ELECTRICAL SYMBOLS.

2. THE EXISTING ELECTRICAL SYSTEMS, AS DEPICTED ON THE PLANS, ARE INTENDED TO INDICATE THE GENERAL EQUIPMENT INSTALLATIONS INVOLVED AND SHALL NOT BE CONSTRUED AS AN EXACT REPRESENTATION OF THE FIELD CONDITIONS. IT IS THE CONTRACTOR'S RESPONSIBILITY TO CONFIRM AND ASCERTAIN THE EXACT CONDITION, SIZE, TYPE, QUANTITY AND LOCATION OF THE EXISTING ELECTRICAL EQUIPMENT. ANY DISCREPANCIES BETWEEN THE ACTUAL EXISTING ELECTRICAL EQUIPMENT IN THE FIELD AND THE DEPICTION OF THE EXISTING ELECTRICAL EQUIPMENT SHOWN ON THE PLANS SHALL IMMEDIATELY BE BROUGHT TO THE ATTENTION OF THE RESIDENT ENGINEER FOR RESOLUTION. FAILURE TO VERIFY THE CONDITIONS, DIMENSIONS AND DETAILS OF THE EXISTING ELECTRICAL EQUIPMENT TO CONFIRM THAT THE NEW EQUIPMENT IS COMPATIBLE WITH THE EXISTING EQUIPMENT AND CAN BE PROPERLY INSTALLED AND CONNECTED AS SHOWN ON THE PLANS WILL NOT RELIEVE THE CONTRACTOR OF THEIR RESPONSIBILITY FOR PROVIDING A SAFE, COMPLETE AND FULLY FUNCTIONAL ELECTRICAL SYSTEM.

3. ALL WORK SHOWN ON THIS DRAWING MUST BE COORDINATED WITH THIS CONTRACT'S CONSTRUCTION WORK AND STAGING.

4. IDOT CONTRACTS 60X94, 62A77, 62A76 AND 60Y00 WILL BE ONGOING SIMULTANEOUSLY WITH THIS CONTRACT. THE CONTRACTOR IS RESPONSIBLE FOR COORDINATING ALL ELECTRICAL WORK FOR THIS CONTRACT WITH THE WORK IN THOSE CONTRACTS. THIS COORDINATION WORK SHALL BE INCLUDED AT NO ADDITIONAL COST TO THIS CONTRACT.

5. ALL OF THE EXISTING LIGHTING UNITS AND LIGHTING CIRCUITS CURRENTLY FED FROM EXISTING IDOT LIGHTING CONTROLLERS SHALL REMAIN ENERGIZED DURING NIGHTTIME HOURS FOR THE DURATION OF THE CONTRACT. ANY TEMPORARY POWER REQUIRED TO KEEP THE LIGHTING SYSTEM ENERGIZED WILL BE PROVIDED BY THE CONTRACTOR AT NO ADDITIONAL COST TO THE CONTRACT.

6. ALL EXISTING LIGHT TOWERS SHOWN TO BE REMOVED SHALL BE DISPOSED OF PROPERLY OFFSITE.


7. TEMPORARY LIGHTING UNIT 4 CCD2 SHALL BE REMOVED ONCE PROPOSED LIGHT TOWER 8 CCD2 ON DRAWING E-18 HAS BEEN INSTALLED, ENERGIZED, TESTED, AND APPROVED BY IDOT. ALL EXISTING UNDERGROUND FEEDS SHALL BE ABANDONED.

8. REMOVE EXISTING SIGN LUMINAIRES. THIS REMOVAL WORK SHALL BE INCLUDED IN THE COST OF THE "REMOVE OVERHEAD SIGN STRUCTURE -CANTILEVER" PAY ITEM.


9. DISCONNECT THE EXISTING SIGN LIGHTING ELECTRICAL FEED AND REMOVE CABLES BACK TO THE NEAREST SPLICE POINT UNAFFECTED BY CONSTRUCTION. THIS WORK SHALL BE PAID FOR UNDER THE "DISCONNECT SIGN LIGHTING AND REMOVE WIRING TO THE NEAREST SPLICE" PAY ITEM.

10. REMOVE EXISTING SIGN LUMINAIRES. THIS REMOVAL WORK SHALL BE INCLUDED IN THE COST OF THE "REMOVE OVERHEAD SIGN STRUCTURE-SPAN" PAY ITEM.

11. REMOVE EXISTING SIGN LUMINAIRES. THIS REMOVAL WORK SHALL BE INCLUDED IN THE COST OF THE "REMOVE OVERHEAD SIGN STRUCTURE-BRIDGE MOUNTED" PAY ITEM.

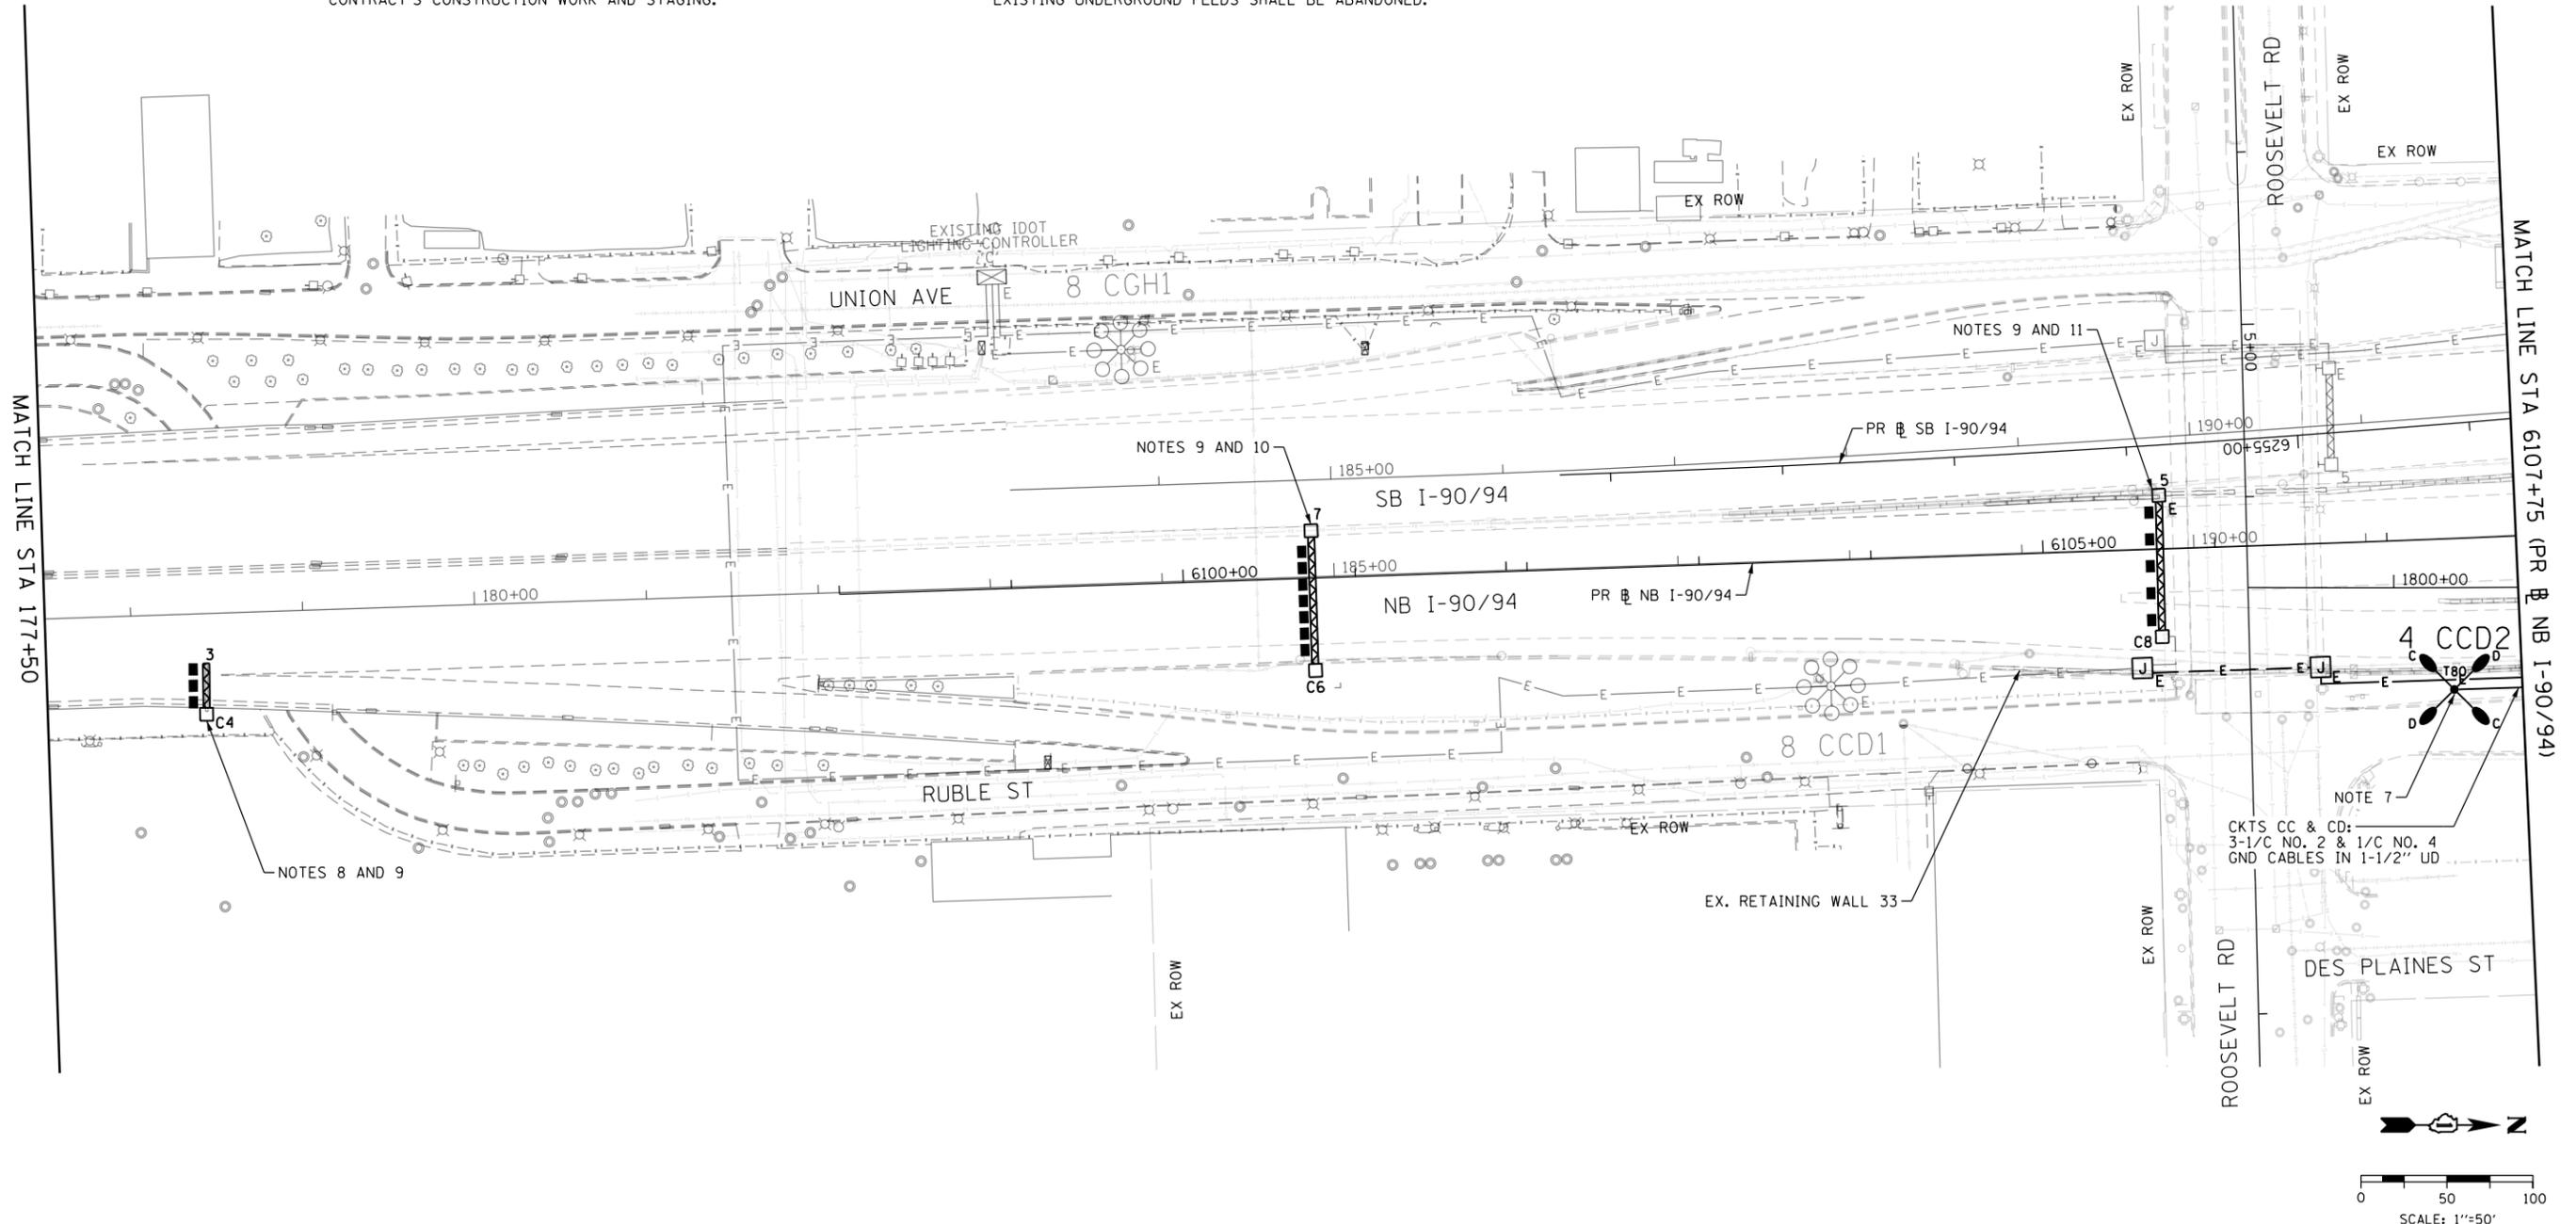

CKTS CC & CD:
3-1/C NO. 2 & 1/C NO. 4
GND CABLES IN 1-1/2" UD

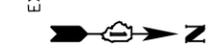

0 50 100
SCALE: 1"=50'

E-07

FILE PATH = p:\V\AECOM\NA-AWS\encomon\line\local\AECOM_DS02_NA\Documents\01_Americas\Transportation\60269938_Circle_Phase_1\1000_CAD\01E_Electrical\Sheets\62A76_Contract\0162A76_Sht-Light-07



D162A76-Sht-Light-07
USER NAME = myersc
PLOT SCALE = 100.0000' / in.
PLOT DATE = 3/2/2020

DESIGNED - TJL
DRAWN - CAM
CHECKED - WDS
DATE - 3/4/20

REVISED -
REVISED -
REVISED -
REVISED -

STATE OF ILLINOIS
DEPARTMENT OF TRANSPORTATION



EXISTING/TEMPORARY LIGHTING PLAN
NB I-90/94

SCALE: 1"=50' SHEET 7 OF 33 SHEETS STA. 177+50 TO STA. 6107+75

F.A.I. RTE.	SECTION	COUNTY	TOTAL SHEETS	SHEET NO.
90/94/290	2015-D18R	COOK	2155	1086
CONTRACT NO. 62A76				
ILLINOIS FED. AID PROJECT				

NOTES:

1. SEE DRAWING E-01 FOR IDOT ELECTRICAL SYMBOLS.
2. THE EXISTING ELECTRICAL SYSTEMS, AS DEPICTED ON THE PLANS, ARE INTENDED TO INDICATE THE GENERAL EQUIPMENT INSTALLATIONS INVOLVED AND SHALL NOT BE CONSTRUED AS AN EXACT REPRESENTATION OF THE FIELD CONDITIONS. IT IS THE CONTRACTOR'S RESPONSIBILITY TO CONFIRM AND ASCERTAIN THE EXACT CONDITION, SIZE, TYPE, QUANTITY AND LOCATION OF THE EXISTING ELECTRICAL EQUIPMENT. ANY DISCREPANCIES BETWEEN THE ACTUAL EXISTING ELECTRICAL EQUIPMENT IN THE FIELD AND THE DEPICTION OF THE EXISTING ELECTRICAL EQUIPMENT SHOWN ON THE PLANS SHALL IMMEDIATELY BE BROUGHT TO THE ATTENTION OF THE RESIDENT ENGINEER FOR RESOLUTION. FAILURE TO VERIFY THE CONDITIONS, DIMENSIONS AND DETAILS OF THE EXISTING ELECTRICAL EQUIPMENT TO CONFIRM THAT THE NEW EQUIPMENT IS COMPATIBLE WITH THE EXISTING EQUIPMENT AND CAN BE PROPERLY INSTALLED AND CONNECTED AS SHOWN ON THE PLANS WILL NOT RELIEVE THE CONTRACTOR OF THEIR RESPONSIBILITY FOR PROVIDING A SAFE, COMPLETE AND FULLY FUNCTIONAL ELECTRICAL SYSTEM.
3. ALL WORK SHOWN ON THIS DRAWING MUST BE COORDINATED WITH THIS CONTRACTOR'S CONSTRUCTION WORK AND STAGING.
4. IDOT CONTRACTS 60X94, 62A77, 62A76 AND 60Y00 WILL BE ONGOING SIMULTANEOUSLY WITH THIS CONTRACT. THE CONTRACTOR IS RESPONSIBLE FOR COORDINATING ALL ELECTRICAL WORK FOR THIS CONTRACT WITH THE WORK IN THOSE CONTRACTS. THIS COORDINATION WORK SHALL BE INCLUDED AT NO ADDITIONAL COST TO THIS CONTRACT.
5. ALL OF THE EXISTING LIGHTING UNITS AND LIGHTING CIRCUITS CURRENTLY FED FROM EXISTING IDOT LIGHTING CONTROLLERS SHALL REMAIN ENERGIZED DURING NIGHTTIME HOURS FOR THE DURATION OF THE CONTRACT. ANY TEMPORARY POWER REQUIRED TO KEEP THE LIGHTING SYSTEM ENERGIZED WILL BE PROVIDED BY THE CONTRACTOR AT NO ADDITIONAL COST TO THE CONTRACT.
6. ALL EXISTING LIGHT TOWERS SHOWN TO BE REMOVED SHALL BE DISPOSED OF PROPERLY OFFSITE.
7. ROUTE THE PROPOSED UNIT DUCT INTO THE BASE OF EXISTING LIGHT TOWER 4 DAB1 AND CONNECT THE CABLES TO THE EXISTING CABLES WITHIN THE HANDHOLE OF THE HIGH MAST LIGHT TOWER.
8. NOT USED
9. DISCONNECT THE EXISTING SIGN LIGHTING ELECTRICAL FEED AND REMOVE CABLES BACK TO THE NEAREST SPLICE POINT UNAFFECTED BY CONSTRUCTION. THIS WORK SHALL BE PAID FOR UNDER THE "DISCONNECT SIGN LIGHTING AND REMOVE WIRING TO THE NEAREST SPLICE" PAY ITEM.
10. ONCE PROPOSED LIGHT TOWER 7 DIJ2 ON DRAWING E-18 HAS BEEN INSTALLED, ENERGIZED, TESTED, AND APPROVED BY IDOT THE EXISTING LIGHT TOWER 4 DAB1, AND TEMPORARY LIGHTING UNIT 4 DAB4, SHALL BE DEENERGIZED AND REMOVED. ALL EXISTING UNDERGROUND CABLES AND CONDUITS SHALL BE ABANDONED.
11. SPLICE THE PROPOSED UNIT DUCT TO THE EXISTING LIGHTING CIRCUIT CABLES LOCATED IN THE JUNCTION BOX ATTACHED TO THE EXISTING SIGN TRUSS.
12. THE LOCATIONS OF THE WOOD POLES SHOWN ARE APPROXIMATIONS. THE FINAL INSTALLATION LOCATION OF THE POLE SHALL BE STAKED IN THE FIELD AND APPROVED BY THE ENGINEER PRIOR TO INSTALLATION TO IDENTIFY ANY CONFLICTS WITH EXISTING/PROPOSED UTILITIES AND WORK TO BE PERFORMED BY OTHER DISCIPLINES.
13. THE TEMPORARY WOOD POLES AND ASSOCIATED AERIAL CABLES SHALL BE REMOVED ONCE THE PERMANENT FEEDS HAVE BEEN INSTALLED. ANY TEMPORARY UNIT DUCT INSTALLED SHALL BE DISCONNECTED AND ABANDONED IN PLACE. REMOVAL OF AERIAL CABLES ATTACHED TO WOOD POLES WILL NOT BE PAID FOR SEPARATELY AND SHALL BE INCLUDED IN THE COST OF "REMOVE TEMPORARY WOOD POLE" PAY ITEM.
14. TEMPORARY LIGHTING UNIT 4 CCD3 SHALL BE REMOVED ONCE PROPOSED LIGHT TOWER 7 CCD3 ON DRAWING E-18 HAS BEEN INSTALLED, ENERGIZED, TESTED, AND APPROVED BY IDOT. ALL EXISTING UNDERGROUND FEEDS SHALL BE ABANDONED.

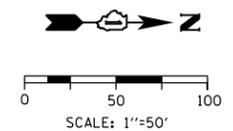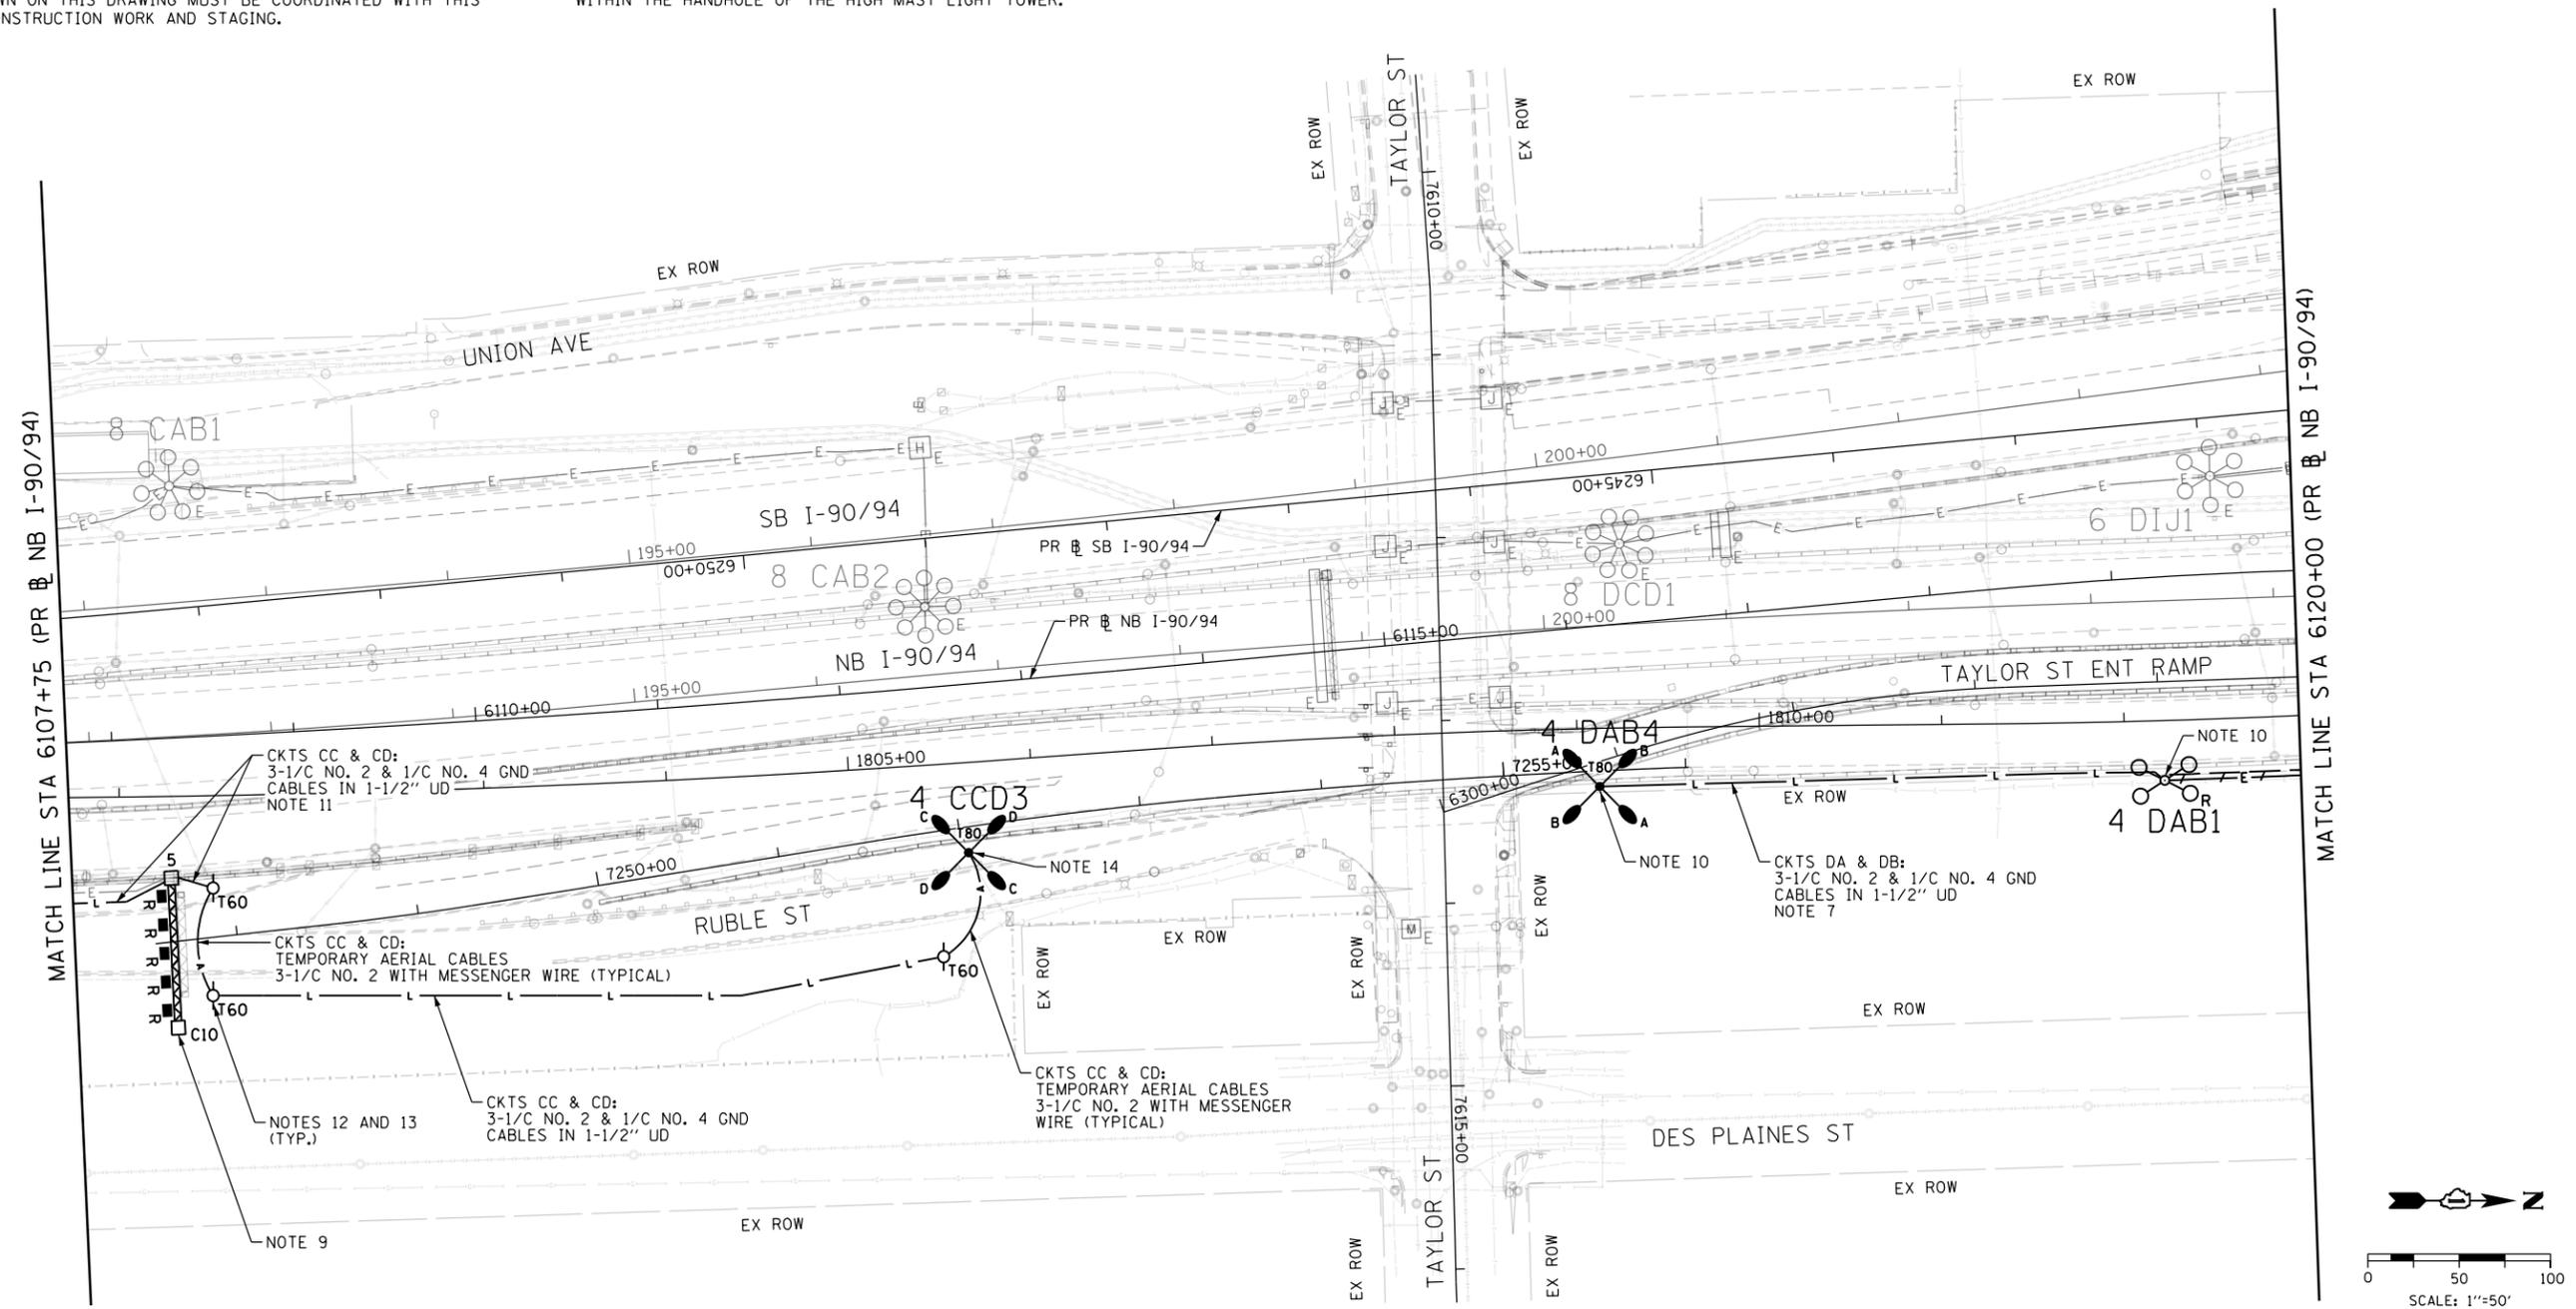

FILE PATH = p:\V\AECOM\NA-AWS\encom\line\local\AECOM_DS02_NA\Documents\01_Americas\Transportation\60269938_Circle Phase\11000_CAD\01E\Electrical\Sheets\62A76_Contract\0162A76_Sht-Light-08



D162A76-Sht-Light-08	DESIGNED - TJL	REVISED -
USER NAME = myersc	DRAWN - CAM	REVISED -
PLOT SCALE = 100.0000' / in.	CHECKED - WDS	REVISED -
PLOT DATE = 3/2/2020	DATE - 3/4/20	REVISED -

**STATE OF ILLINOIS
DEPARTMENT OF TRANSPORTATION**

EXISTING/TEMPORARY LIGHTING PLAN	
NB I-90/94	
SCALE: 1"=50'	SHEET 8 OF 33 SHEETS
STA. 6107+75	TO STA. 6120+00



F.A.I. RTE.	SECTION	COUNTY	TOTAL SHEETS	SHEET NO.
90/94/290	2015-D18R	COOK	2155	1087
CONTRACT NO. 62A76				
ILLINOIS FED. AID PROJECT				

E-08

NOTES:

1. SEE DRAWING E-01 FOR IDOT ELECTRICAL SYMBOLS.
2. THE EXISTING ELECTRICAL SYSTEMS, AS DEPICTED ON THE PLANS, ARE INTENDED TO INDICATE THE GENERAL EQUIPMENT INSTALLATIONS INVOLVED AND SHALL NOT BE CONSTRUED AS AN EXACT REPRESENTATION OF THE FIELD CONDITIONS. IT IS THE CONTRACTOR'S RESPONSIBILITY TO CONFIRM AND ASCERTAIN THE EXACT CONDITION, SIZE, TYPE, QUANTITY AND LOCATION OF THE EXISTING ELECTRICAL EQUIPMENT. ANY DISCREPANCIES BETWEEN THE ACTUAL EXISTING ELECTRICAL EQUIPMENT IN THE FIELD AND THE DEPICTION OF THE EXISTING ELECTRICAL EQUIPMENT SHOWN ON THE PLANS SHALL IMMEDIATELY BE BROUGHT TO THE ATTENTION OF THE RESIDENT ENGINEER FOR RESOLUTION. FAILURE TO VERIFY THE CONDITIONS, DIMENSIONS AND DETAILS OF THE EXISTING ELECTRICAL EQUIPMENT TO CONFIRM THAT THE NEW EQUIPMENT IS COMPATIBLE WITH THE EXISTING EQUIPMENT AND CAN BE PROPERLY INSTALLED AND CONNECTED AS SHOWN ON THE PLANS WILL NOT RELIEVE THE CONTRACTOR OF THEIR RESPONSIBILITY FOR PROVIDING A SAFE, COMPLETE AND FULLY FUNCTIONAL ELECTRICAL SYSTEM.
3. ALL WORK SHOWN ON THIS DRAWING MUST BE COORDINATED WITH THIS CONTRACT'S CONSTRUCTION WORK AND STAGING.
4. IDOT CONTRACTS 60X94, 62A77, 62A76 AND 60Y00 WILL BE ONGOING SIMULTANEOUSLY WITH THIS CONTRACT. THE CONTRACTOR IS RESPONSIBLE FOR COORDINATING ALL ELECTRICAL WORK FOR THIS CONTRACT WITH THE WORK IN THOSE CONTRACTS. THIS COORDINATION WORK SHALL BE INCLUDED AT NO ADDITIONAL COST TO THIS CONTRACT.
5. ALL OF THE EXISTING LIGHTING UNITS AND LIGHTING CIRCUITS CURRENTLY FED FROM EXISTING IDOT LIGHTING CONTROLLERS SHALL REMAIN ENERGIZED DURING NIGHTTIME HOURS FOR THE DURATION OF THE CONTRACT. ANY TEMPORARY POWER REQUIRED TO KEEP THE LIGHTING SYSTEM ENERGIZED WILL BE PROVIDED BY THE CONTRACTOR AT NO ADDITIONAL COST TO THE CONTRACT.
6. DRILL THE EXISTING JUNCTION BOX ATTACHED TO THE BACK OF THE RETAINING WALL AND CONNECT THE PROPOSED UNIT DUCT TO THE EXISTING LIGHTING CABLES WITHIN THE JUNCTION BOX. ROUTE THE UNIT DUCT FROM THE JUNCTION BACK TO THE TEMPORARY LIGHTING UNIT 4 DAB5.
7. TEMPORARY LIGHTING UNIT 4 DAB5 SHALL BE REMOVED ONCE PROPOSED LIGHT TOWER 7 DIJ1 ON DRAWING E-19 HAS BEEN INSTALLED, ENERGIZED, TESTED, AND APPROVED BY IDOT. ALL EXISTING UNDERGROUND FEEDS SHALL BE ABANDONED.
8. THE EXISTING FEED FOR LIGHT TOWER 4 DAB1 SHALL REMAIN ACTIVE UNTIL LIGHT TOWER 7 DIJ2 ON DRAWING E-18 HAS BEEN INSTALLED, ENERGIZED, TESTED, AND APPROVED BY IDOT.

FILE PATH = p:\a\ecdm\m\ansi\ecdm\local\ecdm\0502\NA\Documents\01_Americas\Transportation\60269938_Circle\Phase\I\000_CAD\01E\Electrical\Sheets\62A76_Contract\I\62A76_Sht-Light-09

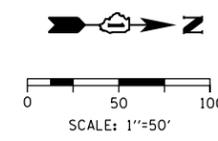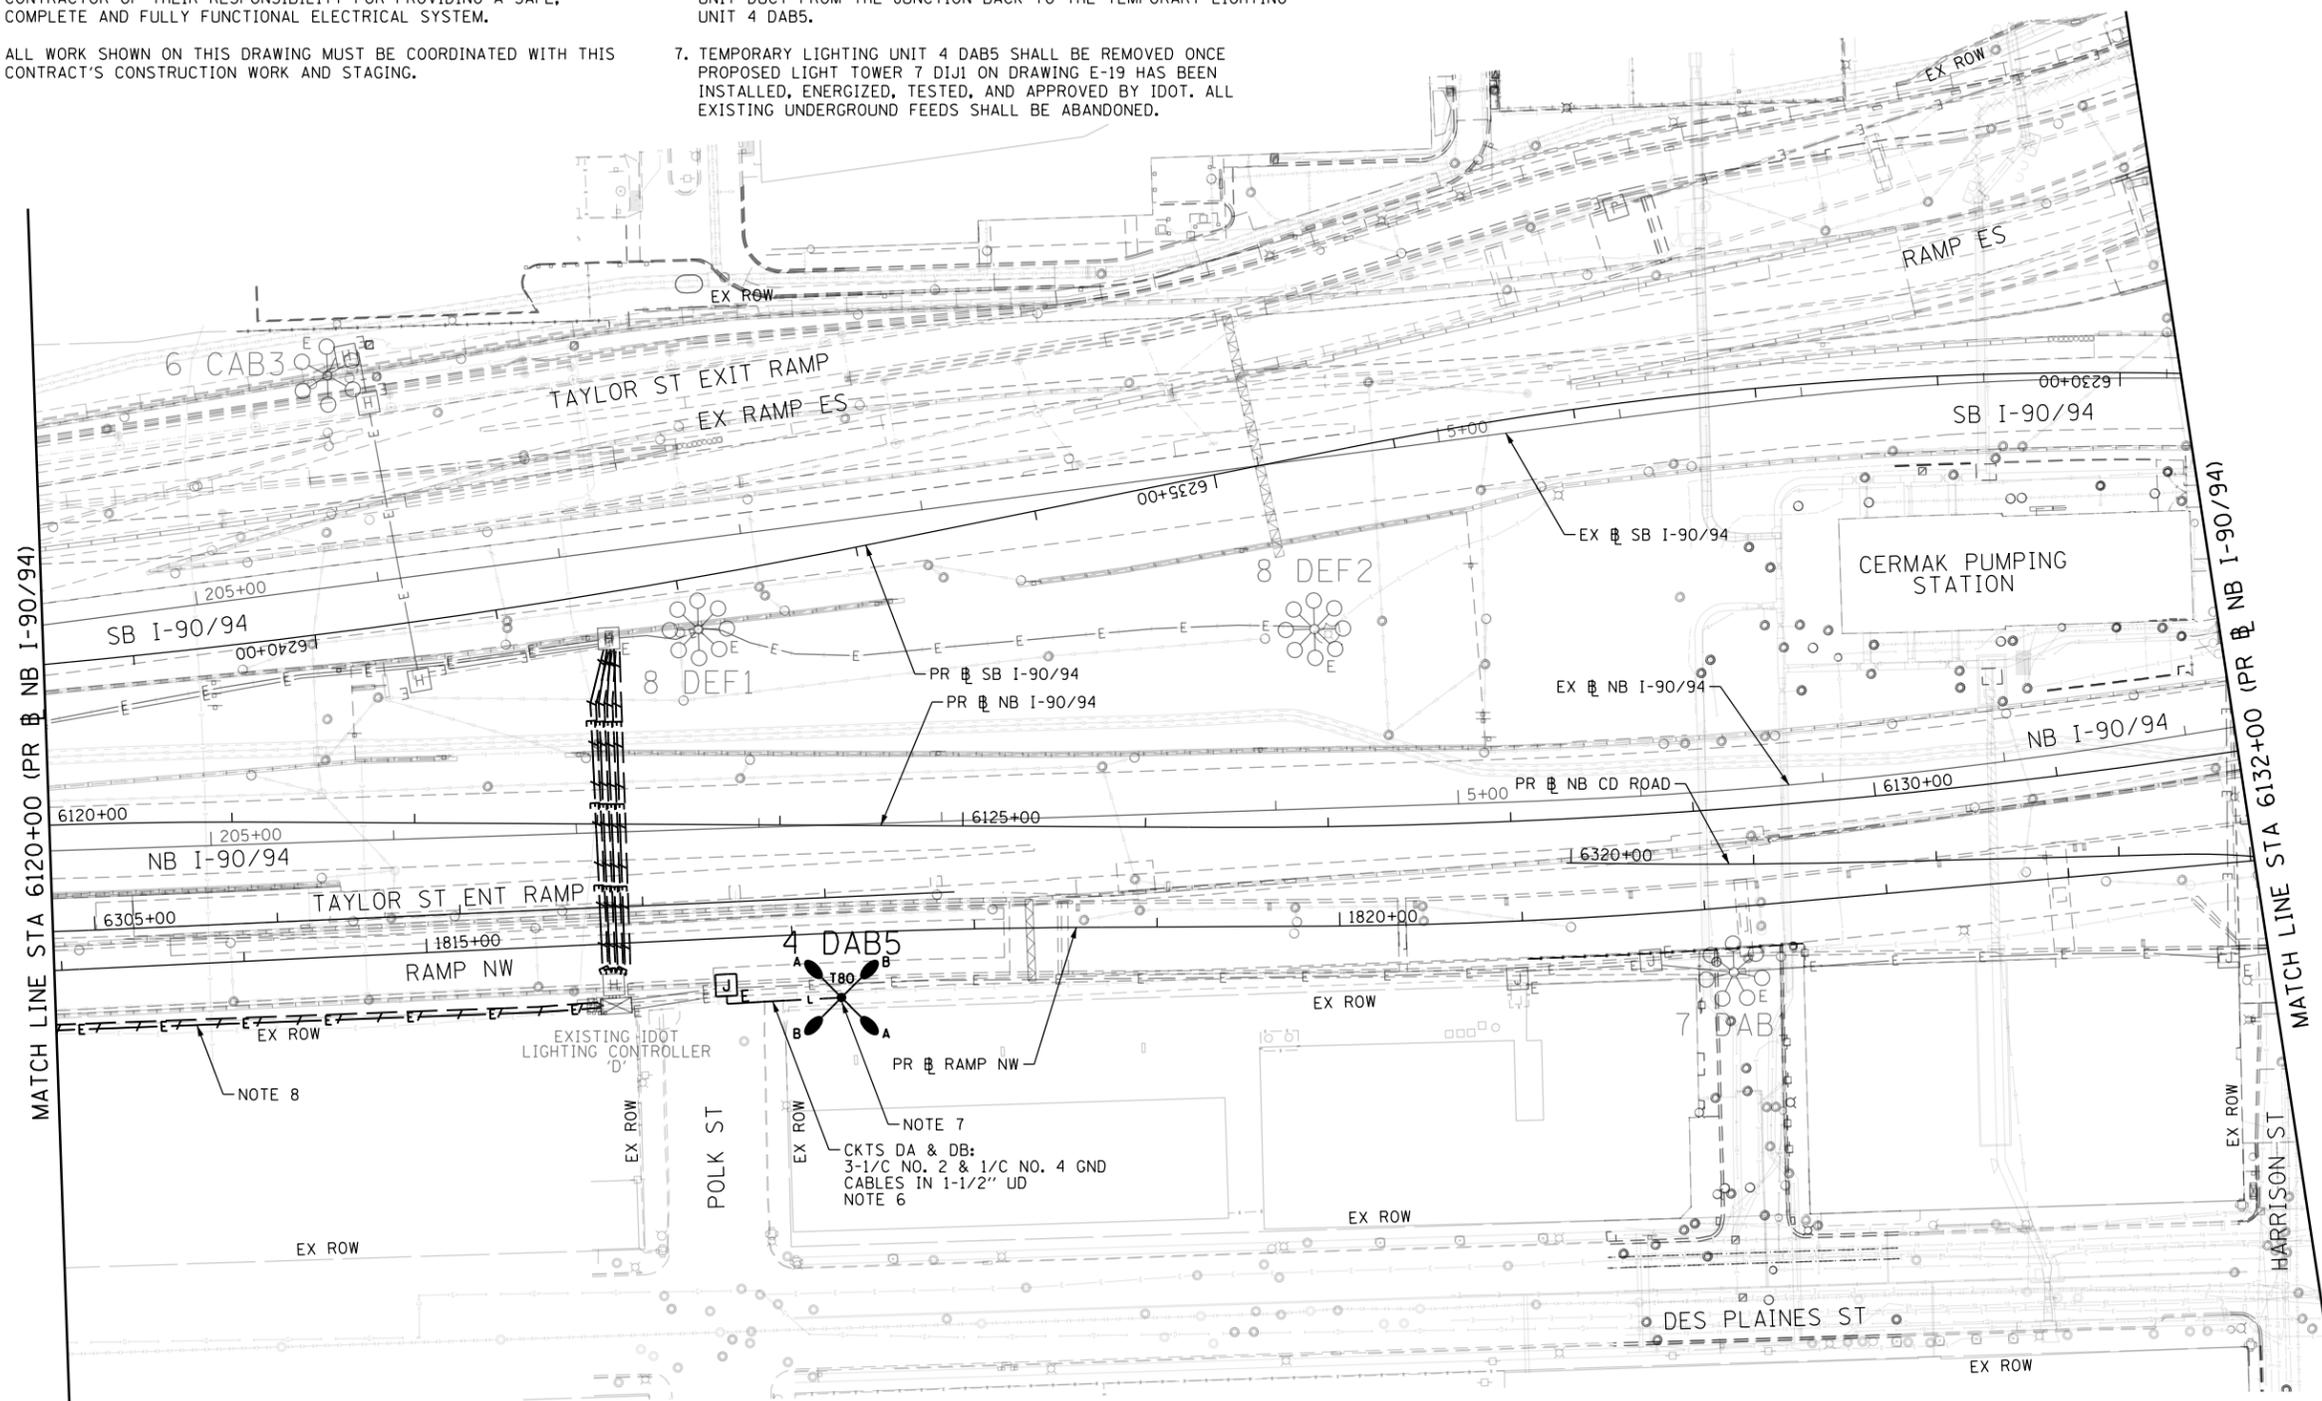

E-09



D162A76-Sht-Light-09
 USER NAME = myersc
 PLOT SCALE = 100.0000' / 1"
 PLOT DATE = 1/23/2020

DESIGNED - TJL	REVISED -
DRAWN - CAM	REVISED -
CHECKED - WDS	REVISED -
DATE - 1/29/20	REVISED -

STATE OF ILLINOIS
 DEPARTMENT OF TRANSPORTATION

EXISTING/TEMPORARY LIGHTING PLAN
 NB I-90/94


SCALE: 1"=50' SHEET 9 OF 33 SHEETS STA. 6120+00 TO STA. 6132+00

F.A.I. RTE.	SECTION	COUNTY	TOTAL SHEETS	SHEET NO.
90/94/290	2015-D18R	COOK	2155	1088
CONTRACT NO. 62A76				
ILLINOIS FED. AID PROJECT				

NO WORK SHOWN ON THIS SHEET

NOTES:

1. SEE DRAWING E-01 FOR IDOT ELECTRICAL SYMBOLS.
2. THE EXISTING ELECTRICAL SYSTEMS, AS DEPICTED ON THE PLANS, ARE INTENDED TO INDICATE THE GENERAL EQUIPMENT INSTALLATIONS INVOLVED AND SHALL NOT BE CONSTRUED AS AN EXACT REPRESENTATION OF THE FIELD CONDITIONS. IT IS THE CONTRACTOR'S RESPONSIBILITY TO CONFIRM AND ASCERTAIN THE EXACT CONDITION, SIZE, TYPE, QUANTITY AND LOCATION OF THE EXISTING ELECTRICAL EQUIPMENT. ANY DISCREPANCIES BETWEEN THE ACTUAL EXISTING ELECTRICAL EQUIPMENT IN THE FIELD AND THE DEPICTION OF THE EXISTING ELECTRICAL EQUIPMENT SHOWN ON THE PLANS SHALL IMMEDIATELY BE BROUGHT TO THE ATTENTION OF THE RESIDENT ENGINEER FOR RESOLUTION. FAILURE TO VERIFY THE CONDITIONS, DIMENSIONS AND DETAILS OF THE EXISTING ELECTRICAL EQUIPMENT TO CONFIRM THAT THE NEW EQUIPMENT IS COMPATIBLE WITH THE EXISTING EQUIPMENT AND CAN BE PROPERLY INSTALLED AND CONNECTED AS SHOWN ON THE PLANS WILL NOT RELIEVE THE CONTRACTOR OF THEIR RESPONSIBILITY FOR PROVIDING A SAFE, COMPLETE AND FULLY FUNCTIONAL ELECTRICAL SYSTEM.

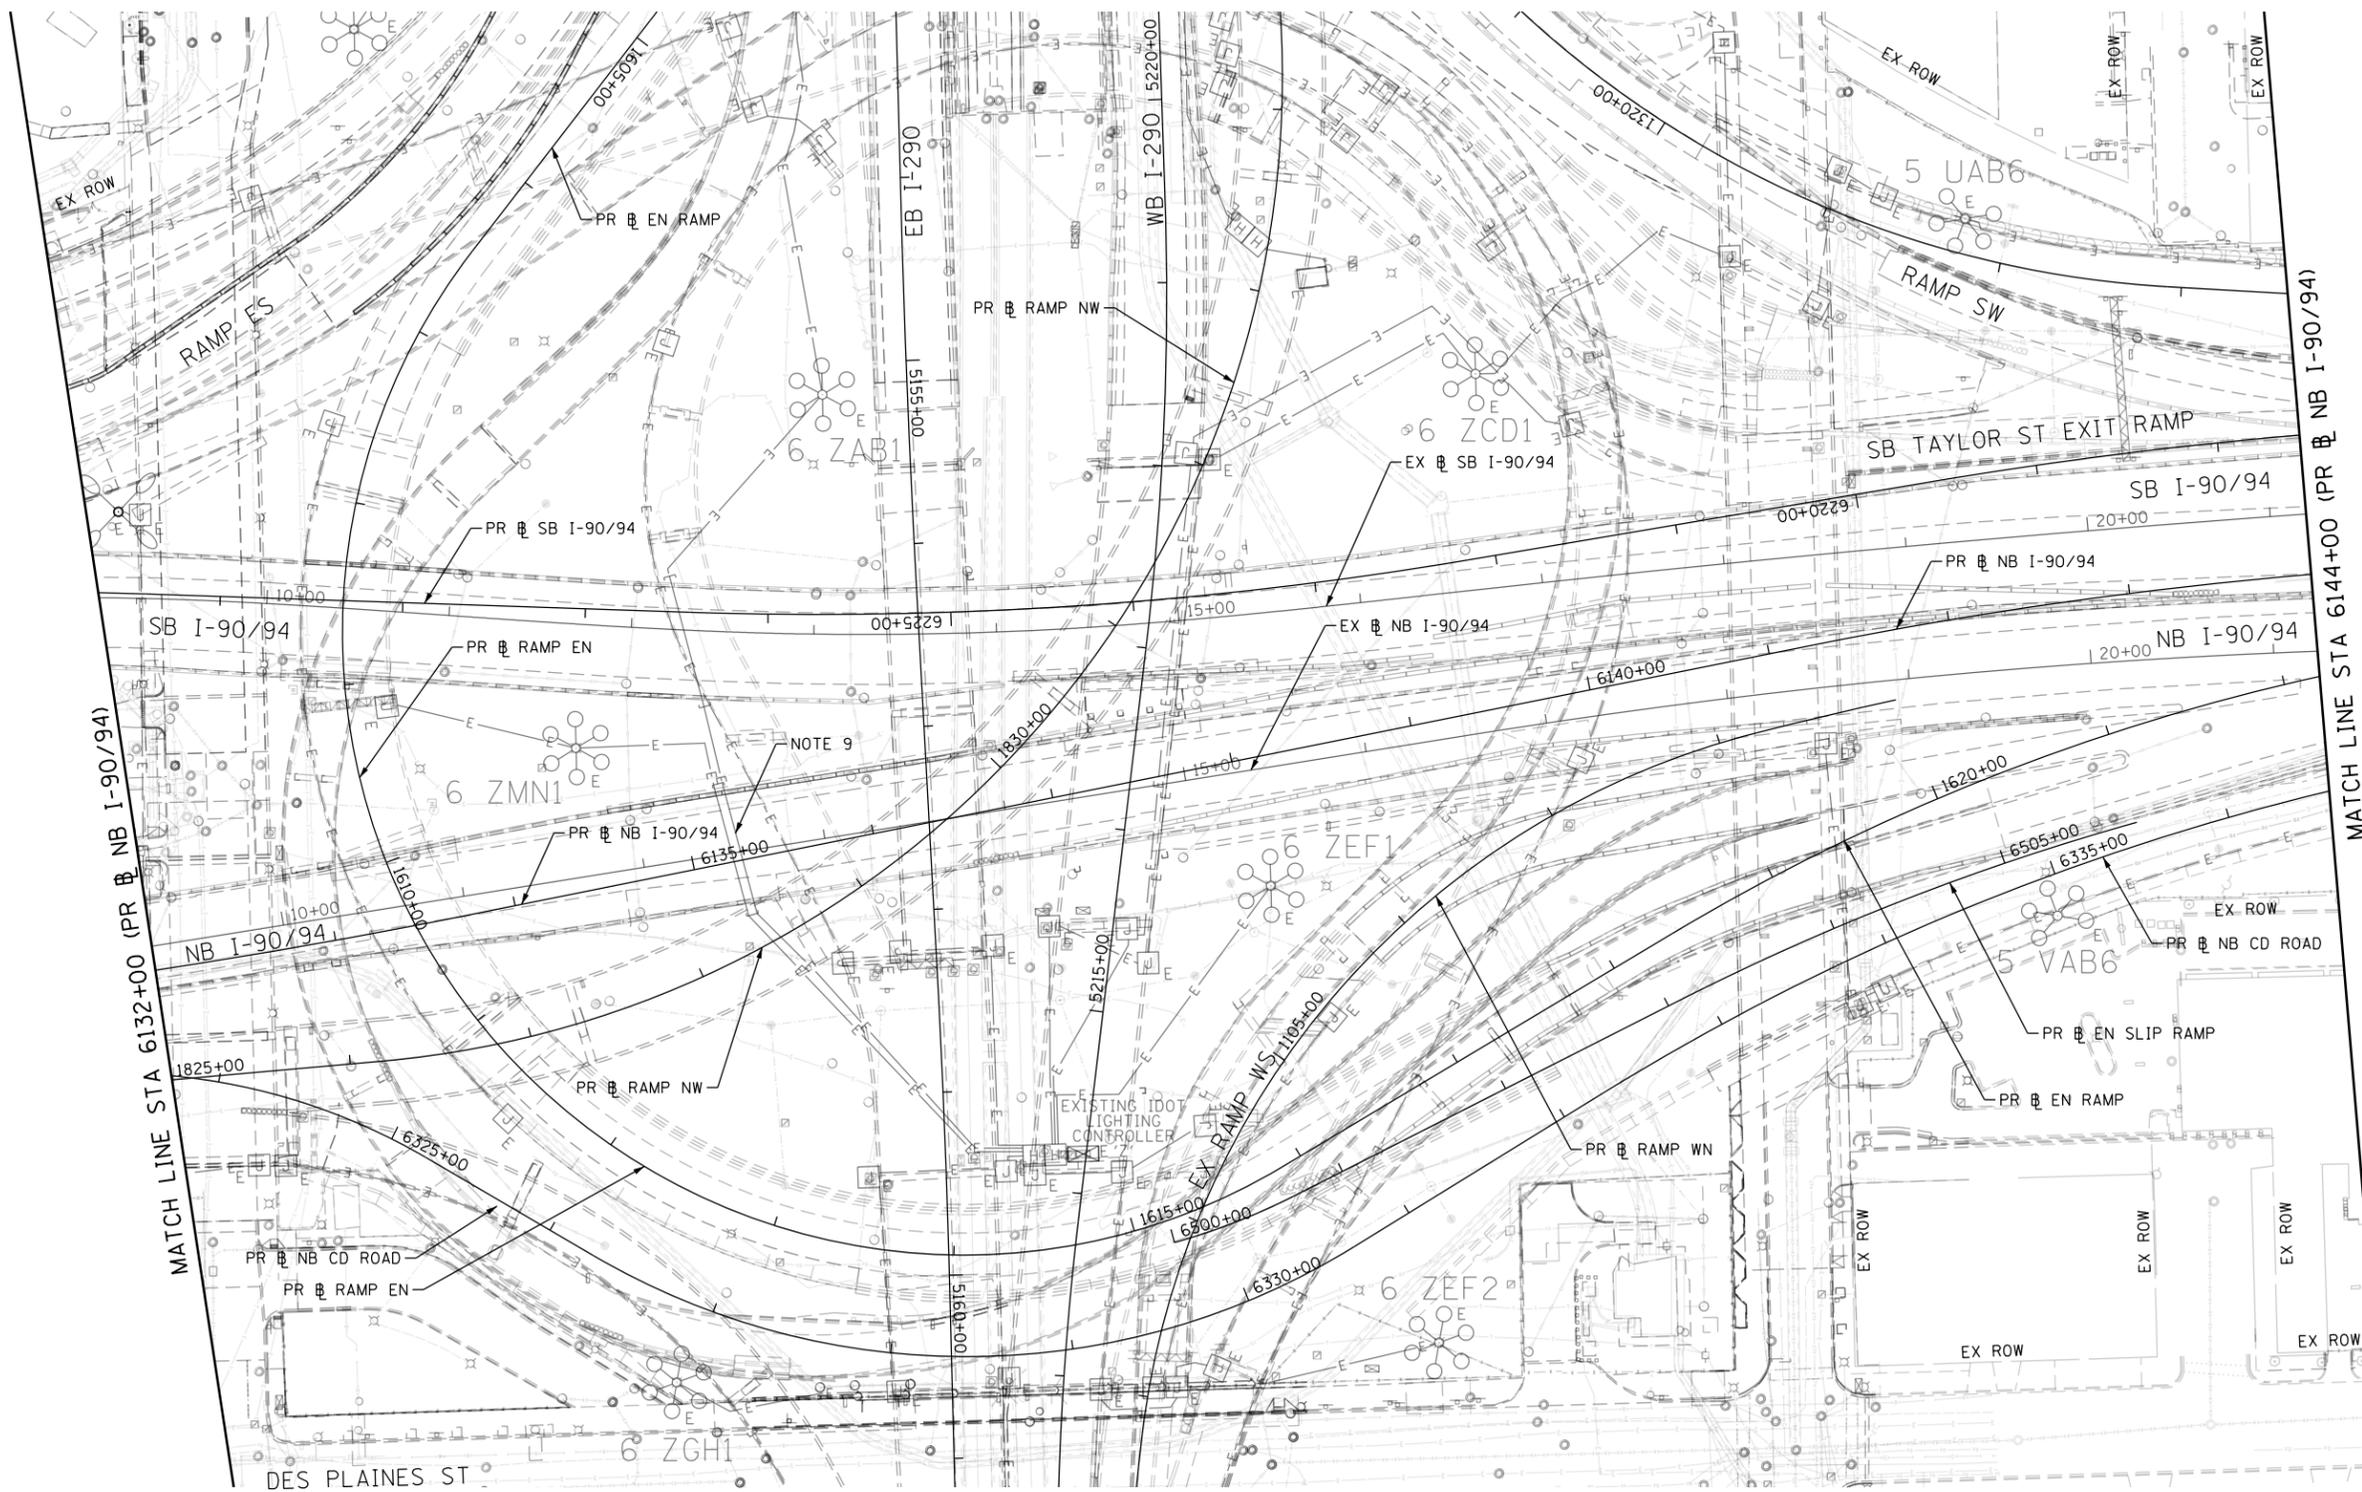

FILE PATH = p:\AECOM\NA-AWS\encom\line\local\AECOM_DS02_NA\Documents\01_Americas\Transportation\60269938_Circle_Phase_1\000_CAD\01E_Electrical\Sheets\62A76_Contract\0162A76_Sht-Light-10



D162A76-Sht-Light-10
 USER NAME = myersc
 PLOT SCALE = 100.0000' / in.
 PLOT DATE = 1/23/2020

DESIGNED - TJL
 DRAWN - CAM
 CHECKED - WDS
 DATE - 1/29/20

REVISED -
 REVISED -
 REVISED -
 REVISED -

STATE OF ILLINOIS
 DEPARTMENT OF TRANSPORTATION

EXISTING LIGHTING PLAN
 NB I-90/94



SCALE: 1"=50' SHEET 10 OF 33 SHEETS STA. 6132+00 TO STA. 6144+00

F.A.I. RTE.	SECTION	COUNTY	TOTAL SHEETS	SHEET NO.
90/94/290	2015-D18R	COOK	2155	1089
CONTRACT NO. 62A76				
ILLINOIS FED. AID PROJECT				

E-10

NOTES:

- SEE DRAWING E-01 FOR IDOT ELECTRICAL SYMBOLS.
- THE EXISTING ELECTRICAL SYSTEMS, AS DEPICTED ON THE PLANS, ARE INTENDED TO INDICATE THE GENERAL EQUIPMENT INSTALLATIONS INVOLVED AND SHALL NOT BE CONSTRUED AS AN EXACT REPRESENTATION OF THE FIELD CONDITIONS. IT IS THE CONTRACTOR'S RESPONSIBILITY TO CONFIRM AND ASCERTAIN THE EXACT CONDITION, SIZE, TYPE, QUANTITY AND LOCATION OF THE EXISTING ELECTRICAL EQUIPMENT. ANY DISCREPANCIES BETWEEN THE ACTUAL EXISTING ELECTRICAL EQUIPMENT IN THE FIELD AND THE DEPICTION OF THE EXISTING ELECTRICAL EQUIPMENT SHOWN ON THE PLANS SHALL IMMEDIATELY BE BROUGHT TO THE ATTENTION OF THE RESIDENT ENGINEER FOR RESOLUTION. FAILURE TO VERIFY THE CONDITIONS, DIMENSIONS AND DETAILS OF THE EXISTING ELECTRICAL EQUIPMENT TO CONFIRM THAT THE NEW EQUIPMENT IS COMPATIBLE WITH THE EXISTING EQUIPMENT AND CAN BE PROPERLY INSTALLED AND CONNECTED AS SHOWN ON THE PLANS WILL NOT RELIEVE THE CONTRACTOR OF THEIR RESPONSIBILITY FOR PROVIDING A SAFE, COMPLETE AND FULLY FUNCTIONAL ELECTRICAL SYSTEM.
- ALL WORK SHOWN ON THIS DRAWING MUST BE COORDINATED WITH THIS CONTRACT'S CONSTRUCTION WORK AND STAGING.
- IDOT CONTRACTS 60X94, 62A77, 62A76 AND 60Y00 WILL BE ONGOING SIMULTANEOUSLY WITH THIS CONTRACT. THE CONTRACTOR IS RESPONSIBLE FOR COORDINATING ALL ELECTRICAL WORK FOR THIS CONTRACT WITH THE WORK IN THOSE CONTRACTS. THIS COORDINATION WORK SHALL BE INCLUDED AT NO ADDITIONAL COST TO THIS CONTRACT.
- ALL OF THE EXISTING LIGHTING UNITS AND LIGHTING CIRCUITS CURRENTLY FED FROM EXISTING IDOT LIGHTING CONTROLLERS SHALL REMAIN ENERGIZED DURING NIGHTTIME HOURS FOR THE DURATION OF THE CONTRACT. ANY TEMPORARY POWER REQUIRED TO KEEP THE LIGHTING SYSTEM ENERGIZED WILL BE PROVIDED BY THE CONTRACTOR AT NO ADDITIONAL COST TO THE CONTRACT.
- RELOCATE THE EXISTING AERIAL CABLE AND TEMPORARY WOOD POLE AS SHOWN ON DRAWING E-12. ALL NECESSARY WORK FOR RELOCATING THE AERIAL CABLES AND WOOD POLE SHALL BE INCLUDED IN THE COST OF THE "RELOCATE EXISTING WOOD POLES" PAY ITEM.
- ALL EXISTING LIGHT TOWERS SHOWN TO BE REMOVED SHALL BE DISPOSED OF PROPERLY OFFSITE.
- REMOVAL OF THE AERIAL CABLES ATTACHED TO THE TEMPORARY WOOD POLES WILL NOT BE PAID FOR SEPARATELY AND SHALL BE INCLUDED IN THE COST OF THE "REMOVE TEMPORARY WOOD POLE" PAY ITEM.

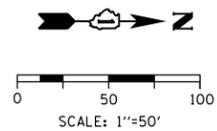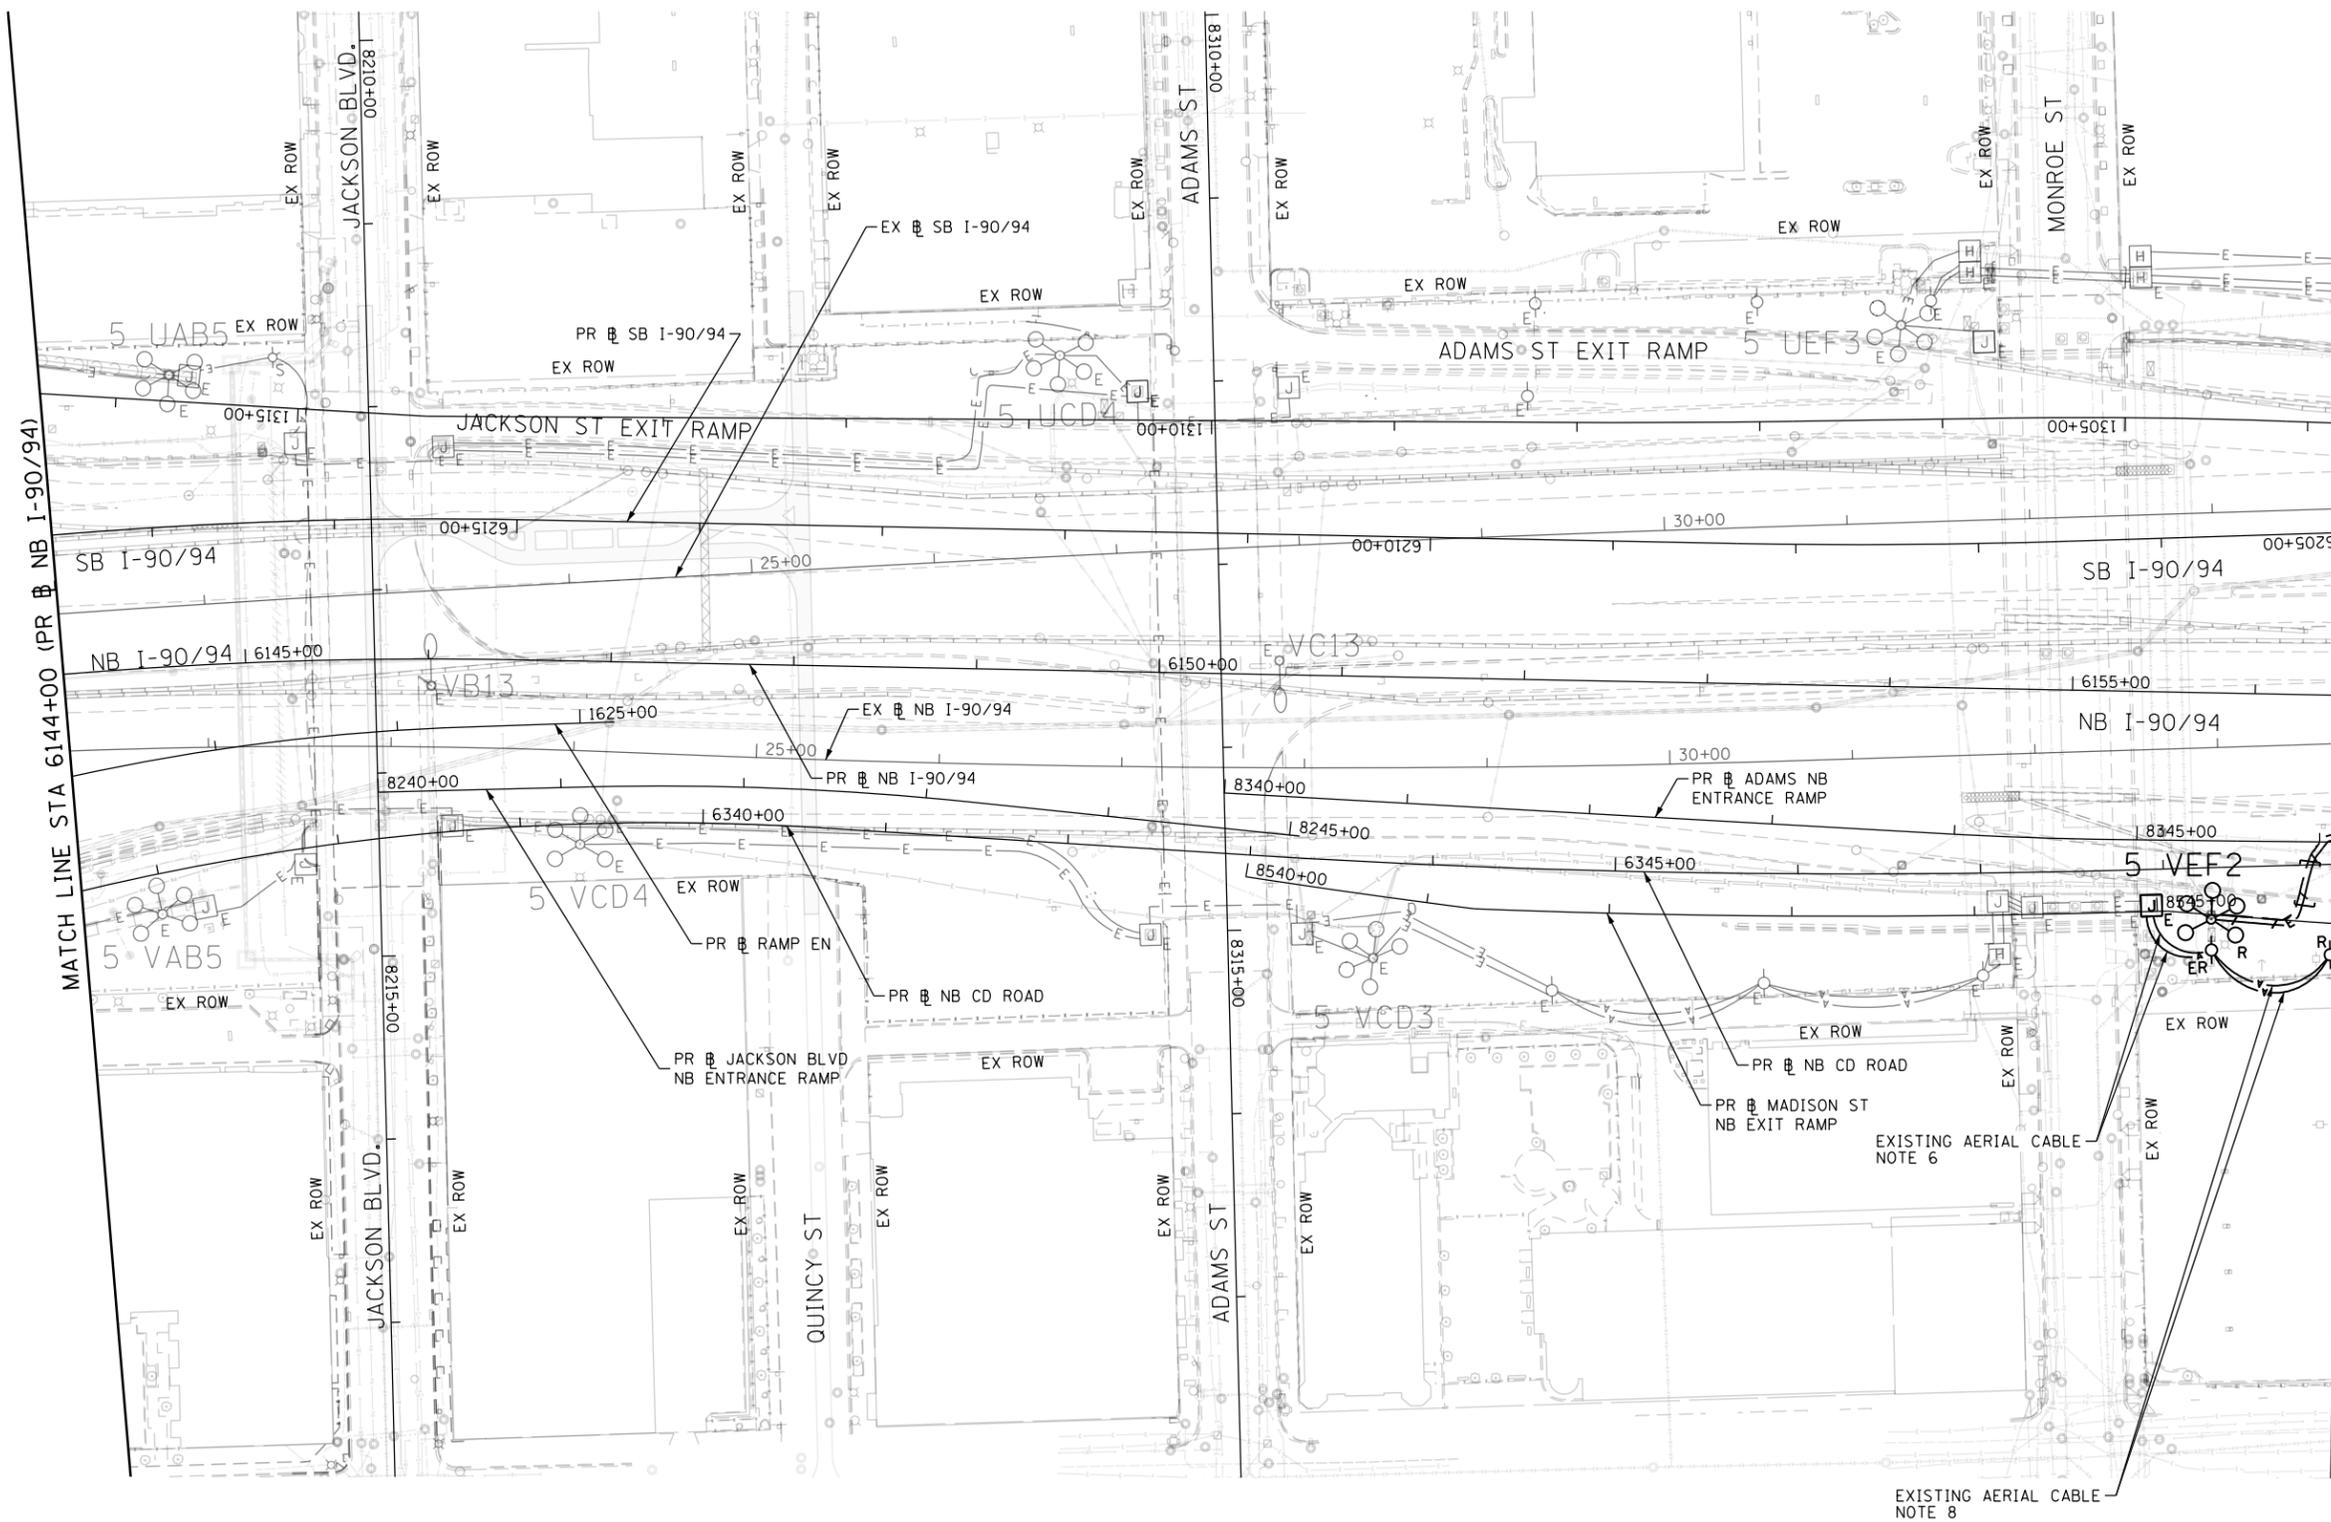

FILE PATH = p:\aecom\ms-ansi\ecomm\line\local\AECOM_DS02_IL\000_CAD\01E\Electrical\Sheets\62A76_Contract\0162A76-Sht-Light-11



D162A76-Sht-Light-11
 USER NAME = myersc
 PLOT SCALE = 100.0000' / in.
 PLOT DATE = 3/2/2020

DESIGNED - TJL	REVISED -
DRAWN - CAM	REVISED -
CHECKED - WDS	REVISED -
DATE - 3/4/20	REVISED -

**STATE OF ILLINOIS
 DEPARTMENT OF TRANSPORTATION**

**EXISTING LIGHTING REMOVAL PLAN
 NB I-90/94**

SCALE: 1"=50' SHEET 11 OF 33 SHEETS STA. 6144+00 TO STA. 6156+50


F.A.I. RTE.	SECTION	COUNTY	TOTAL SHEETS	SHEET NO.
90/94/290	2015-D18R	COOK	2155	1090
CONTRACT NO. 62A76				
ILLINOIS FED. AID PROJECT				

NOTES:


1. SEE DRAWING E-01 FOR IDOT ELECTRICAL SYMBOLS.
2. THE EXISTING ELECTRICAL SYSTEMS, AS DEPICTED ON THE PLANS, ARE INTENDED TO INDICATE THE GENERAL EQUIPMENT INSTALLATIONS INVOLVED AND SHALL NOT BE CONSTRUED AS AN EXACT REPRESENTATION OF THE FIELD CONDITIONS. IT IS THE CONTRACTOR'S RESPONSIBILITY TO CONFIRM AND ASCERTAIN THE EXACT CONDITION, SIZE, TYPE, QUANTITY AND LOCATION OF THE EXISTING ELECTRICAL EQUIPMENT. ANY DISCREPANCIES BETWEEN THE ACTUAL EXISTING ELECTRICAL EQUIPMENT IN THE FIELD AND THE DEPICTION OF THE EXISTING ELECTRICAL EQUIPMENT SHOWN ON THE PLANS SHALL IMMEDIATELY BE BROUGHT TO THE ATTENTION OF THE RESIDENT ENGINEER FOR RESOLUTION. FAILURE TO VERIFY THE CONDITIONS, DIMENSIONS AND DETAILS OF THE EXISTING ELECTRICAL EQUIPMENT TO CONFIRM THAT THE NEW EQUIPMENT IS COMPATIBLE WITH THE EXISTING EQUIPMENT AND CAN BE PROPERLY INSTALLED AND CONNECTED AS SHOWN ON THE PLANS WILL NOT RELIEVE THE CONTRACTOR OF THEIR RESPONSIBILITY FOR PROVIDING A SAFE, COMPLETE AND FULLY FUNCTIONAL ELECTRICAL SYSTEM.
3. ALL WORK SHOWN ON THIS DRAWING MUST BE COORDINATED WITH THIS CONTRACT'S CONSTRUCTION WORK AND STAGING.
4. IDOT CONTRACTS 60X94, 62A77, 62A76 AND 60Y00 WILL BE ONGOING SIMULTANEOUSLY WITH THIS CONTRACT. THE CONTRACTOR IS RESPONSIBLE FOR COORDINATING ALL ELECTRICAL WORK FOR THIS CONTRACT WITH THE WORK IN THOSE CONTRACTS. THIS COORDINATION WORK SHALL BE INCLUDED AT NO ADDITIONAL COST TO THIS CONTRACT.
5. ALL OF THE EXISTING LIGHTING UNITS AND LIGHTING CIRCUITS CURRENTLY FED FROM EXISTING IDOT LIGHTING CONTROLLERS SHALL REMAIN ENERGIZED DURING NIGHTTIME HOURS FOR THE DURATION OF THE CONTRACT. ANY TEMPORARY POWER REQUIRED TO KEEP THE LIGHTING SYSTEM ENERGIZED WILL BE PROVIDED BY THE CONTRACTOR AT NO ADDITIONAL COST TO THE CONTRACT.
6. REMOVAL OF THE AERIAL CABLES ATTACHED TO THE TEMPORARY WOOD POLES WILL NOT BE PAID FOR SEPARATELY AND SHALL BE INCLUDED IN THE COST OF THE "REMOVE TEMPORARY WOOD POLE" PAY ITEM.
7. THE TEMPORARY WOOD POLES AND ASSOCIATED AERIAL CABLES SHALL BE REMOVED ONCE THE PERMANENT FEEDS SHOWN ON DRAWING E-21 HAVE BEEN INSTALLED, ENERGIZED, TESTED AND APPROVED BY IDOT.

MATCH LINE STA 6157+00 (PR NB I-90/94) SEE DRAWING E-14


MATCH LINE STA 6157+00 (PR NB I-90/94) SEE DRAWING E-14

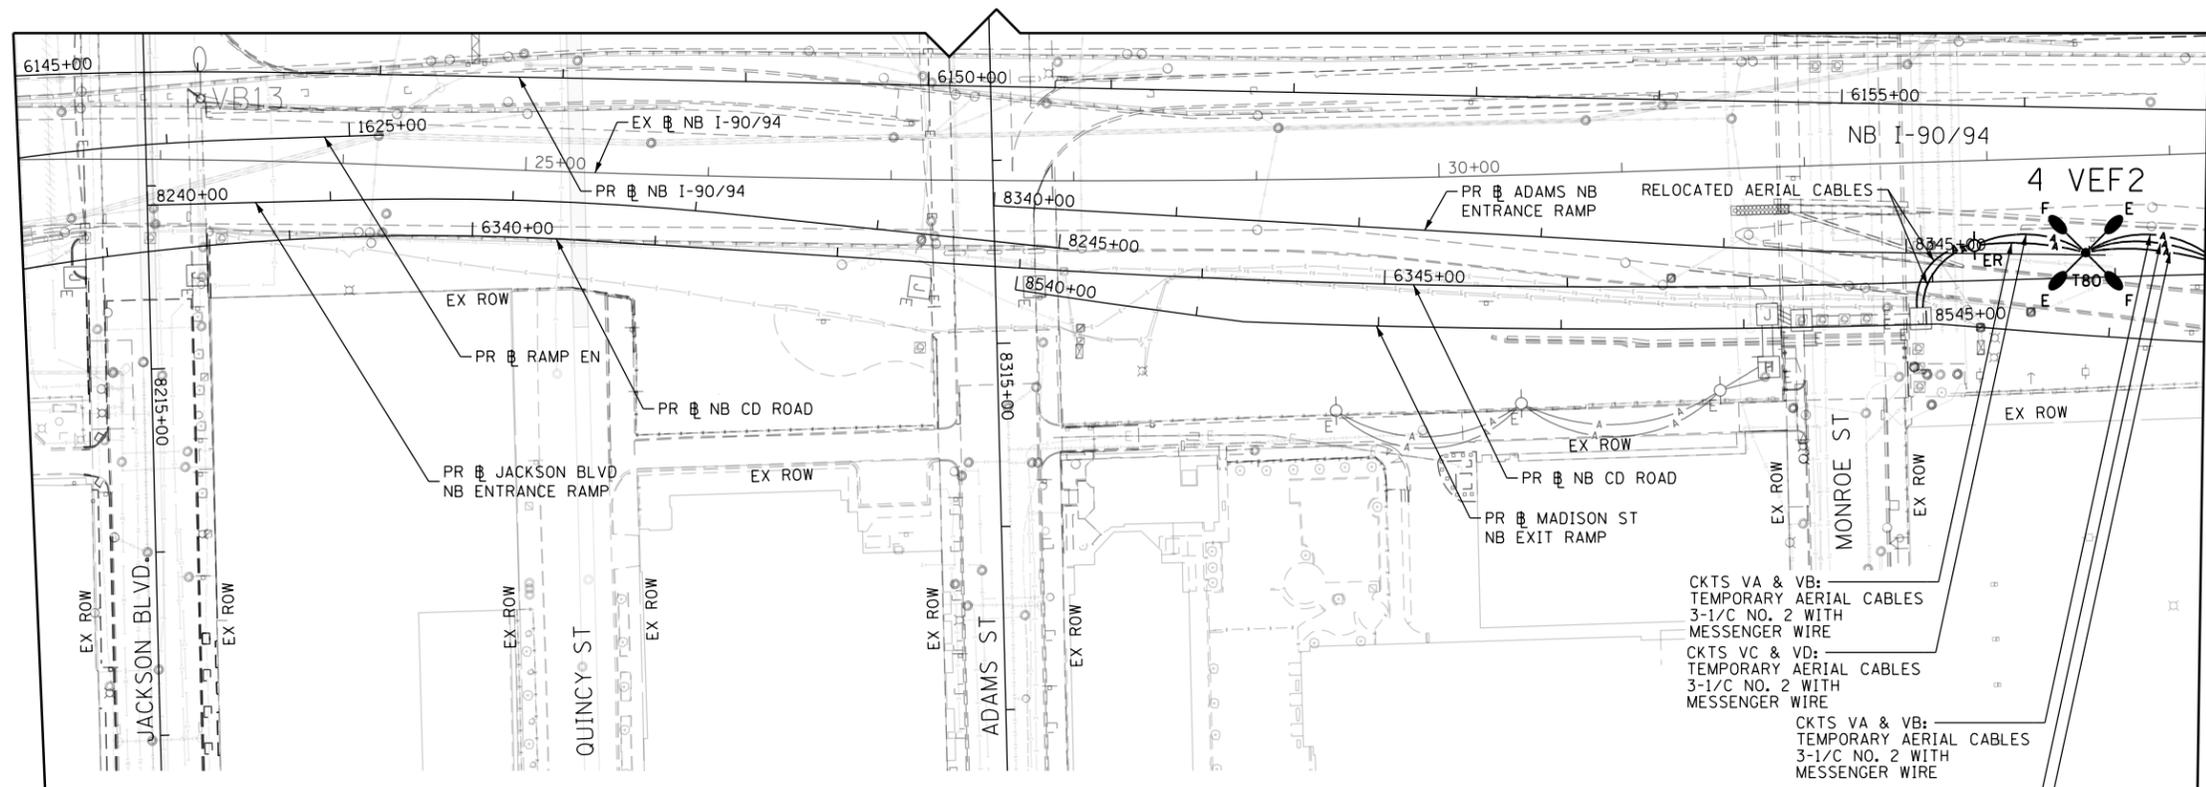

TEMPORARY LIGHTING PLAN - STAGE 1

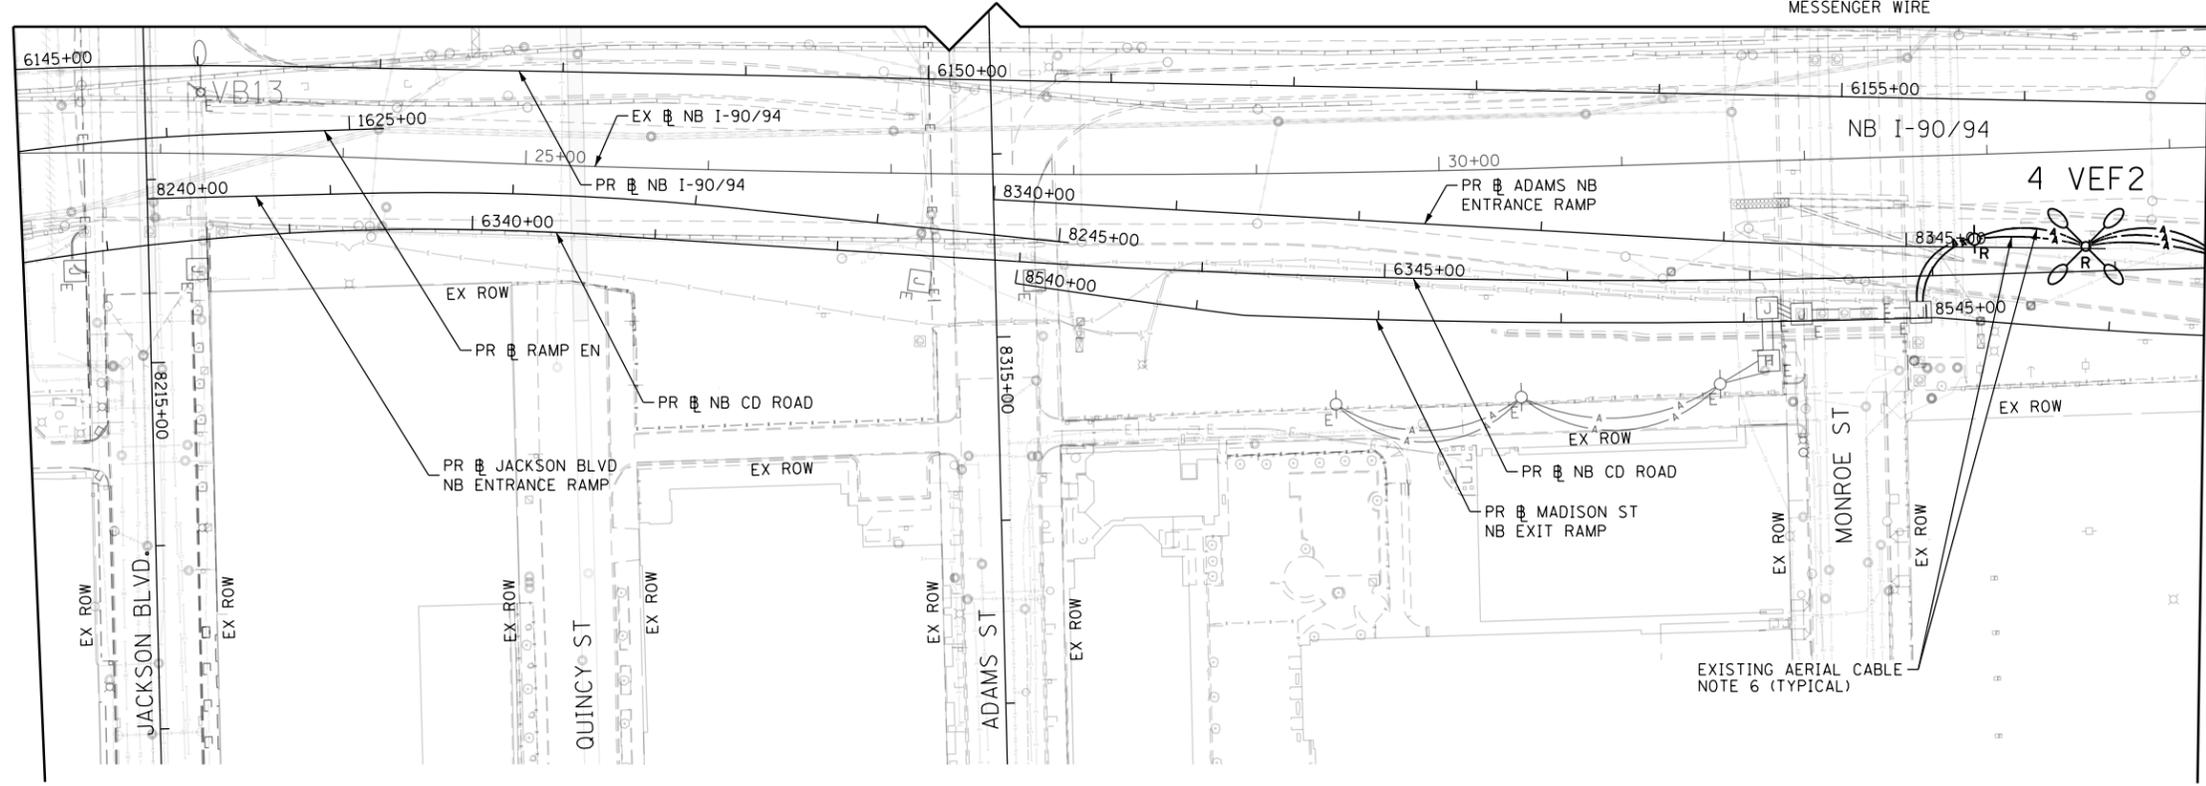

TEMPORARY LIGHTING PLAN - STAGE 2
NOTE 7

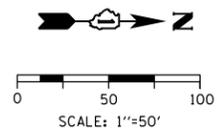

FILE PATH = p:\aecom\ms-ansi\ecmon\line\local\AECOM_DS02_MA_Documents\01_Americas\Transportation\60269938_Circle Phase II\000_CAD\01E\Electrical\Sheets\62A76_Contract\0162A76-Sht-Light-12



D162A76-Sht-Light-12	DESIGNED - TJL	REVISED -
USER NAME = myersc	DRAWN - CAM	REVISED -
PLOT SCALE = 100.0000' / in.	CHECKED - WDS	REVISED -
PLOT DATE = 1/23/2020	DATE - 1/29/20	REVISED -

**STATE OF ILLINOIS
DEPARTMENT OF TRANSPORTATION**



**TEMPORARY LIGHTING PLAN
NB I-90/94**

SCALE: 1"=50' SHEET 12 OF 33 SHEETS STA. 6145+00 TO STA. 6157+00

F.A.I. RTE.	SECTION	COUNTY	TOTAL SHEETS	SHEET NO.
90/94/290	2015-D18R	COOK	2155	1091
CONTRACT NO. 62A76				
ILLINOIS FED. AID PROJECT				

NOTES:

- SEE DRAWING E-01 FOR IDOT ELECTRICAL SYMBOLS.
- THE EXISTING ELECTRICAL SYSTEMS, AS DEPICTED ON THE PLANS, ARE INTENDED TO INDICATE THE GENERAL EQUIPMENT INSTALLATIONS INVOLVED AND SHALL NOT BE CONSTRUED AS AN EXACT REPRESENTATION OF THE FIELD CONDITIONS. IT IS THE CONTRACTOR'S RESPONSIBILITY TO CONFIRM AND ASCERTAIN THE EXACT CONDITION, SIZE, TYPE, QUANTITY AND LOCATION OF THE EXISTING ELECTRICAL EQUIPMENT. ANY DISCREPANCIES BETWEEN THE ACTUAL EXISTING ELECTRICAL EQUIPMENT IN THE FIELD AND THE DEPICTION OF THE EXISTING ELECTRICAL EQUIPMENT SHOWN ON THE PLANS SHALL IMMEDIATELY BE BROUGHT TO THE ATTENTION OF THE RESIDENT ENGINEER FOR RESOLUTION. FAILURE TO VERIFY THE CONDITIONS, DIMENSIONS AND DETAILS OF THE EXISTING ELECTRICAL EQUIPMENT TO CONFIRM THAT THE NEW EQUIPMENT IS COMPATIBLE WITH THE EXISTING EQUIPMENT AND CAN BE PROPERLY INSTALLED AND CONNECTED AS SHOWN ON THE PLANS WILL NOT RELIEVE THE CONTRACTOR OF THEIR RESPONSIBILITY FOR PROVIDING A SAFE, COMPLETE AND FULLY FUNCTIONAL ELECTRICAL SYSTEM.
- ALL WORK SHOWN ON THIS DRAWING MUST BE COORDINATED WITH THIS CONTRACT'S CONSTRUCTION WORK AND STAGING.
- IDOT CONTRACTS 60X94, 62A77, 62A76 AND 60Y00 WILL BE ONGOING SIMULTANEOUSLY WITH THIS CONTRACT. THE CONTRACTOR IS RESPONSIBLE FOR COORDINATING ALL ELECTRICAL WORK FOR THIS CONTRACT WITH THE WORK IN THOSE CONTRACTS. THIS COORDINATION WORK SHALL BE INCLUDED AT NO ADDITIONAL COST TO THIS CONTRACT.
- ALL OF THE EXISTING LIGHTING UNITS AND LIGHTING CIRCUITS CURRENTLY FED FROM EXISTING IDOT LIGHTING CONTROLLERS SHALL REMAIN ENERGIZED DURING NIGHTTIME HOURS FOR THE DURATION OF THE CONTRACT. ANY TEMPORARY POWER REQUIRED TO KEEP THE LIGHTING SYSTEM ENERGIZED WILL BE PROVIDED BY THE CONTRACTOR AT NO ADDITIONAL COST TO THE CONTRACT.
- RELOCATE THE EXISTING AERIAL CABLE AND TEMPORARY WOOD POLE AS SHOWN ON DRAWING E-14. ALL NECESSARY WORK FOR RELOCATING THE AERIAL CABLES AND WOOD POLE SHALL BE INCLUDED IN THE COST OF THE "RELOCATE EXISTING WOOD POLES" PAY ITEM.
- ALL EXISTING LIGHT TOWERS SHOWN TO BE REMOVED SHALL BE DISPOSED OF PROPERLY OFFSITE.
- REMOVAL OF THE AERIAL CABLES ATTACHED TO THE TEMPORARY WOOD POLES WILL NOT BE PAID FOR SEPARATELY AND SHALL BE INCLUDED IN THE COST OF THE "REMOVE TEMPORARY WOOD POLE" PAY ITEM.
- REMOVE THE EXISTING JUNCTION BOX ATTACHED TO THE SOUTH END OF THE MADISON STREET ABUTMENT AND RELOCATE IT TO THE WEST FACE OF THE ABUTMENT IN LINE WITH THE EXISTING CONDUIT ATTACHED TO STRUCTURE.
- THE EXISTING WOOD POLE SHALL BE RELOCATED TO AVOID CONFLICT WITH THE PROPOSED TSRS BEING INSTALLED FOR THE CONSTRUCTION OF PROPOSED RETAINING WALL 31. SEE STRUCTURAL PLANS FOR LIMITS OF TSRS.

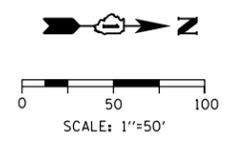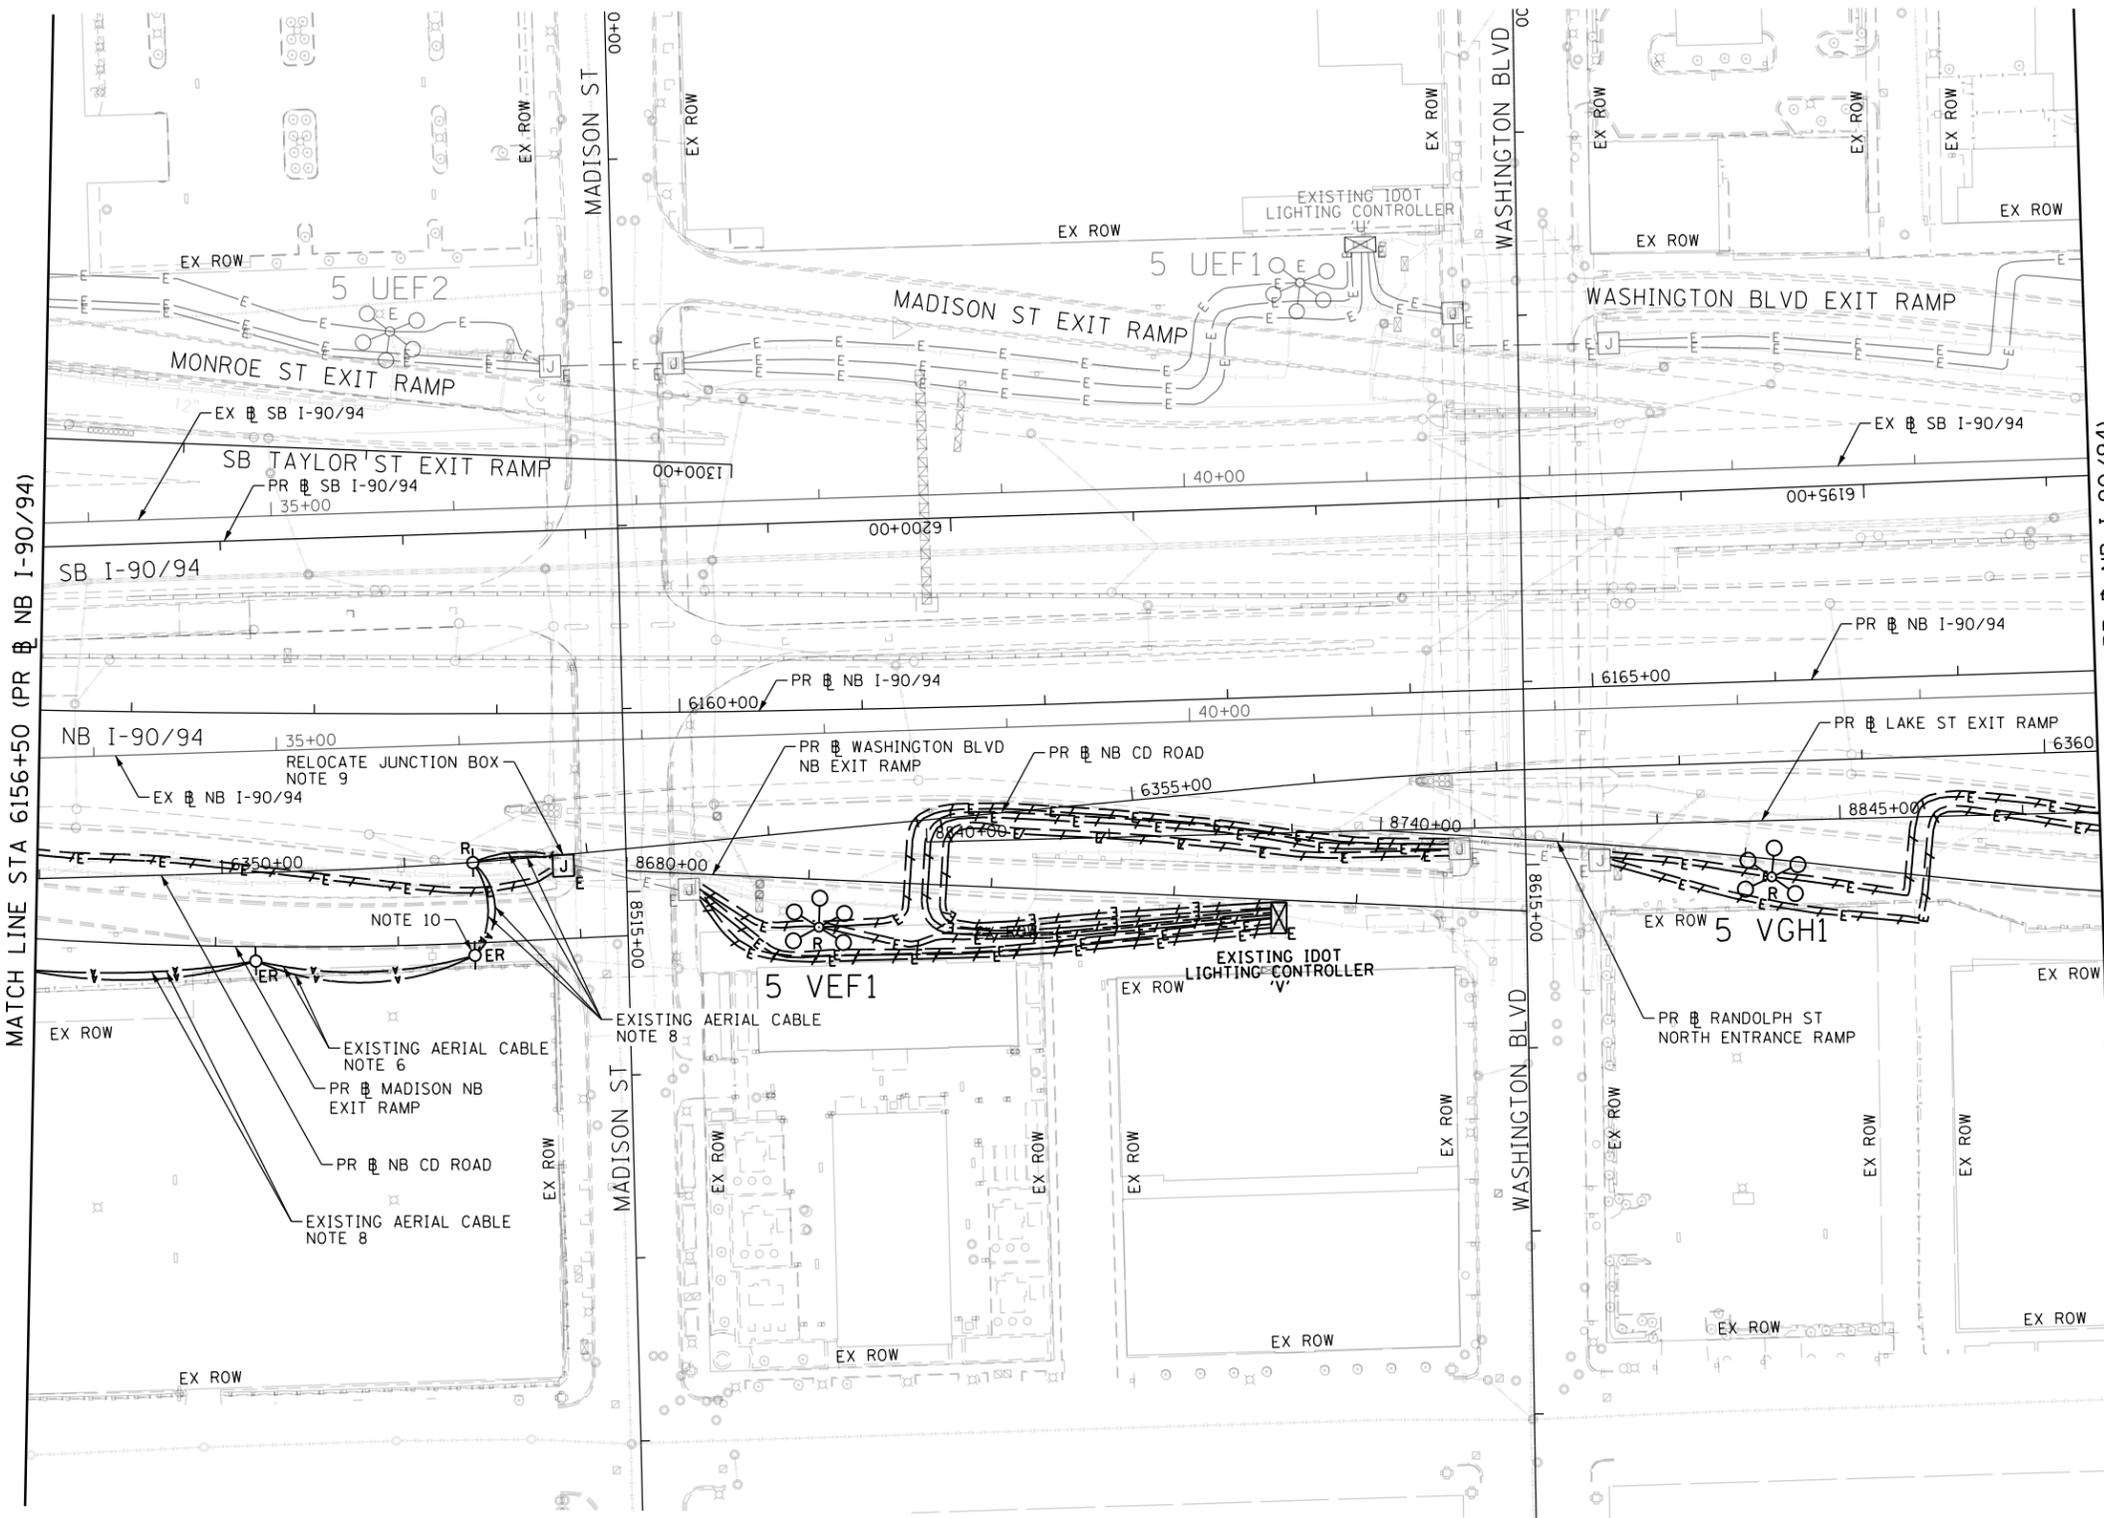

E-13

FILE PATH = p:\aecom\m-n\ansi\electrical\local\AECOM_D502_MA\Documents\01_Americas\Transportation\60269938_Circle Phase II\000_CAD\01E\Electrical\Sheets\62A76_Contract\0162A76_Sht-Light-13



D162A76-Sht-Light-13
 USER NAME = myersc
 PLOT SCALE = 100.0000' / in.
 PLOT DATE = 3/2/2020

DESIGNED - TJL	REVISED -
DRAWN - CAM	REVISED -
CHECKED - WDS	REVISED -
DATE - 3/4/20	REVISED -


**STATE OF ILLINOIS
 DEPARTMENT OF TRANSPORTATION**

**EXISTING LIGHTING REMOVAL PLAN
 NB I-90/94**


SCALE: 1"=50' SHEET 13 OF 33 SHEETS STA. 6156+50 TO STA. 6167+75

F.A.I. RTE.	SECTION	COUNTY	TOTAL SHEETS	SHEET NO.
90/94/290	2015-D18R	COOK	2155	1092
CONTRACT NO. 62A76				
ILLINOIS FED. AID PROJECT				

FILE PATH = p:\V\AECOM\NA-AWS\encom\line\local\AECOM_DS02_NA\Documents\01_Americas\Transportation\60269938_Circle Phase\11000_CAD\01E\Electrical\Sheets\62A76_Contract\11000_Sht-Light-14

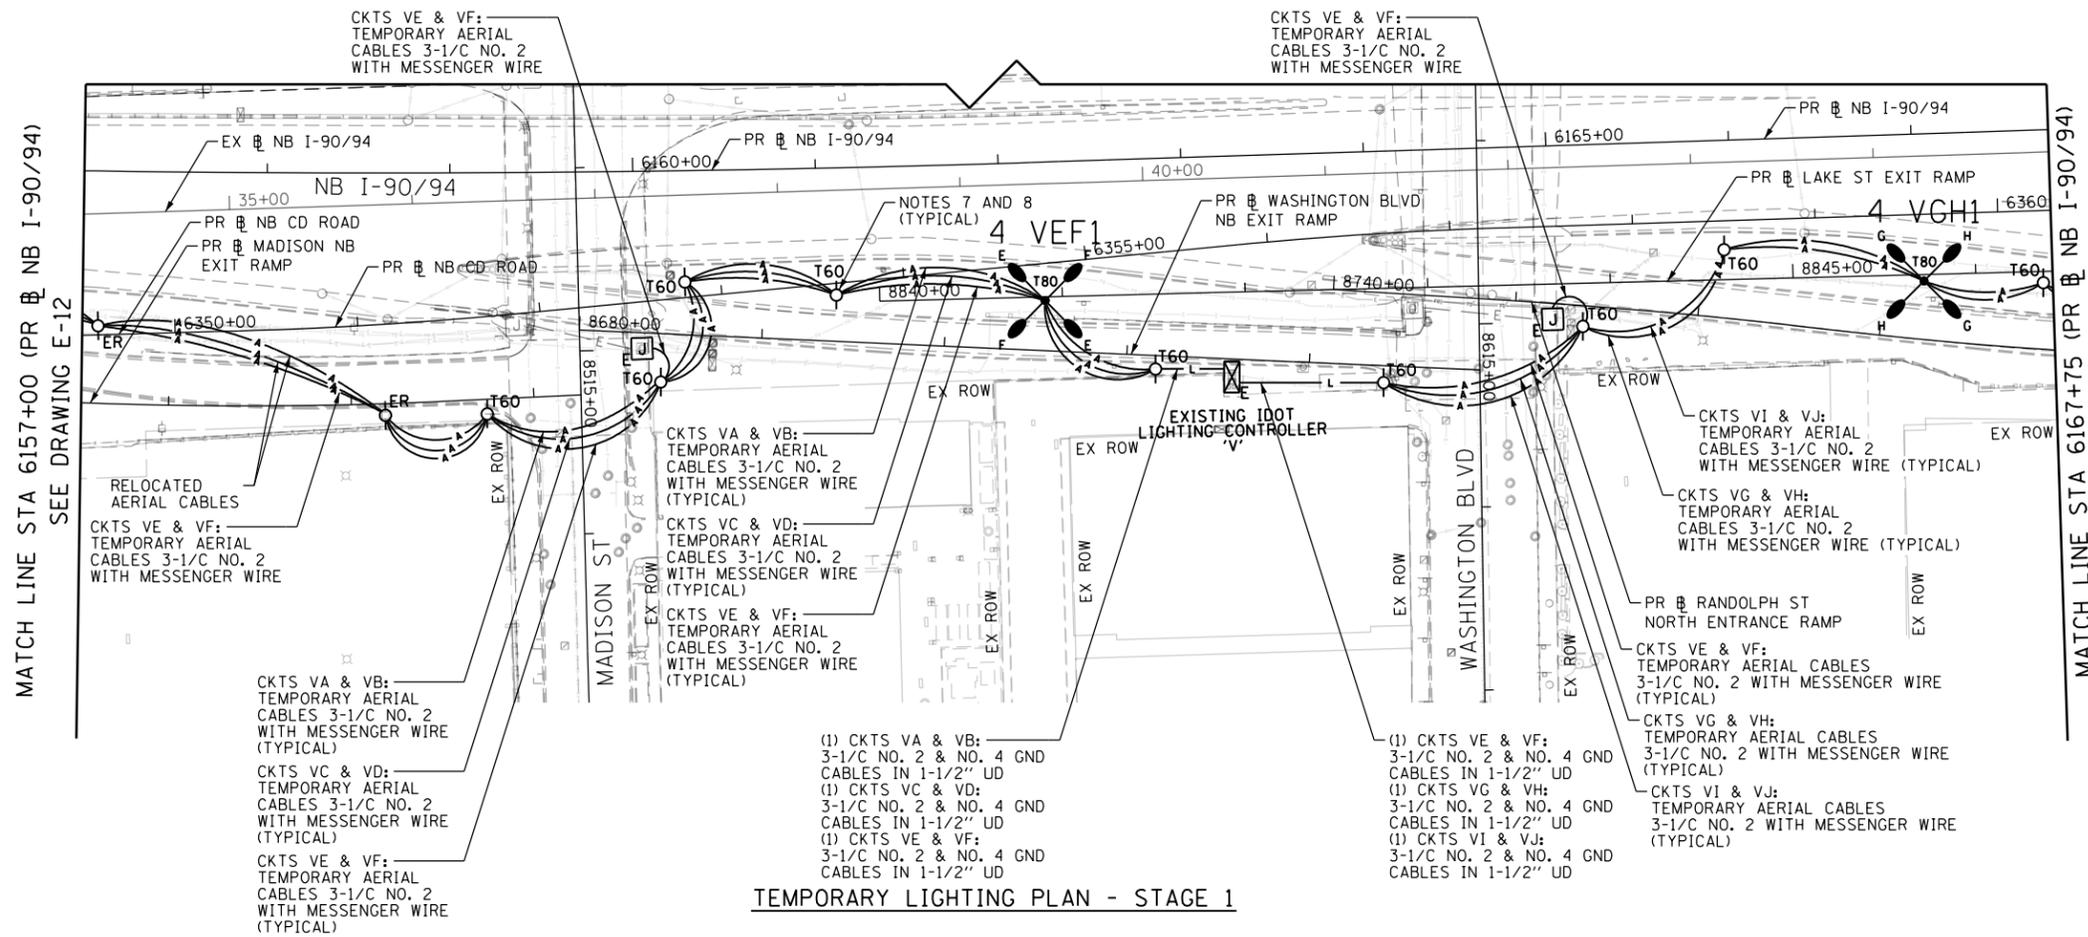


TEMPORARY LIGHTING PLAN - STAGE 1

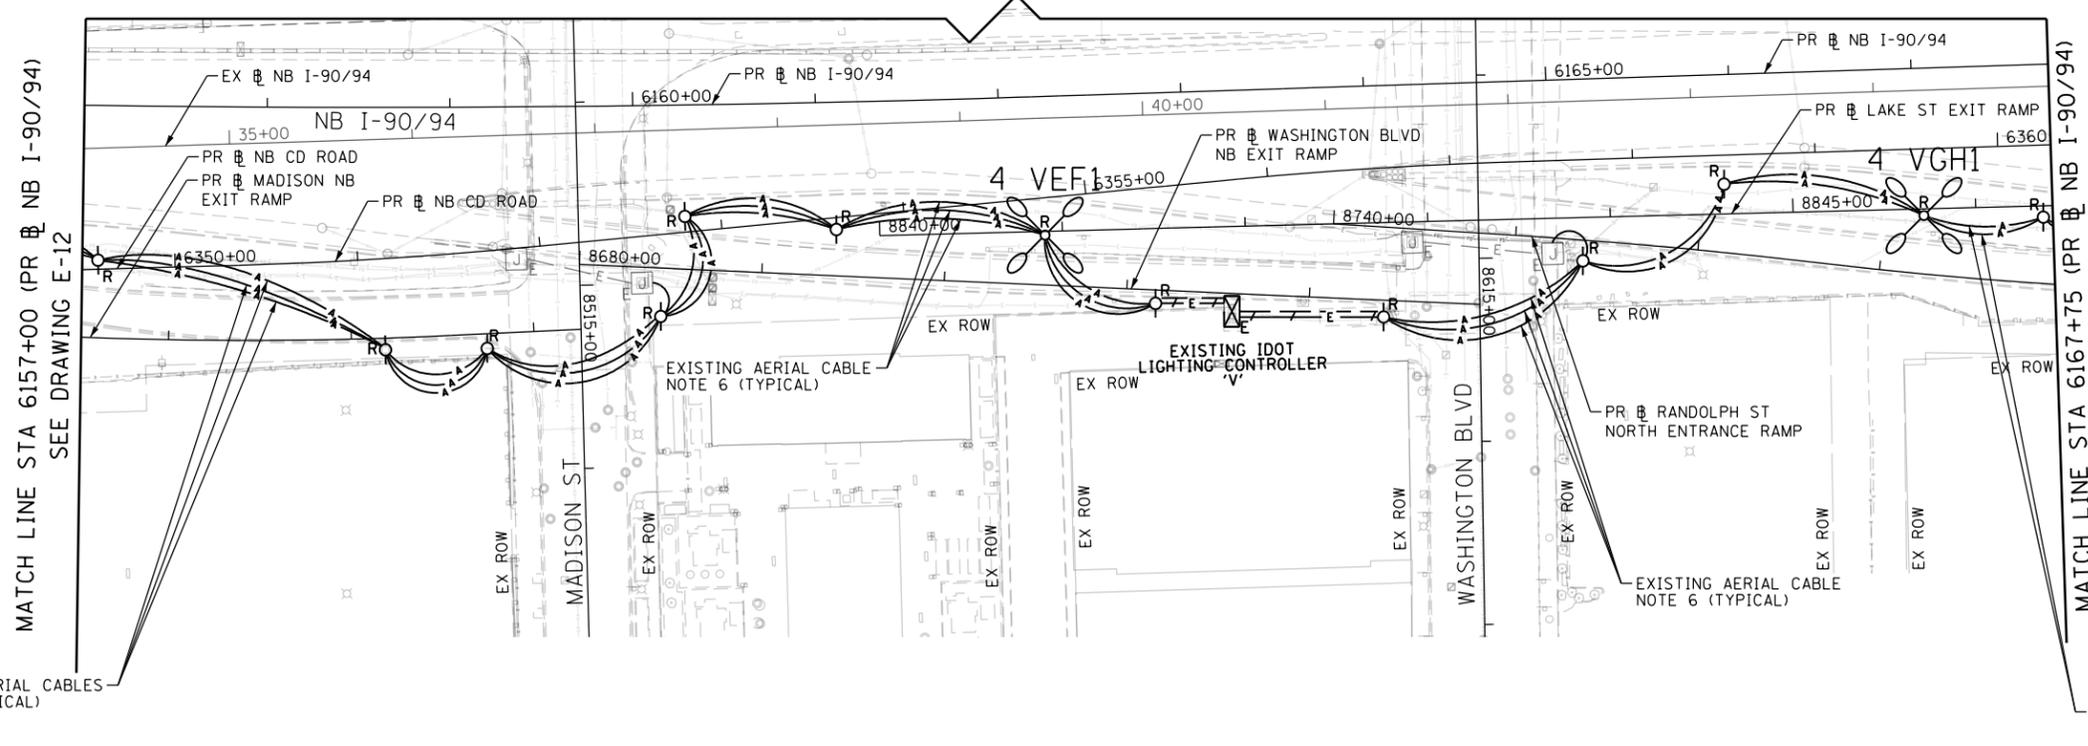

TEMPORARY LIGHTING PLAN - STAGE 2

- NOTES:**
- SEE DRAWING E-01 FOR IDOT ELECTRICAL SYMBOLS.
 - THE EXISTING ELECTRICAL SYSTEMS, AS DEPICTED ON THE PLANS, ARE INTENDED TO INDICATE THE GENERAL EQUIPMENT INSTALLATIONS INVOLVED AND SHALL NOT BE CONSTRUED AS AN EXACT REPRESENTATION OF THE FIELD CONDITIONS. IT IS THE CONTRACTOR'S RESPONSIBILITY TO CONFIRM AND ASCERTAIN THE EXACT CONDITION, SIZE, TYPE, QUANTITY AND LOCATION OF THE EXISTING ELECTRICAL EQUIPMENT. ANY DISCREPANCIES BETWEEN THE ACTUAL EXISTING ELECTRICAL EQUIPMENT IN THE FIELD AND THE DEPICTION OF THE EXISTING ELECTRICAL EQUIPMENT SHOWN ON THE PLANS SHALL IMMEDIATELY BE BROUGHT TO THE ATTENTION OF THE RESIDENT ENGINEER FOR RESOLUTION. FAILURE TO VERIFY THE CONDITIONS, DIMENSIONS AND DETAILS OF THE EXISTING ELECTRICAL EQUIPMENT TO CONFIRM THAT THE NEW EQUIPMENT IS COMPATIBLE WITH THE EXISTING EQUIPMENT AND CAN BE PROPERLY INSTALLED AND CONNECTED AS SHOWN ON THE PLANS WILL NOT RELIEVE THE CONTRACTOR OF THEIR RESPONSIBILITY FOR PROVIDING A SAFE, COMPLETE AND FULLY FUNCTIONAL ELECTRICAL SYSTEM.
 - ALL WORK SHOWN ON THIS DRAWING MUST BE COORDINATED WITH THIS CONTRACT'S CONSTRUCTION WORK AND STAGING.
 - IDOT CONTRACTS 60X94, 62A77, 62A76 AND 60Y00 WILL BE ONGOING SIMULTANEOUSLY WITH THIS CONTRACT. THE CONTRACTOR IS RESPONSIBLE FOR COORDINATING ALL ELECTRICAL WORK FOR THIS CONTRACT WITH THE WORK IN THOSE CONTRACTS. THIS COORDINATION WORK SHALL BE INCLUDED AT NO ADDITIONAL COST TO THIS CONTRACT.
 - ALL OF THE EXISTING LIGHTING UNITS AND LIGHTING CIRCUITS CURRENTLY FED FROM EXISTING IDOT LIGHTING CONTROLLERS SHALL REMAIN ENERGIZED DURING NIGHTTIME HOURS FOR THE DURATION OF THE CONTRACT. ANY TEMPORARY POWER REQUIRED TO KEEP THE LIGHTING SYSTEM ENERGIZED WILL BE PROVIDED BY THE CONTRACTOR AT NO ADDITIONAL COST TO THE CONTRACT.
 - REMOVAL OF THE AERIAL CABLES ATTACHED TO THE TEMPORARY WOOD POLES WILL NOT BE PAID FOR SEPARATELY AND SHALL BE INCLUDED IN THE COST OF THE "REMOVE TEMPORARY WOOD POLE" PAY ITEM.
 - THE LOCATIONS OF THE WOOD POLES SHOWN ARE APPROXIMATIONS. THE FINAL INSTALLATION LOCATION OF THE POLE SHALL BE STAKED IN THE FIELD AND APPROVED BY THE ENGINEER PRIOR TO INSTALLATION TO IDENTIFY ANY CONFLICTS WITH EXISTING/PROPOSED UTILITIES AND WORK TO BE PERFORMED BY OTHER DISCIPLINES.
 - PROVIDE 50 FEET OF SLACK CABLE AT EACH TEMPORARY WOOD POLE TO ALLOW FOR RELOCATION OF AERIAL CABLES DURING THE DIFFERENT STAGES OF CONSTRUCTION.
 - THE TEMPORARY WOOD POLES AND ASSOCIATED AERIAL CABLES SHALL BE REMOVED ONCE THE PERMANENT FEEDS SHOWN ON DRAWING E-22 HAVE BEEN INSTALLED, ENERGIZED, TESTED, AND APPROVED BY IDOT. ANY TEMPORARY UNIT DUCT INSTALLED SHALL BE DISCONNECTED AND ABANDONED IN PLACE.

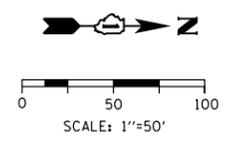

D162A76-Sht-Light-14	DESIGNED - TJL	REVISED -
USER NAME = myersc	DRAWN - CAM	REVISED -
PLOT SCALE = 100.0000' / in.	CHECKED - WDS	REVISED -
PLOT DATE = 1/23/2020	DATE - 1/29/20	REVISED -



STATE OF ILLINOIS
DEPARTMENT OF TRANSPORTATION

TEMPORARY LIGHTING PLAN	
NB I-90/94	
SCALE: 1"=50'	SHEET 14 OF 33 SHEETS
STA. 6157+00	TO STA. 6167+75

F.A.I. RTE.	SECTION	COUNTY	TOTAL SHEETS	SHEET NO.
90/94/290	2015-D18R	COOK	2155	1093
CONTRACT NO. 62A76				
ILLINOIS FED. AID PROJECT				

NOTES:

1. SEE DRAWING E-01 FOR IDOT ELECTRICAL SYMBOLS.
2. THE EXISTING ELECTRICAL SYSTEMS, AS DEPICTED ON THE PLANS, ARE INTENDED TO INDICATE THE GENERAL EQUIPMENT INSTALLATIONS INVOLVED AND SHALL NOT BE CONSTRUED AS AN EXACT REPRESENTATION OF THE FIELD CONDITIONS. IT IS THE CONTRACTOR'S RESPONSIBILITY TO CONFIRM AND ASCERTAIN THE EXACT CONDITION, SIZE, TYPE, QUANTITY AND LOCATION OF THE EXISTING ELECTRICAL EQUIPMENT. ANY DISCREPANCIES BETWEEN THE ACTUAL EXISTING ELECTRICAL EQUIPMENT IN THE FIELD AND THE DEPICTION OF THE EXISTING ELECTRICAL EQUIPMENT SHOWN ON THE PLANS SHALL IMMEDIATELY BE BROUGHT TO THE ATTENTION OF THE RESIDENT ENGINEER FOR RESOLUTION. FAILURE TO VERIFY THE CONDITIONS, DIMENSIONS AND DETAILS OF THE EXISTING ELECTRICAL EQUIPMENT TO CONFIRM THAT THE NEW EQUIPMENT IS COMPATIBLE WITH THE EXISTING EQUIPMENT AND CAN BE PROPERLY INSTALLED AND CONNECTED AS SHOWN ON THE PLANS WILL NOT RELIEVE THE CONTRACTOR OF THEIR RESPONSIBILITY FOR PROVIDING A SAFE, COMPLETE AND FULLY FUNCTIONAL ELECTRICAL SYSTEM.
3. ALL WORK SHOWN ON THIS DRAWING MUST BE COORDINATED WITH THIS CONTRACT'S CONSTRUCTION WORK AND STAGING.
4. IDOT CONTRACTS 60X94, 62A77, 62A76 AND 60Y00 WILL BE ONGOING SIMULTANEOUSLY WITH THIS CONTRACT. THE CONTRACTOR IS RESPONSIBLE FOR COORDINATING ALL ELECTRICAL WORK FOR THIS CONTRACT WITH THE WORK IN THOSE CONTRACTS. THIS COORDINATION WORK SHALL BE INCLUDED AT NO ADDITIONAL COST TO THIS CONTRACT.

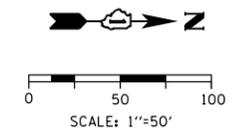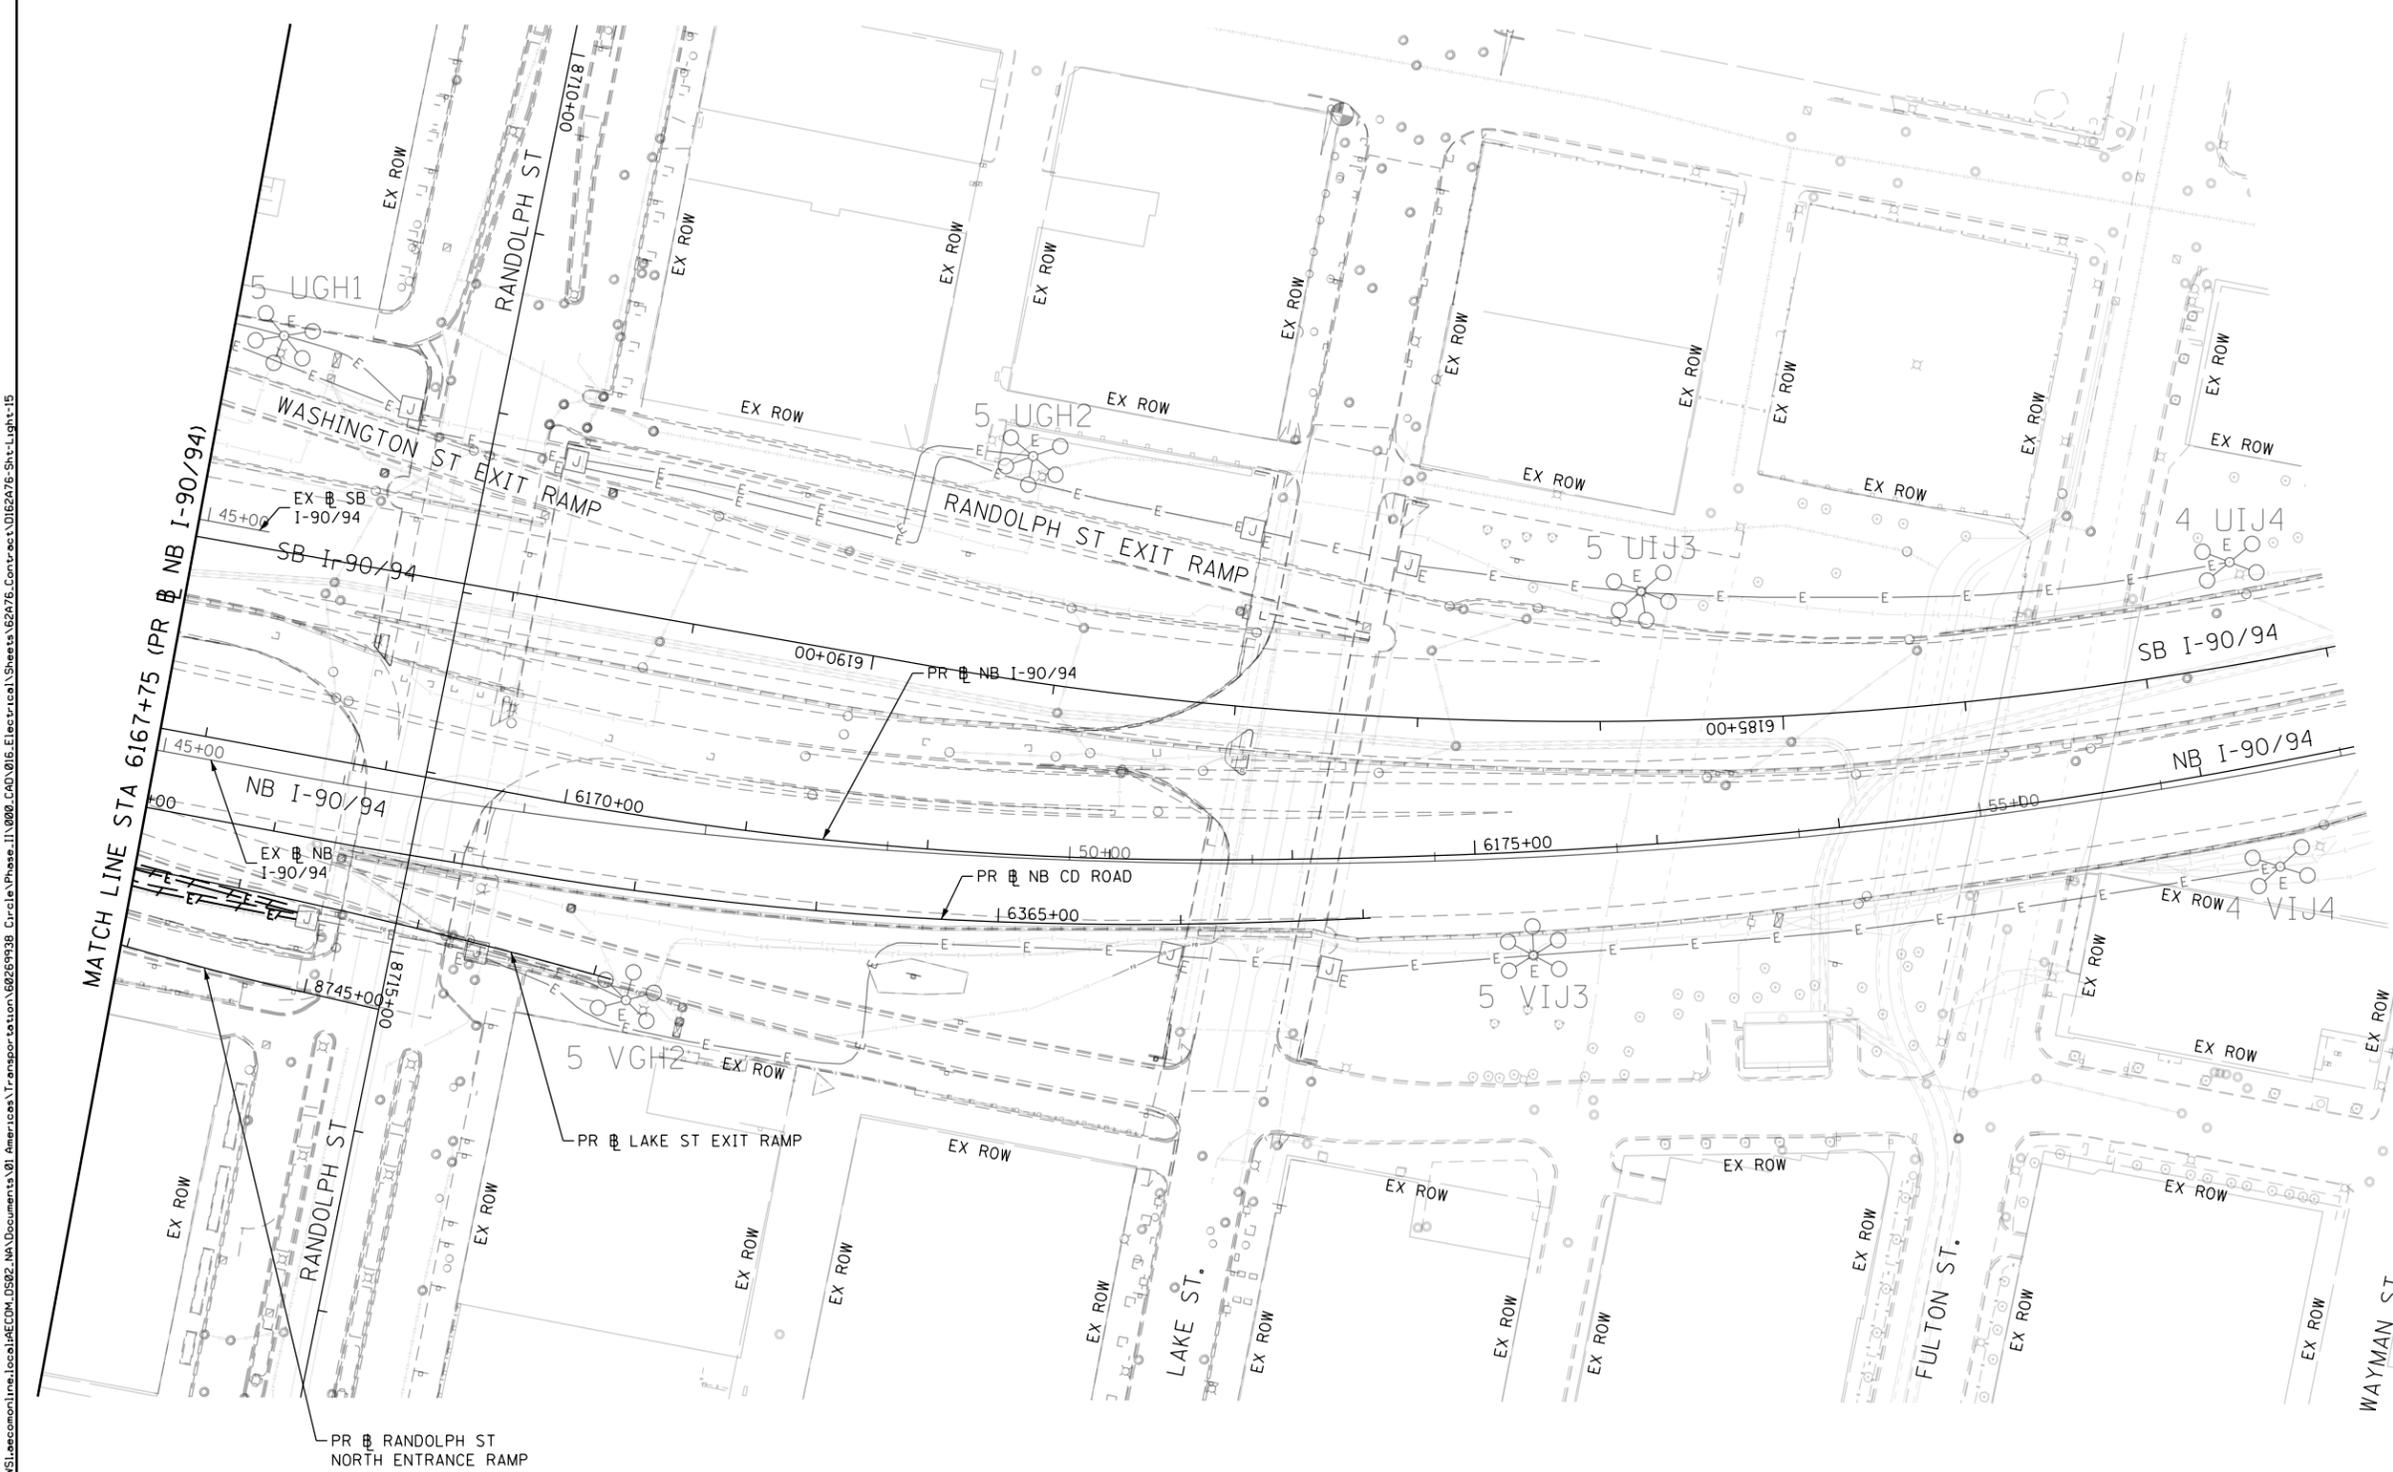

E-15

FILE PATH = p:\VACOM\NA-AWS\ecom\line\local\AECOM_0502_INA\Documents\01_Americas\Transportation\60269938_Circle Phase II\000_CAD\01E\Electrical\Sheets\62A76_Contract\01E2A76_Sht-Light-15



D162A76-Sht-Light-15
 USER NAME = myersc
 PLOT SCALE = 100.0095' / in.
 PLOT DATE = 1/23/2020


DESIGNED - TJL	REVISED -
DRAWN - CAM	REVISED -
CHECKED - WDS	REVISED -
DATE - 1/29/20	REVISED -

**STATE OF ILLINOIS
 DEPARTMENT OF TRANSPORTATION**


**EXISTING LIGHTING REMOVAL PLAN
 NB I-90/94**

SCALE: 1"=50' SHEET 15 OF 33 SHEETS STA. 6167+75 TO STA.

F.A.I. RTE.	SECTION	COUNTY	TOTAL SHEETS	SHEET NO.
90/94/290	2015-D18R	COOK	2155	1094
CONTRACT NO. 62A76				
ILLINOIS FED. AID PROJECT				

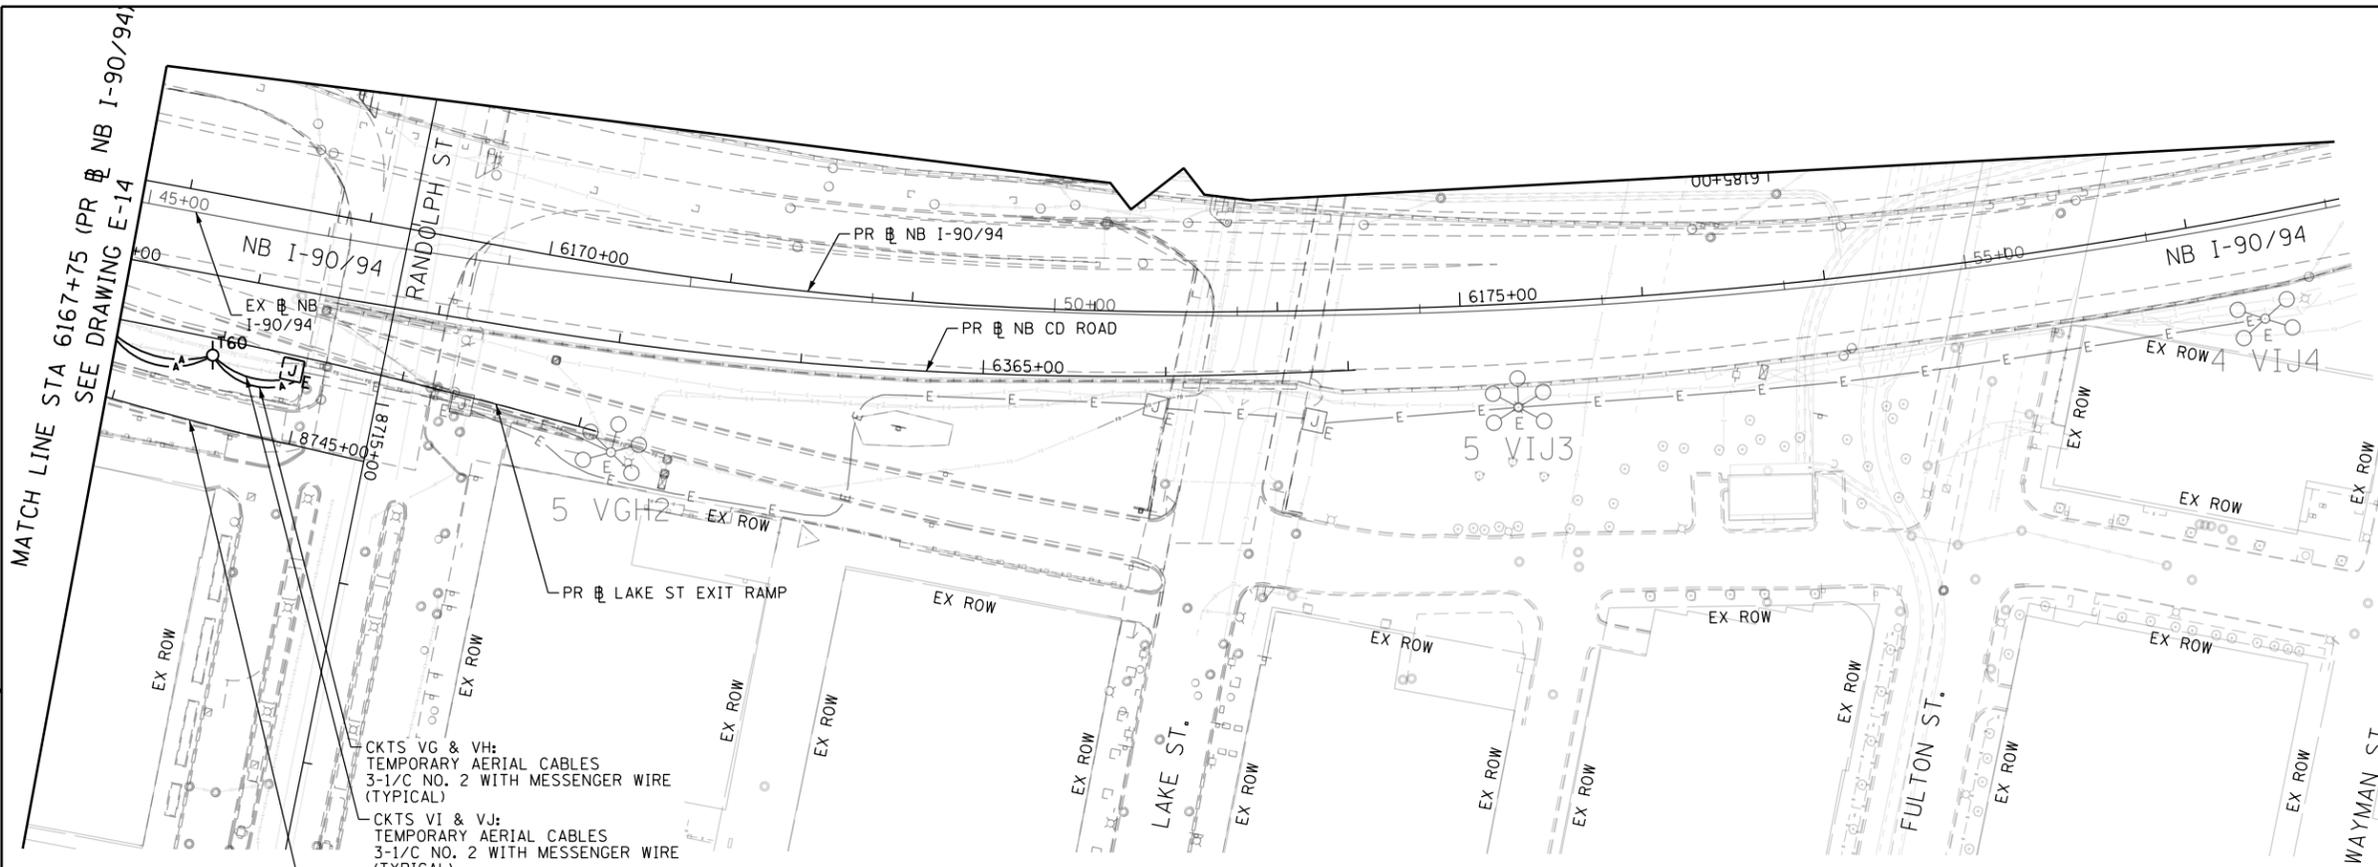


TEMPORARY LIGHTING PLAN - STAGE 1

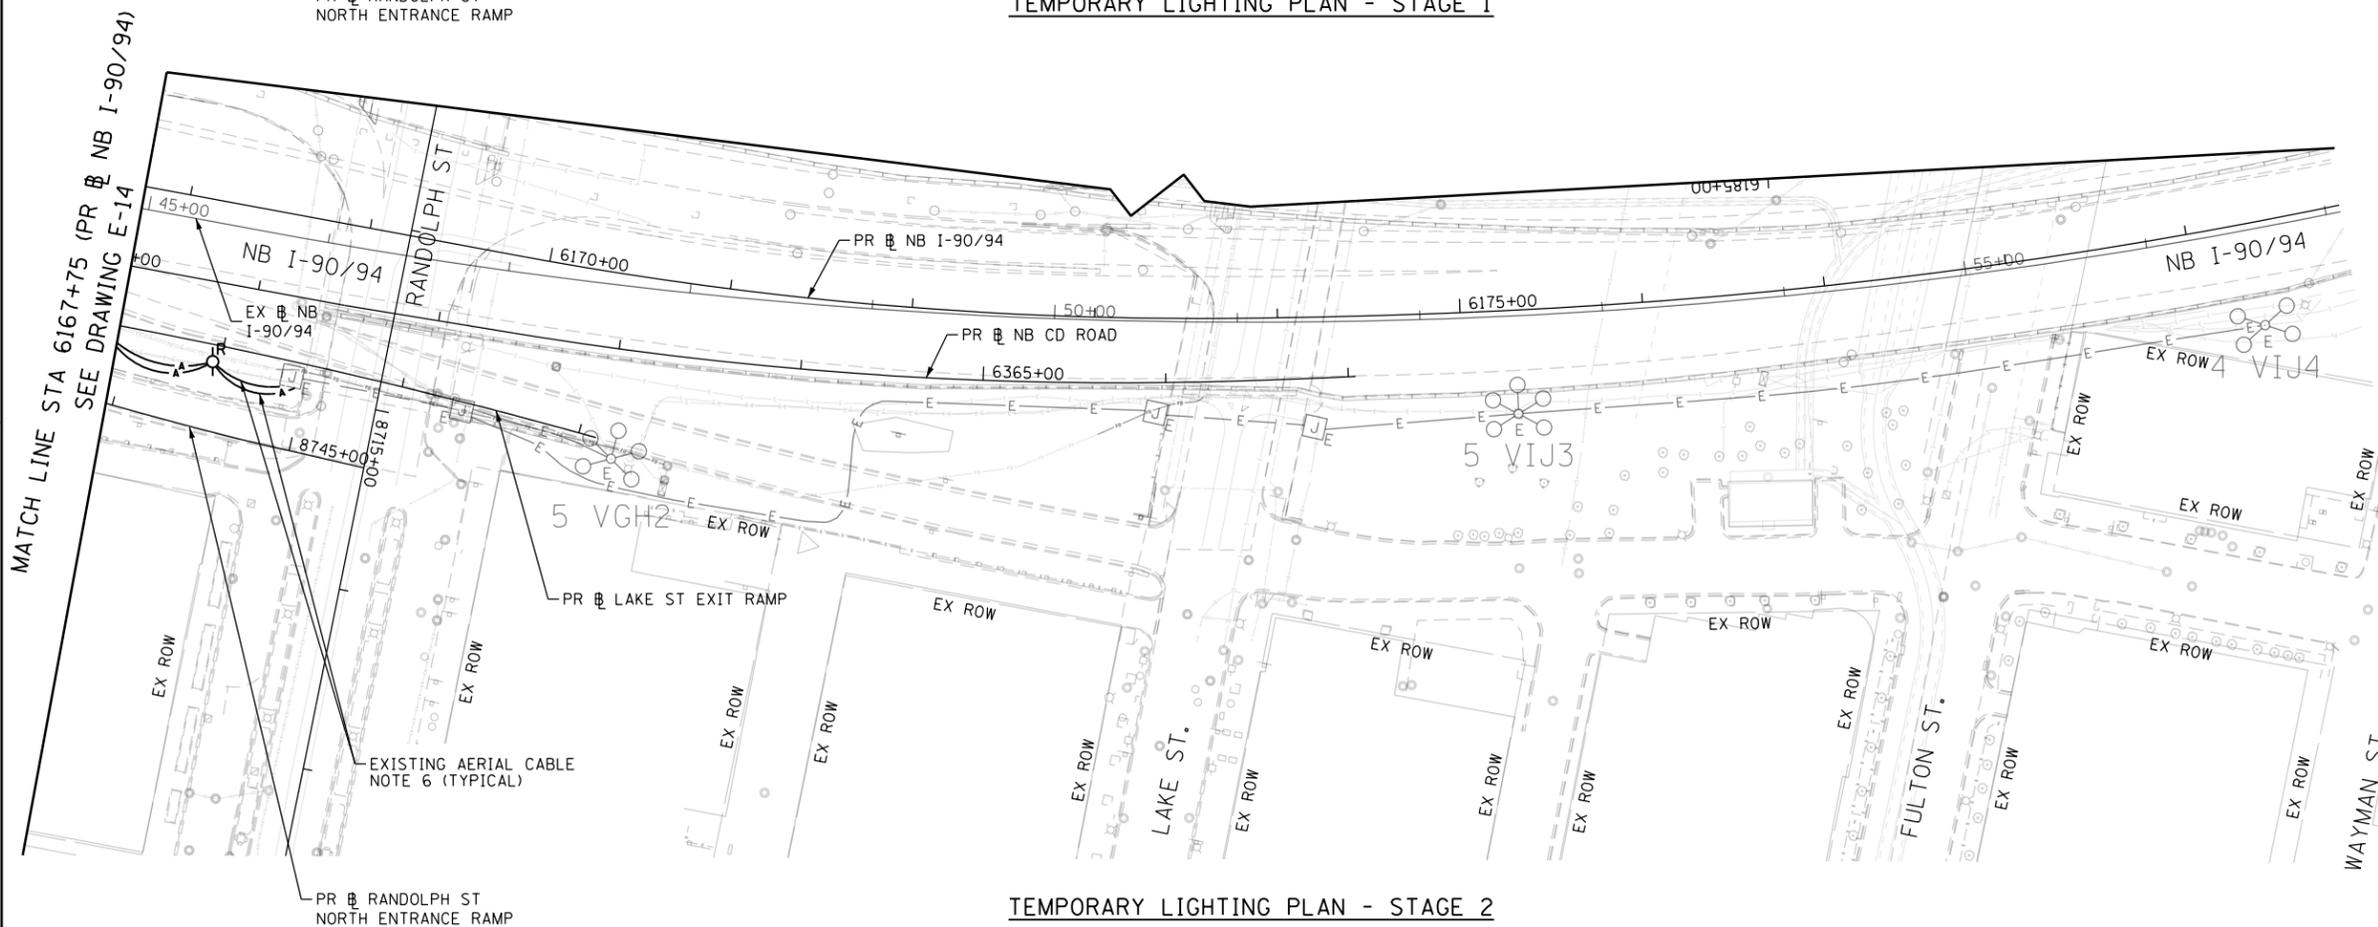

TEMPORARY LIGHTING PLAN - STAGE 2

- NOTES:**
1. SEE DRAWING E-01 FOR IDOT ELECTRICAL SYMBOLS.
 2. THE EXISTING ELECTRICAL SYSTEMS, AS DEPICTED ON THE PLANS, ARE INTENDED TO INDICATE THE GENERAL EQUIPMENT INSTALLATIONS INVOLVED AND SHALL NOT BE CONSTRUED AS AN EXACT REPRESENTATION OF THE FIELD CONDITIONS. IT IS THE CONTRACTOR'S RESPONSIBILITY TO CONFIRM AND ASCERTAIN THE EXACT CONDITION, SIZE, TYPE, QUANTITY AND LOCATION OF THE EXISTING ELECTRICAL EQUIPMENT. ANY DISCREPANCIES BETWEEN THE ACTUAL EXISTING ELECTRICAL EQUIPMENT IN THE FIELD AND THE DEPICTION OF THE EXISTING ELECTRICAL EQUIPMENT SHOWN ON THE PLANS SHALL IMMEDIATELY BE BROUGHT TO THE ATTENTION OF THE RESIDENT ENGINEER FOR RESOLUTION. FAILURE TO VERIFY THE CONDITIONS, DIMENSIONS AND DETAILS OF THE EXISTING ELECTRICAL EQUIPMENT TO CONFIRM THAT THE NEW EQUIPMENT IS COMPATIBLE WITH THE EXISTING EQUIPMENT AND CAN BE PROPERLY INSTALLED AND CONNECTED AS SHOWN ON THE PLANS WILL NOT RELIEVE THE CONTRACTOR OF THEIR RESPONSIBILITY FOR PROVIDING A SAFE, COMPLETE AND FULLY FUNCTIONAL ELECTRICAL SYSTEM.
 3. ALL WORK SHOWN ON THIS DRAWING MUST BE COORDINATED WITH THIS CONTRACT'S CONSTRUCTION WORK AND STAGING.
 4. IDOT CONTRACTS 60X94, 62A77, 62A76 AND 60Y00 WILL BE ONGOING SIMULTANEOUSLY WITH THIS CONTRACT. THE CONTRACTOR IS RESPONSIBLE FOR COORDINATING ALL ELECTRICAL WORK FOR THIS CONTRACT WITH THE WORK IN THOSE CONTRACTS. THIS COORDINATION WORK SHALL BE INCLUDED AT NO ADDITIONAL COST TO THIS CONTRACT.
 5. ALL OF THE EXISTING LIGHTING UNITS AND LIGHTING CIRCUITS CURRENTLY FED FROM EXISTING IDOT LIGHTING CONTROLLERS SHALL REMAIN ENERGIZED DURING NIGHTTIME HOURS FOR THE DURATION OF THE CONTRACT. ANY TEMPORARY POWER REQUIRED TO KEEP THE LIGHTING SYSTEM ENERGIZED WILL BE PROVIDED BY THE CONTRACTOR AT NO ADDITIONAL COST TO THE CONTRACT.
 6. REMOVAL OF THE AERIAL CABLES ATTACHED TO THE TEMPORARY WOOD POLES WILL NOT BE PAID FOR SEPARATELY AND SHALL BE INCLUDED IN THE COST OF THE "REMOVE TEMPORARY WOOD POLE" PAY ITEM.

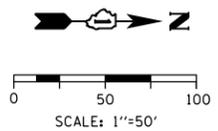

E-16

P:\VACOM\NA-AWS\ecom\line\local\AECOM_DS02_IL\000_CAD\01E\Electrical\Sheets\62A76-Sht-Light-16
 FILE PATH = P:\VACOM\NA-AWS\ecom\line\local\AECOM_DS02_IL\000_CAD\01E\Electrical\Sheets\62A76-Sht-Light-16




D162A76-Sht-Light-16	DESIGNED - TJL	REVISED -
USER NAME = myersc	DRAWN - CAM	REVISED -
PLOT SCALE = 100.00'95' / in.	CHECKED - WDS	REVISED -
PLOT DATE = 1/23/2020	DATE - 1/29/20	REVISED -

STATE OF ILLINOIS
DEPARTMENT OF TRANSPORTATION


TEMPORARY LIGHTING PLAN	
NB I-90/94	
SCALE: 1"=50'	SHEET 16 OF 33 SHEETS STA. 6167+75 TO STA.

F.A.I. RTE.	SECTION	COUNTY	TOTAL SHEETS	SHEET NO.
90/94/290	2015-D18R	COOK	2155	1095
CONTRACT NO. 62A76				
ILLINOIS FED. AID PROJECT				

- NOTES:**
1. SEE DRAWING E-01 FOR IDOT ELECTRICAL SYMBOLS.
 2. ALL WORK SHOWN ON THIS DRAWING MUST BE COORDINATED WITH THIS CONTRACT'S CONSTRUCTION WORK AND STAGING.
 3. IDOT CONTRACTS 60X94, 62A77, 62A76 AND 60Y00 WILL BE ONGOING SIMULTANEOUSLY WITH THIS CONTRACT. THE CONTRACTOR IS RESPONSIBLE FOR COORDINATING ALL ELECTRICAL WORK FOR THIS CONTRACT WITH THE WORK IN THOSE CONTRACTS. THIS COORDINATION WORK SHALL BE INCLUDED AT NO ADDITIONAL COST TO THIS CONTRACT.

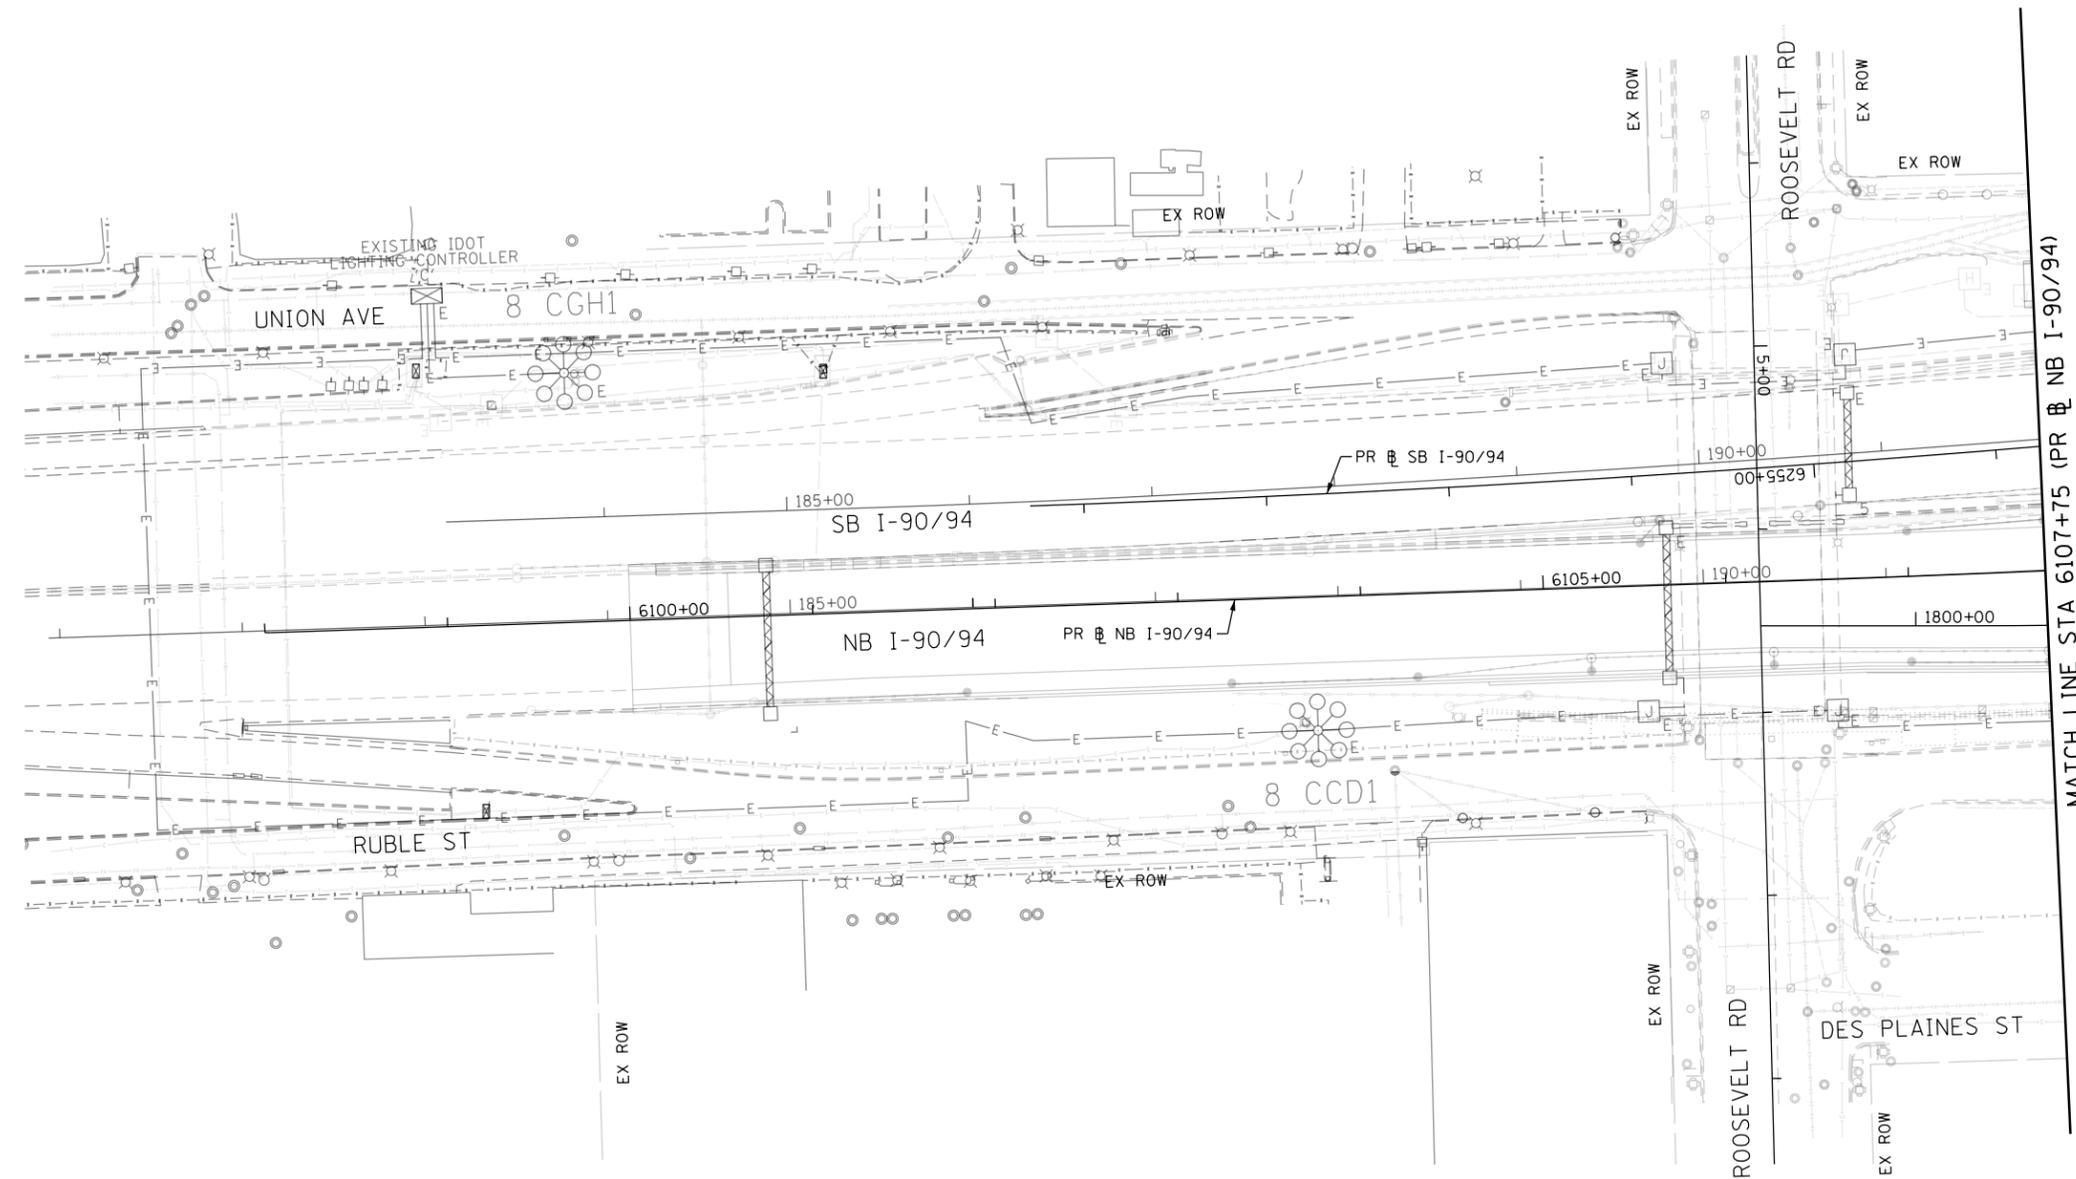

NO WORK SHOWN ON THIS SHEET

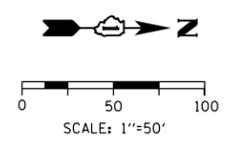

E-17

FILE PATH = p:\AECOM\NA-AVSI\ecommon\line\local\AECOM_DS02_IL\000_CAD\01E\Electrical\Sheets\62A76_Contract\0162A76_Sht-Light-17



D162A76-Sht-Light-17	DESIGNED - TJL	REVISED -
USER NAME = myersc	DRAWN - CAM	REVISED -
PLOT SCALE = 100.0000' / in.	CHECKED - WDS	REVISED -
PLOT DATE = 1/23/2020	DATE - 1/29/20	REVISED -

DESIGNED - TJL	REVISED -
DRAWN - CAM	REVISED -
CHECKED - WDS	REVISED -
DATE - 1/29/20	REVISED -

**STATE OF ILLINOIS
DEPARTMENT OF TRANSPORTATION**


**PROPOSED LIGHTING PLAN
NB I-90/94**

SCALE: 1"=50' SHEET 17 OF 33 SHEETS STA. TO STA. 6107+75

F.A.I. RTE.	SECTION	COUNTY	TOTAL SHEETS	SHEET NO.
90/94/290	2015-D18R	COOK	2155	1096
CONTRACT NO. 62A76				
ILLINOIS FED. AID PROJECT				

NOTES:

1. SEE DRAWING E-01 FOR IDOT ELECTRICAL SYMBOLS.
2. ALL WORK SHOWN ON THIS DRAWING MUST BE COORDINATED WITH THIS CONTRACT'S CONSTRUCTION WORK AND STAGING.
3. IDOT CONTRACTS 60X94, 62A77, 62A76 AND 60Y00 WILL BE ONGOING SIMULTANEOUSLY WITH THIS CONTRACT. THE CONTRACTOR IS RESPONSIBLE FOR COORDINATING ALL ELECTRICAL WORK FOR THIS CONTRACT WITH THE WORK IN THOSE CONTRACTS. THIS COORDINATION WORK SHALL BE INCLUDED AT NO ADDITIONAL COST TO THIS CONTRACT.
4. CONNECT NEW LIGHTING CIRCUIT CABLES TO EXISTING CABLES LOCATED IN JUNCTION BOX ATTACHED TO SIGN STRUCTURE.

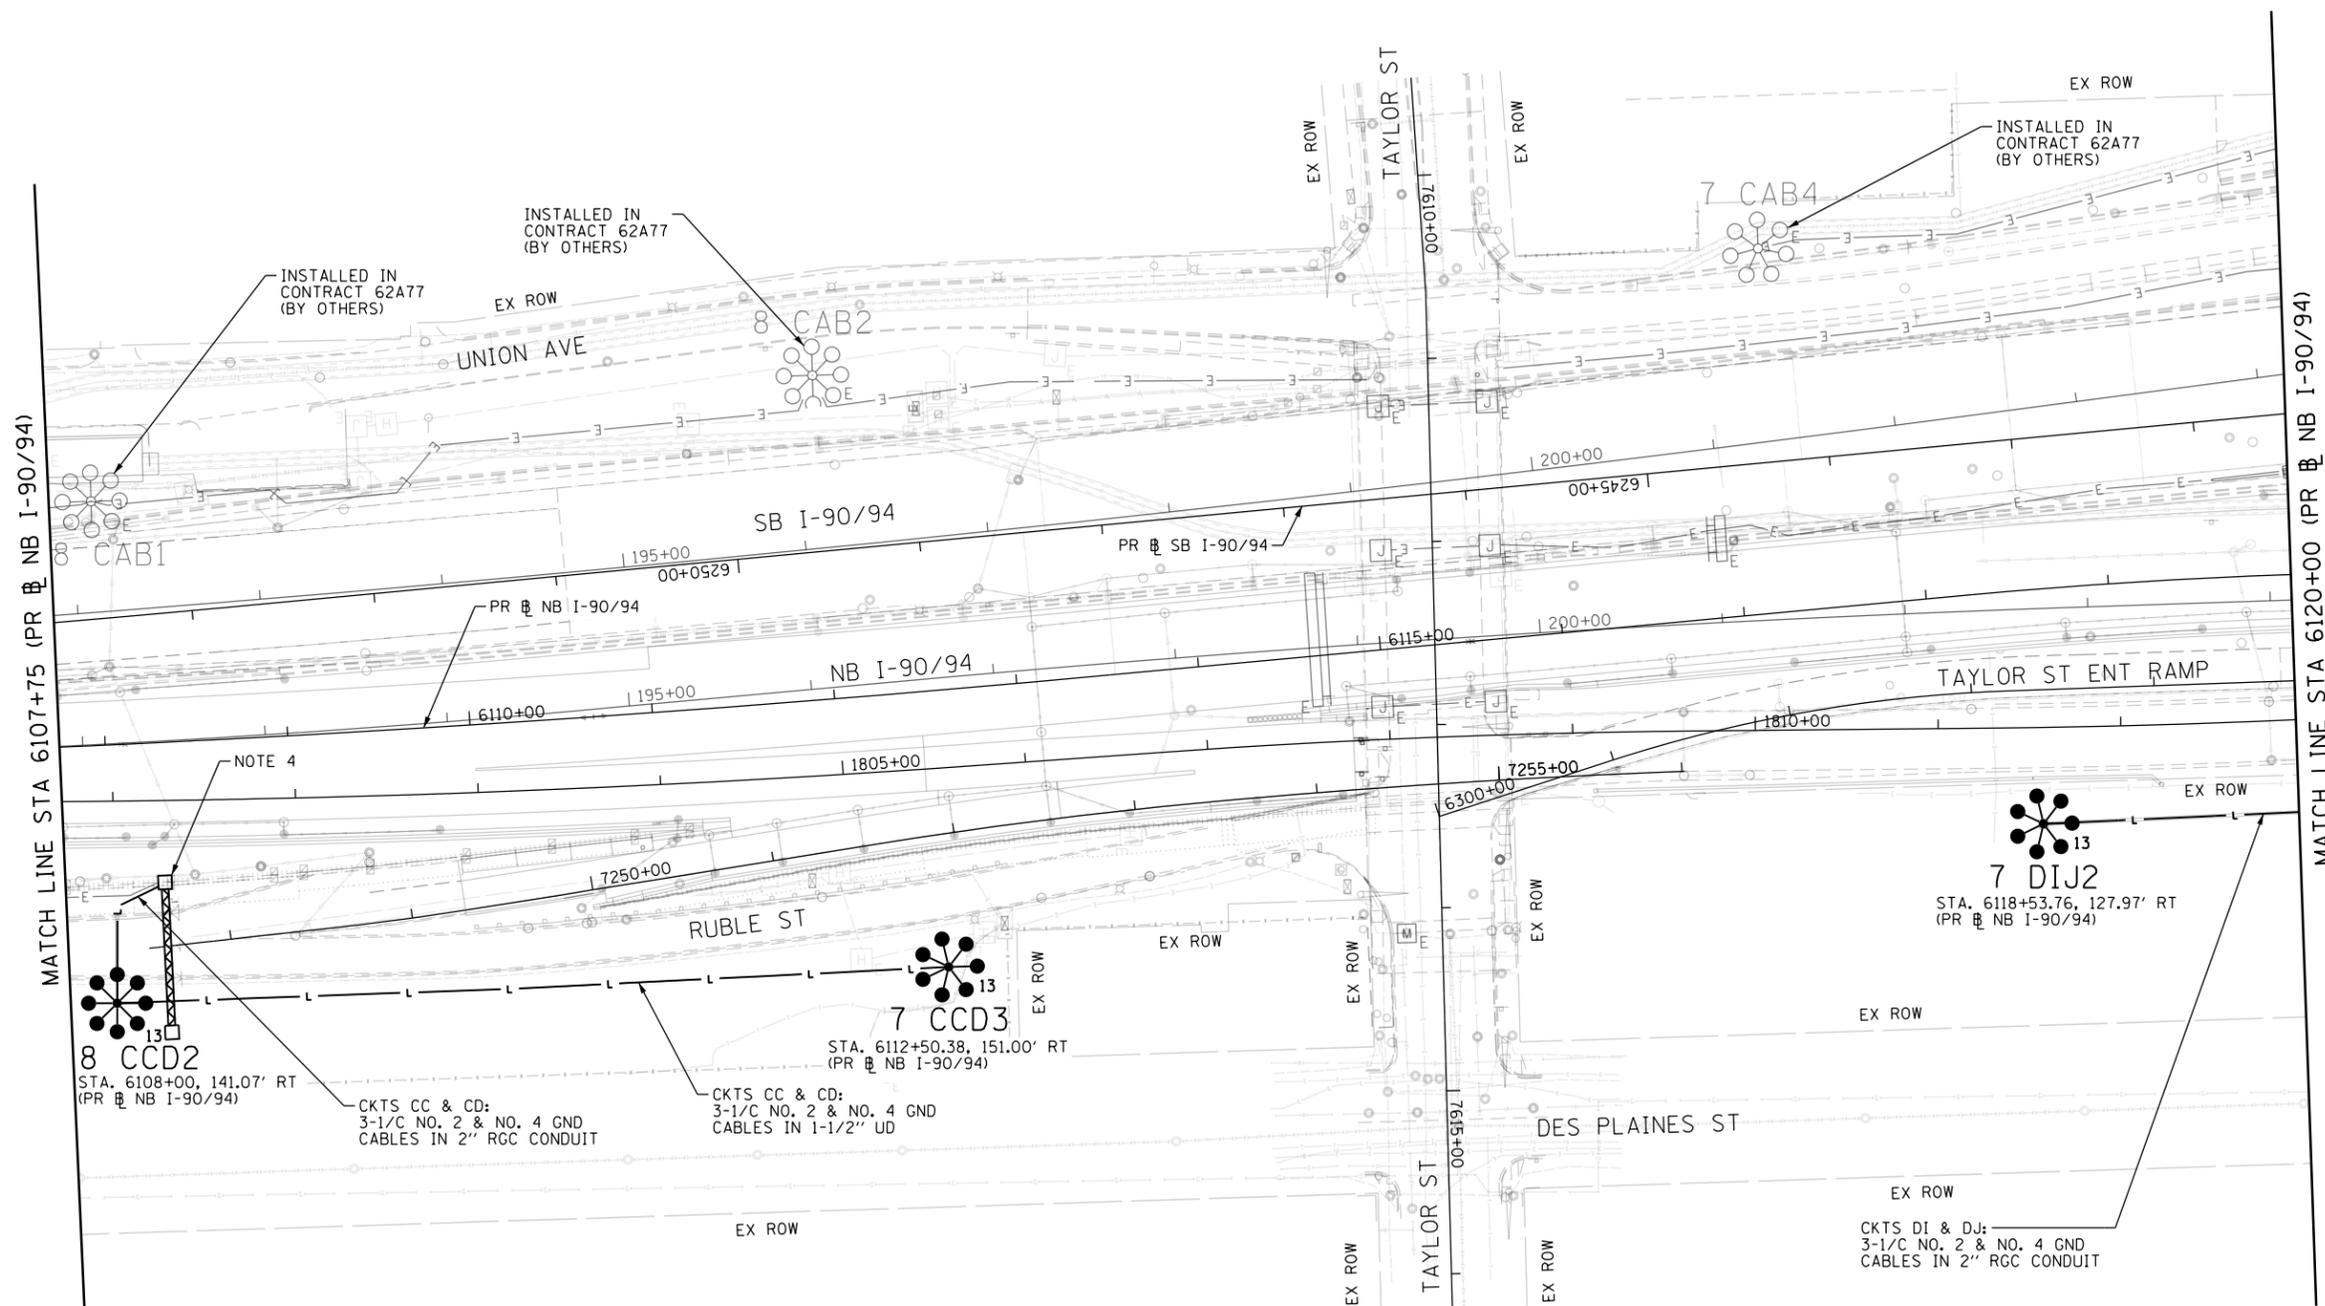

INSTALLED IN CONTRACT 62A77 (BY OTHERS)

INSTALLED IN CONTRACT 62A77 (BY OTHERS)


INSTALLED IN CONTRACT 62A77 (BY OTHERS)

NOTE 4

CKTS CC & CD:
3-1/C NO. 2 & NO. 4 GND
CABLES IN 2" RGC CONDUIT

CKTS CC & CD:
3-1/C NO. 2 & NO. 4 GND
CABLES IN 1-1/2" UD

CKTS DI & DJ:
3-1/C NO. 2 & NO. 4 GND
CABLES IN 2" RGC CONDUIT

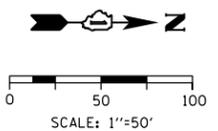

FILE PATH = p:\naecom\ms-ansi\ecommon\line\local\ae\com\0502_n\documents\01_america\transportation\60269938_Circle_Phase_1\000_CAD\01E_Electrical\Sheets\62A76_Contract\0162A76_Sht-Light-18



D162A76-Sht-Light-18	DESIGNED - TJL	REVISED -
USER NAME = myersc	DRAWN - CAM	REVISED -
PLOT SCALE = 100.0000' / in.	CHECKED - WDS	REVISED -
PLOT DATE = 1/23/2020	DATE - 1/29/20	REVISED -

**STATE OF ILLINOIS
DEPARTMENT OF TRANSPORTATION**


**PROPOSED LIGHTING PLAN
NB I-90/94**

SCALE: 1"=50' SHEET 18 OF 33 SHEETS STA. 6107+75 TO STA. 6120+00


F.A.I. RTE.	SECTION	COUNTY	TOTAL SHEETS	SHEET NO.
90/94/290	2015-D18R	COOK	2155	1097
CONTRACT NO. 62A76				
ILLINOIS FED. AID PROJECT				

NOTES:

1. SEE DRAWING E-01 FOR IDOT ELECTRICAL SYMBOLS.
2. ALL WORK SHOWN ON THIS DRAWING MUST BE COORDINATED WITH THIS CONTRACT'S CONSTRUCTION WORK AND STAGING.
3. IDOT CONTRACTS 60X94, 62A77, 62A76 AND 60Y00 WILL BE ONGOING SIMULTANEOUSLY WITH THIS CONTRACT. THE CONTRACTOR IS RESPONSIBLE FOR COORDINATING ALL ELECTRICAL WORK FOR THIS CONTRACT WITH THE WORK IN THOSE CONTRACTS. THIS COORDINATION WORK SHALL BE INCLUDED AT NO ADDITIONAL COST TO THIS CONTRACT.
4. ROUTE NEW LIGHT CIRCUITS DI & DJ INTO EXISTING IDOT LIGHTING CONTROLLER 'D' THROUGH EXISTING CONDUIT SLEEVE AT BASE OF FOUNDATION.
5. SEE DRAWING E-31 FOR THE DETAILS SHOWING THE SAFETY BOLLARDS TO BE INSTALLED AROUND PROPOSED ITS CABINET 'D4' AND EXISTING IDOT LIGHTING CONTROLLER 'D'.

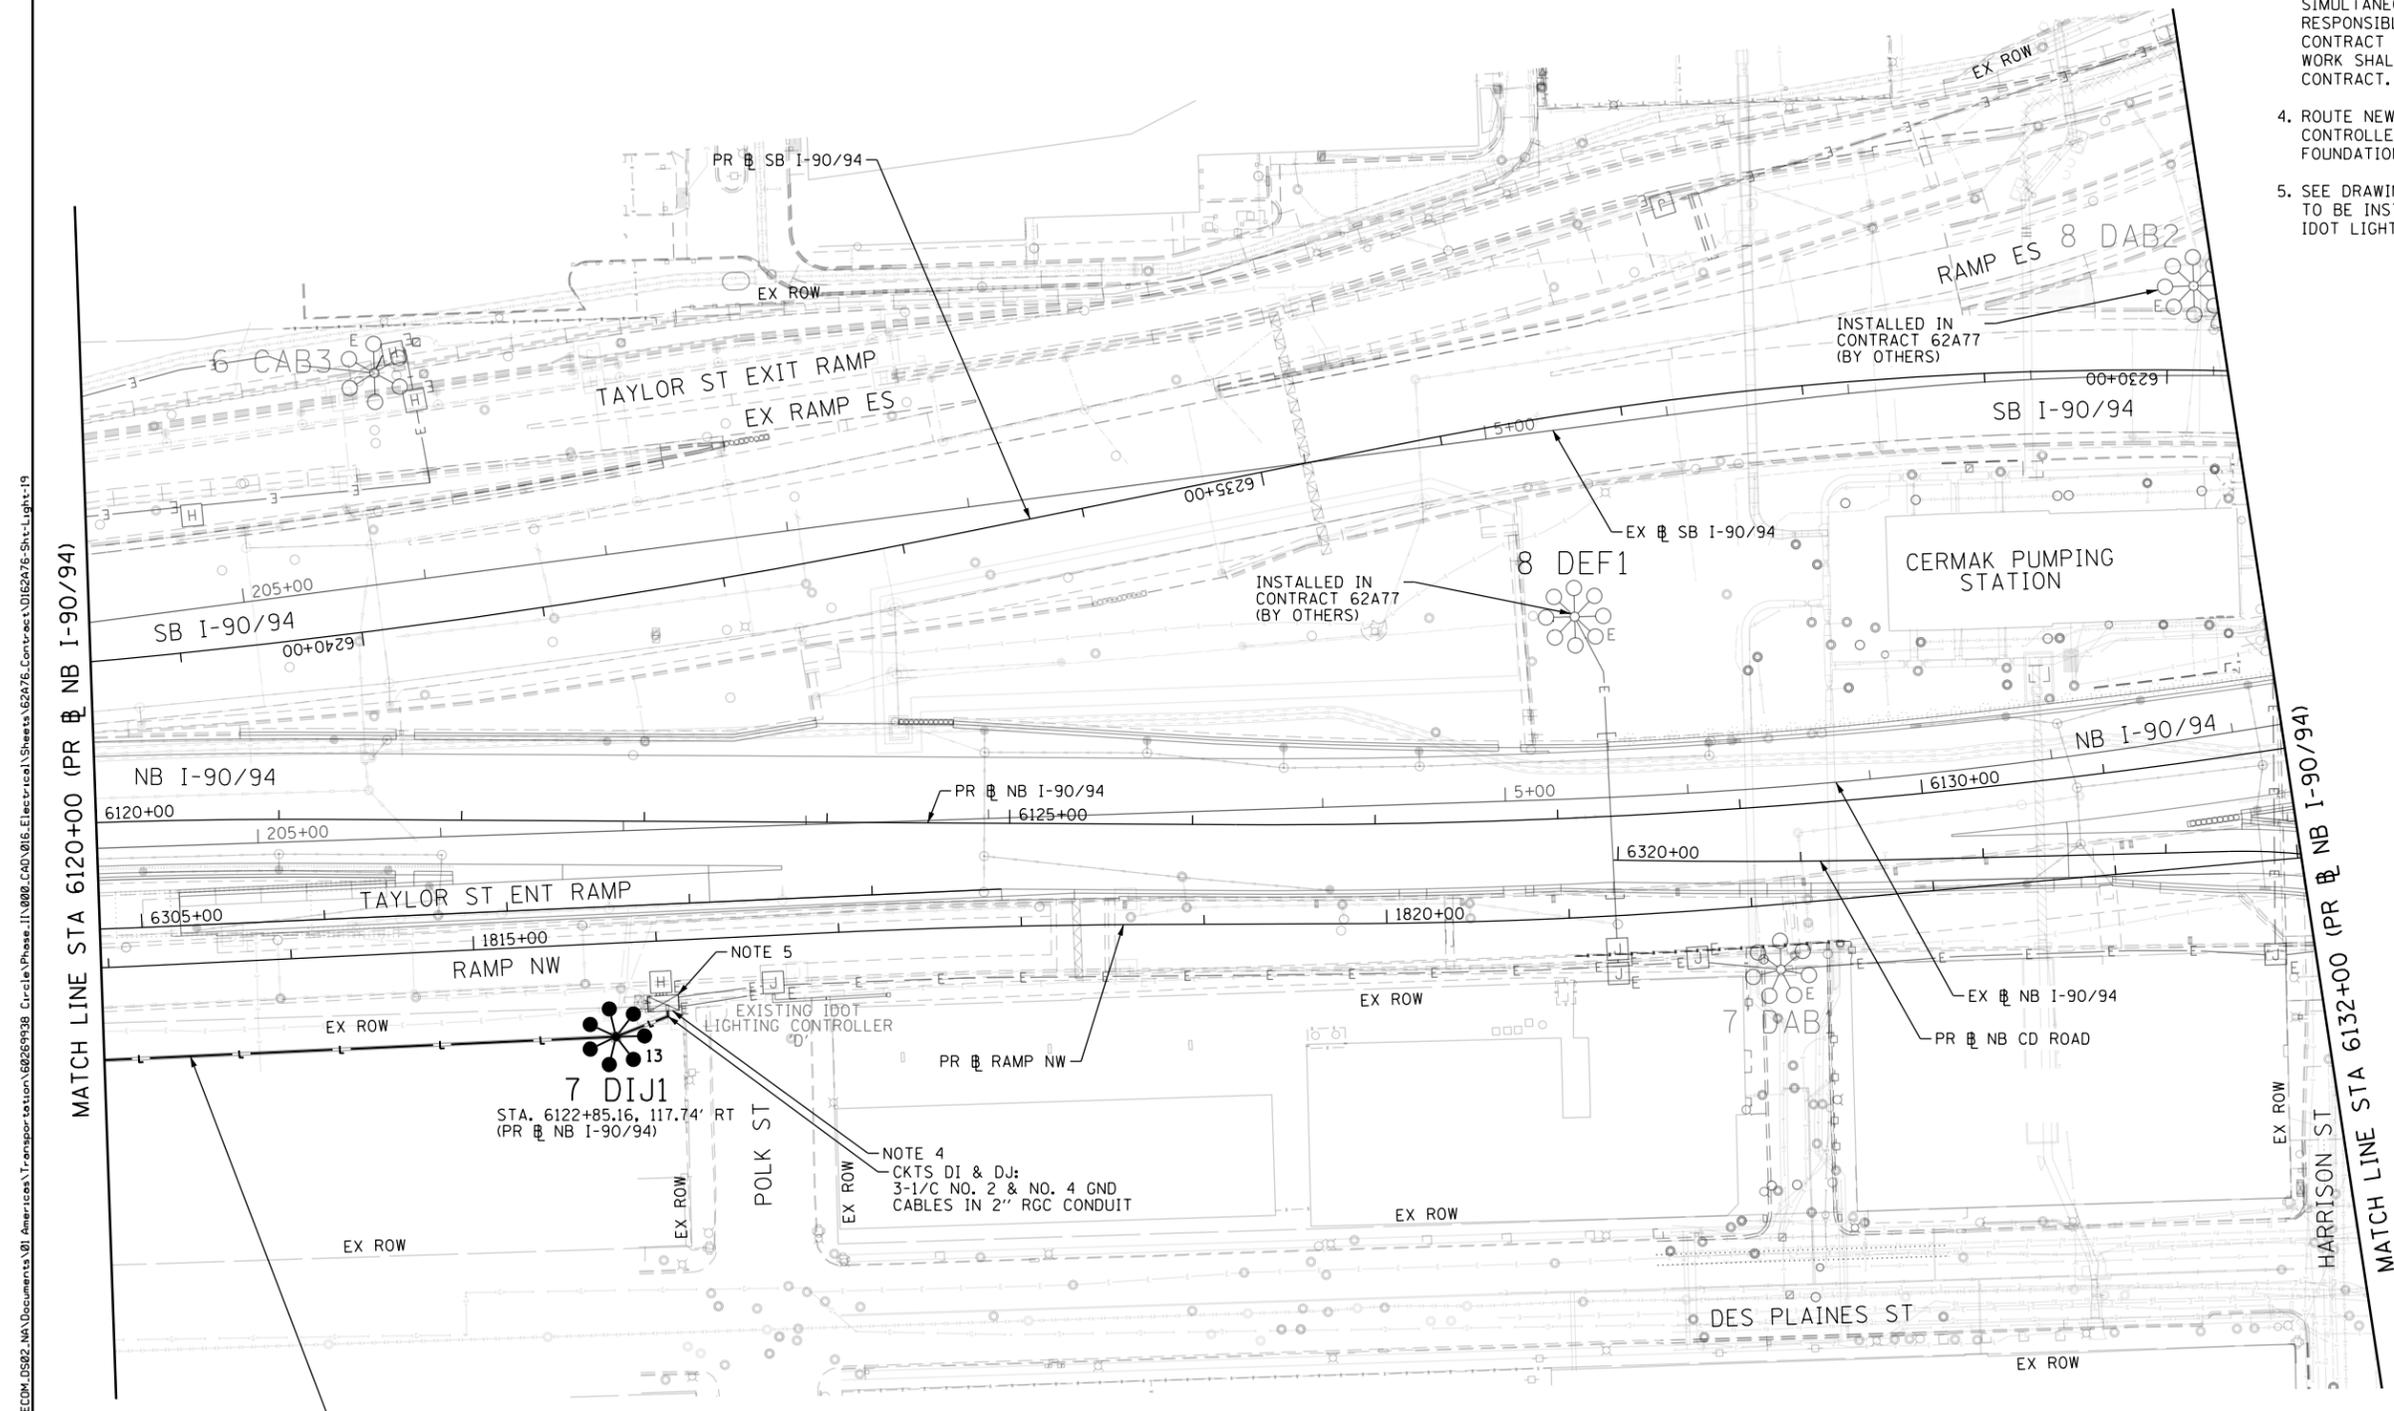

CKTS DI & DJ:
3-1/C NO. 2 & NO. 4 GND
CABLES IN 2" RGC CONDUIT

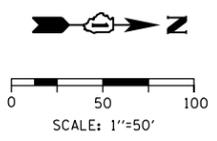

FILE PATH = p:\naecdm-na-ansi\ecommon\line\local\ae\COM_D502_NA\Documents\01_Americas\Transportation\60269938_Circle Phase II\000_CAD\01E\Electrical\Sheets\62A76_Contract\0162A76_Sht-Light-19



D162A76-Sht-Light-19	DESIGNED - TJL	REVISED -
USER NAME = myersc	DRAWN - CAM	REVISED -
PLOT SCALE = 100.0000' / in.	CHECKED - WDS	REVISED -
PLOT DATE = 1/24/2020	DATE - 1/29/20	REVISED -

**STATE OF ILLINOIS
DEPARTMENT OF TRANSPORTATION**


PROPOSED LIGHTING PLAN NB I-90/94	
SCALE: 1"=50'	SHEET 19 OF 33 SHEETS
STA. 6120+00	TO STA. 6132+00

F.A.I. RTE.	SECTION	COUNTY	TOTAL SHEETS	SHEET NO.
90/94/290	2015-D18R	COOK	2155	1098
CONTRACT NO. 62A76				
ILLINOIS FED. AID PROJECT				

NOTES:

1. SEE DRAWING E-01 FOR IDOT ELECTRICAL SYMBOLS.
2. ALL WORK SHOWN ON THIS DRAWING MUST BE COORDINATED WITH THIS CONTRACT'S CONSTRUCTION WORK AND STAGING.
3. IDOT CONTRACTS 60X94, 62A77, 62A76 AND 60Y00 WILL BE ONGOING SIMULTANEOUSLY WITH THIS CONTRACT. THE CONTRACTOR IS RESPONSIBLE FOR COORDINATING ALL ELECTRICAL WORK FOR THIS CONTRACT WITH THE WORK IN THOSE CONTRACTS. THIS COORDINATION WORK SHALL BE INCLUDED AT NO ADDITIONAL COST TO THIS CONTRACT.
4. PROTECT THE EXISTING CONDUIT SLEEVES ROUTED UNDER NB I-90/94 FROM DAMAGE DURING THE PAVEMENT EXCAVATION AND RECONSTRUCTION WORK. ANY DAMAGE INCURRED TO THE CONDUIT SLEEVES AND THE LIGHTING CIRCUITS CONTAINED WITHIN SHALL BE REPLACED IN KIND AT NO COST TO THE CONTRACT.

NO WORK SHOWN ON THIS SHEET

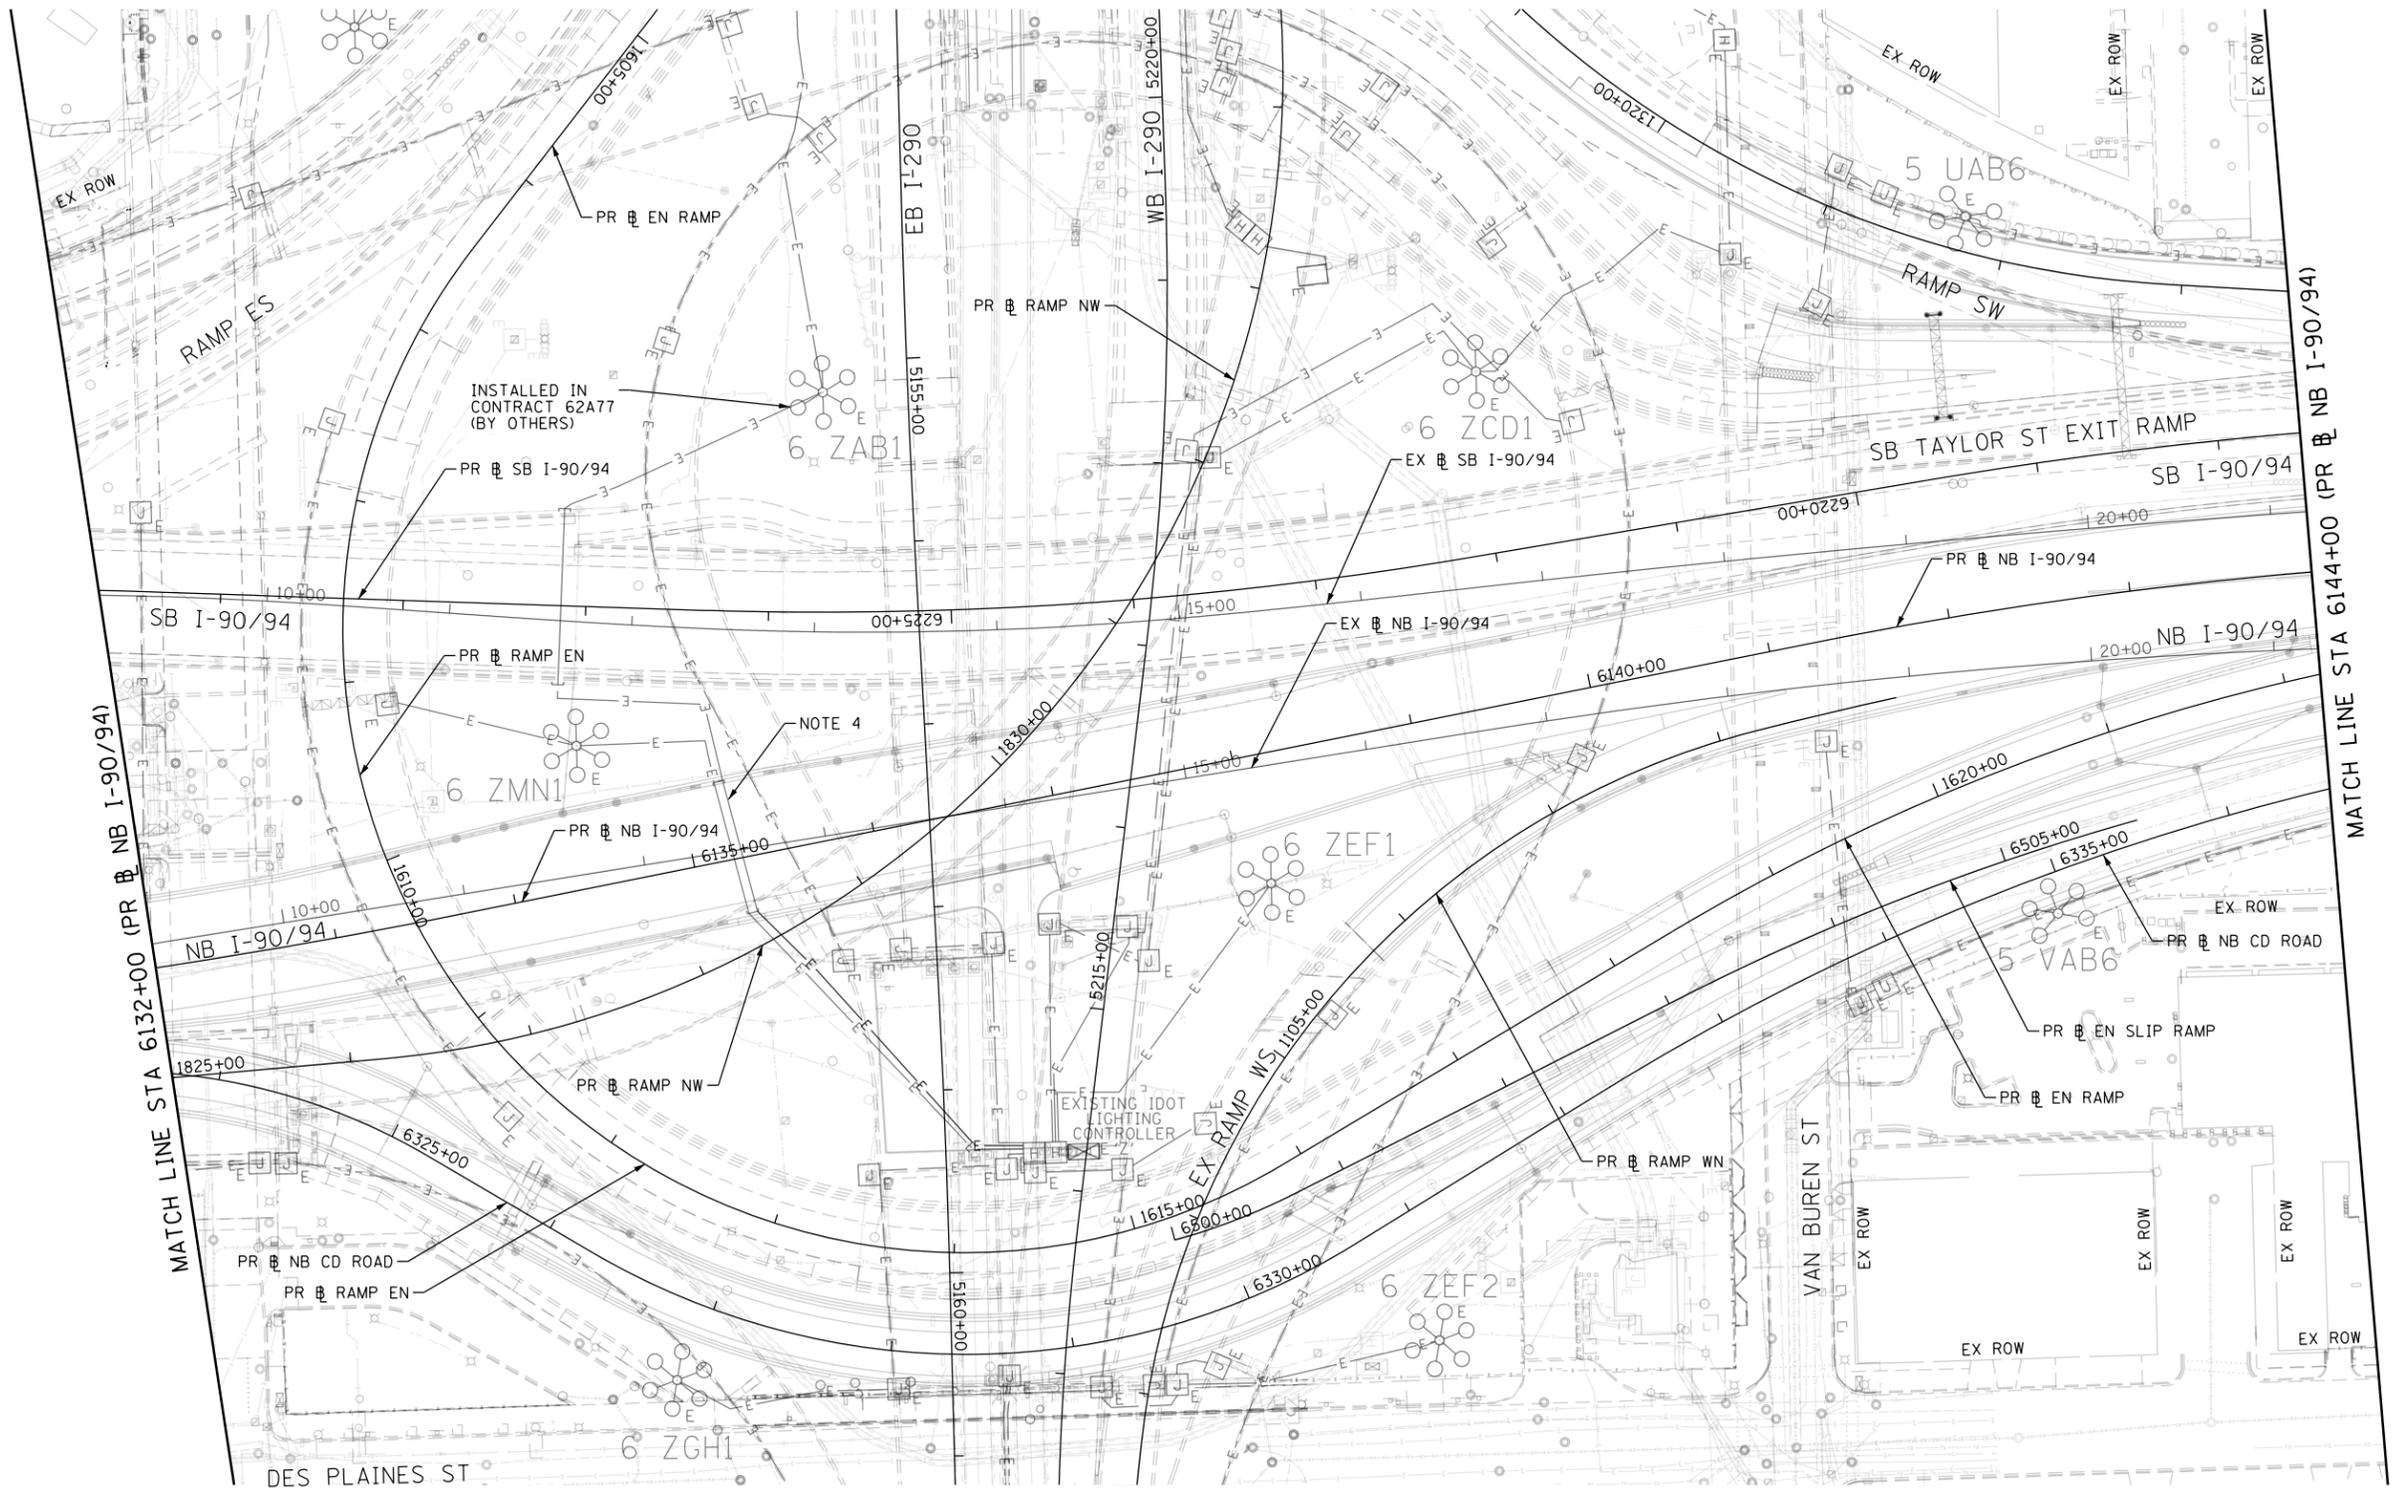

E-20

FILE PATH = p:\AECOM\NA-AWS\encom\line\local\AECOM_DS02_NA\Documents\01_Americas\Transportation\60269938_Circle_Phase_1\000_CAD\01E\Electrical\Sheets\62A76_Contract\0162A76_Sht-Light-20



D162A76-Sht-Light-20	DESIGNED - TJL	REVISED -
USER NAME = myersc	DRAWN - CAM	REVISED -
PLOT SCALE = 100.0000' / in.	CHECKED - WDS	REVISED -
PLOT DATE = 1/23/2020	DATE - 1/29/20	REVISED -

**STATE OF ILLINOIS
DEPARTMENT OF TRANSPORTATION**


**PROPOSED LIGHTING PLAN
NB I-90/94**

SCALE: 1"=50' SHEET 20 OF 33 SHEETS STA. 6132+00 TO STA. 6144+00


F.A.I. RTE.	SECTION	COUNTY	TOTAL SHEETS	SHEET NO.
90/94/290	2015-D18R	COOK	2155	1099
CONTRACT NO. 62A76				
ILLINOIS FED. AID PROJECT				

NOTES:

1. SEE DRAWING E-01 FOR IDOT ELECTRICAL SYMBOLS.
2. ALL WORK SHOWN ON THIS DRAWING MUST BE COORDINATED WITH THIS CONTRACT'S CONSTRUCTION WORK AND STAGING.
3. IDOT CONTRACTS 60X94, 62A77, 62A76 AND 60Y00 WILL BE ONGOING SIMULTANEOUSLY WITH THIS CONTRACT. THE CONTRACTOR IS RESPONSIBLE FOR COORDINATING ALL ELECTRICAL WORK FOR THIS CONTRACT WITH THE WORK IN THOSE CONTRACTS. THIS COORDINATION WORK SHALL BE INCLUDED AT NO ADDITIONAL COST TO THIS CONTRACT.
4. A LIGHT TOWER SERVICE PAD SHALL NOT BE INSTALLED AT THIS LOCATION.

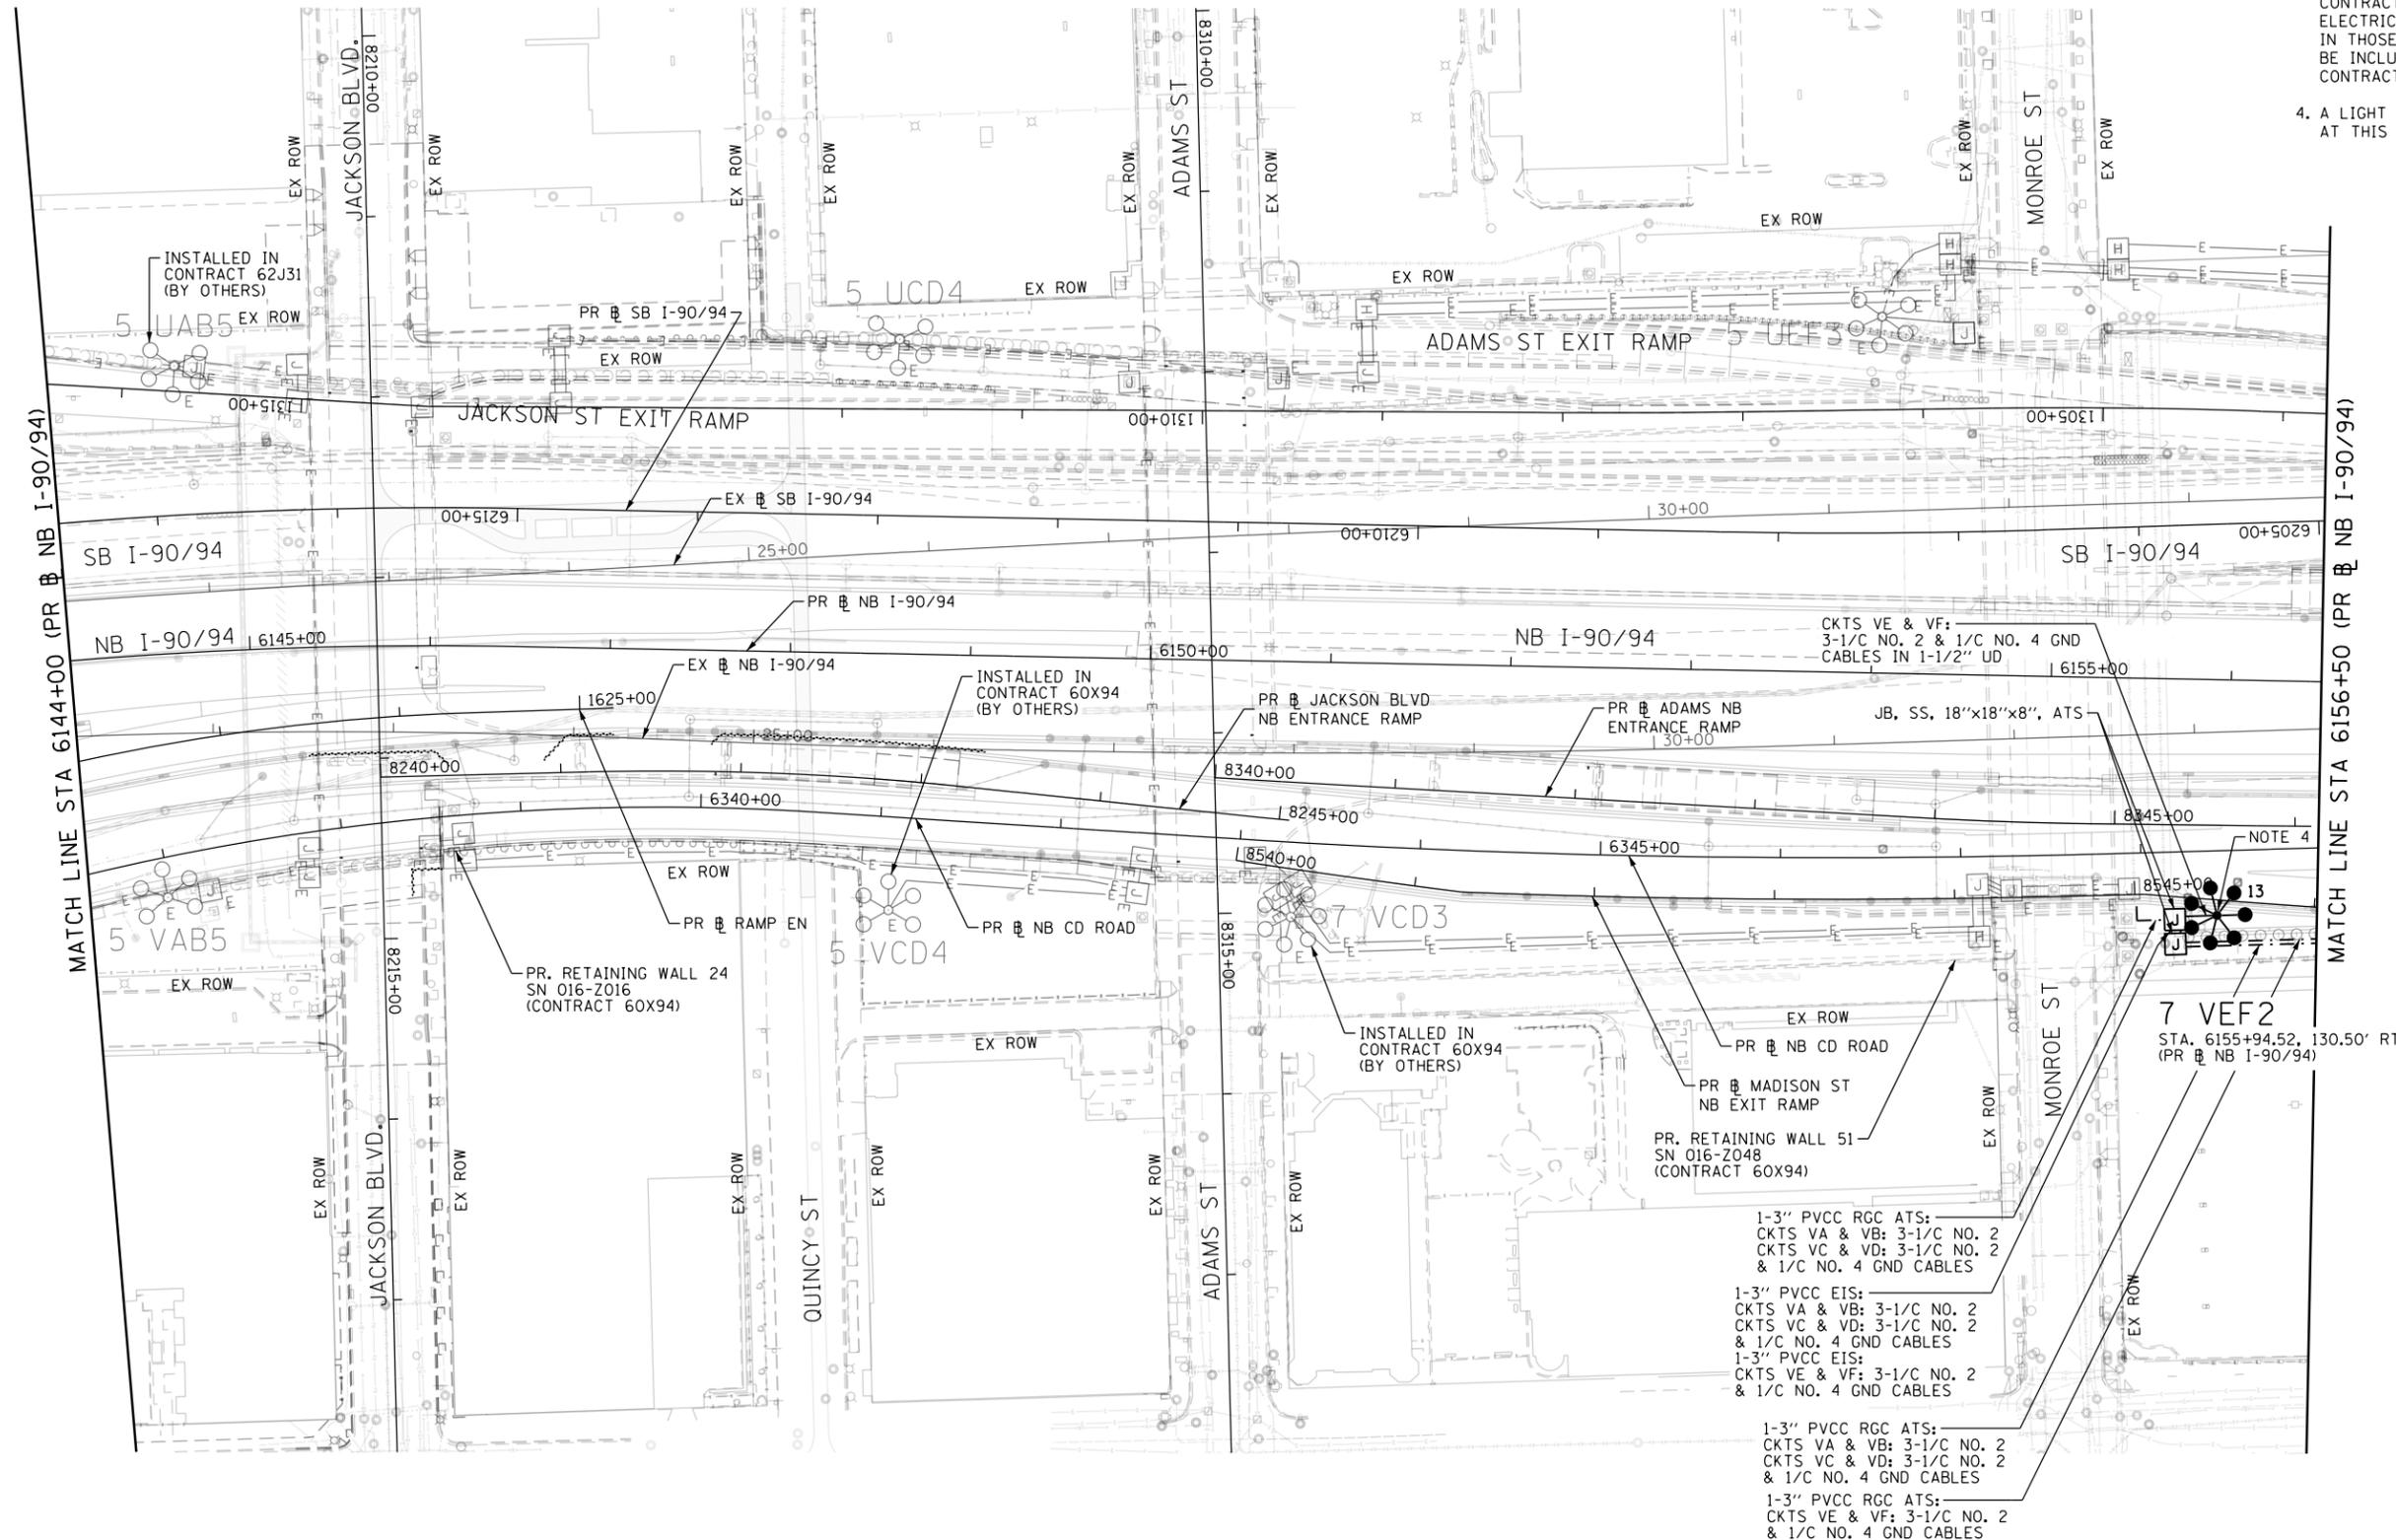

- 1-3" PVCC RGC ATS:
CKTS VA & VB: 3-1/C NO. 2
CKTS VC & VD: 3-1/C NO. 2
& 1/C NO. 4 GND CABLES
- 1-3" PVCC EIS:
CKTS VA & VB: 3-1/C NO. 2
CKTS VC & VD: 3-1/C NO. 2
& 1/C NO. 4 GND CABLES
- 1-3" PVCC EIS:
CKTS VE & VF: 3-1/C NO. 2
& 1/C NO. 4 GND CABLES
- 1-3" PVCC RGC ATS:
CKTS VA & VB: 3-1/C NO. 2
CKTS VC & VD: 3-1/C NO. 2
& 1/C NO. 4 GND CABLES
- 1-3" PVCC RGC ATS:
CKTS VE & VF: 3-1/C NO. 2
& 1/C NO. 4 GND CABLES

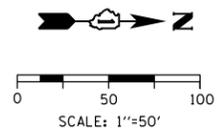

FILE PATH = p:\a\ecdm\m-n\si\ecdm\local\ecdm\0502_01\000_CAD\01E\Electrical\Sheets\62A76_Contract\0162A76_Sht-Light-21



D162A76-Sht-Light-21	DESIGNED - TJL	REVISED -
USER NAME = myersc	DRAWN - CAM	REVISED -
PLOT SCALE = 100.0000' / 1"	CHECKED - WDS	REVISED -
PLOT DATE = 1/23/2020	DATE - 1/29/20	REVISED -

**STATE OF ILLINOIS
DEPARTMENT OF TRANSPORTATION**

PROPOSED LIGHTING PLAN NB I-90/94		
SCALE: 1"=50'	SHEET 21 OF 33 SHEETS	STA. 6144+00 TO STA. 6156+50

F.A.I. RTE. 90/94/290	SECTION 2015-D18R	COUNTY COOK	TOTAL SHEETS 2155	SHEET NO. 1100
CONTRACT NO. 62A76				
ILLINOIS FED. AID PROJECT				