


PROJECT NO.	SECTION	COUNTY	TOTAL SHEETS	SHEET NO.
FAU 2503	(35)BR-2	KENDALL	129	61
FED. ROAD DIST. NO.	ILLINOIS	FED. AID PROJECT		
5				

REVISED SECTION A-A 2A


STATE OF ILLINOIS
DEPARTMENT OF TRANSPORTATION

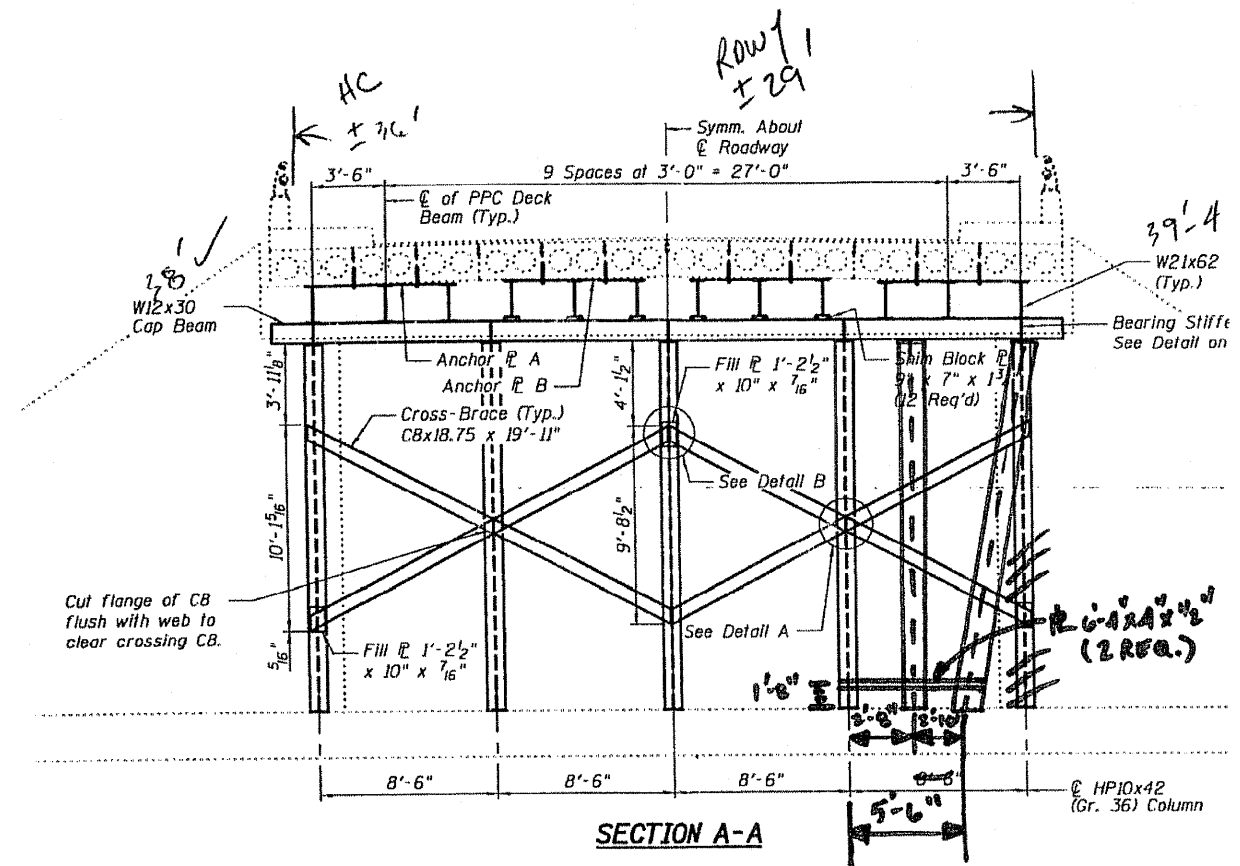



LOOK N.
S. ABT.

REVISED SECTION A-A 2B

STATE OF ILLINOIS
DEPARTMENT OF TRANSPORTATION

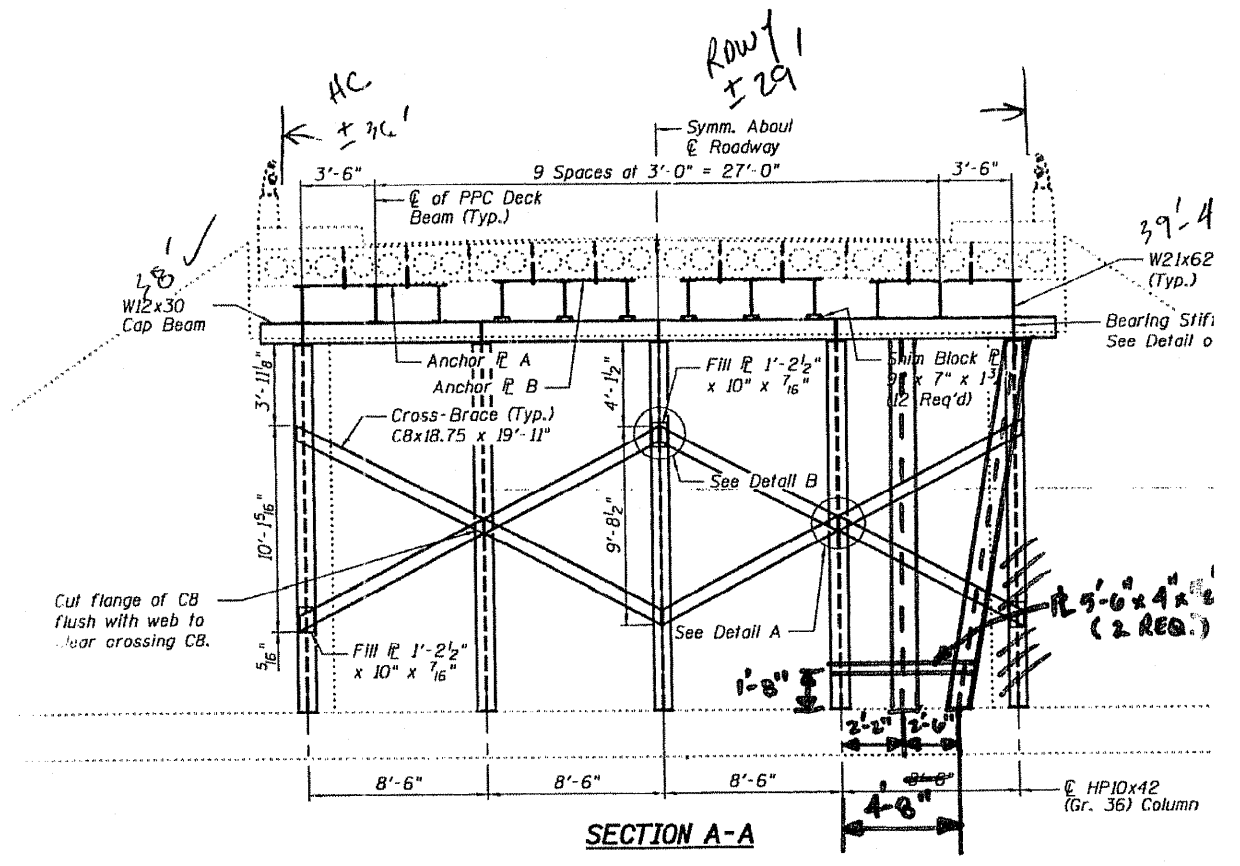

LOOK N.
N. ABT.

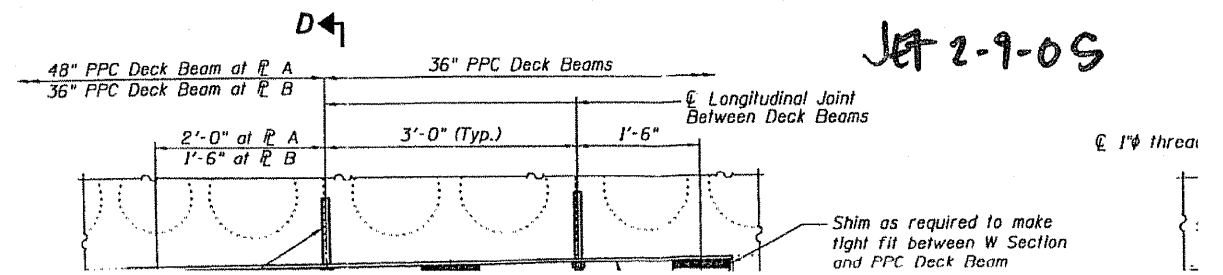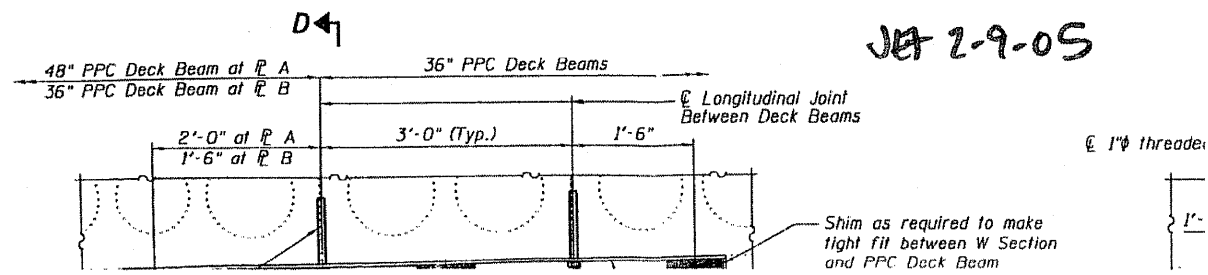

HAMPTON, LENZINI & RENWICK, INC.
CIVIL & STRUCTURAL ENGINEERS

3085 STEVENSON DRIVE, SUITE 201
SPRINGFIELD, ILLINOIS 62703
(217) 546-3400

ELGIN • SPRINGFIELD

PROJECT NUMBER: 12-06-0029-1 DATE: 12/13/07
DESIGNED: CHECKED: DRAWN:

AS-BUILT BRIDGE PLANS
SECTION (35) BR-2
IL 25 OVER WAUBONSEE CREEK
KENDALL COUNTY

PLOT DATE: 11/24/2008 8:35:57 AM