



FOR INFORMATION ONLY

STATE OF ILLINOIS  
DEPARTMENT OF TRANSPORTATION

ROUTE NO.	SECTION	COUNTY	TOTAL SHEETS	SHEET NO.
90/94	8	COOK	79	45
STA.	TO STA.			
PER. NO. DIST. NO.	ILLINOIS	FED. AID PROJECT		
W 1985-080 R				

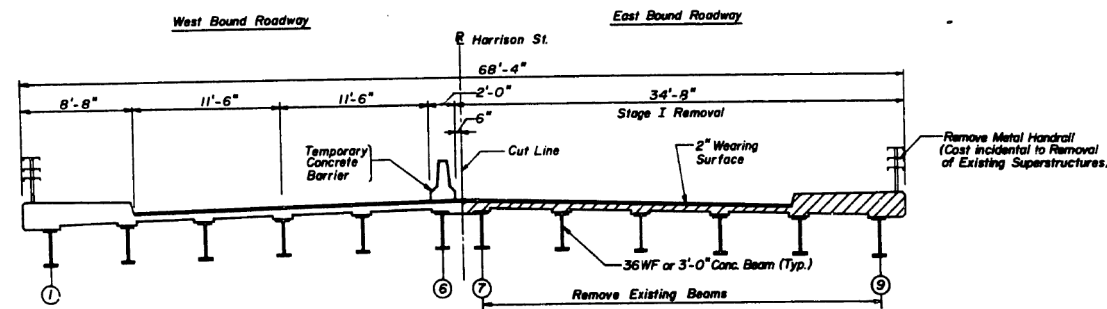


STAGE I

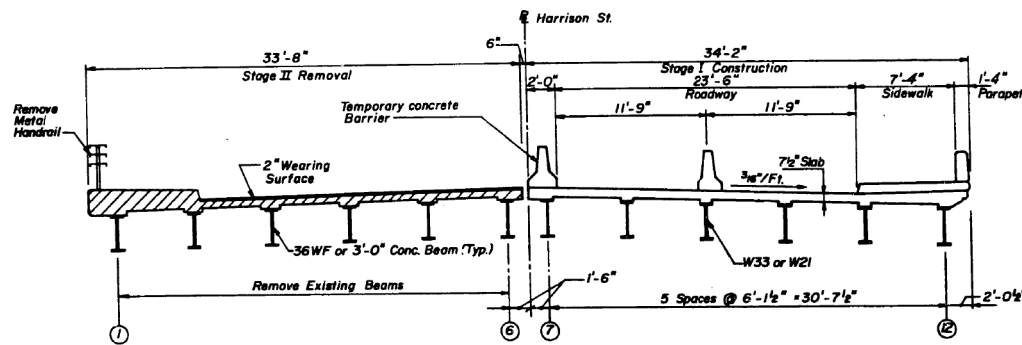

STAGE II

LEGEND

Removal of Existing Superstructure

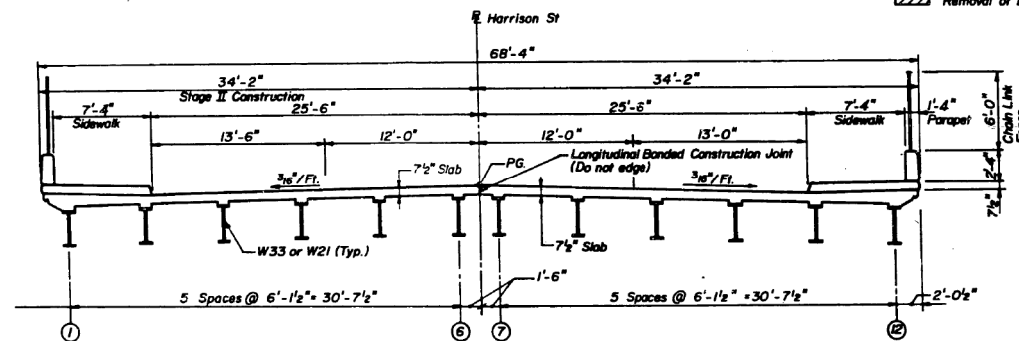

FINAL CROSS SECTION

SHEET S-3 OF S-17

REVISIONS	
NAME	DATE

PLANS PREPARED BY  
P.A. ENGINEERING ASSOCIATES, INC.  
600 WEST JACKSON BLVD.  
CHICAGO, ILLINOIS, 60601

STATE OF ILLINOIS  
DEPARTMENT OF TRANSPORTATION  
F.A.I. ROUTE 90/94 (DAN RYAN EXPRESSWAY)  
SECTION 1985-080 R - COOK COUNTY  
HARRISON STREET OVER DAN RYAN EXPRESSWAY  
STAGE CONSTRUCTION DETAILS

Scale: None      Drawn By: S.D.D.  
Date: AUGUST 14, 1987      Checked By:

ENVIROTHE ENGINEERS INC.  
Chicago, Illinois

D:\60W71-shr-AS-BUILT-06.dgn

USER NAME = dunkerleyb	DESIGNED -	REVISED
	CHECKED -	REVISED
PLOT SCALE = N.T.S.	DRAWN -	REVISED
PLOT DATE = 11/26/2013	CHECKED -	REVISED

STATE OF ILLINOIS  
DEPARTMENT OF TRANSPORTATION

EXISTING AS-BUILTS SN 016-1088

SHEET NO. AS-06 OF AS-72 SHEETS

F.A.I. RTE.	SECTION	COUNTY	TOTAL SHEETS	SHEET NO.
90/94/290	2013-036R	COOK	256	148
				CONTRACT NO. 60W71
ILLINOIS FED. AID PROJECT -NUMBER-				