


FOR INFORMATION ONLY

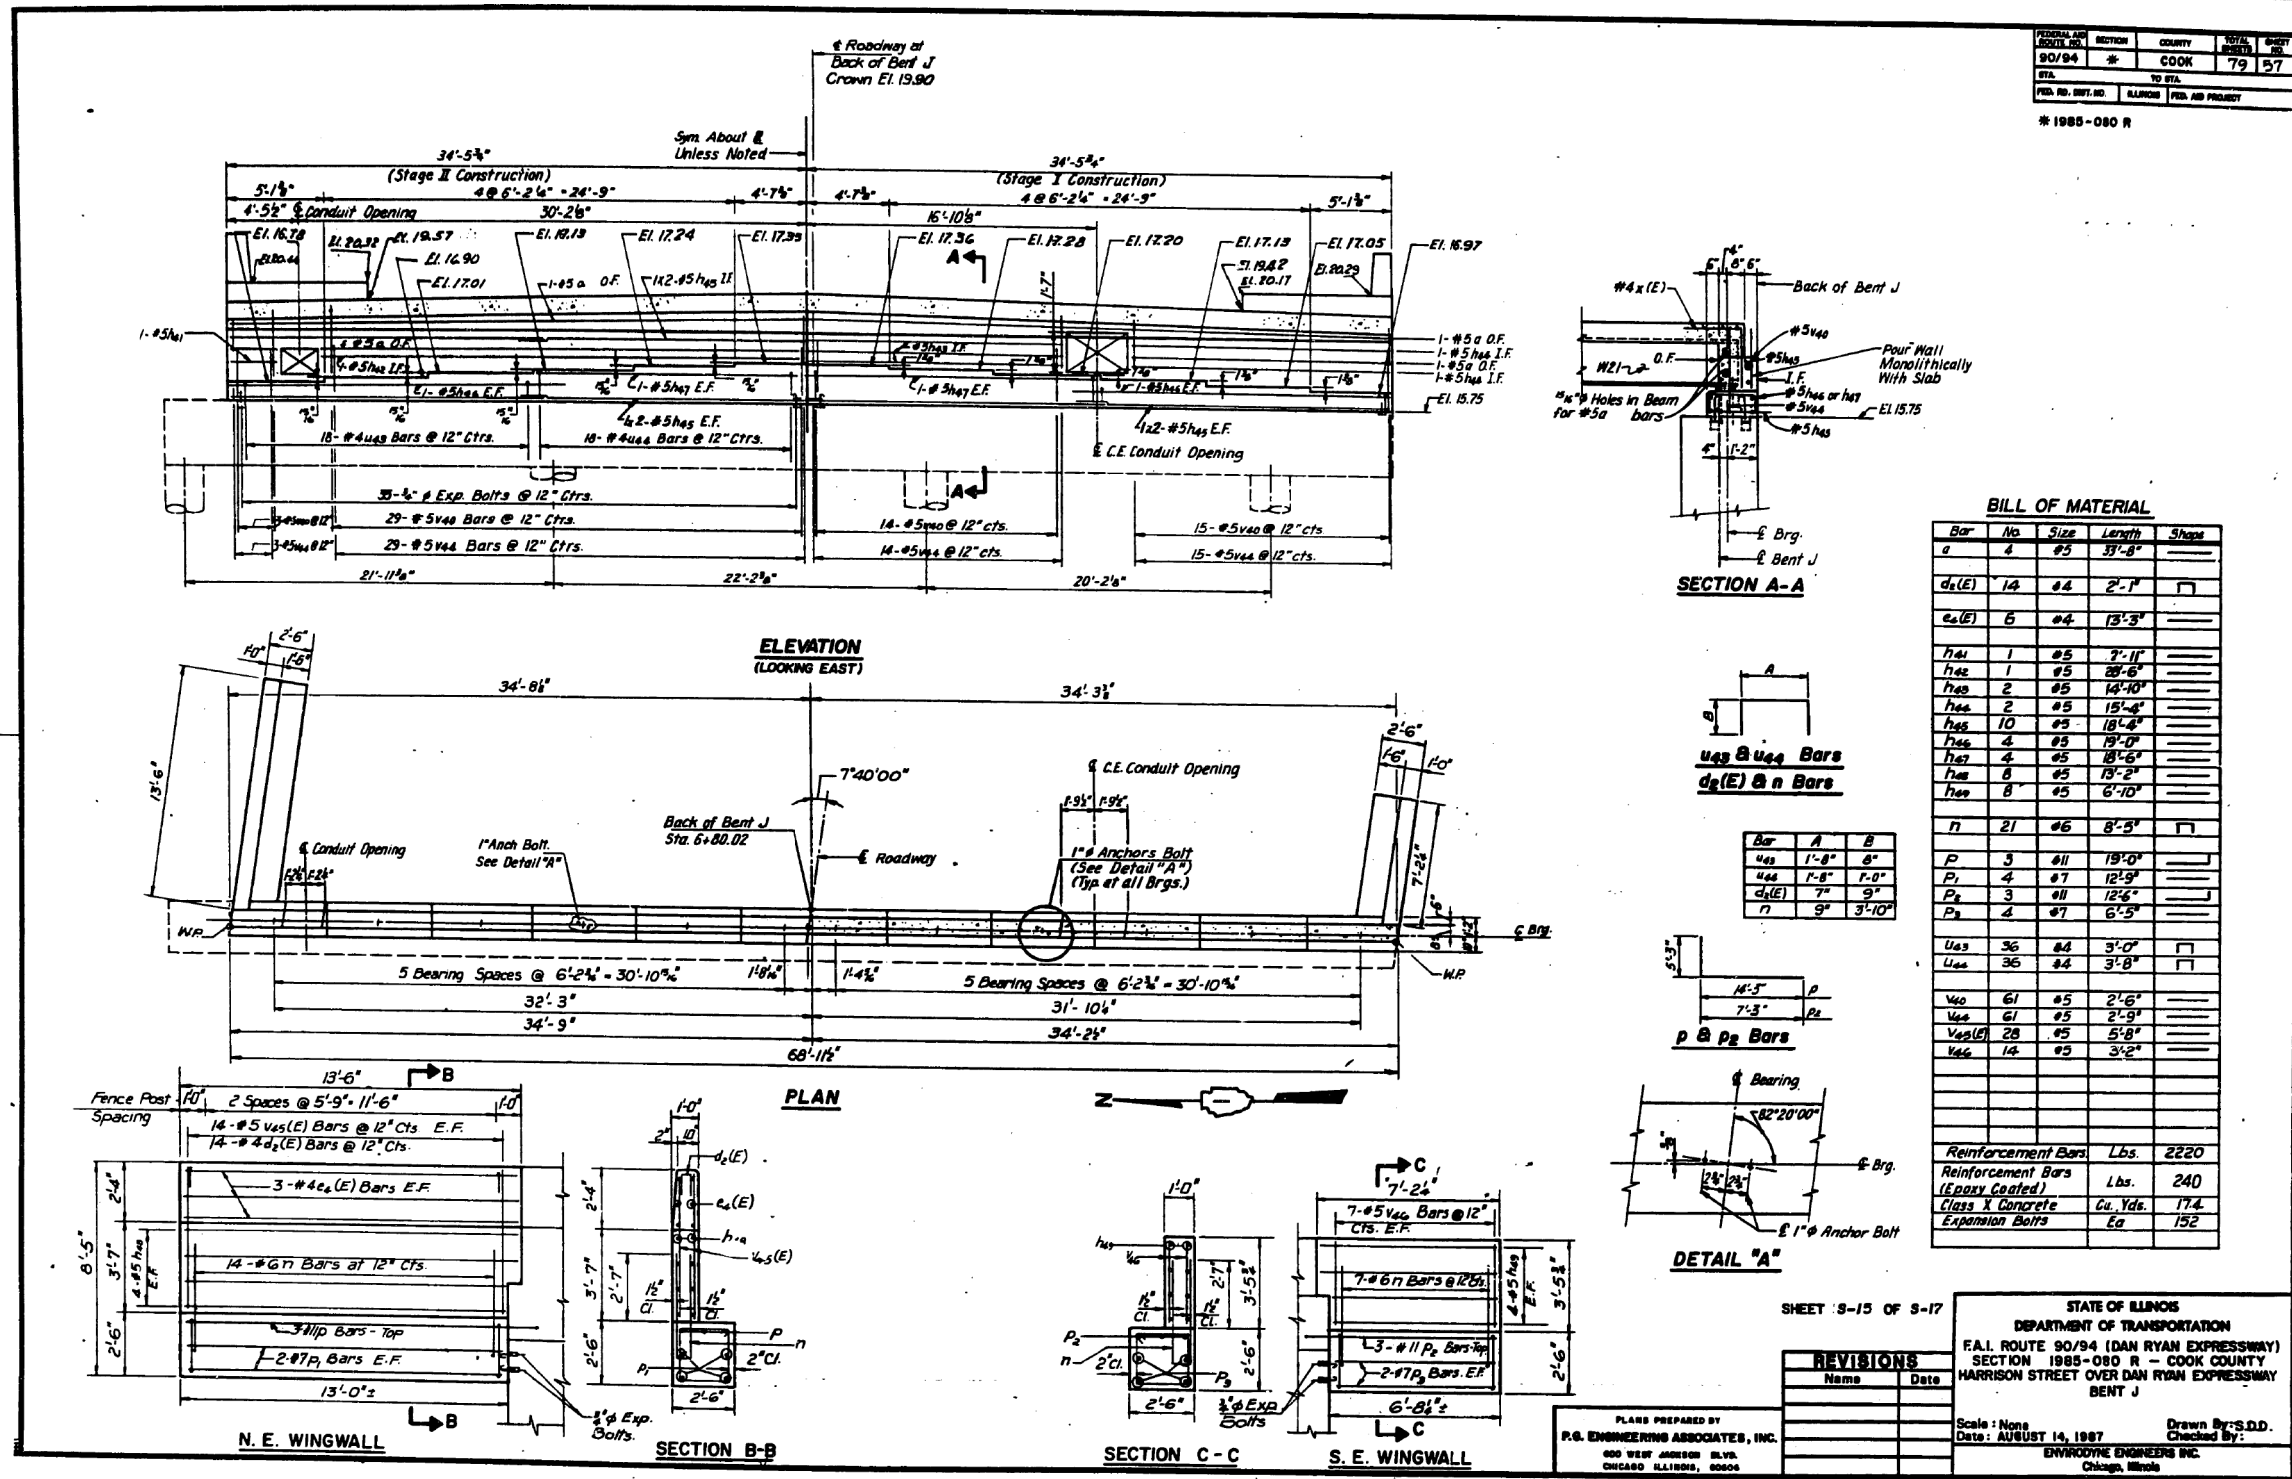

FEDERAL AID DISTRICT NO.	SECTION	COUNTY	TOTAL SHEETS	SHEET NO.
90/94	3	COOK	79	57
STA.	TO STA.			
FED. RD. DIST. NO.	ALIGNED	FED. AID PROJECT		
		* 1985-080 R		

STATE OF ILLINOIS  
DEPARTMENT OF TRANSPORTATION  
F.A.I. ROUTE 90/94 (DAN RYAN EXPRESSWAY)  
SECTION 1985-080 R - COOK COUNTY  
HARRISON STREET OVER DAN RYAN EXPRESSWAY  
BENT J

Scale: None  
Date: AUGUST 14, 1987  
Drawn By: S.D.D.  
Checked By: [Signature]

ENVIRODYNE ENGINEERS INC.  
Chicago, Illinois

PLANS PREPARED BY  
P.B. ENGINEERS ASSOCIATES, INC.  
400 WEST JANSSEN BLVD.  
CHICAGO ILLINOIS, 60604

USER NAME = dunkerleyb  
DESIGNED -  
CHECKED -  
PLOT SCALE = N.T.S.  
DRAWN -  
PLOT DATE = 11/26/2013  
CHECKED -

DESIGNED -  
CHECKED -  
DRAWN -  
CHECKED -

REVISED  
REVISED  
REVISED  
REVISED

STATE OF ILLINOIS  
DEPARTMENT OF TRANSPORTATION

EXISTING AS-BUILTS SN 016-1088

SHEET NO. AS-18 OF AS-72 SHEETS

F.A.I. R.T.E.	SECTION	COUNTY	TOTAL SHEETS	SHEET NO.
90/94/290	2013-036R	COOK	256	160
CONTRACT NO. 60W71				
ILLINOIS FED. AID PROJECT -NUMBER-				