
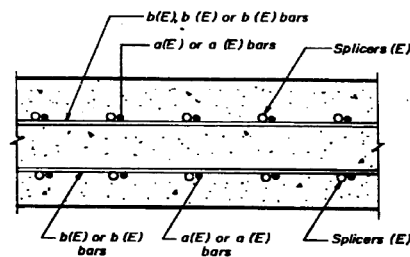


FOR INFORMATION ONLY

STATE OF ILLINOIS
DEPARTMENT OF TRANSPORTATION

ROUTE NO.	SECTION	COUNTY	DATE	SHEET NO.
90/94		COOK	79	56
STA.	1/2 STA.			
FILE NO. DIST. NO.	ILLINOIS	FILE AND PROJECT		
1985-080 R				

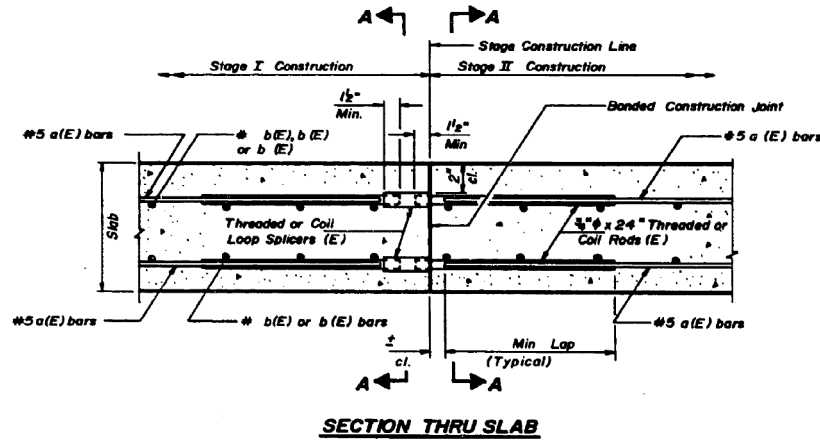

SECTION A-A

SPLICER DETAILS
(No Req'd.)

Cost incidental to reinforcement bars (Epoxy Coated)



Rolled Thread Dowel Bar


ONE PIECE

WIRE CONNECTOR

WELDED SECTIONS

SPLICER ALTERNATIVES

** Heavy Hex Nuts conforming to ASTM A563, Grade C, D or DH may be used.

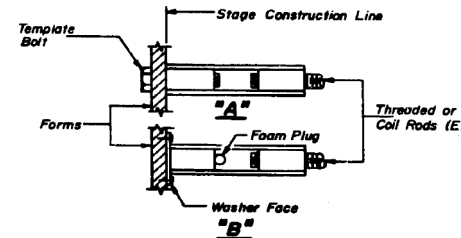

INSTALLATION AND SETTING METHODS


- "A" Set splicer by means of a template bar.
- "B" Set splicer by nailing to wood forms or cementing to steel forms.
- (E) Indicates epoxy coating, see Special Provisions

NOTES


Steel Splicer (Coupler) assembly shall be of an approved type and shall develop in tension at least 125 percent of the yield strength of the lapped reinforcement bars.
Steel Splicer rods shall be of minimum 60 ksi yield strength, threaded or coiled full length and have effective tensile stress area equal or greater than that of the lapped reinforcement bars.
Splicer rods shall extend minimum 1/2 inches into the couplers.
All reinforcement bars shall be lapped and tied to the splicer rods.
Splicer (coupler) assembly in the slab shall be epoxy coated in accordance with the requirements for reinforcement bars.
Other systems of similar design may be submitted to the Engineer for approval. Approval shall be based on certified test results from an approved testing laboratory that the proposed splicer (coupler) assembly satisfies the following requirements:
1 Minimum Capacity = $1.25 \times f_y \times A_s$
(Tension in kips)
2 Minimum Pull-out Strength = $1.25 \times f_{allow} \times A_s$
(Tension in kips)
Where f_y = Yield strength of lapped reinforcement bars in k.s.i.
 f_{allow} = Allowable tensile stress in lapped reinforcement bars in k.s.i. (Service Load)
 A_s = Tensile stress area of lapped reinforcement bars.
28 day concrete

Typical Splicer (Coupler) Assembly Sizes:

In Slabs	#5 bar lap with 3/8" Splicer (Coupler) x 2'-0" Splicer Rods	Minimum Capacity = 23.0 kips - tension
		Minimum Pull-out Strength = 9.2 kips - tension
In Sub-structures	#7 bar lap with 1" Splicer (Coupler) x 3'-5" Splicer Rods	Minimum Capacity = 45.1 kips - tension
		Minimum Pull-out Strength = 18.0 kips - tension
	#8 bar lap with 1 1/4" Splicer (Coupler) x 4'-6" Splicer Rods	Minimum Capacity = 58.9 kips - tension
		Minimum Pull-out Strength = 23.6 kips - tension

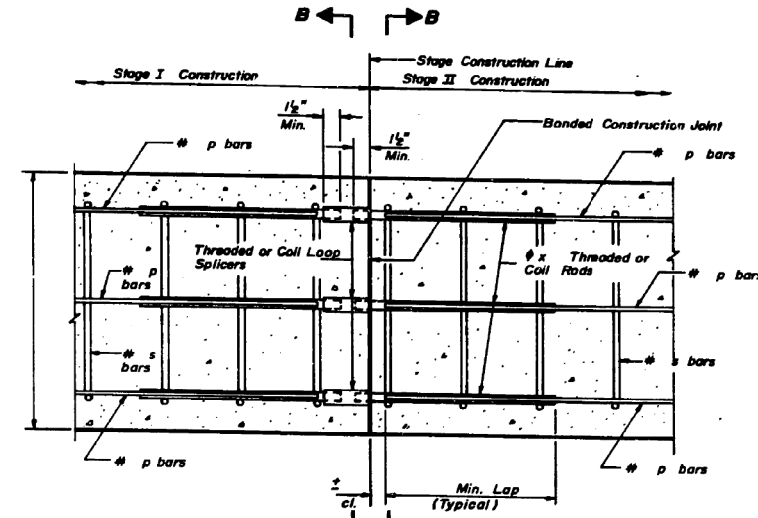

SECTION THRU ABUTMENTS AND PIERS
No epoxy coating required

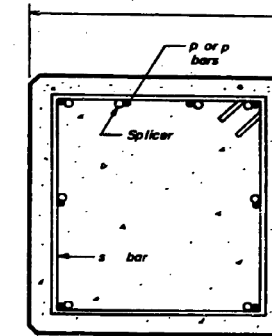

SECTION B-B

SPLICER DETAILS
(No Req'd.)

Cost incidental to reinforcement bars.

SHEET S-16 OF S-17

REVISIONS

NAME	DATE

PLANS PREPARED BY
P.E. ENGINEERING ASSOCIATES, INC.
600 WEST JACKSON BLVD.
CHICAGO, ILLINOIS, 60606

STATE OF ILLINOIS
DEPARTMENT OF TRANSPORTATION
F.A.I. ROUTE 90/94 (DAN RYAN EXPRESSWAY)
SECTION 1985-080 R - COOK COUNTY
HARRISON STREET OVER DAN RYAN EXPRESSWAY
SPLICER BAR DETAILS

Scale: None
Date: AUGUST 14, 1987
Drawn By: S.J.D.
Checked By: ENVIRONMENTAL ENGINEERS INC.
Chicago, Illinois

D:\GOW71-shr-AS-BUILT-19.dgn

USER NAME = dunkerleyb	DESIGNED -	REVISED
	CHECKED -	REVISED
PLOT SCALE = N.T.S.	DRAWN -	REVISED
PLOT DATE = 11/26/2013	CHECKED -	REVISED

STATE OF ILLINOIS
DEPARTMENT OF TRANSPORTATION

EXISTING AS-BUILTS SN 016-1088

SHEET NO. AS-19 OF AS-72 SHEETS

F.A.I. R.T.E.	SECTION	COUNTY	TOTAL SHEETS	SHEET NO.
90/94/290	2013-036R	COOK	256	161
				CONTRACT NO. 60W71
ILLINOIS FED. AID PROJECT -NUMBER-				