


FOR INFORMATION ONLY

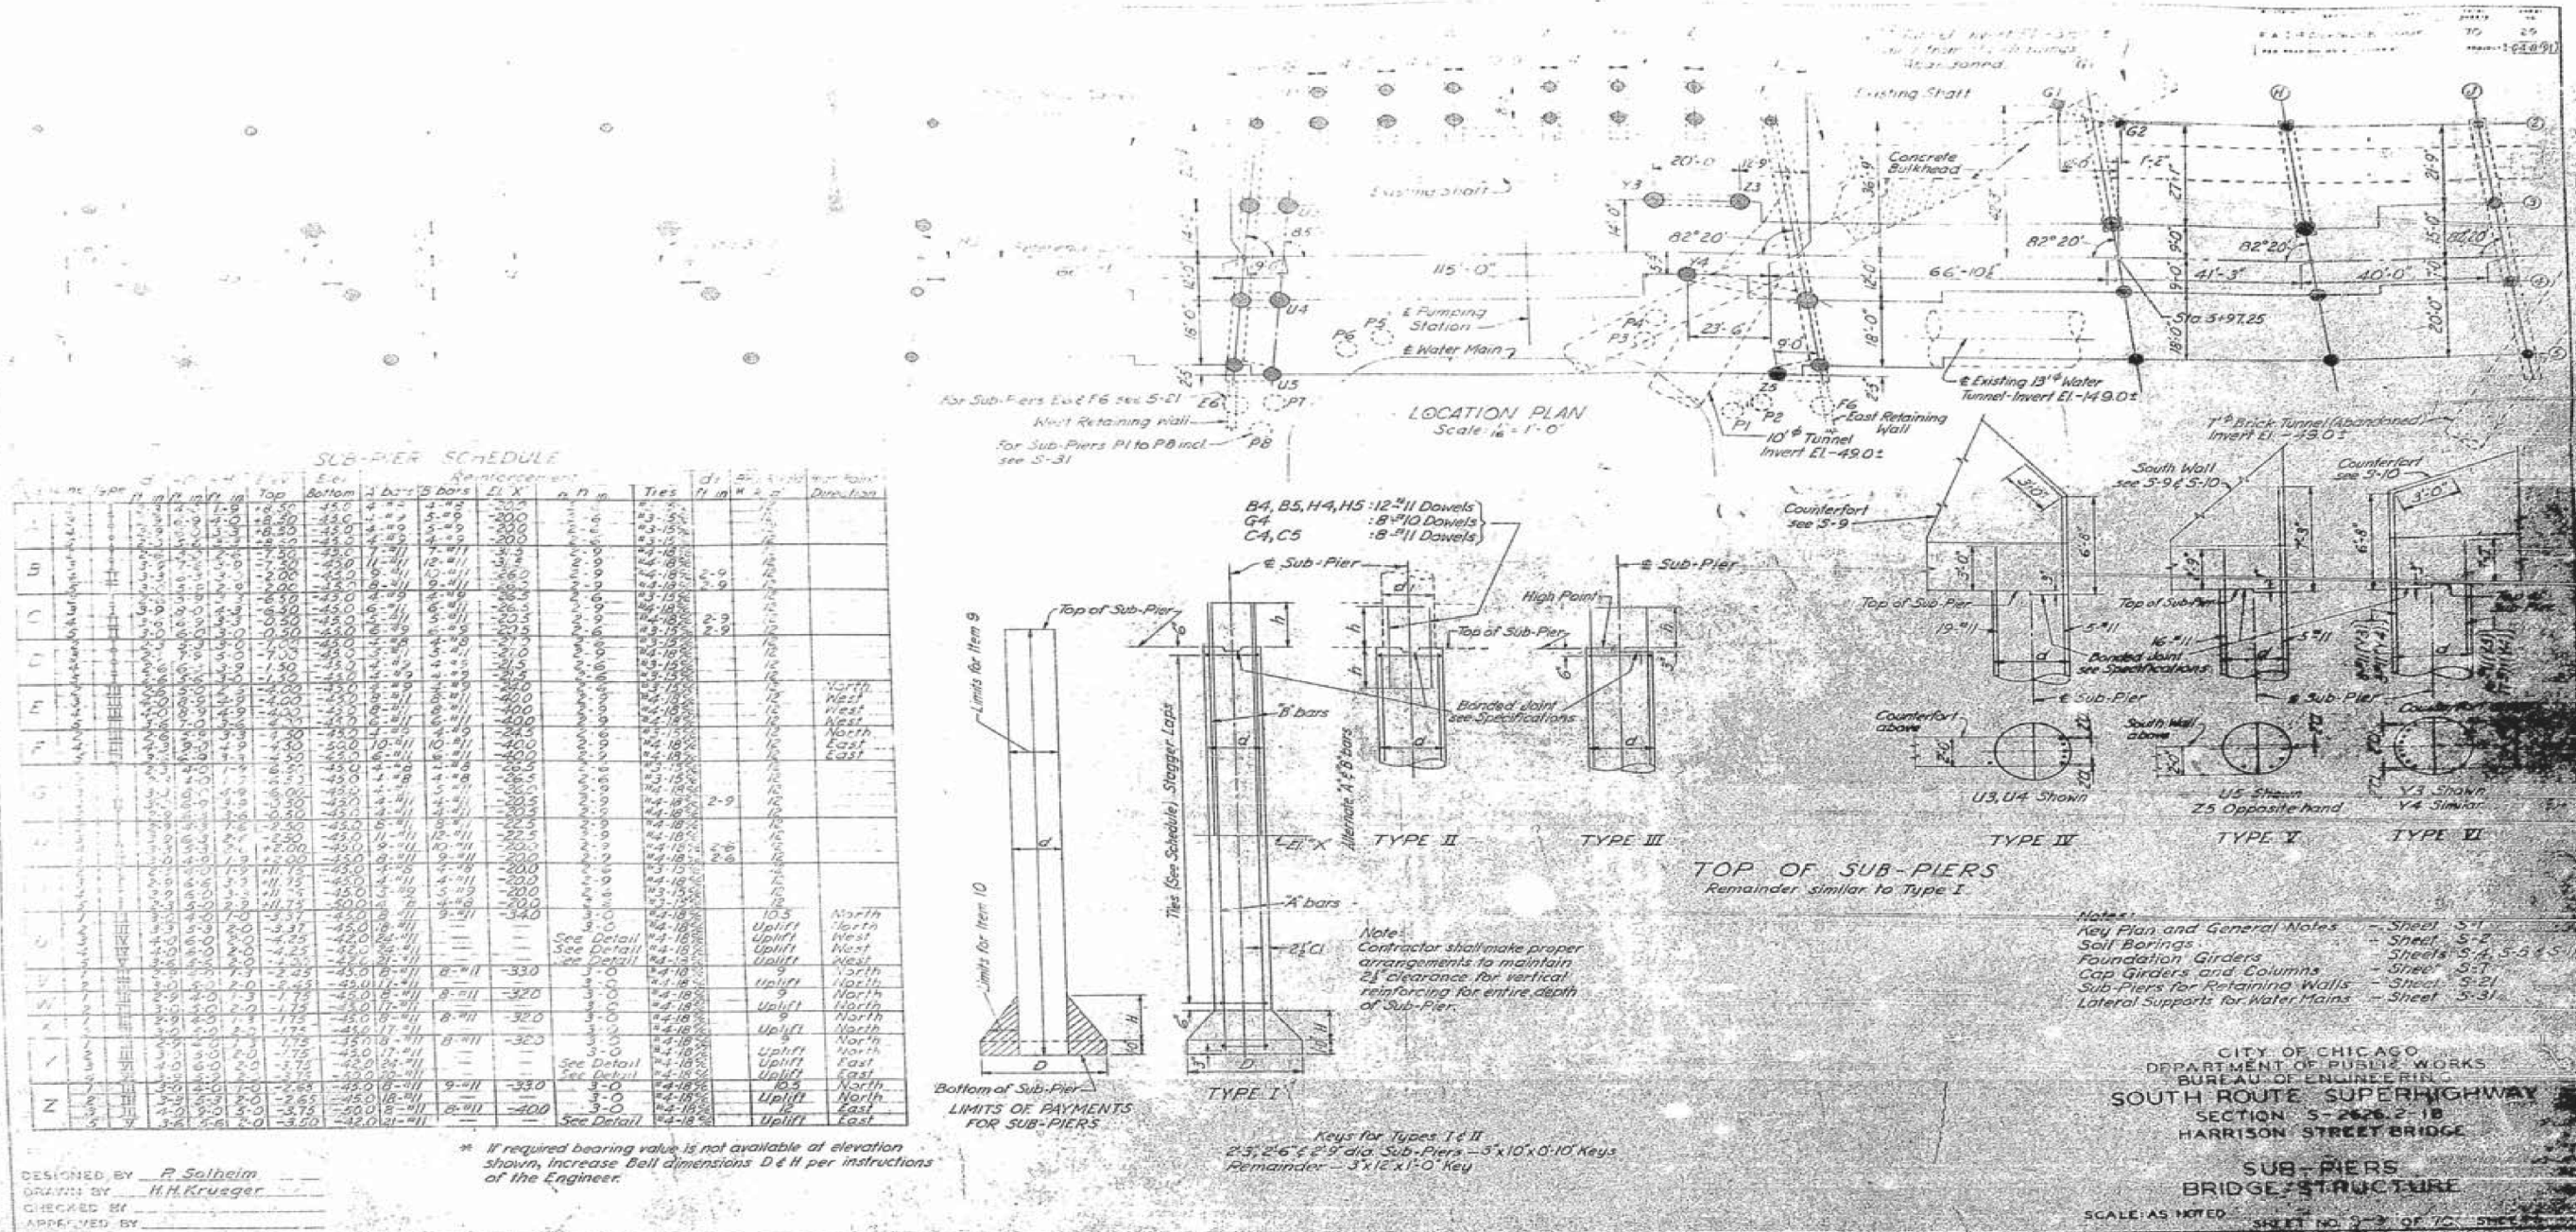

Sub-Pier	Top	Bottom	Notes	Uplift	Direction
U1	115.00	115.00			North
U2	115.00	115.00			West
U3	115.00	115.00			West
U4	115.00	115.00			North
U5	115.00	115.00			East
P1	115.00	115.00			North
P2	115.00	115.00			West
P3	115.00	115.00			West
P4	115.00	115.00			North
P5	115.00	115.00			North
P6	115.00	115.00			North
P7	115.00	115.00			North
P8	115.00	115.00			East

DESIGNED BY P. Solheim
 DRAWN BY H.H. Krueger
 CHECKED BY
 APPROVED BY

* If required bearing value is not available at elevation shown, increase Bell dimensions D & H per instructions of the Engineer.

Notes:
 Key Plan and General Notes - Sheet S-1
 Soil Borings - Sheet S-2
 Foundation Girders - Sheets S-3, S-4, S-5 & S-6
 Cap Girders and Columns - Sheet S-7
 Sub-Piers for Retaining Walls - Sheet S-21
 Lateral Supports for Water Mains - Sheet S-31

CITY OF CHICAGO
 DEPARTMENT OF PUBLIC WORKS
 BUREAU OF ENGINEERING
 SOUTH ROUTE SUPERHIGHWAY
 SECTION 5-26.2-1B
 HARRISON STREET BRIDGE
 SUB-PIERS
 BRIDGE STRUCTURE
 SCALE AS NOTED
 SHEET NO. 3-3 OF 10 SHEETS

D160W71-sht-AS-BUILT-32.dgn

USER NAME = dunkerleyb	DESIGNED -	REVISED	STATE OF ILLINOIS DEPARTMENT OF TRANSPORTATION	EXISTING AS-BUILTS SN 016-1088	F.A.I. R.E.	SECTION	COUNTY	TOTAL SHEETS	SHEET NO.
PLOT SCALE = N.T.S.	CHECKED -	REVISED			90/94/290	2013-036R	COOK	256	174
PLOT DATE = 11/26/2013	DRAWN -	REVISED			SHEET NO. AS-32 OF AS-72 SHEETS		CONTRACT NO. 60W71		ILLINOIS FED. AID PROJECT -NUMBER-