


FOR INFORMATION ONLY

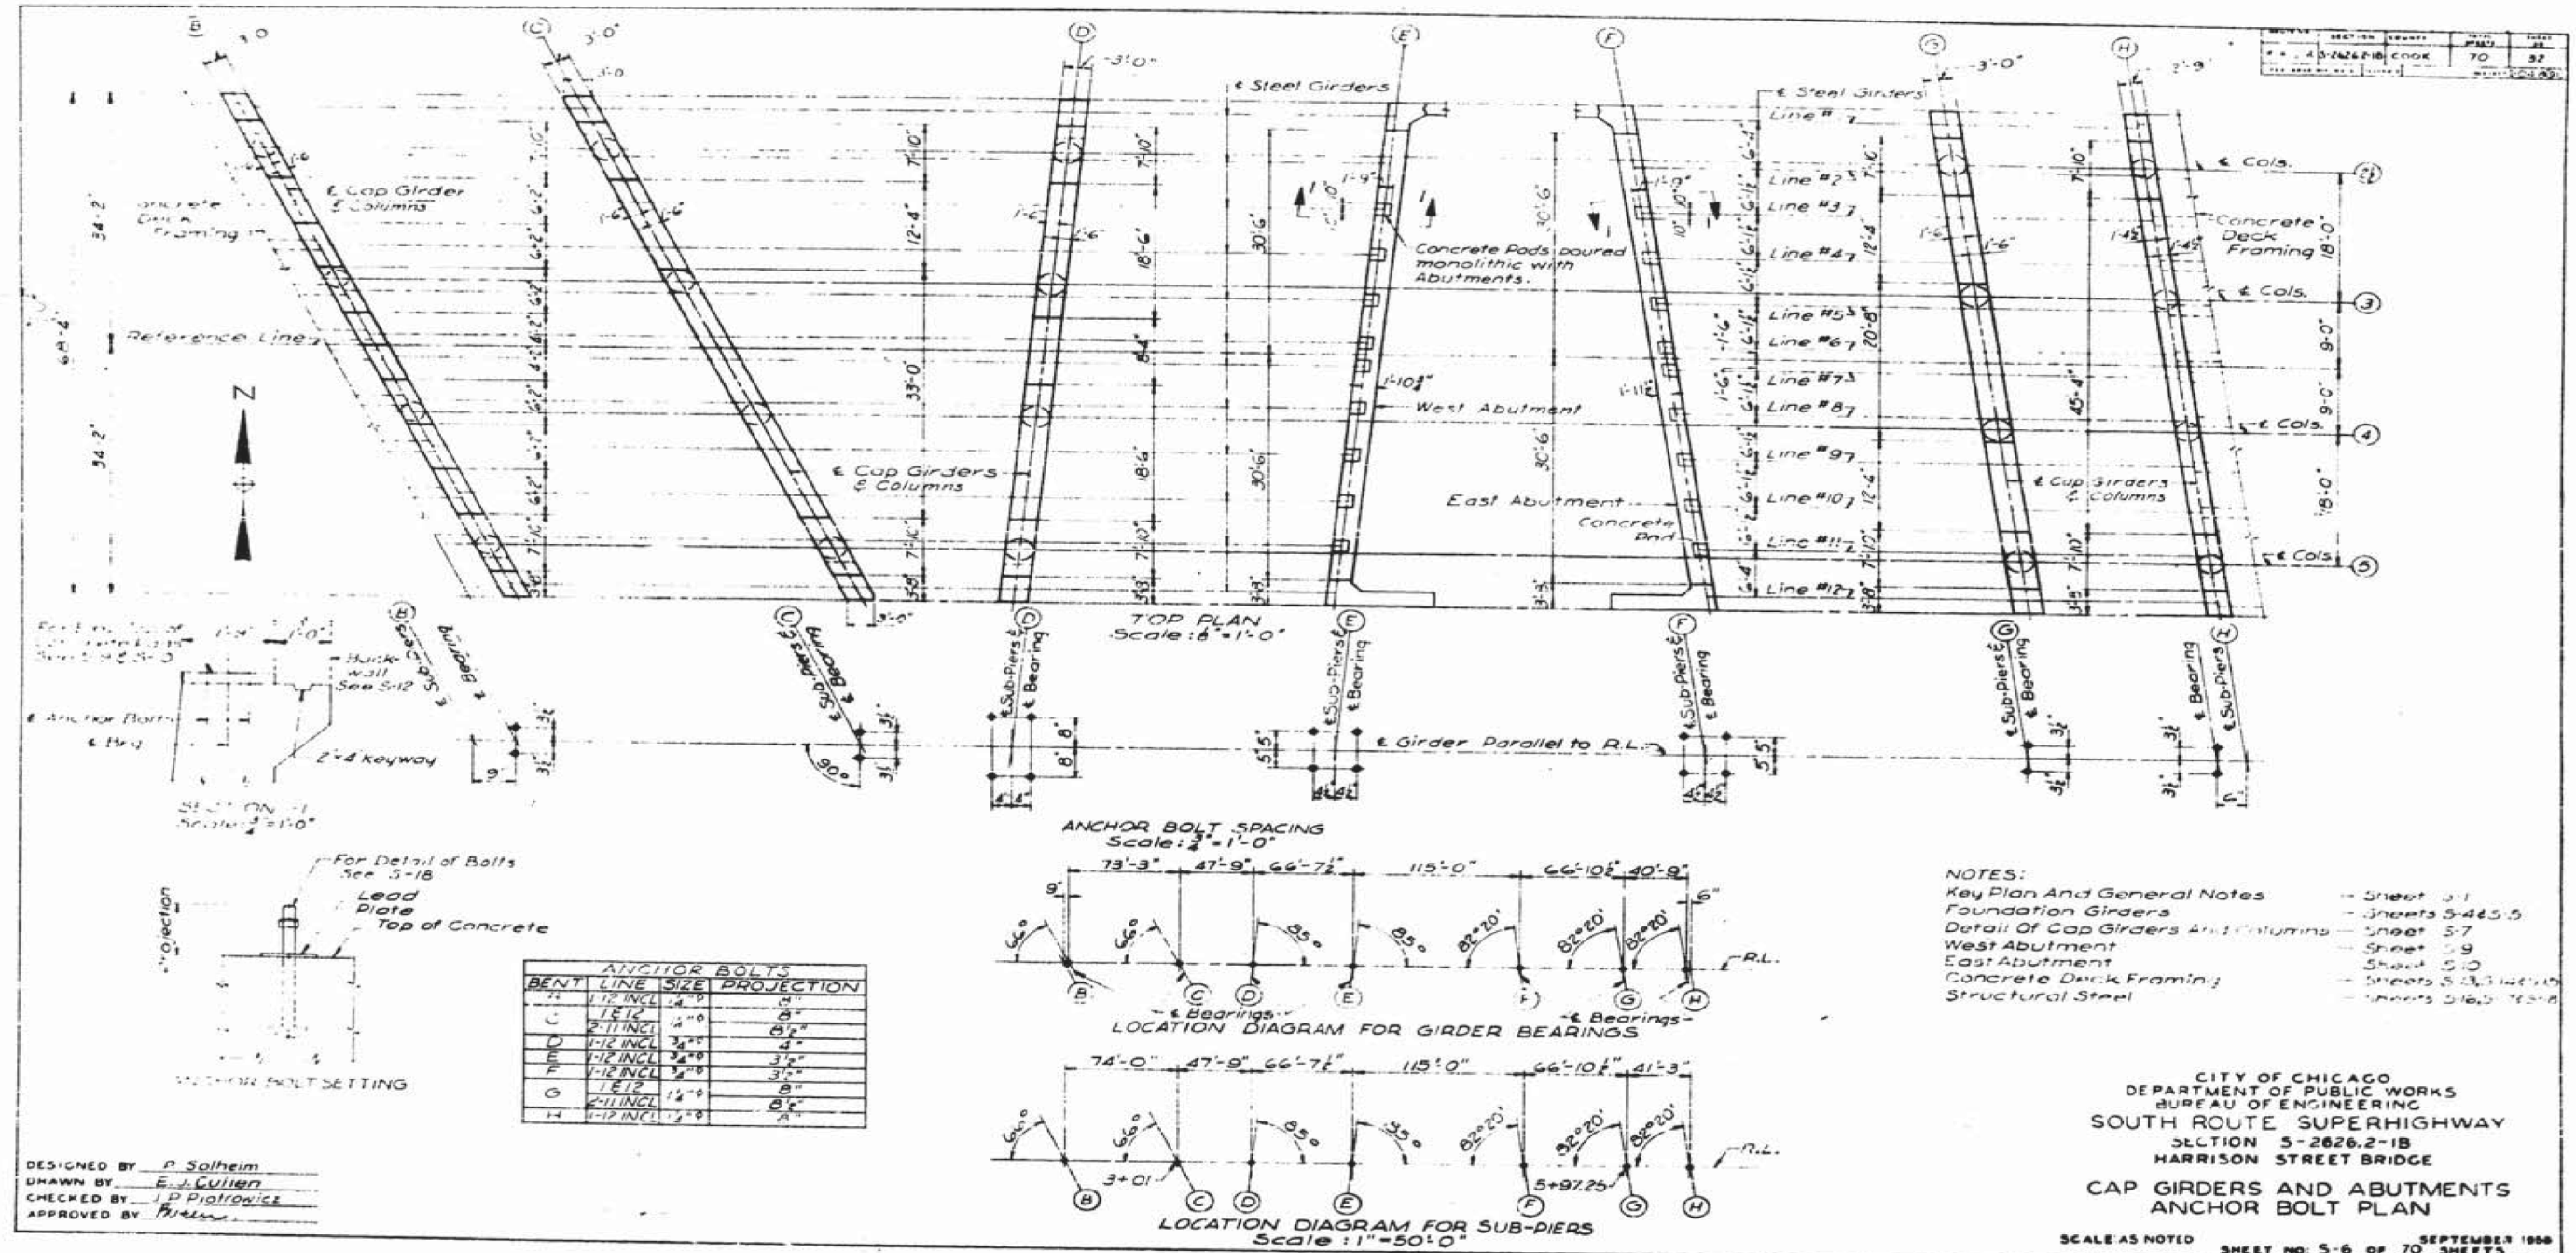

DESIGNED BY P. Solheim  
 DRAWN BY E. J. GILBERT  
 CHECKED BY J. P. PIATONICE  
 APPROVED BY [Signature]

D:\60W71-sht-AS-BUILT-35.dgn

USER NAME = dunkerleyb	DESIGNED -	REVISED
	CHECKED -	REVISED
PLOT SCALE = N.T.S.	DRAWN -	REVISED
PLOT DATE = 11/26/2013	CHECKED -	REVISED

STATE OF ILLINOIS  
 DEPARTMENT OF TRANSPORTATION

EXISTING AS-BUILTS SN 016-1088

SHEET NO. AS-35 OF AS-72 SHEETS

F.A.I. R.E. 90/94/290	SECTION 2013-036R	COUNTY COOK	TOTAL SHEETS 256	SHEET NO. 177
CONTRACT NO. 60W71				ILLINOIS FED. AID PROJECT -NUMBER-