


FOR INFORMATION ONLY

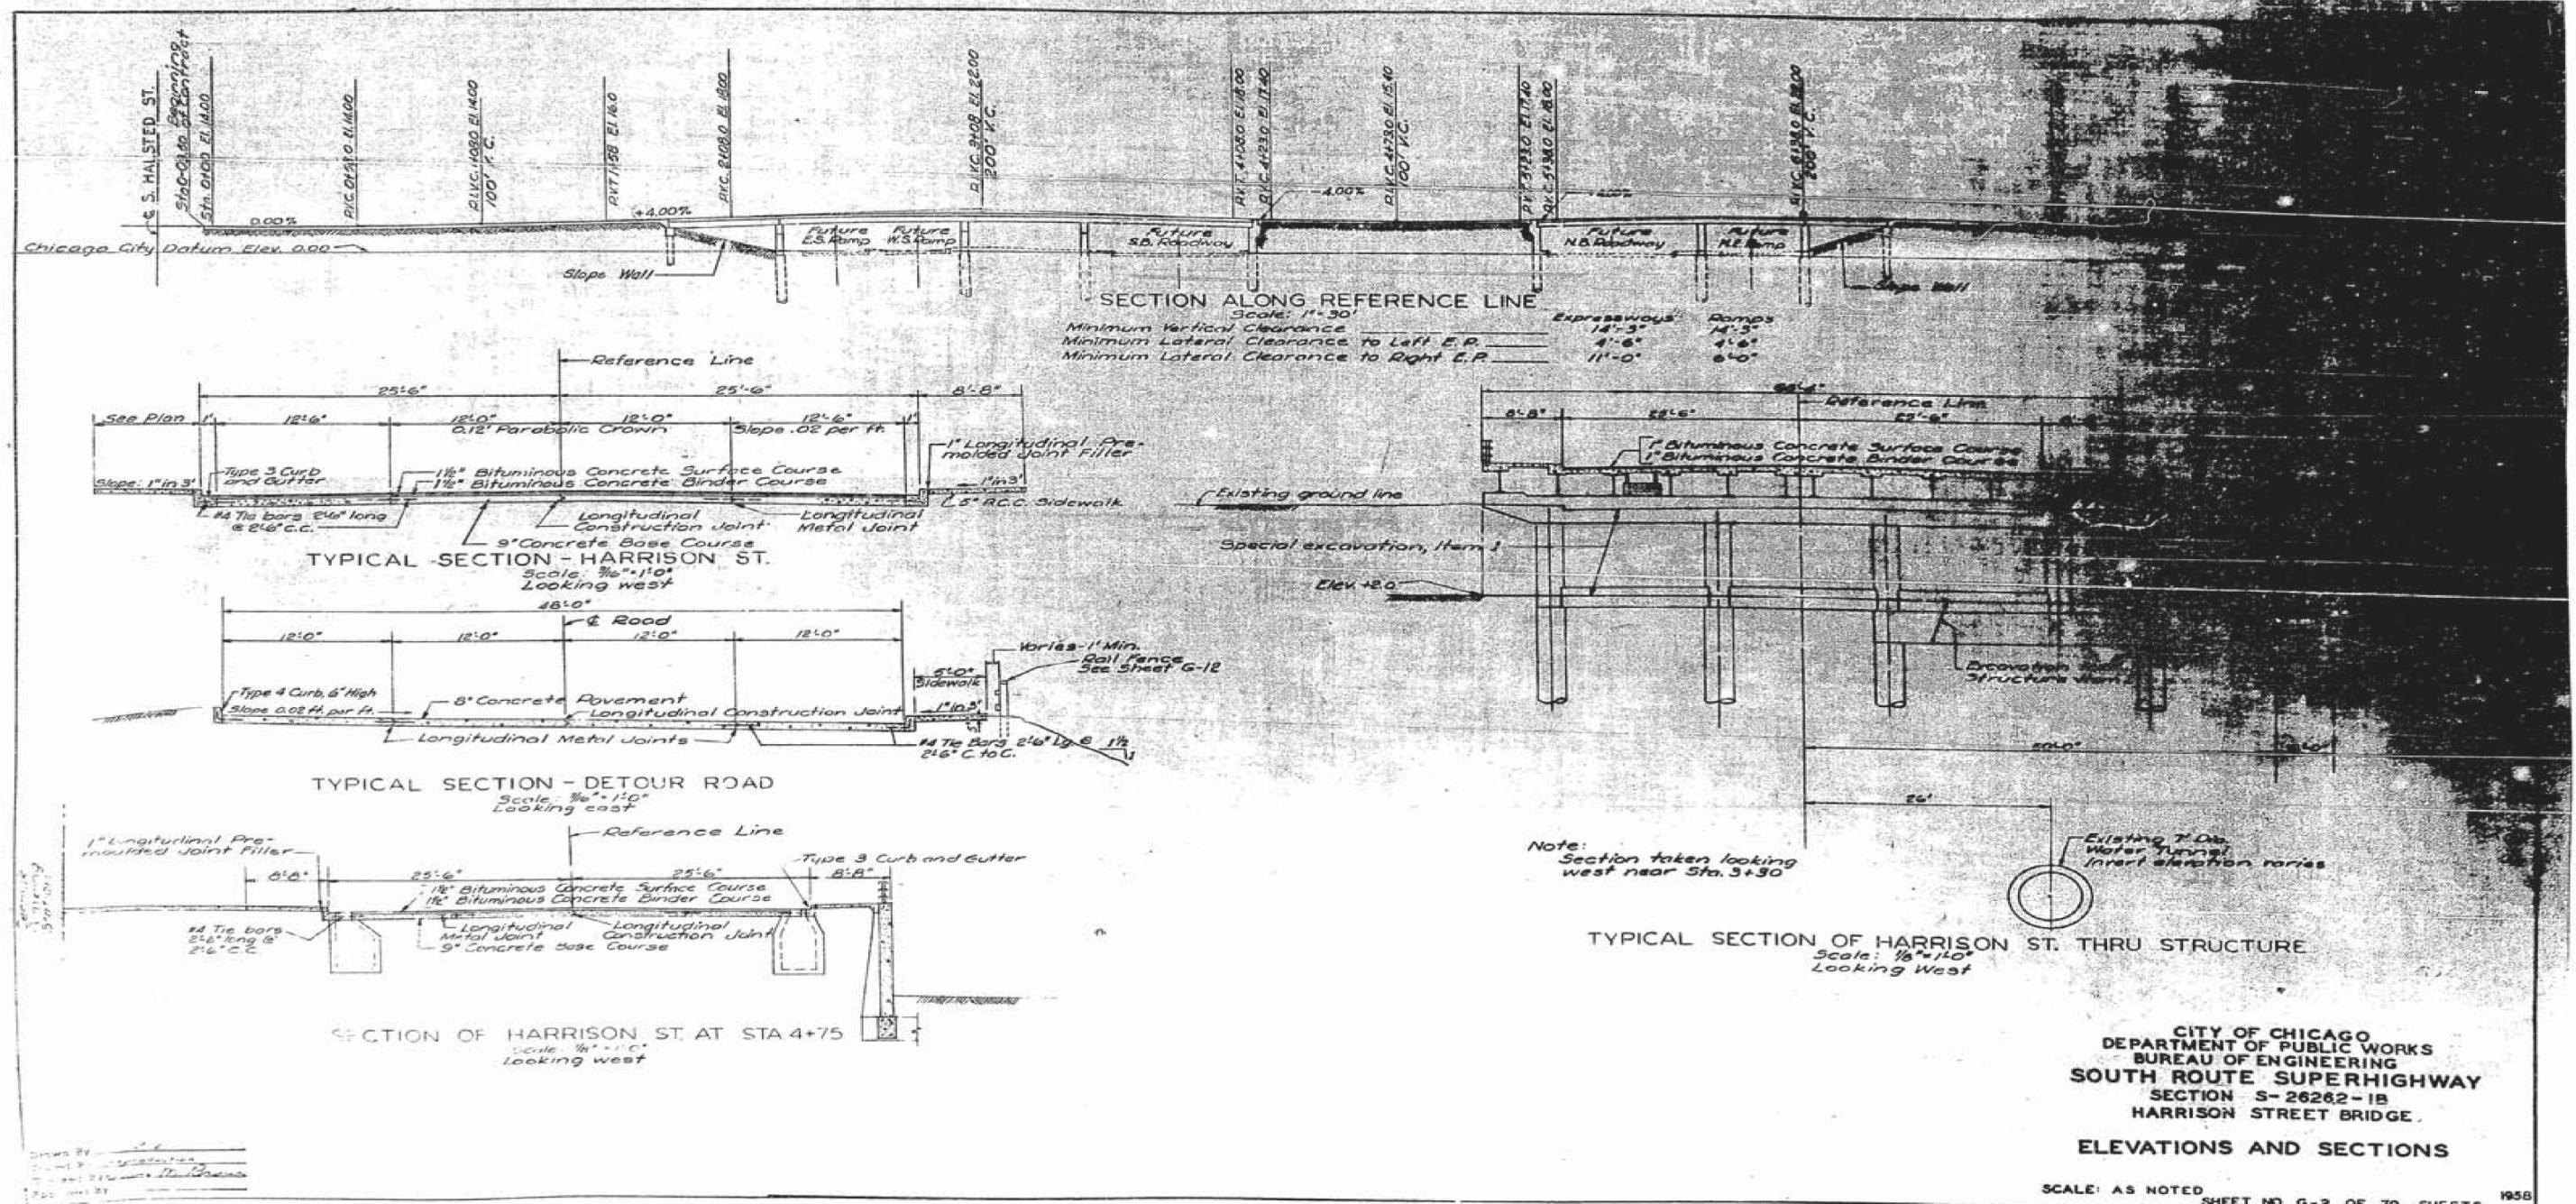

D:\6071-sht-AS-BUILT-40.dgn

USER NAME = dunkerleyb	DESIGNED -	REVISED
	CHECKED -	REVISED
PLOT SCALE = N.T.S.	DRAWN -	REVISED
PLOT DATE = 11/26/2013	CHECKED -	REVISED

STATE OF ILLINOIS  
DEPARTMENT OF TRANSPORTATION

EXISTING AS-BUILTS SN 016-1088

SHEET NO. AS-40 OF AS-72 SHEETS

F.A.I. RTE.	SECTION	COUNTY	TOTAL SHEETS	SHEET NO.
90/94/290	2013-036R	COOK	256	182
				CONTRACT NO. 60W71
ILLINOIS FED. AID PROJECT -NUMBER-				

SCALE: AS NOTED SHEET NO G-2 OF 70 SHEETS 1958